


1ST FLOOR - UNIT B SPRINKLER PLAN  
SCALE 1/8"=1'-0"

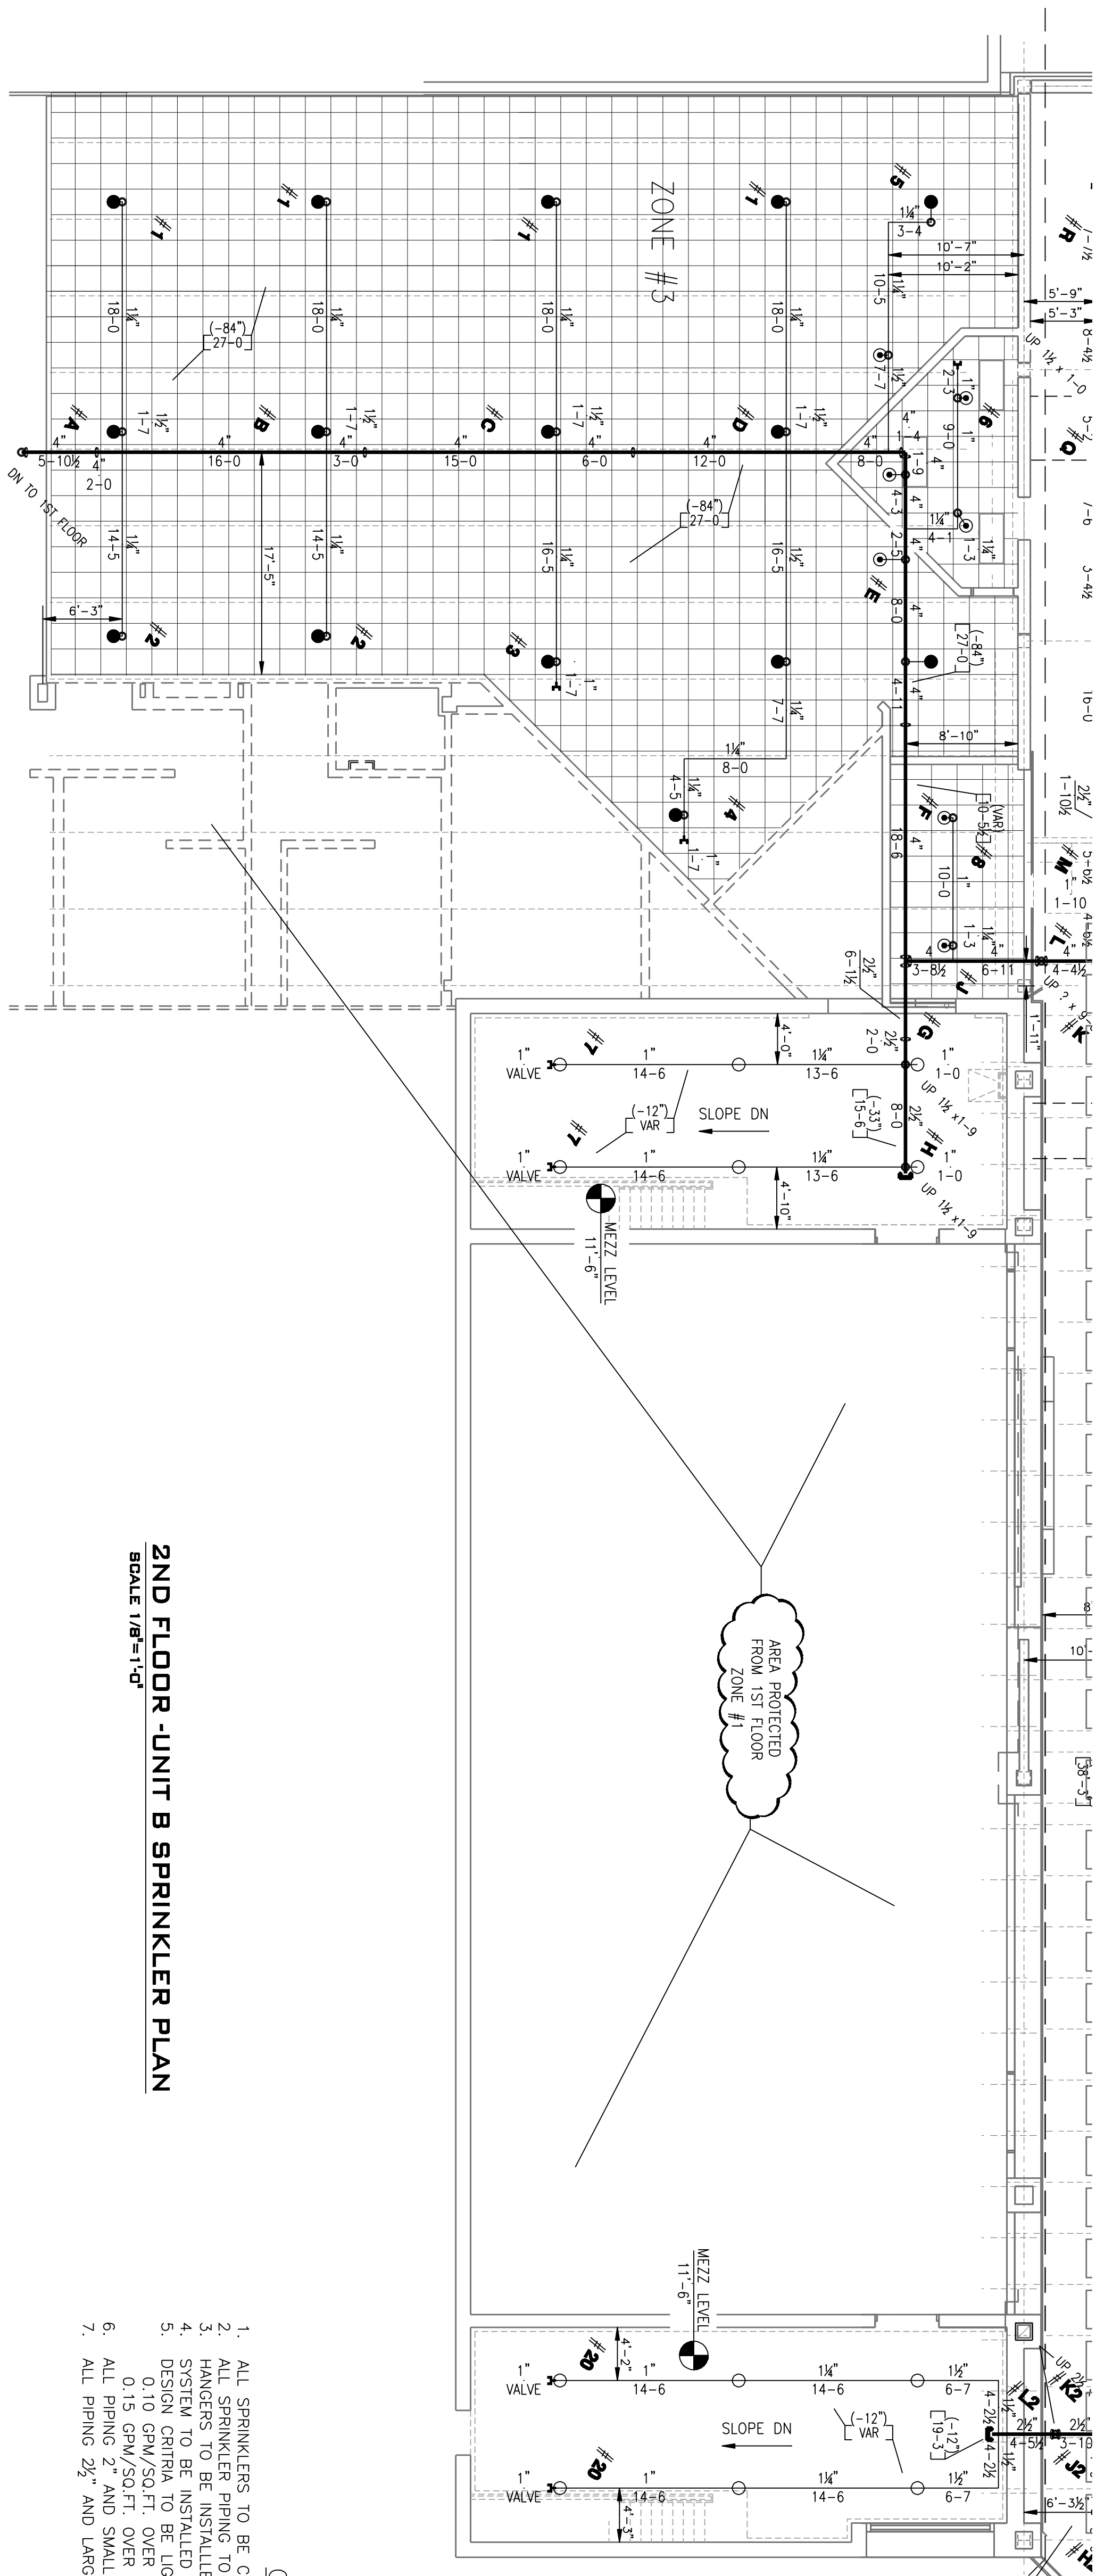


2ND FLOOR - UNIT B SPRINKLER PLAN  
SCALE 1/8"=1'-0"

**GENERAL NOTES**

- ALL SPRINKLERS TO BE CENTERED IN CEILING TILE (BOTH DIRECTIONS)
- ALL SPRINKLER PIPING TO HAVE LABELS AND MARKERS
- HANGERS TO BE INSTALLED AND LOCATED PER NFPA #13
- SYSTEM TO BE INSTALLED AND TESTED PER NFPA #13 AND AZADO GROUP 1.
- 0.10 GPM/50 FT. OVER 1500 SQ. FT. PLUS 100 GPM OF OUTSIDE HOSE
- 0.15 GPM/50 FT. OVER 1500 SQ. FT. PLUS 250 GPM OF OUTSIDE HOSE
- ALL PIPING 2" AND SMALLER TO BE SCH. 40 BLACK WITH C.I. FITTINGS.
- ALL PIPING 2 1/2" AND LARGER TO SCHEDULE 10 BLACK WITH GROVED FITTINGS.

**RISER DETAIL**

N.T.S.

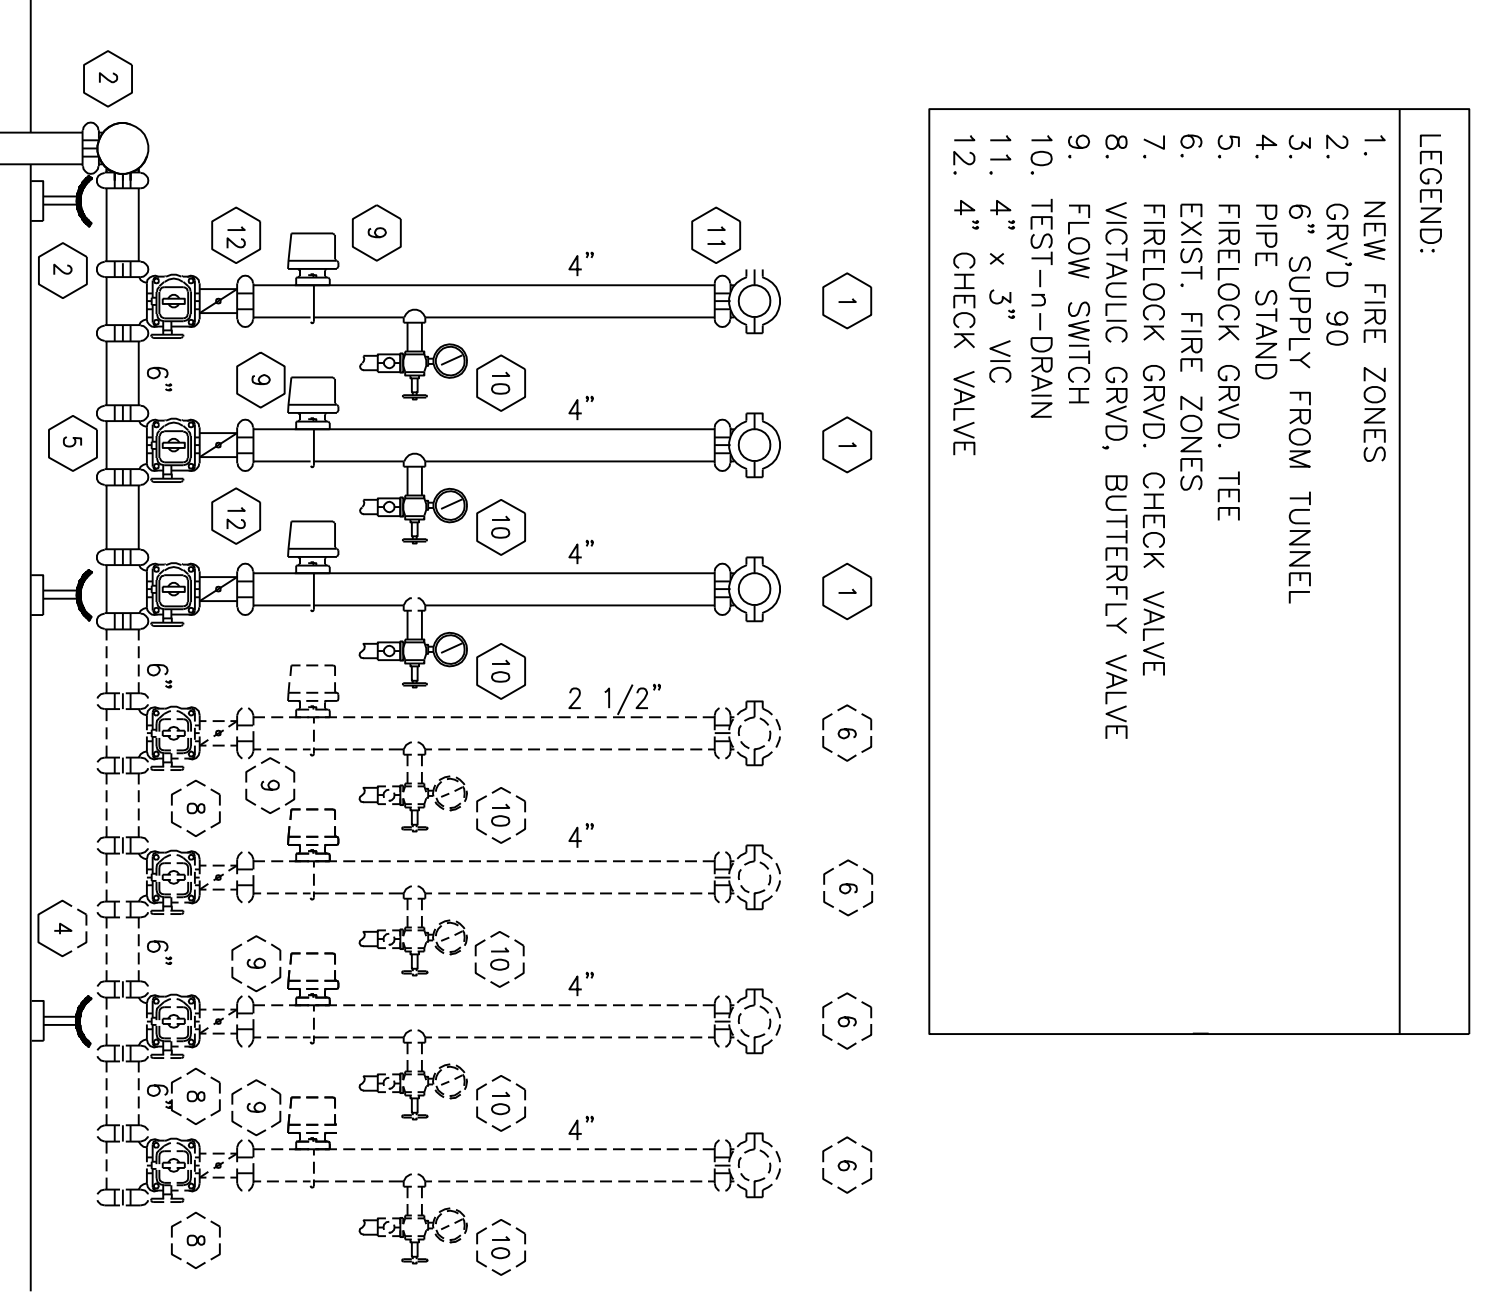

- LEGEND:**
- NEW FIRE ZONES
  - GRID/90
  - SPRINKLER FROM TUNNEL
  - FIRELOCK GRD. TEE
  - EXIST. FIRE ZONES
  - FIRELOCK GRD. CHECK VALVE
  - VICI/AULC GRD. BUTTERFLY VALVE
  - FLOW SWITCH
  - FEST-DRAIN
  - 4" CHECK VALVE
  - 4" CHECK VALVE

NO. DATE		REVISIONS	
#	DATE	DESCRIPTION	BY/CHK

FLOW INFORMATION	
CITY STATIC PRESSURE	58 PSF
RESIDUAL PRESSURE	54 PSF
PIPE SIZING BASED ON	CALCS.
PUMP RATED CAPACITY	N/A GPM
RATED PRESSURE	N/A PSI

SYSTEMS DESIGN CRITERIA			
WET	<input type="checkbox"/> DRY	<input type="checkbox"/> DELUGE	<input type="checkbox"/> PRE-ACTION
SO. FI.	WMA	HARD SPRING	
HYDRAULIC CALCULATIONS			
DESIGN	50 PSI		

PIPE / FITTING MATERIAL			
UNES	SCH. 40 BLK STL	UNES	125 CAST IRON HUB
OTHER	OTHER	OTHER	OTHER

SPRINKLER HEAD SYMBOLS:			
1	ROSS OR THERM	RS RK43	RS
2	ROSS OR THERM	RS RK41	RS
3	ROSS OR THERM	RS RK41	RS
**GRUNAUL COMPANY, LLC**  
AS-BUILT DRAWING

**PROJECT: LAWRENCE CENTRAL HIGH SCHOOL**  
INDIANAPOLIS, IN

APP. NO.	40834	DATE	7/1/2007
ENGINEER	BOR HARLOW	DRAWN BY	BH
CHECKED BY	BH	DATE	7/1/2007
SCALE	1/8"=1'-0"		
PROJECT	INDIANAPOLIS, IN		

**GRUNAUL**  
FIRE PROTECTION SYSTEMS  
4341 W. 96TH STREET  
INDIANAPOLIS, IN 46268

FP3 of FP6