ADDENDUM NO. 3

February 25, 2022

DOUGLAS MACARTHUR ELEMENTARY SCHOOL ADDITIONS, RENOVATIONS, AND RELATED WORK

Crown Point, IN 46307

TO: ALL BIDDERS OF RECORD

This Addendum forms a part of and modifies the Bidding Requirements, Contract Forms, Contract Conditions, the Specifications, and the Drawings dated January 31, 2022 by Gibraltar Design. Acknowledge receipt of the Addendum in the space provided on the Bid Form. Failure to do so may subject the Bidder to disqualification.

This Addendum consists of Pages ADD 3-1 through ADD 3-3 and attached Addendum No. 3 from Gibraltar Design dated February 24, 2022 and consisting of 10 pages, Specification Sections 33 11 00 - Water Distribution Systems, 33 11 50 - Exterior Water Lines, Fire Lines, and Facilities, 33 13 00 - Disinfection of Water Distribution System, and 88 drawings.

A. <u>SPECIFICATION SECTION 00 00 20 - TABLE OF CONTENTS</u>

1. **Add:**

- 1. Specification Section 33 11 00 Water Distribution Systems
- 2. Specification Section 33 11 50 Exterior Water Lines, Fire Lines, and Facilities
- 3. Specification Section 33 13 00 Disinfection of Water Distribution System

B. SPECIFICATION SECTION 01 12 00 - MULTIPLE CONTRACT SUMMARY

1. <u>BID CATEGORY NO. 1 - GENERAL TRADES</u>

1. **Add:**

- 1. Specification Section 33 11 00 Water Distribution Systems
- 2. Specification Section 33 11 50 Exterior Water Lines, Fire Lines, and Facilities
- 3. Specification Section 33 13 00 Disinfection of Water Distribution System

Clarification No. 25:

Reference drawing sheet C3.0, all work associated with the youth baseball field shall be provided by the **Bid Category No. 1 Contractor**.

2. Replace:

Clarification No. 23:

Reference the AD Drawings; the **Bid Category No. 2 Contractor** shall provide all work indicated on Note 85. the **Bid Category No. 3 Contractor** shall provide all work indicated on Notes 37, 39 and 42. The **Bid Category No. 4 Contractor** shall provide all work indicated on Notes 40 and 73. The **Bid Category No. 5 Contractor** shall provide all work indicated on Note 86. All other notes are the responsibility of the **Bid Category No. 1 Contractor** unless otherwise noted.

2. BID CATEGORY NO. 2 - MASONRY

1. **Add:**

Clarification No. 8:

Reference the AD Drawings; the **Bid Category No. 2 Contractor** shall provide all work indicated on Note 85. the **Bid Category No. 3 Contractor** shall provide all work indicated on Notes 37, 39 and 42. The **Bid Category No. 4 Contractor** shall provide all work indicated on Notes 40 and 73. The **Bid Category No. 5 Contractor** shall provide all work indicated on Note 86. All other notes are the responsibility of the **Bid Category No. 1 Contractor** unless otherwise noted.

Clarification No. 9:

The **Bid Category No. 2 Contractor** shall provide all work indicated on Detail 10 on drawing sheet S-413.

3. BID CATEGORY NO. 3 - ROOFING

1. Replace:

Clarification No. 7:

Reference the AD Drawings; the **Bid Category No. 2 Contractor** shall provide all work indicated on Note 85. the **Bid Category No. 3 Contractor** shall provide all work indicated on Notes 37, 39 and 42. The **Bid Category No. 4 Contractor** shall provide all work indicated on Notes 40 and 73. The **Bid Category No. 5 Contractor** shall provide all work indicated on Note 86. All other notes are the responsibility of the **Bid Category No. 1 Contractor** unless otherwise noted.

4. BID CATEGORY NO. 4 - ALUMINUM ENTRANCES/GLAZING

1. Replace:

Clarification No. 4:

Reference the AD Drawings; the **Bid Category No. 2 Contractor** shall provide all work indicated on Note 85. the **Bid Category No. 3 Contractor** shall provide all work indicated on Notes 37, 39 and 42. The **Bid Category No. 4 Contractor** shall provide all work indicated on Notes 40 and 73. The **Bid Category No. 5 Contractor** shall provide all work indicated on Note 86. All other notes are the responsibility of the **Bid Category No. 1 Contractor** unless otherwise noted.

5. BID CATEGORY NO. 5 - METAL STUDS/DRYWALL/CEILINGS

1. **Add:**

Clarification No. 6:

Reference the AD Drawings; the **Bid Category No. 2 Contractor** shall provide all work indicated on Note 85. the **Bid Category No. 3 Contractor** shall provide all work indicated on Notes 37, 39 and 42. The **Bid Category No. 4 Contractor** shall provide all work indicated on Notes 40 and 73. The **Bid Category No. 5 Contractor** shall provide all work indicated on Note 86. All other notes are the responsibility of the **Bid Category No. 1 Contractor** unless otherwise noted.



ADDENDUM THREE

Addendum Three (AD.03) to the drawings and specifications prepared by Gibraltar Design for **MacArthur Elementary School Additions & Renovations** for Crown Point Community School Corporation, Crown Point, Indiana.

All Contractors bidding on this project shall read all of the items covered below and shall comply with all of the requirements as set forth, including any necessary refinements or additions generated by this Addendum and required by the intent of the original contract documents. All Contractors shall acknowledge on their bid form that they have received this Addendum, Addendum One and Addendum Two, and include the appropriate content of same within their bid proposal.

GENERAL

A. Question: I see all the TV's and projectors being removed on the demo drawings (demolition note 7), it appears as though we're being asked to include that in our bid. There is no mention of reinstalling them on the T-xxxx series drawings. Will these be reinstalled by the school or another entity or should these be factored into the bid?

Answer: Yes, Demo Note Scope is included in the Project. Most of the classroom projectors are sitting on portable carts and have no permanent cabling. New devices will be provided in a latter bid package. Addendum #3 modifies the Demo Note 7.

B. Question: What kind of termination is needed at the LCD clocks?

Answer: See Sheet T001 Symbol Legend for LED Clock Cabling Requirements (One data cable is required per clock location).

C. Question: Existing cameras that are to be reinstalled, are we running new data lines to them? Asking because there's a specific termination called out for them on T501.

Answer: For the "T" series sheets "ALL" camera locations, require a new Category 6 cable. Some locations shown on the floor plans correspond to existing cameras that are to be re-installed, other locations will receive new cameras in a future bid package. Detail #10 "Above Ceiling Outlet" on Sheet T501, does depict the termination requirements for all ceiling mounted Cameras. See updated T501 drawing issued with Addendum #3 that clarifies the drawing symbols.

D. Question: In some rooms such as A106 (T104 drawing) I see local input duplex jack but no TV or monitor to output to. How should these situations be handled, should we assume, there will be a TV or do you want it coiled in the ceiling for future use? On the other hand in other rooms A132 (T104) as an example I see a duplex jack next to a TV but no local input. Do we want to run HDMI and USB (local input) cables to all TV's or are the drawings correct and these are just being run off of a data drop?

Answer: TV's located in Classrooms and/or offices should have an associated "LI" however there are a few TV locations like in a Hallway or the Cafeteria that do not have an associated "LI". See updated floor plan drawings being issued in



Addendum #3 for plan updates that include the appropriate outlet types. You do not need to provide the HDMI and USB Cables as part of this Bid.

SPECIFICATIONS

1. Specification Section 00 01 10 Table of Contents

- A. Add the following Specification Sections to the Table of Contents:
 - 1. Section 33 11 00, Water Distribution Systems.
 - 2. Section 33 11 50, Exterior Water Lines, Fire Lines, and Facilities.
 - 3. Section 33 13 00, Disinfection of Water Distribution System.

2. Specification Section 08 71 00 Door Hardware

A. Replace Paragraph 3.8 of Specification Section 08 71 00, Door Hardware, with updated Paragraph 3.8 included in this Addendum.

3. Specification Section 09 51 00 Acoustical Ceilings

A. Delete Paragraphs 1.1.C., 2.3, and 3.2.S. in their entirety.

4. Specification Section 09 84 00 Acoustical Wall Panels

- A. Add new Paragraph 1.1.B., as "B. Light weight composite profile paneling and seam finishing material for sculptured wall surface."
- B. Add new Paragraph 2.4 Composite Profile Paneling as follows:
 - "2.4 Composite Profile Paneling
 - A. Panels as fabricated by Modular Arts, Inc., Seattle, Washington.
 - B. Profile: Smooth surface mineral composite panel with light weight plant-based foam back.
 - C. Size and Design: 32-inch square by 1/4-inch to 1-inch relief, Design is CLIF.
 - D. Include Manufacturers Installation Kit for size of installation.
 - E. Include all accessories, including stainless steel anchors, as required for a complete installation.
 - F. Finish: Refer to Finish Legend."
- C. Add new Paragraph 3.2.C. as "C. Install profile paneling in accordance with Manufacturer's Installation Instructions except that seam finishing shall be performed in accordance with Section 09 29 00, Gypsum Board. Sealing and painting shall be performed in accordance with Section 09 91 00 Painting."

5. Specification Section 11 40 00 Foodservice Equipment

- A. Item #14 Island Work Counter w/Prep Sink
 - 1. Delete all reference to "h. stainless-steel u-channels for vertical cutting board storage".
 - 2. Delete all reference to "i. Provide two (2) only 20" X 24" x ½" polyethylene cutting boards, white".
- B. Item #17 Island Work Counter w/Prep Sink



- 1. Delete all reference to "f. Stainless-steel u-channels for vertical cutting board storage".
- 2. Delete all reference to "g. Provide two (2) only 20" x 24" x ½" polyethylene cutting boards, white".
- C. Item #46 Worktable
 - 1. Delete all reference to "C. Open-Base w/stainless steel cross rails".
- D. Items #69, 72, 75, 79, 82, 85 and 86 Serving Counters and Cashier Counters
 - 1. Clarification: Provide three (3) raised stainless steel tray slide runners on student side of countertop.

6. Specification Section 11 66 43 Scoreboards

A. Revise Paragraph 2.2.B.1. to read "Total of Two (2) Scoreboards required."

7. Specification Section 23 09 23 Temperature Controls

- A. Add Paragraph 1.02 D. to read:
 - "D. The intent of this specification is to provide seamless integration with the existing district-wide Schneider Electric I/A Series building automation system in place at Crown Point Community School Corporation. Integration software drivers and graphics being provided with the new project at MacArthur Elementary School must be seamlessly integrated into the existing Schneider Electric Web Server. The existing Schneider Electric System in place consists of both N4 and legacy AX platforms that will be seamlessly integrated."

8. Specification Section 23 83 23 Unit Ventilators

A. Add the following sentence to end of Paragraph 2.02 K: "Provide painted closure panels and concealed support required for complete finished assembly."

9. Specification Sections 33 11 00, 33 11 50 and 33 13 00

A. Add Water Distribution Specification Sections 33 11 00, 33 11 50 and 33 13 00, included in this Addendum, to the Project Manual.

DRAWINGS

10. Sheet C-1.0

A. Refer to revised, full size drawing, included in this Addendum, for added location of existing well.

11. Sheet C-1.1

- A. Refer to revised, full size drawing, included in this Addendum, for the following revisions:
 - 1. Clarification for removal of existing water main and the removal of the abandoned septic tank were added.
 - 2. Additional tree removal along the western boundary was added.
 - 3. Note Number 19 was removed.
 - 4. Additional asphalt has been marked for removal along the north side of the building to be replaced by concrete sidewalk.
 - 5. Added note regarding removal of tanks by Owner.



12. Sheet C-2.0

- A. Refer to revised, full size drawing, included in this Addendum, for the following revisions:
 - 1. A new concrete sidewalk has been added along the north side of the building, to be installed as concrete pavement.
 - 2. A split rail fence has been added along the west side of the right-of-way next to the detention pond.
 - 3. The approaches from 129th have been changed to concrete pavement.
 - 4. Fencing around soft play area connected to existing building has been labeled as 4' C.L. Fence. Other new fencing around play areas has been labeled to match existing style.
 - 5. New locations and revised locations for parking log lighting.

13. Sheet C-3.0

- A. Refer to revised, full size drawing, included in this Addendum, for the following revisions:
 - 1. Both east and west ponds have been modified.
 - 2. Additional note was added regarding grates on outfall pipes.
 - 3. A new perforated pipe has been added along the southern perimeter of the baseball field.
 - 4. A new 6" PVC pipe has been added for the soft and hard play areas both north and south.
 - 5. New specialized grates have been added to structures 15, 16 and 18.
 - 6. A new 4" PVC pipe from the building and a new manhole have been added as structure number 24.
 - 7. Text clarifying the pipe sizes from the new western addition have been added.
 - 8. The storm sewer connections along the eastern side of the building have been relocated and changed.
 - 9. Added notes regarding construction and seeding of baseball field.
 - 10. Callouts for continuation of piping into building have been changed from "see architectural plans" to "see MEP plans".
 - 11. The new 4" STS on north side of building has been removed.

14. Sheet C-3.1

- A. Refer to revised, full size drawing, included in this Addendum, for the following revisions:
 - 1. The sanitary sewer along the eastern side of the building has been completely removed.
 - 2. A new water main service line and a sanitary sewer cleanout have been added along the eastern side of the existing building.
 - 3. Callouts for continuation of piping into building have been changed from "see architectural plans" to "see MEP plans".



15. Sheet C-4.0

- A. Refer to revised, full size drawing, included in this Addendum, for the following revisions:
 - 1. Revised Soft-Surface and Hard Surface Play details.

16. Sheet C-4.3

- A. Refer to revised, full size drawing, included in this Addendum, for the following revisions:
 - 1. Casting types, precast concrete barriers and a downspout roof drain connection have been added.
 - 2. The contractor should refer to Sheet C-3.0 for specialized grates on structures 15, 16 and 18.
 - 3. Refer to the addition of a new detail for the Wood Guard Rail.

17. Sheet C-4.4

- A. Refer to revised, full size drawing, included in this Addendum, for the following revisions:
 - Perforated pipe details, PVC Inline drain details and a grating detail have been added.

18. Sheet C-5.0

- A. Refer to revised, full size drawing, included in this Addendum, for the following revisions:
 - 1. A revised storm water pollution prevention plan is being issued.
 - 2. All items previously mentioned have been added.

19. Sheet C-6.1

- A. Refer to revised, full size drawing, included in this Addendum, for the following revisions:
 - 1. The reference to structure 3 has been removed.

20. Sheets S-001, S-201, S-202, S-204, S-205, S-206, S-301, S-403, S-411, S-412, and S-413

A. Refer to eleven (11) revised, full size drawings, included in this Addendum, for revisions.

21. Sheets S-201

A. General NOTE: Contractors are to refer to Sections 1/A-402 and 2/A-402 for delineation of rigid insulation thickness at exterior foundations.

22. Sheets AD101, AD102, AD103

- A. Refer to three (3) revised, full size drawings, included in this Addendum, for the following revisions:
 - 1. Revise Notes 36 and 36.
 - 2. Add Notes 83-86.
 - 3. Add notes 83-86 to plan where indicated.

23. Sheets A-101, A-102, A-103, A-104

A. Refer to four (4) revised, full size drawings, included in this Addendum, for the following revisions:



- 1. Revise Note 30.
- 2. Where note 33 and 58 occur together, CMU wall is to be partial height with the corridor face being glazed CMU. On top of the CMU wall is to be metal stud gypsum board, and insulation as called out on Note 58. Intent is for new wall construction to match adjacent wall construction. The CMU will not go to deck in these locations.
- 3. Add Note 69 to the following Vestibules B-101, B-131, D-101, D-103, and D-118.
- 4. Brick columns at canopies outside of B-101 and D-103 to have full CMU backup.

24. Sheets A-201, A-202

- A. Refer to two (2) revised, full size drawings, included in this Addendum, for the following revisions:
 - 1. Revise Reference bubbles on Note 28 to say 6/A-210 and 15/A-210.
 - 2. Revise Roof Types as indicated.
 - 3. Revise Roof Plan as indicated.

25. Sheets A-301, A-302, A-303

- A. Revise Reference bubble on Note 14 to say 6/A-501.
- B. Revise Reference bubble on Note 14 to say 8/A-501.

26. Sheet A-401, A-402, A-403, A-404, A-405, A-406, A-408, A-409, A-410, A-411

A. Refer to ten (10) revised, full size drawings, included in this Addendum, for revised sections.

27. Sheet A-501

- A. Refer to revised, full size drawing, included in this Addendum, for the following revisions:
 - 1. Revise Detail 6/A-501 and 10/A-501.

28. Sheet A-703

- A. Refer to revised, full size drawing, included in this Addendum, for the following revisions:
 - 1. Revise plan as indicated in Media C-144.

29. Sheet A-710

- A. Refer to revised, full size drawing, included in this Addendum, for the following revisions:
 - 1. Revise Note 15 to say "Baby Changing Table". This is to be furnished and installed by contractor.

30. Sheet A-802

A. Revise finish tag Cafeteria B-124 to say B2 for wall base.

31. Sheet K-602

- A. Refer to revised, full size drawing, included in this Addendum, for the following revisions:
 - 1. Details "H", "I" and "J": Clarify note on s/s tray runners.



32. Sheet K-603

- A. Refer to revised, full size drawing, included in this Addendum, for the following revisions:
 - 1. Detail "A": Clarify note on s/s tray runners.

33. Sheet MV-103

- A. Refer to revised, full size drawing, included in this Addendum, for the following revisions:
 - 1. Updated chiller symbol and added existing curb.
 - 2. Added dryer vent.

34. Sheet M-501

- A. Refer to revised, full size drawing, included in this Addendum, for the following revisions:
 - 1. Added note to provide 10" wide side mounted pipe chase.
 - 2. Added note to provide 10" deep false back where indicated on plans.

35. Sheet M-603

A. Refer to revised, full size drawing, included in this Addendum, for the following revisions:

36. Sheet P-001

- A. Refer to revised, full size drawing, included in this Addendum, for the following revisions:
 - 1. Revised RD-2 and OFRD-1 in Plumbing Equipment and Fixture Schedule.

37. Sheet PD-102

A. Refer to revised, full size drawing, included in this Addendum, for removed existing storm piping shown on plan.

38. Sheet PD-103

A. Refer to revised, full size drawing, included in this Addendum, for revised storm and sanitary piping.

39. Sheet P-101

A. Refer to revised, full size drawing, included in this Addendum, for revised storm piping.

40. Sheet P-102

A. Refer to revised, full size drawing, included in this Addendum, for revised storm piping and added roof drains.

41. Sheet P-103

A. Refer to revised, full size drawing, included in this Addendum, for revised storm piping routing and connections.

42. Sheet P-104

A. Refer to revised, full size drawing, included in this Addendum, for revised storm piping.

43. Sheet P-105

A. Refer to revised, full size drawing, included in this Addendum, for revised storm water piping.



44. Sheet P-106

A. Refer to revised, full size drawing, included in this Addendum, for revised storm water piping and added roof drains.

45. Sheet P-107

A. Refer to revised, full size drawing, included in this Addendum, for revised storm water piping.

46. Sheet E-002

- A. Refer to revised, full size drawing, included in this Addendum, for the following revisions:
 - 1. Revised "RR" type pole-mounted fixtures to "ER".
 - 2. Revised "NE" type pole-mounted fixtures to new type.
 - 3. Revised "EX" type pole-mounted fixtures to "ER".
 - 4. Revised site lighting locations and quantities.
 - 5. Revised GENERAL notes.
 - 6. Revised SHEET NOTES.
 - 7. Added new location of existing floodlight.

47. Sheet ED-103

A. Refer to revised, full size drawing, included in this Addendum, for revised demolition floodlight to be removed and relocated.

48. Sheet EL-102

A. Refer to revised, full size drawing, included in this Addendum, for revised Café B-124 lighting.

49. Sheet EL-103

A. Refer to revised, full size drawing, included in this Addendum, for revised Media C-144 desk lighting.

50. Sheet EP-101

- A. Refer to revised, full size drawing, included in this Addendum, for the following revisions:
 - 1. Moved panel "EM-TECH1" to south wall.
 - 2. Moved quad receptacle to south wall.
 - 3. Revised GENERAL notes.

51. Sheet EP-102

- A. Refer to revised, full size drawing, included in this Addendum, for the following revisions:
 - 1. Removed duplicate "EM-TECH1" panel.
 - 2. Revised GENERAL notes.

52. Sheets EP-103, EP-104, EP-105

A. Refer to three (3) revised, full size drawings, included in this Addendum, for revised GENERAL notes.



53. Sheet EP-201

- A. Refer to revised, full size drawing, included in this Addendum, for the following revisions:
 - 1. Added GEF-3 and associated connections.
 - 2. Added GEF-4 and associated connections.

54. Sheet E-501

A. Refer to revised, full size drawing, included in this Addendum, for revised Electrical One-Line Schematic Diagram Sheet Notes.

55. Sheet E-502

A. Refer to revised, full size drawing, included in this Addendum, for revised Interior and Exterior Lighting Luminaire Schedules.

56. Sheet E-504

- A. Refer to revised, full size drawing, included in this Addendum, for the following revisions:
 - Added motorized projection screen to "Main Gymnasium Control Cabinet Detail".
 - 2. Reduced number of spares from four (4) to three (3) in "Main Gymnasium Control Cabinet Detail".
 - 3. Added Kitchen Equipment Schedule.

57. Sheet T 001

- A. Refer to revised, full size drawing, included in this Addendum, for the following revisions:
 - 1. Changed the text for telecom symbol 2D/LI to note that the A/V cabling is future.

58. Sheet TD 100 (and all demo sheets)

- A. Refer to revised, full size drawing, included in this Addendum, for the following revisions:
 - 1. Demo Plan Note #7 language revised.
 - 2. Revised note applies to all demo sheets issued with the Project.

59. Sheet T-101

- A. Refer to revised, full size drawing, included in this Addendum, for the following revisions:
 - 1. Rooms A-105, A-108, A-132: Added "LI" to data outlet.
 - 2. Room A-106: Removed "LI" from data outlet.

60. Sheet T-102

- A. Refer to revised, full size drawing, included in this Addendum, for the following revisions:
 - 1. Rooms B-118, B-119, B-120 and B-122: Added "LI" to data outlet.

61. Sheet T-103

A. Refer to revised, full size drawing, included in this Addendum, for the following revisions:





- 1. Room C-141: Added "LI" to data outlet.
- 2. Room C-144: Added "LI" to (2) data outlets.

62. Sheet T-501

A. Refer to revised, full size drawing, included in this Addendum, for Detail 10 – added additional security camera symbols.

63. Sheet T-502

A. Refer to revised, full size drawing, included in this Addendum, for Details #1 and #2 – deleted the requirements for the HDMI and USB jacks and cables.

Pages 1 through 10, inclusive, Hardware List of Paragraph 3.8 of Specification Sections 08 71 00, and Full Specification Sections 33 11 00, 33 11 50 and 33 13 00, and Eighty-Eight (88) Full-Size Drawings, constitute the total makeup of **Addendum Three**.



Y:\21-113 Crown Point CSC - MacArthur ES Addition and Renovations\Specs\Addendum Three\AD03.doc



3.8 Door Hardware Schedule

- A. Locksets, exit devices, and other hardware items are referenced in the following hardware sets for series, type and function. Refer to the above-specifications for special features, options, cylinders/keying, and other requirements.
- B. Hardware Sets:

HARDWARE GROUP NO. 01

For use on Door #(s):

C-139A

Provide each OPENING with the following:

C	ΣΤΥ	DESCRIPTION	CATALOG NUMBER	FINISH	MFR
3	EA	HINGE	5BB1 4.5 X 4.5 (NRP AS REQ'D)	652	IVE
1	EA	PASSAGE SET	9K0 N 14D	626	BES
1	EA	OH STOP	90\$	630	GLY
3	EA	SILENCER	SR64	GRY	IVE

HARDWARE GROUP NO. 02

For use on Door #(s):

B-121A

Provide each OPENING with the following:

QTY		DESCRIPTION	CATALOG NUMBER	FINISH	MFR
3	EA	HINGE	5BB1 4.5 X 4.5 (NRP AS REQ'D)	652	IVE
1	EA	PASSAGE SET	9K0 N 14D	626	BES
1	EA	WALL STOP	WS401/402CVX	626	IVE
3	EA	SILENCER	SR64	GRY	IVE

HARDWARE GROUP NO. 03

For use on Door #(s):

A-109A A-111A A-131A A-133A

Provide each OPENING with the following:

OTY		DESCRIPTION	CATALOG NUMBER	FINISH	MFR
1	EA	CONT. HINGE	224HD	628	IVE
1	EA	PRIVACY SET	45H 0 L 14S VIN	626	BES
1	EA	OH STOP	90\$	630	GLY
1	EA	GASKETING	488SCL PSA	CL	ZER
1	EA	FINGER GUARD	51A-90	Α	ZER



For	use on	Door	#(′ς `	١.
1 01	USC OII		// \		

A-114A A-115A B-109A B-110A B-111A C-126A

C-129A C-140A

Provide each OPENING with the following:

QTY		DESCRIPTION	CATALOG NUMBER	FINISH	MFR
3	EA	HINGE	5BB1 4.5 X 4.5 (NRP AS REQ'D)	652	IVE
1	EA	PRIVACY SET	45H 0 L 14S VIN	626	BES
1	EA	WALL STOP	WS401/402CVX	626	IVE
1	EA	GASKETING	488SCL PSA	CL	ZER

HARDWARE GROUP NO. 05

For use on Door #(s):

A-128A

Provide each OPENING with the following:

QTY		DESCRIPTION	CATALOG NUMBER	FINISH	MFR
1	EA	CONT. HINGE	224HD	628	IVE
1	EA	PRIVACY SET	45H 0 L 14S VIN	626	BES
1	EA	WALL STOP	WS401/402CVX	626	IVE
1	EA	GASKETING	488SCL PSA	CL	ZER
1	EA	FINGER GUARD	51A-90	Α	ZER

HARDWARE GROUP NO. 06 - NOT USED

HARDWARE GROUP NO. 07

For use on Door #(s):

B-116A B-117A C-123A C-149A C-150A D-123A

D-124A

Provide each OPENING with the following:

QTY		DESCRIPTION	CATALOG NUMBER	FINISH	MFR
3	EA	HINGE	5BB1 4.5 X 4.5 (NRP AS REQ'D)	652	IVE
1	EA	PRIVACY SET	45H 0 L 14S VIN	626	BES
1	EA	SURFACE CLOSER	4040XP RW/PA	689	LCN
1	EA	KICK PLATE	8400 10" X 1 1/2" LDW B-CS	630	IVE
1	EA	WALL STOP	WS401/402CVX	626	IVE
1	EA	GASKETING	488SCL PSA	CL	ZER



For use on Door #(s):

B-107A

Provide each OPENING with the following:

QTY		DESCRIPTION	CATALOG NUMBER	FINISH	MFR
3	EA	HINGE	5BB1 4.5 X 4.5 (NRP AS REQ'D)	652	IVE
1	EA	OFFICE LOCKSET	9K7 AB 14D	626	BES
1	EA	OH STOP	90S	630	GLY
3	EA	SILENCER	SR64	GRY	IVE

HARDWARE GROUP NO. 09

For use on Door #(s):

A-103A A-106A B-108A C-135A C-143A

Provide each OPENING with the following:

QTY		DESCRIPTION	CATALOG NUMBER	FINISH	MFR
3	EA	HINGE	5BB1 4.5 X 4.5 (NRP AS REQ'D)	652	IVE
1	EA	OFFICE LOCKSET	9K7 AB 14D	626	BES
1	EA	WALL STOP	WS401/402CVX	626	IVE
3	EA	SILENCER	SR64	GRY	IVE

HARDWARE GROUP NO. 10

For use on Door #(s):

B-146A

Provide each OPENING with the following:

QTY		DESCRIPTION	CATALOG NUMBER	FINISH	MFR
3	EA	HINGE	5BB1 4.5 X 4.5 (NRP AS REQ'D)	652	IVE
1	EA	OFFICE LOCKSET	9K7 AB 14D	626	BES
1	EA	WALL STOP	WS401/402CVX	626	IVE
1	EA	THRESHOLD	BY WOOD FLOOR INSTALLER		B/O
3	EA	SILENCER	SR64	GRY	IVE



For use on Door #(s): B-107B

Provide each OPENING with the following:

QTY		DESCRIPTION	CATALOG NUMBER	FINISH	MFR
3	EA	HINGE	5BB1 4.5 X 4.5 (NRP AS REQ'D)	652	IVE
1	EA	OFFICE LOCKSET	9K7 AB 14D	626	BES
1	EA	OH STOP	90S	630	GLY
1	EA	SURFACE CLOSER	4040XP RW/PA	689	LCN
1	EA	KICK PLATE	8400 10" X 1 1/2" LDW B-CS	630	IVE
3	EA	SILENCER	SR64	GRY	IVE

HARDWARE GROUP NO. 12

For use on Door #(s):

B-103B

Provide each OPENING with the following:

	DESCRIPTION	CATALOG NUMBER	FINISH	MFR
EA	HINGE	5BB1 4.5 X 4.5 (NRP AS REQ'D)	652	IVE
EA	CLASSROOM X STORERM	ND70X80CD SPA XN12-006	626	SCH
EA	PERMANENT CORE	1C7	626	BES
EA	ELECTRIC STRIKE	6212 FSE 12/16/24/28 VAC/VDC	630	VON
EA	OH STOP	90\$	630	GLY
EA	SURFACE CLOSER	4040XP RW/PA	689	LCN
EA	KICK PLATE	8400 10" X 1 1/2" LDW B-CS	630	IVE
EA	MULTITECH READER	MTB11/15 - BY ACCESS CONTROL PROVIDER (COORDINATE W/ HEAD END AND CREDENTIAL TYPE)	BLK	SCE
EA	AI PHONE	BY ACCESS CONTROL PROVIDER		
EA	DOOR CONTACT	7764	628	SCE
EA	MOTION SENSOR	SCANII 12/24 VDC	BLK	SCE
EA	POWER SUPPLY	PS902 900-4R [COORDINATE WITH ACCESS CONTROL PROVIDER]	LGR	SCE
EA	DIAGRAM	ELEVATION		DLR
EA	DIAGRAM	POINT TO POINT		DLR
	EA EA EA EA EA EA EA	EA HINGE EA CLASSROOM X STORERM EA PERMANENT CORE EA ELECTRIC STRIKE EA OH STOP EA SURFACE CLOSER EA KICK PLATE EA MULTITECH READER EA AI PHONE EA DOOR CONTACT EA MOTION SENSOR EA POWER SUPPLY EA DIAGRAM	EA HINGE 5BB1 4.5 X 4.5 (NRP AS REQ'D) EA CLASSROOM X STORERM ND70X80CD SPA XN12-006 EA PERMANENT CORE 1C7 EA ELECTRIC STRIKE 6212 FSE 12/16/24/28 VAC/VDC EA OH STOP 90S EA SURFACE CLOSER 4040XP RW/PA EA KICK PLATE 8400 10" X 1 1/2" LDW B-CS EA MULTIITECH READER MTB11/15 - BY ACCESS CONTROL PROVIDER (COORDINATE W/ HEAD END AND CREDENTIAL TYPE) EA AI PHONE BY ACCESS CONTROL PROVIDER EA DOOR CONTACT 7764 EA MOTION SENSOR SCANII 12/24 VDC EA POWER SUPPLY PS902 900-4R [COORDINATE WITH ACCESS CONTROL PROVIDER] EA DIAGRAM ELEVATION	EA HINGE 5BB1 4.5 X 4.5 (NRP AS REQ'D) 652 EA CLASSROOM X STORERM ND70X80CD SPA XN12-006 626 EA PERMANENT CORE 1C7 626 EA ELECTRIC STRIKE 6212 FSE 12/16/24/28 VAC/VDC 630 EA OH STOP 90S 630 EA SURFACE CLOSER 4040XP RW/PA 689 EA KICK PLATE 8400 10" X 1 1/2" LDW B-CS 630 EA MULTITECH READER MTB11/15 - BY ACCESS CONTROL PROVIDER (COORDINATE W/ HEAD END AND CREDENTIAL TYPE) EA AI PHONE BY ACCESS CONTROL PROVIDER EA DOOR CONTACT 7764 628 EA MOTION SENSOR SCANII 12/24 VDC BLK EA POWER SUPPLY PS902 900-4R [COORDINATE WITH LGR ACCESS CONTROL PROVIDER] EA DIAGRAM ELEVATION

OPERATION: DOOR CLOSED AND ALWAYS LOCKED FROM RECEPTION SIDE. DOOR UNLOCKED FROM CORRIDOR SIDE DURING SCHOOL HOURS AND LOCKED FROM CORRIDOR SIDE AFTER HOURS AND ON WEEKENDS.

AI PHONE AT RECEPTION DESK OR VALID CREDENTIAL MOMENTARILY UNLOCKS DOOR ALLOWING ENTRY. DOOR REMAINS LOCKED UPON LOSS OF POWER. DOOR CONTACT TO MONITOR DOOR POSITION. MOTION SENSOR ON PUSH SIDE SHUNTS DOOR CONTACT FOR VALID EGRESS.



For use on Door #(s):

B-104A B-147A C-134A

Provide each OPENING with the following:

QTY		DESCRIPTION	CATALOG NUMBER	FINISH	MFR
3	EA	HINGE	5BB1 4.5 X 4.5 (NRP AS REQ'D)	652	IVE
1	EA	CLASSROOM LOCKSET	9K7 R 14D	626	BES
1	EA	OH STOP	90S	630	GLY
3	EA	SILENCER	SR64	GRY	IVE

HARDWARE GROUP NO. 14 - NOT USED

HARDWARE GROUP NO. 15

For use on Door #(s):

A-110A A-110B A-130A A-130B B-106A B-112A B-113A B-145A C-142A D-114A

Provide each OPENING with the following:

QTY		DESCRIPTION	CATALOG NUMBER	FINISH	MFR
3	EA	HINGE	5BB1 4.5 X 4.5 (NRP AS REQ'D)	652	IVE
1	EA	CLASSROOM LOCKSET	9K7 R 14D	626	BES
1	EA	WALL STOP	WS401/402CVX	626	IVE
3	EA	SILENCER	SR64	GRY	IVE

HARDWARE GROUP NO. 16

For use on Door #(s): C-132A C-132C

Provide each OPENING with the following:

QTY		DESCRIPTION	CATALOG NUMBER	FINISH	MFR
3	EA	HINGE	5BB1 4.5 X 4.5 (NRP AS REQ'D)	652	IVE
1	EA	CLASSROOM LOCKSET	9K7 R 14D	626	BES
1	EA	WALL STOP/HOLDER	WS45	626	IVE
3	EA	SILENCER	SR64	GRY	IVE





For use on Door #(s): C-147A

Provide each OPENING with the following:

QTY		DESCRIPTION	CATALOG NUMBER	FINISH	MFR
3	EA	HINGE	5BB1 4.5 X 4.5 (NRP AS REQ'D)	652	IVE
1	EA	CLASSROOM LOCKSET	9K7 R 14D	626	BES
1	EA	SURFACE CLOSER	4040XP RW/PA	689	LCN
1	EA	KICK PLATE	8400 10" X 1 1/2" LDW B-CS	630	IVE
1	EA	WALL STOP	WS401/402CVX	626	IVE
3	EA	SILENCER	SR64	GRY	IVE

HARDWARE GROUP NO. 18

For use on Door #(s):

B-125A

Provide each OPENING with the following:

QTY		DESCRIPTION	CATALOG NUMBER	FINISH	MFR
6	EA	HINGE	5BB1 4.5 X 4.5 (NRP AS REQ'D)	652	IVE
1	EA	CONST LATCHING BOLT	FB51T/FB61T AS REQ'D	630	IVE
1	EA	CLASSROOM LOCKSET	9K7 R 14D	626	BES
2	EA	OH STOP	90S	630	GLY
2	EA	SILENCER	SR64	GRY	IVE

HARDWARE GROUP NO. 19

For use on Door #(s): B-142A B-144A

Provide each OPENING with the following:

QTY		DESCRIPTION	CATALOG NUMBER	FINISH	MFR
6	EA	HINGE	5BB1 4.5 X 4.5 (NRP AS REQ'D)	652	IVE
1	EA	CONST LATCHING BOLT	FB51T/FB61T AS REQ'D	630	IVE
1	EA	CLASSROOM LOCKSET	9K7 R 14D	626	BES
2	EA	OH STOP	90S	630	GLY
1	EA	THRESHOLD	BY WOOD FLOOR INSTALLER		B/O
2	EA	SILENCER	SR64	GRY	IVE

HARDWARE GROUP NO. 20 - NOT USED





For use on Door #(s):

C-138A

Provide each OPENING with the following:

QTY		DESCRIPTION	CATALOG NUMBER	FINISH	MFR
3	EA	HINGE	5BB1 4.5 X 4.5 (NRP AS REQ'D)	652	IVE
1	EA	STOREROOM LOCKSET	9K7 D 14D	626	BES
1	EA	OH STOP & HOLDER	90H J	630	GLY
1	EA	KICK PLATE	8400 10" X 1 1/2" LDW B-CS	630	IVE
3	EA	SILENCER	SR64	GRY	IVE

HARDWARE GROUP NO. 22

For use on Door #(s):

A-108A A-113A B-115B D-108A

Provide each OPENING with the following:

QTY		DESCRIPTION	CATALOG NUMBER	FINISH	MFR
3	EA	HINGE	5BB1 4.5 X 4.5 (NRP AS REQ'D)	652	IVE
1	EA	STOREROOM LOCKSET	9K7 D 14D	626	BES
1	EA	WALL STOP	WS401/402CVX	626	IVE
3	EA	SILENCER	SR64	GRY	IVE

HARDWARE GROUP NO. 23 - NOT USED

HARDWARE GROUP NO. 24 - NOT USED

HARDWARE GROUP NO. 25

For use on Door #(s):

C-125A

Provide each OPENING with the following:

QTY		DESCRIPTION	CATALOG NUMBER	FINISH	MFR
3	EA	HINGE	5BB1 4.5 X 4.5 (NRP AS REQ'D)	652	IVE
1	EA	STOREROOM LOCKSET	9K7 D 14D	626	BES
1	EA	OH STOP & HOLDER	90H J	630	GLY
1	EA	SURFACE CLOSER	4040XP RW/PA	689	LCN
1	EA	KICK PLATE	8400 10" X 1 1/2" LDW B-CS	630	IVE
3	EA	SILENCER	SR64	GRY	IVE



For use on Door #(s): C-148A

Provide each OPENING with the following:

QTY		DESCRIPTION	CATALOG NUMBER	FINISH	MFR
3	EA	HINGE	5BB1 4.5 X 4.5 (NRP AS REQ'D)	652	IVE
1	EA	STOREROOM LOCKSET	9K7 D 14D	626	BES
1	EA	OH STOP	90S J	630	GLY
1	EA	SURFACE CLOSER	4040XP RW/PA	689	LCN
1	EA	KICK PLATE	8400 10" X 1 1/2" LDW B-CS	630	IVE
3	EA	SILENCER	SR64	GRY	IVE

HARDWARE GROUP NO. 27

For use on Door #(s):

A-102A	A-105A	A-132A	B-115A	B-118A	B-119A
B-120A	B-141A	C-122A	C-141A	D-104A	D-113A
D-125A					

Provide each OPENING with the following:

QTY		DESCRIPTION	CATALOG NUMBER	FINISH	MFR
3	EA	HINGE	5BB1 4.5 X 4.5 (NRP AS REQ'D)	652	IVE
1	EA	STOREROOM LOCKSET	9K7 D 14D	626	BES
1	EA	SURFACE CLOSER	4040XP RW/PA	689	LCN
1	EA	KICK PLATE	8400 10" X 1 1/2" LDW B-CS	630	IVE
1	EA	WALL STOP	WS401/402CVX	626	IVE
3	EA	SILENCER	SR64	GRY	IVE



For use on Door #(s): B-136A

Provide each OPENING with the following:

QTY		DESCRIPTION	CATALOG NUMBER	FINISH	MFR
3	EA	HINGE	5BB1 4.5 X 4.5 (NRP AS REQ'D)	652	IVE
1	EA	STOREROOM LOCKSET	9K7 D 14D	626	BES
1	EA	SURFACE CLOSER	4040XP RW/PA	689	LCN
1	EA	KICK PLATE	8400 10" X 1 1/2" LDW B-CS	630	IVE
1	EA	WALL STOP	WS401/402CVX	626	IVE
3	EA	SILENCER	SR64	GRY	IVE

NOTE: VERIFY/COORDINATE PREPS ON EXISTING DOORS AND FRAMES. PROVIDE CORRECT STRIKES, FIELD MODIFICATIONS AND/OR FILLERS TO EXISTING DOORS AND FRAMES AS NECESSARY TO ACCEPT NEW SPECIFIED HARDWARE AND COVER EXPOSED HOLES.

HARDWARE GROUP NO. 29

For use on Door #(s):

C-128A	D-110A	D-111A	D-112A	D-115A	D-116A
D-117A	D-119A	D-120A	D-121A	D-126A	D-127A
D-128A	D-129A				

Provide each OPENING with the following:

QTY		DESCRIPTION	CATALOG NUMBER	FINISH	MFR
3	EA	HINGE	5BB1 4.5 X 4.5 (NRP AS REQ'D)	652	IVE
1	EA	STOREROOM LOCKSET	9K7 D 14D	626	BES
1	EA	SURFACE CLOSER	4040XP RW/PA	689	LCN
1	EA	KICK PLATE	8400 10" X 1 1/2" LDW B-CS	630	IVE
1	EA	WALL STOP/HOLDER	WS45	626	IVE
3	EA	SILENCER	SR64	GRY	IVE

HARDWARE GROUP NO. 30 - NOT USED





For use on Door #(s): C-133A

Provide each OPENING with the following:

QTY		DESCRIPTION	CATALOG NUMBER	FINISH	MFR
3	EA	HINGE	5BB1HW 4.5 X 4.5 (NRP AS REQ'D)	652	IVE
1	EA	STOREROOM LOCKSET	9K7 D 14D	626	BES
1	EA	SURFACE CLOSER	4040XP RW/PA	689	LCN
1	EA	KICK PLATE	8400 10" X 1 1/2" LDW B-CS	630	IVE
1	EA	WALL STOP/HOLDER	WS45	626	IVE
3	EA	SILENCER	SR64	GRY	IVE

HARDWARE GROUP NO. 32

For use on Door #(s):

A-107A	A-107B	A-112A	A-112B	A-127A	A-127B
A-129A	A-129B	A-134A	A-134B		

Provide each OPENING with the following:

QTY		DESCRIPTION	CATALOG NUMBER	FINISH	MFR
3	EA	HINGE	5BB1 4.5 X 4.5 (NRP AS REQ'D)	652	IVE
1	EA	STOREROOM LOCKSET	9K7 D 14D	626	BES
1	EA	SURFACE CLOSER	4040XP RW/PA	689	LCN
1	EA	PA FLUSH PANEL ADAPTER	4040XP-419 SRT	689	LCN
1	EA	KICK PLATE	8400 10" X 1 1/2" LDW B-CS	630	IVE
1	EA	WALL STOP/HOLDER	WS45	626	IVE
3	EA	SILENCER	SR64	GRY	IVE

HARDWARE GROUP NO. 33

For use on Door #(s): B-137A

Provide each OPENING with the following:

QTY		DESCRIPTION	CATALOG NUMBER	FINISH	MFR
3	EA	HINGE	5BB1 4.5 X 4.5 (NRP AS REQ'D)	652	IVE
1	EA	STOREROOM LOCKSET	9K7 D 14D	626	BES
1	EA	SURFACE CLOSER	4040XP RW/PA	689	LCN
1	EA	PA FLUSH PANEL ADAPTER	4040XP-419 SRT	689	LCN
1	EA	KICK PLATE	8400 10" X 1 1/2" LDW B-CS	630	IVE
1	EA	WALL STOP	WS401/402CVX	626	IVE
3	EA	SILENCER	SR64	GRY	IVE





HARDWARE GROUP NO. 34 - NOT USED

HARDWARE GROUP NO. 35

For use on Door #(s): B-127A B-127B

Provide each OPENING with the following:

QTY		DESCRIPTION	CATALOG NUMBER	FINISH	MFR
6	EA	HINGE	5BB1 4.5 X 4.5 (NRP AS REQ'D)	652	IVE
1	EA	CONST LATCHING BOLT	FB51T/FB61T AS REQ'D	630	IVE
1	EA	STOREROOM LOCKSET	9K7 D 14D	626	BES
2	EA	OH STOP	90S J	630	GLY
2	EA	SILENCER	SR64	GRY	IVE

DOORS AND TRANSOM TO BE RABBETED.



For use on Door #(s): B-130A

Provide each OPENING with the following:

	DESCRIPTION	CATALOG NUMBER	FINISH	MFR
EA	CONT. HINGE	224HD	628	IVE
EA	CONT. HINGE	224HD EPT	628	IVE
EA	POWER TRANSFER	EPT10	689	VON
EA	AUTO FLUSH BOLT	FB31P/FB41P AS REQ'D	630	IVE
EA	DUST PROOF STRIKE	DP2	626	IVE
EA	ELECTRIFIED LOCKSET	9K7 DEU 14D RQE	626	BES
EA	COORDINATOR	COR X FL	628	IVE
EA	MOUNTING BRACKET	MB [AS REQ'D]	689	IVE
EA	SURFACE CLOSER	4040XP SCUSH	689	LCN
EA	PA MOUNTING PLATE	4040XP-18PA AS REQ'D	689	LCN
EA	CUSH SHOE SUPPORT	4040XP-30 AS REQ'D	689	LCN
EA	BLADE STOP SPACER	4040XP-61 AS REQ'D	689	LCN
EA	RAIN DRIP	142AA	AA	ZER
EA	WEATHER STRIPPING	By Door/Frame Manufacturer		
EA	DOOR SWEEP	8192AA	AA	ZER
EA	THRESHOLD	655A-223	Α	ZER
EA	MULTITECH READER	MTB11/15 - BY ACCESS CONTROL PROVIDER (COORDINATE W/ HEAD END AND CREDENTIAL TYPE)	BLK	SCE
EA	DOOR CONTACT	7764	628	SCE
EA	POWER SUPPLY	PS902 900-4R [COORDINATE WITH ACCESS CONTROL PROVIDER]	LGR	SCE
EA	DIAGRAM	ELEVATION		DLR
EA	DIAGRAM	POINT TO POINT		DLR
	EA EA EA EA EA EA EA EA EA	EA CONT. HINGE EA CONT. HINGE EA POWER TRANSFER EA AUTO FLUSH BOLT EA DUST PROOF STRIKE EA ELECTRIFIED LOCKSET EA COORDINATOR EA MOUNTING BRACKET EA SURFACE CLOSER EA PA MOUNTING PLATE EA CUSH SHOE SUPPORT EA BLADE STOP SPACER EA RAIN DRIP EA WEATHER STRIPPING EA DOOR SWEEP EA THRESHOLD EA MULTITECH READER EA DOOR CONTACT EA POWER SUPPLY EA DIAGRAM	EA CONT. HINGE 224HD EPT EA POWER TRANSFER EPT10 EA AUTO FLUSH BOLT FB31P/FB41P AS REQ'D EA DUST PROOF STRIKE DP2 EA ELECTRIFIED LOCKSET 9K7 DEU 14D RQE EA COORDINATOR COR X FL EA MOUNTING BRACKET MB [AS REQ'D] EA SURFACE CLOSER 4040XP SCUSH EA PA MOUNTING PLATE 4040XP-18PA AS REQ'D EA CUSH SHOE SUPPORT 4040XP-30 AS REQ'D EA RAIN DRIP 142AA EA WEATHER STRIPPING BY DOOR/Frame Manufacturer EA DOOR SWEEP 8192AA EA THRESHOLD 655A-223 EA MULTITECH READER MTB11/15 - BY ACCESS CONTROL PROVIDER (COORDINATE W/ HEAD END AND CREDENTIAL TYPE) EA DOOR CONTACT 7764 EA DOOR SUPPLY PS902 900-4R [COORDINATE WITH ACCESS CONTROL PROVIDER] EA DIAGRAM ELEVATION	EA CONT. HINGE 224HD EPT 628 EA CONT. HINGE 224HD EPT 628 EA POWER TRANSFER EPT10 689 EA AUTO FLUSH BOLT FB31P/FB41P AS REQ'D 630 EA DUST PROOF STRIKE DP2 626 EA ELECTRIFIED LOCKSET 9K7 DEU 14D RQE 626 EA COORDINATOR COR X FL 628 EA MOUNTING BRACKET MB [AS REQ'D] 689 EA SURFACE CLOSER 4040XP SCUSH 689 EA PA MOUNTING PLATE 4040XP-18PA AS REQ'D 689 EA CUSH SHOE SUPPORT 4040XP-30 AS REQ'D 689 EA BLADE STOP SPACER 4040XP-61 AS REQ'D 689 EA RAIN DRIP 142AA AA EA WEATHER STRIPPING By DOOR/Frame Manufacturer EA DOOR SWEEP 8192AA AA EA THRESHOLD 655A-223 A EA MULTITECH READER MTB11/15 - BY ACCESS CONTROL PROVIDER (COORDINATE W/ HEAD END AND CREDENTIAL TYPE) EA DOOR CONTACT 7764 628 EA POWER SUPPLY PS902 900-4R [COORDINATE WITH ACCESS CONTROL PROVIDER] EA DIAGRAM ELEVATION

OPERATION: DOOR NORMALLY CLOSED AND LOCKED. VALID CREDENITAL MOMENTARILY UNLOCKS DOOR ALLOWING ENTRY. DOOR REMAINS LOCKED UPON LOSS OF POWER. DOOR CONTACTS TO MONITOR DOOR POSITION. RX SWITCH (INTEGRAL TO LOCK SET) SHUNTS DOOR CONTACT FOR VALID EGRESS. FREE EGRESS AT ALL TIMES.





For use on Door #(s): B-201A B-201B

Provide each OPENING with the following:

QT	Υ	DESCRIPTION	CATALOG NUMBER	FINISH	MFR
2	EA	CONT. HINGE	224HD	628	IVE
1	EA	AUTO FLUSH BOLT	FB31P/FB41P AS REQ'D	630	IVE
1	EA	DUST PROOF STRIKE	DP2	626	IVE
1	EA	STOREROOM LOCKSET	9K7 D 14D	626	BES
1	EA	COORDINATOR	COR X FL	628	IVE
2	EA	MOUNTING BRACKET	MB [AS REQ'D]	689	IVE
2	EA	SURFACE CLOSER	4040XP SCUSH	689	LCN
2	EA	PA MOUNTING PLATE	4040XP-18PA AS REQ'D	689	LCN
2	EA	CUSH SHOE SUPPORT	4040XP-30 AS REQ'D	689	LCN
2	EA	BLADE STOP SPACER	4040XP-61 AS REQ'D	689	LCN
1	EA	WEATHER STRIPPING	By Door/Frame Manufacturer		
2	EA	DOOR SWEEP	8192AA	AA	ZER
1	EA	THRESHOLD	655A-223	Α	ZER

HARDWARE GROUP NO. 38

For use on Door #(s):

C-127A

Provide each OPENING with the following:

QTY		DESCRIPTION	CATALOG NUMBER	FINISH	MFR
6	EA	HINGE	5BB1 4.5 X 4.5 (NRP AS REQ'D)	652	IVE
1	EA	CONST LATCHING BOLT	FB51T/FB61T AS REQ'D	630	IVE
1	EA	STOREROOM LOCKSET	9K7 D 14D	626	BES
1	EA	COORDINATOR	COR X FL	628	IVE
2	EA	MOUNTING BRACKET	MB [AS REQ'D]	689	IVE
2	EA	SURFACE CLOSER	4040XP RW/PA	689	LCN
2	EA	KICK PLATE	8400 10" X 1" LDW B-CS	630	IVE
2	EA	WALL STOP	WS401/402CVX	626	IVE
2	EA	SILENCER	SR64	GRY	IVE

HARDWARE GROUP NO. 39 - NOT USED

HARDWARE GROUP NO. 40 - NOT USED



For use on Door #(s): B-103A

Provide each OPENING with the following:

QTY		DESCRIPTION	CATALOG NUMBER	FINISH	MFR
3	EA	HINGE	5BB1 4.5 X 4.5 (NRP AS REQ'D)	652	IVE
1	EA	POWER TRANSFER	EPT10	689	VON
1	EA	ELECTRIFIED LOCKSET	9K7 DEU 14D RQE	626	BES
1	EA	OH STOP	90S	630	GLY
1	EA	SURFACE CLOSER	4040XP RW/PA	689	LCN
1	EA	KICK PLATE	8400 10" X 1 1/2" LDW B-CS	630	IVE
1	EA	MULTITECH READER	MTB11/15 - BY ACCESS CONTROL PROVIDER (COORDINATE W/ HEAD END AND CREDENTIAL TYPE)	BLK	SCE
1	EA	AI PHONE	BY ACCESS CONTROL PROVIDER		
1	EA	DOOR CONTACT	7764	628	SCE
1	EA	POWER SUPPLY	PS902 900-4R [COORDINATE WITH ACCESS CONTROL PROVIDER]	LGR	SCE
1	EA	DIAGRAM	ELEVATION		DLR
1	EA	DIAGRAM	POINT TO POINT		DLR

OPERATION: DOOR NORMALLY CLOSED AND LOCKED. VALID CREDENITAL OR AI PHONE AT RECEPTION DESNK MOMENTARILY UNLOCKS DOOR ALLOWING ENTRY. DOOR REMAINS LOCKED UPON LOSS OF POWER. DOOR CONTACT TO MONITOR DOOR POSITION. RX SWITCH (INTEGRAL TO LOCKSET) SHUNTS DOOR CONTACT FOR VALID EGRESS. FREE EGRESS AT ALL TIMES.

HARDWARE GROUP NO. 42

For use on Door #(s):

A-135A D-101A D-118A

Provide each OPENING with the following:

Q	ΓΥ	DESCRIPTION	CATALOG NUMBER	FINISH	MFR
2	EA	CONT. HINGE	224HD EPT	628	IVE
2	EA	POWER TRANSFER	EPT10	689	VON
1	EA	REMOVABLE MULLION	KR4954 STAB	689	VON
3	EA	MORTISE CYLINDER	1E74	626	BES
1	EA	ELEC PANIC HARDWARE	SD-RX-QEL-98-EO 24 VDC	626	VON
1	EA	ELEC PANIC HARDWARE	SD-RX-QEL-98-NL-OP-110MD 24 VDC	626	VON
1	EA	RIM CYLINDER	1E72	626	BES
2	EA	90 DEG OFFSET PULL	8190HD 12" O	630	IVE
1	EA	OH STOP	100S	630	GLY
1	EA	SURFACE CLOSER	4040XP SCUSH	689	LCN
1	EA	SURF. AUTO OPERATOR	4642 TBWMS 120 VAC	689	LCN
1	EA	PA MOUNTING PLATE	4040XP-18PA AS REQ'D	689	LCN





QTY		DESCRIPTION	CATALOG NUMBER	FINISH	MFR
1	EA	CUSH SHOE SUPPORT	4040XP-30 AS REQ'D	689	LCN
1	EA	BLADE STOP SPACER	4040XP-61 AS REQ'D	689	LCN
1	EA	WEATHER RING	8310-801		LCN
1	EA	ACTUATOR, TOUCH	8310-853T	630	LCN
1	EA	ACTUATOR, TOUCH	8310-855	630	LCN
1	EA	MULLION SEAL	8780NBK	BK	ZER
1	EA	WEATHER STRIPPING	By Door/Frame Manufacturer		
2	EA	DOOR SWEEP	8192AA	AA	ZER
1	EA	THRESHOLD	655A-223	Α	ZER
1	EA	MULTITECH READER	MTB11/15 - BY ACCESS CONTROL PROVIDER (COORDINATE W/ HEAD END AND CREDENTIAL TYPE)	BLK	SCE
2	EA	DOOR CONTACT	7764	628	SCE
1	EA	POWER SUPPLY	PS904 900-4RL [COORDINATE WITH ACCESS CONTROL PROVIDER]		VON
1	EA	DIAGRAM	ELEVATION		DLR
1	EA	DIAGRAM	POINT TO POINT		DLR

UNLOCKED HOURS: PRESSING EITHER ACTUATOR CYCLES AUTOMATIC OPERATOR AND MOMENTARILY OPEN DOOR.

LOCKED HOURS: VALID CREDENTIAL MOMENTARILY UNLOCKS DOOR AND ACTIVATES EXTERIOR ACTUATOR. WHEN ACTIVE, PRESSING EXTERIOR ACTUATOR CYCLES AUTOMATIC OPERATOR AND MOMENTARILY OPENS DOOR. INTERIOR ACTUATOR ALWAYS ACTIVE. DOORS REMAIN LOCKED UPON LOSS OF POWER. DOOR CONTACTS TO MONITOR DOOR POSITION. RX SWITCH (INTEGRAL TO EXIT DEVICE) SHUNTS DOOR CONTACTS FOR VALID EGRESS. FREE EGRESS AT ALL TIMES.

DUAL ACTUATOR (8310-855) IN VESTIBULE SHARED FOR EXTERIOR AND INTERIOR VESTIBULE DOOR.

HARDWARE GROUP NO. 43

For use on Door #(s): B-101B D-103B

Provide each OPENING with the following:

QTY		DESCRIPTION	CATALOG NUMBER	FINISH	MFR
2	EA	CONT. HINGE	224HD EPT	628	IVE
2	EA	POWER TRANSFER	EPT10	689	VON
1	EA	REMOVABLE MULLION	KR4954 STAB	689	VON
3	EA	MORTISE CYLINDER	1E74	626	BES
1	EA	ELEC PANIC HARDWARE	SD-RX-QEL-98-EO 24 VDC	626	VON
1	EA	ELEC PANIC HARDWARE	SD-RX-QEL-98-NL-OP-110MD 24 VDC	626	VON
1	EA	RIM CYLINDER	1E72	626	BES



QTY		DESCRIPTION	CATALOG NUMBER	FINISH	MFR
2	EA	90 DEG OFFSET PULL	8190HD 12" O	630	IVE
1	EA	OH STOP	100S	630	GLY
1	EA	SURFACE CLOSER	4040XP SCUSH	689	LCN
1	EA	SURF. AUTO OPERATOR	4642 TBWMS 120 VAC	689	LCN
1	EA	PA MOUNTING PLATE	4040XP-18PA AS REQ'D	689	LCN
1	EA	CUSH SHOE SUPPORT	4040XP-30 AS REQ'D	689	LCN
1	EA	BLADE STOP SPACER	4040XP-61 AS REQ'D	689	LCN
1	EA	WEATHER RING	8310-801		LCN
1	EA	ACTUATOR, TOUCH	8310-853T	630	LCN
1	EA	ACTUATOR, TOUCH	8310-855	630	LCN
1	EA	MULLION SEAL	8780NBK	BK	ZER
1	EA	WEATHER STRIPPING	By Door/Frame Manufacturer		
2	EA	DOOR SWEEP	8192AA	AA	ZER
1	EA	THRESHOLD	655A-223	Α	ZER
1	EA	MULTITECH READER	MTB11/15 - BY ACCESS CONTROL PROVIDER (COORDINATE W/ HEAD END AND CREDENTIAL TYPE)	BLK	SCE
1	EA	AI PHONE	BY ACCESS CONTROL PROVIDER		
2	EA	DOOR CONTACT	7764	628	SCE
1	EA	POWER SUPPLY	PS904 900-4RL [COORDINATE WITH ACCESS CONTROL PROVIDER]		VON
1	EA	DIAGRAM	ELEVATION		DLR
1	EA	DIAGRAM	POINT TO POINT		DLR

UNLOCKED HOURS: PRESSING EITHER ACTUATOR CYCLES AUTOMATIC OPERATOR AND MOMENTARILY OPEN DOOR.

LOCKED HOURS: VALID CREDENTIAL OR AIPHONE AT RECEPTION DESK MOMENTARILY UNLOCKS DOOR AND ACTIVATES EXTERIOR ACTUATOR. WHEN ACTIVE, PRESSING EXTERIOR ACTUATOR CYCLES AUTOMATIC OPERATOR AND MOMENTARILY OPENS DOOR. INTERIOR ACTUATOR ALWAYS ACTIVE. DOORS REMAIN LOCKED UPON LOSS OF POWER. DOOR CONTACTS TO MONITOR DOOR POSITION. RX SWITCH (INTEGRAL TO EXIT DEVICE) SHUNTS DOOR CONTACTS FOR VALID EGRESS. FREE EGRESS AT ALL TIMES.

HARDWARE GROUP NO. 44

For use on Door #(s): B-101D

Provide each OPENING with the following:

QTY		DESCRIPTION	CATALOG NUMBER	FINISH	MFR
2	EΑ	CONT. HINGE	224HD EPT	628	IVE



QTY		DESCRIPTION	CATALOG NUMBER	FINISH	MFR
2	EA	POWER TRANSFER	EPT10	689	VON
1	EA	REMOVABLE MULLION	KR4954 STAB	689	VON
3	EA	MORTISE CYLINDER	1E74	626	BES
1	EA	ELEC PANIC HARDWARE	SD-RX-QEL-98-EO 24 VDC	626	VON
1	EA	ELEC PANIC HARDWARE	SD-RX-QEL-98-NL-OP-110MD 24 VDC	626	VON
1	EA	RIM CYLINDER	1E72	626	BES
2	EA	90 DEG OFFSET PULL	8190HD 12" O	630	IVE
1	EA	OH STOP	100S	630	GLY
1	EA	SURFACE CLOSER	4040XP SCUSH	689	LCN
1	EA	SURF. AUTO OPERATOR	4642 TBWMS 120 VAC	689	LCN
1	EA	PA MOUNTING PLATE	4040XP-18PA AS REQ'D	689	LCN
1	EA	CUSH SHOE SUPPORT	4040XP-30 AS REQ'D	689	LCN
1	EA	BLADE STOP SPACER	4040XP-61 AS REQ'D	689	LCN
1	EA	ACTUATOR, TOUCH	8310-853T	630	LCN
1	EA	ACTUATOR	VESTIBULE ACTUATOR SPECIFIED WITH EXTERIOR VESTIBULE DOOR		
1	EA	MULLION SEAL	8780NBK	BK	ZER
1	EA	MULTITECH READER	MTB11/15 - BY ACCESS CONTROL PROVIDER (COORDINATE W/ HEAD END AND CREDENTIAL TYPE)	BLK	SCE
2	EA	DOOR CONTACT	7764	628	SCE
1	EA	POWER SUPPLY	PS904 900-4RL [COORDINATE WITH ACCESS CONTROL PROVIDER]		VON
1	EA	DIAGRAM	ELEVATION		DLR
1	EA	DIAGRAM	POINT TO POINT		DLR

UNLOCKED HOURS: PRESSING EITHER ACTUATOR CYCLES AUTOMATIC OPERATOR AND MOMENTARILY OPEN DOOR.

LOCKED HOURS: VALID CREDENTIAL MOMENTARILY UNLOCKS DOOR AND ACTIVATES EXTERIOR ACTUATOR. WHEN ACTIVE, PRESSING EXTERIOR ACTUATOR CYCLES AUTOMATIC OPERATOR AND MOMENTARILY OPENS DOOR. ITNERIOR ACTUATOR ALWAYS ACTIVE. DOORS REMAIN LOCKED UPON LOSS OF POWER. DOOR CONTACTS TO MONITOR DOOR POSITION. RX SWITCH (INTEGRAL TO EXIT DEVICE) SHUNTS DOOR CONTACTS FOR VALID EGRESS. FREE EGRESS AT ALL TIMES.



For use on Door #(s): A-116A

Provide each OPENING with the following:

QT	Υ	DESCRIPTION	CATALOG NUMBER	FINISH	MFR
2	EA	CONT. HINGE	224HD EPT	628	IVE
2	EA	POWER TRANSFER	EPT10	689	VON
1	EA	REMOVABLE MULLION	KR4954 STAB	689	VON
3	EA	MORTISE CYLINDER	1E74	626	BES
1	EA	ELEC PANIC HARDWARE	SD-RX-QEL-98-EO 24 VDC	626	VON
1	EA	ELEC PANIC HARDWARE	SD-RX-QEL-98-NL-OP-110MD 24 VDC	626	VON
1	EA	RIM CYLINDER	1E72	626	BES
2	EA	90 DEG OFFSET PULL	8190HD 12" O	630	IVE
1	EA	OH STOP	100S	630	GLY
1	EA	SURFACE CLOSER	4040XP SCUSH	689	LCN
1	EA	SURF. AUTO OPERATOR	4642 TBWMS 120 VAC	689	LCN
1	EA	PA MOUNTING PLATE	4040XP-18PA AS REQ'D	689	LCN
1	EA	CUSH SHOE SUPPORT	4040XP-30 AS REQ'D	689	LCN
1	EA	BLADE STOP SPACER	4040XP-61 AS REQ'D	689	LCN
1	EA	WEATHER RING	8310-801		LCN
2	EA	ACTUATOR, TOUCH	8310-853T	630	LCN
1	EA	MULLION SEAL	8780NBK	BK	ZER
1	EA	WEATHER STRIPPING	By Door/Frame Manufacturer		
2	EA	DOOR SWEEP	8192AA	AA	ZER
1	EA	THRESHOLD	655A-223	Α	ZER
1	EA	MULTITECH READER	MTB11/15 - BY ACCESS CONTROL PROVIDER (COORDINATE W/ HEAD END AND CREDENTIAL TYPE)	BLK	SCE
2	EA	DOOR CONTACT	7764	628	SCE
1	EA	POWER SUPPLY	PS904 900-4RL [COORDINATE WITH ACCESS CONTROL PROVIDER]		VON
1	EA	DIAGRAM	ELEVATION		DLR
1	EA	DIAGRAM	POINT TO POINT		DLR





UNLOCKED HOURS: PRESSING EITHER ACTUATOR CYCLES AUTOMATIC OPERATOR AND MOMENTARILY OPEN DOOR.

LOCKED HOURS: VALID CREDENTIAL MOMENTARILY UNLOCKS DOOR AND ACTIVATES EXTERIOR ACTUATOR. WHEN ACTIVE, PRESSING EXTERIOR ACTUATOR CYCLES AUTOMATIC OPERATOR AND MOMENTARILY OPENS DOOR. INTERIOR ACTUATOR ALWAYS ACTIVE. DOORS REMAIN LOCKED UPON LOSS OF POWER. DOOR CONTACTS TO MONITOR DOOR POSITION. RX SWITCH (INTEGRAL TO EXIT DEVICE) SHUNTS DOOR CONTACTS FOR VALID EGRESS. FREE EGRESS AT ALL TIMES.

DUAL ACTUATOR (8310-855) IN VESTIBULE SHARED FOR EXTERIOR AND INTERIOR VESTIBULE DOOR.

HARDWARE GROUP NO. 46

For use on Door #(s):

B-131A B-133A C-101A C-115A

Provide each OPENING with the following:

	DESCRIPTION	CATALOG NUMBER	FINISH	MFR
EA	CONT. HINGE	224HD EPT	628	IVE
EA	POWER TRANSFER	EPT10	689	VON
EA	REMOVABLE MULLION	KR4954 STAB	689	VON
EA	MORTISE CYLINDER	1E74	626	BES
EA	ELEC PANIC HARDWARE	SD-RX-QEL-98-EO 24 VDC	626	VON
EA	ELEC PANIC HARDWARE	SD-RX-QEL-98-NL-OP-110MD 24 VDC	626	VON
EA	RIM CYLINDER	1E72	626	BES
EA	90 DEG OFFSET PULL	8190HD 12" O	630	IVE
EA	SURFACE CLOSER	4040XP SCUSH	689	LCN
EA	PA MOUNTING PLATE	4040XP-18PA AS REQ'D	689	LCN
EA	CUSH SHOE SUPPORT	4040XP-30 AS REQ'D	689	LCN
EA	BLADE STOP SPACER	4040XP-61 AS REQ'D	689	LCN
EA	MULLION SEAL	8780NBK	BK	ZER
EA	WEATHER STRIPPING	By Door/Frame Manufacturer		
EA	DOOR SWEEP	8192AA	AA	ZER
EA	THRESHOLD	655A-223	Α	ZER
EA	MULTITECH READER	MTB11/15 - BY ACCESS CONTROL PROVIDER (COORDINATE W/ HEAD END AND CREDENTIAL TYPE)	BLK	SCE
EA	DOOR CONTACT	7764	628	SCE
EA	POWER SUPPLY	PS904 900-2RS [COORDINATE WITH ACCESS CONTROL PROVIDER]		VON
EA	DIAGRAM	ELEVATION		DLR
EA	DIAGRAM	POINT TO POINT		DLR
	EA EA EA EA EA EA EA EA EA EA	EA CONT. HINGE EA POWER TRANSFER EA REMOVABLE MULLION EA MORTISE CYLINDER EA ELEC PANIC HARDWARE EA ELEC PANIC HARDWARE EA GOUTH OF THE PROPERTY OF THE PROPERTY OF THE POWER SUPPORT EA MULLION SEAL EA WEATHER STRIPPING EA DOOR SWEEP EA THRESHOLD EA MULTITECH READER EA DOOR CONTACT EA POWER SUPPLY EA DIAGRAM	EA CONT. HINGE EA POWER TRANSFER EA REMOVABLE MULLION EA REMOVABLE MULLION EA MORTISE CYLINDER EA ELEC PANIC HARDWARE EA ELEC PANIC HARDWARE EA RIM CYLINDER EA RIM CYLINDER EA PO DEG OFFSET PULL EA SURFACE CLOSER EA PA MOUNTING PLATE EA CUSH SHOE SUPPORT EA BLADE STOP SPACER EA MULLION SEAL EA WEATHER STRIPPING EA DOOR SWEEP EA THRESHOLD EA THRESHOLD EA DOOR CONTACT EA POWER SUPPLY EA DIAGRAM ELEVATION EA DIAGRAM ELEVATION EPT10 EACONT. HINGE EPT10 EA PA MOULION EAR RE4954 STAB EAPT4 EAPT4 EAPT6 EAP	EA CONT. HINGE 224HD EPT 628 EA POWER TRANSFER EPT10 689 EA REMOVABLE MULLION KR4954 STAB 689 EA MORTISE CYLINDER 1E74 626 EA ELEC PANIC HARDWARE SD-RX-QEL-98-BC 24 VDC 626 EA ELEC PANIC HARDWARE SD-RX-QEL-98-NL-OP-110MD 24 626 EA RIM CYLINDER 1E72 626 EA RIM CYLINDER 1E72 626 EA PO DEG OFFSET PULL 8190HD 12" O 630 EA SURFACE CLOSER 4040XP SCUSH 689 EA PA MOUNTING PLATE 4040XP-30 AS REQ'D 689 EA PA MOULTING PLATE 4040XP-30 AS REQ'D 689 EA BLADE STOP SPACER 4040XP-61 AS REQ'D 689 EA MULLION SEAL 8780NBK BK EA WEATHER STRIPPING By Door/Frame Manufacturer EA DOOR SWEEP 8192AA A EA MULTITECH READER MTB11/15 - B



LOCKED HOURS: VALID CREDENTIAL MOMENTARILY UNLOCKS DOOR ALLOWING ACCESS. DOORS REMAIN LOCKED UPON LOSS OF POWER. DOOR CONTACTS TO MONITOR DOOR POSITION. RX SWITCH (INTEGRAL TO EXIT DEVICE) SHUNTS DOOR CONTACTS FOR VALID EGRESS. FREE EGRESS AT ALL TIMES.

HARDWARE GROUP NO. 47

For use on Door #(s): C-130A

Provide each OPENING with the following:

1 EA REMOVABLE MULLION KR4954 STAB 689 VON 3 EA MORTISE CYLINDER 1E74 626 BES 1 EA ELEC PANIC HARDWARE SD-RX-QEL-98-EO 24 VDC 626 VON 1 EA ELEC PANIC HARDWARE SD-RX-QEL-98-NL-OP-110MD 24 626 VON 1 EA RIM CYLINDER 1E72 626 BES 2 EA RIM CYLINDER 1E72 626 BES 2 EA 90 DEG OFFSET PULL 8190HD 12" O 630 IVE 2 EA 90 DEG OFFSET PULL 8190HD 12" O 630 IVE 2 EA SURFACE CLOSER 4040XP SCUSH 689 LCN 2 EA PA MOUNTING PLATE 4040XP-18PA AS REQ'D 689 LCN 2 EA CUSH SHOE SUPPORT 4040XP-30 AS REQ'D 689 LCN 1 EA MULLION SEAL 8780NBK BK ZER 1 EA DOOR SWEE	QTY		DESCRIPTION	CATALOG NUMBER	FINISH	MFR
1 EA REMOVABLE MULLION KR4954 STAB 689 VON 3 EA MORTISE CYLINDER 1E74 626 BES 1 EA ELEC PANIC HARDWARE SD-RX-QEL-98-EO 24 VDC 626 VON 1 EA ELEC PANIC HARDWARE SD-RX-QEL-98-NL-OP-110MD 24 626 VON 1 EA RIM CYLINDER 1E72 626 BES 2 EA RIM CYLINDER 1E72 626 BES 2 EA 90 DEG OFFSET PULL 8190HD 12" O 630 IVE 2 EA SURFACE CLOSER 4040XP SCUSH 689 LCN 2 EA SURFACE CLOSER 4040XP-18PA AS REQ'D 689 LCN 2 EA PA MOUNTING PLATE 4040XP-30 AS REQ'D 689 LCN 2 EA BLADE STOP SPACER 4040XP-31 AS REQ'D 689 LCN 1 EA MULLION SEAL 8780NBK BK ZER 1 EA DOOR SW	2	EA	CONT. HINGE	224HD EPT	628	IVE
3 EA MORTISE CYLINDER 1E74 626 BES 1 EA ELEC PANIC HARDWARE SD-RX-QEL-98-EO 24 VDC 626 VON 1 EA ELEC PANIC HARDWARE SD-RX-QEL-98-NL-OP-110MD 24 626 VON 1 EA RIM CYLINDER 1E72 626 BES 2 EA PO DEG OFFSET PULL 8190HD 12" O 630 IVE 2 EA 90 DEG OFFSET PULL 8190HD 12" O 630 IVE 2 EA SURFACE CLOSER 4040XP SCUSH 689 LCN 2 EA PA MOUNTING PLATE 4040XP-18PA AS REQ'D 689 LCN 2 EA PA MOUNTING PLATE 4040XP-30 AS REQ'D 689 LCN 2 EA BLADE STOP SPACER 4040XP-61 AS REQ'D 689 LCN 1 EA MULLION SEAL 8780NBK BK ZER 1 EA DOOR SWEEP 8192AA AA ZER 1 EA MUL	2	EA	POWER TRANSFER	EPT10	689	VON
1 EA ELEC PANIC HARDWARE SD-RX-QEL-98-EO 24 VDC 626 VON VDC 1 EA ELEC PANIC HARDWARE SD-RX-QEL-98-NL-OP-110MD 24 626 VON VDC 1 EA RIM CYLINDER 1E72 626 BES 12 EA 90 DEG OFFSET PULL 8190HD 12" O 630 IVE 689 LCN 68	1	EA	REMOVABLE MULLION	KR4954 STAB	689	VON
1EAELEC PANIC HARDWARESD-RX-QEL-98-NL-OP-110MD 24 VDC626VON ON ODE VDC1EARIM CYLINDER1E72626BES2EA90 DEG OFFSET PULL 8190HD 12" O630IVE2EASURFACE CLOSER 4040XP SCUSH 4040XP-18PA AS REQ'D689LCN2EAPA MOUNTING PLATE 4040XP-30 AS REQ'D689LCN2EACUSH SHOE SUPPORT 4040XP-30 AS REQ'D689LCN1EABLADE STOP SPACER 4040XP-61 AS REQ'D689LCN1EAMULLION SEAL EA8780NBK 8780NBK BY DOOT/Frame ManufacturerBKZER2EADOOR SWEEP8192AAAAZER1EATHRESHOLD END AND CREDENTIAL TYPE)BLK BLK END AND CREDENTIAL TYPE)BLK BLK SCE PROVIDER (COORDINATE W/ HEAD END AND CREDENTIAL TYPE)BLK BLK SCE1EAAI PHONEBY ACCESS CONTROL PROVIDERC28SCE1EADOOR CONTACT ACCESS CONTROL PROVIDER]7764 CCESS CONTROL PROVIDER]COORDINATE WITH ACCESS CONTROL PROVIDER]VON ACCESS CONTROL PROVIDER]1EADIAGRAMELEVATIONDLR	3	EA	MORTISE CYLINDER	1E74	626	BES
VDC	1	EA	ELEC PANIC HARDWARE	SD-RX-QEL-98-EO 24 VDC	626	VON
EA 90 DEG OFFSET PULL 8190HD 12" O 630 IVE EA SURFACE CLOSER 4040XP SCUSH 689 LCN EA PA MOUNTING PLATE 4040XP-18PA AS REQ'D 689 LCN EA CUSH SHOE SUPPORT 4040XP-30 AS REQ'D 689 LCN EA BLADE STOP SPACER 4040XP-61 AS REQ'D 689 LCN EA MULLION SEAL 8780NBK BK ZER EA WEATHER STRIPPING BY DOOR/Frame Manufacturer EA DOOR SWEEP 8192AA AA ZER EA THRESHOLD 655A-223 A ZER EA MULTITECH READER MTB11/15 - BY ACCESS CONTROL PROVIDER EA AI PHONE BY ACCESS CONTROL PROVIDER EA DOOR CONTACT 7764 628 SCE EA DOOR CONTACT 7764 628 SCE EA DIAGRAM ELEVATION DLR	1	EA	ELEC PANIC HARDWARE		626	VON
2 EA SURFACE CLOSER 4040XP SCUSH 689 LCN 2 EA PA MOUNTING PLATE 4040XP-18PA AS REQ'D 689 LCN 2 EA CUSH SHOE SUPPORT 4040XP-30 AS REQ'D 689 LCN 2 EA BLADE STOP SPACER 4040XP-61 AS REQ'D 689 LCN 1 EA MULLION SEAL 8780NBK BK ZER 1 EA WEATHER STRIPPING By Door/Frame Manufacturer 2 EA DOOR SWEEP 8192AA AA ZER 1 EA THRESHOLD 655A-223 A ZER 1 EA MULTITECH READER MTB11/15 - BY ACCESS CONTROL BLK SCE PROVIDER (COORDINATE W/ HEAD END AND CREDENTIAL TYPE) 1 EA AI PHONE BY ACCESS CONTROL PROVIDER 2 EA DOOR CONTACT 7764 628 SCE 1 EA POWER SUPPLY PS904 900-2RS [COORDINATE WITH ACCESS CONTROL PROVIDER] 1 EA DIAGRAM ELEVATION DLR	1	EA	RIM CYLINDER	1E72	626	BES
2 EA PA MOUNTING PLATE 4040XP-18PA AS REQ'D 689 LCN 2 EA CUSH SHOE SUPPORT 4040XP-30 AS REQ'D 689 LCN 2 EA BLADE STOP SPACER 4040XP-61 AS REQ'D 689 LCN 1 EA MULLION SEAL 8780NBK BK ZER 1 EA WEATHER STRIPPING By Door/Frame Manufacturer 2 EA DOOR SWEEP 8192AA AA ZER 1 EA THRESHOLD 655A-223 A ZER 1 EA MULTITECH READER MTB11/15 - BY ACCESS CONTROL PROVIDER (COORDINATE W/ HEAD END AND CREDENTIAL TYPE) 1 EA AI PHONE BY ACCESS CONTROL PROVIDER 2 EA DOOR CONTACT 7764 628 SCE 1 EA POWER SUPPLY PS904 900-2RS [COORDINATE WITH ACCESS CONTROL PROVIDER] 1 EA DIAGRAM ELEVATION DLR	2	EA	90 DEG OFFSET PULL	8190HD 12" O	630	IVE
2 EA CUSH SHOE SUPPORT 4040XP-30 AS REQ'D 689 LCN 2 EA BLADE STOP SPACER 4040XP-61 AS REQ'D 689 LCN 1 EA MULLION SEAL 8780NBK BK ZER 1 EA WEATHER STRIPPING By Door/Frame Manufacturer 2 EA DOOR SWEEP 8192AA AA ZER 1 EA THRESHOLD 655A-223 A ZER 1 EA MULTITECH READER MTB11/15 - BY ACCESS CONTROL PROVIDER (COORDINATE W/ HEAD END AND CREDENTIAL TYPE) 1 EA AI PHONE BY ACCESS CONTROL PROVIDER 2 EA DOOR CONTACT 7764 628 SCE 1 EA POWER SUPPLY PS904 900-2RS [COORDINATE WITH ACCESS CONTROL PROVIDER] 1 EA DIAGRAM ELEVATION DLR	2	EA	SURFACE CLOSER	4040XP SCUSH	689	LCN
2 EA BLADE STOP SPACER 4040XP-61 AS REQ'D 689 LCN 1 EA MULLION SEAL 8780NBK BK ZER 1 EA WEATHER STRIPPING By Door/Frame Manufacturer 2 EA DOOR SWEEP 8192AA AA ZER 1 EA THRESHOLD 655A-223 A ZER 1 EA MULTITECH READER MTB11/15 - BY ACCESS CONTROL PROVIDER (COORDINATE W/ HEAD END AND CREDENTIAL TYPE) 1 EA AI PHONE BY ACCESS CONTROL PROVIDER 2 EA DOOR CONTACT 7764 628 SCE 1 EA POWER SUPPLY PS904 900-2RS [COORDINATE WITH ACCESS CONTROL PROVIDER] 1 EA DIAGRAM ELEVATION DLR	2	EA	PA MOUNTING PLATE	4040XP-18PA AS REQ'D	689	LCN
1 EA MULLION SEAL 8780NBK BK ZER 1 EA WEATHER STRIPPING By Door/Frame Manufacturer 2 EA DOOR SWEEP 8192AA AA ZER 1 EA THRESHOLD 655A-223 A ZER 1 EA MULTIITECH READER MTB11/15 - BY ACCESS CONTROL PROVIDER (COORDINATE W/ HEAD END AND CREDENTIAL TYPE) 1 EA AI PHONE BY ACCESS CONTROL PROVIDER 2 EA DOOR CONTACT 7764 628 SCE 1 EA POWER SUPPLY PS904 900-2RS [COORDINATE WITH ACCESS CONTROL PROVIDER] 1 EA DIAGRAM ELEVATION DLR	2	EA	CUSH SHOE SUPPORT	4040XP-30 AS REQ'D	689	LCN
1 EA WEATHER STRIPPING By Door/Frame Manufacturer 2 EA DOOR SWEEP 8192AA AA ZER 1 EA THRESHOLD 655A-223 A ZER 1 EA MULTITECH READER MTB11/15 - BY ACCESS CONTROL BLK SCE PROVIDER (COORDINATE W/ HEAD END AND CREDENTIAL TYPE) 1 EA AI PHONE BY ACCESS CONTROL PROVIDER 2 EA DOOR CONTACT 7764 628 SCE 1 EA POWER SUPPLY PS904 900-2RS [COORDINATE WITH ACCESS CONTROL PROVIDER] 1 EA DIAGRAM ELEVATION DLR	2	EA	BLADE STOP SPACER	4040XP-61 AS REQ'D	689	LCN
2 EA DOOR SWEEP 8192AA AA ZER 1 EA THRESHOLD 655A-223 A ZER 1 EA MULTITECH READER MTB11/15 - BY ACCESS CONTROL PROVIDER (COORDINATE W/ HEAD END AND CREDENTIAL TYPE) 1 EA AI PHONE BY ACCESS CONTROL PROVIDER 2 EA DOOR CONTACT 7764 628 SCE 1 EA POWER SUPPLY PS904 900-2RS [COORDINATE WITH ACCESS CONTROL PROVIDER] 1 EA DIAGRAM ELEVATION DLR	1	EA	MULLION SEAL	8780NBK	BK	ZER
1 EA THRESHOLD 655A-223 A ZER 1 EA MULTITECH READER MTB11/15 - BY ACCESS CONTROL PROVIDER (COORDINATE W/ HEAD END AND CREDENTIAL TYPE) 1 EA AI PHONE BY ACCESS CONTROL PROVIDER 2 EA DOOR CONTACT 7764 628 SCE 1 EA POWER SUPPLY PS904 900-2RS [COORDINATE WITH ACCESS CONTROL PROVIDER] 1 EA DIAGRAM ELEVATION DLR	1	EA	WEATHER STRIPPING	By Door/Frame Manufacturer		
1 EA MULTITECH READER MTB11/15 - BY ACCESS CONTROL PROVIDER (COORDINATE W/ HEAD END AND CREDENTIAL TYPE) 1 EA AI PHONE BY ACCESS CONTROL PROVIDER 2 EA DOOR CONTACT 7764 628 SCE 1 EA POWER SUPPLY PS904 900-2RS [COORDINATE WITH ACCESS CONTROL PROVIDER] 1 EA DIAGRAM ELEVATION DLR	2	EA	DOOR SWEEP	8192AA	AA	ZER
PROVIDER (COORDINATE W/ HEAD END AND CREDENTIAL TYPE) 1 EA AI PHONE BY ACCESS CONTROL PROVIDER 2 EA DOOR CONTACT 7764 628 SCE 1 EA POWER SUPPLY PS904 900-2RS [COORDINATE WITH ACCESS CONTROL PROVIDER] 1 EA DIAGRAM ELEVATION DLR	1	EA	THRESHOLD	655A-223	Α	ZER
2 EA DOOR CONTACT 7764 628 SCE 1 EA POWER SUPPLY PS904 900-2RS [COORDINATE WITH ACCESS CONTROL PROVIDER] 1 EA DIAGRAM ELEVATION DLR	1	EA	MULTITECH READER	PROVIDER (COORDINATE W/ HEAD	BLK	SCE
1 EA POWER SUPPLY PS904 900-2RS [COORDINATE WITH ACCESS CONTROL PROVIDER] 1 EA DIAGRAM ELEVATION DLR	1	EA	AI PHONE	BY ACCESS CONTROL PROVIDER		
ACCESS CONTROL PROVIDER] 1 EA DIAGRAM ELEVATION DLR	2	EA	DOOR CONTACT	7764	628	SCE
	1	EA	POWER SUPPLY			VON
1 EA DIAGRAM POINT TO POINT DLR	1	EA	DIAGRAM	ELEVATION		DLR
	1	EA	DIAGRAM	POINT TO POINT		DLR






LOCKED HOURS: VALID CREDENTIAL OR AIPHONE AT RECEPTION DESK MOMENTARILY UNLOCKS DOOR ALLOWING ACCESS. DOORS REMAIN LOCKED UPON LOSS OF POWER. DOOR CONTACTS TO MONITOR DOOR POSITION. RX SWITCH (INTEGRAL TO EXIT DEVICE) SHUNTS DOOR CONTACTS FOR VALID EGRESS. FREE EGRESS AT ALL TIMES.

HARDWARE GROUP NO. 48

For use on Door #(s): B-129A

Provide each OPENING with the following:

QTY		DESCRIPTION	CATALOG NUMBER	FINISH	MFR
2	EA	CONT. HINGE	224HD EPT	628	IVE
2	EA	POWER TRANSFER	EPT10	689	VON
1	EA	REMOVABLE MULLION	KR4954 STAB	689	VON
3	EA	MORTISE CYLINDER	1E74	626	BES
1	EA	ELEC PANIC HARDWARE	SD-RX-QEL-98-EO 24 VDC	626	VON
1	EA	ELEC PANIC HARDWARE	SD-RX-QEL-98-NL-OP-110MD 24 VDC	626	VON
1	EA	RIM CYLINDER	1E72	626	BES
2	EA	90 DEG OFFSET PULL	8190HD 12" O	630	IVE
2	EA	SURFACE CLOSER	4040XP SHCUSH	689	LCN
2	EA	PA MOUNTING PLATE	4040XP-18PA AS REQ'D	689	LCN
2	EA	CUSH SHOE SUPPORT	4040XP-30 AS REQ'D	689	LCN
2	EA	BLADE STOP SPACER	4040XP-61 AS REQ'D	689	LCN
1	EA	MULLION SEAL	8780NBK	BK	ZER
1	EA	WEATHER STRIPPING	By Door/Frame Manufacturer		
2	EA	DOOR SWEEP	8192AA	AA	ZER
1	EA	THRESHOLD	655A-223	Α	ZER
1	EA	MULTITECH READER	MTB11/15 - BY ACCESS CONTROL PROVIDER (COORDINATE W/ HEAD END AND CREDENTIAL TYPE)	BLK	SCE
2	EA	DOOR CONTACT	7764	628	SCE
1	EA	POWER SUPPLY	PS904 900-2RS [COORDINATE WITH ACCESS CONTROL PROVIDER]		VON
1	EA	DIAGRAM	ELEVATION		DLR
1	EA	DIAGRAM	POINT TO POINT		DLR

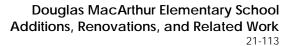



LOCKED HOURS: VALID CREDENTIAL MOMENTARILY UNLOCKS DOOR ALLOWING ACCESS. DOORS REMAIN LOCKED UPON LOSS OF POWER. DOOR CONTACTS TO MONITOR DOOR POSITION. RX SWITCH (INTEGRAL TO EXIT DEVICE) SHUNTS DOOR CONTACTS FOR VALID EGRESS. FREE EGRESS AT ALL TIMES.



For use on Door #(s):

B-131B C-115B C-130B D-103C

Provide each OPENING with the following:

QTY		DESCRIPTION	CATALOG NUMBER	FINISH	MFR
2	EA	CONT. HINGE	224HD	628	IVE
2	EA	DUMMY PUSH BAR	350	626	VON
2	EA	90 DEG OFFSET PULL	8190HD 12" O	630	IVE
2	EA	SURFACE CLOSER	4040XP SCUSH	689	LCN
2	EA	PA MOUNTING PLATE	4040XP-18PA AS REQ'D	689	LCN
2	EA	CUSH SHOE SUPPORT	4040XP-30 AS REQ'D	689	LCN
2	EA	BLADE STOP SPACER	4040XP-61 AS REQ'D	689	LCN

HARDWARE GROUP NO. 50

For use on Door #(s):

A-135B D-101B D-103D D-118B

Provide each OPENING with the following:

QTY		DESCRIPTION	CATALOG NUMBER	FINISH	MFR
2	EA	CONT. HINGE	224HD	628	IVE
2	EA	DUMMY PUSH BAR	350	626	VON
2	EA	90 DEG OFFSET PULL	8190HD 12" O	630	IVE
1	EA	OH STOP	100S	630	GLY
1	EA	SURFACE CLOSER	4040XP SCUSH	689	LCN
1	EA	SURF. AUTO OPERATOR	4642 TBWMS 120 VAC	689	LCN
1	EA	PA MOUNTING PLATE	4040XP-18PA AS REQ'D	689	LCN
1	EA	CUSH SHOE SUPPORT	4040XP-30 AS REQ'D	689	LCN
1	EA	BLADE STOP SPACER	4040XP-61 AS REQ'D	689	LCN
1	EA	ACTUATOR, TOUCH	8310-853T	630	LCN
1	EA	ACTUATOR	VESTIBULE ACTUATOR SPECIFIED		
			WITH EXTERIOR VESTIBULE DOOR		
1	EA	DIAGRAM	ELEVATION		DLR
1	EA	DIAGRAM	POINT TO POINT		DLR

OPERATION: PRESSING EITHER ACTUATOR CYCLES AUTOMATIC OPERATOR AND MOMENTARILY OPENS DOOR. FREE EGRESS AT ALL TIMES.

DUAL ACTUATOR (8310-855) IN VESTIBULE SHARED FOR EXTERIOR AND INTERIOR VESTIBULE DOOR. (SPECIFIED WITH EXTERIOR VESTIBULE DOOR)





For use on Door #(s):

B-101A C-101B D-103A

Provide each OPENING with the following:

QTY		DESCRIPTION	CATALOG NUMBER	FINISH	MFR
2	EA	CONT. HINGE	224HD EPT	628	IVE
2	EA	POWER TRANSFER	EPT10	689	VON
1	EA	REMOVABLE MULLION	KR4954 STAB	689	VON
3	EA	MORTISE CYLINDER	1E74	626	BES
2	EA	ELEC PANIC HARDWARE	SD-RX-QEL-98-EO 24 VDC	626	VON
2	EA	90 DEG OFFSET PULL	8190HD 12" O	630	IVE
2	EA	SURFACE CLOSER	4040XP SCUSH	689	LCN
2	EA	PA MOUNTING PLATE	4040XP-18PA AS REQ'D	689	LCN
2	EA	CUSH SHOE SUPPORT	4040XP-30 AS REQ'D	689	LCN
2	EA	BLADE STOP SPACER	4040XP-61 AS REQ'D	689	LCN
1	EA	RAIN DRIP	142AA	AA	ZER
1	EA	MULLION SEAL	8780NBK	BK	ZER
1	EA	WEATHER STRIPPING	By Door/Frame Manufacturer		
2	EA	DOOR SWEEP	8192AA	AA	ZER
1	EA	THRESHOLD	655A-223	Α	ZER
2	EA	DOOR CONTACT	7764	628	SCE
1	EA	POWER SUPPLY	PS904 900-2RS [COORDINATE WITH ACCESS CONTROL PROVIDER]		VON
1	EA	DIAGRAM	ELEVATION		DLR
1	EA	DIAGRAM	POINT TO POINT		DLR

OPERATION: DOORS NORMALLY CLOSED AND LOCKED. DOORS CAN BE LEFT UNLOCKED AS PROGRAMMED BY ACCESS CONTROL.

DOOR CONTACTS TO MONITOR DOOR POSITION. RX SWITCH (INTEGRAL TO EXIT DEVICE) SHUNTS DOOR CONTACT FOR VALID EGRESS. FREE EGRESS AT ALL TIMES.



For use on Door #(s): B-101C

Provide each OPENING with the following:

QTY		DESCRIPTION	CATALOG NUMBER	FINISH	MFR
2	EA	CONT. HINGE	224HD EPT	628	IVE
2	EA	POWER TRANSFER	EPT10	689	VON
1	EA	REMOVABLE MULLION	KR4954 STAB	689	VON
3	EA	MORTISE CYLINDER	1E74	626	BES
2	EA	ELEC PANIC HARDWARE	SD-RX-QEL-98-EO 24 VDC	626	VON
2	EA	90 DEG OFFSET PULL	8190HD 12" O	630	IVE
2	EA	SURFACE CLOSER	4040XP SCUSH	689	LCN
2	EA	PA MOUNTING PLATE	4040XP-18PA AS REQ'D	689	LCN
2	EA	CUSH SHOE SUPPORT	4040XP-30 AS REQ'D	689	LCN
2	EA	BLADE STOP SPACER	4040XP-61 AS REQ'D	689	LCN
1	EA	MULLION SEAL	8780NBK	BK	ZER
2	EA	DOOR CONTACT	7764	628	SCE
1	EA	POWER SUPPLY	PS904 900-2RS [COORDINATE WITH		VON
			ACCESS CONTROL PROVIDER]		
1	EA	DIAGRAM	ELEVATION		DLR
1	EA	DIAGRAM	POINT TO POINT		DLR

OPERATION: DOORS NORMALLY CLOSED AND LOCKED. DOORS CAN BE LEFT UNLOCKED AS PROGRAMMED BY ACCESS CONTROL.

DOOR CONTACTS TO MONITOR DOOR POSITION. RX SWITCH (INTEGRAL TO EXIT DEVICE) SHUNTS DOOR CONTACT FOR VALID EGRESS. FREE EGRESS AT ALL TIMES.



For use on Door #(s): B-143B

Provide each OPENING with the following:

QTY		DESCRIPTION	CATALOG NUMBER	FINISH	MFR
6	EA	HINGE	5BB1 4.5 X 4.5 (NRP AS REQ'D)	652	IVE
2	EA	MORTISE CYLINDER	1E74	626	BES
2	EA	PANIC HARDWARE	CDSI-9827-DT-LBR	626	VON
2	EA	STRIKE	260U	626	VON
2	EA	SURFACE CLOSER	4040XP HCUSH	689	LCN
2	EA	PA FLUSH PANEL ADAPTER	4040XP-419 SRT	689	LCN
2	EA	KICK PLATE	8400 10" X 1" LDW B-CS	630	IVE
1	EA	THRESHOLD	BY WOOD FLOOR INSTALLER		B/O
2	EA	SILENCER	SR64	GRY	IVE

DOORS AND TRANSOM TO BE RABBETED.

HARDWARE GROUP NO. 54 - NOT USED

HARDWARE GROUP NO. 55

For use on Door #(s): B-124A

Provide each OPENING with the following:

QTY		DESCRIPTION	CATALOG NUMBER	FINISH	MFR
6	EA	HINGE	5BB1 4.5 X 4.5 (NRP AS REQ'D)	652	IVE
2	EA	MORTISE CYLINDER	1E74	626	BES
2	EA	PANIC HARDWARE	CDSI-9827-DT-LBR	626	VON
2	EA	STRIKE	260U	626	VON
1	EA	SURFACE CLOSER	4040XP EDA (MOUNT CLOSER TO ALLOW DOOR TO SWING AGAINST WALL)	689	LCN
1	EA	SURFACE CLOSER	4040XP HCUSH	689	LCN
2	EA	PA FLUSH PANEL ADAPTER	4040XP-419 SRT	689	LCN
2	EA	KICK PLATE	8400 10" X 1" LDW B-CS	630	IVE
1	EA	WALL STOP/HOLDER	WS45	626	IVE
2	EA	SILENCER	SR64	GRY	IVE

DOORS AND TRANSOM TO BE RABBETED.



For use on Door #(s): B-114A

Provide each OPENING with the following:

QTY		DESCRIPTION	CATALOG NUMBER	FINISH	MFR
6	EA	HINGE	5BB1HW 5 X 4.5 (NRP AS REQ'D)	652	IVE
2	EA	POWER TRANSFER	EPT10	689	VON
1	EA	ELEC PANIC HARDWARE	RX-QEL-9827-DT-LBR 24 VDC	626	VON
1	EA	ELEC PANIC HARDWARE	RX-QEL-9827-NL-LBR 24 VDC	626	VON
2	EA	STRIKE	260U	626	VON
1	EA	RIM CYLINDER	1E72	626	BES
2	EA	SURFACE CLOSER	4040XP RW/PA	689	LCN
2	EA	PA FLUSH PANEL ADAPTER	4040XP-419 SRT	689	LCN
2	EA	KICK PLATE	8400 10" X 1" LDW B-CS	630	IVE
2	EA	FIRE/LIFE WALL MAG	SEM7800 SERIES AS REQ'D	689	LCN
2	EA	SILENCER	SR64	GRY	IVE
1	EA	MULTITECH READER	MTB11/15 - BY ACCESS CONTROL PROVIDER (COORDINATE W/ HEAD END AND CREDENTIAL TYPE)	BLK	SCE
2	EA	DOOR CONTACT	679-05WD/679-05HM AS REQ	BLK	SCE
1	EA	POWER SUPPLY	PS904 900-4R [COORDINATE WITH ACCESS CONTROL PROVIDER]		VON
1	EA	DIAGRAM	ELEVATION		DLR
1	EA	DIAGRAM	POINT TO POINT		DLR

OPERATION: DOORS NORMALLY HELD OPEN. UPON LOSS OF POWER OR FIRE ALARM, MAGNETIC HOLD OPENS RELEASE, ALLOWING DOORS TO CLOSE, LOCK AND LATCH. FREE EGRESS AT ALL TIMES.

WHEN DOORS ARE CLOSED AND LOCKED: VALID CREDENTIAL MOMENTARILY UNLOCKS DOOR ALLOWING ENTRY. DOOR CONTACTS TO MONITOR DOOR POSITION. RX SWITCH (INTEGRAL TO PANIC DEVICE) SHUNTS DOOR CONTACT FOR VALID EGRESS. FREE EGRESS AT ALL TIMES.

POWER SUPPLY TIED INTO FIRE ALARM SYSETM.

DOORS AND TRANSOM TO BE RABBETED.



For use on Door #(s): B-138B

Provide each OPENING with the following:

QTY		DESCRIPTION	CATALOG NUMBER	FINISH	MFR			
3	EA	HINGE	5BB1 4.5 X 4.5 (NRP AS REQ'D)	652	IVE			
2	EA	MORTISE CYLINDER	1E74	626	BES			
1	EA	PANIC HARDWARE	CDSI-9875-NL	626	VON			
1	EA	SURFACE CLOSER	4040XP SCUSH	689	LCN			
1	EA	PA FLUSH PANEL ADAPTER	4040XP-419 SRT	689	LCN			
1	EA	KICK PLATE	8400 10" X 1 1/2" LDW B-CS	630	IVE			
2	EA	GASKETING	119WB PSA	В	ZER			
1	EA	GASKETING	870AA	AA	ZER			
1	EA	DOOR BOTTOM	364AA	AA	ZER			
1	EA	THRESHOLD	564A	Α	ZER			
1	EA	MOUNTING BRACKET	870SPB		ZER			
HARE	HARDWARE GROUP NO. 58 - NOT USED							

HARDWARE GROUP NO. 59

For use on Door #(s): B-143A

Provide each OPENING with the following:

QTY		DESCRIPTION	CATALOG NUMBER	FINISH	MFR
6	EA	HINGE	5BB1 4.5 X 4.5 (NRP AS REQ'D)	652	IVE
2	EA	MORTISE CYLINDER	1E74	626	BES
1	EA	PANIC HARDWARE	CDSI-9827-DT-LBR	626	VON
1	EA	PANIC HARDWARE	CDSI-9827-NL-LBR	626	VON
2	EA	STRIKE	260U	626	VON
1	EA	RIM CYLINDER	1E72	626	BES
2	EA	SURFACE CLOSER	4040XP HCUSH	689	LCN
2	EA	PA FLUSH PANEL ADAPTER	4040XP-419 SRT	689	LCN
2	EA	KICK PLATE	8400 10" X 1" LDW B-CS	630	IVE
1	EA	THRESHOLD	BY WOOD FLOOR INSTALLER		B/O
2	EA	SILENCER	SR64	GRY	IVE

NOTE: VERIFY/COORDINATE PREPS ON EXISTING DOORS AND FRAMES. PROVIDE CORRECT STRIKES, FIELD MODIFICATIONS AND/OR FILLERS TO EXISTING DOORS AND FRAMES AS NECESSARY TO ACCEPT NEW SPECIFIED HARDWARE AND COVER EXPOSED HOLES.

DOORS AND TRANSOM TO BE RABBETED.





For use on Door #(s): B-124C

Provide each OPENING with the following:

QTY		DESCRIPTION	CATALOG NUMBER	FINISH	MFR
6	EA	HINGE	5BB1 4.5 X 4.5 (NRP AS REQ'D)	652	IVE
2	EA	MORTISE CYLINDER	1E74	626	BES
1	EA	PANIC HARDWARE	CDSI-9827-DT-LBR	626	VON
1	EA	PANIC HARDWARE	CDSI-9827-NL-LBR	626	VON
2	EA	STRIKE	260U	626	VON
1	EA	RIM CYLINDER	1E72	626	BES
1	EA	SURFACE CLOSER	4040XP HCUSH	689	LCN
1	EA	SURFACE CLOSER	4040XP RW/PA	689	LCN
2	EA	PA FLUSH PANEL ADAPTER	4040XP-419 SRT	689	LCN
2	EA	KICK PLATE	8400 10" X 1" LDW B-CS	630	IVE
1	EA	WALL STOP/HOLDER	WS45	626	IVE
2	EA	SILENCER	SR64	GRY	IVE

NOTE: VERIFY/COORDINATE PREPS ON EXISTING DOORS AND FRAMES. PROVIDE CORRECT STRIKES, FIELD MODIFICATIONS AND/OR FILLERS TO EXISTING DOORS AND FRAMES AS NECESSARY TO ACCEPT NEW SPECIFIED HARDWARE AND COVER EXPOSED HOLES.

DOORS AND TRANSOM TO BE RABBETED.



For use on Door #(s): B-124B

Provide each OPENING with the following:

QTY		DESCRIPTION	CATALOG NUMBER	FINISH	MFR
6	EA	HINGE	5BB1 4.5 X 4.5 (NRP AS REQ'D)	652	IVE
2	EA	MORTISE CYLINDER	1E74	626	BES
1	EA	PANIC HARDWARE	CDSI-9827-DT-LBR	626	VON
1	EA	PANIC HARDWARE	CDSI-9827-NL-LBR	626	VON
2	EA	STRIKE	260U	626	VON
1	EA	RIM CYLINDER	1E72	626	BES
1	EA	SURFACE CLOSER	4040XP EDA (MOUNT CLOSER TO ALLOW DOOR TO SWING 180 DEGRESS)	689	LCN
1	EA	SURFACE CLOSER	4040XP HCUSH	689	LCN
2	EA	PA FLUSH PANEL ADAPTER	4040XP-419 SRT	689	LCN
2	EA	KICK PLATE	8400 10" X 1" LDW B-CS	630	IVE
1	EA	WALL STOP/HOLDER	WS45	626	IVE
2	EA	SILENCER	SR64	GRY	IVE

DOORS AND TRANSOM TO BE RABBETED.



For use on Door #(s): C-102A

Provide each OPENING with the following:

QTY		DESCRIPTION	CATALOG NUMBER	FINISH	MFR
6	EA	HINGE	5BB1HW 5 X 4.5 (NRP AS REQ'D)	652	IVE
2	EA	MORTISE CYLINDER	1E74	626	BES
1	EA	PANIC HARDWARE	CDSI-9827-DT-LBR	626	VON
1	EA	PANIC HARDWARE	CDSI-9827-NL-LBR	626	VON
2	EA	STRIKE	260U	626	VON
1	EA	RIM CYLINDER	1E72	626	BES
1	EA	SURFACE CLOSER	4040XP EDA (MOUNT CLOSER TO ALLOW DOOR TO SWING 180 DEGREES)	689	LCN
1	EA	SURFACE CLOSER	4040XP SHCUSH	689	LCN
2	EA	PA FLUSH PANEL ADAPTER	4040XP-419 SRT	689	LCN
2	EA	KICK PLATE	8400 10" X 1" LDW B-CS	630	IVE
1	EA	WALL STOP/HOLDER	WS45	626	IVE
2	EA	SILENCER	SR64	GRY	IVE

DOORS AND TRANSOM TO BE RABBETED.

HARDWARE GROUP NO. 63

Provide each OPENING with the following:

QTY		DESCRIPTION	CATALOG NUMBER	FINISH	MFR
6	EA	HINGE	5BB1HW 5 X 4.5 (NRP AS REQ'D)	652	IVE
2	EA	MORTISE CYLINDER	1E74	626	BES
1	EA	PANIC HARDWARE	CDSI-9827-DT-LBR	626	VON
1	EA	PANIC HARDWARE	CDSI-9827-NL-LBR	626	VON
2	EA	STRIKE	260U	626	VON
1	EA	RIM CYLINDER	1E72	626	BES
2	EA	SURFACE CLOSER	4040XP SHCUSH	689	LCN
2	EA	PA FLUSH PANEL ADAPTER	4040XP-419 SRT	689	LCN
2	EA	KICK PLATE	8400 10" X 1" LDW B-CS	630	IVE
2	EA	SILENCER	SR64	GRY	IVE

DOORS AND TRANSOM TO BE RABBETED.

HARDWARE GROUP NO. 64 - NOT USED



For use on Door #(s):

C-145A C-146A C-146B

Provide each OPENING with the following:

QTY		DESCRIPTION	CATALOG NUMBER	FINISH	MFR
3	EA	HINGE	5BB1 4.5 X 4.5 (NRP AS REQ'D)	652	IVE
1	EA	MORTISE CYLINDER	1E74	626	BES
1	EA	PANIC HARDWARE	CDSI-98-L-NL-17	626	VON
1	EA	RIM CYLINDER	1E72	626	BES
1	EA	SURFACE CLOSER	4040XP RW/PA	689	LCN
1	EA	PA FLUSH PANEL ADAPTER	4040XP-419 SRT	689	LCN
1	EA	KICK PLATE	8400 10" X 2" LDW B-CS	630	IVE
1	EA	WALL STOP/HOLDER	WS45	626	IVE
3	EA	SILENCER	SR64	GRY	IVE

HARDWARE GROUP NO. 66

For use on Door #(s):

B-138A

Provide each OPENING with the following:

QTY		DESCRIPTION	CATALOG NUMBER	FINISH	MFR
3	EA	HINGE	5BB1 4.5 X 4.5 (NRP AS REQ'D)	652	IVE
2	EA	MORTISE CYLINDER	1E74	626	BES
1	EA	PANIC HARDWARE	CDSI-9875-NL	626	VON
1	EA	SURFACE CLOSER	4040XP RW/PA	689	LCN
1	EA	PA FLUSH PANEL ADAPTER	4040XP-419 SRT	689	LCN
1	EA	KICK PLATE	8400 10" X 1 1/2" LDW B-CS	630	IVE
1	EA	WALL STOP	WS401/402CVX	626	IVE
2	EA	GASKETING	119WB PSA	В	ZER
1	EA	GASKETING	870AA	AA	ZER
1	EA	DOOR BOTTOM	364AA	AA	ZER
1	EA	THRESHOLD	564A	Α	ZER
1	EA	MOUNTING BRACKET	870SPB		ZER



For use on Door #(s): B-143C B-143D

Provide each OPENING with the following:

QTY		DESCRIPTION	CATALOG NUMBER	FINISH	MFR
2	EA	CONT. HINGE	224HD	628	IVE
1	EA	REMOVABLE MULLION	KR4954 STAB	689	VON
3	EA	MORTISE CYLINDER	1E74	626	BES
1	EA	PANIC HARDWARE	CD-98-EO	626	VON
1	EA	PANIC HARDWARE	CD-98-NL-OP-110MD	626	VON
1	EA	RIM CYLINDER	1E72	626	BES
2	EA	90 DEG OFFSET PULL	8190HD 12" O	630	IVE
2	EA	SURFACE CLOSER	4040XP SCUSH	689	LCN
2	EA	PA MOUNTING PLATE	4040XP-18PA AS REQ'D	689	LCN
2	EA	CUSH SHOE SUPPORT	4040XP-30 AS REQ'D	689	LCN
2	EA	BLADE STOP SPACER	4040XP-61 AS REQ'D	689	LCN
1	EA	RAIN DRIP	142AA	AA	ZER
1	EA	MULLION SEAL	8780NBK	BK	ZER
1	EA	WEATHER STRIPPING	By Door/Frame Manufacturer		
1	EA	THRESHOLD	BY WOOD FLOOR INSTALLER		B/O
2	EA	DOOR SWEEP	8192AA	AA	ZER

HARDWARE GROUP NO. 68

For use on Door #(s):

A-103B A-108B A-132B B-121B B-146B

Provide each OPENING with the following:

QTY DESCRIPTION CATALOG NUMBER FINISH MFR

EA NOTE NO HARDWARE REQUIRED

(BORROWED LITE)

HARDWARE GROUP NO. 69

Provide each OPENING with the following:

QTY DESCRIPTION CATALOG NUMBER FINISH MFR

1 EA CYLINDER RIM/MORTISE CYLINDER AS REQ'D 626 BES

NOTE BALANCE OF HARDWARE BY DOOR

MFG



For use on Door #(s):

A-119A A-120A A-124A A-125A

Provide each OPENING with the following:

QTY		DESCRIPTION	CATALOG NUMBER	FINISH	MFR
3	EA	HINGE	5BB1 4.5 X 4.5 (NRP AS REQ'D)	652	IVE
1	EA	PRIVACY SET	45H 0 L 14S VIN	626	BES
1	EA	WALL STOP	WS401/402CVX	626	IVE
1	EA	GASKETING	488SCL PSA	CL	ZER

NOTE: VERIFY/COORDINATE PREPS ON EXISTING DOORS AND FRAMES. PROVIDE CORRECT STRIKES, FIELD MODIFICATIONS AND/OR FILLERS TO EXISTING DOORS AND FRAMES AS NECESSARY TO ACCEPT NEW SPECIFIED HARDWARE AND COVER EXPOSED HOLES.

HARDWARE GROUP NO. ALT-14

For use on Door #(s):

A-122A

Provide each OPENING with the following:

QTY		DESCRIPTION	CATALOG NUMBER	FINISH	MFR
3	EA	HINGE	5BB1 4.5 X 4.5 (NRP AS REQ'D)	652	IVE
1	EA	CLASSROOM LOCKSET	9K7 R 14D	626	BES
1	EA	OH STOP	90\$	630	GLY
3	EA	SILENCER	SR64	GRY	IVE

NOTE: VERIFY/COORDINATE PREPS ON EXISTING DOORS AND FRAMES. PROVIDE CORRECT STRIKES, FIELD MODIFICATIONS AND/OR FILLERS TO EXISTING DOORS AND FRAMES AS NECESSARY TO ACCEPT NEW SPECIFIED HARDWARE AND COVER EXPOSED HOLES.



Provide each OPENING with the following:

QTY		DESCRIPTION	CATALOG NUMBER	FINISH	MFR
3	EA	HINGE	5BB1 4.5 X 4.5 (NRP AS REQ'D)	652	IVE
1	EA	STOREROOM LOCKSET	9K7 D 14D	626	BES
1	EA	OH STOP	90S J	630	GLY
3	EA	SILENCER	SR64	GRY	IVE

NOTE: VERIFY/COORDINATE PREPS ON EXISTING DOORS AND FRAMES. PROVIDE CORRECT STRIKES, FIELD MODIFICATIONS AND/OR FILLERS TO EXISTING DOORS AND FRAMES AS NECESSARY TO ACCEPT NEW SPECIFIED HARDWARE AND COVER EXPOSED HOLES.

HARDWARE GROUP NO. ALT-23

For use on Door #(s):

B-132A

Provide each OPENING with the following:

Q	TY	DESCRIPTION	CATALOG NUMBER	FINISH	MFR
3	EA	HINGE	5BB1HW 4.5 X 4.5 (NRP AS REQ'D)	652	IVE
1	EA	STOREROOM LOCKSET	9K7 D 14D	626	BES
1	EA	WALL STOP	WS401/402CVX	626	IVE
3	EA	SILENCER	SR64	GRY	IVE

NOTE: VERIFY/COORDINATE PREPS ON EXISTING DOORS AND FRAMES. PROVIDE CORRECT STRIKES, FIELD MODIFICATIONS AND/OR FILLERS TO EXISTING DOORS AND FRAMES AS NECESSARY TO ACCEPT NEW SPECIFIED HARDWARE AND COVER EXPOSED HOLES.



For use on Door #(s):

B-122A	C-103B	C-104B	C-105A	C-106B	C-107A
C-109B	C-110A	C-111B	C-112A	C-113B	C-114A
C-117B	C-121B	C-124A			

Provide each OPENING with the following:

QTY		DESCRIPTION	CATALOG NUMBER	FINISH	MFR
3	EA	HINGE	5BB1 4.5 X 4.5 (NRP AS REQ'D)	652	IVE
1	EA	STOREROOM LOCKSET	9K7 D 14D	626	BES
1	EA	OH STOP & HOLDER	90H J	630	GLY
1	EA	SURFACE CLOSER	4040XP RW/PA	689	LCN
1	EA	KICK PLATE	8400 10" X 1 1/2" LDW B-CS	630	IVE
3	EA	SILENCER	SR64	GRY	IVE

NOTE: VERIFY/COORDINATE PREPS ON EXISTING DOORS AND FRAMES. PROVIDE CORRECT STRIKES, FIELD MODIFICATIONS AND/OR FILLERS TO EXISTING DOORS AND FRAMES AS NECESSARY TO ACCEPT NEW SPECIFIED HARDWARE AND COVER EXPOSED HOLES.

HARDWARE GROUP NO. ALT-28

For use on Door #(s): B-125B

Provide each OPENING with the following:

QTY		DESCRIPTION	CATALOG NUMBER	FINISH	MFR
3	EA	HINGE	5BB1 4.5 X 4.5 (NRP AS REQ'D)	652	IVE
1	EA	STOREROOM LOCKSET	9K7 D 14D	626	BES
1	EA	SURFACE CLOSER	4040XP RW/PA	689	LCN
1	EA	KICK PLATE	8400 10" X 1 1/2" LDW B-CS	630	IVE
1	EA	WALL STOP	WS401/402CVX	626	IVE
3	EA	SILENCER	SR64	GRY	IVE

NOTE: VERIFY/COORDINATE PREPS ON EXISTING DOORS AND FRAMES. PROVIDE CORRECT STRIKES, FIELD MODIFICATIONS AND/OR FILLERS TO EXISTING DOORS AND FRAMES AS NECESSARY TO ACCEPT NEW SPECIFIED HARDWARE AND COVER EXPOSED HOLES.

HARDWARE GROUP NO. ALT-29 - NOT USED



For use on Door #(s): A-117A A-126A

Provide each OPENING with the following:

QTY		DESCRIPTION	CATALOG NUMBER	FINISH	MFR
3	EA	HINGE	5BB1 4.5 X 4.5 (NRP AS REQ'D)	652	IVE
1	EA	STOREROOM LOCKSET	9K7 D 14D	626	BES
1	EA	SURFACE CLOSER	4040XP RW/PA	689	LCN
1	EA	PA FLUSH PANEL ADAPTER	4040XP-419 SRT	689	LCN
1	EA	KICK PLATE	8400 10" X 1 1/2" LDW B-CS	630	IVE
1	EA	WALL STOP/HOLDER	WS45	626	IVE
3	EA	SILENCER	SR64	GRY	IVE

NOTE: VERIFY/COORDINATE PREPS ON EXISTING DOORS AND FRAMES. PROVIDE CORRECT STRIKES, FIELD MODIFICATIONS AND/OR FILLERS TO EXISTING DOORS AND FRAMES AS NECESSARY TO ACCEPT NEW SPECIFIED HARDWARE AND COVER EXPOSED HOLES.

HARDWARE GROUP NO. ALT-34

For use on Door #(s): B-129B

Provide each OPENING with the following:

QTY		DESCRIPTION	CATALOG NUMBER	FINISH	MFR
6	EA	HINGE	5BB1 4.5 X 4.5 (NRP AS REQ'D)	652	IVE
1	EA	CONST LATCHING BOLT	FB51T/FB61T AS REQ'D	630	IVE
1	EA	STOREROOM LOCKSET	9K7 D 14D	626	BES
2	EA	OH STOP	90S J	630	GLY
2	EA	SILENCER	SR64	GRY	IVE

NOTE: VERIFY/COORDINATE PREPS ON EXISTING DOORS AND FRAMES. PROVIDE CORRECT STRIKES, FIELD MODIFICATIONS AND/OR FILLERS TO EXISTING DOORS AND FRAMES AS NECESSARY TO ACCEPT NEW SPECIFIED HARDWARE AND COVER EXPOSED HOLES.

DOORS AND TRANSOM TO BE RABBETED.





For use on Door #(s):

C-103A C-104A C-106A C-109A C-111A C-113A C-117A C-121A D-112B D-120B D-126B

D-128B

Provide each OPENING with the following:

QTY		DESCRIPTION	CATALOG NUMBER	FINISH	MFR
3	EA	HINGE	5BB1 4.5 X 4.5 (NRP AS REQ'D)	652	IVE
1	EA	COMMUNICATING LOCK	9K7 W 14D	626	BES
1	EA	OH STOP & HOLDER	90H	630	GLY
3	EA	SILENCER	SR64	GRY	IVE

HARDWARE GROUP NO. ALT-40

For use on Door #(s):

D-111B D-117B D-119B

Provide each OPENING with the following:

QTY		DESCRIPTION	CATALOG NUMBER	FINISH	MFR
3	EA	HINGE	5BB1 4.5 X 4.5 (NRP AS REQ'D)	652	IVE
1	EA	COMMUNICATING LOCK	9K7 W 14D	626	BES
1	EA	WALL STOP/HOLDER	WS45	626	IVE
3	EA	SILENCER	SR64	GRY	IVE

HARDWARE GROUP NO. ALT-54

FOR USE ON DOOR #(S):

B-124E

PROVIDE EACH OPENING WITH THE FOLLOWING:

<u>QTY</u>		<u>DESCRIPTION</u>	CATALOG NUMBER	<u>FINISH</u>	<u>MFR</u>
6	EA	HINGE	5BB1 4.5 X 4.5 (NRP AS REQ'D)	652	IVE
2	EA	MORTISE CYLINDER	1E74	626	BES
2	EA	PANIC HARDWARE	CDSI-9827-DT-LBR	626	VON
2	EA	STRIKE	260U AS REQ'D	626	VON
1	EA	SURFACE CLOSER	4040XP HCUSH	689	LCN
1	EA	SURFACE CLOSER	4040XP RW/PA	689	LCN
2	EA	PA FLUSH PANEL ADAPTER	4040XP-419 AS REQ'D	689	LCN
2	EA	KICK PLATE	8400 10" X 1" LDW B-CS	630	IVE
1	EA	WALL STOP/HOLDER	WS45	626	IVE
2	EA	SILENCER	SR64	GRY	IVE

NOTE: VERIFY/COORDINATE PREPS ON EXISTING DOORS AND FRAMES. PROVIDE CORRECT STRIKES, FIELD MODIFICATIONS AND/OR FILLERS TO EXISTING DOORS AND FRAMES AS NECESSARY TO ACCEPT NEW SPECIFIED HARDWARE AND COVER EXPOSED HOLES.





For use on Door #(s):

C-144A C-144B C-145B

Provide each OPENING with the following:

QTY		DESCRIPTION	CATALOG NUMBER	FINISH	MFR
6	EA	HINGE	5BB1 4.5 X 4.5 (NRP AS REQ'D)	652	IVE
2	EA	MORTISE CYLINDER	1E74	626	BES
1	EA	PANIC HARDWARE	CDSI-9827-DT-LBR	626	VON
1	EA	PANIC HARDWARE	CDSI-9827-NL-LBR	626	VON
2	EA	STRIKE	260U	626	VON
1	EA	RIM CYLINDER	1E72	626	BES
2	EA	SURFACE CLOSER	4040XP HCUSH	689	LCN
2	EA	PA FLUSH PANEL ADAPTER	4040XP-419 SRT	689	LCN
2	EA	KICK PLATE	8400 10" X 1" LDW B-CS	630	IVE
2	EA	SILENCER	SR64	GRY	IVE

NOTE: VERIFY/COORDINATE PREPS ON EXISTING DOORS AND FRAMES. PROVIDE CORRECT STRIKES, FIELD MODIFICATIONS AND/OR FILLERS TO EXISTING DOORS AND FRAMES AS NECESSARY TO ACCEPT NEW SPECIFIED HARDWARE AND COVER EXPOSED HOLES.

DOORS AND TRANSOM TO BE RABBETED.

HARDWARE GROUP NO. ALT-60

FOR USE ON DOOR #(S):

B-124D

PROVIDE EACH OPENING WITH THE FOLLOWING:

<u>QTY</u>		<u>DESCRIPTION</u>	CATALOG NUMBER	<u>FINISH</u>	<u>MFR</u>
6	EA	HINGE	5BB1 4.5 X 4.5 (NRP AS REQ'D)	652	IVE
2	EA	MORTISE CYLINDER	1E74	626	BES
1	EA	PANIC HARDWARE	CDSI-9827-DT-LBR	626	VON
1	EA	PANIC HARDWARE	CDSI-9827-NL-LBR	626	VON
2	EA	STRIKE	260U AS REQ'D	626	VON
1	EA	RIM CYLINDER	1E72	626	BES
1	EA	SURFACE CLOSER	4040XP HCUSH	689	LCN
1	EA	SURFACE CLOSER	4040XP RW/PA	689	LCN
2	EA	PA FLUSH PANEL ADAPTER	4040XP-419 AS REQ'D	689	LCN
2	EA	KICK PLATE	8400 10" X 1" LDW B-CS	630	IVE
1	EA	WALL STOP/HOLDER	WS45	626	IVE
2	EA	SILENCER	SR64	GRY	IVE

NOTE: VERIFY/COORDINATE PREPS ON EXISTING DOORS AND FRAMES. PROVIDE CORRECT STRIKES, FIELD MODIFICATIONS AND/OR FILLERS TO EXISTING DOORS AND FRAMES AS NECESSARY TO ACCEPT NEW SPECIFIED HARDWARE AND COVER EXPOSED HOLES.



FOR USE ON DOOR #(S): B-124F

PROVIDE EACH OPENING WITH THE FOLLOWING:

<u>QTY</u>		<u>DESCRIPTION</u>	CATALOG NUMBER	<u>FINISH</u>	<u>MFR</u>
6	EA	HINGE	5BB1 4.5 X 4.5 (NRP AS REQ'D)	652	IVE
2	EA	MORTISE CYLINDER	1E74	626	BES
1	EA	PANIC HARDWARE	CDSI-9827-DT-LBR	626	VON
1	EA	PANIC HARDWARE	CDSI-9827-NL-LBR	626	VON
2	EA	STRIKE	260U	626	VON
1	EA	RIM CYLINDER	1E72	626	BES
2	EA	SURFACE CLOSER	4040XP RW/PA	689	LCN
2	EA	PA FLUSH PANEL ADAPTER	4040XP-419 SRT	689	LCN
2	EA	KICK PLATE	8400 10" X 1" LDW B-CS	630	IVE
2	EA	WALL STOP/HOLDER	WS45	626	IVE
2	EA	SILENCER	SR64	GRY	IVE

NOTE: VERIFY/COORDINATE PREPS ON EXISTING DOORS AND FRAMES. PROVIDE CORRECT STRIKES, FIELD MODIFICATIONS AND/OR FILLERS TO EXISTING DOORS AND FRAMES AS NECESSARY TO ACCEPT NEW SPECIFIED HARDWARE AND COVER EXPOSED HOLES.

DOORS AND TRANSOM TO BE RABBETED. VERIFY AND NOTIFY ARCHITECT OF CONFLICTS.

END OF SECTION



SECTION 33 11 00 WATER DISTRIBUTION SYSTEMS

1 General

1.1 Section Includes

- A. Fire water piping, fittings, and accessories.
- B. Potable water piping, fittings, and accessories.
- C. Connection of building system to Municipal Water System

1.2 Related Sections

- A. Section 31 20 00 Earthwork: Trenching and backfill for water distribution systems.
- B. Section 32 13 80 Exterior Concrete: Concrete type for water system construction.
- C. Section 33 13 00 Disinfection of Water Distribution System.

1.3 References

- A. ANSI B16.22 Wrought Copper and Copper Alloy Solder Joint Pressure Fittings.
- B. ASTM A126 Standard Specifications for Gray Iron Castings for Valves, Flanges, and Fittings.
- C. ASTM A197 Standard Specifications for Cupola Malleable Iron.
- D. ASTM A307 Standard Specification for Carbon Steel Bolts and Studs.
- E. ASTM A506 Standard Specifications for Steel, Sheet and Strip.
- F. ASTM A575 Standard Specification for Steel Bars.
- G. ASTM B88 Standard Specification for Seamless Copper Water Tube.
- H. AWWA C104 Cement Water Lining for Ductile Iron Pipe and Fittings.
- I. AWWA C110 Ductile and Gray Iron Fittings.
- J. AWWA C111 Rubber Gasket Joints for Ductile Iron and Gray Iron Pipe.
- K. AWWA C151 Ductile Iron Pipe.
- L. AWWA C500 Gate Valves.
- M. AWWA C504 Standard for Rubber Seated Butterfly Valves.



- N. AWWA C508 Standard for Swing Check Valves.
- O. AWWA C600 Standard for Installation of Ductile Iron Water Mains and Their Appurtenances.
- P. AWWA C651 Standard for Disinfecting Water Mains.
- Q. AWWA C900 Standard for Polyvinyl Chloride Pressure Pipe.
- R. AWWA M17 Installation, Field Testing, and Maintenance of Fire Hydrants.
- S. NFPA 24 Standard for Installation of Private Fire Service Mains and Their Appurtenances.
- T. UL 246 Hydrants for Fire Protection Service.

1.4 Regulatory Requirements

- A. Conform to Indiana BOCA National Plumbing Code for materials and installation of work of this Section.
- B. Conform to requirements of Water Utility Company supplying water to project; obtain required permits and inspections.
- C. Install fire water system in accordance with NFPA 24.
- D. Conform with local Fire Department regulations pertaining to hydrants, including hose unit threading.
- E. Provide fire hydrants that comply with UL 246 and are listed by UL.

1.5 Submittals

- A. Submit product data under provisions of Division 1.
- B. Submit product data for pipe, pipe accessories.

1.6 Project Record Documents

- A. Submit documents under provisions of Division 1.
 - 1. Accurately record locations of pipe runs, connections, valves and hydrants.
 - 2. Maintain accurate as-built drawings as project progresses, on a set of project drawings.
 - 3. Identify and describe unexpected variations to subsoil conditions or discovery of uncharted utilities.
 - 4. Upon completion of project, submit one set of reproducible mylar drawings and two sets of blueline prints, with Contractor's stamp indicating date and labeled "Record Documents."



2 Products

2.1 Potable Water Piping Materials

- A. Ductile Iron Pipe: AWWA C151, with cement mortar lining complying with AWWA C104; Class 51 for 3 inch and 4 inch pipe, and Class 50 for 6 inch and larger pipe.
 - 1. Fittings: Ductile iron, AWWA C110; cement lined, AWWA C104; and rubber gasket joints, AWWA C111.
- B. Polyvinyl Chloride Pipe: AWWA C900 for 4 inch through 12 inch sizes; Class 100.
 - 1. Fittings: Mechanical joint ductile iron complying with AWWA C110, with AWWA C104 cement mortar lining and retainer gland.
- C. Copper Tube: ASTM B88; Type K, soft annealed temper.
 - 1. Wrought copper solder joint fittings, ANSI B16.22; soldered joints.

2.2 Fire Water Piping Materials

- A. Ductile Iron Pipe: AWWA C151 with cement mortar lining complying with AWWA C104; Class 50.
 - 1. Fittings: Ductile iron, AWWA C110; cement lined, AWWA C104; and rubber gasket joints, AWWA C111.
- B. Polyvinyl Chloride Pipe: AWWA C900 for 4 inch to 12 inch sizes; Class 150; bell and spigot with rubber sealing ring.
 - 1. Fittings: Mechanical joint ductile iron complying with AWWA C110, with AWWA C104 cement mortar lining and retainer gland.

2.3 Potable Water System Valves

- A. Gate Valve: AWWA C500, 175 psi working pressure.
 - 1. Provide threaded, flanged, hub, or other end configuration to suit size of valve and piping connection.
- B. Valve Box: Cast iron adjustable arch base with drop in lid for use with buried gate valves.
- C. Butterfly Valve: AWWA C504, 150 psi working pressure, iron body, bronze disc, stainless steel stem, and metal-reinforced EPDM seat.
- D. Check Valve: AWWA C508, 150 psi working pressure, iron body, cast iron disc, bolted cap.



2.4 Fire Water System Valves

- A. Gate Valve: UL listed, FM approved, 175 psi working pressure for 12 inches and smaller, 150 psi for sizes larger than 12 inches.
 - 1. Provide threaded, flanged, hub, or other end configurations to suit size of valve and piping connection.
 - 2. Provide inside screw type for use with indicator post, iron body, bronze mounted, non-rising, stem with operating nut, solid wedge disc.
- B. Indicator Posts: UL listed FM approved, designed for use with underground gate valves to provide above ground means for operating valves and indicating position of valves.
 - 1. Provide telescoping barrel type with indicating target, intended for use with gate valves 4 inches through 14 inches, with operating wrench.
 - 2. Provide electrically supervised valves.
- C. Valve Box: Cast iron adjustable arch base with buried gate valves.
- D. Butterfly Valves: UL listed, FM approved, 175 psi working pressure for 2 inches through 12 inches, 150 psi for sizes larger than 12 inches.
 - 1. Provide gear actuator with detachable crank, position indicator, and fail safe torque spring.
- E. Detector Check Valve: UL listed, FM approved, 175 psi working pressure for 2 inches through 12 inches, 150 psi for sizes larger than 12 inches.
 - 1. Provide swing type, iron body bronze mounted with metal to metal or rubber faced checks.
 - 2. Provide threaded, flanged, or hub end, to suit size and piping connection.

2.5 Fire Hydrants

- A. Provide UL listed, FM approved, cast iron body, compression type fire hydrants, opening against pressure and closing against pressure, base valve design, 150 psi working pressure, with 1/4 inch gage topping and bronze plug in standpipe.
- B. Size: 5 1/4 inch valve opening.
- C. Direction to Open Hydrant: As required by Local Fire Department and Utility Company.
- D. Size and Shape of Operating and Cap Nuts: As required by Local Fire Department and Utility Company.
- E. Hose Nozzles and Thread Standards: As required by Local Fire Department and Utility Company.



- F. Pumper Nozzles and Thread Standards: As required by Local Fire Department and Utility Company.
- G. Depth of Trench: 5 feet.
- H. Connection to Main: 6 inch mechanical joint.

2.6 Hydrant Hose Houses

- A. Provide hose houses as indicated, FM approved, constructed of 16 gage steel, weatherproof sloping top, front overhang, double-panel reinforced doors, continuous hinges, hasp for padlock, and ventilated design.
 - 1. Prime coat and finish in red baked enamel.
 - 2. Provide the following equipment, and hooks for its storage:

Quantity	Item
1	Gated wye, 2 1/2" by 1 1/2" by 1 1/2" brass.
2	Fog nozzles, 2 1/2" brass.
1	Fog nozzle, 1 1/2" Lexan.
1	Reducer, 2 1/2" to 1 1/2" brass.
2	Hydrant wrenches.
4	Spanner wrenches, 2 1/2".
2	Spanner wrenches, 1 1/2".
4	50' by 2 1/2" Single jacket lined hose with brass couplings.
2	50' by 1 1/2" Single jacket lined hose with brass couplings.
1	Fire ax.

2.7 Reaction Anchors

- A. Provide concrete thrust blocking or joint harness for all pressure piping in accordance with NFPA 24.
- B. Thrust Blocking: Sufficient mass of concrete bearing on solid undisturbed earth, to resist hydraulic thrust at maximum pressure pipe will be subjected to, 150 psi minimum.
 - 1. Refer to Detail and Schedule on Drawings.
- C. Joint Harness: Steel straps and rods across joints, securely anchored on pipe or other adequate anchorage, to resist hydraulic thrust at maximum pressure pipe will be subjected to, 150 psi minimum.
 - 1. Coal Tar Coating: Carboline Bitumastic 50.
 - 2. Clamps, Straps, and Washers: Steel, ASTM A506.
 - 3. Rods: Steel, ASTM A575.



- 4. Rod Couplings: Malleable Iron ASTM A197.
- 5. Bolts: Steel ASTM A307.
- 6. Cast Iron Washers: Gray-iron ASTM A126.

2.8 Fire Department Connection

- A. Provide Y-type cast brass sidewalk Siamese connection, escutcheon plate and sleeve assembly; with two 90 degree, 2 1/2 inch fire department inlets with female hose connection, 4 inch inlet pipe, plugs and chain.
 - 1. Provide inlet connection with type and number of threads per inch to match those of the local fire department.

2.9 Valve Pits

- A. Provide valve pits as indicated, constructed of poured in place or precast concrete.
 - Construct of dimensions indicated with manhole access, ladder, and drain.
 - 2. Provide sleeves for pipe entry and exit, provide waterproof sleeve seals.

3 Execution

3.1 Examination

- A. Verify that trench cut is ready to receive work, and excavations, dimensions, and elevations are as indicated on Drawings.
- B. Beginning of installation means acceptance of existing conditions.

3.2 Preparation

- A. Hand trim excavations to required elevations.
 - 1. Correct over excavation with fill material.
- B. Remove large stones or other hard matter which could damage water pipe or impede consistent backfilling or compaction.

3.3 Installation - Pipe

- A. Copper Pipe: Install in accordance with CDA Copper Tube Handbook.
- B. Ductile-Iron Pipe: Install in accordance with AWWA C600.
- Polyvinyl Chloride Pipe: Install in accordance with manufacturer's installation instructions.
- D. Depth of Cover: Install yard and lead-in piping at minimum 5 foot depth of bury.



- E. Water Main Connection: Arrange and pay for tap in water main, of size and location as indicated, from Water Utility Company.
- F. Water Service Termination: Terminate potable water piping outside inside building where indicated.
 - 1. Provide line sized gate valve, 3/4 inch valved test tee, and pressure gage.
 - 2. Provide reaction anchors.
- G. Water lines and sewers shall not be laid in the same trench.
 - 1. Maintain a horizontal separation of 10 feet.
- H. Increase compaction of each successive lift.
 - 1. Refer to Section 31 20 00 for compaction requirements.
 - 2. Do not displace or damage pipe when compacting.

3.4 Reaction Anchors

- A. Use concrete thrust blocking where solid undisturbed earth is available.
- B. Use joint harness in other areas.
- C. If back of solid undisturbed earth is due to improper trench excavation, provide joint harness at no extra cost.
- D. Coat underground metal surfaces not encased in concrete with Carboline Bitumastic 50.
 - 1. Apply to clean, dry surface.
 - 2. Allow first coat to dry hard; apply second coat.

3.5 Installation - Valves

- A. Provide valve box for underground potable water valves.
- B. Install post indicator valve at each fire water connection into building, locate 40 feet from building outside wall or as indicated.
- C. Install shut-off valve with valve box ahead of each hydrant.
 - 1. Provide valve key and stem.

3.6 Installation Of Hydrants

A. Install Fire Hydrants in accordance with AWWA M17.

3.7 Field Quality Control

A. Field inspection will be performed under provisions of Division 1.



3.8 Protection

- A. Protect finished installation under provisions of Division 1.
- B. Protect pipe from damage or displacement until backfilling operation is in progress.

3.9 Disinfection Of Water Piping System

A. AWWA C651 - Standard for Disinfecting Water Mains.

END OF SECTION



SECTION 33 11 50

EXTERIOR WATER LINES, FIRE LINES, AND FACILITIES

1 General

1.1 Section Includes

- A. The work covered by this section of the specifications and the accompanying Drawings consist of the furnishing of all labor, equipment, appliances, and material, and performing all operations in connection with the construction of all exterior water lines, fire lines, fire hydrants, valves, facilities, etc.
- B. Install in a manner that each section of the work is complete in every detail and meets or exceeds all of the laws, ordinances, rules and regulations in effect in the State and local requirements which apply.

1.2 Fees

A. Pay all tapping and service fees and all other costs, not borne by the Water Company, which are required to provide a complete domestic water and fire line service.

1.3 Concrete

A. All concrete required for the work under this heading shall conform to Section 03 30 00.

1.4 Painting

A. All finish painting will be done by the Painting Contractor under another contract.

1.5 Clean-Up

A. Remove all debris and surplus materials from the premises.

1.6 Seeding And Sodding

A. Seeding and sodding within the limits of the property will be done under another contract.

1.7 Streets, Sidewalks, Drives, Paving, And Repair

A. Repair or replace all streets, sidewalks, drives, curbs, drainage structures, which are damaged due to any work included under this contract.



2 Products

2.1 Exterior Water Lines

- A. Provide all new exterior water mains and branches 3 inches and larger as manufactured by James B. Clow and Sons; ductile iron pipe with super bell-tight push on joints and cement lining as manufactured by U.S. Piping and Foundry Class 50, or American Piping Class 50.
 - 1. All Fittings: Push-on gasket type cast iron fittings.
 - 2. All Cast Iron Pipe, Fittings, Joint Gaskets and Installation: Meet the requirements of ASA A2I.5I, AWWA 151.
- B. All new exterior water mains and branches 2 1/2 inches and smaller Type "K" hard copper tubing with copper or wrought brass fittings.
 - 1. Copper piping and fittings furnished and installed as specified under in Division 15.

2.2 Vacuum Breakers And Relief Valves

- A. Provide valves of proper size and type to relieve excess pressure and prevent the formation of a vacuum.
- B. Provide valves to automatically remove air from the lines when the lines are being filled with water, and admit air into the lines when water is being withdrawn in excess of the inflow.

2.3 Exterior Gate Valves

- A. Valves: Iron-body, brass mounted and conforming to the Standard Specifications of the AWWA 7F.1.
- B. Design exterior gate valves for a minimum water working pressure of 150 pounds per square inch.
- C. Provide gate valves with a clear waterway equal to the full nominal diameter of the valve, and which open by turning counterclockwise.
- D. Provide an operating nut or wheel with an arrow, cast in the metal, indicating the direction of opening.
- E. Identify each valve with the maker's initials and pressure rating cast on the body.
- F. Prior to shipment from the factory, test each valve by hydraulic pressure equal to twice the specified water working pressure.

2.4 Valve Boxes

- A. Valve Boxes: Cast iron of the extension type having screw or slide type adjustment end with flared base.
 - 1. Minimum Metal Thickness: 3/16 inch.



- 2. Provide cover with the word "WATER" cast in the metal.
- 3. Provide boxes of such lengths to provide, without extensions, a cover of not less than 4'-6" over the pipe.

2.5 Lawn Hydrants

- A. Lawn Hydrants: Automatic nonfreezing "Government Pattern" street washer type, as manufactured by J. R. Smith Manufacturing Company, No. 5810 or an approved equal, with a 3/4 inch hose and inlet connection.
 - 1. Furnish a detachable "T" handle to the Owner for each hydrant installed.
 - 2. Provide a vacuum breaker in each water line serving lawn hydrants at the point where it leaves the building and elsewhere where required by State and Local Codes.

2.6 Fire Hydrants

- A. Provide all fire hydrants of the type and the exact standard as established by the local Fire Department.
- B. Providing there is no local standard, then the fire hydrants be compression type, Safetop fire hydrants as manufactured by the Kennedy Valve Manufacturing Co., or an approved equal.
 - Constructed hydrants in such a manner that there will be no interruption
 of water service or loss of water should the hydrant be broken, and upon
 impact the entire top section shall break cleanly at the "safety breakable
 section".
 - 2. Provide fire hydrants with a 6 inch bell connection, two 2 1/2 inch hose connections, one 4 1/2 inch hose connection, and one 4 1/2 inch pumper connection.
 - 3. Provide hose and pumper connections with the type and number of threads per inch to match those of the local fire department.
- C. Design hydrants for 175 pounds working pressure or 300 pounds hydrostatic test pressure, and conform to the latest specifications of the American Water Works Association.
 - 1. Provide bronze working parts.
 - 2. Connect hydrants to the mains by 6 inch diameter pipes.
 - Provide design, material, and workmanship similar and equal to the latest stock pattern ordinarily produced by the manufacturer, having an arrow indicating direction of opening, and opening in the direction required by the local fire department.
 - 4. Paint hydrants one coat of red lead paint and two finish coats of approved paint of the color approved by the Architect.



- 5. Provide hydrants with 5 inch valve openings.
- 6. Install hydrants in accordance with the manufacturer's recommendations and the applicable requirements hereinafter noted.
- 7. Provide a gate valve and valve box ahead of each fire hydrant.

3 Execution

3.1 General Installation

- A. Rest the full length of each section of pipe solidly upon the pipe bed, with recesses excavated to accommodate the joints.
- B. Take up and re-lay any pipe that has the grade or joint disturbed after laying.
- C. Thoroughly clean the interior of the pipe of all foreign matter before lowering into the trench, and keep clean with plugs or other approved methods.
- D. Do not lay the pipe in water, or when trench or weather conditions are unsuitable for the work, except by special permission of the Architect.
- E. Keep water out of the trench until each joint is made watertight.
- F. When work is not in progress, keep open ends of pipe and fittings securely closed so that no trench water, earth, or other substance will enter the pipes or fittings.

3.2 Domestic Water Service And Fire Lines

- A. Wet Tap: Relocate or extend existing water mains as shown and noted on Drawings.
- B. Provide new domestic water service and fire lines to the point of connection to the building piping being installed under the Mechanical Base Bid.

3.3 Domestic Water Service

- A. Provide a new domestic water service to the point of connection to the building piping.
- B. Connect to the well as shown and noted on Drawings.
- C. After testing, flush all new domestic water lines and sterilize as follows:
 - 1. Sterilize each unit of the completed water line with chlorine before acceptance for domestic operation.
 - 2. Provide amount of chlorine for a dosage of 50 parts per million.
 - 3. Introduce the chlorinating material into the water lines and distribution systems in an approved manner.
 - 4. After a contact period of 8 hours, flush the system with clean water until the residual chlorine content is not greater than 0.2 parts per million.



5. Open and close all valves in the lines being sterilized several times during the contact period.

3.4 Installation

- A. Handle pipe and accessories in such a manner as to insure delivery of the work in sound, undamaged condition.
 - 1. Provide 4'-6" minimum cover, after final grading, over all new exterior water mains.
- B. Cut pipe in a neat and workmanlike manner without damage to the pipe.
 - 1. Cut with an approved mechanical cutter.
 - 2. Wheel cutters may be used when practicable.
- C. While suspended in the sling and before lowering into the trench, inspect the pipe for defects and tap with a light hammer to detect cracks.
 - 1. Defective, damaged, or unsound pipe will be rejected.
 - 2. Deflections from a straight line or grade, as required by vertical curves, horizontal curves, or offsets, shall not exceed 6/D inches per linear foot of pipe for pipe less than 14 inches in nominal diameter, where D represents the nominal diameter of the pipe expressed in inches, between the center lines extended, of any two connecting pipes.
 - 3. If the alignment requires deflections in excess of these limitations provide angular deflections within the limit set forth.
- D. Where pipe ends are left for future connections; valve, plug or cap and mark.
- E. Where connections are made between this work and work under another contract, make the connections by using special end fittings to suit the actual conditions.
- F. After the pipe is laid, the joints completed, and the trench partially backfilled, leaving the joints exposed for examination, the newly laid piping or any valved section of piping shall be subjected to a pressure test of 50 pounds per square inch in excess of the static pressure.
 - 1. Carefully examine all exposed pipe, joints, fittings, valves, and hydrants during the open trench test.
 - Replace cracked or defective pipe, fittings, valves, or hydrants disclosed in the pressure test and repeat the test until the test results are satisfactory.



- 3. Where the actual visible inspection of each joint cannot be made because of the necessity for immediate backfilling or where the line is laid below water level and it is impracticable to lower the water level by pumping, the Contractor shall provide suitable means for determining the quantity of water lost by leakage under normal operating pressure.
- 4. No piping installation will be accepted until or unless this leakage (evaluated on a pressure basis of 150 pounds per square inch) is less than 100 US gallons per 24 hours per mile of pipe per inch nominal diameter for pipe in 12 foot lengths; 75 gallons for pipe in 16 foot lengths and proportionately varied for other lengths of pipe.
- 5. In calculating leakage, the Architect will make allowance for added joints in the pipe line above normal for unit lengths of pipe.
- 6. Should any test of combined sections of pipe line disclose leakage per mile greater than that herein specified, or if individual sections show leakage greater than that herein specified, the Contractor shall locate and repair the defective joints.

3.5 Vacuum Breakers And Relief Valves

A. Install vacuum breaker and relief valves at high points in the water mains.

3.6 Valve Boxes

- A. Install boxes over each outside gate valve.
- B. Where water mains are located in paved streets or drives, locate the boxes directly back of the curbs.
- C. Where no curbing exists, install service boxes in accessible locations, beyond the limits of streets, walks and driveways.

3.7 Lawn Hydrants

- A. Length below grade shall be 48 inches and the hinged cover set 1 inch below finished grade.
- B. Install lawn hydrants complete where shown on Drawings.

3.8 Setting Lawn And Fire Hydrants, Valves, And Valve Boxes

- A. Install hydrants, valves, and valve boxes in the lines as shown on Drawings.
- B. Set hydrants, valves, and valve boxes plumb and centered, with valve boxes directly over the valves.
- C. Locate valve boxes, if possible, outside the area of drives, sidewalks, and streets.
- D. Carefully tamp earth fill around the valve box to a distance of 4 feet on all sides of the box, or to the undisturbed trench face if less than 4 feet.



- E. Set hydrants at such elevations that the connecting pipe will have the same depth of cover as the distributing mains.
- F. Set the hydrant on a concrete slab not less than 4 inches thick and 15 inches square.
- G. Firmly wedge the back of the hydrant, opposite the pipe connection, against the vertical face of the trench to prevent the hydrant from blowing off the line.
- H. If the character of the soil is such that, in the opinion of the Architect, the hydrant cannot be securely wedged, bridle rods and rod collars shall be used.
 - 1. Provide bridle rods and rod collars not less than 3/4 inch stock and protect by a coat of acid-resisting paint.
 - 2. Place not less than 7 cubic feet of broken stone around hydrant to insure drainage.
 - 3. Thoroughly compact the backfill around hydrants to the grade line in a manner satisfactory to the Architect.
 - 4. Clean interiors of hydrants and valves of all foreign matter before installation.
 - 5. Tighten stuffing boxes and inspect the hydrant or valve in opened and closed positions, to see that all parts are in working condition.

3.9 Standard Valve Manholes

A. Provide standard valve manholes constructed at locations shown on Drawings or as required by the nature of the installation.

END OF SECTION



SECTION 33 13 00

DISINFECTION OF WATER DISTRIBUTION SYSTEM

1 General

1.1 Section Includes

- A. Disinfection of potable water distribution and transmission system.
- B. Test and report results.

1.2 Related Sections

- A. Section 33 11 00 Water Distribution Systems.
- B. Section 22 10 00 Plumbing Piping: Disinfection of building domestic water piping system.

1.3 References

A. AWWA C651 - Standard for Disinfecting Water Mains.

1.4 Submittals

- A. Submit name of treatment firm and evidence of qualification.
- B. Submit name of testing laboratory and evidence of qualification.
- C. Submit three copies of reports.

1.5 Project Record Documents

- A. Submit reports under provisions of Division 1.
- B. Disinfection report; accurately record:
 - 1. Type and form of disinfectant used.
 - 2. Date and time of disinfectant injection start and time of completion.
 - 3. Test locations.
 - 4. Initial and 24 hour disinfectant residuals (quantity in treated water) in ppm for each outlet tested.
 - 5. Date and time of flushing start and completion.
 - 6. Disinfectant residual after flushing in ppm for each outlet tested.



C. Bacteriological report; accurately record:

- 1. Date issued, project name, and testing laboratory name, address, and telephone number.
- 2. Time and date of water sample collection.
- 3. Name of person collecting samples.
- 4. Test locations.
- 5. Initial and 24 hour disinfectant residuals in ppm for each outlet tested.
- 6. Coliform bacteria test results for each outlet tested.
- 7. Certification that water conforms, or fails to conform, to bacterial standards.
- 8. Bacteriologist's signature.

1.6 Quality Assurance

- A. Water Treatment Firm: Certified for disinfection by an approved company; specializing in this work with five (5) years experience.
- B. Testing Laboratory: Certified and approved for examination of drinking water in compliance with applicable legislation of the State of Indiana.

1.7 Regulatory Requirements

A. Conform to Indiana Plumbing Code or regulations for work of this Section.

2 Products

Not Used.

3 Execution

3.1 Preparation

- A. Verify that piping system has been cleaned, inspected, and pressure tested.
- B. Beginning of treatment and testing means acceptance of existing piped system.
- C. Perform scheduling and disinfection activity with startup, testing, adjusting, and balancing, and demonstration procedures, including coordination with related systems.

3.2 Execution

- A. Provide and attach equipment required to execute work of this Section.
- B. Inject treatment disinfectant into piping system.
- C. Circulate and flush repeatedly until required cleanliness is achieved.





- D. Flush and clean with municipal domestic water.
- E. Replace permanent system devices removed for disinfection.
- F. Pressure test system as required by the utility company.
 - 1. Repair leaks and retest.

3.3 Tests

- A. Provide analysis and testing of treated water under provisions Division 1.
- B. Test samples in accordance with AWWA C651.

END OF SECTION



3.8 Door Hardware Schedule

- A. Locksets, exit devices, and other hardware items are referenced in the following hardware sets for series, type and function. Refer to the above-specifications for special features, options, cylinders/keying, and other requirements.
- B. Hardware Sets:

HARDWARE GROUP NO. 01

For use on Door #(s):

C-139A

Provide each OPENING with the following:

C	ΣΤΥ	DESCRIPTION	CATALOG NUMBER	FINISH	MFR
3	EA	HINGE	5BB1 4.5 X 4.5 (NRP AS REQ'D)	652	IVE
1	EA	PASSAGE SET	9K0 N 14D	626	BES
1	EA	OH STOP	90\$	630	GLY
3	EA	SILENCER	SR64	GRY	IVE

HARDWARE GROUP NO. 02

For use on Door #(s):

B-121A

Provide each OPENING with the following:

QTY		DESCRIPTION	CATALOG NUMBER	FINISH	MFR
3	EA	HINGE	5BB1 4.5 X 4.5 (NRP AS REQ'D)	652	IVE
1	EA	PASSAGE SET	9K0 N 14D	626	BES
1	EA	WALL STOP	WS401/402CVX	626	IVE
3	EA	SILENCER	SR64	GRY	IVE

HARDWARE GROUP NO. 03

For use on Door #(s):

A-109A A-111A A-131A A-133A

Provide each OPENING with the following:

OTY		DESCRIPTION	CATALOG NUMBER	FINISH	MFR
1	EA	CONT. HINGE	224HD	628	IVE
1	EA	PRIVACY SET	45H 0 L 14S VIN	626	BES
1	EA	OH STOP	90\$	630	GLY
1	EA	GASKETING	488SCL PSA	CL	ZER
1	EA	FINGER GUARD	51A-90	Α	ZER



For	use on	Door	#(′ς `	١.
1 01	USC OII		// \		

A-114A A-115A B-109A B-110A B-111A C-126A

C-129A C-140A

Provide each OPENING with the following:

QTY		DESCRIPTION	CATALOG NUMBER	FINISH	MFR
3	EA	HINGE	5BB1 4.5 X 4.5 (NRP AS REQ'D)	652	IVE
1	EA	PRIVACY SET	45H 0 L 14S VIN	626	BES
1	EA	WALL STOP	WS401/402CVX	626	IVE
1	EA	GASKETING	488SCL PSA	CL	ZER

HARDWARE GROUP NO. 05

For use on Door #(s):

A-128A

Provide each OPENING with the following:

QTY		DESCRIPTION	CATALOG NUMBER	FINISH	MFR
1	EA	CONT. HINGE	224HD	628	IVE
1	EA	PRIVACY SET	45H 0 L 14S VIN	626	BES
1	EA	WALL STOP	WS401/402CVX	626	IVE
1	EA	GASKETING	488SCL PSA	CL	ZER
1	EA	FINGER GUARD	51A-90	Α	ZER

HARDWARE GROUP NO. 06 - NOT USED

HARDWARE GROUP NO. 07

For use on Door #(s):

B-116A B-117A C-123A C-149A C-150A D-123A

D-124A

Provide each OPENING with the following:

QTY		DESCRIPTION	CATALOG NUMBER	FINISH	MFR
3	EA	HINGE	5BB1 4.5 X 4.5 (NRP AS REQ'D)	652	IVE
1	EA	PRIVACY SET	45H 0 L 14S VIN	626	BES
1	EA	SURFACE CLOSER	4040XP RW/PA	689	LCN
1	EA	KICK PLATE	8400 10" X 1 1/2" LDW B-CS	630	IVE
1	EA	WALL STOP	WS401/402CVX	626	IVE
1	EA	GASKETING	488SCL PSA	CL	ZER



For use on Door #(s):

B-107A

Provide each OPENING with the following:

QTY		DESCRIPTION	CATALOG NUMBER	FINISH	MFR
3	EA	HINGE	5BB1 4.5 X 4.5 (NRP AS REQ'D)	652	IVE
1	EA	OFFICE LOCKSET	9K7 AB 14D	626	BES
1	EA	OH STOP	90S	630	GLY
3	EA	SILENCER	SR64	GRY	IVE

HARDWARE GROUP NO. 09

For use on Door #(s):

A-103A A-106A B-108A C-135A C-143A

Provide each OPENING with the following:

QTY		DESCRIPTION	CATALOG NUMBER	FINISH	MFR
3	EA	HINGE	5BB1 4.5 X 4.5 (NRP AS REQ'D)	652	IVE
1	EA	OFFICE LOCKSET	9K7 AB 14D	626	BES
1	EA	WALL STOP	WS401/402CVX	626	IVE
3	EA	SILENCER	SR64	GRY	IVE

HARDWARE GROUP NO. 10

For use on Door #(s):

B-146A

Provide each OPENING with the following:

QTY		DESCRIPTION	CATALOG NUMBER	FINISH	MFR
3	EA	HINGE	5BB1 4.5 X 4.5 (NRP AS REQ'D)	652	IVE
1	EA	OFFICE LOCKSET	9K7 AB 14D	626	BES
1	EA	WALL STOP	WS401/402CVX	626	IVE
1	EA	THRESHOLD	BY WOOD FLOOR INSTALLER		B/O
3	EA	SILENCER	SR64	GRY	IVE



For use on Door #(s): B-107B

Provide each OPENING with the following:

QTY		DESCRIPTION	CATALOG NUMBER	FINISH	MFR
3	EA	HINGE	5BB1 4.5 X 4.5 (NRP AS REQ'D)	652	IVE
1	EA	OFFICE LOCKSET	9K7 AB 14D	626	BES
1	EA	OH STOP	90S	630	GLY
1	EA	SURFACE CLOSER	4040XP RW/PA	689	LCN
1	EA	KICK PLATE	8400 10" X 1 1/2" LDW B-CS	630	IVE
3	EA	SILENCER	SR64	GRY	IVE

HARDWARE GROUP NO. 12

For use on Door #(s):

B-103B

Provide each OPENING with the following:

	DESCRIPTION	CATALOG NUMBER	FINISH	MFR
EA	HINGE	5BB1 4.5 X 4.5 (NRP AS REQ'D)	652	IVE
EA	CLASSROOM X STORERM	ND70X80CD SPA XN12-006	626	SCH
EA	PERMANENT CORE	1C7	626	BES
EA	ELECTRIC STRIKE	6212 FSE 12/16/24/28 VAC/VDC	630	VON
EA	OH STOP	90\$	630	GLY
EA	SURFACE CLOSER	4040XP RW/PA	689	LCN
EA	KICK PLATE	8400 10" X 1 1/2" LDW B-CS	630	IVE
EA	MULTITECH READER	MTB11/15 - BY ACCESS CONTROL PROVIDER (COORDINATE W/ HEAD END AND CREDENTIAL TYPE)	BLK	SCE
EA	AI PHONE	BY ACCESS CONTROL PROVIDER		
EA	DOOR CONTACT	7764	628	SCE
EA	MOTION SENSOR	SCANII 12/24 VDC	BLK	SCE
EA	POWER SUPPLY	PS902 900-4R [COORDINATE WITH ACCESS CONTROL PROVIDER]	LGR	SCE
EA	DIAGRAM	ELEVATION		DLR
EA	DIAGRAM	POINT TO POINT		DLR
	EA EA EA EA EA EA EA	EA HINGE EA CLASSROOM X STORERM EA PERMANENT CORE EA ELECTRIC STRIKE EA OH STOP EA SURFACE CLOSER EA KICK PLATE EA MULTITECH READER EA AI PHONE EA DOOR CONTACT EA MOTION SENSOR EA POWER SUPPLY EA DIAGRAM	EA HINGE 5BB1 4.5 X 4.5 (NRP AS REQ'D) EA CLASSROOM X STORERM ND70X80CD SPA XN12-006 EA PERMANENT CORE 1C7 EA ELECTRIC STRIKE 6212 FSE 12/16/24/28 VAC/VDC EA OH STOP 90S EA SURFACE CLOSER 4040XP RW/PA EA KICK PLATE 8400 10" X 1 1/2" LDW B-CS EA MULTIITECH READER MTB11/15 - BY ACCESS CONTROL PROVIDER (COORDINATE W/ HEAD END AND CREDENTIAL TYPE) EA AI PHONE BY ACCESS CONTROL PROVIDER EA DOOR CONTACT 7764 EA MOTION SENSOR SCANII 12/24 VDC EA POWER SUPPLY PS902 900-4R [COORDINATE WITH ACCESS CONTROL PROVIDER] EA DIAGRAM ELEVATION	EA HINGE 5BB1 4.5 X 4.5 (NRP AS REQ'D) 652 EA CLASSROOM X STORERM ND70X80CD SPA XN12-006 626 EA PERMANENT CORE 1C7 626 EA ELECTRIC STRIKE 6212 FSE 12/16/24/28 VAC/VDC 630 EA OH STOP 90S 630 EA SURFACE CLOSER 4040XP RW/PA 689 EA KICK PLATE 8400 10" X 1 1/2" LDW B-CS 630 EA MULTITECH READER MTB11/15 - BY ACCESS CONTROL PROVIDER (COORDINATE W/ HEAD END AND CREDENTIAL TYPE) EA AI PHONE BY ACCESS CONTROL PROVIDER EA DOOR CONTACT 7764 628 EA MOTION SENSOR SCANII 12/24 VDC BLK EA POWER SUPPLY PS902 900-4R [COORDINATE WITH LGR ACCESS CONTROL PROVIDER] EA DIAGRAM ELEVATION

OPERATION: DOOR CLOSED AND ALWAYS LOCKED FROM RECEPTION SIDE. DOOR UNLOCKED FROM CORRIDOR SIDE DURING SCHOOL HOURS AND LOCKED FROM CORRIDOR SIDE AFTER HOURS AND ON WEEKENDS.

AI PHONE AT RECEPTION DESK OR VALID CREDENTIAL MOMENTARILY UNLOCKS DOOR ALLOWING ENTRY. DOOR REMAINS LOCKED UPON LOSS OF POWER. DOOR CONTACT TO MONITOR DOOR POSITION. MOTION SENSOR ON PUSH SIDE SHUNTS DOOR CONTACT FOR VALID EGRESS.



For use on Door #(s):

B-104A B-147A C-134A

Provide each OPENING with the following:

QTY		DESCRIPTION	CATALOG NUMBER	FINISH	MFR
3	EA	HINGE	5BB1 4.5 X 4.5 (NRP AS REQ'D)	652	IVE
1	EA	CLASSROOM LOCKSET	9K7 R 14D	626	BES
1	EA	OH STOP	90S	630	GLY
3	EA	SILENCER	SR64	GRY	IVE

HARDWARE GROUP NO. 14 - NOT USED

HARDWARE GROUP NO. 15

For use on Door #(s):

A-110A A-110B A-130A A-130B B-106A B-112A B-113A B-145A C-142A D-114A

Provide each OPENING with the following:

QTY		DESCRIPTION	CATALOG NUMBER	FINISH	MFR
3	EA	HINGE	5BB1 4.5 X 4.5 (NRP AS REQ'D)	652	IVE
1	EA	CLASSROOM LOCKSET	9K7 R 14D	626	BES
1	EA	WALL STOP	WS401/402CVX	626	IVE
3	EA	SILENCER	SR64	GRY	IVE

HARDWARE GROUP NO. 16

For use on Door #(s): C-132A C-132C

Provide each OPENING with the following:

QTY		DESCRIPTION	CATALOG NUMBER	FINISH	MFR
3	EA	HINGE	5BB1 4.5 X 4.5 (NRP AS REQ'D)	652	IVE
1	EA	CLASSROOM LOCKSET	9K7 R 14D	626	BES
1	EA	WALL STOP/HOLDER	WS45	626	IVE
3	EA	SILENCER	SR64	GRY	IVE





For use on Door #(s): C-147A

Provide each OPENING with the following:

QTY		DESCRIPTION	CATALOG NUMBER	FINISH	MFR
3	EA	HINGE	5BB1 4.5 X 4.5 (NRP AS REQ'D)	652	IVE
1	EA	CLASSROOM LOCKSET	9K7 R 14D	626	BES
1	EA	SURFACE CLOSER	4040XP RW/PA	689	LCN
1	EA	KICK PLATE	8400 10" X 1 1/2" LDW B-CS	630	IVE
1	EA	WALL STOP	WS401/402CVX	626	IVE
3	EA	SILENCER	SR64	GRY	IVE

HARDWARE GROUP NO. 18

For use on Door #(s):

B-125A

Provide each OPENING with the following:

QTY		DESCRIPTION	CATALOG NUMBER	FINISH	MFR
6	EA	HINGE	5BB1 4.5 X 4.5 (NRP AS REQ'D)	652	IVE
1	EA	CONST LATCHING BOLT	FB51T/FB61T AS REQ'D	630	IVE
1	EA	CLASSROOM LOCKSET	9K7 R 14D	626	BES
2	EA	OH STOP	90S	630	GLY
2	EA	SILENCER	SR64	GRY	IVE

HARDWARE GROUP NO. 19

For use on Door #(s): B-142A B-144A

Provide each OPENING with the following:

QTY		DESCRIPTION	CATALOG NUMBER	FINISH	MFR
6	EA	HINGE	5BB1 4.5 X 4.5 (NRP AS REQ'D)	652	IVE
1	EA	CONST LATCHING BOLT	FB51T/FB61T AS REQ'D	630	IVE
1	EA	CLASSROOM LOCKSET	9K7 R 14D	626	BES
2	EA	OH STOP	90S	630	GLY
1	EA	THRESHOLD	BY WOOD FLOOR INSTALLER		B/O
2	EA	SILENCER	SR64	GRY	IVE

HARDWARE GROUP NO. 20 - NOT USED





For use on Door #(s):

C-138A

Provide each OPENING with the following:

QTY		DESCRIPTION	CATALOG NUMBER	FINISH	MFR
3	EA	HINGE	5BB1 4.5 X 4.5 (NRP AS REQ'D)	652	IVE
1	EA	STOREROOM LOCKSET	9K7 D 14D	626	BES
1	EA	OH STOP & HOLDER	90H J	630	GLY
1	EA	KICK PLATE	8400 10" X 1 1/2" LDW B-CS	630	IVE
3	EA	SILENCER	SR64	GRY	IVE

HARDWARE GROUP NO. 22

For use on Door #(s):

A-108A A-113A B-115B D-108A

Provide each OPENING with the following:

QTY		DESCRIPTION	CATALOG NUMBER	FINISH	MFR
3	EA	HINGE	5BB1 4.5 X 4.5 (NRP AS REQ'D)	652	IVE
1	EA	STOREROOM LOCKSET	9K7 D 14D	626	BES
1	EA	WALL STOP	WS401/402CVX	626	IVE
3	EA	SILENCER	SR64	GRY	IVE

HARDWARE GROUP NO. 23 - NOT USED

HARDWARE GROUP NO. 24 - NOT USED

HARDWARE GROUP NO. 25

For use on Door #(s):

C-125A

Provide each OPENING with the following:

QTY		DESCRIPTION	CATALOG NUMBER	FINISH	MFR
3	EA	HINGE	5BB1 4.5 X 4.5 (NRP AS REQ'D)	652	IVE
1	EA	STOREROOM LOCKSET	9K7 D 14D	626	BES
1	EA	OH STOP & HOLDER	90H J	630	GLY
1	EA	SURFACE CLOSER	4040XP RW/PA	689	LCN
1	EA	KICK PLATE	8400 10" X 1 1/2" LDW B-CS	630	IVE
3	EA	SILENCER	SR64	GRY	IVE



For use on Door #(s): C-148A

Provide each OPENING with the following:

QTY		DESCRIPTION	CATALOG NUMBER	FINISH	MFR
3	EA	HINGE	5BB1 4.5 X 4.5 (NRP AS REQ'D)	652	IVE
1	EA	STOREROOM LOCKSET	9K7 D 14D	626	BES
1	EA	OH STOP	90S J	630	GLY
1	EA	SURFACE CLOSER	4040XP RW/PA	689	LCN
1	EA	KICK PLATE	8400 10" X 1 1/2" LDW B-CS	630	IVE
3	EA	SILENCER	SR64	GRY	IVE

HARDWARE GROUP NO. 27

For use on Door #(s):

A-102A	A-105A	A-132A	B-115A	B-118A	B-119A
B-120A	B-141A	C-122A	C-141A	D-104A	D-113A
D-125A					

Provide each OPENING with the following:

QTY		DESCRIPTION	CATALOG NUMBER	FINISH	MFR
3	EA	HINGE	5BB1 4.5 X 4.5 (NRP AS REQ'D)	652	IVE
1	EA	STOREROOM LOCKSET	9K7 D 14D	626	BES
1	EA	SURFACE CLOSER	4040XP RW/PA	689	LCN
1	EA	KICK PLATE	8400 10" X 1 1/2" LDW B-CS	630	IVE
1	EA	WALL STOP	WS401/402CVX	626	IVE
3	EA	SILENCER	SR64	GRY	IVE



For use on Door #(s): B-136A

Provide each OPENING with the following:

QTY		DESCRIPTION	CATALOG NUMBER	FINISH	MFR
3	EA	HINGE	5BB1 4.5 X 4.5 (NRP AS REQ'D)	652	IVE
1	EA	STOREROOM LOCKSET	9K7 D 14D	626	BES
1	EA	SURFACE CLOSER	4040XP RW/PA	689	LCN
1	EA	KICK PLATE	8400 10" X 1 1/2" LDW B-CS	630	IVE
1	EA	WALL STOP	WS401/402CVX	626	IVE
3	EA	SILENCER	SR64	GRY	IVE

NOTE: VERIFY/COORDINATE PREPS ON EXISTING DOORS AND FRAMES. PROVIDE CORRECT STRIKES, FIELD MODIFICATIONS AND/OR FILLERS TO EXISTING DOORS AND FRAMES AS NECESSARY TO ACCEPT NEW SPECIFIED HARDWARE AND COVER EXPOSED HOLES.

HARDWARE GROUP NO. 29

For use on Door #(s):

C-128A	D-110A	D-111A	D-112A	D-115A	D-116A
D-117A	D-119A	D-120A	D-121A	D-126A	D-127A
D-128A	D-129A				

Provide each OPENING with the following:

QTY		DESCRIPTION	CATALOG NUMBER	FINISH	MFR
3	EA	HINGE	5BB1 4.5 X 4.5 (NRP AS REQ'D)	652	IVE
1	EA	STOREROOM LOCKSET	9K7 D 14D	626	BES
1	EA	SURFACE CLOSER	4040XP RW/PA	689	LCN
1	EA	KICK PLATE	8400 10" X 1 1/2" LDW B-CS	630	IVE
1	EA	WALL STOP/HOLDER	WS45	626	IVE
3	EA	SILENCER	SR64	GRY	IVE

HARDWARE GROUP NO. 30 - NOT USED





For use on Door #(s): C-133A

Provide each OPENING with the following:

QTY		DESCRIPTION	CATALOG NUMBER	FINISH	MFR
3	EA	HINGE	5BB1HW 4.5 X 4.5 (NRP AS REQ'D)	652	IVE
1	EA	STOREROOM LOCKSET	9K7 D 14D	626	BES
1	EA	SURFACE CLOSER	4040XP RW/PA	689	LCN
1	EA	KICK PLATE	8400 10" X 1 1/2" LDW B-CS	630	IVE
1	EA	WALL STOP/HOLDER	WS45	626	IVE
3	EA	SILENCER	SR64	GRY	IVE

HARDWARE GROUP NO. 32

For use on Door #(s):

A-107A	A-107B	A-112A	A-112B	A-127A	A-127B
A-129A	A-129B	A-134A	A-134B		

Provide each OPENING with the following:

QTY		DESCRIPTION	CATALOG NUMBER	FINISH	MFR
3	EA	HINGE	5BB1 4.5 X 4.5 (NRP AS REQ'D)	652	IVE
1	EA	STOREROOM LOCKSET	9K7 D 14D	626	BES
1	EA	SURFACE CLOSER	4040XP RW/PA	689	LCN
1	EA	PA FLUSH PANEL ADAPTER	4040XP-419 SRT	689	LCN
1	EA	KICK PLATE	8400 10" X 1 1/2" LDW B-CS	630	IVE
1	EA	WALL STOP/HOLDER	WS45	626	IVE
3	EA	SILENCER	SR64	GRY	IVE

HARDWARE GROUP NO. 33

For use on Door #(s): B-137A

Provide each OPENING with the following:

QTY		DESCRIPTION	CATALOG NUMBER	FINISH	MFR
3	EA	HINGE	5BB1 4.5 X 4.5 (NRP AS REQ'D)	652	IVE
1	EA	STOREROOM LOCKSET	9K7 D 14D	626	BES
1	EA	SURFACE CLOSER	4040XP RW/PA	689	LCN
1	EA	PA FLUSH PANEL ADAPTER	4040XP-419 SRT	689	LCN
1	EA	KICK PLATE	8400 10" X 1 1/2" LDW B-CS	630	IVE
1	EA	WALL STOP	WS401/402CVX	626	IVE
3	EA	SILENCER	SR64	GRY	IVE





HARDWARE GROUP NO. 34 - NOT USED

HARDWARE GROUP NO. 35

For use on Door #(s): B-127A B-127B

Provide each OPENING with the following:

QTY		DESCRIPTION	CATALOG NUMBER	FINISH	MFR
6	EA	HINGE	5BB1 4.5 X 4.5 (NRP AS REQ'D)	652	IVE
1	EA	CONST LATCHING BOLT	FB51T/FB61T AS REQ'D	630	IVE
1	EA	STOREROOM LOCKSET	9K7 D 14D	626	BES
2	EA	OH STOP	90S J	630	GLY
2	EA	SILENCER	SR64	GRY	IVE

DOORS AND TRANSOM TO BE RABBETED.



For use on Door #(s): B-130A

Provide each OPENING with the following:

	DESCRIPTION	CATALOG NUMBER	FINISH	MFR
EA	CONT. HINGE	224HD	628	IVE
EA	CONT. HINGE	224HD EPT	628	IVE
EA	POWER TRANSFER	EPT10	689	VON
EA	AUTO FLUSH BOLT	FB31P/FB41P AS REQ'D	630	IVE
EA	DUST PROOF STRIKE	DP2	626	IVE
EA	ELECTRIFIED LOCKSET	9K7 DEU 14D RQE	626	BES
EA	COORDINATOR	COR X FL	628	IVE
EA	MOUNTING BRACKET	MB [AS REQ'D]	689	IVE
EA	SURFACE CLOSER	4040XP SCUSH	689	LCN
EA	PA MOUNTING PLATE	4040XP-18PA AS REQ'D	689	LCN
EA	CUSH SHOE SUPPORT	4040XP-30 AS REQ'D	689	LCN
EA	BLADE STOP SPACER	4040XP-61 AS REQ'D	689	LCN
EA	RAIN DRIP	142AA	AA	ZER
EA	WEATHER STRIPPING	By Door/Frame Manufacturer		
EA	DOOR SWEEP	8192AA	AA	ZER
EA	THRESHOLD	655A-223	Α	ZER
EA	MULTITECH READER	MTB11/15 - BY ACCESS CONTROL PROVIDER (COORDINATE W/ HEAD END AND CREDENTIAL TYPE)	BLK	SCE
EA	DOOR CONTACT	7764	628	SCE
EA	POWER SUPPLY	PS902 900-4R [COORDINATE WITH ACCESS CONTROL PROVIDER]	LGR	SCE
EA	DIAGRAM	ELEVATION		DLR
EA	DIAGRAM	POINT TO POINT		DLR
	EA EA EA EA EA EA EA EA EA	EA CONT. HINGE EA CONT. HINGE EA POWER TRANSFER EA AUTO FLUSH BOLT EA DUST PROOF STRIKE EA ELECTRIFIED LOCKSET EA COORDINATOR EA MOUNTING BRACKET EA SURFACE CLOSER EA PA MOUNTING PLATE EA CUSH SHOE SUPPORT EA BLADE STOP SPACER EA RAIN DRIP EA WEATHER STRIPPING EA DOOR SWEEP EA THRESHOLD EA MULTITECH READER EA DOOR CONTACT EA POWER SUPPLY EA DIAGRAM	EA CONT. HINGE 224HD EPT EA POWER TRANSFER EPT10 EA AUTO FLUSH BOLT FB31P/FB41P AS REQ'D EA DUST PROOF STRIKE DP2 EA ELECTRIFIED LOCKSET 9K7 DEU 14D RQE EA COORDINATOR COR X FL EA MOUNTING BRACKET MB [AS REQ'D] EA SURFACE CLOSER 4040XP SCUSH EA PA MOUNTING PLATE 4040XP-18PA AS REQ'D EA CUSH SHOE SUPPORT 4040XP-30 AS REQ'D EA RAIN DRIP 142AA EA WEATHER STRIPPING BY DOOR/Frame Manufacturer EA DOOR SWEEP 8192AA EA THRESHOLD 655A-223 EA MULTITECH READER MTB11/15 - BY ACCESS CONTROL PROVIDER (COORDINATE W/ HEAD END AND CREDENTIAL TYPE) EA DOOR CONTACT 7764 EA DOOR SUPPLY PS902 900-4R [COORDINATE WITH ACCESS CONTROL PROVIDER] EA DIAGRAM ELEVATION	EA CONT. HINGE 224HD EPT 628 EA CONT. HINGE 224HD EPT 628 EA POWER TRANSFER EPT10 689 EA AUTO FLUSH BOLT FB31P/FB41P AS REQ'D 630 EA DUST PROOF STRIKE DP2 626 EA ELECTRIFIED LOCKSET 9K7 DEU 14D RQE 626 EA COORDINATOR COR X FL 628 EA MOUNTING BRACKET MB [AS REQ'D] 689 EA SURFACE CLOSER 4040XP SCUSH 689 EA PA MOUNTING PLATE 4040XP-18PA AS REQ'D 689 EA CUSH SHOE SUPPORT 4040XP-30 AS REQ'D 689 EA BLADE STOP SPACER 4040XP-61 AS REQ'D 689 EA RAIN DRIP 142AA AA EA WEATHER STRIPPING By DOOR/Frame Manufacturer EA DOOR SWEEP 8192AA AA EA THRESHOLD 655A-223 A EA MULTITECH READER MTB11/15 - BY ACCESS CONTROL PROVIDER (COORDINATE W/ HEAD END AND CREDENTIAL TYPE) EA DOOR CONTACT 7764 628 EA POWER SUPPLY PS902 900-4R [COORDINATE WITH ACCESS CONTROL PROVIDER] EA DIAGRAM ELEVATION

OPERATION: DOOR NORMALLY CLOSED AND LOCKED. VALID CREDENITAL MOMENTARILY UNLOCKS DOOR ALLOWING ENTRY. DOOR REMAINS LOCKED UPON LOSS OF POWER. DOOR CONTACTS TO MONITOR DOOR POSITION. RX SWITCH (INTEGRAL TO LOCK SET) SHUNTS DOOR CONTACT FOR VALID EGRESS. FREE EGRESS AT ALL TIMES.





For use on Door #(s): B-201A B-201B

Provide each OPENING with the following:

QT	Υ	DESCRIPTION	CATALOG NUMBER	FINISH	MFR
2	EA	CONT. HINGE	224HD	628	IVE
1	EA	AUTO FLUSH BOLT	FB31P/FB41P AS REQ'D	630	IVE
1	EA	DUST PROOF STRIKE	DP2	626	IVE
1	EA	STOREROOM LOCKSET	9K7 D 14D	626	BES
1	EA	COORDINATOR	COR X FL	628	IVE
2	EA	MOUNTING BRACKET	MB [AS REQ'D]	689	IVE
2	EA	SURFACE CLOSER	4040XP SCUSH	689	LCN
2	EA	PA MOUNTING PLATE	4040XP-18PA AS REQ'D	689	LCN
2	EA	CUSH SHOE SUPPORT	4040XP-30 AS REQ'D	689	LCN
2	EA	BLADE STOP SPACER	4040XP-61 AS REQ'D	689	LCN
1	EA	WEATHER STRIPPING	By Door/Frame Manufacturer		
2	EA	DOOR SWEEP	8192AA	AA	ZER
1	EA	THRESHOLD	655A-223	Α	ZER

HARDWARE GROUP NO. 38

For use on Door #(s):

C-127A

Provide each OPENING with the following:

QTY		DESCRIPTION	CATALOG NUMBER	FINISH	MFR
6	EA	HINGE	5BB1 4.5 X 4.5 (NRP AS REQ'D)	652	IVE
1	EA	CONST LATCHING BOLT	FB51T/FB61T AS REQ'D	630	IVE
1	EA	STOREROOM LOCKSET	9K7 D 14D	626	BES
1	EA	COORDINATOR	COR X FL	628	IVE
2	EA	MOUNTING BRACKET	MB [AS REQ'D]	689	IVE
2	EA	SURFACE CLOSER	4040XP RW/PA	689	LCN
2	EA	KICK PLATE	8400 10" X 1" LDW B-CS	630	IVE
2	EA	WALL STOP	WS401/402CVX	626	IVE
2	EA	SILENCER	SR64	GRY	IVE

HARDWARE GROUP NO. 39 - NOT USED

HARDWARE GROUP NO. 40 - NOT USED



For use on Door #(s): B-103A

Provide each OPENING with the following:

QTY		DESCRIPTION	CATALOG NUMBER	FINISH	MFR
3	EA	HINGE	5BB1 4.5 X 4.5 (NRP AS REQ'D)	652	IVE
1	EA	POWER TRANSFER	EPT10	689	VON
1	EA	ELECTRIFIED LOCKSET	9K7 DEU 14D RQE	626	BES
1	EA	OH STOP	90S	630	GLY
1	EA	SURFACE CLOSER	4040XP RW/PA	689	LCN
1	EA	KICK PLATE	8400 10" X 1 1/2" LDW B-CS	630	IVE
1	EA	MULTITECH READER	MTB11/15 - BY ACCESS CONTROL PROVIDER (COORDINATE W/ HEAD END AND CREDENTIAL TYPE)	BLK	SCE
1	EA	AI PHONE	BY ACCESS CONTROL PROVIDER		
1	EA	DOOR CONTACT	7764	628	SCE
1	EA	POWER SUPPLY	PS902 900-4R [COORDINATE WITH ACCESS CONTROL PROVIDER]	LGR	SCE
1	EA	DIAGRAM	ELEVATION		DLR
1	EA	DIAGRAM	POINT TO POINT		DLR

OPERATION: DOOR NORMALLY CLOSED AND LOCKED. VALID CREDENITAL OR AI PHONE AT RECEPTION DESNK MOMENTARILY UNLOCKS DOOR ALLOWING ENTRY. DOOR REMAINS LOCKED UPON LOSS OF POWER. DOOR CONTACT TO MONITOR DOOR POSITION. RX SWITCH (INTEGRAL TO LOCKSET) SHUNTS DOOR CONTACT FOR VALID EGRESS. FREE EGRESS AT ALL TIMES.

HARDWARE GROUP NO. 42

For use on Door #(s):

A-135A D-101A D-118A

Provide each OPENING with the following:

Q	ΓΥ	DESCRIPTION	CATALOG NUMBER	FINISH	MFR
2	EA	CONT. HINGE	224HD EPT	628	IVE
2	EA	POWER TRANSFER	EPT10	689	VON
1	EA	REMOVABLE MULLION	KR4954 STAB	689	VON
3	EA	MORTISE CYLINDER	1E74	626	BES
1	EA	ELEC PANIC HARDWARE	SD-RX-QEL-98-EO 24 VDC	626	VON
1	EA	ELEC PANIC HARDWARE	SD-RX-QEL-98-NL-OP-110MD 24 VDC	626	VON
1	EA	RIM CYLINDER	1E72	626	BES
2	EA	90 DEG OFFSET PULL	8190HD 12" O	630	IVE
1	EA	OH STOP	100S	630	GLY
1	EA	SURFACE CLOSER	4040XP SCUSH	689	LCN
1	EA	SURF. AUTO OPERATOR	4642 TBWMS 120 VAC	689	LCN
1	EA	PA MOUNTING PLATE	4040XP-18PA AS REQ'D	689	LCN





QTY		DESCRIPTION	CATALOG NUMBER	FINISH	MFR
1	EA	CUSH SHOE SUPPORT	4040XP-30 AS REQ'D	689	LCN
1	EA	BLADE STOP SPACER	4040XP-61 AS REQ'D	689	LCN
1	EA	WEATHER RING	8310-801		LCN
1	EA	ACTUATOR, TOUCH	8310-853T	630	LCN
1	EA	ACTUATOR, TOUCH	8310-855	630	LCN
1	EA	MULLION SEAL	8780NBK	BK	ZER
1	EA	WEATHER STRIPPING	By Door/Frame Manufacturer		
2	EA	DOOR SWEEP	8192AA	AA	ZER
1	EA	THRESHOLD	655A-223	Α	ZER
1	EA	MULTITECH READER	MTB11/15 - BY ACCESS CONTROL PROVIDER (COORDINATE W/ HEAD END AND CREDENTIAL TYPE)	BLK	SCE
2	EA	DOOR CONTACT	7764	628	SCE
1	EA	POWER SUPPLY	PS904 900-4RL [COORDINATE WITH ACCESS CONTROL PROVIDER]		VON
1	EA	DIAGRAM	ELEVATION		DLR
1	EA	DIAGRAM	POINT TO POINT		DLR

UNLOCKED HOURS: PRESSING EITHER ACTUATOR CYCLES AUTOMATIC OPERATOR AND MOMENTARILY OPEN DOOR.

LOCKED HOURS: VALID CREDENTIAL MOMENTARILY UNLOCKS DOOR AND ACTIVATES EXTERIOR ACTUATOR. WHEN ACTIVE, PRESSING EXTERIOR ACTUATOR CYCLES AUTOMATIC OPERATOR AND MOMENTARILY OPENS DOOR. INTERIOR ACTUATOR ALWAYS ACTIVE. DOORS REMAIN LOCKED UPON LOSS OF POWER. DOOR CONTACTS TO MONITOR DOOR POSITION. RX SWITCH (INTEGRAL TO EXIT DEVICE) SHUNTS DOOR CONTACTS FOR VALID EGRESS. FREE EGRESS AT ALL TIMES.

DUAL ACTUATOR (8310-855) IN VESTIBULE SHARED FOR EXTERIOR AND INTERIOR VESTIBULE DOOR.

HARDWARE GROUP NO. 43

For use on Door #(s): B-101B D-103B

Provide each OPENING with the following:

QTY		DESCRIPTION	CATALOG NUMBER	FINISH	MFR
2	EA	CONT. HINGE	224HD EPT	628	IVE
2	EA	POWER TRANSFER	EPT10	689	VON
1	EA	REMOVABLE MULLION	KR4954 STAB	689	VON
3	EA	MORTISE CYLINDER	1E74	626	BES
1	EA	ELEC PANIC HARDWARE	SD-RX-QEL-98-EO 24 VDC	626	VON
1	EA	ELEC PANIC HARDWARE	SD-RX-QEL-98-NL-OP-110MD 24 VDC	626	VON
1	EA	RIM CYLINDER	1E72	626	BES



QTY		DESCRIPTION	CATALOG NUMBER	FINISH	MFR
2	EA	90 DEG OFFSET PULL	8190HD 12" O	630	IVE
1	EA	OH STOP	100S	630	GLY
1	EA	SURFACE CLOSER	4040XP SCUSH	689	LCN
1	EA	SURF. AUTO OPERATOR	4642 TBWMS 120 VAC	689	LCN
1	EA	PA MOUNTING PLATE	4040XP-18PA AS REQ'D	689	LCN
1	EA	CUSH SHOE SUPPORT	4040XP-30 AS REQ'D	689	LCN
1	EA	BLADE STOP SPACER	4040XP-61 AS REQ'D	689	LCN
1	EA	WEATHER RING	8310-801		LCN
1	EA	ACTUATOR, TOUCH	8310-853T	630	LCN
1	EA	ACTUATOR, TOUCH	8310-855	630	LCN
1	EA	MULLION SEAL	8780NBK	BK	ZER
1	EA	WEATHER STRIPPING	By Door/Frame Manufacturer		
2	EA	DOOR SWEEP	8192AA	AA	ZER
1	EA	THRESHOLD	655A-223	Α	ZER
1	EA	MULTITECH READER	MTB11/15 - BY ACCESS CONTROL PROVIDER (COORDINATE W/ HEAD END AND CREDENTIAL TYPE)	BLK	SCE
1	EA	AI PHONE	BY ACCESS CONTROL PROVIDER		
2	EA	DOOR CONTACT	7764	628	SCE
1	EA	POWER SUPPLY	PS904 900-4RL [COORDINATE WITH ACCESS CONTROL PROVIDER]		VON
1	EA	DIAGRAM	ELEVATION		DLR
1	EA	DIAGRAM	POINT TO POINT		DLR

UNLOCKED HOURS: PRESSING EITHER ACTUATOR CYCLES AUTOMATIC OPERATOR AND MOMENTARILY OPEN DOOR.

LOCKED HOURS: VALID CREDENTIAL OR AIPHONE AT RECEPTION DESK MOMENTARILY UNLOCKS DOOR AND ACTIVATES EXTERIOR ACTUATOR. WHEN ACTIVE, PRESSING EXTERIOR ACTUATOR CYCLES AUTOMATIC OPERATOR AND MOMENTARILY OPENS DOOR. INTERIOR ACTUATOR ALWAYS ACTIVE. DOORS REMAIN LOCKED UPON LOSS OF POWER. DOOR CONTACTS TO MONITOR DOOR POSITION. RX SWITCH (INTEGRAL TO EXIT DEVICE) SHUNTS DOOR CONTACTS FOR VALID EGRESS. FREE EGRESS AT ALL TIMES.

HARDWARE GROUP NO. 44

For use on Door #(s): B-101D

Provide each OPENING with the following:

QTY		DESCRIPTION	CATALOG NUMBER	FINISH	MFR
2	EΑ	CONT. HINGE	224HD EPT	628	IVE



QTY		DESCRIPTION	CATALOG NUMBER	FINISH	MFR
2	EA	POWER TRANSFER	EPT10	689	VON
1	EA	REMOVABLE MULLION	KR4954 STAB	689	VON
3	EA	MORTISE CYLINDER	1E74	626	BES
1	EA	ELEC PANIC HARDWARE	SD-RX-QEL-98-EO 24 VDC	626	VON
1	EA	ELEC PANIC HARDWARE	SD-RX-QEL-98-NL-OP-110MD 24 VDC	626	VON
1	EA	RIM CYLINDER	1E72	626	BES
2	EA	90 DEG OFFSET PULL	8190HD 12" O	630	IVE
1	EA	OH STOP	100S	630	GLY
1	EA	SURFACE CLOSER	4040XP SCUSH	689	LCN
1	EA	SURF. AUTO OPERATOR	4642 TBWMS 120 VAC	689	LCN
1	EA	PA MOUNTING PLATE	4040XP-18PA AS REQ'D	689	LCN
1	EA	CUSH SHOE SUPPORT	4040XP-30 AS REQ'D	689	LCN
1	EA	BLADE STOP SPACER	4040XP-61 AS REQ'D	689	LCN
1	EA	ACTUATOR, TOUCH	8310-853T	630	LCN
1	EA	ACTUATOR	VESTIBULE ACTUATOR SPECIFIED WITH EXTERIOR VESTIBULE DOOR		
1	EA	MULLION SEAL	8780NBK	BK	ZER
1	EA	MULTITECH READER	MTB11/15 - BY ACCESS CONTROL PROVIDER (COORDINATE W/ HEAD END AND CREDENTIAL TYPE)	BLK	SCE
2	EA	DOOR CONTACT	7764	628	SCE
1	EA	POWER SUPPLY	PS904 900-4RL [COORDINATE WITH ACCESS CONTROL PROVIDER]		VON
1	EA	DIAGRAM	ELEVATION		DLR
1	EA	DIAGRAM	POINT TO POINT		DLR

UNLOCKED HOURS: PRESSING EITHER ACTUATOR CYCLES AUTOMATIC OPERATOR AND MOMENTARILY OPEN DOOR.

LOCKED HOURS: VALID CREDENTIAL MOMENTARILY UNLOCKS DOOR AND ACTIVATES EXTERIOR ACTUATOR. WHEN ACTIVE, PRESSING EXTERIOR ACTUATOR CYCLES AUTOMATIC OPERATOR AND MOMENTARILY OPENS DOOR. ITNERIOR ACTUATOR ALWAYS ACTIVE. DOORS REMAIN LOCKED UPON LOSS OF POWER. DOOR CONTACTS TO MONITOR DOOR POSITION. RX SWITCH (INTEGRAL TO EXIT DEVICE) SHUNTS DOOR CONTACTS FOR VALID EGRESS. FREE EGRESS AT ALL TIMES.



For use on Door #(s): A-116A

Provide each OPENING with the following:

QT	Υ	DESCRIPTION	CATALOG NUMBER	FINISH	MFR
2	EA	CONT. HINGE	224HD EPT	628	IVE
2	EA	POWER TRANSFER	EPT10	689	VON
1	EA	REMOVABLE MULLION	KR4954 STAB	689	VON
3	EA	MORTISE CYLINDER	1E74	626	BES
1	EA	ELEC PANIC HARDWARE	SD-RX-QEL-98-EO 24 VDC	626	VON
1	EA	ELEC PANIC HARDWARE	SD-RX-QEL-98-NL-OP-110MD 24 VDC	626	VON
1	EA	RIM CYLINDER	1E72	626	BES
2	EA	90 DEG OFFSET PULL	8190HD 12" O	630	IVE
1	EA	OH STOP	100S	630	GLY
1	EA	SURFACE CLOSER	4040XP SCUSH	689	LCN
1	EA	SURF. AUTO OPERATOR	4642 TBWMS 120 VAC	689	LCN
1	EA	PA MOUNTING PLATE	4040XP-18PA AS REQ'D	689	LCN
1	EA	CUSH SHOE SUPPORT	4040XP-30 AS REQ'D	689	LCN
1	EA	BLADE STOP SPACER	4040XP-61 AS REQ'D	689	LCN
1	EA	WEATHER RING	8310-801		LCN
2	EA	ACTUATOR, TOUCH	8310-853T	630	LCN
1	EA	MULLION SEAL	8780NBK	BK	ZER
1	EA	WEATHER STRIPPING	By Door/Frame Manufacturer		
2	EA	DOOR SWEEP	8192AA	AA	ZER
1	EA	THRESHOLD	655A-223	Α	ZER
1	EA	MULTITECH READER	MTB11/15 - BY ACCESS CONTROL PROVIDER (COORDINATE W/ HEAD END AND CREDENTIAL TYPE)	BLK	SCE
2	EA	DOOR CONTACT	7764	628	SCE
1	EA	POWER SUPPLY	PS904 900-4RL [COORDINATE WITH ACCESS CONTROL PROVIDER]		VON
1	EA	DIAGRAM	ELEVATION		DLR
1	EA	DIAGRAM	POINT TO POINT		DLR





UNLOCKED HOURS: PRESSING EITHER ACTUATOR CYCLES AUTOMATIC OPERATOR AND MOMENTARILY OPEN DOOR.

LOCKED HOURS: VALID CREDENTIAL MOMENTARILY UNLOCKS DOOR AND ACTIVATES EXTERIOR ACTUATOR. WHEN ACTIVE, PRESSING EXTERIOR ACTUATOR CYCLES AUTOMATIC OPERATOR AND MOMENTARILY OPENS DOOR. INTERIOR ACTUATOR ALWAYS ACTIVE. DOORS REMAIN LOCKED UPON LOSS OF POWER. DOOR CONTACTS TO MONITOR DOOR POSITION. RX SWITCH (INTEGRAL TO EXIT DEVICE) SHUNTS DOOR CONTACTS FOR VALID EGRESS. FREE EGRESS AT ALL TIMES.

DUAL ACTUATOR (8310-855) IN VESTIBULE SHARED FOR EXTERIOR AND INTERIOR VESTIBULE DOOR.

HARDWARE GROUP NO. 46

For use on Door #(s):

B-131A B-133A C-101A C-115A

Provide each OPENING with the following:

	DESCRIPTION	CATALOG NUMBER	FINISH	MFR
EA	CONT. HINGE	224HD EPT	628	IVE
EA	POWER TRANSFER	EPT10	689	VON
EA	REMOVABLE MULLION	KR4954 STAB	689	VON
EA	MORTISE CYLINDER	1E74	626	BES
EA	ELEC PANIC HARDWARE	SD-RX-QEL-98-EO 24 VDC	626	VON
EA	ELEC PANIC HARDWARE	SD-RX-QEL-98-NL-OP-110MD 24 VDC	626	VON
EA	RIM CYLINDER	1E72	626	BES
EA	90 DEG OFFSET PULL	8190HD 12" O	630	IVE
EA	SURFACE CLOSER	4040XP SCUSH	689	LCN
EA	PA MOUNTING PLATE	4040XP-18PA AS REQ'D	689	LCN
EA	CUSH SHOE SUPPORT	4040XP-30 AS REQ'D	689	LCN
EA	BLADE STOP SPACER	4040XP-61 AS REQ'D	689	LCN
EA	MULLION SEAL	8780NBK	BK	ZER
EA	WEATHER STRIPPING	By Door/Frame Manufacturer		
EA	DOOR SWEEP	8192AA	AA	ZER
EA	THRESHOLD	655A-223	Α	ZER
EA	MULTITECH READER	MTB11/15 - BY ACCESS CONTROL PROVIDER (COORDINATE W/ HEAD END AND CREDENTIAL TYPE)	BLK	SCE
EA	DOOR CONTACT	7764	628	SCE
EA	POWER SUPPLY	PS904 900-2RS [COORDINATE WITH ACCESS CONTROL PROVIDER]		VON
EA	DIAGRAM	ELEVATION		DLR
EA	DIAGRAM	POINT TO POINT		DLR
	EA EA EA EA EA EA EA EA EA EA	EA CONT. HINGE EA POWER TRANSFER EA REMOVABLE MULLION EA MORTISE CYLINDER EA ELEC PANIC HARDWARE EA ELEC PANIC HARDWARE EA GOUTH OF THE PROPERTY OF THE PROPERTY OF THE POWER SUPPORT EA MULLION SEAL EA WEATHER STRIPPING EA DOOR SWEEP EA THRESHOLD EA MULTITECH READER EA DOOR CONTACT EA POWER SUPPLY EA DIAGRAM	EA CONT. HINGE EA POWER TRANSFER EA REMOVABLE MULLION EA REMOVABLE MULLION EA MORTISE CYLINDER EA ELEC PANIC HARDWARE EA ELEC PANIC HARDWARE EA ELEC PANIC HARDWARE EA RIM CYLINDER EA RIM CYLINDER EA 90 DEG OFFSET PULL EA SURFACE CLOSER EA PA MOUNTING PLATE EA CUSH SHOE SUPPORT EA BLADE STOP SPACER EA MULLION SEAL EA WEATHER STRIPPING EA DOOR SWEEP EA THRESHOLD EA THRESHOLD EA MULTITECH READER EA DOOR CONTACT EA POWER SUPPLY EA DIAGRAM ELEVATION EA DIAGRAM ELEVATION EA DIAGRAM ELEVATION EA DIAGRAM ELEVATION EA DIAGRAM ELEVATION EA DIAGRAM ELEVATION	EA CONT. HINGE 224HD EPT 628 EA POWER TRANSFER EPT10 689 EA REMOVABLE MULLION KR4954 STAB 689 EA MORTISE CYLINDER 1E74 626 EA ELEC PANIC HARDWARE SD-RX-QEL-98-BC 24 VDC 626 EA ELEC PANIC HARDWARE SD-RX-QEL-98-NL-OP-110MD 24 626 EA RIM CYLINDER 1E72 626 EA RIM CYLINDER 1E72 626 EA PO DEG OFFSET PULL 8190HD 12" O 630 EA SURFACE CLOSER 4040XP SCUSH 689 EA PA MOUNTING PLATE 4040XP-30 AS REQ'D 689 EA PA MOUNTING PLATE 4040XP-30 AS REQ'D 689 EA BLADE STOP SPACER 4040XP-61 AS REQ'D 689 EA MULLION SEAL 8780NBK BK EA WEATHER STRIPPING By Door/Frame Manufacturer EA DOOR SWEEP 8192AA A EA MULTITECH READER MTB11/15 - B



LOCKED HOURS: VALID CREDENTIAL MOMENTARILY UNLOCKS DOOR ALLOWING ACCESS. DOORS REMAIN LOCKED UPON LOSS OF POWER. DOOR CONTACTS TO MONITOR DOOR POSITION. RX SWITCH (INTEGRAL TO EXIT DEVICE) SHUNTS DOOR CONTACTS FOR VALID EGRESS. FREE EGRESS AT ALL TIMES.

HARDWARE GROUP NO. 47

For use on Door #(s): C-130A

Provide each OPENING with the following:

1 EA REMOVABLE MULLION KR4954 STAB 689 VON 3 EA MORTISE CYLINDER 1E74 626 BES 1 EA ELEC PANIC HARDWARE SD-RX-QEL-98-EO 24 VDC 626 VON 1 EA ELEC PANIC HARDWARE SD-RX-QEL-98-NL-OP-110MD 24 626 VON 1 EA RIM CYLINDER 1E72 626 BES 2 EA RIM CYLINDER 1E72 626 BES 2 EA 90 DEG OFFSET PULL 8190HD 12" O 630 IVE 2 EA 90 DEG OFFSET PULL 8190HD 12" O 630 IVE 2 EA SURFACE CLOSER 4040XP SCUSH 689 LCN 2 EA PA MOUNTING PLATE 4040XP-18PA AS REQ'D 689 LCN 2 EA CUSH SHOE SUPPORT 4040XP-30 AS REQ'D 689 LCN 1 EA MULLION SEAL 8780NBK BK ZER 1 EA DOOR SWEE	QTY		DESCRIPTION	CATALOG NUMBER	FINISH	MFR
1 EA REMOVABLE MULLION KR4954 STAB 689 VON 3 EA MORTISE CYLINDER 1E74 626 BES 1 EA ELEC PANIC HARDWARE SD-RX-QEL-98-EO 24 VDC 626 VON 1 EA ELEC PANIC HARDWARE SD-RX-QEL-98-NL-OP-110MD 24 626 VON 1 EA RIM CYLINDER 1E72 626 BES 2 EA RIM CYLINDER 1E72 626 BES 2 EA 90 DEG OFFSET PULL 8190HD 12" O 630 IVE 2 EA SURFACE CLOSER 4040XP SCUSH 689 LCN 2 EA SURFACE CLOSER 4040XP-18PA AS REQ'D 689 LCN 2 EA PA MOUNTING PLATE 4040XP-30 AS REQ'D 689 LCN 2 EA BLADE STOP SPACER 4040XP-31 AS REQ'D 689 LCN 1 EA MULLION SEAL 8780NBK BK ZER 1 EA DOOR SW	2	EA	CONT. HINGE	224HD EPT	628	IVE
3 EA MORTISE CYLINDER 1E74 626 BES 1 EA ELEC PANIC HARDWARE SD-RX-QEL-98-EO 24 VDC 626 VON 1 EA ELEC PANIC HARDWARE SD-RX-QEL-98-NL-OP-110MD 24 626 VON 1 EA RIM CYLINDER 1E72 626 BES 2 EA PO DEG OFFSET PULL 8190HD 12" O 630 IVE 2 EA 90 DEG OFFSET PULL 8190HD 12" O 630 IVE 2 EA SURFACE CLOSER 4040XP SCUSH 689 LCN 2 EA PA MOUNTING PLATE 4040XP-18PA AS REQ'D 689 LCN 2 EA PA MOUNTING PLATE 4040XP-30 AS REQ'D 689 LCN 2 EA BLADE STOP SPACER 4040XP-61 AS REQ'D 689 LCN 1 EA MULLION SEAL 8780NBK BK ZER 1 EA DOOR SWEEP 8192AA AA ZER 1 EA MUL	2	EA	POWER TRANSFER	EPT10	689	VON
1 EA ELEC PANIC HARDWARE SD-RX-QEL-98-EO 24 VDC 626 VON VDC 1 EA ELEC PANIC HARDWARE SD-RX-QEL-98-NL-OP-110MD 24 626 VON VDC 1 EA RIM CYLINDER 1E72 626 BES 12 EA 90 DEG OFFSET PULL 8190HD 12" O 630 IVE 689 LCN 68	1	EA	REMOVABLE MULLION	KR4954 STAB	689	VON
1EAELEC PANIC HARDWARESD-RX-QEL-98-NL-OP-110MD 24 VDC626VON ON ODE VDC1EARIM CYLINDER1E72626BES2EA90 DEG OFFSET PULL 8190HD 12" O630IVE2EASURFACE CLOSER 4040XP SCUSH 4040XP-18PA AS REQ'D689LCN2EAPA MOUNTING PLATE 4040XP-30 AS REQ'D689LCN2EACUSH SHOE SUPPORT 4040XP-30 AS REQ'D689LCN1EABLADE STOP SPACER 4040XP-61 AS REQ'D689LCN1EAMULLION SEAL EA8780NBK 8780NBK BY DOOT/Frame ManufacturerBKZER2EADOOR SWEEP8192AAAAZER1EATHRESHOLD END AND CREDENTIAL TYPE)BLK BLK END AND CREDENTIAL TYPE)BLK BLK SCE PROVIDER (COORDINATE W/ HEAD END AND CREDENTIAL TYPE)BLK BLK SCE1EAAI PHONEBY ACCESS CONTROL PROVIDERC28SCE1EADOOR CONTACT ACCESS CONTROL PROVIDER]7764 CCESS CONTROL PROVIDER]COORDINATE WITH ACCESS CONTROL PROVIDER]VON ACCESS CONTROL PROVIDER]1EADIAGRAMELEVATIONDLR	3	EA	MORTISE CYLINDER	1E74	626	BES
VDC	1	EA	ELEC PANIC HARDWARE	SD-RX-QEL-98-EO 24 VDC	626	VON
EA 90 DEG OFFSET PULL 8190HD 12" O 630 IVE EA SURFACE CLOSER 4040XP SCUSH 689 LCN EA PA MOUNTING PLATE 4040XP-18PA AS REQ'D 689 LCN EA CUSH SHOE SUPPORT 4040XP-30 AS REQ'D 689 LCN EA BLADE STOP SPACER 4040XP-61 AS REQ'D 689 LCN EA MULLION SEAL 8780NBK BK ZER EA WEATHER STRIPPING BY DOOR/Frame Manufacturer EA DOOR SWEEP 8192AA AA ZER EA THRESHOLD 655A-223 A ZER EA MULTITECH READER MTB11/15 - BY ACCESS CONTROL PROVIDER EA AI PHONE BY ACCESS CONTROL PROVIDER EA DOOR CONTACT 7764 628 SCE EA DOOR CONTACT 7764 628 SCE EA DIAGRAM ELEVATION DLR	1	EA	ELEC PANIC HARDWARE		626	VON
2 EA SURFACE CLOSER 4040XP SCUSH 689 LCN 2 EA PA MOUNTING PLATE 4040XP-18PA AS REQ'D 689 LCN 2 EA CUSH SHOE SUPPORT 4040XP-30 AS REQ'D 689 LCN 2 EA BLADE STOP SPACER 4040XP-61 AS REQ'D 689 LCN 1 EA MULLION SEAL 8780NBK BK ZER 1 EA WEATHER STRIPPING By Door/Frame Manufacturer 2 EA DOOR SWEEP 8192AA AA ZER 1 EA THRESHOLD 655A-223 A ZER 1 EA MULTITECH READER MTB11/15 - BY ACCESS CONTROL BLK SCE PROVIDER (COORDINATE W/ HEAD END AND CREDENTIAL TYPE) 1 EA AI PHONE BY ACCESS CONTROL PROVIDER 2 EA DOOR CONTACT 7764 628 SCE 1 EA POWER SUPPLY PS904 900-2RS [COORDINATE WITH ACCESS CONTROL PROVIDER] 1 EA DIAGRAM ELEVATION DLR	1	EA	RIM CYLINDER	1E72	626	BES
2 EA PA MOUNTING PLATE 4040XP-18PA AS REQ'D 689 LCN 2 EA CUSH SHOE SUPPORT 4040XP-30 AS REQ'D 689 LCN 2 EA BLADE STOP SPACER 4040XP-61 AS REQ'D 689 LCN 1 EA MULLION SEAL 8780NBK BK ZER 1 EA WEATHER STRIPPING By Door/Frame Manufacturer 2 EA DOOR SWEEP 8192AA AA ZER 1 EA THRESHOLD 655A-223 A ZER 1 EA MULTITECH READER MTB11/15 - BY ACCESS CONTROL PROVIDER (COORDINATE W/ HEAD END AND CREDENTIAL TYPE) 1 EA AI PHONE BY ACCESS CONTROL PROVIDER 2 EA DOOR CONTACT 7764 628 SCE 1 EA POWER SUPPLY PS904 900-2RS [COORDINATE WITH ACCESS CONTROL PROVIDER] 1 EA DIAGRAM ELEVATION DLR	2	EA	90 DEG OFFSET PULL	8190HD 12" O	630	IVE
2 EA CUSH SHOE SUPPORT 4040XP-30 AS REQ'D 689 LCN 2 EA BLADE STOP SPACER 4040XP-61 AS REQ'D 689 LCN 1 EA MULLION SEAL 8780NBK BK ZER 1 EA WEATHER STRIPPING By Door/Frame Manufacturer 2 EA DOOR SWEEP 8192AA AA ZER 1 EA THRESHOLD 655A-223 A ZER 1 EA MULTITECH READER MTB11/15 - BY ACCESS CONTROL PROVIDER (COORDINATE W/ HEAD END AND CREDENTIAL TYPE) 1 EA AI PHONE BY ACCESS CONTROL PROVIDER 2 EA DOOR CONTACT 7764 628 SCE 1 EA POWER SUPPLY PS904 900-2RS [COORDINATE WITH ACCESS CONTROL PROVIDER] 1 EA DIAGRAM ELEVATION DLR	2	EA	SURFACE CLOSER	4040XP SCUSH	689	LCN
2 EA BLADE STOP SPACER 4040XP-61 AS REQ'D 689 LCN 1 EA MULLION SEAL 8780NBK BK ZER 1 EA WEATHER STRIPPING By Door/Frame Manufacturer 2 EA DOOR SWEEP 8192AA AA ZER 1 EA THRESHOLD 655A-223 A ZER 1 EA MULTITECH READER MTB11/15 - BY ACCESS CONTROL PROVIDER (COORDINATE W/ HEAD END AND CREDENTIAL TYPE) 1 EA AI PHONE BY ACCESS CONTROL PROVIDER 2 EA DOOR CONTACT 7764 628 SCE 1 EA POWER SUPPLY PS904 900-2RS [COORDINATE WITH ACCESS CONTROL PROVIDER] 1 EA DIAGRAM ELEVATION DLR	2	EA	PA MOUNTING PLATE	4040XP-18PA AS REQ'D	689	LCN
1 EA MULLION SEAL 8780NBK BK ZER 1 EA WEATHER STRIPPING By Door/Frame Manufacturer 2 EA DOOR SWEEP 8192AA AA ZER 1 EA THRESHOLD 655A-223 A ZER 1 EA MULTIITECH READER MTB11/15 - BY ACCESS CONTROL PROVIDER (COORDINATE W/ HEAD END AND CREDENTIAL TYPE) 1 EA AI PHONE BY ACCESS CONTROL PROVIDER 2 EA DOOR CONTACT 7764 628 SCE 1 EA POWER SUPPLY PS904 900-2RS [COORDINATE WITH ACCESS CONTROL PROVIDER] 1 EA DIAGRAM ELEVATION DLR	2	EA	CUSH SHOE SUPPORT	4040XP-30 AS REQ'D	689	LCN
1 EA WEATHER STRIPPING By Door/Frame Manufacturer 2 EA DOOR SWEEP 8192AA AA ZER 1 EA THRESHOLD 655A-223 A ZER 1 EA MULTITECH READER MTB11/15 - BY ACCESS CONTROL BLK SCE PROVIDER (COORDINATE W/ HEAD END AND CREDENTIAL TYPE) 1 EA AI PHONE BY ACCESS CONTROL PROVIDER 2 EA DOOR CONTACT 7764 628 SCE 1 EA POWER SUPPLY PS904 900-2RS [COORDINATE WITH ACCESS CONTROL PROVIDER] 1 EA DIAGRAM ELEVATION DLR	2	EA	BLADE STOP SPACER	4040XP-61 AS REQ'D	689	LCN
2 EA DOOR SWEEP 8192AA AA ZER 1 EA THRESHOLD 655A-223 A ZER 1 EA MULTITECH READER MTB11/15 - BY ACCESS CONTROL PROVIDER (COORDINATE W/ HEAD END AND CREDENTIAL TYPE) 1 EA AI PHONE BY ACCESS CONTROL PROVIDER 2 EA DOOR CONTACT 7764 628 SCE 1 EA POWER SUPPLY PS904 900-2RS [COORDINATE WITH ACCESS CONTROL PROVIDER] 1 EA DIAGRAM ELEVATION DLR	1	EA	MULLION SEAL	8780NBK	BK	ZER
1 EA THRESHOLD 655A-223 A ZER 1 EA MULTITECH READER MTB11/15 - BY ACCESS CONTROL PROVIDER (COORDINATE W/ HEAD END AND CREDENTIAL TYPE) 1 EA AI PHONE BY ACCESS CONTROL PROVIDER 2 EA DOOR CONTACT 7764 628 SCE 1 EA POWER SUPPLY PS904 900-2RS [COORDINATE WITH ACCESS CONTROL PROVIDER] 1 EA DIAGRAM ELEVATION DLR	1	EA	WEATHER STRIPPING	By Door/Frame Manufacturer		
1 EA MULTITECH READER MTB11/15 - BY ACCESS CONTROL PROVIDER (COORDINATE W/ HEAD END AND CREDENTIAL TYPE) 1 EA AI PHONE BY ACCESS CONTROL PROVIDER 2 EA DOOR CONTACT 7764 628 SCE 1 EA POWER SUPPLY PS904 900-2RS [COORDINATE WITH ACCESS CONTROL PROVIDER] 1 EA DIAGRAM ELEVATION DLR	2	EA	DOOR SWEEP	8192AA	AA	ZER
PROVIDER (COORDINATE W/ HEAD END AND CREDENTIAL TYPE) 1 EA AI PHONE BY ACCESS CONTROL PROVIDER 2 EA DOOR CONTACT 7764 628 SCE 1 EA POWER SUPPLY PS904 900-2RS [COORDINATE WITH ACCESS CONTROL PROVIDER] 1 EA DIAGRAM ELEVATION DLR	1	EA	THRESHOLD	655A-223	Α	ZER
2 EA DOOR CONTACT 7764 628 SCE 1 EA POWER SUPPLY PS904 900-2RS [COORDINATE WITH ACCESS CONTROL PROVIDER] 1 EA DIAGRAM ELEVATION DLR	1	EA	MULTITECH READER	PROVIDER (COORDINATE W/ HEAD	BLK	SCE
1 EA POWER SUPPLY PS904 900-2RS [COORDINATE WITH ACCESS CONTROL PROVIDER] 1 EA DIAGRAM ELEVATION DLR	1	EA	AI PHONE	BY ACCESS CONTROL PROVIDER		
ACCESS CONTROL PROVIDER] 1 EA DIAGRAM ELEVATION DLR	2	EA	DOOR CONTACT	7764	628	SCE
	1	EA	POWER SUPPLY			VON
1 EA DIAGRAM POINT TO POINT DLR	1	EA	DIAGRAM	ELEVATION		DLR
	1	EA	DIAGRAM	POINT TO POINT		DLR






LOCKED HOURS: VALID CREDENTIAL OR AIPHONE AT RECEPTION DESK MOMENTARILY UNLOCKS DOOR ALLOWING ACCESS. DOORS REMAIN LOCKED UPON LOSS OF POWER. DOOR CONTACTS TO MONITOR DOOR POSITION. RX SWITCH (INTEGRAL TO EXIT DEVICE) SHUNTS DOOR CONTACTS FOR VALID EGRESS. FREE EGRESS AT ALL TIMES.

HARDWARE GROUP NO. 48

For use on Door #(s): B-129A

Provide each OPENING with the following:

QTY		DESCRIPTION	CATALOG NUMBER	FINISH	MFR
2	EA	CONT. HINGE	224HD EPT	628	IVE
2	EA	POWER TRANSFER	EPT10	689	VON
1	EA	REMOVABLE MULLION	KR4954 STAB	689	VON
3	EA	MORTISE CYLINDER	1E74	626	BES
1	EA	ELEC PANIC HARDWARE	SD-RX-QEL-98-EO 24 VDC	626	VON
1	EA	ELEC PANIC HARDWARE	SD-RX-QEL-98-NL-OP-110MD 24 VDC	626	VON
1	EA	RIM CYLINDER	1E72	626	BES
2	EA	90 DEG OFFSET PULL	8190HD 12" O	630	IVE
2	EA	SURFACE CLOSER	4040XP SHCUSH	689	LCN
2	EA	PA MOUNTING PLATE	4040XP-18PA AS REQ'D	689	LCN
2	EA	CUSH SHOE SUPPORT	4040XP-30 AS REQ'D	689	LCN
2	EA	BLADE STOP SPACER	4040XP-61 AS REQ'D	689	LCN
1	EA	MULLION SEAL	8780NBK	BK	ZER
1	EA	WEATHER STRIPPING	By Door/Frame Manufacturer		
2	EA	DOOR SWEEP	8192AA	AA	ZER
1	EA	THRESHOLD	655A-223	Α	ZER
1	EA	MULTITECH READER	MTB11/15 - BY ACCESS CONTROL PROVIDER (COORDINATE W/ HEAD END AND CREDENTIAL TYPE)	BLK	SCE
2	EA	DOOR CONTACT	7764	628	SCE
1	EA	POWER SUPPLY	PS904 900-2RS [COORDINATE WITH ACCESS CONTROL PROVIDER]		VON
1	EA	DIAGRAM	ELEVATION		DLR
1	EA	DIAGRAM	POINT TO POINT		DLR

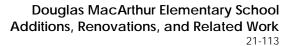



LOCKED HOURS: VALID CREDENTIAL MOMENTARILY UNLOCKS DOOR ALLOWING ACCESS. DOORS REMAIN LOCKED UPON LOSS OF POWER. DOOR CONTACTS TO MONITOR DOOR POSITION. RX SWITCH (INTEGRAL TO EXIT DEVICE) SHUNTS DOOR CONTACTS FOR VALID EGRESS. FREE EGRESS AT ALL TIMES.



For use on Door #(s):

B-131B C-115B C-130B D-103C

Provide each OPENING with the following:

QTY		DESCRIPTION	CATALOG NUMBER	FINISH	MFR
2	EA	CONT. HINGE	224HD	628	IVE
2	EA	DUMMY PUSH BAR	350	626	VON
2	EA	90 DEG OFFSET PULL	8190HD 12" O	630	IVE
2	EA	SURFACE CLOSER	4040XP SCUSH	689	LCN
2	EA	PA MOUNTING PLATE	4040XP-18PA AS REQ'D	689	LCN
2	EA	CUSH SHOE SUPPORT	4040XP-30 AS REQ'D	689	LCN
2	EA	BLADE STOP SPACER	4040XP-61 AS REQ'D	689	LCN

HARDWARE GROUP NO. 50

For use on Door #(s):

A-135B D-101B D-103D D-118B

Provide each OPENING with the following:

QTY		DESCRIPTION	CATALOG NUMBER	FINISH	MFR
2	EA	CONT. HINGE	224HD	628	IVE
2	EA	DUMMY PUSH BAR	350	626	VON
2	EA	90 DEG OFFSET PULL	8190HD 12" O	630	IVE
1	EA	OH STOP	100S	630	GLY
1	EA	SURFACE CLOSER	4040XP SCUSH	689	LCN
1	EA	SURF. AUTO OPERATOR	4642 TBWMS 120 VAC	689	LCN
1	EA	PA MOUNTING PLATE	4040XP-18PA AS REQ'D	689	LCN
1	EA	CUSH SHOE SUPPORT	4040XP-30 AS REQ'D	689	LCN
1	EA	BLADE STOP SPACER	4040XP-61 AS REQ'D	689	LCN
1	EA	ACTUATOR, TOUCH	8310-853T	630	LCN
1	EA	ACTUATOR	VESTIBULE ACTUATOR SPECIFIED		
			WITH EXTERIOR VESTIBULE DOOR		
1	EA	DIAGRAM	ELEVATION		DLR
1	EA	DIAGRAM	POINT TO POINT		DLR

OPERATION: PRESSING EITHER ACTUATOR CYCLES AUTOMATIC OPERATOR AND MOMENTARILY OPENS DOOR. FREE EGRESS AT ALL TIMES.

DUAL ACTUATOR (8310-855) IN VESTIBULE SHARED FOR EXTERIOR AND INTERIOR VESTIBULE DOOR. (SPECIFIED WITH EXTERIOR VESTIBULE DOOR)





For use on Door #(s):

B-101A C-101B D-103A

Provide each OPENING with the following:

QTY		DESCRIPTION	CATALOG NUMBER	FINISH	MFR
2	EA	CONT. HINGE	224HD EPT	628	IVE
2	EA	POWER TRANSFER	EPT10	689	VON
1	EA	REMOVABLE MULLION	KR4954 STAB	689	VON
3	EA	MORTISE CYLINDER	1E74	626	BES
2	EA	ELEC PANIC HARDWARE	SD-RX-QEL-98-EO 24 VDC	626	VON
2	EA	90 DEG OFFSET PULL	8190HD 12" O	630	IVE
2	EA	SURFACE CLOSER	4040XP SCUSH	689	LCN
2	EA	PA MOUNTING PLATE	4040XP-18PA AS REQ'D	689	LCN
2	EA	CUSH SHOE SUPPORT	4040XP-30 AS REQ'D	689	LCN
2	EA	BLADE STOP SPACER	4040XP-61 AS REQ'D	689	LCN
1	EA	RAIN DRIP	142AA	AA	ZER
1	EA	MULLION SEAL	8780NBK	BK	ZER
1	EA	WEATHER STRIPPING	By Door/Frame Manufacturer		
2	EA	DOOR SWEEP	8192AA	AA	ZER
1	EA	THRESHOLD	655A-223	Α	ZER
2	EA	DOOR CONTACT	7764	628	SCE
1	EA	POWER SUPPLY	PS904 900-2RS [COORDINATE WITH ACCESS CONTROL PROVIDER]		VON
1	EA	DIAGRAM	ELEVATION		DLR
1	EA	DIAGRAM	POINT TO POINT		DLR

OPERATION: DOORS NORMALLY CLOSED AND LOCKED. DOORS CAN BE LEFT UNLOCKED AS PROGRAMMED BY ACCESS CONTROL.

DOOR CONTACTS TO MONITOR DOOR POSITION. RX SWITCH (INTEGRAL TO EXIT DEVICE) SHUNTS DOOR CONTACT FOR VALID EGRESS. FREE EGRESS AT ALL TIMES.



For use on Door #(s): B-101C

Provide each OPENING with the following:

QTY		DESCRIPTION	CATALOG NUMBER	FINISH	MFR
2	EA	CONT. HINGE	224HD EPT	628	IVE
2	EA	POWER TRANSFER	EPT10	689	VON
1	EA	REMOVABLE MULLION	KR4954 STAB	689	VON
3	EA	MORTISE CYLINDER	1E74	626	BES
2	EA	ELEC PANIC HARDWARE	SD-RX-QEL-98-EO 24 VDC	626	VON
2	EA	90 DEG OFFSET PULL	8190HD 12" O	630	IVE
2	EA	SURFACE CLOSER	4040XP SCUSH	689	LCN
2	EA	PA MOUNTING PLATE	4040XP-18PA AS REQ'D	689	LCN
2	EA	CUSH SHOE SUPPORT	4040XP-30 AS REQ'D	689	LCN
2	EA	BLADE STOP SPACER	4040XP-61 AS REQ'D	689	LCN
1	EA	MULLION SEAL	8780NBK	BK	ZER
2	EA	DOOR CONTACT	7764	628	SCE
1	EA	POWER SUPPLY	PS904 900-2RS [COORDINATE WITH		VON
			ACCESS CONTROL PROVIDER]		
1	EA	DIAGRAM	ELEVATION		DLR
1	EA	DIAGRAM	POINT TO POINT		DLR

OPERATION: DOORS NORMALLY CLOSED AND LOCKED. DOORS CAN BE LEFT UNLOCKED AS PROGRAMMED BY ACCESS CONTROL.

DOOR CONTACTS TO MONITOR DOOR POSITION. RX SWITCH (INTEGRAL TO EXIT DEVICE) SHUNTS DOOR CONTACT FOR VALID EGRESS. FREE EGRESS AT ALL TIMES.



For use on Door #(s): B-143B

Provide each OPENING with the following:

QTY		DESCRIPTION	CATALOG NUMBER	FINISH	MFR
6	EA	HINGE	5BB1 4.5 X 4.5 (NRP AS REQ'D)	652	IVE
2	EA	MORTISE CYLINDER	1E74	626	BES
2	EA	PANIC HARDWARE	CDSI-9827-DT-LBR	626	VON
2	EA	STRIKE	260U	626	VON
2	EA	SURFACE CLOSER	4040XP HCUSH	689	LCN
2	EA	PA FLUSH PANEL ADAPTER	4040XP-419 SRT	689	LCN
2	EA	KICK PLATE	8400 10" X 1" LDW B-CS	630	IVE
1	EA	THRESHOLD	BY WOOD FLOOR INSTALLER		B/O
2	EA	SILENCER	SR64	GRY	IVE

DOORS AND TRANSOM TO BE RABBETED.

HARDWARE GROUP NO. 54 - NOT USED

HARDWARE GROUP NO. 55

For use on Door #(s): B-124A

Provide each OPENING with the following:

QTY		DESCRIPTION	CATALOG NUMBER	FINISH	MFR
6	EA	HINGE	5BB1 4.5 X 4.5 (NRP AS REQ'D)	652	IVE
2	EA	MORTISE CYLINDER	1E74	626	BES
2	EA	PANIC HARDWARE	CDSI-9827-DT-LBR	626	VON
2	EA	STRIKE	260U	626	VON
1	EA	SURFACE CLOSER	4040XP EDA (MOUNT CLOSER TO ALLOW DOOR TO SWING AGAINST WALL)	689	LCN
1	EA	SURFACE CLOSER	4040XP HCUSH	689	LCN
2	EA	PA FLUSH PANEL ADAPTER	4040XP-419 SRT	689	LCN
2	EA	KICK PLATE	8400 10" X 1" LDW B-CS	630	IVE
1	EA	WALL STOP/HOLDER	WS45	626	IVE
2	EA	SILENCER	SR64	GRY	IVE

DOORS AND TRANSOM TO BE RABBETED.



For use on Door #(s): B-114A

Provide each OPENING with the following:

QTY		DESCRIPTION	CATALOG NUMBER	FINISH	MFR
6	EA	HINGE	5BB1HW 5 X 4.5 (NRP AS REQ'D)	652	IVE
2	EA	POWER TRANSFER	EPT10	689	VON
1	EA	ELEC PANIC HARDWARE	RX-QEL-9827-DT-LBR 24 VDC	626	VON
1	EA	ELEC PANIC HARDWARE	RX-QEL-9827-NL-LBR 24 VDC	626	VON
2	EA	STRIKE	260U	626	VON
1	EA	RIM CYLINDER	1E72	626	BES
2	EA	SURFACE CLOSER	4040XP RW/PA	689	LCN
2	EA	PA FLUSH PANEL ADAPTER	4040XP-419 SRT	689	LCN
2	EA	KICK PLATE	8400 10" X 1" LDW B-CS	630	IVE
2	EA	FIRE/LIFE WALL MAG	SEM7800 SERIES AS REQ'D	689	LCN
2	EA	SILENCER	SR64	GRY	IVE
1	EA	MULTITECH READER	MTB11/15 - BY ACCESS CONTROL PROVIDER (COORDINATE W/ HEAD END AND CREDENTIAL TYPE)	BLK	SCE
2	EA	DOOR CONTACT	679-05WD/679-05HM AS REQ	BLK	SCE
1	EA	POWER SUPPLY	PS904 900-4R [COORDINATE WITH ACCESS CONTROL PROVIDER]		VON
1	EA	DIAGRAM	ELEVATION		DLR
1	EA	DIAGRAM	POINT TO POINT		DLR

OPERATION: DOORS NORMALLY HELD OPEN. UPON LOSS OF POWER OR FIRE ALARM, MAGNETIC HOLD OPENS RELEASE, ALLOWING DOORS TO CLOSE, LOCK AND LATCH. FREE EGRESS AT ALL TIMES.

WHEN DOORS ARE CLOSED AND LOCKED: VALID CREDENTIAL MOMENTARILY UNLOCKS DOOR ALLOWING ENTRY. DOOR CONTACTS TO MONITOR DOOR POSITION. RX SWITCH (INTEGRAL TO PANIC DEVICE) SHUNTS DOOR CONTACT FOR VALID EGRESS. FREE EGRESS AT ALL TIMES.

POWER SUPPLY TIED INTO FIRE ALARM SYSETM.

DOORS AND TRANSOM TO BE RABBETED.



For use on Door #(s): B-138B

Provide each OPENING with the following:

QTY		DESCRIPTION	CATALOG NUMBER	FINISH	MFR			
3	EA	HINGE	5BB1 4.5 X 4.5 (NRP AS REQ'D)	652	IVE			
2	EA	MORTISE CYLINDER	1E74	626	BES			
1	EA	PANIC HARDWARE	CDSI-9875-NL	626	VON			
1	EA	SURFACE CLOSER	4040XP SCUSH	689	LCN			
1	EA	PA FLUSH PANEL ADAPTER	4040XP-419 SRT	689	LCN			
1	EA	KICK PLATE	8400 10" X 1 1/2" LDW B-CS	630	IVE			
2	EA	GASKETING	119WB PSA	В	ZER			
1	EA	GASKETING	870AA	AA	ZER			
1	EA	DOOR BOTTOM	364AA	AA	ZER			
1	EA	THRESHOLD	564A	Α	ZER			
1	EA	MOUNTING BRACKET	870SPB		ZER			
HARE	HARDWARE GROUP NO. 58 - NOT USED							

HARDWARE GROUP NO. 59

For use on Door #(s): B-143A

Provide each OPENING with the following:

QTY		DESCRIPTION	CATALOG NUMBER	FINISH	MFR
6	EA	HINGE	5BB1 4.5 X 4.5 (NRP AS REQ'D)	652	IVE
2	EA	MORTISE CYLINDER	1E74	626	BES
1	EA	PANIC HARDWARE	CDSI-9827-DT-LBR	626	VON
1	EA	PANIC HARDWARE	CDSI-9827-NL-LBR	626	VON
2	EA	STRIKE	260U	626	VON
1	EA	RIM CYLINDER	1E72	626	BES
2	EA	SURFACE CLOSER	4040XP HCUSH	689	LCN
2	EA	PA FLUSH PANEL ADAPTER	4040XP-419 SRT	689	LCN
2	EA	KICK PLATE	8400 10" X 1" LDW B-CS	630	IVE
1	EA	THRESHOLD	BY WOOD FLOOR INSTALLER		B/O
2	EA	SILENCER	SR64	GRY	IVE

NOTE: VERIFY/COORDINATE PREPS ON EXISTING DOORS AND FRAMES. PROVIDE CORRECT STRIKES, FIELD MODIFICATIONS AND/OR FILLERS TO EXISTING DOORS AND FRAMES AS NECESSARY TO ACCEPT NEW SPECIFIED HARDWARE AND COVER EXPOSED HOLES.

DOORS AND TRANSOM TO BE RABBETED.





For use on Door #(s): B-124C

Provide each OPENING with the following:

QTY		DESCRIPTION	CATALOG NUMBER	FINISH	MFR
6	EA	HINGE	5BB1 4.5 X 4.5 (NRP AS REQ'D)	652	IVE
2	EA	MORTISE CYLINDER	1E74	626	BES
1	EA	PANIC HARDWARE	CDSI-9827-DT-LBR	626	VON
1	EA	PANIC HARDWARE	CDSI-9827-NL-LBR	626	VON
2	EA	STRIKE	260U	626	VON
1	EA	RIM CYLINDER	1E72	626	BES
1	EA	SURFACE CLOSER	4040XP HCUSH	689	LCN
1	EA	SURFACE CLOSER	4040XP RW/PA	689	LCN
2	EA	PA FLUSH PANEL ADAPTER	4040XP-419 SRT	689	LCN
2	EA	KICK PLATE	8400 10" X 1" LDW B-CS	630	IVE
1	EA	WALL STOP/HOLDER	WS45	626	IVE
2	EA	SILENCER	SR64	GRY	IVE

NOTE: VERIFY/COORDINATE PREPS ON EXISTING DOORS AND FRAMES. PROVIDE CORRECT STRIKES, FIELD MODIFICATIONS AND/OR FILLERS TO EXISTING DOORS AND FRAMES AS NECESSARY TO ACCEPT NEW SPECIFIED HARDWARE AND COVER EXPOSED HOLES.

DOORS AND TRANSOM TO BE RABBETED.



For use on Door #(s): B-124B

Provide each OPENING with the following:

QTY		DESCRIPTION	CATALOG NUMBER	FINISH	MFR
6	EA	HINGE	5BB1 4.5 X 4.5 (NRP AS REQ'D)	652	IVE
2	EA	MORTISE CYLINDER	1E74	626	BES
1	EA	PANIC HARDWARE	CDSI-9827-DT-LBR	626	VON
1	EA	PANIC HARDWARE	CDSI-9827-NL-LBR	626	VON
2	EA	STRIKE	260U	626	VON
1	EA	RIM CYLINDER	1E72	626	BES
1	EA	SURFACE CLOSER	4040XP EDA (MOUNT CLOSER TO ALLOW DOOR TO SWING 180 DEGRESS)	689	LCN
1	EA	SURFACE CLOSER	4040XP HCUSH	689	LCN
2	EA	PA FLUSH PANEL ADAPTER	4040XP-419 SRT	689	LCN
2	EA	KICK PLATE	8400 10" X 1" LDW B-CS	630	IVE
1	EA	WALL STOP/HOLDER	WS45	626	IVE
2	EA	SILENCER	SR64	GRY	IVE

DOORS AND TRANSOM TO BE RABBETED.



For use on Door #(s): C-102A

Provide each OPENING with the following:

QTY		DESCRIPTION	CATALOG NUMBER	FINISH	MFR
6	EA	HINGE	5BB1HW 5 X 4.5 (NRP AS REQ'D)	652	IVE
2	EA	MORTISE CYLINDER	1E74	626	BES
1	EA	PANIC HARDWARE	CDSI-9827-DT-LBR	626	VON
1	EA	PANIC HARDWARE	CDSI-9827-NL-LBR	626	VON
2	EA	STRIKE	260U	626	VON
1	EA	RIM CYLINDER	1E72	626	BES
1	EA	SURFACE CLOSER	4040XP EDA (MOUNT CLOSER TO ALLOW DOOR TO SWING 180 DEGREES)	689	LCN
1	EA	SURFACE CLOSER	4040XP SHCUSH	689	LCN
2	EA	PA FLUSH PANEL ADAPTER	4040XP-419 SRT	689	LCN
2	EA	KICK PLATE	8400 10" X 1" LDW B-CS	630	IVE
1	EA	WALL STOP/HOLDER	WS45	626	IVE
2	EA	SILENCER	SR64	GRY	IVE

DOORS AND TRANSOM TO BE RABBETED.

HARDWARE GROUP NO. 63

Provide each OPENING with the following:

QTY		DESCRIPTION	CATALOG NUMBER	FINISH	MFR
6	EA	HINGE	5BB1HW 5 X 4.5 (NRP AS REQ'D)	652	IVE
2	EA	MORTISE CYLINDER	1E74	626	BES
1	EA	PANIC HARDWARE	CDSI-9827-DT-LBR	626	VON
1	EA	PANIC HARDWARE	CDSI-9827-NL-LBR	626	VON
2	EA	STRIKE	260U	626	VON
1	EA	RIM CYLINDER	1E72	626	BES
2	EA	SURFACE CLOSER	4040XP SHCUSH	689	LCN
2	EA	PA FLUSH PANEL ADAPTER	4040XP-419 SRT	689	LCN
2	EA	KICK PLATE	8400 10" X 1" LDW B-CS	630	IVE
2	EA	SILENCER	SR64	GRY	IVE

DOORS AND TRANSOM TO BE RABBETED.

HARDWARE GROUP NO. 64 - NOT USED



For use on Door #(s):

C-145A C-146A C-146B

Provide each OPENING with the following:

QTY		DESCRIPTION	CATALOG NUMBER	FINISH	MFR
3	EA	HINGE	5BB1 4.5 X 4.5 (NRP AS REQ'D)	652	IVE
1	EA	MORTISE CYLINDER	1E74	626	BES
1	EA	PANIC HARDWARE	CDSI-98-L-NL-17	626	VON
1	EA	RIM CYLINDER	1E72	626	BES
1	EA	SURFACE CLOSER	4040XP RW/PA	689	LCN
1	EA	PA FLUSH PANEL ADAPTER	4040XP-419 SRT	689	LCN
1	EA	KICK PLATE	8400 10" X 2" LDW B-CS	630	IVE
1	EA	WALL STOP/HOLDER	WS45	626	IVE
3	EA	SILENCER	SR64	GRY	IVE

HARDWARE GROUP NO. 66

For use on Door #(s):

B-138A

Provide each OPENING with the following:

QTY		DESCRIPTION	CATALOG NUMBER	FINISH	MFR
3	EA	HINGE	5BB1 4.5 X 4.5 (NRP AS REQ'D)	652	IVE
2	EA	MORTISE CYLINDER	1E74	626	BES
1	EA	PANIC HARDWARE	CDSI-9875-NL	626	VON
1	EA	SURFACE CLOSER	4040XP RW/PA	689	LCN
1	EA	PA FLUSH PANEL ADAPTER	4040XP-419 SRT	689	LCN
1	EA	KICK PLATE	8400 10" X 1 1/2" LDW B-CS	630	IVE
1	EA	WALL STOP	WS401/402CVX	626	IVE
2	EA	GASKETING	119WB PSA	В	ZER
1	EA	GASKETING	870AA	AA	ZER
1	EA	DOOR BOTTOM	364AA	AA	ZER
1	EA	THRESHOLD	564A	Α	ZER
1	EA	MOUNTING BRACKET	870SPB		ZER



For use on Door #(s): B-143C B-143D

Provide each OPENING with the following:

QTY		DESCRIPTION	CATALOG NUMBER	FINISH	MFR
2	EA	CONT. HINGE	224HD	628	IVE
1	EA	REMOVABLE MULLION	KR4954 STAB	689	VON
3	EA	MORTISE CYLINDER	1E74	626	BES
1	EA	PANIC HARDWARE	CD-98-EO	626	VON
1	EA	PANIC HARDWARE	CD-98-NL-OP-110MD	626	VON
1	EA	RIM CYLINDER	1E72	626	BES
2	EA	90 DEG OFFSET PULL	8190HD 12" O	630	IVE
2	EA	SURFACE CLOSER	4040XP SCUSH	689	LCN
2	EA	PA MOUNTING PLATE	4040XP-18PA AS REQ'D	689	LCN
2	EA	CUSH SHOE SUPPORT	4040XP-30 AS REQ'D	689	LCN
2	EA	BLADE STOP SPACER	4040XP-61 AS REQ'D	689	LCN
1	EA	RAIN DRIP	142AA	AA	ZER
1	EA	MULLION SEAL	8780NBK	BK	ZER
1	EA	WEATHER STRIPPING	By Door/Frame Manufacturer		
1	EA	THRESHOLD	BY WOOD FLOOR INSTALLER		B/O
2	EA	DOOR SWEEP	8192AA	AA	ZER

HARDWARE GROUP NO. 68

For use on Door #(s):

A-103B A-108B A-132B B-121B B-146B

Provide each OPENING with the following:

QTY DESCRIPTION CATALOG NUMBER FINISH MFR

EA NOTE NO HARDWARE REQUIRED

(BORROWED LITE)

HARDWARE GROUP NO. 69

Provide each OPENING with the following:

QTY DESCRIPTION CATALOG NUMBER FINISH MFR

1 EA CYLINDER RIM/MORTISE CYLINDER AS REQ'D 626 BES

NOTE BALANCE OF HARDWARE BY DOOR

MFG



HARDWARE GROUP NO. ALT-06

For use on Door #(s):

A-119A A-120A A-124A A-125A

Provide each OPENING with the following:

QTY		DESCRIPTION	CATALOG NUMBER	FINISH	MFR
3	EA	HINGE	5BB1 4.5 X 4.5 (NRP AS REQ'D)	652	IVE
1	EA	PRIVACY SET	45H 0 L 14S VIN	626	BES
1	EA	WALL STOP	WS401/402CVX	626	IVE
1	EA	GASKETING	488SCL PSA	CL	ZER

NOTE: VERIFY/COORDINATE PREPS ON EXISTING DOORS AND FRAMES. PROVIDE CORRECT STRIKES, FIELD MODIFICATIONS AND/OR FILLERS TO EXISTING DOORS AND FRAMES AS NECESSARY TO ACCEPT NEW SPECIFIED HARDWARE AND COVER EXPOSED HOLES.

HARDWARE GROUP NO. ALT-14

For use on Door #(s):

A-122A

Provide each OPENING with the following:

QTY		DESCRIPTION	CATALOG NUMBER	FINISH	MFR
3	EA	HINGE	5BB1 4.5 X 4.5 (NRP AS REQ'D)	652	IVE
1	EA	CLASSROOM LOCKSET	9K7 R 14D	626	BES
1	EA	OH STOP	90\$	630	GLY
3	EA	SILENCER	SR64	GRY	IVE

NOTE: VERIFY/COORDINATE PREPS ON EXISTING DOORS AND FRAMES. PROVIDE CORRECT STRIKES, FIELD MODIFICATIONS AND/OR FILLERS TO EXISTING DOORS AND FRAMES AS NECESSARY TO ACCEPT NEW SPECIFIED HARDWARE AND COVER EXPOSED HOLES.





HARDWARE GROUP NO. ALT-20

For use on Door #(s): A-121A A-123A

Provide each OPENING with the following:

QTY		DESCRIPTION	CATALOG NUMBER	FINISH	MFR
3	EA	HINGE	5BB1 4.5 X 4.5 (NRP AS REQ'D)	652	IVE
1	EA	STOREROOM LOCKSET	9K7 D 14D	626	BES
1	EA	OH STOP	90S J	630	GLY
3	EA	SILENCER	SR64	GRY	IVE

NOTE: VERIFY/COORDINATE PREPS ON EXISTING DOORS AND FRAMES. PROVIDE CORRECT STRIKES, FIELD MODIFICATIONS AND/OR FILLERS TO EXISTING DOORS AND FRAMES AS NECESSARY TO ACCEPT NEW SPECIFIED HARDWARE AND COVER EXPOSED HOLES.

HARDWARE GROUP NO. ALT-23

For use on Door #(s):

B-132A

Provide each OPENING with the following:

QTY		DESCRIPTION	CATALOG NUMBER	FINISH	MFR
3	EA	HINGE	5BB1HW 4.5 X 4.5 (NRP AS REQ'D)	652	IVE
1	EA	STOREROOM LOCKSET	9K7 D 14D	626	BES
1	EA	WALL STOP	WS401/402CVX	626	IVE
3	EA	SILENCER	SR64	GRY	IVE

NOTE: VERIFY/COORDINATE PREPS ON EXISTING DOORS AND FRAMES. PROVIDE CORRECT STRIKES, FIELD MODIFICATIONS AND/OR FILLERS TO EXISTING DOORS AND FRAMES AS NECESSARY TO ACCEPT NEW SPECIFIED HARDWARE AND COVER EXPOSED HOLES.



For use on Door #(s):

B-122A	C-103B	C-104B	C-105A	C-106B	C-107A
C-109B	C-110A	C-111B	C-112A	C-113B	C-114A
C-117B	C-121B	C-124A			

Provide each OPENING with the following:

QTY		DESCRIPTION	CATALOG NUMBER	FINISH	MFR
3	EA	HINGE	5BB1 4.5 X 4.5 (NRP AS REQ'D)	652	IVE
1	EA	STOREROOM LOCKSET	9K7 D 14D	626	BES
1	EA	OH STOP & HOLDER	90H J	630	GLY
1	EA	SURFACE CLOSER	4040XP RW/PA	689	LCN
1	EA	KICK PLATE	8400 10" X 1 1/2" LDW B-CS	630	IVE
3	EA	SILENCER	SR64	GRY	IVE

NOTE: VERIFY/COORDINATE PREPS ON EXISTING DOORS AND FRAMES. PROVIDE CORRECT STRIKES, FIELD MODIFICATIONS AND/OR FILLERS TO EXISTING DOORS AND FRAMES AS NECESSARY TO ACCEPT NEW SPECIFIED HARDWARE AND COVER EXPOSED HOLES.

HARDWARE GROUP NO. ALT-28

For use on Door #(s): B-125B

Provide each OPENING with the following:

QTY		DESCRIPTION	CATALOG NUMBER	FINISH	MFR
3	EA	HINGE	5BB1 4.5 X 4.5 (NRP AS REQ'D)	652	IVE
1	EA	STOREROOM LOCKSET	9K7 D 14D	626	BES
1	EA	SURFACE CLOSER	4040XP RW/PA	689	LCN
1	EA	KICK PLATE	8400 10" X 1 1/2" LDW B-CS	630	IVE
1	EA	WALL STOP	WS401/402CVX	626	IVE
3	EA	SILENCER	SR64	GRY	IVE

NOTE: VERIFY/COORDINATE PREPS ON EXISTING DOORS AND FRAMES. PROVIDE CORRECT STRIKES, FIELD MODIFICATIONS AND/OR FILLERS TO EXISTING DOORS AND FRAMES AS NECESSARY TO ACCEPT NEW SPECIFIED HARDWARE AND COVER EXPOSED HOLES.

HARDWARE GROUP NO. ALT-29 - NOT USED



For use on Door #(s): A-117A A-126A

Provide each OPENING with the following:

QTY		DESCRIPTION	CATALOG NUMBER	FINISH	MFR
3	EA	HINGE	5BB1 4.5 X 4.5 (NRP AS REQ'D)	652	IVE
1	EA	STOREROOM LOCKSET	9K7 D 14D	626	BES
1	EA	SURFACE CLOSER	4040XP RW/PA	689	LCN
1	EA	PA FLUSH PANEL ADAPTER	4040XP-419 SRT	689	LCN
1	EA	KICK PLATE	8400 10" X 1 1/2" LDW B-CS	630	IVE
1	EA	WALL STOP/HOLDER	WS45	626	IVE
3	EA	SILENCER	SR64	GRY	IVE

NOTE: VERIFY/COORDINATE PREPS ON EXISTING DOORS AND FRAMES. PROVIDE CORRECT STRIKES, FIELD MODIFICATIONS AND/OR FILLERS TO EXISTING DOORS AND FRAMES AS NECESSARY TO ACCEPT NEW SPECIFIED HARDWARE AND COVER EXPOSED HOLES.

HARDWARE GROUP NO. ALT-34

For use on Door #(s): B-129B

Provide each OPENING with the following:

QTY		DESCRIPTION	CATALOG NUMBER	FINISH	MFR
6	EA	HINGE	5BB1 4.5 X 4.5 (NRP AS REQ'D)	652	IVE
1	EA	CONST LATCHING BOLT	FB51T/FB61T AS REQ'D	630	IVE
1	EA	STOREROOM LOCKSET	9K7 D 14D	626	BES
2	EA	OH STOP	90S J	630	GLY
2	EA	SILENCER	SR64	GRY	IVE

NOTE: VERIFY/COORDINATE PREPS ON EXISTING DOORS AND FRAMES. PROVIDE CORRECT STRIKES, FIELD MODIFICATIONS AND/OR FILLERS TO EXISTING DOORS AND FRAMES AS NECESSARY TO ACCEPT NEW SPECIFIED HARDWARE AND COVER EXPOSED HOLES.

DOORS AND TRANSOM TO BE RABBETED.





For use on Door #(s):

C-103A C-104A C-106A C-109A C-111A C-113A C-117A C-121A D-112B D-116B D-120B D-126B

D-128B

Provide each OPENING with the following:

QTY		DESCRIPTION	CATALOG NUMBER	FINISH	MFR
3	EA	HINGE	5BB1 4.5 X 4.5 (NRP AS REQ'D)	652	IVE
1	EA	COMMUNICATING LOCK	9K7 W 14D	626	BES
1	EA	OH STOP & HOLDER	90H	630	GLY
3	EA	SILENCER	SR64	GRY	IVE

HARDWARE GROUP NO. ALT-40

For use on Door #(s):

D-111B D-117B D-119B

Provide each OPENING with the following:

QTY		DESCRIPTION	CATALOG NUMBER	FINISH	MFR
3	EA	HINGE	5BB1 4.5 X 4.5 (NRP AS REQ'D)	652	IVE
1	EA	COMMUNICATING LOCK	9K7 W 14D	626	BES
1	EA	WALL STOP/HOLDER	WS45	626	IVE
3	EA	SILENCER	SR64	GRY	IVE

HARDWARE GROUP NO. ALT-54

FOR USE ON DOOR #(S):

B-124E

PROVIDE EACH OPENING WITH THE FOLLOWING:

<u>QTY</u>		<u>DESCRIPTION</u>	CATALOG NUMBER	<u>FINISH</u>	<u>MFR</u>
6	EA	HINGE	5BB1 4.5 X 4.5 (NRP AS REQ'D)	652	IVE
2	EA	MORTISE CYLINDER	1E74	626	BES
2	EA	PANIC HARDWARE	CDSI-9827-DT-LBR	626	VON
2	EA	STRIKE	260U AS REQ'D	626	VON
1	EA	SURFACE CLOSER	4040XP HCUSH	689	LCN
1	EA	SURFACE CLOSER	4040XP RW/PA	689	LCN
2	EA	PA FLUSH PANEL ADAPTER	4040XP-419 AS REQ'D	689	LCN
2	EA	KICK PLATE	8400 10" X 1" LDW B-CS	630	IVE
1	EA	WALL STOP/HOLDER	WS45	626	IVE
2	EA	SILENCER	SR64	GRY	IVE

NOTE: VERIFY/COORDINATE PREPS ON EXISTING DOORS AND FRAMES. PROVIDE CORRECT STRIKES, FIELD MODIFICATIONS AND/OR FILLERS TO EXISTING DOORS AND FRAMES AS NECESSARY TO ACCEPT NEW SPECIFIED HARDWARE AND COVER EXPOSED HOLES.





For use on Door #(s):

C-144A C-144B C-145B

Provide each OPENING with the following:

QTY		DESCRIPTION	CATALOG NUMBER	FINISH	MFR
6	EA	HINGE	5BB1 4.5 X 4.5 (NRP AS REQ'D)	652	IVE
2	EA	MORTISE CYLINDER	1E74	626	BES
1	EA	PANIC HARDWARE	CDSI-9827-DT-LBR	626	VON
1	EA	PANIC HARDWARE	CDSI-9827-NL-LBR	626	VON
2	EA	STRIKE	260U	626	VON
1	EA	RIM CYLINDER	1E72	626	BES
2	EA	SURFACE CLOSER	4040XP HCUSH	689	LCN
2	EA	PA FLUSH PANEL ADAPTER	4040XP-419 SRT	689	LCN
2	EA	KICK PLATE	8400 10" X 1" LDW B-CS	630	IVE
2	EA	SILENCER	SR64	GRY	IVE

NOTE: VERIFY/COORDINATE PREPS ON EXISTING DOORS AND FRAMES. PROVIDE CORRECT STRIKES, FIELD MODIFICATIONS AND/OR FILLERS TO EXISTING DOORS AND FRAMES AS NECESSARY TO ACCEPT NEW SPECIFIED HARDWARE AND COVER EXPOSED HOLES.

DOORS AND TRANSOM TO BE RABBETED.

HARDWARE GROUP NO. ALT-60

FOR USE ON DOOR #(S):

B-124D

PROVIDE EACH OPENING WITH THE FOLLOWING:

<u>QTY</u>		<u>DESCRIPTION</u>	CATALOG NUMBER	<u>FINISH</u>	<u>MFR</u>
6	EA	HINGE	5BB1 4.5 X 4.5 (NRP AS REQ'D)	652	IVE
2	EA	MORTISE CYLINDER	1E74	626	BES
1	EA	PANIC HARDWARE	CDSI-9827-DT-LBR	626	VON
1	EA	PANIC HARDWARE	CDSI-9827-NL-LBR	626	VON
2	EA	STRIKE	260U AS REQ'D	626	VON
1	EA	RIM CYLINDER	1E72	626	BES
1	EA	SURFACE CLOSER	4040XP HCUSH	689	LCN
1	EA	SURFACE CLOSER	4040XP RW/PA	689	LCN
2	EA	PA FLUSH PANEL ADAPTER	4040XP-419 AS REQ'D	689	LCN
2	EA	KICK PLATE	8400 10" X 1" LDW B-CS	630	IVE
1	EA	WALL STOP/HOLDER	WS45	626	IVE
2	EA	SILENCER	SR64	GRY	IVE

NOTE: VERIFY/COORDINATE PREPS ON EXISTING DOORS AND FRAMES. PROVIDE CORRECT STRIKES, FIELD MODIFICATIONS AND/OR FILLERS TO EXISTING DOORS AND FRAMES AS NECESSARY TO ACCEPT NEW SPECIFIED HARDWARE AND COVER EXPOSED HOLES.



FOR USE ON DOOR #(S): B-124F


PROVIDE EACH OPENING WITH THE FOLLOWING:


QTY		<u>DESCRIPTION</u>	CATALOG NUMBER	<u>FINISH</u>	<u>MFR</u>
6	EA	HINGE	5BB1 4.5 X 4.5 (NRP AS REQ'D)	652	IVE
2	EA	MORTISE CYLINDER	1E74	626	BES
1	EA	PANIC HARDWARE	CDSI-9827-DT-LBR	626	VON
1	EA	PANIC HARDWARE	CDSI-9827-NL-LBR	626	VON
2	EA	STRIKE	260U	626	VON
1	EA	RIM CYLINDER	1E72	626	BES
2	EA	SURFACE CLOSER	4040XP RW/PA	689	LCN
2	EA	PA FLUSH PANEL ADAPTER	4040XP-419 SRT	689	LCN
2	EA	KICK PLATE	8400 10" X 1" LDW B-CS	630	IVE
2	EA	WALL STOP/HOLDER	WS45	626	IVE
2	EA	SILENCER	SR64	GRY	IVE


NOTE: VERIFY/COORDINATE PREPS ON EXISTING DOORS AND FRAMES. PROVIDE CORRECT STRIKES, FIELD MODIFICATIONS AND/OR FILLERS TO EXISTING DOORS AND FRAMES AS NECESSARY TO ACCEPT NEW SPECIFIED HARDWARE AND COVER EXPOSED HOLES.


DOORS AND TRANSOM TO BE RABBETED. VERIFY AND NOTIFY ARCHITECT OF CONFLICTS.


END OF SECTION

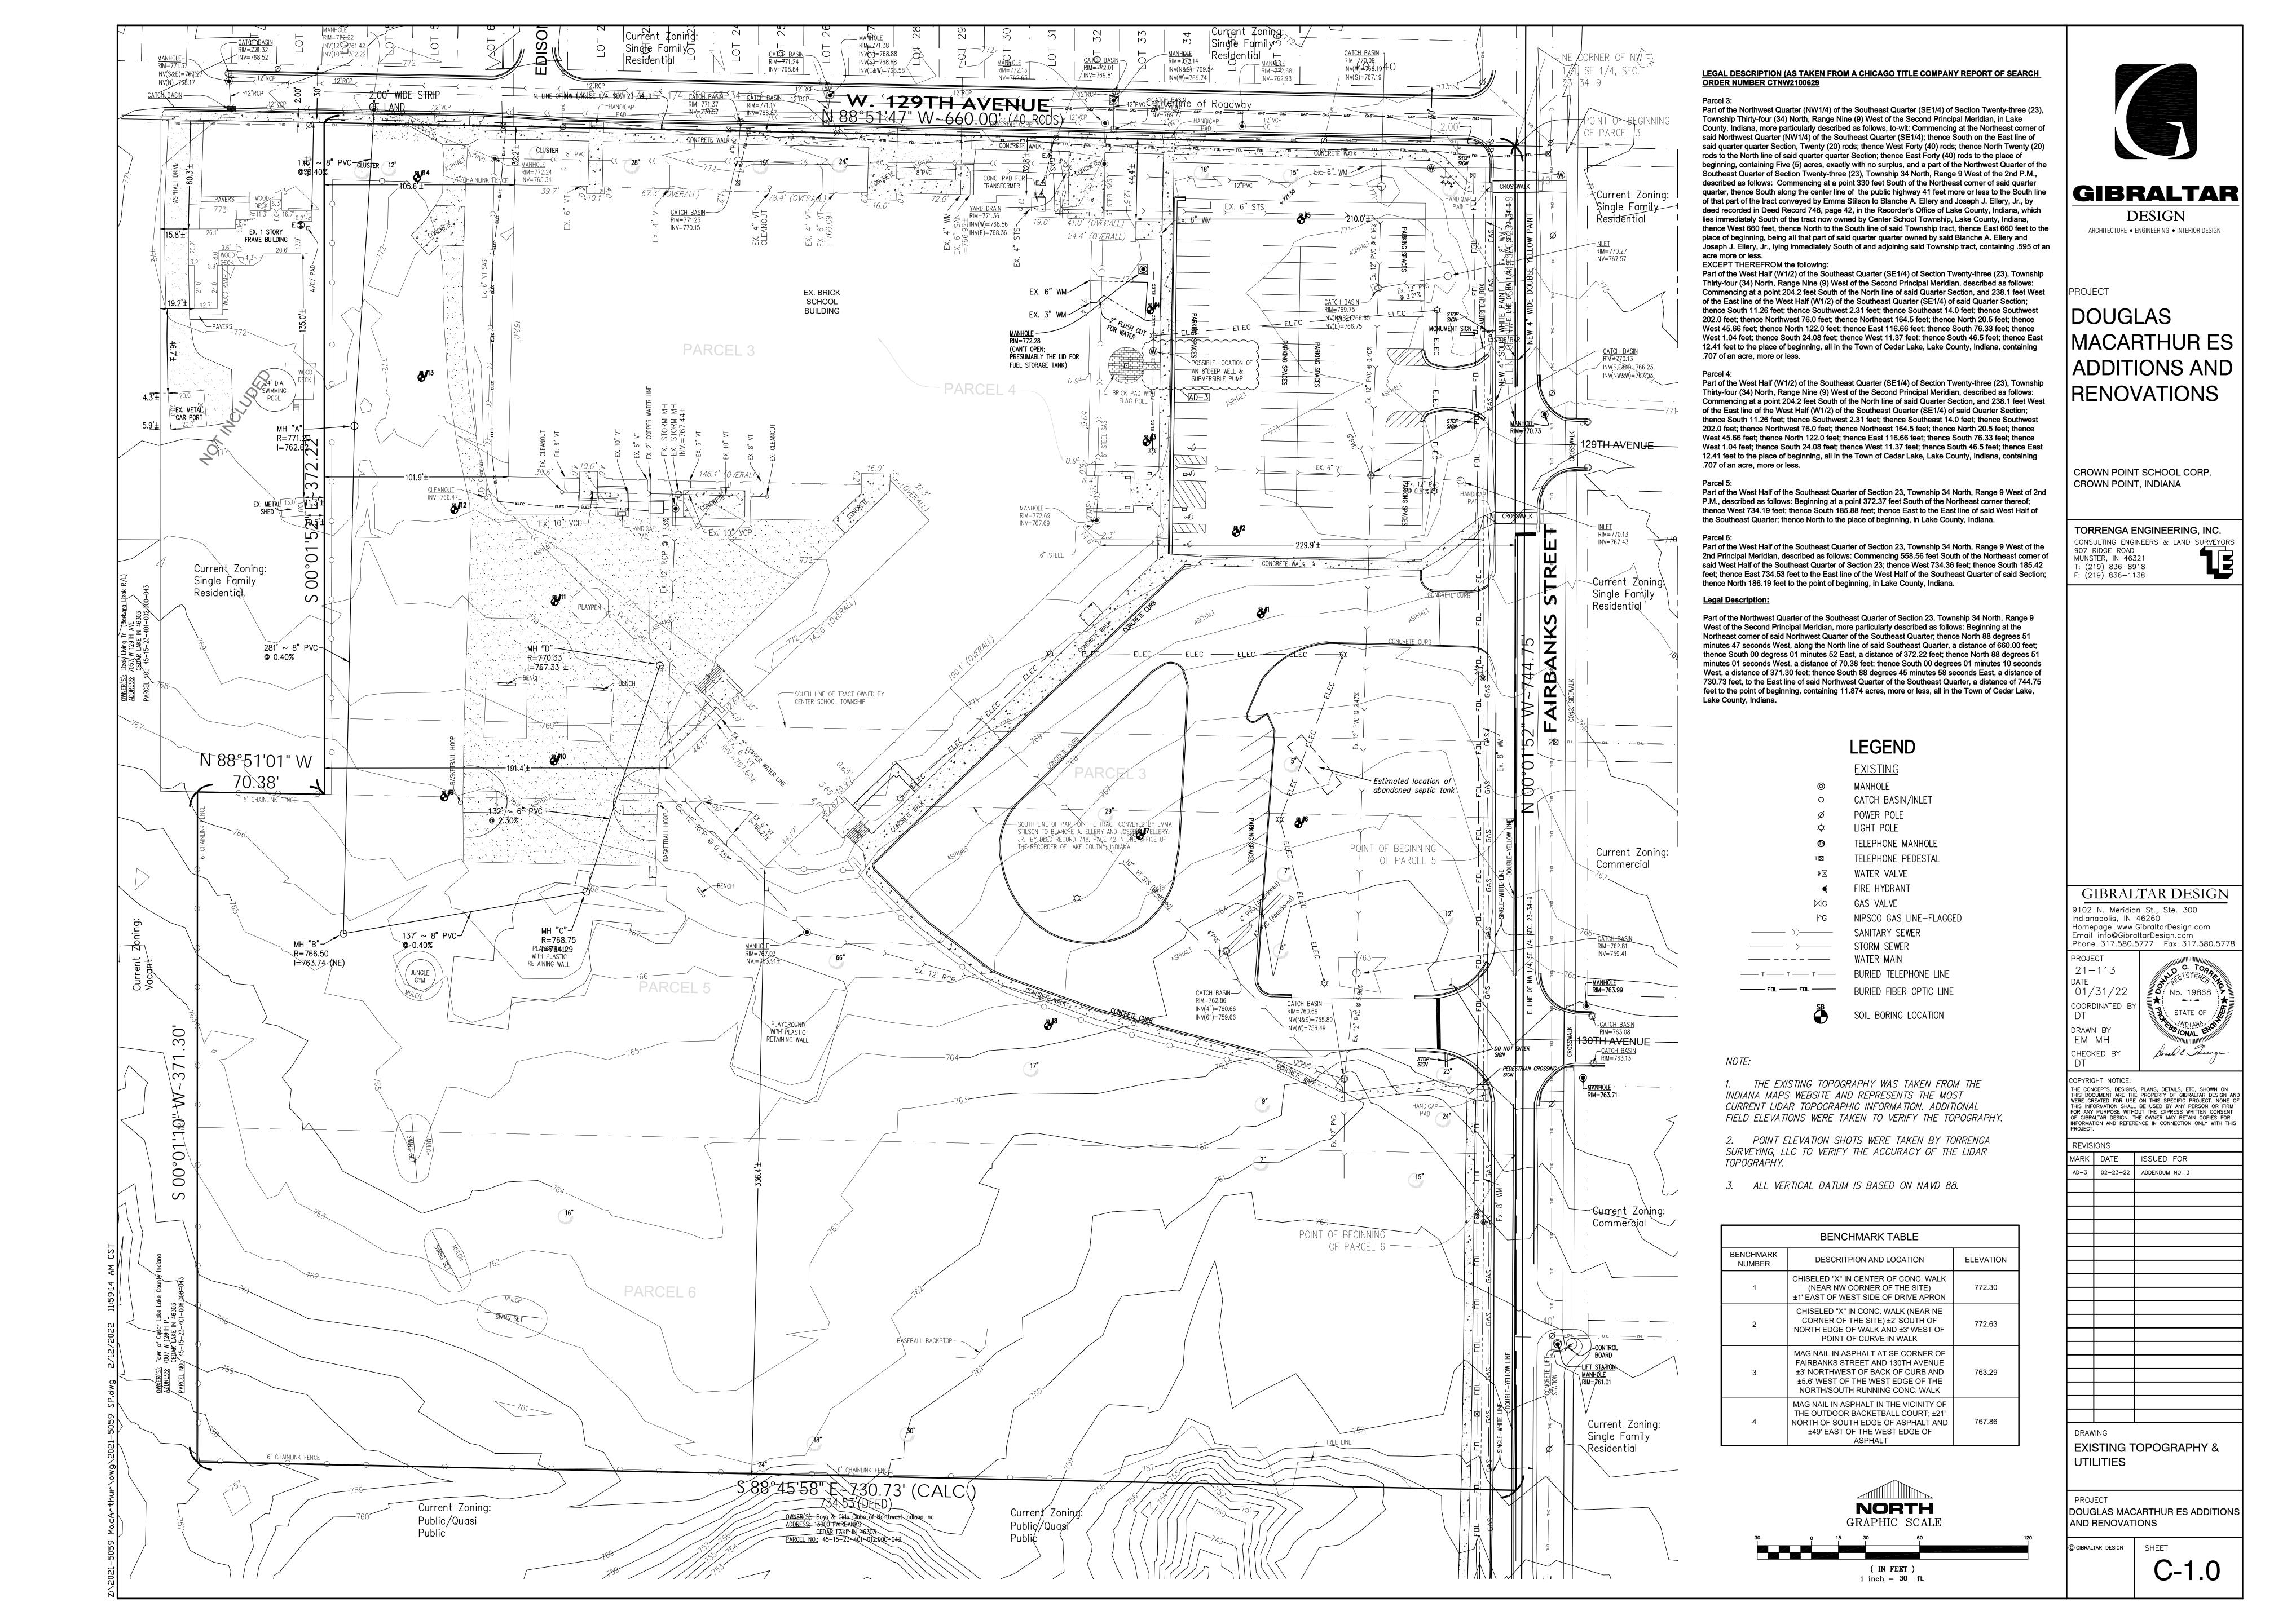


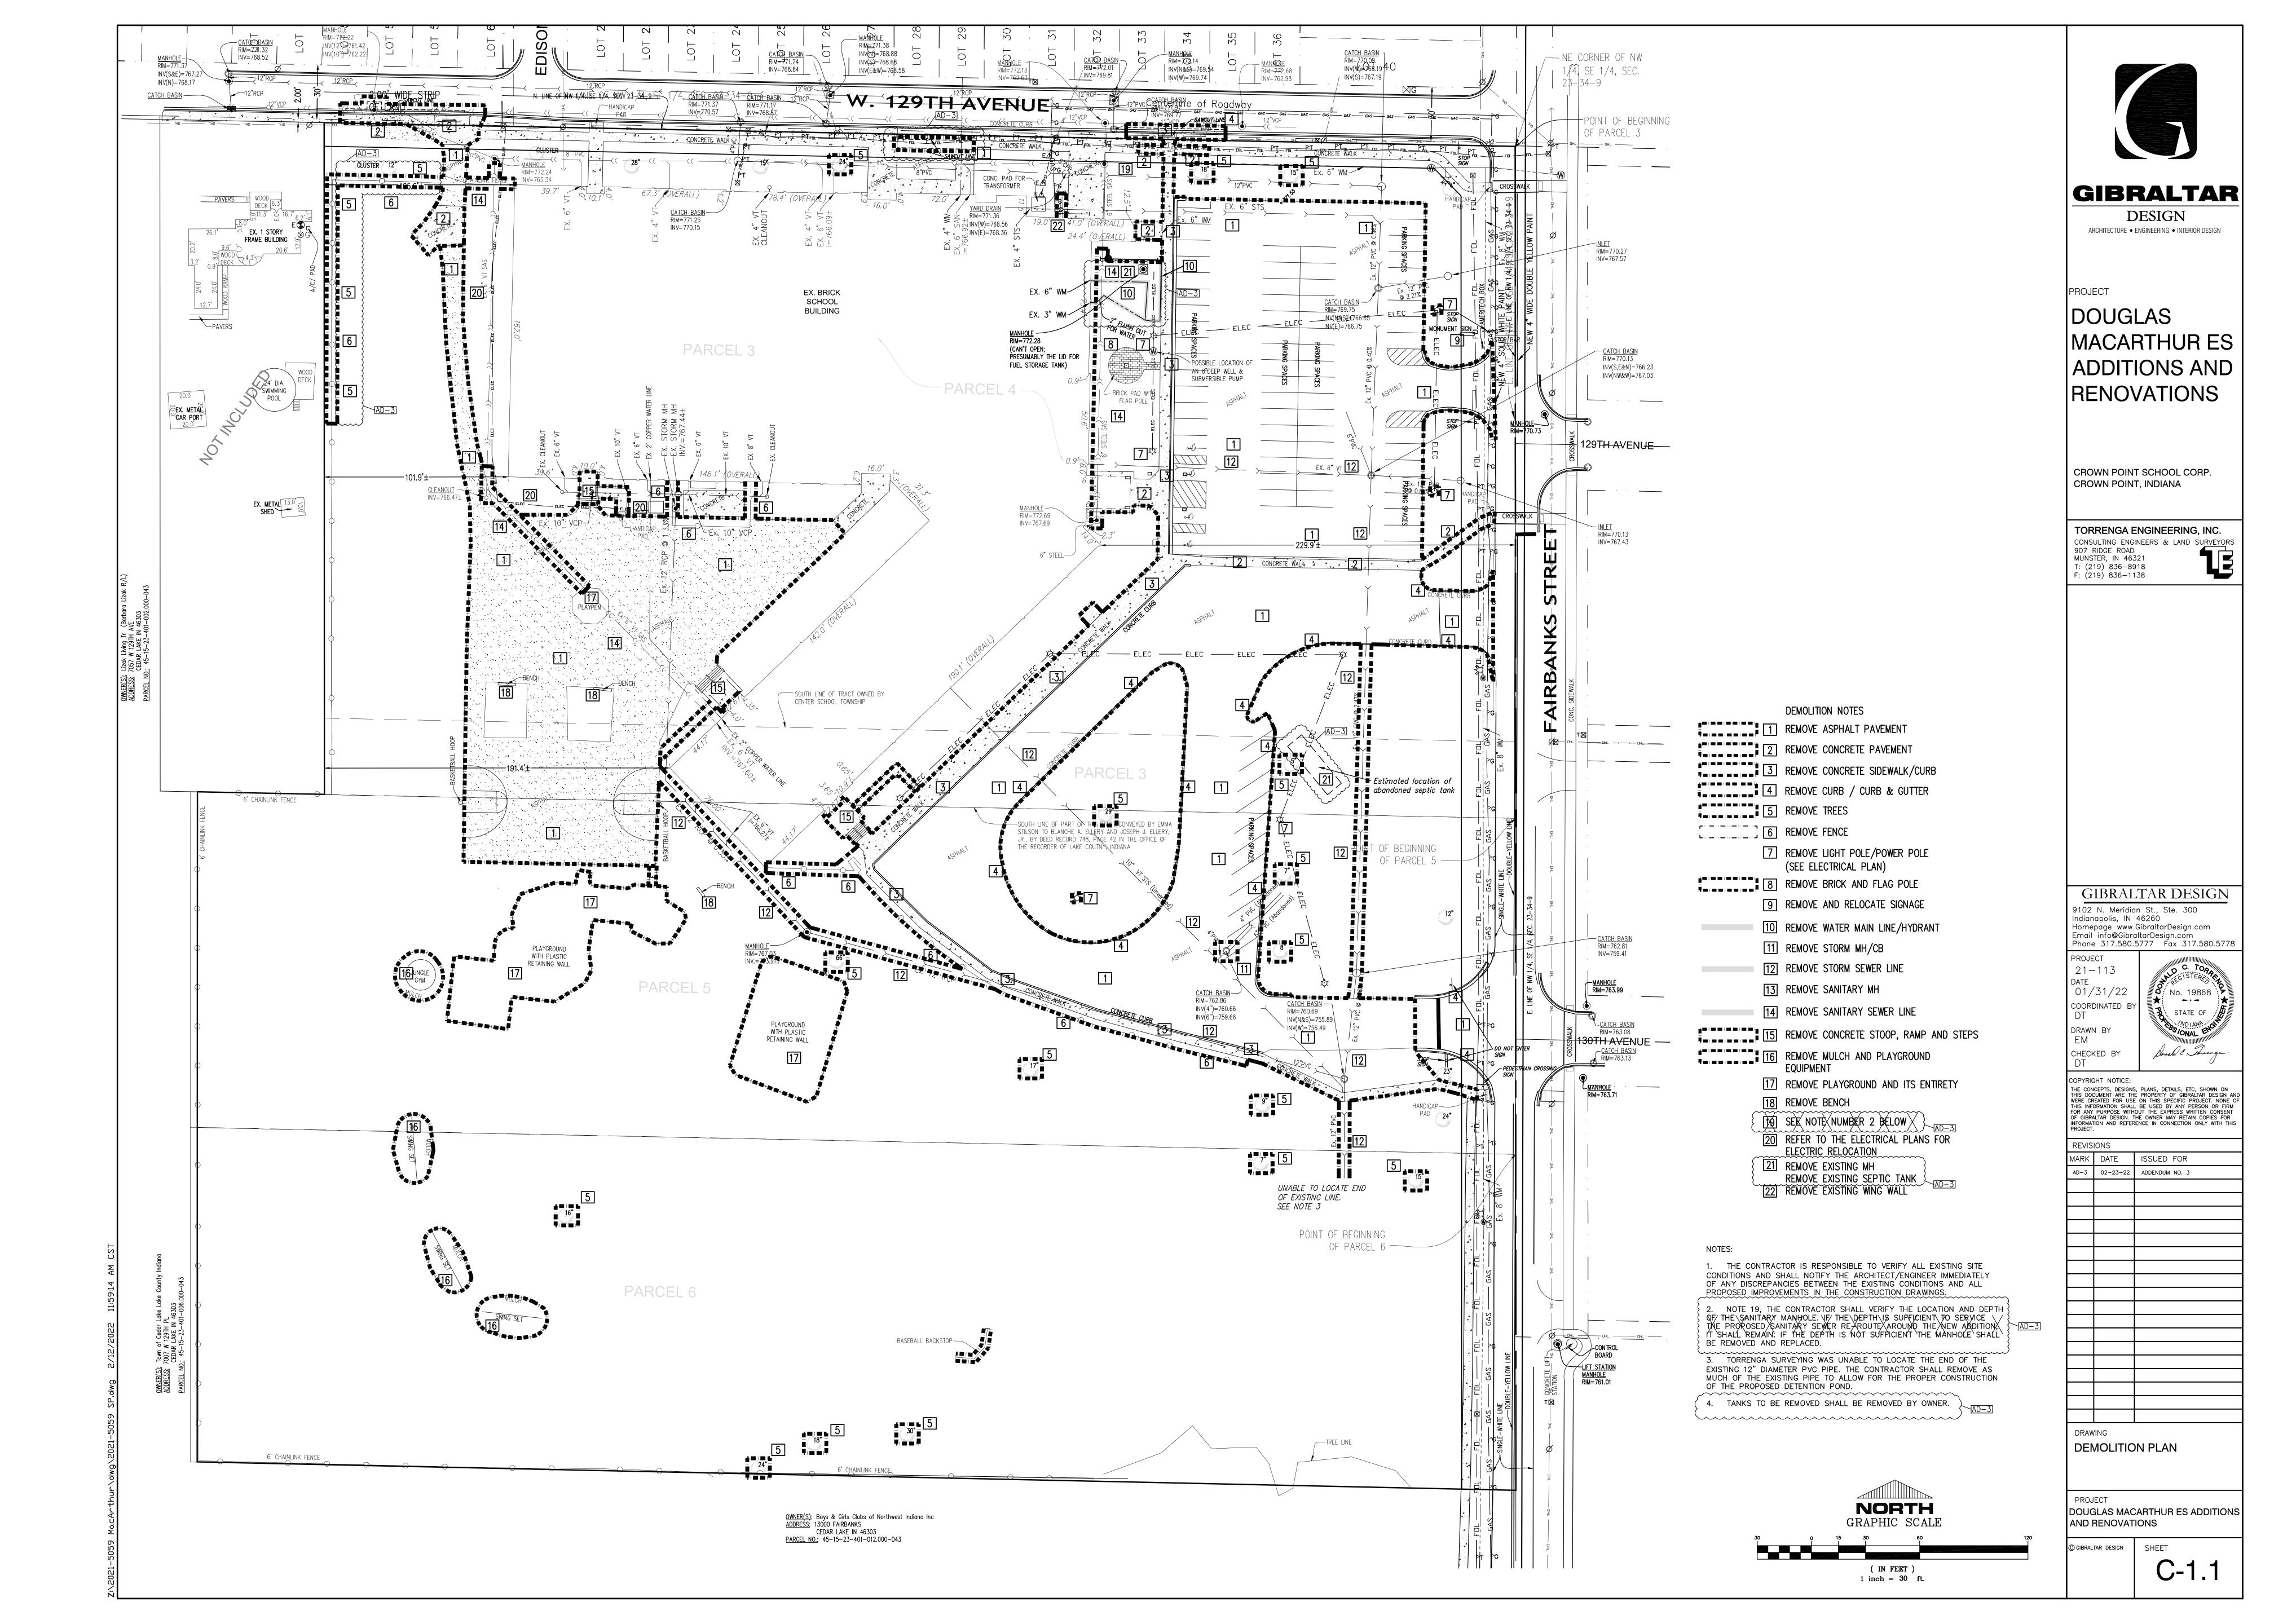

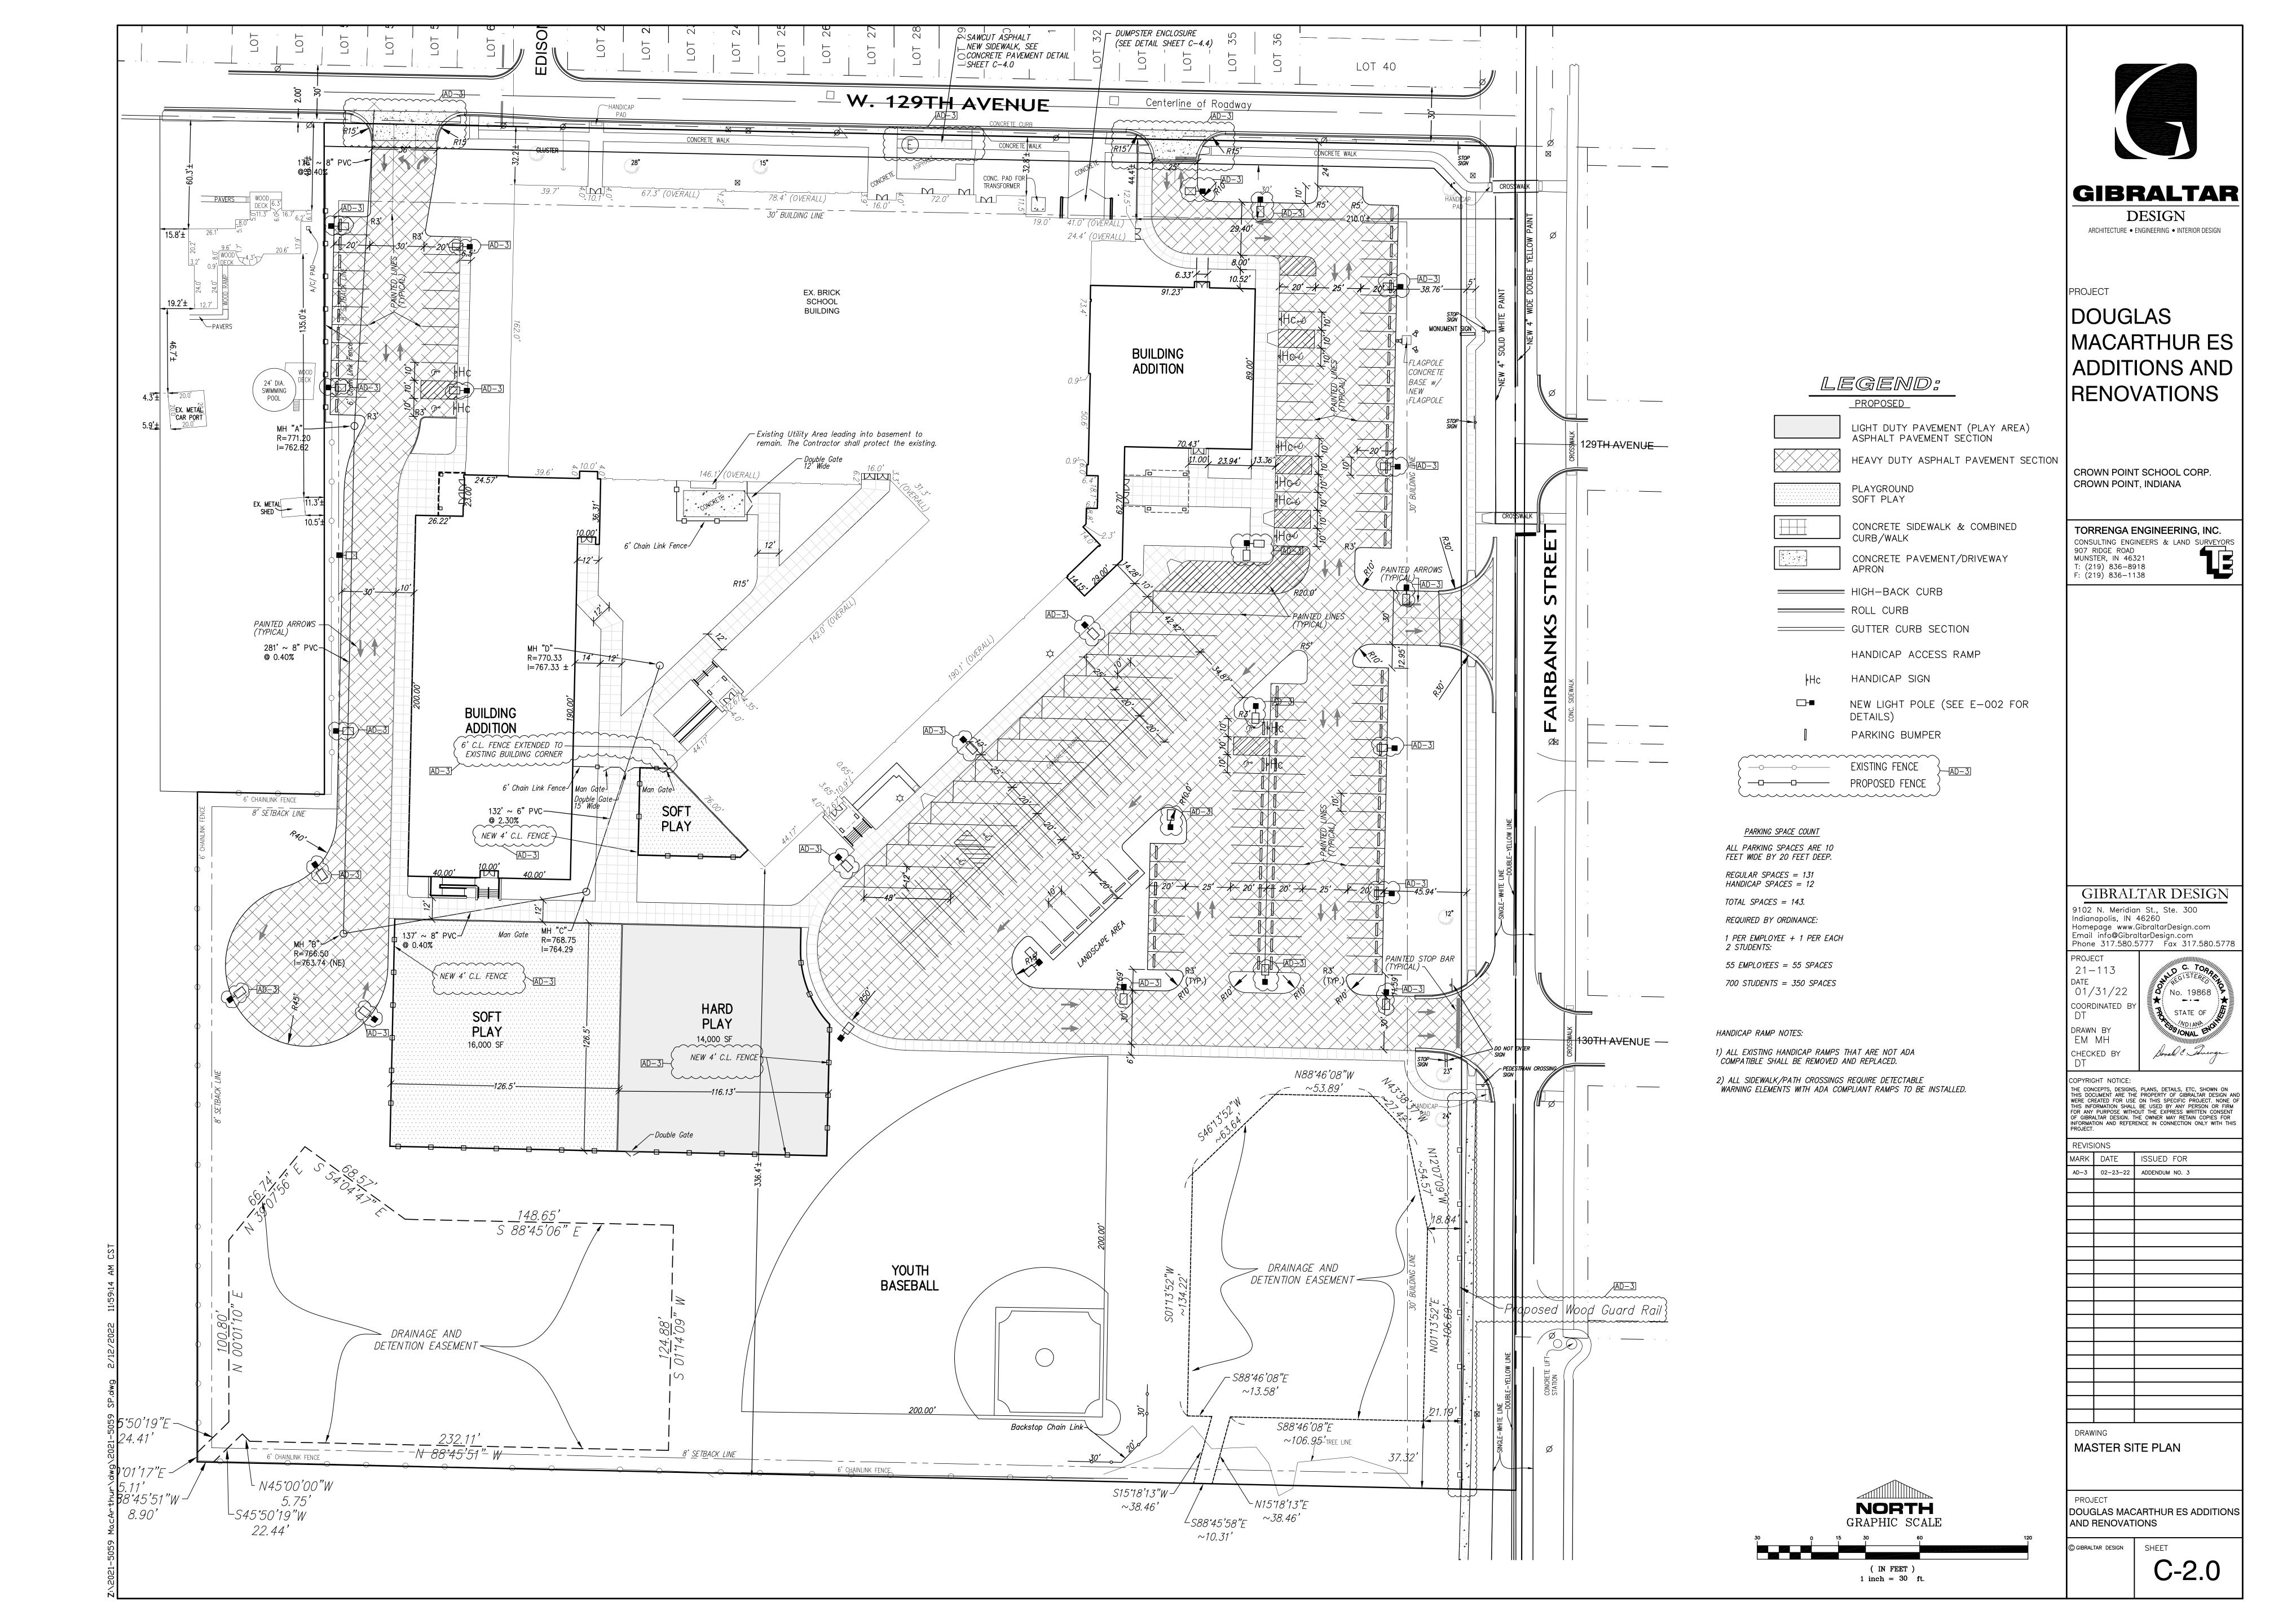

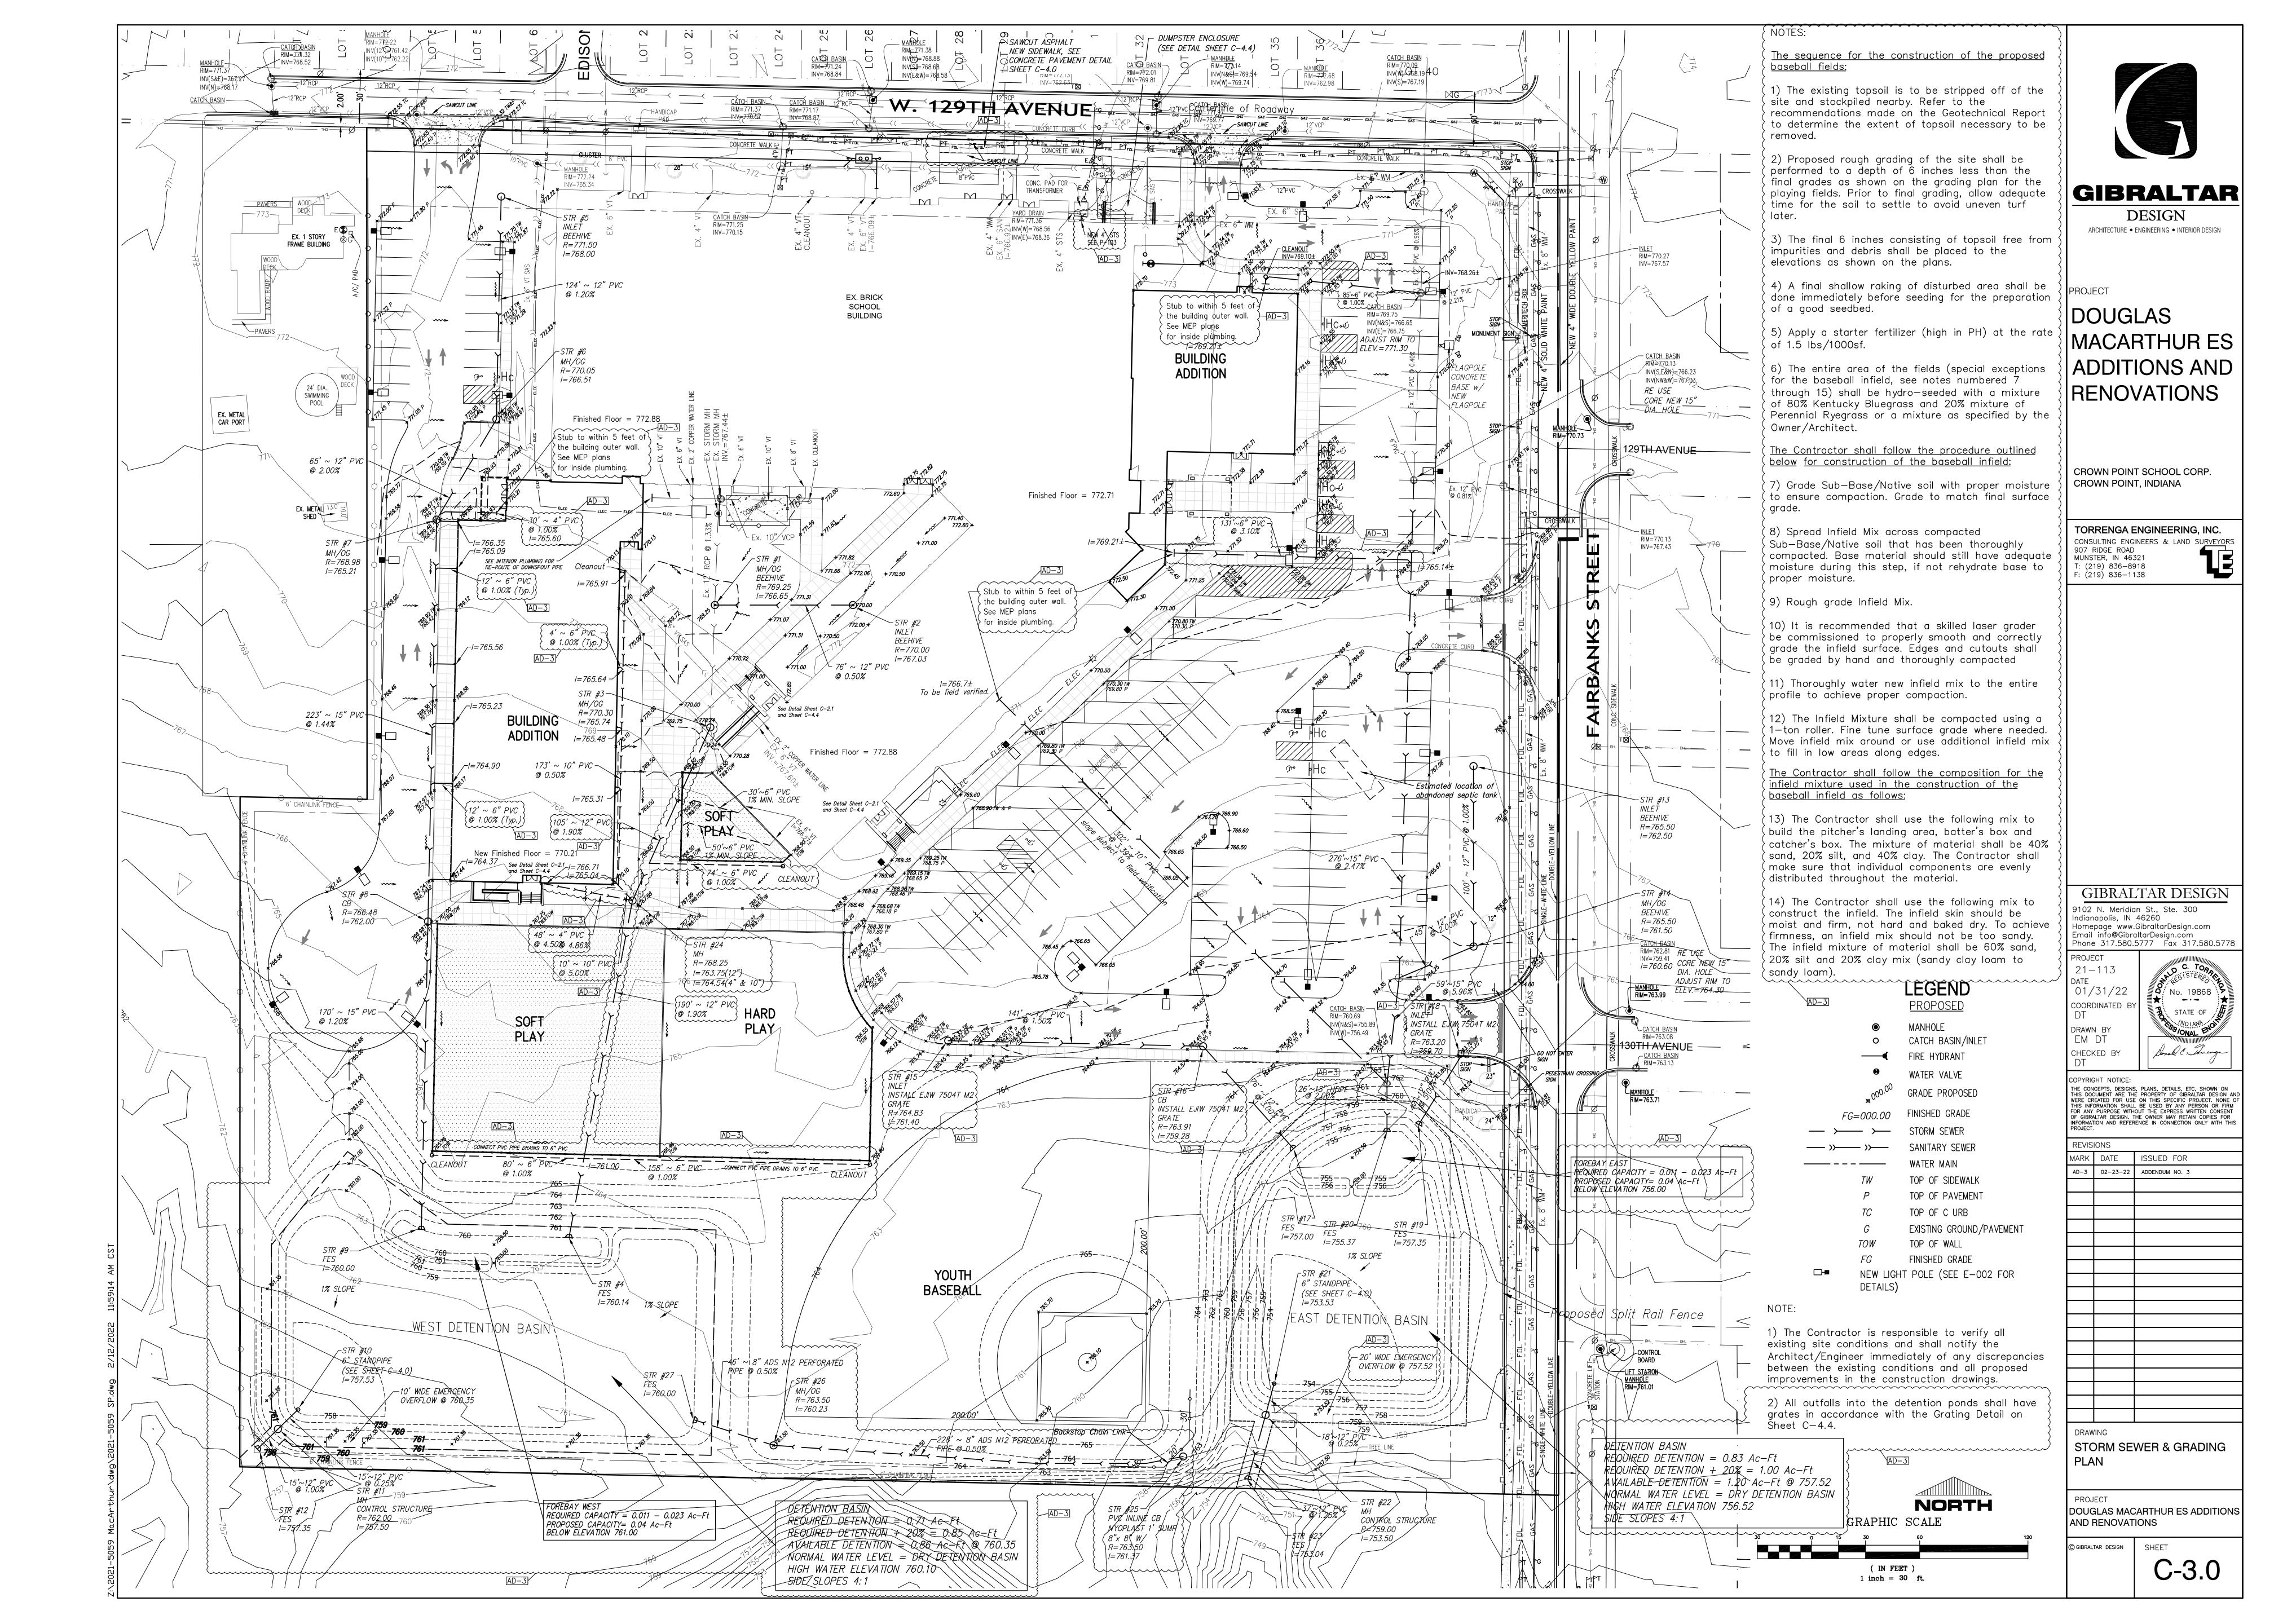

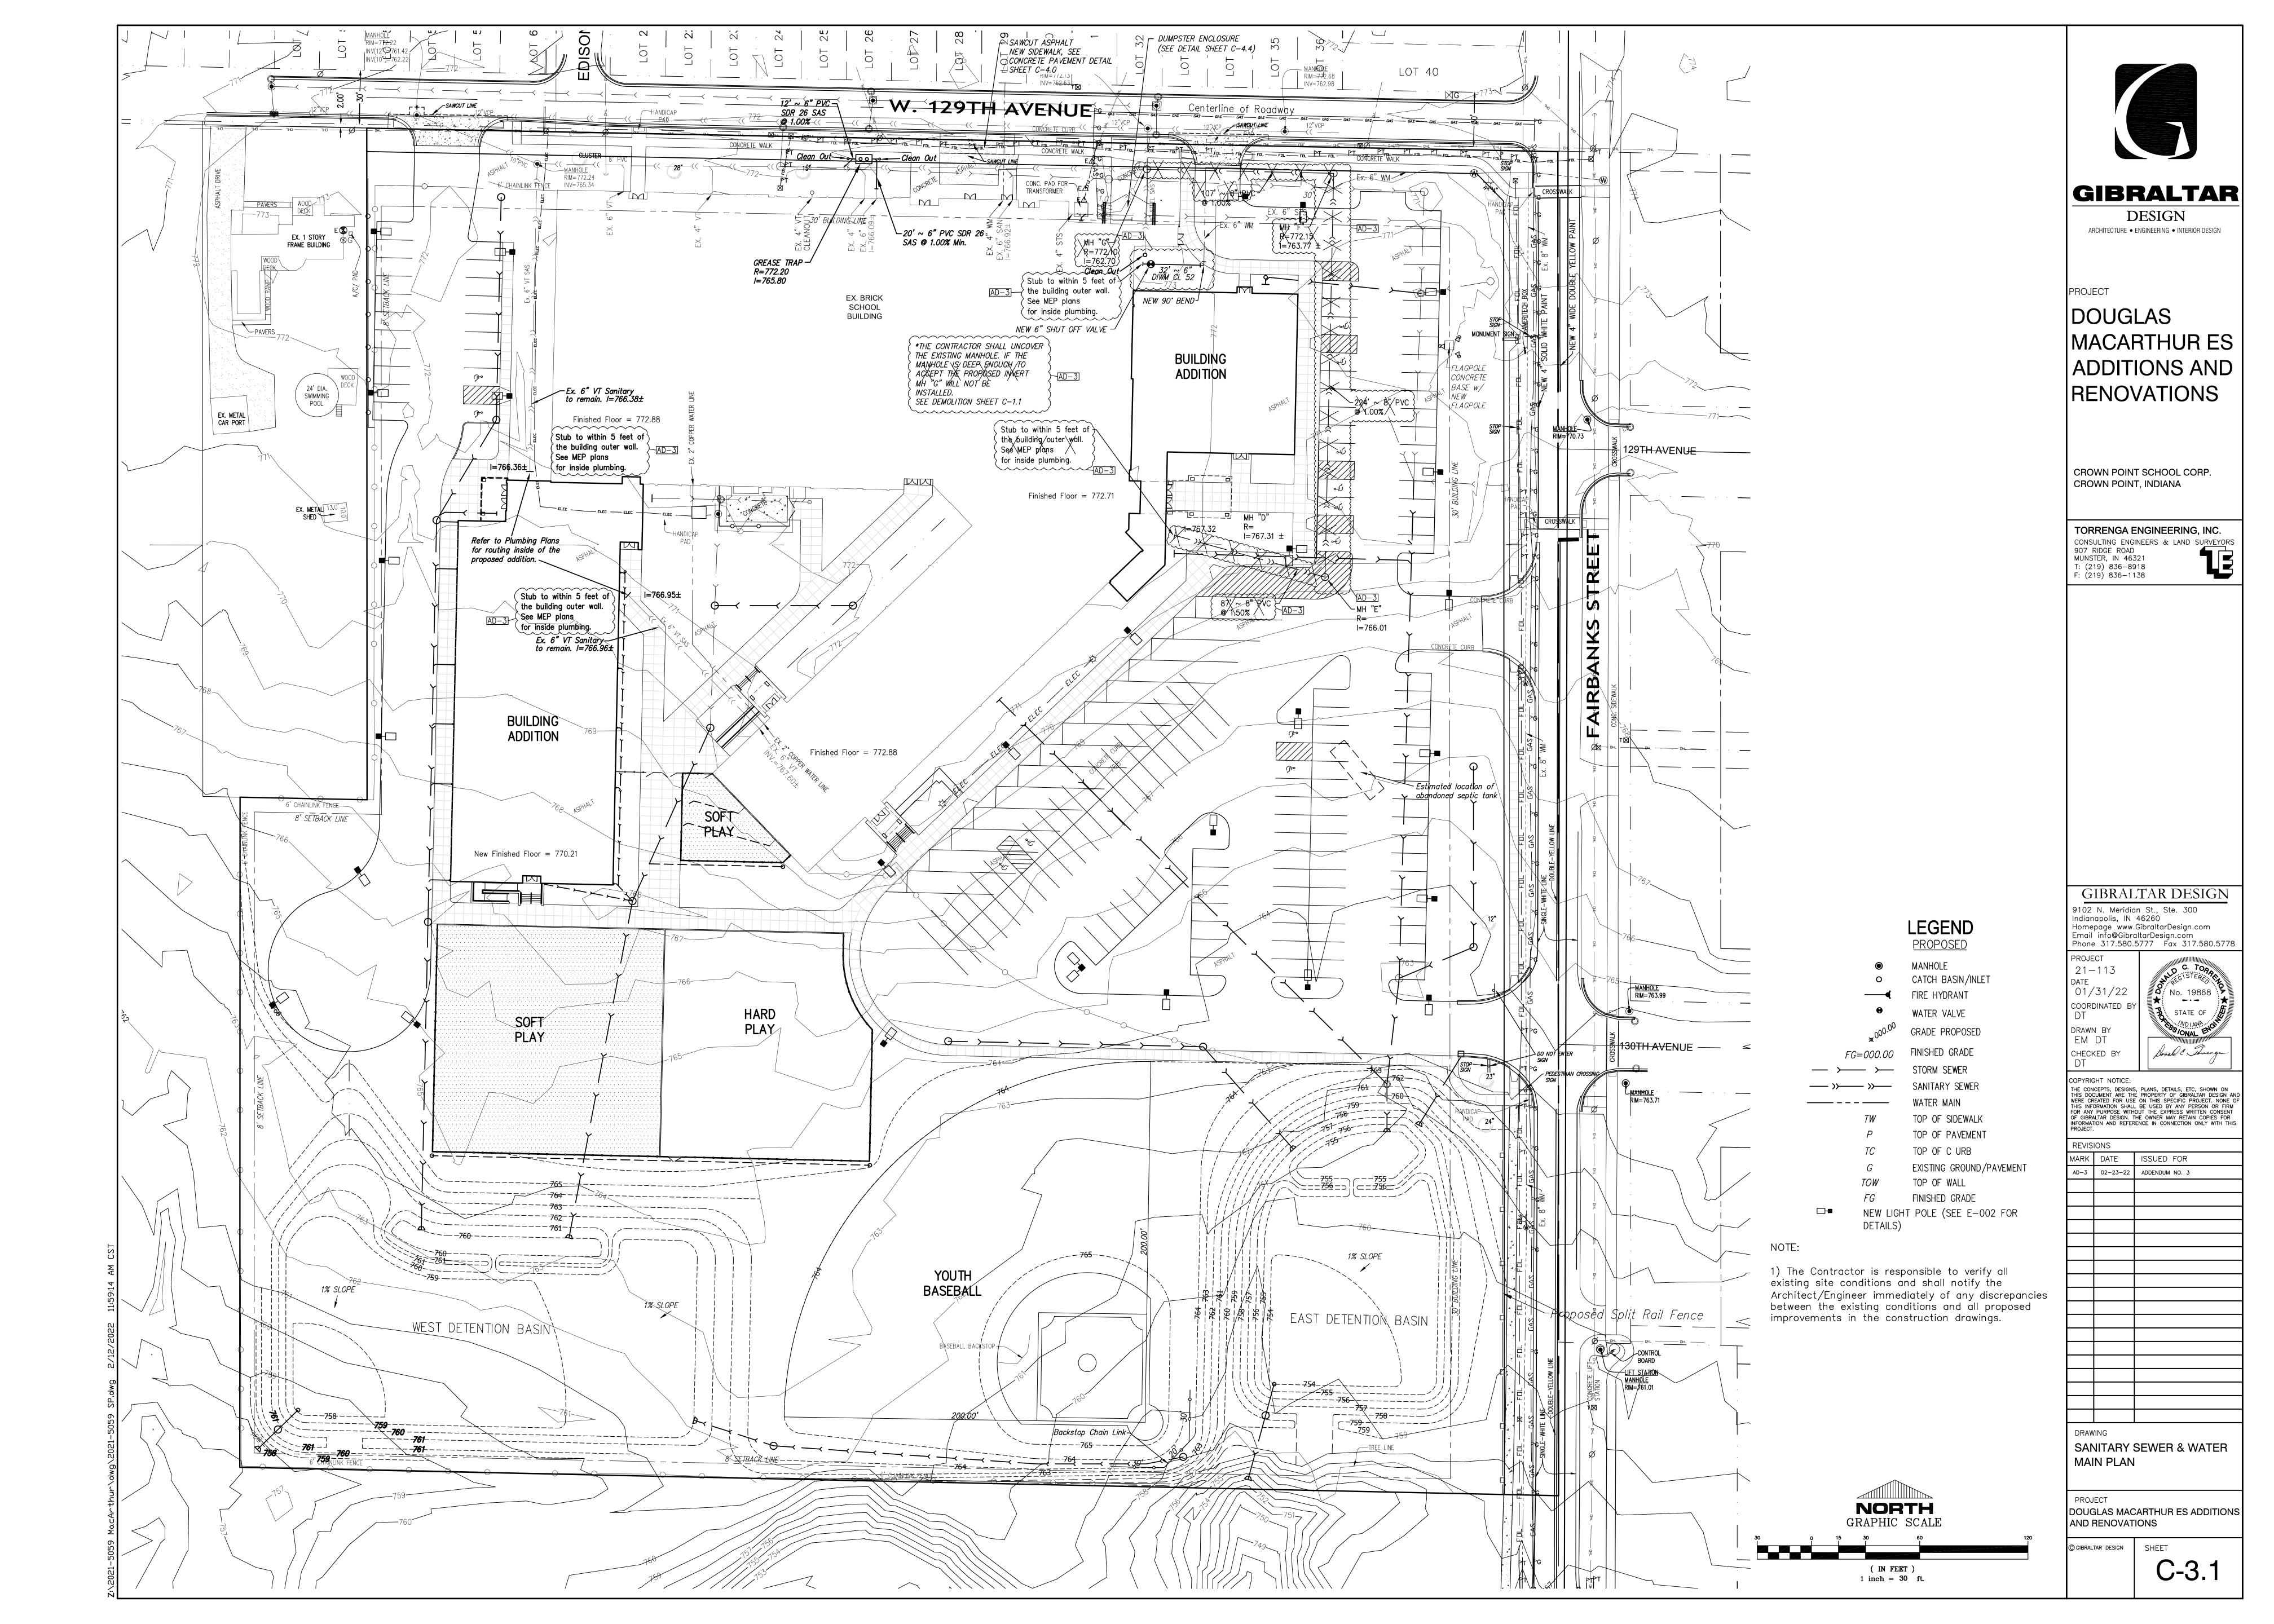

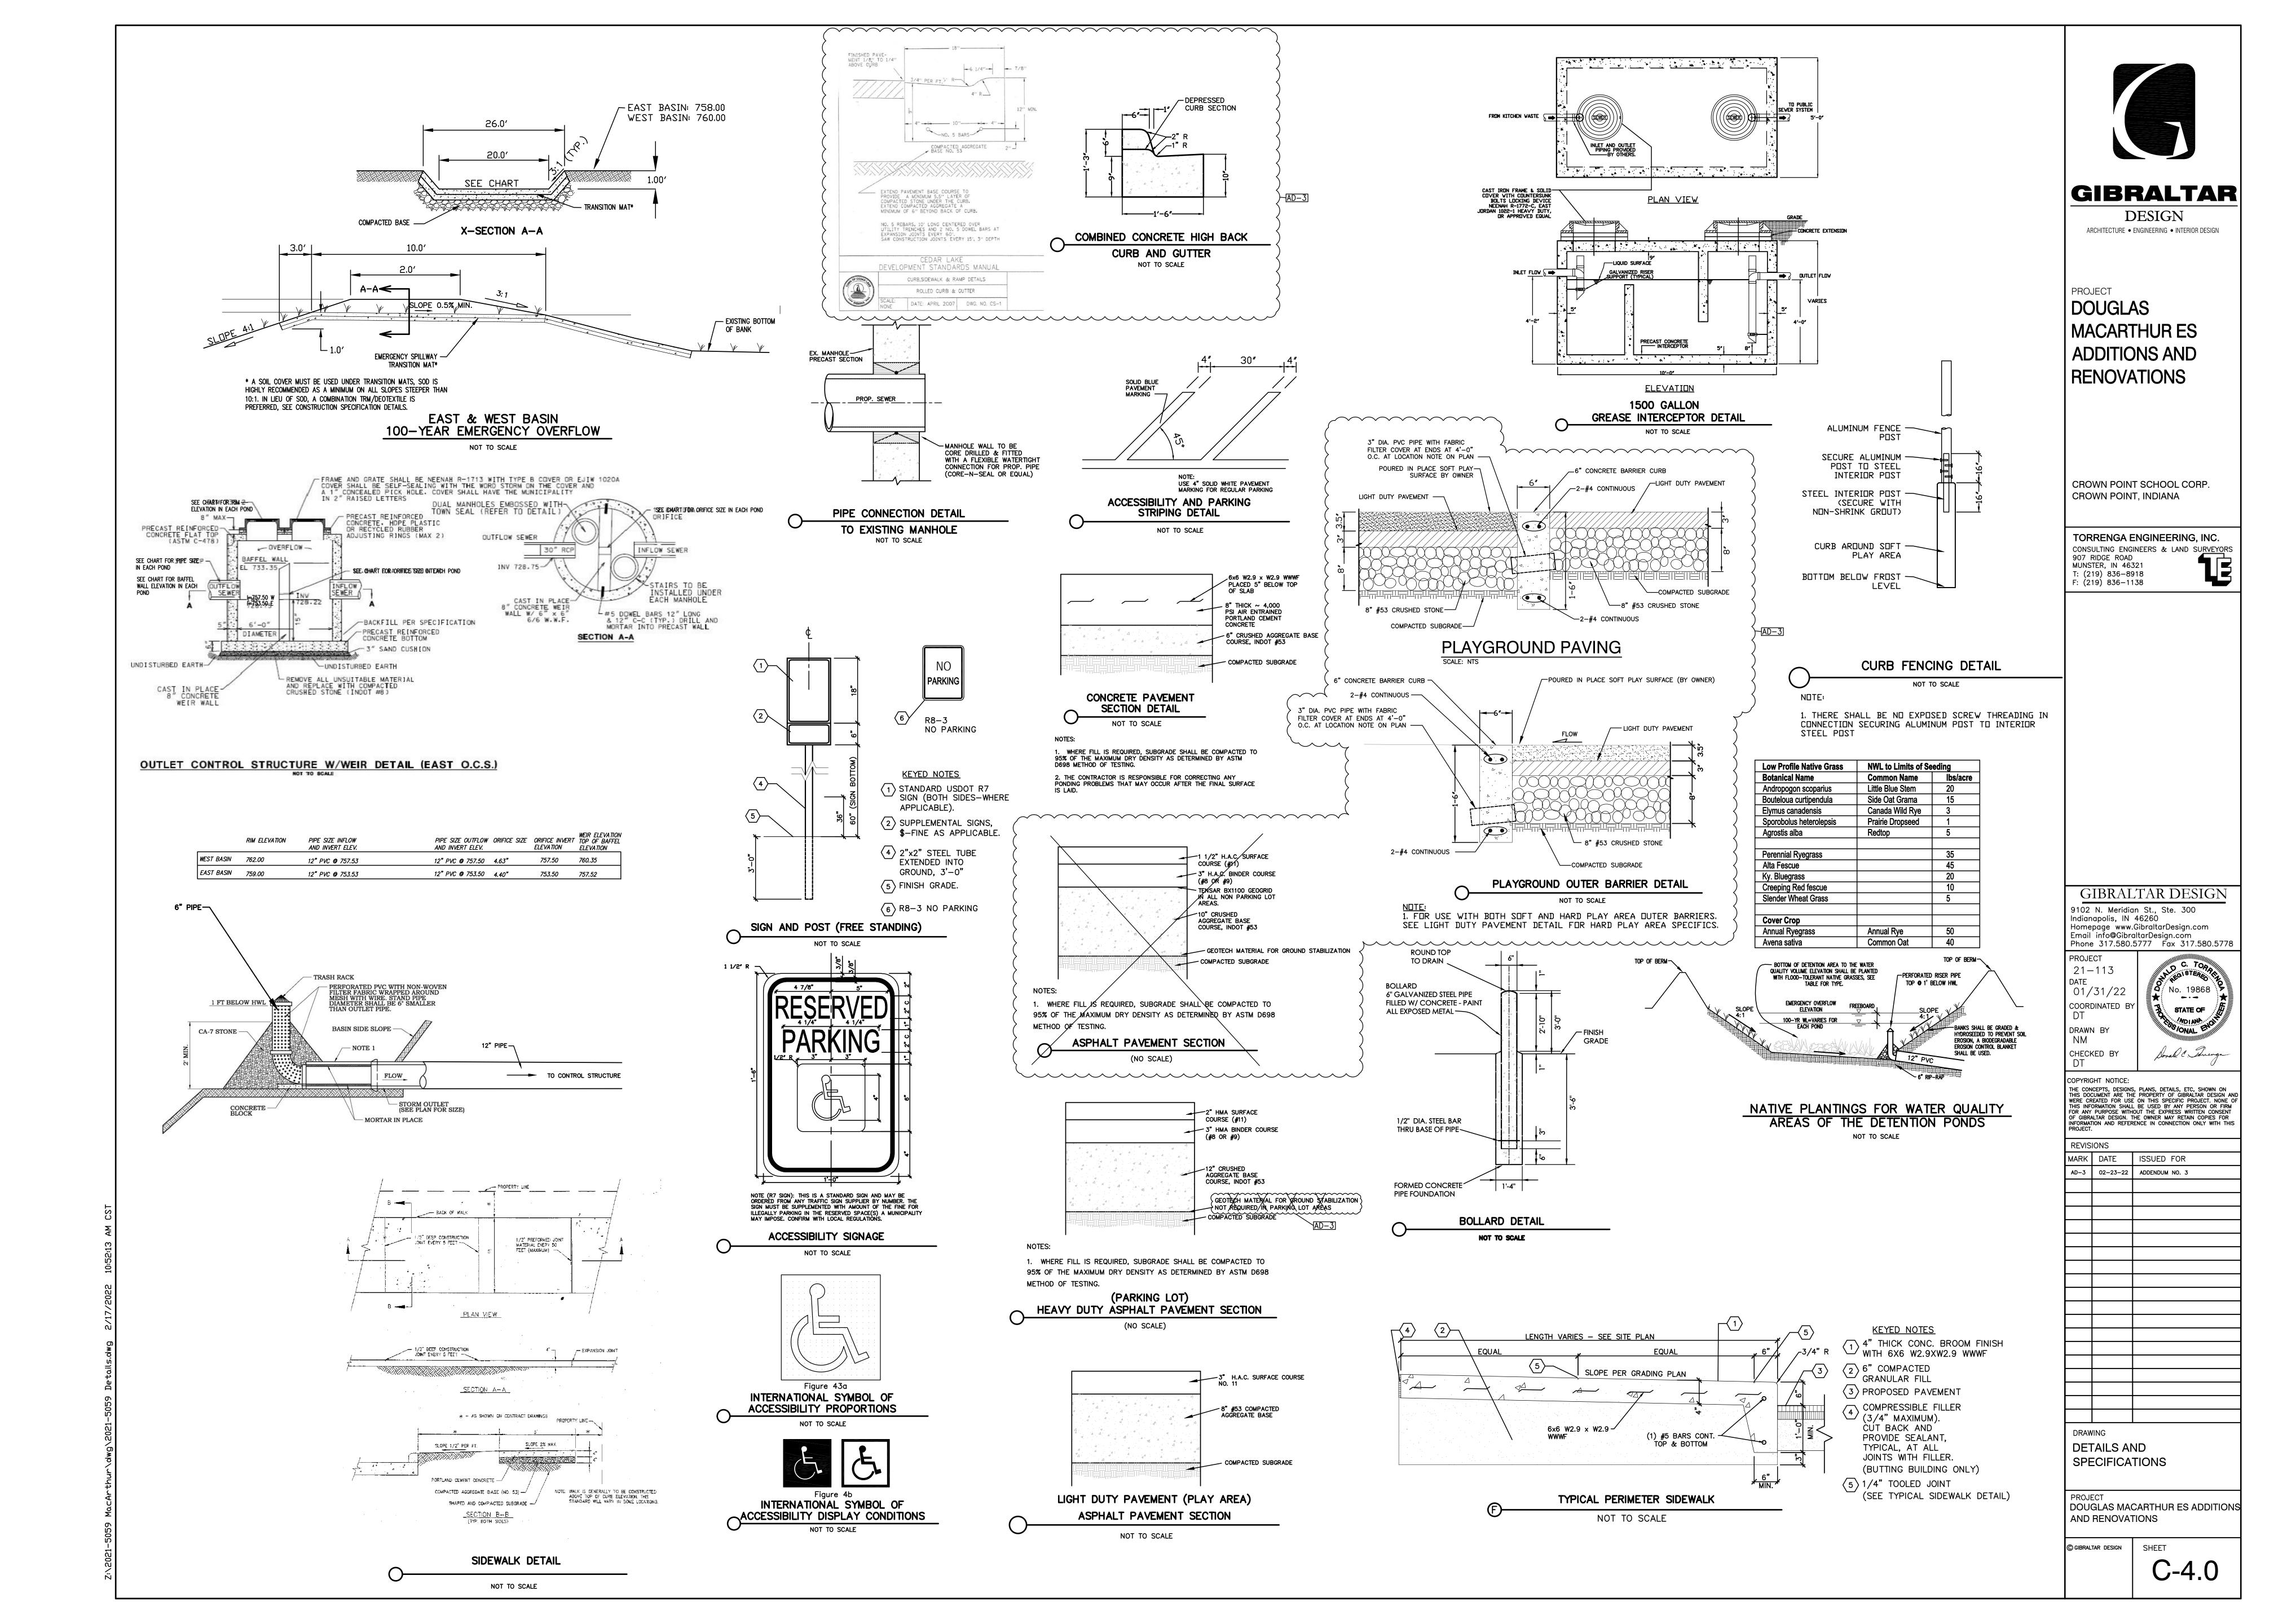

SECTION E **WATER DISTRIBUTION SYSTEMS**

PART 1 GENERAL

1.1 General Requirements

A. Comply with all requirements specified by all applicable Town Ordinances. B. Submittals: At the time of application for required permits, submit all information required by all applicable Town Ordinances C. All products specified shall use English units of measure unless otherwise specified or approved.

1.2 References

- A. ANSI / AWWA C104 / A21.3-03 Cement Mortar Lining for Ductile-Iron Pipe and Fittings for Water
- B. ANSI / AWWA C105 / A21.5-05 American National Standard for Polyethylene casement for Ductile-Iron Pipe Syster
- C. ANSI / AWWA C110 / A21.10 Ductile-Iron and Gray-Iron Fittings for Water D. ANSI / AWWA C111 / A21.11 - Rubber-Gasket Joints for Ductile-Iron Pressure
- E. ANSI / AWWA C151 / A21.51 American National Standard for Ductile-Iron
- Pipe, Centrifugally Cast, for Water
- F. ANSI / AWWA C600-05 Installation of Ductile-Iron Water Mains and Their G. ANSI / AWWA C509-01 - Resilient-Seated Gate Valves for Water-Supply
- H. ANSI / AWWA C500-02 Standard for Metal-Seated Gate Valves for Water Supply Service
- . ANSI / AWWA C502-05 Dry-Barrel Fire Hydrants
- J. AWWA C651-05 Disinfecting Water Mains

Place by the Rubber Balloon Method

Follow current edition of all references.

- K. ASTM A48 / A48M-03 Standard Specification for Gray Iron Castings
- L. ASTM C478-09 Standard Specification for Precast Reinforced Concrete Manhole Sections M. ASTM D1556-07 - Standard Test Method for Density and Unit Weight of Soil in
- Place by the Sand-Cone Method N. ASTM D1557-07 - Standard Test Methods for Laboratory Compaction
- acteristics of Soil Using Modified Effo O. ASTM D2167-08 - Standard Test Method for Density and Unit Weight of Soil in
- P. ASTM D6938-08a Standard Test Method for In-Place Density and Water Content of Soil and Soil-Aggregate by Nuclear Methods
- Q. Indiana Department of Transportation (INDOT) Standard Specifications

PART 2 PRODUCTS

2.1 Ductile-Iron Pipe

- A. All pipe shall conform to the applicable specifications and requirements set
- B. Pipe used in water main construction shall be Ductile-Iron Pipe and conform to AWWA C151 / ANSI A21.51. Class 52 thickness designation, casting, marking, testing, etc. shall be provided in accordance with applicable ANSI or AWWA standards; unless otherwise approved by the Director of Operations or the Town Engineer whereby this will be the only acceptable type of pipe
- C. Ductile-fron pipe shall be lined with double thickness cement lining in accordance with AWWA C104 / ANSI A21.3-03
- Pipe Fittings
 All ductile iron fittings shall conform to the latest ANSI A21.10 for short body, cast iron fittings twelve inches (12") and less, and AWWA C110 for fittings fourteen inches (14") and larger.
- 2. Lining, or other special items, shall be specified in special provision. E. Minimum Size: The minimum permissible sizes for water main are, as follows: . Residential: 8" ø = 0.3491 ft2
- 2.2 Polyethylene Encasement

Commercial: 10" ø = 0.5454 ft2

3. Industrial: 12" ø = 0.7854 ft2

A. Polyethylene encasements shall be required of all underground installations of newly constructed ductile-iron pipe water mains and fittings and other relate appurtenances, in accordance with AWWA-C105 / ANSI A21.5-05. The installation method shall be approved by the Director of Operations or Town

2.3 Valves for Water Mains

- A. The valves shall be suitable for ordinary waterworks service, intended to be installed in a normal position on buried pipe lines for water distribution
- B. The minimum requirements for all valves shall, in design, material and workmanship, conform to the standards of the latest AWWA C500 and C509 All materials used in the manufacture of water works valves shall conform to the AWWA standards designed for each material listed.
- 1. Manufacture and Marking: The valves shall be standard pattern and shall have the name or make of the manufacturer, size and working pressure plainly cast in raised letters on the valve body. Valves from one of the bllowing manufacturers are acceptable: Mueller, U.S. Valve, Clow, or East Jordan Iron Works. 2. Type and Mounting: The valve bodies shall be cast iron, mounted with approved non-corrosive metals. All wearing surfaces shall be bronze, or other approved non-corrosive materials and there shall be no moving bearing or contact surfaces or iron in contact with iron. Contact surf shall be machined and finished in the best workmanlike manner, and all wearing surfaces shall be easily renewable.

 3. Butterfly valves may not be used in the Town of Cedar Lake, except as
- authorized by the Director of Operations or Town Engineer. D. Gate Valves: All gate valves shall meet the standards of AWWA C509. The stem shall be of high tensile strength bronze or other approved non-corrosiv metal. All nonferrous bushings shall be of substantial thickness tightly fitted and pressed into machined seats. All valves shall open by turning to the left counterclockwise.

 1. Manufacture – Mueller, U.S. Valve, East Jordan Iron Works or McWane
- Resilient Seated Wedge ANSI/AWWA C509 . Working Pressure: 200 psi a. Mechanical Joint
- b. Push-On (Rubber Gasket) Joint . Flange Joint 5. Bolts: Stainless Steel, Class 304 or 314

(Clow) or approved equal

- . Operating Stem: Non-Rising with "O" Ring Seals. 8. Operating Nut: Two inches (2") square at the bottom, one and fifteer
- sixteenths inches (1-15/16") at the top and one and three quarter inches (1 3/4") high; Open Left 9. Markings to be cast on the bonnet or body
- . Pressure rating d. Year of manufacture

a. Open indicating arrow

10. Hydrostatic Test Pressure at Factory: Each gate valve shall be tested at the factory for performance and operation prior to painting and shall be subjected to the following hydrostatic pressure tests: each three-inch (3) to twelve-inch (12") valve, inclusive, shall be subjected to hydrostatic pressure test under pressures of both three hundred pounds per square nch (300 psi) and one hundred seventy-five pounds per square inch (17 psi) and each sixteen-inch (16") to forty-eight-inch (48") valve, inclusive, shall be subjected to test pressures of three hundred pounds per square inch (300 psi) and one hundred fifty pounds per square inch (150 psi).

hese tests shall be conducted in accordance with provisions of AWWA

C500. Tests for special valves shall be made as provided in the special E. Tapping Valves: Tapping valves shall be furnished with flanged inlet and

The outlet ends shall conform in dimensions to the AWWA Standards for the hub or mechanical joint connections, except that the outside of the hub shall have a large flange for attaching a drilling machine. The seat opening of the valves shall be larger than normal size to permit full diameter cuts. Tapping sleeve or cross shall be of the same manufacture as the tapping valve.

machined recess on the outlet flanges of the tapping sleeves and crosse

- McWane (Clow) resilient wedge tapping valve. Seat Opening larger than normal valve to permit full diameter cuts. Flanged inlet by mechanical joint.
- Tapping sleeve or cross: Same manufacturer as tapping valve. b. Sleeve, nuts and bolts for buried installations to be minimum type 304
- F. Valves sixteen inches (16") and larger installed in vertical or inclined lines shall be equipped with hard-babbitt tracks secured to the valve body and bonnet to
- support the lower disc during the operation, and equipped with slides to assist the travel of the gate assembly G. Gate Valve Stem Seals: Unless otherwise designated in the special provisions all gate valves up to and including twelve inch in size, shall be furnished with
- D-ring stem seals. Number, size and design shall conform to the AWWA standard for gate valve O-ring Stem Seals. Valves larger than twelve inches (12") shall be equipped with packing glands. H. Wrench nuts on gate valves shall be made of cast iron and shall be one and fifteen-sixteenths inches (1-15/16") square at the top, two inches (2") square at
- the base, one and three quarter inches (1-3/4") high, unless otherwise designated in the special provisions. Nuts shall have a flanged base upon which shall be cast an arrow at least two inches (2") long showing the direction of the opening. The word "Open" in one-half inch (1/2") or larger letters shall be cast on the nut to clearly indicate the direction of opening the valve.
- . Boxes for Water Mains and Water Services: Standard valve vaults, special valve vaults, cast iron valve boxes, curb boxes and meter boxes, all in accordance with the Cedar Lake standards.

 1. Material: Ring and Cover and Valve Box Castings. Castings for cast iron ring and cover and for cast iron parts of valve boxes shall conform to the requirements of Standard Specifications for Gray Iron Castings, ASTM

2.4 Fire Hydrants

- A. These specifications are to be used in conjunction with the AWWA Standard C502 for fire hydrants for ordinary water works service and follow standard
- 1. All materials used in the production of fire hydrants for ordinary service shall conform to the specifications designated for each material listed in AWWA Standard C502 2. The hydrant shall be East Jordan Iron Works, 5CD250 (three nozzle with
- pattern approved by the Director of Operations or Town Engineer. The name or make of the manufacturer and size of the valve opening shall be plainly cast in raised letters and so placed on the hydrant barrel as to be visible after the hydrant has been installed 3. As a minimum requirement, all hydrants shall be designed for a working. pressure of one hundred fifty pounds per square inch (150 psi) and in either bronze or other approved popcorrodible material, and there shall be

operating cap dust shield) traffic model, or approved equal and of a

- no moving bearing or contact surfaces of iron in contact with iron or steel. All contact surfaces shall be finished or machined in the best workmanlike manner and all wearing surfaces shall be easily renewable. 4. The design of the hydrant shall be such that all working parts may be removed through the top of the hydrant and shall have the required AWWA specified number of turns of the stem to open the gate an ear equal to the area of the valve opening. Any change in area equal to the area of the valve opening. Any change in area of the water passage
- through the valve must have an easy curve, and all outlets must have round corners of good radius. 5. Lugs, if required for harnessing the hydrant to the connecting pipe from e main in the street, shall be provided on the bell of the elbow or on the hydrant bottom casting. A drawing of the lug construction shall be submitted for approval, on request of the Director of Operations.

- 6. Hydrants shall be provided with a sidewalk or breakaway flange. Breaking devices shall be at the sidewalk flange, which will allow the hydrant barre to separate at this point with a minimum breakage of hydrant parts in case of damage. There shall also be provided at this point, a safety stem coupling on the operating stem that will shear at the time of impact. Unless otherwise specified, all hydrants shall be equipped with O-ring
- 7. All bolts and nuts for water main fittings shall be class 304 or 314 stainless steel. C. Hydrant Details: The dimensions and details of hydrants and nozzles, unless otherwise
- noted, shall be as follows:
 a. Hydrant six inches (6") connection (East Jordan Iron Works, 5BR250, C-Dome) b. Hydrant connection pipe size diameter - six inches (6")
- Standpipe, minimum inside diameter eight inches (8" Hydrant base shall include bottom and rear support shoe. e. Female type base restrained mechanical joint is recommended for connection to the auxiliary valve.
- Length of hydrant from bottom of hydrant connection to sidewalk ring As required by Director of Operations or Town Engineer. Valve opening - six inches (6" Size of auxiliary gate valve - six inches (6") Hose nozzles, number and size: Two (2) - two and one half inches (2-1/2") & One (1) - four inches (4")
- . All nozzles shall be fitted with cast iron threaded caps with operating nut of the same design and proportions as the hydrant stem nut. Caps sha be threaded to fit the corresponding nozzles and shall be fitted with suitable gaskets for positive water tightness under test pressures The operating nuts on hydrants stem and nozzle caps shall be the same

Thread pattern - National Standard

- Dimensions shall be as follows: Pattern of nut - Tapered pentagonal Height - One and one sixteenth inches (1-1/16")
- Size of pentagon One and thirty five one hundredths inches (1.35") at (As measured from point of flange) The hydrant valve shall open by turning to the left (counterclockwise).
- . All bolts and nuts below grade must be class 304 or 314. D. Factory Hydrostatic Test: Before the hydrant is painted at the factory, it shall be subjected to an internal hydrostatic test of three hundred pounds per
- square inch (300 psi) with the hydrant valve in a closed position and again with the hydrant valve in an open position.

corrosion resistant, top flange mounted with a spring base and shall not

nterfere with hydrant operation. Tag number designation to be provided by

E. Painting: All exposed parts of the hydrant shall be painted red. F. Marking: All hydrants shall have a location marker rod and hydrant tag number per drawing number W - 2. Location rod shall be five feet tall,

the Cedar Lake Public Works Department. 2.5 Fire Flow Requirements

- A. The amount of water necessary to fight a fire for a particular building is called the required fire flow. It is based on the type of construction, building size, and fire hazard of the occupancy
- B. Fire flow calculations shall be prepared in accordance with the Guide for Determination of Required Fire Flow, published by Insurance Services Office, Inc. (ISO). Fire flow for sprinkler buildings shall be reviewed for approval under part D of this section.
- C. The design engineer shall show that the water system can supply the required fire flow. The minimum fire flow requirement shall be as noted below:
- Industrial/Commercial 3,500 GPM D. The Cedar Lake Town Council or its Designee and Fire Chief, jointly, shall eview and approve plans and specifications related to fire flows

PART 3 EXECUTION

- 3.1 Surface Conditions A. Examine the areas and conditions under which work of this section will be formed. Correct conditions detrimental to timely and proper completion of the Work. Do not proceed until unsatisfactory conditions are corrected.
- B. Erosion and sediment control shall be provided to and approved by the irector of Operations or Town Engineer. 3.2 Field Measurements, Survey Lines, Reference Points &

A. Make necessary measurements in the field to assure precise fit of items in accordance with the approved design.

- 3.3 Installation of Pipe
- 1. All poles, fences, sewer, gas, water or other pipes, wires, conduits, manholes, buildings, structures and property in the proximity of a
- excavation shall be supported and protected from damage by the Contractor during construction. 2. Wherever sewer, gas, water or other pipes or conduits cross the excavation, the Contractor shall support said pipes and conduits without damage to them and without interrupting their use during the progress of the Work. The manner of supporting such pipes, etc., shall be subject to review by Town.
- 3. All property shall be thoroughly cleaned of all surplus materials, earth and rubbish placed thereon by the Contractor. 4. The Contractor shall notify Town and the appropriate utility companies at least seventy-two (72) hours prior to the start of construction. a. The Contractor shall coordinate all utility companies' location of any existing underground utilities and structures within the site limits.
 b. The Contractor, prior to the start of construction, shall verify the location of any existing underground utilities and structures within the site limits. It is the Contractor's responsibility to make any and all exploratory investigation, which may be necessary to verify or locate
- Water mains shall be located in the public right-of-way or front yard easements. Water mains shall not be located in side or rear yard easements, unless no other reasonable alternative exists, and approved by the Cedar Lake Town Council or its Designee.

the utility pipe, wires, structures and appurtenances of others.

- 2. Not closer than ten feet (10') from a public sewer system or service line (measured edge to edge). The edge of any water main or water service line shall not be less than eight feet (8') from the edge of manholes Where the bottom of the water pipe will be at least eighteen inches (18") above the top of the sewer pipe. a. If eighteen inches (18") of separation is not allowable, encase the
- lower elevation pipe per standard drawing W 9. 4. Where the top of the water pipe will be at least eighteen inches (18") below the bottom of the sewer pipe.

 a. If eighteen inches (18") of separation is not allowable, encase the lower elevation pipe per standard drawing W - 9.
- 5. The Contractor shall use pressure pipe with no joint closer horizontally than sixty inches (60") from the crossing of gravity flow sewers above 6. Unless otherwise shown on the plans or indicated in the special provision, all pipe shall be laid to a minimum depth of five feet (5') measured from the existing ground surface or established grade to the top of the barrel of the pipe. In areas subject to subsequent excavation or fill, the mains shall be
- laid to grades shown on the plans. 7. A hydrant shall be placed on dead end water mains. Water mains shall extend to the subdivision or property boundary line and shall be located in a public Right-of-Way or Easement.

 8. Dead end mains shall not be allowed except with the direct permission of the Director of Operations or Town Engineer.
- 9. Water mains shall be installed in casing pipes below street crossings where directed by the Director of Operations of Town Engineer.
- 1. All pipe shall be reinspected for soundness and damage due to handling immediately before being lowered into the trench. Any pipe found to be unsound or damaged will be rejected and shall be removed immediately from the site of the work. All material shall be new and of first quality. All pipe shall be laid accurately to the required line and grade and in such manner as to form a close, concentric joint with the adjoining pipe and to
- bring the invert of each section to the required grade. Bell holes shall be dug in advance of the pipe being laid as required. The supporting of the pipe on blocks will not be permitted. 3. All open ends of pipes and branches shall be sealed with plugs or bulkheads firmly held in place. 4. At the end of each day's work, the open ends of all pipes shall be protected
- against the entrance of animals, children, earth, or debris by bulkheads or 5. Each length of section shall be properly pulled or shoved "home" with a winch or come-a-long against the section previously laid to make a proper joint. The pipe shall then be securely held in position during the backfill perations. Joints shall not be pulled or cramped more than the design of the joint will permit and so as not to injure the conduit.

 6. Lower pipe, fittings, and valves into the trench by hand, by means of hoists
- or ropes, or by other suitable tools or equipment which will not damage products, coatings, or linings. Do not drop or dump pipe, fittings, or valves Provide thrust restraint at horizontal and vertical deflection fittings and at tees, plugs, tapping sleeves, and tapping saddles, only with the direct permission of the Director of Operations. 8. Laying of ductile iron piping shall meet the requirements of ANSI / AWWA C600-05, unless otherwise specified in this Section

Open excavation shall be satisfactorily protected at all times.

- 10. Pipe found not to comply with these standards shall be removed and D. Dewatering 1. Dewatering sufficient to maintain the water level below the surface of the trench bottom shall be accomplished prior to pipe laying and jointing, if not done prior to excavation and placement of the bedding as called for. 2. The dewatering operation, however accomplished, shall be carried out so
- that it does not destroy or weaken the strength of the soil under or alongside the trench. 3. When the dewatering operation is ended, the trench shall be replaced in such a manner so as not to disturb the pipe and its foundation
- E. Backfill Materials 1. B-Borrow shall comply with INDOT Standard Specifications, current edition. Maximum stone size shall not exceed one inch (1") or the maximum size recommended by the pipe manufacturer, whichever is
- material, no particles larger than four-inches (4") and shall be free of trash rubble and debris. The Plastic Index of the fraction passing the No. 40 sieve shall not be more than twenty-five (25) 3. Coarse aggregate material shall be No. 53 or 73 complying with INDOT Standard Specifications, current edition. Coarse aggregate is required for all pipe installed below pavement and sidewalks. 4. Backfill materials may vary from those specified depending upon utility

2. Earth backfill material shall contain no more than five percent (5%) organic

5. The use of slag material as backfill is not an acceptable alternative in the Town of Cedar Lake F. Bedding
1. Each pipe shall be laid and bedding with INDOT No. 8 coarse aggregate

company requirements when trenches cross existing utilities.

- limestone, unless otherwise approved.

 a. There shall be a minimum of 6 inches beneath the pipe. The lower half of the laid pipe shall be haunched to eliminate voids. There shall be a minimum of 12 inches of bedding above the laid pipe.
- 1. Sheet piling (permanent or temporary) shall be provided as required for construction in areas where wide excavation cannot be permitted, or for an excavation that is open for an extended period, or where soil conditions dictate to protect adjacent structures, roadways and utilities. 2. The section modulus of piling sections shall be as required to function properly as intended. 3. Piling sections shall be marked for length and sorted and stacked at the job
- site to prevent distortion and to facilitate proper sequence of setting and Interlocks shall be protected from becoming obstructed by sand, gravel, mud or other materials. 5. Pile tips are approved for use at the Contractor's option.

applicable ASTM Standards to the Town Engineer for all materials

1. The Developer shall submit Manufacturer's Certificate of Compliance with

3.4 General Trenching

B. Unless otherwise directed or permitted, not more than one hundred feet (100') of any trench shall be open at any time. C. Surface encumbrances, located so as to create a hazard to employees involved in excavation work or in the vicinity thereof at any time during

operations, shall be removed or made safe before excavating is begu

A. Follow the standard drawing number W - 7 for pipe trench

D. During excavation, material satisfactory for backfilling shall be stockpiled in an orderly manner at a distance from the banks of the trench sufficient to avoid overloading and to prevent slides and cave-ins. Adequate drainage shall be provided for the stockpiles and surrounding areas by means of ditches, dikes or other approved methods. The stockpiles shall also be protected from contamination with unsatisfactory excavated material or other material that may destroy the quality and fitness of the suitable stockpiled material. If the Contractor fails to protect the stockpiles and any material becomes unsatisfactory as a result, such material, if directed by the Town Engineer, shall be removed and replaced with satisfactory on-site or imported material

from approved sources.

- E. Grading shall be done as may be necessary to prevent surface water from flowing into the excavation, and any water accumulating therein shall be removed so that the stability of the bottom and sides of the excavation is maintained. In wet trenches dewatering equipment shall be operated ahead of pipe laying and the water level kept below the pipe inver
- F. The trench shall be excavated as shown in these Standards or as recommended by the manufacturer of the pipe to be installed, whichever is more stringent. Trench walls below and above the top of the pipe shall be sloped, or made vertical, as recommended in the manufacturer's installa manual. The trench width below an elevation one foot (1') above the top of pipe shall not exceed that recommended in the installation manual. Where no nanufacturer's installation manual is available, trench walls below an elevatio one foot (1') above the top of pipe shall be vertical and trench walls one foot (1') or more above the top of pipe shall be adequately sloped as required to prevent slides and cave-ins unless proper precautions, as stipulated by OSHA are taken. If adequate trench slopes cannot be provided in the available work space and right-of-way limits, then use of sheeting and shoring and/or a trench
- G. Excavation for manholes or similar structures shall be sufficient to leave at least twelve inches (12") clear between the outer structure surfaces and the face of the excavation or support members and be of sufficient size to permit the placement and removal of forms for the full length and width of structure footings and foundations. When concrete is to be placed in an excavated area, special care shall be taken not to disturb the bottom of the excavation Excavation to the final grade level shall not be made until just before the concrete is to be placed.
- H. Dust conditions shall be kept to a minimum by the use of water. The use of salt or calcium chloride will not be permitted.
- 3.5 Removal of Material A. As trenches are backfilled, the Contractor shall remove all surplus material, regrade and leave clear, free, and in good order all roadways and sidewall expiration of the guarantee period, he shall maintain in good and safe conditions the surface or any street over the trenches and promptly fill all depressions over and adjacent to trenches caused by settlement of backfilling

B. Surplus or unsatisfactory excavated material shall be properly disposed of at a

3.6 Stabilization A. If portions of the bottom of trenches or excavations consist of material unstable to such a degree that, in the opinion of the Town, it cannot adequately support the pipe or structure, the bottom shall be overexcavated and stabilized with granular material in compliance with the INDOT Standard Specification urrent edition. Depth of stabilization shall be as directed by the Town.

location off the property limits.

- 3.7 Backfilling A. Pipe bedding and initial backfill shall be clean granular material to a depth per tandard drawing number W - 7. Initial backfill shall be placed in lifts of a maximum of six inches (6") loose thickness. The method for placing and compacting the backfill shall comply with the INDOT Standard Specifications as applicable. At a minimum, the Contractor shall use a vibrating plate compactor with adequate passes to achieve compaction. The backfill shall be brought up evenly on both sides of pipe for the full length of pipe. Care shall be taken to ensure thorough compaction of the fill under pipe haunches.
- B. Final backfill for the remainder of the trenches shall be as follows: Backfill for trenches under sidewalks, under turfed or seeded areas, and in miscellaneous areas shall be of approved earth material and contain no stones over four inches (4") in their largest dimensions. Stones which are used in backfilling shall be distributed among the earth backfill so that all interspaces are filled with fine material. All such backfilling shall be deposited in lifts of a maximum twelve inches (12") loose thickness and compacted with a vibrating plate compactor or approved mechanical tamping devices. Excess earth to the amount required to replace settlement shall be neatly rounded over the trench and the remainder
- hauled off the work site. Trenches shall be maintained by the Contractor until settlement has ceased and trenches remain level with the adjacent Backfill of all trenches under existing or proposed roadways and structural footings or slabs shall be approved granular material only. In addition, the top six inches (6") below the base of the pavement shall be backfilled with No. 53 crushed limestone. The backfill shall be placed in six inch (6") maximum lifts and the method of placing and compacting the backfill shall comply with the INDOT Standard Specifications, as applicable. At a minimum, the Contractor shall use a vibrating plate compactor with adequate passes to achieve compaction.
- C. Pipe bedding and each backfill lift shall be compacted to a dry density not less than the following percentage of maximum dry density as determined by the Modified Proctor Test (ASTM D1557):
- Compaction % Upper two feet (2') of backfill under roadways Under roadways (except upper two feet (2") of backfill) Under haunches and up to springline of pipe From springline to twelve inches (12") above top of pipe Adjacent to (or behind) vertical walls
- Under turfed or seeded areas below topsoil, and Miscellaneous area (from twelve inch [12"] above pipe to surface) D. No fill shall be placed against any manhole or other structure until placed concrete has been allowed to cure for at least three (3) days. Backfill shall be placed in such a manner that the structure will not be damaged by shock from falling earth. The backfill material shall be deposited and compacted as specified for final backfill, and shall be placed in such a manner as to prevent eccentric loading and excessive stress on the structure. Heavy equipment for spreading and compacting shall not operate closer to foundation walls than set . Fill placed adjacent to vertical or near vertical walls (within a zone defined by imaginary lines extending horizontally away from the base of the wall for a distance of three feet and thence upward and outward on a one to one

specified density with light equipment not exceeding fifteen hundred (1500) pounds in static weight or dynamic rated impact. 3.8 Compaction Testing

A. Sampling and testing shall be the responsibility of the Contractor. Tests shall be performed by a Town approved commercial testing laboratory or may be ested with approved facilities furnished by the Contractor.

(1:1) slope to the elevation of the top of the wall) shall be compacted to the

- B. Laboratory tests for moisture-density relations shall be determined in accordance with ASTM D1557. A minimum of one test shall be performed on each different type of material used for backfill, or as directed by the Town. C. Field In-Place Density Tests: I. Shall be performed in sufficient numbers to ensure that the specified compaction is being obtained. A minimum of one test per lift of backfill for
- very two hundred feet (200') of installation shall be performed. Locations for performing the density tests will be coordinated with the Town. Shall be determined in accordance with ASTM D1556, ASTM D2167 or When ASTM D6938 is used, the calibration curves shall be checked and adjusted using only the sand cone method as per ASTM D1556. ASTM 6938 results in a wet unit weight of soil and the moisture content of the soil. The calibration curves furnished with the moisture gages shall be checked along with density calibration checks as described in ASTM D6938. The calibration checks of both the density and moisture gages
- shall be made at the beginning of a job, on each different type of material incountered and at intervals as directed by the Town. Copies of calibration curves and results of calibration tests shall be submitted to the Town. D. All test results shall be submitted to the Town. E. Trenches improperly compacted shall be reopened to the depth directed by the Town and then refilled and compacted to the density specified. Field inplace density tests shall also be repeated for improperly compacted trenches
- that are reopened, refilled and recompacted. A minimum of one (1) repeat test per lift of backfill for every two hundred feet (200') of improperly compacted rench that is reopened, refilled and recompacted shall be performed. 3.9 Connections to Existing Water Mains A. Connections to existing water mains shall be accomplished without interruption
- 3.10 Laying of Pipe on Curves A. Long radius curves, either horizontal or vertical, may be laid with standard pipe

of service. Tap and valves will be provided at the point of connection to the

- by deflections at the joints. B. Where deflection of curves is required, the Director of Operations or Town Engineer will approve the methods to be used.
- C. Maximum deflections at pipe joints and laying radius for various pipe lengths are as found in the following standards: Ductile Iron Pipe Restrained Joints AWWA C600 Ductile Iron Pipe Push-On Joints AWWA C600 D. When rubber gasketed pipe is laid on a curve, the pipe shall be jointed in a

straight alignment and then deflected, as required. Trenches shall be made wider on curves for this purpose. 3.11 Fire Hydrants

- A. Locate Fire Hydrant: Per standard drawing number W 2 Where public water supplies may be extended, fire hydrants shall be nstalled along public streets. 2. Hydrants shall be installed in residential districts on the basis of serving
- one hundred twenty thousand square feet (120,000 sf) of area and not be within the public right of way or easement, at the side property lines. In commercial and industrial districts, hydrants shall be installed on the basis of serving eighty thousand square feet (80,000 sf) of area and not be more than two hundred fifty feet (250") apart. The farthest distance from a hydrant to any point on a building it services shall be three hundred fifty linear feet (350'). The closest edge of an installed hydrant shall be no closer than approximately forty-two inches (42") from the back of the street
- curb and no further than approximately forty-eight inches (48") distant B. Hydrant Construction Details . Hydrant shall be plumb and shall be set so that the lowest hose nections are at least eighteen inches (18") and no more than twenty . All hydrants shall be inspected in the field upon delivery to the job to ensure proper operations before installatio
- or like porous material, shall be placed at and around the base of the hydrant to ensure proper drainage of the hydrant after use. 4. Care shall be taken to ensure that weep holes are not covered by 5. The hydrant shall be set on a concrete base block to ensure a firm bearing for the hydrant base, with thrust blocking behind the elbow, per standard 6. All joints shall be restrained by retainer glands, as approved by the Director

The resetting of existing hydrants and moving and reconnection of existing hydrants shall be handled in a manner similar to a new installation.

3. A minimum of one quarter cubic yard (1/4 cy) of coarse stone, with gravel

Fire hydrant assemblies removed shall be delivered to the Cedar Lake Public Works Department.

of Operations or Town Engineer.

- 3.12 Gate Valves A. Locate Water Valves: 1. Maximum spacing of valves is four hundred feet (400') and located at the
- 2. Locate a valve at each branch of a tee or crossing, unless otherwise directed by the Director of Operations or the Town Engineer. B. All gate valves shall be inspected upon delivery in the field to ensure proper working order before installation. They shall be set and jointed to the pipe on the manner as set forth in the AWWA Standards for the type of connection

C. All valves shall be installed in a vertical position and be provided with a

standard valve box and valve box stabilizer, as shown in Cedar Lake Standard D. After installation, all valves shall be subjected to the field test for piping and

- Clean the interior of valves of foreign matter before installation. Tighten stuffing boxes. Inspect valves in opened and closed positions to ensure all 2. Set buried valves and valve boxes plumb. Center valve boxes on the valves or valve operators. Locate valves outside the area of roads and streets where feasible, or where shown on the drawings. Tamp backfill around each valve box to a distance of four feet (4') on all sides of the box,
- or to the undisturbed trench face if less than four feet (4'). F. Construction Details of Cast Iron Valve Boxes for Gate Valves. Per standard drawing number W - 3. Adjustable cast iron valve boxes shall be set to position during backfilling operations so they will be in a vertical alignment to the gate valve operating stem. The lower casting of the unit shall be installed on top of a valve bo stabilizer, in such a manner as to be cushioned and to not rest directly upon the body of the gate valve or upon the water main alignment into such an elevation that its top will be at final grade. Backfill around the uni shall be placed and compacted to the satisfaction of the Director of Operations or Town Engineer
- G. Concrete Valve Vaults shall be installed in paved areas and in accordance with ASTM C-478 per standard drawing number W - 4 and W - 5. 3.13 Water Services A. Installation: Per standard drawing number W -1. The minimum size of water service connections in the Town of Cedar Lake shall be one inch (1") and shall be copper tube type "K". Water service
- connections four-inches (4") and larger shall be ductile iron pipe water main and shall comply with all specifications for water mains. All copper connections shall be made with compression fittings.

 2. The corporation stop shall be Mueller Company H-1500 Ori-seal III or approved equal and shall be installed by tapping machine. The tap shall be made in the upper third of the main as close to a forty-five degree (45° angle with the horizontal axis as is practical. A tap into the top of the main will not be permitted. All taps shall have a minimum of one foot (1') 3. The round way ground key stop shall be Mueller Company H-1504-2 Ori seal III with quarter turn check or approved equal. Buffalo box shall be
- Mueller Company H-10334 Arch Type with thirty three inch (33") minimum rod length or approved equal five and one half feet (5-1/2') in length having an inside diameter of the upper section of not less than one inch (1"). All water services shall have a minimum of five feet (5') of cover over the service. All buffalo boxes shall be installed approximately eighteen inche (18") from the street side of the sidewalk and as near to the common lot line as possible. 4. The contractor shall record the location of each buffalo box in relation to
- the nearest corner lot line. Two copies of this record shall be filed with the Town prior to final inspection. 5. When a water service is installed beneath existing roadways, sidewalks and/or driveways, the pipe shall be installed by pushing or auguring a hole beneath the said roadway, sidewalk and/or driveway and installing the service pipe through the hole. 6. The size of any opening in the roadway to connect the water service to the main shall be kept to a minimum, and the roadway replaced in accordance with in the current version of the Cedar Lake Development Standards,
- materials and thickness to be approved by the Town. Installation of a water service in the same trench as the sanitary sewe service will not be allowed. A ten-foot (10') horizontal separation between a sanitary sewer and water service shall be maintained. . The buffalo box shall not be placed within a hard surface sidewalk, driveway or access drive 9. Water service corporation valves shall not be installed on dead end mains.
- 1. All water services shall be metered as close to the point where the service enters the building as possible. All meters shall be provided by the Town and purchased by the owner and installed by a licensed contractor. Water meter must be installed so that it is easily accessible, without obstruction either temporary or permanent, for normal reading and maintenance. Water service shall be installed in such a manner that all meters shall be centered eighteen inches (18") above the floor and spaced from the outside wall as follows: One inch (1") meter span shall be ten inches (10") from outside wall. One and one half inch (1-1/2") meter span shall be twelve inches (12")
- Two inches (2") and larger meter spans shall be not less than fifteen inches (15") from outside wall.

 2. Valves shall be installed on both sides of the meter spread. In the case of a bypass system utilized around a meter installation, a gate valve shall be nstalled in the bypass line and a positive locking system provided by the C. Back Flow Preventers: . Residential back flow preventers up to one and one half inches shall be

Commercial back flow preventers and those larger than one and one half inches shall be reduced Pressure Zone (RPZ) assembly style. All State and Local building codes apply. 3.14 Jointing Rubber Gaskets Joint Pipe

inserted to the full depth of the joints.

double check valve assembly style.

from outside wall.

A. Jointing Rubber Gaskets to join pipe are to be AWWA Standard C111. B. The inside of the bell shall be thoroughly cleaned to remove all foreign matter

from the joint. The circular rubber gasket shall be inserted in the gasket seat

- C. A thin film of gasket lubricant shall be applied to inside surface of the gasket. Gasket lubricant shall be supplied by the pipe manufacturer, or approved
- D. The spigot end of the pipe shall be cleaned and entered in the rubber gasket in the bell, using care to keep the joint from contacting the ground. The joint shall then be completed by forcing the plain end to the seat of the

E. All pipe shall be furnished with a depth mark to assure that the spigot end is

F. Field-cut pipe lengths shall be beveled to avoid damage to the gasket and

- 3.15 Mechanical Restrained Joints for Ductile-Iron Pipe A. Mechanical restrained Joints shall be use for all fittings unless other wise directed by the Director of Operations or Town Engineer. Joints for ductile iron pipe shall consist of one of the two following types unless otherwise provided
- . Acceptable Manufacturers shall be EBBA Iron Co: Mega Lugs or approved equal. 2. Install thrust restraints at all bends, tees, hydrants, valves, dead ends and plugs per standard drawing number W - 6.

All bolts exposed to earth in an underground location shall be type 304 or

314 stainless steel B. Push on Restraints (Field Lock or approved equal) shall only be used with the approval of the Director of Operations or Town Engineer 3.16 Thrust Blocking and Restrained Joints

A. Push on Restraints (Field Lok, as manufactured by U.S. Pipe or approved equal) shall only be used with the approval of the Director of Operations or B. Thrust blocking shall follow standard drawing number W - 6, and shall be used

only at selected locations where restrained fittings are not feasible and at the

direct permission of the Director of Operations or Town Engineer. C. All fittings and bends of eleven and one quarter degrees (11-1/4°) or greater and all tees, plugs, valves and fire hydrants shall use restrained joints to revent movement of the lines under pressure.

D. If restrained joints are used the following table shall be used for length of RESTRAINED PIPE LENGTH (Linear Feet) 45° 22-1/2° 11-1/4° VALVE OR 68.25 77.00 15.75 17.50 19.25 21.00 24.50 29.75

- *MINIMUM ONE FULL LENGTH (18') OF PIPE ON BOTH SIDES OF BRANCH TEST PRESSURE BASED ON 150 PSI.
- 3.17 Testing for Water Main A. Pressure Test: Perform the following tests upon completion of the system and prior to being placed into service Pressure and Leakage Test a. Perform pressure and leakage test in accordance with ANSI/AWWA
 - b. Test Pressure: 150 psi. Do not allow pressure to vary more than 5 psi during the test. Test Duration: Not less than 2 hours. . Allowable Leakage: one-half of the volume allowed by ANSI/AWWA C600; which is equivalent to the following formula:

with main testing.

construction of water mains.

and perform coliform test on each sample.

3.19 Disinfection

- L = Allowable Leakage in Gallons per Hour. S = Length of Pipe Tested in Feet. D = Nominal Diameter of Pipe in Inches. P = Average Test Pressure during Test in Pounds/Square Inch (psi)
- a. Perform separate pressure and leakage test on the services with the corporation stops open. b. Test Pressure: 100 psi Allowable Leakage: None. d. At the Contractor's option, service testing may be done concurrent
- B. Hydrant Testing: Flow test to be performed by the Contractor and witnessed by Cedar Lake Public Works staff before acceptance. Minimum acceptable flow is one thousand gallons per minute (1000gpm) at a residual pressure of twenty pounds per square inch (20 psi).


A. Section of pipe to be disinfected shall first be flushed to remove any solids or

- shall be installed at the end of the main. One two and one-half inch (2-1/2") lydrant opening will, under normal pressure, provide this velocity in pipe sizes up to and including twelve inches (12") B. All taps required by the Contractor for chlorination or flushing purposes or for temporary or permanent release of air shall be provided by him as a part of the
- A. Disinfect all newly installed water mains, appurtenances and services in accordance with ANSI/AWWA C651 B. Flush system within twenty four (24) hours after disinfection is completed. C. Obtain two (2) water samples at locations to be determined by the Engineer
- 3.20 Final Flushing and Testing A. Following chlorination, all treated water shall be thoroughly flushed from the newly laid pipe at its extremity until the replacement water throughout its length shows, upon test, the absence of chlorine. Flushing shall discharge to a Sanitary Sewer System. Storm Sewer System discharge is not acceptable. Chlorine residual shall not be in excess of that carried in the system.

D. Re-chlorinate as required if any sample tests positive for coliform.

- B. After flushing, water samples collected on two (2) successive days shall show by a laboratory certified by the State of Indiana.
- C. Should the initial treatment result in an unsatisfactory bacterial test, the original chlorination procedure shall be repeated by the Contractor until satisfactory results are obtained.
- D. Results of all tests shall be provided by to the Cedar Lake Public Works Department. Acceptance of the water system shall not be made without receipt of the passing tests.


- Professional Engineer or Architect.
- B. The intent is to provide dimensional information to the nearest half foot (0.5 ft) for the location of water mains, valves, hydrants, and all fittings. C. Follow standard drawing W - 8, record drawing example.

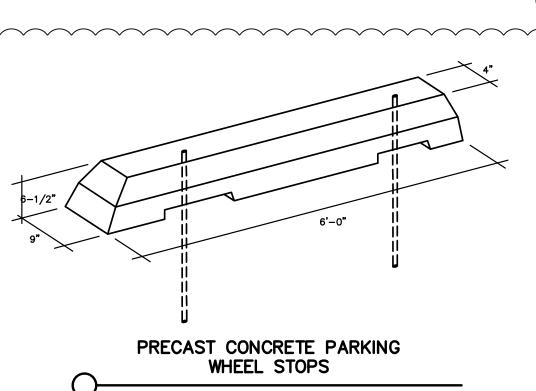

ALL PARKING STOPS SHALL BE PINNED TO THE ASPHALT WITH #4 REBAR

ANCHORED 18" INTO THE GROUND. PARKING STOPS PLACED OVER THE


PAVERS SHALL BE UNPINNED.

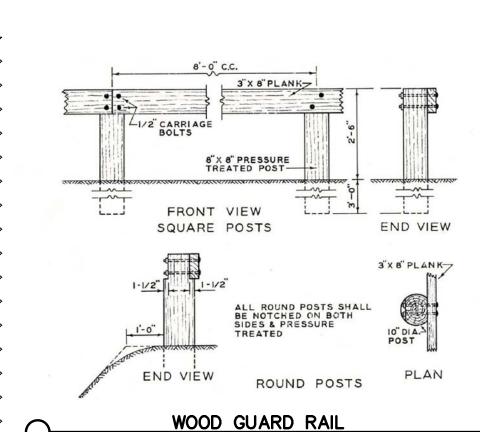



satisfactory bacteriological results. Bacteriological analysis must be performed

3.21 Record Drawings


- A. The record drawings must be sealed, signed, and dated by a registered

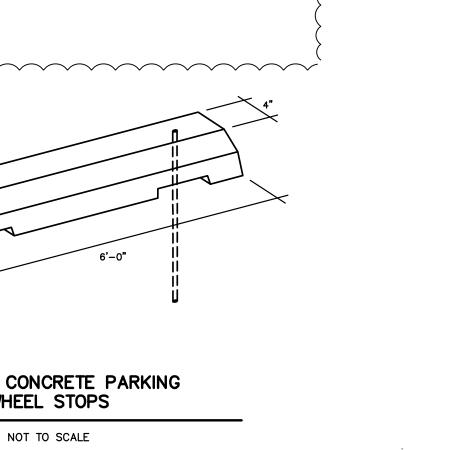


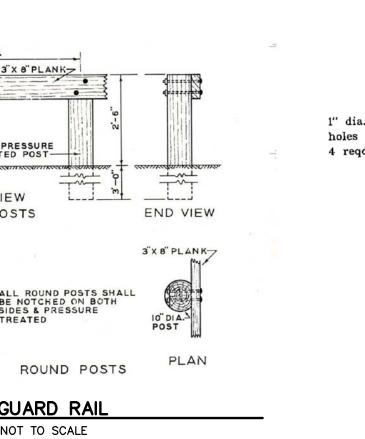


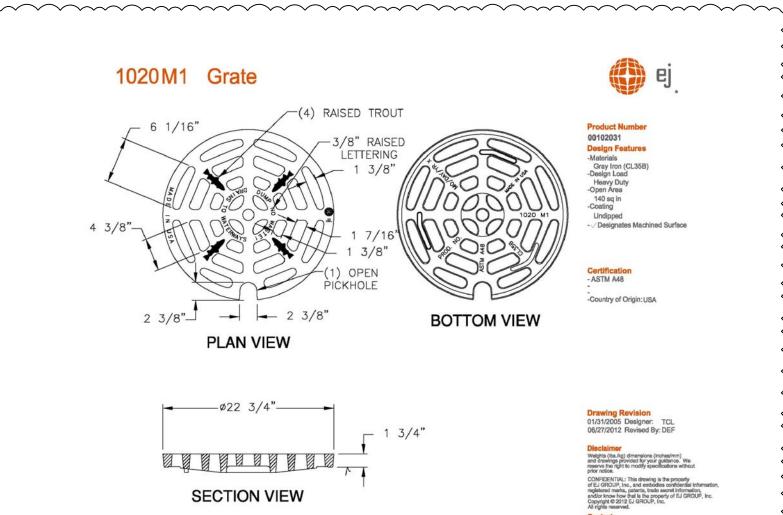


1020 EJIW 1020, M1

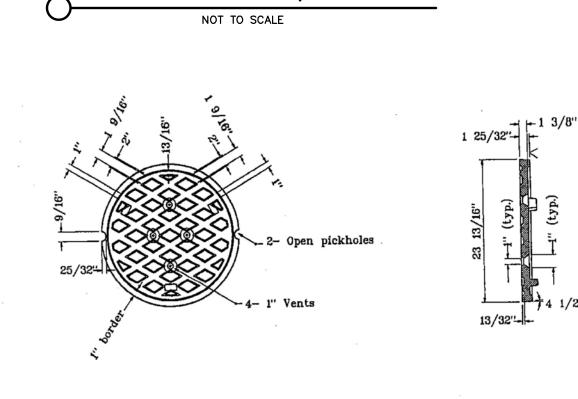

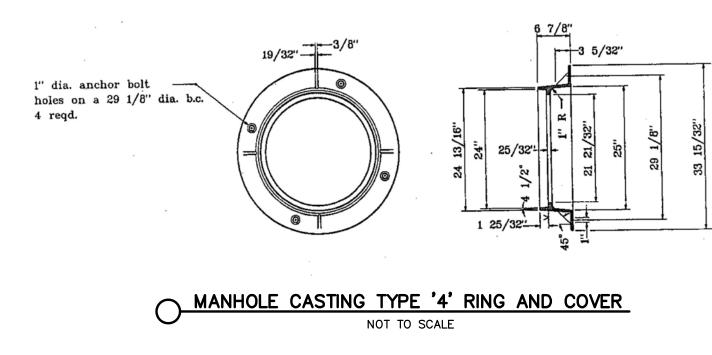

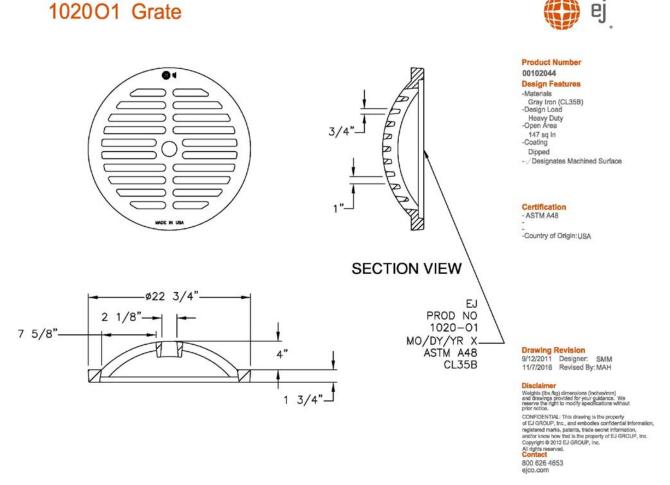

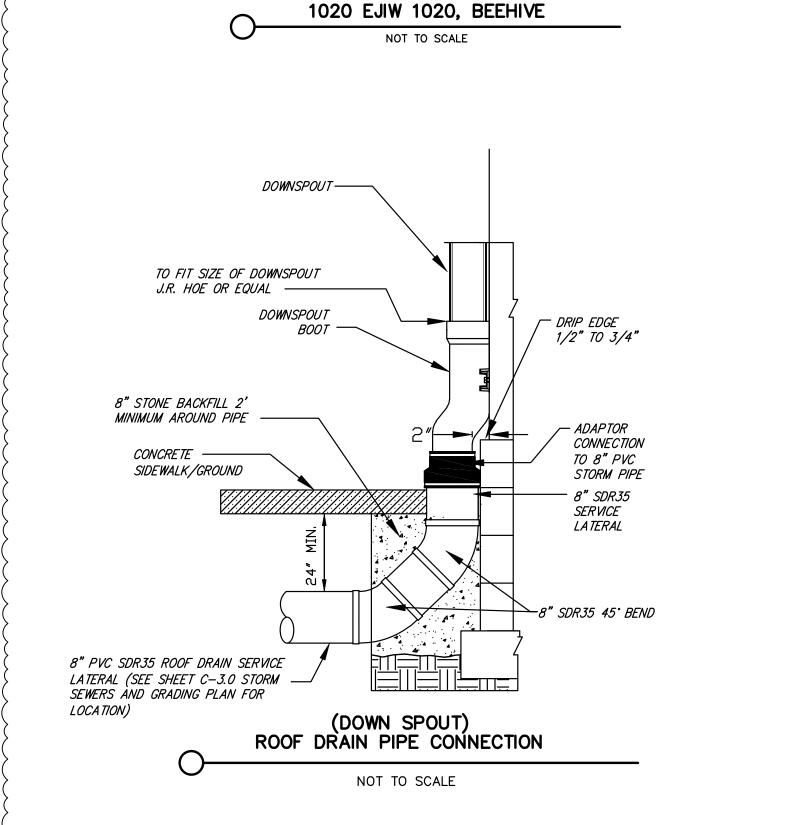



PROJECT DOUGLAS MACARTHUR ES **ADDITIONS AND RENOVATIONS**

CROWN POINT SCHOOL CORP

CROWN POINT, INDIANA

TORRENGA ENGINEERING, INC. CONSULTING ENGINEERS & LAND 907 RIDGE ROAD MUNSTER, IN 46321 T: (219) 836-8918 F: (219) 836-1138

GIBRALTAR DESIGN 9102 N. Meridian St., Ste. 300 Indianapolis, IN 46260 Homepage www.GibraltarDesign.com

PROJECT

DRAWN BY

REVISIONS

MARK DATE

NM

Email info@GibraltarDesign.com Phone 317.580.5777 Fax 317.580.5778 21 - 113- - -COORDINATED STATE OF CHECKED E

COPYRIGHT NOTICE: THE CONCEPTS, DESIGNS, PLANS, DETAILS, ETC, SHOWN ON THIS DOCUMENT ARE THE PROPERTY OF GIBRALTAR DESIGN ANI VERE CREATED FOR USE ON THIS SPECIFIC PROJECT. NONE THIS INFORMATION SHALL BE USED BY ANY PERSON OR FIRM FOR ANY PURPOSE WITHOUT THE EXPRESS WRITTEN CONSENT OF GIBRALTAR DESIGN. THE OWNER MAY RETAIN COPIES FOR NFORMATION AND REFERENCE IN CONNECTION ONLY WITH TH

ISSUED FOR

AD-3 02-23-22 ADDENDUM NO. 3 DRAWING


DOUGLAS MACARTHUR ES ADDITIONS AND RENOVATIONS

DETAILS AND

SPECIFICATIONS

GIBRALTAR DESIGN

C-4.3

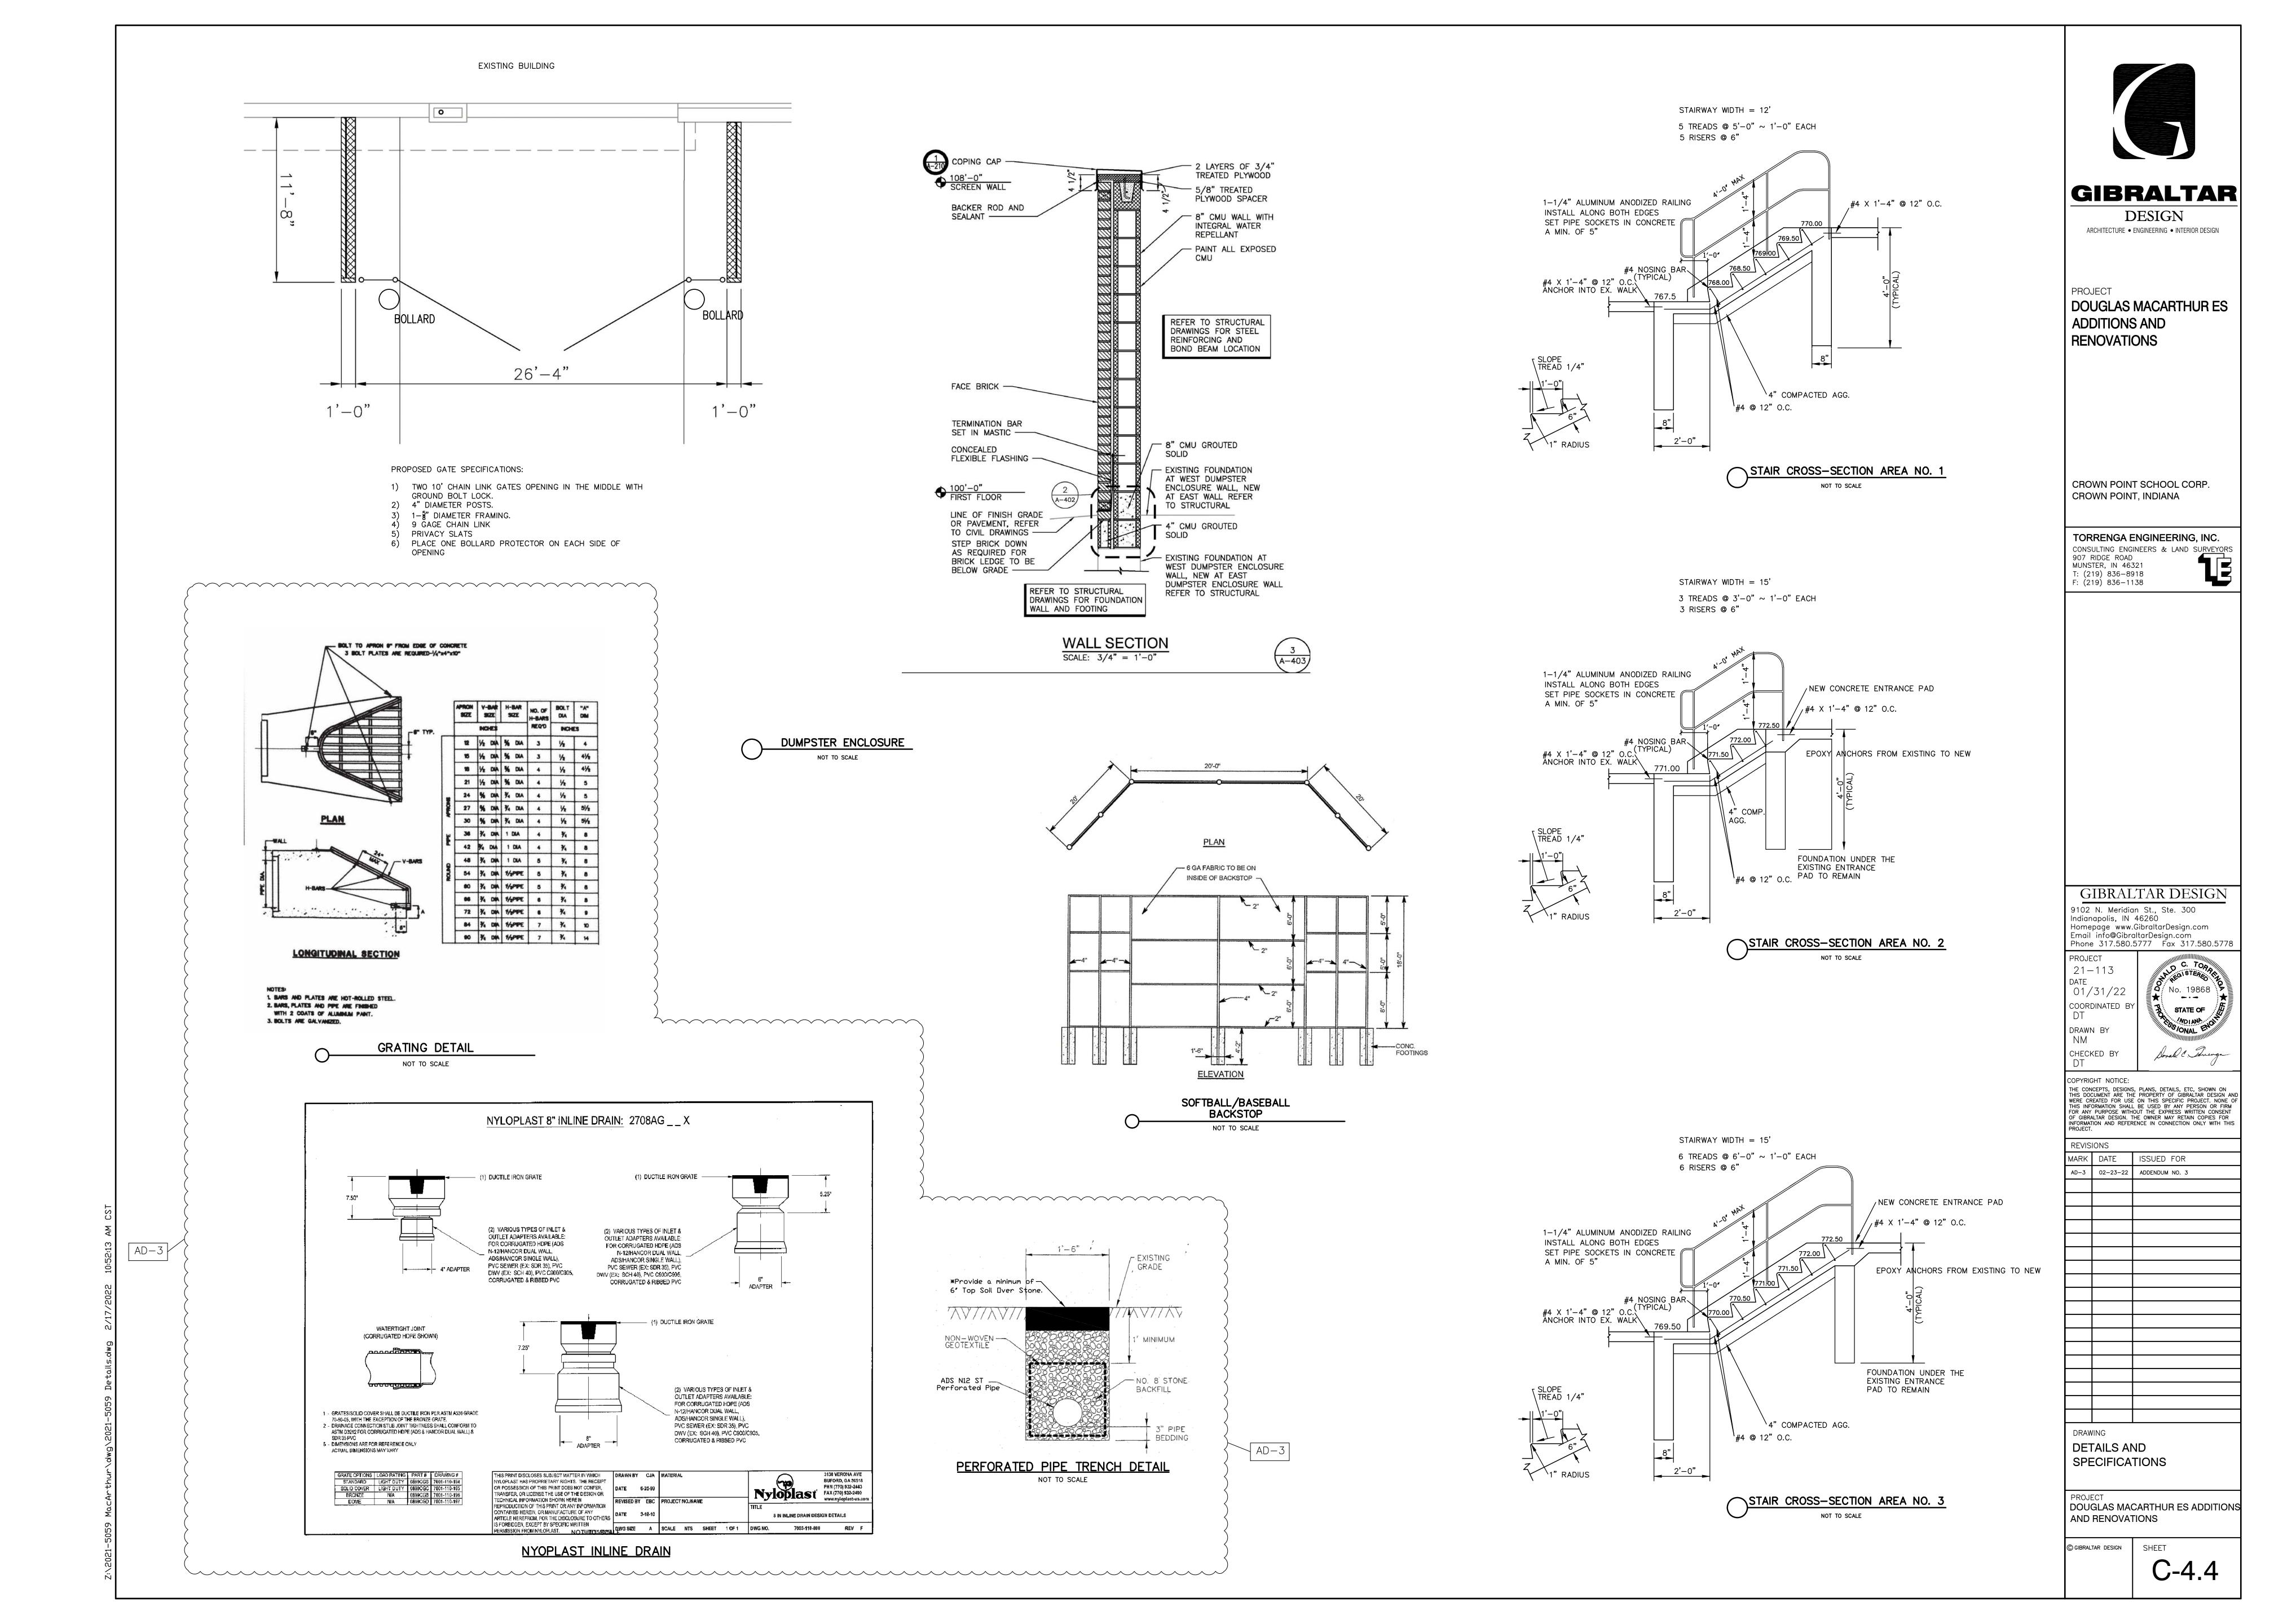



-SITE





MAP UNIT SYMBOL MAP UNIT NAME
BIA BLOUNT SILT LOAM, LAKE MICHIGAN LOBE, 0 TO 2 PERCENT SLOPES
OZAC2 OZAUKEE SILT LOAM, 6 TO 12 PERCENT SLOPES, ERODED

OZAUKEE SILT LOAM, 2 TO 6 PERCENT SLOPES

1. FOR POST—CONSTRUCTION STORM WATER POLLUTION PREVENTION, TEMPORARY SEEDING LOCATIONS SHALL BE PERMANANTLY SEEDED, EROSION CONTROL BLANKET SHALL REMAIN IN PLACE, TURF REINFORCED MAT SHALL REMAIN IN PLACE, AND ROCK CHUTES AT FLARED END SECTIONS SHALL REMAIN IN PLACE.

GENERAL NOTES:

1. THIS PROPERTY IS LOCATED IN FLOOD ZONE X (UNSHADED) AS DETERMINED BY USING SCALE MEASUREMENT FOR LOCATION UPON THE APPLICABLE FLOOD INSURANCE RATE MAP FOR THE TOWN OF CEDAR LAKE, LAKE COUNTY, INDIANA AS SHOWN IN COMMUNITY PANEL(S) 18089C0243E EFFECTIVE JANUARY 18, 2012. TRACTS OF LAND LOCATED IN FLOOD ZONE X (UNSHADED) ARE AREAS DETERMINED TO BE OUTSIDE OF THE 0.2% ANNUAL CHANCE FLOODPLAIN.

2. 07120001130060 LAKE DALECARLIA - CEDAR LAKE

3. STATE OR FEDERAL WATER QUALITY PERMITS ARE REQUIRED FOR THE PROJECT, A NATIONAL POLLUTANT DISCHARGE ELIMINATION SYSTEM (NPDES) IDEM RULE 5 WATER QUALITY PERMIT IS REQUIRED.

4. AT PRESENT THE SITE IS A SCHOOL CONTAINING A BUILDING, PARKING LOTS, AND PLAYGROUND AREAS.

5. THERE IS NO PRESENCE OF HYDRIC SOILS ON THIS PROPERTY, (PC) PEWAMO SILTY CLAY LOAM.

6. THERE ARE NO EXISTING WETLAND AREAS ON THIS PROPERTY AND DO NOT EXIST ON ADJACENT PROPERTY AS CLASSIFIED BY THE U.S. FISH AND WILDLIFE SERVICE, NATIONAL WETLANDS INVENTORY, AND THE UNITED STATES DEPARTMENT OF THE INTERIOR. THERE ARE NO LAKES, BUT A WATER COURSE DOES EXIST ON THIS PROPERTY. LAKE DALECARLIA — CEDAR LAKE IS THE WATER COURSE WHICH THE STORMWATER FROM THE SITE WILL ULTIMATELY DISCHARGE INTO WHICH IS LOCATED APPROXIMATELY 1/4 MILE SOUTHWEST OF THIS PROPERTY.

7. POTENTIAL SOURCE OF STORM WATER DISCHARGE ENTERING THE GROUNDWATER FROM THIS DEVELOPMENT WILL BE THROUGH NATURAL GROUND ABSORPTION ONLY. THERE ARE NO ABANDONED WELLS OR SINKHOLES ON THE PROPERTY.

8. THERE ARE NO SENSITIVE AREAS ASSOCIATED WITH THIS PROPERTY.

9. THERE ARE NO REGULATED DRAINS WITHIN THIS PROPERTY, OR ON ADJACENT PROPERTIES. THERE IS NO RECORD OR KNOWLEDGE OF EXISTING FARM DRAINS OR FIELD TILE, INLETS AND OUTFALLS LOCATED WITHIN THE EXISTING PROPERTY LIMITS.

10. SOIL STOCKPILES, BORROW AND DISPOSAL AREAS ARE LOCATED WITHIN THE PROJECT SITE. SOIL STOCKPILES SHALL BE SURROUNDED WITH SILT FENCING AT ALL TIMES TO PREVENT EXCESSIVE EROSION, AND IF LEFT UNDISTURBED FOR A PERIOD OF MORE THAN 14 DAYS, IT SHALL BE TEMPORARY SEEDED. UPON SITE COMPLETION THE TOPSOIL STOCKPILE SHALL BE RESPREAD, GRADED, AND PERMANENTLY SEEDED. SOIL STOCKPILES SHALL NOT BE LEFT ON THE SITE FOR GREATER THAN 6 MONTHS AFTER CONSTRUCTION IS COMPLETED. NO SOIL FROM THE STOCKPILES SHALL BE REMOVED FROM THE SITE. ALL EXTRA STOCKPILE MATERIAL SHALL BE RESPREAD IN AREAS DESIGNATED BY THE CONSTRUCTION MANAGER.

11. AREAS WHERE THE PROPOSED DETENTION AREA, BUILDING, AND DRIVES AS WELL AS AREAS WHERE PROPOSED UTILITIES ARE LOCATED WILL BE DISTURBED DURING CONSTRUCTION. IN ALL OTHER AREAS, EXISTING VEGETATIVE COVER WILL BE PRESERVED.

12. FUEL STORAGE AREA IF REQUIRED SHALL BE WITHIN THE CONSTRUCTION STAGING AREA, FUEL SHALL BE STORED IN APPROVED MOBILE REFUELING TANK LOCATED AWAY FROM DRAINAGE STRUCTURES AND CHANNELS. FIRE EXTINGUISHERS SHALL BE LOCATED NEAR FUEL STORAGE AREA AND BE OF SUITABLE TYPE, POSTED, AND BE MAINTAINED IN GOOD CONDITION.

13. TEMPORARY SEED ALL AREAS OF BARE SOIL (WITH THE ADDITION OF A BLANKET WHERE SLOPES ARE 4:1 OR GREATER) THAT WILL REMAIN UNDISTURBED FOR A PERIOD OF MORE THAN 14 DAYS. SEEDING: OPTIMUM SEEDING DATED ARE MARCH 1 — MAY 10 AND AUGUST 10 — SEPTEMBER 30. SEEDING DATES BETWEEN MAY 10 AND AUGUST 10, MAY NEED TO BE IRRIGATED. FOR SEEDING RECOMMENDATIONS SEE PRACTICE 3.12, INDIANA STORM WATER QUALITY MANUAL.

LEFT INACTIVE FOR FOURTEEN (14) CALENDAR DAYS OR MORE MUST BE TEMPORARILY OR PERMANENTLY SEEDED WITH MEASURES APPROPRIATE FOR THE SEASON.

14. ALL SOIL STOCKPILES, AREAS THAT ARE DISTURBED DURING CONSTRUCTION, AND DRAINAGE SWALES WHICH ARE SCHEDULED OR LIKELY TO BE

15. LOCATION OF TOWN'S STORMWATER PERMIT AND THE ON-SITE POSTING OF THE COMPLETE RULE 5 NOI WITH ASSIGNED PERMIT NUMBER, NOS LETTERS AND LOCATION OF THE COMPLETE SET OF ENGINEERING PLANS, SHALL BE AVAILABLE AT THE ENTRANCE TO THE SITE AND VISIBLE TO THE

16. ALL APPLICABLE MATERIAL SAFETY DATA SHEETS (MSDS) SHOULD BE INCLUDED ON—SITE FOR MATERIALS EXPECTED POLLUTANTS OF CONCERN FOR THE PROJECT SITE.

17. SITE ELEVATIONS ARE BASED ON NAVD 88, AND HORIZONTAL DATUM IS BASED ON INDIANA STATE PLANE COORDINATES NAD 83.

Temporary stabilization plans and sequence of implementation.

- a. On site posting of the complete Rule 5 NOI, NOS letter, and Town Stormwater Permit. Location of the posting and plans shall be made available by the owners contractor.
- b. Installation of all erosion/sedimentation controls including stabilized construction entrance, silt fences, etc... per the engineering plans.
 c. Clearing and grubbing
 d. Topsoil stockpile surrounded with silt fencing.
- e. Rough cut and fill of all proposed detention area, and other major grading per the engineering plans shall be done to rough grades at the start of construction to prevent excessive soil erosion due to construction.
- f. Silt fence to be placed around the perimeter of the detention basin once it has been completed and stabilized.
 g. Construction of storm sewers and other utility.
- h. Implementation of storm sewer inlet protection at each open—grate structure (basket insert inlet protection, as per engineering plans).
 i. Construct buildings and driveway.
- j. Upon site completion when no additional disturbance is anticipated stockpile shall be respread, graded, and all disturbed areas shall be permanent seeded, mulched, and landscaped.

 **Complete permanent erosion control and restoration of site vacatation. Fresion control measures are to be removed upon permanent vacatative.
- k. Complete permanent erosion control and restoration of site vegetation. Erosion control measures are to be removed upon permanent vegetative cover being established. Note the NOI letter will remain active until NOT letter is filed, weekly inspections and inspections after a 0.5—inch rainfall event shall be required by owner.
 I. Submit NOT letter for Rule 5.

SWPPP LEGEND:

- T

TEMPORARY ENTRANCE/EXIT (GRAVEL OR MAT)

- SOIL STOCK PILE

B - BASKET INSERT INLET PROTECTION

-GD - GRADE LIMITS


— SF — SILT FENCE

CW — CONCRETE WASH OUT AREA

 POSTING RULE 5 NOI & NOS LETTERS AND LOCAL SWPPP PERMIT

P = GRADES (PRO

- STREET SWEEPING
- EROSION CONTROL BLANKET

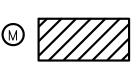

- TURF REINFORCEMENT MAT

NORTH
GRAPHIC SCALE

(IN FEET)
1 inch = 40 ft.



DESIGN

ARCHITECTURE ◆ ENGINEERING ◆ INTERIOR DESIGN

PROJECT

DOUGLAS MACARTHUR ES ADDITIONS AND RENOVATIONS

CROWN POINT SCHOOL CORP.

CROWN POINT, INDIANA

F: (219) 836-1138

TORRENGA ENGINEERING, INC.

CONSULTING ENGINEERS & LAND SURVEYORS
907 RIDGE ROAD
MUNSTER, IN 46321
T: (219) 836-8918

GIBRALTAR DESIGN
9102 N. Meridian St., Ste. 300
Indianapolis, IN 46260
Homepage www.GibraltarDesign.com

PROJECT
21-113
DATE
01/31/22
COORDINATED BY
DT

PROJECT
21-113
STATE OF
WOLANG

PROJECT
21-113
STATE OF
STATE

Email info@GibraltarDesign.com

COORDINATED BY DT

DRAWN BY
DT RT

CHECKED BY
DT

COPYRIGHT NOTICE:

THE CONCEPTS, DESIGNS, PLANS, DETAILS, ETC, SHOWN ON THIS DOCUMENT ARE THE PROPERTY OF GIBRALTAR DESIGN AND WERE CREATED FOR USE ON THIS SPECIFIC PROJECT. NONE OF THIS INFORMATION SHALL BE USED BY ANY PERSON OR FIRM FOR ANY PURPOSE WITHOUT THE EXPRESS WRITTEN CONSENT OF GIBRALTAR DESIGN. THE OWNER MAY RETAIN COPIES FOR INFORMATION AND REFERENCE IN CONNECTION ONLY WITH THIS PROJECT.

REVISIONS

MARK DATE ISSUED FOR

AD-3 02-23-22 ADDENDUM NO. 3

DRAWING
STORM WATER POLLUTION
PREVENTION PLAN

PROJECT

DOUGLAS MACARTHUR ES ADDITIONS

AND RENOVATIONS

© GIBRALTAR DESIGN SHEET

C-5.0

Purpose: To protect slopes, stream banks and channels, which are subject to erosion. Where run off velocity is great, at the outlet pipe of a detention basin, channel or culvert.

Rock: Hard angular, weather-resistant and well graded stone, the largest pieces should not exceed two times the specified stone diameter.

Thickness: 12" minimum or two times the specified stone diameter, which ever is greater.

Filter: Under permanent riprap install geotextile fabric for stabilization and filtration **Installation:**

Subgrade Replacement:

Remove brush, trees, stumps, and other debris. 2. Excavate only deep enough for both filter and riprap.

Filter Placement:


1. Place geotextile fabric on a smoothed foundation, overlap the edges at least 12 inches and secure with anchor pins spaced every 3 feet along the overlap. 2. If fabric is damaged, remove the riprap and repair damaged area by 12 inches.

RipRap Replacement:

Immediately after installing the filter, add the riprap to full thickness in one operation to the design elevation, and extend riprap to the top of the bank. Place smaller rock in voids to form a dense, uniform, well-graded mass.

Blend the riprap smoothly to the surrounding grade. Stabilize all disturbed areas immediately following installation.

1. Inspect periodically for displaced rock material, slumping, and erosion at edges, especially down stream or down slope.

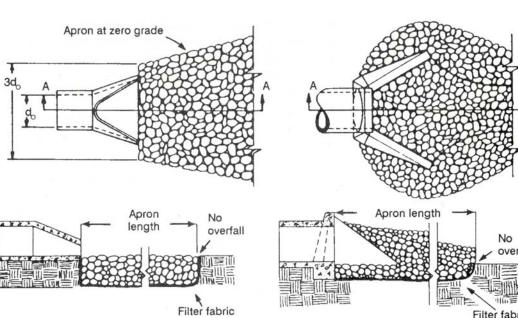

Pipe outlet aprons for a channel (left) that is not well defined and (right) that is well defined.

FABRIC DROP INLET PROTECTION

system during the construction period.

Purpose: To capture sediment at the entrance to a storm drain, allowing full use of the storm drain

Requirements: Contributing Area: 1 acre maximum. Capacity: Fabric material:

Height of fabric:

Approach:

Runoff from 2-yr, 24-hr. Storm without bypass flow. Geotextile fabric for filtration. 1 to 1-1/2 ft., measured from top of inlet. Pool area flat (less than 1% slope) with sediment storage of 945 cu.ft./acre disturbed.


Stability: Structure must withstand 1-1/2 ft. head of water and sediment without collapsing or undercutting. Support posts: Steel fence post or 2 x 2 in. or 2 x 4 in. hard wood post, 3 ft. min. length, 3 ft. max. spacing; top of frame support recommended. Cross bracing tops of posts to opposite corners greatly strengthens support.


1. To prevent runoff from bypassing the inlet, set top of the fabric at least 6" below the downslope ground elevation, or build a temporary dike (compacted to 6" higher than the fabric) on the low side of the inlet. (See Exhibit 3.52-C). 2. Cut the fabric from a single roll to eliminate joints. (Provide at least 2' of overlap if a

joint is needed) 3. Bury the bottom of the fabric at least 1 ft. deep, backfill, and compact the backfill (See Exhibit 3.52-B). 4. Space the support posts evenly against the inlet perimeter a maximum of 3 ft. apart, and drive the about 1-1/2 ft. into the ground. (Overflow must fall directly into the inlet and not on unprotected soil.

Inspect the fabric barrier after storm events, and make needed repairs immediately. Remove sediment from the pool area to provide storage for the next storm. Avoid damaging or undercutting the fabric during sediment removal.

3. When the contributing drainage area has been stabilized, remove and properly dispose of all construction material and sediment, grade area to the elevation on the top of the inlet, then stabilize.

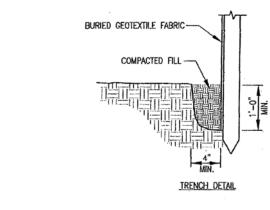

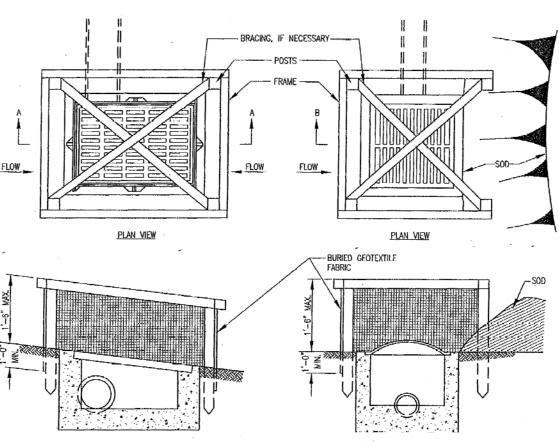

BASKET INLET PROTECTION

Purpose: To prevent excessive sediment from entering storm sewers at curb inlets, allowing full use of the storm drain system during the construction period.


Requirements: (At owner's discretion either a Basket type or Sack type may be ussed.) Basket type: Fabricated metal with top width-length dimensions such that the basket fits into the inlet without gaps, and line it with geotextile fabric for filtration, Marathon Materials, Inc. Catch-All inlet protectors or approved equal.


Sack type: Open-top geotextile fabric underneath a storm grate, for flat grate and mountable curb inlet Mirafi Dandy Curb Sack or Dandy Sack or approved equal.

Installation: 1. Install basket curb inlet protections as soon as inlet boxes are installed in a new development or before land disturbing activities begin in a stabilized area.

2. Remove the grate, and place the basket in the inlet. 3. Cut and install a piece of filter fabric large enough to line the inside of the basket and extend at least 6 in. beyond the frame. 4. Replace the inlet grate, which also serves to anchor the fabric.

Maintenance: 1. Inspect after each storm event 2. Remove built-up sediment and replace the Geotextile fabric after each storm event.

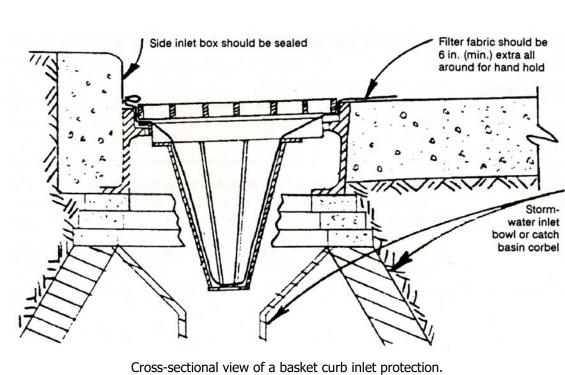

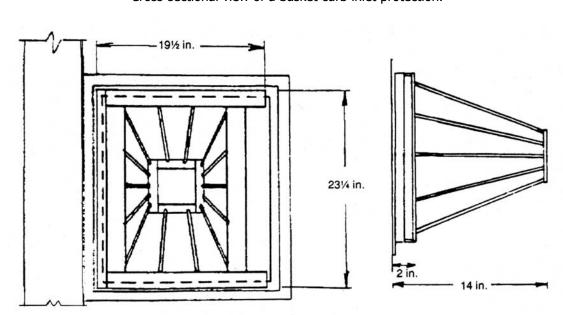

Top view (left) and front view (right) of a basket curb inlet protection.

SILT FENCE

Purpose: To retain sediment from small sloping disturbed areas by reducing the velocity of sheet

Trench: 8" minimum depth, flat bottom or v-shaped, filled with compacted soil or gravel to bury lower portion of support wire and/or fence fabric. 2" x 2" hardwood posts set at lease 1 foot deep.

Spacing of Posts: 8-foot maximum if fence supported by wire, otherwise 6 foot for extra strength fabric without wire backing.

A 3 feet minimum or high enough so depth of impounded water does not exceed 1.5 feet at any point along fence line. 14 gauge, 6" mesh wire fence. (needed if using standard-strength fabric Support wire:

Fence Fabric: Woven or non-woven Geotextile fabric with specified filtering efficiency and tensile strength and containing UV inhibitors and stabilizers to ensure 6 months minimum life at temperatures 0-120 degrees F.

Installation: 1. Along the entire intended fence line, maintain contour as much as possible, dig an 8"

deep flat bottom or v-shaped trench. 2. On the downslope side of the trench, drive the post at least 1 foot into the ground. (Note: If the fence has pre-attached posts or stakes, drive them deep enough so the fabric is satisfactorily in the trench per step 6) 3. Fasten support wire fence to the upslope side of the posts, extending it 8" into trench.

(use only if required by manufacturer) Run a continuous length of Geotextile fabric along upslope side of posts. 5. If a joint is necessary, nail the overlap to the nearest post with a wood lath. 6. Place the bottom 1' of fabric in the 8" deep trench, extending the remaining 4" of fabric


toward the upslope side. Backfill the trench with compacted earth.

(optional)

Inspect silt fence periodically and after each storm event.

If fence fabric tears, starts to decompose, or becomes ineffective, replace the affected Remove deposited sediment when it reaches half the height of the fence at its lowest point or is causing the fabric to bulge.

Take care to avoid undermining the fence during clean out. After watershed has been stabilized, remove fence and sediment deposits, bring the disturbed area to grade and stabilize.

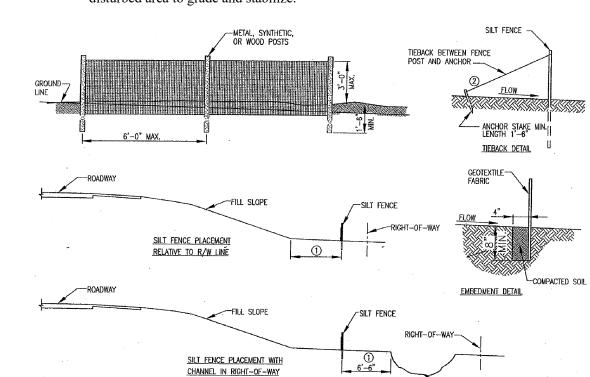

Detailed example of silt fence installation

CONCRETE WASHOUT

Purpose: To reduce the discharge of pollutants associated with concrete waste through consolidation of solids and retention of liquids.

1.) Locate concrete washout systems at least 50 feet from any creeks, wetlands, ditches, karst features, or storm drains/manmade conveyance systems. 2.) Locate concrete washout systems in relatively flat areas with established vegetative

cover and do not receive runoff from adjacent land areas. 3.) Locate in areas that provide easy access for concrete trucks and other construction

4.) Locate away from other construction traffic to reduce the potential for damage to the

5.) Minimum of ten millimeter polyethylene sheeting that is free of holes, tears, and other defects. The sheeting selected should be of an appropriate size to fit the washout system without seams or overlap of the lining.

6.) Signage.

Orange safety fencing or equivalent. Straw bales, sandbags (bags should be ultraviolet-stabilized geotextile fabric), soil material, or other appropriate materials that can be used to construct a containment system (above grade systems).

1.) Dependent upon the type of system, either excavate the pit or install the containment

2.) A base shall be constructed and prepared that is free of rocks and other debris that may cause tears or punctures in the polyethylene lining. 3.) Install the polyethylene lining. For excavated systems, the lining should extend over the entire excavation. The lining for bermed systems should be installed over the pooling area

with enough material to extend the lining over the berm or containment system. The lining

should be secured with pins, staples, or other fasteners. 4.) Place flags, safety fencing, or equivalent to provide a barrier to construction equipment and other traffic.

5.) Place a non-collapsing, non-water holding cover over the washout facility prior to a predicted rainfall event to prevent accumulation of water and possible overflow of the system (optional).

6.) Install signage that identifies concrete washout areas. 7.) Post signs directing contractors and suppliers to designated locations.

Maintenance:

1.) Inspect daily and after each storm event. 2.) Inspect the integrity of the overall structure including, where applicable, the

Inspect the system for leaks, spills, and tracking of soil by equipment.

Inspect the polyethylene lining for failure, including tears and punctures. Once concrete wastes harden, remove and dispose of the material.

Excess concrete should be removed when the washout system reaches 50 percent of the design capacity. Use of the system should be discontinued until appropriate measures can be initiated to clean the structure. Prefabricated systems should also utilize this criterion, unless the manufacturer has alternate specifications. 7.) Upon removal of the solids, inspect the structure. Repair the structure as needed or

construct a new system. 8.) Dispose of all concrete in a legal manner. Reuse the material on site, recycle, or haul the material to an approved construction/demolition landfill site. Recycling of material is encouraged. The waste material can be used for multiple applications including but not

9.) The plastic liner should be replaced after every cleaning; the removal of material will usually damage the lining. 10.) The concrete washout system should be repaired or enlarged as necessary to maintain

limited to roadbeds and building. The availability for recycling should be checked locally.

capacity for concrete waste. 11.) Concrete washout systems are designed to promote evaporation. However, if the liquids do not evaporate and the system is near capacity it may be necessary to vacuum or remove the liquids and dispose of them in an acceptable method. Disposal may be allowed at the local sanitary sewer authority provided their National Pollutant Discharge Elimination System permits allow for acceptance of this material. Another option would be to utilize a


secondary containment system or basin for further dewatering.

12.) Prefabricated units are often pumped and the company supplying the unit provides this 13.) Inspect construction activities on a regular basis to ensure suppliers, contractors, and

others are utilizing designated washout areas. If concrete waste is being disposed of improperly, identify the violators and take appropriate action. 14.) When concrete washout systems are no longer required, the concrete washout systems shall be closed. Dispose of all hardened concrete and other materials used to construct the

15.) Holes, depressions and other land disturbances associated with the system should be backfilled, graded, and stabilized.

1.) Concrete washout areas will be properly posted with signage indicating location and

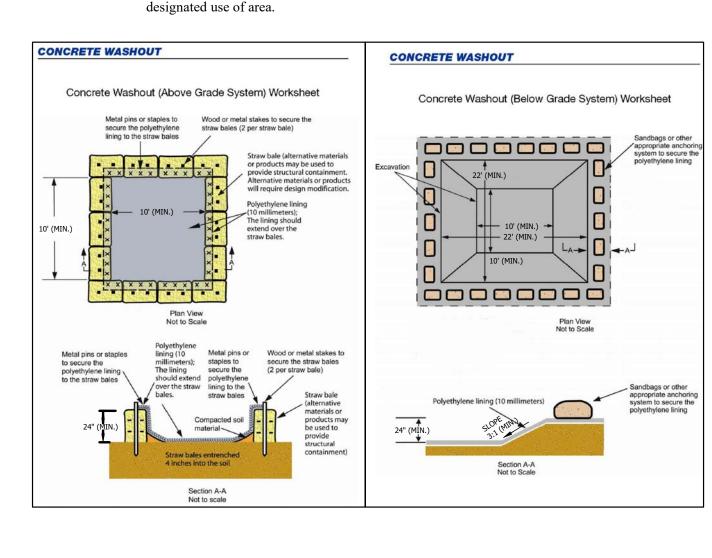

PROJECT

DOUGLAS MACARTHUR ES **ADDITIONS AND** RENOVATIONS

GIBRALTAR

DESIGN ARCHITECTURE ● ENGINEERING ● INTERIOR DESIGN

CROWN POINT SCHOOL CORP. CROWN POINT, INDIANA

TORRENGA ENGINEERING, INC. CONSULTING ENGINEERS & LAND SURVEYOR 907 RIDGE ROAD MUNSTER, IN 46321 T: (219) 836-8918

F: (219) 836-1138

GIBRALTAR DESIGN 9102 N. Meridian St., Ste. 300 ndianapolis, IN 46260 lomepage www.GibraltarDesign.com


Email info@GibraltarDesign.com Phone 317.580.5777 Fax 317.580.5778 PROJECT 21-113 01/31/22 COORDINATED E

DRAWN BY DCT

REVISIONS

MARK DATE ISSUED FOR

CHECKED BY

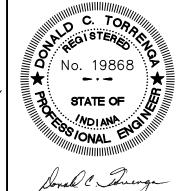

COPYRIGHT NOTICE: THE CONCEPTS, DESIGNS, PLANS, DETAILS, ETC, SHOWN ON THIS DOCUMENT ARE THE PROPERTY OF GIBRALTAR DESIGN AND WERE CREATED FOR USE ON THIS SPECIFIC PROJECT. NONE OF THIS INFORMATION SHALL BE USED BY ANY PERSON OR FIRM FOR ANY PURPOSE WITHOUT THE EXPRESS WRITTEN CONSENT OF GIBRALTAR DESIGN. THE OWNER MAY RETAIN COPIES FOR INFORMATION AND REFERENCE IN CONNECTION ONLY WITH THIS PROJECT.

AD-3 02-23-22 ADDENDUM NO. 3

DRAWING SWPPP DETAILS &

SPECIFICATIONS

AND RENOVATIONS

DOUGLAS MACARTHUR ES ADDITIONS

DETAIL OF EXISTING EASTERN DETENTION BASIN STRUCTURE AND EXISTING OXIFICE.

DETAIL OF EXISTING WESTERN DETENTION BASIN STRUCTURE AND EXISTING ORIFICE.

12" HDPE - Invert @ 761.48 -

C-6.1

© GIBRALTAR DESIGN SHEET

EXISTING CONSTRUCTION

- 1. The contractor shall field verify the dimensions, elevations, etc. necessary for the proper construction and alignment of the new portions of the work to the existing work. The Contractor shall make all necessary measurements for fabrication and erection of the structural members. Any discrepancy shall be immediately brought to the attention of the Structural Engineer of Record.
- Before proceeding with any work within the existing facility, the Contractor shall familiarize himself with existing structural and other conditions. Any shoring shown or noted on the Plans is a partial and schematic representation of that required. It shall be the Contractor's responsibility to provide all necessary bracing, shoring, and other safeguards to maintain all parts of the work in a safe condition during the progress of demolition and construction, and to protect from damage those portions of the existing work
- which are to remain. Shoring shall remain in place until the structural work is complete, has been inspected by the Testing Agency, and is certified to be in substantial compliance with the Contract Documents. 3. When required by the Specifications or by Plan Note, the Contractor shall submit for the Structural Engineer of Record's review, a "Proposed Shoring Plan," including, but not limited to: plans, sections, details, notes, description of proposed sequence of work, and calculations prepared by, or under the supervision of a
- Specialty Structural Engineer (SSE). The SSE shall be registered in the State where the project is located. 4. Welding to and within an existing facility presents potential hazards including:

Recommendations to prevent these hazards include:

- A. Fire Hazard Due to the existing construction and building contents. B. Structural Liquefaction - Due to welding across the full section of the structural members.
- A. Fire Hazard Protect existing combustibles prior to welding. Keep a separate watchman and
- several fire extinguishers on hand.
- B. Structural Liquefaction weld in small increments. Allow welds to harden before continuing to the next increment.
- C. Do not leave the site until satisfied that no fire hazard exists.
- D. Preference should be given to the use of beam clamps, mechanical fasteners, or bolted connections in lieu of welding within existing facilities, whenever possible. Do not field-drill existing structural members without the written permission of the Structural Engineer of Record.

COORDINATION WITH OTHER TRADES

- 1. The Contractor shall coordinate and check all dimensions relating to Architectural finishes, mechanical equipment and openings, elevator shafts and overrides, etc. and notify the Architect/Engineer of any discrepancies before proceeding with any work in the area under question.
- 2. The Structural Drawings shall be used in conjunction with the Drawings of all other disciplines and the Specifications. The Contractor shall verify the requirements of other trades as to sleeves, chases, hangers, inserts, anchors, holes, and other items to be placed or set in the Structural Work.
- 3. There shall be no vertical or horizontal sleeves set, or holes cut or drilled in any beam or column unless it is shown on the Structural Drawings or approved in writing by the Structural Engineer of Record. 4. Mechanical and electrical openings through supported slabs and walls, 8" diameter or larger, not shown on
- than 8" in diameter shall have at least 1'-0" clear between openings, unless approved in writing by the SER. 5. Verify locations and dimensions of mechanical and electrical openings through supported slabs and walls shown on the Structural Drawings with the Mechanical and Electrical Contractors.

the Structural Drawings must be approved by the Structural Engineer of Record (SER). Openings less

- 6. Do not install conduit in supported slabs, slabs on grade, or concrete walls unless explicitly shown or noted on the Structural Drawings.
- 7. Do not suspend any items, such as ductwork, mechanical or electrical fixtures, ceilings, etc. from steel roof deck or wood roof sheathing.
- 8. The Mechanical Contractor shall verify that mechanical units supported by the steel framing are capable of spanning the distance between the supporting members indicated on the Structural Drawings. The Mechanical Contractor shall supply additional support framing as required.
- 9. If drawings and specifications are in conflict, the most stringent restrictions and requirements shall govern.

GENERAL NOTES

- 1. The Contractor shall be responsible for complying with all safety precautions and regulations during the work. The Structural Engineer of Record will not advise on, nor issue direction as to safety precautions and programs. 2. The Structural Drawings herein represent the finished structure. The Contractor shall provide all temporary guying and bracing required to erect and hold the structure in proper alignment until all Structural Work and connections have been completed. The investigation, design, safety, adequacy and inspection of erection bracing, shoring, temporary supports, etc. is the sole responsibility of the Contractor.
- 3. The Structural Engineer of Record (SER) shall not be responsible for the methods, techniques and sequences are not specifically shown, similar details of construction shall be used, subject to approval of the SER. Drawings indicate general and typical details of construction. Where conditions are not specifically shown,
- similar details of construction shall be used, subject to approval of the Structural Engineer of Record. 5. All structural systems which are to be composed of components to be field erected shall be supervised by the Supplier during manufacturing, delivery, handling, storage, and erection in accordance with the Supplier's instructions and requirements.
- 6. Loading applied to the structure during the process of construction shall not exceed the safe loadcarrying capacity of the structural members. The live loading used in the design of this structure are indicated in the "Design Criteria Notes." Do not apply any construction loads until structural framing is properly connected together and until all temporary bracing is in place. 7. All ASTM and other referenced standards and codes are for the latest editions of these publications, unless otherwise noted.
- 8. Shop drawings and other items shall be submitted to the Structural Engineer of Record (SER) for review prior to fabrication. All Shop Drawings shall be reviewed by the Contractor before submittal. The SER's review is to be fore conformance with the design concept and general compliance with the relevant Contract Documents. The SER's review does not relieve the Contractor of the sole responsibility to review, check, and coordinate the Shop Drawings prior to submission. The Contractor remains solely responsible for errors and omissions associated with the preparation of Shop Drawings as they pertain to member sizes, details, dimensions, etc.
- 9. Submit Shop Drawings in the form of blueline/blackline prints (min. 2 sets/ max. 5 sets) and one reproducible blackline or sepia copy. In no case shall reproductions of the Contract Documents be used as shop drawings. As a minimum, submit the following items for review. A. Concrete Mix Design(s).
- B. Reinforcing Steel Shop Drawings.
- C. Structural Steel Shop Drawings.
- D. Steel Joist Shop Drawings E. Steel Deck Shop Drawings.
- F. Prefabricated Cold-Formed Steel Truss Systems.
- G. Cold-Formed Steel Framing Systems. 10. Resubmitted Shop Drawings: Resubmitted shop drawings are reviewed only for responses to
- comments made in the previous submittal. 11. When calculations are included in the submittals for components of work designed and certified by a Specialty Structural Engineer (SSE), the review by the Structural Engineer of Record (SER) shall be for conformance with the relevant Contract Documents. The SER's review does not relieve the SSE from responsibility for the design of the system(s) and the coordination with the elements of the structure
- the accuracy or completeness of the SSE's design. 12. Contractors shall visit the site prior to bid to ascertain conditions which may adversely affect the work

under the certification of the SER, or other SSE's. The SER's review does not constitute a warranty of

- 13. No structural member may be cut, notched, or otherwise reduced in strength without written direction from the Structural Engineer of Record.
- 14. When modifications are proposed to structural elements under the design and certification of a Specialty Structural Engineer (SSE), written authorization by the SSE must be obtained and submitted to the Structural Engineer of Record for review, prior to performing the proposed modification.

DESIGN CRITERIA

. DESIGN STANDARDS: The intended design standards and/or criteria are as follows: The 2014 Indiana Building Code (2012 International Building Code (IBC) with Indiana Amendments)

ACI 530 AISC Manual, Allowable Stress Design (ASD) Steel Joist Institute Steel Deck Steel Deck Institute Cold-Formed Metal AISI-ASD

(IBC 2012, 1607.1):

Ground Snow Load, Po

All referenced standards and codes, as well as ASTM numbers, are for the editions of these publications referenced in the Building Code listed above, unless otherwise noted.

2. DEAD LOADS: Gravity Dead Loads used in the design of the structure are as computed for the materials of construction incorporated into the building, including but not limited to walls, floors, ceilings, stairways, fixed partitions, finishes, cladding and other similar architectural and structural items, as well as mechanical, electrical and plumbing equipment and fixtures, and material handling and fixed service equipment, including the weight of cranes. 3. LIVE LOADS: Gravity live loads used in the design of the structure meet, or exceed the following table

	OCCUPANCY OR USE	UNIFORM (PSF)	CONCENTRATED (LB) [Note #1]
A.	Schools		
	 Classrooms 	40	
	2. First Floor Corridors	100	
	3. Mechanical Mezzanine	100	
	Note #1: Unless otherwi	se noted, the indicated concentrated I	oad has been assumed to be

- uniformly distributed over an area of 30" x 30". 4. PARTITION ALLOWANCE: a uniform partition allowance of 15 PSF has been used to account for the load of all floors where partition locations are subject to change, unless the specified live load exceeds 80 PSF. 5. COLLATERAL LOAD: Unless otherwise noted, a minimum uniform collateral load of 10 PSF has been used to account for ductwork, ceilings, sprinklers, lighting, etc. The collateral load is in addition to the weight of mechanical units, larger piping (greater than 4" diameter) and suspended fixtures or equipment
- that have been specifically accounted for in the design 6. COLLATERAL LOAD ABOVE CORRIDORS & MECHANICAL ROOMS: A minimum uniform collateral load of 20 PSF has been used to account for large ductwork, sprinkler mains, concentrations of piping, and electrical distribution above corridors and mechanical rooms. The collateral load is in addition to the weight of mechanical units and larger piping (greater than 4" diameter) and suspended fixtures or equipment that have been specifically accounted for in the design.
- 7. CONCENTRATED LOADS: All single panel points of the lower chord of exposed roof trusses or any point along the primary structural members supporting roofs over manufacturing, commercial storage and warehousing, and commercial garage floors shall be capable of carrying safely a suspended concentrated load of not less than 2000 LBS in addition to dead load. All single panel points of the lower chord of exposed roof trusses or any point along the primary structural
- members supporting roofs over all other occupancies shall be capable of carrying safely a suspended concentrated load of not less than 200 LBS in addition to dead load, unless noted. 8. HANDRAILS AND GUARDS
- A. Handrail Assemblies and Guards 50 PLF applied in any direction 200 LB concentrated load applied in any direction (non-concurrent with 50 PLF load) B. Components, Intermediate Rails, 50 LBS horizontally applied normal load Balusters, Fillers, Etc. on an area not to exceed 1 square foot not
- superimposed with those of handrail assemblies 9. ROOF LIVE/SNOW LOADS: Gravity Live Loads used in the design of the roof structure meet or exceed the following table: A. Snow Load

25 PSF

- 22 PSF Flat Roof Snow Load, P Low Slope Minimum Snow Load, Pm 20 PSF Exposure Factor, Ce Risk Category (IBC Table 1604.5) Snow Importance Factor, Is Thermal Factor, Ct
- Minimum Roof Live Load Overhang Eaves & Projections . Sloped roof snow loads calculated in accordance with Section 7.4, ASCE 7. Unbalanced roof snow loads calculated in accordance with Section 7.6, ASCE 7. Specialty Structural Engineers must consider unbalanced snow loads in the design of pre-engineered
- trusses, frames, skylights, curtain walls, cold-formed metal framing, canopies, etc. 3. Drift loads calculated in accordance with Section 7.7, ASCE 7. ATERAL LOADS: Lateral loads were computed using the following criteria
- 120 MPH Ultimate Design Wind Speed, Vult 89 MPH Nominal Design Wind Speed, Vasd Wind Exposure Category Risk Category (IBC Table 1604.5) Internal Pressure Coefficient, GCpi ± 0.18 . Seismic Load
- Site Classification Risk Category (IBC Table 1604.5) Seismic Importance Factor, le Mapped Spectral Response Acceleration, Ss 0.131g Mapped Spectral Response Acceleration, S1 Design Spectral Response Acceleration, Sds 0.140g Design Spectral Response Acceleration, Sd1 Seismic Design Category, SDC Response Modification Coefficient, R
- 11. SAFETY FACTORS: This structure has been designed with 'Safety Factors' in accordance with accepted principles of structural engineering. The fundamental nature of the 'Safety Factor' is to compensate for uncertainties in the design, fabrication, and erection of structural building components. It is intended that ' Safety Factors' be used such that the load-carrying capacity of the structure does not fall below the design load and that the building will perform under design load without distress. While the use of 'Safety Factors' implies some excess capacity beyond design load, such excess capacity cannot be adequately predicted and SHALL NOT BE RELIED UPON.

REINFORCED MASONRY NOTES

- 1. All construction of reinforced masonry walls to be in accordance with the Building Code Requirements
- A) f'm = 2000 PSI
- B) Maximum height of masonry lift: 5'-0" C) Maximum height of grout lift: 5'-0"

for Concrete Masonry Structures (ACI 530) and Commentary.

- D) See Specifications for additional masonry wall information.
- 2. CONCRETE BLOCK: Minimum compressive test strength on the net cross-sectional area: 2800 PSI.
- MORTAR: Type S required.
- 4. GROUT: ASTM C476, 2500 PSI with a slump of 8" min. and 11" max. 5. REINFORCING: fy = 60000 PSI with a min. lap of 48 bar diameters.

LINTEL SCHEDULE

Where lintels are not specifically shown or noted on the Structural or Architectural Drawing	s, provide
the following lintels over all openings and recesses in both interior and exterior non-load-be	aring walls

the 1	following linte	els over all openings and rece	sses in both interior and e
A) Brick:		Masonry Opening	Angle Size
		Up to 5'-0"	L4x4x5/16
		Over 5'-0" & up to 7'-0"	L6x4x5/16

- All angles are LLV (long leg vertical), unless noted otherwise. Provide 1" of bearing per foot of span each end with minimum 8". All lintels in exterior walls are to be hot-dip galvanized B) Block: For openings up to 8'-0" long exposed in the finished room, use lintel block filled with grout.
- Grout all exposed joints and reinforce as follows: 1) For 6" thick block: 1 - #5 bar
- 2) For 8" thick block: 2 #5 bars 3) For 10" thick block: 2 - #6 bars 4) For 12" thick block: 2 - #6 bars
- C) Block: For openings over 8'-0" & up to 12'-0" long exposed in the finished room, use lintel block filled with grout. Grout all exposed joints and reinforce per the "Long Masonry Lintel Detail" on the Typical Masonry Detail Drawing.
- D) Block (stack bond openings over 4'-0"): See framing plans for steel beam lintels. Where not shown on plan, the criteria in the following table shall be used. Contact Structural Engineer of Record for lintels not shown on plan which do not meet this criteria. See architectural drawings for opening quantities, sizes, locations heights of wall above etc.

Block 't'	LINTEL	WIDTH OF OPENING	MAX. ALLOW. HEIGHT OF CMU ABOVE LINTEL
6"	C8x11.5 w/ CONTIN.	≤ 8'-0"	30'-0"
0"	PL 3/8 x 5	≤ 12'-0"	8'-0"
8" 10" 12"	PL 3/8 x7	≤ 8'-0"	30'-0"
		≤ 12'-0"	8'-0"
		≤ 8'-0"	25'-0"
		≤ 12'-0"	8'-0"
	W8x28 w/ CONTIN.	≤ 8'-0"	40'-0"
	PL 3/8 x11	≤ 12'-0"	18'-0"

LOAD BEARING WALL CMU LINTEL SCHEDULE

	LINTEL MARK	UNIT	DEPTH	BOTTOM REINF.	TOP REINF.	STIRRUPS (SIZE/SPC.)	LOOSE LINTELS AT BRICK LOCATIONS
	CMU-L1	14"	16"	(2) #8	(2) #8	#3 @ 8"o.c.	L7x4x3/8 (LLH)
AD-3	CMU-L2	12"	16"	(2) #7	(2) #7	#3 @ 8"o.c.	NONE
` `	EMU-L3	8"	16"	(2) #5	(2) #5	#3 @ 8"o.c.	L7x4x3/8 (LLH)
	NOTES:						

1. REFER TO DETAIL 8/S-404 FOR ADDITIONAL INFORMATION AND FOR CMU LINTELS LOCATED IN NON-LOAD BEARING WALLS. 2. VERTICAL CONTROL JOINTS MUST BE LOCATED AT LEAST 8" OFF OF JAMB OF OPENING. REFER TO DETAIL 3/S-404. 3. COORDINATE ALL DIMENSIONS TO LOCATE AND DEFINE OPENINGS W/ ARCHITECTURAL DRAWINGS (HEIGHT, WIDTH, LOCATION, ETC.).

FOUNDATIONS

- 1. Proofroll slab on grade areas with a medium-weight roller or other suitable equipment to check for pockets of soft material hidden beneath a thin crust of better soil. Any unsuitable materials thus exposed should be removed and replaced with compacted, engineered fill as outlined in the
- specifications. Proofrolling operations shall be monitored by the Geotechnical Testing Agency. 2. All engineered fill beneath slabs and over footings should be compacted to a dry density of at least 93% of the Modified Proctor maximum dry density (ASTM D-1557). All fill which shall be stressed by foundation loads shall be approved granular materials compacted to a dry density of at least 95% (ASTM D-1557). Coordinate all fill and compaction operations with the Specifications and the Subsurface Investigation. 3. Compaction shall be accomplished by placing fill in approximate 8" lifts and mechanically compacting
- each lift to at least the specified minimum dry density. For large areas of fill, field density tests shall be performed for each 3,000 square feet of building area for each lift as necessary to insure adequate compaction is being achieved.
- Column footings and wall footings to bear on firm natural soils or well-compacted engineered fill with allowable bearing pressures of 3,000 PSF and 2,500 PSF for column and wall footings respectively, as outlined in the Subsurface Investigation Report.
- It is essential that the foundations be inspected to insure that all loose, soft, or otherwise undesirable material (such as organics, existing uncontrolled fill, etc.) is removed and that the foundations will bear on satisfactory material. The Geotechnical Testing Agency shall inspect the subgrade and perform any necessary tests to insure that the actual bearing capacities meet or exceed the design capacities. The Geotechnical Testing Agency shall verify the bearing capacity at each spread column footing and every 10 feet on center for strip footings prior to placement of concrete.
- 5. Place footings the same day the excavation is performed. If this is not possible, the footings shall be adequately protected against any detrimental change in condition, such as from disturbance, rain, or 6. It is the responsibility of the Contractor and each Sub-Contractor to verify the location of all utilities and
- services shown, or not shown; and establish safe working conditions before commencing work. 7. The Contractor shall layout the entire building and field verify all dimensions prior to excavation. For information regarding subsurface conditions, refer to the Subsurface Investigation & Foundation

POST-INSTALLED DOWELS & ANCHOR BOLTS/RODS

Recommendation Report prepared by Professional Service Industries, Inc., PSI Project No. 00474864,

- 1. All reinforcing steel and threaded rod anchors to be installed in a 2-part chemical anchoring system shall be treated as follows:
- A. Drill holes larger than bar or rod to be embedded. Coordinate hole diameter with Manufacturer's recommendations. B. Holes must be cleaned and prepared in accordance with Manufacturer's recommendations. C. When reinforcing steel is encountered during drilling for installation of anchors; stop drilling, use a
- sensor to locate the reinforcing in the surrounding area and install anchor(s) as close as possible to the original location. Contact the Structural Engineer of Record (SER) for direction when the revised location is more than 2" from the original location, or when the original function of the anchorage is significantly altered. When in doubt, contact the SER for direction.
- D. Drill the hole a minimum of 15 bar diameters or as shown on the plans. E. Use a 2-part adhesive anchoring system, Hilti HY-200, or approved equal. F. For anchorage into hollow substrate, use Hilti HY-270, or approved equal.
- G. Reinforcing steel dowels shall be ASTM A615, Grade 60, unless noted. H. Anchor rods shall be Hilti HAS-V-36, unless noted. Provide finish as noted on the Drawings. If not noted, provide hot-dip galvanized finish for interior applications. Provide stainless steel finish for
- all exterior applications, unless noted. When column anchor bolts have been omitted, or damaged by construction operations, the Contractor must obtain the written approval of the Structural Engineer of Record prior to repair or replacement. A. As a precaution, the affected column must be guyed and braced after repair for the balance of the
- erection period. B. As an alternate to guying and bracing, the Contractor may at his option, employ a testing agency to perform a tensile pull test to confirm the strength for the repaired or replaced anchor bolt. The tensile proof load must exceed 1.33 x the design load of the original anchor without causing distress of the anchor bolt or the surrounding concrete. Reference the following table for the minimum proof loads: 3/4" diameter: 12.8 kips
- 7/8" diameter: 17.4 kips 1" diameter: 22.7 kips 1 1/8" diameter: 28.8 kips
- 1 1/4" diameter: 35.6 kips
- Note: Values listed above are for ASTM F-1554, Grade 36 material. When higher grade or allowable loads to be multiplied by 1.33.
- C. When affected anchor bolts are part of a fixed moment resisting column base, such as those in moment-resisting space frames, canopies, or fixed-base installations, the repaired anchor bolts must be proof-loaded, or the affected column footing and/or pier replaced in its entirety. D. When affected anchor bolts are part of a braced frame the affected column footing and/or pier
- must be replaced in its entirety. E. Prior to erection, the controlling Contractor must provide written notification to the Steel Erector if there has been a repair, replacement or modification of the anchor bolts for that column.

STRUCTURAL STEEL NOTES

- 1. Structural steel construction shall conform to the American Institute of Steel Construction
- 'Specification for Structural Steel Buildings" 2. All structural wide flange members shall be ASTM A992, Fy=50 ksi
- 3. All plates, channels, bars, angles, and rods shall be ASTM A36, unless noted. 4. All rectangular structural tube members shall be ASTM A500, Grade C, Fy = 50 ksi unless noted. 5. All round structural tube members shall be ASTM A500, Grade C, Fy = 46 ksi unless noted.
- 6. All structural pipe members shall be ASTM A53, Grade B, Fy=35 ksi unless noted. 7. Details for design, fabrication and erection of all structural steel shall be in accordance with the latest AISC Standards, unless otherwise noted or specified. 8. Provide temporary erection guying and bracing as required.
- 9. Unless otherwise shown or noted on the Drawings, provide 8" minimum bearing each end for all loose lintels and beams. 10. For loose lintels, masonry shelf angles and other such items generally not shown on the Structural
- Drawings, refer to the Architectural Drawings. See general notes on lintels this sheet for sizes, reinforcing, etc. 11. Steel columns below grade shall be encased in a minimum of 4" concrete or painted with 2 coats of asphaltum paint, unless otherwise shown.
- 12. Fabricate simple span beams not specifically noted to receive camber so that after erection, any minor camber due to rolling or shop assembly be upward. 13. Refer to the Division 5 Structural Steel Specification of the Project Manual for structural steel surface preparations and prime painting requirements.
- 14. The Erector shall shim between parallel roof beams and joists with differential mill and induced cambers for level deck bearing. 15. Provide cap plates/end plates to close off exposed, open ends of all tubular members, unless

noted. Seal weld with partial penetration square groove welds for watertight condition.

STEEL DECK NOTES 1. All steel deck material, fabrication and installation shall conform to the Steel Deck Institute "SDI SHORT FORM SPECIFICATIONS" and "SDI CODE OF STANDARD PRACTICE," current edition,

- 2. Provide members for deck support at all deck span changes. Provide L3x3x3/16 deck support at all columns where required 3. All deck shall be provided in a minimum of 3-span lengths where possible.
- 4. All welding of steel deck shall be in conformance with AWS Specification D1.3. Provide welding washers for all floor decks less than 22 gauge in thickness. 5. Mechanical fasteners may be used in lieu of welding, providing fasteners meet, or exceed the strength of specified welds. Submit fastener design data to the Structural Engineer of Record for review. Substitution of fiber secondary reinforcement for welded wire fabric on supported slabs is prohibited.
- 7. Do not suspend any items, such as ductwork, mechanical and electrical fixtures, ceilings, etc. from 8. Roof deck sidelaps shall be attached at ends of cantilevers and at a maximum spacing 12" o.c. from cantilevered roof deck ends. The roof deck must be completely fastened to the supports and at the
- sidelaps before any load is applied to the cantilever. 9. Submit shop drawings for review of general conformance to design concept in accordance with Specifications in the Project Manual. Erection drawings shall show type of deck, shop finish, accessories. method of attachment, edge details, deck openings and reinforcement, and sequence of installation. 10. Installation holes shall be sealed with a closure plate 2 gauges thicker than deck and mechanically fastened to deck. Steel deck holes visible from below will be rejected. Deck units that are bent, warped, or damaged in any way which would impair the strength and appearance of the deck shall be
- removed from the site. 11. Where gauge metal pourstops are indicated, supply pourstops designed to meet, or exceed the gauges listed in the SDI Pourstop Selection Table (min. 18 ga.) as required for slab depth, concrete weight, and cantilever distance, unless noted otherwise.
- 12. The Erector shall shim between parallel roof beams and joists with differential mill and induced cambers for level deck bearing.

STEEL STAIRS

- 1. Refer to the Design Criteria notes for live load and handrail requirements. All stair designs shall be provided by the Stair Manufacturer/Fabricator's Specialty Structural Engine
- and shall be stamped by a Professional Engineer registered in the State of Indiana. Stair designs shall be in accordance with all applicable code provisions of the IBC. 3. The Stair Manufacturer/Fabricator's Specialty Structural Engineer shall provide the Structural Engineer of Record with drawings showing location, direction and magnitudes of all stair load reactions on the building structure for approval, prior to fabrication.

guardrail design, shaft wall construction, etc.

4. The Stair Manufacturer/Fabricator shall coordinate the transition between the supported structural floor slab and the stair structure with the Structural Steel Fabricator, prior to fabrication. 5. Refer to the Architectural Drawings for stair width, rise, run, tread and riser geometry, handrail and

- STEEL CONNECTION NOTES 1. Typical beam-to-beam and beam-to-column connections shall be bearing type using A325 bolts, unless noted otherwise.
- 2. Shop connections unless otherwise shown, may be either bolted or welded. All field connections shall 3. Connections shall be designed by the Steel Fabricator to support the reactions shown on the framing plan(s). Simple span connections without reactions listed on the Structural Drawings shall be designed by
- the Steel Fabricator in accordance with Table 3-6 of the AISC "Manual of Steel Construction, 14th
- Edition". For composite beams where reactions are not indicated, design connections for 75% of the Maximum Total Uniform Load ASD value for the applicable beam size and span given in Table 3-6. For non-composite beams, design connections for 50% of the tabulated ASD value.
- 4. Submit calculations for connections not detailed on the Structural Drawings and not covered by the AISC Tables, including but not limited to: A) Column Splices.
- B) Moment Connections. C) Bracing Connections including Collectors and Drag Struts.

be bolted unless otherwise shown on the Structural Drawings.

- D) Skewed Shear Connections. E) Girder and Truss Splices.
- F) Truss-to-Column and Truss-to-Truss Connections. G) Truss Web-to-Chord and Web-to-Gusset Connections.
- H) Compression Ring/Tension Ring, and Raker Beam Connections. 5. All beam-to-beam connections shall be double angle, unless shown or noted otherwise.
- 6. All beam-to-column connections shall be at the column centerline, unless noted otherwise. Shear tab connections to tubes are permitted unless otherwise noted or detailed. 7. Typical beam-to-beam, and beam-to-column field-bolted connections may be tightened to the snug-
- tight condition, unless otherwise shown or noted. 8. Bolted connections in moment frames, bracing connections, hangers and stub columns, crane connections, and those designated PT (pretensioned) on the Drawings shall be pretensioned joints utilizing tension-control (TC) bolts or direct tension indicators. Holes for PT bolts shall be 1/16" larger
- than the bolt diameter. All pretensioned joints must be inspected by the Testing Agency. 9. Connect bracing members for two components of stress unless otherwise approved by the Structural Engineer of Record. Provide a minimum 2-bolt or welded field connection.
- 10. Locate centerlines of all vertical bracing members on column centerlines in vertical plane and on column and beam centerlines in horizontal plane, unless otherwise shown on the Structural Drawings. 11. All welding shall be in conformance with AWS D1.1, using E70XX electrodes, unless shown or noted otherwise. Welding, both shop and field, shall be performed by welders certified for the weld types and positions involved according to the current edition of AWS D1.1. Perform all AESS welds with care to provide a clean, uniform appearance.
- 12. Backup bars required for welded connections shall be continuous. 13. Holes in steel shall be drilled or punched. All slotted holes shall be provided with smooth edges. Burning of holes in structural steel shall not be allowed without approval of the Structural Engineer of Record.
- 14. The minimum thickness of all connection material shall be 5/16" unless noted. 15. Continuous bent plate and angle closures, roof edges, diaphragm chords, etc. around perimeter of the floor and roof, as well as around openings shall be welded with a minimum 1/4" fillet weld x 3" long at 12" o.c., top & bottom, unless noted otherwise. Butt weld joints in continuous diaphragm chord for continuity. For continuous perimeter angles and bent plates perpendicular to and connected to the top chords of joists, provide a minimum 3" of 1/4" weld at each joist. Continuous angle and bent plate closures may be shop-applied to the supporting structural members only when requested and
- approved by Structural Engineer of Record. 16. Where steel beams are called to have wood nailers supporting wood floor or roof framing, provide 1/2" diameter carriage bolts spaced at 24" on center and staggered each side of the beam web, unless noted otherwise. Carriage bolts may be over-tightened to compress the rounded head in the nailer to
- facilitate installation of continuous band/rim joists, rafters, trusses, etc. 17. A qualified independent Testing Agency shall be retained to perform inspection and testing of structural steel field weldaments as follows:

WELD INSPECTION SCHEDULE						
ELD TYPE	VT	MT	UT	PT	CRT	COMMENTS
LLET (SINGLE ASS)	25%	-	-	-	-	ROOT PASS AND FINISHED WELD
LLET MULTIPLE PASS)	50%	25%	•	•	ı	
LARE BEVEL/ LARE V	25%		•	•	ı	
ROOVE (PARTIAL ENETRATION)	100%		100%	-	-	REFERENCE NOTE 'E' BELOW
ROOVE (FULL ENETRATION)	100%	-	100%	-	-	ALL FULL PENE- TRATION WELDS

- A) Test procedures: VT = Visual Test (inspection)
- MT = Magnetic Particle Test: ASTM E109, cracks or incomplete fusion or penetration not acceptable. UT = Ultrasonic Test: ASTM E164.
- PT = Penetrant Test: ASTM E165. RT = Radiographic Test: ASTM E94 and ASTM E142, min. quality level 2-21.
- B) Acceptance standards in AWS D1.1 shall be followed for each test procedure. Test procedures may be substituted to meet feasibility requirements of test based upon weld geometry or other factors with the approval of the Structural Engineer of Record.
- D) Samples shall occur at random locations; additional tests may be required at locations noted on the E) Groove welds include square, bevel, V, U, and J grooves including single and double pass types.
- F) Partial penetration square groove welds at end seal plates of tubular members do not require inspection. G) Weld Procedure Specifications (WPS) shall be produced and maintained in accordance with AWS D1.1. The independent Testing Agency shall have access to all WPS's during the course of testing and H) For highly-restrained welded joints, especially in thick plates and/or heavy structural shapes, details the

welds so that shrinkage occurs as much as possible in the direction the steel was rolled. Refer to the

AISC Manual for preferred welded-joint arrangements that reduce the possibility for lamellar tearing.

Members scheduled to receive highly-restrained connections shall be tested by the independent Testing Agency by Ultrasonic Testing prior to commencing welding. I) In addition to inspection requirements for fillet welds in Table above, 100% of field welding of diagonal

STEEL JOIST NOTES

1. All steel joists shall be designed, fabricated, and erected in accordance with SJI Standard

bracing members to gusset plates shall be visually inspected (VT).

- 2. Joist bridging (if shown) is schematically indicated. Provide all bridging necessary to conform to SJI
- 3. The ends of all bridging lines terminating at walls or beams shall be anchored to the wall or beam. 4. Joist bridging and connections shall be completely installed prior to placing any construction loads on the joists. Construction loading shall not exceed the joist design load. 5. All roof joists shall be capable of resisting the net uplift a noted on the Structural Drawings (min. 15 psf
- net). Provide an additional row of continuous horizontal bottom chord bridging at the first panel point location at each end of all roof joists. 6. Special joists (SP) shall be designed for the load designations specified on the Structural Drawings. Designs shall properly account for the distribution of concentrated loads, live loads, and for the effect of openings. Designs are to meet the requirements of SJI.
- 7. Joists shall meet the following deflection criteria per SJI. Maximum live load deflection shall not exceed: A) Roofs without suspended ceilings: L/240 B) Roof with suspended ceilings: L/360 C) Floors:
- 8. The Joist Manufacturer shall submit calculations for all special joists to Structural Engineer of Record for record purposes prior to fabrication. These calculations shall bear the seal and signature of a Professional Engineer registered in the State of Indiana.
- 9. Joists on column centerlines shall have extended bottom chord connections for erection stability, unless otherwise noted. Do not connect bottom chord extensions, unless otherwise noted or shown. 10. Joists on, or near column centerlines shall have field-bolted connections for erection stability, unless otherwise noted.

11. The Joist Manufacturer shall coordinate with the Structural Steel Fabricator for the design of all

- connections to support columns, beams, bearing seats, etc. prior to submittal of shop drawings. 12. Where a joist is part of a moment-resisting frame, delay the connection of the bottom chord to the column until all dead loads have been placed. All field-bolted and field-welded connections in momentresisting frames shall be inspected per AWS and AISC requirements.
- moment of inertia (lx) listed on the Plans. Where a minimum lx value is not specified, the lx value can be that required to meet the specified loading and deflection criteria. 14. All steel joists shall be furnished with standard SJI camber, unless noted otherwise. 15. All items suspended from joists such as catwalks, basketball goals, operable partitions, etc. should be

13. The Joist Manufacturer shall furnish evidence that the joist meets or exceeds the specified minimum

16. All joists shall be shop primed in accordance with SJI requirements, unless note otherwise. Color to match structural steel primer, unless approved in writing. 17. Provide sloped bearing ends where joist slope exceeds 1/4" per foot.

18. Do not field cut or alter joists without the written approval of the Joist Manufacturer.

installed after all dead loads of roofing, flooring, ceilings, etc. are installed.

CAST IN PLACE CONCRETE

- 1. Details of fabrication of reinforcement, handling and placing of the concrete, construction of forms and placement of reinforcement not otherwise covered by the Plans and Specifications, shall comply with the ACI Code requirements of the latest revised date.
- Cold weather concreting shall be in accordance with ACI 306. Cold weather is defined as a period when for more than 3 successive days the average daily air temperature drops below 40F and stays below 50F. The Contractor shall maintain a copy of this publication on site.
- 3. Hot weather concreting shall be in accordance with ACI 305. Hot weather is defined as any combination of the following conditions that tends to impair the quality of the freshly mixed or hardened
- concrete: high ambient temperature, high concrete temperature, low relative humidity, wind speed, or solar radiation The Contractor shall maintain a copy of this publication on site. 4. A certified Testing Agency shall be retained to perform industry standard testing including measurement of slump, air temperature, concrete cylinder testing, etc. to ensure conformance with the
- Contract Documents. Submit reports to Architect/Engineer. 5. Finishing of Slabs: After screeding, bull floating and floating operations have been completed, apply final finish as indicated below, and as described in the Division 3 Cast In Place Concrete Specification
- of the Project Manual. A. Floor Slabs Hard Trowel Finish Broom Finish B. Ramps, Stairs, & Sidewalks
- C. Surfaces to Receive Topping Slab Float Finish

C. Surfaces not exposed to public view

jointing, and finish details.

- D. Surfaces to receive thick-set mortar Float Finish beds or similar cementitious materials E. Driving Surfaces Rough Swirl Finish Sample Finishes: See Specifications for sample and mockup requirements, if any.
- performed by the Testing Agency in accordance with ASTM E-1155. Results, including acceptance or rejection of the work will be provided to the Contractor and the Architect/Engineer within 48 hours after data collection. Remedies for out-of-tolerance work shall be in accordance with the Specifications. 6. Finishing of Formed Surfaces: Finish formed surfaces as indicated below, and as described in the

Floor Tolerances: See the Specifications for specified Ff and FI tolerances. Ff and FI testing shall be

Division 3 Cast In Place Concrete Specification of the Project Manual. A. Sides of Footings & Pile Caps Rough Form Finish Rough Form Finish B. Sides of Grade Beams

Rough Form Finish

- Smooth Form Finish D. Surfaces exposed to public view 7. The Contractor shall consult with the Structural Engineer of Record before starting concrete work to establish a satisfactory placing schedule and to determine the location of construction joints so as to minimize the effects of shrinkage in the floor system.
- 8. Sawn or tooled control/contraction joints shall be provided in all slabs on grade. For a framed structure, joints shall be located on all column lines. If the column spacing exceeds 20'-0", provide intermediate joints. Exterior slabs, and interior slabs without column shall have joints spaced a maximum of 15'-0" apart. Layout joints so that maximum aspect ratio (ratio of long side to short side) does not exceed 1.5 Where vinyl composition tile, vinyl sheets goods, thin-set epoxy terrazzo, or other similar material is the specified finish floor material, the Contractor shall coordinate the locations of control/contraction and
- construction joints with the Finish Flooring Contractor. Submit a dimensioned plan showing joint locations and proposed sequence of floor pours. 10. Unless specifically noted on the Plans, composite and non-composite supported slabs on metal deck, and supported cast-in-place concrete slabs do not require sawn control joints. 11. Joints in slabs to receive a finished floor may remain unfilled, unless required by the finish flooring
- industrial, manufacturing, or warehouse applications subject to wheeled traffic shall be filled with specified epoxy resin sealant, all other joints shall be filled with specified elastometric sealant. Defer filling of joints as long as possible, preferably a minimum of 4 to 6 weeks after the slab has been cured. Prior to filling, remove all debris from the slab joints, the fill in accordance with the manufacturer's recommendations.

13. Refer to the Architectural Drawings for chamfer requirements for corners of concrete. Where not

contractor. All exposed slabs shall be filled with sealant specified in Division 7, or as follows: All slabs in

indicated, provide 3/4" chamfers on exposed corners of concrete, except those abutting masonry. 14. Refer to the Architectural Drawings for exact locations and dimensions of recessed slabs, ramps, stairs, thickened slabs, etc. Slope slabs to drains where shown on the Architectural and Plumbing Drawings. 15. Sidewalks, drives, exterior retaining walls, and other site concrete are not indicated on the Structural

12. Refer to the Architectural Drawings for locations and details of reveals (1" maximum depth) in exposed walls.

CONCRETE REINFORCING

Drawings. Refer to the Site/Civil and Architectural Drawings for locations, dimensions, elevations,

- 1. Reinforcement, other than cold drawn wire for spirals and welded wire fabric, shall have deformed surfaces in accordance with ASTM A305.
- Reinforcing steel shall conform to ASTM A615. Grade 60, unless note 3. Welded wire fabric shall conform to ASTM A1064, unless noted. 4. Where hooks are indicated, provide standard hooks per ACI and CRSI for all bars unless other hook dimensions are shown on the plans or details.
- 5. Reinforcement in footings, walls and beams shall be continuous. Lap bars a minimum of 40 diameters, unless noted otherwise. 6. Reinforcement shall be supported and secured against displacement in accordance with the CRSI 'Manual of Standard Practice'
- 7. Details of reinforcing steel fabrication and placement shall conform to ACI 315 'Details and Detailing of Concrete Reinforcement' and ACI 315R 'Manual of Engineering and Placing Drawings for Reinforced Concrete Structures', unless otherwise indicated. 8. Spread reinforcing steel around small openings and sleeves in slabs and walls, where possible, and where bar spacing will not exceed 1.5 times the normal spacing. Discontinue bars at all large openings where necessary, and provide an area of reinforcement, equal to the interrupted
- of the opening. Provide #5 x 4'-0" long diagonal bars in both faces, at each corner of openings larger than 12" in any direction. 9. Provide standees for the support of top reinforcement for footings, pile caps, and mats. 10. Provide individual high chairs with support bars, as required for the support of top reinforcement

reinforcement, in full length bars, distributing one-half each side of the opening. Where shrinkage

and temperature reinforcement is interrupted, add (2) #5 x opening dimension + 4'-0" on each side

12. Where walls sit on column footings, provide dowels for the wall. Dowels shall be the same size and spacing as the vertical wall reinforcement, unless noted otherwise, with lab splices as shown on the application sections. Install dowels in the footing forms before concrete is placed. Do NOT stick dowels into footings after concrete is placed.

14. Minimum concrete cover over reinforcing steel shall be as follows, unless noted otherwise on plan,

13. Field bending of reinforcing steel is prohibited, unless noted on drawings

11. Provide snap-on plastic space wheels to maintain required concrete cover for vertical wall

for supported slabs. Do NOT provide standees.

section or note:

CONCRETE MIX CLAS	SSES
FOOTINGS, FOUNDATION WALLS, PIERS, & GRADE BEAMS	S
COMPRESSIVE STRENGTH	4000 PSI
MAXIMUM WATER/CEMENT RATIO	0.45
AIR CONTENT	0 - 3 PERCENT
WATER-REDUCING ADMIXTURE	REQUIRED
SLUMP	5" TO 6 1/2"
INTERIOR CONCRETE SLABS	
COMPRESSIVE STRENGTH	4000 PSI
MINIMUM CEMENTITIOUS MATERIAL CONTENT	517 LB/CU YD
AIR CONTENT	0 - 3 PERCENT
WATER-REDUCING ADMIXTURE	REQUIRED
SLUMP	5" TO 6 1/2"
PROVIDE ELEMENT 5 SYSTEM (INTERALA CURE & CA PLAN NOTES ON FOUNDATION PLANS	ATALYST) PER
EXTERIOR CONCRETE SUBJECT TO FREEZE-THAW	
COMPRESSIVE STRENGTH	4500 PSI
MINIMUM CEMENTITIOUS MATERIAL CONTENT	564 LB/CU YD
AIR CONTENT	6 ± 1 PERCENT
WATER-REDUCING ADMIXTURE	REQUIRED
SLUMP	5" TO 6 1/2"
COARSE AGGREGATE	CRUSHED STON
LEAN CONCRETE FILL	
COMPRESSIVE STRENGTH	2000 PSI
MAXIMUM WATER/CEMENT RATIO	0.65
AIR CONTENT	OPTIONAL
WATER-REDUCING ADMIXTURE	NOT REQUIRED
SLUMP	4" TO 7"
INTERIOR TOPPING SLAB	
COMPRESSIVE STRENGTH	4000 PSI
MINIMUM CEMENTITIOUS MATERIAL CONTENT	517 LB/CU YD
AIR CONTENT	0 - 3 PERCENT
WATER-REDUCING ADMIXTURE	REQUIRED
SLUMP	5" TO 6 1/2"
THE CONTRACTOR SHALL CONSIDER THE EFFECTS TOLERANCE ON THE MINIMUM TOPPING THICKNESS	

SLUMP:

WATER REDUCING ADMIXTURES.

MIXES CONTAINING TYPE A WRDA 5" MAXIMUM MIXES CONTAINING MID-RANGE WRDA 5 - 6 1/2" MIXES CONTAINING HIGH-RANGE WRDA 2. SPECIFIED MINIMUM CEMENTITIOUS MATERIAL CONTENTS ARE BASED ON THE USE OF

SIZE OF LARGE AGGREGATE ACCORDINGLY.

AND THAWING IN SERVICE AND FOR ALL CONCRETE EXPOSED TO COLD WEATHER DURING CONSTRUCTION, BEFORE ATTAINING ITS SPECIFIED DESIGN COMPRESSIVE STRENGTH. REF. ACI 306 FOR DEFINITION OF COLD WEATHER.

4. CLASS C FLY ASH MAY BE USED AS A CEMENT SUBSTITUTE WITH A MAXIMUM 20%

. INCLUDE AN AIR-ENTRAINING ADMIXTURE FOR ALL CONCRETE EXPOSED TO FREEZING

- SUBSTITUTION RATE ON A POUND-PER-POUND BASIS. 5. SLAG CEMENT MAY BE USED AS A SUBSTITUTE FOR PORTLAND CEMENT WITH A MAXIMUM 50% SUBSTITUTION RATE ON A POUND-PER-POUND BASIS WITH THE EXCEPTION OF CLASS E CONCRETE, WHICH SHALL BE LIMITED TO 30%.
- SUBSTITUTION RATES SHALL COMPLY WITH THE FOLLOWING: PORTLAND CEMENT/SLAG/FLY ASH RATIO: CLASS E EXTERIOR CONCRETE 70% / 20% / 10% ALL OTHER CLASSES 50% / 30% / 20%
- 7. FOR CONCRETE TO BE CAST DURING COLD WEATHER, THE MAXIMUM SUBSTITUTION RATE FOR SLAG CEMENT SHALL BE 30%. IF SLAG CEMENT AND FLY ASH ARE USED IN THE SAME MIX, THE MAXIMUM SUBSTITUTION RATES SHALL COMPLY WITH A RATIO OF PORTLAND CEMENT/SLAG/FLY ASH OF 70% / 20% / 10%.

6. WHEN SLAB CEMENT AND FLY ASH ARE USED IN THE SAME CONCRETE MIX, THE MAXIMUM

8. PROPORTION CONCRETE MIXES TO PROVIDE WORKABILITY AND CONSISTENCY TO PERMIT CONCRETE TO BE WORKED READILY INTO THE CORNERS AND ANGLES OF THE FORMS AND AROUND REINFORCEMENT BY THE METHODS OF PLACEMENT AND CONSOLIDATION TO BE EMPLOYED, WITHOUT SEGREGATION AND EXCESSIVE BLEEDING.

CONTRACTOR WHEN JOB CONDITIONS, WEATHER, TEST RESULTS, OR OTHER

9. ADJUSTMENTS TO THE APPROVED MIX DESIGNS MAY BE REQUESTED BY THE

ARCHITECT/ENGINEER FOR APPROVAL PRIOR TO USE.

2. It is the Specialty Structural Engineer's responsibility to review the Construction Drawings and

Specifications to determine the appropriate scope of engineering.

SPECIALTY STRUCTURAL ENGINEERING (SSE) 1. A Specialty Structural Engineer is defined as a Professional Engineer licensed in the State of Indiana, not the Structural Engineer of Record, who performs Structural Engineering functions necessary for the structure to be completed and who has shown experience and/or training in the specific speciality.

CIRCUMSTANCES WARRANT. THESE REVISED MIX DESIGNS SHALL BE SUBMITTED TO THE

3. It is the intent of the Drawings and Specifications to provide sufficient information for the Specialty Structural Engineer (SSE) to perform his design and analysis. If the SSE determines there are details, features, or unanticipated project limits which conflict with the engineering requirements as described in the project documents, the SSE shall in a timely manner, contact the Structural Engineer of Record for resolution of conflicts.

4. The Specialty Structural Engineer (SSE) shall forward documents to the Structural Engineer of Record

for review. Such documents shall bear the stamp of the SSE and include: A) Drawings introducing engineering input, such as defining the configuration or structural capacity of structural components and/or their assembly into structural systems. B) Calculations. C) Computer printouts which are an acceptable substitute for manual calculations provided they are

accompanied by sufficient design assumptions and identified input and output information to

permit their proper evaluation. Such information shall bear the stamp of the Specialty Engineer as an indication that said engineer has accepted responsibility for the results. 5. Contractors are referred to the specific technical specification sections and the structural drawings for those elements requiring Specialty Structural Engineering. Examples of components requiring

A) Shoring and Bracing Systems.

B) Structural Steel Connections.

C) Steel Joist Systems.

Specialty Structural Engineering include, but are not limited to the following:

Engineer of Record for review, prior to performing the proposed modification.

D) Long Span and Acoustical Steel Decks. E) Cold-Formed Steel Framing. F) Prefabricated Cold-Formed Steel Trusses 6. When modifications are proposed to elements under the design and certification of the Specialty

Structural Engineer (SSE), written authorization by the SSE must be obtained and submitted to the

PROJECT DOUGLAS MACARTHUR ES ADDITIONS AND **RENOVATIONS CROWN POINT COMMUNITY** SCHOOL CORPORATION CEDAR LAKE, INDIANA

GIBRALTAR

DESIGN

ARCHITECTURE • ENGINEERING • INTERIOR DESIGN

GIBRALTAR DESIGN 9102 N. Meridian St., Ste. 300 Indianapolis, IN 46260 Homepage www.GibraltarDesign.com Email info@GibraltarDesign.com

Phone 317.580.5777 Fax 317.580.5778

1/31/22 **COORDINATED BY** DRAWN BY

PROJECT

21-113

CHECKED BY

DATE


THE CONCEPTS, DESIGNS, PLANS, DETAILS, ETC, SHOWN ON THIS DOCUMENT ARE THE PROPERTY OF GIBRALTAR DESIGN AND WERE CREATED FOR USE ON THIS SPECIFIC PROJECT. NONE OF THIS INFORMATION SHALL BE USED BY ANY PERSON OR FIRM FOR ANY PURPOSE WITHOUT THE EXPRESS WRITTEN CONSENT OF GIBRALTAR DESIGN. THE OWNER MAY RETAIN COPIES FOR INFORMATION AND REFERENCE IN CONNECTION ONLY WITH THIS **REVISIONS** MARK DATE ISSUED FOR

AD-3 02.23.2022 ADDENDUM #3

PROJECT DOUGLAS MACARTHUR ES ADDITIONS AND RENOVATIONS

STRUCTURAL NOTES

© GIBRALTAR DESIGN SHEET

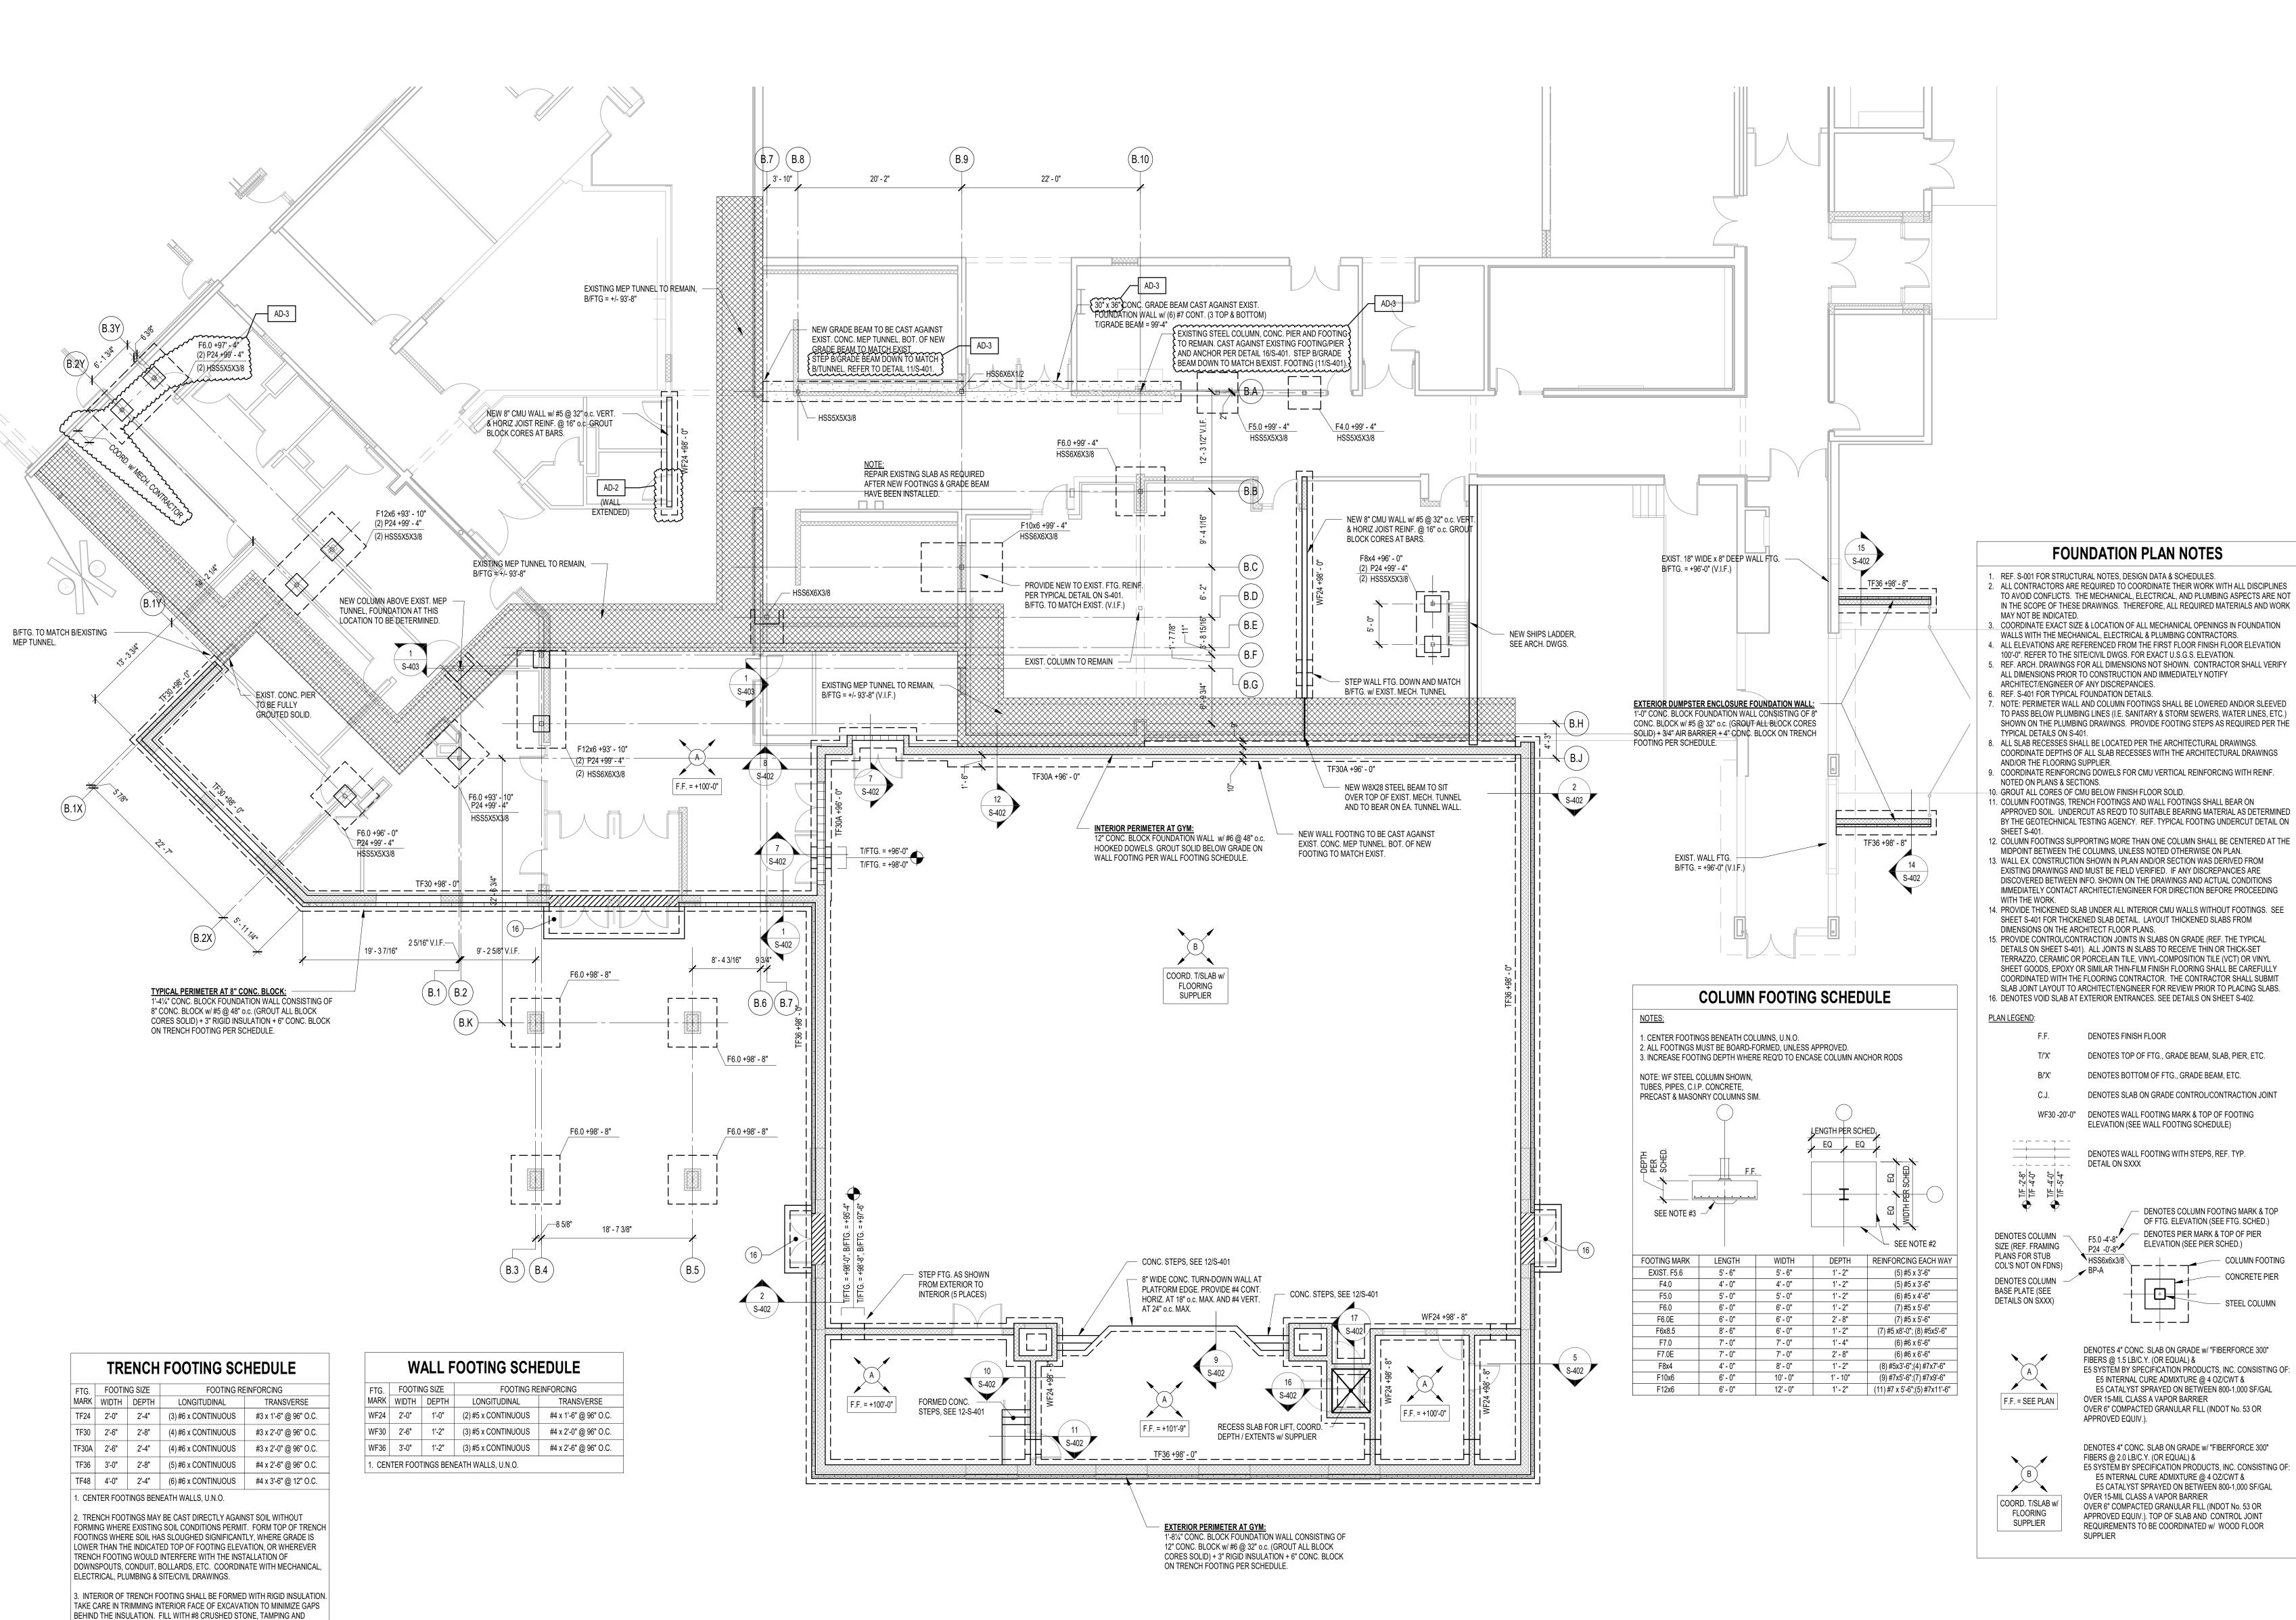




GIBRALTAR DESIGN

ARCHITECTURE • ENGINEERING • INTERIOR DESIGN

PROJECT

DOUGLAS MACARTHUR ES ADDITIONS AND RENOVATIONS

CROWN POINT COMMUNITY SCHOOL CORPORATION CEDAR LAKE, INDIANA

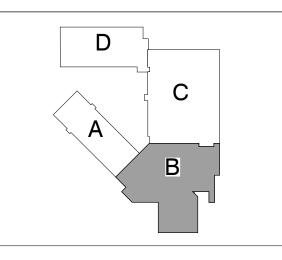

KEY PLAN

GIBRALTAR DESIGN 9102 N. Meridian St., Ste. 300 Indianapolis, IN 46260

Homepage www.GibraltarDesign.com | Email info@GibraltarDesign.com Phone 317.580.5777 Fax 317.580.5778 **PROJECT**

21-113 DATE 1/31/22 **COORDINATED BY** DRAWN BY **CHECKED BY**

DENOTES COLUMN FOOTING MARK & TOP

OF FTG. ELEVATION (SEE FTG. SCHED.)

DENOTES PIER MARK & TOP OF PIER

ELEVATION (SEE PIER SCHED.)

- — | — —-



THE CONCEPTS, DESIGNS, PLANS, DETAILS, ETC, SHOWN ON THIS DOCUMENT ARE THE PROPERTY OF GIBRALTAR DESIGN AND WERE CREATED FOR USE ON THIS SPECIFIC PROJECT. NONE OF THIS INFORMATION SHALL BE USED BY ANY PERSON OR FIRM FOR ANY PURPOSE WITHOUT THE EXPRESS WRITTEN CONSENT OF GIBRALTAR DESIGN. THE OWNER MAY RETAIN COPIES FOR INFORMATION AND PREFERENCE IN CONNECTION ONLY WITH THIS INFORMATION AND REFERENCE IN CONNECTION ONLY WITH THIS

REVISIONS MARK DATE ISSUED FOR AD-2 02.17.2022 ADDENDUM #2 AD-3 | 02.23.2022 | ADDENDUM #3

COLUMN FOOTING CONCRETE PIER — STEEL COLUMN


> DRAWING FOUNDATION PLAN - UNIT B


PROJECT DOUGLAS MACARTHUR ES ADDITIONS AND RENOVATIONS

© GIBRALTAR DESIGN SHEET

FOUNDATION PLAN - UNIT B

COMPACTING WHERE SPACE PERMITS.

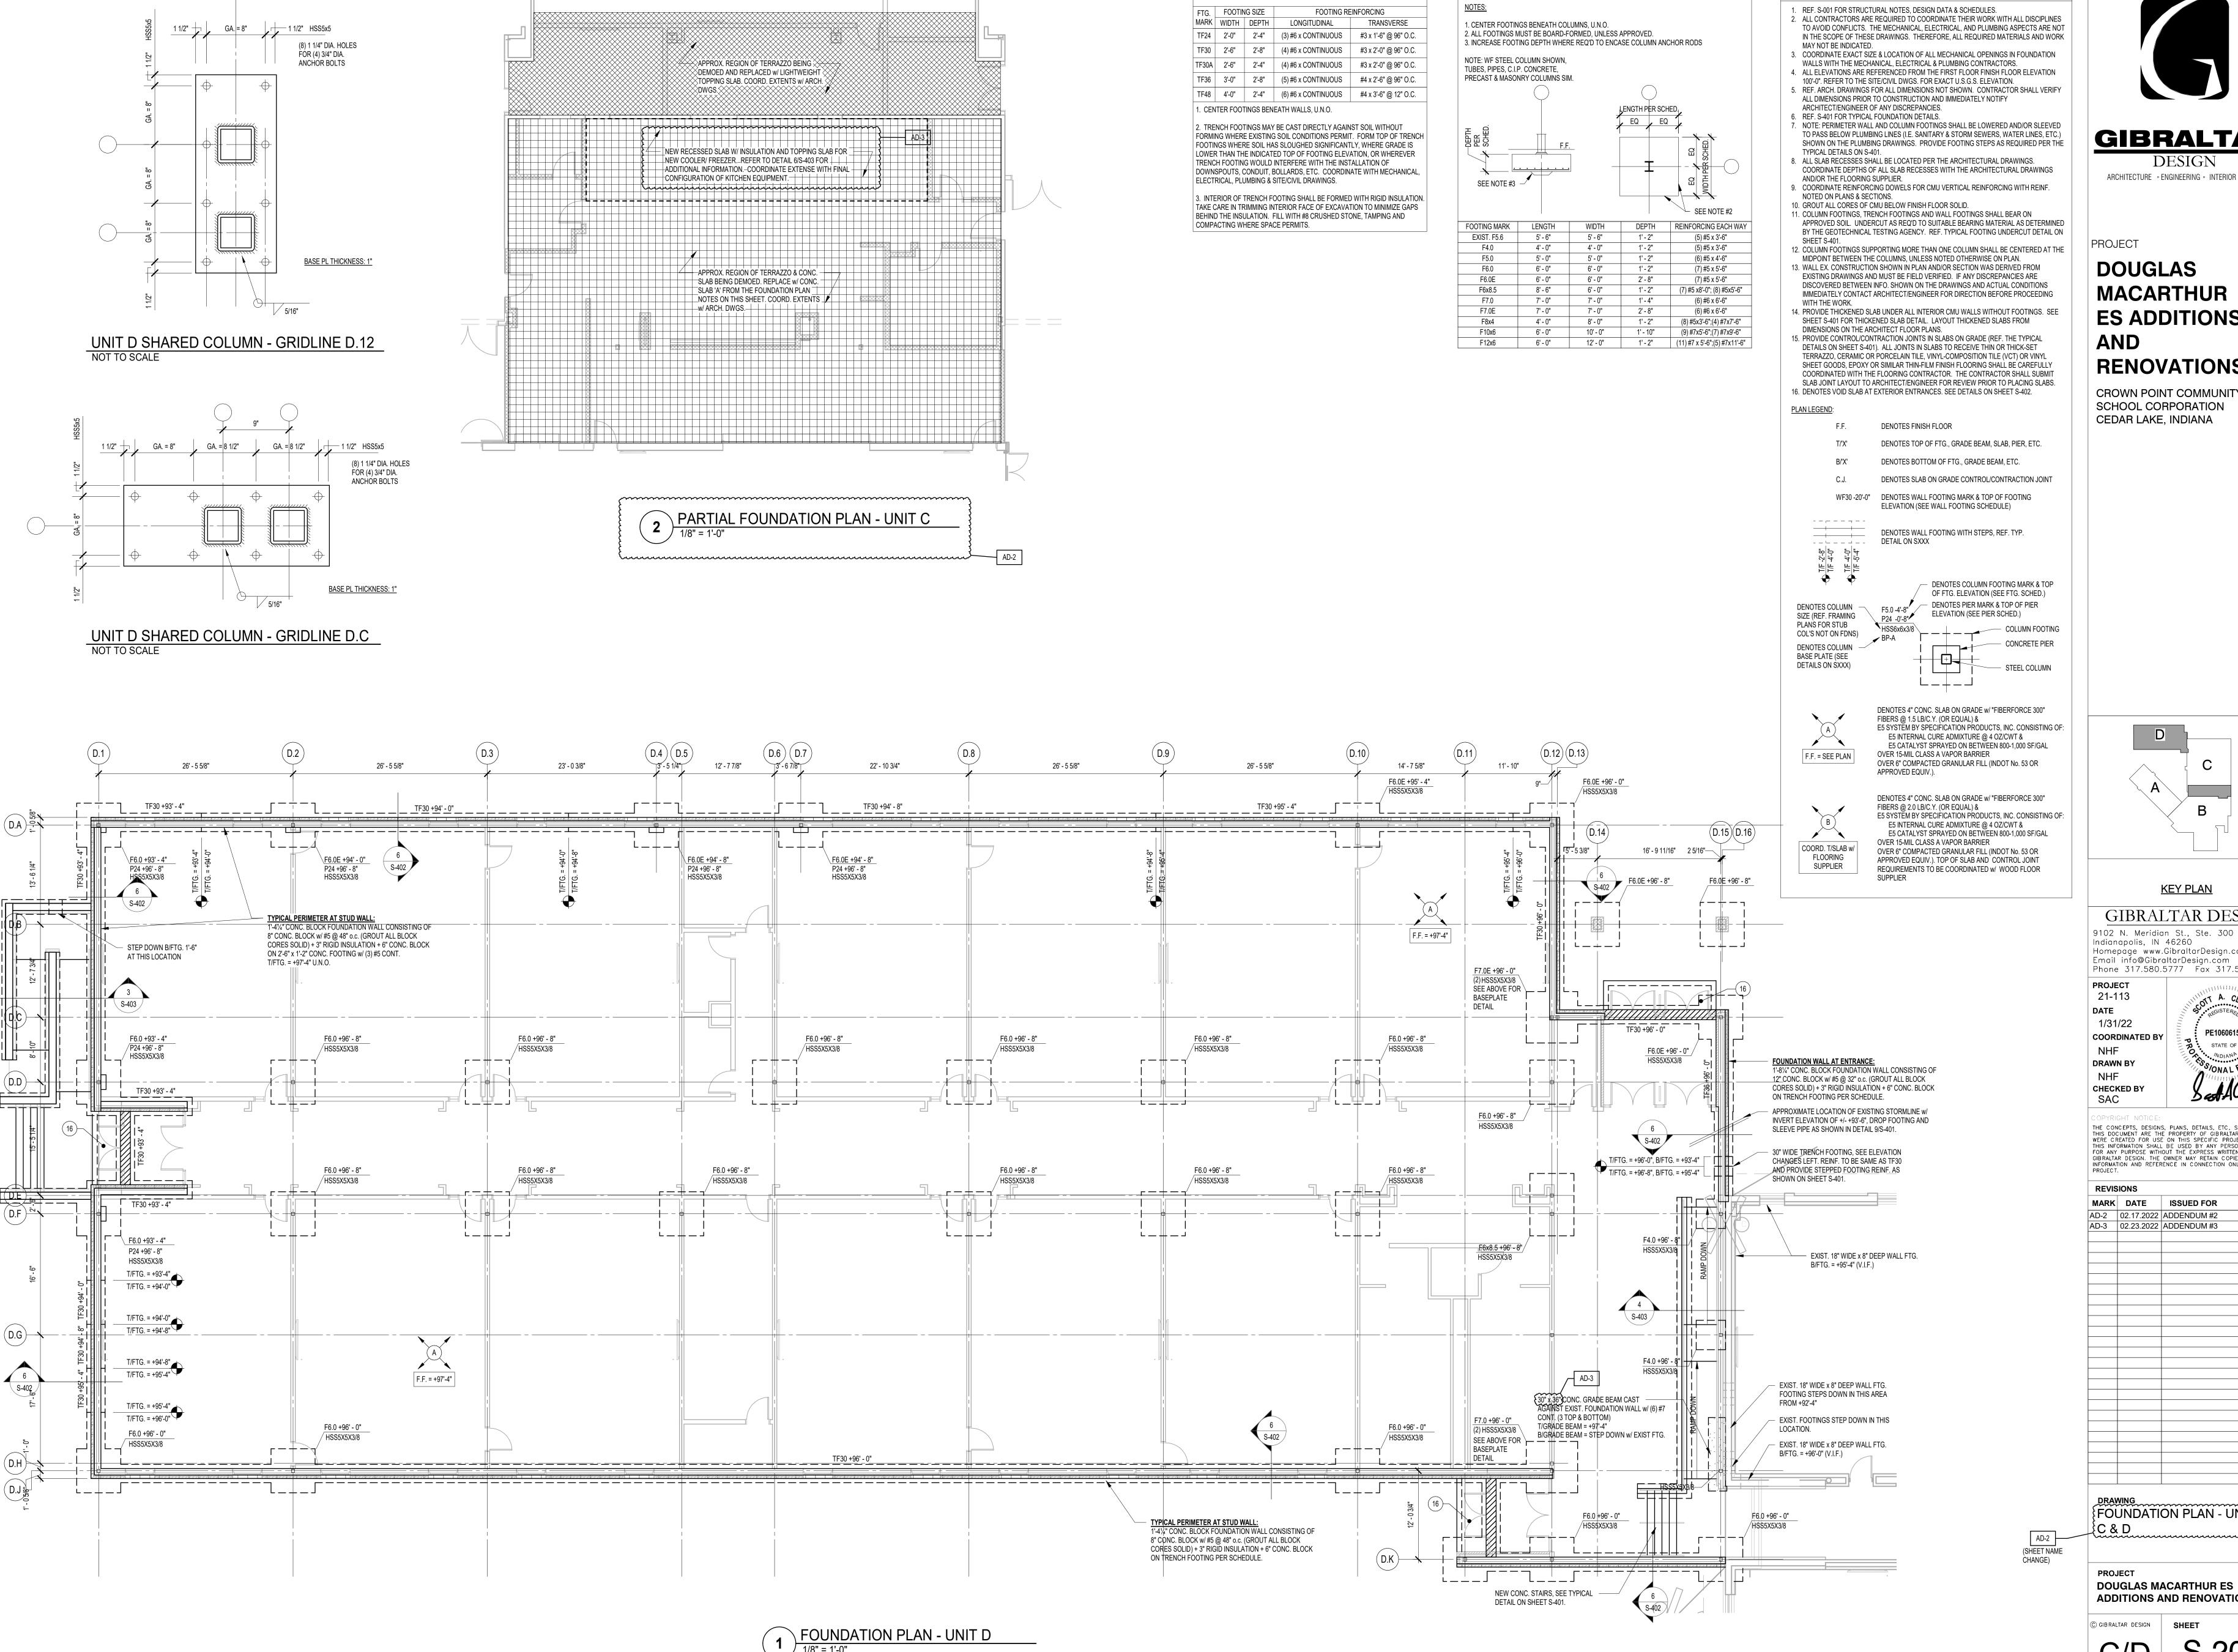

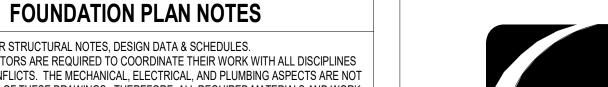

COLUMN FOOTING SCHEDULE


TRENCH FOOTING SCHEDULE

GIBRALTAR

DESIGN ARCHITECTURE • ENGINEERING • INTERIOR DESIGN

DOUGLAS MACARTHUR ES ADDITIONS AND


RENOVATIONS CROWN POINT COMMUNITY SCHOOL CORPORATION

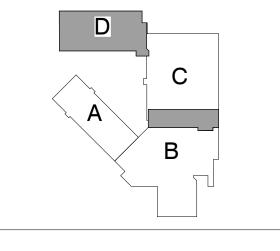

KEY PLAN

GIBRALTAR DESIGN 9102 N. Meridian St., Ste. 300 Indianapolis, IN 46260 | Homepage www.GibraltarDesign.com Email info@GibraltarDesign.com Phone 317.580.5777 Fax 317.580.5778

1/31/22 **COORDINATED BY DRAWN BY**

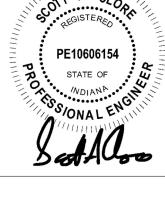


THE CONCEPTS, DESIGNS, PLANS, DETAILS, ETC, SHOWN ON THIS DOCUMENT ARE THE PROPERTY OF GIBRALTAR DESIGN AND WERE CREATED FOR USE ON THIS SPECIFIC PROJECT. NONE OF THIS INFORMATION SHALL BE USED BY ANY PERSON OR FIRM FOR ANY PURPOSE WITHOUT THE EXPRESS WRITTEN CONSENT OF GIBRALTAR DESIGN. THE OWNER MAY RETAIN COPIES FOR INFORMATION AND REFERENCE IN CONNECTION ONLY WITH THIS PROJECT.

MARK DATE ISSUED FOR AD-2 02.17.2022 ADDENDUM #2 AD-3 02.23.2022 ADDENDUM #3

FOUNDATION PLAN - UNITS

ADDITIONS AND RENOVATIONS

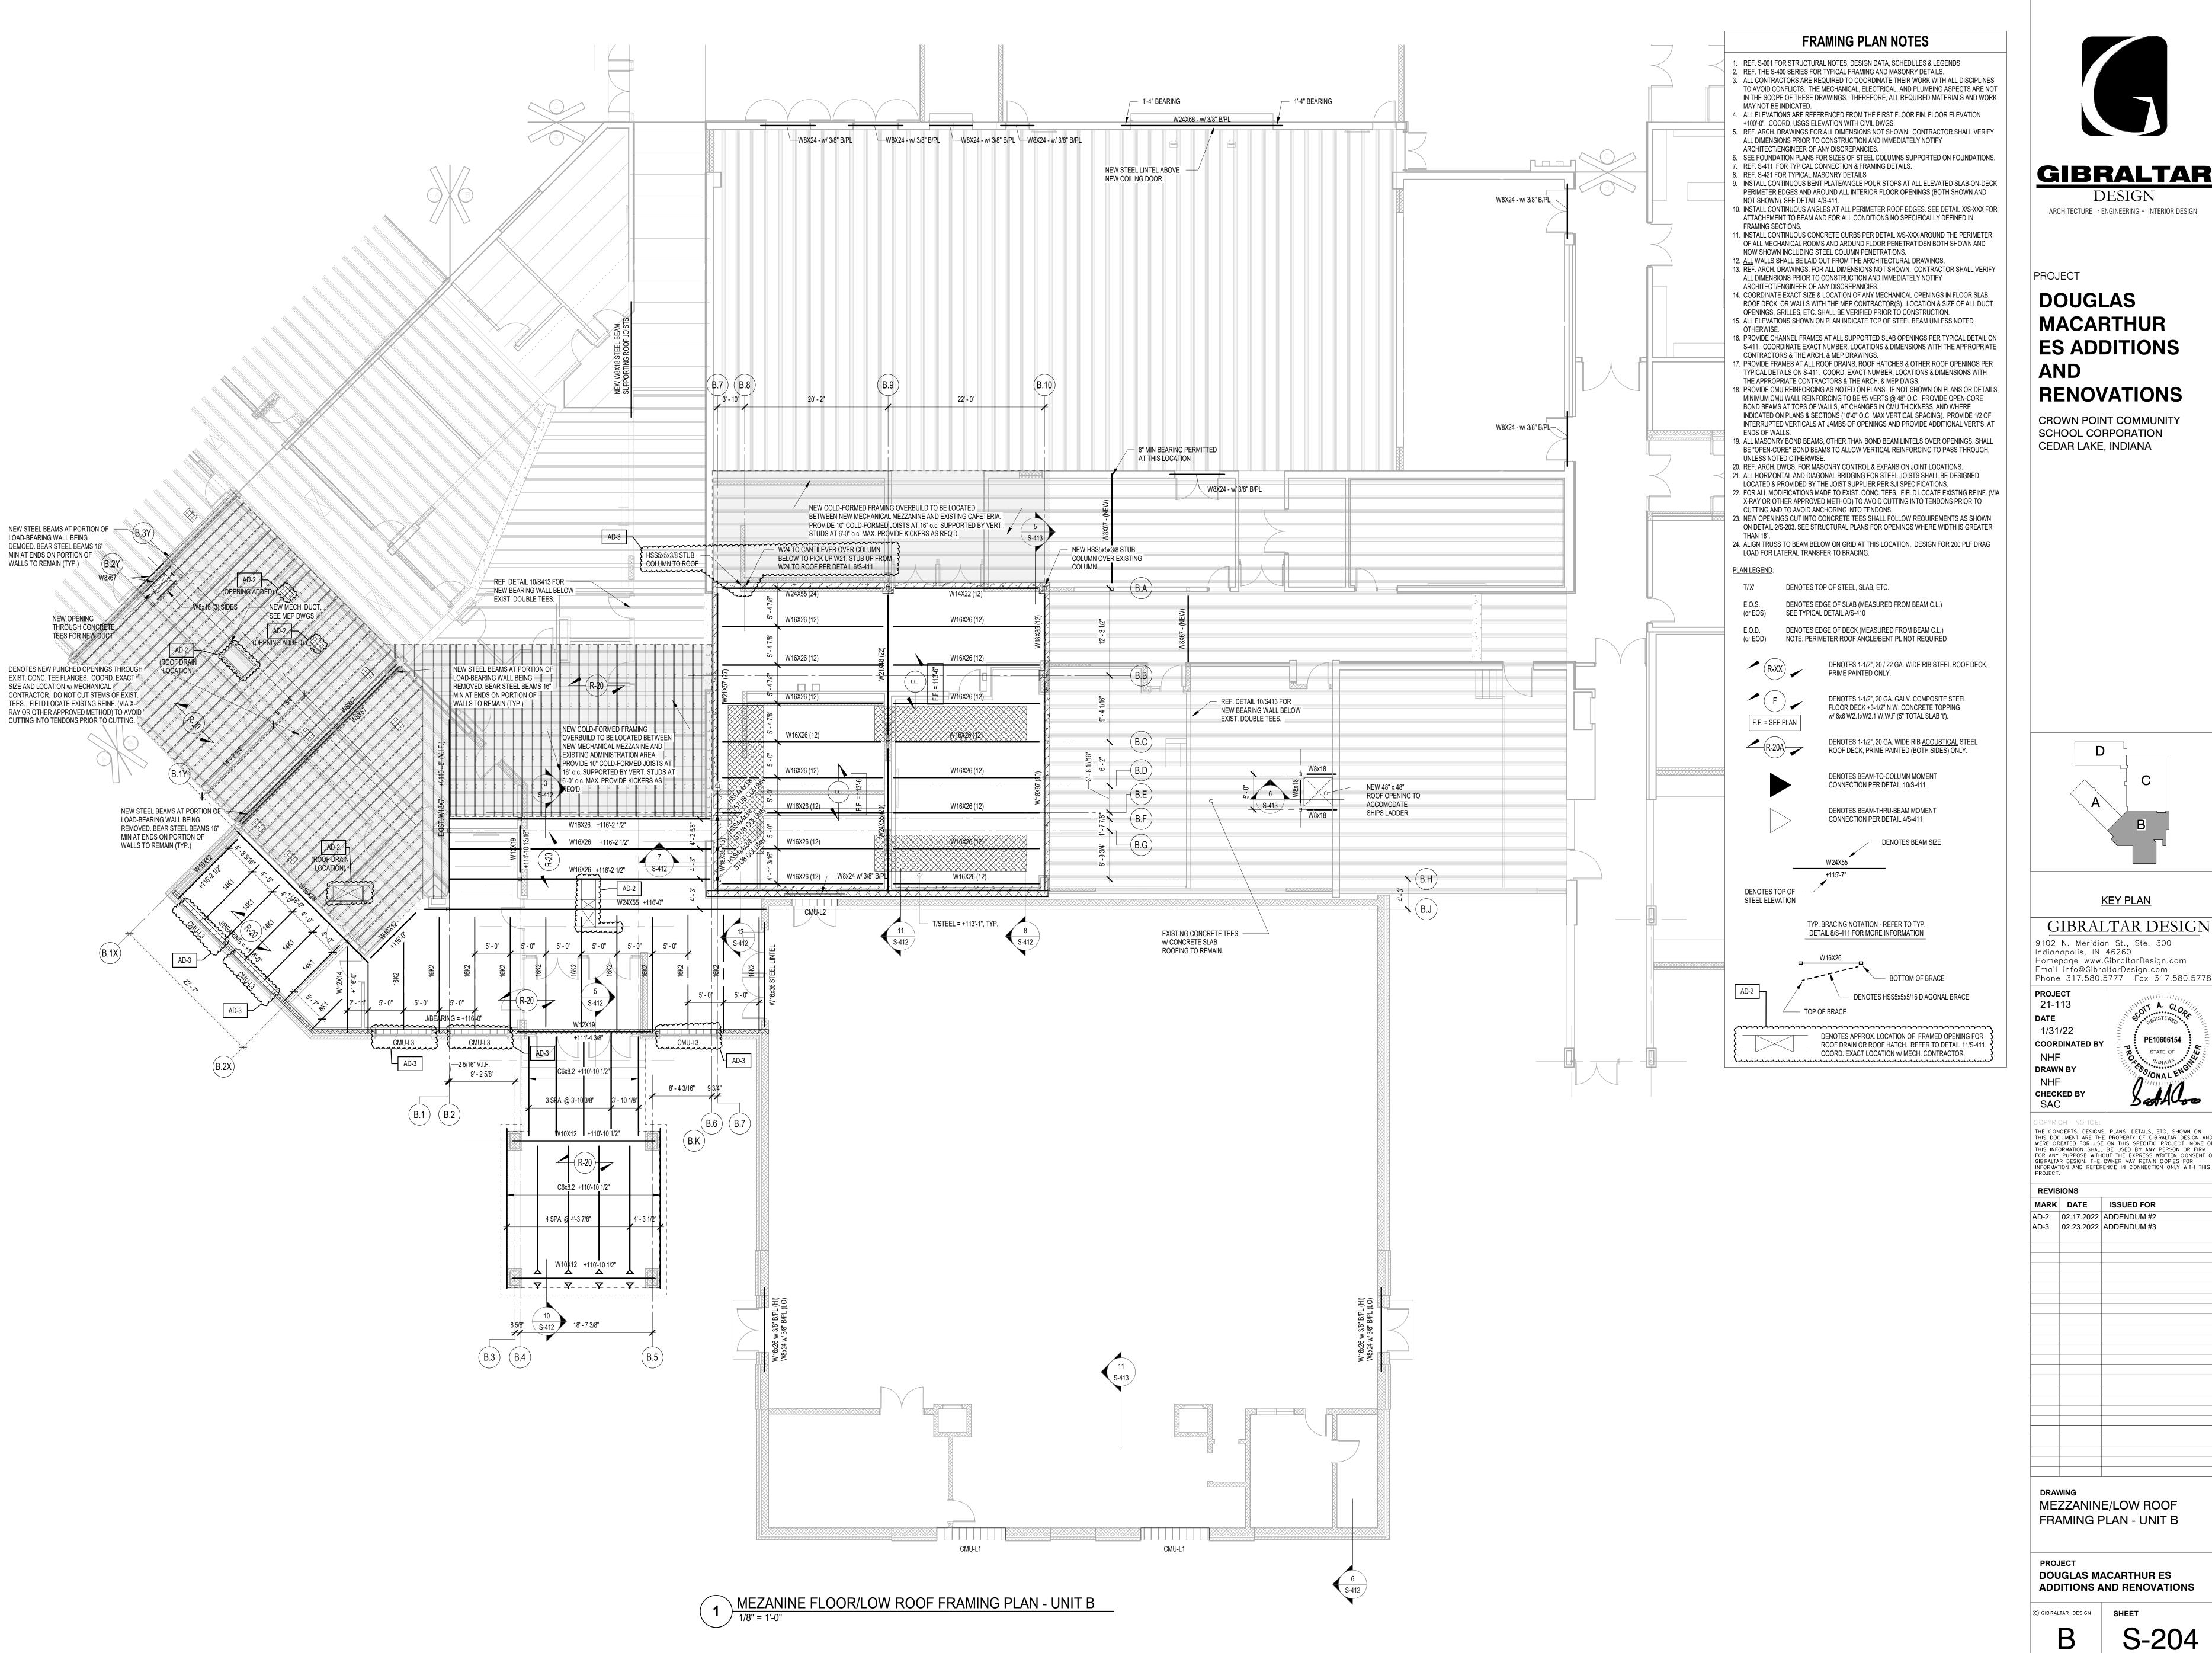




GIBRALTAR DESIGN

ARCHITECTURE • ENGINEERING • INTERIOR DESIGN

PROJECT

DOUGLAS MACARTHUR ES ADDITIONS AND RENOVATIONS


CROWN POINT COMMUNITY SCHOOL CORPORATION CEDAR LAKE, INDIANA

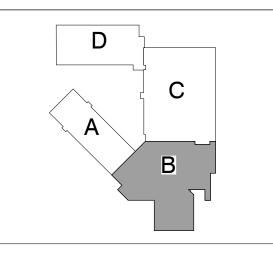

KEY PLAN

GIBRALTAR DESIGN 9102 N. Meridian St., Ste. 300 Indianapolis, IN 46260 Homepage www.GibraltarDesign.com Email info@GibraltarDesign.com

PROJECT 21-113 DATE 1/31/22 **COORDINATED BY**

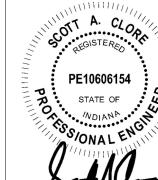


THE CONCEPTS, DESIGNS, PLANS, DETAILS, ETC, SHOWN ON THIS DOCUMENT ARE THE PROPERTY OF GIBRALTAR DESIGN AND WERE CREATED FOR USE ON THIS SPECIFIC PROJECT. NONE OF THIS INFORMATION SHALL BE USED BY ANY PERSON OR FIRM FOR ANY PURPOSE WITHOUT THE EXPRESS WRITTEN CONSENT OF GIBRALTAR DESIGN. THE OWNER MAY RETAIN COPIES FOR INFORMATION AND REFERENCE IN CONNECTION ONLY WITH THIS PROJECT.


REVISIONS MARK DATE ISSUED FOR

AD-3	02.23.2022	ADDENDUM #3

MEZZANINE/LOW ROOF FRAMING PLAN - UNIT B

DOUGLAS MACARTHUR ES **ADDITIONS AND RENOVATIONS**

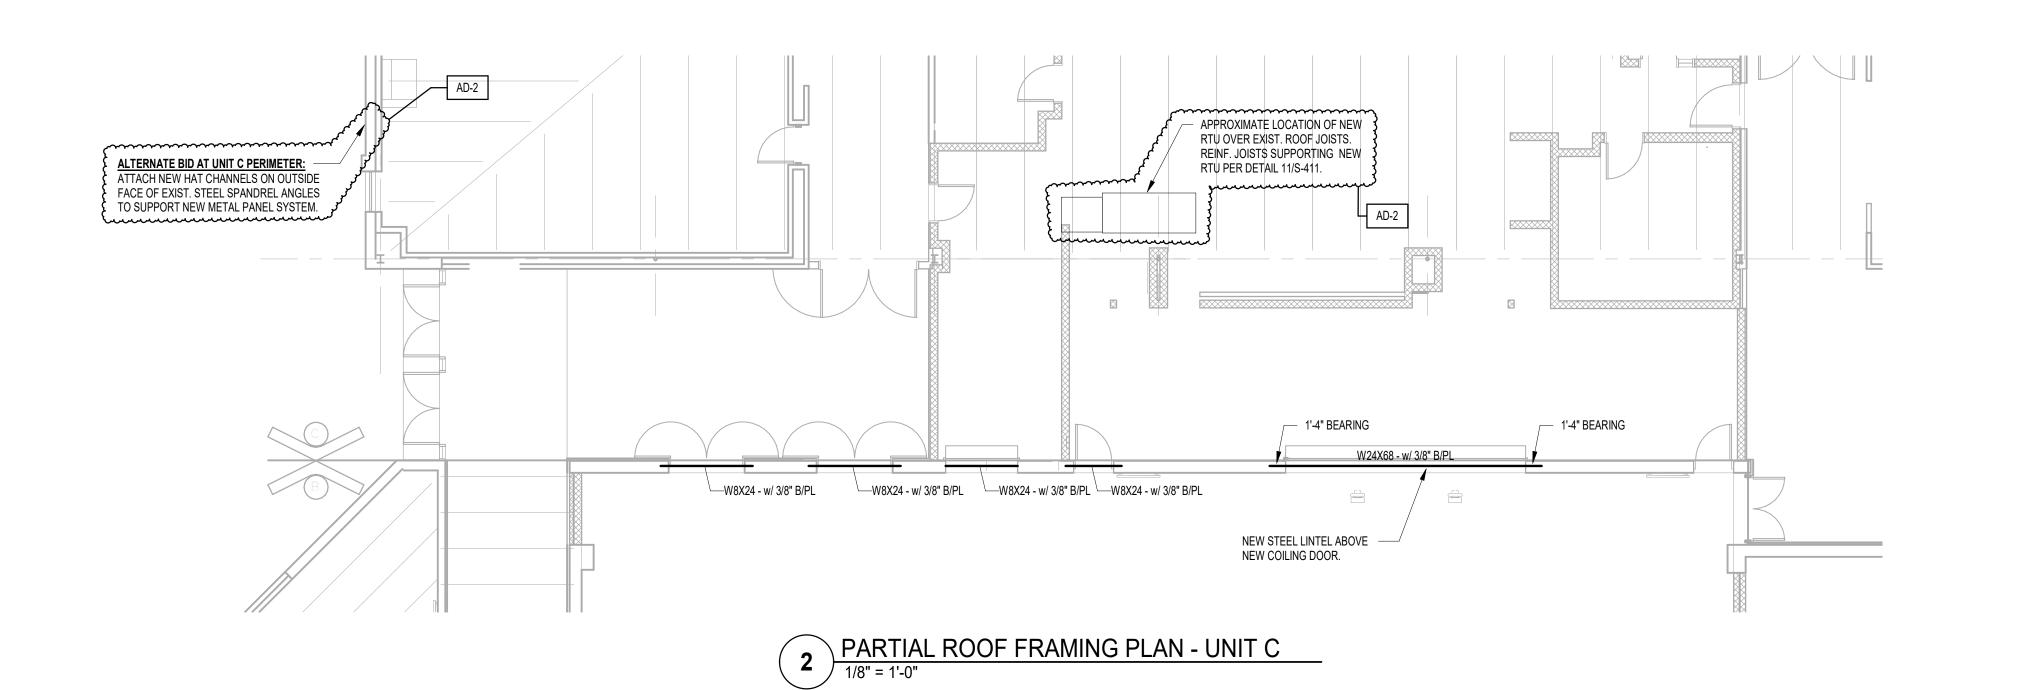

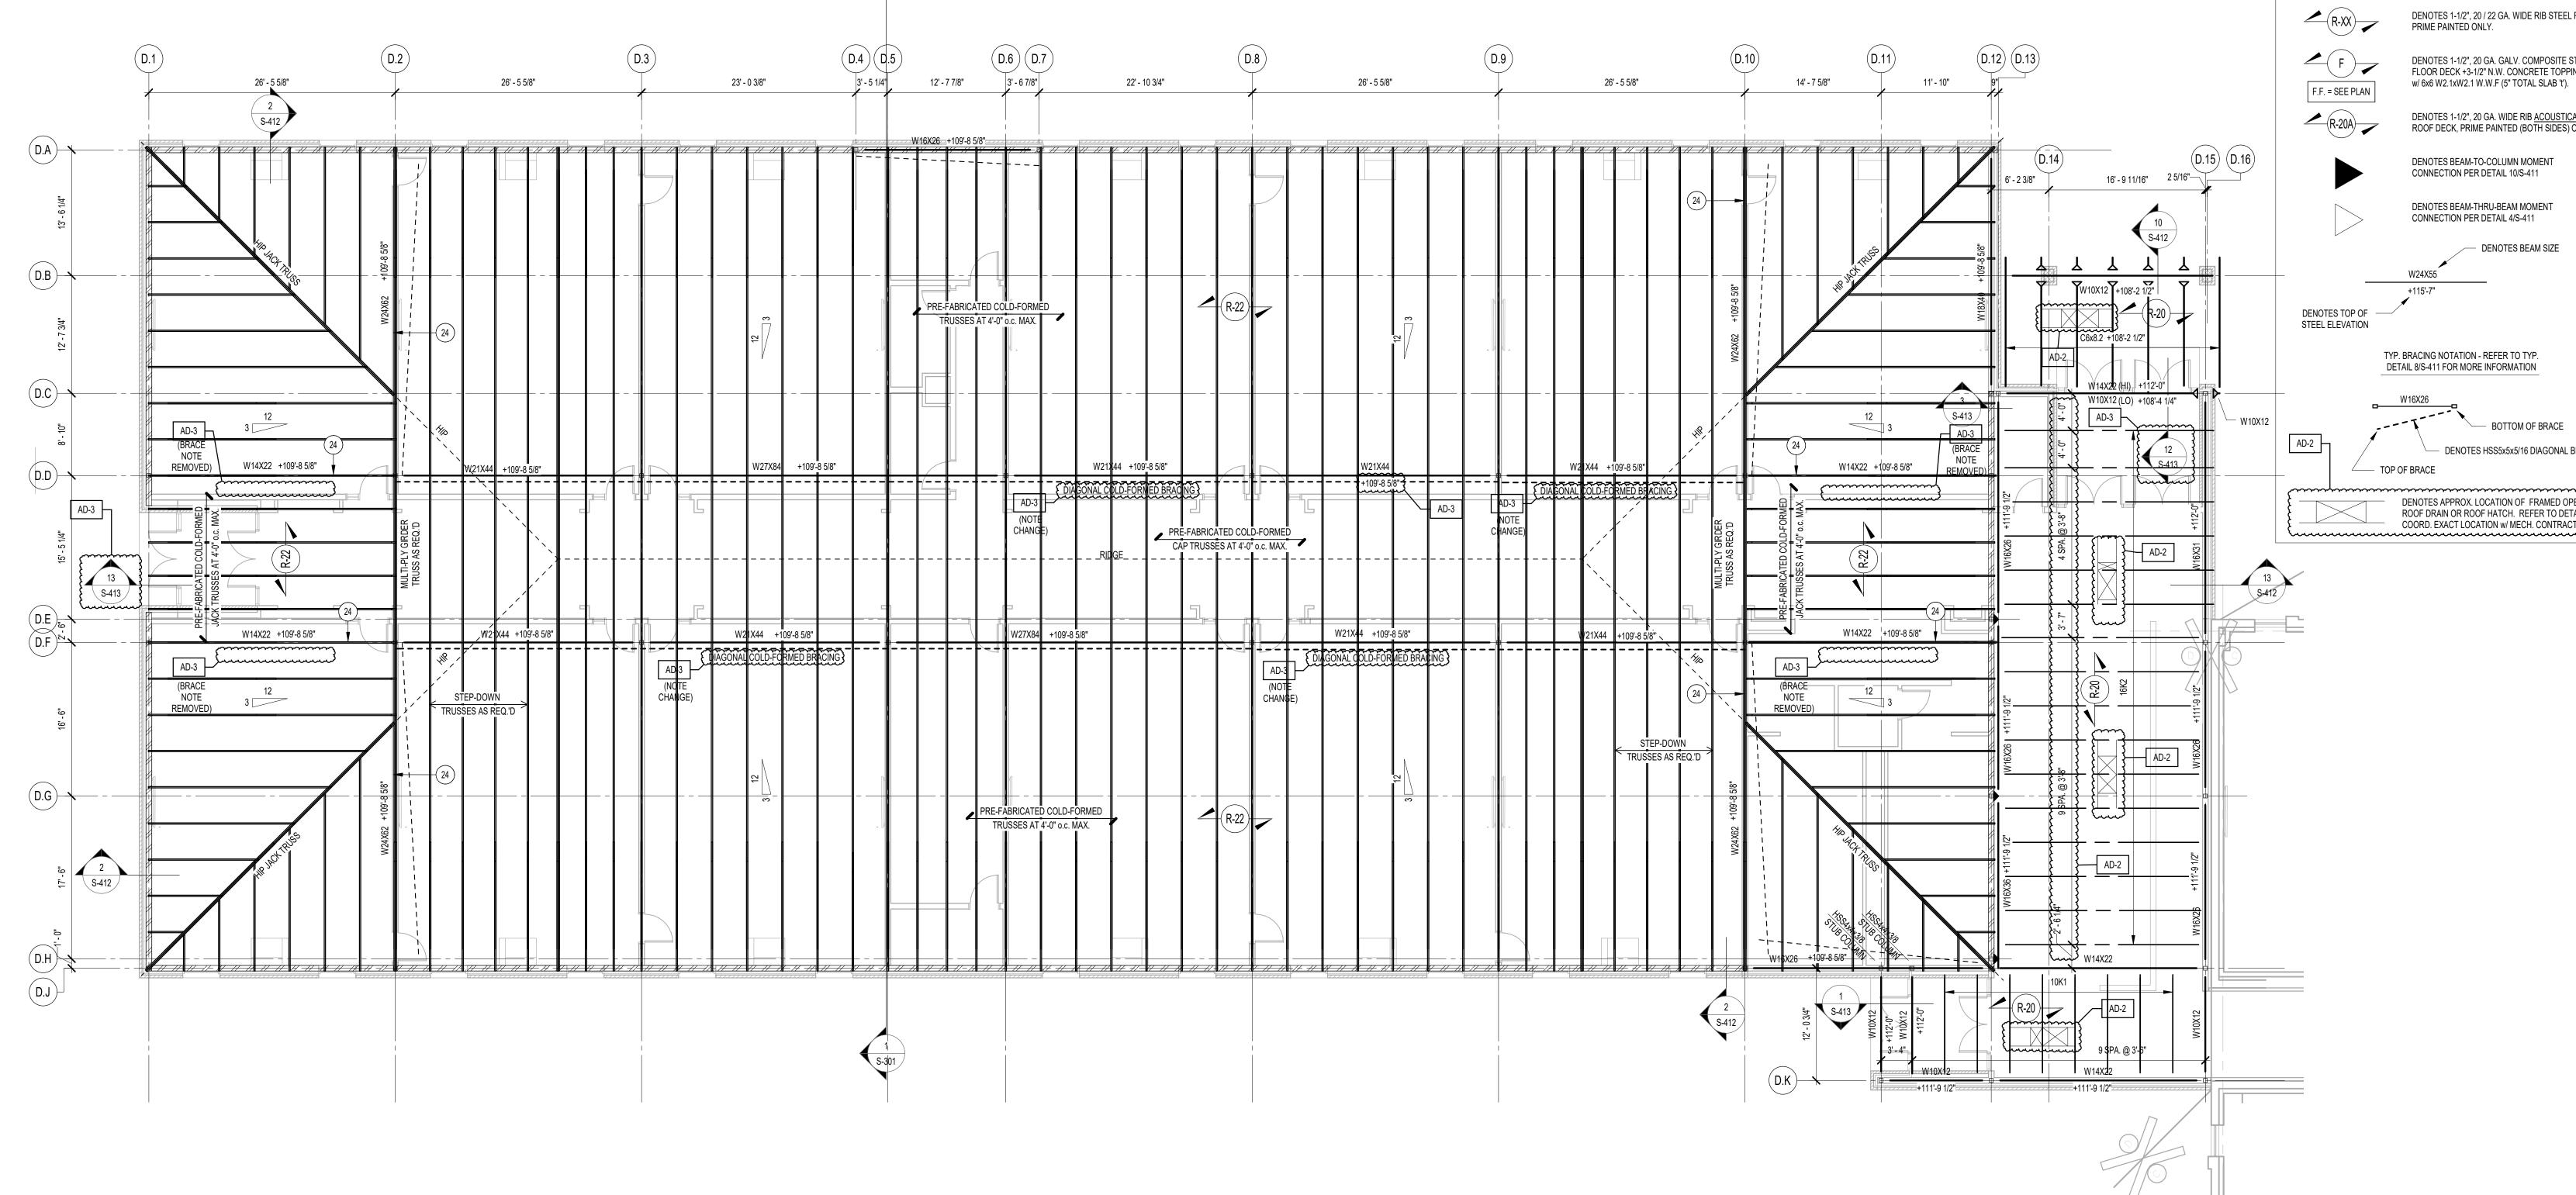

FRAMING PLAN NOTES

- 1. REF. S-001 FOR STRUCTURAL NOTES, DESIGN DATA, SCHEDULES & LEGENDS. 2. REF. THE S-400 SERIES FOR TYPICAL FRAMING AND MASONRY DETAILS.
- 3. ALL CONTRACTORS ARE REQUIRED TO COORDINATE THEIR WORK WITH ALL DISCIPLINES TO AVOID CONFLICTS. THE MECHANICAL, ELECTRICAL, AND PLUMBING ASPECTS ARE NOT IN THE SCOPE OF THESE DRAWINGS. THEREFORE, ALL REQUIRED MATERIALS AND WORK MAY NOT BE INDICATED.
- 4. ALL ELEVATIONS ARE REFERENCED FROM THE FIRST FLOOR FIN. FLOOR ELEVATION +100'-0". COORD. USGS ELEVATION WITH CIVIL DWGS. 5. REF. ARCH. DRAWINGS FOR ALL DIMENSIONS NOT SHOWN. CONTRACTOR SHALL VERIFY
- ALL DIMENSIONS PRIOR TO CONSTRUCTION AND IMMEDIATELY NOTIFY ARCHITECT/ENGINEER OF ANY DISCREPANCIES. 6. SEE FOUNDATION PLANS FOR SIZES OF STEEL COLUMNS SUPPORTED ON FOUNDATIONS.
- 8. REF. S-421 FOR TYPICAL MASONRY DETAILS 9. INSTALL CONTINUOUS BENT PLATE/ANGLE POUR STOPS AT ALL ELEVATED SLAB-ON-DECK PERIMETER EDGES AND AROUND ALL INTERIOR FLOOR OPENINGS (BOTH SHOWN AND NOT SHOWN). SEE DETAIL 4/S-411. 10. INSTALL CONTINUOUS ANGLES AT ALL PERIMETER ROOF EDGES. SEE DETAIL X/S-XXX FOR ATTACHEMENT TO BEAM AND FOR ALL CONDITIONS NO SPECIFICALLY DEFINED IN

7. REF. S-411 FOR TYPICAL CONNECTION & FRAMING DETAILS.

ARCHITECT/ENGINEER OF ANY DISCREPANCIES.

- 11. INSTALL CONTINUOUS CONCRETE CURBS PER DETAIL X/S-XXX AROUND THE PERIMETER OF ALL MECHANICAL ROOMS AND AROUND FLOOR PENETRATIOSN BOTH SHOWN AND NOW SHOWN INCLUDING STEEL COLUMN PENETRATIONS.
- 12. ALL WALLS SHALL BE LAID OUT FROM THE ARCHITECTURAL DRAWINGS. 13. REF. ARCH. DRAWINGS. FOR ALL DIMENSIONS NOT SHOWN. CONTRACTOR SHALL VERIFY ALL DIMENSIONS PRIOR TO CONSTRUCTION AND IMMEDIATELY NOTIFY
- 14. COORDINATE EXACT SIZE & LOCATION OF ANY MECHANICAL OPENINGS IN FLOOR SLAB, ROOF DECK, OR WALLS WITH THE MEP CONTRACTOR(S). LOCATION & SIZE OF ALL DUCT OPENINGS, GRILLES, ETC. SHALL BE VERIFIED PRIOR TO CONSTRUCTION. 15. ALL ELEVATIONS SHOWN ON PLAN INDICATE TOP OF STEEL BEAM UNLESS NOTED OTHERWISE.
- 16. PROVIDE CHANNEL FRAMES AT ALL SUPPORTED SLAB OPENINGS PER TYPICAL DETAIL ON S-411. COORDINATE EXACT NUMBER, LOCATIONS & DIMENSIONS WITH THE APPROPRIATE CONTRACTORS & THE ARCH. & MEP DRAWINGS. 17. PROVIDE FRAMES AT ALL ROOF DRAINS, ROOF HATCHES & OTHER ROOF OPENINGS PER

TYPICAL DETAILS ON S-411. COORD. EXACT NUMBER, LOCATIONS & DIMENSIONS WITH

INTERRUPTED VERTICALS AT JAMBS OF OPENINGS AND PROVIDE ADDITIONAL VERT'S. AT

- THE APPROPRIATE CONTRACTORS & THE ARCH. & MEP DWGS. 18. PROVIDE CMU REINFORCING AS NOTED ON PLANS. IF NOT SHOWN ON PLANS OR DETAILS, MINIMUM CMU WALL REINFORCING TO BE #5 VERTS @ 48" O.C. PROVIDE OPEN-CORE BOND BEAMS AT TOPS OF WALLS, AT CHANGES IN CMU THICKNESS, AND WHERE INDICATED ON PLANS & SECTIONS (10'-0" O.C. MAX VERTICAL SPACING). PROVIDE 1/2 OF
- ENDS OF WALLS. 19. ALL MASONRY BOND BEAMS, OTHER THAN BOND BEAM LINTELS OVER OPENINGS, SHALL BE "OPEN-CORE" BOND BEAMS TO ALLOW VERTICAL REINFORCING TO PASS THROUGH, UNLESS NOTED OTHERWISE.

X-RAY OR OTHER APPROVED METHOD) TO AVOID CUTTING INTO TENDONS PRIOR TO

- 20. REF. ARCH. DWGS. FOR MASONRY CONTROL & EXPANSION JOINT LOCATIONS. 21. ALL HORIZONTAL AND DIAGONAL BRIDGING FOR STEEL JOISTS SHALL BE DESIGNED, LOCATED & PROVIDED BY THE JOIST SUPPLIER PER SJI SPECIFICATIONS. 22. FOR ALL MODIFICATIONS MADE TO EXIST. CONC. TEES, FIELD LOCATE EXISTNG REINF. (VIA
- CUTTING AND TO AVOID ANCHORING INTO TENDONS. 23. NEW OPENINGS CUT INTO CONCRETE TEES SHALL FOLLOW REQUIREMENTS AS SHOWN ON DETAIL 2/S-203. SEE STRUCTURAL PLANS FOR OPENINGS WHERE WIDTH IS GREATER
- 24. ALIGN TRUSS TO BEAM BELOW ON GRID AT THIS LOCATION. DESIGN FOR 200 PLF DRAG LOAD FOR LATERAL TRANSFER TO BRACING.

T/'X' DENOTES TOP OF STEEL, SLAB, ETC.

E.O.S. DENOTES EDGE OF SLAB (MEASURED FROM BEAM C.L.) (or EOS) SEE TYPICAL DETAIL A/S-410

DENOTES EDGE OF DECK (MEASURED FROM BEAM C.L.) (or EOD) NOTE: PERIMETER ROOF ANGLE/BENT PL NOT REQUIRED

DENOTES 1-1/2", 20 / 22 GA. WIDE RIB STEEL ROOF DECK, PRIME PAINTED ONLY. DENOTES 1-1/2", 20 GA. GALV. COMPOSITE STEEL FLOOR DECK +3-1/2" N.W. CONCRETE TOPPING

> DENOTES 1-1/2", 20 GA. WIDE RIB ACOUSTICAL STEEL ROOF DECK, PRIME PAINTED (BOTH SIDES) ONLY.

DENOTES BEAM-TO-COLUMN MOMENT CONNECTION PER DETAIL 10/S-411 DENOTES BEAM-THRU-BEAM MOMENT CONNECTION PER DETAIL 4/S-411

BOTTOM OF BRACE - DENOTES HSS5x5x5/16 DIAGONAL BRACE

DENOTES APPROX. LOCATION OF FRAMED OPENING FOR ROOF DRAIN OR ROOF HATCH. REFER TO DETAIL 11/S-411. COORD. EXACT LOCATION w/ MECH. CONTRACTOR.




GIBRALTAR DESIGN

ARCHITECTURE • ENGINEERING • INTERIOR DESIGN

DOUGLAS MACARTHUR ES ADDITIONS AND **RENOVATIONS**

CROWN POINT COMMUNITY SCHOOL CORPORATION CEDAR LAKE, INDIANA

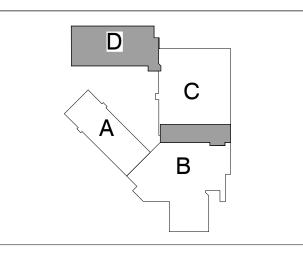

KEY PLAN

GIBRALTAR DESIGN 9102 N. Meridian St., Ste. 300 Indianapolis, IN 46260 Homepage www.GibraltarDesign.com

Email info@GibraltarDesign.com Phone 317.580.5777 Fax 317.580.5778 **PROJECT**

21-113 DATE 1/31/22 **COORDINATED BY** DRAWN BY



PE10606154

STATE OF

THE CONCEPTS, DESIGNS, PLANS, DETAILS, ETC, SHOWN ON THIS DOCUMENT ARE THE PROPERTY OF GIBRALTAR DESIGN AND WERE CREATED FOR USE ON THIS SPECIFIC PROJECT. NONE OF THIS INFORMATION SHALL BE USED BY ANY PERSON OR FIRM FOR ANY PURPOSE WITHOUT THE EXPRESS WRITTEN CONSENT OF GIBRALTAR DESIGN. THE OWNER MAY RETAIN COPIES FOR INFORMATION AND REFERENCE IN CONNECTION ONLY WITH THIS PROJECT

MARK DATE ISSUED FOR


CHECKED BY

AD-2 02.17.2022 ADDENDUM #2 AD-3 02.23.2022 ADDENDUM #3

ROOF FRAMING PLAN -UNITS C & D

DOUGLAS MACARTHUR ES **ADDITIONS AND RENOVATIONS**

ROOF FRAMING PLAN - UNIT D

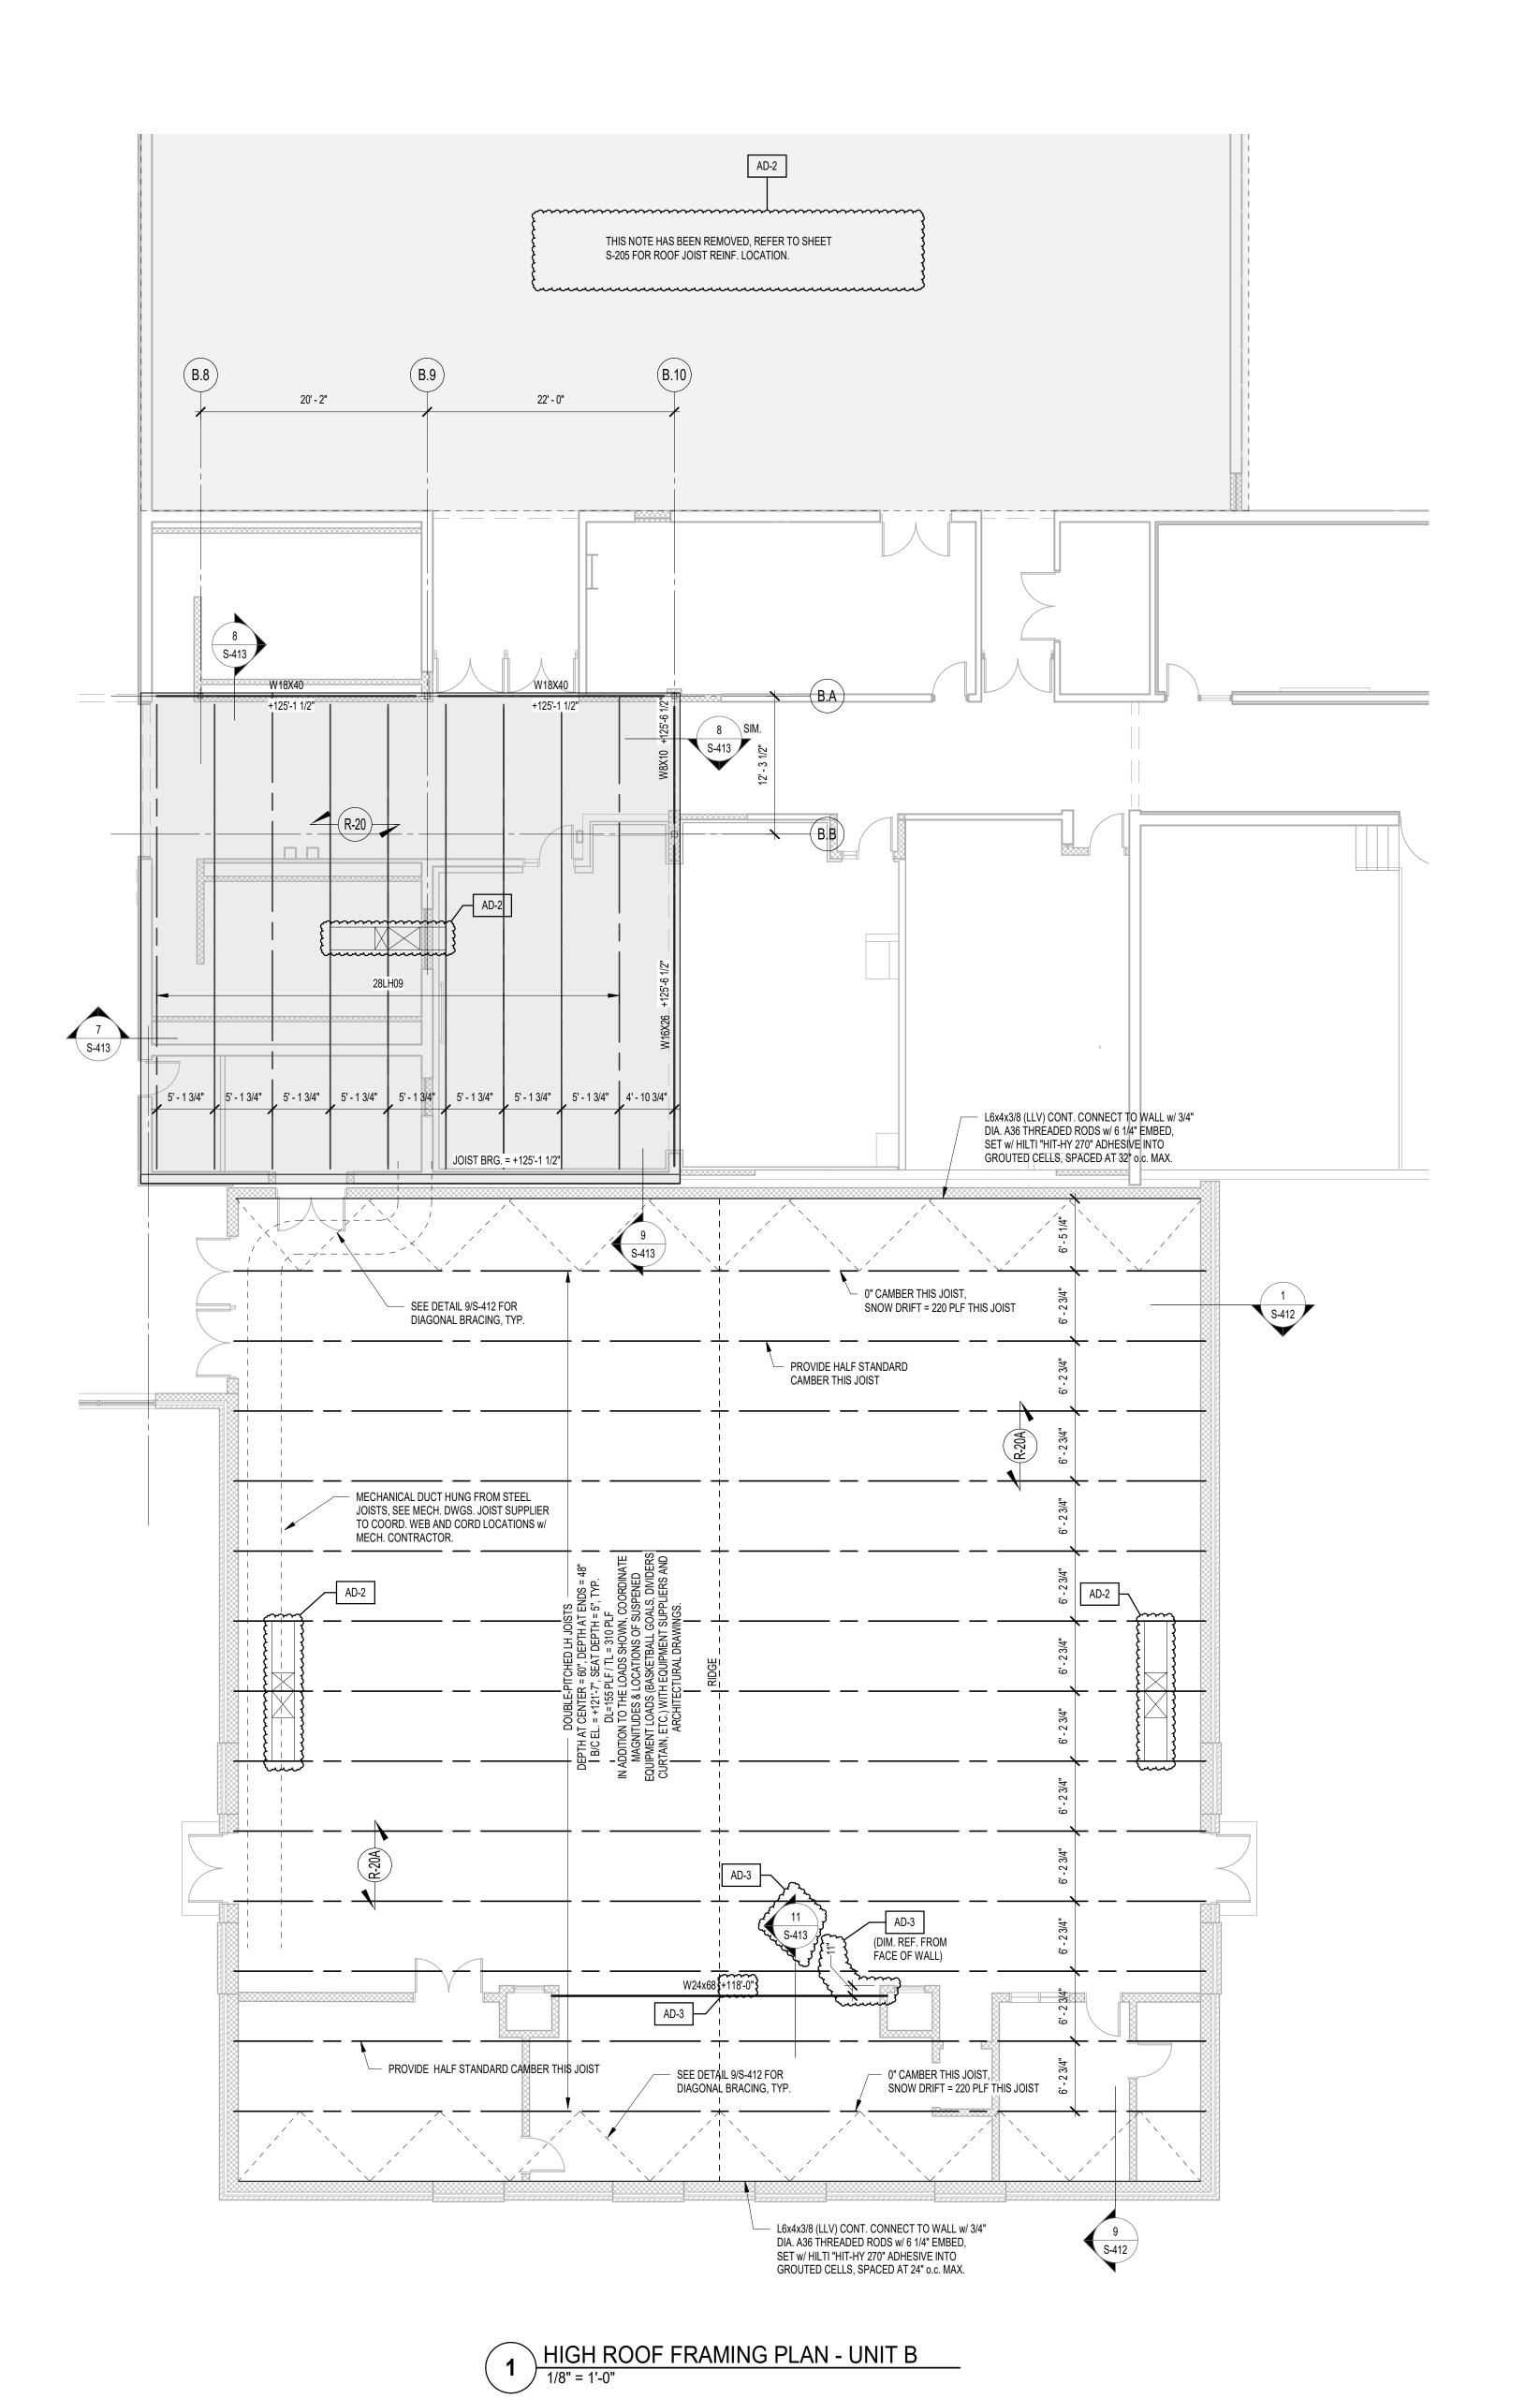

FRAMING PLAN NOTES

- 1. REF. S-001 FOR STRUCTURAL NOTES, DESIGN DATA, SCHEDULES & LEGENDS.
- 2. REF. THE S-400 SERIES FOR TYPICAL FRAMING AND MASONRY DETAILS. 3. ALL CONTRACTORS ARE REQUIRED TO COORDINATE THEIR WORK WITH ALL DISCIPLINES TO AVOID CONFLICTS. THE MECHANICAL, ELECTRICAL, AND PLUMBING ASPECTS ARE NOT IN THE SCOPE OF THESE DRAWINGS. THEREFORE, ALL REQUIRED MATERIALS AND WORK
- MAY NOT BE INDICATED. 4. ALL ELEVATIONS ARE REFERENCED FROM THE FIRST FLOOR FIN. FLOOR ELEVATION +100'-0". COORD. USGS ELEVATION WITH CIVIL DWGS.
- 5. REF. ARCH. DRAWINGS FOR ALL DIMENSIONS NOT SHOWN. CONTRACTOR SHALL VERIFY ALL DIMENSIONS PRIOR TO CONSTRUCTION AND IMMEDIATELY NOTIFY
- ARCHITECT/ENGINEER OF ANY DISCREPANCIES. 6. SEE FOUNDATION PLANS FOR SIZES OF STEEL COLUMNS SUPPORTED ON FOUNDATIONS. 7. REF. S-411 FOR TYPICAL CONNECTION & FRAMING DETAILS.
- 8. REF. S-421 FOR TYPICAL MASONRY DETAILS 9. INSTALL CONTINUOUS BENT PLATE/ANGLE POUR STOPS AT ALL ELEVATED SLAB-ON-DECK PERIMETER EDGES AND AROUND ALL INTERIOR FLOOR OPENINGS (BOTH SHOWN AND NOT SHOWN). SEE DETAIL 4/S-411.
- 10. INSTALL CONTINUOUS ANGLES AT ALL PERIMETER ROOF EDGES. SEE DETAIL X/S-XXX FOR ATTACHEMENT TO BEAM AND FOR ALL CONDITIONS NO SPECIFICALLY DEFINED IN FRAMING SECTIONS. 11. INSTALL CONTINUOUS CONCRETE CURBS PER DETAIL X/S-XXX AROUND THE PERIMETER OF ALL MECHANICAL ROOMS AND AROUND FLOOR PENETRATIOSN BOTH SHOWN AND
- NOW SHOWN INCLUDING STEEL COLUMN PENETRATIONS. 12. <u>ALL</u> WALLS SHALL BE LAID OUT FROM THE ARCHITECTURAL DRAWINGS. 13. REF. ARCH. DRAWINGS. FOR ALL DIMENSIONS NOT SHOWN. CONTRACTOR SHALL VERIFY ALL DIMENSIONS PRIOR TO CONSTRUCTION AND IMMEDIATELY NOTIFY
- ARCHITECT/ENGINEER OF ANY DISCREPANCIES. 14. COORDINATE EXACT SIZE & LOCATION OF ANY MECHANICAL OPENINGS IN FLOOR SLAB, ROOF DECK, OR WALLS WITH THE MEP CONTRACTOR(S). LOCATION & SIZE OF ALL DUCT
- OPENINGS, GRILLES, ETC. SHALL BE VERIFIED PRIOR TO CONSTRUCTION. 15. ALL ELEVATIONS SHOWN ON PLAN INDICATE TOP OF STEEL BEAM UNLESS NOTED 16. PROVIDE CHANNEL FRAMES AT ALL SUPPORTED SLAB OPENINGS PER TYPICAL DETAIL ON S-411. COORDINATE EXACT NUMBER, LOCATIONS & DIMENSIONS WITH THE APPROPRIATE
- CONTRACTORS & THE ARCH. & MEP DRAWINGS. 7. PROVIDE FRAMES AT ALL ROOF DRAINS, ROOF HATCHES & OTHER ROOF OPENINGS PER TYPICAL DETAILS ON S-411. COORD. EXACT NUMBER, LOCATIONS & DIMENSIONS WITH THE APPROPRIATE CONTRACTORS & THE ARCH. & MEP DWGS. 18. PROVIDE CMU REINFORCING AS NOTED ON PLANS. IF NOT SHOWN ON PLANS OR DETAILS, MINIMUM CMU WALL REINFORCING TO BE #5 VERTS @ 48" O.C. PROVIDE OPEN-CORE

BOND BEAMS AT TOPS OF WALLS, AT CHANGES IN CMU THICKNESS, AND WHERE INDICATED ON PLANS & SECTIONS (10'-0" O.C. MAX VERTICAL SPACING). PROVIDE 1/2 OF

- INTERRUPTED VERTICALS AT JAMBS OF OPENINGS AND PROVIDE ADDITIONAL VERT'S. AT 19. ALL MASONRY BOND BEAMS, OTHER THAN BOND BEAM LINTELS OVER OPENINGS, SHALL BE "OPEN-CORE" BOND BEAMS TO ALLOW VERTICAL REINFORCING TO PASS THROUGH,
- UNLESS NOTED OTHERWISE. 20. REF. ARCH. DWGS. FOR MASONRY CONTROL & EXPANSION JOINT LOCATIONS. 21. ALL HORIZONTAL AND DIAGONAL BRIDGING FOR STEEL JOISTS SHALL BE DESIGNED,
- LOCATED & PROVIDED BY THE JOIST SUPPLIER PER SJI SPECIFICATIONS. 22. FOR ALL MODIFICATIONS MADE TO EXIST. CONC. TEES, FIELD LOCATE EXISTNG REINF. (VIA X-RAY OR OTHER APPROVED METHOD) TO AVOID CUTTING INTO TENDONS PRIOR TO CUTTING AND TO AVOID ANCHORING INTO TENDONS.
- 23. NEW OPENINGS CUT INTO CONCRETE TEES SHALL FOLLOW REQUIREMENTS AS SHOWN ON DETAIL 2/S-203. SEE STRUCTURAL PLANS FOR OPENINGS WHERE WIDTH IS GREATER
- 24. ALIGN TRUSS TO BEAM BELOW ON GRID AT THIS LOCATION. DESIGN FOR 200 PLF DRAG LOAD FOR LATERAL TRANSFER TO BRACING.

PLAN LEGEND: T/'X'

DENOTES TOP OF STEEL, SLAB, ETC.

DENOTES EDGE OF SLAB (MEASURED FROM BEAM C.L.) SEE TYPICAL DETAIL A/S-410


DENOTES EDGE OF DECK (MEASURED FROM BEAM C.L.) (or EOD) NOTE: PERIMETER ROOF ANGLE/BENT PL NOT REQUIRED



PRIME PAINTED ONLY.


FLOOR DECK +3-1/2" N.W. CONCRETE TOPPING w/ 6x6 W2.1xW2.1 W.W.F (5" TOTAL SLAB 't').

DENOTES 1-1/2", 20 / 22 GA. WIDE RIB STEEL ROOF DECK,

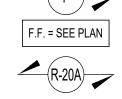


STEEL ELEVATION

DENOTES 1-1/2", 20 GA. WIDE RIB ACOUSTICAL STEEL ROOF DECK, PRIME PAINTED (BOTH SIDES) ONLY.

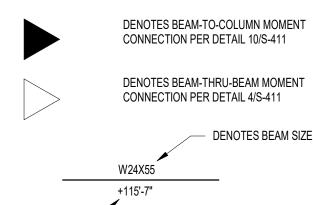

TYP. BRACING NOTATION - REFER TO TYP. DETAIL 8/S-411 FOR MORE INFORMATION

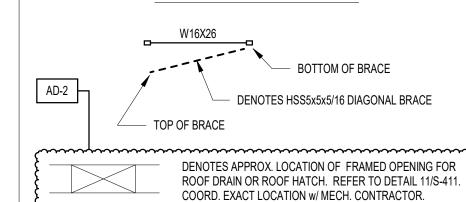




GIBRALTAR DESIGN

ARCHITECTURE • ENGINEERING • INTERIOR DESIGN

PROJECT

DOUGLAS MACARTHUR ES ADDITIONS AND RENOVATIONS

CROWN POINT COMMUNITY SCHOOL CORPORATION CEDAR LAKE, INDIANA

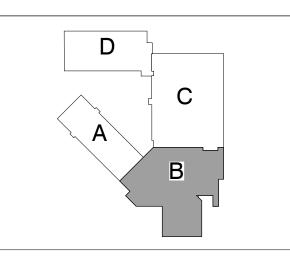


KEY PLAN

GIBRALTAR DESIGN 9102 N. Meridian St., Ste. 300 Indianapolis, IN 46260 Homepage www.GibraltarDesign.com Email info@GibraltarDesign.com

PROJECT 21-113 DATE 1/31/22 **COORDINATED BY** DRAWN BY

CHECKED BY

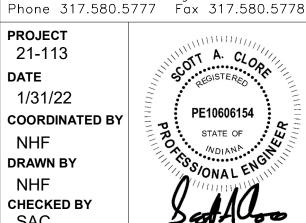


THE CONCEPTS, DESIGNS, PLANS, DETAILS, ETC, SHOWN ON THIS DOCUMENT ARE THE PROPERTY OF GIBRALTAR DESIGN AND WERE CREATED FOR USE ON THIS SPECIFIC PROJECT. NONE OF THIS INFORMATION SHALL BE USED BY ANY PERSON OR FIRM FOR ANY PURPOSE WITHOUT THE EXPRESS WRITTEN CONSENT OF GIBRALTAR DESIGN. THE OWNER MAY RETAIN COPIES FOR INFORMATION AND REFERENCE IN CONNECTION ONLY WITH THIS PROJECT.

REVISIONS MARK DATE ISSUED FOR AD-2 02.17.2022 ADDENDUM #2 AD-3 02.23.2022 ADDENDUM #3

HIGH ROOF FRAMING PLAN

DOUGLAS MACARTHUR ES **ADDITIONS AND RENOVATIONS**

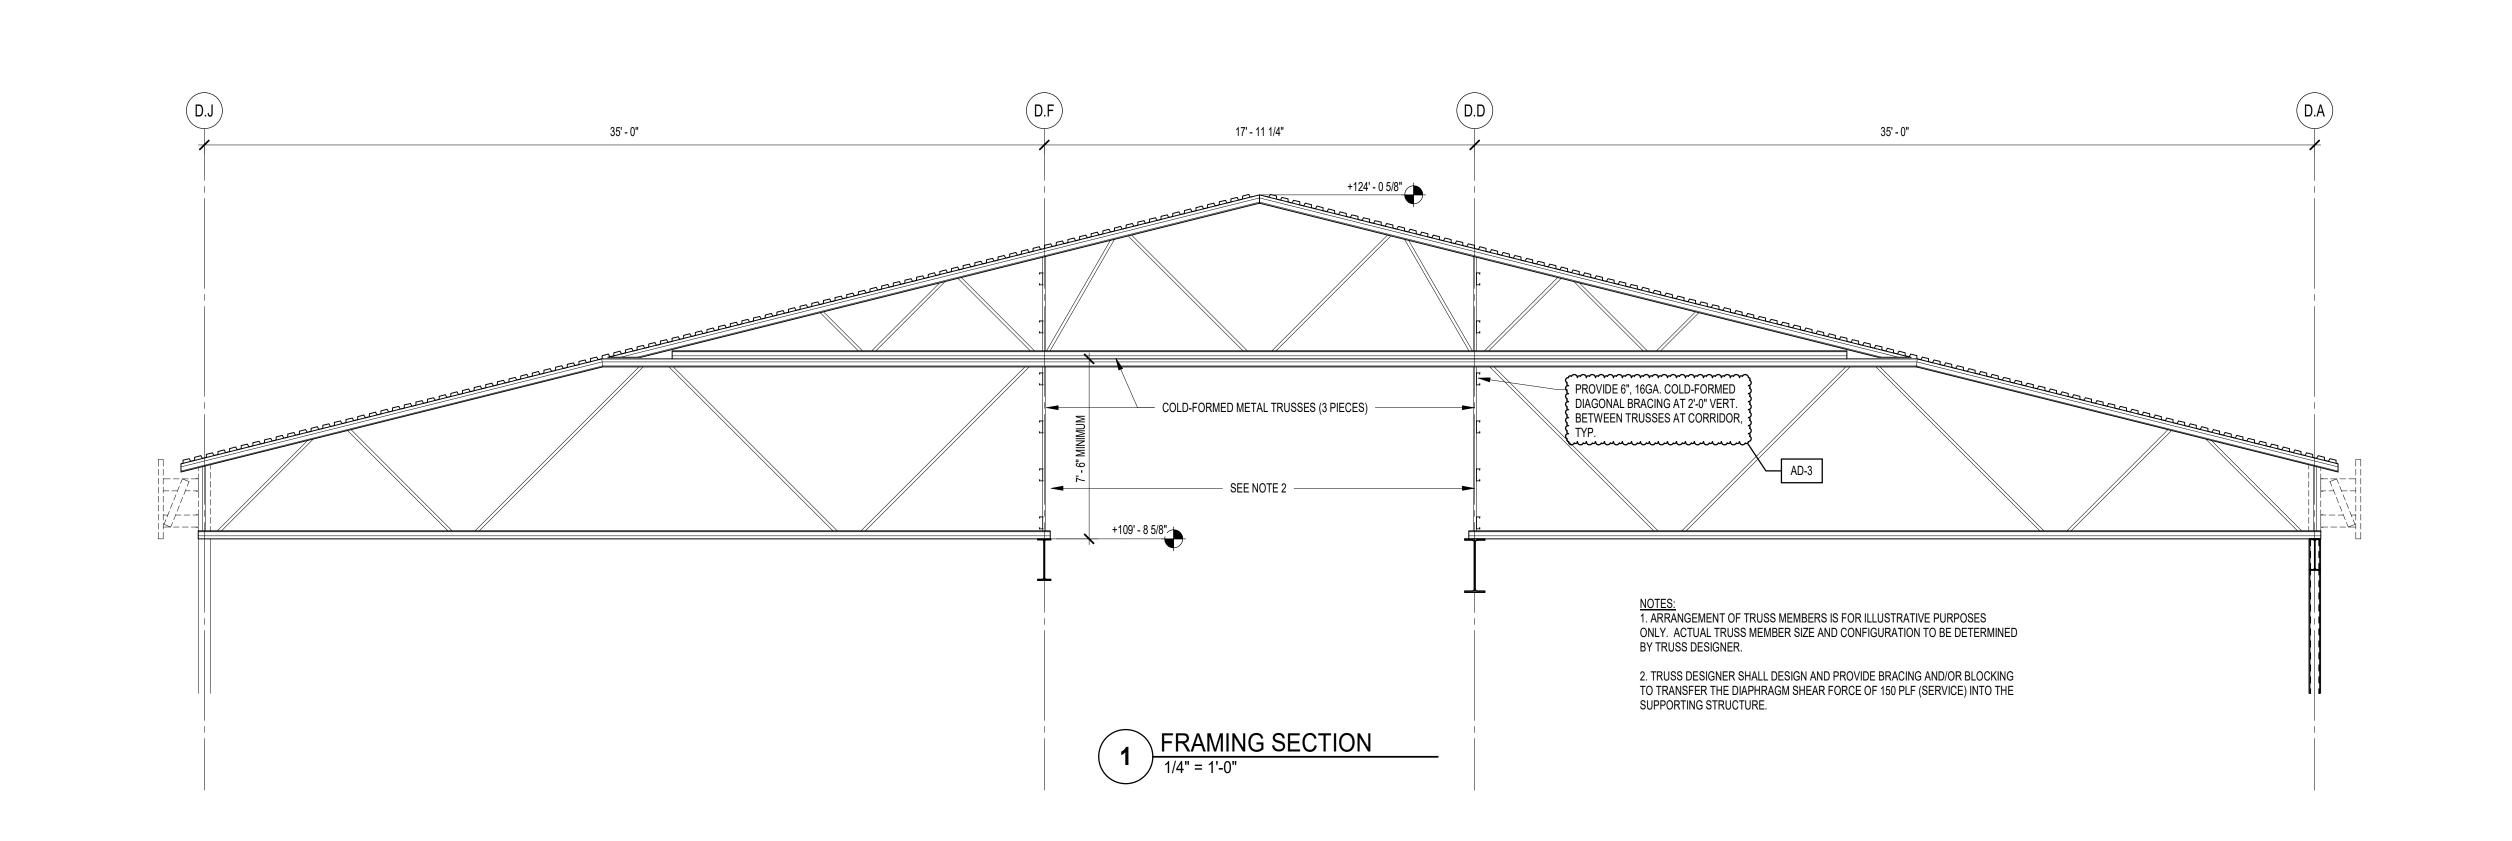



GIBRALTAR DESIGN

ARCHITECTURE • ENGINEERING • INTERIOR DESIGN

PROJECT

DOUGLAS **MACARTHUR ES ADDITIONS** AND RENOVATIONS

CROWN POINT COMMUNITY SCHOOL CORPORATION CEDAR LAKE, INDIANA

GIBRALTAR DESIGN

9102 N. Meridian St., Ste. 300 Indianapolis, IN 46260 Homepage www.GibraltarDesign.com Email info@GibraltarDesign.com Phone 317.580.5777 Fax 317.580.5778

PROJECT 21-113 DATE

1/31/22 COORDINATED BY **DRAWN BY** CHECKED BY SAC



THE CONCEPTS, DESIGNS, PLANS, DETAILS, ETC, SHOWN ON THIS DOCUMENT ARE THE PROPERTY OF GIBRALTAR DESIGN AND WERE CREATED FOR USE ON THIS SPECIFIC PROJECT. NONE OF THIS INFORMATION SHALL BE USED BY ANY PERSON OR FIRM FOR ANY PURPOSE WITHOUT THE EXPRESS WRITTEN CONSENT OF GIBRALTAR DESIGN. THE OWNER MAY RETAIN COPIES FOR INFORMATION AND REFERENCE IN CONNECTION ONLY WITH THIS PROJECT.

REVISIONS


MARK	DATE	ISSUED FOR
AD-3	02.23.2022	ADDENDUM #3
		l

DRAWING COLD-FORMED METAL TRUSS SECTIONS


PROJECT DOUGLAS MACARTHUR ES **ADDITIONS AND RENOVATIONS**

© GIBRALTAR DESIGN SHEET


S-301

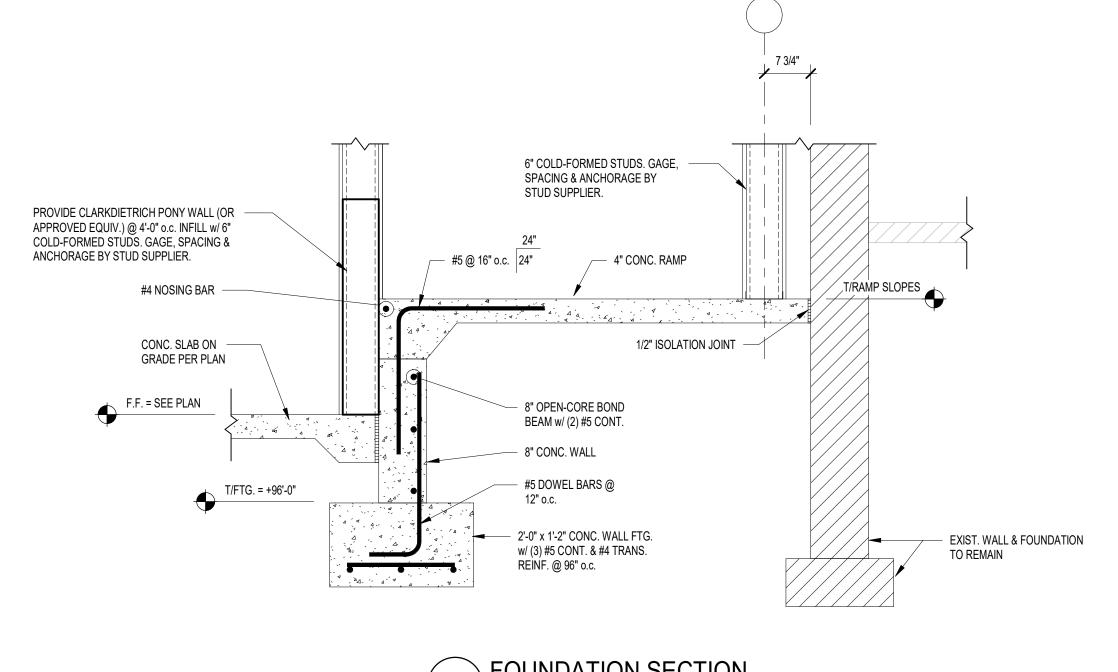


FOUNDATION SECTION

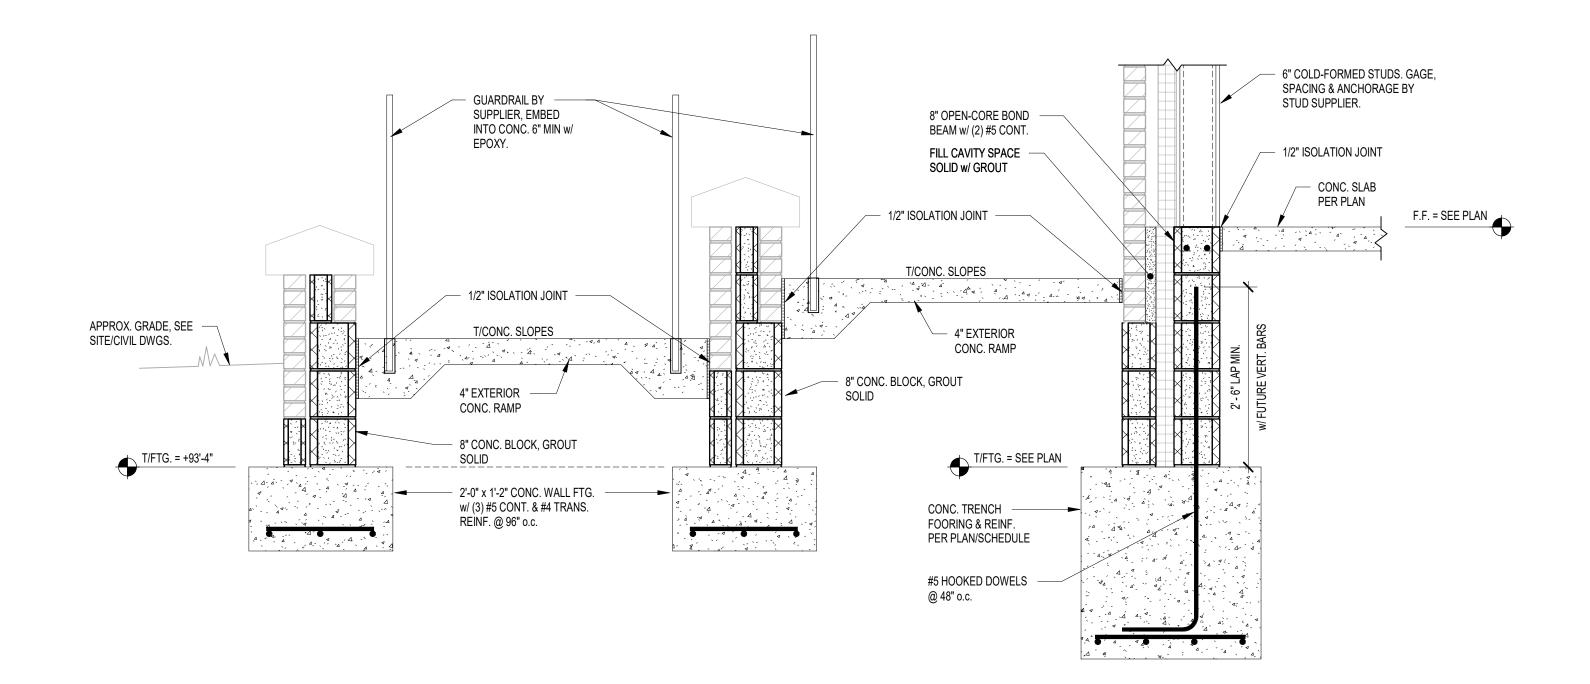

FOUNDATION SECTION 3/4" = 1'-0"

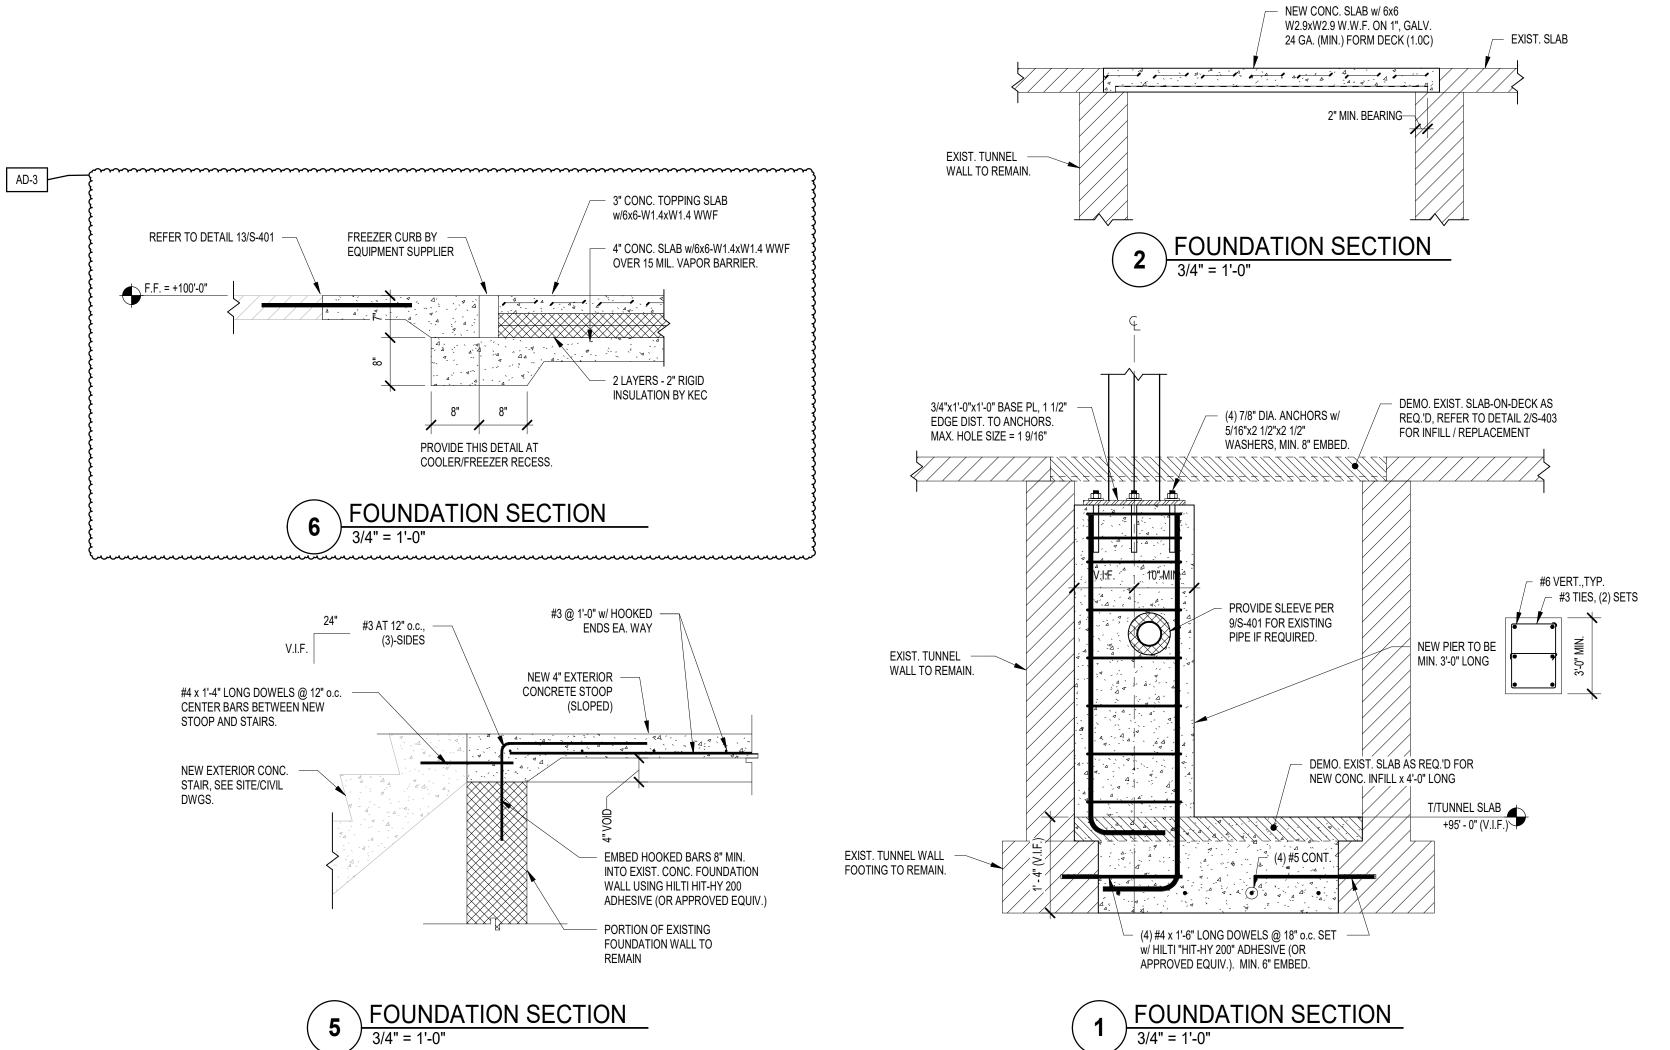

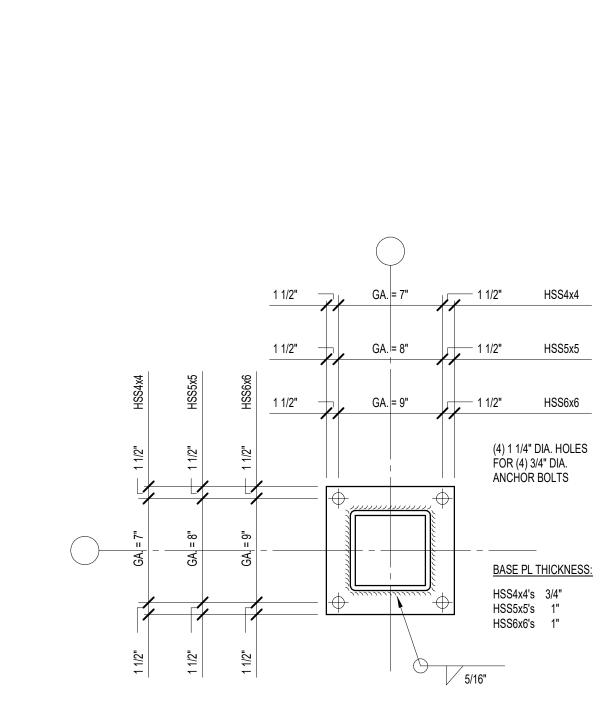

X HSS4, HSS5 & HSS6 BASE PL DETAILS
NOT TO SCALE



GIBRALTAR DESIGN ARCHITECTURE • ENGINEERING • INTERIOR DESIGN

PROJECT


DOUGLAS MACARTHUR ES ADDITIONS AND RENOVATIONS

CROWN POINT COMMUNITY SCHOOL CORPORATION CEDAR LAKE, INDIANA

GIBRALTAR DESIGN 9102 N. Meridian St., Ste. 300 Indianapolis, IN 46260
Homepage www.GibraltarDesign.com
Email info@GibraltarDesign.com
Phone 317.580.5777 Fax 317.580.5778

21-113 DATE 1/31/22 **COORDINATED BY** DRAWN BY

CHECKED BY

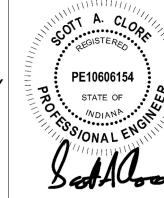

THE CONCEPTS, DESIGNS, PLANS, DETAILS, ETC, SHOWN ON THIS DOCUMENT ARE THE PROPERTY OF GIBRALTAR DESIGN AND WERE CREATED FOR USE ON THIS SPECIFIC PROJECT. NONE OF THIS INFORMATION SHALL BE USED BY ANY PERSON OR FIRM FOR ANY PURPOSE WITHOUT THE EXPRESS WRITTEN CONSENT OF GIBRALTAR DESIGN. THE OWNER MAY RETAIN COPIES FOR INFORMATION AND REFERENCE IN CONNECTION ONLY WITH THIS PROJECT.


REVISIONS MARK DATE ISSUED FOR AD-3 02.23.2022 ADDENDUM #3

DRAWING STRUCTURAL FOUNDATION SECTIONS

PROJECT DOUGLAS MACARTHUR ES ADDITIONS AND RENOVATIONS

© GIBRALTAR DESIGN SHEET

S-403

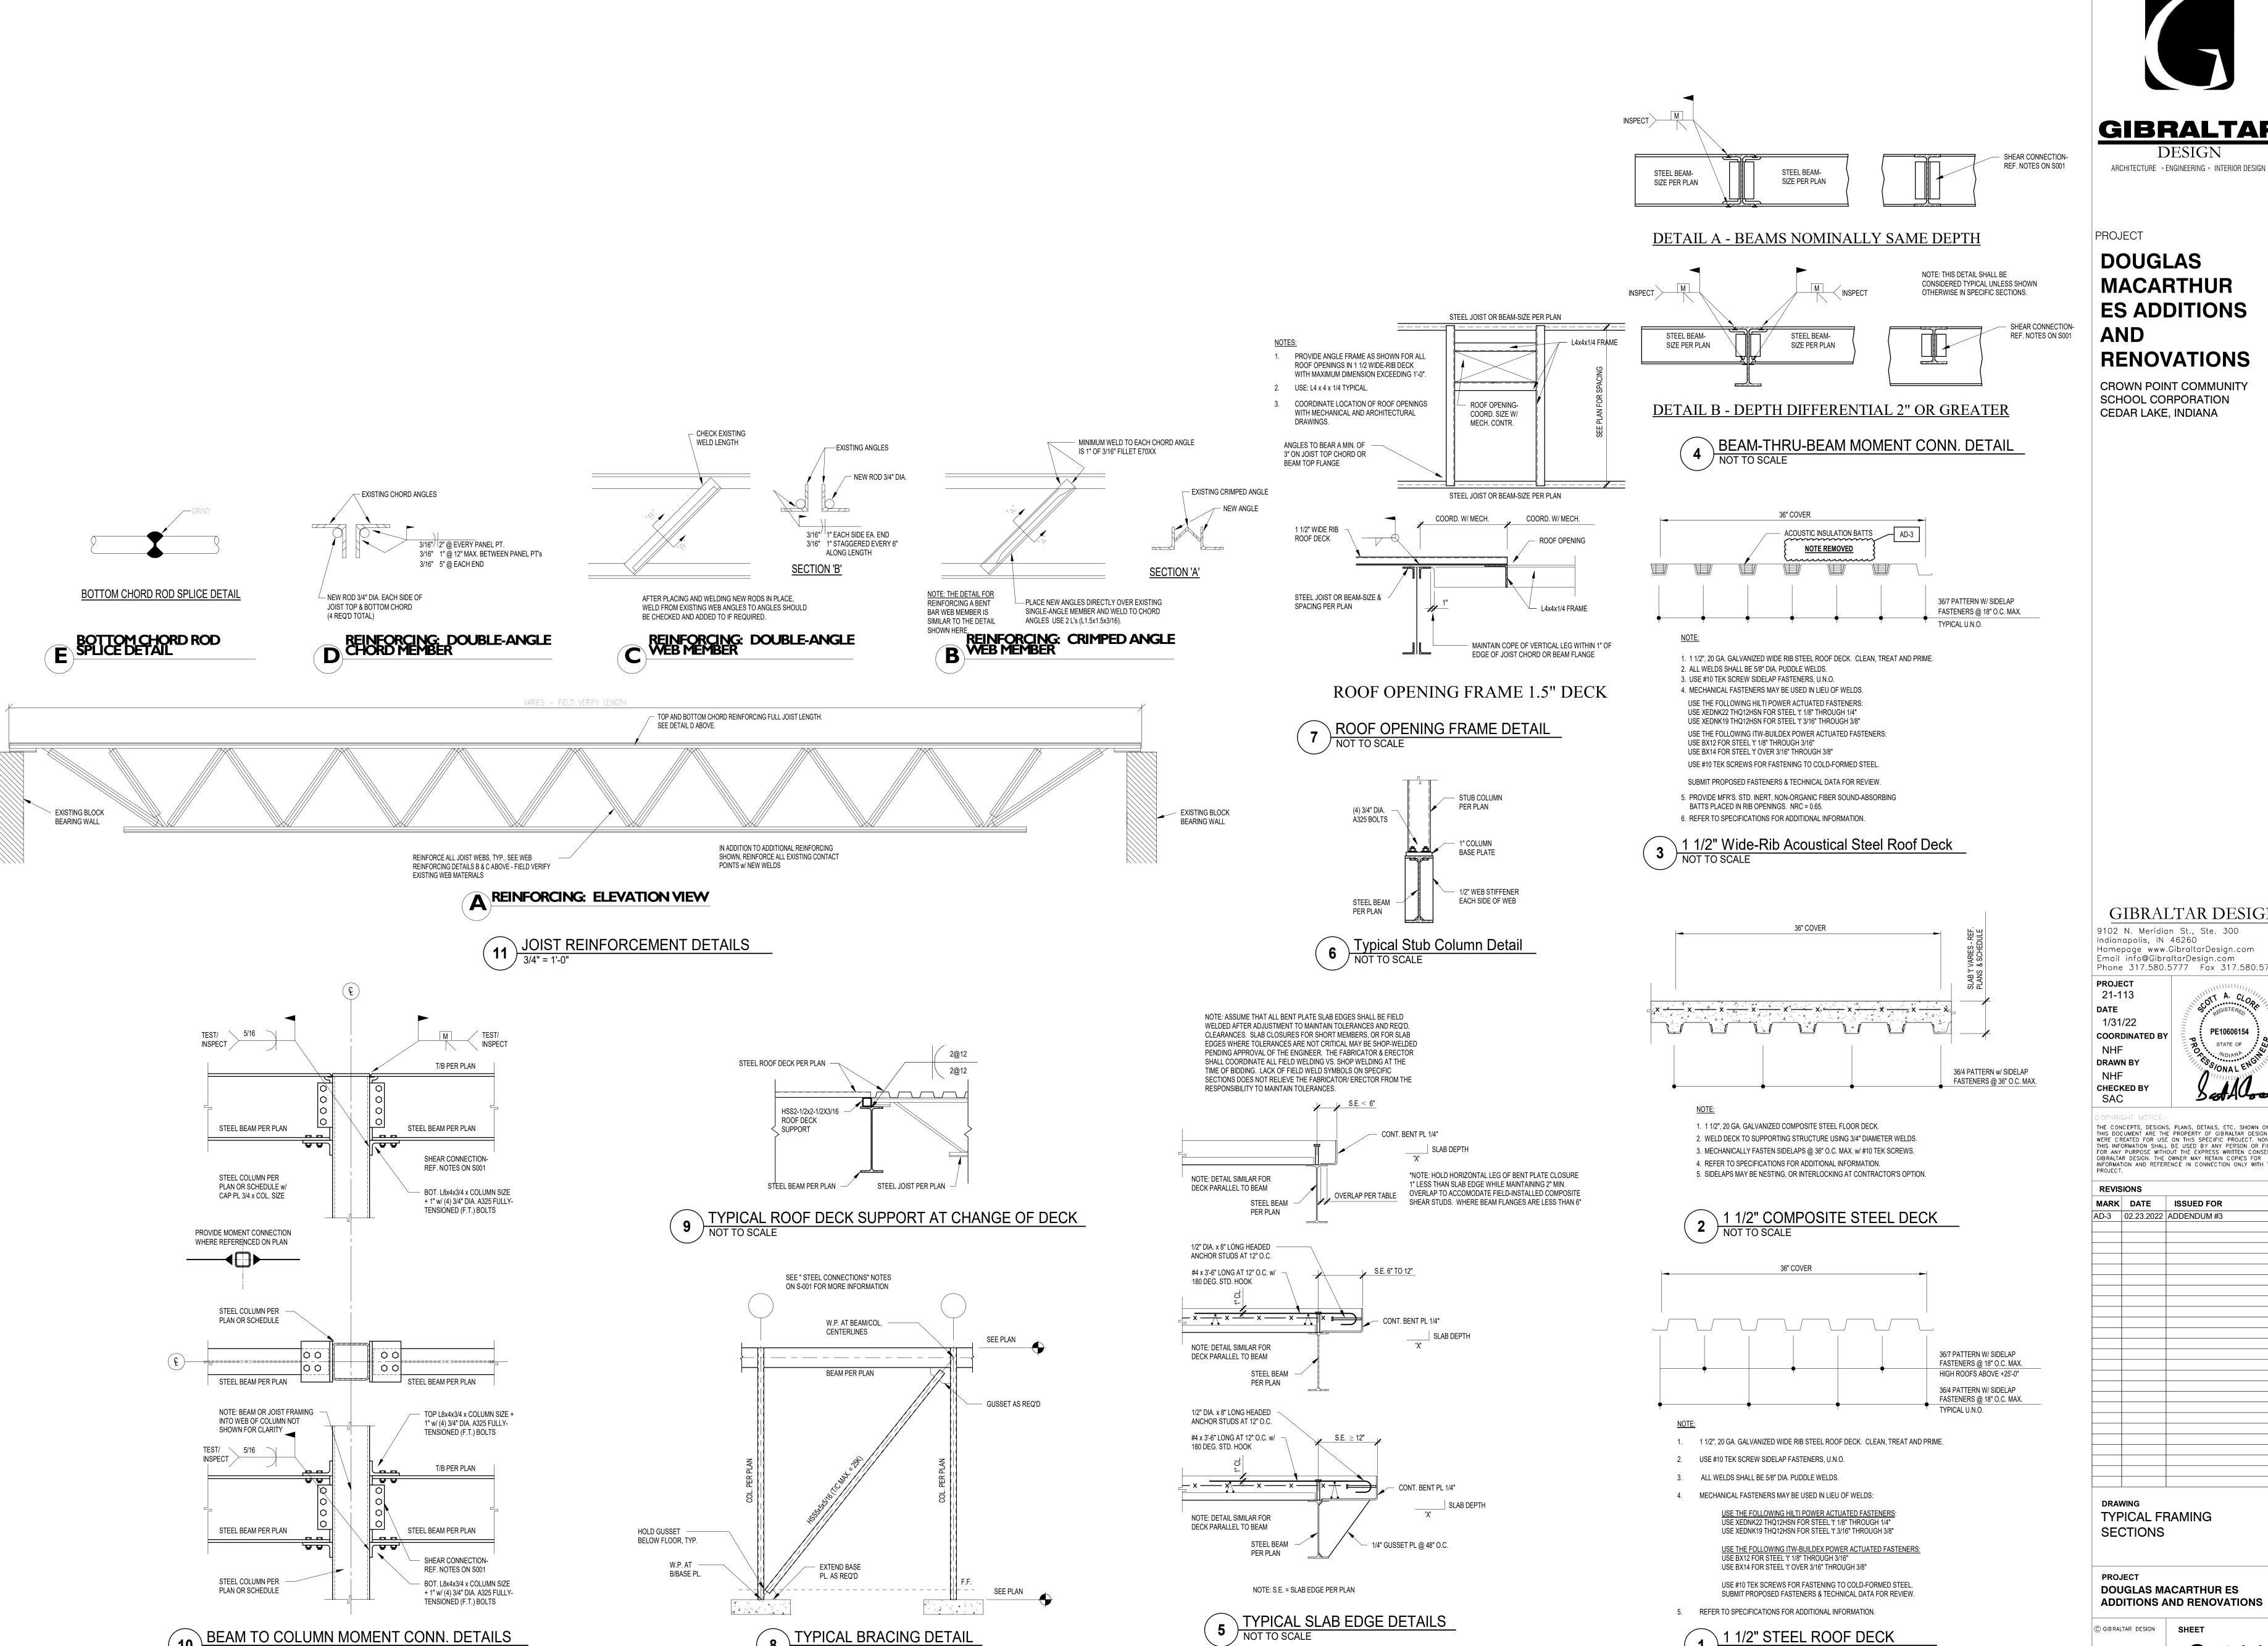




GIBRALTAR DESIGN

DOUGLAS **MACARTHUR ES ADDITIONS AND**

CROWN POINT COMMUNITY SCHOOL CORPORATION

GIBRALTAR DESIGN 9102 N. Meridian St., Ste. 300 Indianapolis, IN 46260 | Homepage www.GibraltarDesign.com Email info@GibraltarDesign.com Phone 317.580.5777 Fax 317.580.5778

COORDINATED BY

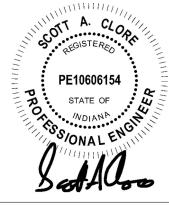


THE CONCEPTS, DESIGNS, PLANS, DETAILS, ETC, SHOWN ON THIS DOCUMENT ARE THE PROPERTY OF GIBRALTAR DESIGN AND WERE CREATED FOR USE ON THIS SPECIFIC PROJECT. NONE OF THIS INFORMATION SHALL BE USED BY ANY PERSON OR FIRM FOR ANY PURPOSE WITHOUT THE EXPRESS WRITTEN CONSENT OF GIBRALTAR DESIGN. THE OWNER MAY RETAIN COPIES FOR INFORMATION AND REFERENCE IN CONNECTION ONLY WITH THIS PROJECT

MARK DATE ISSUED FOR AD-3 02.23.2022 ADDENDUM #3

TYPICAL FRAMING

PROJECT DOUGLAS MACARTHUR ES ADDITIONS AND RENOVATIONS

© GIBRALTAR DESIGN SHEET

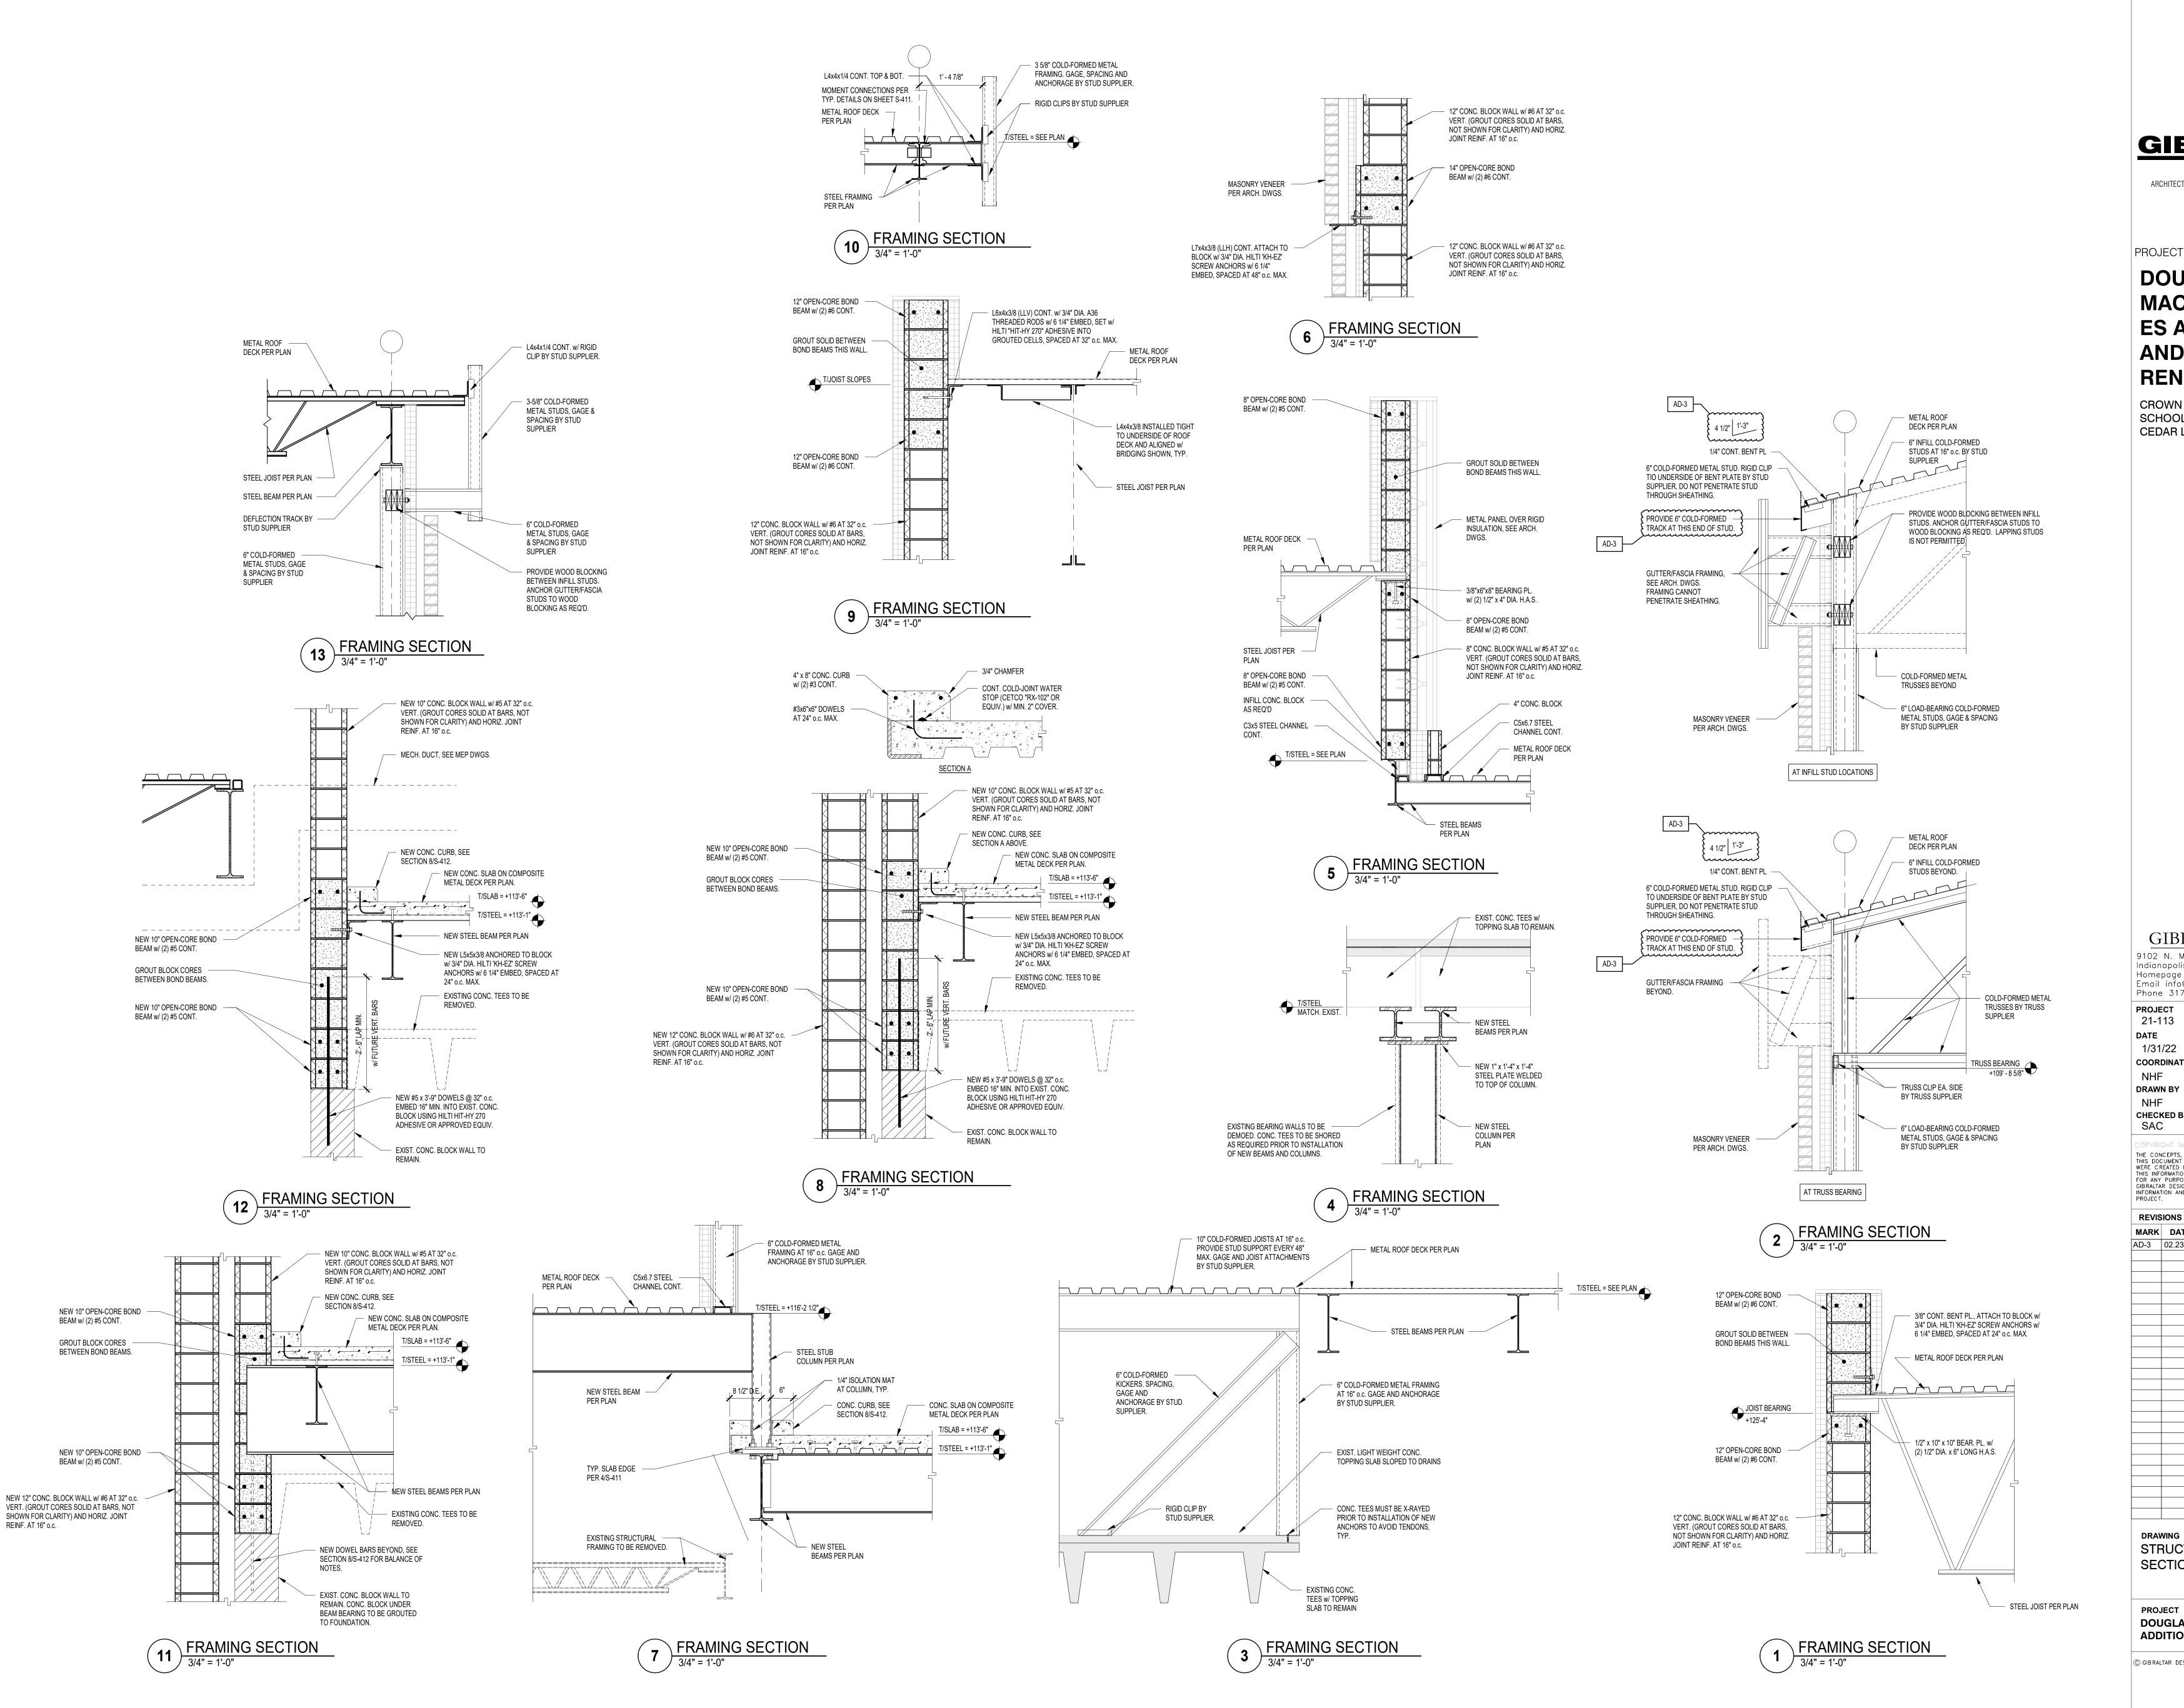



DESIGN ARCHITECTURE • ENGINEERING • INTERIOR DESIGN

PROJECT

DOUGLAS MACARTHUR ES ADDITIONS AND RENOVATIONS

CROWN POINT COMMUNITY SCHOOL CORPORATION CEDAR LAKE, INDIANA

GIBRALTAR DESIGN 9102 N. Meridian St., Ste. 300 Indianapolis, IN 46260 Homepage www.GibraltarDesign.com Email info@GibraltarDesign.com Phone 317.580.5777 Fax 317.580.5778

PROJECT 21-113 DATE 1/31/22 **COORDINATED BY DRAWN BY CHECKED BY**



THE CONCEPTS, DESIGNS, PLANS, DETAILS, ETC, SHOWN ON THIS DOCUMENT ARE THE PROPERTY OF GIBRALTAR DESIGN AND WERE CREATED FOR USE ON THIS SPECIFIC PROJECT. NONE OF THIS INFORMATION SHALL BE USED BY ANY PERSON OR FIRM FOR ANY PURPOSE WITHOUT THE EXPRESS WRITTEN CONSENT OF GIBRALTAR DESIGN. THE OWNER MAY RETAIN COPIES FOR INFORMATION AND REFERENCE IN CONNECTION ONLY WITH THIS PROJECT


MARK DATE ISSUED FOR AD-3 02.23.2022 ADDENDUM #3

DRAWING STRUCTURAL FRAMING SECTIONS

PROJECT DOUGLAS MACARTHUR ES **ADDITIONS AND RENOVATIONS**

© GIBRALTAR DESIGN SHEET

S-412

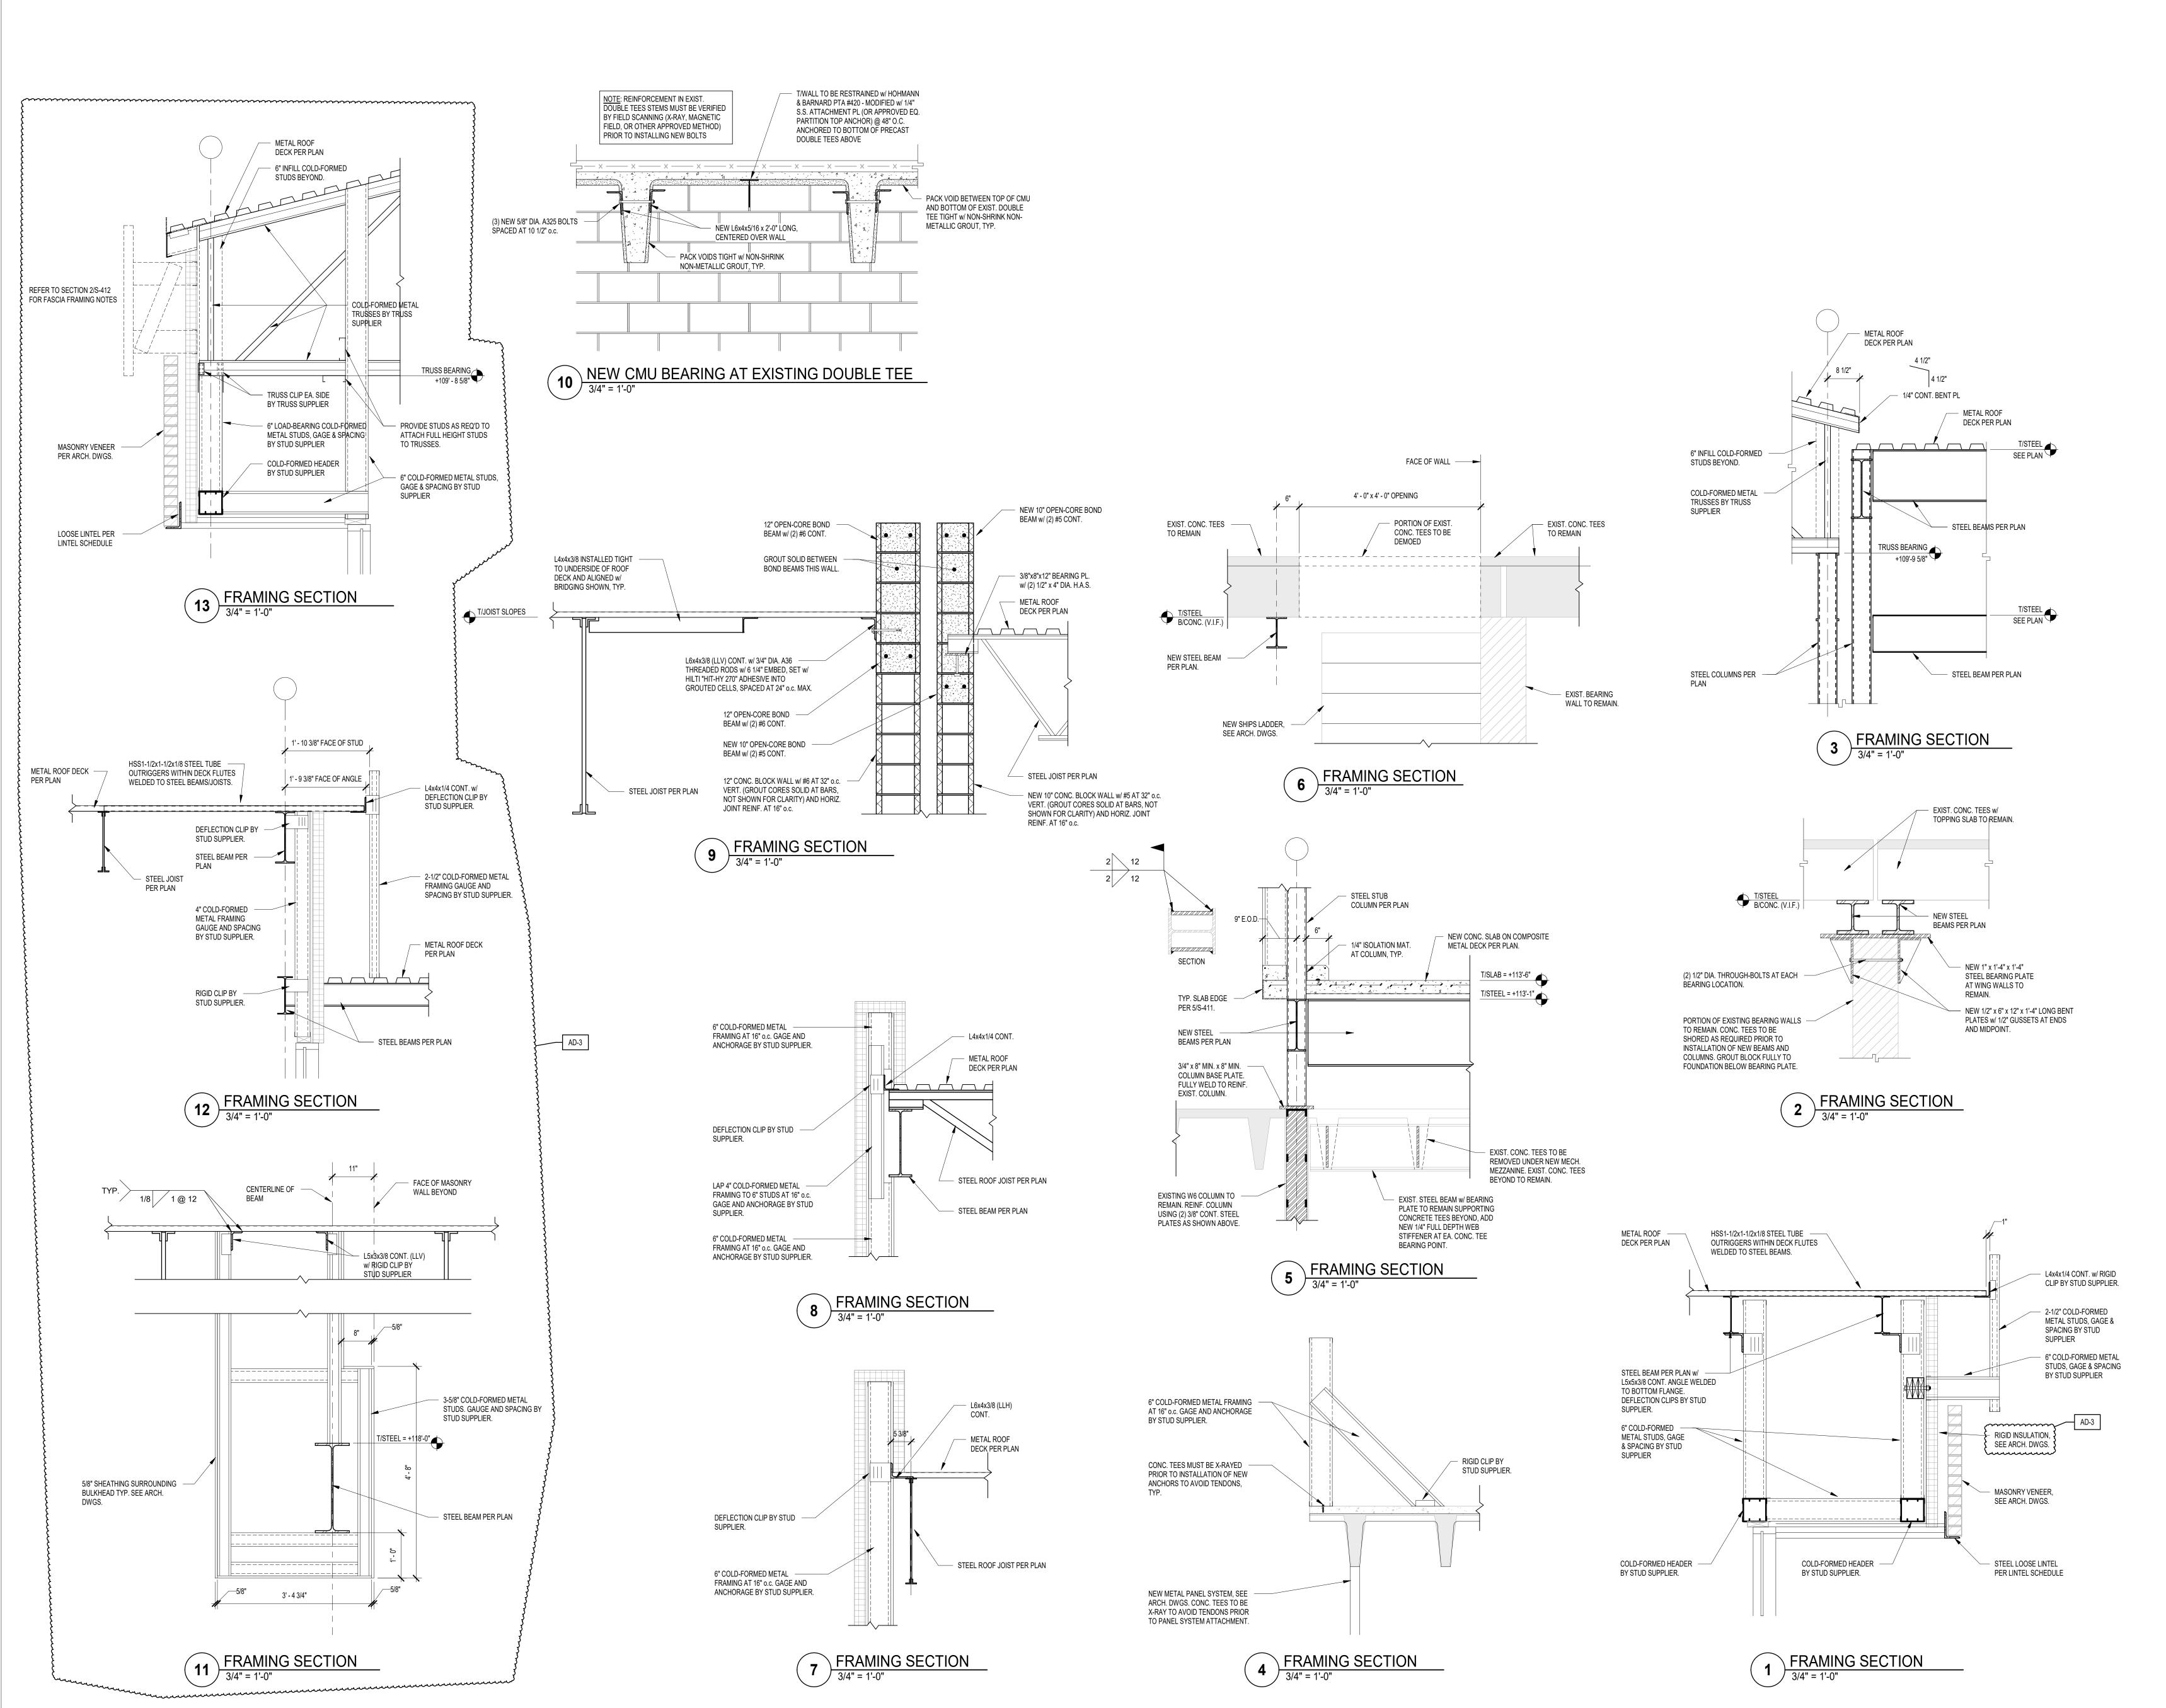



DESIGN

ARCHITECTURE • ENGINEERING • INTERIOR DESIGN

PROJECT

DOUGLAS
MACARTHUR
ES ADDITIONS
AND
RENOVATIONS

CROWN POINT COMMUNITY SCHOOL CORPORATION CEDAR LAKE, INDIANA

GIBRALTAR DESIGN
9102 N. Meridian St., Ste. 300
Indianapolis, IN 46260
Homepage www.GibraltarDesign.com
Email info@GibraltarDesign.com
Phone 317.580.5777 Fax 317.580.5778

PROJECT

21-113
DATE
1/31/22
COORDINATED BY
NHF
DRAWN BY
NHF
CHECKED BY



THE CONCEPTS, DESIGNS, PLANS, DETAILS, ETC, SHOWN ON THIS DOCUMENT ARE THE PROPERTY OF GIBRALTAR DESIGN AND WERE CRATED FOR USE ON THIS SPECIFIC PROJECT. NONE OF THIS INFORMATION SHALL BE USED BY ANY PERSON OR FIRM FOR ANY PURPOSE WITHOUT THE EXPRESS WRITTEN CONSENT OF GIBRALTAR DESIGN. THE OWNER MAY RETAIN COPIES FOR INFORMATION AND REFERENCE IN CONNECTION ONLY WITH THIS PROJECT.

REVISIONS

MARK DATE ISSUED FOR

AD-3 02.23.2022 ADDENDUM#3

DRAWING STRUCTURAL FRAMING STRUCTURAL FRAMING STRUCTURAL FRAMING SECTIONS


DRAWING STRUCTURAL FRAMING SECTIONS


DOUGLAS MACARTHUR ES
ADDITIONS AND RENOVATIONS

© GIBRALTAR DESIGN SHEET

PROJECT

S-413

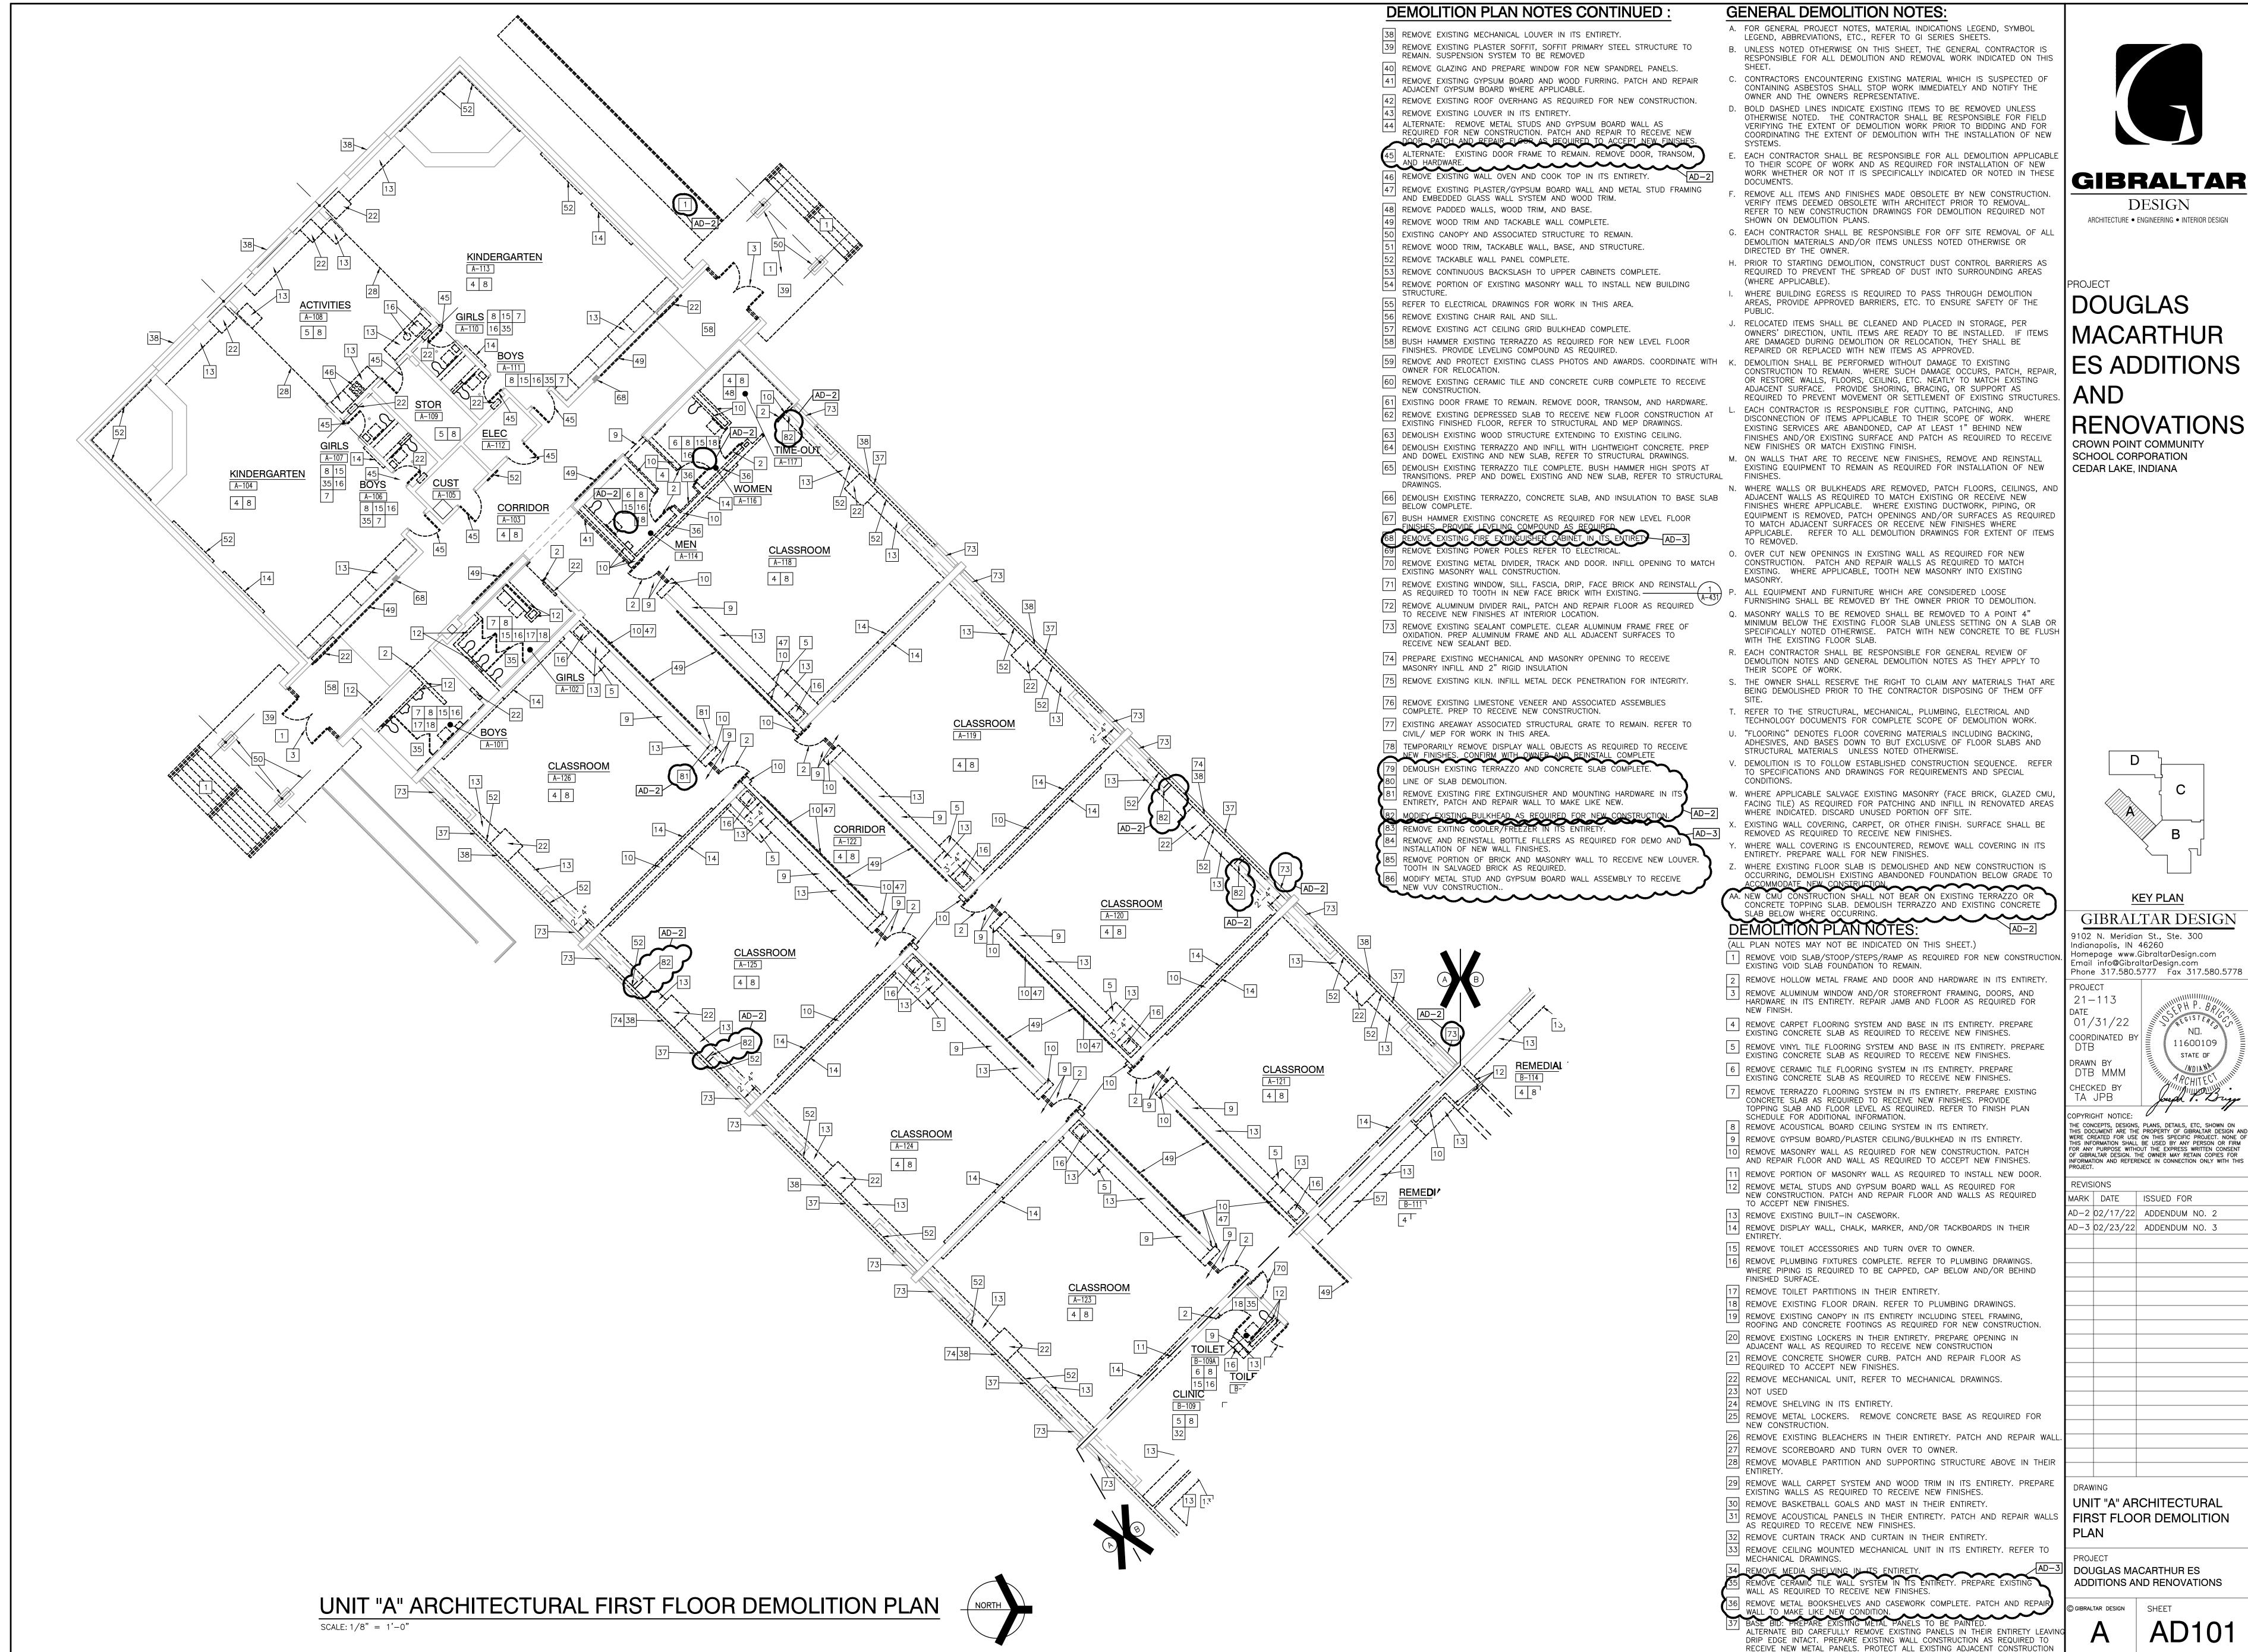

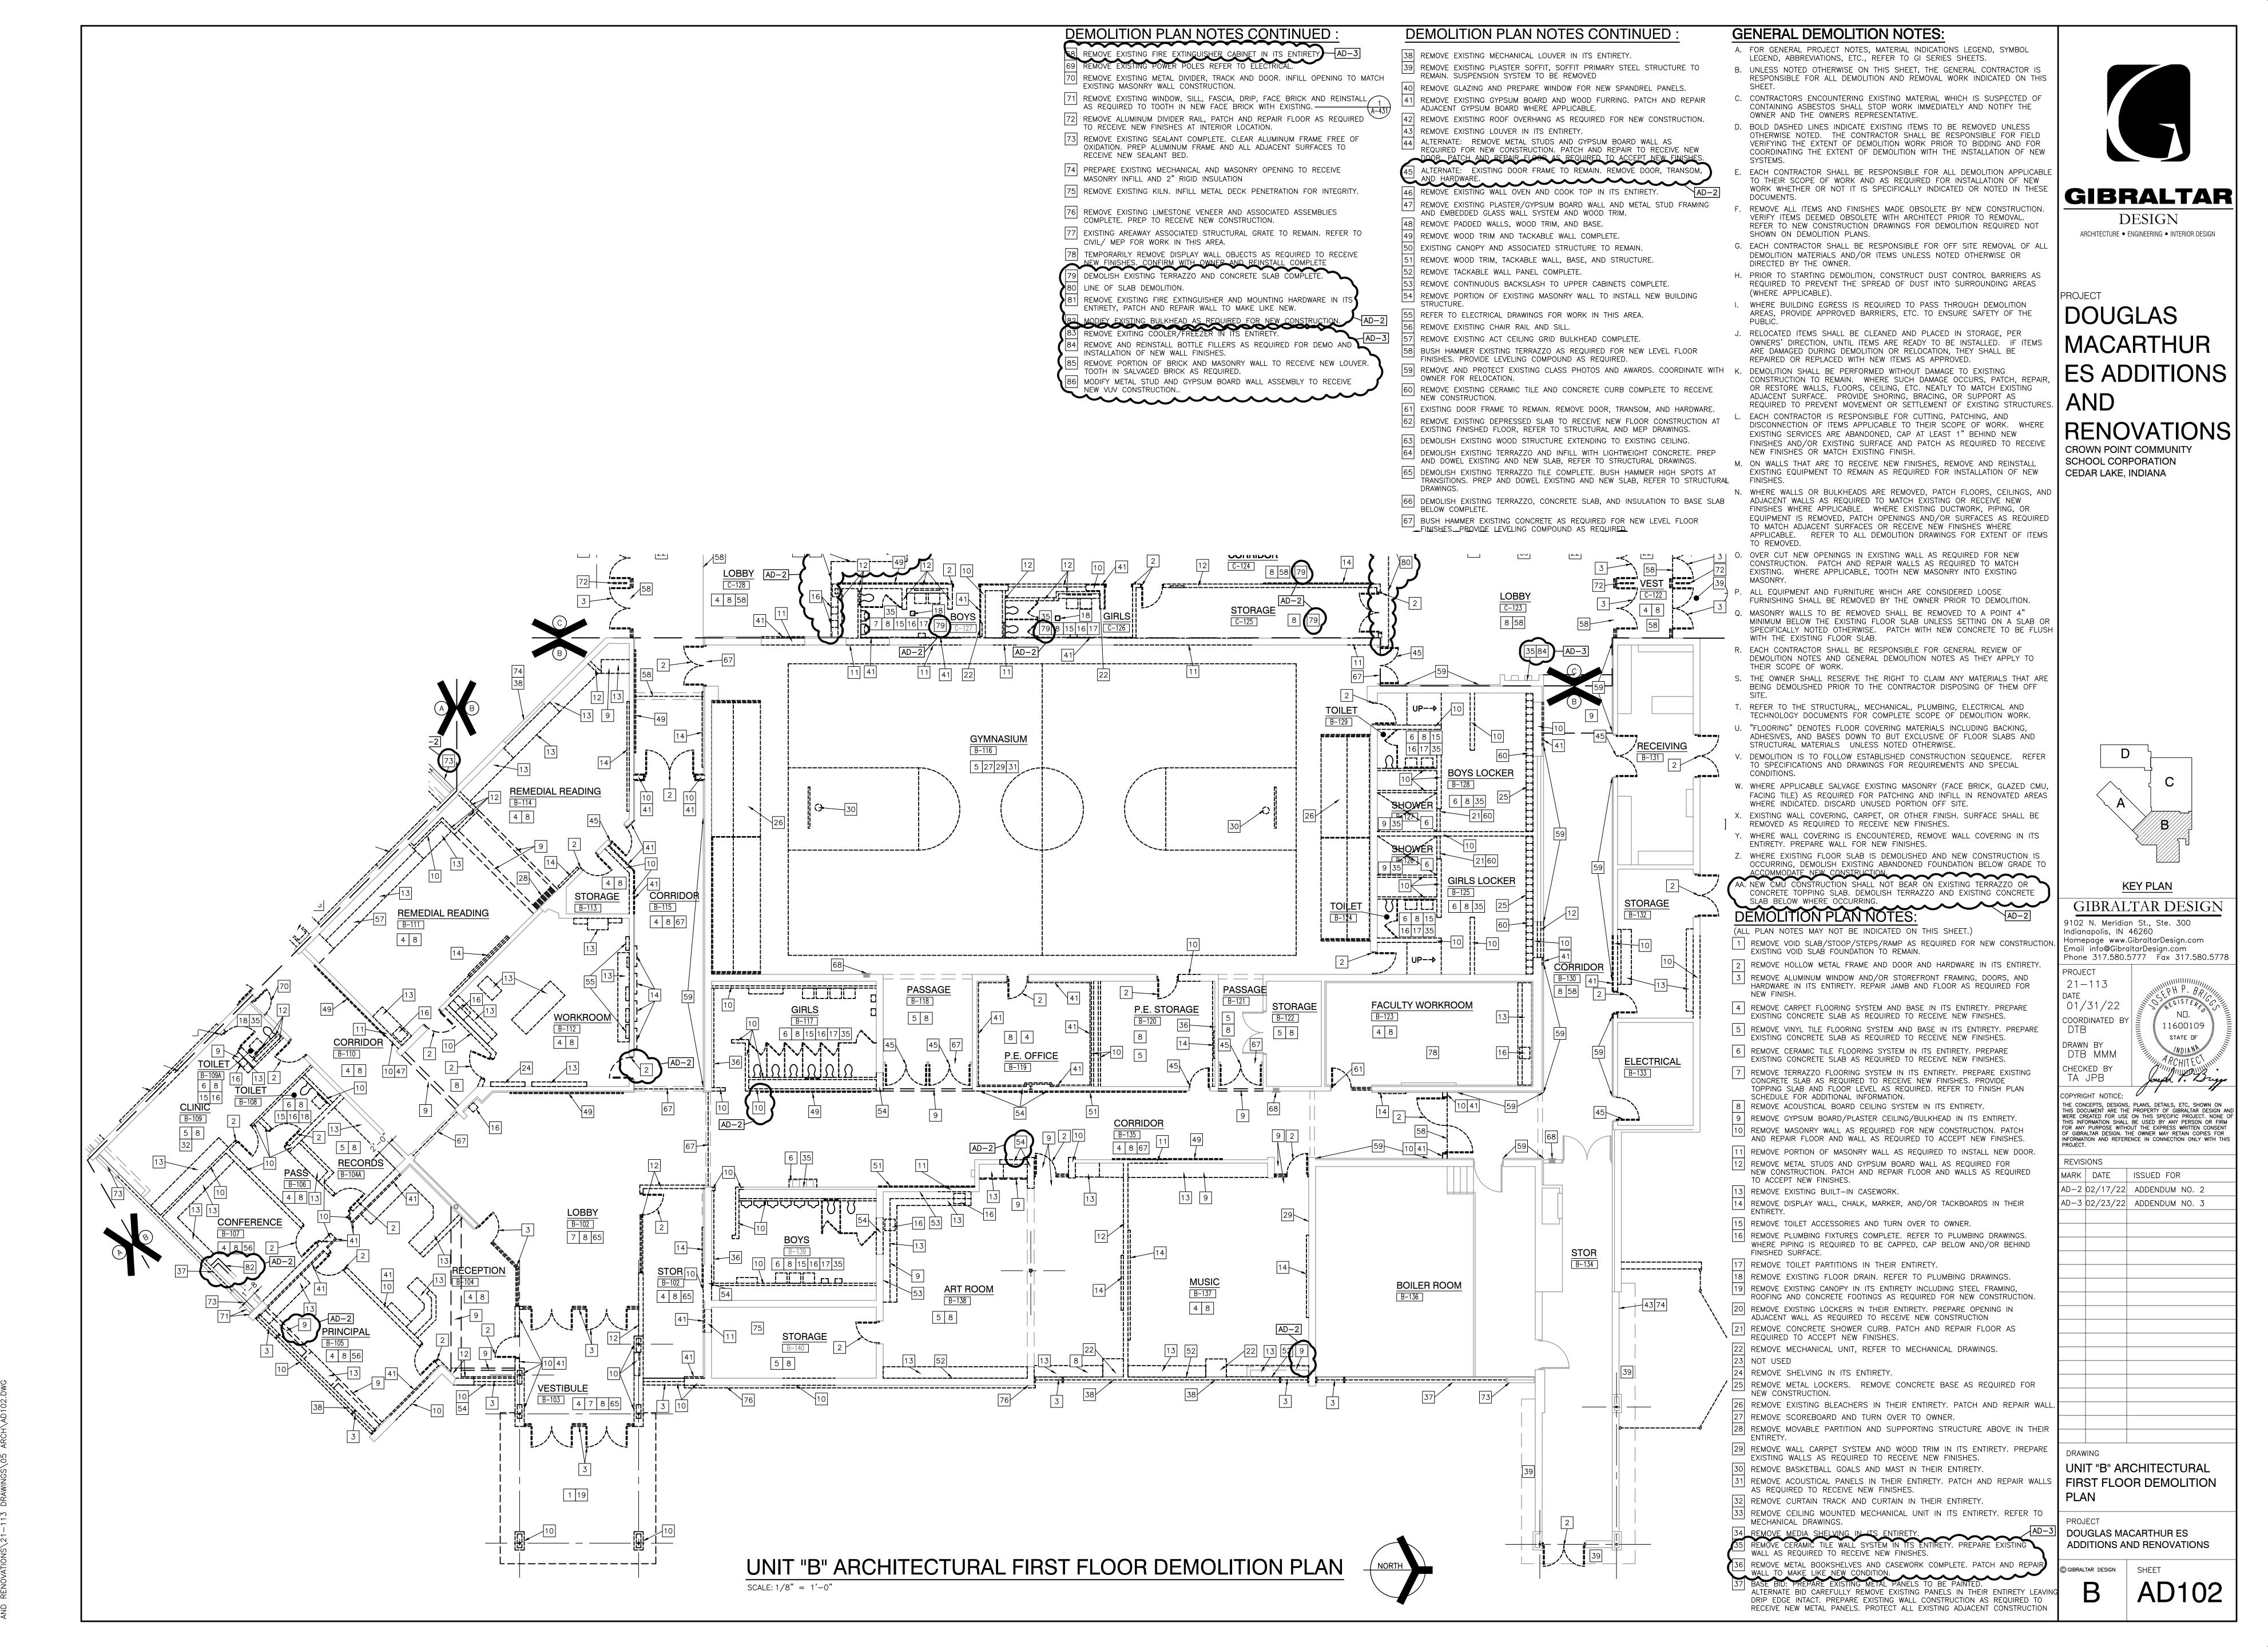

DEMOLITION PLAN NOTES CONTINUED:

- 38 REMOVE EXISTING MECHANICAL LOUVER IN ITS ENTIRETY.
 - 39 REMOVE EXISTING PLASTER SOFFIT, SOFFIT PRIMARY STEEL STRUCTURE TO REMAIN. SUSPENSION SYSTEM TO BE REMOVED
- 40 REMOVE GLAZING AND PREPARE WINDOW FOR NEW SPANDREL PANELS.
- 1 REMOVE EXISTING GYPSUM BOARD AND WOOD FURRING. PATCH AND REPAIR ADJACENT GYPSUM BOARD WHERE APPLICABLE.
- REMOVE EXISTING ROOF OVERHANG AS REQUIRED FOR NEW CONSTRUCTION.
- ALTERNATE: REMOVE METAL STUDS AND GYPSUM BOARD WALL AS REQUIRED FOR NEW CONSTRUCTION. PATCH AND REPAIR TO RECEIVE NEW DOOR PATCH AND REPAIR FLOOR AS REQUIRED TO ACCEPT NEW FINISHE
- AND HARDWARE. 47 REMOVE EXISTING PLASTER/GYPSUM BOARD WALL AND METAL STUD FRAMING
- WORK WHETHER OR NOT IT IS SPECIFICALLY INDICATED OR NOTED IN THES AND EMBEDDED GLASS WALL SYSTEM AND WOOD TRIM.
 - REMOVE ALL ITEMS AND FINISHES MADE OBSOLETE BY NEW CONSTRUCTION VERIFY ITEMS DEEMED OBSOLETE WITH ARCHITECT PRIOR TO REMOVAL. REFER TO NEW CONSTRUCTION DRAWINGS FOR DEMOLITION REQUIRED NOT

SHOWN ON DEMOLITION PLANS.

GENERAL DEMOLITION NOTES

OWNER AND THE OWNERS REPRESENTATIVE.

A. FOR GENERAL PROJECT NOTES, MATERIAL INDICATIONS LEGEND, SYMBOL

B. UNLESS NOTED OTHERWISE ON THIS SHEET, THE GENERAL CONTRACTOR IS

RESPONSIBLE FOR ALL DEMOLITION AND REMOVAL WORK INDICATED ON THIS

CONTRACTORS ENCOUNTERING EXISTING MATERIAL WHICH IS SUSPECTED OF

CONTAINING ASBESTOS SHALL STOP WORK IMMEDIATELY AND NOTIFY THE

OTHERWISE NOTED. THE CONTRACTOR SHALL BE RESPONSIBLE FOR FIELD

VERIFYING THE EXTENT OF DEMOLITION WORK PRIOR TO BIDDING AND FOR

COORDINATING THE EXTENT OF DEMOLITION WITH THE INSTALLATION OF NEW

TO THEIR SCOPE OF WORK AND AS REQUIRED FOR INSTALLATION OF NEW

. BOLD DASHED LINES INDICATE EXISTING ITEMS TO BE REMOVED UNLESS

LEGEND, ABBREVIATIONS, ETC., REFER TO GI SERIES SHEETS.

- G. EACH CONTRACTOR SHALL BE RESPONSIBLE FOR OFF SITE REMOVAL OF ALL DEMOLITION MATERIALS AND/OR ITEMS UNLESS NOTED OTHERWISE OR
- DIRECTED BY THE OWNER. H. PRIOR TO STARTING DEMOLITION, CONSTRUCT DUST CONTROL BARRIERS AS REQUIRED TO PREVENT THE SPREAD OF DUST INTO SURROUNDING AREAS
- (WHERE APPLICABLE) I. WHERE BUILDING EGRESS IS REQUIRED TO PASS THROUGH DEMOLITION
- AREAS, PROVIDE APPROVED BARRIERS, ETC. TO ENSURE SAFETY OF THE
- J. RELOCATED ITEMS SHALL BE CLEANED AND PLACED IN STORAGE, PER OWNERS' DIRECTION, UNTIL ITEMS ARE READY TO BE INSTALLED. IF ITEMS ARE DAMAGED DURING DEMOLITION OR RELOCATION, THEY SHALL BE REPAIRED OR REPLACED WITH NEW ITEMS AS APPROVED DEMOLITION SHALL BE PERFORMED WITHOUT DAMAGE TO EXISTING
- CONSTRUCTION TO REMAIN. WHERE SUCH DAMAGE OCCURS, PATCH, REPAIR OR RESTORE WALLS, FLOORS, CEILING, ETC. NEATLY TO MATCH EXISTING ADJACENT SURFACE. PROVIDE SHORING, BRACING, OR SUPPORT AS REQUIRED TO PREVENT MOVEMENT OR SETTLEMENT OF EXISTING STRUCTURES. EACH CONTRACTOR IS RESPONSIBLE FOR CUTTING, PATCHING, AND DISCONNECTION OF ITEMS APPLICABLE TO THEIR SCOPE OF WORK. WHERE EXISTING SERVICES ARE ABANDONED, CAP AT LEAST 1" BEHIND NEW FINISHES AND/OR EXISTING SURFACE AND PATCH AS REQUIRED TO RECEIVE NEW FINISHES OR MATCH EXISTING FINISH.
- M. ON WALLS THAT ARE TO RECEIVE NEW FINISHES, REMOVE AND REINSTALL EXISTING EQUIPMENT TO REMAIN AS REQUIRED FOR INSTALLATION OF NEW
- N. WHERE WALLS OR BULKHEADS ARE REMOVED, PATCH FLOORS, CEILINGS, AND ADJACENT WALLS AS REQUIRED TO MATCH EXISTING OR RECEIVE NEW FINISHES WHERE APPLICABLE. WHERE EXISTING DUCTWORK, PIPING, OR EQUIPMENT IS REMOVED, PATCH OPENINGS AND/OR SURFACES AS REQUIRED TO MATCH ADJACENT SURFACES OR RECEIVE NEW FINISHES WHERE APPLICABLE. REFER TO ALL DEMOLITION DRAWINGS FOR EXTENT OF ITEMS TO REMOVED.
- . OVER CUT NEW OPENINGS IN EXISTING WALL AS REQUIRED FOR NEW CONSTRUCTION. PATCH AND REPAIR WALLS AS REQUIRED TO MATCH EXISTING. WHERE APPLICABLE, TOOTH NEW MASONRY INTO EXISTING MASONRY.

ALL EQUIPMENT AND FURNITURE WHICH ARE CONSIDERED LOOSE

WITH THE EXISTING FLOOR SLAB.

- FURNISHING SHALL BE REMOVED BY THE OWNER PRIOR TO DEMOLITION. . MASONRY WALLS TO BE REMOVED SHALL BE REMOVED TO A POINT 4" MINIMUM BELOW THE EXISTING FLOOR SLAB UNLESS SETTING ON A SLAB OF SPECIFICALLY NOTED OTHERWISE. PATCH WITH NEW CONCRETE TO BE FLUSH
- R. EACH CONTRACTOR SHALL BE RESPONSIBLE FOR GENERAL REVIEW OF DEMOLITION NOTES AND GENERAL DEMOLITION NOTES AS THEY APPLY TO
- THEIR SCOPE OF WORK. S. THE OWNER SHALL RESERVE THE RIGHT TO CLAIM ANY MATERIALS THAT ARE BEING DEMOLISHED PRIOR TO THE CONTRACTOR DISPOSING OF THEM OF
- T. REFER TO THE STRUCTURAL, MECHANICAL, PLUMBING, ELECTRICAL AND TECHNOLOGY DOCUMENTS FOR COMPLETE SCOPE OF DEMOLITION WORK.
- J. "FLOORING" DENOTES FLOOR COVERING MATERIALS INCLUDING BACKING, ADHESIVES, AND BASES DOWN TO BUT EXCLUSIVE OF FLOOR SLABS AND
- STRUCTURAL MATERIALS UNLESS NOTED OTHERWISE V. DEMOLITION IS TO FOLLOW ESTABLISHED CONSTRUCTION SEQUENCE. REFER TO SPECIFICATIONS AND DRAWINGS FOR REQUIREMENTS AND SPECIAL
- W. WHERE APPLICABLE SALVAGE EXISTING MASONRY (FACE BRICK, GLAZED CMU, FACING TILE) AS REQUIRED FOR PATCHING AND INFILL IN RENOVATED AREAS WHERE INDICATED. DISCARD UNUSED PORTION OFF SITE. EXISTING WALL COVERING, CARPET, OR OTHER FINISH. SURFACE SHALL BE
- REMOVED AS REQUIRED TO RECEIVE NEW FINISHES. WHERE WALL COVERING IS ENCOUNTERED, REMOVE WALL COVERING IN ITS ENTIRETY. PREPARE WALL FOR NEW FINISHES.
- WHERE EXISTING FLOOR SLAB IS DEMOLISHED AND NEW CONSTRUCTION IS OCCURRING, DEMOLISH EXISTING ABANDONED FOUNDATION BELOW GRADE TO ACCOMMODATE NEW CONSTRUCTION.

CONCRETE TOPPING SLAB. DEMOLISH TERRAZZO AND EXISTING CONCRETE SLAB BELOW WHERE OCCURRING.

- (ALL PLAN NOTES MAY NOT BE INDICATED ON THIS SHEET.)
- REMOVE VOID SLAB/STOOP/STEPS/RAMP AS REQUIRED FOR NEW CONSTRUCTION. ' EXISTING VOID SLAB FOUNDATION TO REMAIN.
- \mid $_{2}\mid$ REMOVE HOLLOW METAL FRAME AND DOOR AND HARDWARE IN ITS ENTIRETY 3 REMOVE ALUMINUM WINDOW AND/OR STOREFRONT FRAMING, DOORS, AND HARDWARE IN ITS ENTIRETY. REPAIR JAMB AND FLOOR AS REQUIRED FOR
- NEW FINISH. 4 REMOVE CARPET FLOORING SYSTEM AND BASE IN ITS ENTIRETY. PREPARE EXISTING CONCRETE SLAB AS REQUIRED TO RECEIVE NEW FINISHES.
- 5 REMOVE VINYL TILE FLOORING SYSTEM AND BASE IN ITS ENTIRETY. PREPARE
- EXISTING CONCRETE SLAB AS REQUIRED TO RECEIVE NEW FINISHES. 6 REMOVE CERAMIC TILE FLOORING SYSTEM IN ITS ENTIRETY. PREPARE
- EXISTING CONCRETE SLAB AS REQUIRED TO RECEIVE NEW FINISHES. REMOVE TERRAZZO FLOORING SYSTEM IN ITS ENTIRETY. PREPARE EXISTING
- CONCRETE SLAB AS REQUIRED TO RECEIVE NEW FINISHES. PROVIDE TOPPING SLAB AND FLOOR LEVEL AS REQUIRED. REFER TO FINISH PLAN SCHEDULE FOR ADDITIONAL INFORMATION.
- 8 REMOVE ACOUSTICAL BOARD CEILING SYSTEM IN ITS ENTIRETY. 9 | REMOVE GYPSUM BOARD/PLASTER CEILING/BULKHEAD IN ITS ENTIRETY REMOVE MASONRY WALL AS REQUIRED FOR NEW CONSTRUCTION. PATCH
- AND REPAIR FLOOR AND WALL AS REQUIRED TO ACCEPT NEW FINISHES. 11 REMOVE PORTION OF MASONRY WALL AS REQUIRED TO INSTALL NEW DOOR. 12 REMOVE METAL STUDS AND GYPSUM BOARD WALL AS REQUIRED FOR
- NEW CONSTRUCTION. PATCH AND REPAIR FLOOR AND WALLS AS REQUIRED TO ACCEPT NEW FINISHES. 13 REMOVE EXISTING BUILT-IN CASEWORK.
- 14 REMOVE DISPLAY WALL, CHALK, MARKER, AND/OR TACKBOARDS IN THEIR 15 REMOVE TOILET ACCESSORIES AND TURN OVER TO OWNER.
- 16 REMOVE PLUMBING FIXTURES COMPLETE. REFER TO PLUMBING DRAWINGS. WHERE PIPING IS REQUIRED TO BE CAPPED, CAP BELOW AND/OR BEHIND FINISHED SURFACE.
- 17 REMOVE TOILET PARTITIONS IN THEIR ENTIRETY. 18 REMOVE EXISTING FLOOR DRAIN. REFER TO PLUMBING DRAWINGS. 19 REMOVE EXISTING CANOPY IN ITS ENTIRETY INCLUDING STEEL FRAMING,
- ROOFING AND CONCRETE FOOTINGS AS REQUIRED FOR NEW CONSTRUCTION. 20 REMOVE EXISTING LOCKERS IN THEIR ENTIRETY. PREPARE OPENING IN ADJACENT WALL AS REQUIRED TO RECEIVE NEW CONSTRUCTION
- 21 REMOVE CONCRETE SHOWER CURB. PATCH AND REPAIR FLOOR AS REQUIRED TO ACCEPT NEW FINISHES. 22 REMOVE MECHANICAL UNIT, REFER TO MECHANICAL DRAWINGS.
- 3 NOT USED
- 24 REMOVE SHELVING IN ITS ENTIRETY.

NORTH

- 25 REMOVE METAL LOCKERS. REMOVE CONCRETE BASE AS REQUIRED FOR NEW CONSTRUCTION. 26 REMOVE EXISTING BLEACHERS IN THEIR ENTIRETY. PATCH AND REPAIR WALL
- REMOVE SCOREBOARD AND TURN OVER TO OWNER. 28 REMOVE MOVABLE PARTITION AND SUPPORTING STRUCTURE ABOVE IN THEIR ENTIRETY.
- 29 REMOVE WALL CARPET SYSTEM AND WOOD TRIM IN ITS ENTIRETY. PREPARE EXISTING WALLS AS REQUIRED TO RECEIVE NEW FINISHES. 30 REMOVE BASKETBALL GOALS AND MAST IN THEIR ENTIRETY.
- 31 REMOVE ACOUSTICAL PANELS IN THEIR ENTIRETY. PATCH AND REPAIR WALLS AS REQUIRED TO RECEIVE NEW FINISHES. REMOVE CURTAIN TRACK AND CURTAIN IN THEIR ENTIRETY.
- REMOVE CEILING MOUNTED MECHANICAL UNIT IN ITS ENTIRETY. REFER TO MECHANICAL DRAWINGS. REMOVE MEDIA SHELVING IN ITS ENTIRETY.
 REMOVE CERAMIC TILE WALL SYSTEM IN ITS ENTIRETY. PREPARE EXISTING

ALTERNATE BID CAREFULLY REMOVE EXISTING PANELS IN THEIR ENTIRETY LEAVIN DRIP EDGE INTACT. PREPARE EXISTING WALL CONSTRUCTION AS REQUIRED TO RECEIVE NEW METAL PANELS. PROTECT ALL EXISTING ADJACENT CONSTRUCTION

WALL AS REQUIRED TO RECEIVE NEW FINISHES. REMOVE METAL BOOKSHELVES AND CASEWORK COMPLETE. PATCH AND REPA

EACH CONTRACTOR SHALL BE RESPONSIBLE FOR ALL DEMOLITION APPLICABLE **GIBRALTAR** DESIGN ARCHITECTURE • ENGINEERING • INTERIOR DESIGN

> DOUGLAS MACARTHUR **ES ADDITIONS**

RENOVATIONS CROWN POINT COMMUNIT

SCHOOL CORPORATION

CEDAR LAKE, INDIANA

KEY PLAN GIBRALTAR DESIGN

102 N. Meridian St., Ste. 300 idianapolis, IN 46260 lomepage www.GibraltarDesign.com Imail info@GibraltarDesign.com Phone 317.580.5777 Fax 317.580.577;

COORDINATED E 1600109

DRAWN BY DTB MMM CHECKED BY

THE CONCEPTS, DESIGNS, PLANS, DETAILS, ETC, SHOWN ON THIS DOCUMENT ARE THE PROPERTY OF GIBRALTAR DESIGN AND FOR ANY PURPOSE WITHOUT THE EXPRESS WRITTEN CONSEN OF GIBRALTAR DESIGN. THE OWNER MAY RETAIN COPIES FOR NFORMATION AND REFERENCE IN CONNECTION ONLY WITH THI

REVISIONS

MARK	DATE	ISSUED FOR
AD-2	02/17/22	ADDENDUM NO. 2
AD-3	02/23/22	ADDENDUM NO. 3


UNIT "C" ARCHITECTURAL FIRST FLOOR DEMOLITION PLAN

DOUGLAS MACARTHUR ES ADDITIONS AND RENOVATIONS


GIBRALTAR DESIGN SHEET

AD103


FIRST FLOOR DEMOLITION PLAN

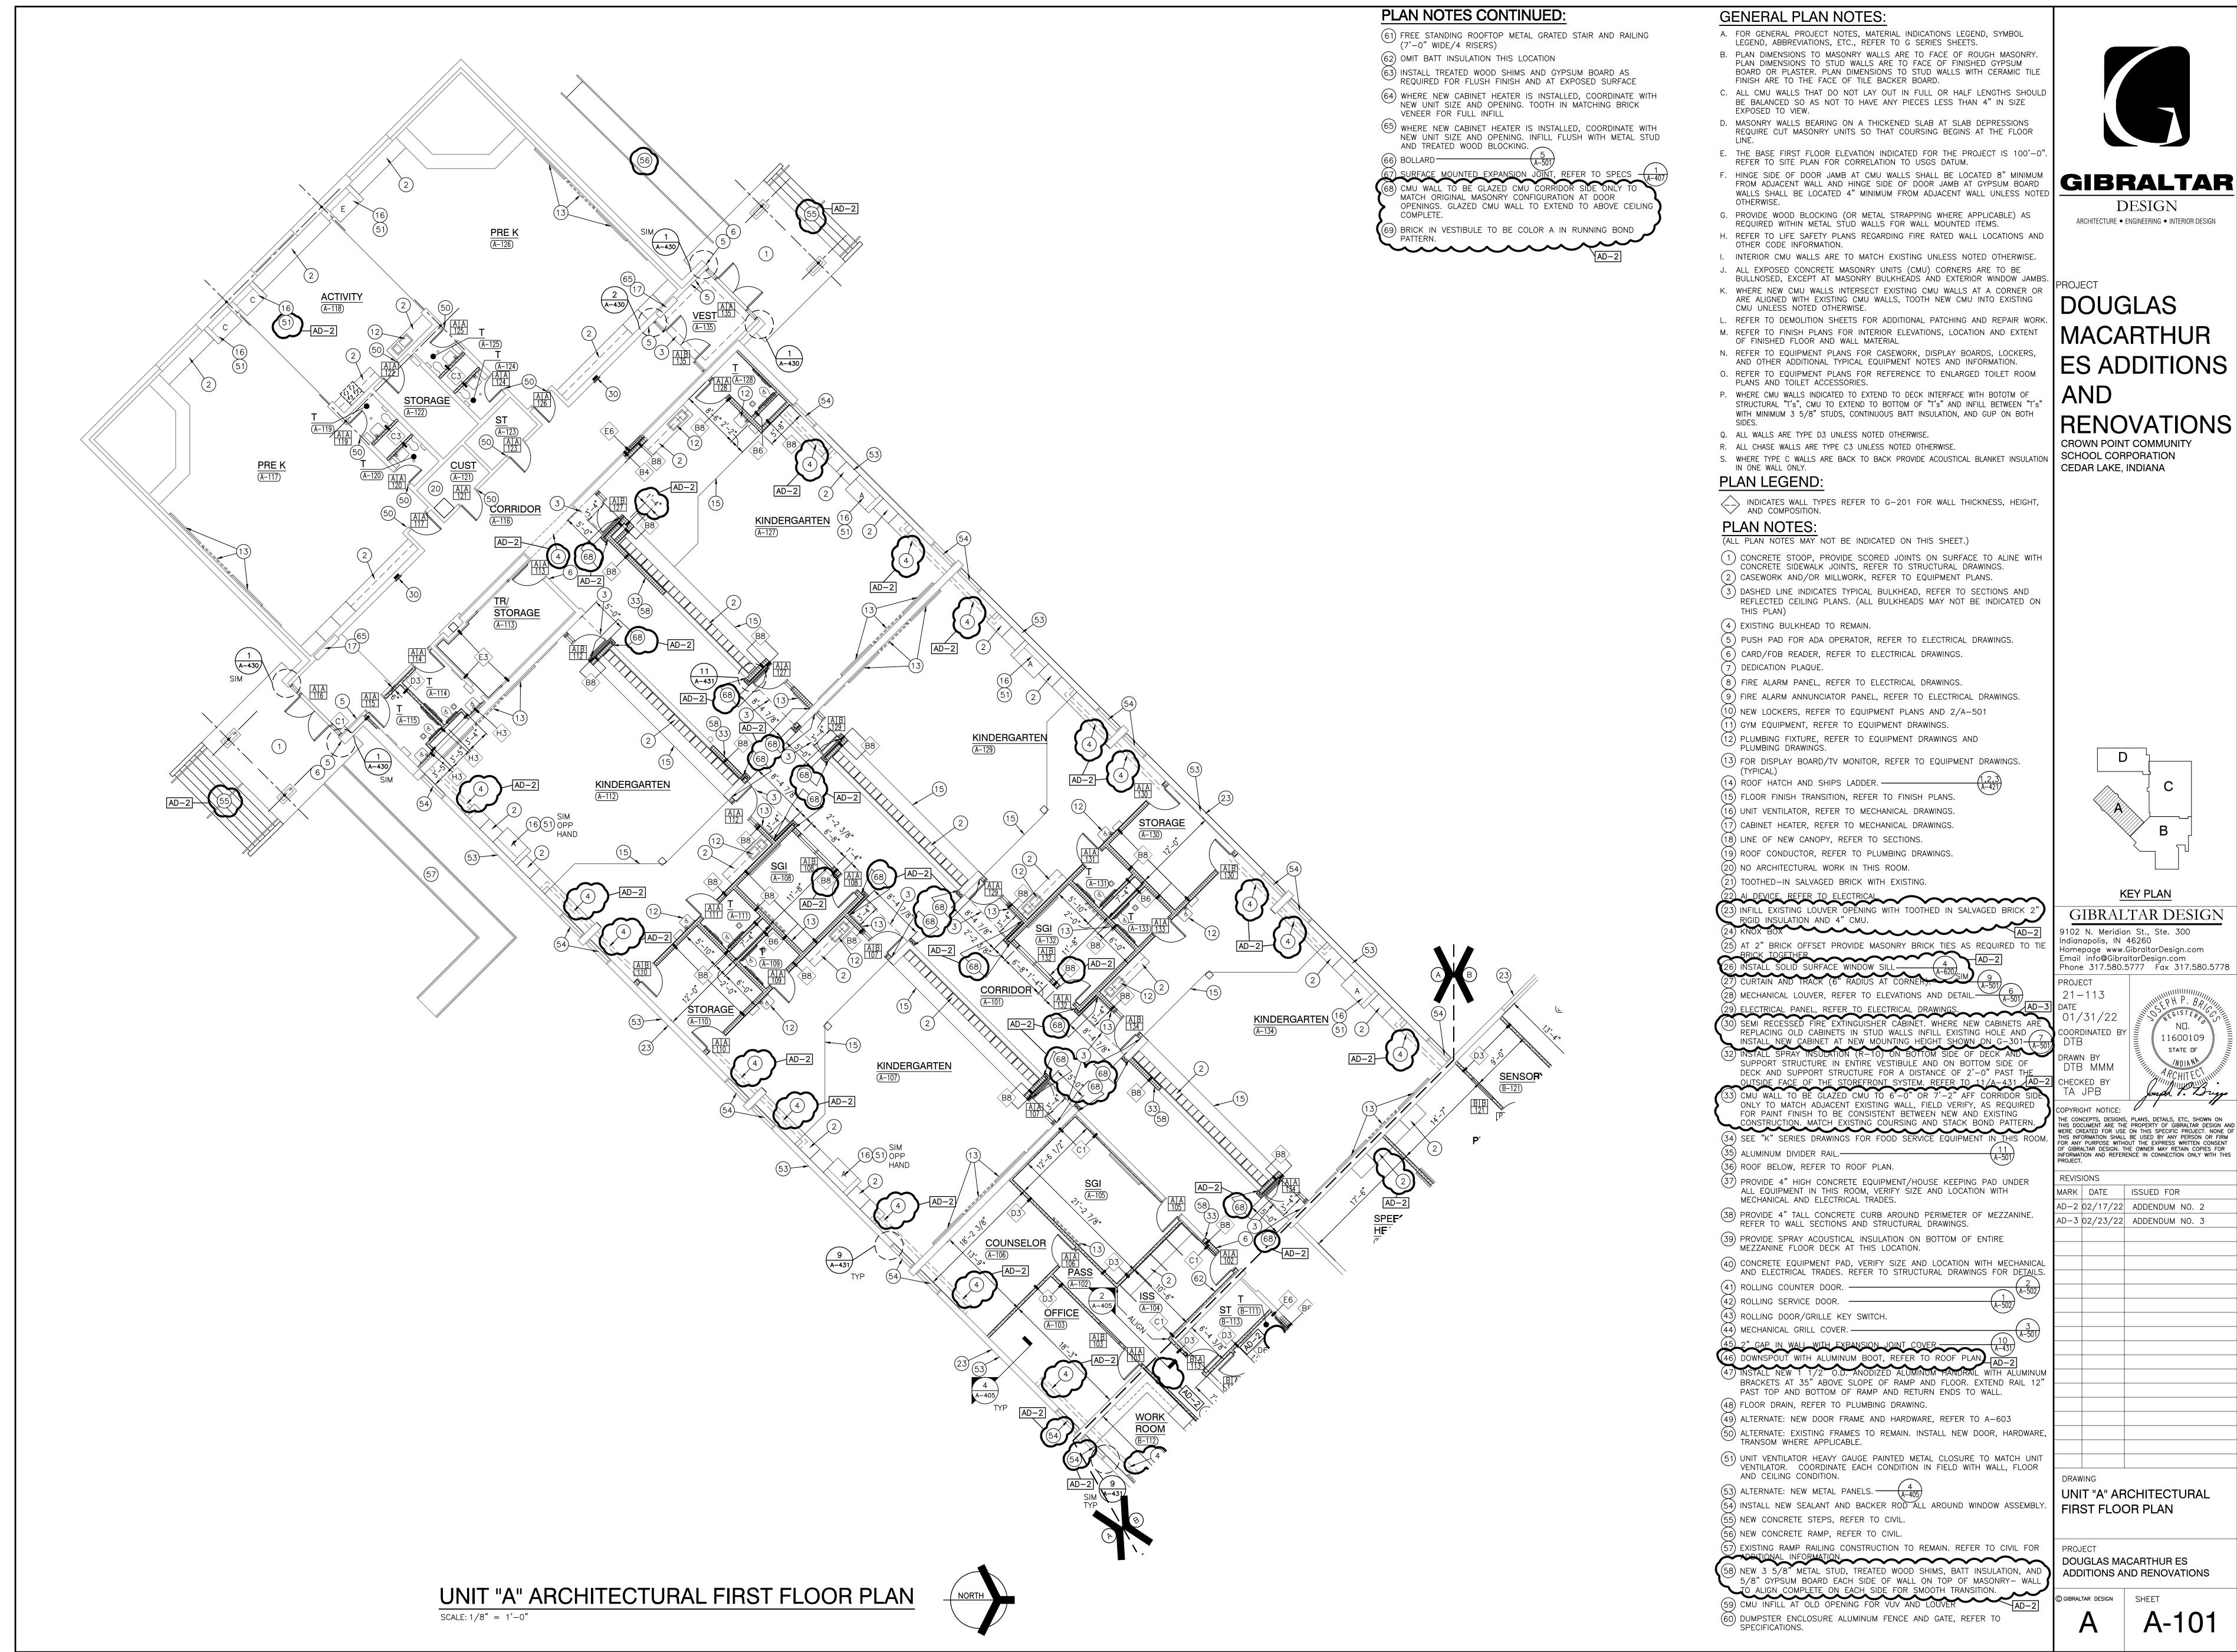

A-101

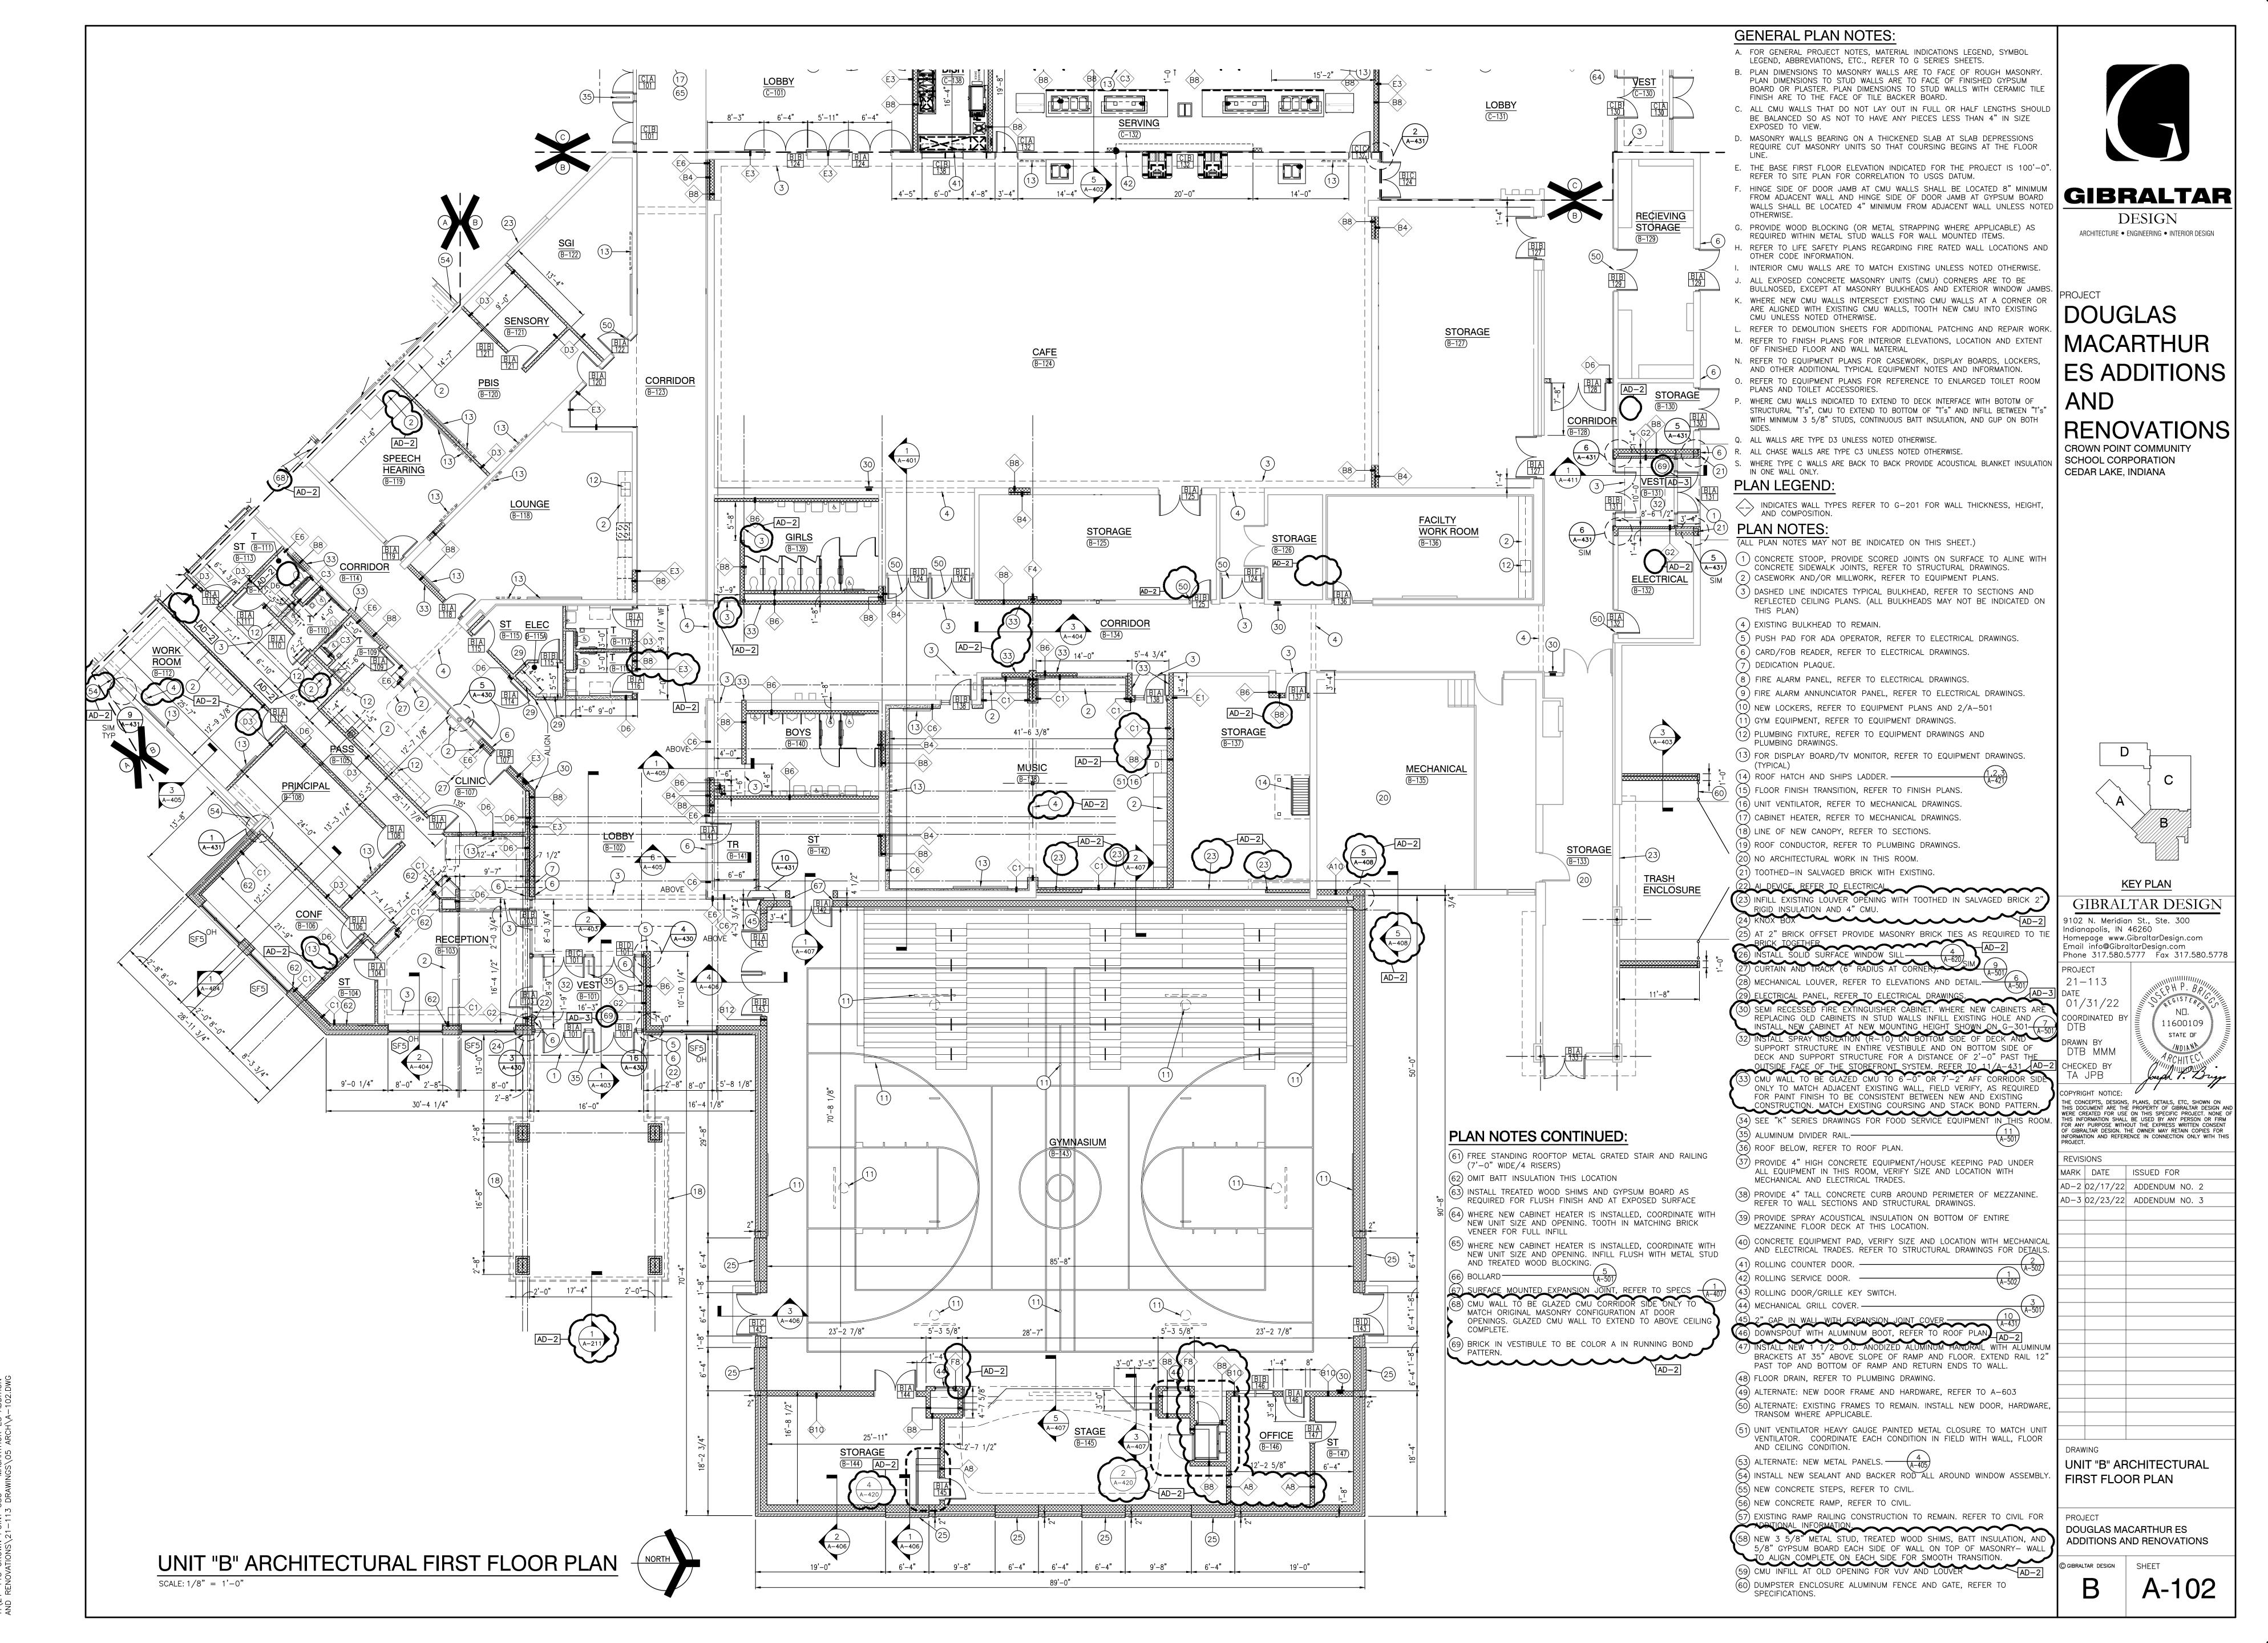


Wednesday, 2/23/2022 - 1:59 PM - LAST SAVED

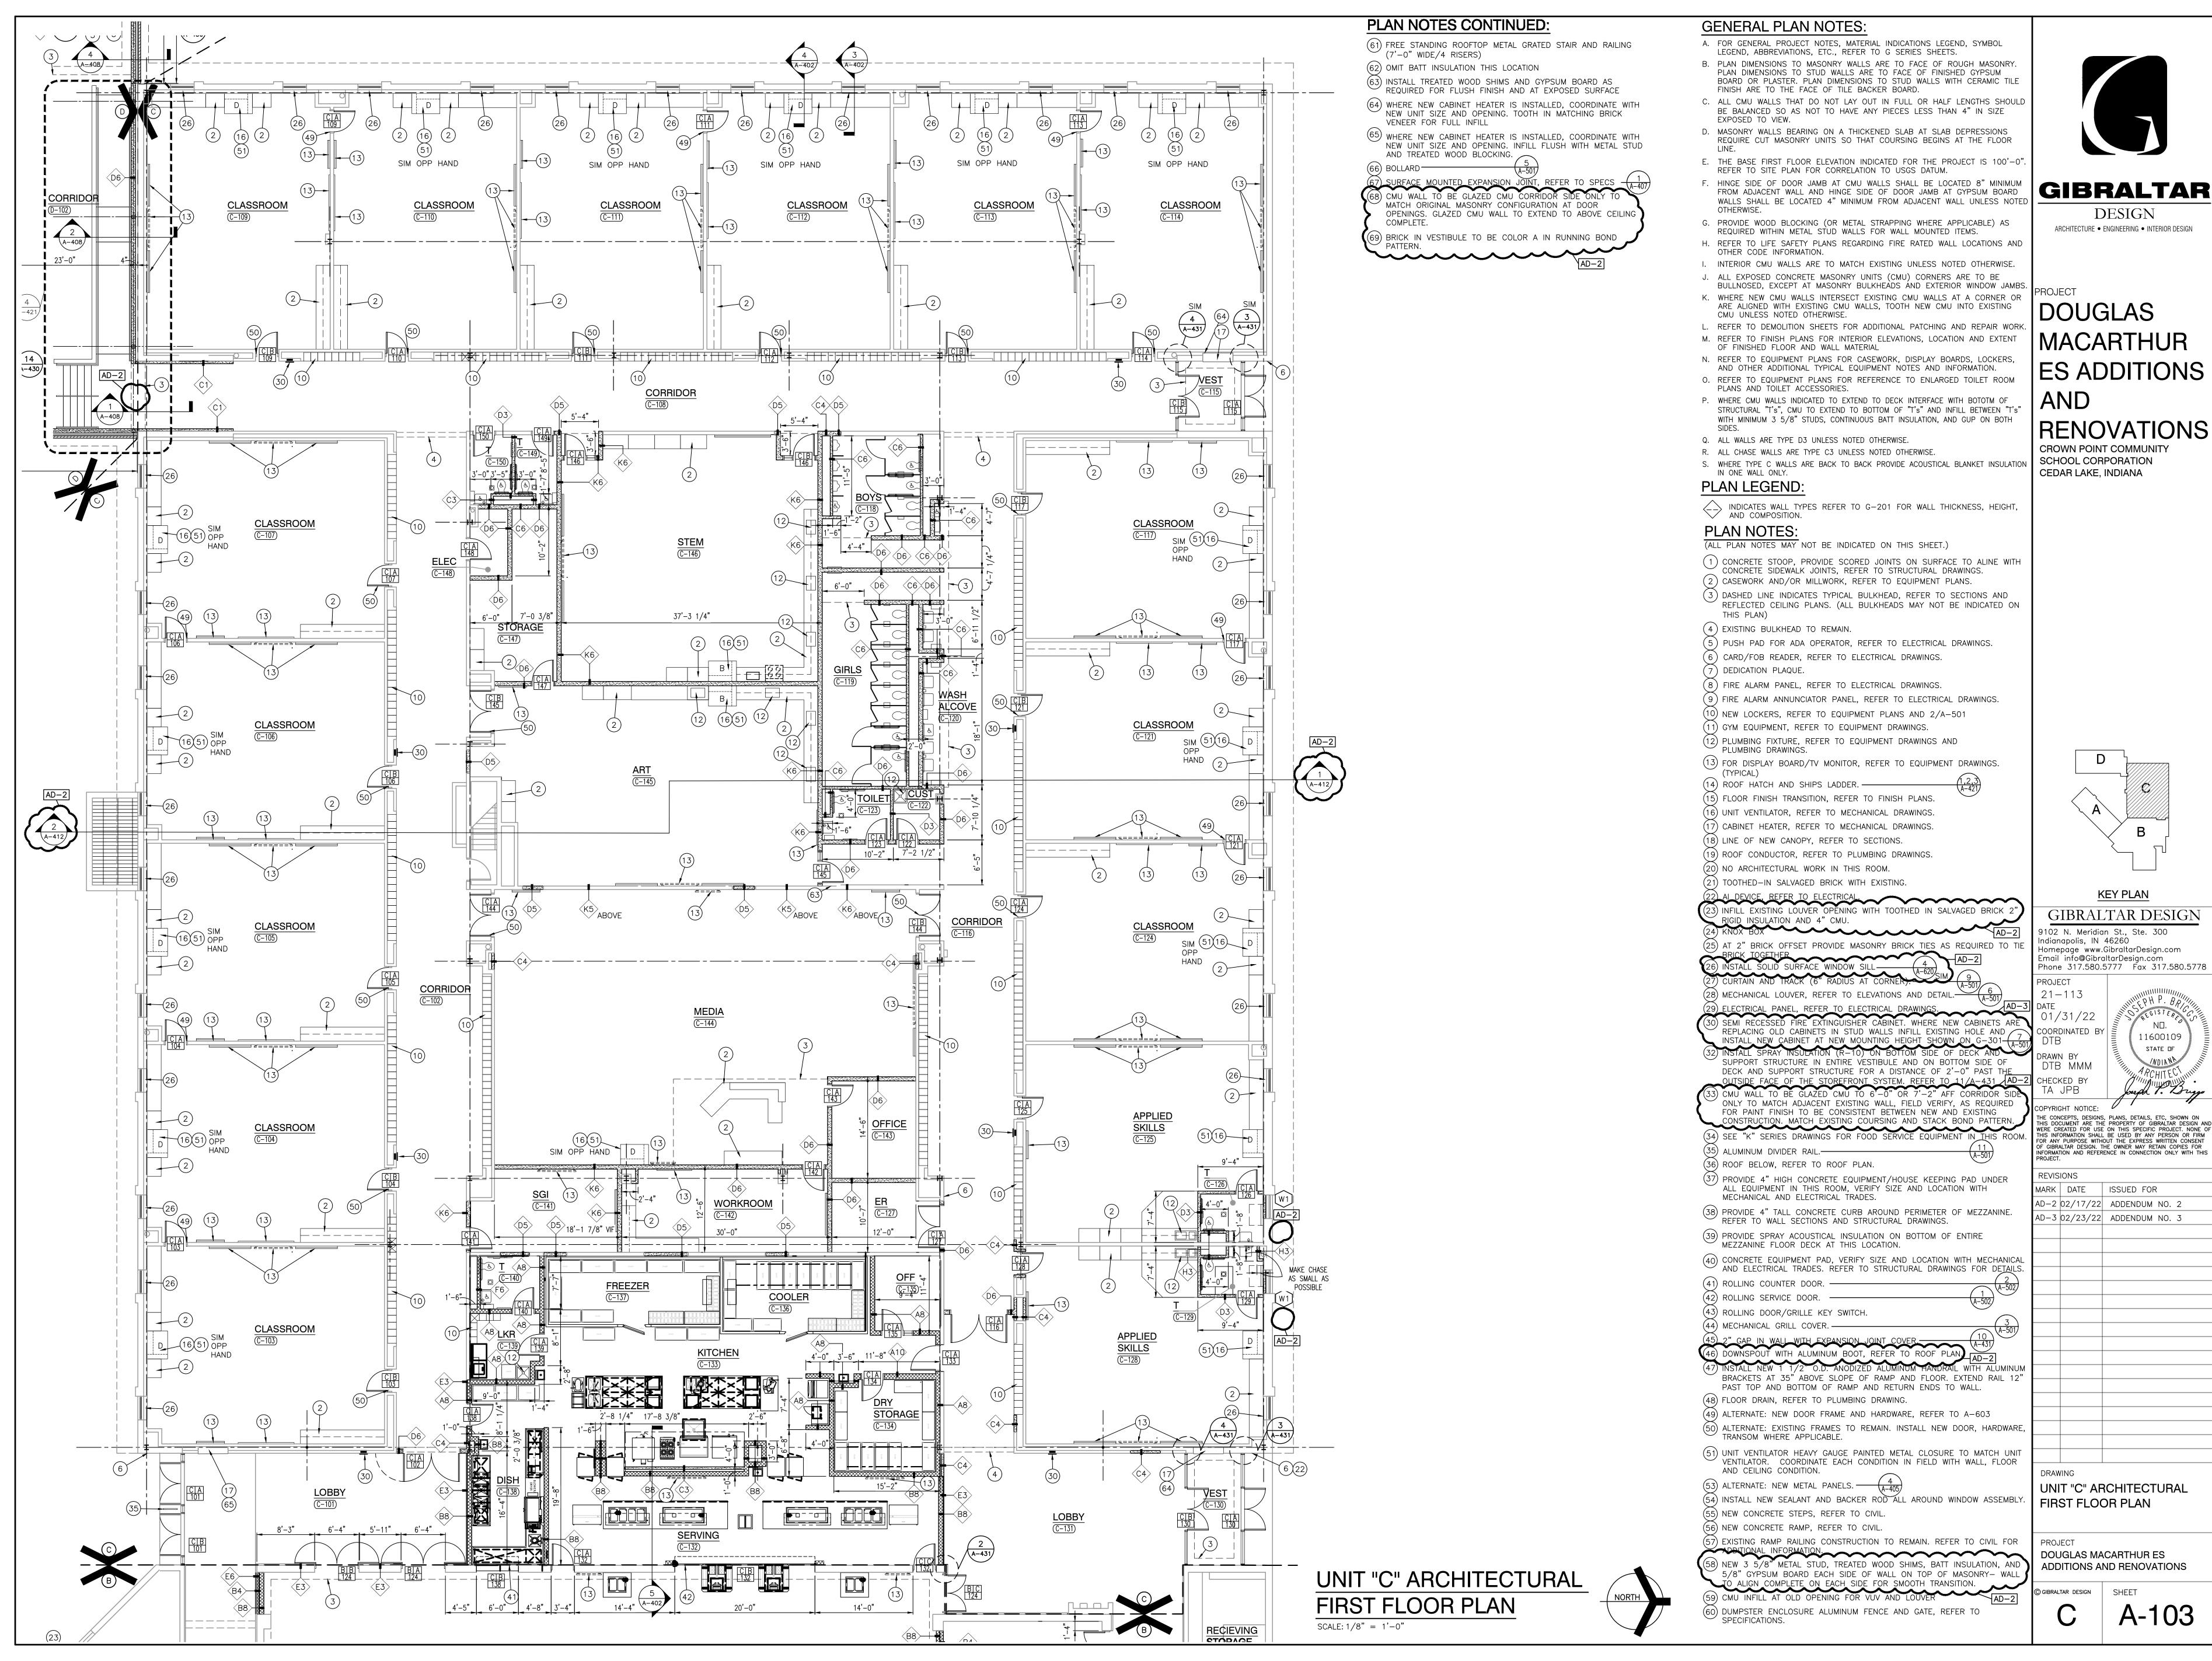

A-103

11600109

STATE OF

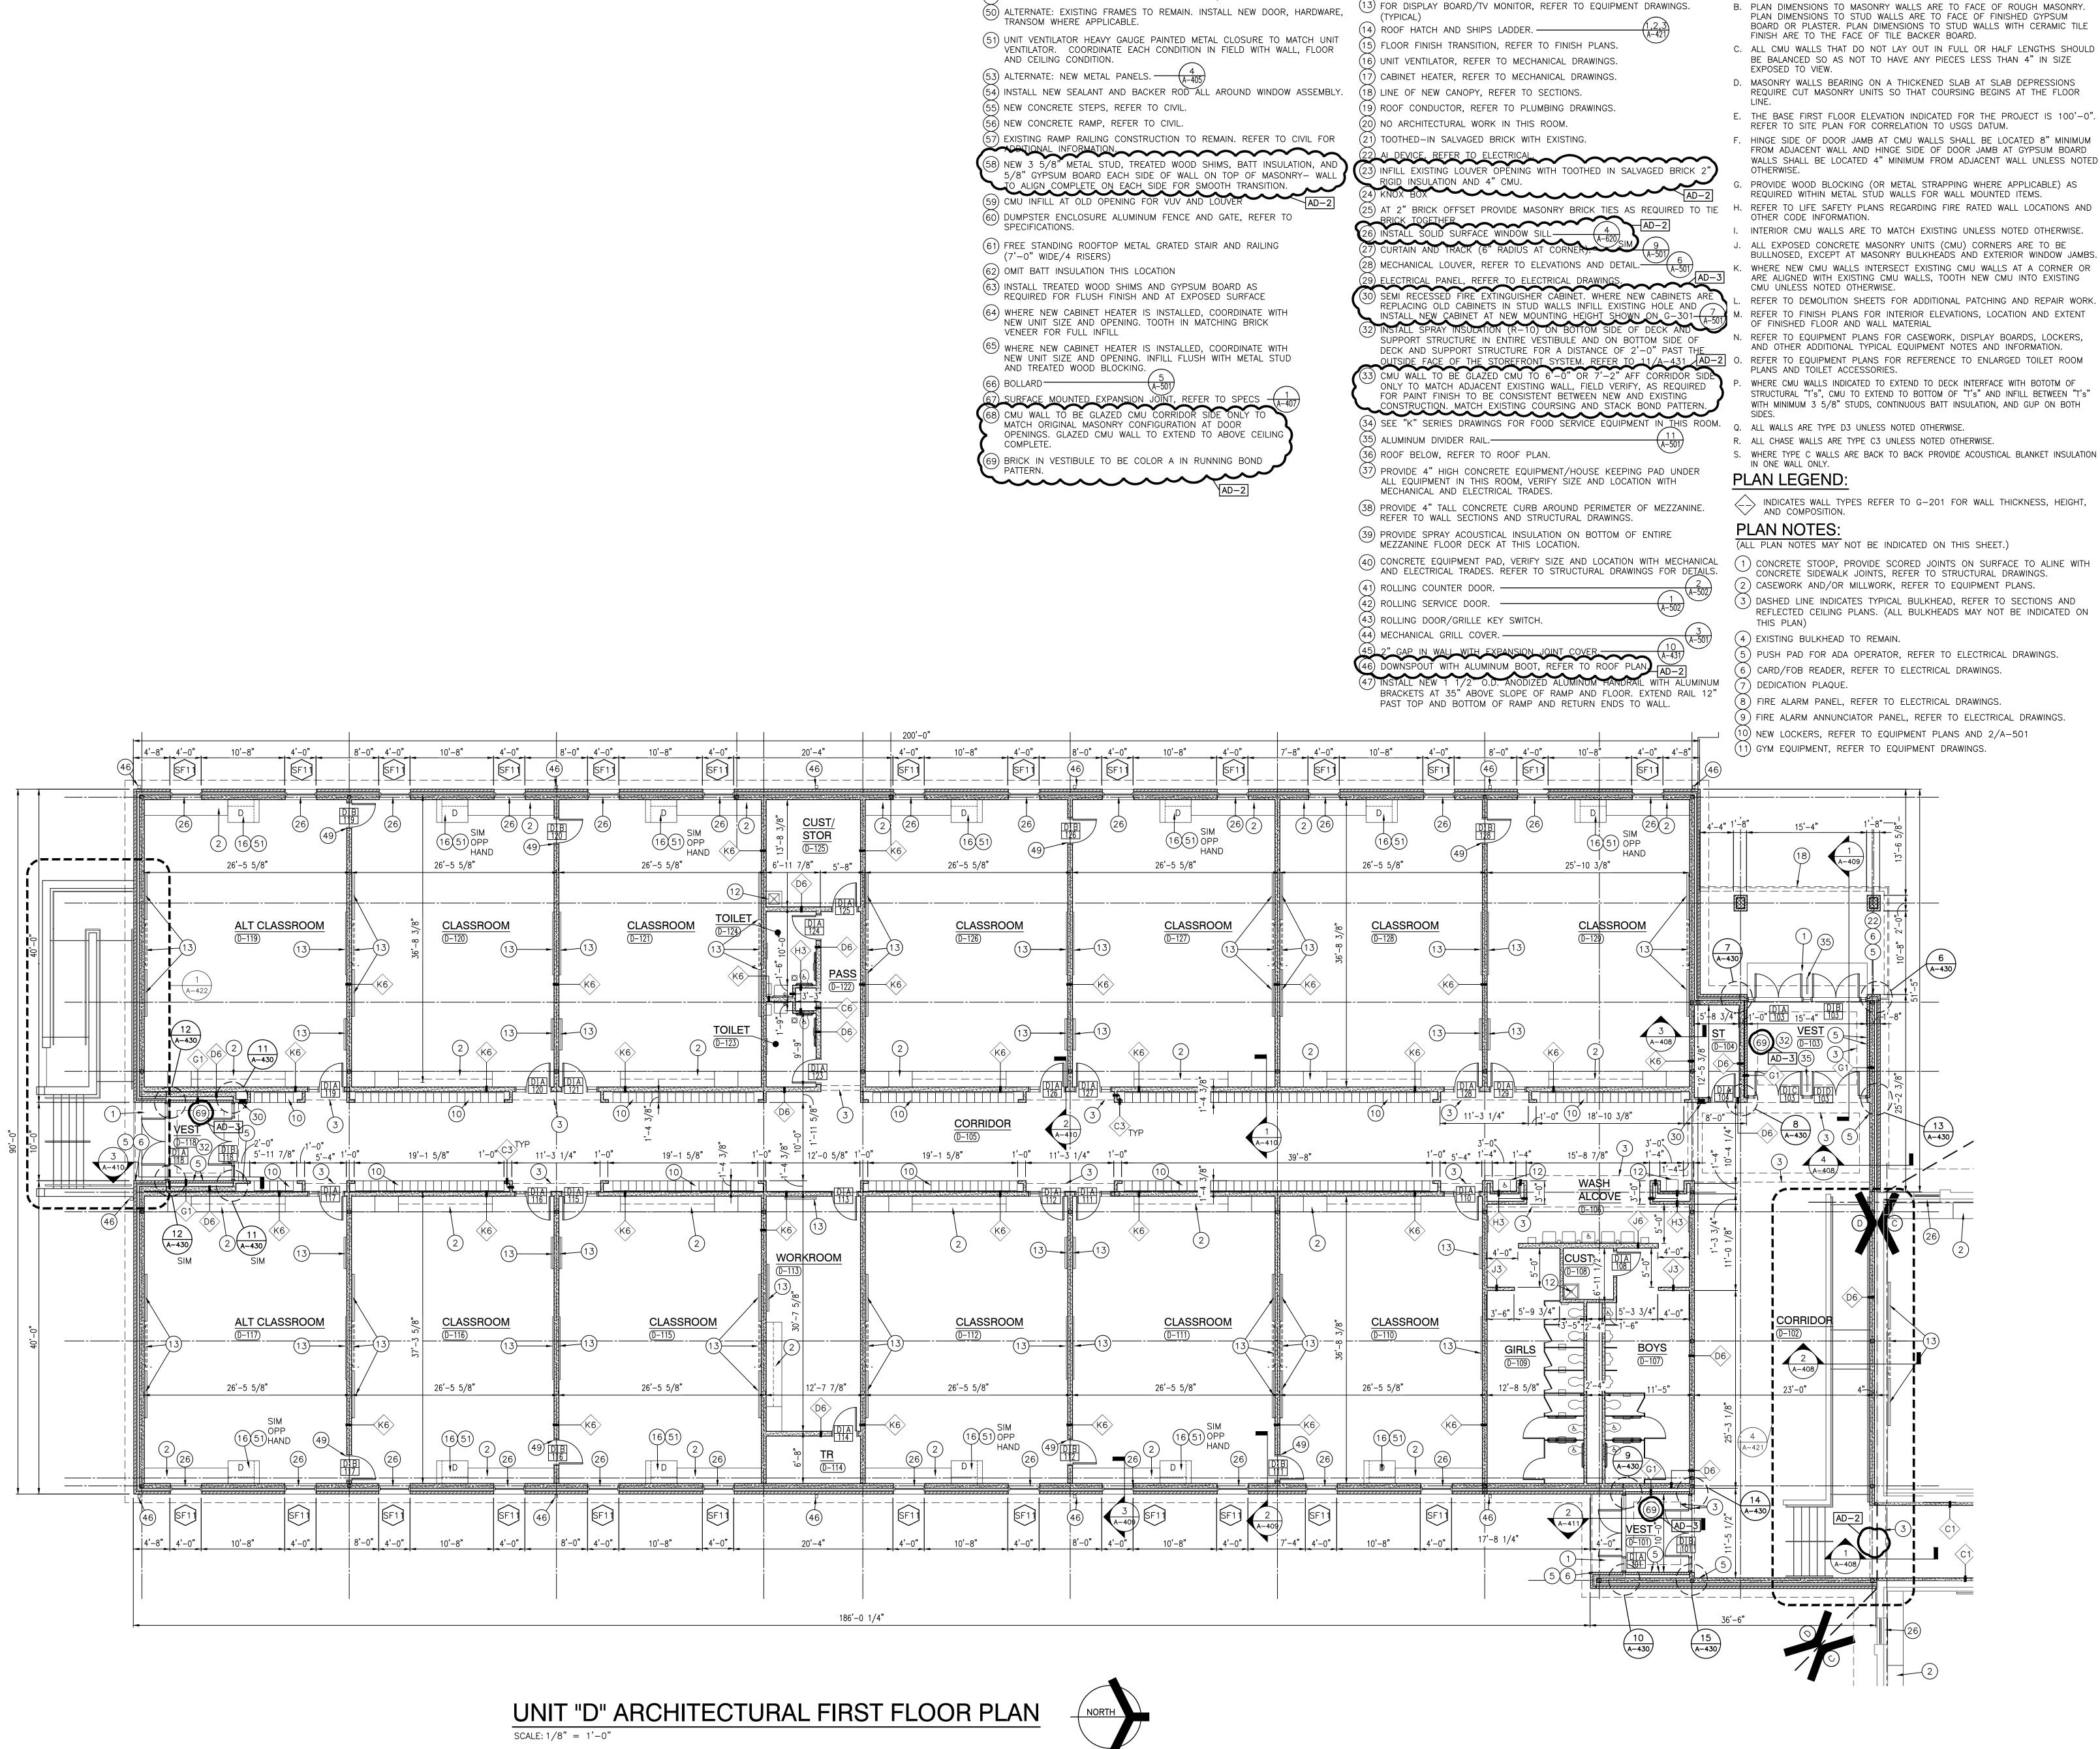

(48) FLOOR DRAIN, REFER TO PLUMBING DRAWING.

(49) ALTERNATE: NEW DOOR FRAME AND HARDWARE, REFER TO A-603

GENERAL PLAN NOTES:

(12) PLUMBING FIXTURE, REFER TO EQUIPMENT DRAWINGS AND

PLUMBING DRAWINGS.

A. FOR GENERAL PROJECT NOTES, MATERIAL INDICATIONS LEGEND, SYMBOL LEGEND, ABBREVIATIONS, ETC., REFER TO G SERIES SHEETS. B. PLAN DIMENSIONS TO MASONRY WALLS ARE TO FACE OF ROUGH MASONRY.

C. ALL CMU WALLS THAT DO NOT LAY OUT IN FULL OR HALF LENGTHS SHOULD BE BALANCED SO AS NOT TO HAVE ANY PIECES LESS THAN 4" IN SIZE

D. MASONRY WALLS BEARING ON A THICKENED SLAB AT SLAB DEPRESSIONS

E. THE BASE FIRST FLOOR ELEVATION INDICATED FOR THE PROJECT IS 100'-0". F. HINGE SIDE OF DOOR JAMB AT CMU WALLS SHALL BE LOCATED 8" MINIMUM FROM ADJACENT WALL AND HINGE SIDE OF DOOR JAMB AT GYPSUM BOARD

PROVIDE WOOD BLOCKING (OR METAL STRAPPING WHERE APPLICABLE) AS H. REFER TO LIFE SAFETY PLANS REGARDING FIRE RATED WALL LOCATIONS AND

I. INTERIOR CMU WALLS ARE TO MATCH EXISTING UNLESS NOTED OTHERWISE. BULLNOSED, EXCEPT AT MASONRY BULKHEADS AND EXTERIOR WINDOW JAMBS. . WHERE NEW CMU WALLS INTERSECT EXISTING CMU WALLS AT A CORNER OR ARE ALIGNED WITH EXISTING CMU WALLS, TOOTH NEW CMU INTO EXISTING

REFER TO DEMOLITION SHEETS FOR ADDITIONAL PATCHING AND REPAIR WORK. M. REFER TO FINISH PLANS FOR INTERIOR ELEVATIONS, LOCATION AND EXTENT REFER TO EQUIPMENT PLANS FOR CASEWORK, DISPLAY BOARDS, LOCKERS,

STRUCTURAL "T's", CMU TO EXTEND TO BOTTOM OF "T's" AND INFILL BETWEEN "T's" WITH MINIMUM 3 5/8" STUDS, CONTINUOUS BATT INSULATION, AND GUP ON BOTH

3) DASHED LINE INDICATES TYPICAL BULKHEAD, REFER TO SECTIONS AND REFLECTED CEILING PLANS. (ALL BULKHEADS MAY NOT BE INDICATED ON

GIBRALTAR

DESIGN

ARCHITECTURE • ENGINEERING • INTERIOR DESIGN

MACARTHUR

RENOVATIONS

CROWN POINT COMMUNITY

SCHOOL CORPORATION

CEDAR LAKE, INDIANA

KEY PLAN GIBRALTAR DESIGN

9102 N. Meridian St., Ste. 300 ndianapolis, IN 46260 Homepage www.GibraltarDesign.com Email info@GibraltarDesign.com Phone 317.580.5777 Fax 317.580.577

11600109

21-113 01/31/22 COORDINATED E DRAWN BY

STATE OF DTB MMM CHECKED BY


OPYRIGHT NOTICE: THE CONCEPTS, DESIGNS, PLANS, DETAILS, ETC, SHOWN ON THIS DOCUMENT ARE THE PROPERTY OF GIBRALTAR DESIGN AND WERE CREATED FOR USE ON THIS SPECIFIC PROJECT. NONE OF THIS INFORMATION SHALL BE USED BY ANY PERSON OR FIRM FOR ANY PURPOSE WITHOUT THE EXPRESS WRITTEN CONSENT OF GIBRALTAR DESIGN. THE OWNER MAY RETAIN COPIES FOR INFORMATION AND REFERENCE IN CONNECTION ONLY WITH THIS PROJECT.

MARK DATE ISSUED FOR AD-2 |02/17/22| ADDENDUM NO. 2 AD-3 | 02/23/22 | ADDENDUM NO. 3


UNIT "D" ARCHITECTURAL FIRST FLOOR PLAN

DOUGLAS MACARTHUR ES ADDITIONS AND RENOVATIONS

A-104

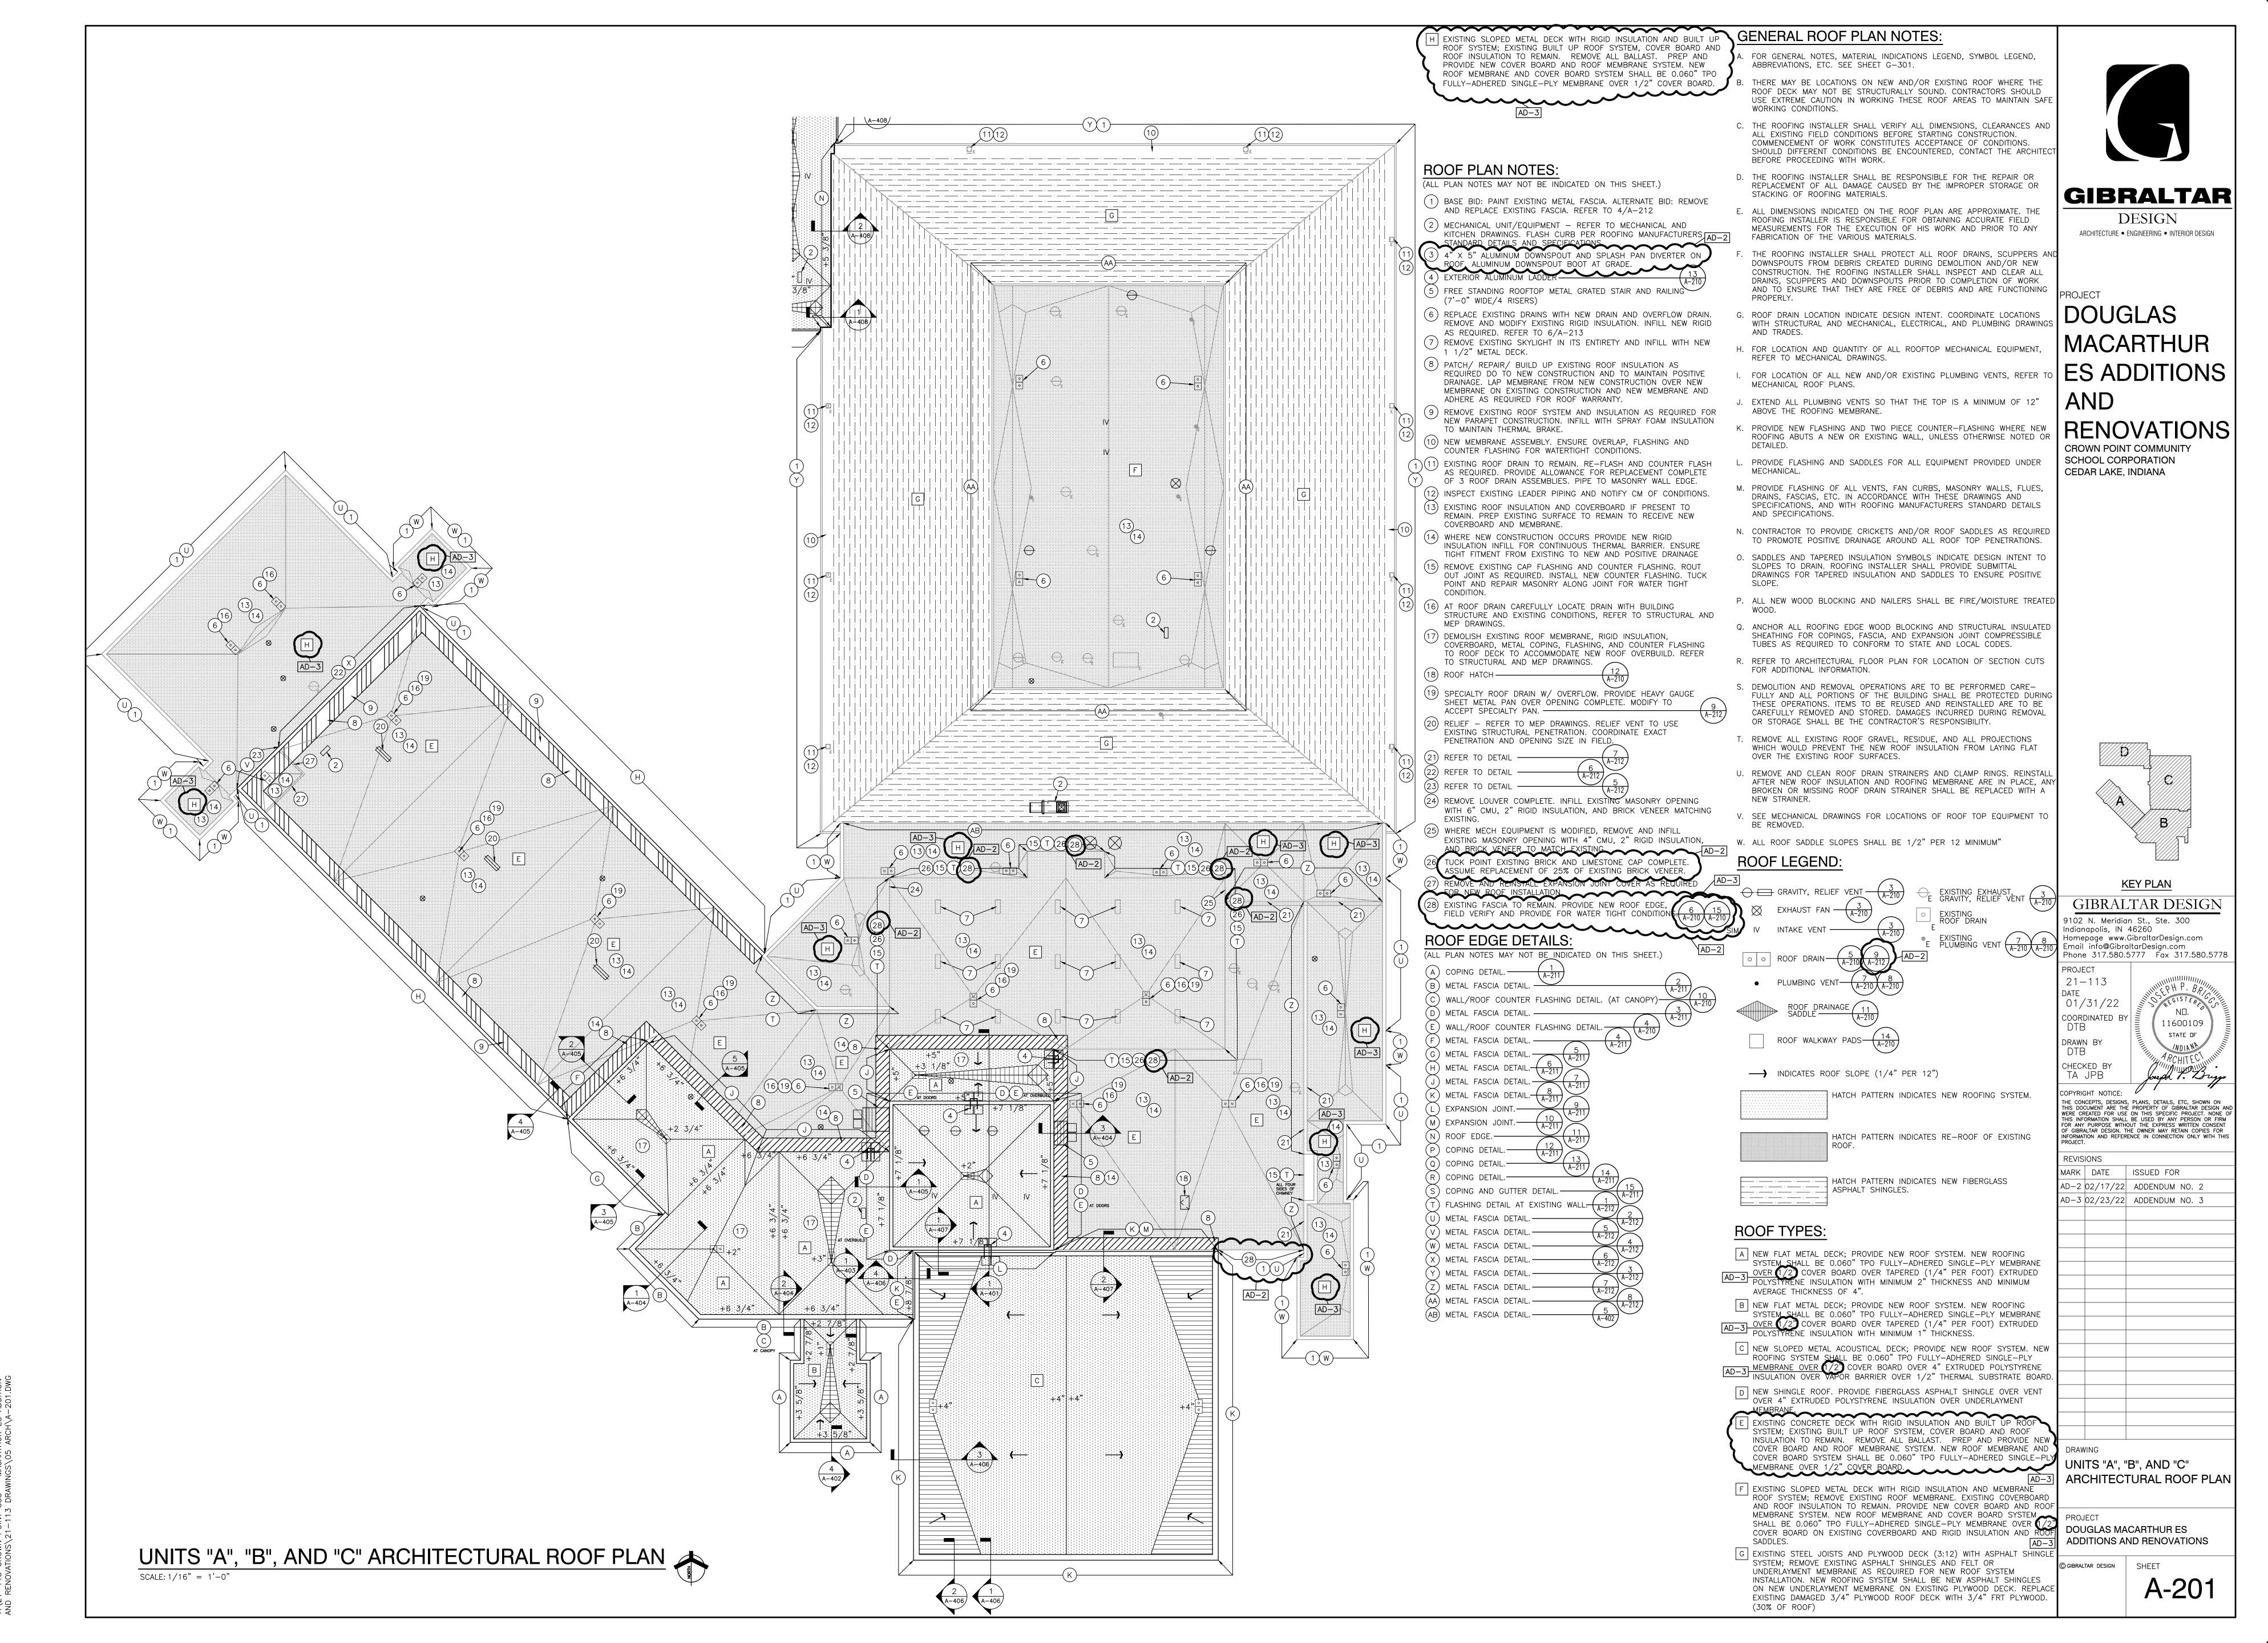

Thursday, 2/24/2022 — 6:11 PM — LAST SAVED BY:TA

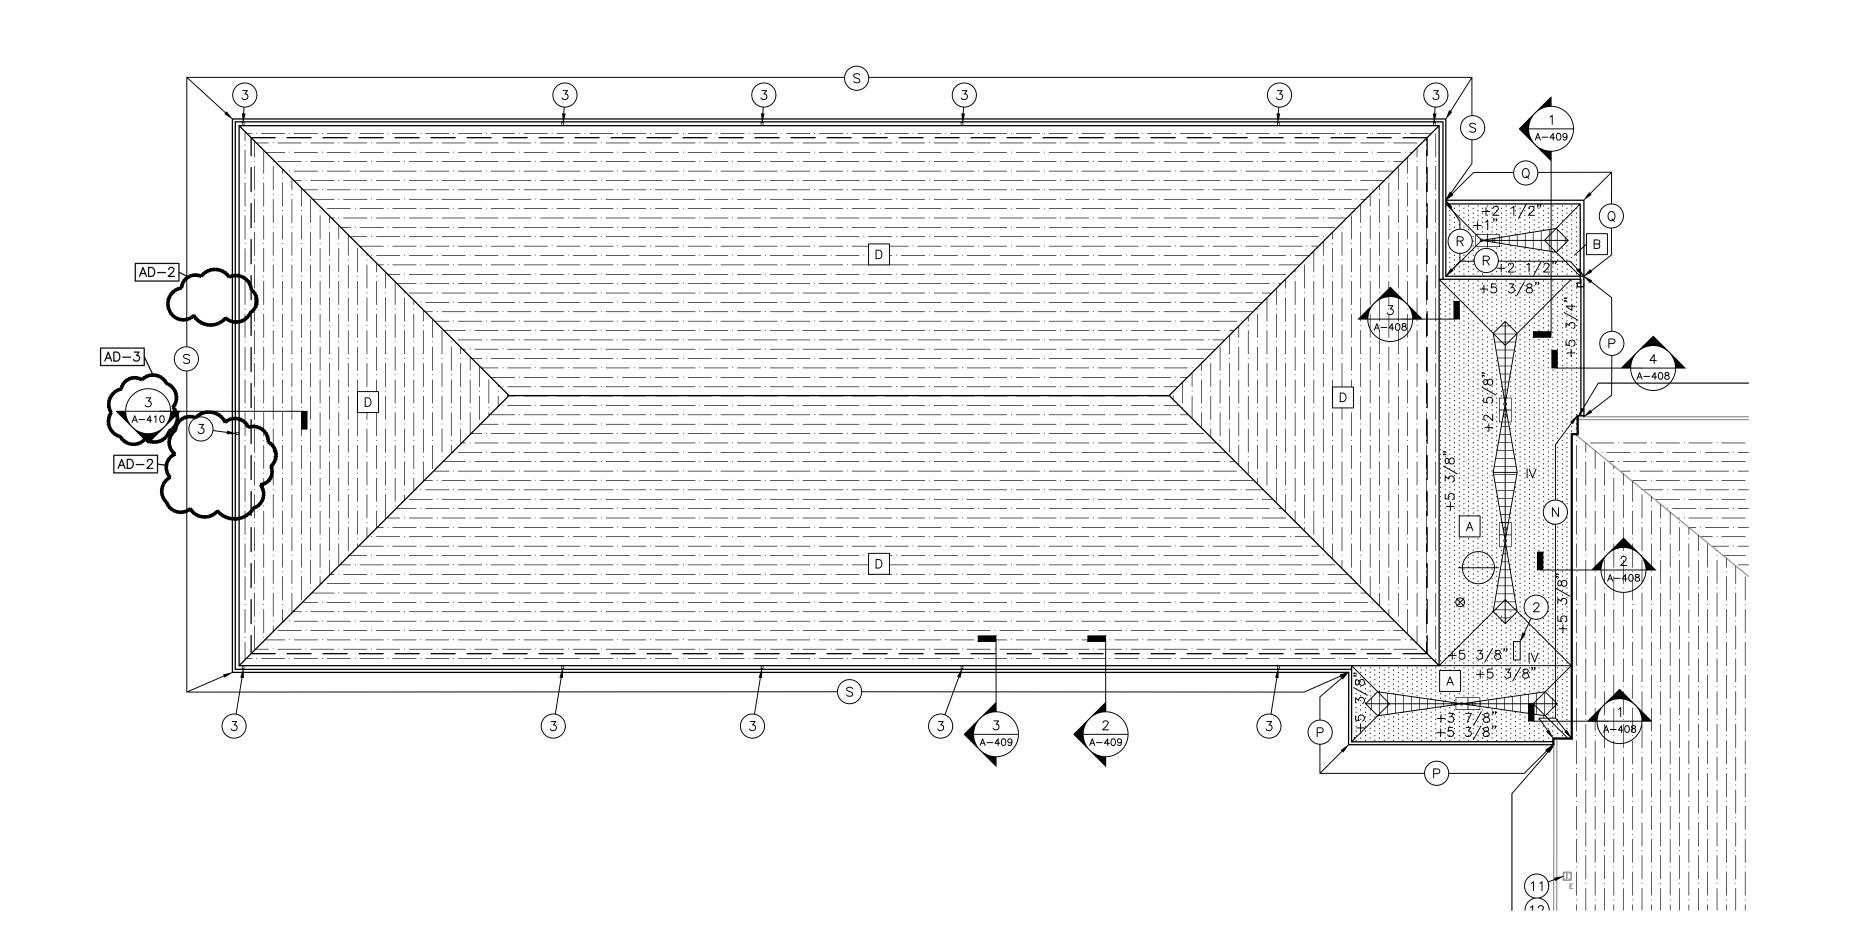

 I^{T} EXISTING SLOPED METAL DECK WITH RIGID INSULATION AND BUILT U ROOF SYSTEM; EXISTING BUILT UP ROOF SYSTEM, COVER BOARD AND ROOF INSULATION TO REMAIN. REMOVE ALL BALLAST. PREP AND PROVIDE NEW COVER BOARD AND ROOF MEMBRANE SYSTEM. NEW ROOF MEMBRANE AND COVER BOARD SYSTEM SHALL BE 0.060" TPO FULLY-ADHERED SINGLE-PLY MEMBRANE OVER 1/2" COVER BOARD.

ROOF PLAN NOTES

- (ALL PLAN NOTES MAY NOT BE INDICATED ON THIS SHEET.)
- (1) BASE BID: PAINT EXISTING METAL FASCIA. ALTERNATE BID: REMOVE AND REPLACE EXISTING FASCIA. REFER TO 4/A-212
- (2) MECHANICAL UNIT/EQUIPMENT REFER TO MECHANICAL AND KITCHEN DRAWINGS. FLASH CURB PER ROOFING MANUFACTURERS AD-2 STANDARD DETAILS AND SPECIFICATIONS

' 4" X 5" ALUMINUM DOWNSPOUT AND SPLASH PAN DIVERTER ON ALUMINUM DOWNSPOUT BOOT AT GRADE.

- $(\,\mathtt{5}\,)$ free standing rooftop metal grated stair and railing $\,$ (7'-0" WIDE/4 RISERS)
- (6) REPLACE EXISTING DRAINS WITH NEW DRAIN AND OVERFLOW DRAIN. REMOVE AND MODIFY EXISTING RIGID INSULATION. INFILL NEW RIGID AS REQUIRED. REFER TO 6/A-213
- (7) REMOVE EXISTING SKYLIGHT IN ITS ENTIRETY AND INFILL WITH NEW 1 1/2" METAL DECK. (8) PATCH/ REPAIR/ BUILD UP EXISTING ROOF INSULATION AS
- MEMBRANE ON EXISTING CONSTRUCTION AND NEW MEMBRANE AND ADHERE AS REQUIRED FOR ROOF WARRANTY. (9) REMOVE EXISTING ROOF SYSTEM AND INSULATION AS REQUIRED FOR NEW PARAPET CONSTRUCTION. INFILL WITH SPRAY FOAM INSULATION

REQUIRED DO TO NEW CONSTRUCTION AND TO MAINTAIN POSITIVE

DRAINAGE. LAP MEMBRANE FROM NEW CONSTRUCTION OVER NEW

- TO MAINTAIN THERMAL BRAKE. (10) NEW MEMBRANE ASSEMBLY. ENSURE OVERLAP, FLASHING AND
- COUNTER FLASHING FOR WATERTIGHT CONDITIONS. (11) EXISTING ROOF DRAIN TO REMAIN. RE-FLASH AND COUNTER FLASH AS REQUIRED. PROVIDE ALLOWANCE FOR REPLACEMENT COMPLETE OF 3 ROOF DRAIN ASSEMBLIES. PIPE TO MASONRY WALL EDGE.

(12) inspect existing leader piping and notify cm of conditions.

3) EXISTING ROOF INSULATION AND COVERBOARD IF PRESENT TO REMAIN. PREP EXISTING SURFACE TO REMAIN TO RECEIVE NEW COVERBOARD AND MEMBRANE.

OUT JOINT AS REQUIRED. INSTALL NEW COUNTER FLASHING. TUCK

- (14) WHERE NEW CONSTRUCTION OCCURS PROVIDE NEW RIGID INSULATION INFILL FOR CONTINUOUS THERMAL BARRIER. ENSURE TIGHT FITMENT FROM EXISTING TO NEW AND POSITIVE DRAINAGE (15) REMOVE EXISTING CAP FLASHING AND COUNTER FLASHING. ROUT
- CONDITION. (16) AT ROOF DRAIN CAREFULLY LOCATE DRAIN WITH BUILDING STRUCTURE AND EXISTING CONDITIONS, REFER TO STRUCTURAL AND

POINT AND REPAIR MASONRY ALONG JOINT FOR WATER TIGHT

- MEP DRAWINGS. (17) DEMOLISH EXISTING ROOF MEMBRANE, RIGID INSULATION, COVERBOARD, METAL COPING, FLASHING, AND COUNTER FLASHING TO ROOF DECK TO ACCOMMODATE NEW ROOF OVERBUILD. REFER
- TO STRUCTURAL AND MEP DRAWINGS. (18) ROOF HATCH ——
- (19) SPECIALTY ROOF DRAIN W/ OVERFLOW. PROVIDE HEAVY GAUGE SHEET METAL PAN OVER OPENING COMPLETE. MODIFY TO ACCEPT SPECIALTY PAN. ---
- (20) RELIEF REFER TO MEP DRAWINGS. RELIEF VENT TO USE EXISTING STRUCTURAL PENETRATION. COORDINATE EXACT PENETRATION AND OPENING SIZE IN FIELD.
- (24) REMOVE LOUVER COMPLETE. INFILL EXISTING MASONRY OPENING WITH 6" CMU, 2" RIGID INSULATION, AND BRICK VENEER MATCHING
- (25) WHERE MECH EQUIPMENT IS MODIFIED, REMOVE AND INFILL EXISTING MASONRY OPENING WITH 4" CMU, 2" RIGID INSULATION, DRILLO VENEER IO MATORI EXISTING

TUCK POINT EXISTING BRICK AND LIMESTONE CAP COMPLETE SSUME REPLACEMENT OF 25% OF EXISTING BRICK VENEER.

ROOF EDGE DETAILS:

- (ALL PLAN NOTES MAY NOT BE_INDICATED ON THIS SHEET.) (A) COPING DETAIL. (A-211)
- B) METAL FASCIA DETAIL.) WALL/ROOF COUNTER FLASHING DETAIL. (AT CANOPY)—
-) METAL FASCIA DETAIL. —
- WALL/ROOF COUNTER FLASHING DETAIL. —

- M) EXPANSION JOINT

-) METAL FASCIA DETAIL.
-) METAL FASCIA DETAIL.-V) METAL FASCIA DETAIL.-
- K) METAL FASCIA DETAIL.-) METAL FASCIA DETAIL.-
- ː) METAL FASCIA DETAIL.-
- (AB) METAL FASCIA DETAIL. -
- (AA) METAL FASCIA DETAIL .-

GENERAL ROOF PLAN NOTES:

- FOR GENERAL NOTES, MATERIAL INDICATIONS LEGEND, SYMBOL LEGEND, ABBREVIATIONS, ETC. SEE SHEET G-301.
- THERE MAY BE LOCATIONS ON NEW AND/OR EXISTING ROOF WHERE THE ROOF DECK MAY NOT BE STRUCTURALLY SOUND. CONTRACTORS SHOULD USE EXTREME CAUTION IN WORKING THESE ROOF AREAS TO MAINTAIN SAFE WORKING CONDITIONS.
- C. THE ROOFING INSTALLER SHALL VERIFY ALL DIMENSIONS, CLEARANCES AND ALL EXISTING FIELD CONDITIONS BEFORE STARTING CONSTRUCTION. COMMENCEMENT OF WORK CONSTITUTES ACCEPTANCE OF CONDITIONS. SHOULD DIFFERENT CONDITIONS BE ENCOUNTERED, CONTACT THE ARCHITEC'
- BEFORE PROCEEDING WITH WORK. D. THE ROOFING INSTALLER SHALL BE RESPONSIBLE FOR THE REPAIR OR REPLACEMENT OF ALL DAMAGE CAUSED BY THE IMPROPER STORAGE OR STACKING OF ROOFING MATERIALS.
- E. ALL DIMENSIONS INDICATED ON THE ROOF PLAN ARE APPROXIMATE. THE ROOFING INSTALLER IS RESPONSIBLE FOR OBTAINING ACCURATE FIELD MEASUREMENTS FOR THE EXECUTION OF HIS WORK AND PRIOR TO ANY FABRICATION OF THE VARIOUS MATERIALS.
- THE ROOFING INSTALLER SHALL PROTECT ALL ROOF DRAINS, SCUPPERS AND DOWNSPOUTS FROM DEBRIS CREATED DURING DEMOLITION AND/OR NEW CONSTRUCTION. THE ROOFING INSTALLER SHALL INSPECT AND CLEAR ALL DRAINS, SCUPPERS AND DOWNSPOUTS PRIOR TO COMPLETION OF WORK AND TO ENSURE THAT THEY ARE FREE OF DEBRIS AND ARE FUNCTIONING
- ROOF DRAIN LOCATION INDICATE DESIGN INTENT. COORDINATE LOCATIONS WITH STRUCTURAL AND MECHANICAL, ELECTRICAL, AND PLUMBING DRAWINGS AND TRADES.
- H. FOR LOCATION AND QUANTITY OF ALL ROOFTOP MECHANICAL EQUIPMENT REFER TO MECHANICAL DRAWINGS.
- FOR LOCATION OF ALL NEW AND/OR EXISTING PLUMBING VENTS, REFER MECHANICAL ROOF PLANS.

ROOFING ABUTS A NEW OR EXISTING WALL, UNLESS OTHERWISE NOTED OR


- J. EXTEND ALL PLUMBING VENTS SO THAT THE TOP IS A MINIMUM OF 12" ABOVE THE ROOFING MEMBRANE. K. PROVIDE NEW FLASHING AND TWO PIECE COUNTER-FLASHING WHERE NEW
- PROVIDE FLASHING AND SADDLES FOR ALL EQUIPMENT PROVIDED UNDER MECHANICAL.
- M. PROVIDE FLASHING OF ALL VENTS, FAN CURBS, MASONRY WALLS, FLUES, DRAINS, FASCIAS, ETC. IN ACCORDANCE WITH THESE DRAWINGS AND SPECIFICATIONS, AND WITH ROOFING MANUFACTURERS STANDARD DETAILS
- N. CONTRACTOR TO PROVIDE CRICKETS AND/OR ROOF SADDLES AS REQUIRED TO PROMOTE POSITIVE DRAINAGE AROUND ALL ROOF TOP PENETRATIONS.
- O. SADDLES AND TAPERED INSULATION SYMBOLS INDICATE DESIGN INTENT TO SLOPES TO DRAIN. ROOFING INSTALLER SHALL PROVIDE SUBMITTAL DRAWINGS FOR TAPERED INSULATION AND SADDLES TO ENSURE POSITIVE
- P. ALL NEW WOOD BLOCKING AND NAILERS SHALL BE FIRE/MOISTURE TREATED
- Q. ANCHOR ALL ROOFING EDGE WOOD BLOCKING AND STRUCTURAL INSULATED SHEATHING FOR COPINGS, FASCIA, AND EXPANSION JOINT COMPRESSIBLE TUBES AS REQUIRED TO CONFORM TO STATE AND LOCAL CODES.
- R. REFER TO ARCHITECTURAL FLOOR PLAN FOR LOCATION OF SECTION CUTS FOR ADDITIONAL INFORMATION.
- FULLY AND ALL PORTIONS OF THE BUILDING SHALL BE PROTECTED DURING THESE OPERATIONS. ITEMS TO BE REUSED AND REINSTALLED ARE TO BE CAREFULLY REMOVED AND STORED. DAMAGES INCURRED DURING REMOVAL OR STORAGE SHALL BE THE CONTRACTOR'S RESPONSIBILITY.
- T. REMOVE ALL EXISTING ROOF GRAVEL, RESIDUE, AND ALL PROJECTIONS WHICH WOULD PREVENT THE NEW ROOF INSULATION FROM LAYING FLAT OVER THE EXISTING ROOF SURFACES.
- U. REMOVE AND CLEAN ROOF DRAIN STRAINERS AND CLAMP RINGS. REINSTALL AFTER NEW ROOF INSULATION AND ROOFING MEMBRANE ARE IN PLACE, ANY BROKEN OR MISSING ROOF DRAIN STRAINER SHALL BE REPLACED WITH A NEW STRAINER.
- V. SEE MECHANICAL DRAWINGS FOR LOCATIONS OF ROOF TOP EQUIPMENT TO
- W. ALL ROOF SADDLE SLOPES SHALL BE 1/2" PER 12 MINIMUM"

ROOF LEGEND:

AND SPECIFICATIONS.

SLOPE.

GRAVITY, RELIEF VENT $\frac{3}{(A-210)}$ \bigotimes EXHAUST FAN $\frac{3}{(A-210)}$

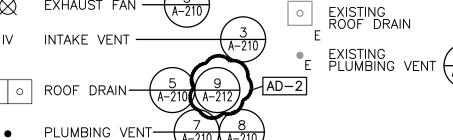

ROOF WALKWAY PADS-

→ INDICATES ROOF SLOPE (1/4" PER 12") HATCH PATTERN INDICATES NEW ROOFING SYSTEM.

HATCH PATTERN INDICATES RE-ROOF OF EXISTING ROOF.

HATCH PATTERN INDICATES NEW FIBERGLASS ASPHALT SHINGLES.

ROOF TYPES:

- A NEW FLAT METAL DECK; PROVIDE NEW ROOF SYSTEM. NEW ROOFING SYSTEM_SHALL BE 0.060" TPO FULLY-ADHERED SINGLE-PLY MEMBRANE AD-3 OVER 1/2 COVER BOARD OVER TAPERED (1/4" PER FOOT) EXTRUDED POLYSTYRENE INSULATION WITH MINIMUM 2" THICKNESS AND MINIMUM AVERAGE THICKNESS OF 4".
- B | NEW FLAT METAL DECK; PROVIDE NEW ROOF SYSTEM. NEW ROOFING SYSTEM SHALL BE 0.060" TPO FULLY—ADHERED SINGLE—PLY MEMBRANE OVER 1/2" COVER BOARD OVER TAPERED (1/4" PER FOOT) EXTRUDED POLYSTYRENE INSULATION WITH MINIMUM 1" THICKNESS.
- C | NEW SLOPED METAL ACOUSTICAL DECK; PROVIDE NEW ROOF SYSTEM. NEW ROOFING SYSTEM SHALL BE 0.060" TPO FULLY—ADHERED SINGLE—PLY MEMBRANE OVER (1/2) COVER BOARD OVER 4" EXTRUDED POLYSTYRENE AD-3 INSULATION OVER VAPOR BARRIER OVER 1/2" THERMAL SUBSTRATE BOARD.
- D NEW SHINGLE ROOF. PROVIDE FIBERGLASS ASPHALT SHINGLE OVER VENT OVER 4" EXTRUDED POLYSTYRENE INSULATION OVER UNDERLAYMENT MEMBRANE.

 E EXISTING CONCRETE DECK WITH RIGID INSULATION AND BUILT UP ROOF SYSTEM; EXISTING BUILT UP ROOF SYSTEM, COVER BOARD AND ROOF INSULATION TO REMAIN. REMOVE ALL BALLAST. PREP AND PROVIDE NEW
- MEMBRANE OVER 1/2" COVER BOARD. F EXISTING SLOPED METAL DECK WITH RIGID INSULATION AND MEMBRANE $^{\mathsf{J}}$ roof system: remove existing roof membrane, existing coverboard AND ROOF INSULATION TO REMAIN. PROVIDE NEW COVER BOARD AND ROOF MEMBRANE SYSTEM. NEW ROOF MEMBRANE AND COVER BOARD SYSTEM PROJECT SHALL BE 0.060" TPO FULLY—ADHERED SINGLE—PLY MEMBRANE OVER 1/2" DOUGLAS MACARTHUR ES COVER BOARD ON EXISTING COVERBOARD AND RIGID INSULATION AND ROOF
- G EXISTING STEEL JOISTS AND PLYWOOD DECK (3:12) WITH ASPHALT SHINGLE SYSTEM; REMOVE EXISTING ASPHALT SHINGLES AND FELT OR UNDERLAYMENT MEMBRANE AS REQUIRED FOR NEW ROOF SYSTEM INSTALLATION. NEW ROOFING SYSTEM SHALL BE NEW ASPHALT SHINGLES ON NEW UNDERLAYMENT MEMBRANE ON EXISTING PLYWOOD DECK. REPLACE EXISTING DAMAGED 3/4" PLYWOOD ROOF DECK WITH 3/4" FRT PLYWOOD. (30% OF ROOF)




DESIGN ARCHITECTURE • ENGINEERING • INTERIOR DESIGN

ES ADDITIONS

CROWN POINT COMMUNIT SCHOOL CORPORATION

CEDAR LAKE, INDIANA

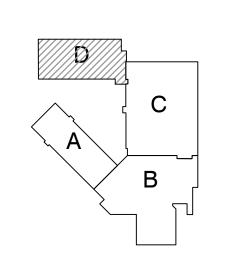

KEY PLAN GIBRALTAR DESIGN

102 N. Meridian St., Ste. 300 idianapolis, IN 46260 Homepage www.GibraltarDesign.com PLUMBING VENT (A-210) Email info@GibraltarDesign.com Phone 317.580.5777 Fax 317.580.577

COORDINATED B' 11600109 DRAWN BY

DTB CHECKED BY

FOR ANY PURPOSE WITHOUT THE EXPRESS WRITTEN CONSEN OF GIBRALTAR DESIGN. THE OWNER MAY RETAIN COPIES FOR INFORMATION AND REFERENCE IN CONNECTION ONLY WITH THIS PROJECT.

MARK DATE ISSUED FOR AD-2 |02/17/22| ADDENDUM NO. 2AD-3 |02/23/22| ADDENDUM NO. 3

COVER BOARD AND ROOF MEMBRANE SYSTEM. NEW ROOF MEMBRANE AND COVER BOARD SYSTEM SHALL BE 0.060" TPO FULLY-ADHERED SINGLE-PLY UNIT "D" ARCHITECTURAL


ADDITIONS AND RENOVATIONS

GIBRALTAR DESIGN SHEET A-202


UNIT "D" ARCHITECTURAL ROOF PLAN SCALE: 1/16" = 1'-0"

- LAST SAVED | MACARTHUR ES / NGS\05 ARCH\A-




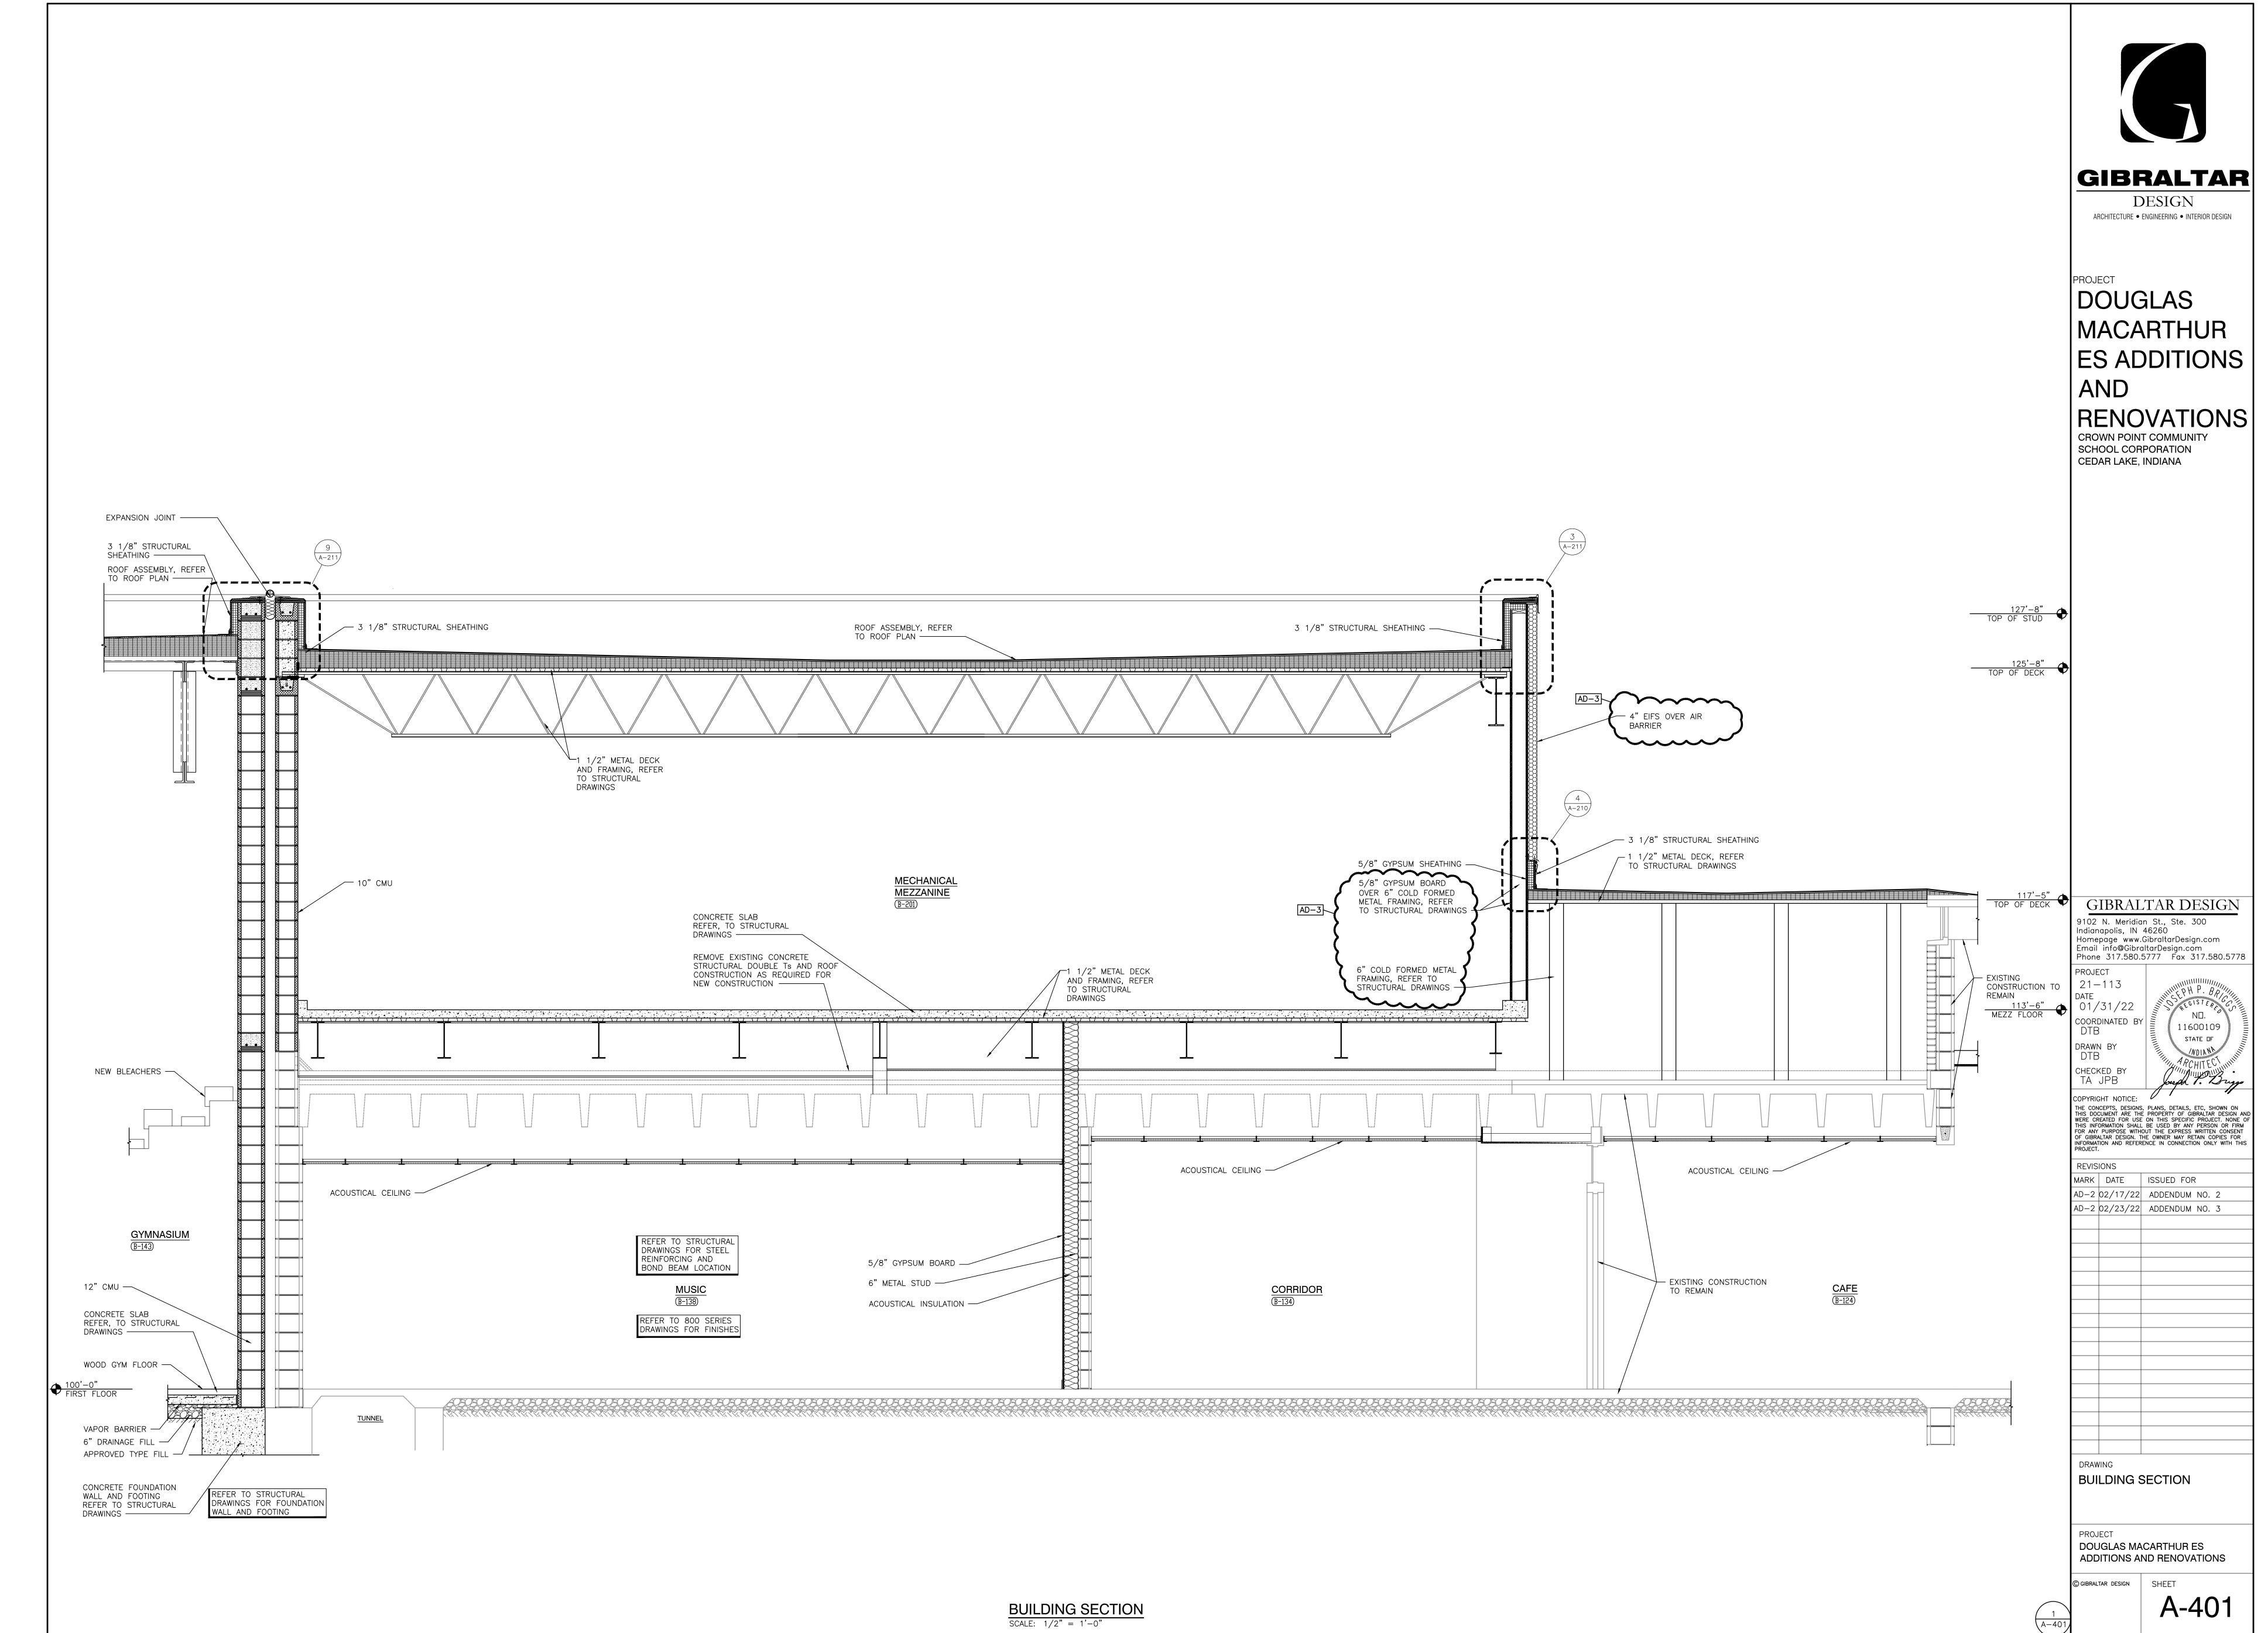


sday, 2/24/2022 — 9:25 AM — LAST SAVED BY:DBURN 1—113 CROWN POINT CSC — MACARTHUR ES ADDITION RENOVATIONS\21—113 DRAWINGS\05 ARCH\A—401.DWG

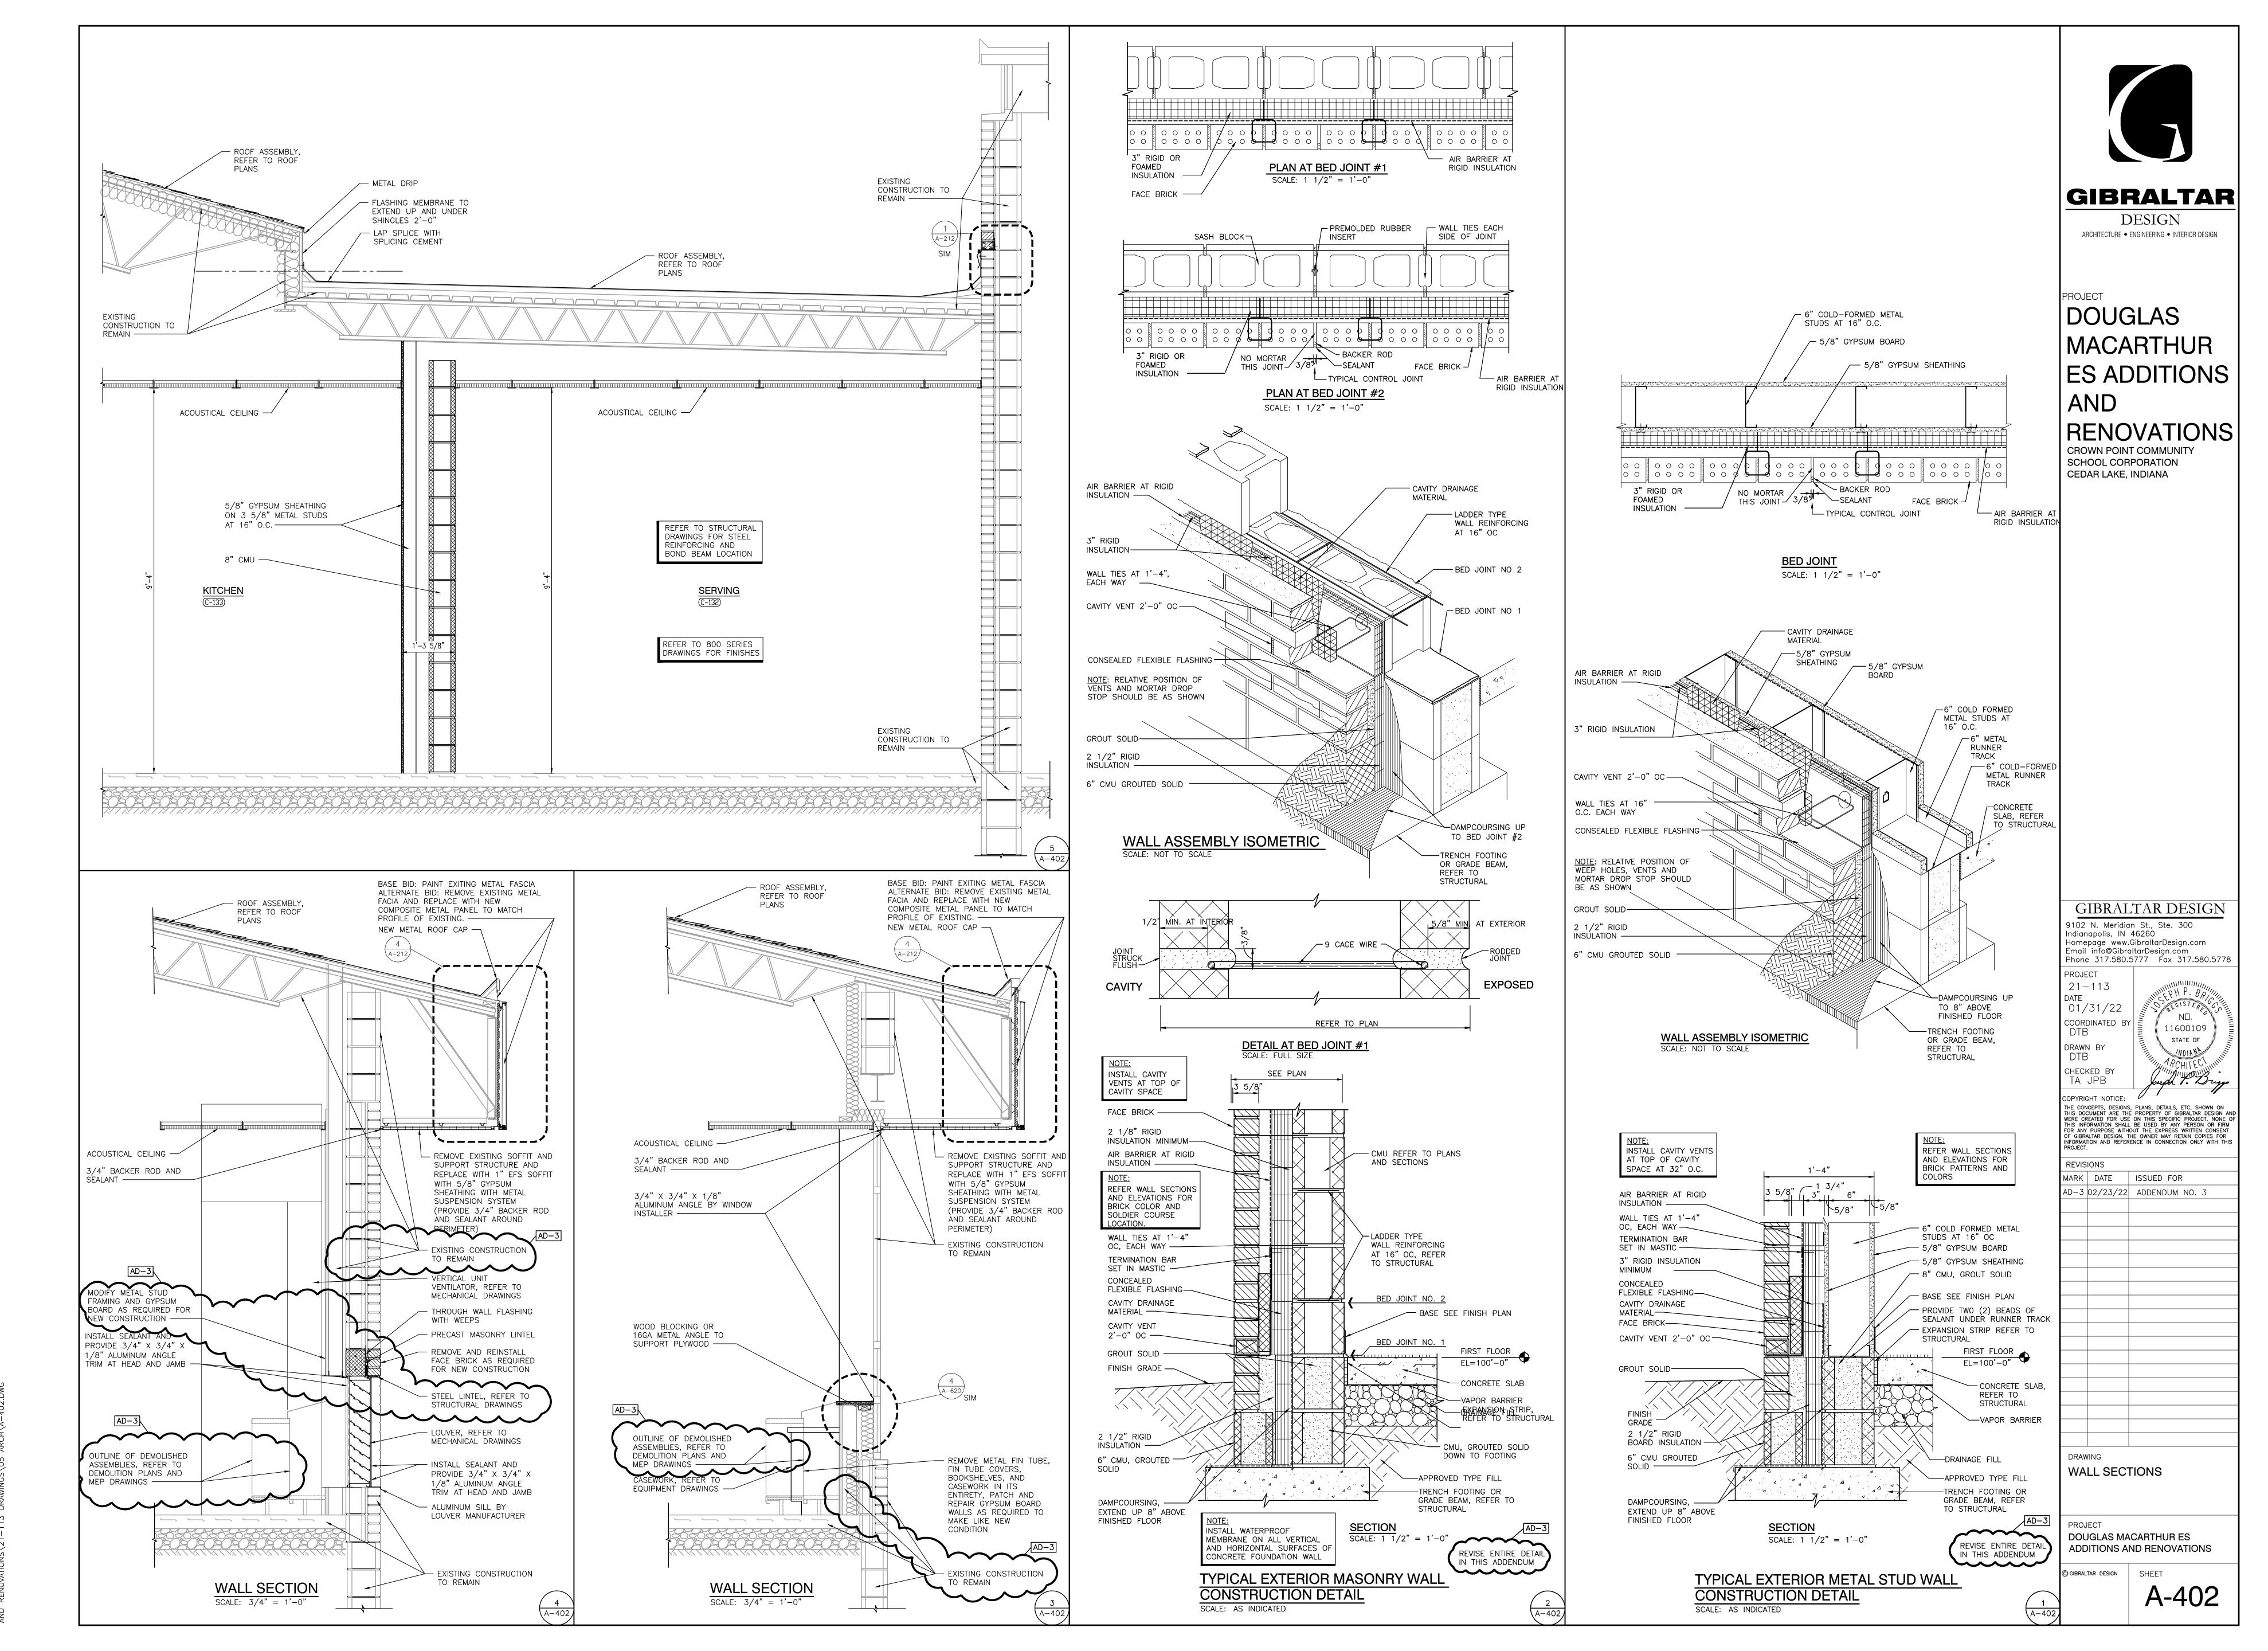


2/24/2022 - 11:37 CROWN POINT CSC -/ATIONS\21-113 DRAW

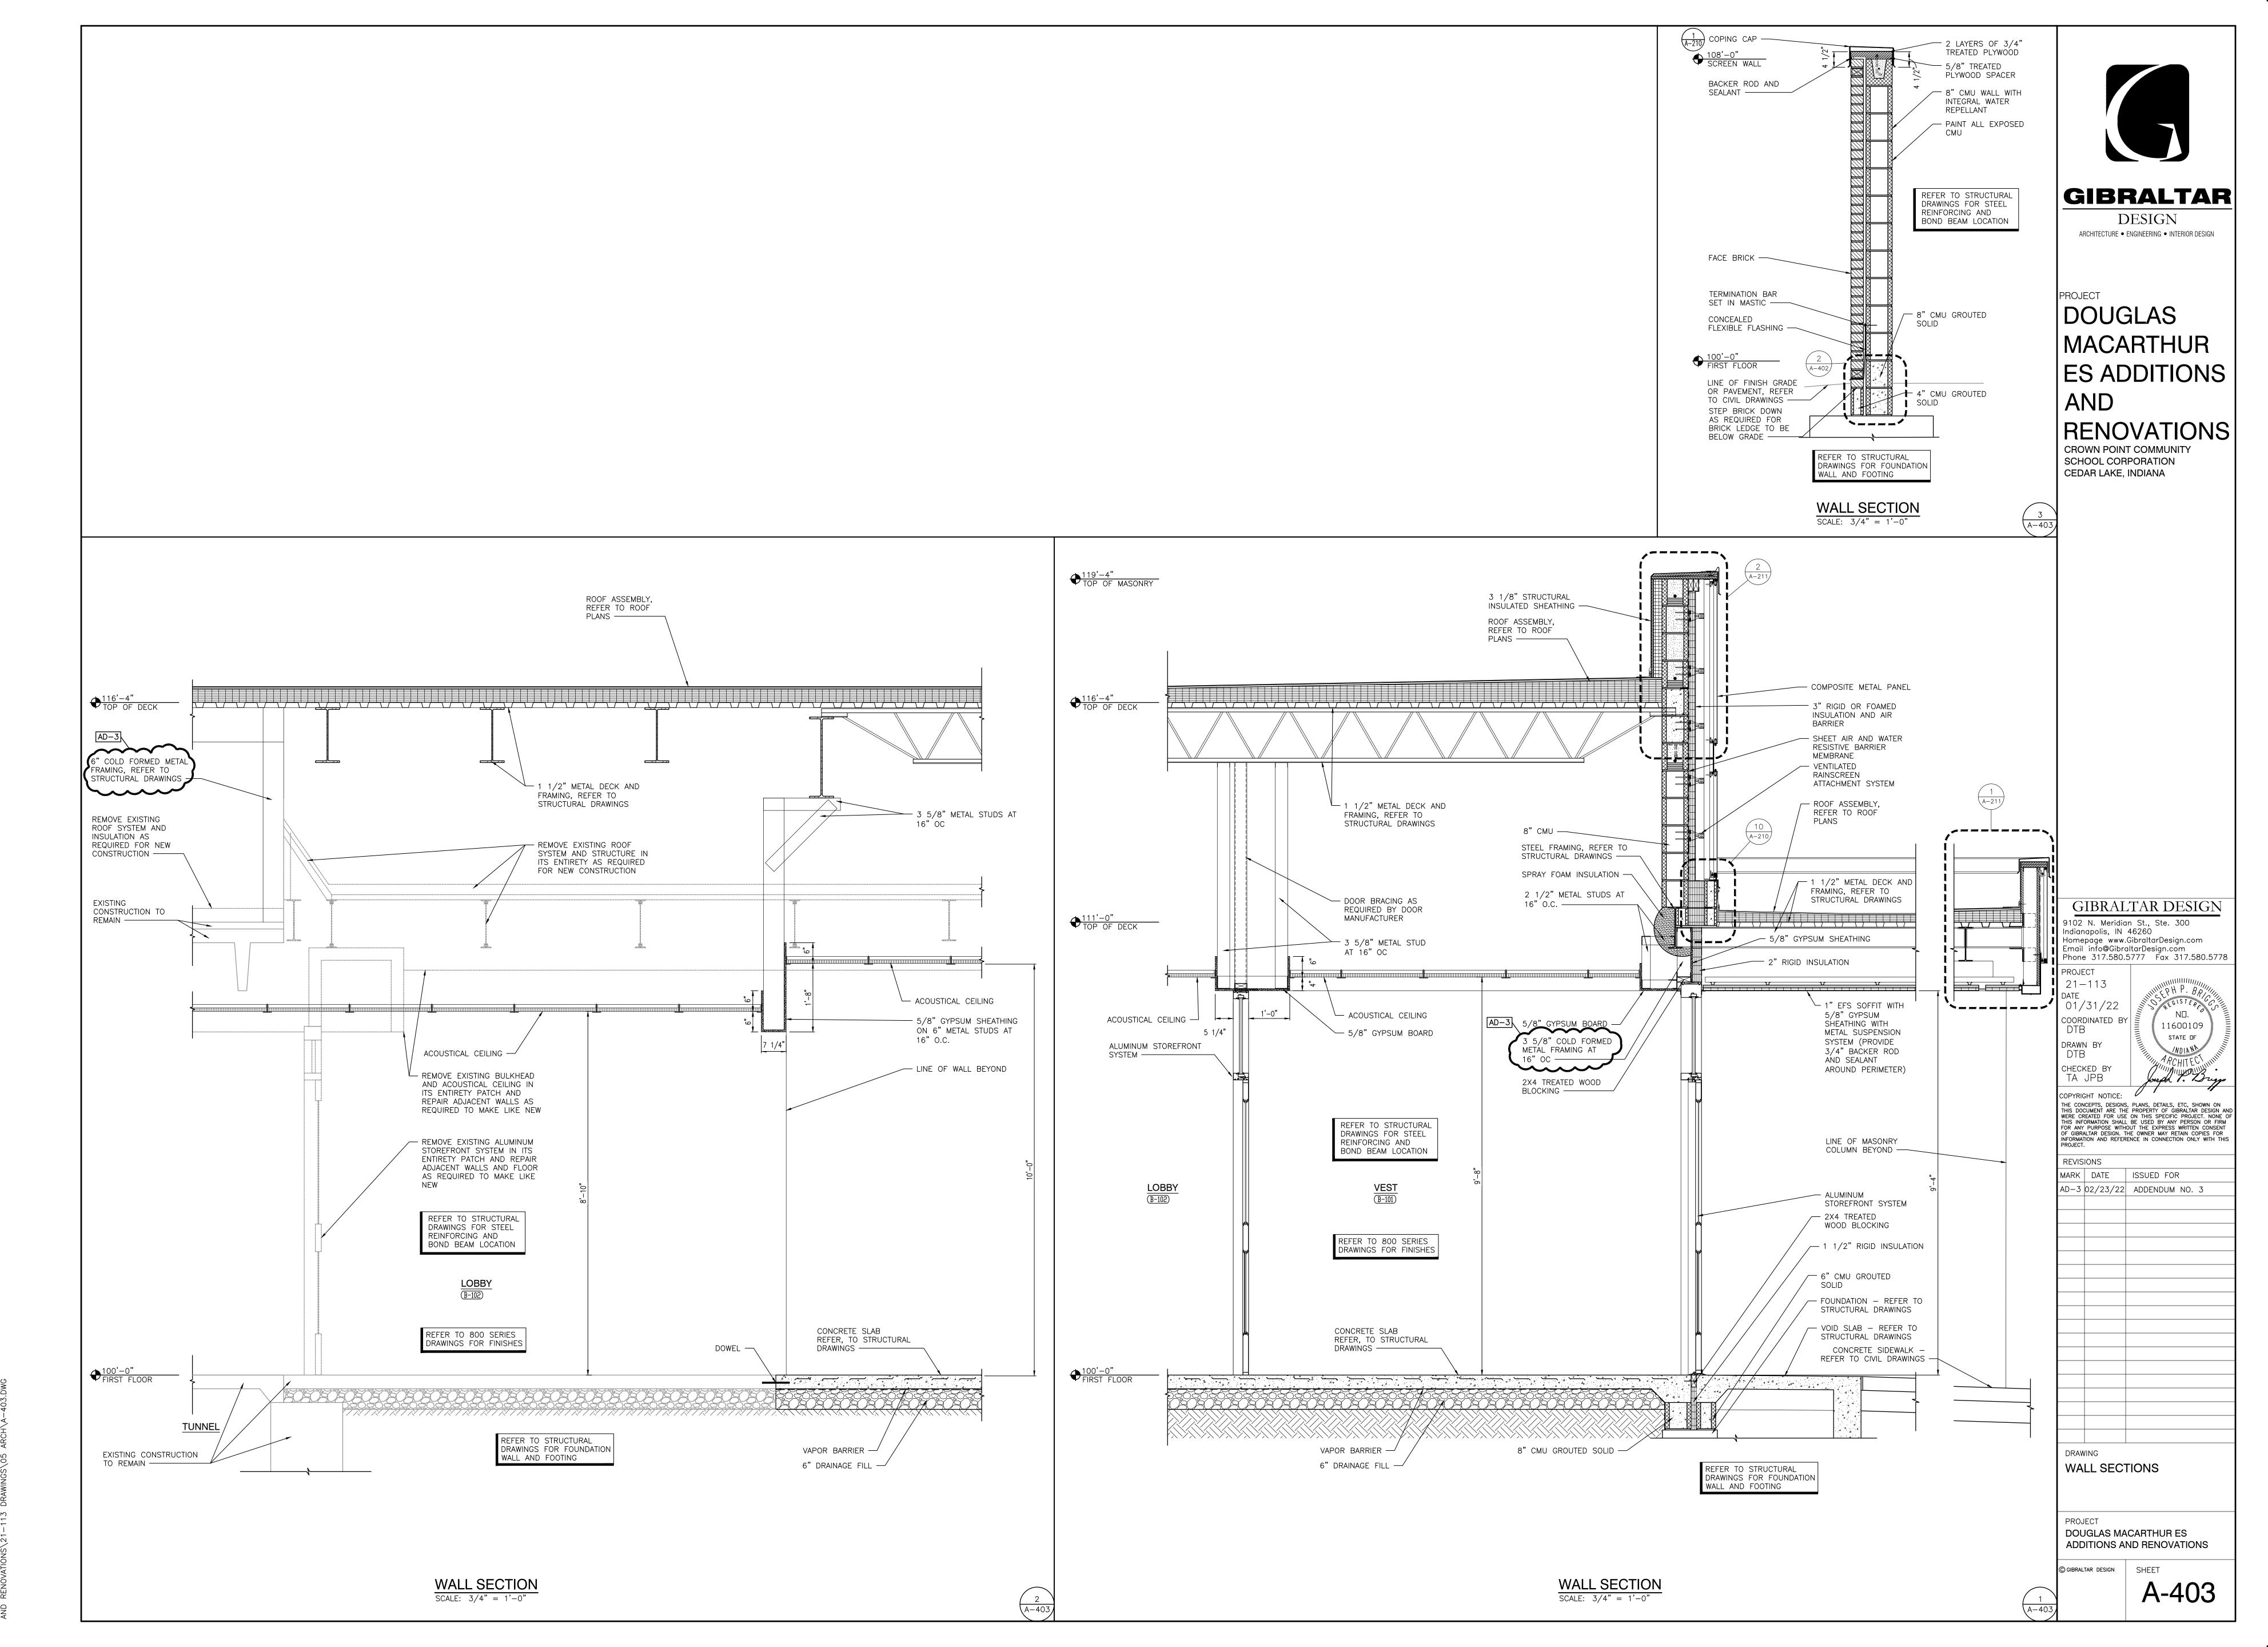


Thursday, 2/24/2022 — 9:26 AM — LAST SAVED BY:DBURNS Y:\21—113 CROWN POINT CSC — MACARTHUR ES ADDITION AND RENOVATIONS\21—113 DRAWINGS\05 ARCH\A—403.DWG

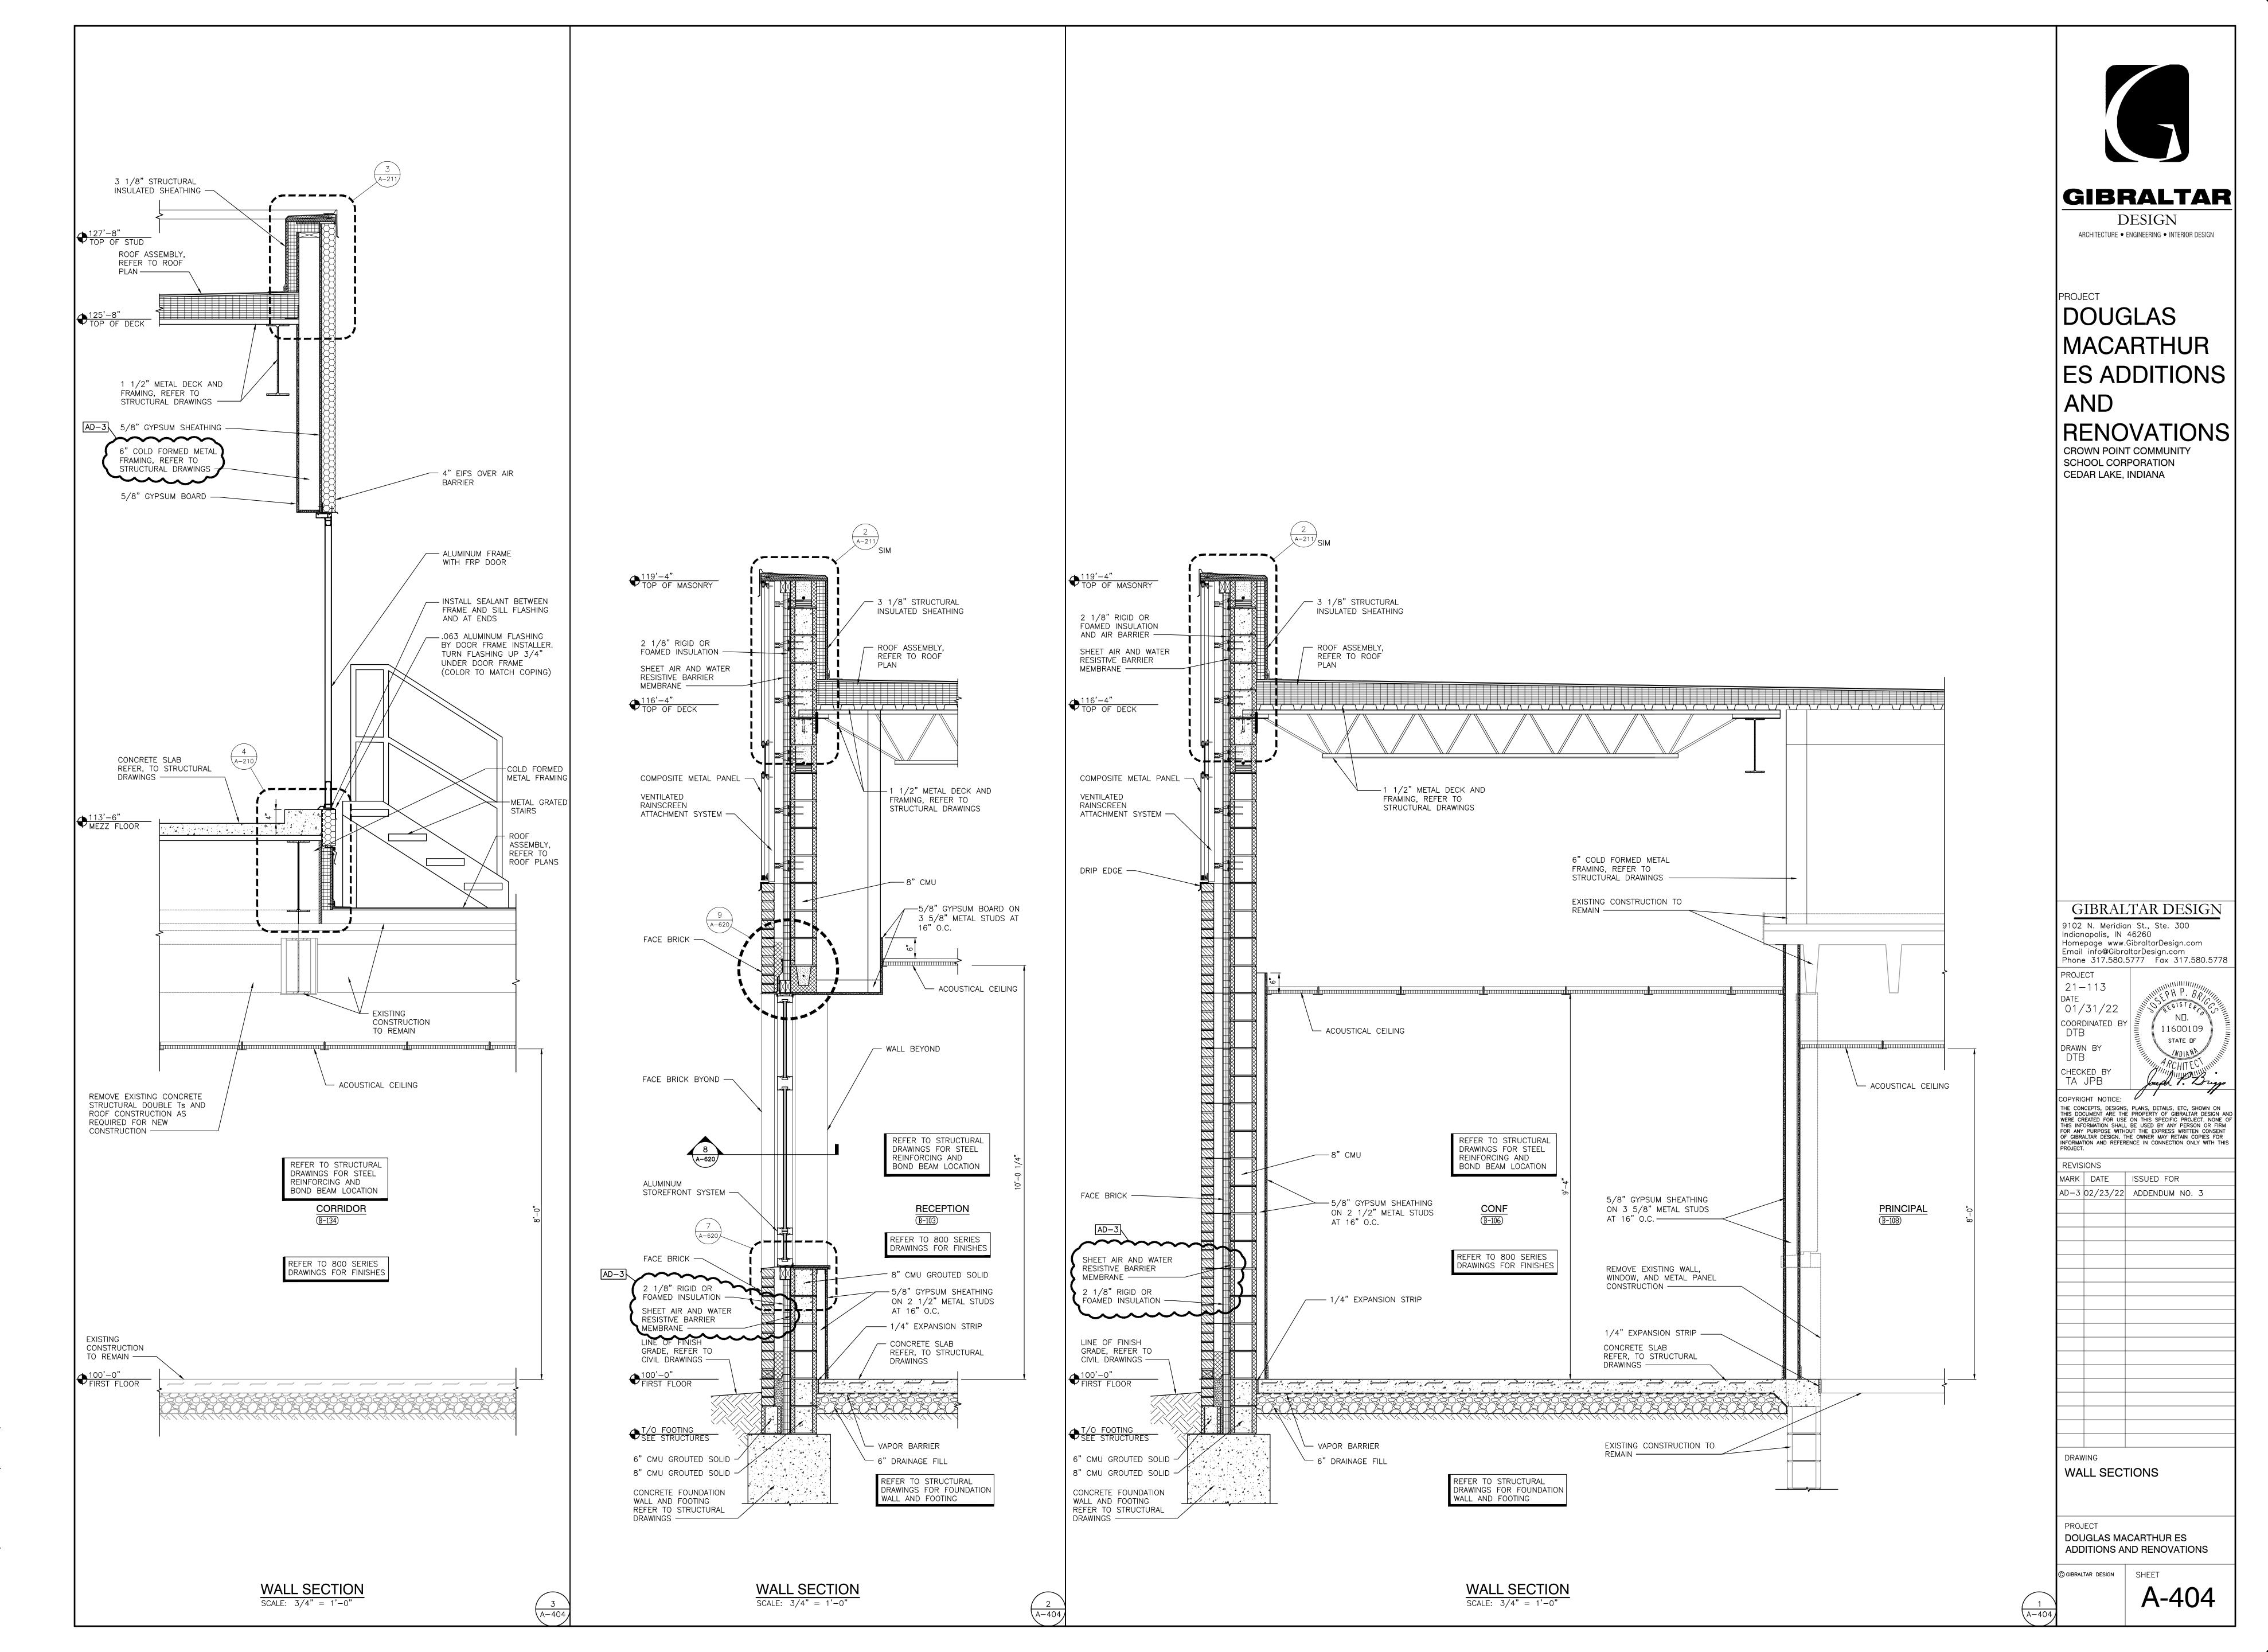


Thursday, 2/24/2022 — 9:28 AM — LAST SAVED BY:DBURNS Y:\21—113 CROWN POINT CSC — MACARTHUR ES ADDITION AND RENOVATIONS\21—113 DRAWINGS\05 ARCH\A—404.DWG

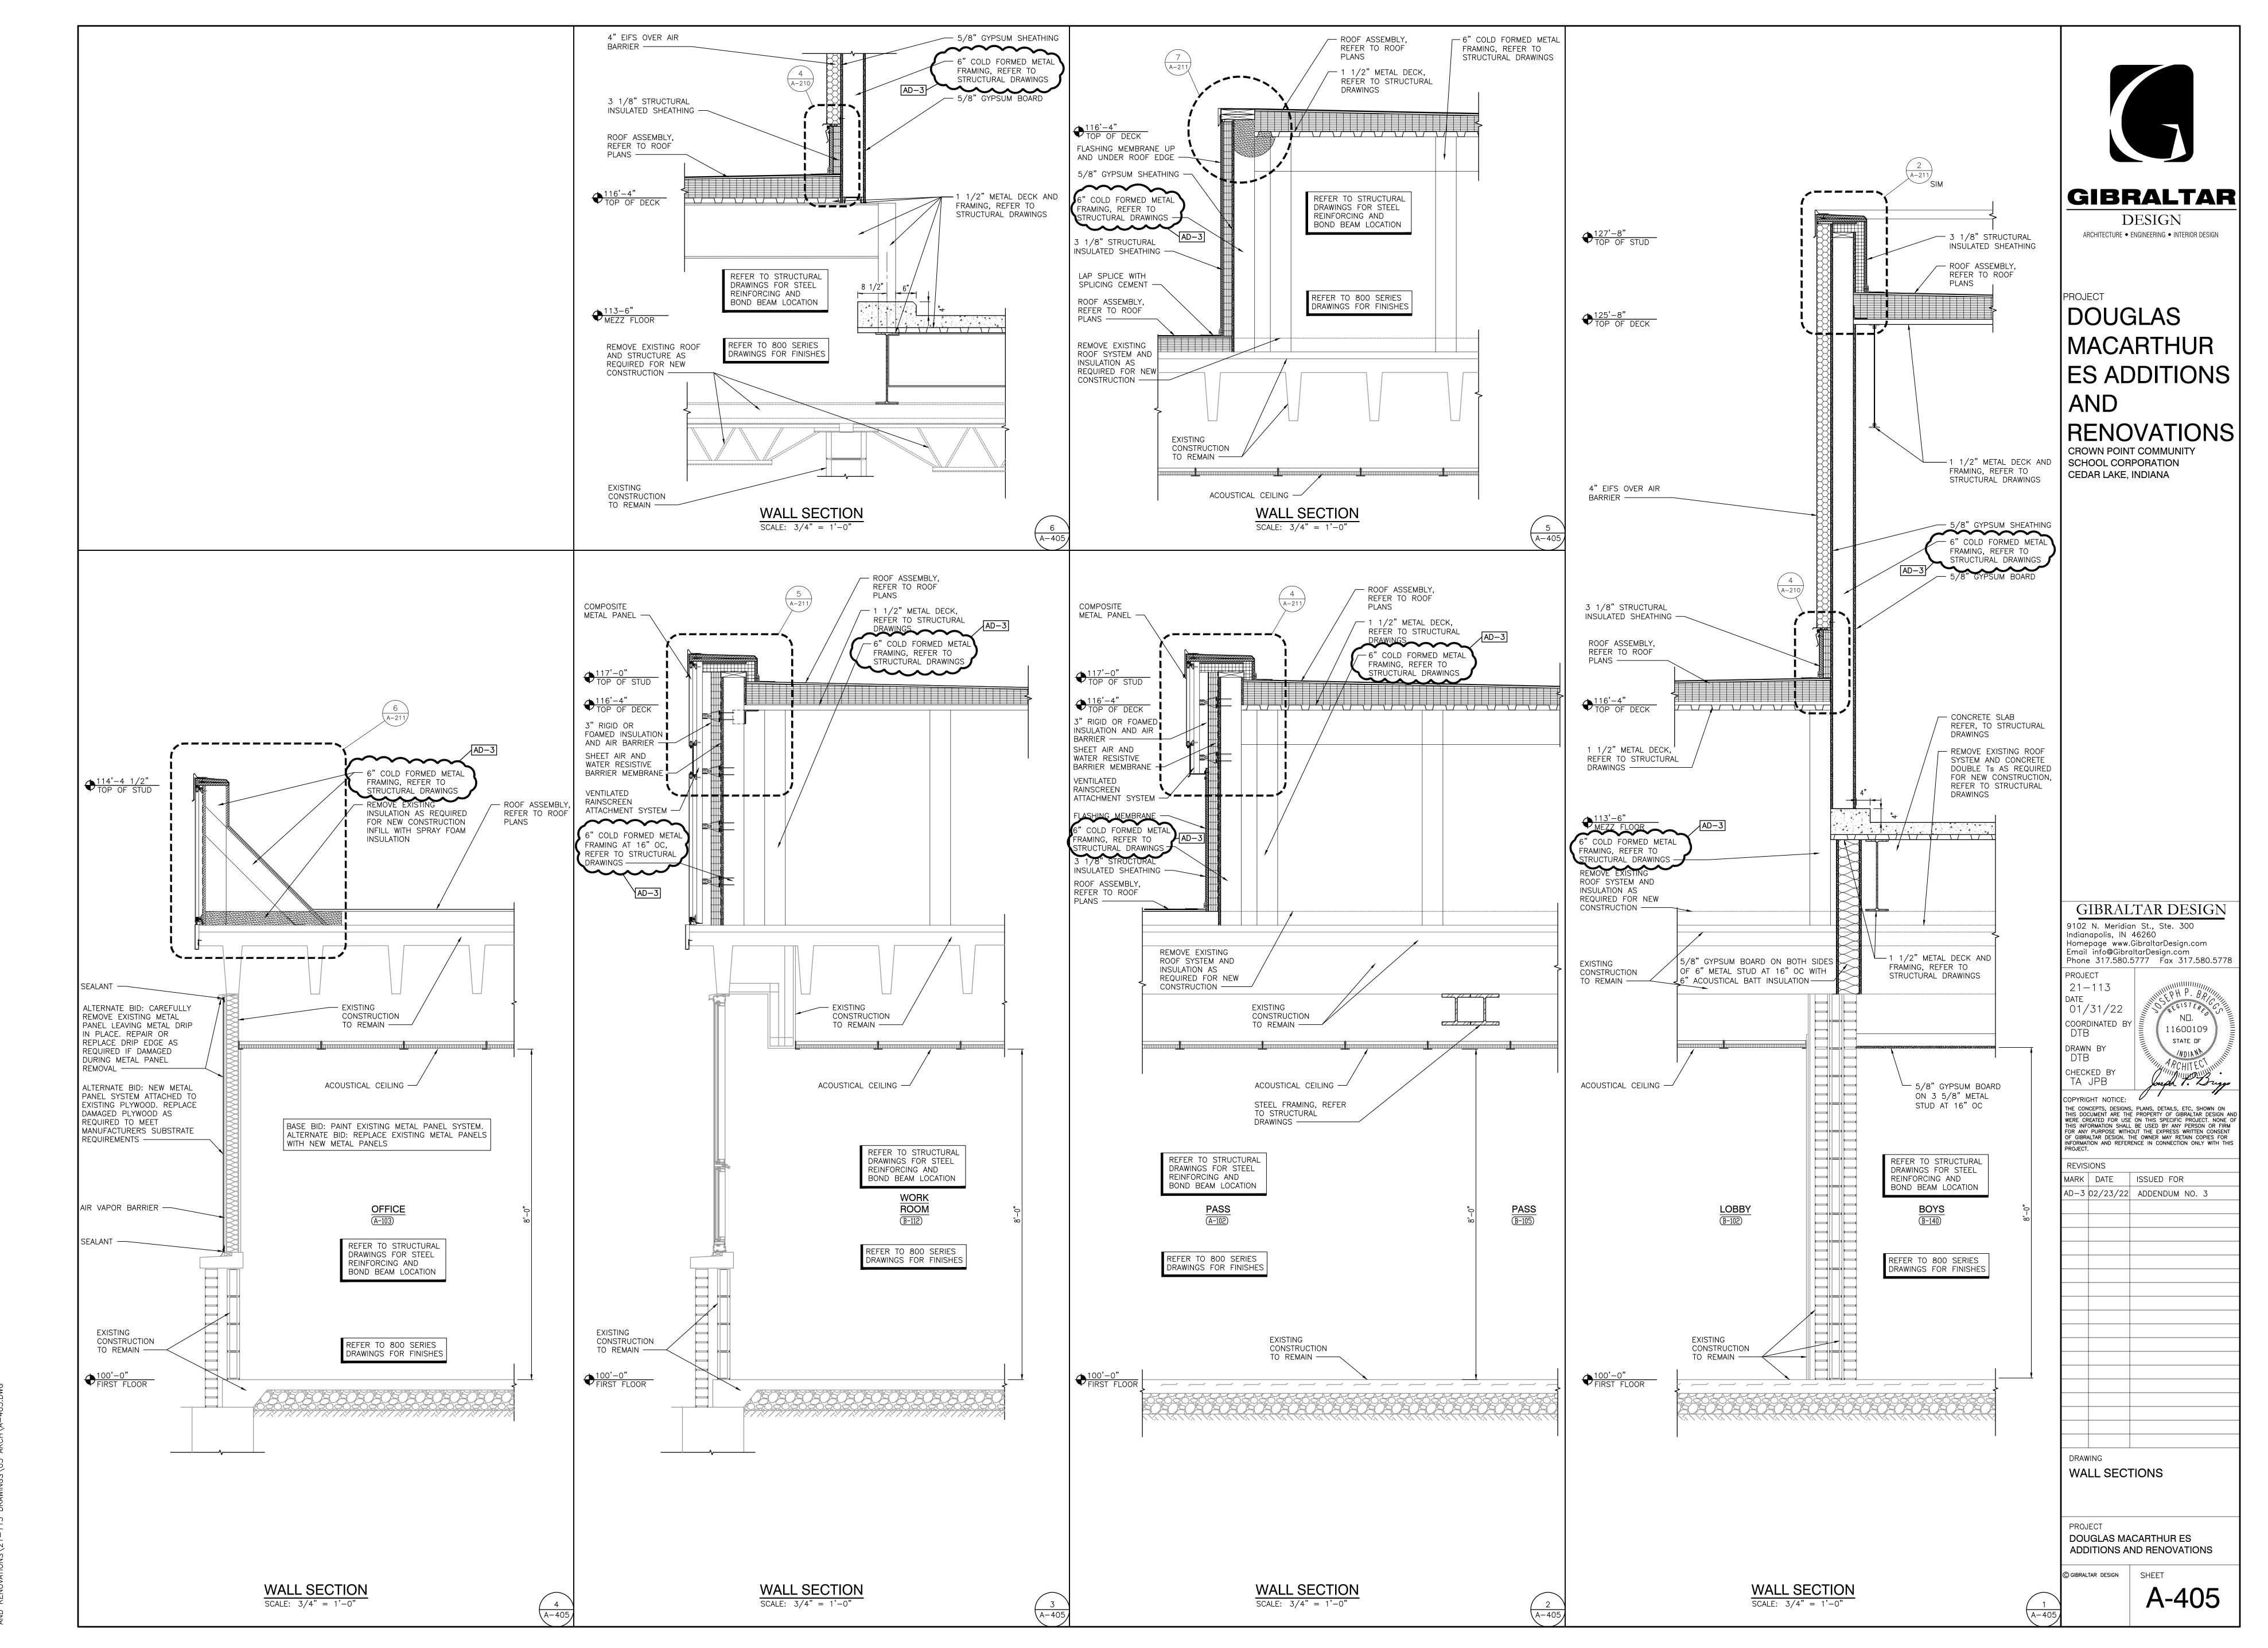


Thursday, 2/24/2022 — 9:28 AM — LAST SAVED BY:DBURNS Y:\21—113 CROWN POINT CSC — MACARTHUR ES ADDITION AND RENOVATIONS\21—113 DRAWINGS\05 ARCH\A—405.DWG

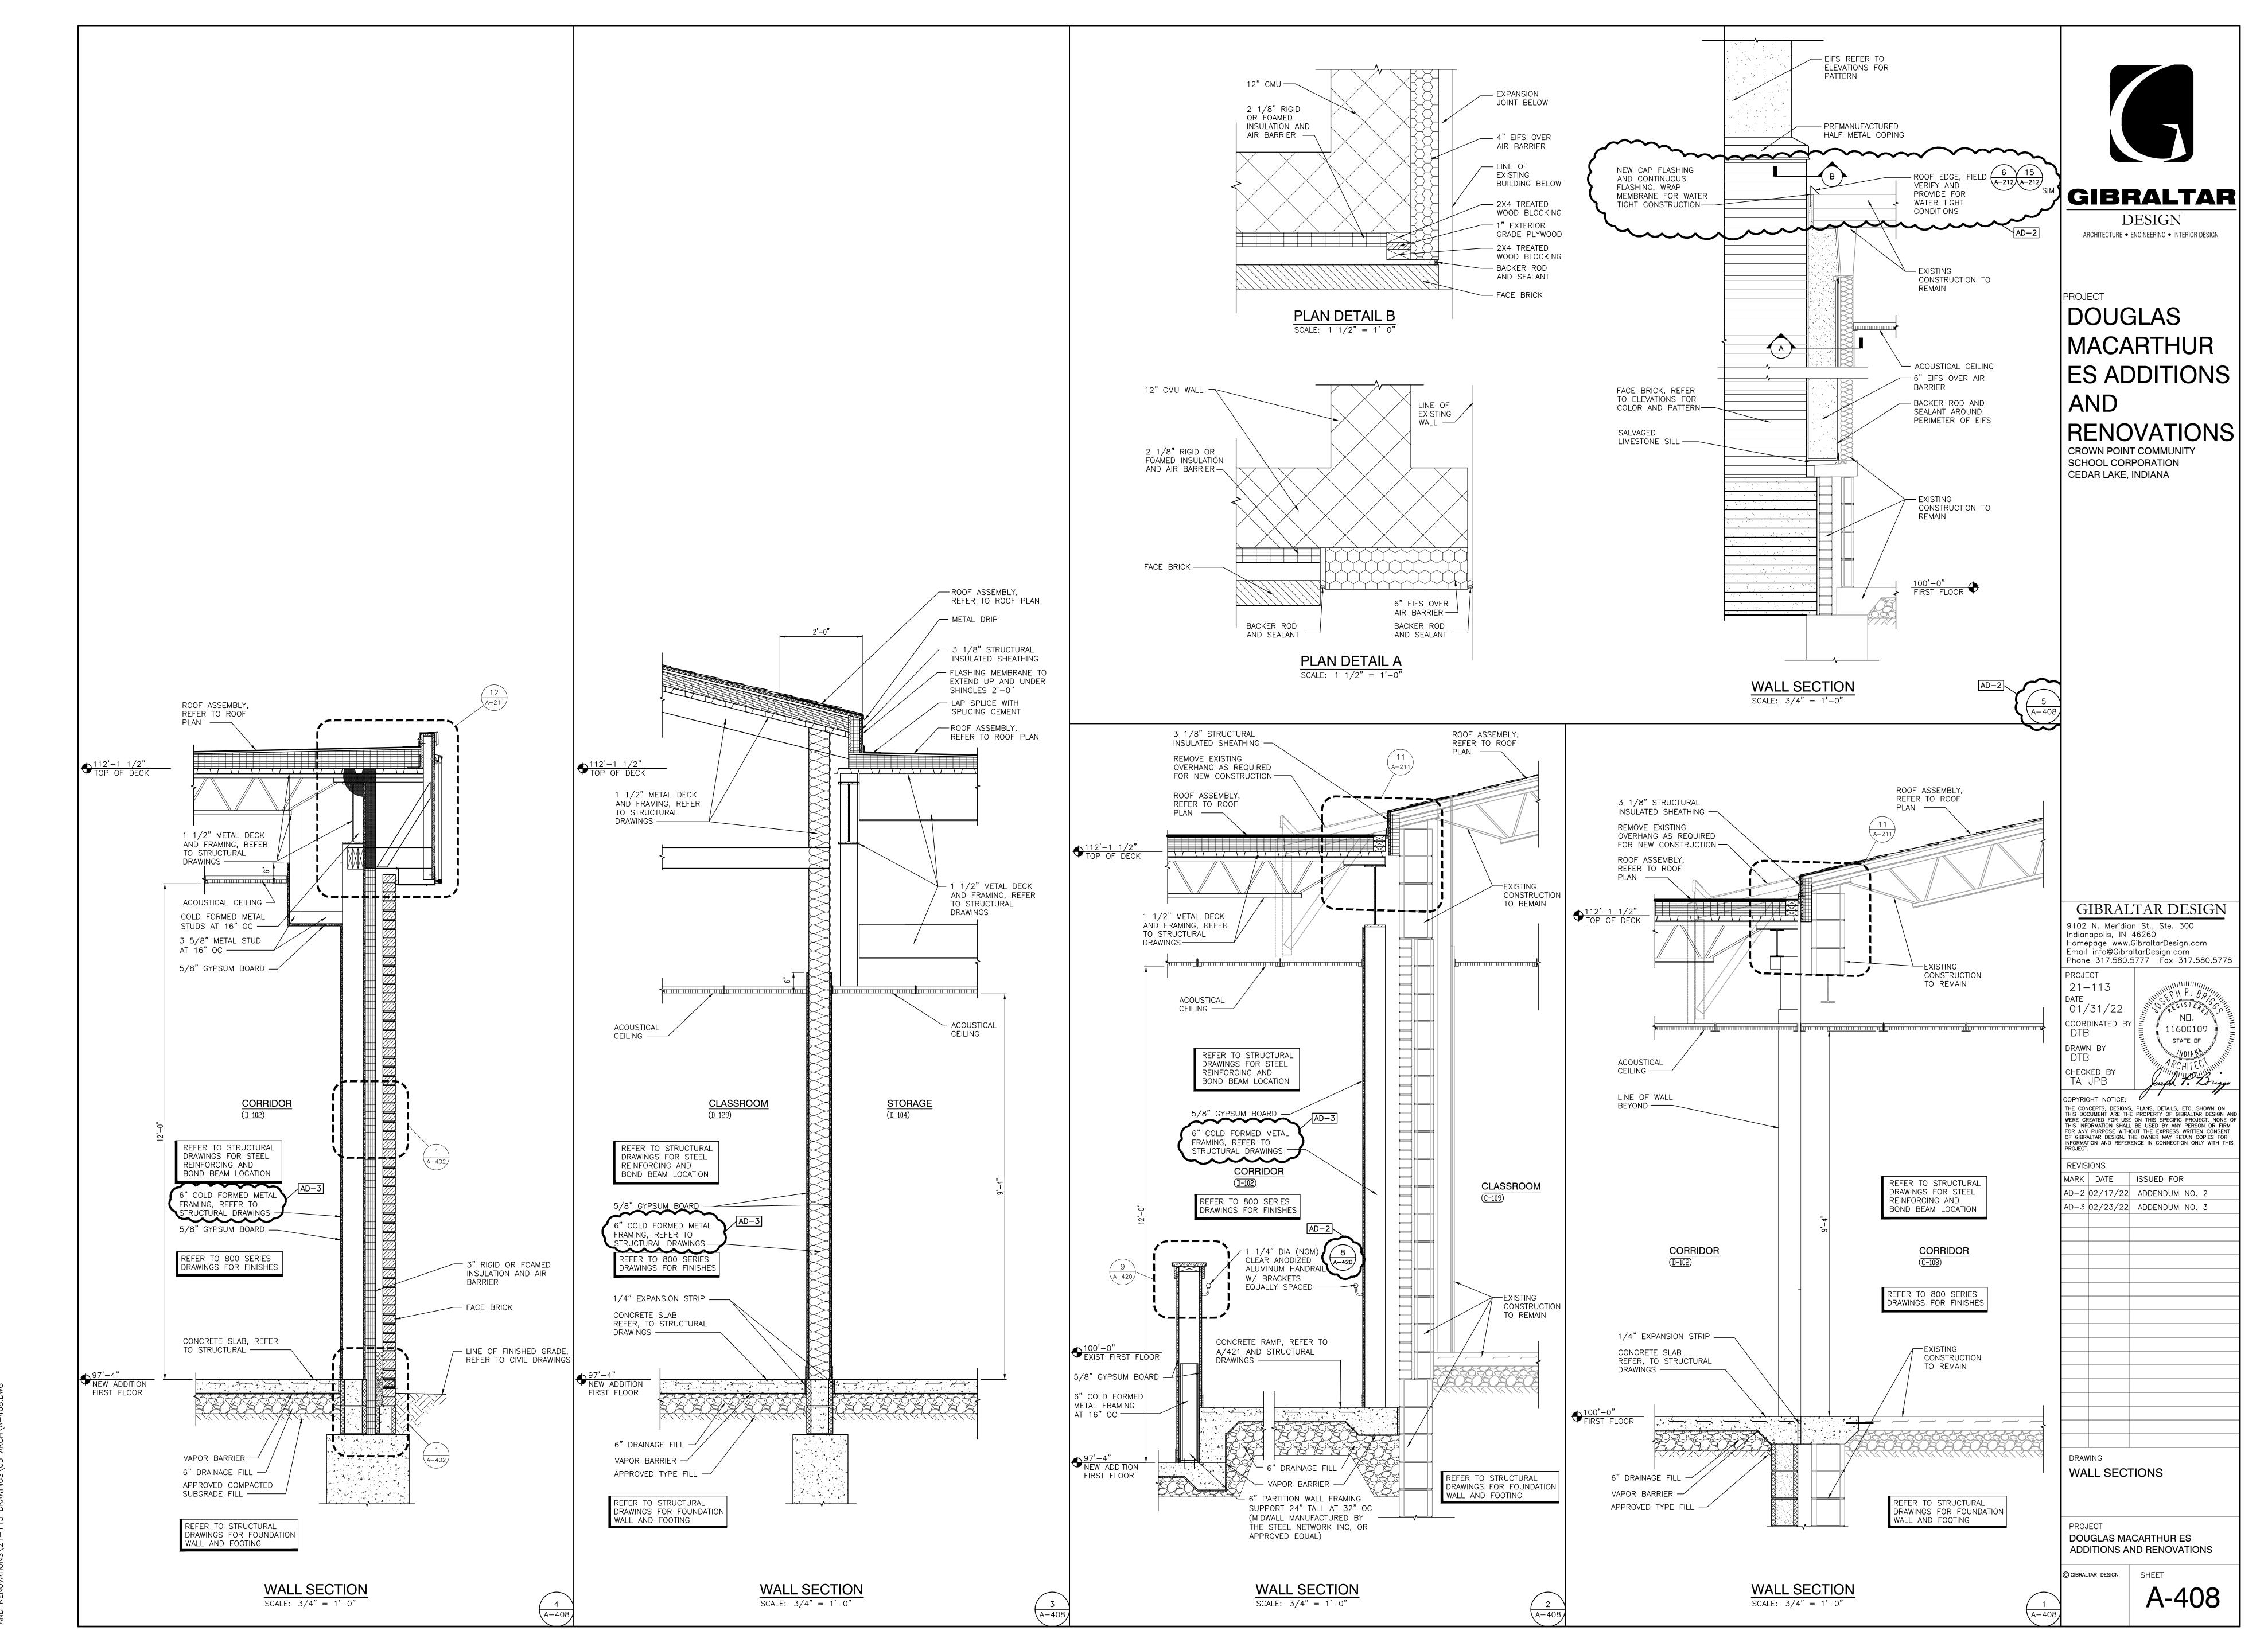


Thursday, 2/24/2022 — 9:29 AM — LAST SAVED BY:DBURNS Y:\21—113 CROWN POINT CSC — MACARTHUR ES ADDITION AND RENOVATIONS\21—113 DRAWINGS\05 ARCH\A—408.DWG

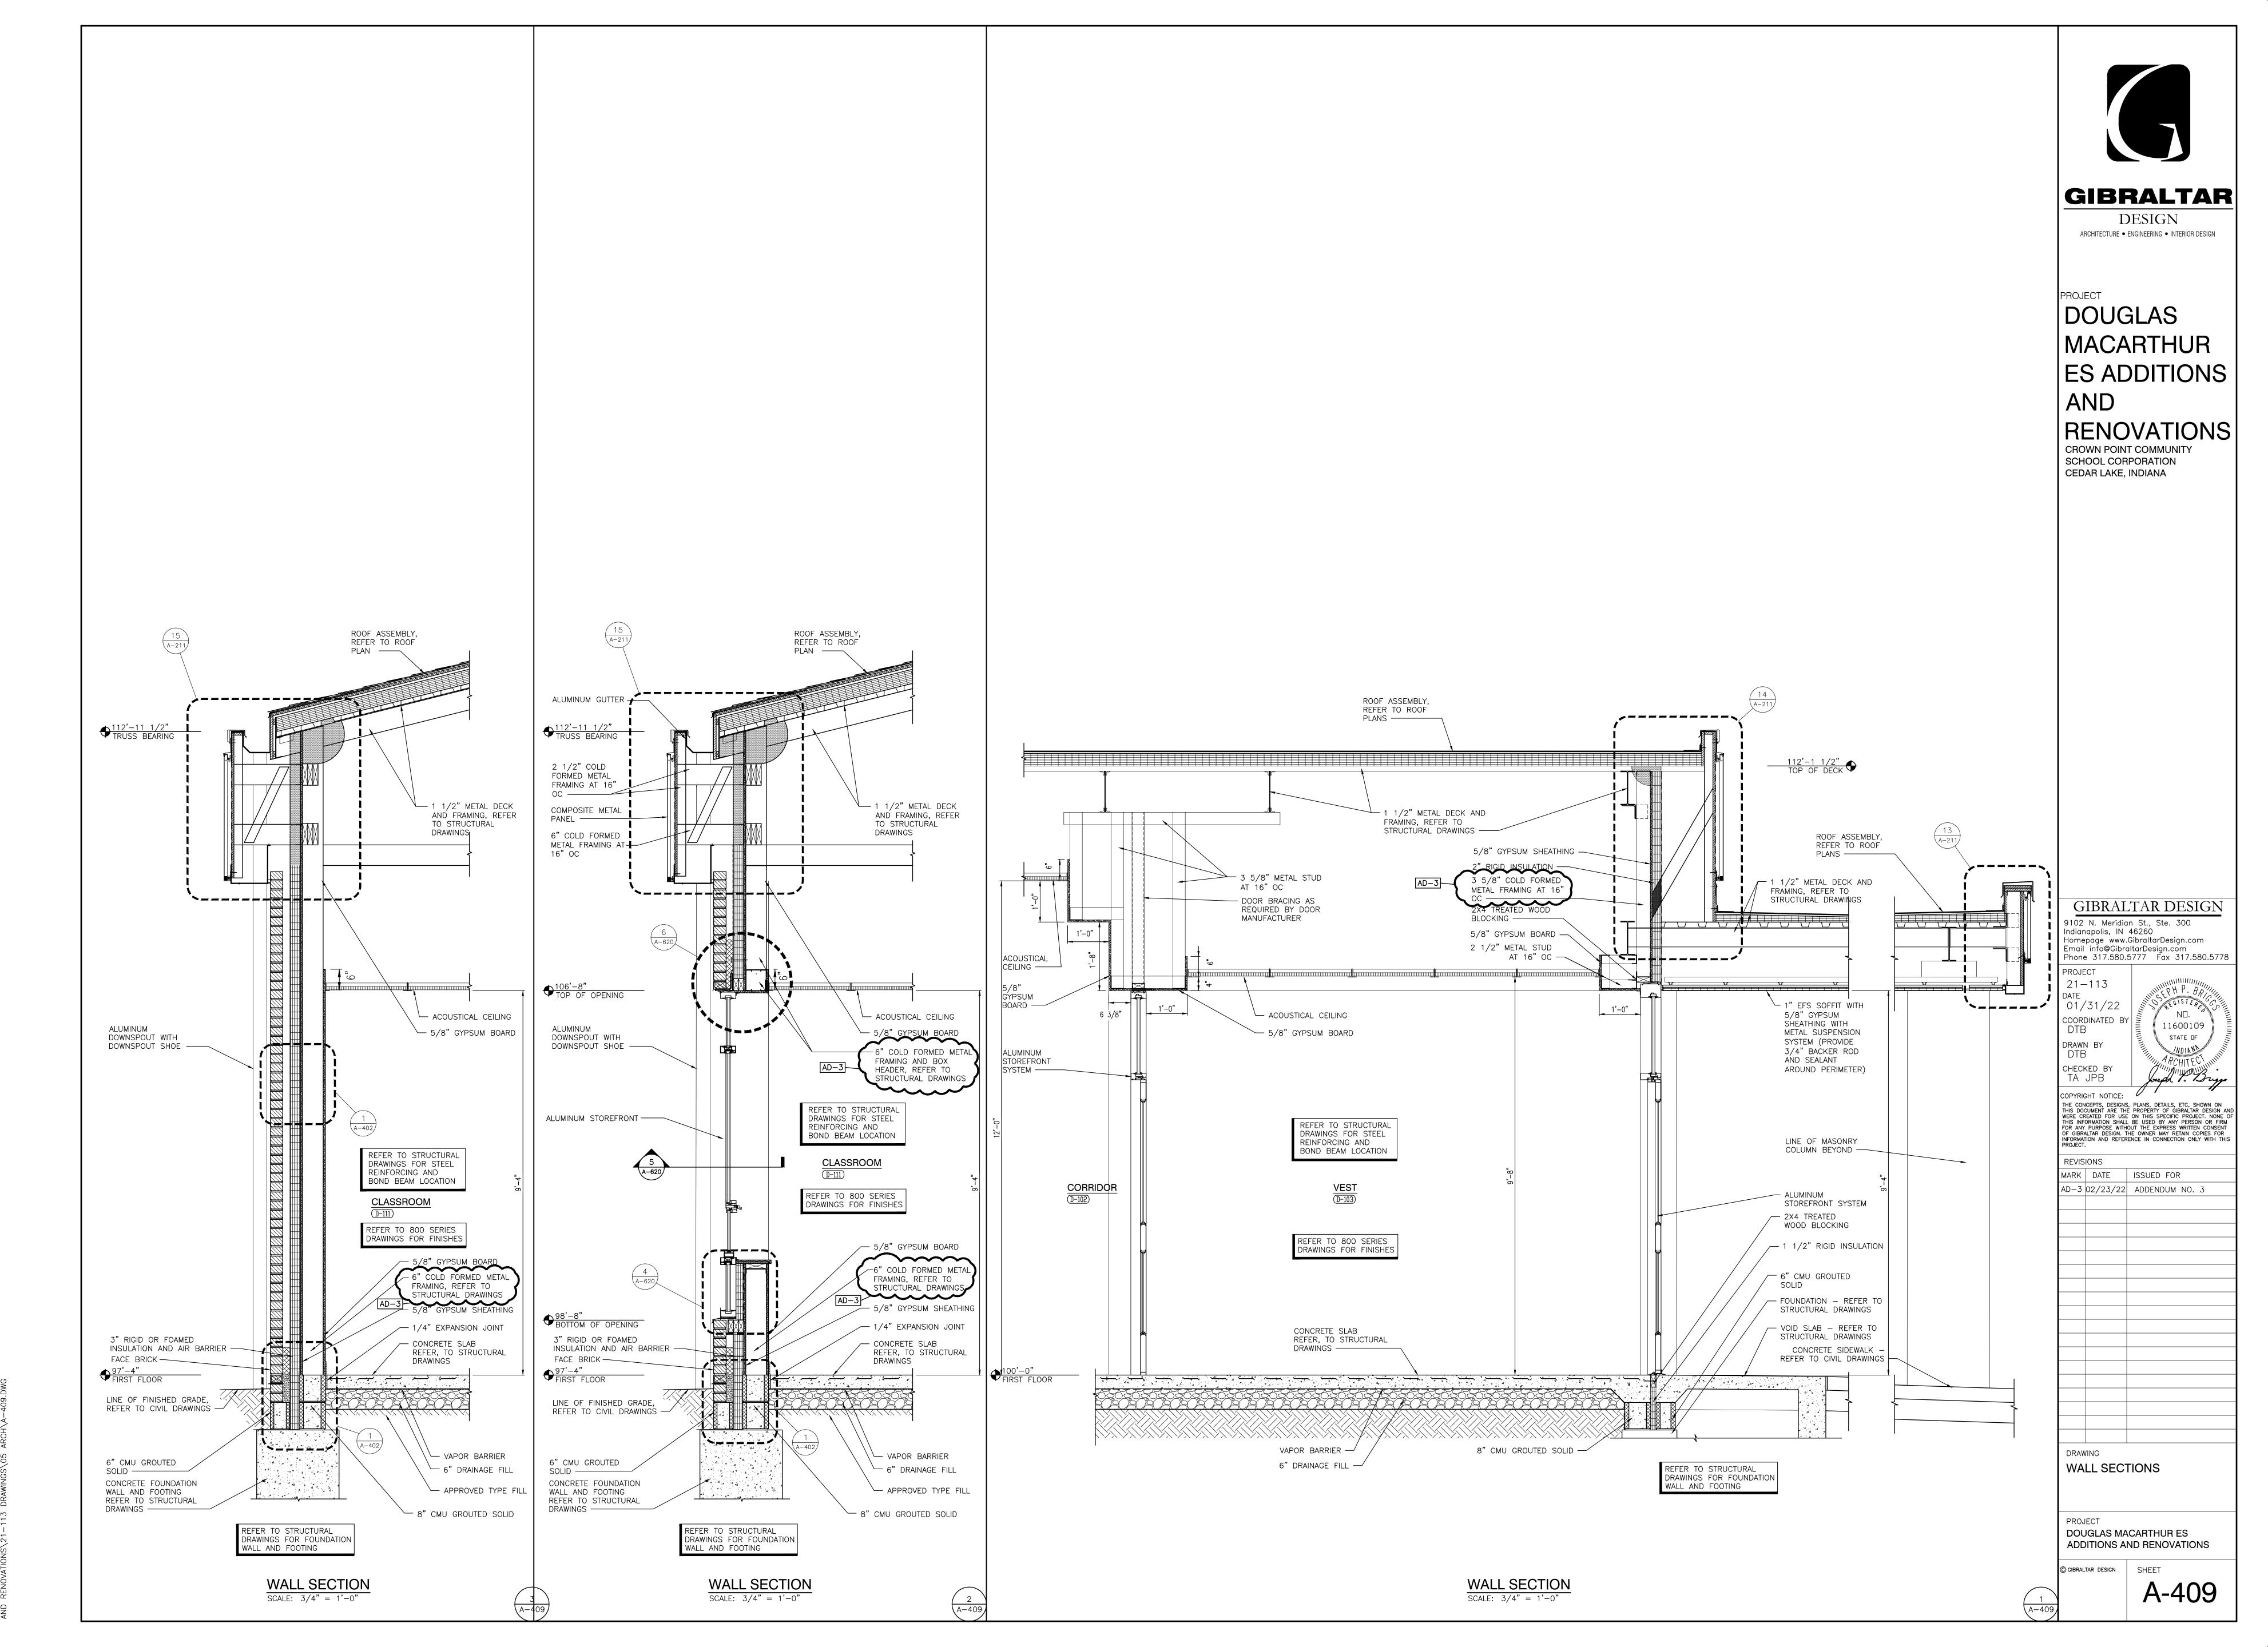


Thursday, 2/24/2022 — 9:27 AM — LAST SAVED BY:DBURNS Y:\21—113 CROWN POINT CSC — MACARTHUR ES ADDITION AND RENOVATIONS\21—113 DRAWINGS\05 ARCH\A—409.DWG

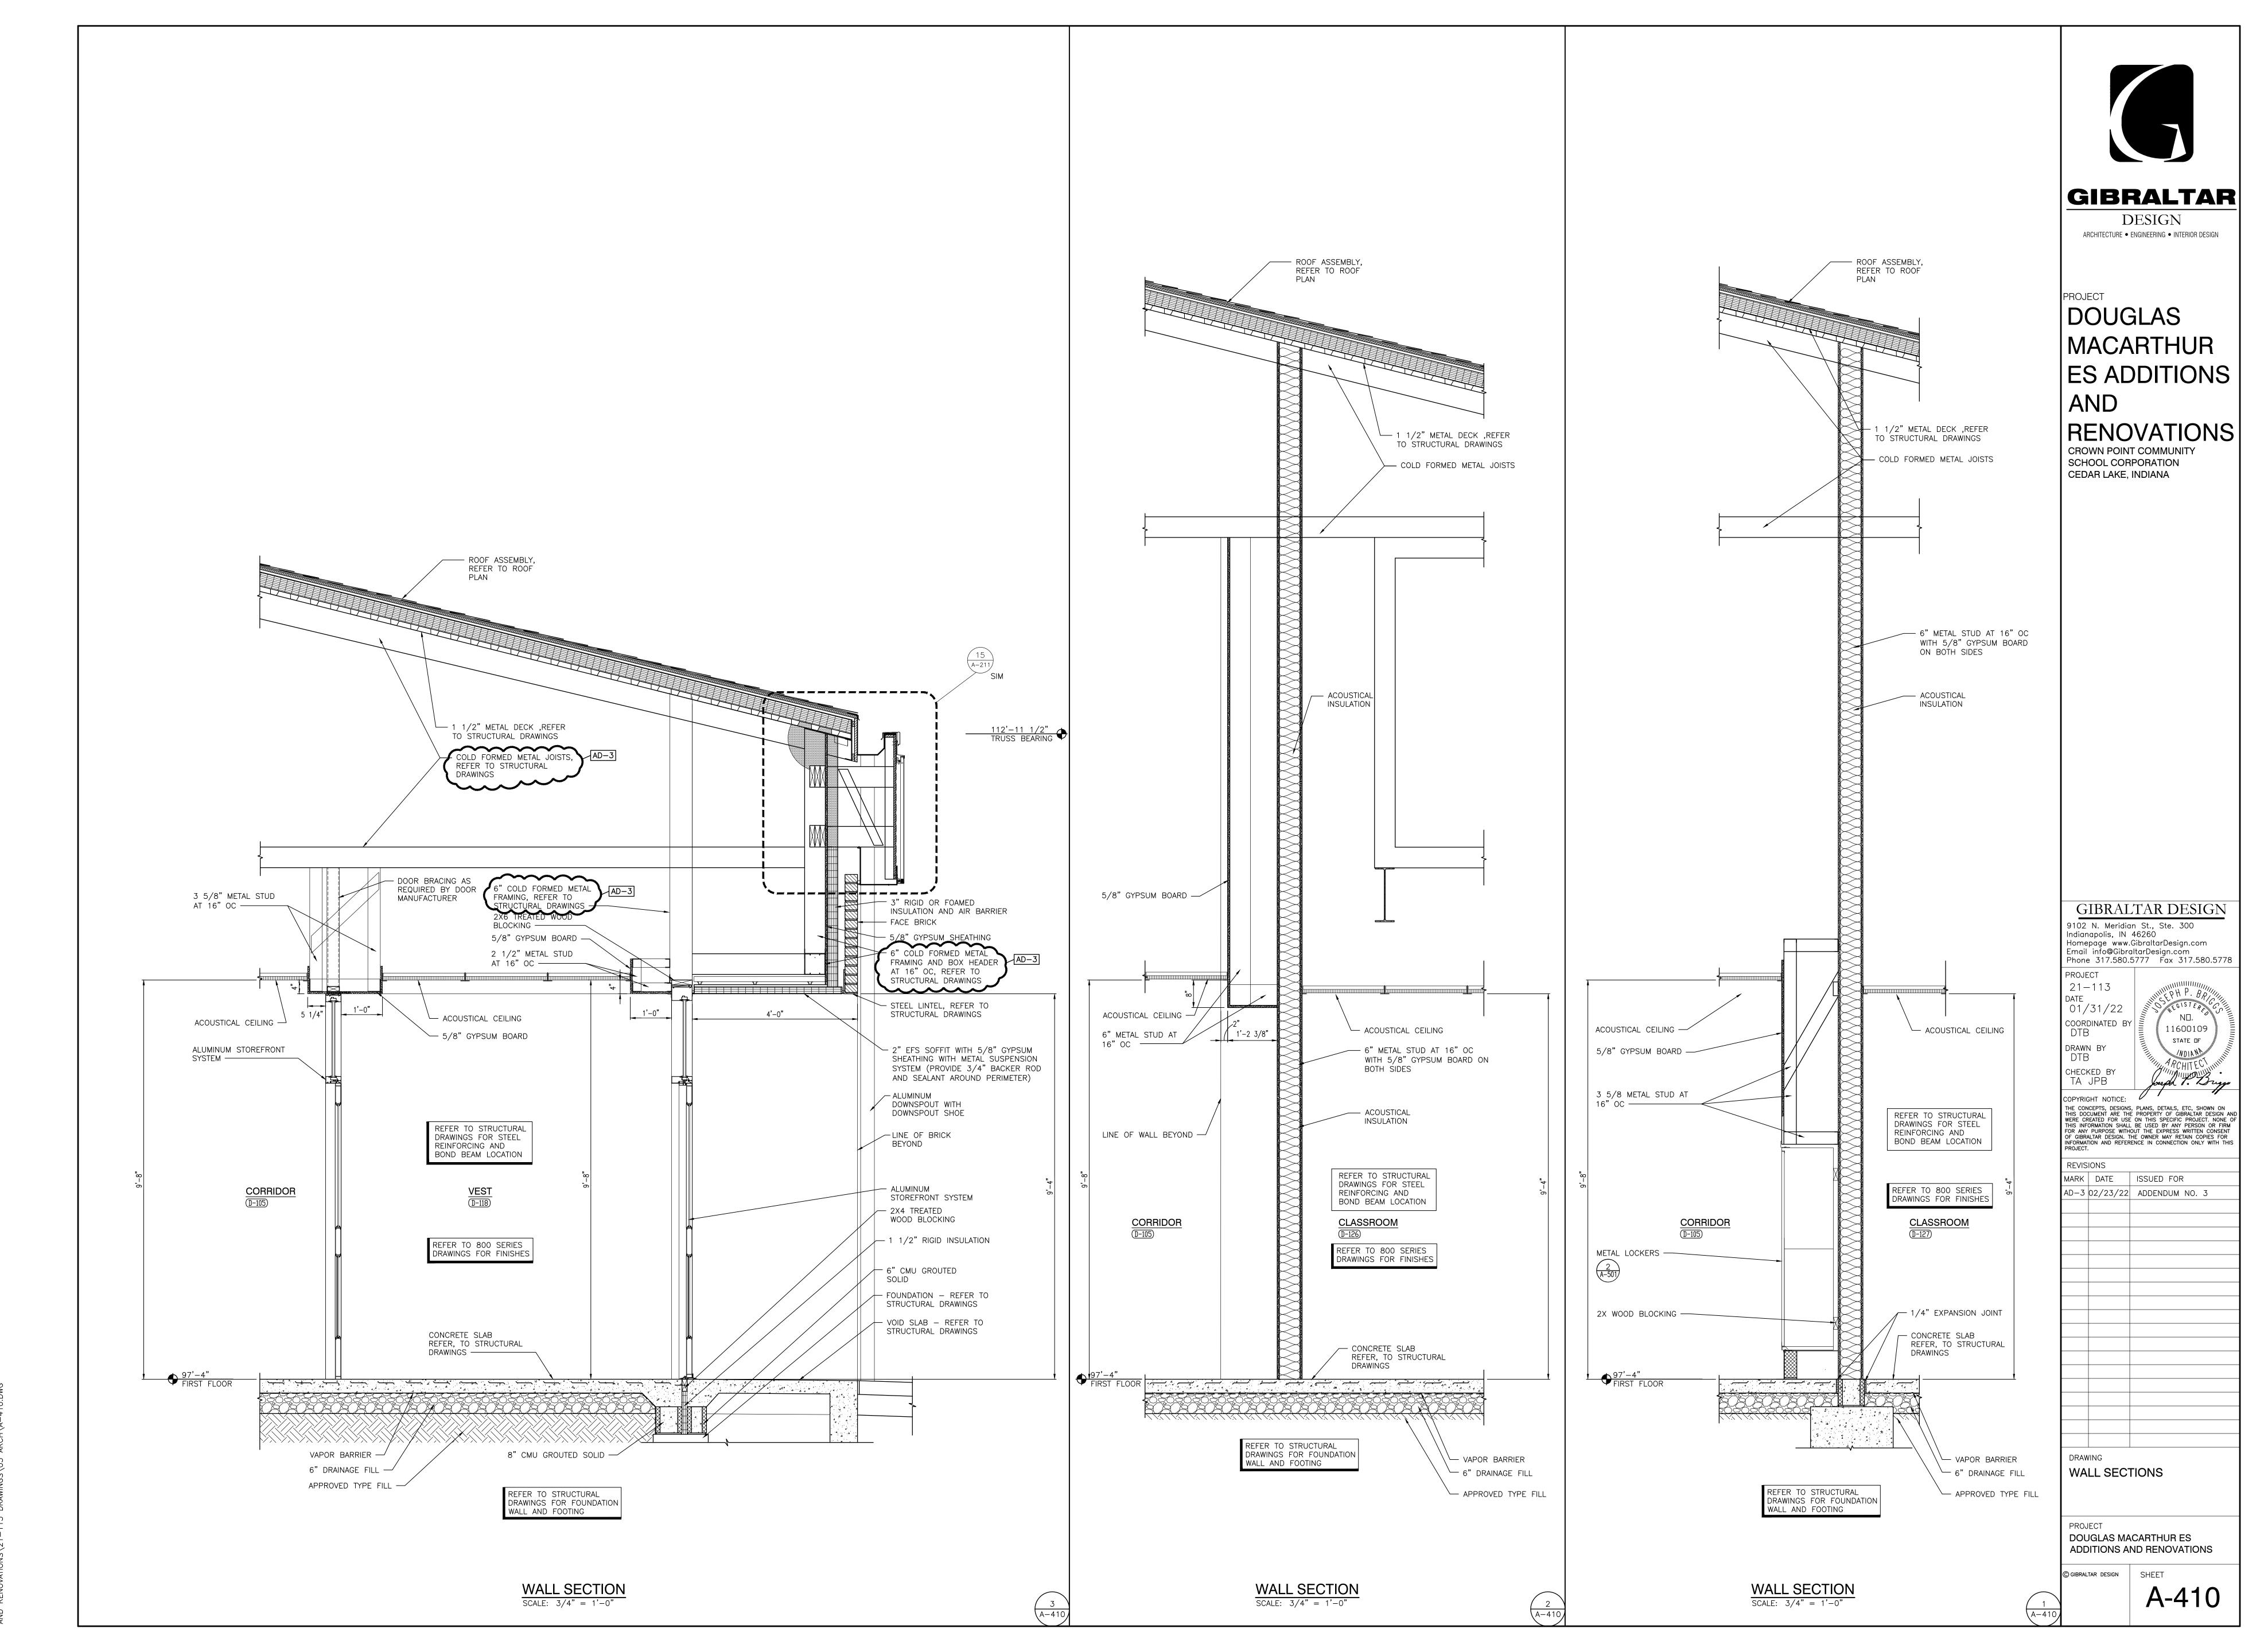


Thursday, 2/24/2022 — 9:29 AM — LAST SAVED BY:DBURNS Y:\21—113 CROWN POINT CSC — MACARTHUR ES ADDITION AND RENOVATIONS\21—113 DRAWINGS\05 ARCH\A—410.DWG

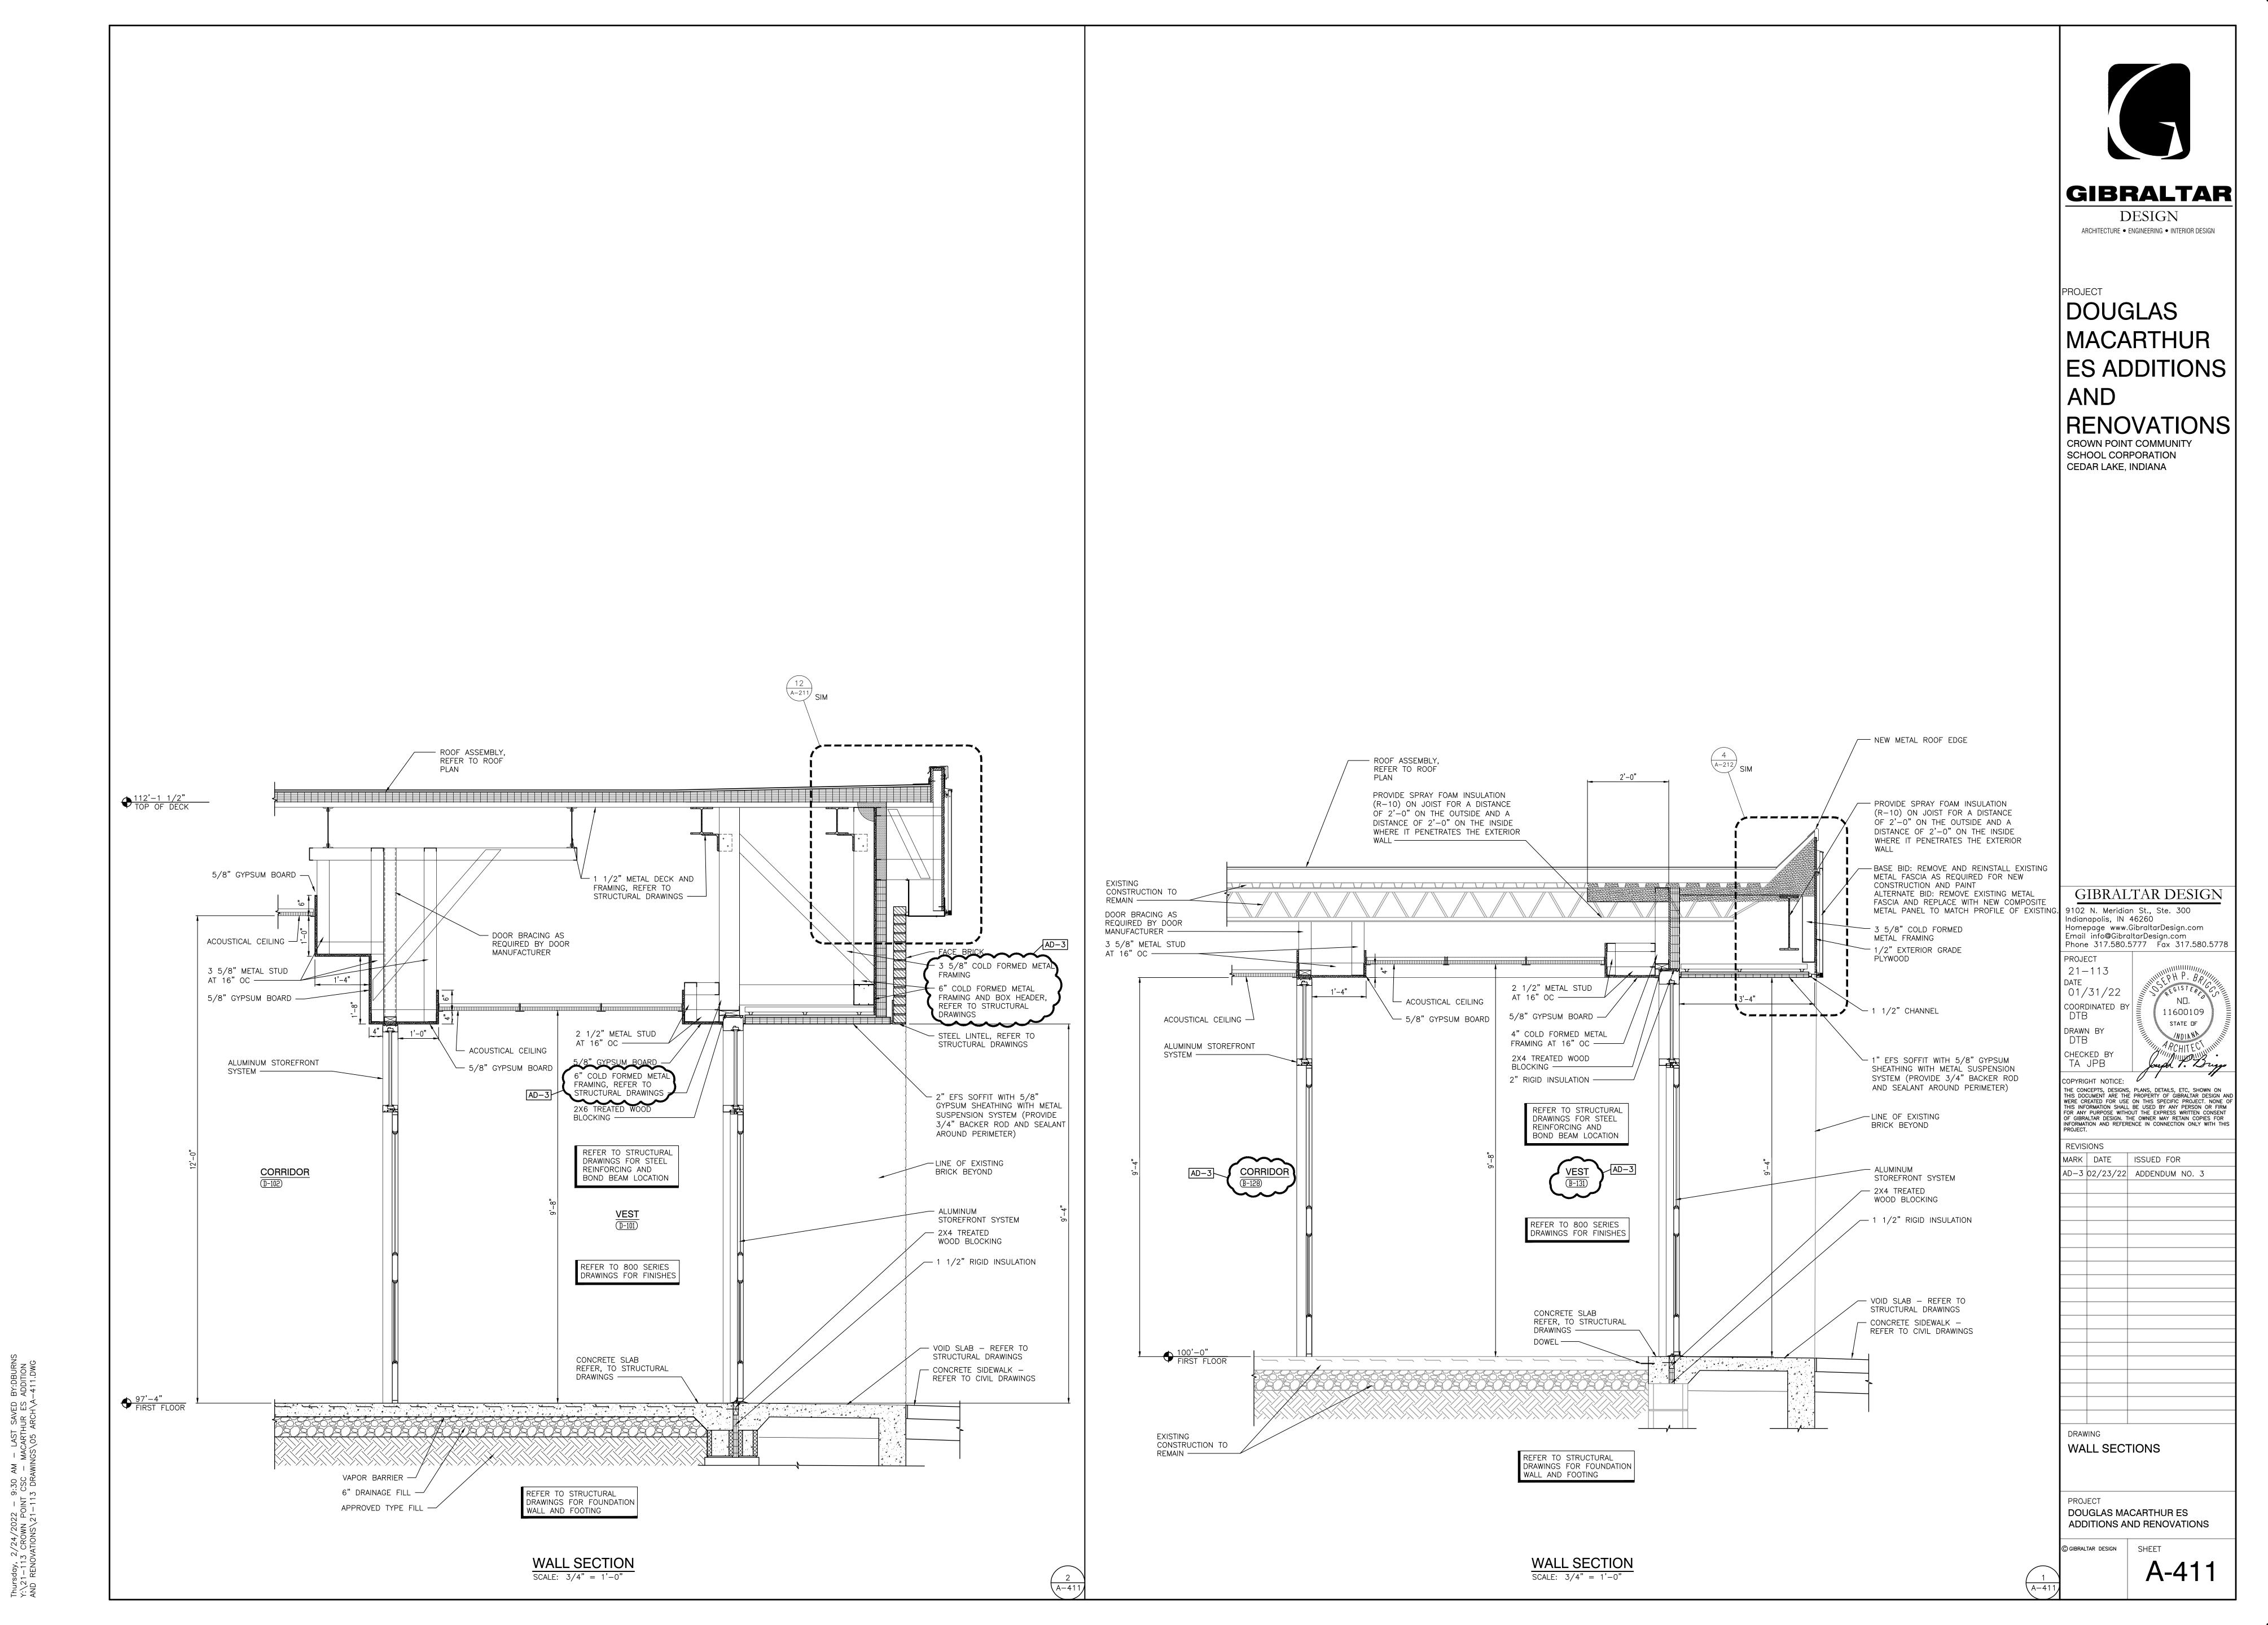

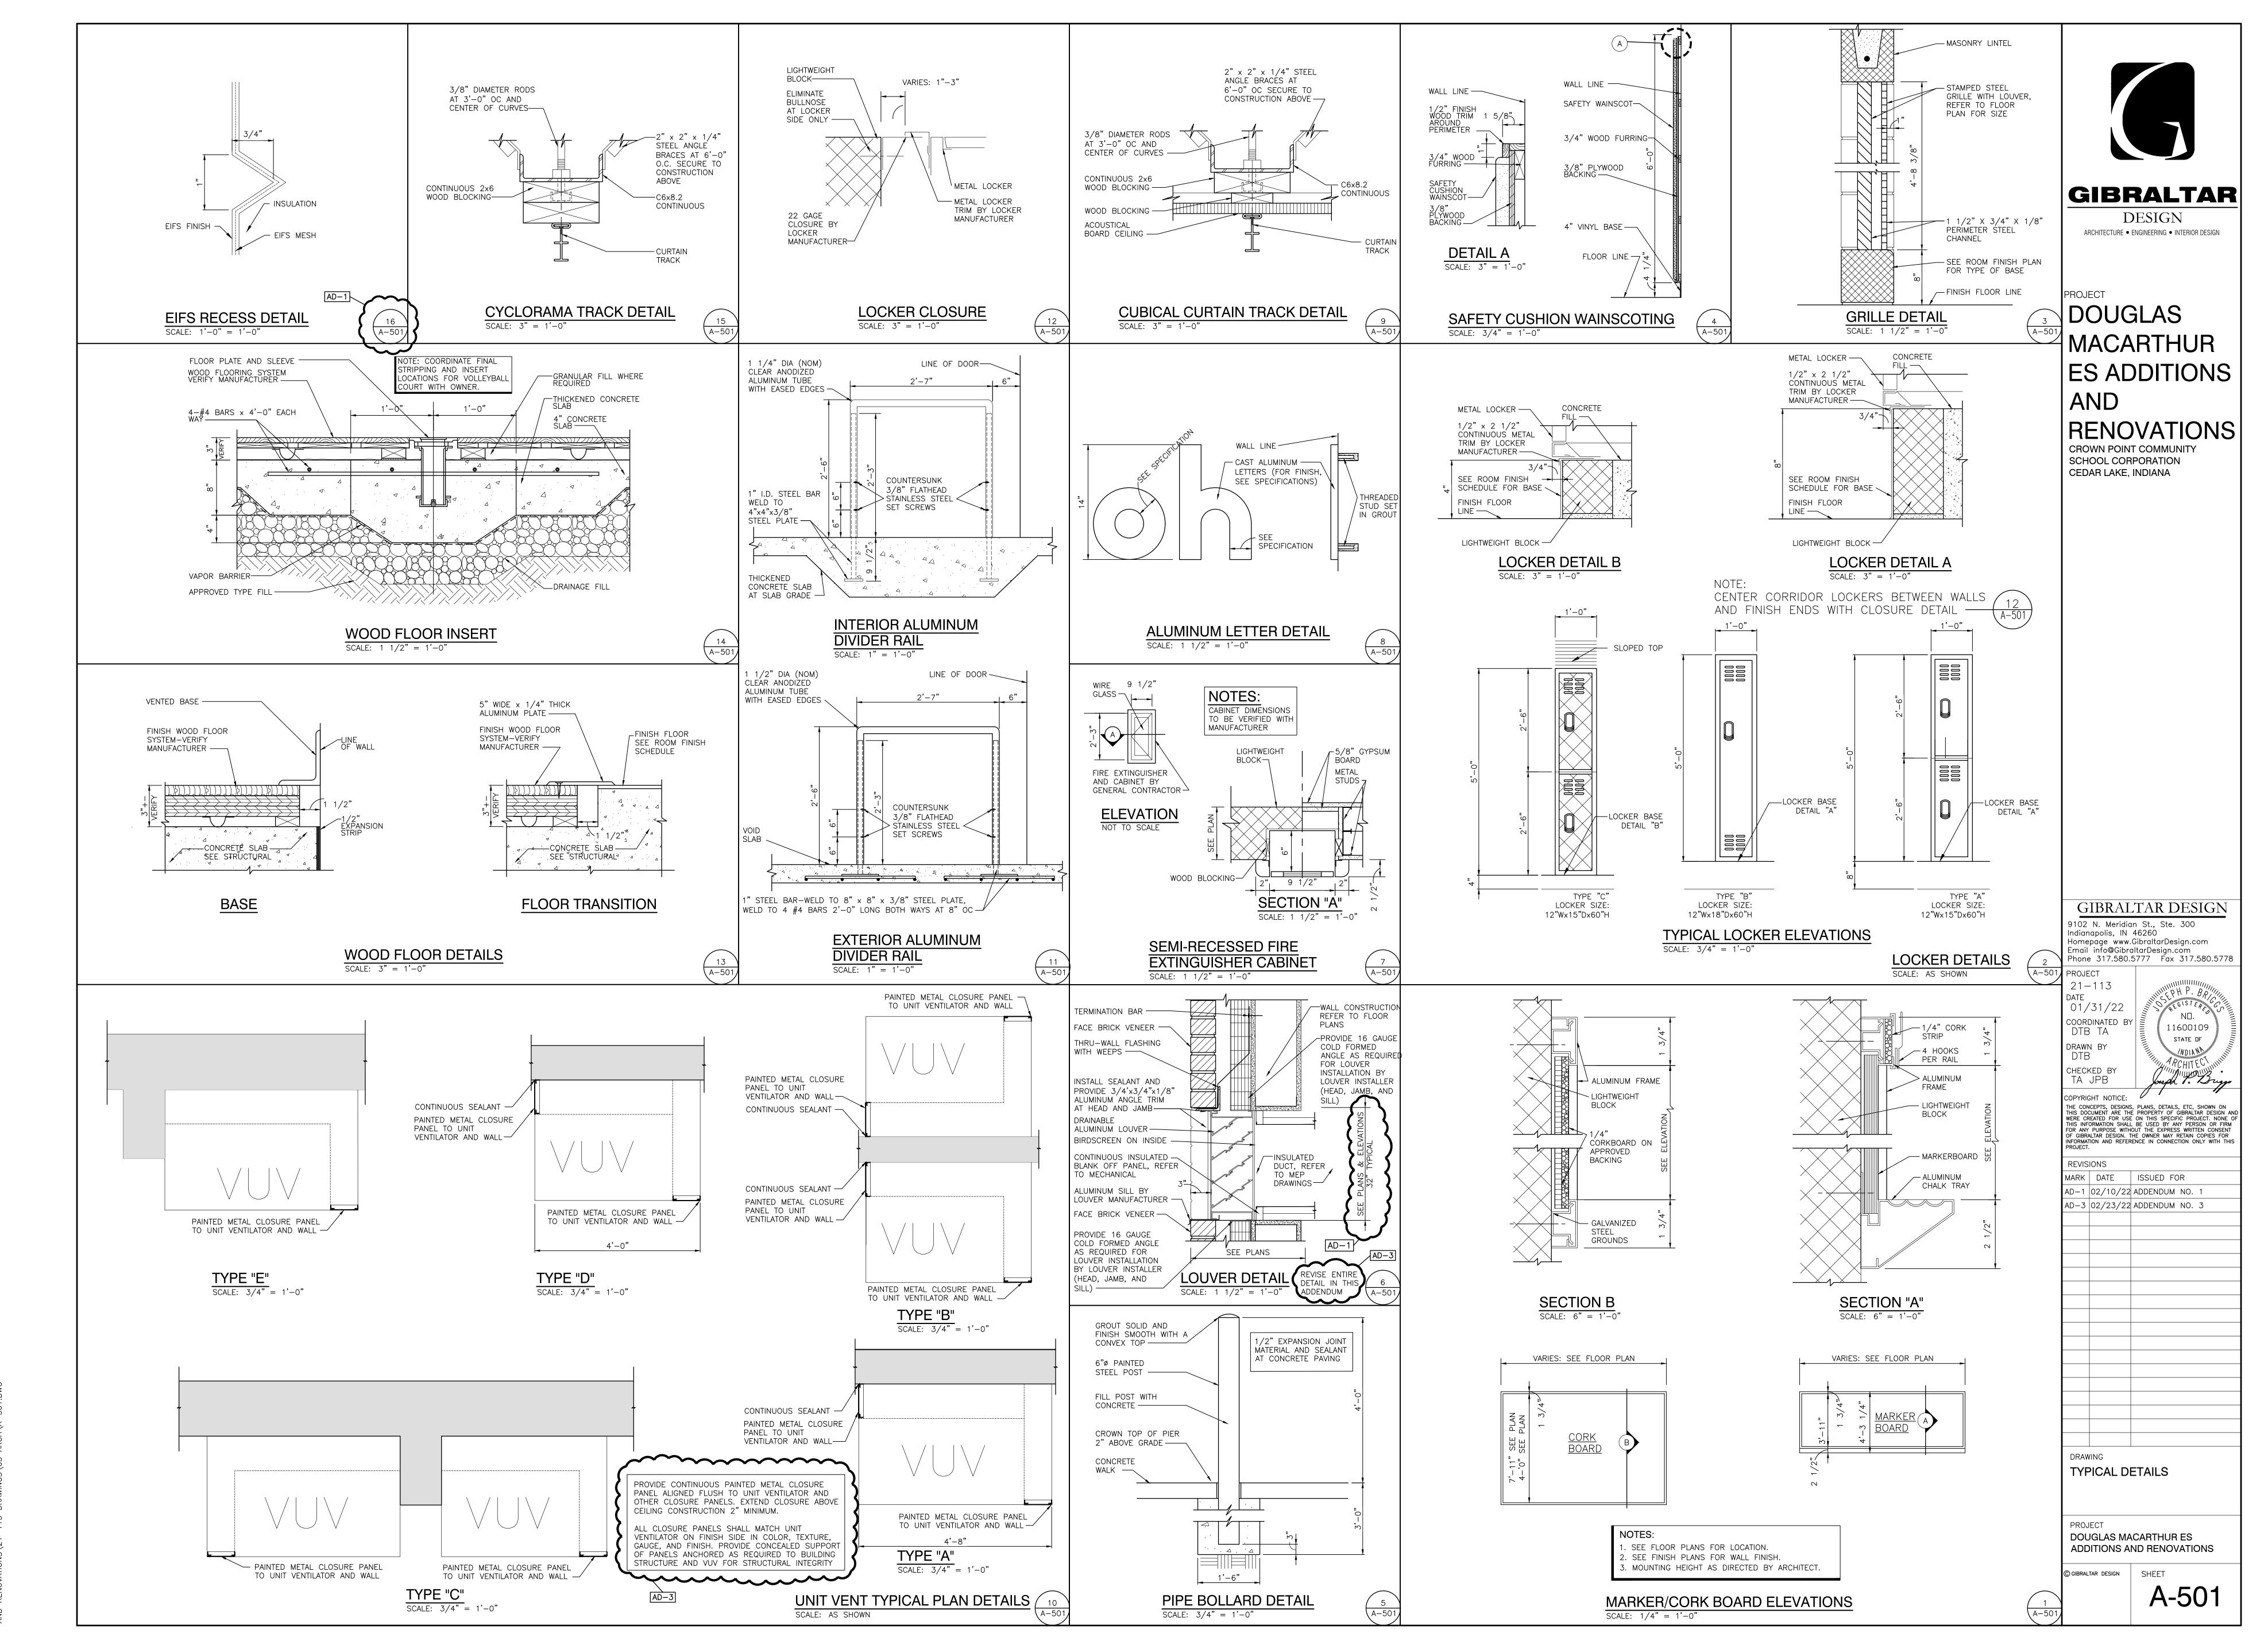

Thursday, 2/24/2022 — 2:34 PM — LAST SAVED BY:DBU Y:\21—113 CROWN POINT CSC — MACARTHUR ES ADDITIO AND RENOVATIONS\21—113 DRAWINGS\05 ARCH\A—501.D\

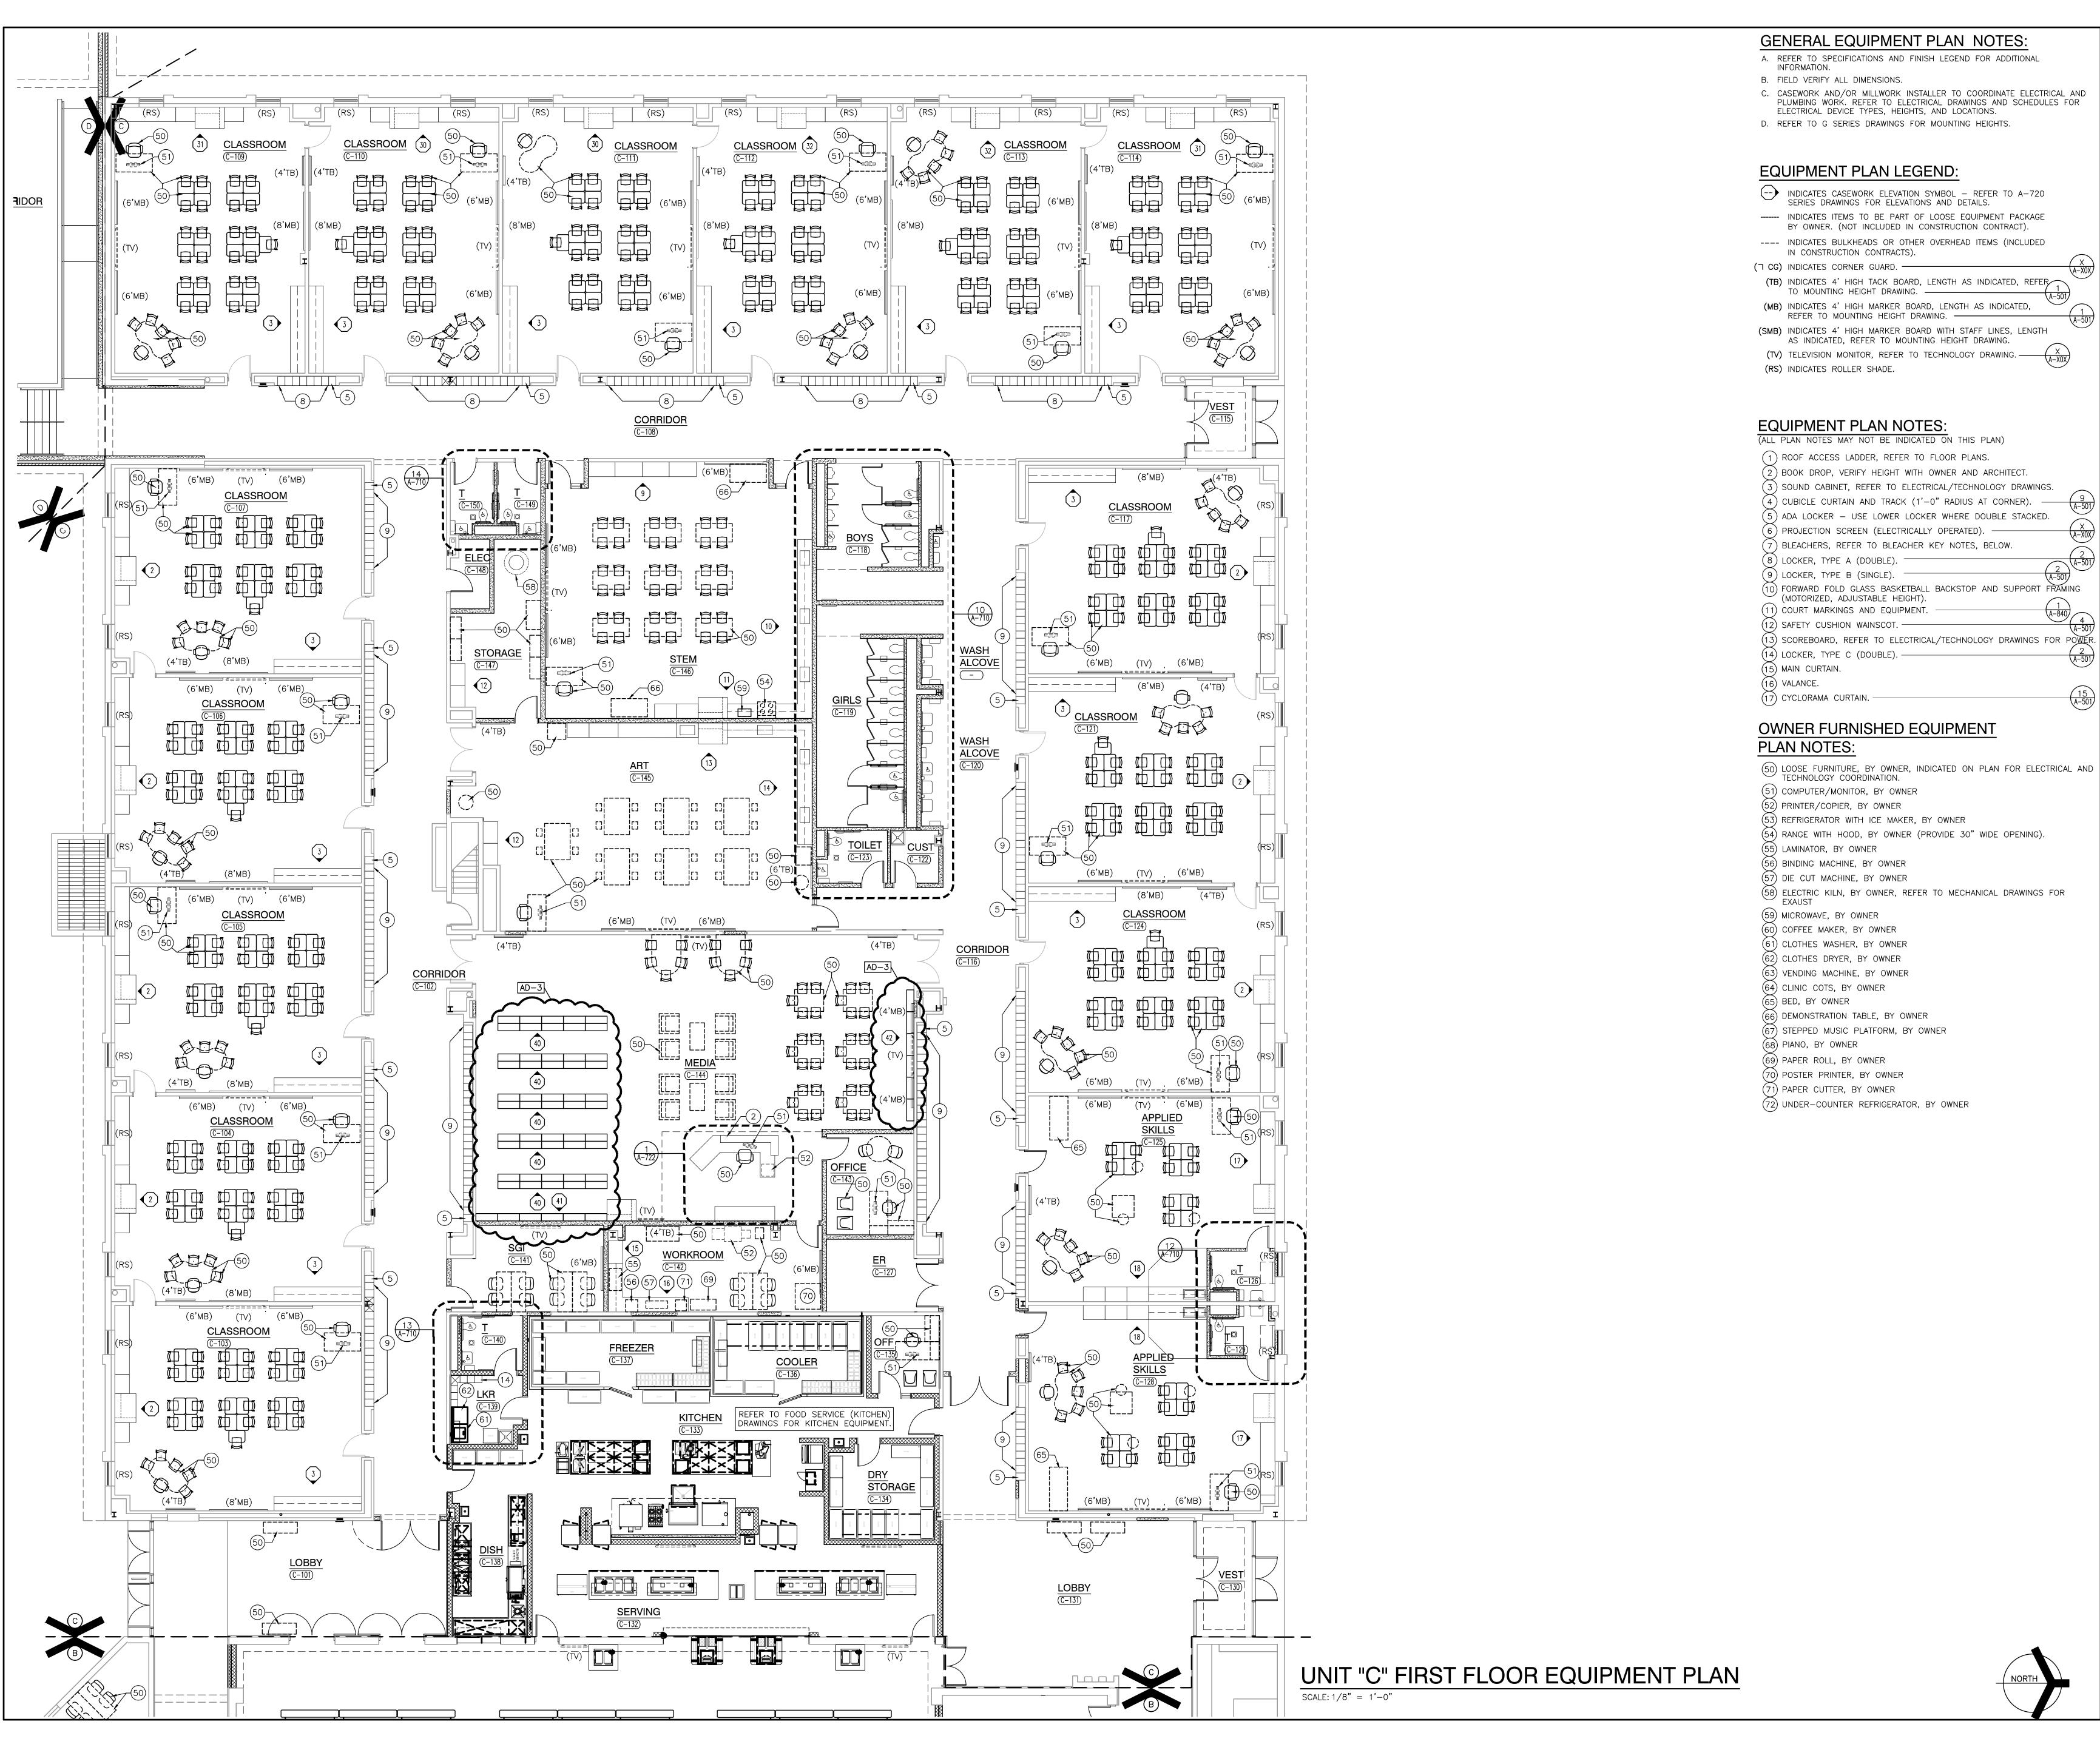

GIBRALTAR

DESIGN

ARCHITECTURE • ENGINEERING • INTERIOR DESIGN

DOUGLAS MACARTHUR ES ADDITIONS

RENOVATIONS
CROWN POINT COMMUNITY

SCHOOL CORPORATION

CEDAR LAKE, INDIANA

AB

KEY PLAN

11600109

STATE OF

GIBRALTAR DESIGN
9102 N. Meridian St., Ste. 300
Indianapolis, IN 46260
Homepage www.GibraltarDesign.com
Email info@GibraltarDesign.com
Phone 317.580.5777 Fax 317.580.5778

PROJECT
21-113
DATE
01/31/22

COORDINATED BY
TA

DRAWN BY
EKM MMM
CHECKED BY

CHECKED BY
NAS

COPYRIGHT NOTICE:

THE CONCEPTS, DESIGNS, PLANS, DETAILS, ETC, SHOWN ON THIS DOCUMENT ARE THE PROPERTY OF GIBRALTAR DESIGN A WERE CREATED FOR USE ON THIS SPECIFIC PROJECT. NONE THIS INFORMATION SHALL BE USED BY ANY PERSON OR FIRM FOR ANY PURPOSE WITHOUT THE EXPRESS WRITTEN CONSENT OF GIBRALTAR DESIGN. THE OWNER MAY RETAIN COPIES FOR INFORMATION AND REFERENCE IN CONNECTION ONLY WITH THIS PROJECT.

REVISIONS

MARK DATE ISSUED FOR

AD-3 02/23/22 ADDENDUM NO. 3

AD-3 02/23/22 ADDENDUM NO. 3

INO

UNIT "C" FIRST FLOOR
EQUIPMENT PLAN

PROJECT

DOUGLAS MACARTHUR ES

ADDITIONS AND RENOVATIONS


BRALTAR DESIGN S

A-703


GENERAL SYMBOL LEGEND	DRAWING SHEET INDEX	GENERAL DRAWING SET NOTES	
EQUIPMENT ITEM NUMBER	SHEET DRAWING NAME K100 FOODSERVICE EQUIPMENT GENERAL NOTES & SHEET INDEX K101 FOODSERVICE EQUIPMENT PLAN & SCHEDULE K102 FOODSERVICE EQUIPMENT SPECIAL CONDITIONS PLAN K200 FOODSERVICE EQUIPMENT SPOT LOCATION SCHEDULES K300 FOODSERVICE EQUIPMENT PLUMBING PLAN	1. THESE DRAWINGS HAVE BEEN PRODUCED USING A GENERAL ARRANGEMENT OF EQUIPMENT FROM ONLY THE INFORMATION THAT WAS MADE AVAILABLE. THESE DRAWINGS ARE INFORMATIONAL BY NATURE FOR BIDDING PURPOSES ONLY AND ARE NOT TO BE USED IN ANY WAY FOR CONSTRUCTION. REITANO DESIGN GROUP ASSUMES NO RESPONSIBILITY FOR THE ACCURACY OF MEASUREMENTS TAKEN FROM THESE DRAWINGS. FABRICATORS, CONTRACTORS AND OTHER PARTIES UTILIZING THESE PLANS, IN CONNECTION WITH THIS JOB, ARE RESPONSIBLE FOR SECURING THEIR OWN MEASUREMENTS. 2. THE KITCHEN EQUIPMENT CONTRACTOR IS RESPONSIBLE TO REVIEW THE PLANS FOR ACCURACY AND VERIFY ALL	
ENLARGED PLAN CALL OUT	K301 FOODSERVICE EQUIPMENT ELECTRICAL PLAN K400 WALK-IN COOLER/FREEZER DRAWING, DETAILS & SCHEDULE K500 EXHAUST VENTILATION SYSTEM DRAWING, DETAILS & SCHEDULE	DIMENSIONS AND EXISTING CONDITIONS PRIOR TO THE FABRICATION OF ANY EQUIPMENT. VERIFY ALL EQUIPMENT CLEARANCES THRU BUILDING DOORS, HALLWAYS OR ENTRY POINTS AS NOT ALL EQUIPMENT WILL FIT THRU STANDARD OPENINGS. THE KITCHEN EQUIPMENT CONTRACTOR IS TO NOTIFY REITANO DESIGN GROUP OF ANY ERRORS, OMISSIONS, AMBIGUITIES, DISCREPANCIES OR IRREGULARITIES PRIOR TO START OF CONSTRUCTION.	GIBRALTA
EQUIPMENT ELEVATION CALL OUT	K501 EXHAUST VENTILATION SYSTEM DRAWING, DETAILS & SCHEDULE K600 FOODSERVICE EQUIPMENT DETAILS, ELEVATIONS & SECTIONS K601 FOODSERVICE EQUIPMENT DETAILS, ELEVATIONS & SECTIONS K602 FOODSERVICE EQUIPMENT DETAILS, ELEVATIONS & SECTIONS	 THESE DRAWINGS AND ACCOMPANYING SPECIFICATIONS MUST BE CONSIDERED A COMPLETE BODY OF WORK. ALL WORK IS TO BE COMPLETED IN A CRAFTSMAN LIKE MANNER AND CONFORM TO ALL APPLICABLE BUILDING AND SAFETY CODES. ANY WORK CALLED FOR IN THE DRAWINGS OR SPECIFICATIONS, INCLUDING ANY WORK THAT CAN REASONABLY BE CONSIDERED A PART OF INSTALLATION AND NECESSARY TO COMPLETE THE PROJECT, SHALL BE INCLUDED. 4. ANY DISCREPANCIES BETWEEN THESE DRAWINGS, BUILDING AND LOCAL CODE REQUIREMENTS THAT MAY AFFECT 	DESIGN ARCHITECTURE • ENGINEERING • INTERIOR DESIG
EQUIPMENT DETAIL CALL OUT	K603 FOODSERVICE EQUIPMENT DETAILS, ELEVATIONS & SECTIONS K603 FOODSERVICE EQUIPMENT DETAILS, ELEVATIONS & SECTIONS	INSTALLATION, FABRICATION AND/OR OVERALL WORK IN ANY WAY SHALL BE BROUGHT TO THE ATTENTION OF REITANO DESIGN GROUP. REITANO DESIGN GROUP ASSUMES NO RESPONSIBILITY FOR ANY CHANGES MADE NECESSARY BY THE LOCAL BUILDING CODES, ORDINANCES, STRUCTURAL CONDITIONS OR CHANGES MADE NECESSARY IN EQUIPMENT SHOWN ON THESE DRAWINGS.	PROJECT
EQUIPMENT SECTION CALL OUT		5. THESE DRAWINGS REFER TO WORK TO BE PERFORMED BY OTHER TRADES NOT INTENDED TO BE PART OF THE KITCHEN EQUIPMENT CONTRACTOR'S SCOPE OF WORK. THESE TRADES ARE REFERENCED USING THE GENERALLY ACCEPTED TITLES FOUND IN THE ABBREVIATION LEGEND. IT IS NOT THE INTENT OF THESE TITLES TO ASSIGN WORK, BUT RATHER TO CLARIFY COORDINATION BETWEEN THE KITCHEN EQUIPMENT CONTRACTOR AND OTHER TRADES. THE CONTRACTOR IS RESPONSIBLE FOR ALL NOTES ON THESE DRAWINGS AND TRANSMITTING THE REQUIRED INFORMATION TO THE RESPECTIVE SUBCONTRACTORS.	DOUGLAS MACARTHUR
E1 SPOT LOCATION CALL OUT		6. THE BASIS OF DESIGN FOR ALL DRAWINGS, SPECIFICATIONS, AND DETAIL REFERENCES IS THE FIRST MANUFACTURER AND MODEL LISTED. IF ANOTHER LISTED MANUFACTURER IS CHOSEN BY THE KITCHEN EQUIPMENT CONTRACTOR, IT IS THE RESPONSIBILITY OF THE KITCHEN EQUIPMENT CONTRACTOR TO PROVIDE A MODEL THAT IS EQUAL IN PRODUCTION CAPABILITIES, CAPACITY, AND PERFORMANCE TO THE FIRST MANUFACTURER AND MODEL LISTED. THE KITCHEN EQUIPMENT CONTRACTOR IS ALSO TO VERIFY, COORDINATE, AND ALLOW FOR PROPER INSTALLATION OF EQUIPMENT; TAKING INTO ACCOUNT POSSIBLE REVISIONS FOR UTILITY CONNECTIONS, LOADS, AND PHYSICAL SIZES. IN THE EVENT	ES ADDITION AND
		THERE ARE ANY UP CHARGES OR CHANGE ORDERS BY OTHER TRADES AS A RESULT OF THE KITCHEN EQUIPMENT CONTRACTOR SUBMITTING ANOTHER LISTED MANUFACTURER, THOSE CHARGES SHALL BE THE SOLE RESPONSIBILITY OF THE KITCHEN EQUIPMENT CONTRACTOR 7. THE CONCEPTS, DESIGNS, PLANS, DETAILS, ETC. SHOWN ON THESE DRAWINGS ARE THE PROPERTY OF REITANO DESIGN GROUP, AND WERE CREATED FOR USE ON THIS SPECIFIC PROJECT. NONE OF THIS INFORMATION SHALL BE USED BY ANY	RENOVATION CROWN POINT COMMUNITY SCHOOL CORPORATION
		PERSON OR FIRM FOR ANY PURPOSE WITHOUT THE EXPRESS WRITTEN CONSENT OF REITANO DESIGN GROUP. THE OWNER MAY RETAIN COPIES FOR INFORMATION AND REFERENCE IN CONNECTION ONLY WITH THIS PROJECT.	CROWN POINT, INDIANA
		GENERAL ENVIRONMENTAL NOTES	
		CONTRACTOR TO PROVIDE SMOOTH AND LEVEL FLOORS BELOW ALL KITCHEN EQUIPMENT UNLESS THESE DRAWINGS SHOW OTHERWISE. FLOORS SHALL BE IMPERVIOUS TO WATER, GREASE, AND ACID AND OF EASILY CLEANABLE	
		CONSTRUCTION. FLOORS IN ALL AREAS WHERE FOOD IS PREPARED, PACKAGED OR STORED OR WHERE REFUSE OR GARBAGE IS STORED, JANITORIAL FACILITIES AND IN ALL TOILET AND HAND WASHING AREAS, SHALL BE AN APPROVED TYPE THAT CONTINUES UP THE WALL 6" WITH A MINIMUM 3/8" RADIUS COVE BASE. 2. CONTRACTOR TO PROVIDE SMOOTH AND NON-ABSORBENT WALLS IN ALL FOOD PREPARATION AND DISHWASHING	
	ABBREVIATION LEGEND	AREAS. WALLS TO BE PROVIDED WITH A LIGHT COLORED, EASILY CLEANABLE FINISH. ALL PAINTED SURFACES SHALL BE SEALED WITH A GLOSS OR SEMI-GLOSS ENAMEL. ALL WALLS WITHIN A.G.A. CLEARANCE REQUIREMENTS FOR COOKING EQUIPMENT SHALL BE CONSTRUCTED OF HEAT PROOF, NON-COMBUSTIBLE MATERIALS. CONTRACTOR TO VERIFY CONSTRUCTION PER LOCAL CODES. 3. CONTRACTOR TO PROVIDE SMOOTH AND NON-ABSORBENT CEILINGS IN IN ALL FOOD PREPARATION AND DISHWASHING AREAS. CEILINGS TO BE PROVIDED WITH A LIGHT COLORED, EASILY CLEANABLE FINISH. ALL PAINTED SURFACES SHALL BE SEALED WITH A GLOSS OR SEMI-GLOSS FINISH.	D
	AFF ABOVE FINISHED FLOOR AGA AMERICAN GAS ASSOCIATION AMPS AMPERAGE	4. IN EVERY ROOM AND AREA WHICH FOOD IS PREPARED, MANUFACTURED, PROCESSED OR PACKAGED, OR IN WHICH UTENSILS ARE CLEANED, LIGHTING SHALL BE PROVIDED TO PRODUCE AN INTENSITY OF NOT LESS THAN 70 FOOTCANDLES AS MEASURED THIRTY INCHES (30") ABOVE THE FLOOR. FOOD AND UTENSIL STORAGE ROOMS, REFRIGERATION STORAGE, TOILET AND DRESSING ROOMS SHALL BE PROVIDED WITH AT LEAST 20 FOOTCANDLES OF LIGHT. LIGHT FIXTURES IN AREAS WHERE FOOD IS PREPARED, OR WHERE OPEN FOOD IS STORED, OR WHERE UTENSILS	B
	ARCH ARCHITECTURAL BLDG BUILDING BTU BRITISH THERMAL UNIT CLG CEILING	ARE CLEANED, SHALL BE OF SHATTERPROOF CONSTRUCTION OR SHALL BE PROTECTED WITH SHATTERPROOF SHIELDS AND SHALL BE READILY CLEANABLE. 5. ALL DELIVERY DOORS LEADING TO THE OUTSIDE SHALL OPEN OUTWARD, BE SELF CLOSING, AND SHALL BE PROVIDED WITH AN OVERHEAD AIR CURTAIN. AIR CURTAIN SHALL PRODUCE A DOWNWARD AND OUTWARD AIRFLOW NOT LESS	KEY PLAN
	CLG CEILING CMU CONCRETE MASONRY UNIT CONN CONNECTION CONST CONSTRUCTION	THAN 3" THICK AT THE NOZZLE WITH AN AIR VELOCITY OF NOT LESS THAN 1600 FPM ACROSS ENTIRE OPENING. 6. TOILET FACILITIES SHALL BE PROVIDED WITHIN EACH FOOD ESTABLISHMENT CONVENIENT FOR THE EMPLOYEES. ALL TOILET ROOMS SHALL BE PROVIDED WITH MECHANICAL VENTILATION APPROVED BY THE HEALTH DEPARTMENT. A ROOM OR ENCLOSURE AT LEAST 5'X5', SEPARATED FROM TOILETS, FOOD STORAGE OR FOOD PREP AREAS SHALL BE PROVIDED WHERE EMPLOYEES MAY CHANGE AND STORE THEIR CLOTHES AND PERSONAL BELONGINGS.	GIBRALTAR DESIGNATION OF STREET OF S
	CW COLD WATER DCO DUPLEX CONVENIENCE OUTLET DFA DROP FROM ABOVE	7. LAVATORY SINKS SHALL BE PROVIDED IN ALL FOOD PREPARATION AND DISHWASHING AREAS. SOAP AND SANITARY TOWELS SHALL BE PROVIDED IN SINGLE SERVICE, PERMANENTLY INSTALLED, DISPENSERS AT THE LAVATORY SINKS. 8. CONTRACTOR TO BE RESPONSIBLE FOR ADA CLEARANCE REQUIREMENTS FOR ALL SPACES, DOOR STRIKES, EXITS, AND	Email info@GibraltarDesign.com Phone 317.580.5777 Fax 317.58 PROJECT 21-113
	DIM DIMENSION DWG DRAWING EC ELECTRICAL CONTRACTOR ED ELECTRICAL DIVISION	AISLE WAYS AS THEY PERTAIN TO CODE ENFORCEMENT AND INTERPRETATION. 9. ALL WORK SHALL CONFORM TO LOCAL BUILDING, SAFETY, FIRE, AND HEALTH REGULATIONS. THE CONTRACTOR SHALL BE RESPONSIBLE FOR OBTAINING ALL NECESSARY LICENSES AND BUILDING REQUIREMENTS, PAYING FEES, AND PASSING INSPECTION. IT IS HIS RESPONSIBILITY TO VERIFY ALL NECESSARY CODES AND REQUIREMENTS PRIOR TO IMPLEMENTATION.	DATE 1/31/22 COORDINATED BY RDG
	ELEC ELECTRIC, ELECTRICAL EXIST EXISTING FLR DRN FLOOR DRAIN	10. ALL PUBLIC USE AREAS ARE TO BE PROVIDED WITH HEATED AND REFRIGERATED CONDITIONING DESIGNED TO PROVIDE A POSITIVE PRESSURE AT OUTSIDE DOORS. (PROVIDED AND INSTALLED BY HVAC CONTRACTOR.) 11. INTENDED ENVIRONMENT FOR REFRIGERATED GLASS FRONT & OPEN FRONT DISPLAY CASES TO BE 75°F/55% RELATIVE	DRAWN BY JJN CHECKED BY RDG
	FLR SINK FLOOR SINK FLR TRGH FLOOR TROUGH GA GAUGE	HUMIDITY.	COPYRIGHT NOTICE: THE CONCEPTS, DESIGNS, PLANS, DETAILS, ETC, SHO THIS DOCUMENT ARE THE PROPERTY OF GIBRALTAR WERE CREATED FOR USE ON THIS SPECIFIC PROJECT THIS INFORMATION SHALL BE USED BY ANY PERSON FOR ANY PURPOSE WITHOUT THE EXPRESS WRITTEN
	GALV GALVANIZED C CONTRACTOR O OTHERS GPH GALLONS PER HOUR		OF GIBRALTAR DESIGN. THE OWNER MAY RETAIN COF INFORMATION AND REFERENCE IN CONNECTION ONLY PROJECT. REVISIONS MARK DATE ISSUED FOR
	HP HORSEPOWER HVAC HEATING, VENTILATION & AIR CONDITIONING HW HOT WATER		02/23/22 ADDENDUM #3
	ID INSIDE DIAMETER KEC KITCHEN EQUIPMENT CONTRACTOR KW KILOWATT MAX MAXIMUM	GENERAL EQUIPMENT NOTES	
	MBTU 1,000 BTU'S MC MECHANICAL CONTRACTOR MD MECHANICAL DIVISION	1. EQUIPMENT WHICH IS FIXED AND WHERE IT ABUTTS OTHER FIXED EQUIPMENT, BUILDING WALLS OR FLOOR SHALL BE SEALED THERETO WITH SILICONE. GAPS BETWEEN EQUIPMENT EXCEEDING 1/8" IN WIDTH MUST BE TRIMMED OUT	
	MECH MECHANICAL MFG MANUFACTURER MIN MINIMUM MISC MISCELLANEOUS	WITH STAINLESS STEEL ANGLED TRIM OR MATCHING MATERIAL TRIM PRIOR TO BEING SEALED. 2. HOT WATER SUPPLY TO ALL FOOD PREPARATION AND THREE COMPARTMENT SINKS SHALL BE 120 DEGREES MINIMUM. HOT WATER SUPPLY TO ALL DISHMACHINES SHALL BE 140 DEGREES MINIMUM. 3. ALL COLINTERS ARE TO BE EARRICATED PROPERLY TO SUPPORT THE SPECIFIED COLINTER TOP MATERIAL IN	
	NIC NOT IN CONTRACT NTS NOT TO SCALE OC ON CENTER	3. ALL COUNTERS ARE TO BE FABRICATED PROPERLY TO SUPPORT THE SPECIFIED COUNTER TOP MATERIAL IN ACCORDANCE WITH THE MATERIAL MANUFACTURER'S GUIDELINES. ALL "DROP-IN" EQUIPMENT AND OTHER EQUIPMENT "ATTACHED TO", "SET ON" OR "BUILT-IN" TO THE COUNTER TOP MATERIAL TO BE INSTALLED IN ACCORDANCE WITH THE MATERIAL MANUFACTURER'S GUIDELINES AND TECHNICAL BULLETINS FOR THE INSTALLATION OF COMMERCIAL FOOD SERVICE EQUIPMENT.	
	OD OUTSIDE DIAMETER PC PLUMBING CONTRACTOR PD PLUMBING DIVISION	 4. ALL FOOD SERVICE EQUIPMENT SHALL BE MANUFACTURED, FABRICATED, FURNISHED & INSTALLED IN STRICT ACCORDANCE WITH, AND BEAR THE EMBLEM OF, THE NATIONAL SANITATION FOUNDATION (NSF) AS WELL AS ANY FEDERAL, STATE & LOCAL CODE REQUIREMENTS. 5. ALL REFRIGERATION EQUIPMENT SHALL HAVE A THERMOMETER WHICH IS EASILY READABLE IN PROPER WORKING CONDITION. 	DRAWING FOODSERVICE EQUIPMI
	PH PHASE		II
	PSI POUNDS PER SQUARE INCH R RADIUS ST STL STAINLESS STEEL		GENERAL NOTES & SHEET INDEX
	PSI POUNDS PER SQUARE INCH R RADIUS		GENERAL NOTES &

Wednesday, 2/23/2022 — 9:53 AM — LAST SAVED BY:JONG:\SHARED DRIVES\RDG PROJECT DATA\RDG PROJECT FOLDER (2021)\2021—025 — GIBRALTAR — MACARTHUR ELEMENTARY SCHOOL\3. DRAWINGS\A.
CAD\QF—2021—025—PLAN.DWG

ı	MARK	DATE	ISSUED FOR
		02/23/22	ADDENDUM #3
ı			
ı			
ı			
1			
ı			
ı			
ı			
1			
ı			
ı			
I			
I			
I			
I			

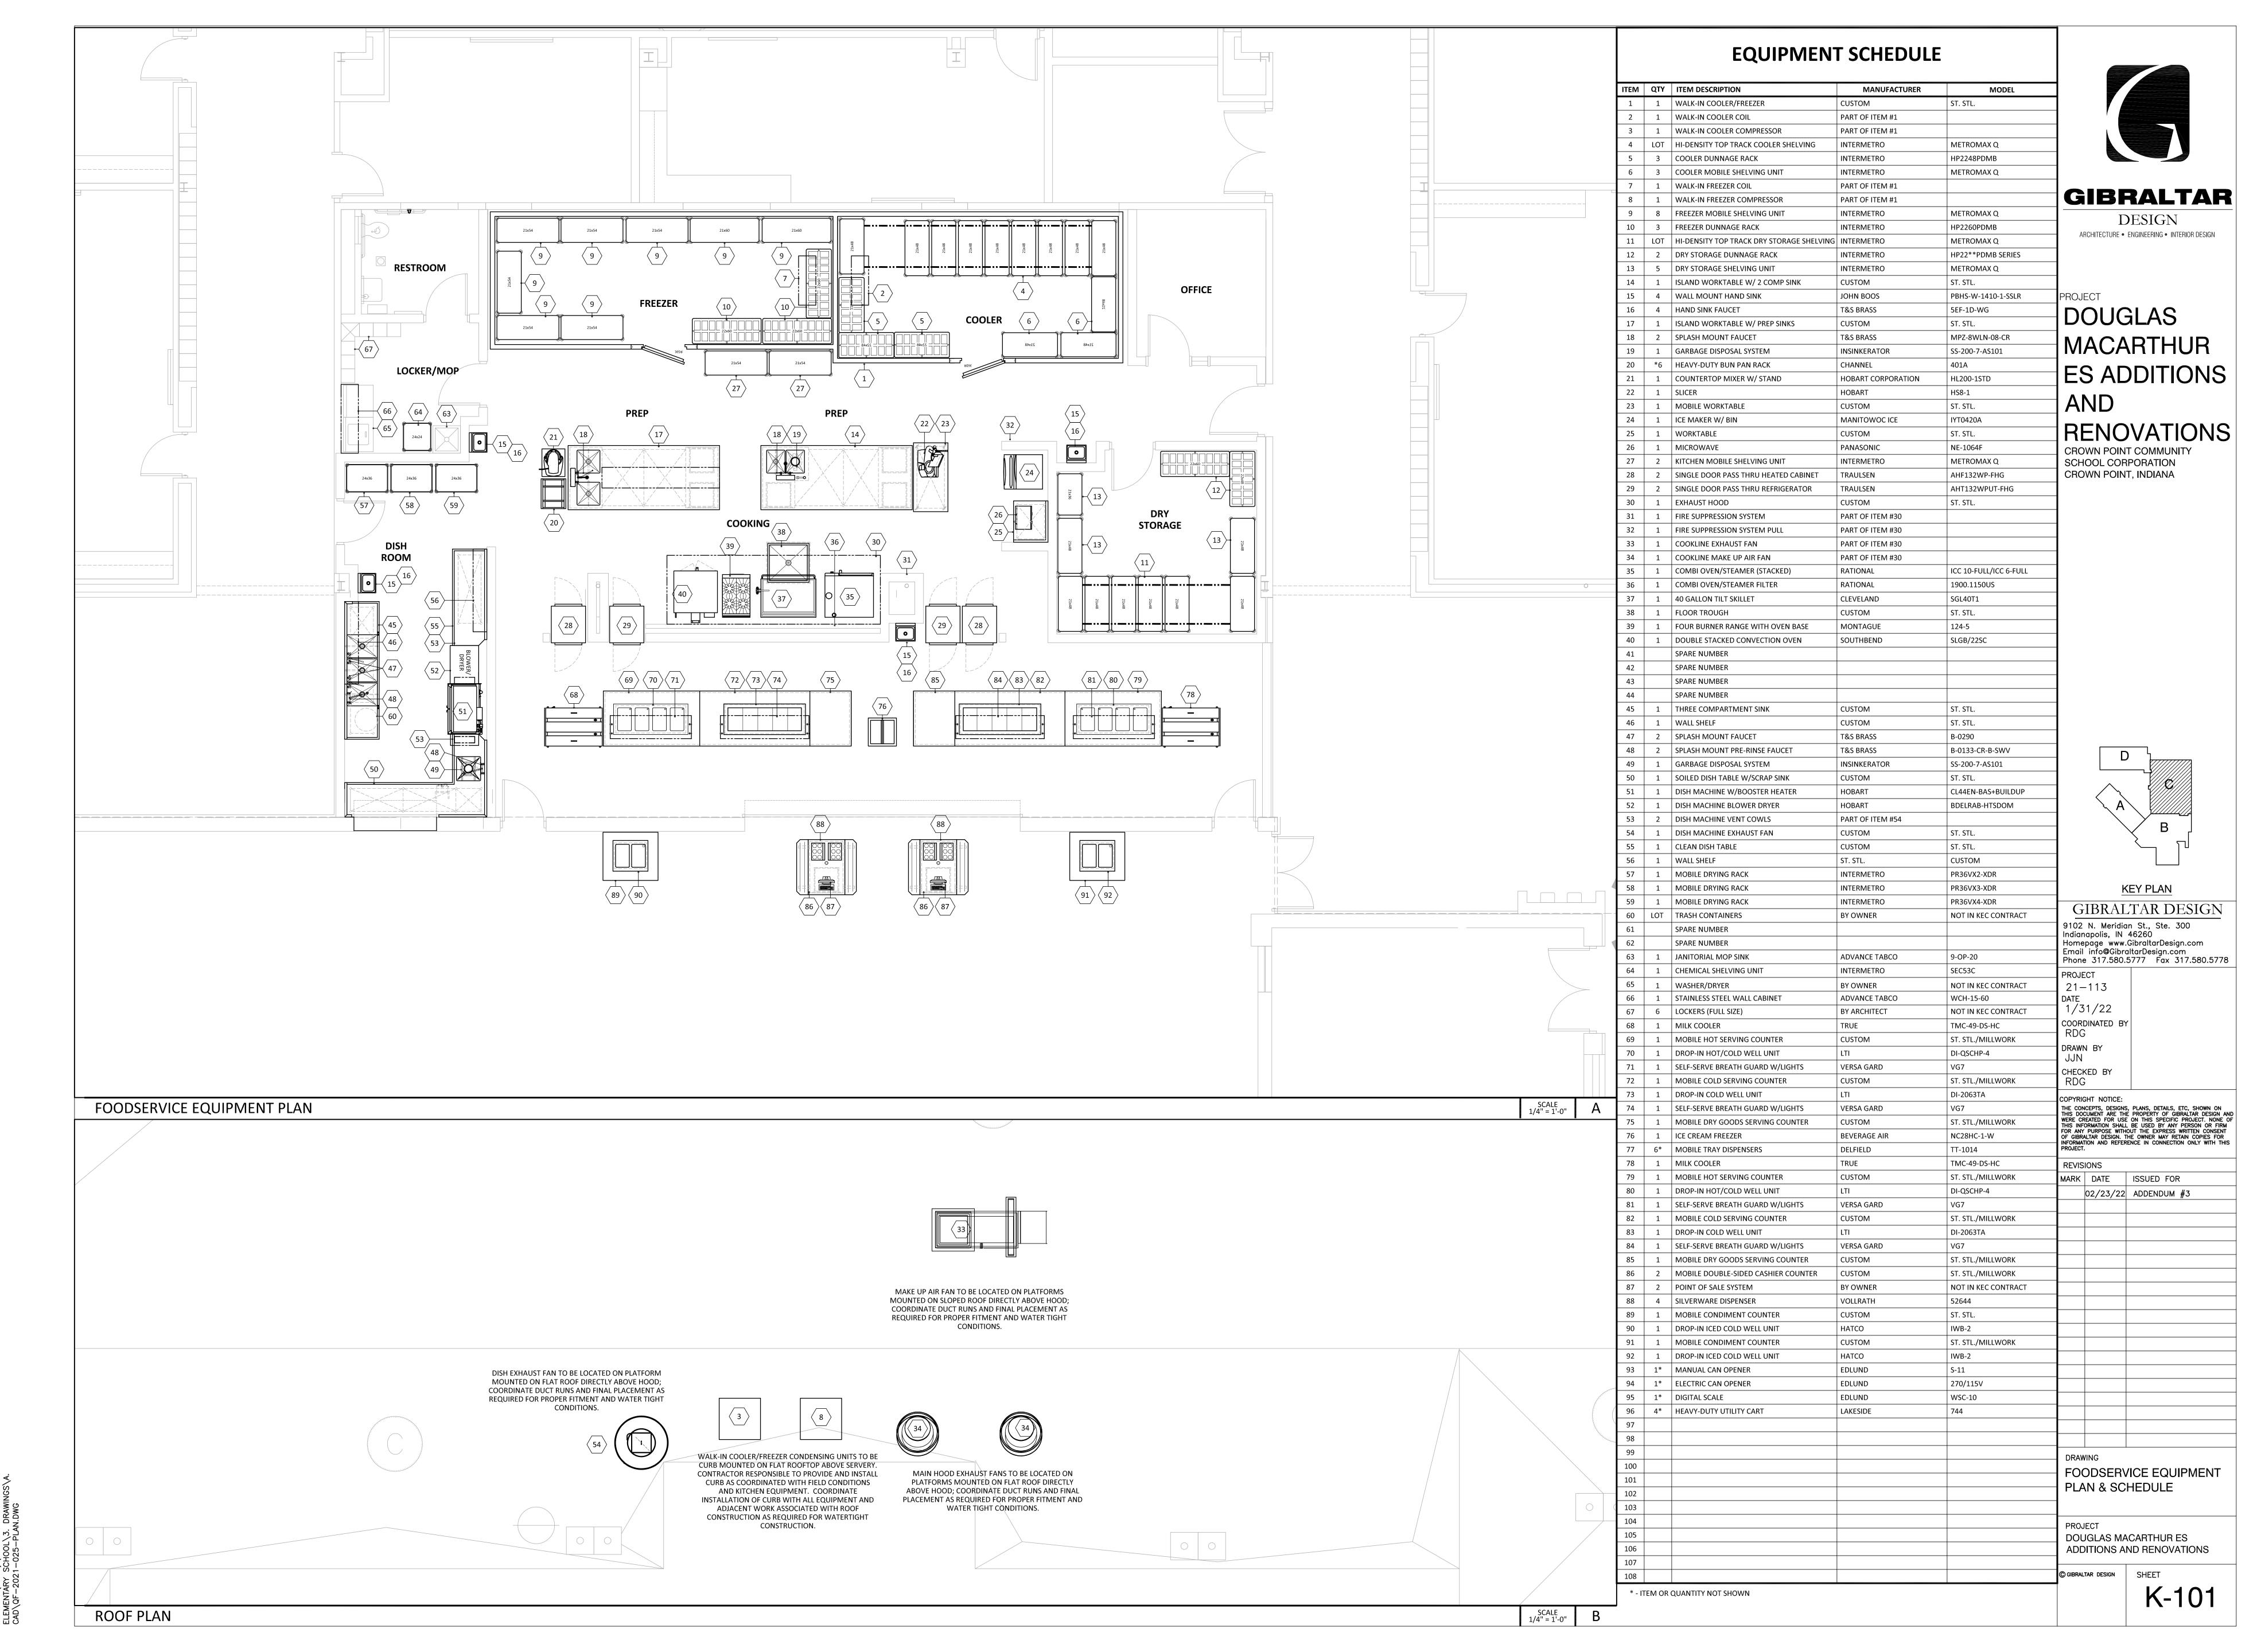

Wednesday, 2/23/2022 — 9:53 AM — LAST SAVED BY:JONATHAN NIKIEL G:\SHARED DRIVES\RDG PROJECT FOLDER (2021)\2021—025 — GIBRALTAR — MACARTHUR ELEMENTARY SCHOOL\3. DRAWINGS\A. CAD\QF—2021—025—PLAN.DWG

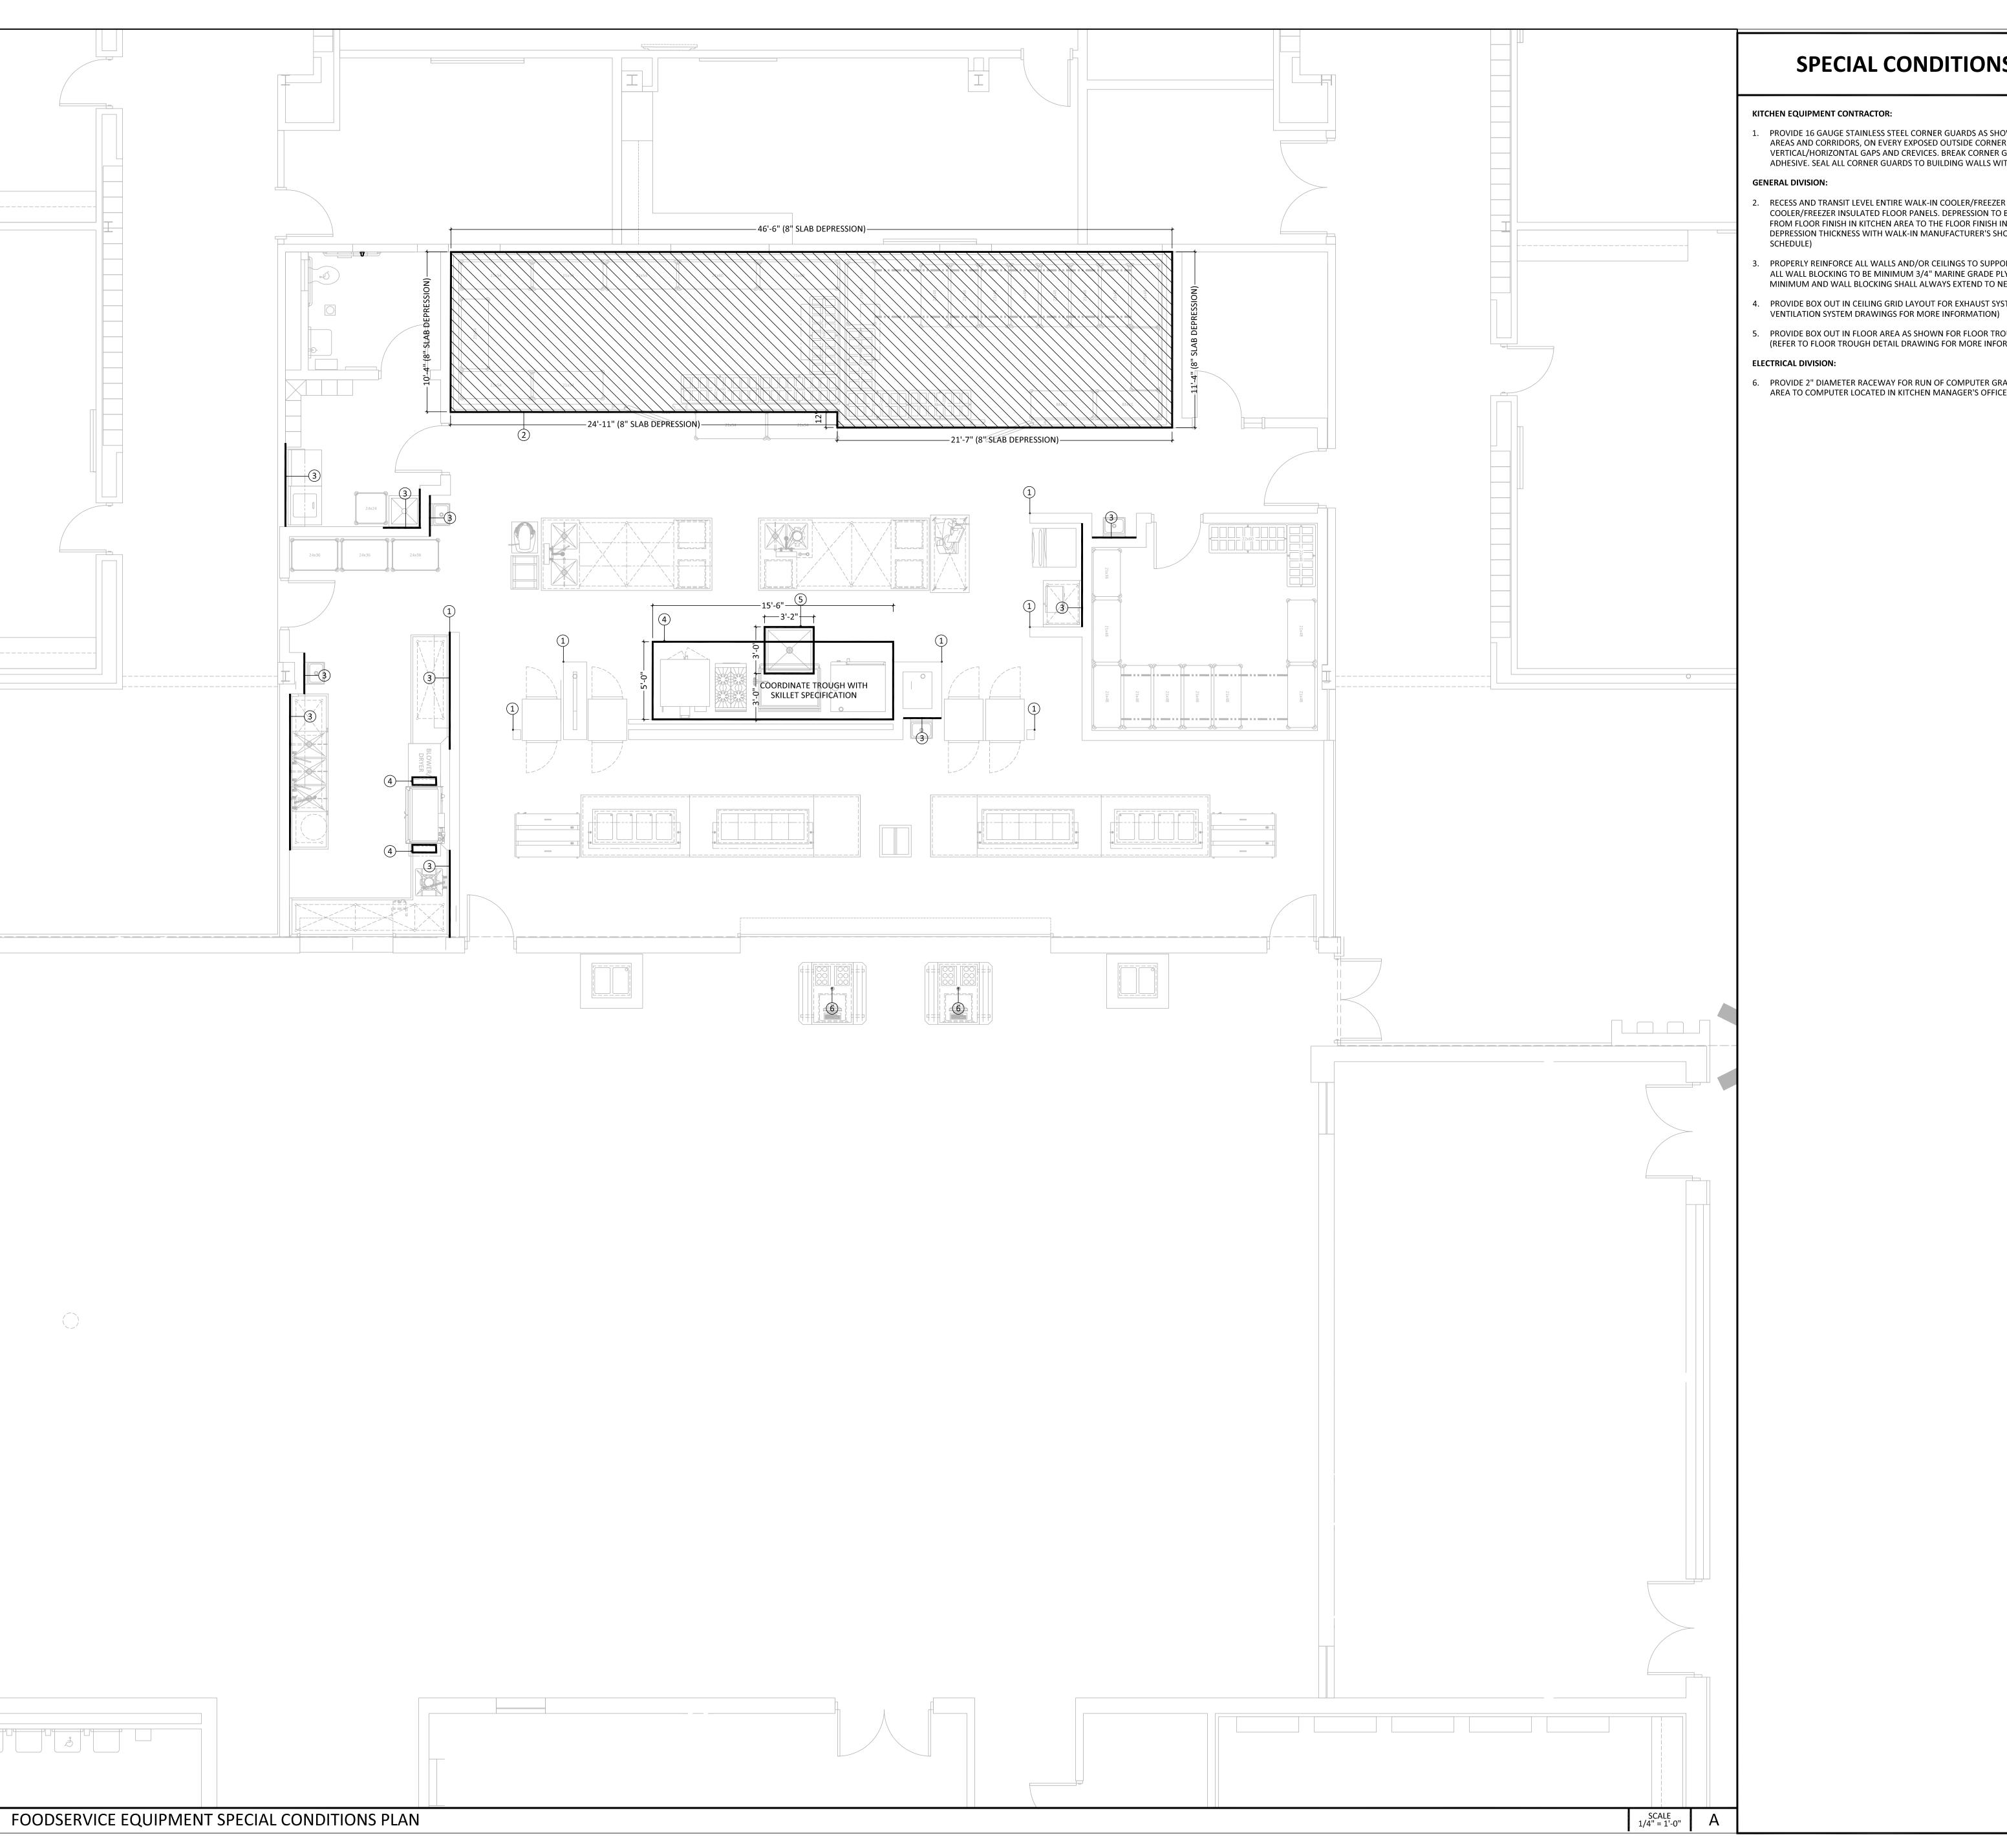

Wednesday, 2/23/2022 — 9:52 AM — LAST SAVED BY G:\SHARED DRIVES\RDG PROJECT DATA\RDG PROJECT FOLDER (2021)\2021—025 — GIBRALTAR — MACARTHU ELEMENTARY SCHOOL\3. DRAWINGS\A. CAD\QF—2021—025—PLAN.DWG

SPECIAL CONDITIONS LAYOUT NOTES

1. PROVIDE 16 GAUGE STAINLESS STEEL CORNER GUARDS AS SHOWN ON PLAN OR AS NECESSARY IN FOOD PRODUCTION AREAS AND CORRIDORS, ON EVERY EXPOSED OUTSIDE CORNER OF CONSTRUCTION, WALK-IN CABINET AND VERTICAL/HORIZONTAL GAPS AND CREVICES. BREAK CORNER GUARDS 90° (+/-) FOR TIGHT FIT AND APPLY WITH MASTIC ADHESIVE. SEAL ALL CORNER GUARDS TO BUILDING WALLS WITH CLEAR SILICONE.

- RECESS AND TRANSIT LEVEL ENTIRE WALK-IN COOLER/FREEZER AREA TO A DEPTH OF 8" TO RECEIVE WALK-IN COOLER/FREEZER INSULATED FLOOR PANELS. DEPRESSION TO BE CONSTRUCTED AS TO PROVIDE A LEVEL TRANSITION FROM FLOOR FINISH IN KITCHEN AREA TO THE FLOOR FINISH IN WALK-IN COOLER/FREEZER. (VERIFY REQUIRED DEPRESSION THICKNESS WITH WALK-IN MANUFACTURER'S SHOP DRAWING AND ARCHITECTURAL FLOOR FINISH
 - PROPERLY REINFORCE ALL WALLS AND/OR CEILINGS TO SUPPORT ALL WALL AND/OR CEILING SUPPORTED EQUIPMENT. ALL WALL BLOCKING TO BE MINIMUM 3/4" MARINE GRADE PLYWOOD. WALL BLOCKING LENGTHS SHOWN ARE MINIMUM AND WALL BLOCKING SHALL ALWAYS EXTEND TO NEXT STUD OVER IN EACH DIRECTION.
 - 4. PROVIDE BOX OUT IN CEILING GRID LAYOUT FOR EXHAUST SYSTEM HOODS AS SHOWN. (REFER TO EXHAUST
 - 5. PROVIDE BOX OUT IN FLOOR AREA AS SHOWN FOR FLOOR TROUGH INSTALLATION PRIOR TO POURING CONCRETE. (REFER TO FLOOR TROUGH DETAIL DRAWING FOR MORE INFORMATION)

6. PROVIDE 2" DIAMETER RACEWAY FOR RUN OF COMPUTER GRADE CONDUIT FROM POINT OF SALE SYSTEMS IN SERVER AREA TO COMPUTER LOCATED IN KITCHEN MANAGER'S OFFICE FOR COMMUNICATION PURPOSES.




DESIGN ARCHITECTURE • ENGINEERING • INTERIOR DESIGN

DOUGLAS MACARTHUR ES ADDITIONS AND

RENOVATIONS

CROWN POINT COMMUNITY SCHOOL CORPORATION CROWN POINT, INDIANA

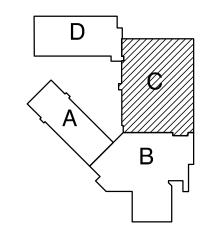

KEY PLAN

GIBRALTAR DESIGN 9102 N. Meridian St., Ste. 300 Indianapolis, IN 46260
Homepage www.GibraltarDesign.com
Email info@GibraltarDesign.com
Phone 317.580.5777 Fax 317.580.5778

1/31/22 COORDINATED BY RDG

DRAWN BY JJN CHECKED BY

RDG

COPYRIGHT NOTICE: THE CONCEPTS, DESIGNS, PLANS, DETAILS, ETC, SHOWN ON THIS DOCUMENT ARE THE PROPERTY OF GIBRALTAR DESIGN AND WERE CREATED FOR USE ON THIS SPECIFIC PROJECT. NONE OF THIS INFORMATION SHALL BE USED BY ANY PERSON OR FIRM FOR ANY PURPOSE WITHOUT THE EXPRESS WRITTEN CONSENT OF GIBRALTAR DESIGN. THE OWNER MAY RETAIN COPIES FOR INFORMATION AND REFERENCE IN CONNECTION ONLY WITH THIS PROJECT.

MARK DATE ISSUED FOR 02/23/22 ADDENDUM #3

FOODSERVICE EQUIPMENT SPECIAL CONDITIONS PLAN

DOUGLAS MACARTHUR ES ADDITIONS AND RENOVATIONS

© GIBRALTAR DESIGN SHEET

120

120

16.0


FURNISH HORIZONTAL RECEPTACLE WHEN MOUNTED

48 ABOVE COUNTERTOP

GIBRALTAR DESIGN ARCHITECTURE • ENGINEERING • INTERIOR DESIGN

DOUGLAS MACARTHUR ES ADDITIONS AND

RENOVATIONS CROWN POINT COMMUNIT SCHOOL CORPORATION CROWN POINT, INDIANA

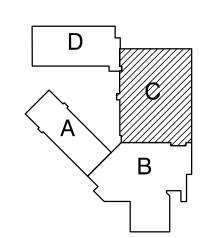

KEY PLAN

GIBRALTAR DESIGN 9102 N. Meridian St., Ste. 300 Indianapolis, IN 46260 Homepage www.GibraltarDesign.com Email info@GibraltarDesign.com Phone 317.580.5777 Fax 317.580.5778

PROJECT 21-113 1/31/22 COORDINATED BY RDG DRAWN BY JJN

COPYRIGHT NOTICE: THE CONCEPTS, DESIGNS, PLANS, DETAILS, ETC, SHOWN ON THIS DOCUMENT ARE THE PROPERTY OF GIBRALTAR DESIGN AND WERE CREATED FOR USE ON THIS SPECIFIC PROJECT. NONE OF THIS INFORMATION SHALL BE USED BY ANY PERSON OR FIRM FOR ANY PURPOSE WITHOUT THE EXPRESS WRITTEN CONSENT OF GIBRALTAR DESIGN. THE OWNER MAY RETAIN COPIES FOR INFORMATION AND REFERENCE IN CONNECTION ONLY WITH THIS PROJECT.

REVIS	SIONS		
MARK	DATE	ISSUED FO	R
	02/23/22	ADDENDUM	#3
DDAV	WIND		

FOODSERVICE EQUIPMENT

DOUGLAS MACARTHUR ES ADDITIONS AND RENOVATIONS

K-200

Wednesday, 2/23/2022 — 10:44 AM — LAST SAVED G:\SHARED DRIVES\RDG PROJECT DATA\RDG PROJECT FOLDER (2021)\2021—025 — GIBRALTAR — MACARTHI ELEMENTARY SCHOOL\3. DRAWINGS\A. CAD\QF—2021—025—SPOT.DWG


DUPLEX CONVENIENCE

DR2 DUPLEX CONVENIENCE RECEPTACLE


RECEPTACLE

SPOT LOCATION SCHEDULES

GIBRALTAR DESIGN SHEET

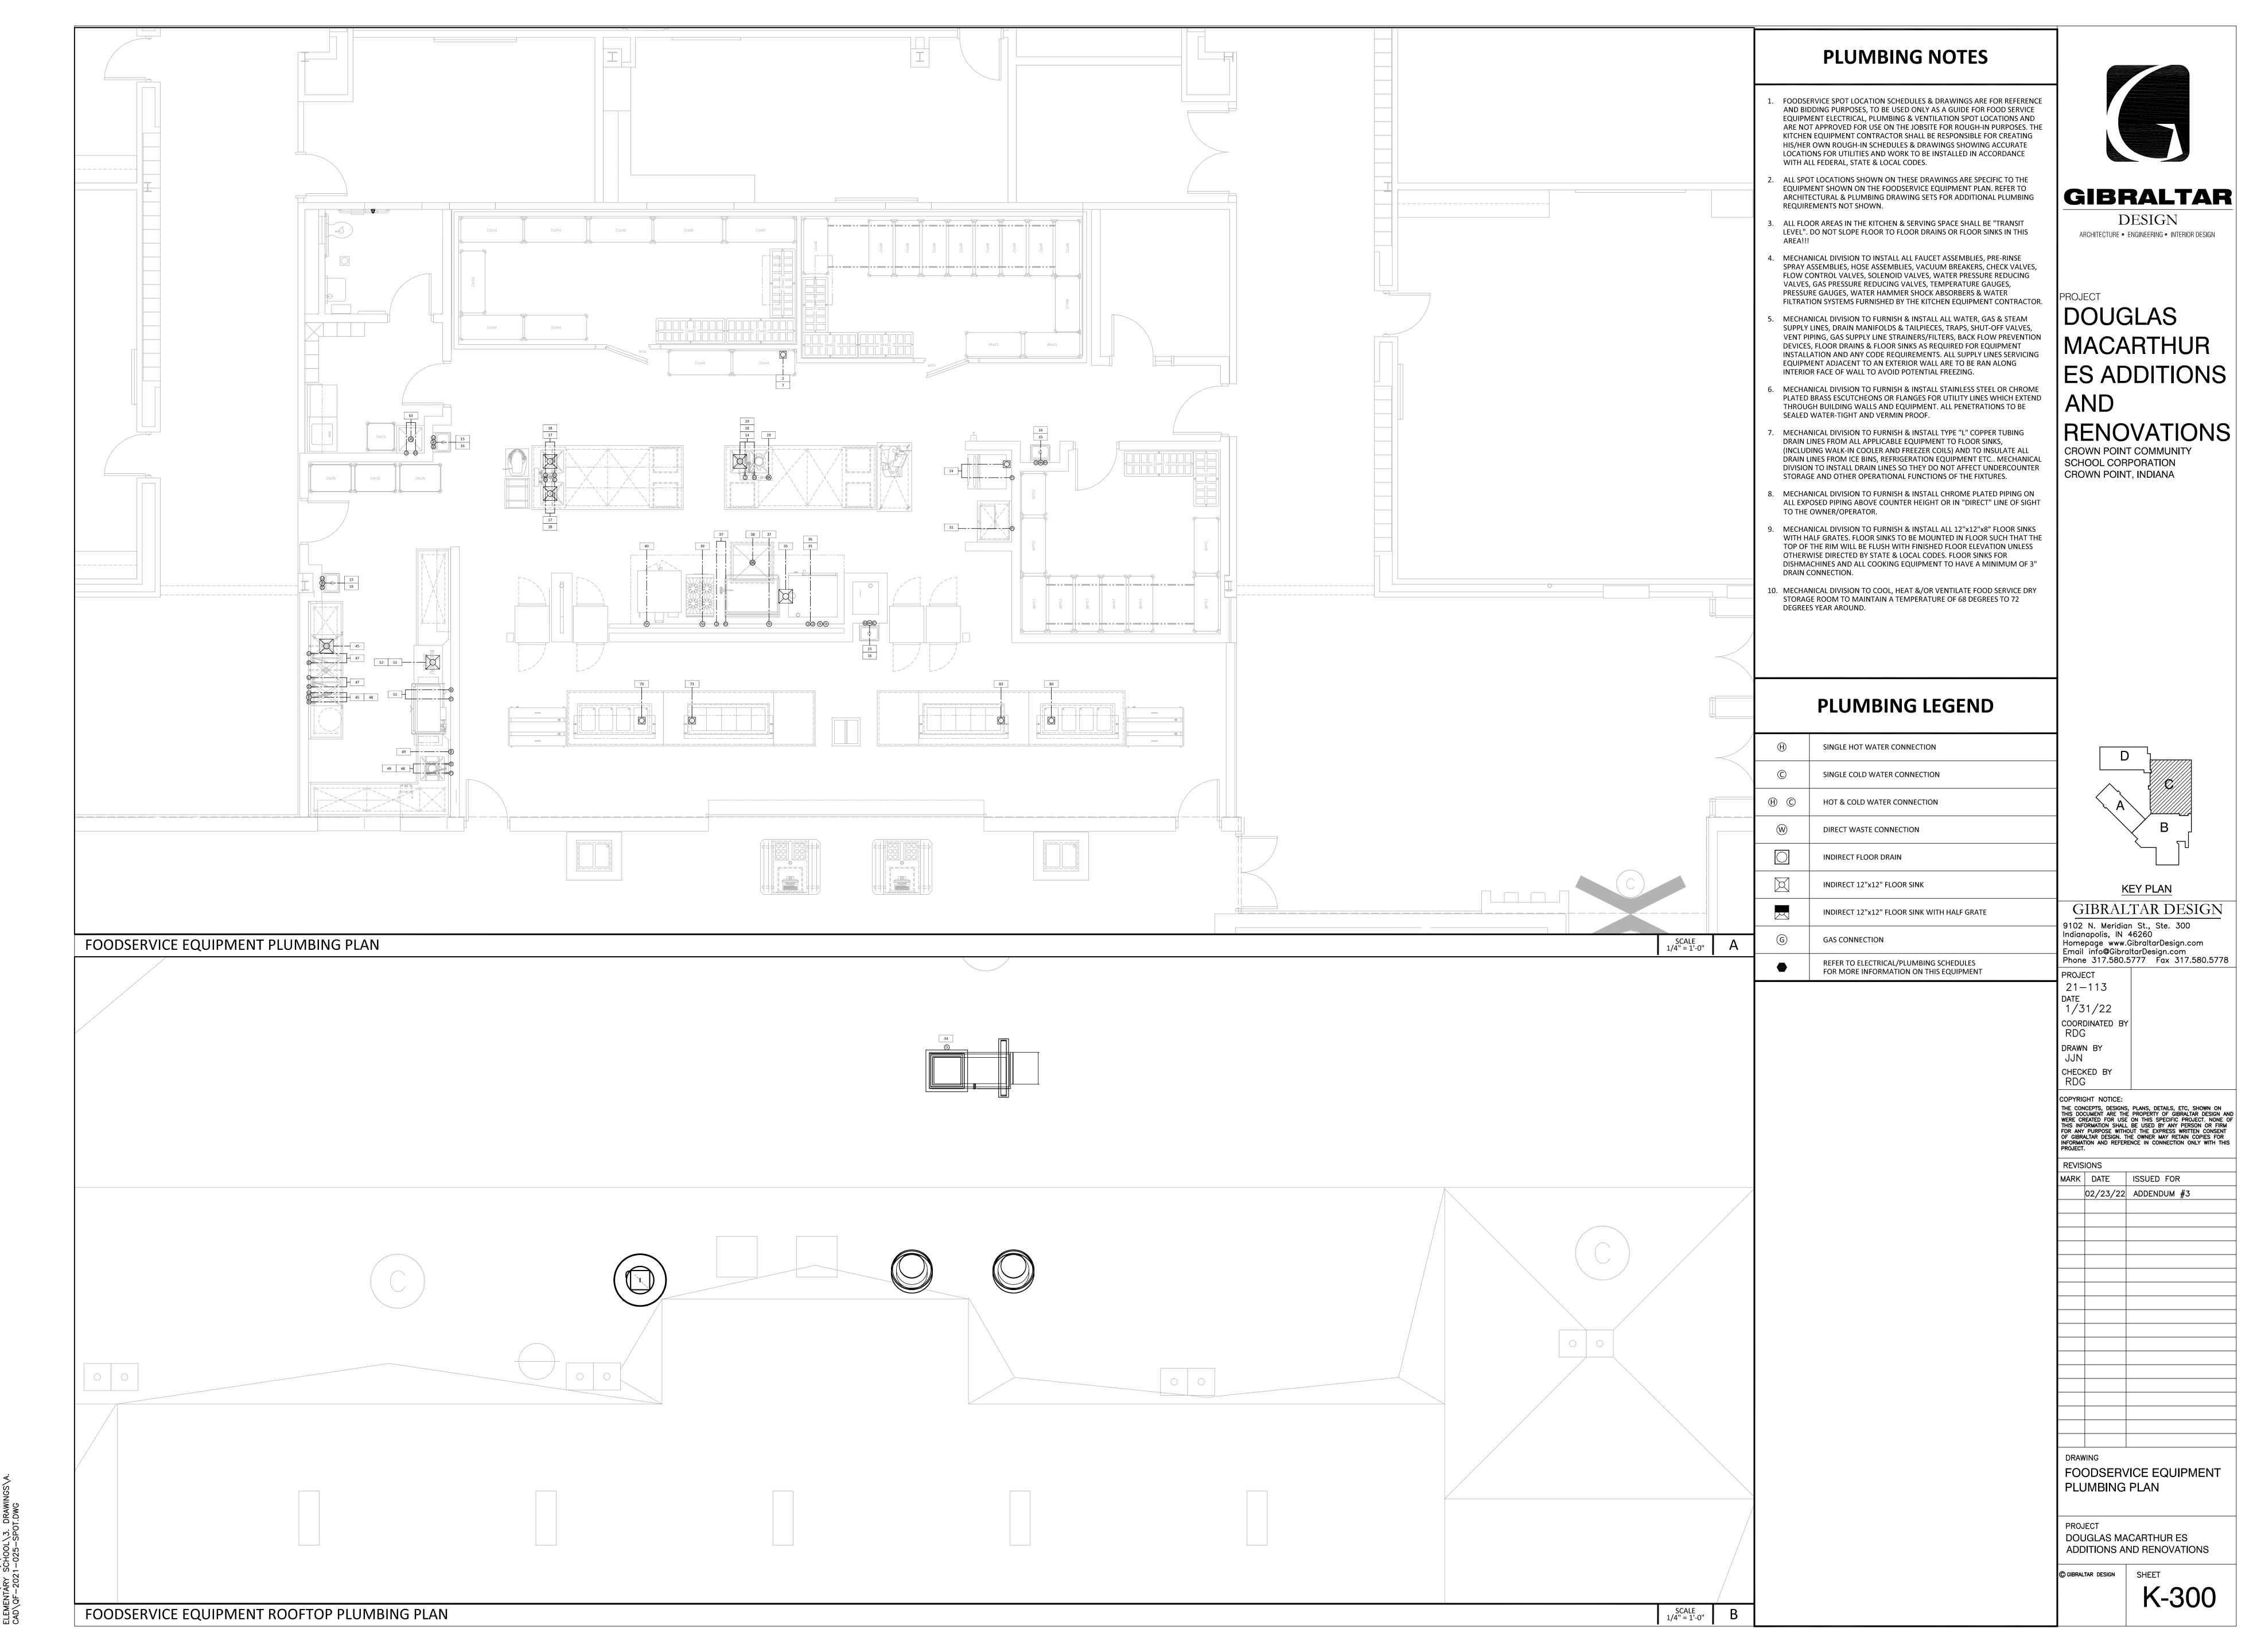

Wednesday, 2/23/2022 — 10:00 AM — LAST SAVED BY:JONATHAN NIKIEL G:\SHARED DRIVES\RDG PROJECT DATA\RDG PROJECT FOLDER (2021)\2021—025 — GIBRALTAR — MACARTHUR ELEMENTARY SCHOOL\3. DRAWINGS\A. CAD\QF—2021—025—SPOT.DWG

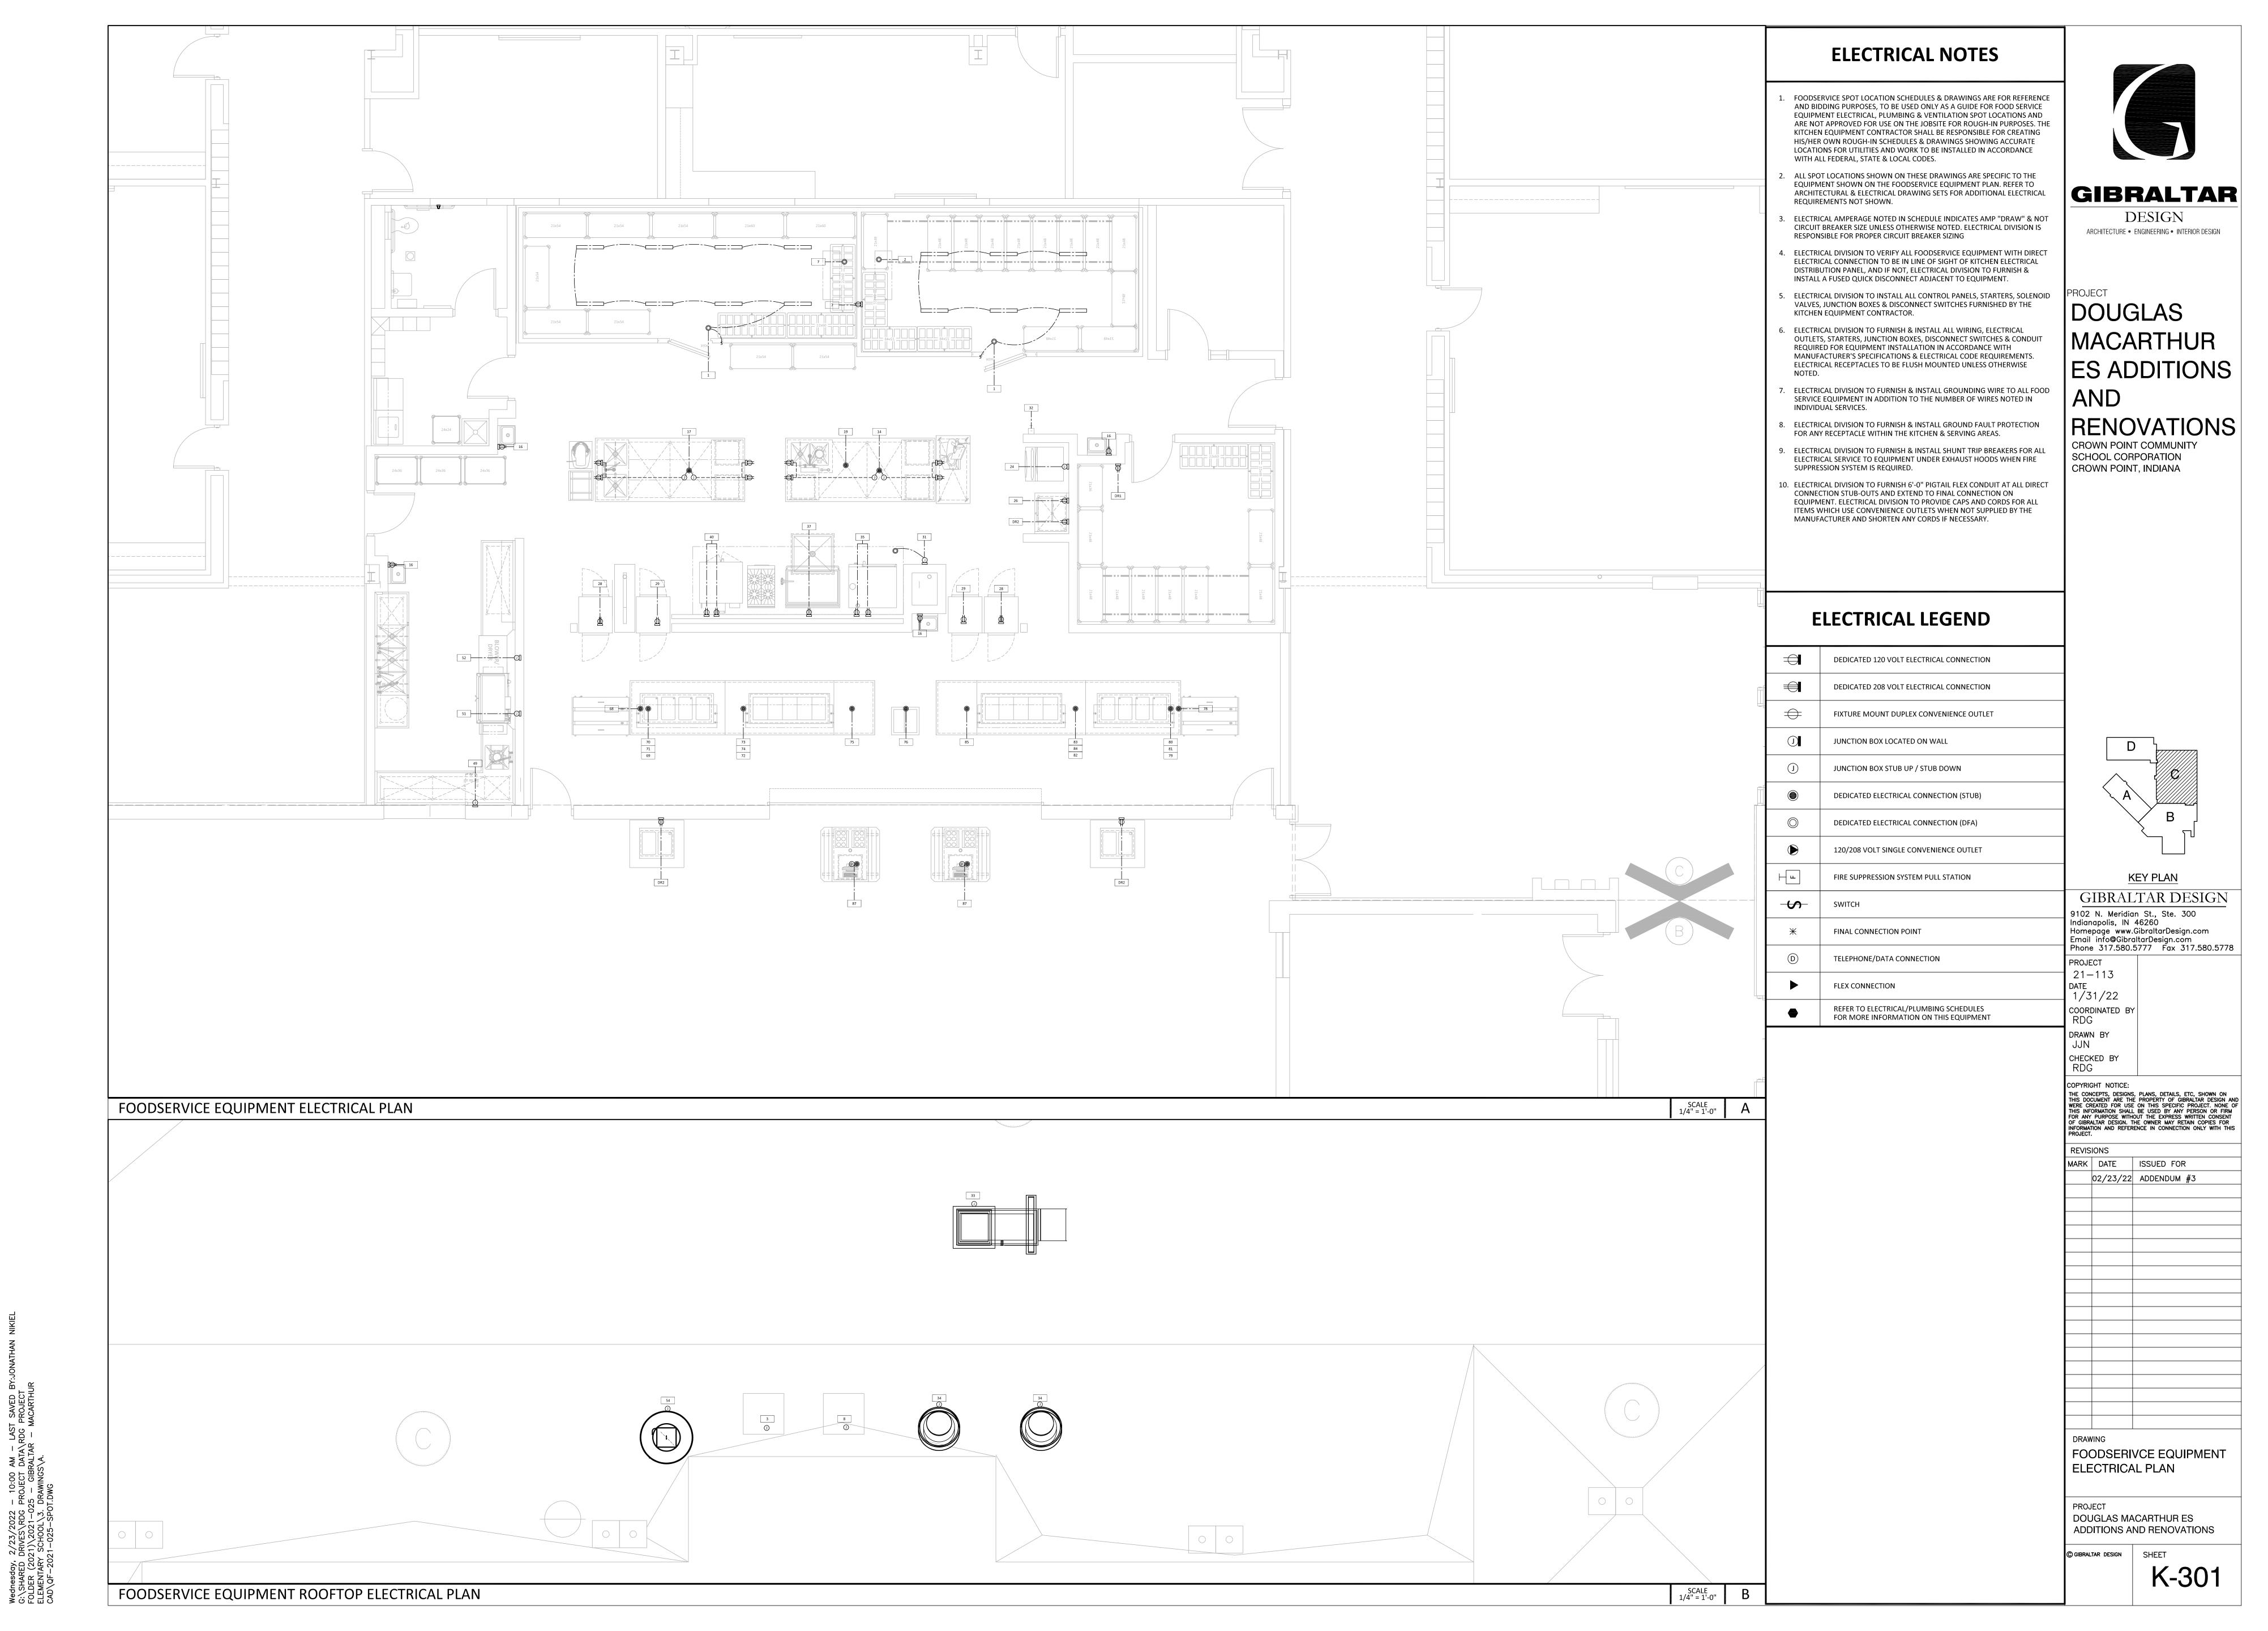

-46'-6" x 10'-4" x 8" DEEP "TRANSIT LEVEL" RECESS BY G.D **WALK-IN FREEZER WALK-IN COOLER** (-10° F) (+35° F) E7A E7B ____ P2 P7 CONDENSATE DRAIN LINE - PLUMBING BY KEC (EXTEND TO FLOOR DRAIN AS SHOWN)

WALK-IN COOLER/FREEZER LAYOUT

Wednesday, 2/23/2022 — 10:04 AM — LAST SAVED G:\SHARED DRIVES\RDG PROJECT DATA\RDG PROJECT FOLDER (2021)\2021—025 — GIBRALTAR — MACARTHI ELEMENTARY SCHOOL\3. DRAWINGS\A. CAD\QF—2021—025—WALK.DWG

WALK-IN COOLER/FREEZER **OPTIONS/ACCESSORIES SCHEDULE**

HEIGHT DIMENSIONS

OUTSIDE DIM. = 9'-8" INSIDE DIM. = 9'-0" FREEZER: OUTSIDE DIM. = 9'-8" INSIDE DIM. = 9'-0"

EXTERIOR FINISH

EXPOSED WALLS: 26 GA. EMBOSSED GALV. STEEL (WHITE BAKED-ON ENAMEL) **UNEXPOSED WALLS:** 26 GA. SMOOTH GALV. STEEL

TO MATCH ADJACENT EXTERIOR WALLS DOOR SECTION: TO MATCH ADJACENT EXTERIOR WALLS

INTERIOR FINISH

DOOR:

WALLS: 26 GA. EMBOSSED GALV. STEEL (WHITE BAKED-ON ENAMEL) CEILING: 26 GA. EMBOSSED GALV. STEEL (WHITE BAKED-ON ENAMEL) TO MATCH ADJACENT INTERIOR WALLS DOOR SECTION: TO MATCH ADJACENT INTERIOR WALLS

36" COOLER/FREEZER DOOR OPTIONS

THREE (3) KASON INDUSTRIES 1346 PERFORMER LIFT-OFF ADJUSTABLE HINGES

ONE (1) KASON INDUSTRIES 27C LOCKING HANDLE ONE (1) KASON INDUSTRIES 1094 PERFORMER WALK-IN DOOR CLOSER ONE (1) KASON INDUSTRIES THERMAFLEX DOUBLE SWING VINYL DOOR ONE (1) PRE-WIRED KASON INDUSTRIES 1807LW LED FIXTURE ONE (1) 14"x24" VIEWPORT W/ HEAT REFLECTIVE TRIPLE PANE GLASS 36" HIGH 1/8" DIAMOND ALUMINUM KICKPLATES (IN & OUT) MODULARM MODEL #75LC MULTI-MONITOR ALARM/THERMOMETER HEATED AIR PRESSURE RELIEF PORT

PRE-WIRED DOOR JAMB HEATER (FREEZER DOOR ONLY) PRE-WIRED THRESHHOLD AND SILL HEATER (FREEZER DOOR ONLY)

WALK-IN ACCESSORIES

(LOT) VERTICAL TRIM STRIPS (MATCH EXTERIOR FINISH) SEAL TO WALK-IN & BUILDING WALL (LOT) CLOSURE PANELS (MATCH EXTERIOR FINISH) FROM TOP OF WALK-IN TO FINISHED CEILING (LOT) 36" HIGH 1/8" DIAMOND ALUMINUM WAINSCOTTING ON EXPOSED FRONT & SIDE WALL (LOT) KASON 1809-4 LED LIGHT FIXTURES TO MEET LIGHTING REQUIREMENTS

WALK-IN COOLER/FREEZER **ELECTRICAL SCHEDULE**

	WALK-IN COOLER	(+35° F) ELECTRIC	CAL REOL	JIREMENTS			
ITEM	EQUIPMENT DESCRIPTION	VOLTAGE	PHS	AMP	НР	AFF	REMARKS
E1	LIGHTS AND DOOR OPTIONS (COOLER)	120	1	20.0		DFA	
E2	WALK-IN COOLER EVAPORATOR FANS	120	1	5.0		DFA	
E3	WALK-IN COOLER CONDENSING UNIT	208	3	7.7	1.50	PAD	
	WALK-IN FREEZER	(-10° F) ELECTRI	CAL REQU	JIREMENTS			
ITEM	EQUIPMENT DESCRIPTION	VOLTAGE	PHS	AMP	НР	AFF	REMARKS
E1A	LIGHTS AND DOOR OPTIONS (FREEZER)	120	1	20.0		DFA	
E7A	WALK-IN FREEZER DRAIN LINE HEAT TAPE	120	1	15.0		90"	
E7B	WALK-IN FREEZER EVAPORATOR FANS	208	1	5.0		DFA	
E7C	WALK-IN FREEZER EVAPORATOR HEATER	208	1	14.3		PAD	
E8	WALK-IN FREEZER CONDENSING UNIT	208	3	17.1	4.50	PAD	

WALK-IN COOLER/FREEZER

RECESS AND TRANSIT LEVEL ENTIRE WALK-IN COOLER/FREEZER AREA TO A DEPTH OF 8" TO RECEIVE WALK-IN COOLER/FREEZER INSULATED FLOOR PANELS. FURNISH AND INSTALL 6 MIL. VAPOR BARRIER (JOINTS TO OVERLAP A MINIMUM OF 6") UNDER ENTIRE AREA OF WALK-IN COMPARTMENTS AND TURN UP ON ALL SIDES. FURNISH AND INSTALL 4" THICK CONCRETE TOPPING SLAB (3,000 PSI) WITH POLYPROPELENE FIBER MESH REINFORCEMENT (1.5#/CY).DEPRESSION TO BE CONSTRUCTED AS TO PROVIDE A LEVEL TRANSITION FROM FLOOR FINISH IN KITCHEN AREA TO THE FLOOR FINISH IN WALK-IN COOLER/FREEZER. (VERIFY REQUIRED DEPRESSION THICKNESS WITH WALK-IN MANUFACTURER'S SHOP DRAWING

FURNISH AND INSTALL ALL SLEEVES THROUGH BUILDING WALLS AND ROOF AS REQUIRED FOR KEC TO RUN REFRIGERATION LINES FROM WALK-IN COOLER/FREEZER TO WALK-IN COOLER/FREEZER COMPRESSORS. SLEEVES TO BE LOCATED AND

FRAME ROOF CURB OPENINGS AS REQUIRED. COORDINATE JOIST OR STRUCTURAL MEMBER INSTALLATION TO PROVIDE REQUIRED STRUCTURAL SUPPORT FOR WALK-IN COOLER/FREEZER COMPRESSORS. CUT OPENINGS IN ROOF FOR ACCESS TO CURBS AND PITCH POCKETS. FURNISH AND INSTALL ADEQUATE STRUCTURAL SUPPORT FOR WALK-IN COOLER/FREEZER

SET-IN-PLACE AND FLASH (WITH CANT IF REQUIRED) ROOF CURBS AND EQUIPMENT SUPPORT RAIL FURNISHED BY THE WALK-IN COOLER/FREEZER SYSTEM MANUFACTURER.

FURNISH AND INSTALL ALL CONDUIT AND WIRING NECESSARY BETWEEN EVAPORATOR COILS, CONDENSING UNITS, AND

FURNISH AND INSTALL ALL FINAL ELECTRICAL HOOK-UPS AND DISCONNECTS TO LIGHTS AND ALL HEATED DOOR OPTIONS IN

FURNISH AND INSTALL ALL WIRING AND CONDUIT ABOVE AND ON THE OUTSIDE OF THE WALK-IN COOLER/FREEZER COMPARTMENT. ALL PENETRATIONS THRU WALLS AND CEILING ARE TO BE EQUIPPED WITH "SEAL-OFFS" AND SEALED WITH SILICONE AT EACH JUNCTION BOX TO PREVENT MOISTURE FROM COLLECTING IN FIXTURE.

INSURE THAT THERE IS CONSTANT AIRFLOW ABOVE AND AROUND ALL SIDES OF WALK-IN COMPARTMENTS TO ELIMINATE

RESPONSIBILITIES BY OTHER TRADES

AND ARCHITECTURAL FLOOR FINISH SCHEDULE)

COORDINATED IN FIELD BY KEC.

ELECTRICAL DIVISION:

ELECTRICAL DISCONNECTS.

WALK-IN COOLER/FREEZER UNIT.

MECHANICAL DIVISION:


MOISTURE BUILD-UP.

WALK-IN COOLER/FREEZER NOTES

- KEC TO FIELD VERIFY ALL BUILDING CONDITIONS, PIT RECESS, WALK-IN DIMENSIONS AND BUILDING DIMENSIONS TO ENSURE PROPER FIT OF WALK-IN COOLER/FREEZER.
- KEC TO EXTEND 3/4" DRAIN LINE FROM EVAPORATOR COILS TO FLOOR DRAIN, AS LOCATED ON DRAWING, ON THE EXTERIOR OF THE WALK-IN COOLER/FREEZER COMPARTMENT. DRAIN LINE TO BE SLOPED MINIMUM OF 1/4" PER FOOT. KEC TO COORDINATE DRAIN LINE HEIGHT AS IT EXITS EACH COIL SO THAT IT DOES NOT INTERFERE WITH SHELVING.
 - KEC TO PROVIDE AND INSTALL ALL REQUIRED ELECTRICAL COMPONENTS (FUSED DISCONNECT, TIME CLOCKS, MAGNETIC STARTERS, ETC.) AND FACTORY WIRED (CONDUIT AND CABLE) FOR ALL CONTROLS WITHIN THE
 - KEC TO PROVIDE ED WITH A SUFFICIENT NUMBER OF LIGHT FIXTURES TO PROVIDE A MINIMUM OF SEVENTY (70) FOOT CANDLES OF LIGHT INTENSITY MEASURED AT 30" AFF AT ANY POINT IN THE COMPARTMENT. THIS EQUATES TO APPROXIMATELY ONE (1) 100 WATT LIGHT FIXTURE PER FIFTY (50) SQUARE FEET NOT INCLUDING THE LIGHT FIXTURE
- KEC TO COORDINATE WITH GD TO DETERMINE EXACT LOCATION AND MOUNTING REQUIREMENTS FOR WALK-IN COOLER/FREEZER COMPRESSORS.
- KEC TO PROVIDE ALL CURBS AND PITCH POCKETS FOR FINAL MOUNTING AND FLASHING BY GD.

REFRIGERATION SYSTEMS, TO A SINGLE POINT OF SERVICE FOR POWER CONNECTION.


- ALL FINAL CONNECTION LOCATIONS, PENETRATIONS AND ELECTRICAL REQUIREMENTS ARE TO BE VERIFIED PER THE WALK-IN MANUFACTURER'S DRAWINGS PRIOR TO CONSTRUCTION.
- 8. KEC TO COORDINATE ALL WORK WITH ALL PROJECT CONTRACTORS AND TRADES

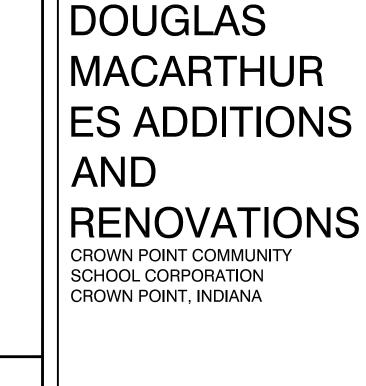

GIBRALTAR

DESIGN

ARCHITECTURE • ENGINEERING • INTERIOR DESIGN

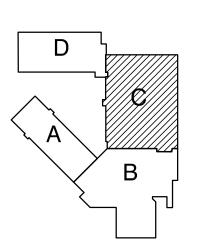

GIBRALTAR DESIGN 9102 N. Meridian St., Ste. 300

Indianapolis, IN 46260 Homepage www.GibraltarDesign.com Email info@GibraltarDesign.com Phone 317.580.5777 Fax 317.580.5778

PROJECT 21-113 01/31/22

COORDINATED BY DRAWN BY JJN

CHECKED BY

RDG

REVISIONS

THE CONCEPTS, DESIGNS, PLANS, DETAILS, ETC, SHOWN ON THIS DOCUMENT ARE THE PROPERTY OF GIBRALTAR DESIGN AND WERE CREATED FOR USE ON THIS SPECIFIC PROJECT. NONE OF THIS INFORMATION SHALL BE USED BY ANY PERSON OR FIRM FOR ANY PURPOSE WITHOUT THE EXPRESS WRITTEN CONSENT OF GIBRALTAR DESIGN. THE OWNER MAY RETAIN COPIES FOR INFORMATION AND REFERENCE IN CONNECTION ONLY WITH THIS PROJECT.


MARK	DATE	ISSUED FOR
	02/23/22	ADDENDUM #3
	1	


DRAWING WALK-IN COOLER AND FREEZER LAYOUT AND

DETAILS

DOUGLAS MACARTHUR ES ADDITIONS AND RENOVATIONS

GIBRALTAR DESIGN SHEET

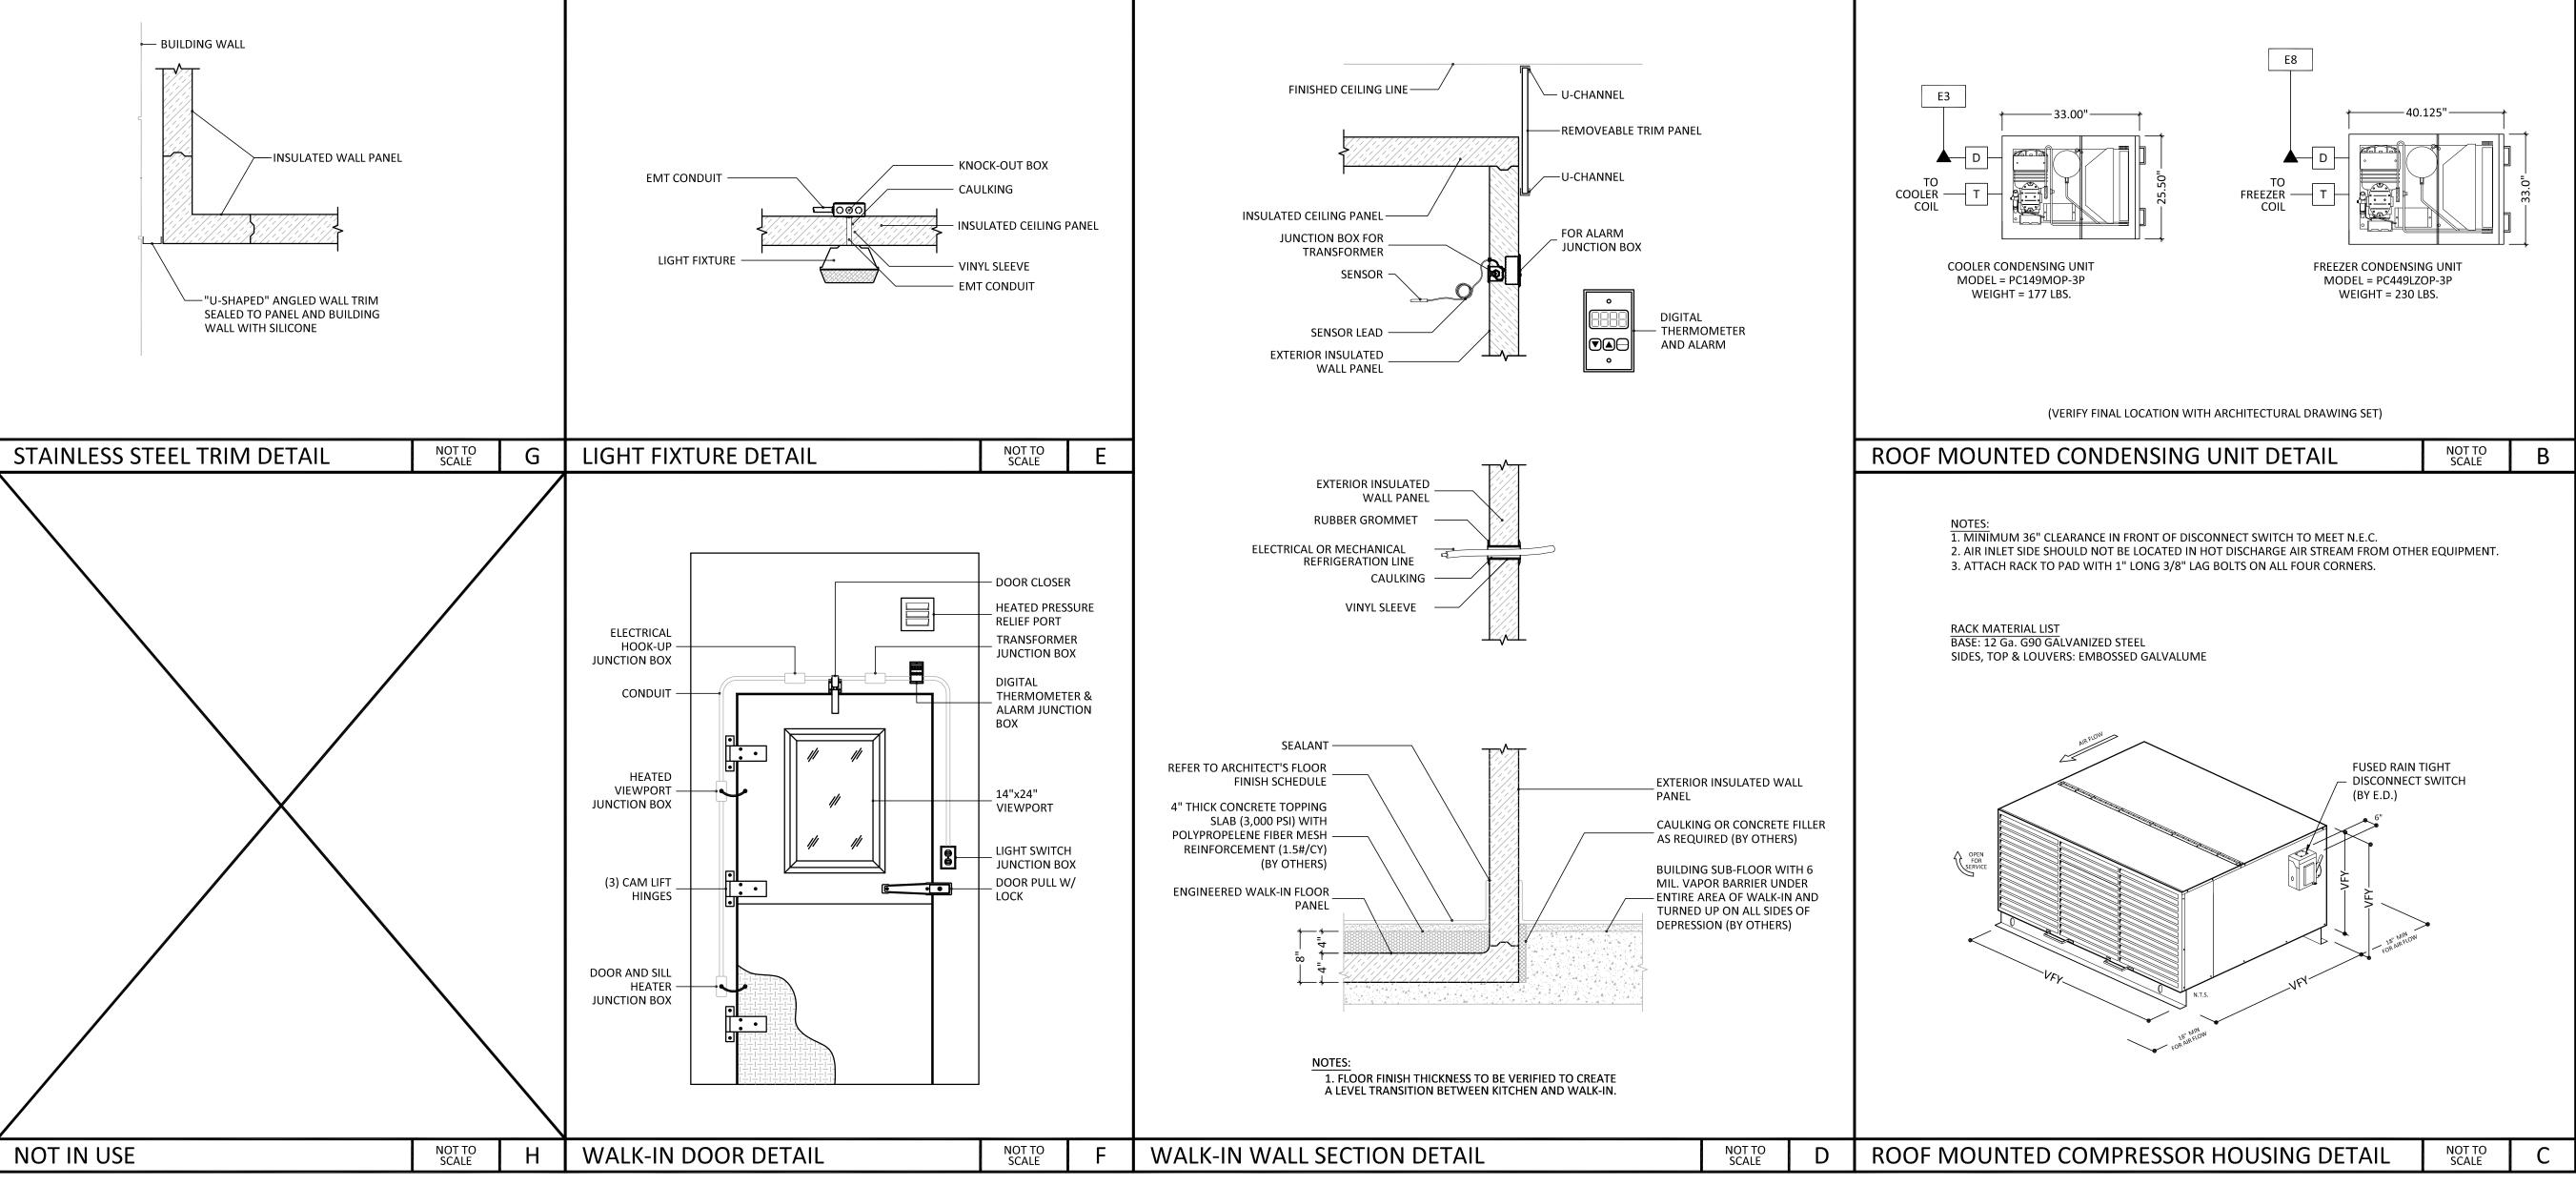

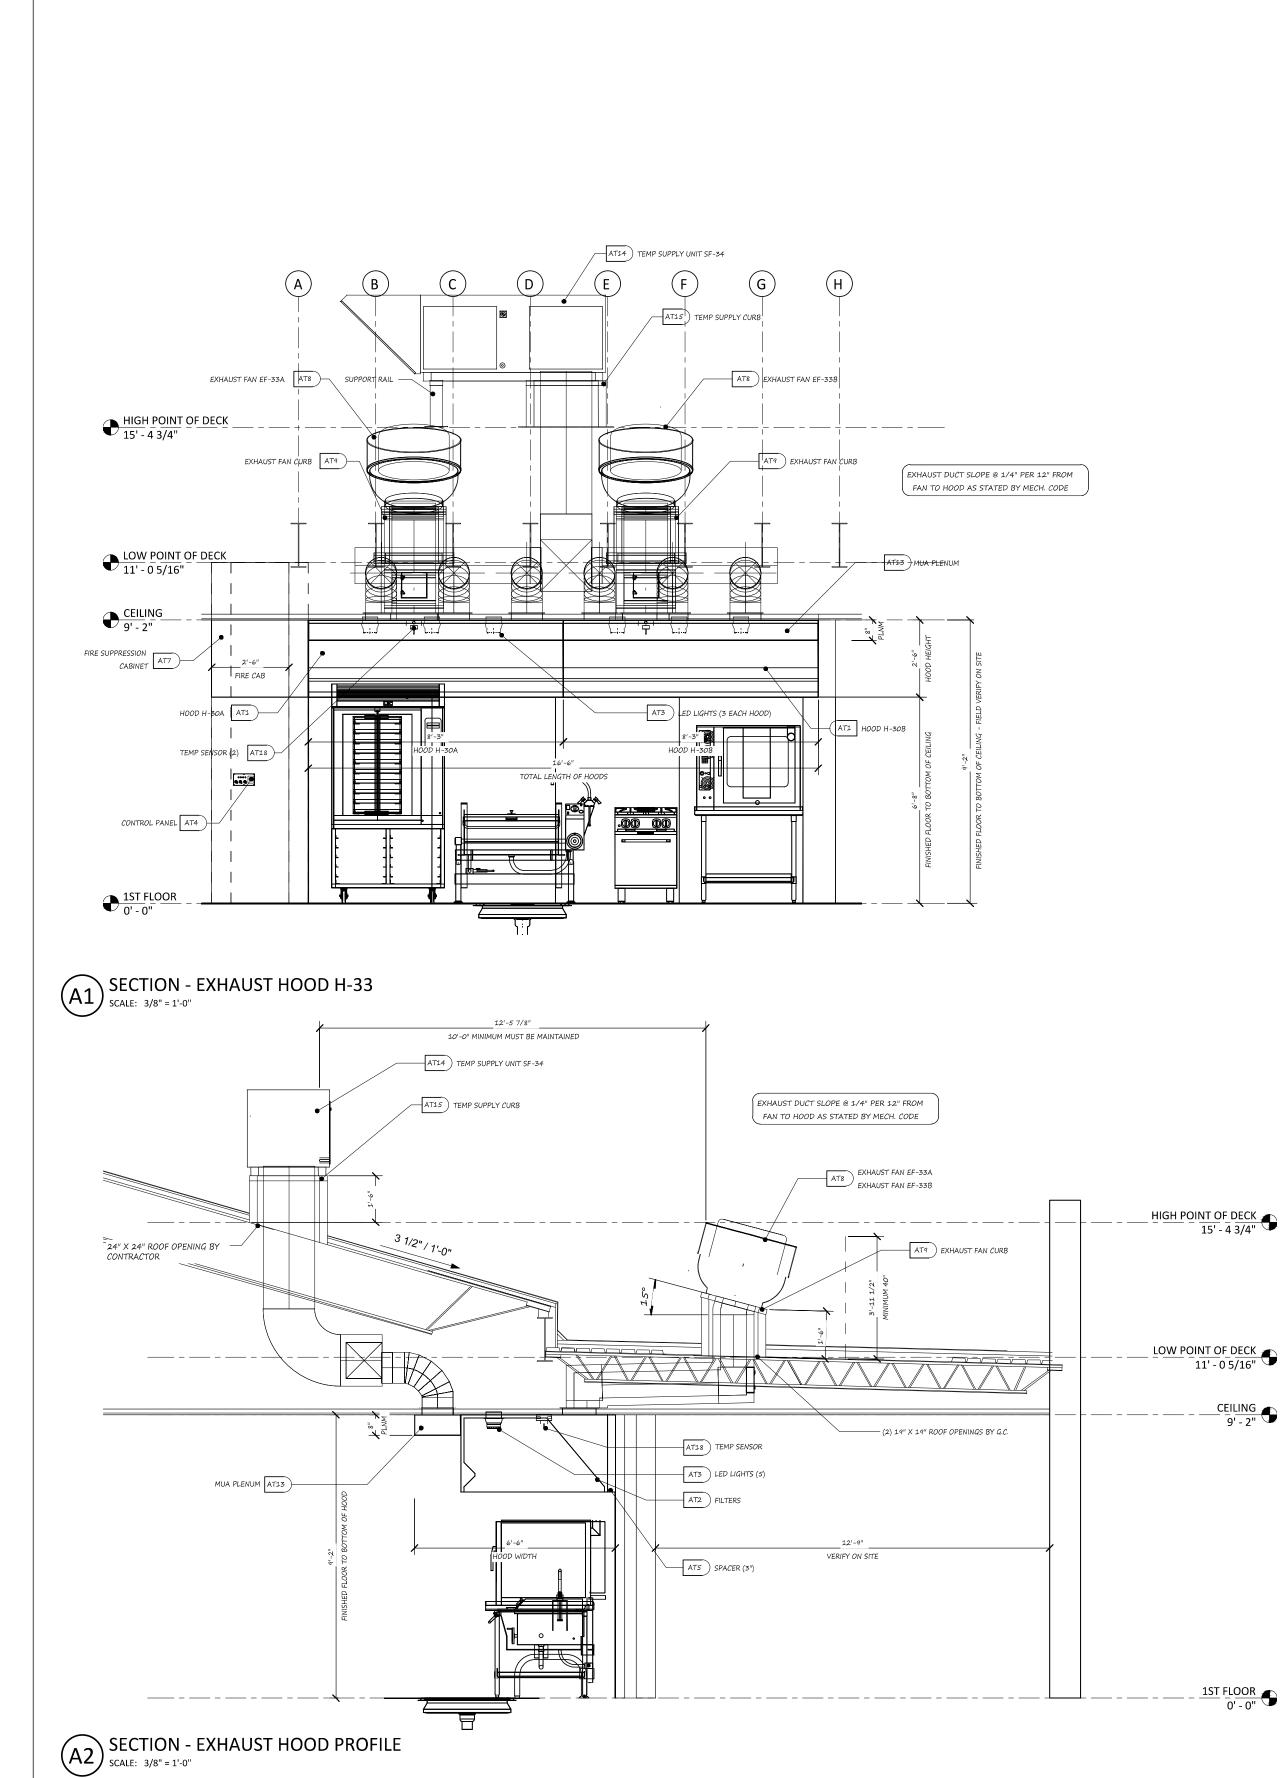

1. REMOTE WALL MOUNTED CONTROL PANEL

2. DESIGNED FOR OPERATION ON 24V CIRCUIT

AT4 - REMOTE MOUNTED HOOD CONTROL PANEL

FANS HEAT ALARM RESET

INDICATOR LIGHTS -

304 N/A

N/A

N/A

SIDE OVERHANG

SPACE BETWEEN HOOD & COOKING

EQUIPTMENT (MAX)

SCALE: NOT TO SCALE

HOOD LABEL

FOR USE WITH UL CLASSIFIED AL. OR STEEL GREASE FILTERS REPLACE FUSIBLE LINK WITH UL LISTED 3-20LB 165°F LINK

ROD CONNECTED TO ROOF JOIST BY OTHERS

1/2"-5/8" HEAVY DUTY LOCK NUT. ONE ABOVE

THREADED ROD, LOCK NUTS

BRACKET DETAIL

SCALE: NOT TO SCALE


AND BELOW, BY OTHERS

AND HARDWARE TO BE SUPPLIED

EQUIPMENT MUST BE SUPPORTED


BY INSTALLING CONTRACTOR.

BY ALL HANGING BRACKETS

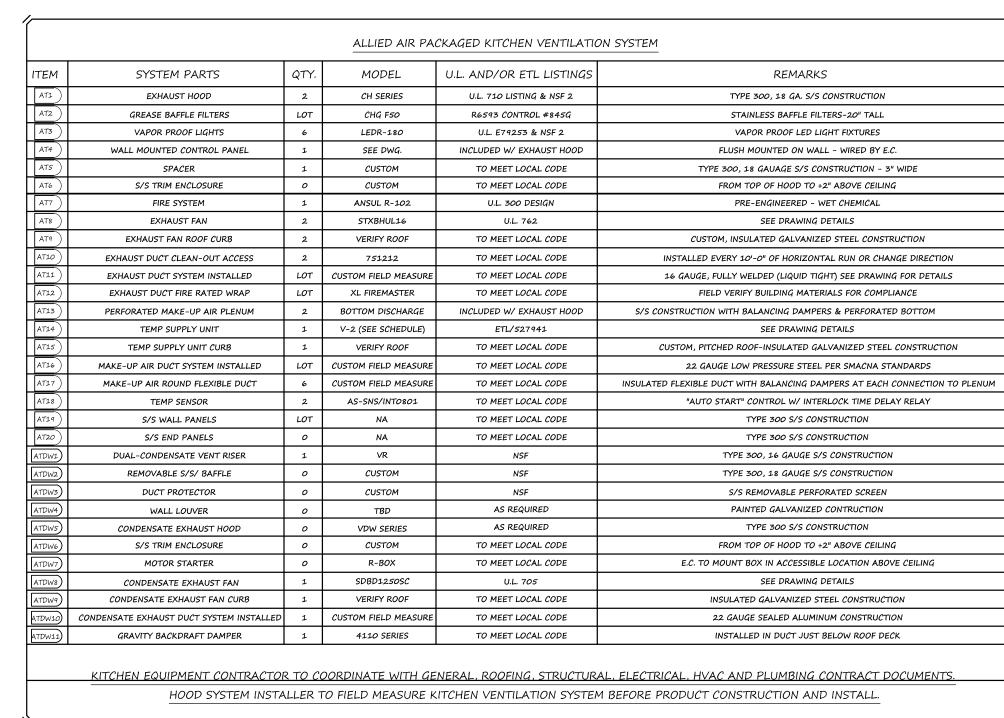



EXHAUST SYSTEM PLAN

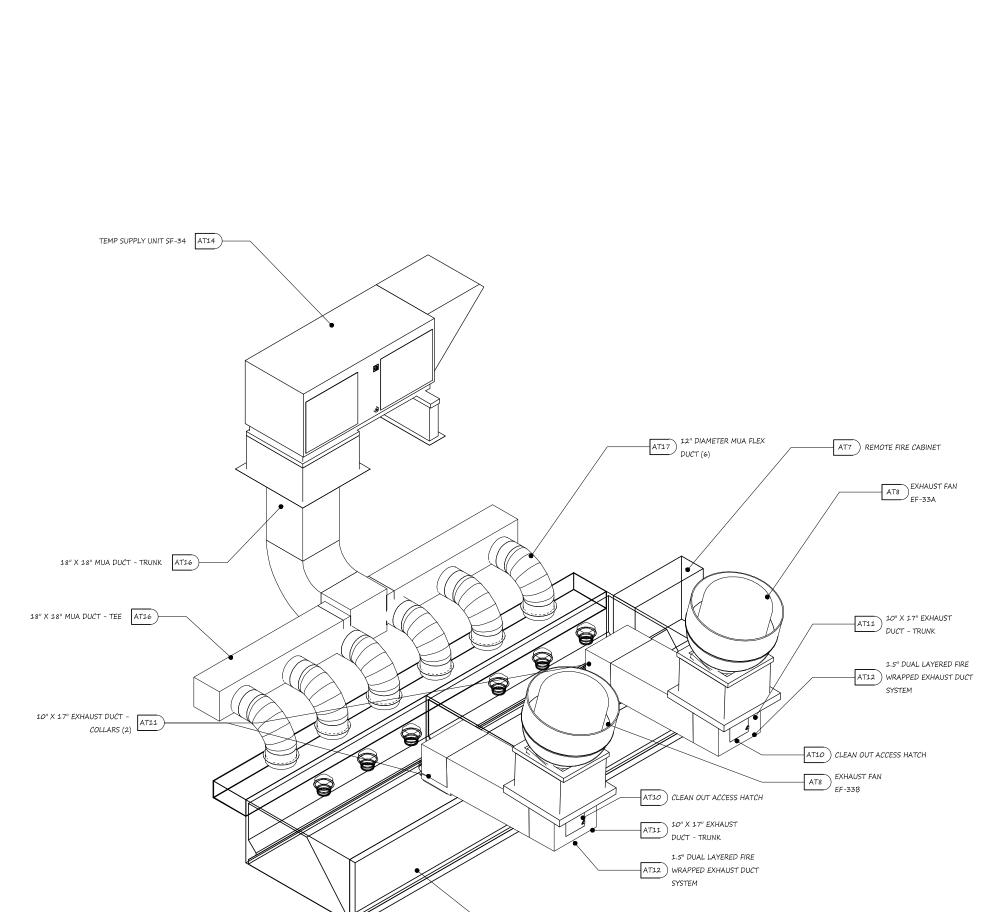


SUPPORT RAIL -

TEMP SUPPLY CURB AT15

DUCT SIZING MODEL

24" X 24" ROOF OPENING BY -CONTRACTOR

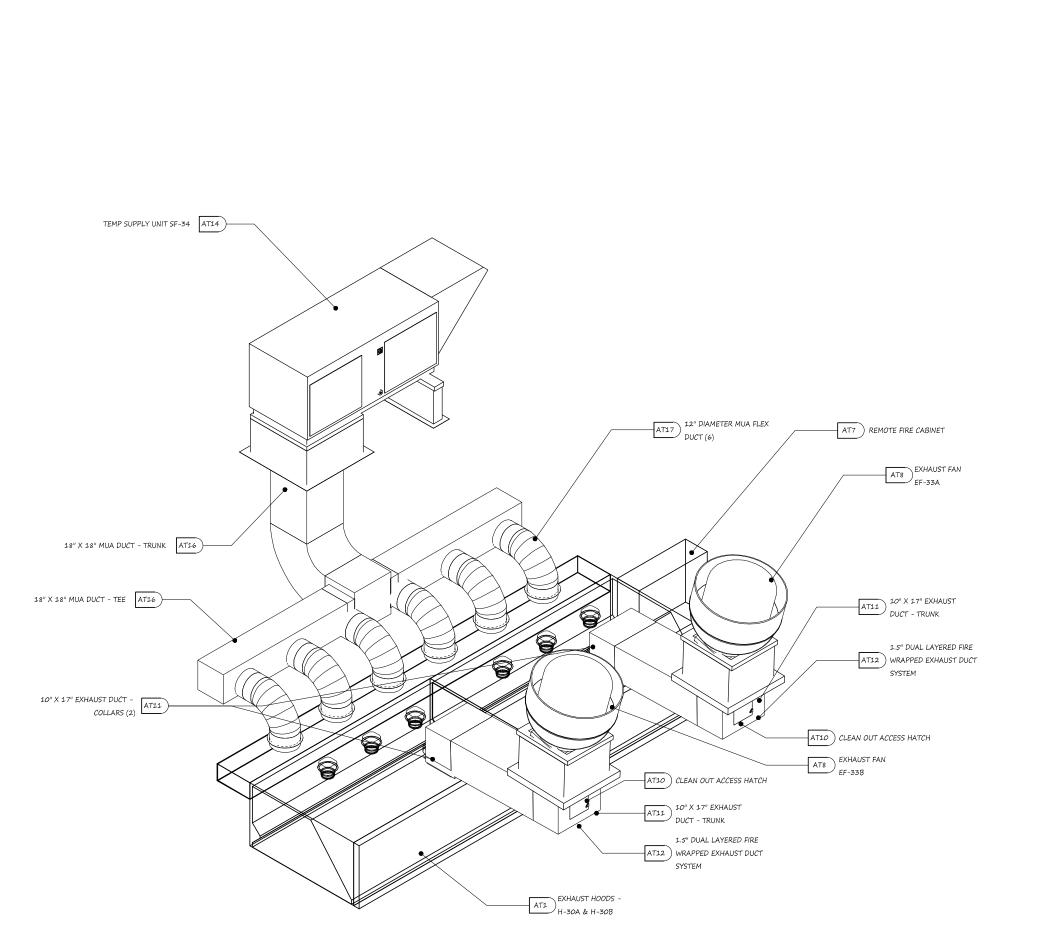



GIBRALTAR DESIGN ARCHITECTURE • ENGINEERING • INTERIOR DESIGN

EXHAUST DUCT SLOPE @ 1/4" PER 12" FROM FAN TO HOOD AS STATED BY MECH. CODE

SEE "DUCT SIZING MODEL" FOR DUCT SIZING INFORMATION & REFERENCES

EXHAUST FAN CURB AT9

3'-10 7/8"

ALLIED AIR REFERENCE (ATI) HOOD SCHEDULE

H-30A 8'-3" X 5' 581.5 2,132.5 10" X 17" 1,800 FPM .525" 1,704 (3) 12" DIA. 724

4,265

3,408

EXHAUST HOOD CFM

CFM TOTAL: 4,265 REMOVED BY HOODS: 4,865 RETURNED BY MUA: 3,408

EXHAUSTED AIR (CFM)

HEATED MAKE-UP AIR (CFM)

H-30B 8'-3" X 5' 581.5 2,132.5 10" X 17" 1,800 FPM .525" 1,704 (3) 12" DIA. 724

HOOD SIZE HOOD EXHAUST EXHAUST EXHAUST SUPPLY SUPPLY AIR SUPPLY AIR SUPPLY

VR-53 4"X16"X60" 60 600 (2) 4" X 16" 1,440 FPM .625" -0- N/A -0- -0-

WEIGHT CFM COLLAR SIZE DUCT VELOCITY S.P. CFM DUCT SIZE DUCT VELOCITY S.P.

CONDENSATE EXHAUST CFM

BALANCE REQUIRED BY HVAC: 1,457 CFM

EXHAUSTED CONDENSATE AIR (CFM)

MAKE-UP AIR (CFM)

AT8 EXHAUST FAN EF-33A

— 24" X 24" ROOF OPENING BY CONTRACTOR

AT10 CLEAN OUT

ACCESS HATCH

— 24" X 24" ROOF OPENING BY CONTRACTOR

AT10 CLEAN OUT
ACCESS HATCH

VERIFY REFERENCE ON SITE

DOUGLAS MACARTHUR ES ADDITIONS AND

RENOVATIONS CROWN POINT COMMUNITY SCHOOL CORPORATION

CROWN POINT, INDIANA

KEY PLAN GIBRALTAR DESIGN 9102 N. Meridian St., Ste. 300 Indianapolis, IN 46260
Homepage www.GibraltarDesign.com
Email info@GibraltarDesign.com
Phone 317.580.5777 Fax 317.580.5778

PROJECT 21-113 1/31/22 COORDINATED BY

RDG DRAWN BY JJN CHECKED BY RDG

COPYRIGHT NOTICE: THE CONCEPTS, DESIGNS, PLANS, DETAILS, ETC, SHOWN ON THIS DOCUMENT ARE THE PROPERTY OF GIBRALTAR DESIGN AN WERE CREATED FOR USE ON THIS SPECIFIC PROJECT. NONE O THIS INFORMATION SHALL BE USED BY ANY PERSON OR FIRM FOR ANY PURPOSE WITHOUT THE EXPRESS WRITTEN CONSENT OF GIBRALTAR DESIGN. THE OWNER MAY RETAIN COPIES FOR INFORMATION AND REFERENCE IN CONNECTION ONLY WITH THIS PROJECT.

REVISIONS MARK DATE ISSUED FOR 02/23/22 ADDENDUM #3 Allied Technologies Food Equipment, Inc. 926 SAYRE DRIVE GREENWOOD, IN 46142 317.887.2020 www.alliedfoodequipment.com

MACARTHUR ELEMENTARY SCHOOL CROWNE POINT, INDIANA DRAWING EXHAUST VENTILATION REITANO DESIGN GROUP

SYSTEM DRAWING, DETAILS & SCHEDULE $\int \int 1 \circ f 2$ PROJECT Scale: As indicated

Project Number MES122721

CHRIS OXFORD


Date 12.28.21


Revisions:

Ø 01.19.22

₿ 00.00.00 ₿ 00.00.00 DOUGLAS MACARTHUR ES ADDITIONS AND RENOVATIONS

© GIBRALTAR DESIGN SHEET

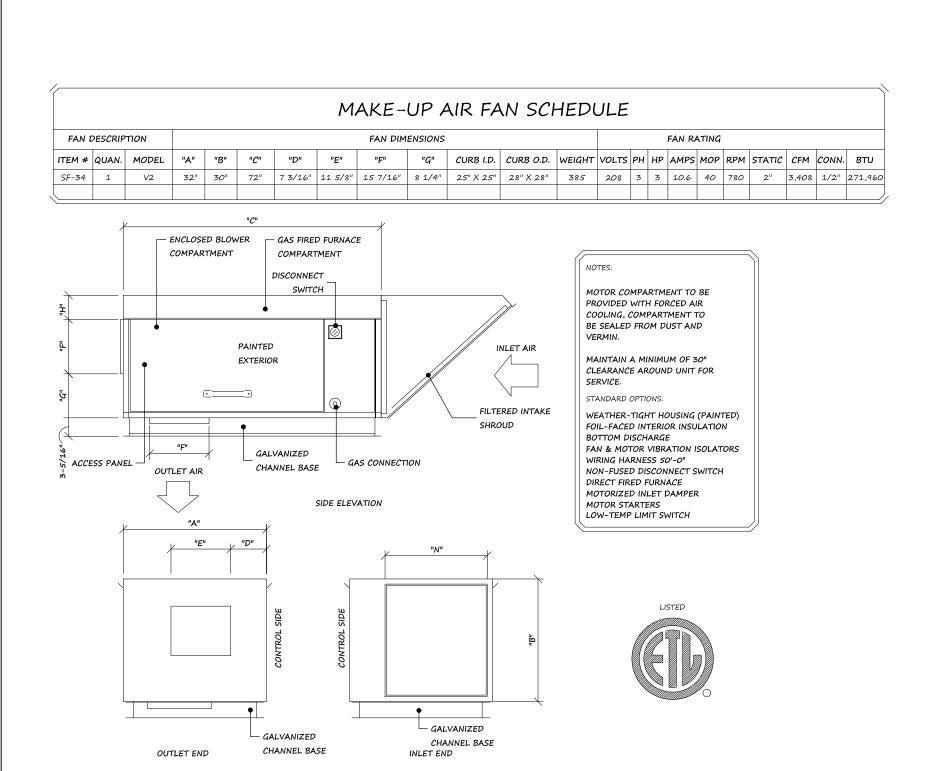


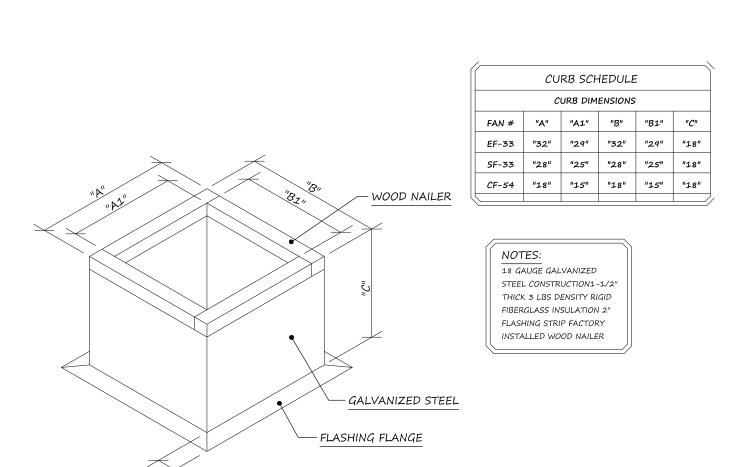


AT15 - CURB DETAIL SCALE: NOT TO SCALE

AT14 - MAKE-UP AIR UNIT DETAIL

SCALE: NOT TO SCALE

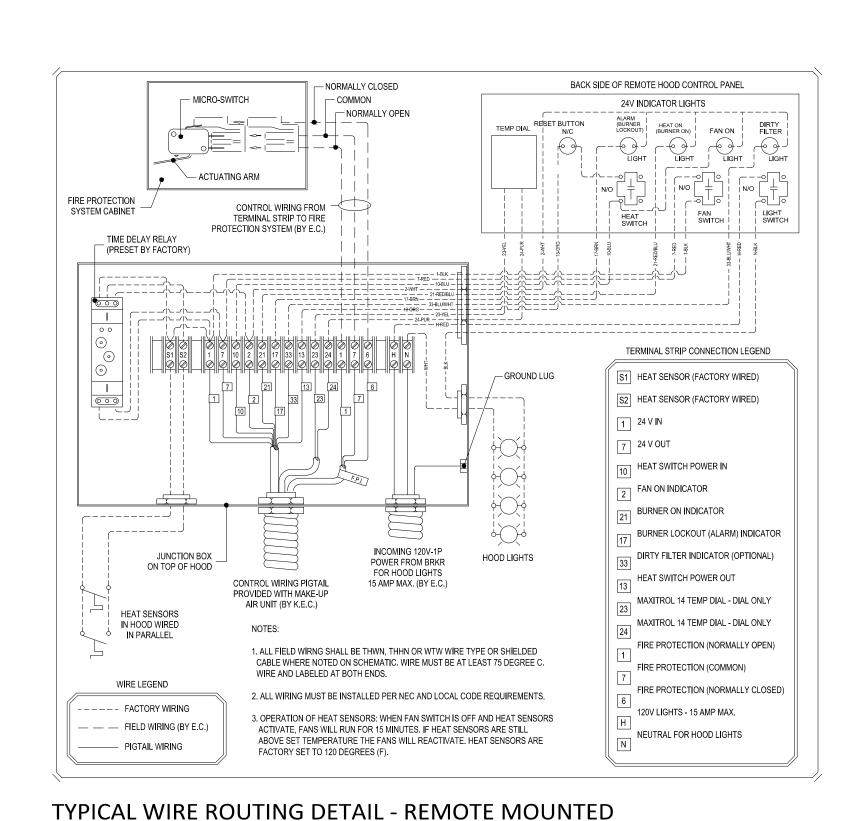

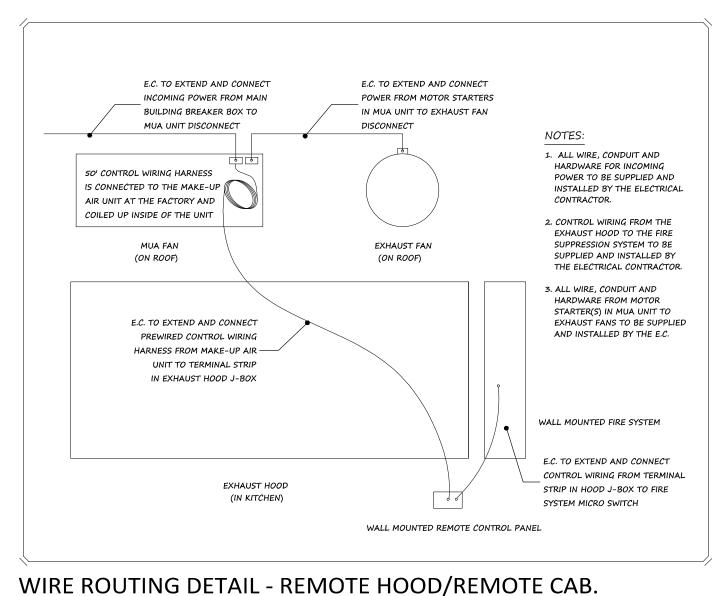

– FLASHING FLANGE

CONDENSATE EXHAUST FAN SCHEDULE

EXHAUST FAN SCHEDULE

ITEM # | QTY. | MODEL | "A" | "B" | "C" | CURB I.D. | CURB O.D. | LBS. | VOLTS | PH | HP | AMPS | RPM | STATIC | CFM

EF-33A | 1 | STXBRHUL-16 | 24" | 31.5" | 36.5" | 19" X 19" | 22" X 22" | 166 | 208 | 3 | 1 | 3.9 | 1,229 | 1.05" | 2,132.5 |

| EF-33B | 1 | STXBRHUL-16 | 24" | 31.5" | 36.5" | 19" X 19" | 22" X 22" | 166 | 208 | 3 | 1 | 3.9 | 1,229 | 1.05" | 2,132.5

BEARINGS

ENCLOSED MOTOR

MOTOR

MOTOR BASE

INSULATION

ALL ALUMINUM

CENTRIFUGAL WHEEL

DISCONNECT SWITCH

ONE PIECE INLET

-18 GAUGE GALVANIZED STEEL

-FACTORY INSTALLED WOOD

WELDED GALVANIZED STEEL CAP ON

TREATED WOOD FRAMING

CONSTRUCTION

NAILER

GALVANIZED

STEEL SKIN

-2" FLASHING STRIP

OVERSIZED VENT TUBE

EXHAUST FAN ASSEMBLY DESCRIPTION

SIZED FOR 150% OF DRIVE H.P., ADJUSTIBLE PITCH SHEAVES

BALL BEARING TYPE PERMANENTLY SEALED AND LUBRICATED

OPEN DRIP-PROOF CONSTURCTION STANDARD.

ISOLATES MOTOR ANDS DRIVES FOR EXHAUST AIR

MOTOR IS ADJUSTIBLE FOR PROPER BELT TENSION

HIGH TEMPERATURE INSULATION PROVIDES LONGER MOTOR LIFE

NON-OVERLOADING, BACKWARDS INCLINE TAPERED BLADES

FOR MAXIMUM EFFICIENCY AND MINIMUM SOUND

RAINPROOF ELECTRICAL BOX WITH WIRING CHASE. ELIMINATES

THE NEED TO UNWIRE AND REWIRE THE MOTOR WHEN

REMOVING MOTOR COMPARTMENT HOUSING

NON-OVERLOADING, BACKWARDS INCLINE TAPERED BLADES

FOR MAXIMUM EFFICIENCY AND MINIMUM SOUND

FAN DIMENSIONS

FAN RATING

PULLEY DRIVES

— MOTOR BASE

INSULATION

CENTRIFUGAL WHEEL

— DISCONNECT SWITCH

. PIECE INLET

BEARINGS

CURB O.D. LBS. VOLTS PH HP AMPS RPM STATIC CFM

FAN DESCRIPTION

FAN DESCRIPTION

PVC-ASSEMBLY INCLUDED FOR

FOR INSTALL

MOTOR COMPARTMENT TO BE PROVIDED

TO BE SEALED FROM CONTAMINATED

EXTERNALLY MOUNTED JUNCTION BOX

NEOPRENE ISOLATORS ARE INCLUDED TO

PREWIRED FOR FIELD CONNECTION.

REDUCE NOISE AND VIBRATION.

STANDARD ACCESSORIES:

UL762 RESTAURANT LISTING

INSULATED GALVANIZED CURB

FAN # "A"

SUPPORT RAIL DETAIL

AT8 - EXHAUST FAN DETAIL

SUPPORT RAIL SCHEDULE

CURB DIMENSIONS

SF-33 "49.5" "5" "15.75"

"B"

EXHAUST AIR.

GREASE TROUGH

HINGED CURB

WITH FORCED AIR COOLING, COMPARTMENT

DRAIN

— GREASE TROUGH

DRAIN RESERVOIR


ACCESSORIES: ALL ALUMINUM HOUSING FLAT ROOF CURB


BIRD SCREEN

UL705 APPROVAL

SPEED CONTROL (SHIPPED LOOSE) GRAVITY BACKDRAFT DAMPER

ATDW8 - DOWNBLAST EXHAUST FAN DETAIL

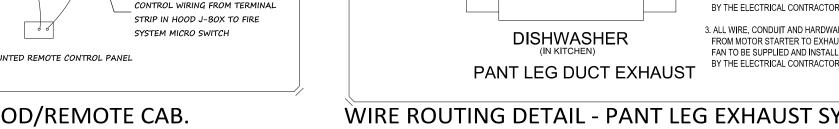

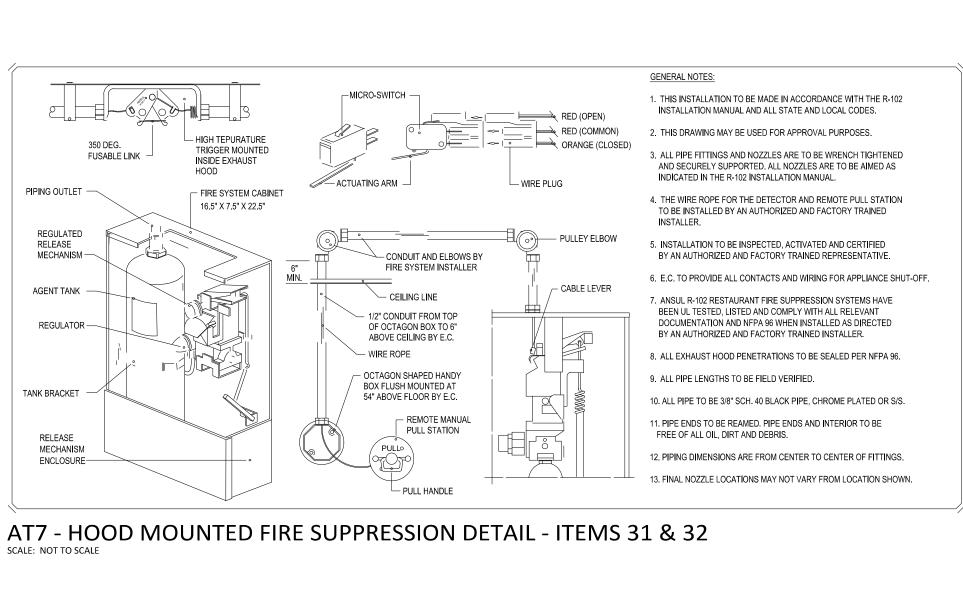

VR-53 ATDW1)

MODEL

CH SERIES

CHG F50

LEDR-180

CUSTOM

CUSTOM

ANSUL R-102

STXBHUL16

VERIFY ROOF

751212

CUSTOM FIELD MEASURE

XL FIREMASTER

BOTTOM DISCHARGE

V-2 (SEE SCHEDULE)

VERIFY ROOF

CUSTOM FIELD MEASURE

AS-SNS/INTO801

CUSTOM

CUSTOM

VDW SERIES

CUSTOM

R-BOX

VERIFY ROOF

CUSTOM FIELD MEASURE

4110 SERIES

ALLIED AIR PACKAGED KITCHEN VENTILATION SYSTEM

U.L. AND/OR ETL LISTINGS

U.L. 710 LISTING & NSF 2

R6593 CONTROL #845G

U.L. E79253 & NSF 2

TO MEET LOCAL CODE

TO MEET LOCAL CODE

U.L. 300 DESIGN

TO MEET LOCAL CODE

TO MEET LOCAL CODE

TO MEET LOCAL CODE

INCLUDED W/ EXHAUST HOOD

TO MEET LOCAL CODE

AS REQUIRED

AS REQUIRED

TO MEET LOCAL CODE

KITCHEN EQUIPMENT CONTRACTOR TO COORDINATE WITH GENERAL, ROOFING, STRUCTURAL, ELECTRICAL, HVAC AND PLUMBING CONTRACT DOCUMENTS. HOOD SYSTEM INSTALLER TO FIELD MEASURE KITCHEN VENTILATION SYSTEM BEFORE PRODUCT CONSTRUCTION AND INSTALL

TO MEET LOCAL CODE

B CONDENSATE SYSTEM PLAN

SCALE: 3/8" = 1'-0"

SYSTEM PARTS

EXHAUST HOOD

GREASE BAFFLE FILTERS

VAPOR PROOF LIGHTS

SPACER

S/S TRIM ENCLOSURE

FIRE SYSTEM

EXHAUST FAN ROOF CURB

EXHAUST DUCT SYSTEM INSTALLED

EXHAUST DUCT FIRE RATED WRAP

PERFORATED MAKE-UP AIR PLENUM

TEMP SUPPLY UNIT

TEMP SUPPLY UNIT CURB

MAKE-UP AIR ROUND FLEXIBLE DUCT

S/S WALL PANELS

DUAL-CONDENSATE VENT RISER

REMOVABLE S/S/ BAFFLE

DUCT PROTECTOR

WALL LOUVER

CONDENSATE EXHAUST HOOD

S/S TRIM ENCLOSURE


MOTOR STARTER


CONDENSATE EXHAUST FAN CURB


GRAVITY BACKDRAFT DAMPER

CONDENSATE EXHAUST FAN

CONDENSATE EXHAUST DUCT SYSTEM INSTALLED

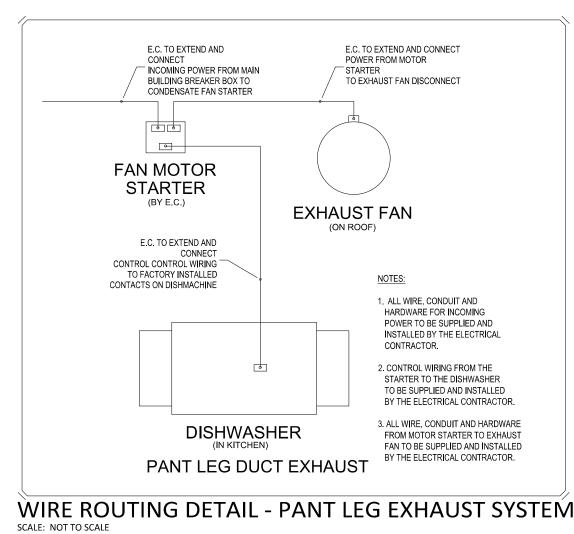

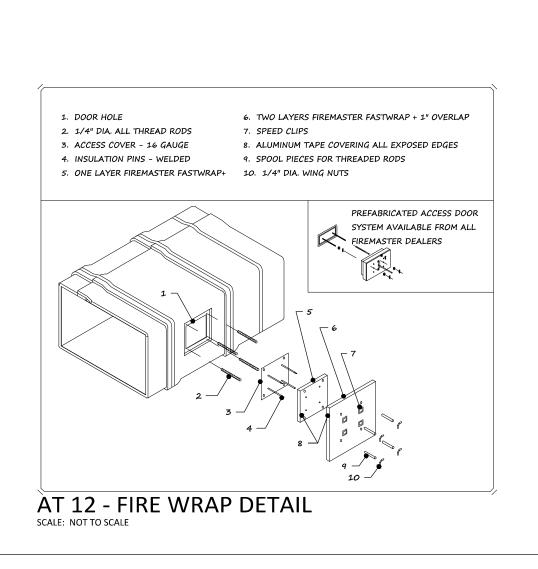

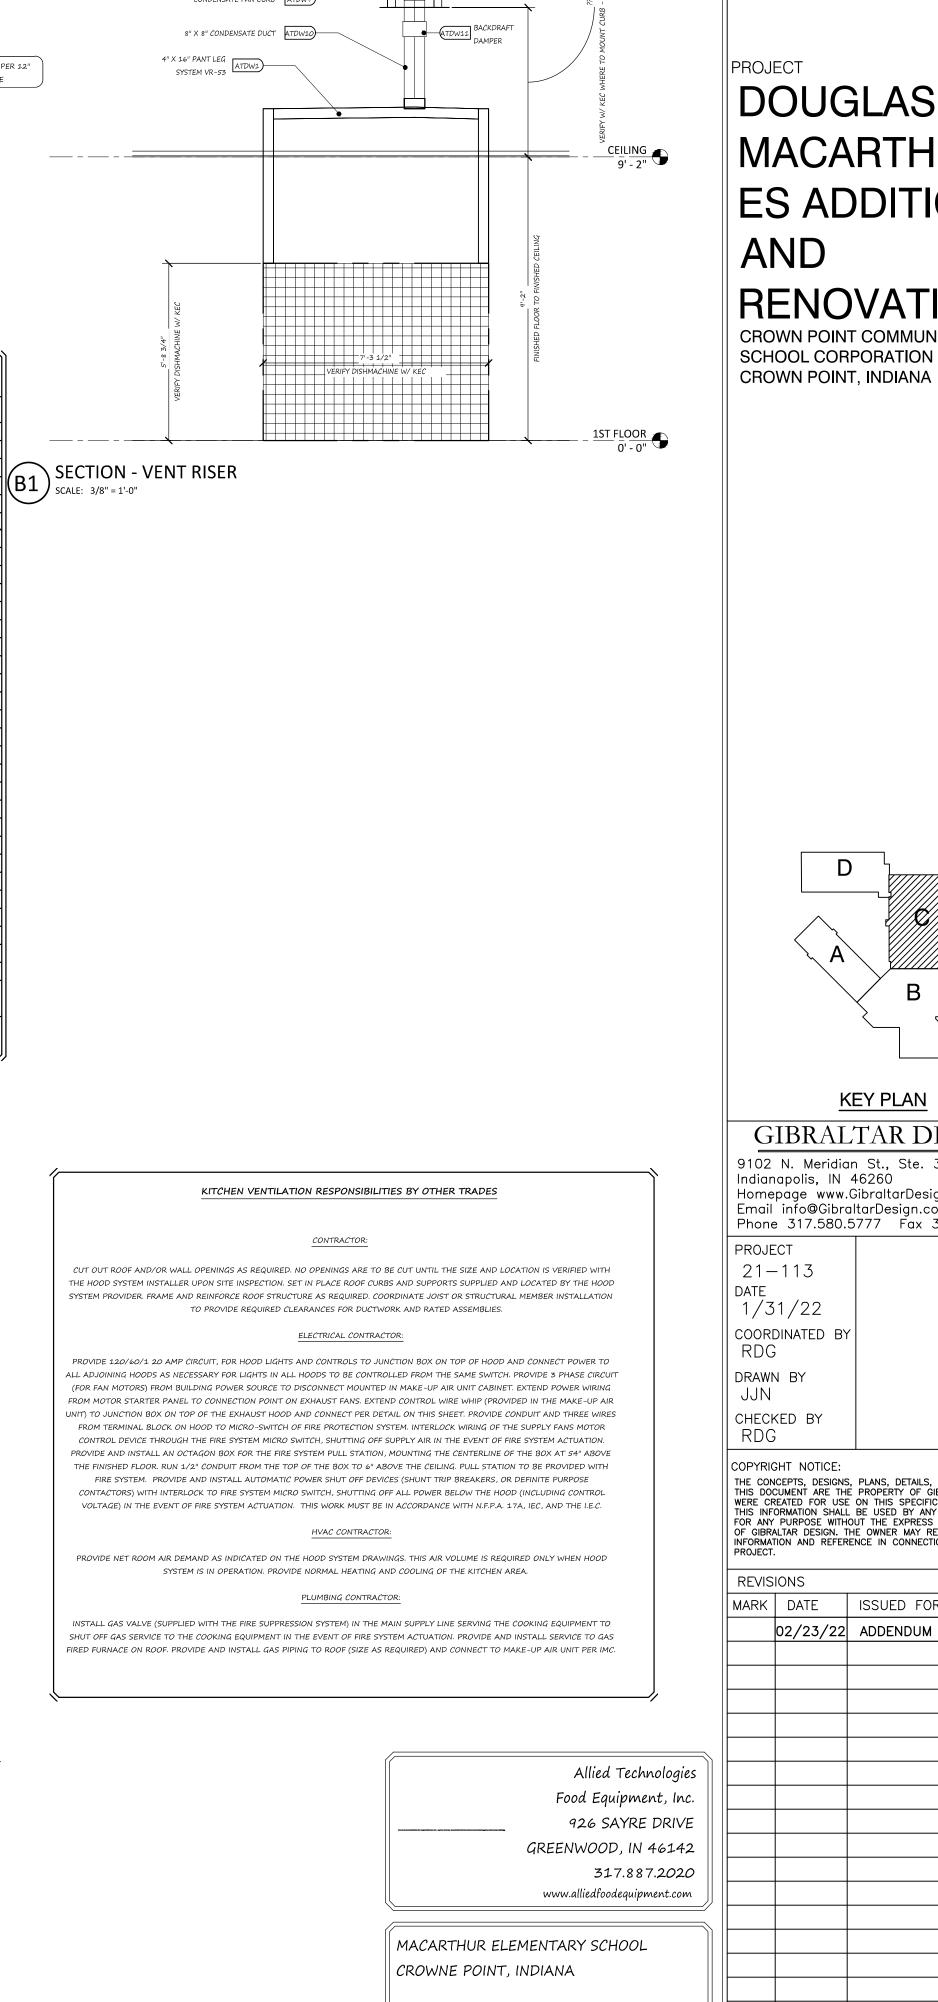

REITANO DESIGN GROUP

 $\int 2 \text{ of } 2$

Scale: As indicated

Project Number MES122721

CHRIS OXFORD

Revisions:

Ø 01.19.22

₿ 00.00.00

₿ 00.00.00

Date 12.28.21

CONDENSATE FAN CF-54 ATDW8

CONDENSATE DUCT SLOPE @ 1/8" PER 12"

AS STATED BY MECH. CODE

REMARKS

TYPE 300, 18 GA. S/S CONSTRUCTION

STAINLESS BAFFLE FILTERS-20" TALL

VAPOR PROOF LED LIGHT FIXTURES

FLUSH MOUNTED ON WALL - WIRED BY E.C.

TYPE 300, 18 GAUAGE S/S CONSTRUCTION - 3" WIDE

FROM TOP OF HOOD TO +2" ABOVE CEILING

SEE DRAWING DETAILS

CUSTOM, INSULATED GALVANIZED STEEL CONSTRUCTION

16 GAUGE, FULLY WELDED (LIQUID TIGHT) SEE DRAWING FOR DETAILS

FIELD VERIFY BUILDING MATERIALS FOR COMPLIANCE

CUSTOM, PITCHED ROOF-INSULATED GALVANIZED STEEL CONSTRUCTION

INSULATED FLEXIBLE DUCT WITH BALANCING DAMPERS AT EACH CONNECTION TO PLENUM

"AUTO START" CONTROL W/ INTERLOCK TIME DELAY RELAY

TYPE 300 S/S CONSTRUCTION

TYPE 300, 16 GAUGE S/S CONSTRUCTION

TYPE 300, 18 GAUGE S/S CONSTRUCTION

S/S REMOVABLE PERFORATED SCREEN

PAINTED GALVANIZED CONTRUCTION

TYPE 300 S/S CONSTRUCTION

FROM TOP OF HOOD TO +2" ABOVE CEILING

E.C. TO MOUNT BOX IN ACCESSIBLE LOCATION ABOVE CEILING

SEE DRAWING DETAILS

INSULATED GALVANIZED STEEL CONSTRUCTION

22 GAUGE SEALED ALUMINUM CONSTRUCTION

INSTALLED IN DUCT JUST BELOW ROOF DECK

TYPE 300 S/S CONSTRUCTION

S/S CONSTRUCTION WITH BALANCING DAMPERS & PERFORATED BOTTOM

GIBRALTAR DESIGN

ARCHITECTURE • ENGINEERING • INTERIOR DESIGN

DOUGLAS MACARTHUR ES ADDITIONS AND

RENOVATIONS **CROWN POINT COMMUNIT** SCHOOL CORPORATION

GIBRALTAR DESIGN 9102 N. Meridian St., Ste. 300 Indianapolis, IN 46260 Homepage www.GibraltarDesign.com Email info@GibraltarDesign.com Phone 317.580.5777 Fax 317.580.5778

21-113 1/31/22 COORDINATED B'

DRAWN BY

COPYRIGHT NOTICE: THE CONCEPTS, DESIGNS, PLANS, DETAILS, ETC, SHOWN ON THIS DOCUMENT ARE THE PROPERTY OF GIBRALTAR DESIGN AND WERE CREATED FOR USE ON THIS SPECIFIC PROJECT. NONE OF THIS INFORMATION SHALL BE USED BY ANY PERSON OR FIRM FOR ANY PURPOSE WITHOUT THE EXPRESS WRITTEN CONSENT OF GIBRALTAR DESIGN. THE OWNER MAY RETAIN COPIES FOR INFORMATION AND REFERENCE IN CONNECTION ONLY WITH THIS PROJECT.


MARK DATE ISSUED FOR 02/23/22 ADDENDUM #3

DRAWING **EXHAUST VENTILATION**


SYSTEM DRAWING, DETAILS & SCHEDULE PROJECT


DOUGLAS MACARTHUR ES ADDITIONS AND RENOVATIONS

© GIBRALTAR DESIGN SHEET

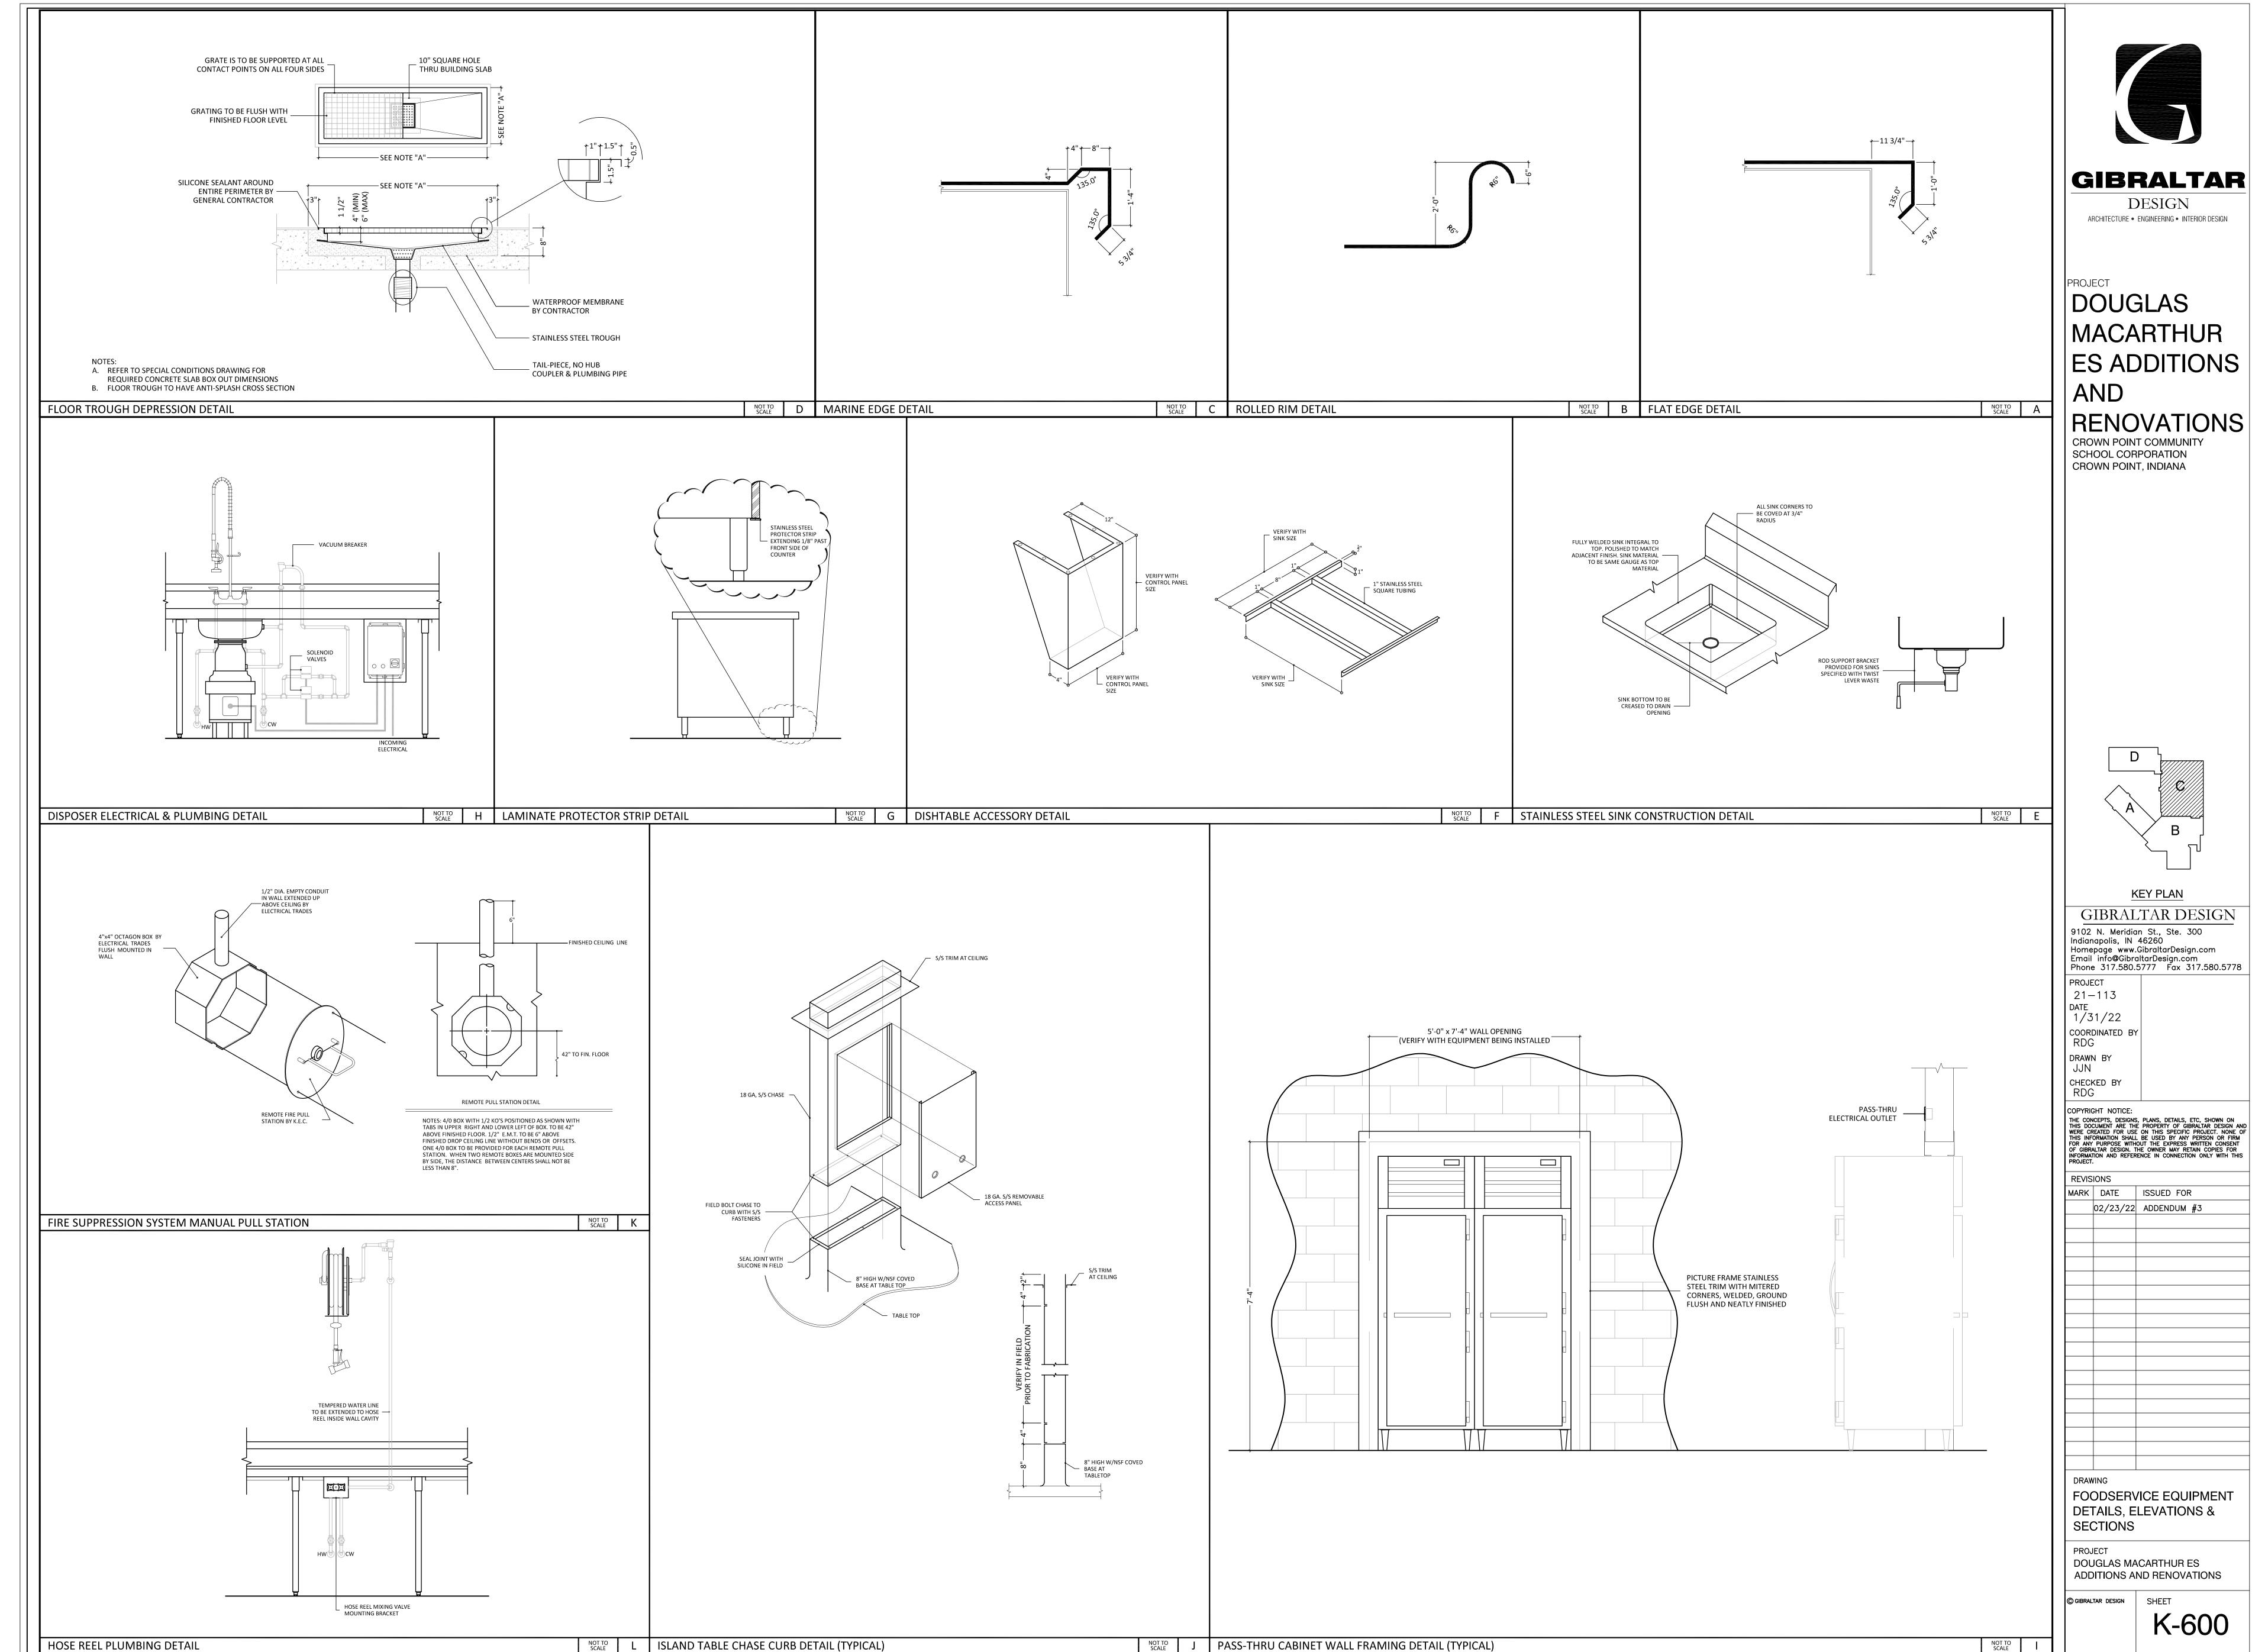


Wednesday, 2/23/2022 — 10:12 AM — LAST SAVED BY G:\SHARED DRIVES\RDG PROJECT DATA\RDG PROJECT FOLDER (2021)\2021—025 — GIBRALTAR — MACARTHUR ELEMENTARY SCHOOL\3. DRAWINGS\A. CAD\QF—2021—025—ELEV.DWG

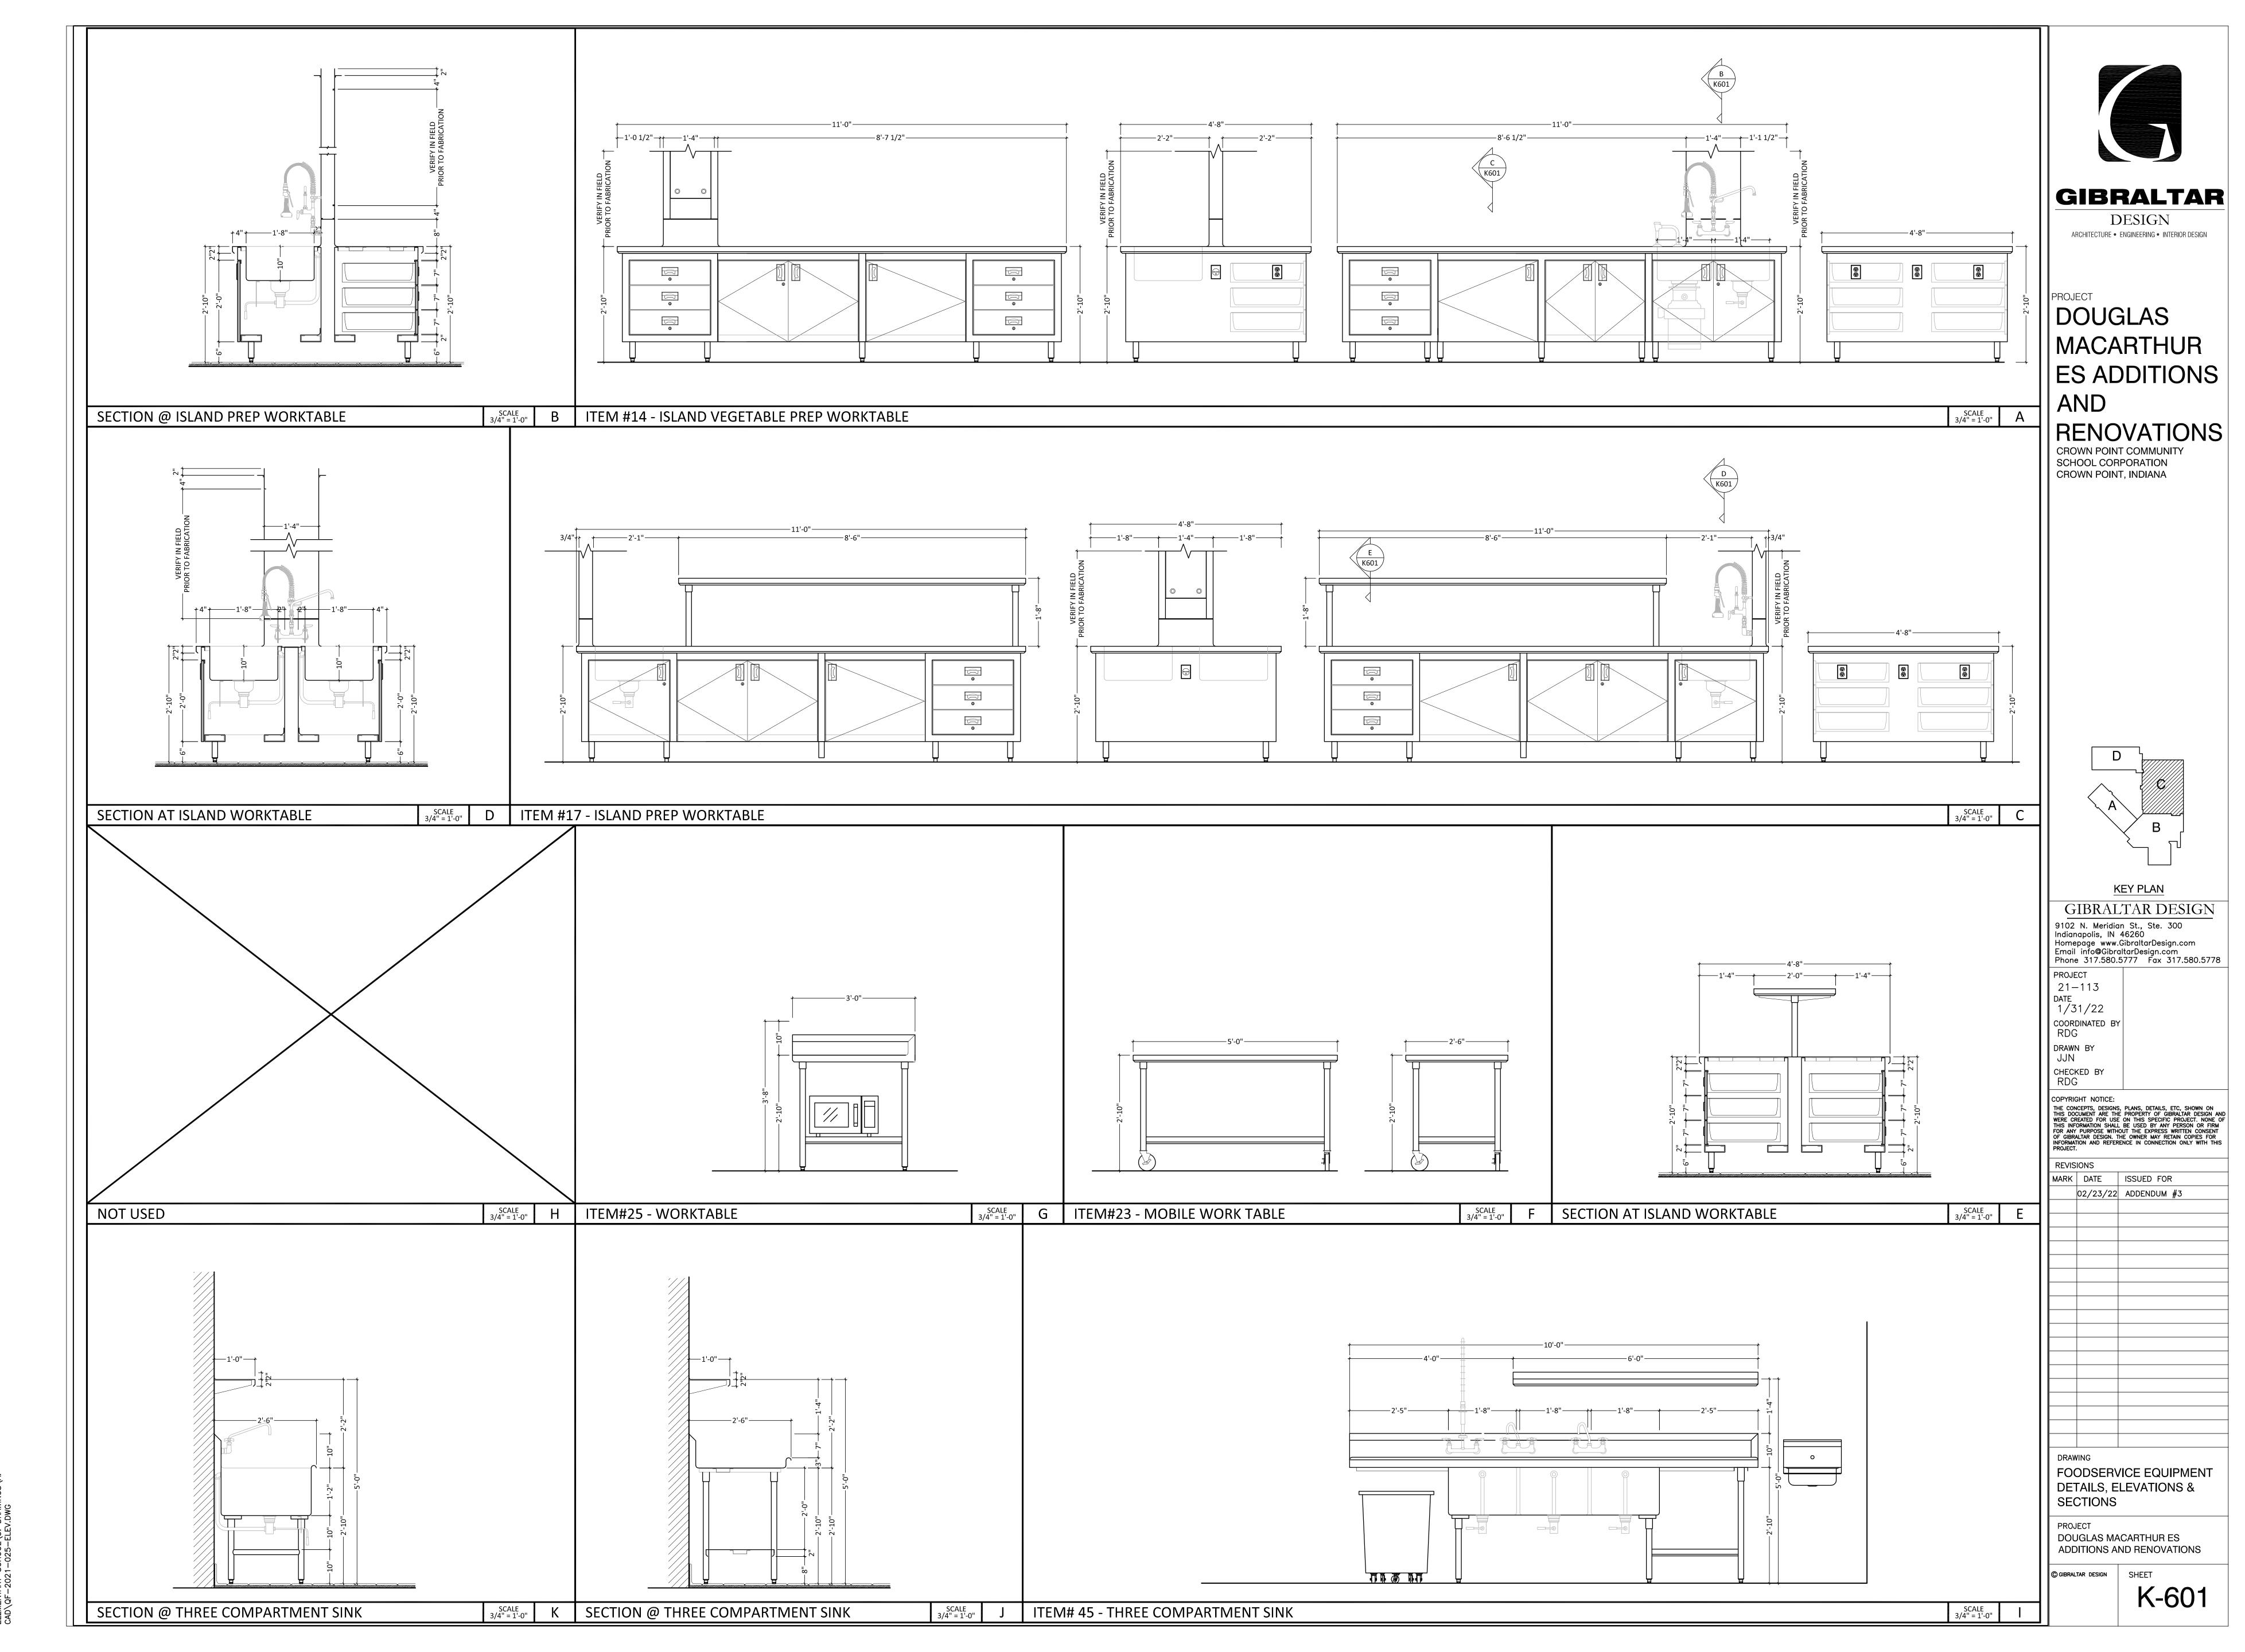

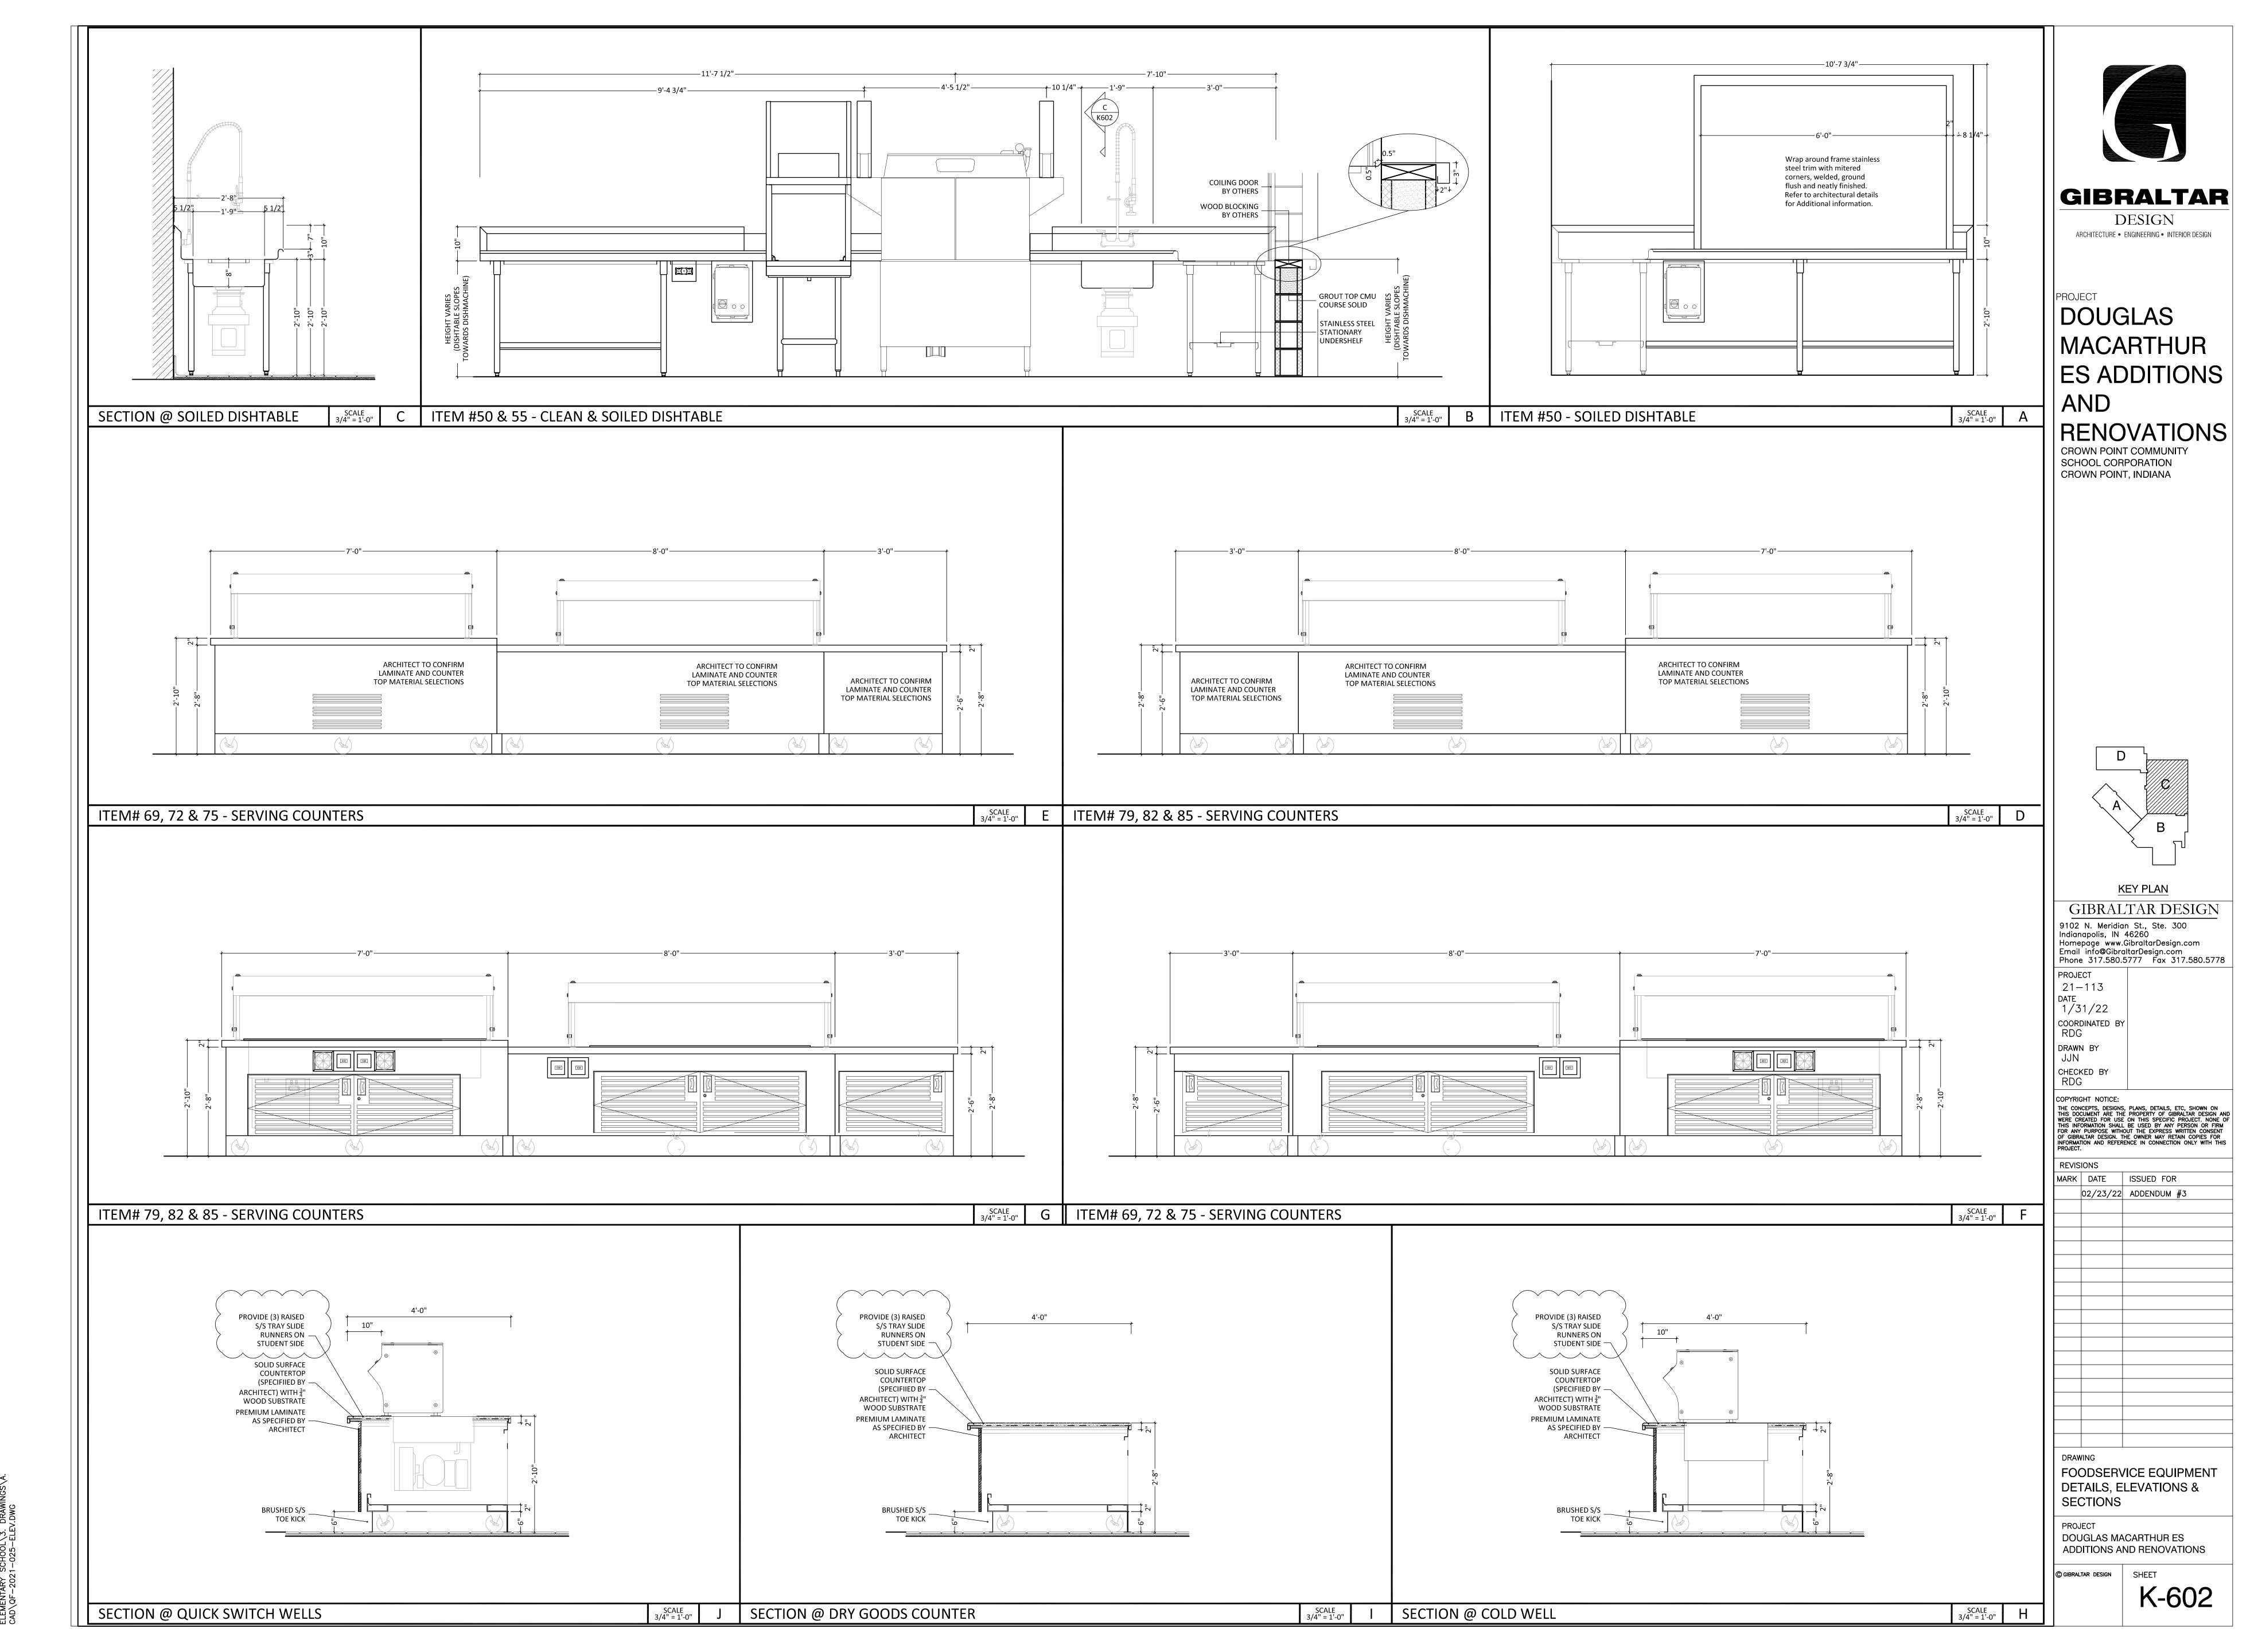

Wednesday, 2/23/2022 — 10:19 AM — LAST SAVED BY:JONATHAN NIKIEL G:\SHARED DRIVES\RDG PROJECT DATA\RDG PROJECT FOLDER (2021)\2021—025 — GIBRALTAR — MACARTHUR ELEMENTARY SCHOOL\3. DRAWINGS\A. CAD\QF—2021—025—ELEV.DWG

Wednesday, 2/23/2022 — 10:20 AM — LAST SAVED BY G:\SHARED DRIVES\RDG PROJECT DATA\RDG PROJECT FOLDER (2021)\2021—025 — GIBRALTAR — MACARTHUR ELEMENTARY SCHOOL\3. DRAWINGS\A. CAD\QF—2021—025—ELEV.DWG

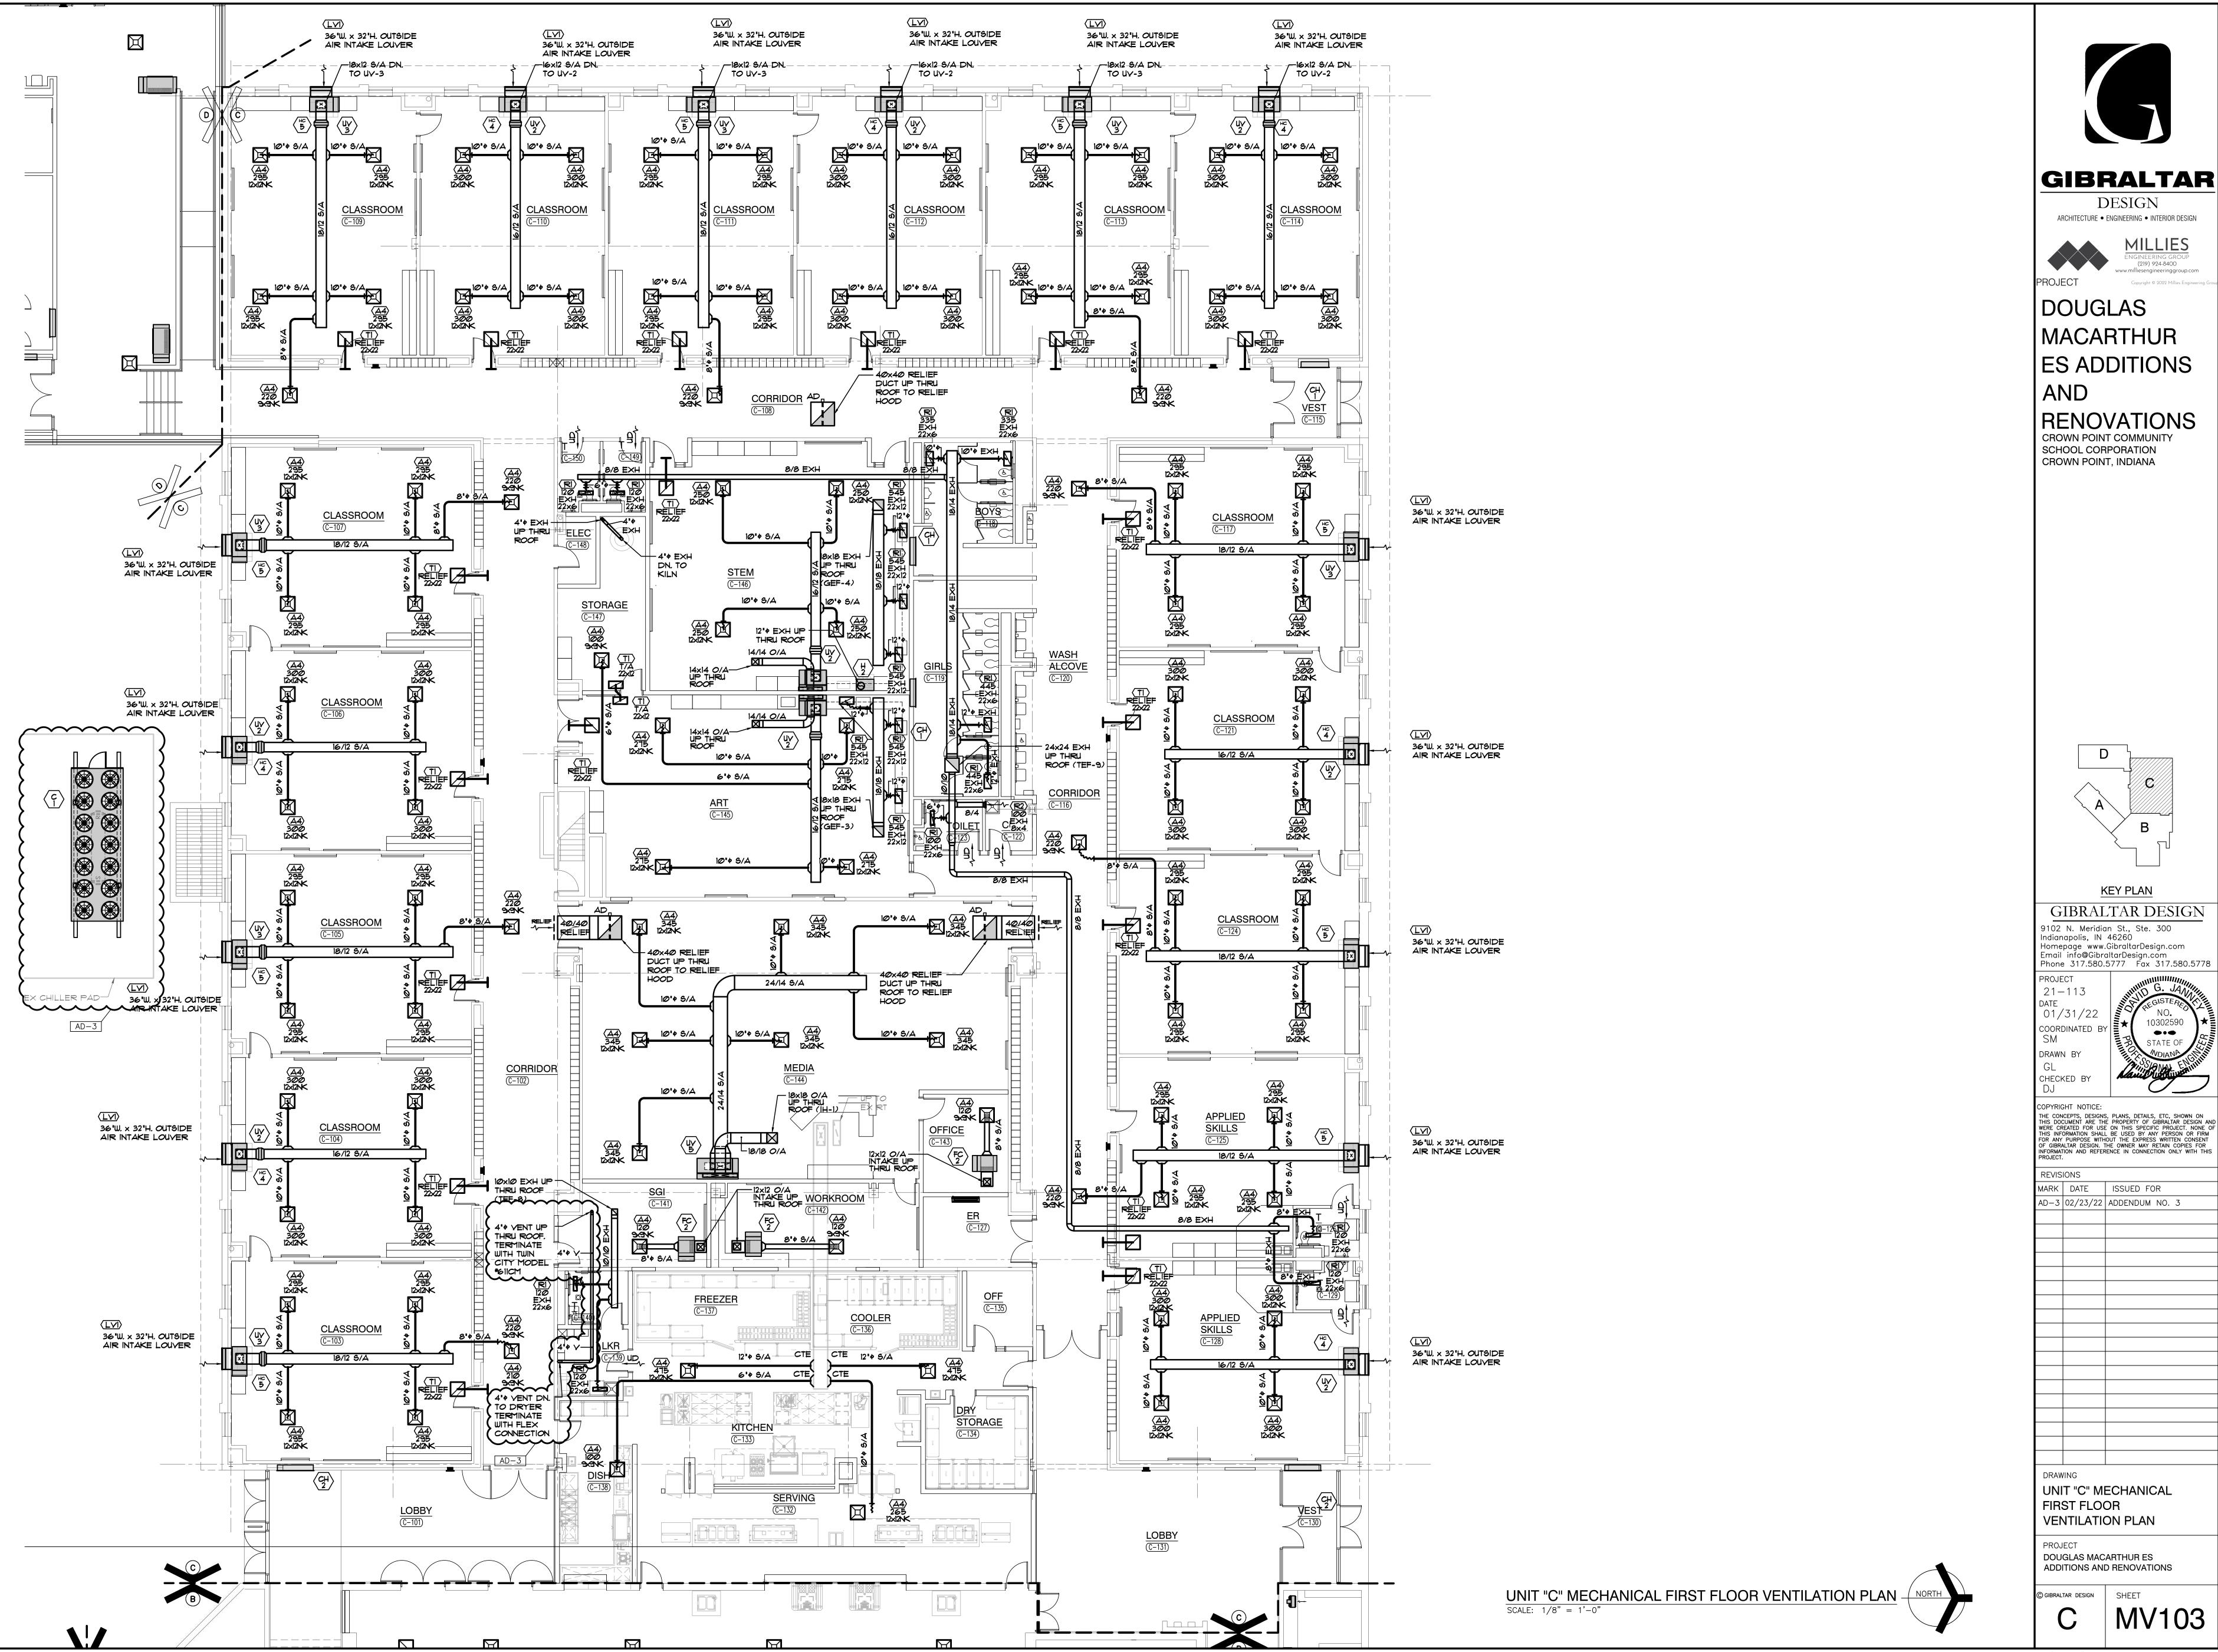

GIBRALTAR DESIGN

THE CONCEPTS, DESIGNS, PLANS, DETAILS, ETC, SHOWN ON THIS DOCUMENT ARE THE PROPERTY OF GIBRALTAR DESIGN AND WERE CREATED FOR USE ON THIS SPECIFIC PROJECT. NONE OF THIS INFORMATION SHALL BE USED BY ANY PERSON OR FIRM FOR ANY PURPOSE WITHOUT THE EXPRESS WRITTEN CONSENT OF GIBRALTAR DESIGN. THE OWNER MAY RETAIN COPIES FOR INFORMATION AND REFERENCE IN CONNECTION ONLY WITH THIS PROJECT.

\bigcirc									MEC	HANICAL	EQUIP	MENT	SCHE	DULE								
					FAN 1	IOTOR DATA	EXHA	JUST FANS	DX COOLING EQUIP DATA	CHILLED WA	TER COOLING D	ATA		ER HEATING DAT		WATER PREHEATING COIL	DATA	E	ECTRICAL DATA	UNITS	EQUIP	
TAG	MANUFACTURER	MODEL NUMBER	DESCRIPTION	EFF CFM H	HIGH LOW	TSP FSP B				BH SHC GPM EDB EWE		MAX MAX		M FAT I AT FUR	MAX MBH		MAXLOAD TURN HR MCA	ELA AMPSMOCE	YOLTPHASE HZ. MC. E		WEIGHT	EMARKS
C-1	TRANE	RTAC-25Ø	GRADE MOUNTED AIR COOLED CHILLER	9.8 EER -						98 - 577		44 25					490		480 3 60 ×	- FMS	15200 No	OTE 1
ΔΗ-1	TRANE	CSAAØ14	INTERIOR CENTRAL STATION AIR HANDLING UNIT	- 6860 1	1200 -	6.3 2.7 9	3.9 (2)7.5 3308 -		28	53 198 503 80 65	53 52 44	54 15			97.7	9.8 -10 65 160 140	0 15 - 69	110	208 3 60 ×	- FMS	3885 No	OTE 2
A(1-1			HOT WATER HEATING / CHILLED WATER COOLING - VAV				6860	1.4 4.6 (2)3 261	5								28	45	208 3 60 ×	- FMS		
∆ H-2	TRANE	CSAAØ21	INTERIOR CENTRAL STATION AIR HANDLING UNIT	- 9550 4	4500 955	4.9 1.4	12 (2)71.5 2272 -		54	40 341 108 83 68,	9 50 50 44	54 15	- 598 60	90 32 90 160	0 140 15 155	16 55 70 100 80	0 15 - 69	110	208 3 60 ×	- FMS	5540 No	OTE 2
AH-2	INAINE	CSAADZI	HOT WATER HEATING / CHILLED WATER COOLING - CAY				9550	1.1 5.2 (2)3 161									28	45	208 3 60 ×	- FMS		
411.2	+ 4.1-	CC 4 4 010		- 5960 2	2980 596	3.7 1.1 6	6.6 (2)5 2891 -		36	58 225 73.4 86 71	51 50 44	54 15	- 388 39	30 90 160	0 140 15 97	9.7 55 70 100 86	0 15 - 46	80	208 3 60 ×	- FMS	3915 No	.OTE 2
AH-3	TRANE	C\$AAØ12	INTERIOR CENTRAL STATION AIR HANDLING UNIT HOT WATER HEATING / CHILLED WATER COOLING - CAY				5960	Ø.9 3.8 (2)3 29i:	3								28	45	208 3 60 ×	- FMS		
∨u ∨-1	ENGINEERED AIR	RUY-800	VERTICAL UNIT VENTILATOR - 4 PIPE HOT/CHILLED WATER	- 800	180 -		- 1/3		29	9.9 20.4 6 80 67	56 55 44	54 15	- 45.9 4.6	5 44 93 160	0 140 15 -		8.3	20	120 1 60 ×	- FMS	535 No	.OTE 3
∀ U ∀ -2	ENGINEERED AIR	RUY-1200	VERTICAL UNIT VENTILATOR - 4 PIPE HOT/CHILLED WATER	- 1200	385 -		- 1/2		4	4.2 31.1 9 80 67	56 55 44	54 15	- 646 68	6 40 90 160	0 140 15 -		8	20	120 1 60 ×	- FMS	590 N	.OTE 3
∀ U ∀ -3	ENGINEERED AIR	RUV-1400	VERTICAL UNIT VENTILATOR - 4 PIPE HOT/CHILLED WATER	- 1400	470 -		- 3/4		5	2.3 36.5 10 80 67	56 55 44	54 15	- T9.9 8	40 93 160	0 140 15 -		13	20	120 1 60 ×	- FMS	645 No	.OTE 3
YUY-4	ENGINEERED AIR	RUV-1600	VERTICAL UNIT VENTILATOR - 4 PIPE HOT/CHILLED WATER	- 1600	530 -		- 3/4		6:	2.8 43 12 80 67	55 54 44	54 15	- 107 11	40 95 160	0 140 15 -		13	20	120 1 60 ×	- FMS	700 N	
	ENGINEERED AIR		VERTICAL UNIT VENTILATOR - 4 PIPE HOT/CHILLED WATER			- -	- (2) 1/2			3.9 63.9 18 80 67				40 90 160	0 140 15 -		14			- FMS	900 N	
FC-I	TRANE		HORIZONTAL DUCTED FAN COIL UNIT - 4 PIPE HOT/CHILLED WATER				- 0.13 1002 -			0.2 6.6 2.03 79 67							28	15			109 No	
FC-2	TRANE		HORIZONTAL DUCTED FAN COIL UNIT - 4 PIPE HOT/CHILLED WATER				- 0.13 1254 -			57 2.75 0.71 79 66				3 58 120 160			28	15	120 1 60 -		81 No	
FC-3	TRANE		HORIZONTAL DUCTED FAN COIL UNIT - 4 PIPE HOT/CHILLED WATER				- 022 1150 -			3 21.8 4.6 76 63	59 56 44	54 10					61	15			200 No	
FC-4	TRANE		HORIZONTAL DUCTED FAN COIL UNIT - 4 PIPE HOT/CHILLED WATER				- 022 1313 -			.5 17.1 3.7 76 63				1 67 132 160			6.1	15			200 No	
FC-5	TRANE		HORIZONTAL DUCTED FAN COIL UNIT - 4 PIPE HOT/CHILLED WATER				- 022 1375 -			3 10.6 2.25 76 63							3.9				140 No	
AC-1/CU-1	MITSUBISHI	TPKAA12/TRUYØ12	WALL MTD AC UNIT/ROOF MTD CONDENSING UNIT	- 320					12 - 95 1								11		208 1 60 -		35/103 No	
AC-2/CU-2	MITSUBISHI	TPKAA12/TRUYØ12	WALL MTD AC UNIT/ROOF MTD CONDENSING UNIT	- 320	_ _				12 - 95 1							 	11		208 1 60 -		35/103 No	
AC-3/CU-3	MITSUBISHI	TPKAA36/TRUYØ36		- 105	_ _				36 - 95 1							 	25		208 1 60 -		46/215 No	
AC-4/CU-4	MITSUBISHI	TPKAA12/TRUYØ12	WALL MTD AC UNIT/ROOF MTD CONDENSING UNIT	- 320					12 - 95 1								11		208 1 60 -		35/103 No	
GEF-1	TWIN CITY	DCRD	ROOF MOUNTED GENERAL EXHAUST FAN	- 320													- 1/2 -		120 1 60 -	- FMS	150 N	
GEF-2	TWIN CITY	DCRD	ROOF MOUNTED GENERAL EXHAUST FAN														- 1/2 -		120 1 60 -		150 N	
GEF-3	TWIN CITY	DCRD 14ØBE	ROOF MOUNTED GENERAL EXHAUST FAN		- -		16.35	0.5 - 3/4 130									- 3/4 -		120 1 60 -	- FMS	200 N	
GEF-4	TWIN CITY		ROOF MOUNTED GENERAL EXHAUST FAN		- -	- -		Ø.5 - 3/4 13Ø						- - -			- 3/4 -		120 1 60 -		200 No	
		DCRD 140BE						0.5 - 1/2 140									- 3/4 -		120 1 60 -			
TEF-1	TWIN CITY	DCRD Ø95BE	ROOF MOUNTED TOILET EXHAUST FAN														- 1/2 -				150 No	
TEF-2	TWIN CITY	DCRD Ø8ØBE	ROOF MOUNTED TOILET EXHAUST FAN		- -				1								- 1/6 -				100 No	
TEF-3	TWIN CITY	DCRD Ø8ØBE	ROOF MOUNTED TOILET EXHAUST FAN					0.3 - 1/6 135									- 1/6 -		120 1 60 -	- FMS	100 No	
TEF-4	TWIN CITY	DCRD Ø8ØBE	ROOF MOUNTED TOILET EXHAUST FAN		- -			0.3 - 1/6 135									- 1/6 -		120 1 60 -	- FMS	100 N	
TEF-5	TWIN CITY	DCRD Ø95BE	ROOF MOUNTED TOILET EXHAUST FAN		- -			0.5 - 1/4 1338									- 1/4 -		120 1 60 -	- FMS	100 N	
TEF-6	TWIN CITY	DCRD Ø8ØBE	ROOF MOUNTED TOILET EXHAUST FAN		- -			0.3 - 1/6 1554									- 1/6 -		120 1 60 -	- FMS	100 N	
TEF-1	TWIN CITY	DCRD 140BE	ROOF MOUNTED TOILET EXHAUST FAN				1200										- 3/4 -		120 1 60 -	- FMS	200 No	
TEF-8	TWIN CITY	DCRD Ø8ØBE	ROOF MOUNTED TOILET EXHAUST FAN					0.3 - 1/6 144									- 1/6 -		120 1 60 -	- FMS	100 No	
TEF-9	TWIN CITY	DCRD 180BE	ROOF MOUNTED TOILET EXHAUST FAN				239@										- 1 -		120 1 60 -	- FMS	250 No	
TEF-10	TWIN CITY	DCRD 140BE	ROOF MOUNTED TOILET EXHAUST FAN					0.5 - 3/4 1299									- 3/4 -		120 1 60 -	- FMS	200 No	
TEF-11	TWIN CITY	TL 9009	INLINE TOILET EXHAUST FAN		- -			0.5 - 1/2 782	?					- - -			- 1/2 -		120 1 60 -	- FMS	150 No	OTE 6
H-1	DENLAR	DIØ3ØDIFFPA	30' WIDE KITCHEN EXHAUST HOOD WITH ANSUL	- -	- -	- -	545			- - - -			- - -	- -	- - -	- - - -		- 3.1 -	120 1 60 -	- WALL SWITCH		e atol
H-2	DENLAR	DIØ3ØDIFFPA	30' WIDE KITCHEN EXHAUST HOOD WITH ANGUL	- -			545						- - -			- - - -		- 3.1 -	120 1 60 -	- WALL SWITCH	- N	OTE 9
UH-1	TRANE	-	SUSPENDED UNIT HEATER - HOT WATER HEATING	- -	- -	- -	550				- -		- - -	- - -	- - -	- - - -	- 3/4 -	- - -	120 1 60 -	- FMS	- N	OTE 7
CH-1	TRANE	FFHBØ4Ø	HOT WATER WALL RECESSED MOUNTED CABINET HEATER	- 400		- -	- 0.06 1163 -						- 25.6 1.3	60 119 160	140	- - - -	2.8	15	120 1 60 -	- INTEGRAL 19141	T 88 No	S ETC
CH-2	TRANE	FFHBØ8Ø	HOT WATER WALL RECESSED MOUNTED CABINET HEATER	- 800	- -	- -	- Ø.13 1252 -					- -	- 50 2.5	60 118 160	0 140	- - -	3.9	15	120 1 60 -	- INTEGRAL TSTAT	T 140 No	S STC
CH-3	TRANE	FFHBØ4Ø	HOT WATER WALL SEMI-RECESSED MOUNTED CABINET HEATER	- 400			- 0.06 1163 -				- -		- 25.6 1.3	60 118 160	0 140		2.8	15	120 1 60 -	- INTEGRAL TSTAT	N 88 1	2TE 8
CH-4	TRANE	FFHB080	HOT WATER WALL SEMI-RECESSED MOUNTED CABINET HEATER	- 800		- -	- 0.13 1252 -			. - - -		- -	- 50 2.5	6 60 118 160	0 140	- - - -	3.9	15	120 1 60 -	- INTEGRAL TSTAT	Γ 140 N	OTE 8

NOTE 1: PROVIDE WITH:

SOUND ATTENUATION KIT
 HEAT TRACE ON EXTERIOR CHW PIPING
 SEE SPECIFICATIONS FOR ADDITIONAL REQUIREMENTS

NOTE 2: SEE PLANS AND SECTIONS FOR LAYOUT OF AIR HANDLING UNIT. PREHEATING COIL DATA IS BASED ON MINIMUM OUTSIDE AIR CFM (MAXIMUM VALUE) SEE SPECIFICATIONS FOR ADDITIONAL REQUIREMENTS

NOTE 3: PROVIDE WITH:

•INTEGRATED ENTHALPY ECONOMIZER
•DISCONNECT SWITCH
•FACE/BYPASS DAMPER • CONDENSATE PUMP (WHERE INDICATED ON / PROVIDE 10' WIDE SIDE MOUNTED PIPE CHASE

WITH ACCESS DOOR • WHERE INDICATED PROVIDE 10' DEEP FALSEBACK FOR UNITS WITH DUCTED OUTSIDE AIR CONNECTIONS (SEE FLOOR PLANS). SEE SPECIFICATIONS FOR ADDITIONAL REQUIREMENTS

PROYIDE WITH: • DISCONNECT SWITCH VIBRATION ISOLATION HANGERS

• TERMINAL STRIPS FOR DDC READY SEE SPECIFICATIONS FOR ADDITIONAL REQUIREMENTS PROVIDE CONDENSING UNIT WITH: LOW AMBIENT CONTROLS FOR 100% COOLING

• EQUIPMENT SUPPORT RAILS PROVIDE AC INDOOR UNIT WITH: • WALL MOUNTED WIRED THERMOSTAT • CONDENSATE PUMP • WALL MOUNTING HARDWARE SEE SPECIFICATIONS FOR ADDITIONAL REQUIREMENTS

PROVIDE WITH: • ECM MOTOR WITH POTENTIOMETER SPEED CONTROLLER MOTORIZED DAMPER

DOWN TO -10°F.

• BIRD SCREEN • ROOF CURB SEE SPECIFICATIONS FOR ADDITIONAL REQUIREMENTS

PROVIDE WITH: · WALL MOUNTED THERMOSTAT • DISCONNECT • VIBRATION ISOLATION HANGERS SEE SPECIFICATIONS FOR ADDITIONAL REQUIREMENTS

PROVIDE WITH: INTEGRAL THERMOSTAT
 DISCONNECT SWITCH
SEE SPECIFICATIONS FOR ADDITIONAL REQUIREMENTS

PROVIDE WITH: • INLINE FAN • ELECTRICAL RANGE SHUTOFF • REMOTE ADA SWITCHES • FAN LIMIT

• MANUAL PULL STATION SEE SPECIFICATIONS FOR ADDITIONAL REQUIREMENTS

PUMP	SCHEDULE

							PUMP	MOTOR	DATA		SUCTION/	
TAG	MANUFACTURER	MODEL NUMBER	DESCRIPTION	GPM	HEAD	HP	RPM	VOLT	PHASE	HZ.	DISCHARGE	REMARKS
					(FT.)						SIZE	
CWP-1	BELL 4 GOSSETT	E-1510 3GB	CHILLED WATER DISTRIBUTION PUMP	289	125	20	-	208	3	60	4' / 3'	CHILLED WATER PRIMARY PUMPS W/VFD OPERATING IN
CWP-2	BELL 4 GOSSETT	E-1510 3GB	CHILLED WATER DISTRIBUTION PUMP	289	125	20	-	208	3	60	4' / 3'	PARALLEL. 578 GPM AT 125 FT. HD. WITH DUAL POWER FEEDERS
CP-1	BELL & GOSSETT	E-1510 3BD	CHILLED WATER RECIRCULATION PUMP (C-1)	577	55	15	-	208	3	60	4' / 3'	-

	DUCT N	MOUNTED H	W HE	ATINO	G C	OIL	SC	HED	ULE	=
TAG	MANUFACTURER	MODEL	SIZE	CFM	HW REH	EAT COIL	DATA			
			W×H		MBH	GPM	WPD	EAT	EWT	REMARKS
HWC-1	TRANE	D5WB24@2@	20 × 24	2,400	52.1	5.2	5'	100	100	
HWC-2	TRANE	D5WB12Ø12	12 × 12	700	15.2	1.5	5'	100	100	
HWC-3	TRANE	D5WB12Ø14	14 × 12	800	17.4	1.7	5'	100	100	
HWC-4	TRANE	D5WB12020	20 × 12	1,200	26.0	2.6	5'	100	100	
HWC-5	TRANE	D5WB12024	24 × 12	1,400	30.4	3.Ø	5'	100	100	
HWC-6	TRANE	DSTB15Ø2Ø	20 × 16	1,600	41.4	4.1	5'	100	100	



GIBRALTAR DESIGN

ARCHITECTURE ● ENGINEERING ● INTERIOR DESIGN

ENGINEERING GROUP
(219) 924-8400
www.milliesengineeringgroup.com PROJECT

DOUGLAS MACARTHUR ES ADDITIONS

RENOVATIONS CROWN POINT COMMUNITY SCHOOL CORPORATION CROWN POINT, INDIANA

GIBRALTAR DESIGN 9102 N. Meridian St., Ste. 300 Indianapolis, IN 46260 Homepage www.GibraltarDesign.com Email info@GibraltarDesign.com Phone 317.580.5777 Fax 317.580.5778

21-113 COORDINATED E DRAWN BY

CHECKED BY

•••

COPYRIGHT NOTICE: THE CONCEPTS, DESIGNS, PLANS, DETAILS, ETC, SHOWN ON THIS DOCUMENT ARE THE PROPERTY OF GIBRALTAR DESIGN AND WERE CREATED FOR USE ON THIS SPECIFIC PROJECT. NONE OF THIS INFORMATION SHALL BE USED BY ANY PERSON OR FIRM FOR ANY PURPOSE WITHOUT THE EXPRESS WRITTEN CONSENT OF GIBRALTAR DESIGN. THE OWNER MAY RETAIN COPIES FOR INFORMATION AND REFERENCE IN CONNECTION ONLY WITH THIS PROJECT.

PROJECT	•	
REVIS	SIONS	
MARK	DATE	ISSUED FOR
AD-3	02/23/22	ADDENDUM NO. 3

DRAWING MECHANICAL SCHEDULES


PROJECT


DOUGLAS MACARTHUR ES


ADDITIONS AND RENOVATIONS


© GIBRALTAR DESIGN SHEET

M-501

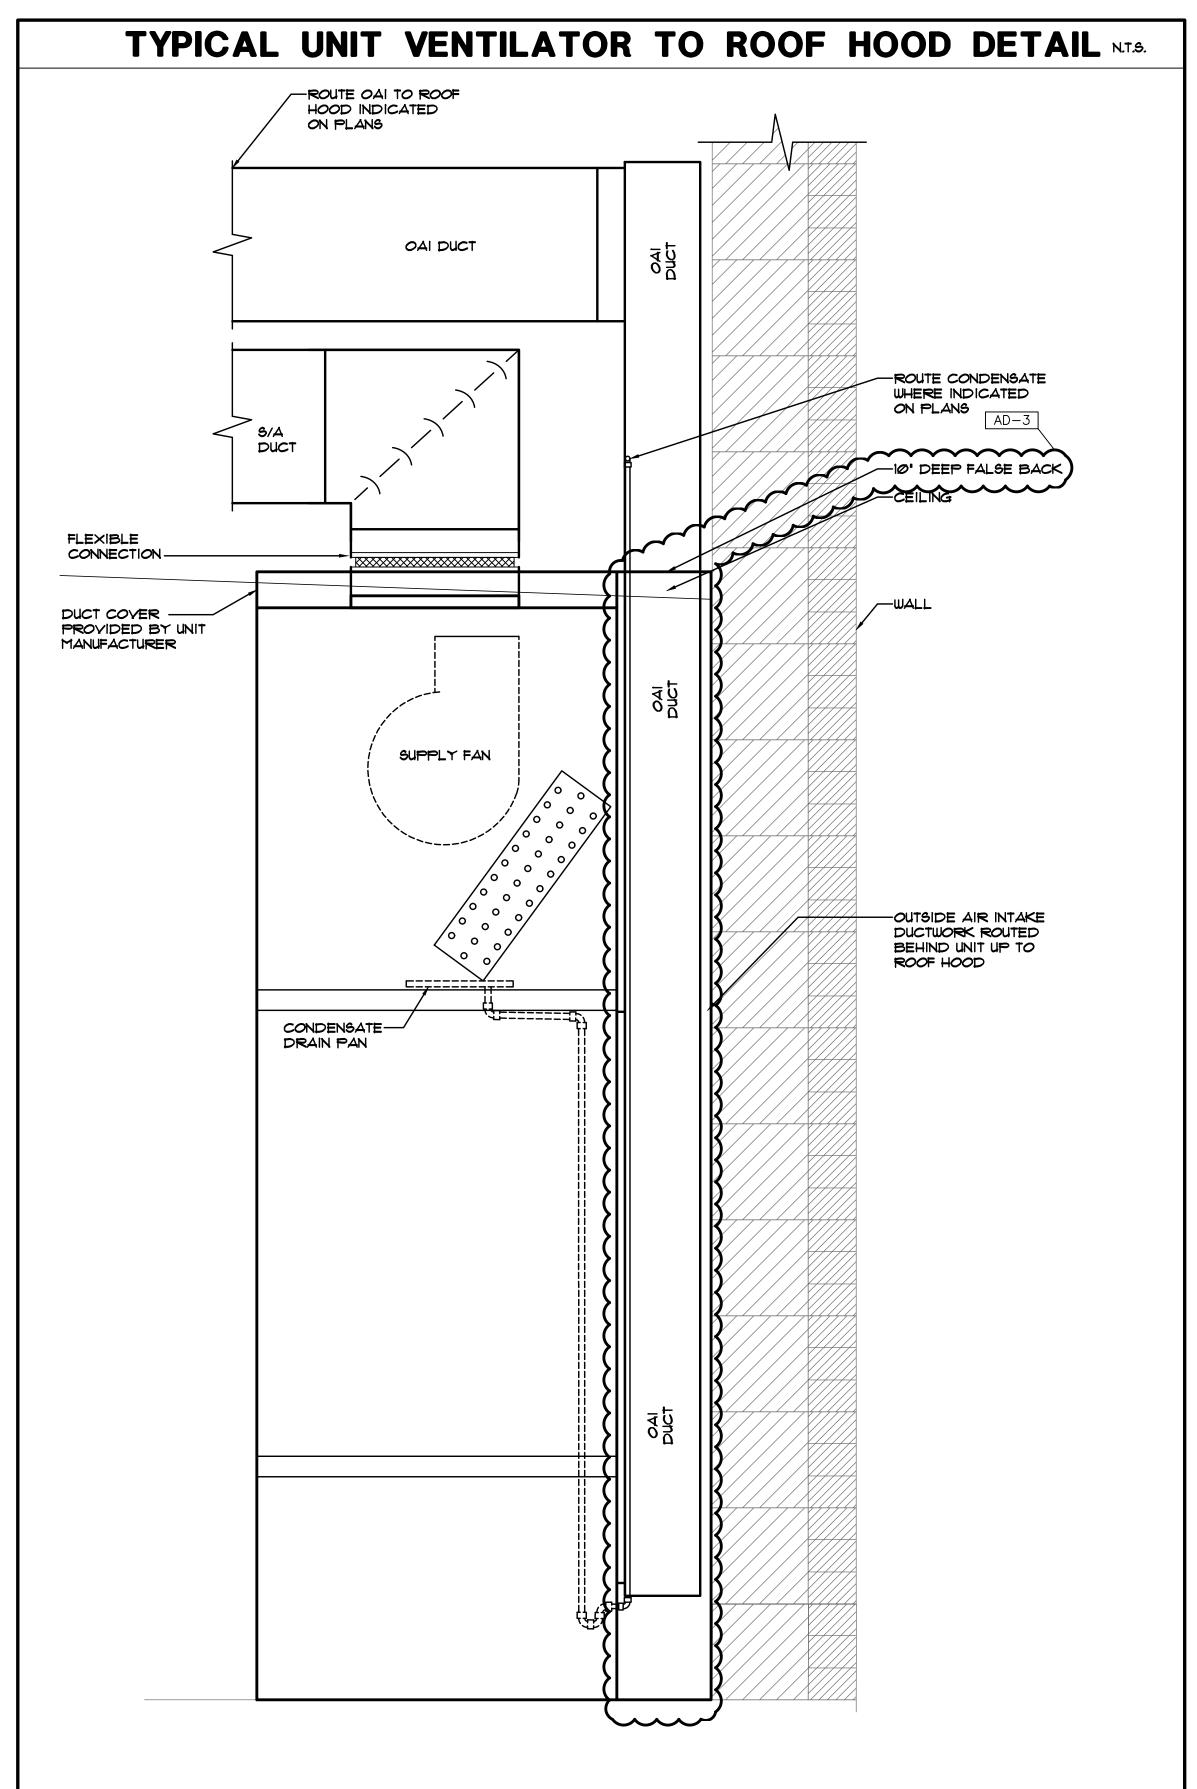

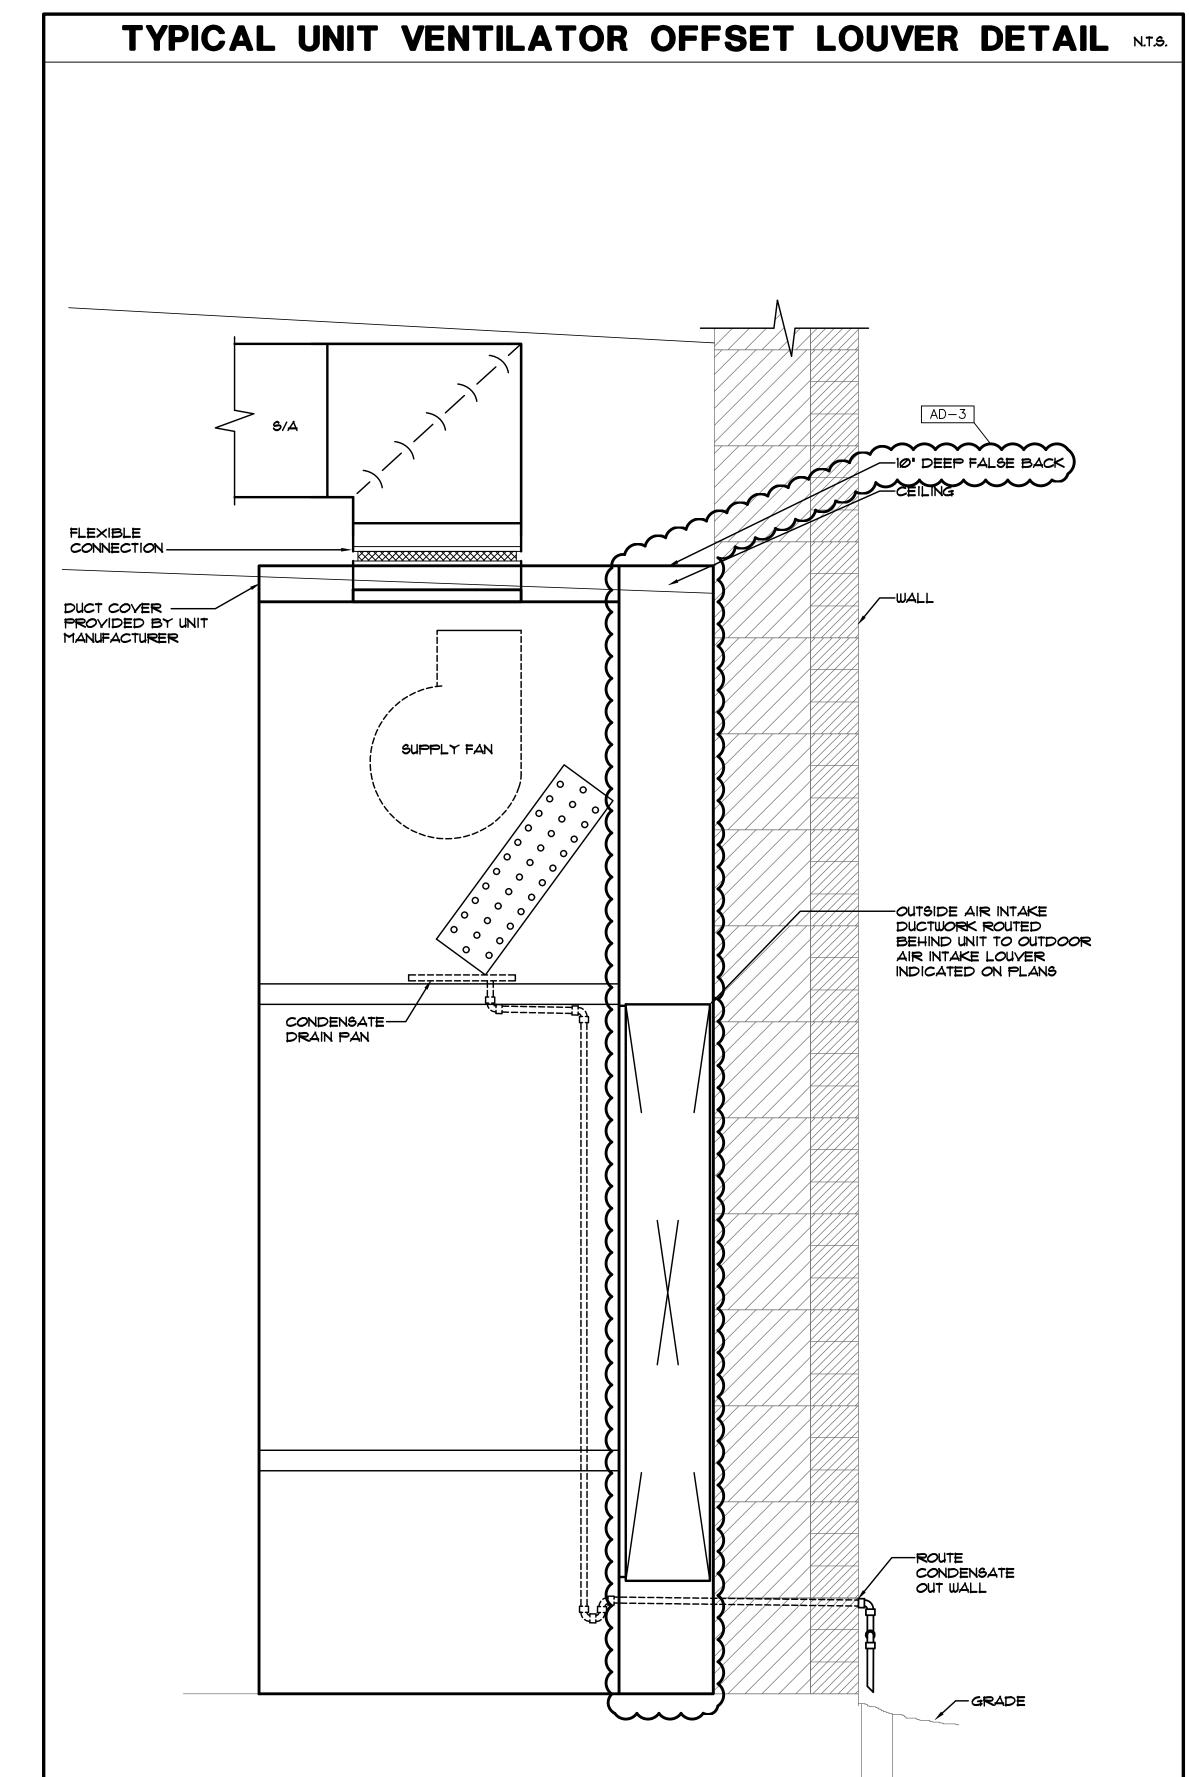

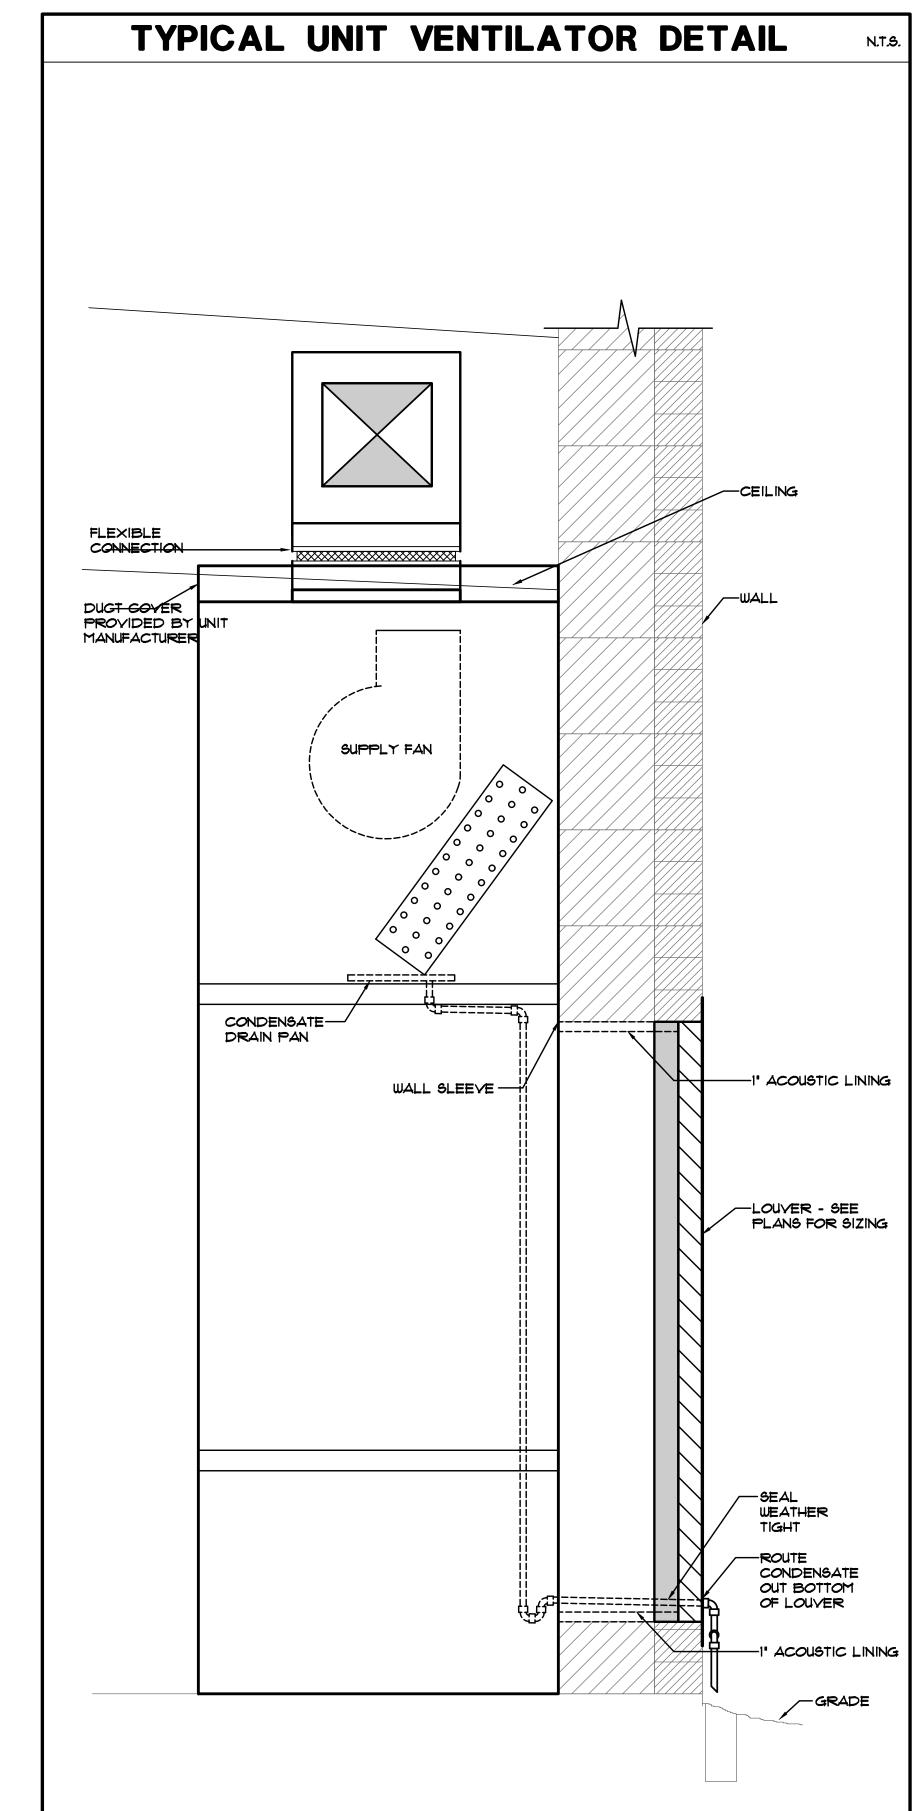

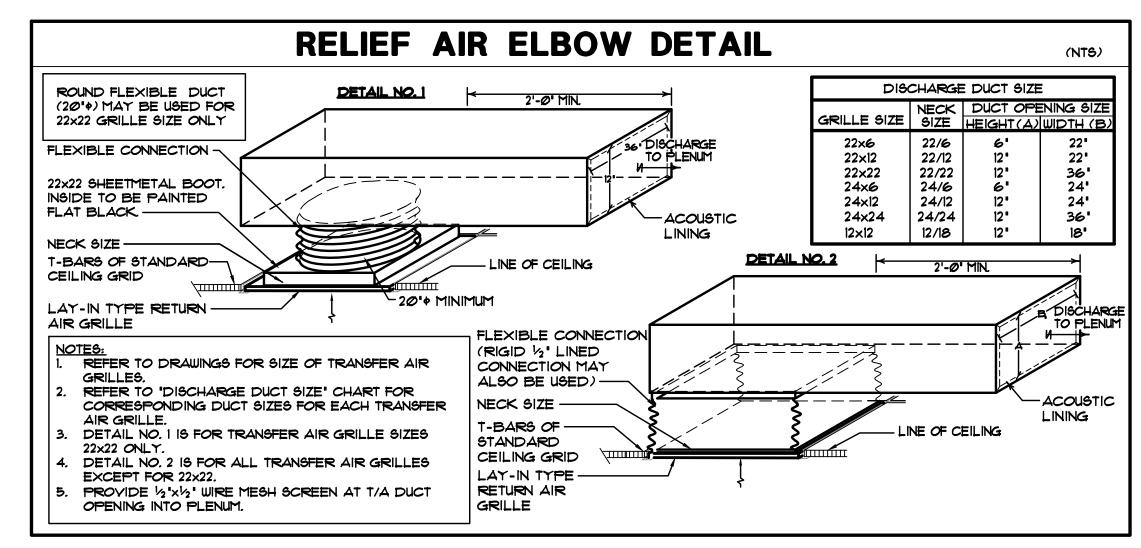



DESIGN
ARCHITECTURE • ENGINEERING • INTERIOR DESIGN



DOUGLAS
MACARTHUR
ES ADDITIONS

RENOVATIONS
CROWN POINT COMMUNITY
SCHOOL CORPORATION
CROWN POINT, INDIANA

GIBRALTAR DESIGN
9102 N. Meridian St., Ste. 300
Indianapolis, IN 46260
Homepage www.GibraltarDesign.com
Email info@GibraltarDesign.com
Phone 317.580.5777 Fax 317.580.5778

21-113
DATE
01/31/22
COORDINATED BY
SM
DRAWN BY
GL
CHECKED BY
DJ

COPYRIGHT NOTICE:

THE CONCEPTS, DESIGNS, PLANS, DETAILS, ETC, SHOWN ON THIS DOCUMENT ARE THE PROPERTY OF GIBRALTAR DESIGN AND WERE CREATED FOR USE ON THIS SPECIFIC PROJECT. NONE OF THIS INFORMATION SHALL BE USED BY ANY PERSON OR FIRM FOR ANY PURPOSE WITHOUT THE EXPRESS WRITTEN CONSENT OF GIBRALTAR DESIGN. THE OWNER MAY RETAIN COPIES FOR INFORMATION AND REFERENCE IN CONNECTION ONLY WITH THIS PROJECT.

REVISIONS

MARK DATE ISSUED FOR

AD-3 02/23/22 ADDENDUM NO. 3

DRAWING

DRAWING
MECHANICAL DETAILS &
DIAGRAMS

PROJECT

DOUGLAS MACARTHUR ES

ADDITIONS AND RENOVATIONS

© GIBRALTAR DESIGN SHEET

M-603

					PLUMBING EQU	IPMENT AND FIXTURE SO	CHEDULE						
TAG	FIXTURE/EQUIPMENT	FIXTURE/EQUIPMENT	FIXTURE/EQUIPMENT	ACCEPTABLE	FIXTURE VALVE/FAUCET	FIXTURE VALVE/FAUCET	ACCEPTABLE	ACCESSORIES/REMARKS			LECTRICAL I		
NO.	TYPE	DESCRIPTION	MANUFACTURER AND MODEL NO.	MANUF.	TYPE	TYPE	MANUF.	(SEE SPECIFICATIONS FOR ADDITIONAL INFORMATION)	HP KW	J FLA	AMPS MO	PVOLT	PH HZ.
WC-1	WATER CLOSET	VITREOUS CHINA, WALL MOUNTED	AMERICAN STANDARD #2257.103	NOTE #	BATTERY SENSOR FLUSH VALVE	SLOAN 'G2 OPTIMA' *8116-1.6	NOTE *8	BEMIS 12155-C SEAT		-		-	
WC-2	WATER CLOSET	VITREOUS CHINA, WALL MOUNTED, ADA	AMERICAN STANDARD *2257.103	NOTE #1	BATTERY SENSOR FLUSH VALVE	SLOAN 'G2 OPTIMA' *8111-16	NOTE *8	BEMIS *2155-C SEAT		-		-	
UR-1	URINAL	BATTERY SENSOR FLUSH VALVE	SLOAN 'G2 OPTIMA' *8111-1.6	NOTE #	BATTERY SENSOR FLUSH VALVE	SLOAN 'G2 OPTIMA' *8111-16	NOTE *8	-		-	- -	-	- -
L-1	LAVATORY	VITREOUS CHINA, WALL MOUNTED, 20"XIS", ADA	AMERICAN STANDARD *0355.012	NOTE #	ELECTRONIC BATTERY SENSOR, 4" CENTERS	SLOAN *EBF-187	C* STON	MCGUIRE "PW-2150-WC 1-1/2" PROWRAP, MCQUIRE "H216TCCLK SUPPLIES		-		-	
EWC-1	ELECTRIC BOTTLE FILLER	ELECTRIC WALL MOUNTED	ELKAY "EZSWSSSMC	NOTE *2	-	-	-	-		-		120	1 60
S-1	SINK	TWO COMPARTMENT STAINLESS STEEL SINK, 33'x19'x6'	ELKAY *LRADQ-3319	NOTE #3	2 HANDLE, HIGH GOOSENECK	ELKAY *LKD2448BH	P* ∃TON	ELKAY *35 STRAINER, ELKAY *LK-53 DRAIN ASSEMBLY, MCGUIRE *H2167CCLK SUPPLIES		-		-	
S-2	SINK	1-COMPARTMENT STAINLESS STEEL SINK, 22"x19-1/2"x6-1/2"	ELKAY *LRADQ-2219	NOTE *3	2 HANDLE, HIGH GOOSENECK	CHICAGO FAUCET CO. #50-317XKABCP	€* ∃TON	MCGUIRE *B-8912-CSDF P-TRAP, MCGUIRE *H2167CCLK SUPPLIES		-		-	
S-3	SINK	2-COMPARTMENT S. S. SINK W/ BUBBLER, 37-1/4" x 17" x 6-1/2"	ELKAY *DRKAD371765LC	NOTE #1	2 HANDLE, HIGH GOOSENECK W/ BUBBLER	ELKAY *LKD2439C W/ LK1141A	€* ∃TON	MCGUIRE *PW-2150-WC 1-1/2" PROWRAP, MCQUIRE *H216TCCLK SUPPLIES		-		-	
S-4	SINK	1-COMPARTMENT STAINLESS STEEL SINK, 22"x19-1/2"x6-1/2"	ELKAY *LRADQ-2219	NOTE *3	2 HANDLE, HIGH GOOSENECK	ELKAY *LKD2448BH	€* ∃TON	MCGUIRE #B-8912-CSDF P-TRAP, MCGUIRE #H2167CCLK SUPPLIES, JOSAM #61030 SOLIDS INTERCEPTOR		-		-	
MB-1	MOP BASIN	MOLDED STONE, 30'x30'x6'H	FIAT *SB-3@3@	NOTE *4	WALL MOUNTED SERVICE FAUCET	CHICAGO FAUCET CO. *897	€* ∃TON	W/ 3/4" HOSE THREAD, VACUUM BREAKER, WALL BRACE		-		-	
SS-1	SERVICE SINK	VITREOUS CHINA WALL MOUNTED, 22"x2@"x13-1/2"D	AMERICAN STANDARD *1695.008	NOTE #	WALL MOUNTED SERVICE FAUCET	CHICAGO FAUCET CO. #897-CP	C* STON	W/ 3/4" HOSE THREAD, VACUUM BREAKER, WALL BRACE		-		-	
PB-1	PLUMBERS BOX	FOR CLOTHES WASHER	GUY GRAY #B200TS	NOTE #14	-	-	-	-		-		-	
FD-1	FLOOR DRAIN	CAST IRON BODY, ADJUSTABLE 6"x6" NICKEL BRONZE TOP	WADE #100-G6	NOTE #5	-	-	-	VANDALPROOF SCREWS, PLUGGED TRAP PRIMER		-		-	
FS-1	FLOOR SINK	CAST IRON, 8-1/8" DEEP, ACID RESISTING, 12"x12" TOP	WADE *9140	NOTE #5	-	-	-	ALUMINUM DOME STRAINER, SECURED HINGED GRATE, SLOPED RIM		-		-	
SC-1	SILLCOCK	NON-FREEZE, VACUUM BREAKER, REMOVABLE KEY	WADE *8600	NOTE *6	-	-	-	-		-		-	
HB-1	HOSEBIBB	VACUUM BREAKER, 3/4" HOSE THREAD	CHICAGO FAUCET CO. #952	NOTE *6	-	-	-	-		-		-	
RD-1	ROOF DRAIN	CAST IRON BODY, GRAVEL STOP, LARGE SUMP AD-3	MIFAB #RI200-EU	NOTE #5	-	-	-	-		-		-	- -
RD-2	ROOF DRAIN W/ OVERFLOW	CAST IRON BODY, GRAVEL STOP, LARGE SUMP	WADE *3043	NOTE #5	-	-	-	-		-		-	
OFRD-1	Overflow roof drain	CAST IRON BODY, GRAVEL STOP, LARGE SUMP	MIFAB *R1200-W	NOTE #5	-	-	-	-		-		-	
TW-1	TEMPERED WATER VALVE	TEMPERED WATER VALVE	BRADLEY *559-4000A TMV	NOTE #1	-	-	-	-		-		-	
TWH-1	TANKLESS WATER HEATER	199 MBH, 4.1 GPM • 90 DEGREE RISE (GAS FIRED)	NORITZ *NCC199CDV	NOTE #12	-	-	-	ISOLATION KIT, TEMP. RELIEF VALVE, DRAIN VALVE AND CONDENSATE PIPED TO FLOOR DRAIN		-		120	1 60
TWH-2	TANKLESS WATER HEATER	199 MBH, 4.1 GPM • 90 DEGREE RISE (GAS FIRED)	NORITZ *NCC199CDV	NOTE #12	-	-	-	ISOLATION KIT, TEMP. RELIEF VALVE, DRAIN VALVE AND CONDENSATE PIPED TO FLOOR DRAIN		-		120	1 60
TWH-3	TANKLESS WATER HEATER	199 MBH, 4.1 GPM • 90 DEGREE RISE (GAS FIRED)	NORITZ *NCC199CDV	NOTE #12	-	-	-	ISOLATION KIT, TEMP. RELIEF VALVE, DRAIN VALVE AND CONDENSATE PIPED TO FLOOR DRAIN		-		120	1 60
RCP-1	RECIRCULATION PUMP	17 GPM @ 7.25' HEAD, ALL BRONZE CONSTRUCTION	B4G *PL-100	NOTE #13	-	-	-	W/ STRAP ON AQUASTAT	2/5 -	-	4.8 -	120	1 60
DBP-1	DOMESTIC BOOSTER PUMP	160 GPM • 60 PSI DISCHARGE W/ SUCTION • 25 PSI	METROPOLITAN #MS-MTIII-5D-PHI-60	NOTE #11	-	-	-	W/ 105 GAL. HYDROPNEUMATIC TANK, 4" SUCTION/ 4" DISCHARGE, (100 GPM @ 80' TDH EA. PUMP) 138' MIN. SHUT-OFF HEAD	(2)5 -	-		208	3 60
WS-1	WATER SOFTENER	PEAK- 95 GPM each, PROGRESSIVE PARALLEL- 190 GPM	CULLIGAN *CTM-300-FF Duplex Softener	NOTE #15	-	-	-	FRP VESSEL 24" Dia. x 95", 30" x 50" BRINE TANK		-		120	1 60

NOTE *1: GERBER, CRANE, KOHLER, ZURN

NOTE * 2: OASIS, HAWS, SUNROC

NOTE #3: JUST

NOTE *4: MUSTEE, SWAN

NOTE #5: ZURN, JOSAM, J.R. SMITH, MIFAB

NOTE *6: JOSAM, ZURN, J.R. SMITH, WOODFORD NOTE *7: LEONARD, POWERS, LAWLER

NOTE *8: ZURN, TOTO

NOTE *9: ZURN, TOTO

NOTE 40: ZURN, DELTA, T49 BRASS, CHICAGO FAUCET CO.

NOTE #11: AMT, B&G NOTE #12: INTELLIHOT, RINNAI, NAVIEN

NOTE *13: ARMSTRONG, GRUNDFOS, TACO NOTE #4: OATY, SIOUX CHIEF

NOTE #15: CULLIGAN, ECO WATER, PELICAN

GENERAL NOTES

- A. WORK SHALL COMPLY WITH LOCAL, MUNICIPAL, AND STATE PLUMBING CODES. B. THE SCOPE OF WORK SPECIFIED HEREIN AND IN THE SPECIFICATIONS SHALL BE COORDINATED WITH THE CONSTRUCTION MANAGER - REFER TO THE SCOPE OF WORK FOR EACH TRADE, ANY DISCREPANCIES BETWEEN THE CONSTRUCTION DOCUMENTS AND CONSTRUCTION MANAGERS SCOPE SHALL BE BROUGHT TO THE ATTENTION OF THE ARCHITECT/ENGINEER FOR CLARIFICATION. THE ARCHITECT/ENGINEER'S DECISION SHALL
- C. LAYOUT IS DIAGRAMMATIC. INSTALL PIPING AND EQUIPMENT TO MEET ACTUAL FIELD CONDITIONS. REVIEW PROJECT SPECIFICATIONS BEFORE STARTING ANY WORK. SUBMIT SHOP DRAWINGS OF WORK AS PER SPECIFICATIONS.
- D. COORDINATE PHASING OF WORK AND PROVIDE TEMPORARY PIPING AND SERVICES AS REQUIRED FOR THE IMPLEMENTATION OF WORK.
- E. LAYOUT WORK TO AVOID CONFLICTS BETWEEN DUCTWORK, LIGHTING, CEILINGS, PIPING AND BUILDING STRUCTURE.
- F. SCHEDULE WORK TO AVOID DOWNTIME AND INCONVENIENCE TO OWNER.
- G. TRADE COORDINATION
- H. COORDINATE EQUIPMENT ELECTRICAL REQUIREMENTS (VOLTAGES, PHASE, LOAD, ETC.) BEFORE ORDERING ANY EQUIPMENT.
- COORDINATE VENT THROUGH ROOF LOCATIONS WITH OUTDOOR AIR INTAKE LOCATIONS TO MAINTAIN A MINIMUM SEPARATION OF TEN FEET.

CONN.	CONNECT TO	COLD	нот	WASTE	FLOOR	REMARKS
NO.		WATER	WATER	WASIE	DRAINS	
2	COOLER COIL	-	-	-	FD-1	-
7	FREEZER COIL	-	-	-	FD-1	-
14	ISLAND WORK TABLE	-	-	-	FS-1	-
15	HAND SINK	-	-	-	11/2"	-
16	HAND SINK FAUCET	1/2"	1/2"	-	11/2"	-
18	PREP SINK	1/2"	1/2"	-	FS-1	-
19	GARBAGE DISPOSAL	1/2"	-	-	2'	-
24	ICE MAKER	1/2"	-	-	FD-1	WATTS *LF9D
35	COMBI OVERN/STEAMER	(2)1/2"	1/2"	-	FS-1	WATTS *9D-BBFP
37	TILT SKILLET	1/2"	1/2"	-	FT	WATTS *9D-BBFP
38	FLOOR TROUGH	-	-	-	4'	-
45	THREE COMPARTMENT SINK	-	-	-	FS-1	-
47	SPLASH MOUNT FAUCET	3/4"	3/4"	-	-	-
48	SPLASH MOUNT PRE-RINSE FAUCET	1/2"	1/2"	-	-	-
49	GARBAGE DISPOSAL	1/2"	-	-	2"	-
51	DISH MACHINE	1/2"	1/2"	-	FS-1	-
52	DISH MACHINE BLOW DRYER	-	-	-	FS-1	-
63	MOP SINK	3/4"	3/4"	-	4'	-
70	DROP-IN HOT/COLD UNIT	-	-	-	FD-1	-
73	DROP-IN COLD WELL	-	-	-	FD-1	-
80	DROP-IN HOT/COLD UNIT	-	-	-	FD-1	-
83	DROP-IN COLD WELL	-	-	-	FD-1	-
90	DROP-IN HOT/COLD UNIT	-	-	-	FD-1	-
92	DROP-IN COLD WELL	-	-	-	FD-I	-

WASTE LINES, INDIRECT PIPING, ETC. FOR FIXTURES AND KITCHEN EQUIPMENT ITEMS. PROVIDE AND INSTALL ALL VALVES, STOPS, TRAPS, AND PRESSURE REGULATORS NECESSARY TO CONNECT LINES. FOR FURTHER INFORMATION AND DESCRIPTION OF KITCHEN EQUIPMENT BEING SUPPLIED REFER TO ARCHITECTURAL DRAWINGS, KITCHEN EQUIPMENT DRAWINGS, AND ENLARGED KITCHEN AREA DRAWINGS.

	EXISTING UNDERGROUND SANITARY PIPING	CO	CLEANOUT COLD WATER
— — ST— —	EXISTING UNDERGROUND STORM SEWER	DBP DN	DOMESTIC BOOSTER PUMP DOWN
	EXISTING COLD WATER PIPING	EWC FCO	ELECTRIC WATER COOLER FLOOR CLEANOUT
	EXISTING HOT WATER PIPING	FD FS	FLOOR DRAIN FLOOR SINK
	EXISTING HOT WATER RECIRCULATION PIPING	GT HB	GREASE TRAP HOSE BIBB
—— G——	EXISTING GAS PIPING		HOT WATER HOT WATER RECIRCULATION
FP	EXISTING FIRE PROTECTION PIPING	IM INV. EL.	ICEMAKER VALVE BOX INVERT ELEVATION
	EXISTING PIPING	L L LT	LAYATORY LAUNDRY TUB
	EXISTING PIPING TO BE REMOVED OR ABANDONED	L- MB MH	MOP BASIN MANHOLE
	NEW UNDERGROUND SANITARY SEWER	OFRD OSD	OVERFLOW ROOF DRAIN OPEN SITE DRAIN
— — ST— —	NEW UNDERGROUND STORM SEWER	PB RCP	PLUMBERS BOX HOT WATER RECIRCULATION PUMP
	NEW COLD WATER PIPING	RD S	ROOF DRAIN SINK
	NEW HOT WATER PIPING	9C 98	SILL COCK SERVICE SINK
	NEW HOT WATER RECIRCULATION PIPING	TW UR	TEMPERED WATER URINAL
	NEW VENT PIPING	V VTR	VENT VENT THROUGH ROOF
—— ST———	NEW OVERHEAD STORM PIPING		WATER CLOSET WALL CLEANOUT
	NEW OVERHEAD SANITARY PIPING	YCO	YARD CLEANOUT
——CA——	COMPRESSED AIR PIPING		
G —	PIPE DOWN		
0—	PIPE UP		
H●	SHUT-OFF VALVE		
7	CHECK YALVE		
	HOSE BIBB/SILL COCK		
*	RELIEF YALVE		
	SHOWER HEAD		
•	BALANCING COCKMANUAL FLOW CONTROL VALVE		
	THERMOMETER		
	PRESSURE GAUGE		
	SHEET NOTE TAG		

KITCHEN EQUIPMENT TAG

SYMBOLS/ABBREVIATIONS



DESIGN ARCHITECTURE • ENGINEERING • INTERIOR DESIGN



DOUGLAS MACARTHUR ES ADDITIONS

RENOVATIONS CROWN POINT COMMUNITY SCHOOL CORPORATION CROWN POINT, INDIANA

GIBRALTAR DESIGN 9102 N. Meridian St., Ste. 300 Indianapolis, IN 46260 Homepage www.GibraltarDesign.com Email info@GibraltarDesign.com Phone 317.580.5777 Fax 317.580.5778

PROJECT 21-113 01/31/22 COORDINATED B' DRAWN BY

CHECKED BY COPYRIGHT NOTICE: THE CONCEPTS, DESIGNS, PLANS, DETAILS, ETC, SHOWN ON THIS DOCUMENT ARE THE PROPERTY OF GIBRALTAR DESIGN AND WERE CREATED FOR USE ON THIS SPECIFIC PROJECT. NONE OF THIS INFORMATION SHALL BE USED BY ANY PERSON OR FIRM FOR ANY PURPOSE WITHOUT THE EXPRESS WRITTEN CONSENT OF GIBRALTAR DESIGN. THE OWNER MAY RETAIN COPIES FOR INFORMATION AND REFERENCE IN CONNECTION ONLY WITH THIS PROJECT.

10302590

•••

MARK DATE ISSUED FOR AD-3 | 02/23/22 | ADDENDUM NO. 3


DRAWING PLUMBING SCHEDULE,

NOTES, SYMBOLS & ABBREVIATIONS


DOUGLAS MACARTHUR ES ADDITIONS AND RENOVATIONS

Copyright © 2022 Millies Engineering Group

© GIBRALTAR DESIGN SHEET

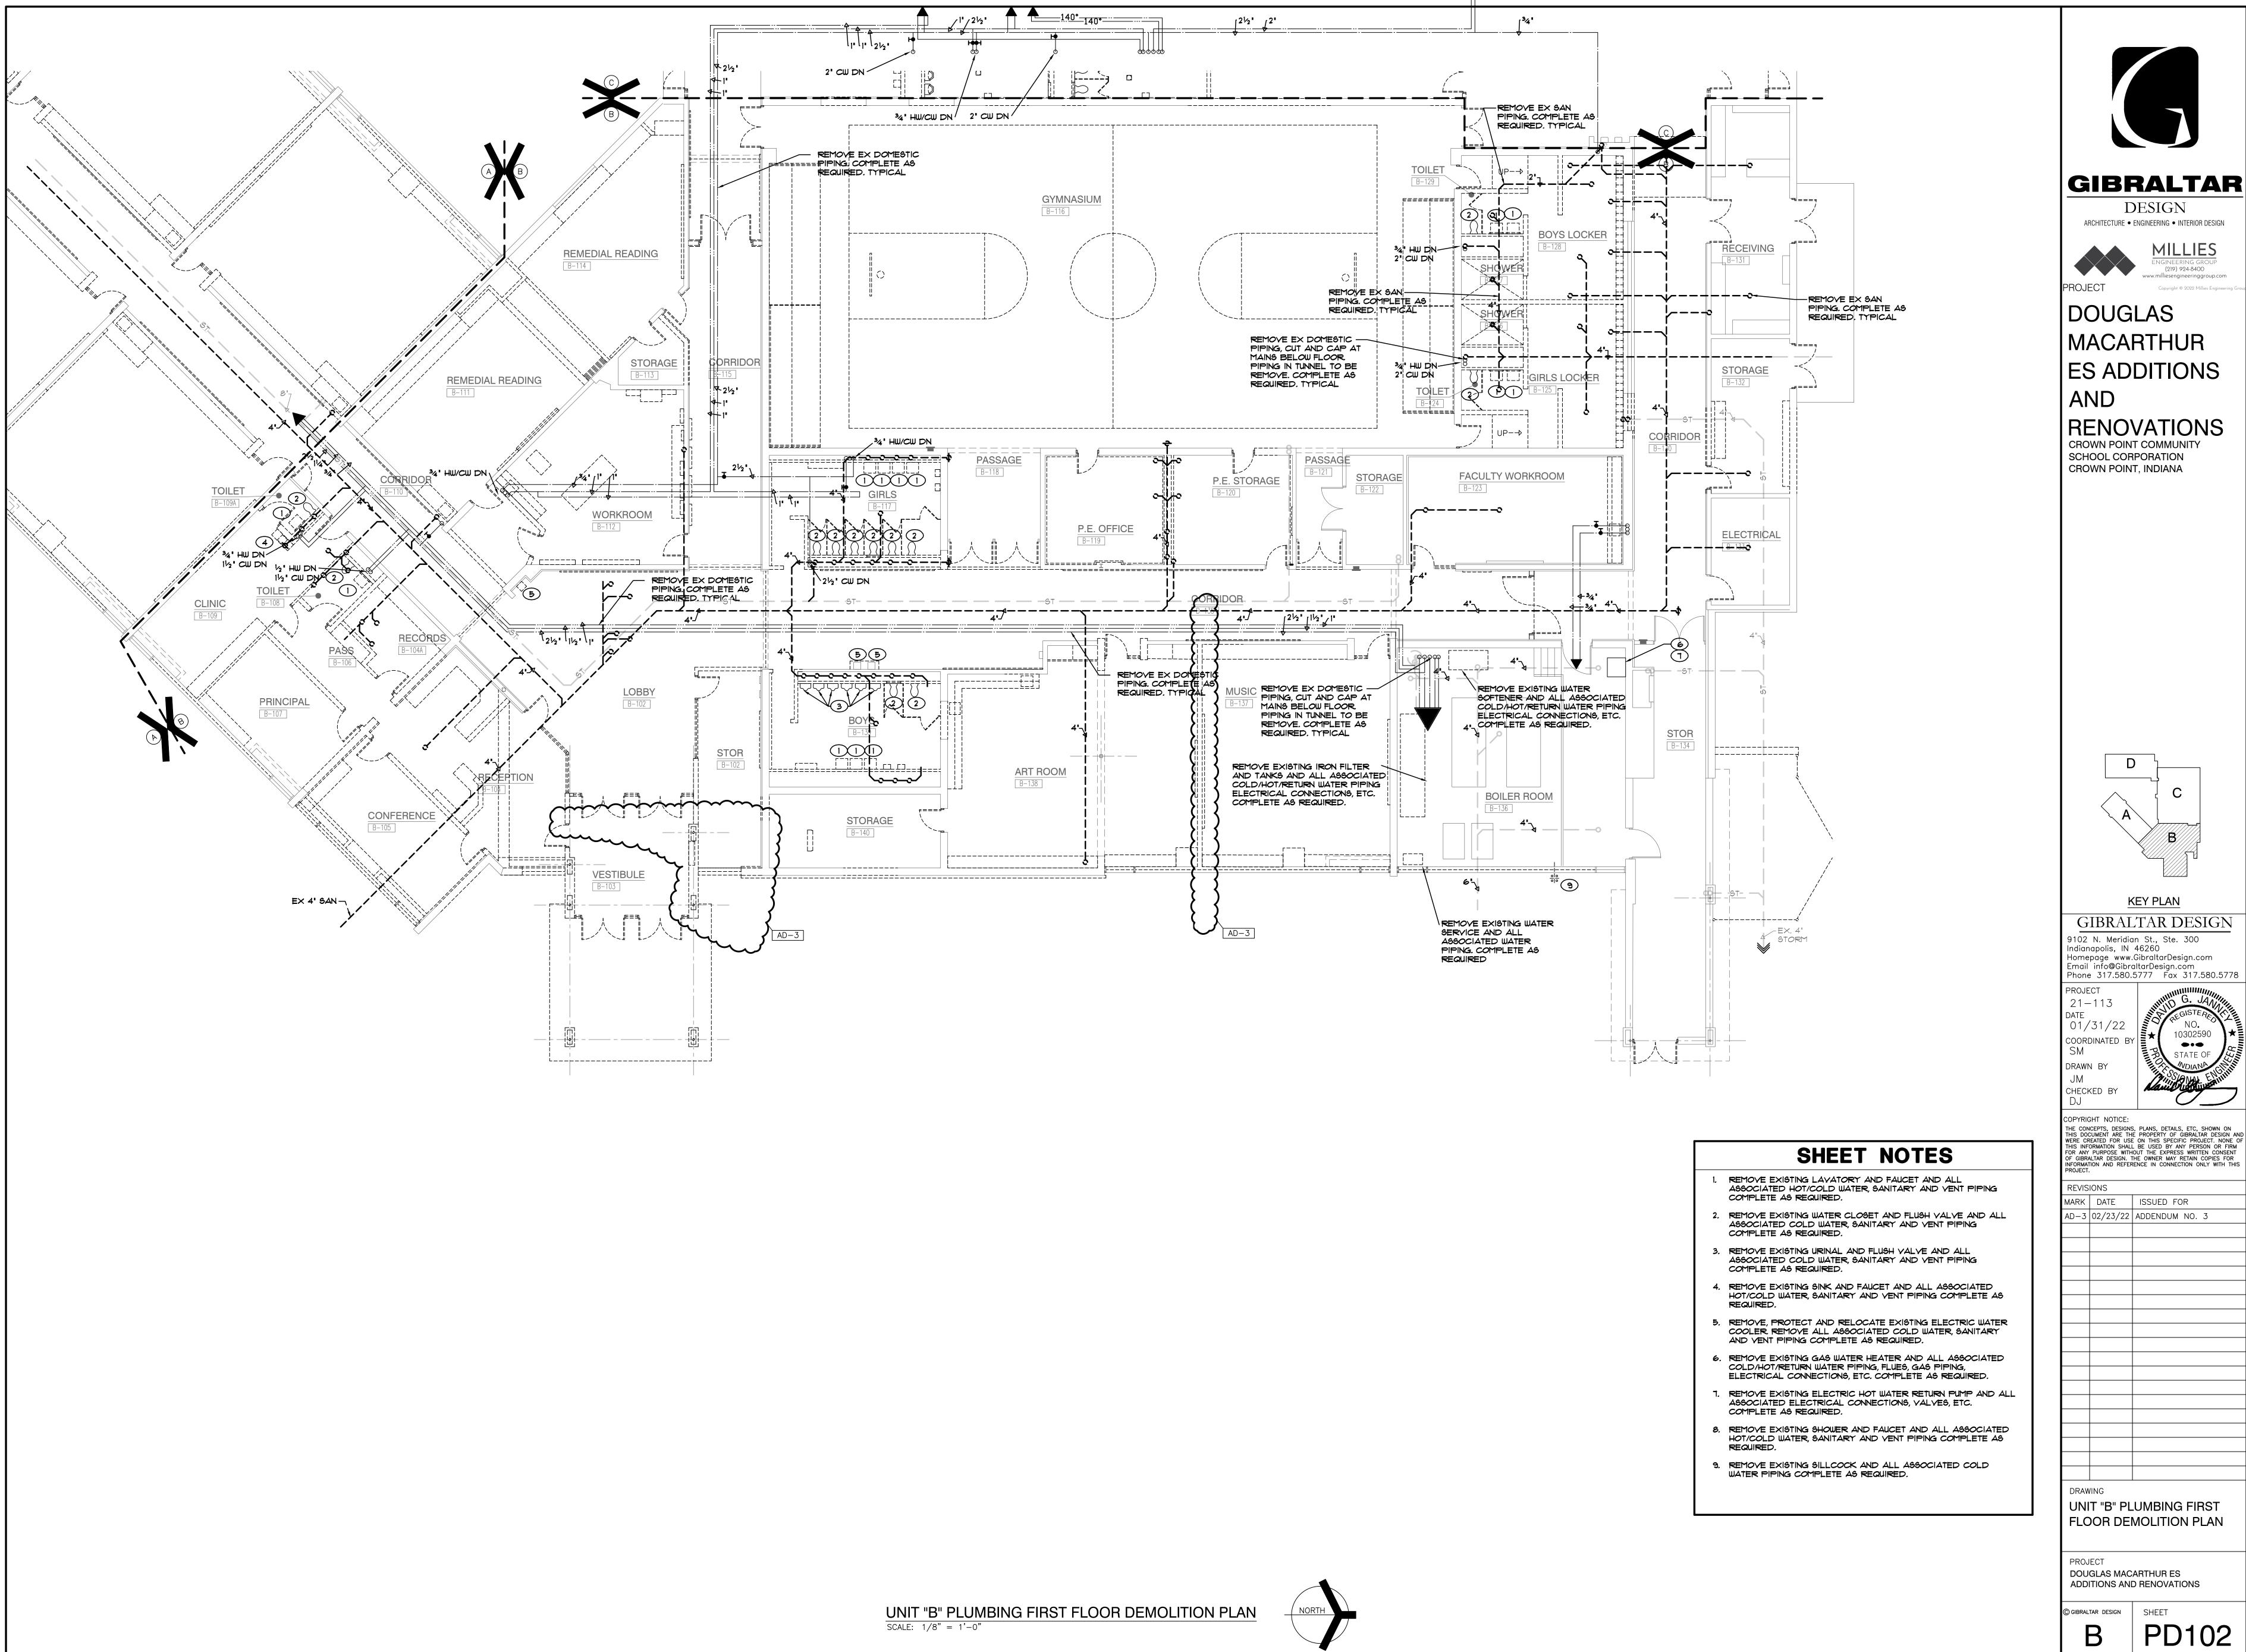

Copyright © 2022 Millies Engineering Group

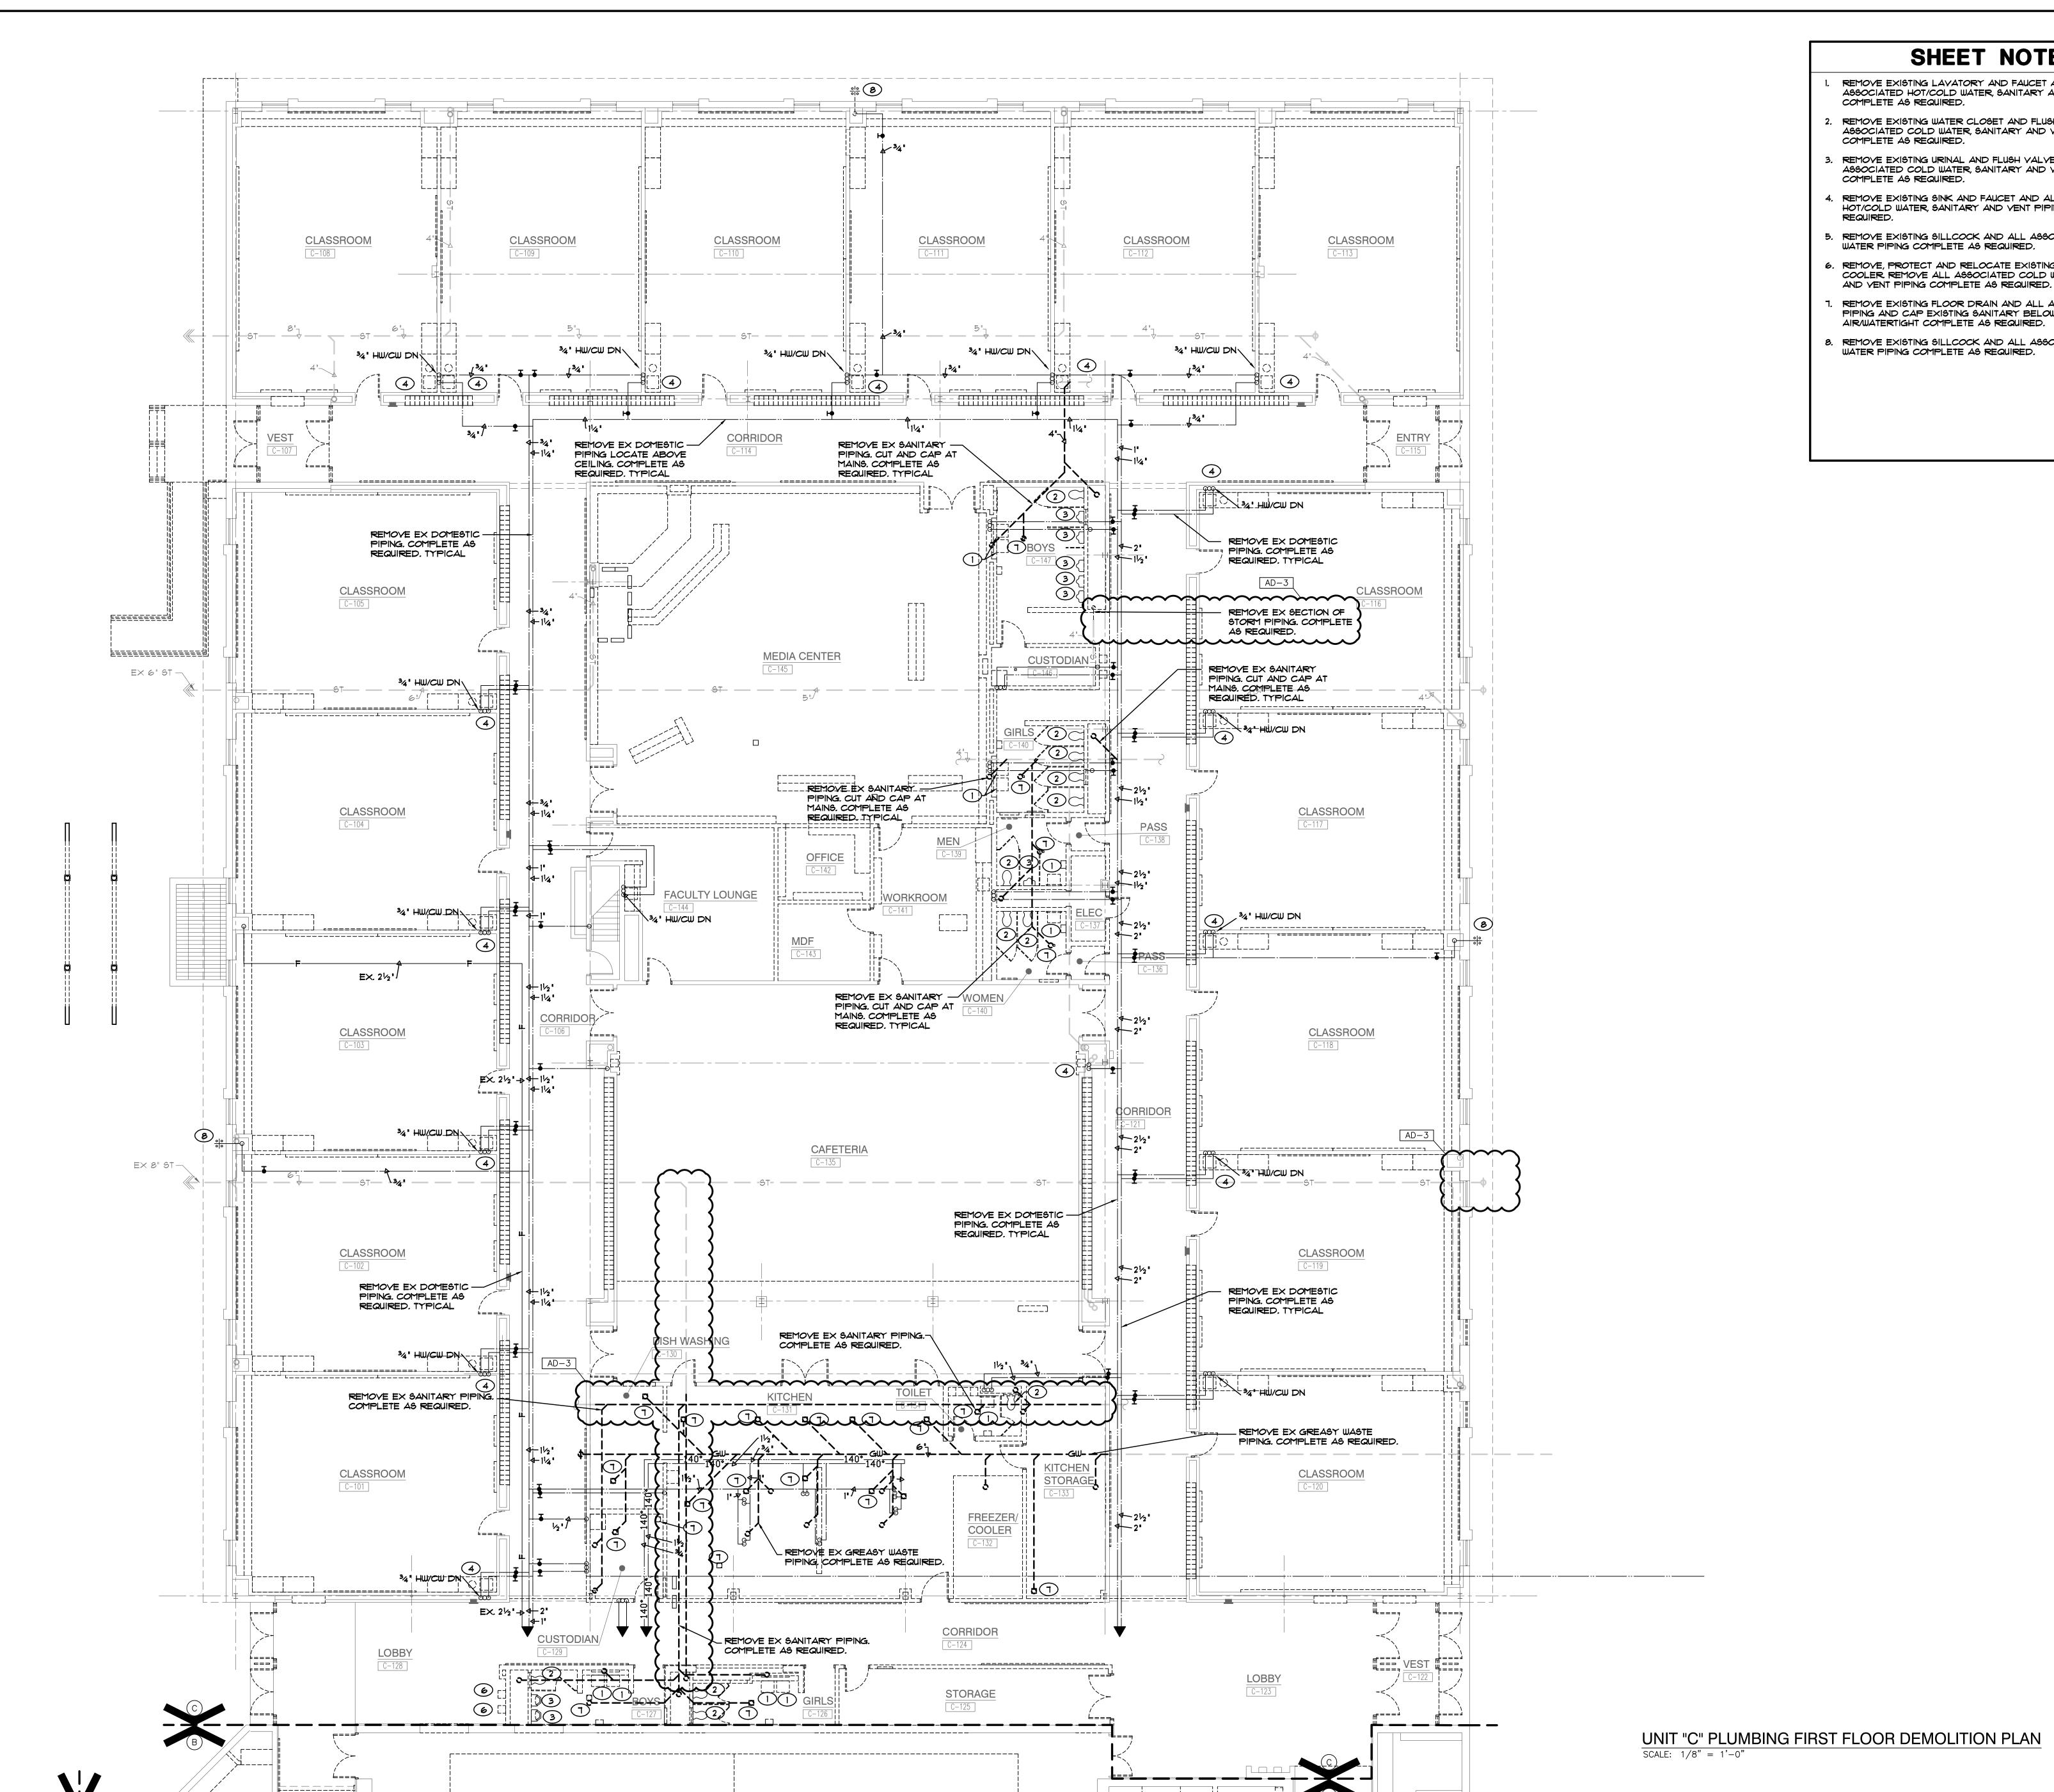

SHEET NOTES

- REMOVE EXISTING LAVATORY AND FAUCET AND ALL ASSOCIATED HOT/COLD WATER, SANITARY AND VENT PIPING COMPLETE AS REQUIRED.
- REMOVE EXISTING WATER CLOSET AND FLUSH VALVE AND ALL ASSOCIATED COLD WATER, SANITARY AND VENT PIPING COMPLETE AS REQUIRED.
- 3. REMOVE EXISTING URINAL AND FLUSH VALVE AND ALL ASSOCIATED COLD WATER, SANITARY AND VENT PIPING
- 4. REMOVE EXISTING SINK AND FAUCET AND ALL ASSOCIATED HOT/COLD WATER, SANITARY AND VENT PIPING COMPLETE AS REQUIRED.
- 5. REMOVE EXISTING SILLCOCK AND ALL ASSOCIATED COLD
- WATER PIPING COMPLETE AS REQUIRED. 6. REMOVE, PROTECT AND RELOCATE EXISTING ELECTRIC WATER COOLER REMOVE ALL ASSOCIATED COLD WATER, SANITARY
- REMOVE EXISTING FLOOR DRAIN AND ALL ASSOCIATED VENT PIPING AND CAP EXISTING SANITARY BELOW FLOOR AIR/WATERTIGHT COMPLETE AS REQUIRED.
- 8. REMOVE EXISTING SILLCOCK AND ALL ASSOCIATED COLD WATER PIPING COMPLETE AS REQUIRED.



GIBRALTAR




(219) 924-8400 PROJECT DOUGLAS

MACARTHUR **ES ADDITIONS**

RENOVATIONS CROWN POINT COMMUNITY SCHOOL CORPORATION

CROWN POINT, INDIANA

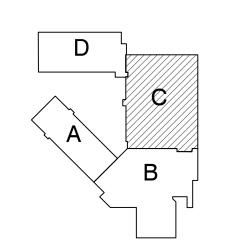

KEY PLAN

GIBRALTAR DESIGN 9102 N. Meridian St., Ste. 300 ndianapolis, IN 46260 Homepage www.GibraltarDesign.com Email info@GibraltarDesign.com

Phone 317.580.5777 Fax 317.580.577

COORDINATED DRAWN BY

CHECKED BY

COPYRIGHT NOTICE: THE CONCEPTS, DESIGNS, PLANS, DETAILS, ETC, SHOWN ON THIS DOCUMENT ARE THE PROPERTY OF GIBRALTAR DESIGN AND WERE CREATED FOR USE ON THIS SPECIFIC PROJECT. NONE OF THIS INFORMATION SHALL BE USED BY ANY PERSON OR FIRM FOR ANY PURPOSE WITHOUT THE EXPRESS WRITTEN CONSENT OF GIBRALTAR DESIGN. THE OWNER MAY RETAIN COPIES FOR INFORMATION AND REFERENCE IN CONNECTION ONLY WITH THIS PROJECT.


REVISIONS				
MARK	DATE	ISSUED FOR		
AD-3	02/23/22	ADDENDUM NO. 3		


UNIT "C" PLUMBING FIRST FLOOR DEMOLITION PLAN


DOUGLAS MACARTHUR ES ADDITIONS AND RENOVATIONS


GIBRALTAR DESIGN SHEET

PD103

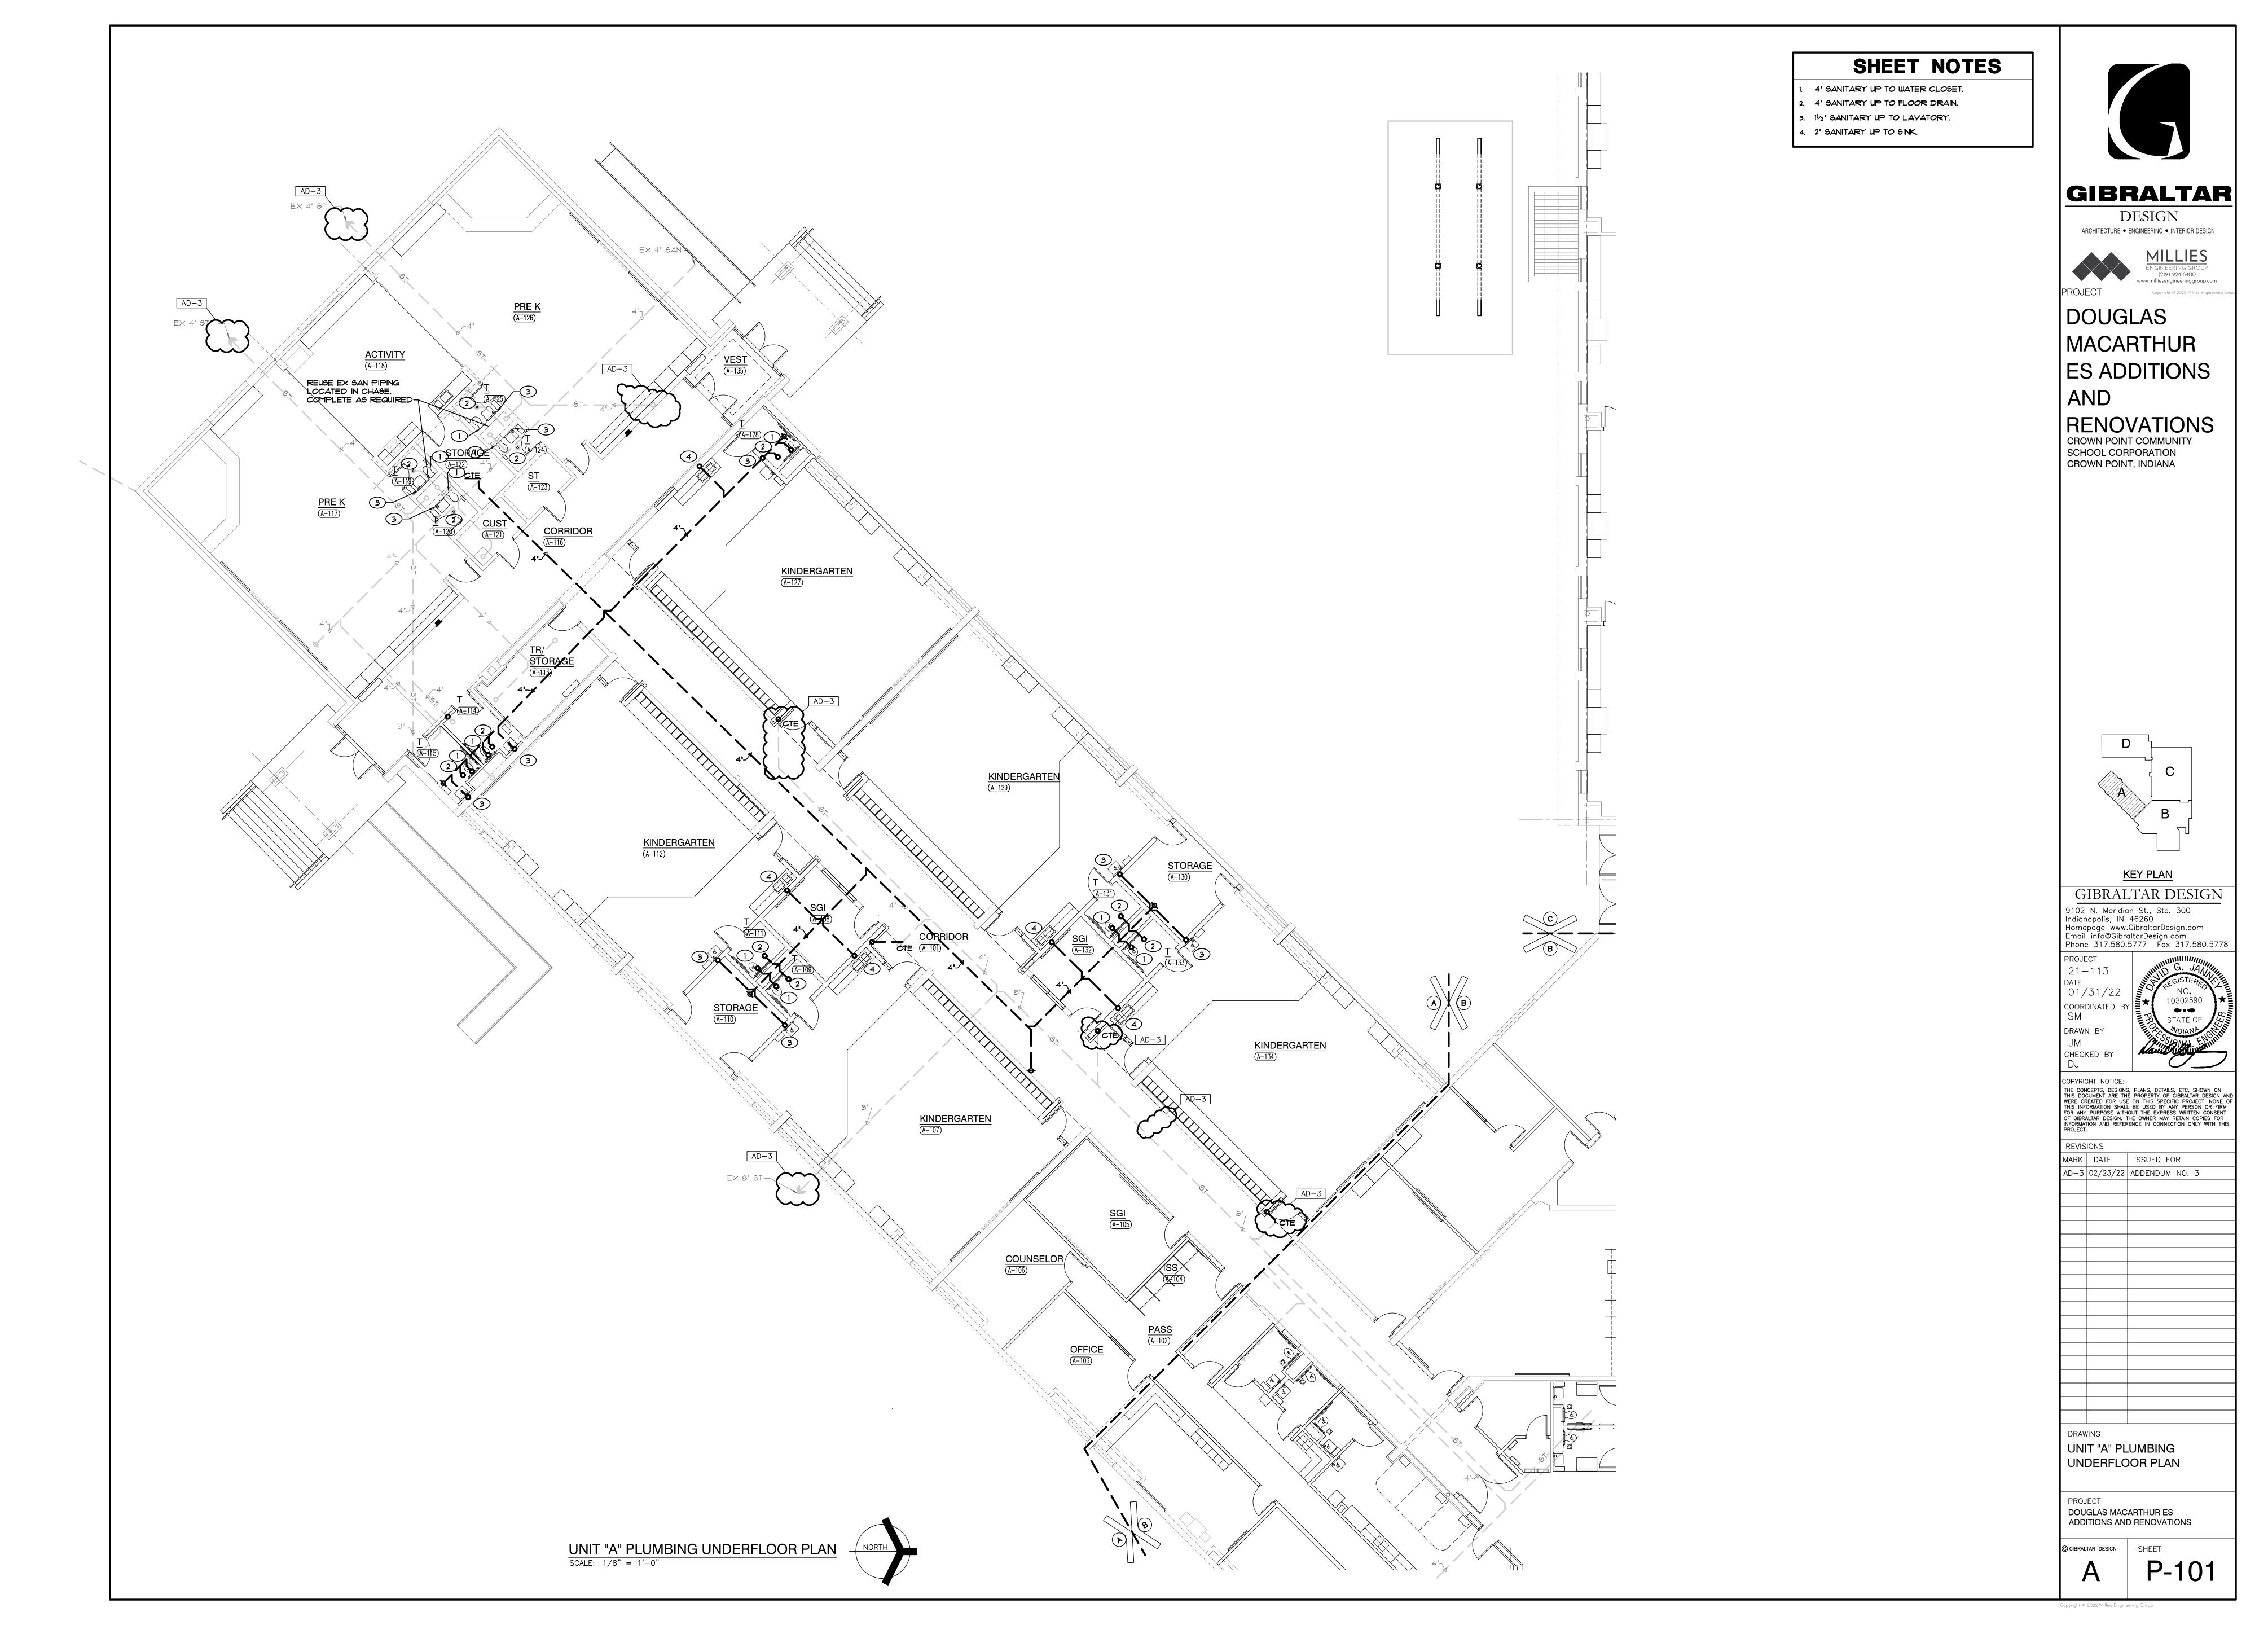

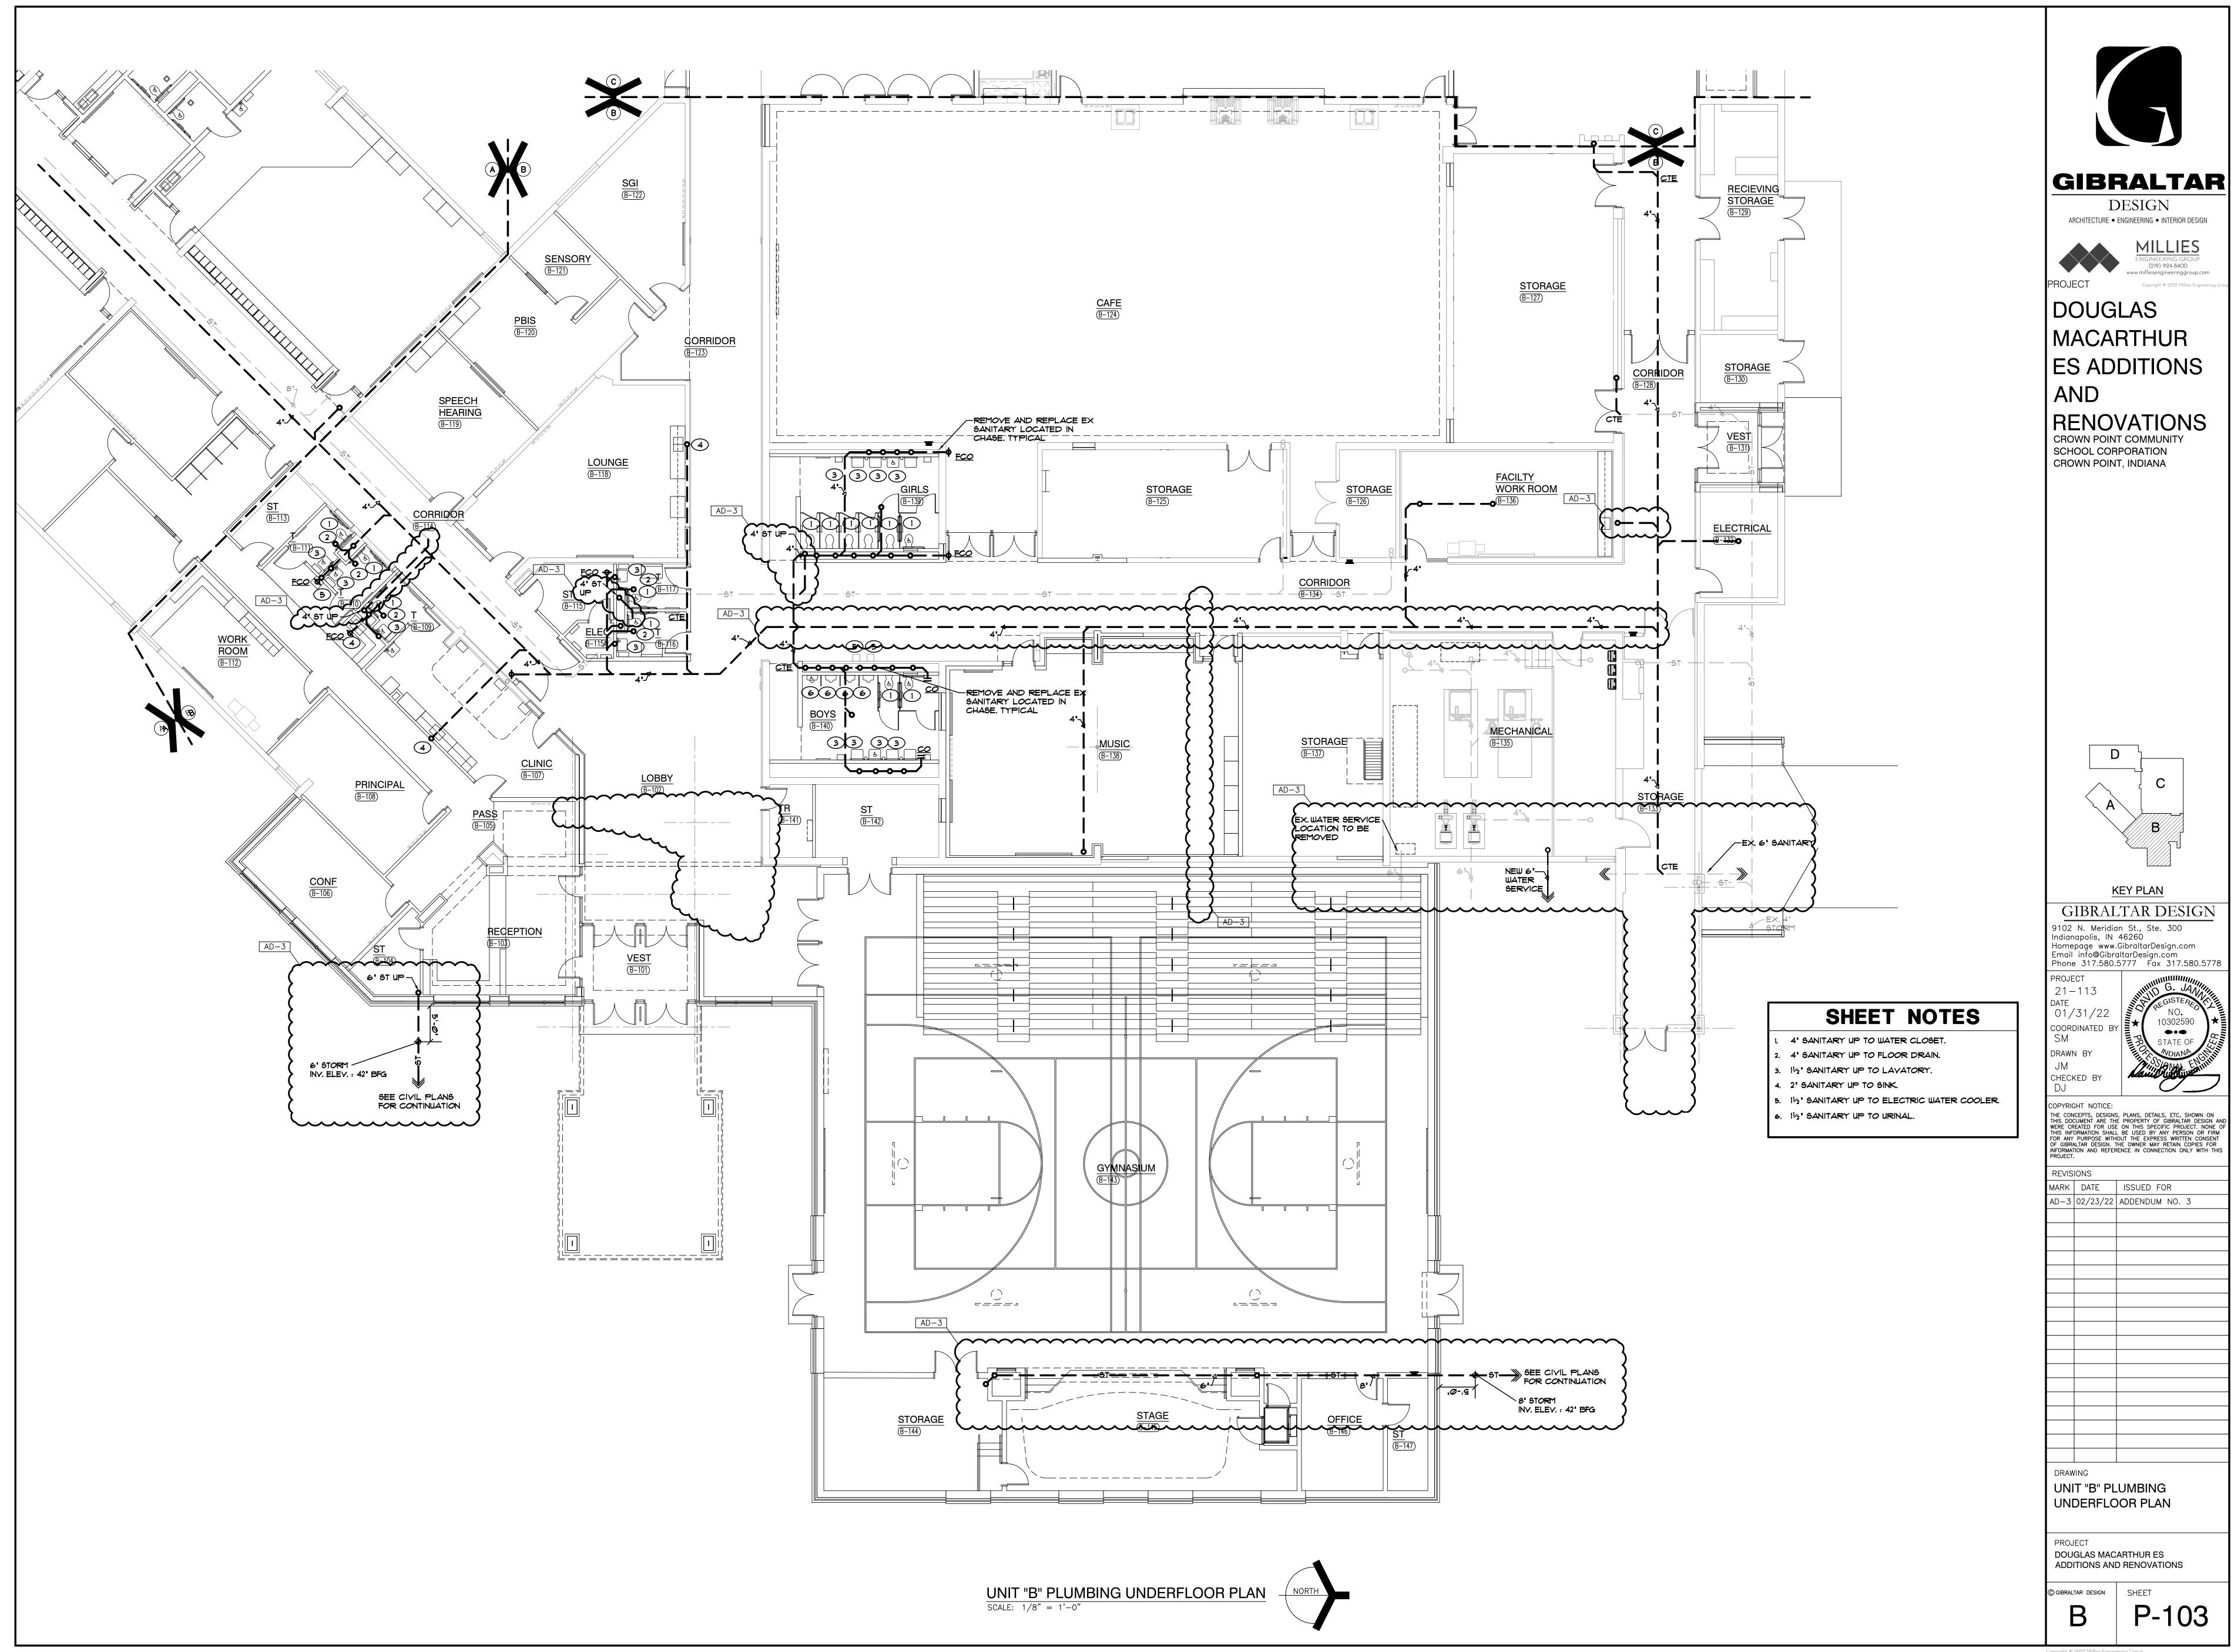

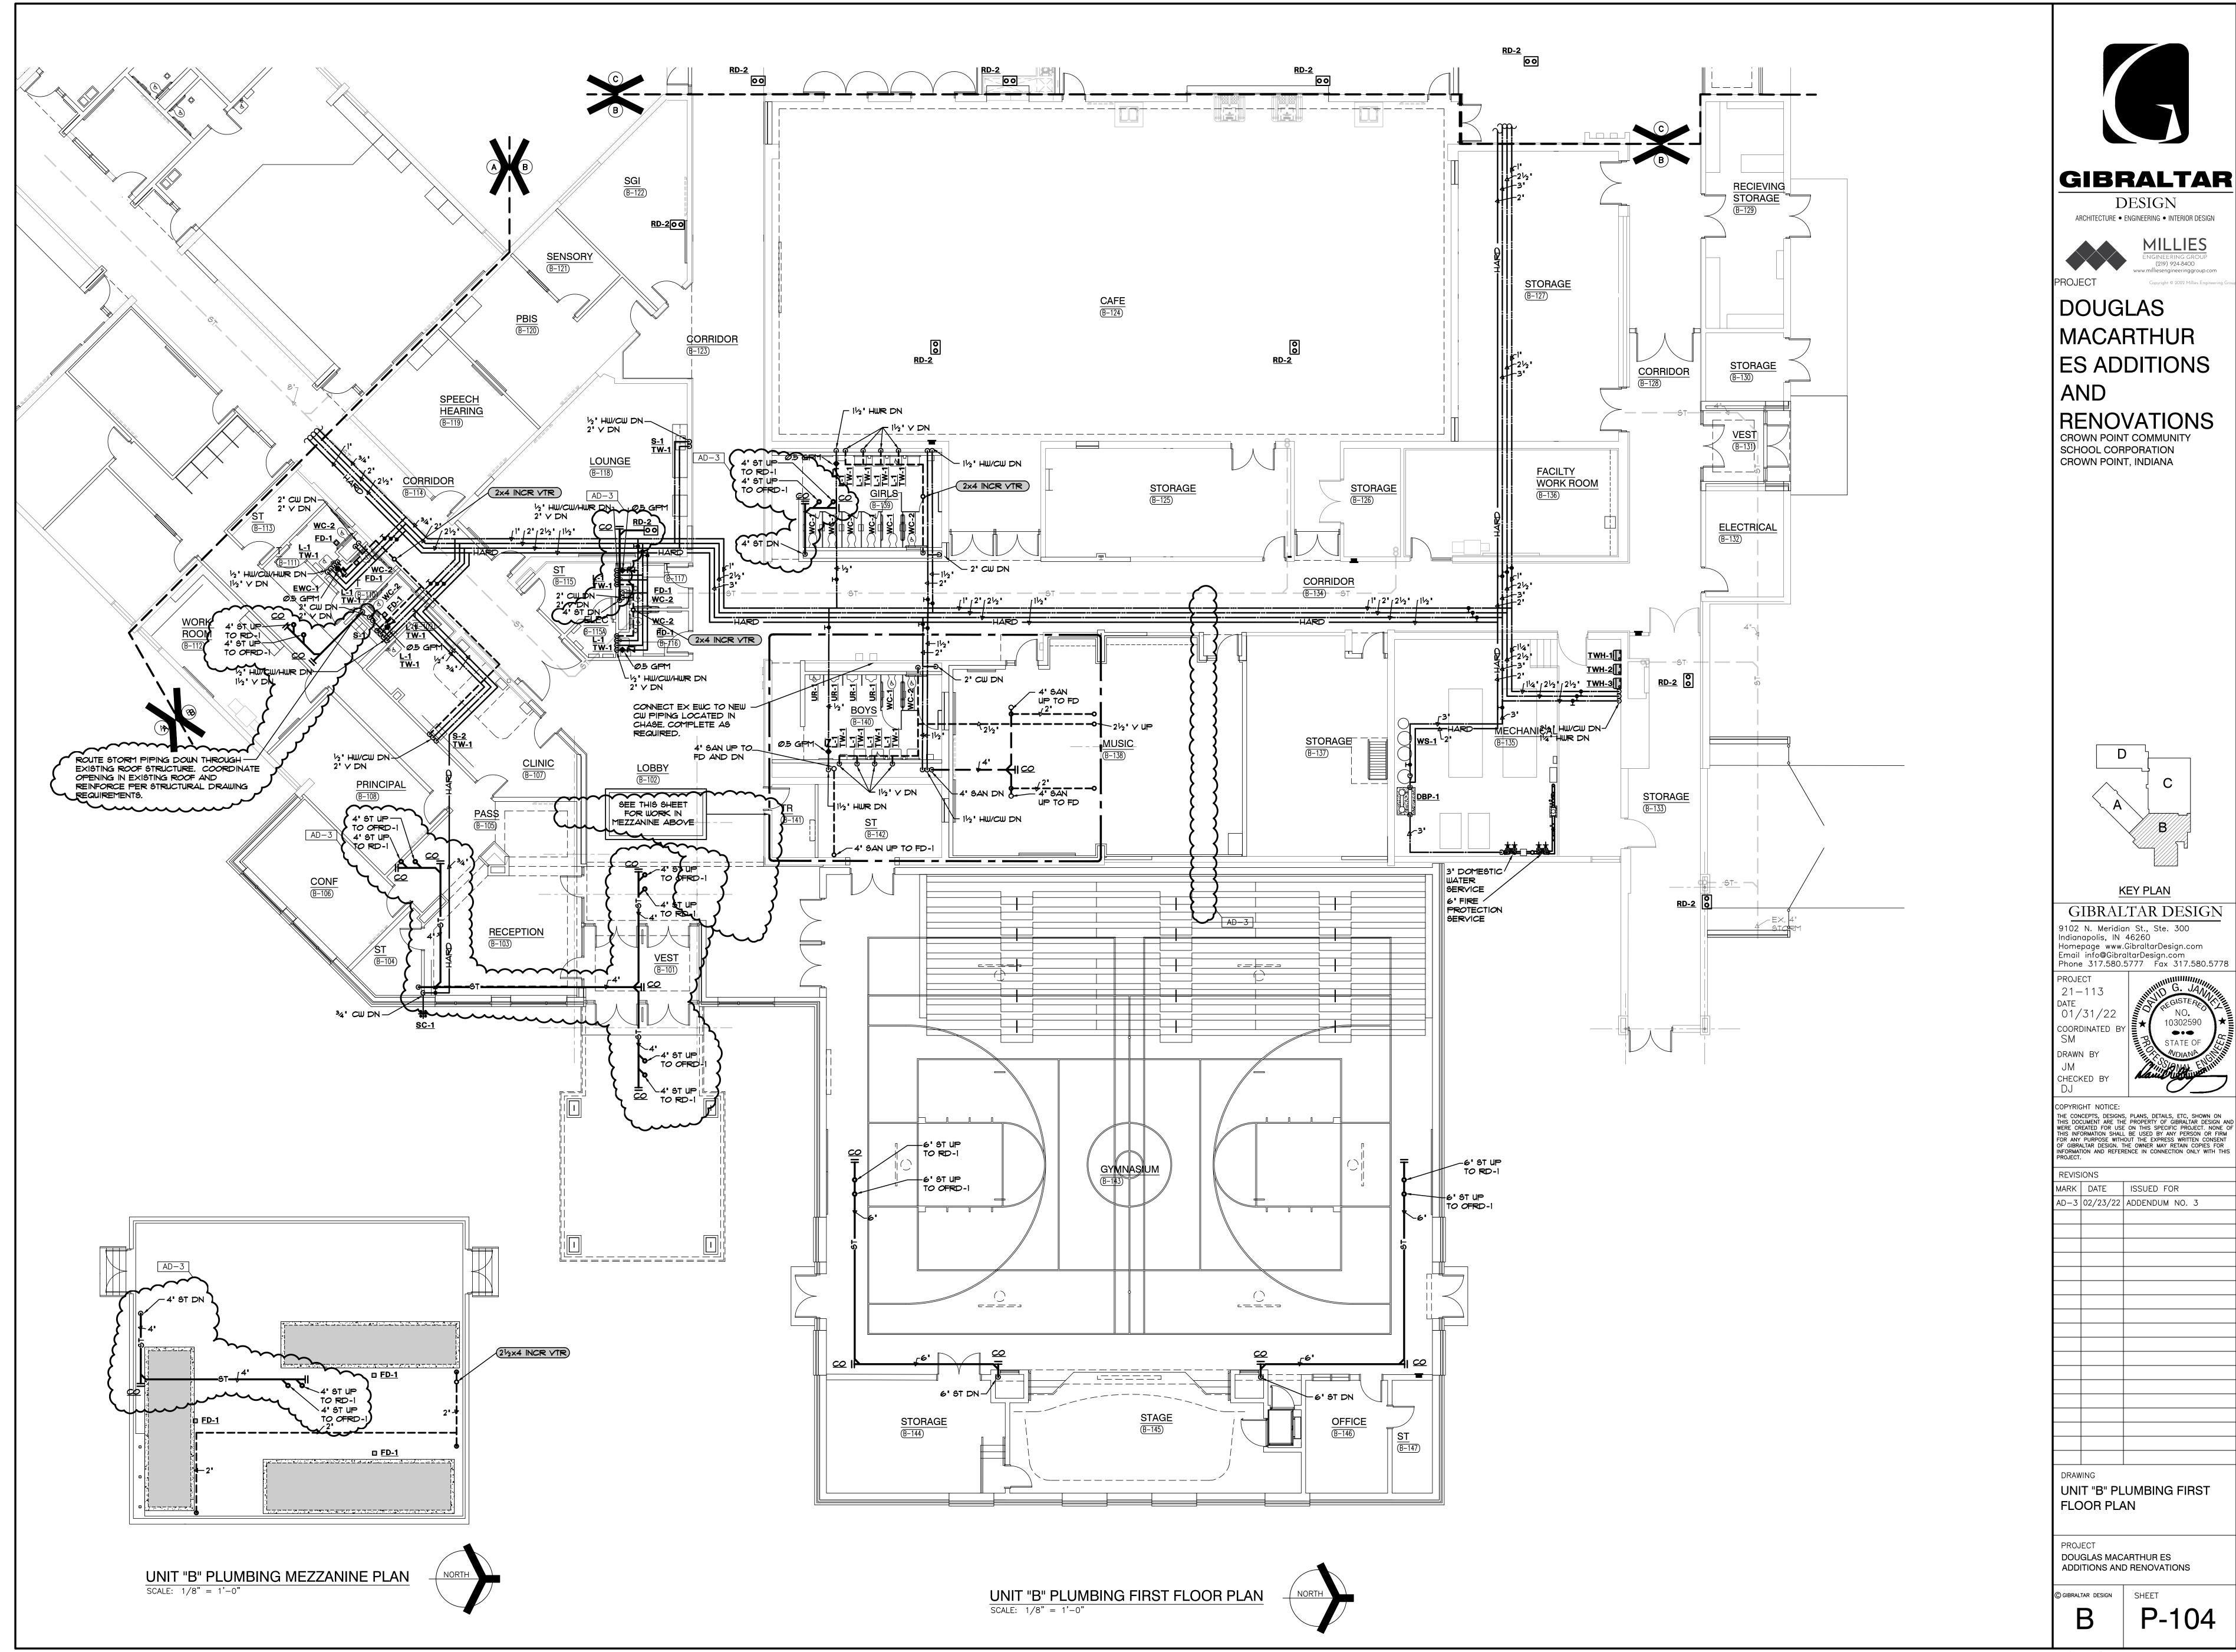

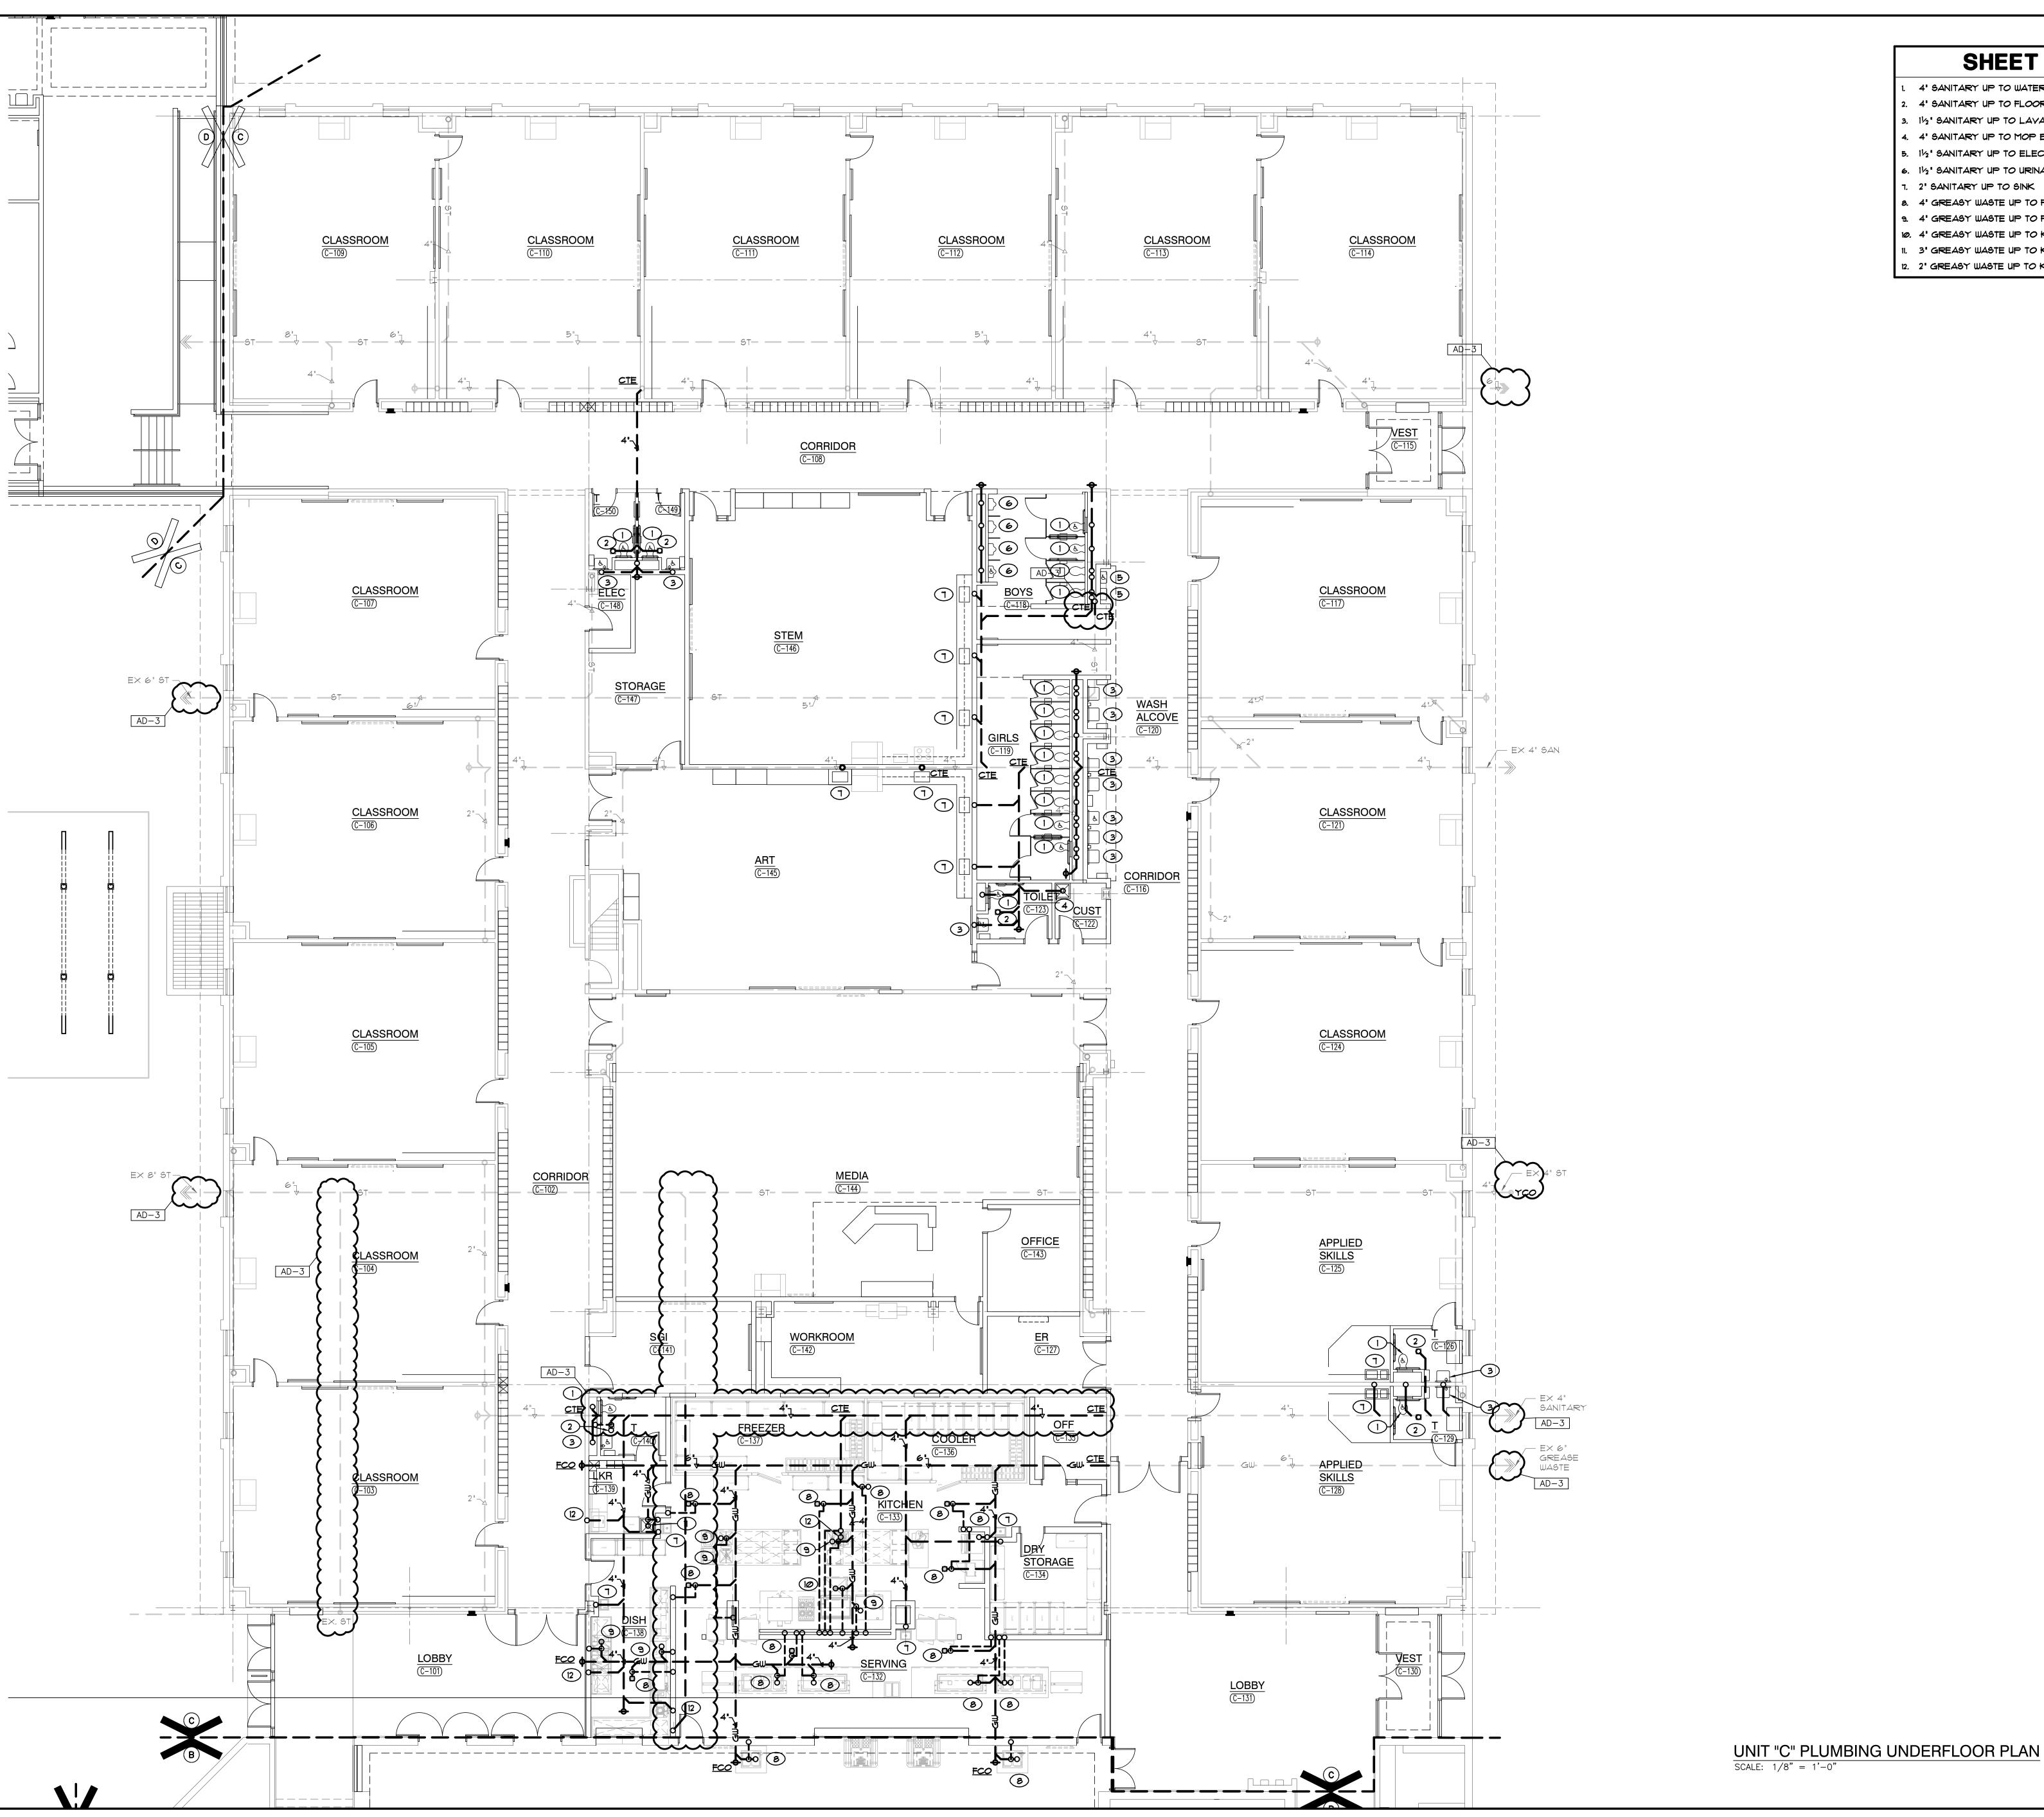



- 4" SANITARY UP TO WATER CLOSET.

- . 4' GREASY WASTE UP TO FLOOR SINK.

- 2. 2' GREASY WASTE UP TO KITCHEN EQUIPMENT




GIBRALTAR DESIGN



DOUGLAS

MACARTHUR ES ADDITIONS AND

RENOVATIONS CROWN POINT COMMUNITY SCHOOL CORPORATION CROWN POINT, INDIANA

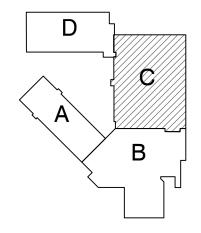


KEY PLAN

GIBRALTAR DESIGN 9102 N. Meridian St., Ste. 300 Indianapolis, IN 46260 Homepage www.GibraltarDesign.com Email info@GibraltarDesign.com Phone 317.580.5777 Fax 317.580.5778

COORDINATED DRAWN BY

CHECKED BY

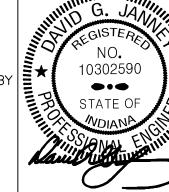

THE CONCEPTS, DESIGNS, PLANS, DETAILS, ETC, SHOWN ON THIS DOCUMENT ARE THE PROPERTY OF GIBRALTAR DESIGN AND WERE CREATED FOR USE ON THIS SPECIFIC PROJECT. NONE OF THIS INFORMATION SHALL BE USED BY ANY PERSON OR FIRM FOR ANY PURPOSE WITHOUT THE EXPRESS WRITTEN CONSENT OF GIBRALTAR DESIGN. THE OWNER MAY RETAIN COPIES FOR INFORMATION AND REFERENCE IN CONNECTION ONLY WITH THIS PROJECT.

MARK DATE ISSUED FOR AD-3 02/23/22 ADDENDUM NO. 3


UNIT "C" PLUMBING UNDERFLOOR PLAN

PROJECT

DOUGLAS MACARTHUR ES

ADDITIONS AND RENOVATIONS

P-105

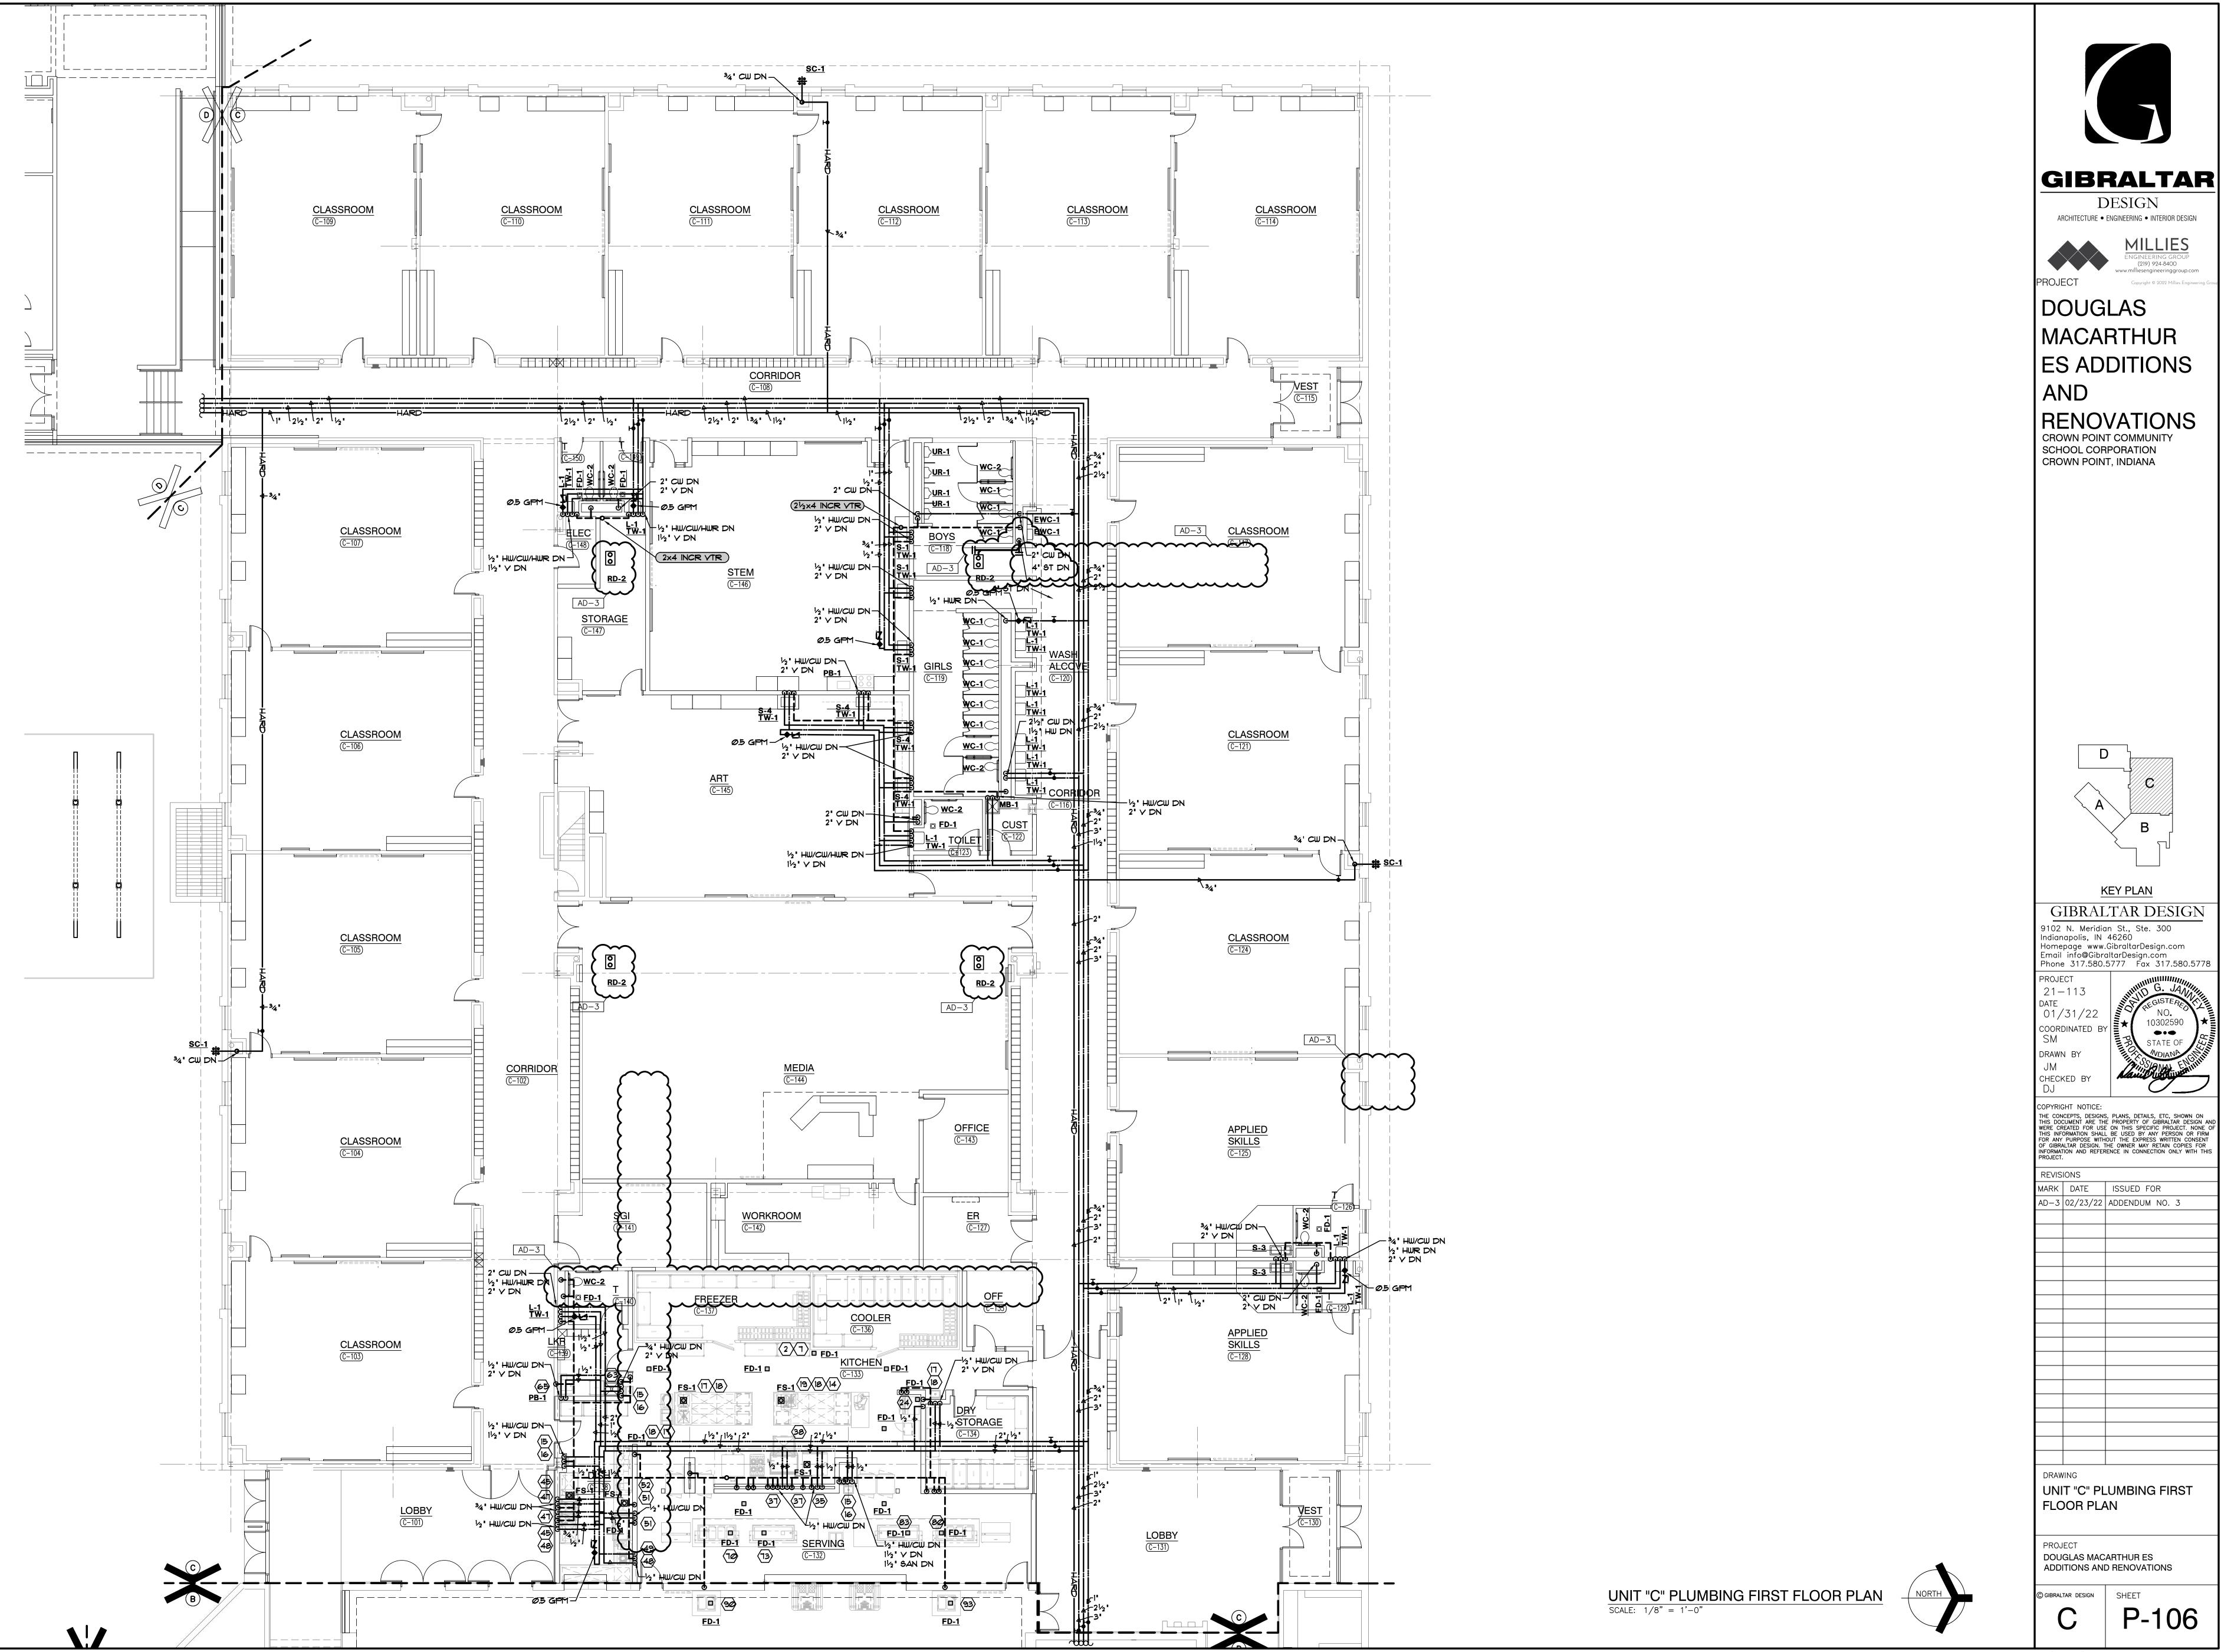

- 4' SANITARY UP TO WATER CLOSET.
- . 4" SANITARY UP TO FLOOR DRAIN.
- 4. 4" SANITARY UP TO MOP BASIN.
- 5. 11/2" SANITARY UP TO ELECTRIC WATER COOLER. 6. 11/2" SANITARY UP TO URINAL.








DOUGLAS MACARTHUR ES ADDITIONS

AND

RENOVATIONS CROWN POINT COMMUNITY SCHOOL CORPORATION CROWN POINT, INDIANA

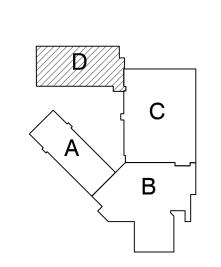

KEY PLAN

GIBRALTAR DESIGN 9102 N. Meridian St., Ste. 300 Indianapolis, IN 46260 Homepage www.GibraltarDesign.com Email info@GibraltarDesign.com Phone 317.580.5777 Fax 317.580.5778

COORDINATED

DRAWN BY

CHECKED BY

THE CONCEPTS, DESIGNS, PLANS, DETAILS, ETC, SHOWN ON THIS DOCUMENT ARE THE PROPERTY OF GIBRALTAR DESIGN AND WERE CREATED FOR USE ON THIS SPECIFIC PROJECT. NONE OF THIS INFORMATION SHALL BE USED BY ANY PERSON OR FIRM FOR ANY PURPOSE WITHOUT THE EXPRESS WRITTEN CONSENT OF GIBRALTAR DESIGN. THE OWNER MAY RETAIN COPIES FOR INFORMATION AND REFERENCE IN CONNECTION ONLY WITH THIS PROJECT.


KEVIS	ION2	
MARK	DATE	ISSUED FOR
AD-3	02/23/22	ADDENDUM NO. 3


DRAWING

UNIT "D" PLUMBING UNDERFLOOR PLAN

DOUGLAS MACARTHUR ES ADDITIONS AND RENOVATIONS

GIBRALTAR DESIGN SHEET P-107

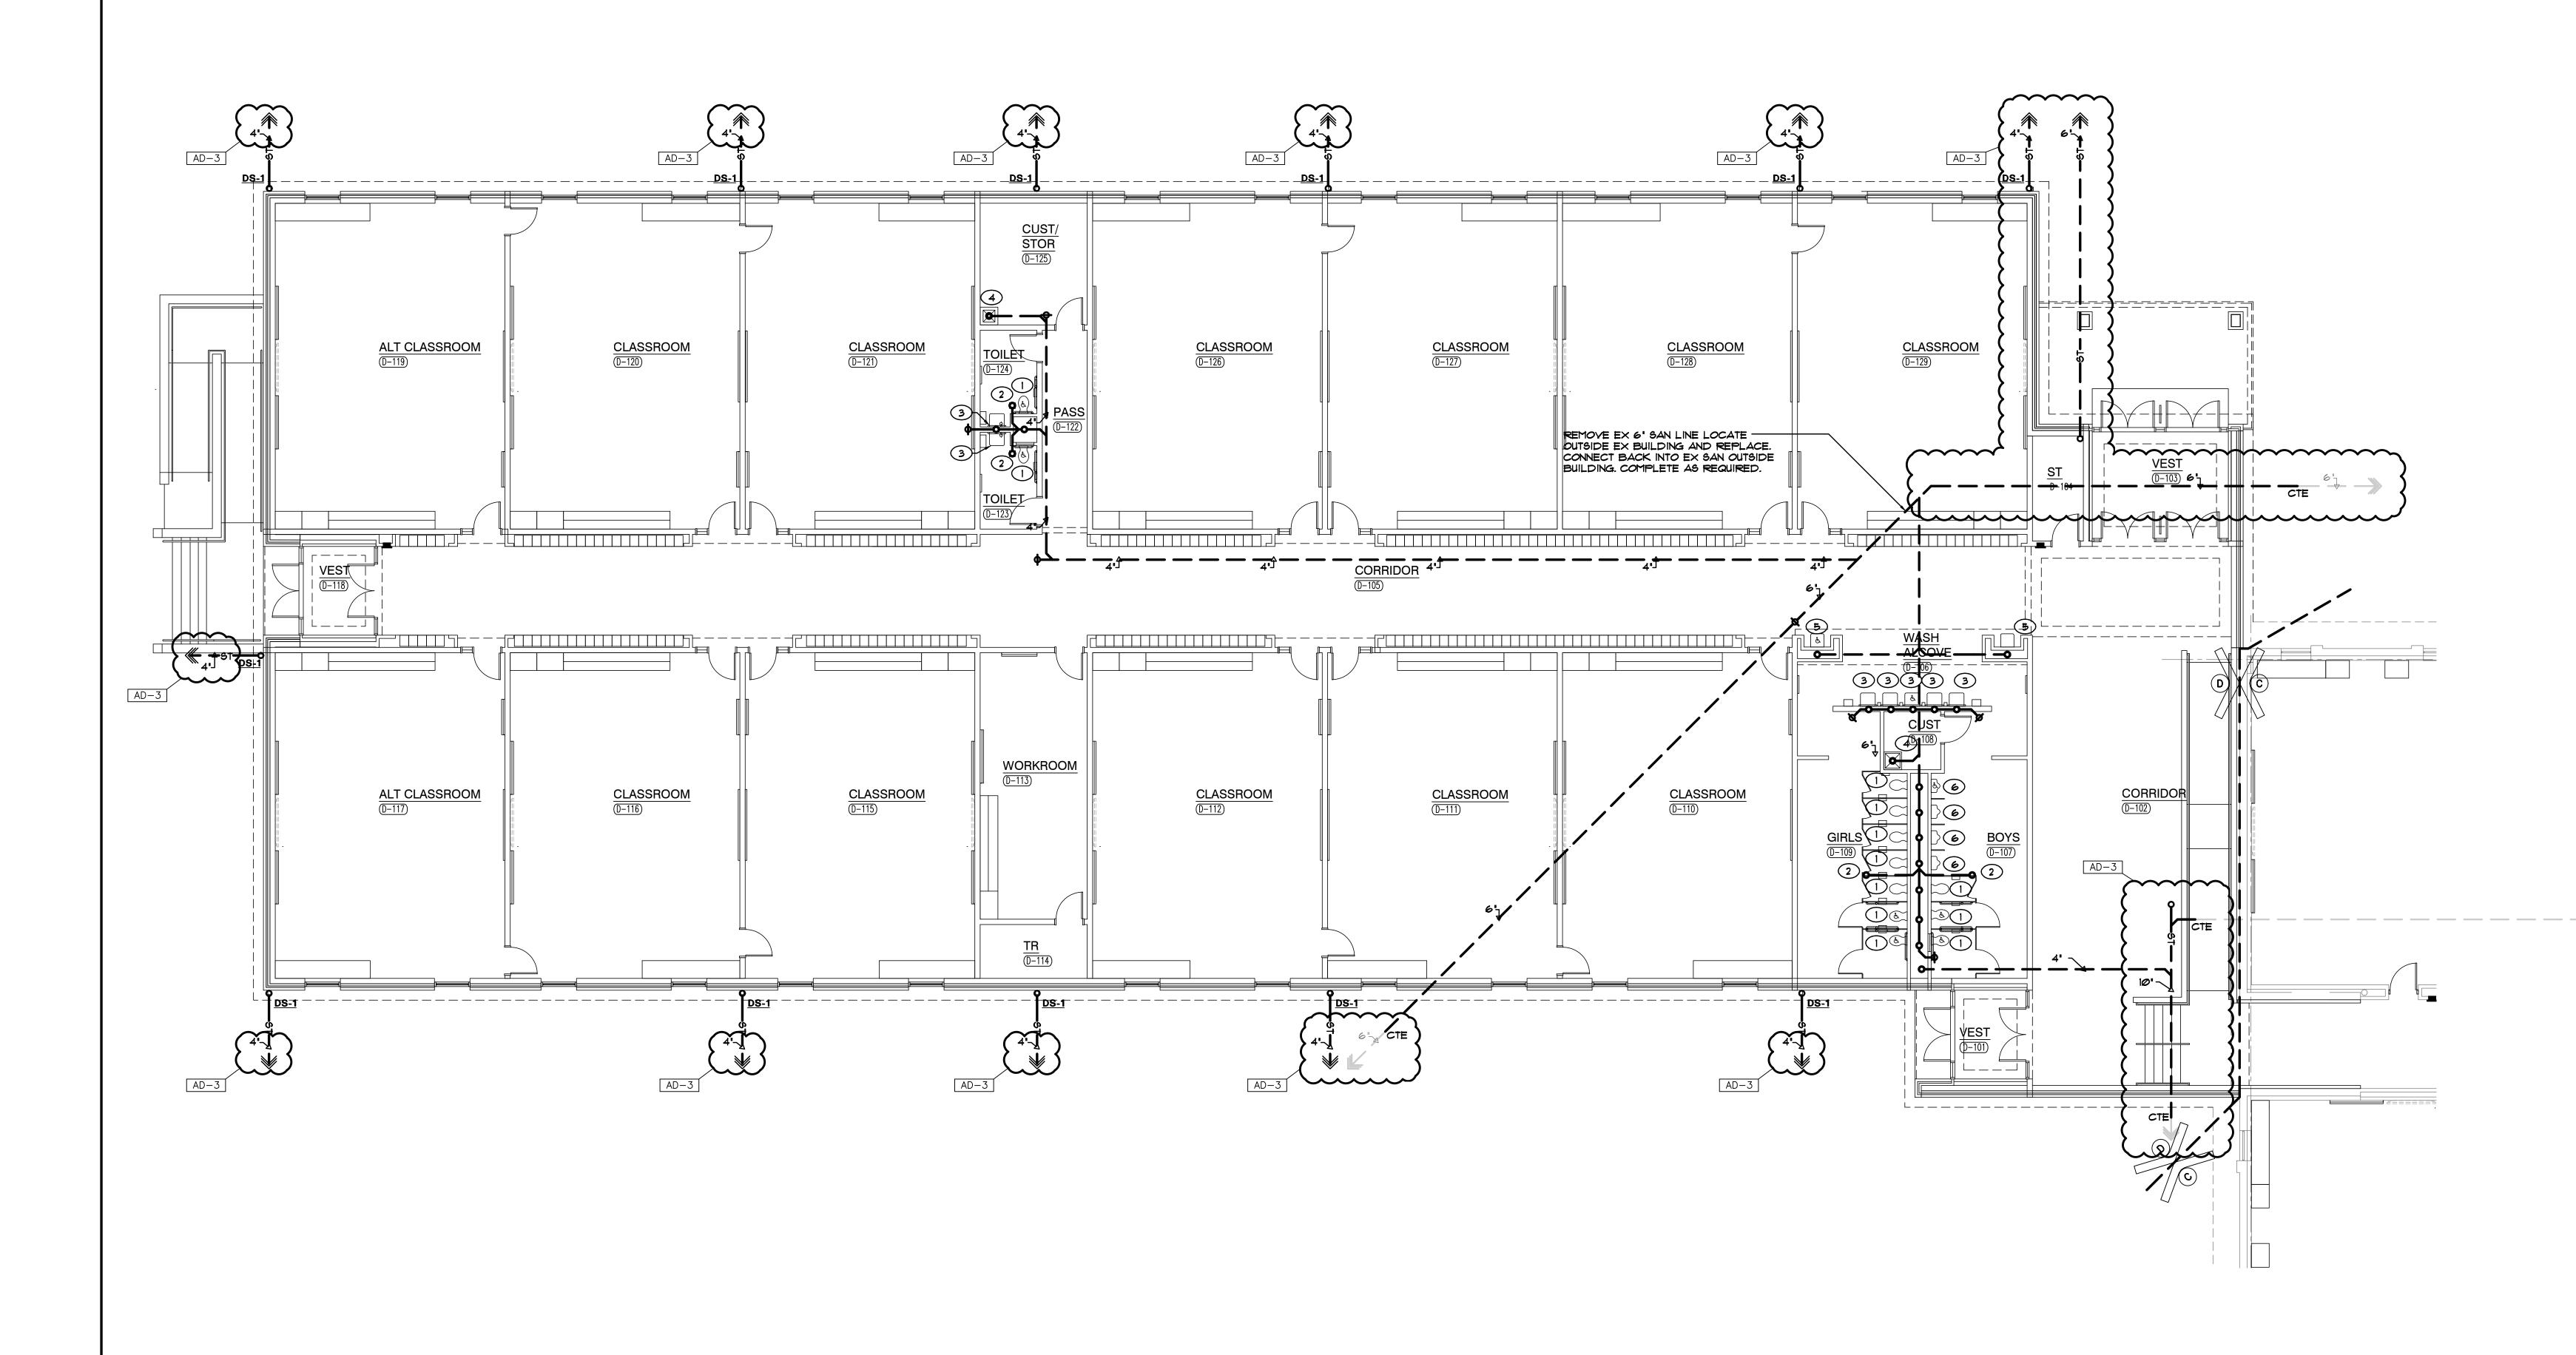

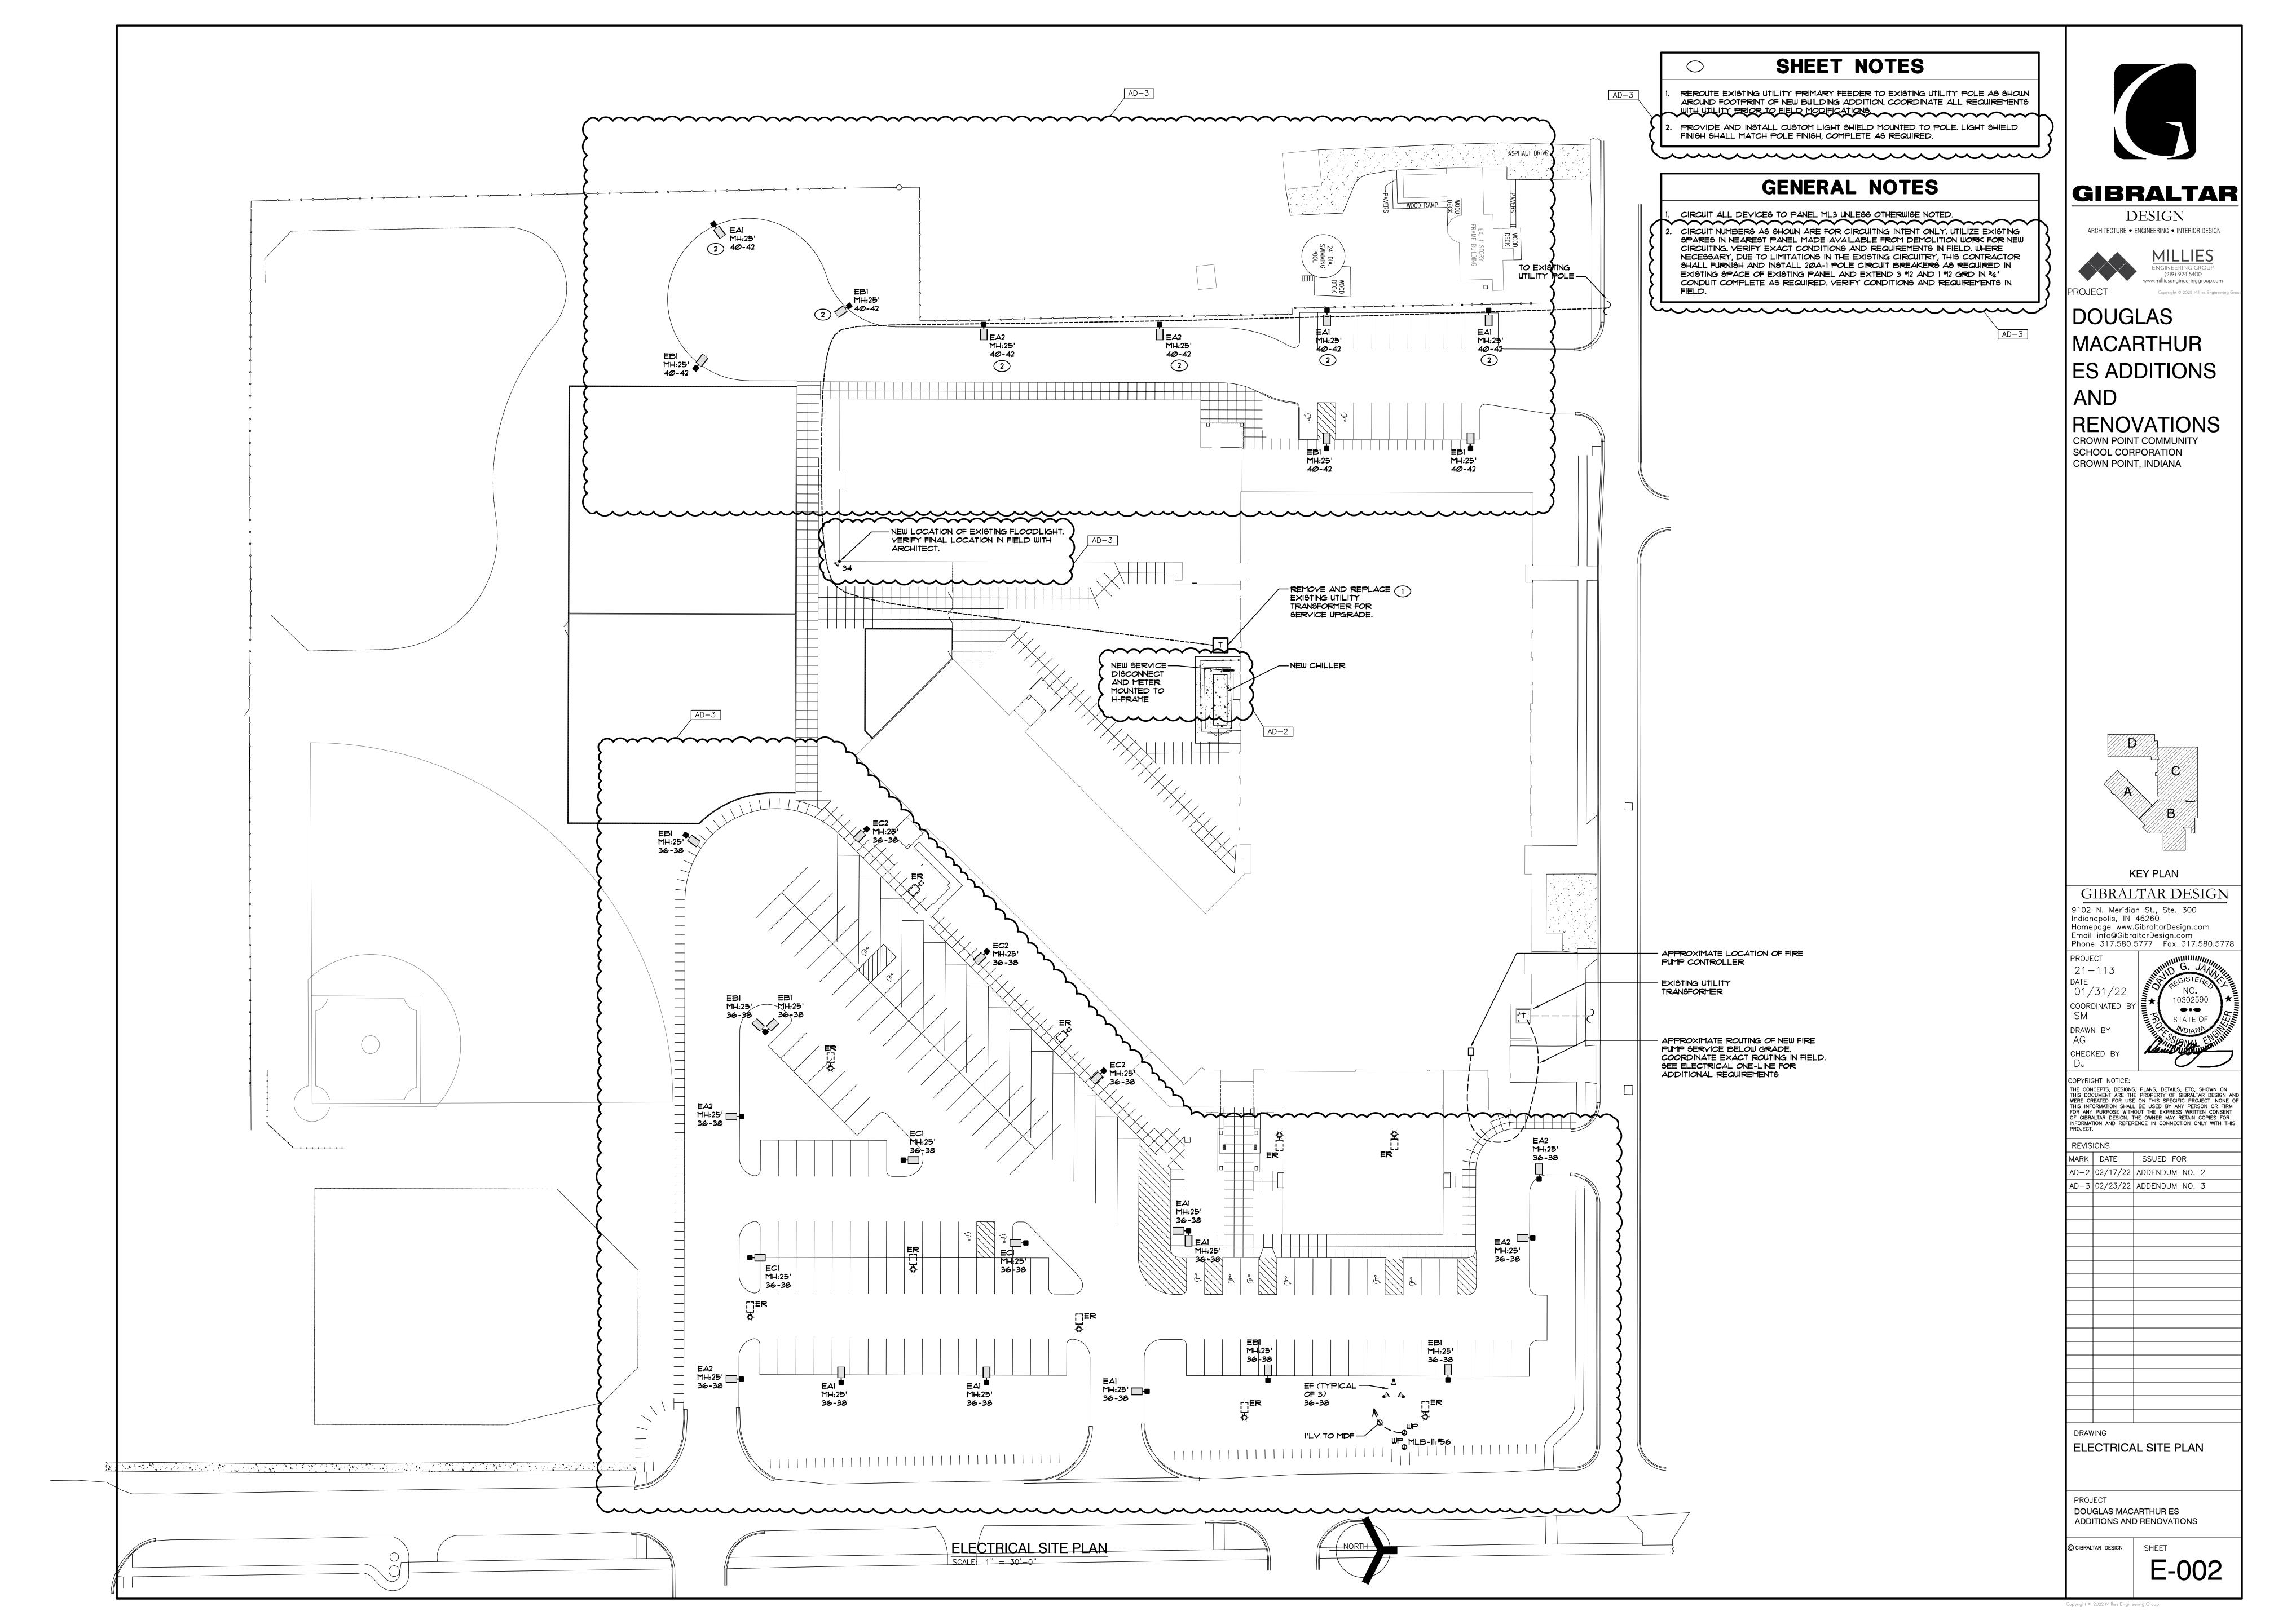



- REMOVE, RELOCATE, & REPLACE EX WESTINGHOUSE PANEL 'ML9', 120/208V, 30, 4W,
- REMOVE, RELOCATE, & REPLACE EX WESTINGHOUSE PANEL 'MLIØ', 120/208V, 34, 4W,
- REMOVE, RELOCATE, & REPLACE EX GE PANEL 'HP-3', 120/208Y, 34, 4W, 225A
- REMOVE, RELOCATE, & REPLACE EX GE PANEL 'CCP2', 120/208V, 34, 4W, 225A
- REMOVE & RELOCATE EX WESTINGHOUSE PANEL 'MLS', 120/208V, 3+, 4W, 225A
- REMOVE & RELOCATE EX GE PANEL 'CCPI', 120/208V, 34, 4W, 225A
- REMOVE, EX WESTINGHOUSE PANEL 'ML6', 120/208V, 34, 4W, 225A
- . REMOVE, EX WESTINGHOUSE PANEL 'MLT', 120/208V, 34, 4W, 225A
- REMOVE, EX WESTINGHOUSE PANEL 'ML4', 120/208V, 34, 4W, 225A
- Ø. REMOVE, EX WESTINGHOUSE PANEL 'MLL4', 120/208Y, 3¢, 4W, 225A
- REMOVE, EX WESTINGHOUSE PANEL 'ML5', 120/2084, 34, 4W, 600A
- EXISTING MECHANICAL EQUIPMENT TO BE REMOVED. DISCONNECT AND REMOVE EXISTING ELECTRICAL CONNECTION, COMPLETE AS REQUIRED.



GIBRALTAR

DESIGN




(219) 924-8400 PROJECT

DOUGLAS MACARTHUR ES ADDITIONS

RENOVATIONS

CROWN POINT COMMUNITY SCHOOL CORPORATION CROWN POINT, INDIANA

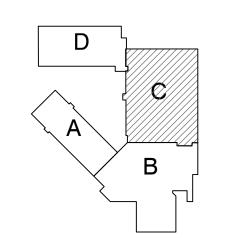


KEY PLAN GIBRALTAR DESIGN

9102 N. Meridian St., Ste. 300 Indianapolis, IN 46260 Homepage www.GibraltarDesign.com Email info@GibraltarDesign.com Phone 317.580.5777 Fax 317.580.5778

COORDINATED DRAWN B'

CHECKED BY

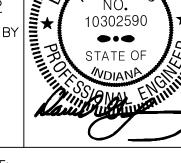

COPYRIGHT NOTICE: THE CONCEPTS, DESIGNS, PLANS, DETAILS, ETC, SHOWN ON THIS DOCUMENT ARE THE PROPERTY OF GIBRALTAR DESIGN AND WERE CREATED FOR USE ON THIS SPECIFIC PROJECT. NONE OF THIS INFORMATION SHALL BE USED BY ANY PERSON OR FIRM FOR ANY PURPOSE WITHOUT THE EXPRESS WRITTEN CONSENT OF GIBRALTAR DESIGN. THE OWNER MAY RETAIN COPIES FOR INFORMATION AND REFERENCE IN CONNECTION ONLY WITH THIS PROJECT.


MARK DATE ISSUED FOR AD-3 02/23/22 ADDENDUM NO. 3

UNIT "C" ELECTRICAL FIRST FLOOR DEMOLITION PLAN

DOUGLAS MACARTHUR ES ADDITIONS AND RENOVATIONS

ED103

UNIT "C" ELECTRICAL FIRST FLOOR DEMOLITION PLAN

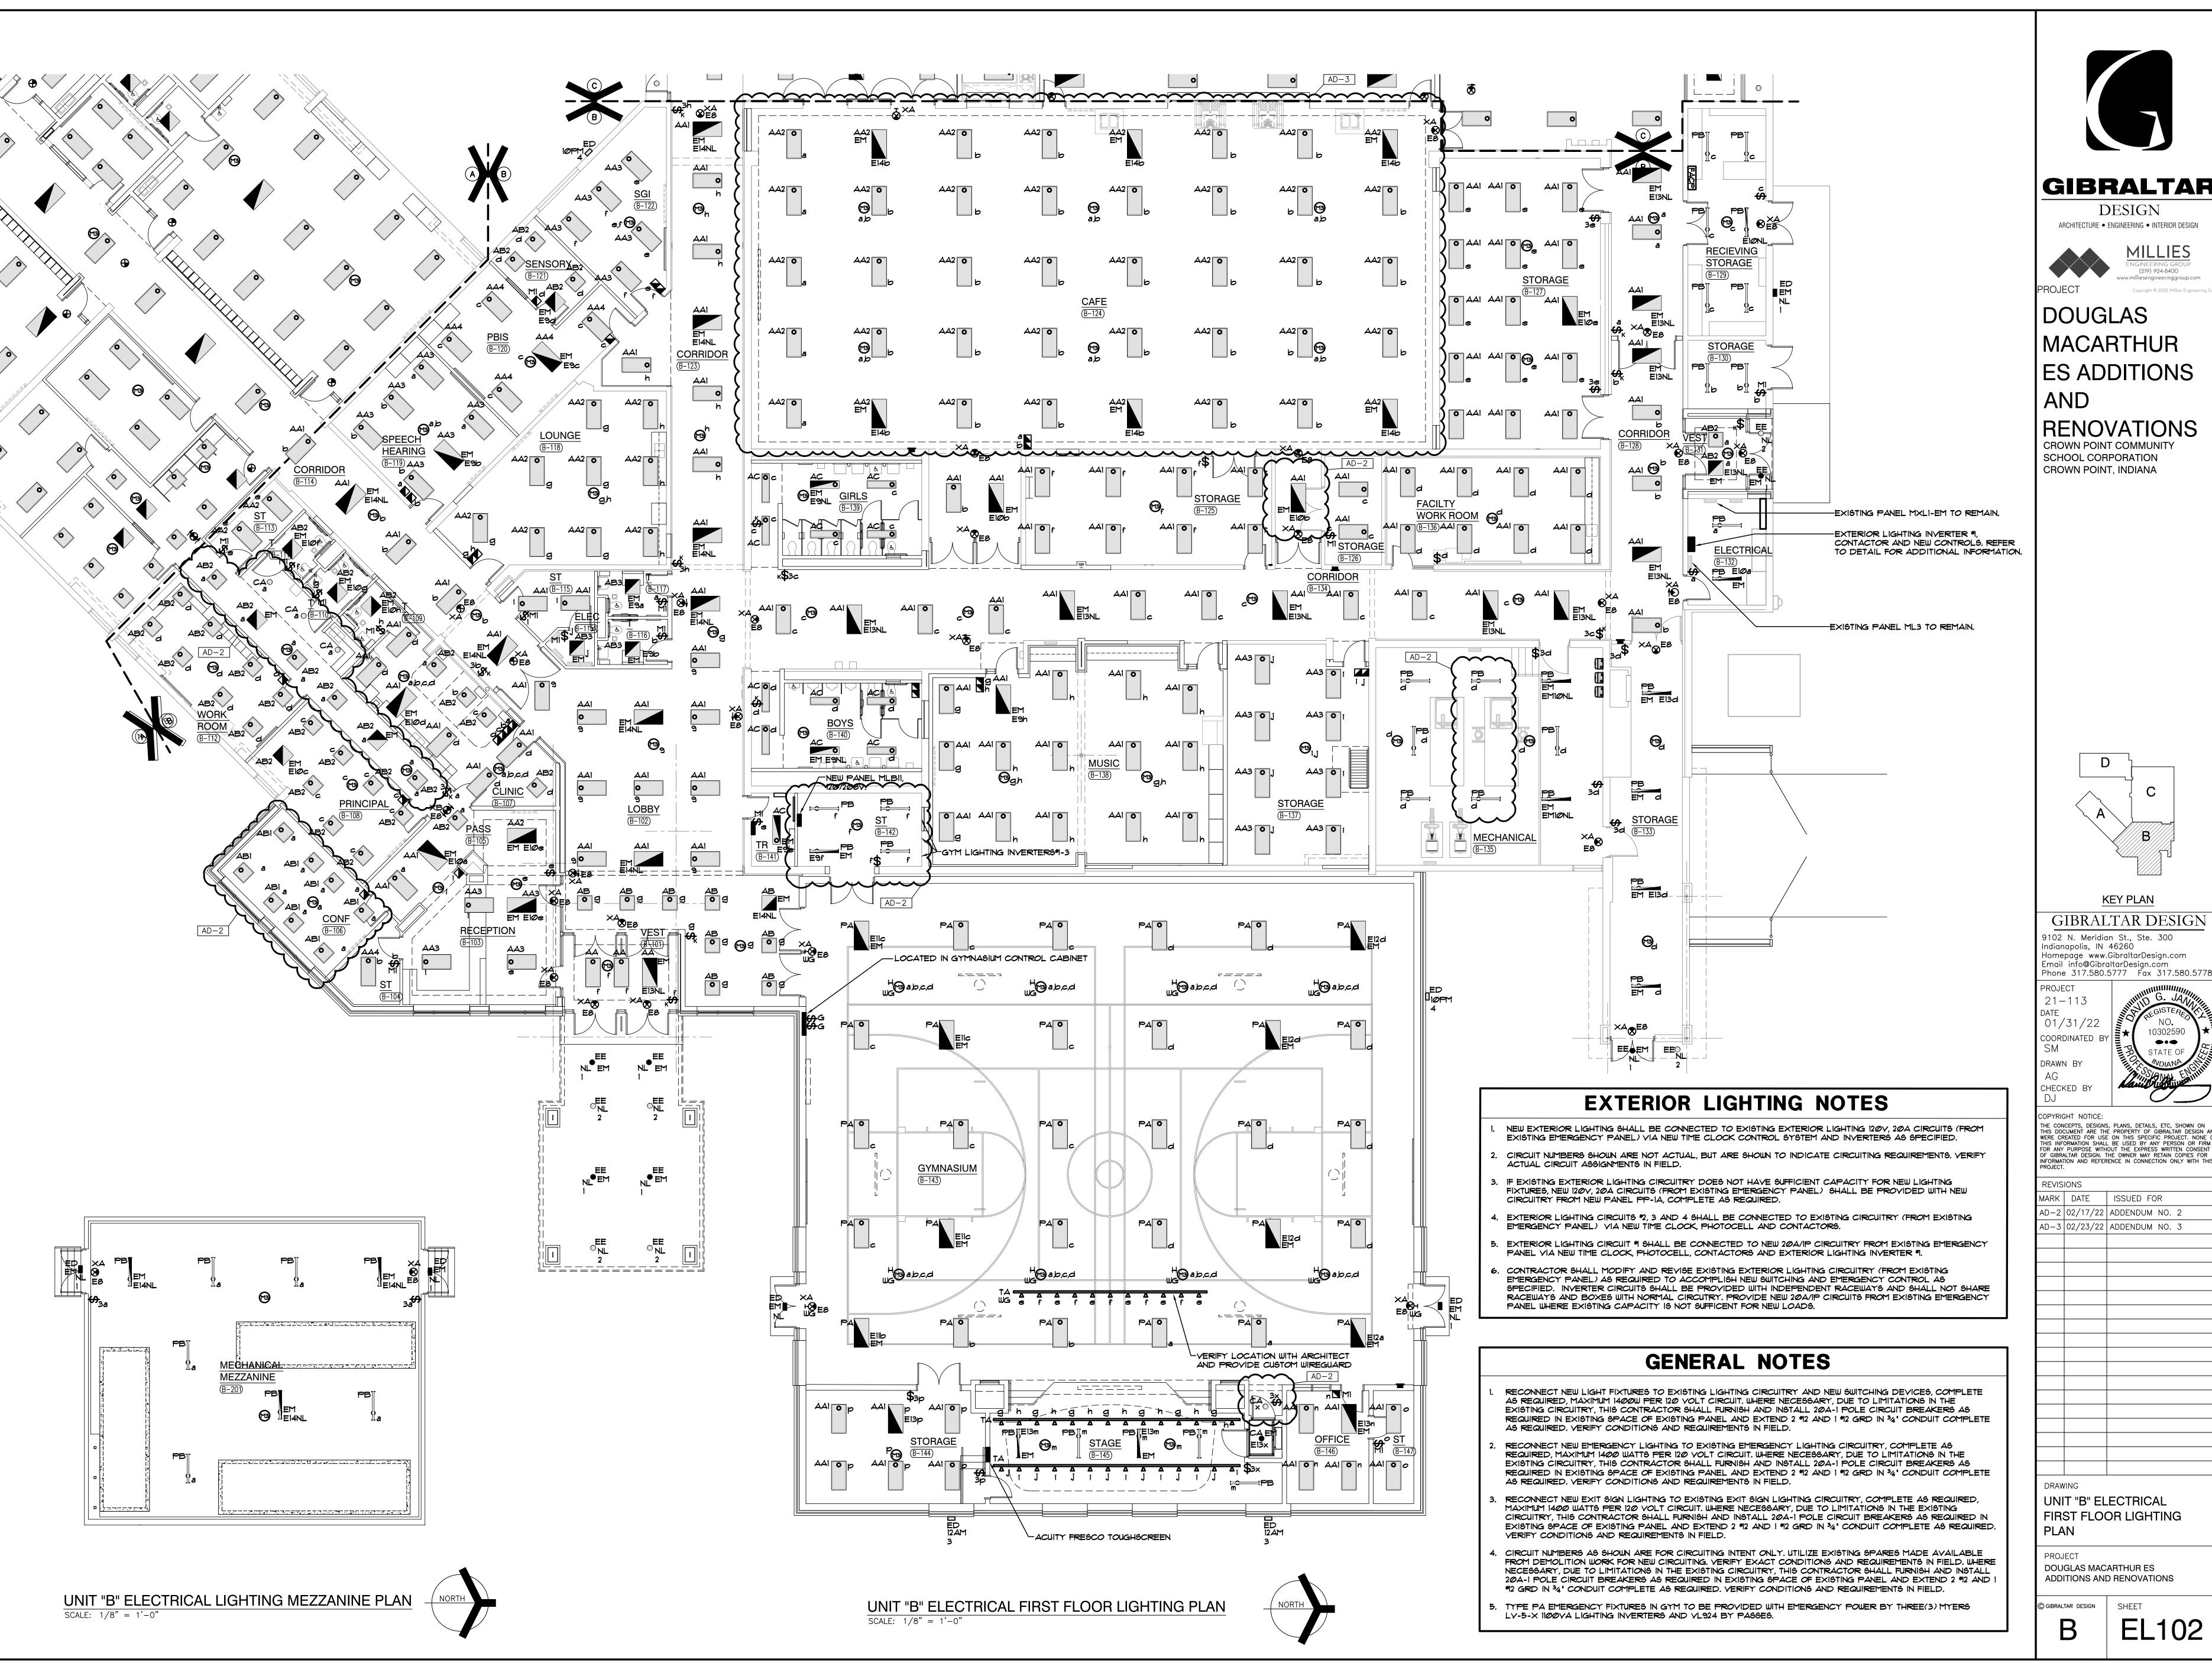


GIBRALTAR

ARCHITECTURE • ENGINEERING • INTERIOR DESIGN



MACARTHUR **ES ADDITIONS**

RENOVATIONS

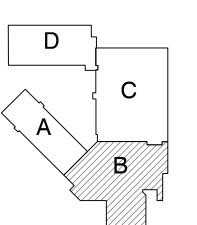

GIBRALTAR DESIGN

9102 N. Meridian St., Ste. 300


MARK DATE ISSUED FOR AD-2 | 02/17/22 | ADDENDUM NO. 2

AD-3 | 02/23/22 | ADDENDUM NO. 3

FIRST FLOOR LIGHTING

ADDITIONS AND RENOVATIONS

EL102

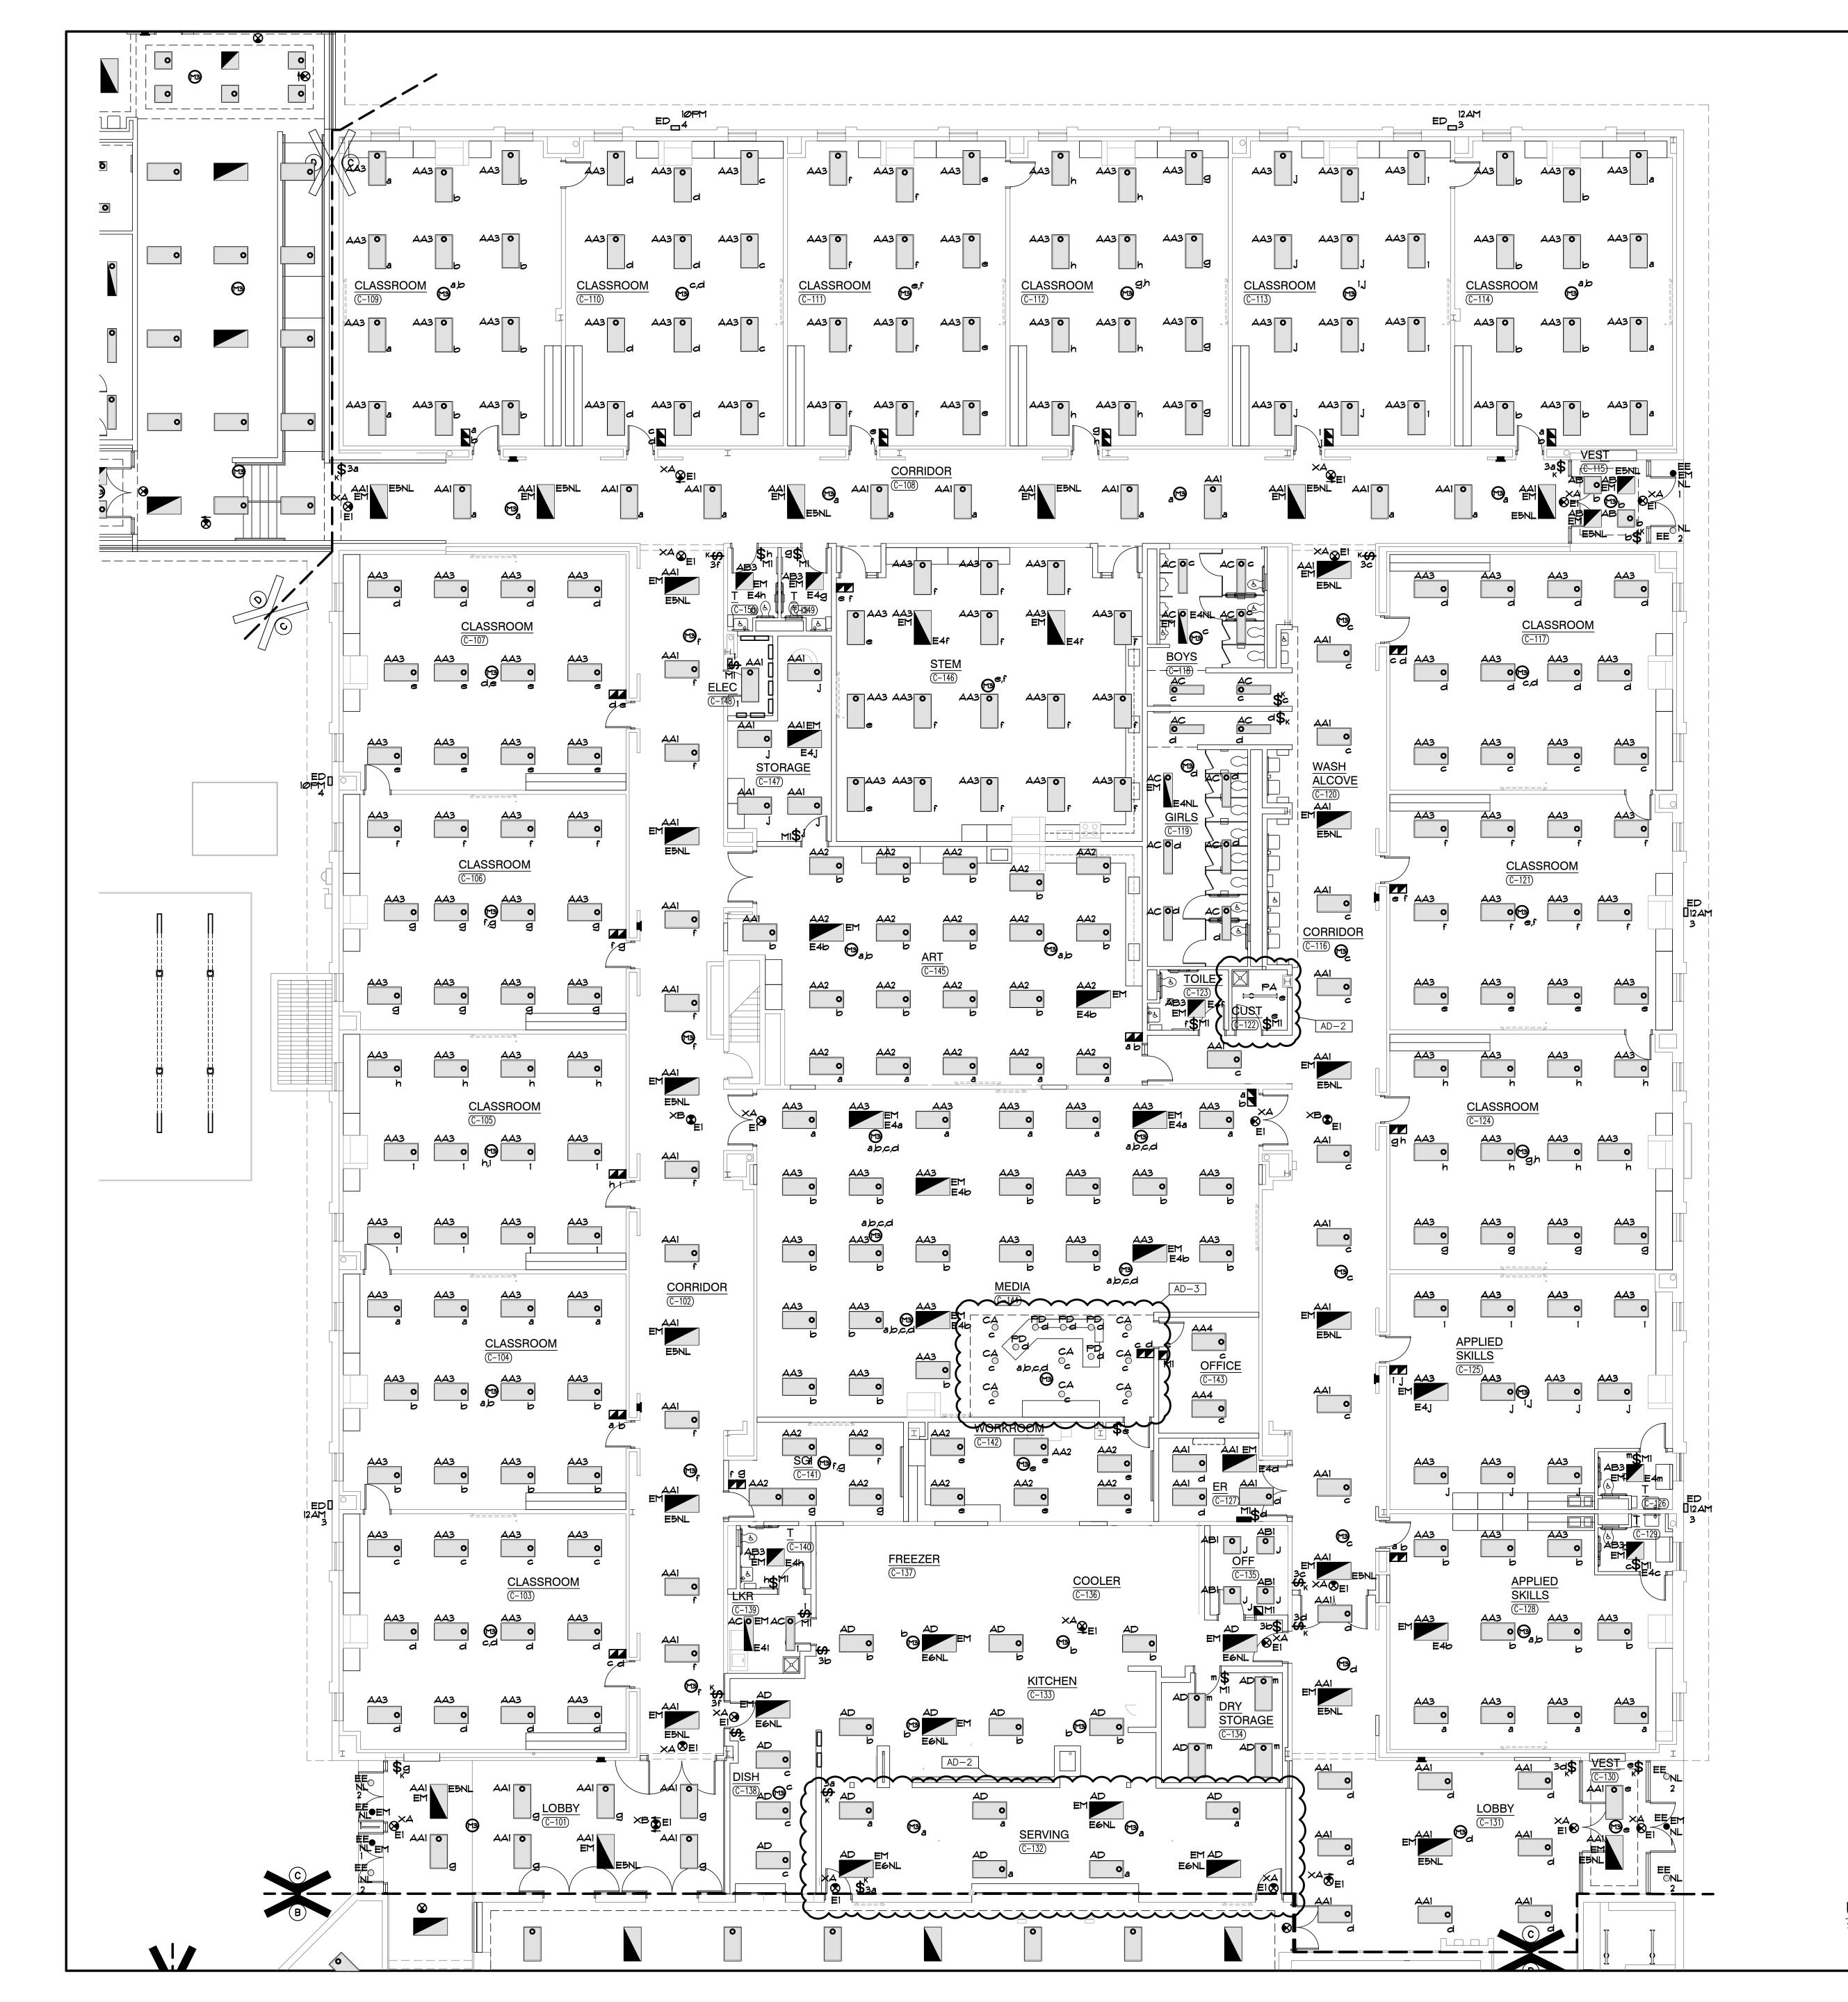

GENERAL NOTES

- 1. RECONNECT NEW LIGHT FIXTURES TO EXISTING LIGHTING CIRCUITRY AND NEW SWITCHING DEVICES, COMPLETE AS REQUIRED, MAXIMUM 1400W PER 120 VOLT CIRCUIT. WHERE NECESSARY, DUE TO LIMITATIONS IN THE EXISTING CIRCUITRY, THIS CONTRACTOR SHALL FURNISH AND INSTALL 20A-1 POLE CIRCUIT BREAKERS AS REQUIRED IN EXISTING SPACE OF EXISTING PANEL AND EXTEND 2 *12 AND 1 *12 GRD IN 34" CONDUIT COMPLETE AS REQUIRED. VERIFY CONDITIONS AND REQUIREMENTS IN FIELD.
- 2. RECONNECT NEW EMERGENCY LIGHTING TO EXISTING EMERGENCY LIGHTING CIRCUITRY, COMPLETE AS REQUIRED, MAXIMUM 1400 WATTS PER 120 VOLT CIRCUIT. WHERE NECESSARY, DUE TO LIMITATIONS IN THE EXISTING CIRCUITRY, THIS CONTRACTOR SHALL FURNISH AND INSTALL 20A-1 POLE CIRCUIT BREAKERS AS REQUIRED IN EXISTING SPACE OF EXISTING PANEL AND EXTEND 2 *12 AND 1 *12 GRD IN 34" CONDUIT COMPLETE AS REQUIRED. VERIFY CONDITIONS AND REQUIREMENTS IN FIELD.
- RECONNECT NEW EXIT SIGN LIGHTING TO EXISTING EXIT SIGN LIGHTING CIRCUITRY COMPLETE AS REQUIRED, MAXIMUM 1400 WATTS PER 120 VOLT CIRCUIT. WHERE NECESSARY, DUE TO LIMITATIONS IN THE EXISTING CIRCUITRY, THIS CONTRACTOR SHALL FURNISH AND INSTALL 20A-1 POLE CIRCUIT BREAKERS AS REQUIRED IN EXISTING SPACE OF EXISTING PANEL AND EXTEND 2 *12 AND 1 *12 GRD IN 34 *1 CONDUIT COMPLETE AS REQUIRED. VERIFY CONDITIONS AND REQUIREMENTS IN FIELD.
- 4. CIRCUIT NUMBERS AS SHOWN ARE FOR CIRCUITING INTENT ONLY. UTILIZE EXISTING SPARES MADE AVAILABLE FROM DEMOLITION WORK FOR NEW CIRCUITING. VERIFY EXACT CONDITIONS AND REQUIREMENTS IN FIELD. WHERE NECESSARY, DUE TO LIMITATIONS IN THE EXISTING CIRCUITRY, THIS CONTRACTOR SHALL FURNISH AND INSTALL 20A-I POLE CIRCUIT BREAKERS AS REQUIRED IN EXISTING SPACE OF EXISTING PANEL AND EXTEND 2 *12 AND I *12 GRD IN 3/4" CONDUIT COMPLETE AS REQUIRED. VERIFY CONDITIONS AND REQUIREMENTS IN FIELD.

EXTERIOR LIGHTING NOTES

- 1. NEW EXTERIOR LIGHTING SHALL BE CONNECTED TO EXISTING EXTERIOR LIGHTING 120V, 20A CIRCUITS (FROM EXISTING EMERGENCY PANEL) VIA NEW TIME CLOCK CONTROL SYSTEM AND INVERTERS AS SPECIFIED.
- 2. CIRCUIT NUMBERS SHOWN ARE NOT ACTUAL, BUT ARE SHOWN TO INDICATE

CIRCUITING REQUIREMENTS. VERIFY ACTUAL CIRCUIT ASSIGNMENTS IN FIELD.

- 3. IF EXISTING EXTERIOR LIGHTING CIRCUITRY DOES NOT HAVE SUFFICIENT CAPACITY FOR NEW LIGHTING FIXTURES, NEW 120Y, 20A CIRCUITS (FROM EXISTING EMERGENCY PANEL) SHALL BE PROVIDED WITH NEW CIRCUITRY FROM
- 4. EXTERIOR LIGHTING CIRCUITS *2, 3 AND 4 SHALL BE CONNECTED TO EXISTING CIRCUITRY (FROM EXISTING EMERGENCY PANEL) VIA NEW TIME CLOCK, PHOTOCELL AND CONTACTORS.

NEW PANEL PP-1A, COMPLETE AS REQUIRED.

- 5. EXTERIOR LIGHTING CIRCUIT #1 SHALL BE CONNECTED TO NEW 20A/IP CIRCUITRY FROM EXISTING EMERGENCY PANEL VIA NEW TIME CLOCK, PHOTOCELL, CONTACTORS AND EXTERIOR LIGHTING INVERTER #1.
- 6. CONTRACTOR SHALL MODIFY AND REVISE EXISTING EXTERIOR LIGHTING CIRCUITRY (FROM EXISTING EMERGENCY PANEL) AS REQUIRED TO ACCOMPLISH NEW SWITCHING AND EMERGENCY CONTROL AS SPECIFIED. INVERTER CIRCUITS SHALL BE PROVIDED WITH INDEPENDENT RACEWAYS AND SHALL NOT SHARE RACEWAYS AND BOXES WITH NORMAL CIRCUITRY. PROVIDE NEW 20A/IP CIRCUITS FROM EXISTING EMERGENCY PANEL WHERE EXISTING CAPACITY IS NOT SUFFICENT FOR NEW LOADS.



GIBRALTAR

DESIGN

ARCHITECTURE • ENGINEERING • INTERIOR DESIGN

MILLIES
ENGINEERING GROUP
(219) 924-8400
www.milliesengineeringgroup.com

PROJECT Copyright © 2022 Millies Engineeri

DOUGLAS

MACARTHUR


ES ADDITIONS

AND

RENOVATIONS CROWN POINT COMMUNITY

SCHOOL CORPORATION

CROWN POINT, INDIANA

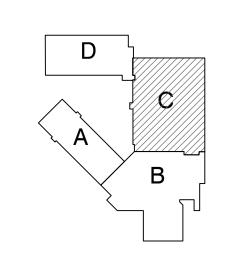

KEY PLAN

GIBRALTAR DESIGN
9102 N. Meridian St., Ste. 300
Indianapolis, IN 46260
Homepage www.GibraltarDesign.com
Email info@GibraltarDesign.com
Phone 317.580.5777 Fax 317.580.5778

PROJECT

21-113

DATE


01/31/22

COORDINATED BY

SM

DRAWN B'

CHECKED BY

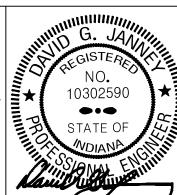

COPYRIGHT NOTICE:

THE CONCEPTS, DESIGNS, PLANS, DETAILS, ETC, SHOWN ON THIS DOCUMENT ARE THE PROPERTY OF GIBRALTAR DESIGN AND WERE CREATED FOR USE ON THIS SPECIFIC PROJECT. NONE OF THIS INFORMATION SHALL BE USED BY ANY PERSON OR FIRM FOR ANY PURPOSE WITHOUT THE EXPRESS WRITTEN CONSENT OF GIBRALTAR DESIGN. THE OWNER MAY RETAIN COPIES FOR INFORMATION AND REFERENCE IN CONNECTION ONLY WITH THIS PROJECT.

REVISIONS

MARK DATE ISSUED FOR

AD-2 02/17/22 ADDENDUM NO. 2

AD-3 02/23/22 ADDENDUM NO. 3

DRAWING

UNIT "C" ELECTRICAL
FIRST FLOOR LIGHTING
PLAN


PROJECT

DOUGLAS MACARTHUR ES

ADDITIONS AND RENOVATIONS

© GIBRALTAR DESIGN

SHEET EL103

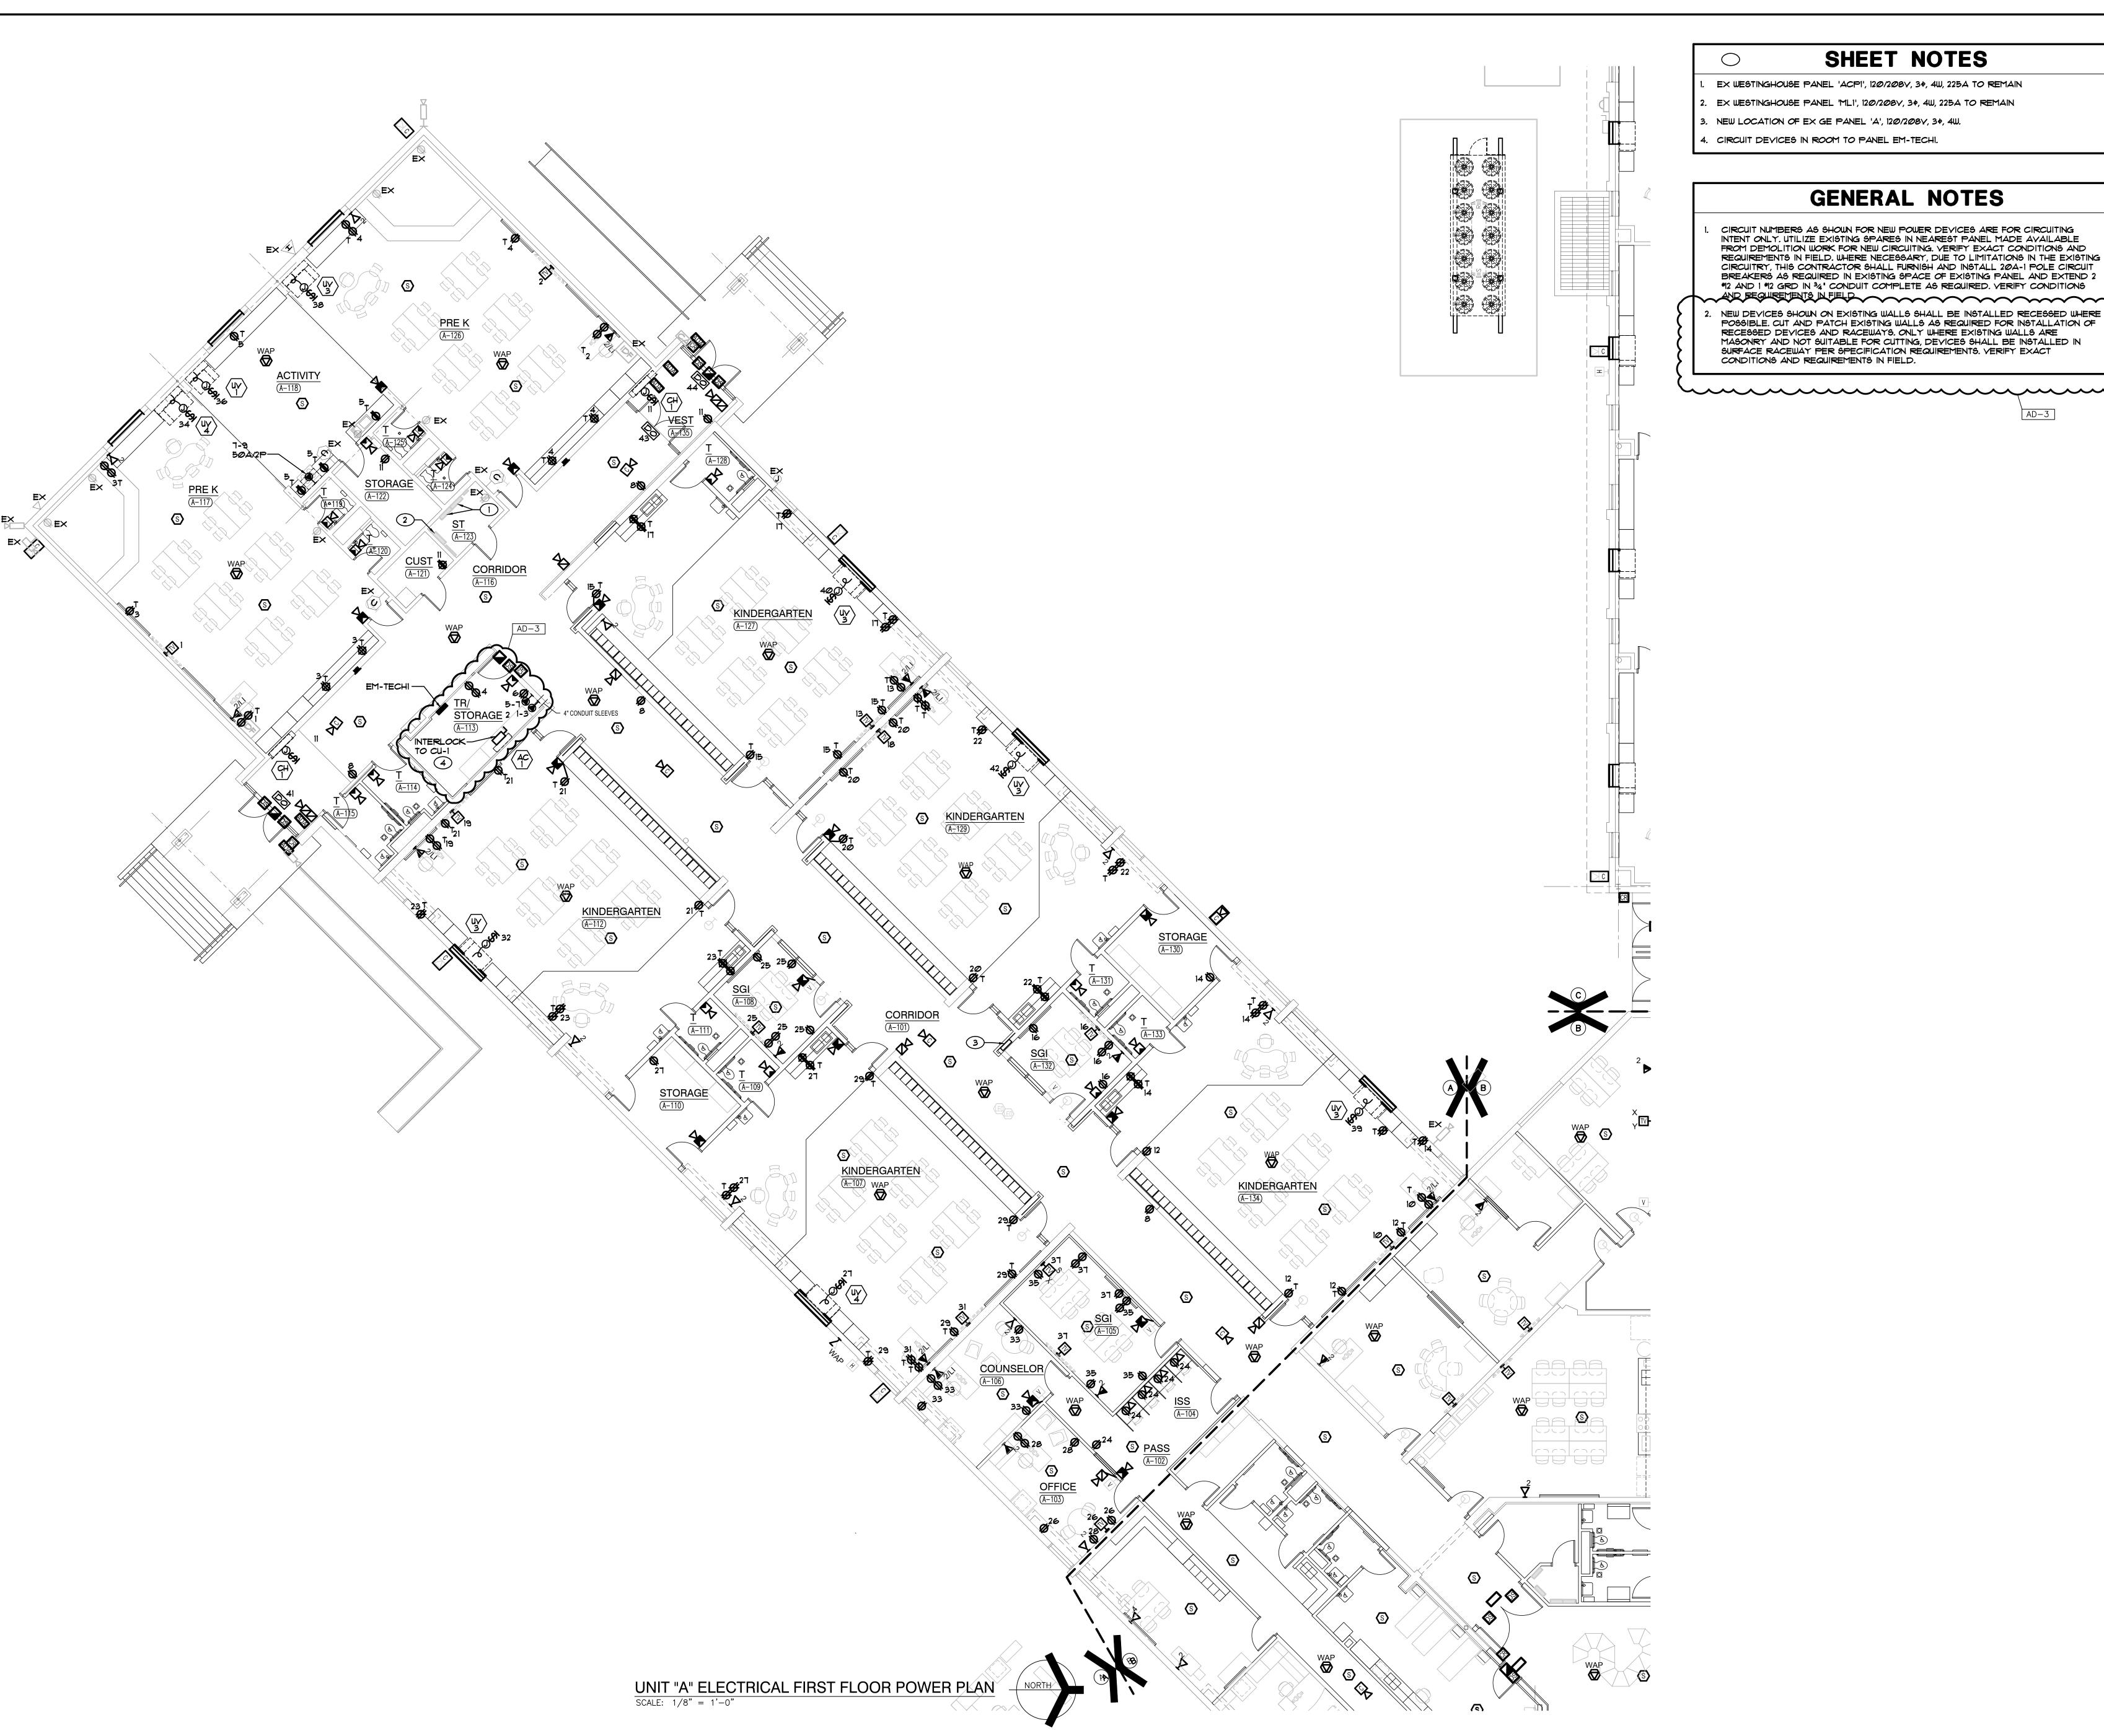

- EX WESTINGHOUSE PANEL 'ACPI', 120/2084, 34, 4W, 225A TO REMAIN
- EX WESTINGHOUSE PANEL 'ML1', 120/208V, 34, 4W, 225A TO REMAIN
- 3. NEW LOCATION OF EXIGE PANEL 'A', 120/2087, 3¢, 4W.
- 4. CIRCUIT DEVICES IN ROOM TO PANEL EM-TECHI.

GENERAL NOTES

1. CIRCUIT NUMBERS AS SHOWN FOR NEW POWER DEVICES ARE FOR CIRCUITING INTENT ONLY. UTILIZE EXISTING SPARES IN NEAREST PANEL MADE AVAILABLE FROM DEMOLITION WORK FOR NEW CIRCUITING. VERIFY EXACT CONDITIONS AND REQUIREMENTS IN FIELD. WHERE NECESSARY, DUE TO LIMITATIONS IN THE EXISTING CIRCUITRY, THIS CONTRACTOR SHALL FURNISH AND INSTALL 20A-1 POLE CIRCUIT BREAKERS AS REQUIRED IN EXISTING SPACE OF EXISTING PANEL AND EXTEND 2 #12 AND 1 #12 GRD IN 34 CONDUIT COMPLETE AS REQUIRED. VERIFY CONDITIONS AND REQUIREMENTS IN FIELD

. NEW DEVICES SHOWN ON EXISTING WALLS SHALL BE INSTALLED RECESSED WHERE POSSIBLE. CUT AND PATCH EXISTING WALLS AS REQUIRED FOR INSTALLATION OF RECESSED DEVICES AND RACEWAYS. ONLY WHERE EXISTING WALLS ARE MASONRY AND NOT SUITABLE FOR CUTTING, DEVICES SHALL BE INSTALLED IN SURFACE RACEWAY PER SPECIFICATION REQUIREMENTS. VERIFY EXACT CONDITIONS AND REQUIREMENTS IN FIELD.



GIBRALTAR


DESIGN ARCHITECTURE • ENGINEERING • INTERIOR DESIGN



ROJECT DOUGLAS MACARTHUR

ES ADDITIONS

RENOVATIONS CROWN POINT COMMUNITY SCHOOL CORPORATION CROWN POINT, INDIANA

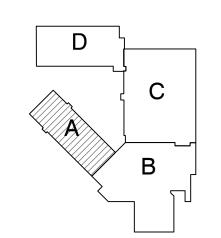

KEY PLAN

GIBRALTAR DESIGN

9102 N. Meridian St., Ste. 300 Indianapolis, IN 46260 Homepage www.GibraltarDesign.com Email info@GibraltarDesign.com Phone 317.580.5777 Fax 317.580.5778


COORDINATED DRAWN BY CHECKED BY


COPYRIGHT NOTICE: THE CONCEPTS, DESIGNS, PLANS, DETAILS, ETC, SHOWN ON THIS DOCUMENT ARE THE PROPERTY OF GIBRALTAR DESIGN AND WERE CREATED FOR USE ON THIS SPECIFIC PROJECT. NONE OF THIS INFORMATION SHALL BE USED BY ANY PERSON OR FIRM FOR ANY PURPOSE WITHOUT THE EXPRESS WRITTEN CONSENT OF GIBRALTAR DESIGN. THE OWNER MAY RETAIN COPIES FOR INFORMATION AND REFERENCE IN CONNECTION ONLY WITH THIS PROJECT.

MARK DATE ISSUED FOR AD-3 02/23/22 ADDENDUM NO. 3

UNIT "A" ELECTRICAL FIRST FLOOR POWER PLAN

DOUGLAS MACARTHUR ES ADDITIONS AND RENOVATIONS

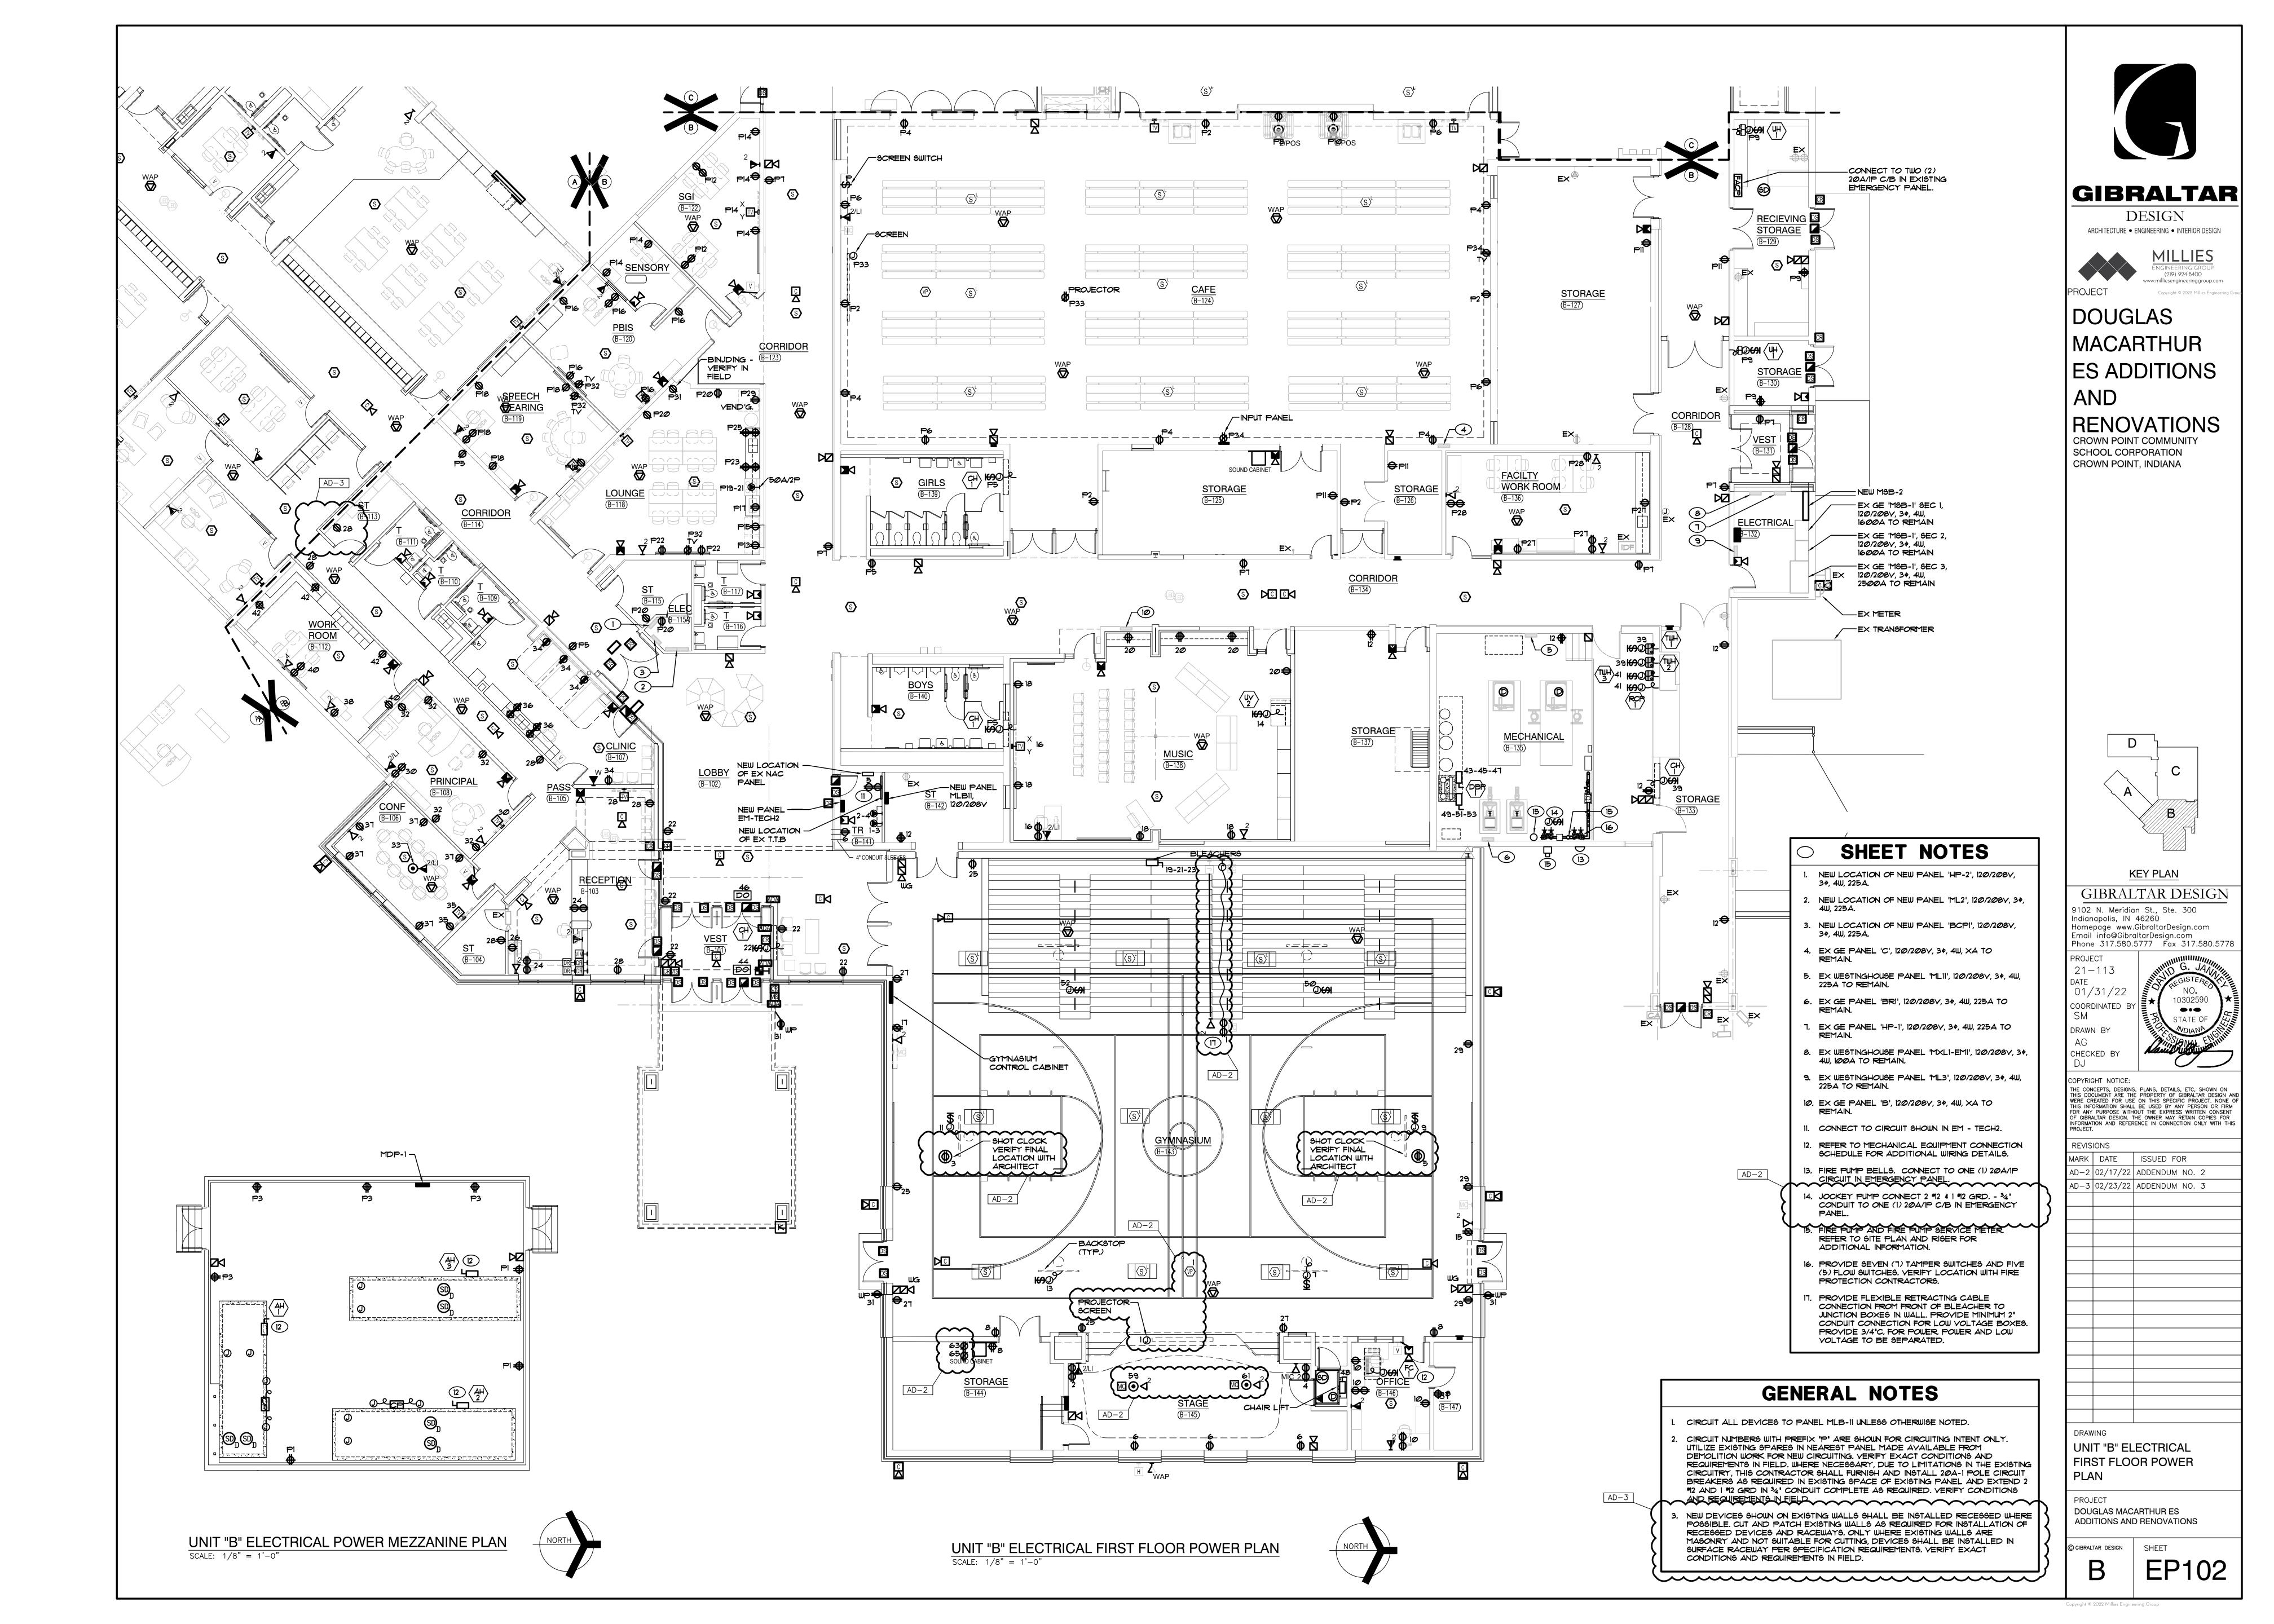

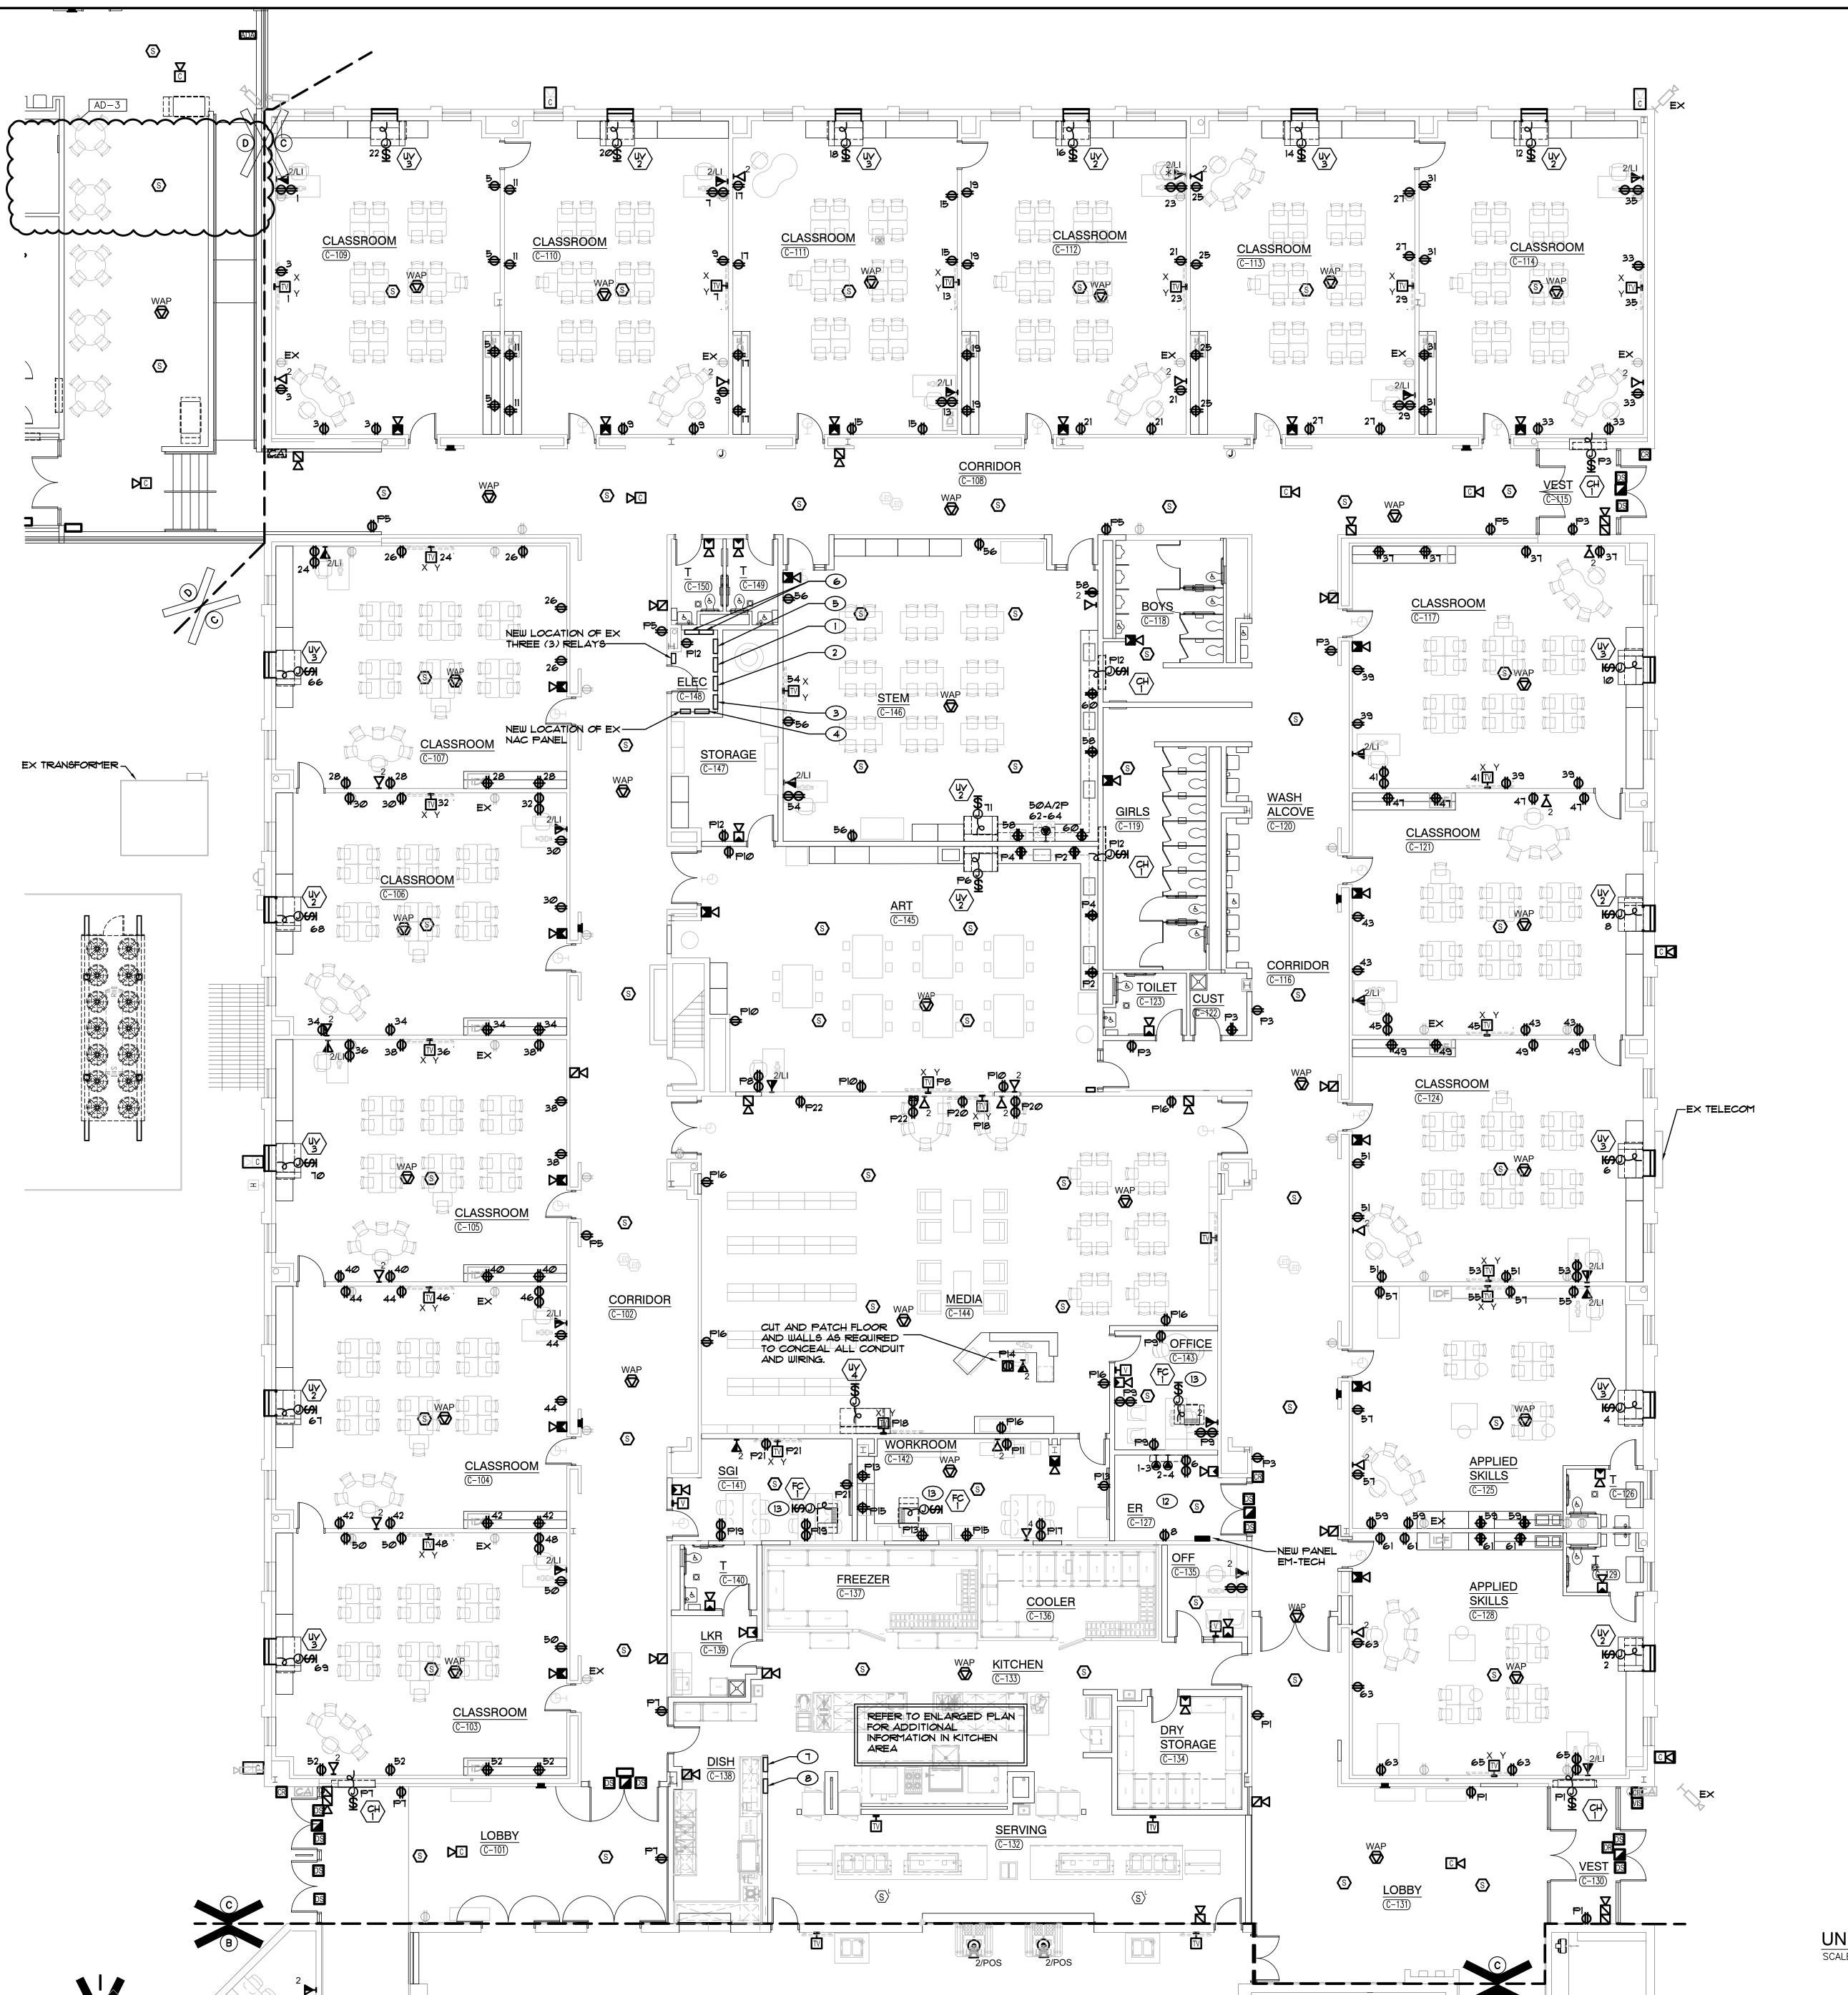

- NEW LOCATION OF NEW PANEL 'ML9', 120/2084, 34, 4W, 225A.
- NEW LOCATION OF NEW PANEL 'MLIØ', 120/208Y, 34, 4W, 225A.
- 3. NEW LOCATION OF NEW PANEL 'HP-3', 12*0/208*V, 3¢, 4W, 225A.

4. NEW LOCATION OF NEW PANEL 'CCP2', 120/208Y, 3¢, 4W, 225A.

- 5. NEW LOCATION OF EX WESTINGHOUSE 'ML8', 120/208V, 3¢, 4W, 225A.
- 6. NEW LOCATION OF EXIGE PANEL 'CCPI', 120/2087, 34, 4W, 225A.
- T. NEW PANEL KP-1.
- 8. NEW PANEL KP-2.
- 9. NOT USED. 10. NOT USED.
- 11. NOT USED.
- 12. CONNECT TO PANEL EM-TECH.
- REFER TO MECHANICAL EQUIPMENT CONNECTION SCHEDULE FOR ADDITIONAL WIRING DETAILS.

GENERAL NOTES

- CIRCUIT NUMBERS WITHOUT A PREFIX ARE SHOWN FOR CIRCUITING INTENT ONLY. UTILIZE EXISTING SPARES IN NEAREST PANEL MADE AVAILABLE FROM DEMOLITION WORK FOR NEW CIRCUITING. VERIFY EXACT CONDITIONS AND REQUIREMENTS IN FIELD. WHERE NECESSARY, DUE TO LIMITATIONS IN THE EXISTING CIRCUITRY, THIS CONTRACTOR SHALL FURNISH AND INSTALL 20A-1 POLE CIRCUIT BREAKERS AS REQUIRED IN EXISTING SPACE OF EXISTING PANEL AND EXTEND 2 #12 AND 1 #12 GRD IN 34" CONDUIT COMPLETE AS REQUIRED. VERIFY CONDITIONS AND REQUIREMENTS IN FIELD.
- CIRCUIT NUMBERS WITH PREFIX "P" ARE SHOWN FOR CIRCUITING INTENT ONLY. UTILIZE EXISTING SPARES IN NEAREST PANEL MADE AVAILABLE FROM DEMOLITION WORK FOR NEW CIRCUITING. VERIFY EXACT CONDITIONS AND REQUIREMENTS IN FIELD. WHERE NECESSARY, DUE TO LIMITATIONS IN THE EXISTING CIRCUITRY, THIS CONTRACTOR SHALL FURNISH AND INSTALL 20A-1 POLE CIRCUIT BREAKERS AS REQUIRED IN EXISTING SPACE OF EXISTING PANEL AND EXTEND 2 *12 AND 1 *12 GRD IN 34" CONDUIT COMPLETE AS REQUIRED. VERIFY CONDITIONS
- NEW DEVICES SHOWN ON EXISTING WALLS SHALL BE INSTALLED RECESSED WHERE POSSIBLE. CUT AND PATCH EXISTING WALLS AS REQUIRED FOR INSTALLATION OF RECESSED DEVICES AND RACEWAYS. ONLY WHERE EXISTING WALLS ARE MASONRY AND NOT SUITABLE FOR CUTTING, DEVICES SHALL BE INSTALLED IN SURFACE RACEWAY PER SPECIFICATION REQUIREMENTS. VERIFY EXACT CONDITIONS AND REQUIREMENTS IN FIELD.



GIBRALTAR


DESIGN ARCHITECTURE • ENGINEERING • INTERIOR DESIGN

(219) 924-8400 ROJECT

DOUGLAS MACARTHUR **ES ADDITIONS**

RENOVATIONS

CROWN POINT COMMUNITY SCHOOL CORPORATION CROWN POINT, INDIANA

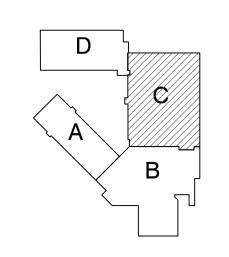

KEY PLAN

GIBRALTAR DESIGN 9102 N. Meridian St., Ste. 300 Indianapolis, IN 46260 Homepage www.GibraltarDesign.com Email info@GibraltarDesign.com Phone 317.580.5777 Fax 317.580.5778

COORDINATED

DRAWN B'

CHECKED BY

COPYRIGHT NOTICE: THE CONCEPTS, DESIGNS, PLANS, DETAILS, ETC, SHOWN ON THIS DOCUMENT ARE THE PROPERTY OF GIBRALTAR DESIGN AND WERE CREATED FOR USE ON THIS SPECIFIC PROJECT. NONE OF THIS INFORMATION SHALL BE USED BY ANY PERSON OR FIRM FOR ANY PURPOSE WITHOUT THE EXPRESS WRITTEN CONSENT OF GIBRALTAR DESIGN. THE OWNER MAY RETAIN COPIES FOR INFORMATION AND REFERENCE IN CONNECTION ONLY WITH THIS PROJECT.

MARK DATE ISSUED FOR AD-3 02/23/22 ADDENDUM NO. 3

UNIT "C" ELECTRICAL FIRST FLOOR POWER PLAN

DOUGLAS MACARTHUR ES ADDITIONS AND RENOVATIONS

GIBRALTAR DESIGN SHEET

EP103

UNIT "C" ELECTRICAL FIRST FLOOR POWER PLAN SCALE: 1/8" = 1'-0"

GENERAL NOTES

- CIRCUIT ALL DEVICES TO PANEL MLB-14 UNLESS OTHERWISE NOTED.
- CIRCUIT ALL DEVICES WITH CIRCUIT PREFIX "P" TO PANEL MLB-13 UNLESS
- NEW DEVICES SHOWN ON EXISTING WALLS SHALL BE INSTALLED RECESSED WHERE POSSIBLE. CUT AND PATCH EXISTING WALLS AS REQUIRED FOR INSTALLATION OF RECESSED DEVICES AND RACEWAYS. ONLY WHERE EXISTING WALLS ARE MASONRY AND NOT SUITABLE FOR CUTTING, DEVICES SHALL BE INSTALLED IN SURFACE RACEWAY PER SPECIFICATION REQUIREMENTS. VERIFY EXACT CONDITIONS AND REQUIREMENTS IN FIELD.

DESIGN ARCHITECTURE • ENGINEERING • INTERIOR DESIGN




GIBRALTAR

DOUGLAS MACARTHUR ES ADDITIONS AND

RENOVATIONS CROWN POINT COMMUNITY

SCHOOL CORPORATION CROWN POINT, INDIANA

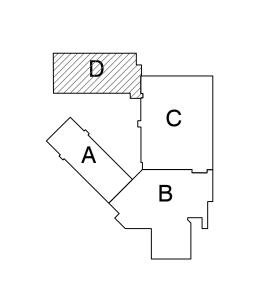

KEY PLAN GIBRALTAR DESIGN

9102 N. Meridian St., Ste. 300 Indianapolis, IN 46260
Homepage www.GibraltarDesign.com
Email info@GibraltarDesign.com
Phone 317.580.5777 Fax 317.580.5778

21-113 COORDINATED DRAWN BY

10302590 ••• CHECKED BY


COPYRIGHT NOTICE: THE CONCEPTS, DESIGNS, PLANS, DETAILS, ETC, SHOWN ON THIS DOCUMENT ARE THE PROPERTY OF GIBRALTAR DESIGN AND WERE CREATED FOR USE ON THIS SPECIFIC PROJECT. NONE OF THIS INFORMATION SHALL BE USED BY ANY PERSON OR FIRM FOR ANY PURPOSE WITHOUT THE EXPRESS WRITTEN CONSENT OF GIBRALTAR DESIGN. THE OWNER MAY RETAIN COPIES FOR INFORMATION AND REFERENCE IN CONNECTION ONLY WITH THIS PROJECT.


MARK DATE ISSUED FOR AD-3 02/23/22 ADDENDUM NO. 3

UNIT "D" ELECTRICAL FIRST FLOOR POWER PLAN

DOUGLAS MACARTHUR ES ADDITIONS AND RENOVATIONS

GIBRALTAR DESIGN SHEET

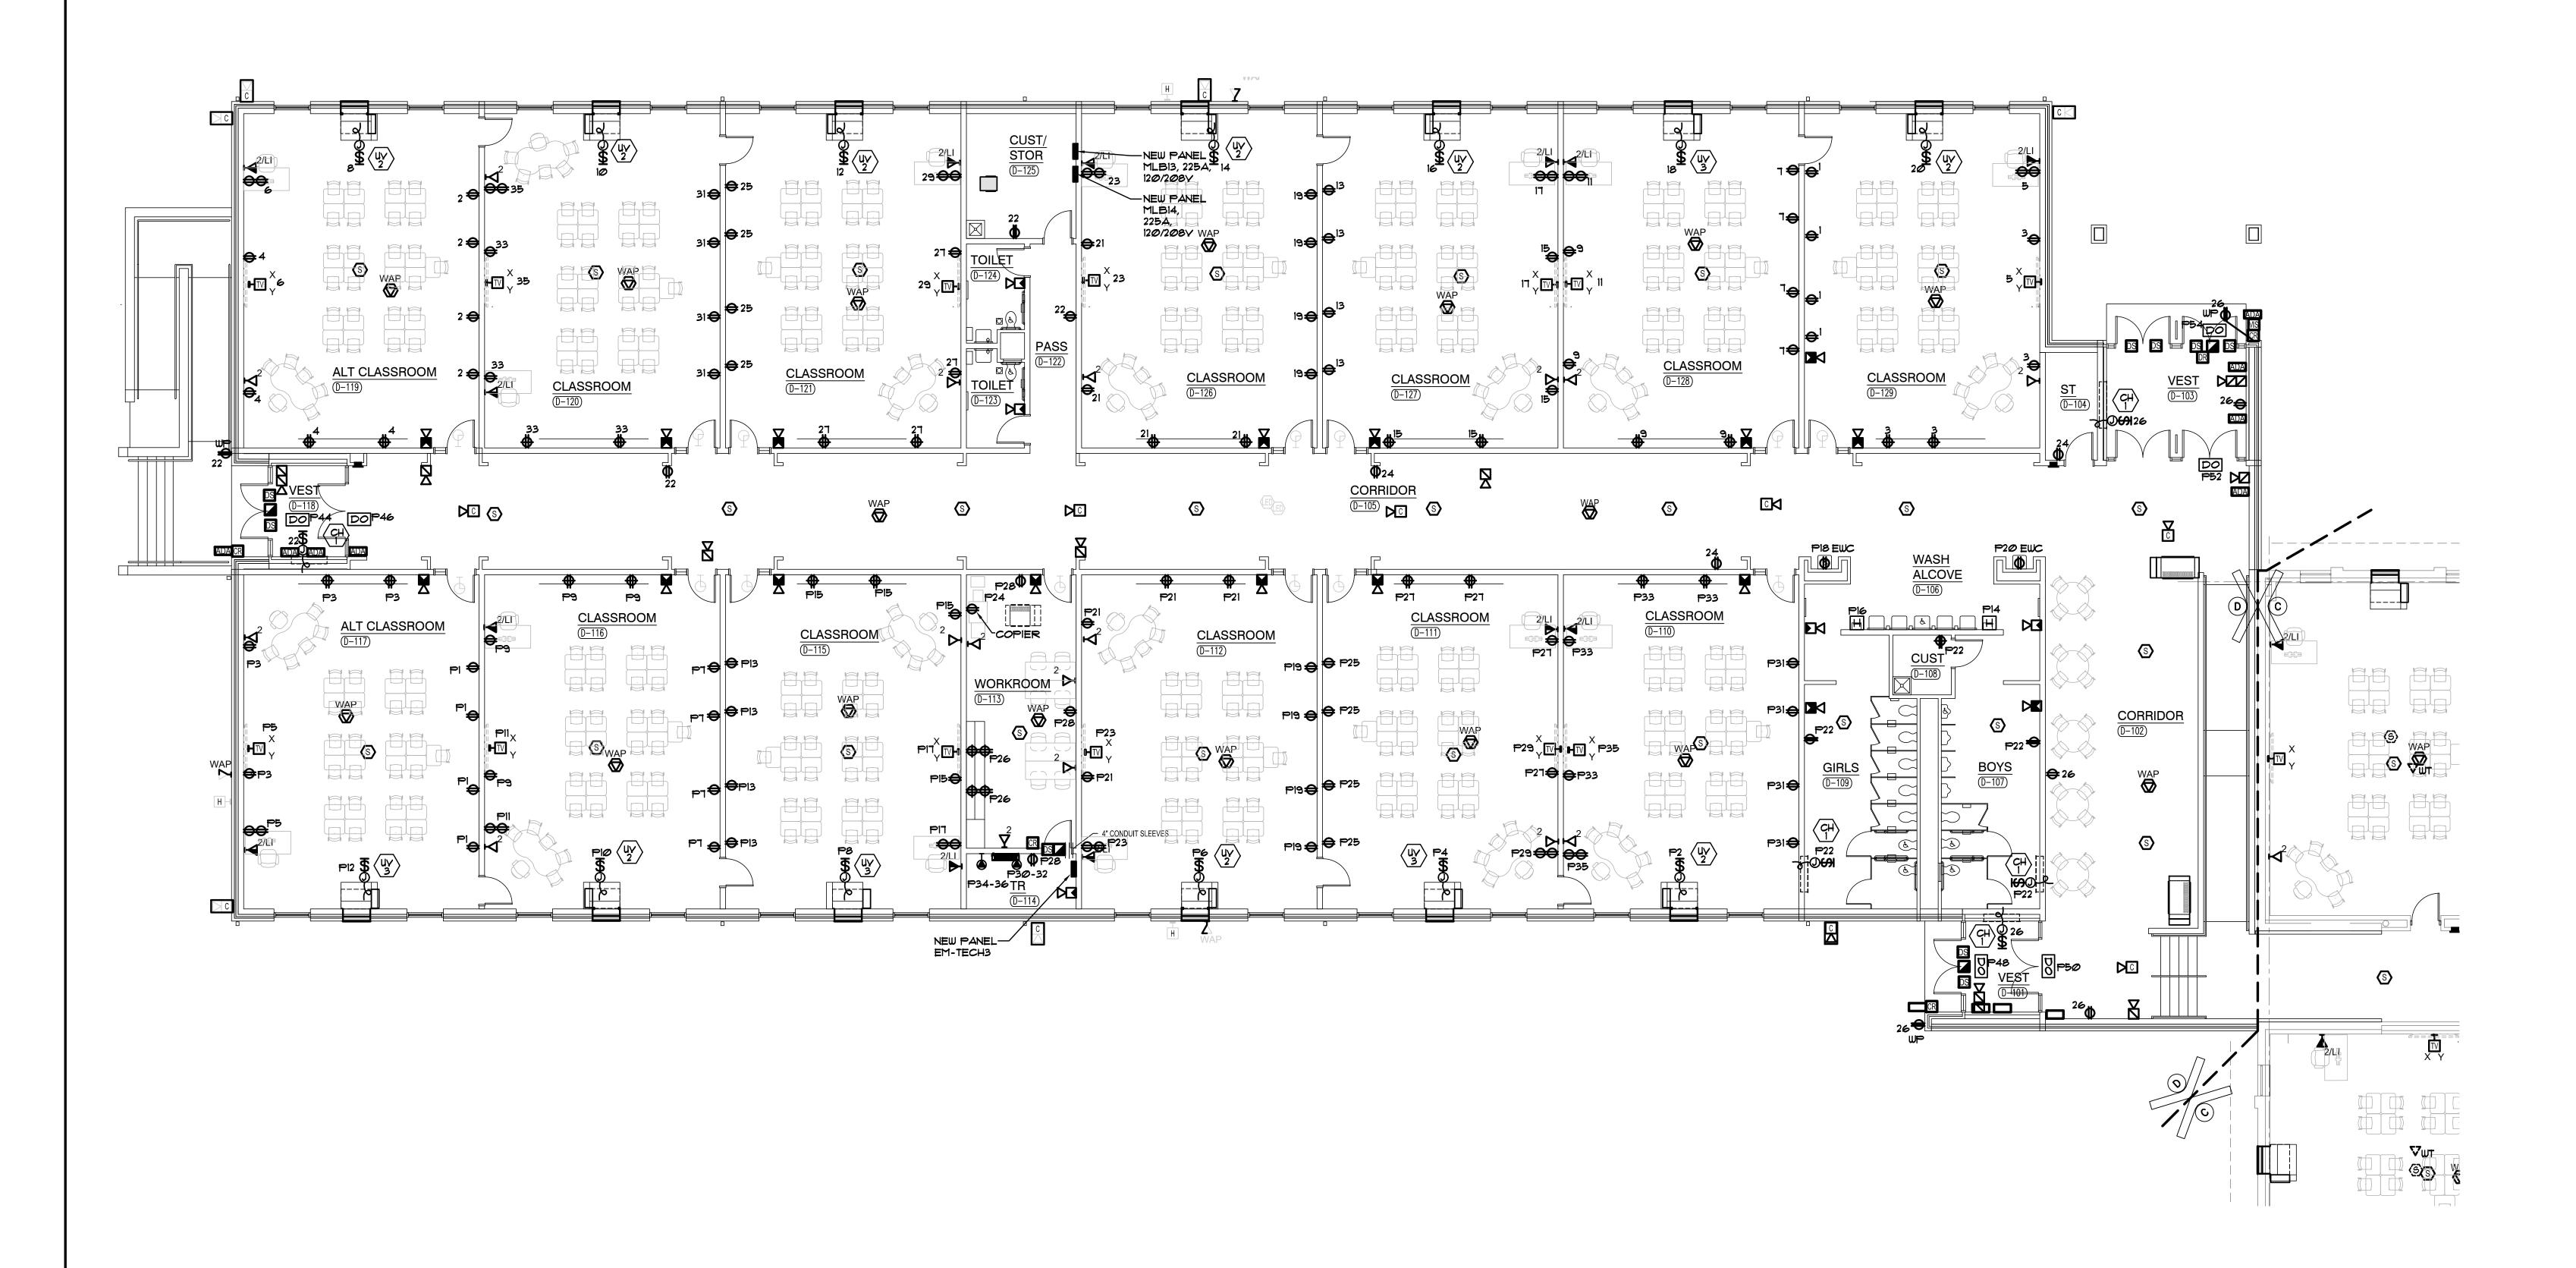


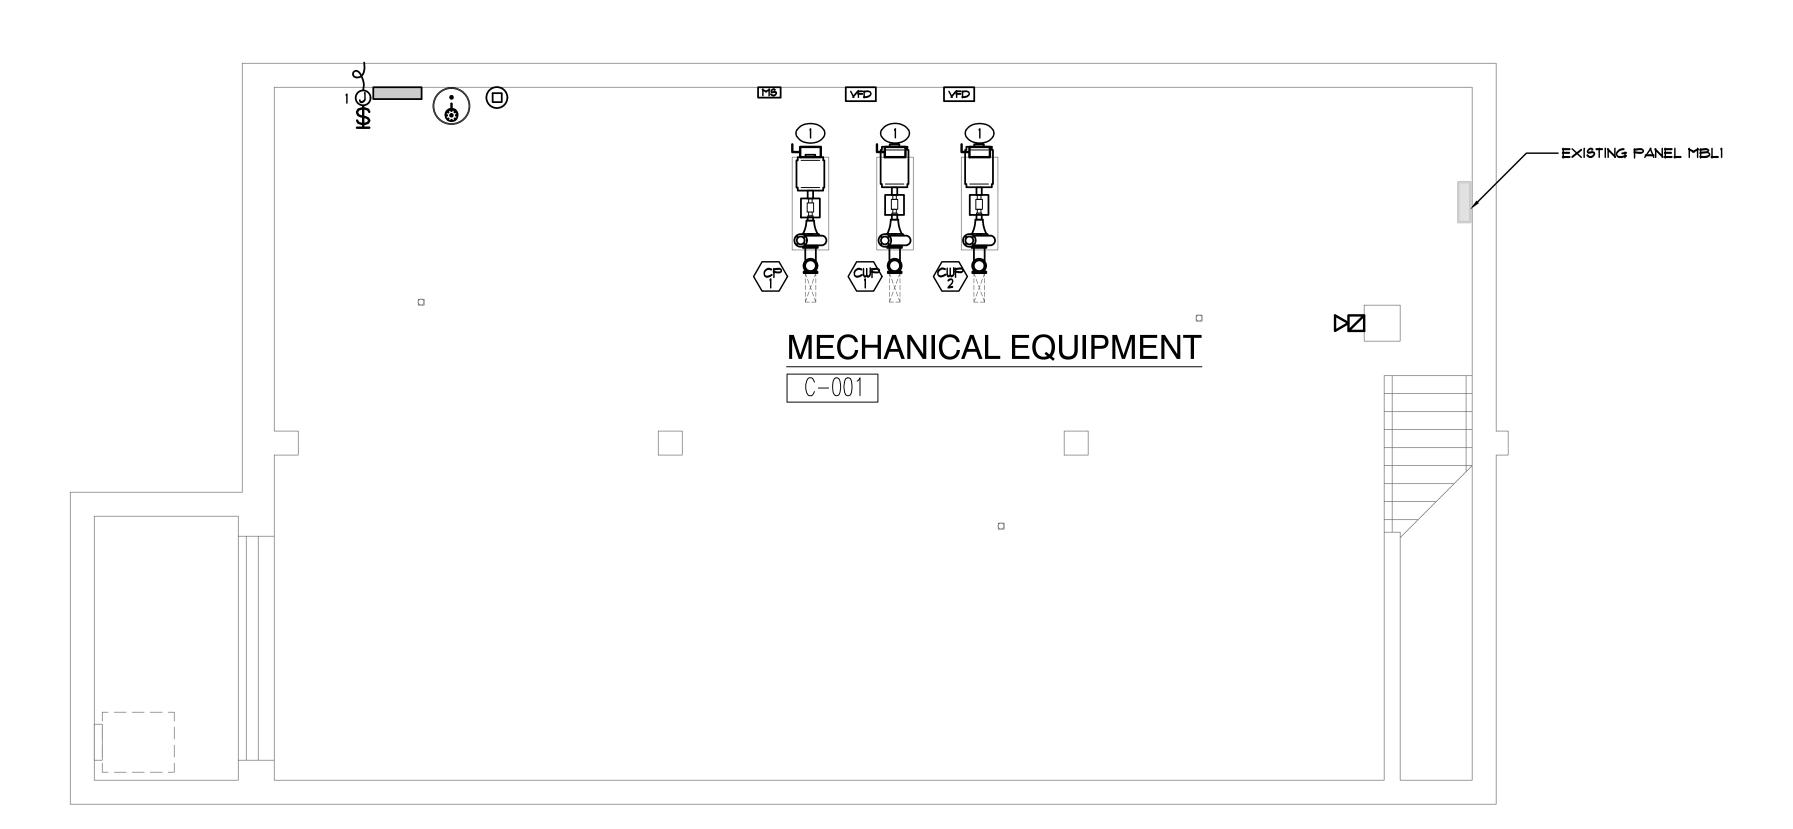

BASEMENT CHILLER ROOM

ELECTRICAL LOWER LEVEL POWER PLAN

SCALE: 1/4" = 1'-0"

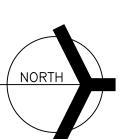

SHEET NOTES

1. REFER TO MECHANICAL EQUIPMENT CONNECTION FOR ADDITIONAL CIRCUITING AND WIRING INFORMATION.

GENERAL NOTES

1. CIRCUIT NUMBERS WITHOUT A PREFIX ARE SHOWN FOR CIRCUITING INTENT ONLY. UTILIZE EXISTING SPARES IN NEAREST PANEL MADE AVAILABLE FROM DEMOLITION WORK FOR NEW CIRCUITING. VERIFY EXACT CONDITIONS AND REQUIREMENTS IN FIELD. WHERE NECESSARY, DUE TO LIMITATIONS IN THE EXISTING CIRCUITRY, THIS CONTRACTOR SHALL FURNISH AND INSTALL 20A-1 POLE CIRCUIT BREAKERS AS REQUIRED IN EXISTING SPACE OF EXISTING PANEL AND EXTEND 2 #12 AND 1 #12 GRD IN 34" CONDUIT COMPLETE AS REQUIRED. VERIFY CONDITIONS

AND REQUIREMENTS IN FIELD

2. NEW DEVICES SHOWN ON EXISTING WALLS SHALL BE INSTALLED RECESSED WHERE POSSIBLE. CUT AND PATCH EXISTING WALLS AS REQUIRED FOR INSTALLATION OF RECESSED DEVICES AND RACEWAYS. ONLY WHERE EXISTING WALLS ARE MASONRY AND NOT SUITABLE FOR CUTTING, DEVICES SHALL BE INSTALLED IN SURFACE RACEWAY PER SPECIFICATION REQUIREMENTS. VERIFY EXACT CONDITIONS AND REQUIREMENTS IN FIELD.

AD-3




DESIGN
ARCHITECTURE • ENGINEERING • INTERIOR DESIGN



DOUGLAS
MACARTHUR
ES ADDITIONS

RENOVATIONS

CROWN POINT COMMUNITY
SCHOOL CORPORATION
CROWN POINT, INDIANA

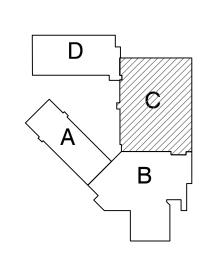

KEY PLAN

GIBRALTAR DESIGN

9102 N. Meridian St., Ste. 300 Indianapolis, IN 46260 Homepage www.GibraltarDesign.com Email info@GibraltarDesign.com Phone 317.580.5777 Fax 317.580.5778

Phone 317.580.5777


PROJECT
21-113

DATE
01/31/22

COORDINATED BY
SM

DRAWN BY

CHECKED BY

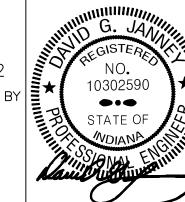

COPYRIGHT NOTICE:

THE CONCEPTS, DESIGNS, PLANS, DETAILS, ETC, SHOWN ON THIS DOCUMENT ARE THE PROPERTY OF GIBRALTAR DESIGN AND WERE CREATED FOR USE ON THIS SPECIFIC PROJECT. NONE OF THIS INFORMATION SHALL BE USED BY ANY PERSON OR FIRM FOR ANY PURPOSE WITHOUT THE EXPRESS WRITTEN CONSENT OF GIBRALTAR DESIGN. THE OWNER MAY RETAIN COPIES FOR INFORMATION AND REFERENCE IN CONNECTION ONLY WITH THIS PROJECT.

REVIS	IONS	
MARK	DATE	ISSUED FOR
AD-3	02/23/22	ADDENDUM NO. 3

DRAWING

BASEMENT CHILLER ROOM ELECTRICAL LOWER LEVEL POWER PLAN


PROJECT

DOUGLAS MACARTHUR ES

ADDITIONS AND RENOVATIONS

© GIBRALTAR DESIGN SHEET

Copyright © 2022 Millies Engineering Group

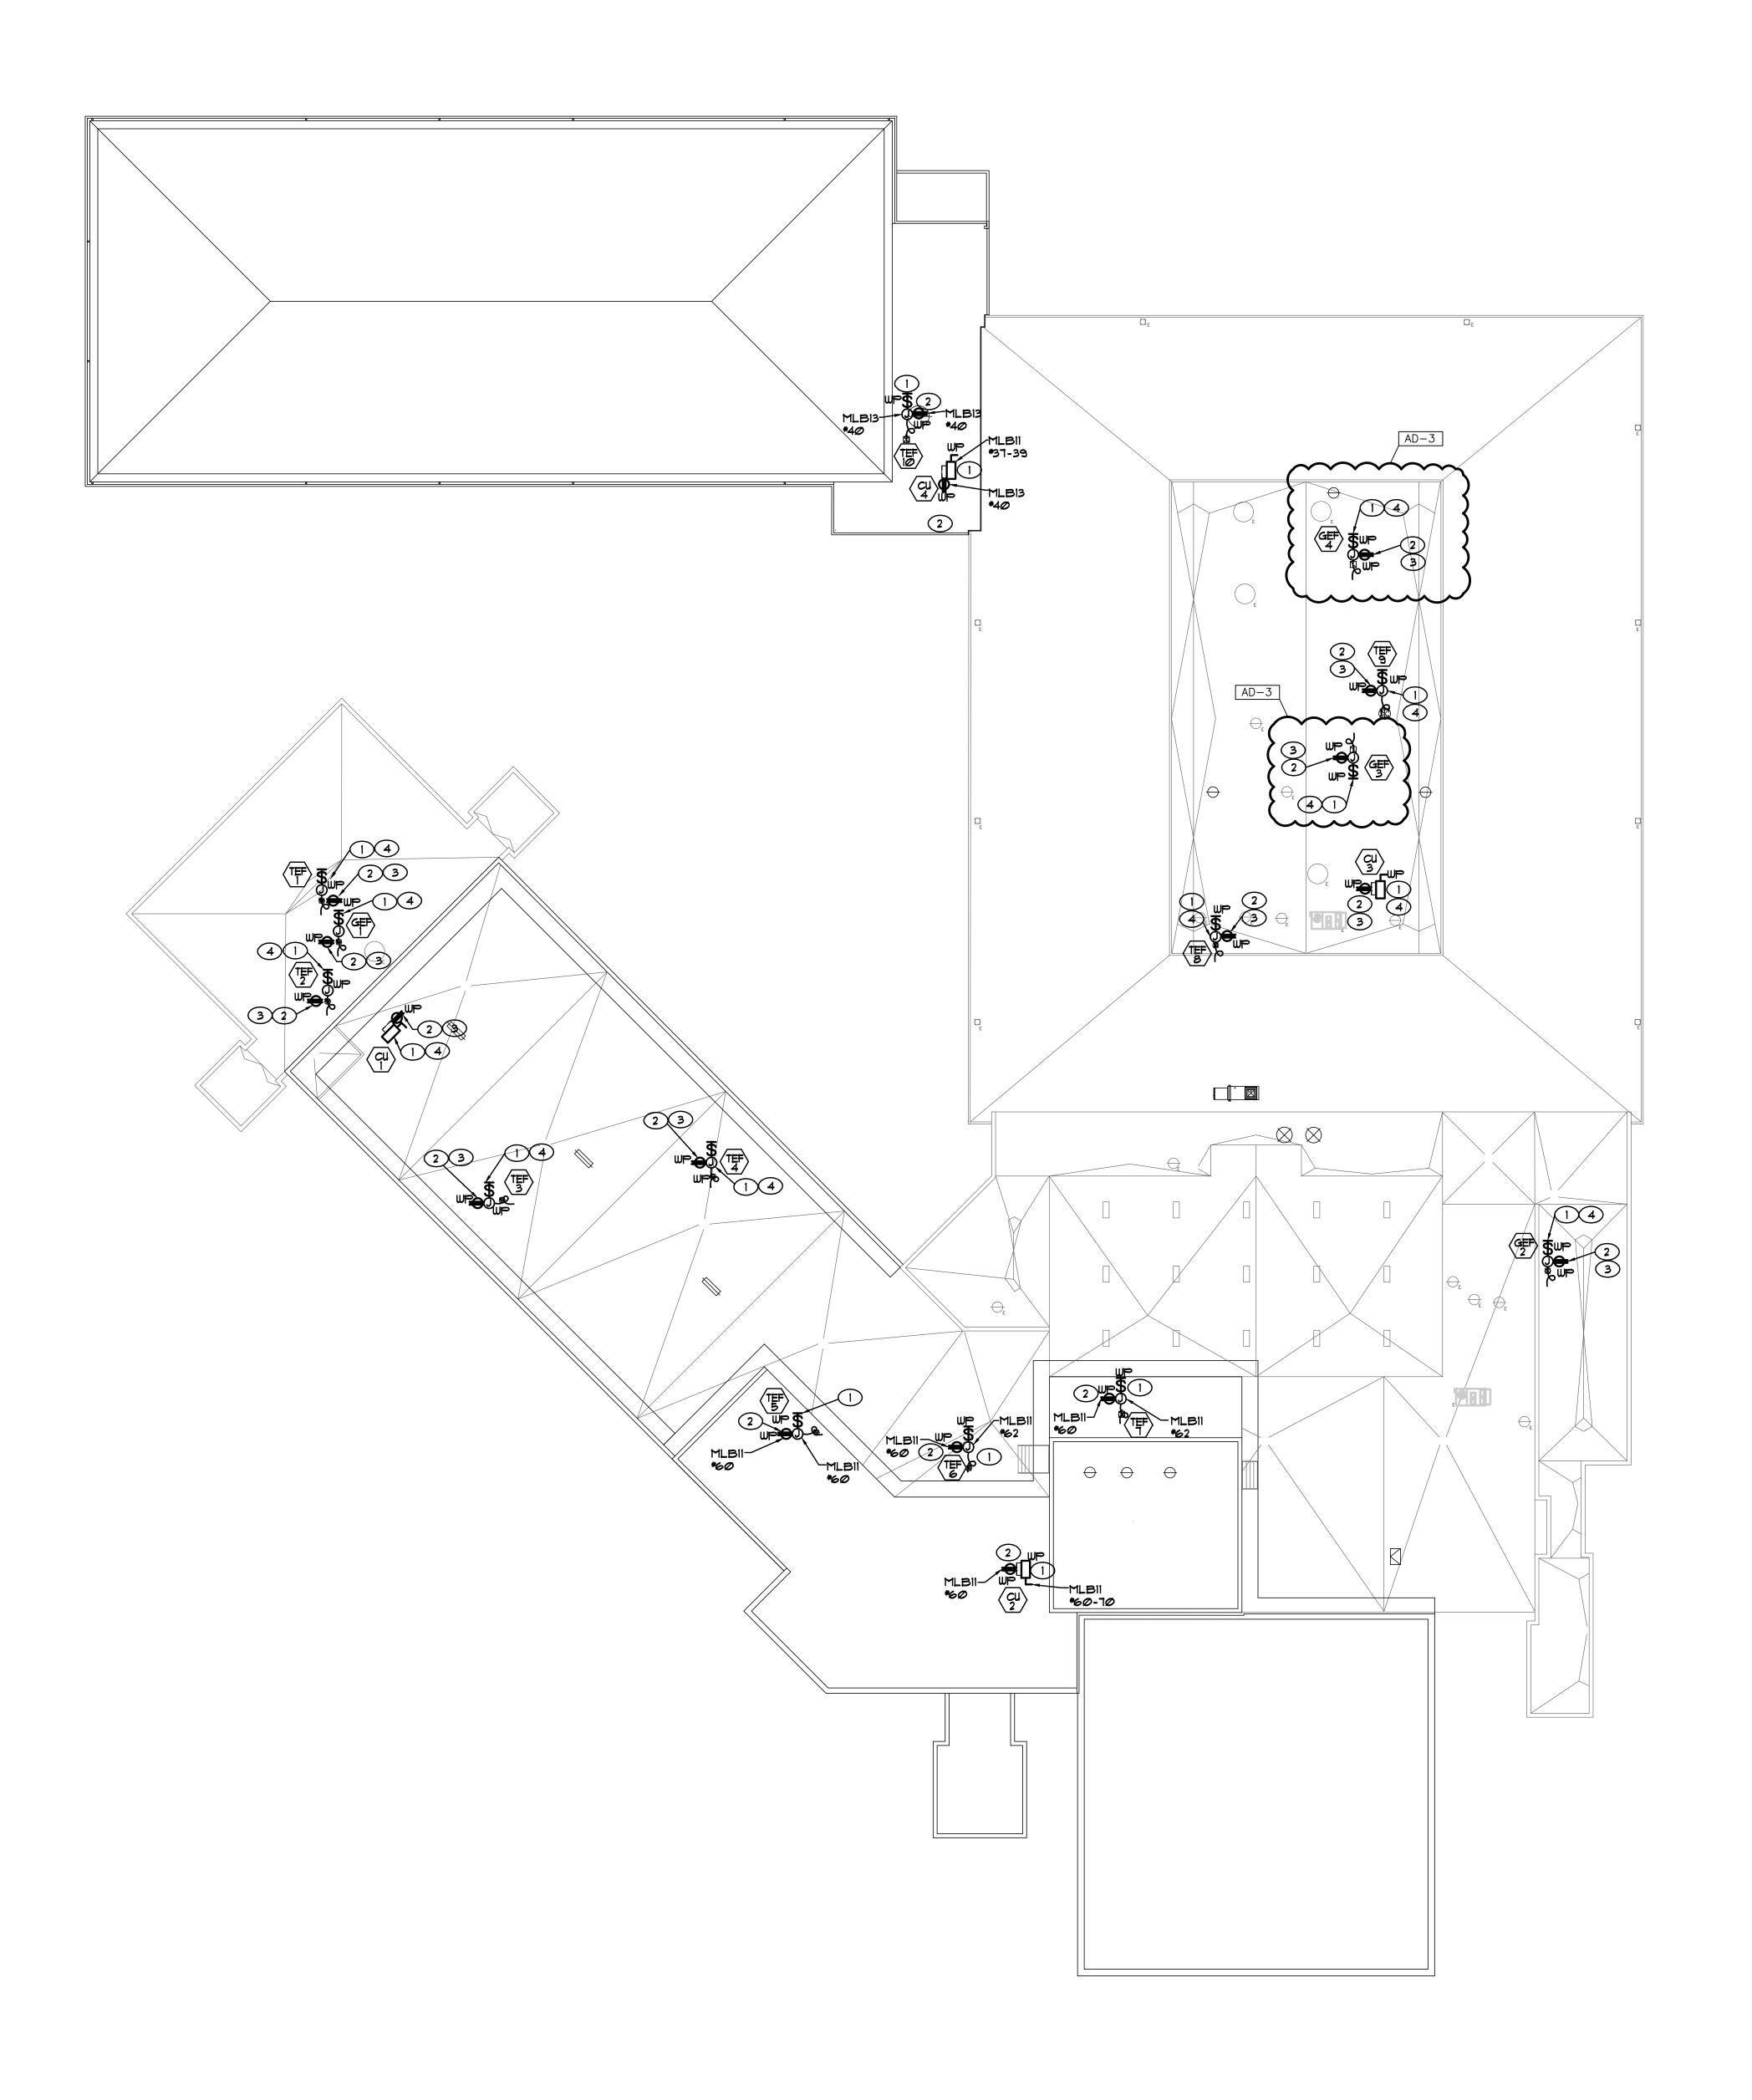

ELECTRICAL POWER ROOF PLAN

SCALE: 1" = 20'-0"



SHEET NOTES

- REFER TO MECHANICAL EQUIPMENT CONNECTION FOR ADDITIONAL CIRCUITING AND WIRING INFORMATION.
- LOCATE WEATHERPROOF GFI TYPE RECEPTACLE ON UNIT IN AN APPROVED
- 3. CONNECT RECEPTACLE TO NEAREST 120V GENERAL RECEPTACLE CIRCUIT WITH AVAILABLE CAPACITY (MAXIMUM 1400W PER 120V CIRCUIT). UTILIZE EXISTING CAPACITY MADE AVAILABLE BY DEMOLITION. VERIFY CONDITIONS AND REQUIREMENTS IN FIELD, COMPLETE AS REQUIRED.
- 4. CONNECT EQUIPMENT TO NEAREST EXISTING 120/208Y PANELS WITH AVAILABLE SPACE AND CAPACITY. UTILIZE EXISTING CAPACITY MADE AVAILABLE BY DEMOLITION. VERIFY CONDITIONS AND REQUIREMENTS IN FIELD, COMPLETE AS REQUIRED.



GIBRALTAR DESIGN


ARCHITECTURE • ENGINEERING • INTERIOR DESIGN



PROJECT DOUGLAS

MACARTHUR ES ADDITIONS

RENOVATIONS CROWN POINT COMMUNITY SCHOOL CORPORATION CROWN POINT, INDIANA

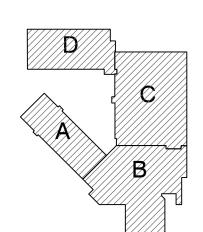

KEY PLAN

GIBRALTAR DESIGN

9102 N. Meridian St., Ste. 300 Indianapolis, IN 46260 Homepage www.GibraltarDesign.com Email info@GibraltarDesign.com Phone 317.580.5777 Fax 317.580.5778

coordinated e SM DRAWN BY

CHECKED BY

COPYRIGHT NOTICE: THE CONCEPTS, DESIGNS, PLANS, DETAILS, ETC, SHOWN ON THIS DOCUMENT ARE THE PROPERTY OF GIBRALTAR DESIGN AND WERE CREATED FOR USE ON THIS SPECIFIC PROJECT. NONE OF THIS INFORMATION SHALL BE USED BY ANY PERSON OR FIRM FOR ANY PURPOSE WITHOUT THE EXPRESS WRITTEN CONSENT OF GIBRALTAR DESIGN. THE OWNER MAY RETAIN COPIES FOR INFORMATION AND REFERENCE IN CONNECTION ONLY WITH THIS PROJECT.


MARK DATE ISSUED FOR AD-3 02/23/22 ADDENDUM NO. 3


ELECTRICAL POWER ROOF PLAN


DOUGLAS MACARTHUR ES ADDITIONS AND RENOVATIONS


Copyright © 2022 Millies Engineering Group


© GIBRALTAR DESIGN SHEET

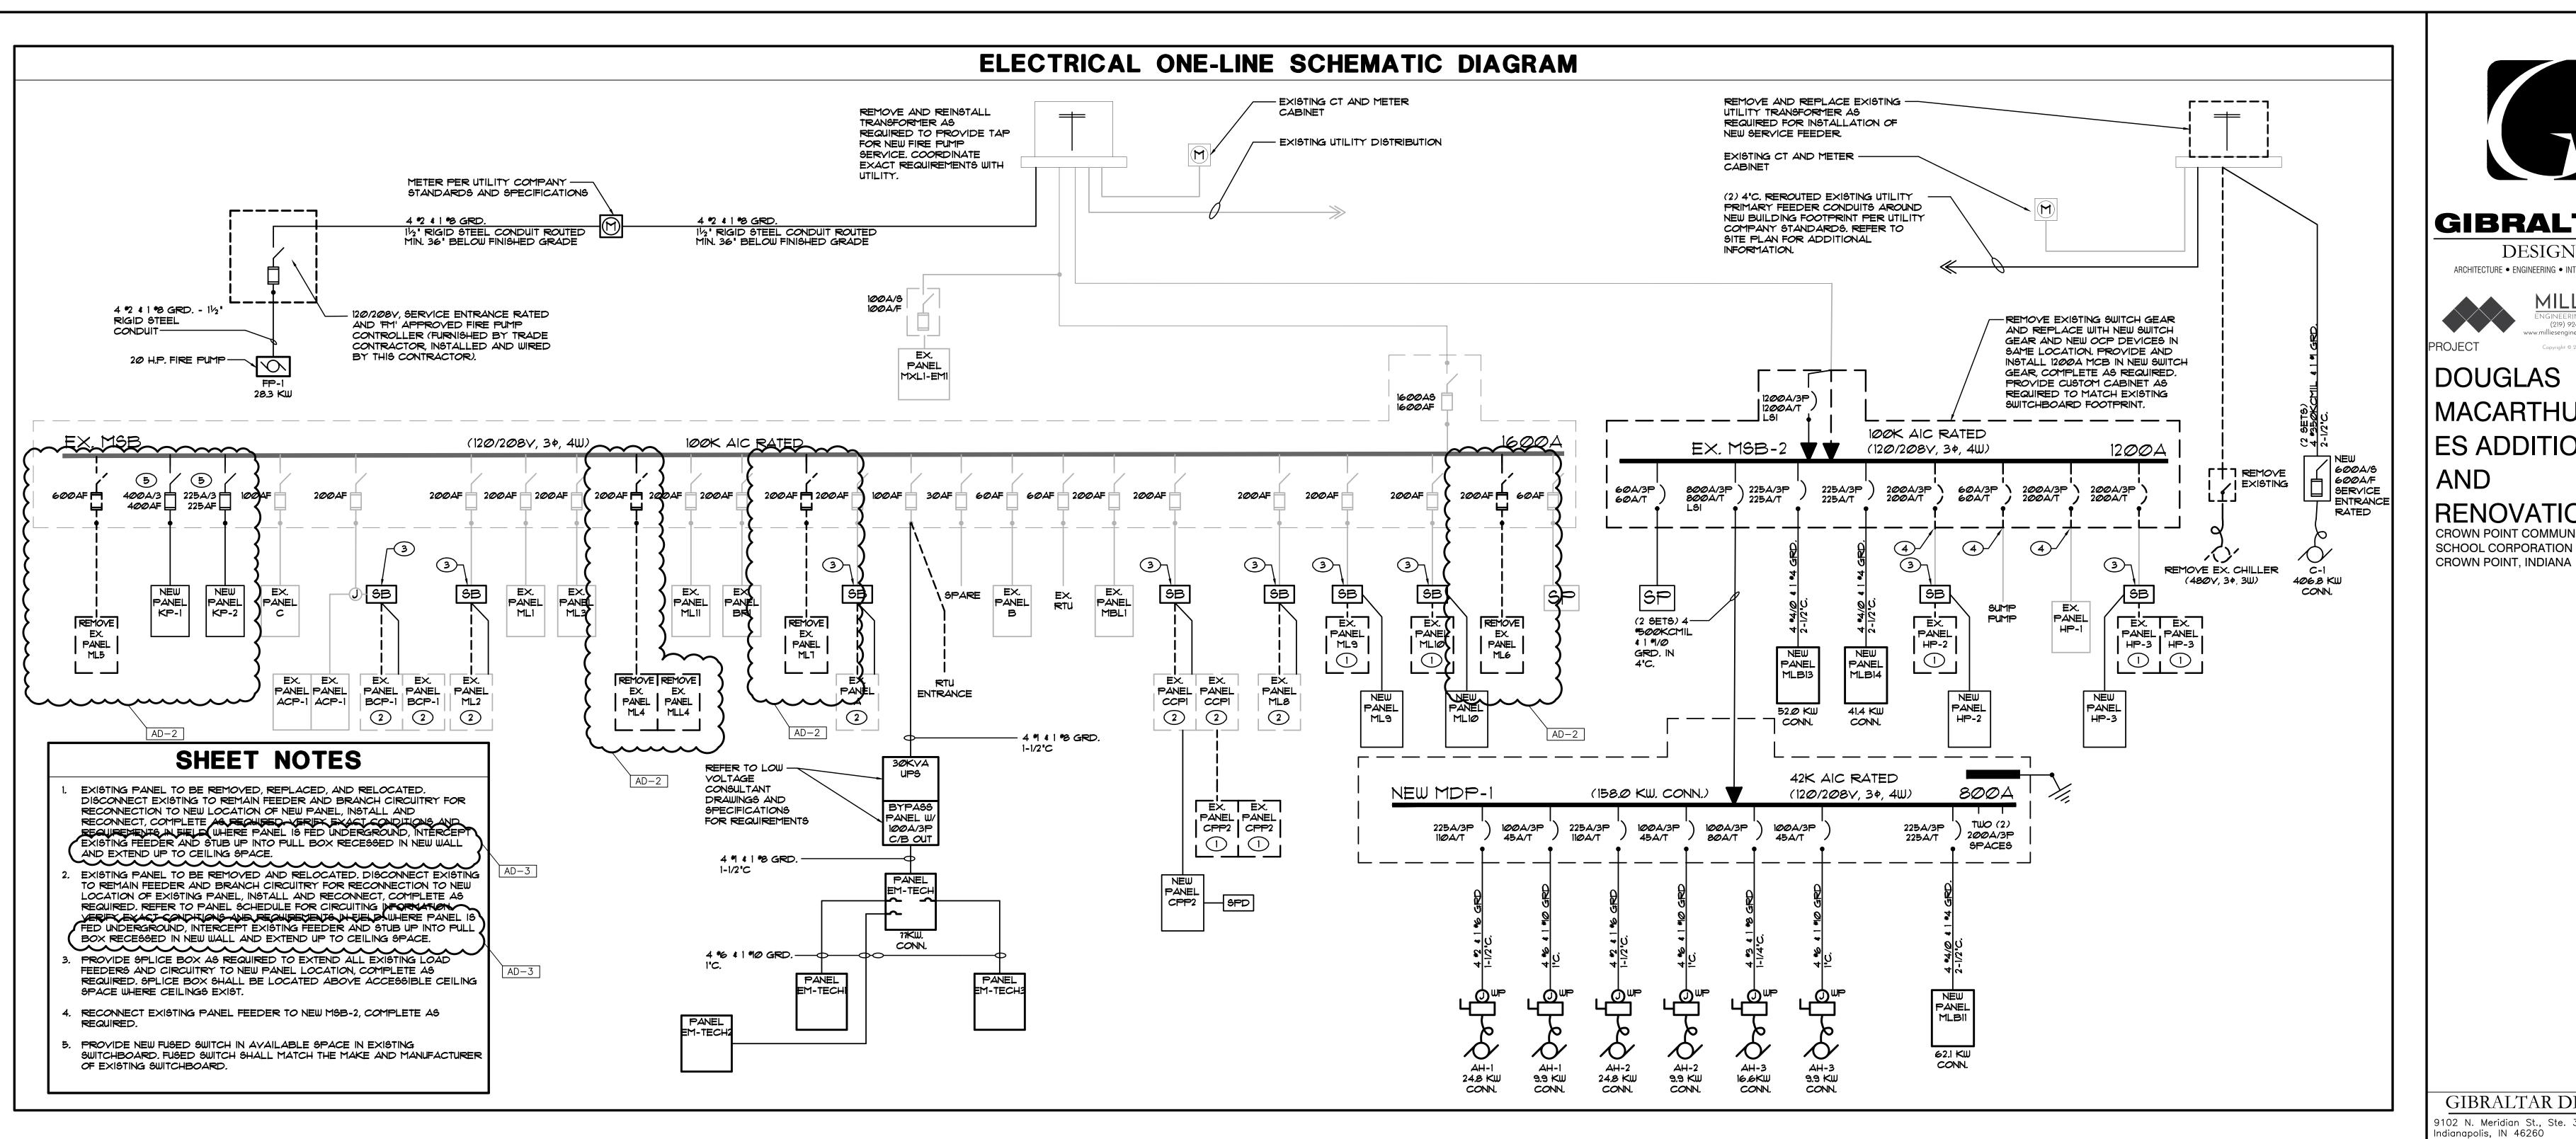


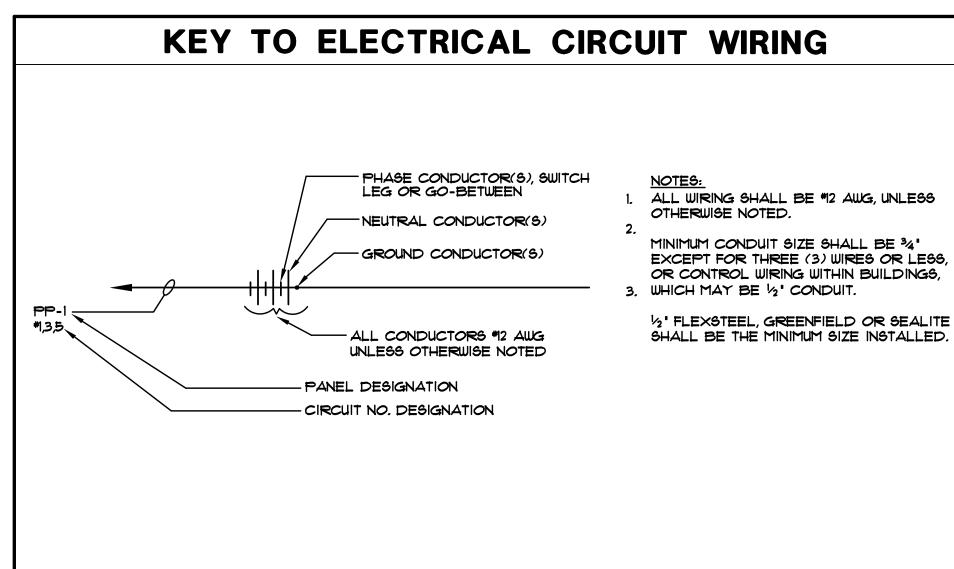


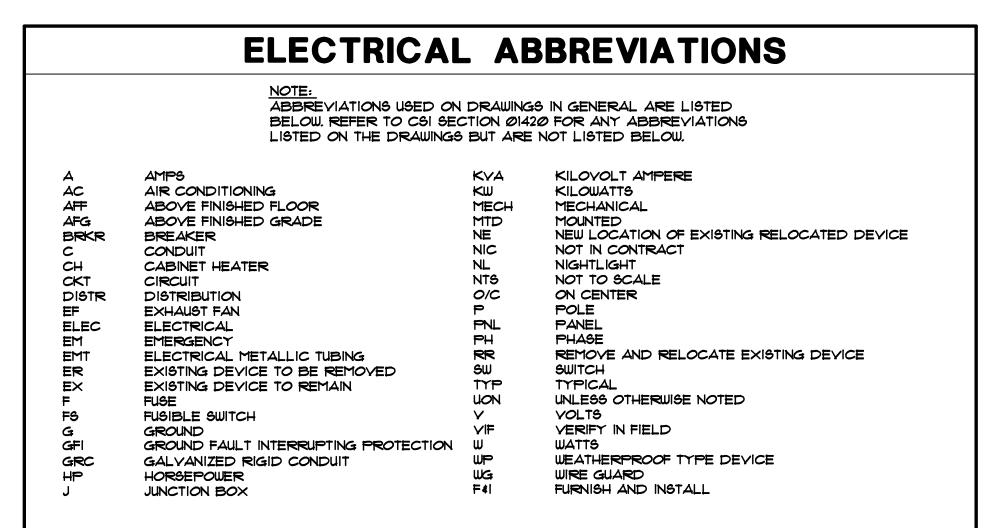

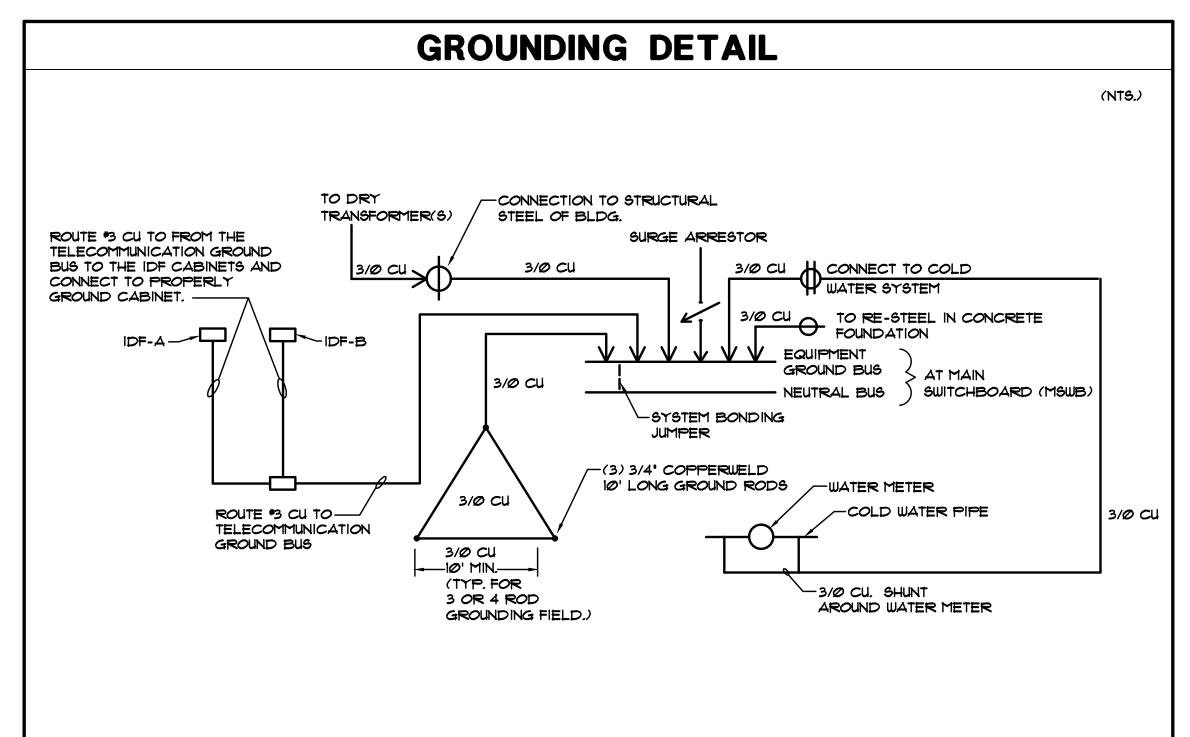

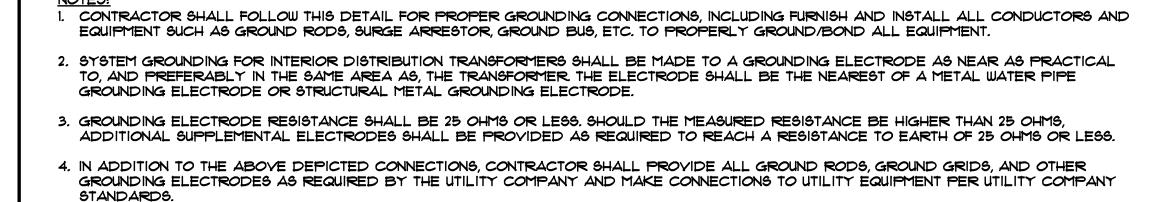

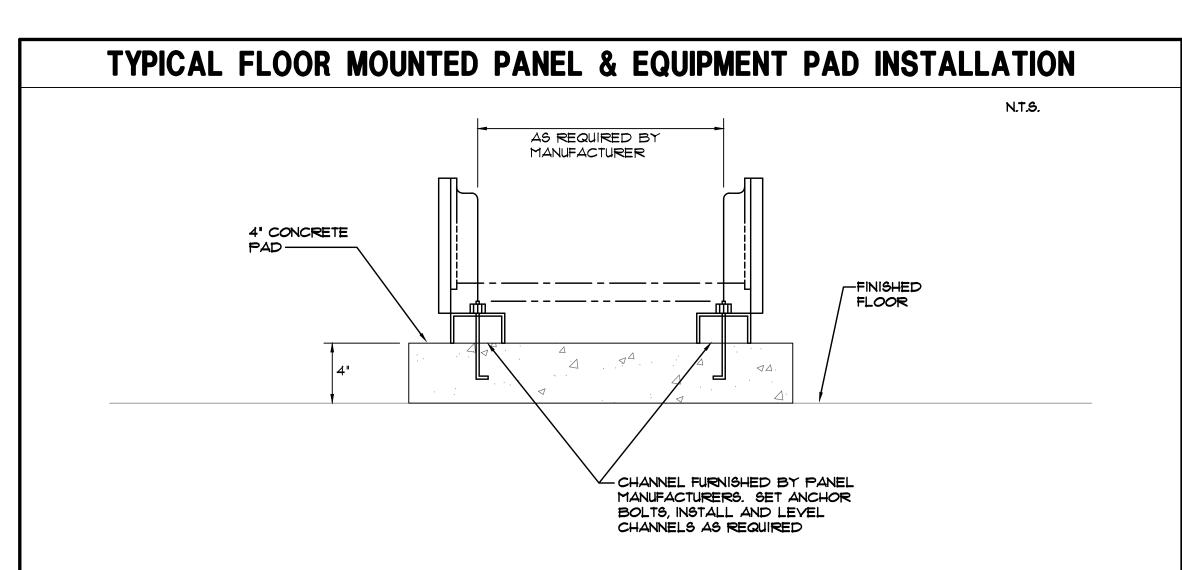

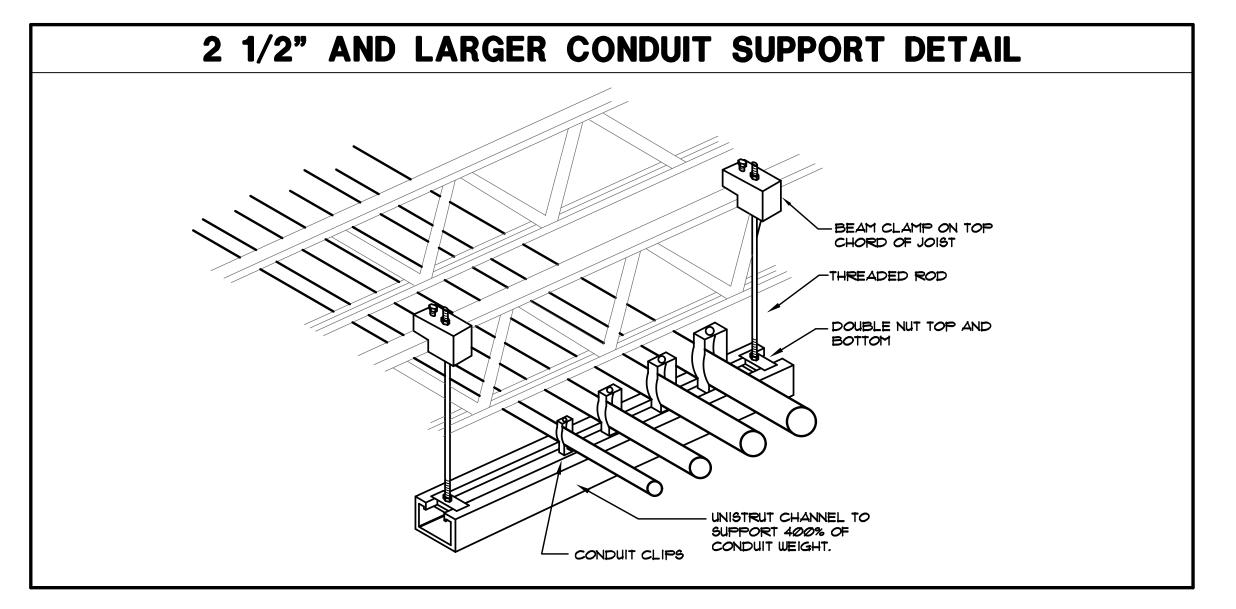



GIBRALTAR DESIGN

ARCHITECTURE • ENGINEERING • INTERIOR DESIGN




DOUGLAS MACARTHUR **ES ADDITIONS**

RENOVATIONS **CROWN POINT COMMUNITY**

GIBRALTAR DESIGN 9102 N. Meridian St., Ste. 300 ndianapolis, IN 46260 Homepage www.GibraltarDesign.com Email info@GibraltarDesign.com

Phone 317.580.5777 Fax 317.580.577 01/31/22 COORDINATED

DRAWN BY

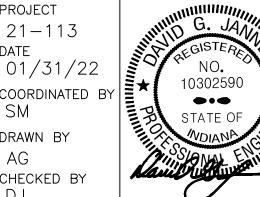

THE CONCEPTS, DESIGNS, PLANS, DETAILS, ETC, SHOWN ON THIS DOCUMENT ARE THE PROPERTY OF GIBRALTAR DESIGN AND WERE CREATED FOR USE ON THIS SPECIFIC PROJECT. NONE OF THIS INFORMATION SHALL BE USED BY ANY PERSON OR FIRM FOR ANY PURPOSE WITHOUT THE EXPRESS WRITTEN CONSENT OF GIBRALTAR DESIGN. THE OWNER MAY RETAIN COPIES FOR INFORMATION AND REFERENCE IN CONNECTION ONLY WITH THIS PROJECT.

REVIS	IONS	
MARK	DATE	ISSUED FOR
AD-2	02/17/22	ADDENDUM NO. 2
AD-3	02/23/22	ADDENDUM NO. 3

DRAWING ELECTRICAL DETAILS & **DIAGRAMS**

DOUGLAS MACARTHUR ES ADDITIONS AND RENOVATIONS

© GIBRALTAR DESIGN SHEET

Copyright © 2022 Millies Engineering Group

E-501

FIXTURE GENERAL NOTES

- INTERIOR FIXTURES, EXTERIOR FIXTURES AND POLE FINISHES AND COLORS TO BE SELECTED BY ARCHITECT. THE ARCHITECT MAY, AT THEIR DISCRETION, CHOOSE A CUSTOM COLOR AT NO ADDITIONAL CHARGE.
- PENDANT FIXTURES SPECIFIED ON THIS PROJECT SHALL BE CAREFULLY COORDINATED WITH CONTRACT DOCUMENTS AND FIXTURE MANUFACTURER AS EACH PENDANT FIXTURE IS A CUSTOM MANUFACTURED FIXTURE. PROVIDE PENDANT EMERGENCY SECTIONS AND EMERGENCY CIRCUITS AS SHOWN. COORDINATE WITH FIXTURE MANUFACTURER AND PROVIDE ADDITIONAL ACCESSORIES FOR A COMPLETE AND PROPER INSTALLATION. PROVIDE PROPER FIXTURE LENGTH, FEEDS, SINGLE AND DUAL CIRCUITING AND SUSPENSION LENGTH AS SHOWN ON DRAWINGS. PROVIDE FABRICATION DRAWINGS FOR REVIEW AS PART OF THE SHOP DRAWING SUBMITTAL PROCESS.
- 3. LED FIXTURES (LESS THAN 10000 LUMENS) SHALL BE PROVIDED WITH FACTORY INSTALLED INTEGRAL EMERGENCY BATTERY UNITS BATTERY UNITS SHALL PROVIDE A MINIMUM OF 1400 LUMENS.
- GREATER THAN 10000 LUMENS SHALL BE PROVIDED WITH EMERGENCY INVERTER (MYERS *LV SERIES OR APPROVED EQUAL) WITH SUITABLE CAPACITY TO POWER FIXTURE FOR A MINIMUM OF 90 MINUTES PER CODE. VERIFY SIZING AND REQUIREMENTS WITH CONTRACT DOCUMENTS PRIOR TO ORDERING.

FIXTURES THAT CANNOT BE PROVIDED WITH EMERGENCY BALLASTS OR FIXTURES WITH


- 5. SHADED FIXTURES SHALL HAVE AN EMERGENCY SOURCE OF POWER AS SPECIFIED.
- 6. EXTERIOR LIGHTING POLES SHALL BE PROVIDED WITH STRAIGHT SQUARE ALUMINUM POLES WITH CAST BASE COVERS AND VIBRATION DAMPENERS. THE POLES SHALL BE SIZED PROPERLY TO SUPPORT FIXTURE WEIGHT AT 100 MPH WIND WITH A 1.3 GUST FACTOR MINIMUM POLE SIZE TO BE 5" SQUARE. PROVIDE ADDITIONAL MOUNTING ACCESSORIES AS REQUIRED FOR A COMPLETE AND PROPER INSTALLATION.
- T. FOR EXTERIOR POLE MOUNTED LIGHTING, PROVIDE FACTORY MOUNTED HOUSE SIDE SHIELDS INTEGRAL TO THE FIXTURE AS SPECIFIED. ADDITIONALLY, PROVIDE CUSTOM FABRICATED POLE MOUNTED HOUSE SIDE SHIELDING AS REQUIRED TO CONTROL LIGHT TRESPASS AND COMPLY WITH LOCAL REQUIREMENTS.
- 8. FIXTURES WITH EMERGENCY BATTERIES SHALL BE PROVIDED WITH CONSTANT HOT SENSING WIRE SO THAT FIXTURE CAN BE SWITCHED ON AND OFF WITHOUT ACTIVATING EMERGENCY BALLAST. UPON LOSS OF POWER, THE FIXTURE SHALL BE ILLUMINATED FOR A MINIMUM OF 90 MINUTES REGARDLESS OF THE LIGHT SWITCH POSITION. PROVIDE TEST SWITCH AND CHARGING INDICATOR FOR EMERGENCY BATTERY AS SPECIFIED.
- 9. CAREFULLY COORDINATE MOUNTING REQUIREMENTS FOR FIXTURES WITH CONTRACT DOCUMENTS AND FIXTURE MANUFACTURER, PROVIDE APPROPRIATE MOUNTING FRAMES

FOR LAY-IN OR GYPSUM CEILINGS. VERIFY CEILING REQUIREMENTS WITH FINAL

10. VERIFY FIXTURE MOUNTING HEIGHTS WITH ARCHITECT PRIOR TO ROUGH-IN.

ARCHITECTURAL REFLECTED CEILING PLAN.

- 11. VERIFY VOLTAGES OF EXISTING LIGHTING CIRCUITRY PRIOR TO ORDERING FIXTURES.
- 12. PROVIDE CUSTOM ANTI-SWAY BRACING FOR PENDANT TO ELIMINATE PENDANT MOVEMENT DUE TO AIR MOVEMENT OR ENVIRONMENTAL CAUSES.
- 13. COORDINATE LOCATIONS OF INTERIOR AND EXTERIOR LIGHTING FIXTURES WITH FINAL ARCHITECTURAL DRAWINGS. FIXTURES THAT ARE NOT INSTALLED IN THE CORRECT LOCATION SHALL BE RELOCATED AND REINSTALLED IN THE CORRECT LOCATION AT NO ADDITIONAL CHARGE.
- 14. FIXTURES SHALL BE PROVIDED WITH ESCUTCHEON PLATES AS REQUIRED TO COVER EXISTING HOLES FROM REMOVED FIXTURES. CANOPY CEILING AROUND NEW FIXTURES SHALL BE REFINISHED TO MATCH EXISTING SURROUNDING CANOPY CEILING SURFACES.
- 15. PROVIDE 5000K COLOR TEMPERATURE IN SPECIAL EDUCATION SPACES AS SPECIFIED.
- 16. FIXTURES SHALL BE CAREFULLY COORDINATED WITH MANUFACTURER TO DELIVER THE SPECIFIED PRODUCT IN SUFFICIENT TIME TO MEET PROJECT DEADLINES. EQUIPMENT DELIVERY LEAD TIME SHALL NOT BE HELD AS A VALID REASON FOR REQUESTING LUMINAIRE SUBSTITUTION UNLESS LUMINAIRE LEAD TIME FROM SPECIFIED MANUFACTURER IS IN EXCESS OF 14 WEEKS. IT SHALL BE THE SOLE RESPONSIBILITY OF THE ELECTRICAL CONTRACTOR TO DETERMINE NECESSARY EQUIPMENT LEAD TIMES, DELIVER SUBMITTALS FOR REVIEW IN A TIMELY FASHION, AND PLACE ORDERS ACCORDINGLY TO ENSURE TIMELY DELIVERY.
- IT. EVALUATION OF APPROVED EQUALS SHALL BE AT THE SOLE DISCRETION OF THE ARCHITECT AND ENGINEER. IF THE PRODUCT SUBMITTED DURING THE REVIEW PROCESS IS NOT JUDGED AS AN EQUAL BY THE REVIEWING ENGINEER, THE CONTRACTOR SHALL PROVIDE THE PRODUCT SPECIFIED.
- 18. CAREFULLY COORDINATE VOLTAGES OF FIXTURES PRIOR TO ORDERING FIXTURES.
- 19. APPROVED EQUALS WILL BE CONSIDERED FROM THE FOLLOWING VENDORS: KSA LIGHTING (630.307.6955), FORCE CHICAGO (312.986.1515) OR PG ENLIGHTEN (847.228.1199).
- 20. CAREFULLY VERIFY COLOR TEMPERATURE OF FIXTURES WITH ARCHITECT PRIOR TO ORDERING.

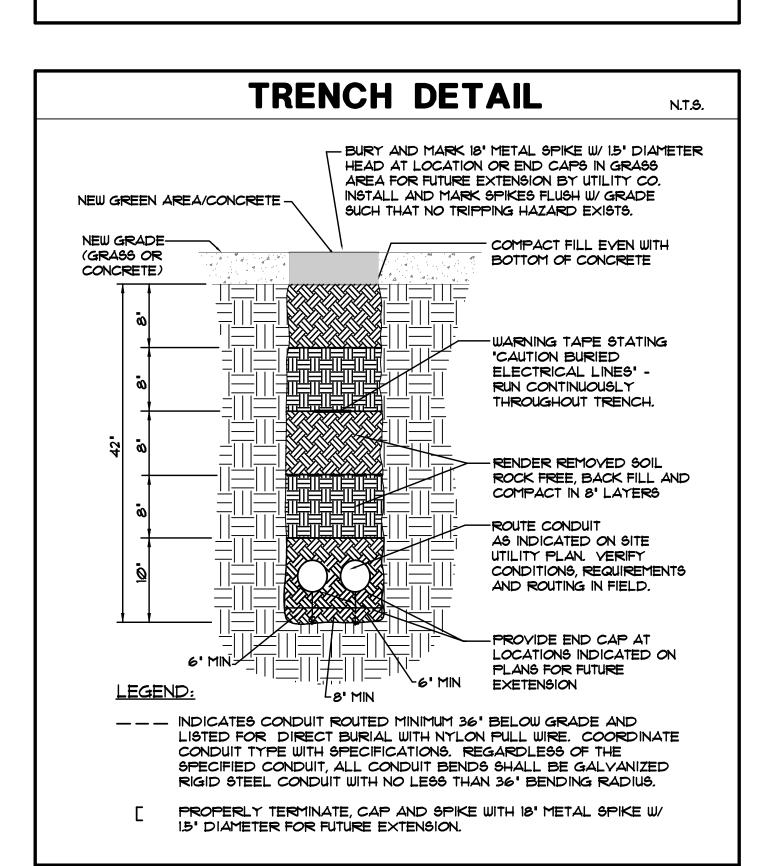

		EXTERIO	OR LIGHTING LUMINA	AIRE S	CHEDI	JLE	
TAG	SYMBOL	DESCRIPTION	MANUFACTURER SERIES OR CATALOG NUMBER	VOLTAGE/ BALLAST	LAMPS/CROSS SECTION	MOUNTING	REMARKS AD-
EAI	•=	EXTERIOR LED FIXTURE MOUNTED ON A STRAIGHT, SQUARE ALUMINUM POLE	LITHONIA *DSXI LED-PI-50K-T4M-208-SPA-HS NO SUBSTITUTIONS	208 VOLT	LED 5000K MIN 7000LM MAX 54W	POLE MTD 25'-Ø' AFG	
EA2	•-	EXTERIOR LED FIXTURE MOUNTED ON A STRAIGHT, SQUARE ALUMINUM POLE	LITHONIA *DSXI LED-PI-50K-TIS-208-SPA-HS NO SUBSTITUTIONS	208 VOLT	LED 5000K MIN 7000LM MAX 54W	POLE MTD 25'-Ø' AFG	
EBI	•—	EXTERIOR LED FIXTURE MOUNTED ON A STRAIGHT, SQUARE ALUMINUM POLE	LITHONIA *DSXI LED-P4-50K-T4M-208-SPA-HS NO SUBSTITUTIONS	208 YOLT	LED 5000K MIN 11000LM MAX 125W	POLE MTD 25'-Ø' AFG	3
EB2	•—	EXTERIOR LED FIXTURE MOUNTED ON A STRAIGHT, SQUARE ALUMINUM POLE	LITHONIA *DSXI LED-P4-50K-T5W-208-SPA NO SUBSTITUTIONS	208 VOLT	LED 5000K MIN 11000LM MAX 125W	POLE MTD 25'-Ø' AFG	}
ECI	•-	EXTERIOR LED FIXTURE MOUNTED ON A STRAIGHT, SQUARE ALUMINUM POLE	LITHONIA *DSXI LED-P7-50K-T5W-208-SPA-HS NO SUBSTITUTIONS	208 VOLT	LED 5000K MIN 15000LM MAX 183W	POLE MTD 25'-Ø' AFG	
EC2	•—	ON A STRAIGHT, SQUARE ALUMINUM	LITHONIA *DSXI LED-PT-50K-T4M-208-SPA NO SUBSTITUTIONS	208 YOLT	LED 5000K MIN 15000LM MAX 183W	POLE MTD 25'-Ø" AFG	3
ED		1 	LITHONIA *WST-P3-40K-VF-120-XX OR APPROVED EQUAL NO SUBSTITUTIONS	120 VOLT	LED 4000K MIN 6000LM MAX 56W	WALL MTD 12'-Ø' AFG OR AS NOTED	-VERIFY FINISH WITH ARCHITECT.
EE	0	FINISH TO BE SELECTED BY	LITEISTRY*LTR-6RD-H-SLI5L-DMI-IC-LTR-6RD- T-SL-40K8-MD-S HALO *HC6I5DOI0 / HM6I2840 / 6IMDHWF SPECTRUM *SGICE6LEDOS SERIES	120 VOLT	LED 4000K MAX 18W MIN 1500LM	RECESSED CANOPY MOUNTED -	-VERIFY TRIM FINISH WITH ARCHITECT -PROVIDE TRIM ACCESSORIES AS REQUIRED FOR MINIMUM 2-5/8" TOTAL CEILING THICKNESS -IC RATED
EF	0	FOR FLAGPOLE WITH FINISH TO BE SELECTED BY ARCHITECT	AYDREC 4991200-X-LED-P4-40K-PNOCH-VICEN	205 VOLT	4000K MIN 7000LM MAX 53W	KECESSED IN-GRADE - -	WITH ARCHITECT

PARAPET, FACING CONDUIT TO PHOT SPACE UP THROUG PHOTOCELL. PRO CURB, FLASH, AND	ALL PHOTOCELL AT NORTH WALL NORTH, ROUTE 2 *12 AWG IN ½" OCELL CONCEALED IN CEILING SH PATE PIPE CURB, ON ROOF, TO OVIDE WEATHER TIGHT PATE PIPE O COUNTER FLASH COMPLETE AS	O PANEL			
REQUIRED.	CONTACTOR (2) 20A/IP (DUSK/DAWN)	120/208V 3¢, 4W IN ELECTRICAL RO	CONTACTOR (2) 20A/2P (NIGHT LIGHT)	CONTACTOR (2) 20A/2P (12AM)	CONTACTOR (2) 20A/2P (10PM)
BUILDING AUTOMATION SYSTEM	H.O.A. MANUAL OVERRIDE SWITCHES EXTERIOR LIGHTING INVER MYERS *LV: 1100VA	RTER MANUAL	DE	TO LOADS	TO LOADS
SYSTEM (BAS) SP INFORMATION, PRO CONTACTORS AS LIGHTING FIXTURES COMPLETE AS RE	NICAL BUILDING AUTOMATION ECIFICATIONS FOR ADDITIONAL DVIDE ALL RELAYS AND REQUIRED TO INTERFACE EXTERI S TO BUILDING AUTOMATION SYST QUIRED. COORDINATE WITH BAS O ORDERING EQUIPMENT.		DE TO	TO LOADS	LOADS
BYPASSES AS REEMERGENCY LIGH POWER, CONTRAC EMERGENCY POW	ONAL ACCESSORIES AND UL924 EQUIRED TO ACCOMPLISH PROPE ITING CONTROL. UPON LOSS OF TORS SHALL BE BYPASSED, AND ER FIXTURES SHALL BE FULLY ON LIGHTING CONTROL SYSTEM		CONTACTOR (2) 20A/IP (NIGHT LIGHT)	CONTACTOR (2) 20A/IP (12AM)	CONTACTOR (2) 20A/IP (I0PM)

			INTERIC	OR LIGHTING I	LUMINAIRE	SCHED	ULE	
	TAG	SYMBOL	DESCRIPTION	MANUFACTURER SEI DR CATALDG NUMI			MOUNTING	REMARKS
Ī	AA	0	2' × 4' LED DIRECT/INDIRECT FIXTURE	LITHONIA *2BLT4-3ØL-ADP-EZI-LI COLUMBIA *LCAT24 SERIES METALUX *24CZ2 SERIES	P840 120/277 v 0-10v i - -		RECESSED LAY-IN	- - -
	AAI	•	2' X 4' LED DIRECT/INDIRECT FIXTURE	LITHONIA *2BLT4-40L-ADP-EZI-LI COLUMBIA *LCAT24 SERIES METALUX *24CZ2 SERIES	P840 120/277 \ 0-10\forall 1 -		RECESSED LAY-IN	- - -
	AA2	0	2' X 4' LED DIRECT/INDIRECT FIXTURE	LITHONIA *2BLT4-48L-ADP-EZI-LF COLUMBIA *LCAT24 SERIES METALUX *24CZ2 SERIES	7840 120/277 \ 0-10\forall 1 -		RECESSED LAY-IN	-
	AA3	0	2' X 4' LED DIRECT/INDIRECT FIXTURE	LITHONIA *2BLT4-60L-ADP-EZI-L COLUMBIA *LCAT24 SERIES METALUX *24CZ2 SERIES	P840 120/277 \ 0-10\forall I -		RECESSED LAY-IN	-
	ДД4	0	2' X 4' LED DIRECT/INDIRECT FIXTURE	LITHONIA *2BLT4-T2L-ADP-EZI-LF COLUMBIA *LCAT24 SERIES METALUX *24CZ2 SERIES	P840 120/277 \ 0-10\forall 1 -		RECESSED LAY-IN	-
ŀ	AB	0	2' × 2' LED DIRECT/INDIRECT FIXTURE	LITHONIA *2BLT2-20L-ADP-EZI-LF COLUMBIA *LCAT22 SERIES METALUX *22CZ2 SERIES	7840 120/277 V 0-10V I -		RECESSED LAY-IN	-
	ABI	0	2' X 2' LED DIRECT/INDIRECT FIXTURE	LITHONIA *2BLT2-33L-ADP-EZI-LF COLUMBIA *LCAT22 SERIES METALUX *22CZ2 SERIES	120/277 V 0-10V I -		RECESSED LAY-IN	- - -
	AB2	0	2' X 2' LED DIRECT/INDIRECT FIXTURE	LITHONIA *2BLT2-40L-ADP-EZI-LE COLUMBIA *LCAT22 SERIES METALUX *22CZ2 SERIES	20/277 V 0-10/ I		RECESSED LAY-IN	-
	AB3	0	2' × 2' LED DIRECT/INDIRECT FIXTURE	LITHONIA *2BLT2-60L-ADP-EZI-LI COLUMBIA *LCAT22 SERIES METALUX *22CZ2 SERIES	P840 120/277 V 0-10V I -		RECESSED LAY-IN	- - -
	AC		I' X 4' LED DIRECT/INDIRECT FIXTURE	LITHONIA *BLT4-40L-ADP-EZI-LP COLUMBIA *LCATI4 SERIES METALUX *14CZ2 SERIES	P840 120/277 V 0-10 V I -		RECESSED LAY-IN	- - -
	AD	0	2' X 4' LED LENSED KITCHEN TROFFER FIXTURE WITH INVERTED LENS AND TRIPLE GASKETING	LITHONIA *2GTL4-100L-RW-A19INY LP840-ABC COLUMBIA *LJT24 SERIES METALUX *GR LED SERIES	-MVOLT-EZI- 120/277 V 0-10V I -		RECESSED LAY-IN	-INVERTED LENS AND TRIPLE GASKETING - -
	СА	0	6" DIAMETER LED DOWNLIGHT WITH SEMI-SPECULAR ALZAK REFLECTOR, IRIDESCENT FREE FINISH, & WHITE FLANGE	LITHONIA *LDN6-40-15-L06-AR-L -EZIØ-XX PRESCOLITE *LTR SERIES PORTFOLIO *LD6B SERIES	120/277 V 0-10V I -		RECESSED LAY-IN/ DRYWALL	-VERIFY TRIM FINISH W ARCHITECT
	PA	•	LED HIGH BAY FIXTURE WITH WIREGUARD AND SAFETY CABLE	LITHONIA *1BG-30L-SEF-AFL-GND 40K-80CRI-WGX-XX-XX COLUMBIA *PEL4 SERIES METALUX *OHB SERIES	-MVOLT-GZIØ- 120/277 V Ø-10V I		CABLE MTD 6' ABOVE BOTTOM OF STRUCTURE	-PROVIDE WIREGUARD AND SAFETY CABLE - -
 	PB	₩	4', LED INDUSTRIAL FIXTURE WITH WIREGUARD AND SAFETY CHAINS	LITHONIA *CLX-L48-7000LM-SEF- -GZI0-40K-80CRI-XX-XX METALUX *SNLED SERIES COLUMBIA *195 SERIES	-FDL-MVOLT 120/277 V 0-10V I		'Y' CHAIN SUSPEND -	-COORD LOCATIONS UDUCTWORK & PIPING
	PD	0	LIBRARY PENDANT	VISA *CPI542-L40-H-MVOLT-XX-> OR APPROVED EQUAL	×× 120/277		SUSPENDED - -	-VERIFY HEIGHT WITH ARCHITECT -VERIFY FINISH WITH ARCHITECT
	TA	ΔΔ	PAR30 DIMMABLE HEAD, TWO CIRCUIT TWO NEUTRAL TRACK	CON-TECH *CTL5030-B-FA-30-BE PROVIDE WITH NTEK-X-B TRACK JUNO *TEK SERIES OR APPROVED EQUAL	03Ø 12Ø VO - - -	ONE (1) LED 15W EQUIV PAR 3Ø PER HEAD	36" STEM MOUNTED TO UNISTRUT	-PROVIDE ALL MOUNT ACCESSORIES -
\lceil	A A		SINGLE FACE EXIT WITH 90	DUAL-LITE *SE-S-R-X-E-I	120 VO	A A A A AA	CEILING/	-VERIFY FINISH WITH
	XA	→			<u> </u>		- - -	-PROVIDE WITH ARRO AS REQUIRED
	ХВ	•	DUAL FACE EXIT WITH 90 MINUTE BATTERY BACKUP	DUAL-LITE *SE-D-R-X-E-I LITHONIA *LE-S-X-2-R-ELN-X SURE-LITES *CX SERIES	120 YO - - -	LED MAX 3W - -	CEILING/ WALL - -	-VERIFY FINISH WITH ARCHITECT -PROVIDE WITH ARRO AS REQUIRED
	EM		FIXTURE ON EMERGENCY CIRCUIT WITH 90 MINUTE, 1400 LUMEN OUTPUT BATTERY UNIT OR INVERTER	BODINE FACTORY INSTALLED DE OR MYERS LY SERIES INVERTER		OLT -	IN FIXTURE/ REMOTE	-PROVIDE TEST SWITC AND CHARGING INDICATOR
ŀ	NL		CONSTANT HOT, UNSWITCHED NIGHT LIGHT FIXTURE					



GIBRALTAR

DESIGN

ARCHITECTURE • ENGINEERING • INTERIOR DESIGN

MILLIES

PROJECT

Copyright © 2022 Millies Engine

Copyright Was a Copy

ES ADDITIONS AND

RENOVATIONS
CROWN POINT COMMUNITY
SCHOOL CORPORATION


CROWN POINT, INDIANA

GIBRALTAR DESIGN

9102 N. Meridian St., Ste. 300 Indianapolis, IN 46260 Homepage www.GibraltarDesign.com Email info@GibraltarDesign.com Phone 317.580.5777 Fax 317.580.5778

PROJECT
21-113
DATE
01/31/22
COORDINATED E
SM
DRAWN BY

CHECKED BY

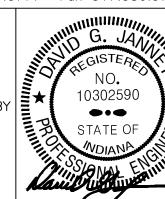

COPYRIGHT NOTICE:

THE CONCEPTS, DESIGNS, PLANS, DETAILS, ETC, SHOWN ON THIS DOCUMENT ARE THE PROPERTY OF GIBRALTAR DESIGN AND WERE CREATED FOR USE ON THIS SPECIFIC PROJECT. NONE OF THIS INFORMATION SHALL BE USED BY ANY PERSON OR FIRM FOR ANY PURPOSE WITHOUT THE EXPRESS WRITTEN CONSENT OF GIBRALTAR DESIGN. THE OWNER MAY RETAIN COPIES FOR INFORMATION AND REFERENCE IN CONNECTION ONLY WITH THIS PROJECT.

EV12	ION2	
ARK	DATE	ISSUED FOR
)-2	02/17/22	ADDENDUM NO. 2
)–3	02/23/22	ADDENDUM NO. 3

DRAWING

ELECTRICAL SCHEDULES, NOTES, DETAILS & DIAGRAMS

PROJECT

DOUGLAS MACARTHUR ES


ADDITIONS AND RENOVATIONS

© GIBRALTAR DESIGN SHEET

Copyright © 2022 Millies Engineering Group

E-502

	NI I	TCHEN EQUIP	MENT		EL	EC	TR		;/	AL	
		DESCRIPTION	SOURCE								REMARKS
ΩĽ	Ŧ	SU=STUB UP		Ä							
	Z	NIKEC = NOT IN KITCHEN		VOLTAGE		AMPS		PHASE	Ž		
#3	ਕੋ	EQUIPMENT CONTRACT		<u>8</u>	₹	<u>₹</u>	<u> </u>	可	$ \mathcal{S} $	AΉ	
1	1	WALK-IN COOLER/FREEZER	KOLPAK CUSTOM	120		16.0		1	D	DFA	CIRCUIT REQUIRED AT EACH
			NOLFAN CUSTOTT								DOOR
2	1	WALK-IN COOLER COIL	PART OF ITEM #	120		5.0		1	D	DFA	
3	1	WALK-IN COOLER COMPRESSOR	PART OF ITEM #	208		10.9	1.50	3	D	ROOF	
				208		9.0			D	DFA	REFER TO COOLER/FREEZER DWG. K400 FOR
7	1		PART OF ITEM #	120		15.0		i	P	96	DRAIN LINE HEAT TAPE, NEMA 5-15P
8	1	WALK-IN FREEZER COMPRESSOR	PART OF ITEM #	208		19.5	3.50	1	P	ROOF	REFER TO COOLER/FREEZER DWG. K400
14	1		CUSTOM ST.STL.	120		16.0		1	P	su	FIXTURE MOUNTED DCO - 4 LOCATIONS
16	4		T46 BRA66								
	4		5EF-ID-WG	120		6.00			P	16	EIVELDE MOUNTED DOO
דו	1	An #40	CUSTOM ST.STL.	120		16.0		1	P	su	FIXTURE MOUNTED DCO - 4 LOCATIONS
19	1	GARBAGE DISPUSAL	IN-SINK-ERATOR	208		3.20		3	D	su	EXTEND SERVICE TO K.E.C. FURNISHED CONTROL PANEL.
	-	COUNTERTOP MIXER W/	65-2 <i>00-</i> 7/A5-1 <i>0</i> 1 HOBART								*PLUG INTO ISLAND
21	1	STAND	HL200-ISTD	120		8.00		<u> </u>	P	*	WORKTABLE
22	1	SLICER	HOBART HSS-1	120		5.40		1	P	*	*PLUG INTO ISLAND WORKTABLE
24	1	ICE MAKER W/ BIN	MANITOWOC	120		11.5		1	D	66	
			PANASONIC					+		_	NEMA E 150
26	1	MICROWAVE	NE-1064F	120		13.4		1	P	24	NEMA 5-15P
28	2	SINGLE DOOR REACH-IN HEATED CABINET	TRAULSEN AHF132W-FHS	208		7.80		1	P	78	NEMA L14-20P MOUNTED IN SOFFIT ABOVE
29	2	SINGLE DOOR REACH-IN REFRIGERATOR	TRAULSEN	120		7.00		1	P	78	NEMA 5-15P MOUNTED IN SOFFIT ABOVE
2 <u>F</u>	•		AHT132WUT-FHS RATIONAL	208		15.0		1	D	48	· · · · · · · · · · · · · · · · · · ·
35	I	GTACK	ICC 6-FULL/ICC 6-FULL	208		15.0		1	D	24	
37	1	40 GALLON TILT SKILLET	CLEVELAND SGL4ØTI	120		10.0		1	P	16	NEMA 5-15P
40	1	DOUBLE STACKED CONVECTION OVEN	SOUTHBEND	120		T.9Ø		1	P	16	NEMA 5-15P (1) REQUIRED
49	1	GARBAGE DISPOSAL	SLGB/22SC IN-SINK-ERATOR	200		226				14	PER OVEN EXTEND SERVICE TO K.E.C.
45	ı	SYSTEM	SS-200-7/AS-101	208		3.20		3	D	16	FURNISHED CONTROL PANEL.
51	1	DISH MACHINE W/BOOSTER HEATER	HOBART CL44EN-BAS	208		133		3	D	60	150 AMP BREAKER REQUIRED
52	1	DISH MACHINE	HOBART	208		34.2		3	D	60	45 AMP BREAKER REQUIRED
		BLOWER DRYER MILK COOLER	BDELRAB-HTSDOM TRUE					<u> </u>			NEMA 5-15P POVIDE FLUSH MOUNTED
58	1		TMC-49-HC	120		2.70		1	P	su	RECEPTACLE IN FLOOR
69	1	MOBILE HOT SERVING COUNTER	CUSTOM ST. STL./ MILLWORK	120		16.0		1	P	su	DCO
10	1	DROP-IN HOT/COLD UNIT	LTI	120/		14.4		1	P	su	NEMA 14-20P
	•	SELF-SERVE BREATH	DI-QSCHP-4 VERSA-GARD	280							
11	1	GUARD W/LIGHTS	VGT	120		6.00		<u> </u>	D	su	
12	1	MOBILE COLD SERVING COUNTER	CUSTOM ST. STL./ MILLWORK	120		16.0		1	P	su	DCO
13	1	DROP-IN COLD WELL UNIT	LTI	120		8.50			P	su	NEMA 5-15P
		SELF-SERVE BREATH	DI-2063TA VERSA-GARD								
14	1	GUARD W/LIGHTS	VGT	120		6.00		<u> </u>	D	su	DCO
15	1	DRY GOODS SERVING COUNTER	CUSTOM ST. STL./ MILLWORK	120		16.0		1	P	su	
16	1	ICE CREAM	BEVERAGE AIR	120		2.00		1	P	su	NEMA 5-15P PROVIDE FLUSH MOUNTED
16	ı	FREEZER MILK COOLER	NC28HC-1-W					·			RECEPTACLE IN FLOOR
18	1		TMC-49-HC	120		2.70		1	P	su	NEMA 5-15P
19	1	MOBILE HOT SERVING	CUSTOM ST. STL/MILLWORK	120		16.0		1	P	su	DCO
30	1	DROP-IN HOT/COLD UNIT	LTI	120/		14.4		+-	P	su	NEMA 14-20P
	•	GELF GED & DOTATE	DI-QSCHP-4 VERSA-GARD	280				 '		<i>-</i>	
31	1	SELF-SERVE BREATH GUARD W/LIGHTS	VERSA-GARD VGT	120		6.00		1	D	su	
32	1	MOBILE COLD SERVING	CUSTOM ST. STI / MILLINGEK	120		16.0		1	P	su	DCO
		COUNTER DROP-IN COLD WELL UNIT	ST. STL./ MILLWORK						-		NEMA 5-15P
33	1		DI-2063TA	120		8.50			P	su	
34	1	SELF-SERVE BREATH GUARD W/LIGHTS	VERSA-GARD VGT	120		6.00		1	D	su	
85	1	DRY GOODS SERVING	CUSTOM	120		16.0		1	P	su	DCO
		COUNTER BOINT OF SALE	ST. STL./ MILLWORK	2				 '			
87	2	POINT OF SALE SYSTEM	BY OWNER NIKEC	120		16.0		1	P	su	DCO. DATA LINE REQUIRED.
				120		16.0				16	
ori		DUPLEX CONVENIENCE RECEPTACLE		1250		10.20		' '			

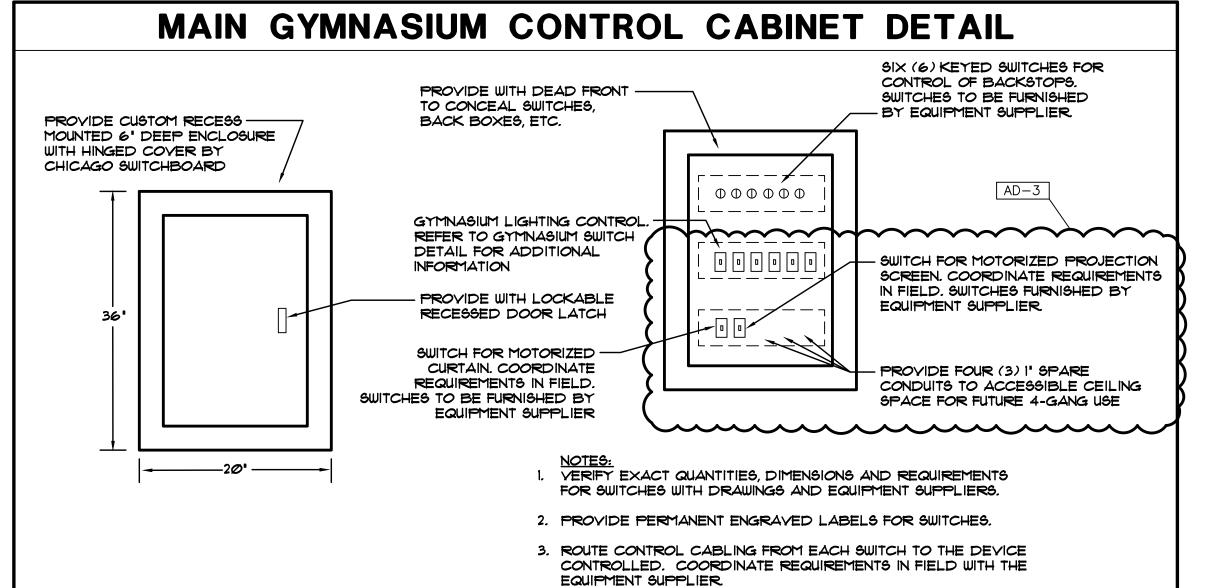


LIGHTING CONTROL SYSTEM NOTES

- UNLESS NOTED OTHERWISE, THE LIGHTING CONTROL SYSTEM SHALL BE A STAND ALONE SENSORSWITCH WIRED SYSTEM COMPLETE WITH OCCUPANCY SENSORS, POWER PACKS, EMERGENCY ACCESSORIES, ETC. SYSTEM TO BE PROVIDED WITH COMPONENTS AND ACCESSORIES AS REQUIRED TO PROVIDE FUNCTIONALITY PER THE CONTRACT DOCUMENTS.
- 2. LIGHTING CONTROL EQUIPMENT WILL BE CONSIDERED FROM THE FOLLOWING MANUFACTURERS: EATON CONTROLS, LEVITON OR HUBBELL CONTROLS. THE SUBMITTED LIGHTING CONTROL SYSTEM SHALL PROVIDE FULL LIGHTING CONTROL FUNCTIONALITY AS SPECIFIED.
- BECAUSE OF DIFFERENCES BETWEEN MANUFACTURERS, DIAGRAMS SHOWN ARE DIAGRAMMATIC AND MAY NOT SHOW ALL PARTS AND ACCESSORIES REQUIRED. CONTRACTOR SHALL COORDINATE ALL REQUIREMENTS WITH LIGHTING CONTROL MANUFACTURER AND CONTRACT DOCUMENTS. CONTRACTOR SHALL PROVIDE ALL PARTS AND ACCESSORIES REQUIRED FOR A COMPLETE AND PROPERLY OPERATING SYSTEM AS SHOWN ON CONTRACT DOCUMENTS. VERIFY ALL CONDITIONS AND REQUIREMENTS, COMPLETE AS REQUIRED.
- 4. NO EXTRAS SHALL BE ALLOWED AFTER BIDDING FOR NOT FULLY UNDERSTANDING THE SCOPE OF WORK INVOLVED OR TO FULLY ACCOMPLISH THE SWITCHING SCHEME SHOWN ON THE CONTRACT DOCUMENTS.
- 5. PROVIDE 12 HOURS OF FACTORY COMMISSIONING AND 6 HOURS FACTORY TRAINING FOR THE OWNER'S BUILDING STAFF.
- 6. UL924 BYPASS DEVICES SHALL BE PROVIDED FOR ALL FIXTURES WITH AN EMERGENCY SOURCE OF POWER THAT IS SWITCHED. THE UL924 BYPASS SHALL PROVIDE BYPASS FOR BOTH THE POWER AND CONTROL
- SIGNAL, COMPLETE AS REQUIRED. ALL LOW YOLTAGE CABLING SHALL BE PLENUM RATED. CABLING ROUTED IN CONCEALED AREAS SHALL BE ROUTED NEATLY EXPOSED WITHIN J-HOOKS. CABLING LOCATED IN EXPOSED CEILINGS SHALL BE


CODE REQUIREMENTS.

CONCEALED IN NEATLY ROUTED CONDUIT. LOW YOLTAGE CABLING INSTALLATION SHALL FULLY MEET LOCAL

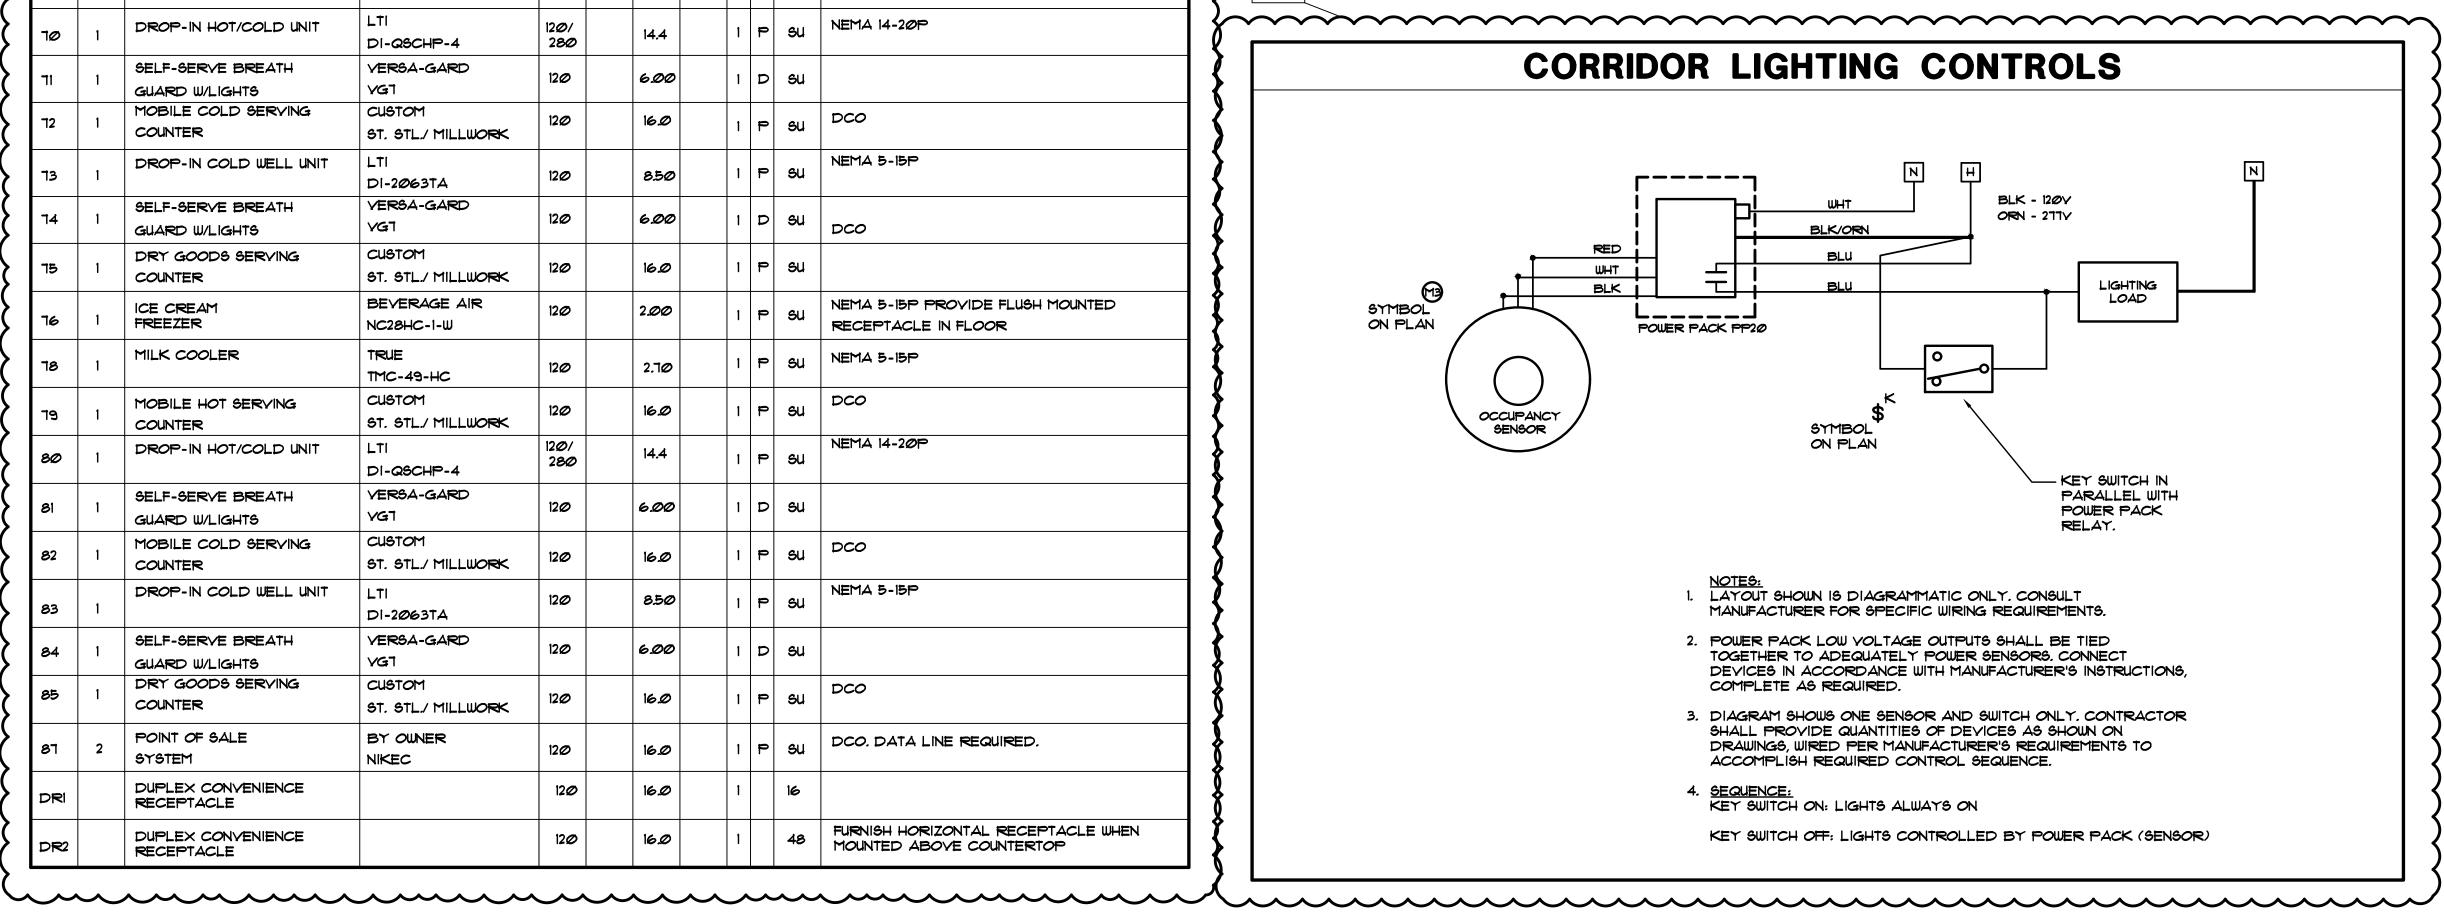

MAIN GYMNASIUM SWITCH DETAIL AND SEQUENCE OF OPERATIONS

PROVIDE ACUITY N-LIGHT SWITCH WITHIN GYMNASIUM CABINET AND LABEL BUTTONS AS SHOWN

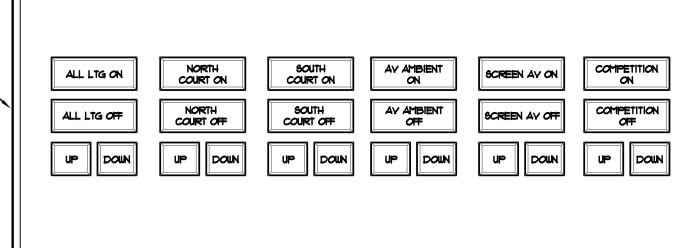

- A. ALL LTG ON: TURNS ALL LIGHTING (SWITCH LEGS 'a', 'b', 'c' AND 'd') TO FULL 50 FC AVERAGE LEVEL. ALLOWS DIMMABLE LIGHTING TO BE SELECTED SO THAT LEVEL MAY BE ADJUSTED MANUALLY BY RAISE/LOWER BUTTON.
- B. ALL LTG OFF: TURNS ALL LIGHTING IN GYM OFF.
- C. NORTH COURT ON: TURNS NORTH COURT LIGHTING (SWITCH LEG 'a' AND 'd') TO FULL 50 FC LEVEL. ALLOWS DIMMABLE NORTH COURT LIGHTING TO BE SELECTED SO THAT LEVEL MAY BE ADJUSTED MANUALLY BY RAISE/LOWER BUTTON.
- D. NORTH COURT OFF: TURNS NORTH COURT LIGHTING (SWITCH LEG 'a' AND 'd') LIGHTING OFF.
- E. SOUTH COURT ON: TURNS SOUTH COURT LIGHTING (SWITCH LEG 'b' AND 'c') TO FULL 50 FC LEVEL. ALLOWS DIMMABLE SOUTH COURT LIGHTING TO BE SELECTED SO THAT LEVEL MAY BE ADJUSTED MANUALLY BY RAISE/LOWER BUTTON.
- F. SOUTH COURT OFF: TURNS SOUTH COURT LIGHTING (SWITCH LEG 'b' AND 'c') LIGHTING OFF.
- G. AY AMBIENT ON: TURNS AY AMBIENT LIGHTING (SWITCH LEG 'C' AND 'd') TO FULL 50 FC LEVEL. ALLOWS DIMMABLE AY AMBIENT LIGHTING TO BE SELECTED SO THAT LEVEL MAY BE ADJUSTED MANUALLY BY RAISE/LOWER BUTTON.
- H. AY AMBIENT OFF: TURNS AY AMBIENT LIGHTING (SWITCH LEG 'c' AND 'd') LIGHTING OFF.
- SCREEN AY ON: TURNS SCREEN AY LIGHTING (SWITCH LEG 'A' AND 'b') TO FULL 50 FC LEVEL. ALLOWS DIMMABLE SCREEN AY LIGHTING TO BE SELECTED SO THAT LEVEL MAY BE ADJUSTED MANUALLY BY RAISE/LOWER BUTTON.
- J. SCREEN AY OFF: TURNS SCREEN AY LIGHTING (SWITCH LEG 'a' AND 'b') LIGHTING OFF.
- K. COMPETITION ON: TURNS ALL LIGHTING (SWITCH LEGS 'a', 'b', 'c' AND 'd') TO FULL 1000 FC AVERAGE LEVEL. ALLOWS DIMMABLE LIGHTING TO BE SELECTED SO THAT LEVEL MAY BE ADJUSTED MANUALLY BY RAISE/LOWER BUTTON.
- L. COMPETITION OFF: TURNS ALL LIGHTING OFF.

- PRESSING "ON" WILL TURN ON ALL LIGHTING REGARDLESS OF OCCUPANCY. IF NO OCCUPANCY IS DETECTED WITHIN 15 MINUTES, THE LIGHTING IN THE UNOCCUPIED AREA SHALL SHUT OF OCCUPANCY IS DETECTED AND THE SWITCH IS IN THE 'ON' STATE, THE LIGHTING SHALL IMMEDIATELY TURN ON ('AUTOMATIC ON OPERATION').
- 2. PROVIDE ACCESSORIES, INTERFACES AND PROGRAMMING TO ACCOMPLISH THE ABOVE SEQUENCE OF OPERATIONS.
- 3. NO FIXTURES ARE CONTROLLED BY THE OCCUPANCY SENSORS ONLY. FIXTURES IN SPACE SHALL BE CONTROLLED WITH BOTH A LIGHT SWITCH AND OCCUPANCY SENSORS.
- 4. SWITCHING ALL LIGHTING OFF WILL CAUSE FIXTURES TO TURN TO 10% DIMMING LEVEL FOR THREE MINUTES BEFORE TURNING COMPLETELY OFF.

STAGE AND GYMNASIUM LIGHTING **CONTROL SYSTEM**

- THE LIGHTING CONTROL SYSTEM SHALL BE A STANDALONE ACUITY #FRESCO SYSTEM (ACUITY FRESCO FC6-1T6N-X) COMPLETE WITH KEYPADS, SENSORS, ACCESSORIES, PROGRAMMING SOFTWARE, ETC. THE SYSTEM SHALL PROVIDE DIMMING CONTROL OF ALL GYMNASIUM, STAGE THEATRICAL LIGHTING AND STAGE AREA HOUSE LIGHTING USING THE FRESCO SYSTEM WITH N-LIGHT COMPONENTS.
- LIGHTING CONTROL EQUIPMENT WILL BE CONSIDERED FROM THE FOLLOWING MANUFACTURERS: HUBBELL CONTROLS, LEVITON OR CRESTRON. THE JUDGMENT OF WHAT IS ACCEPTED AS AN EQUAL SHALL BE AT THE SOLE DISCRETION OF THE REVIEWING ENGINEER IF THE ENGINEER DEEMS THE PRODUCT SUBMITTED DURING THE SHOP DRAWING REVIEW AS NOT EQUAL TO THE SPECIFIED PRODUCT, THE SPECIFIED PRODUCT SHALL BE PROVIDED AT NO ADDITIONAL COST.
- BECAUSE OF DIFFERENCES BETWEEN MANUFACTURERS, CONTRACT DOCUMENTS MAY NOT SHOW ALL PARTS AND ACCESSORIES REQUIRED. CONTRACTOR SHALL COORDINATE ALL REQUIREMENTS WITH LIGHTING CONTROL MANUFACTURER AND CONTRACT DOCUMENTS. CONTRACTOR SHALL PROVIDE ALL PARTS AND ACCESSORIES REQUIRED FOR A COMPLETE AND PROPERLY OPERATING SYSTEM AS SHOWN ON CONTRACT DOCUMENTS. VERIFY ALL CONDITIONS AND REQUIREMENTS, COMPLETE AS REQUIRED.
- 4. NO EXTRAS SHALL BE ALLOWED AFTER BIDDING FOR NOT FULLY UNDERSTANDING THE SCOPE OF WORK INVOLVED OR TO FULLY ACCOMPLISH THE SWITCHING SCHEME SHOWN ON THE CONTRACT DOCUMENTS.
- . THE SYSTEM SHALL BE PROVIDED WITH 6 HOURS OF COMMISSIONING AND 2 HOURS TRAINING BY A FACTORY REPRESENTATIVE. THE USE OF AN AUTHORIZED SALES REPRESENTATIVE FOR THIS WORK IS ACCEPTABLE.
- 6. ALL LOW YOLTAGE CABLING SHALL BE PLENUM RATED. CABLING ROUTED IN CONCEALED AREAS SHALL BE ROUTED NEATLY EXPOSED WITHIN J-HOOKS. CABLING LOCATED IN EXPOSED CEILINGS SHALL BE CONCEALED IN NEATLY ROUTED CONDUIT. LOW YOLTAGE CABLING INSTALLATION SHALL FULLY MEET LOCAL CODE REQUIREMENTS.
- ACUITY SOFTWARE SHALL BE PROVIDED FOR THE OWNER'S COMPUTER TO ALLOW FOR REMOTE ADJUSTMENTS TO BE MADE TO THE LIGHTING CONTROL SYSTEM.
- 8. THE DIGITAL SWITCH ARRANGEMENT AND LABELING SHALL BE VERIFIED WITH OWNER PRIOR TO PROGRAMMING. ALL THEATRICAL TRACK FIXTURE SWITCH LEGS AS WELL AS THE DIMMING BACK OF HOUSE STAGE LIGHTING SHALL BE PROVIDED WITH DIMMING CONTROL AND INDIVIDUAL VIRTUAL BUTTONS ON THE FRESCO TOUCHSCREEN.
- 9. THE CONTROL SYSTEM SHALL BE PROVIDED WITH TWO (2) FUTURE FACTORY AUTHORIZED REP SITE VISITS TO CALIBRATE AND PROVIDE ADJUSTMENTS TO THE LIGHTING CONTROL FOLLOWING SUBSTANTIAL COMPLETION OF THE BUILDING.
- 10. THE SYSTEM SHALL PROVIDE FOR THREE WAY CONTROL OF THE GYMNASIUM LIGHTING FROM THE FRESCO POSITION OR THE GYMNASIUM CABINET. PROVIDE DIGITAL BUTTONS AT THE FRESCO LOCATION TO MATCH THE LAYOUT OF THE PHYSICAL GYMNASIUM LIGHTING CONTROL BUTTONS.



GIBRALTAR DESIGN

ARCHITECTURE • ENGINEERING • INTERIOR DESIGN



DOUGLAS MACARTHUR **ES ADDITIONS**

RENOVATIONS

CROWN POINT COMMUNITY SCHOOL CORPORATION CROWN POINT, INDIANA

GIBRALTAR DESIGN 9102 N. Meridian St., Ste. 300 ndianapolis, IN 46260 Homepage www.GibraltarDesign.com

Email info@GibraltarDesign.com

Phone 317.580.5777 Fax 317.580.577 PROJECT 21-113 01/31/22 COORDINATED

DRAWN BY

CHECKED BY

10302590 •••

COPYRIGHT NOTICE: THE CONCEPTS, DESIGNS, PLANS, DETAILS, ETC, SHOWN ON THIS DOCUMENT ARE THE PROPERTY OF GIBRALTAR DESIGN AND WERE CREATED FOR USE ON THIS SPECIFIC PROJECT. NONE OF THIS INFORMATION SHALL BE USED BY ANY PERSON OR FIRM FOR ANY PURPOSE WITHOUT THE EXPRESS WRITTEN CONSENT OF GIBRALTAR DESIGN. THE OWNER MAY RETAIN COPIES FOR INFORMATION AND REFERENCE IN CONNECTION ONLY WITH THI

MARK DATE ISSUED FOR AD-2 02/17/22 ADDENDUM NO. 2 AD-3 | 02/23/22 | ADDENDUM NO. 3

ELECTRICAL DETAILS &

DOUGLAS MACARTHUR ES ADDITIONS AND RENOVATIONS

GIBRALTAR DESIGN SHEET

E-504

GENERAL ROUGH-IN NOTES:

- CONTRACTOR SHALL USE THESE DRAWINGS IN CONJUNCTION WITH THE SPECIFICATIONS TO DETERMINE THE FULL SCOPE, INTENT AND REQUIREMENTS OF THE PROJECT. SPECIFICATIONS AND DRAWINGS ARE INTENDED TO BE COMPLEMENTARY, NOT MUTUALLY EXCLUSIVE. WORK SHOWN ON THE DRAWINGS BUT NOT LISTED IN THE SPECIFICATIONS, AND WORK DESCRIBED IN THE SPECIFICATIONS BUT NOT SHOWN ON THE DRAWINGS SHALL BE INTERPRETED AS THOUGH WORK WERE FULLY DESCRIBED IN BOTH PLACES. THE HIGHER QUANTITY, HIGHER QUALITY, MORE LABOR INTENSIVE AND OVERALL MORE STRINGENT AND MORE COSTLY REQUIREMENT SHALL APPLY.
- 2) COLORS OF CABLING USED FOR ALL COMMUNICATIONS TECHNOLOGY WORK SHALL BE REVIEWED AND APPROVED PRIOR TO PROCUREMENT AND INSTALLATION.
- ALL LADDER RACK AND OTHER COMMUNICATION TECHNOLOGY CABLING PATHWAYS DEPICTED ON THE ENLARGED FLOOR PLANS AND OTHERWISE NECESSARY FOR PROFESSIONAL WIRE MANAGEMENT WITHIN THE MAIN EQUIPMENT ROOM (ER) AND ALL TELECOMMUNICATION ROOMS (TR) SHALL BE PROVIDED BY THE COMMUNICATIONS TECHNOLOGY CONTRACTOR. SEE DIVISION 27 SPECIFICATIONS AND DRAWINGS FOR REQUIREMENTS.
- 4) THE DIVISION 27 CONTRACTOR SHALL THOROUGHLY REVIEW THE SPECIFIED ROUGH-IN TO ENSURE THAT SUPPLIED ROUGH-IN WILL SUPPORT THE CABLING AND DEVICES BEING SUPPLIED. DIVISION 27 CONTRACTOR SHALL THOROUGHLY COORDINATE WITH THE DIVISION 26 ROUGH-IN PROVIDER PRIOR TO ROUGH-IN MATERIAL ACQUISITION AND INSTALLATION.

GENERAL PATHWAYS NOTES:

- 1) ROUGH-IN/PATHWAYS SHALL BE CLOSELY REVIEWED AND COORDINATED PRIOR TO INSTALLATION. IT IS THE RESPONSIBILITY OF THE ROUGH-IN PROVIDER TO THROUGHLY REVIEW AND UNDERSTAND THE REQUIREMENTS OF THE SYSTEMS THAT WILL USE THE PATHWAYS. THIS INCLUDES, BUT IS NOT LIMITED TO, PROPER SIZING OF BOXES, AND PROVIDING THE CORRECT QUANTITY AND SIZES OF CONVEYANCES. THE COST FOR REMOVING AN INSUFFICIENT PATHWAY SYSTEM AND INSTALLING AN APPROPRIATELY SIZED AND TYPED PATHWAY SYSTEM IS THE RESPONSIBILITY OF THE CONTRACTOR
- PATHWAYS SHALL BE COMPLIANT WITH THE CONTRACT DOCUMENTS.
- WHERE CONDUIT IS SHOWN AND/OR SPECIFIED, PROVIDE PULL BOXES SHOWN ON THE DRAWINGS PLUS ADDITIONAL PULL BOXES AS FOLLOWS:

 A) EVERY 180 DEGREES OF CONDUIT BEND:
- B) EVERY 100 FEET OF CONDUIT PATH.

 3) INSTALLED PULL BOXES AND JUNCTION BOXES BE IN ACCESSIBLE LOCATIONS.
- 4) ROUGH-IN REQUIREMENTS INDICATED ON PLANS, ELEVATIONS AND DETAILS TAKE PRECEDENCE OVER VALUES GIVEN ON THE LEGEND, BUT ONLY TO THE EXTENT THAT THOSE SPECIFIC ITEMS ARE MODIFIED.
- 5) PROVIDE PATHWAYS FOR COMMUNICATIONS AND SECURITY SYTEMS CABLING. REFER TO SECTIONS "PATHWAYS FOR COMMUNICATIONS" AND "PATHWAYS FOR SAFETY AND SECURITY".
- 6) PROVIDE COVER PLATES FOR DEVICE, JUNCTION AND PULL BOXES. COORDINATE MATERIAL AND
- FINISH OF BLANK PLATES TO MATCH SURROUNDING PLATES.

 7) WHERE CONDUITS ARE SPECIFIED "TAAC" (TO ABOVE ACCESSIBLE CEILING) THIS SHALL MEAN THAT CONDUITS SHALL BE STUBBED INTO AN ACCESSIBLE CEILING CAVITY WITHIN THE SAME ROOM AS THE
- 8) WHERE DEVICE CONDUITS ARE SPECIFIED "TAHC" (TO ABOVE ACCESSIBLE HALLWAY/CORRIDOR CEILING) THIS SHALL MEAN THAT CONDUITS SHALL BE RUN CONTINUOUS AND STUBBED OUT INTO AN ACCESSIBLE CEILING CAVITY WITHIN THE NEAREST CORRIDOR FEATURING AN ACCESSIBLE CEILING CAVITY. SEE ALSO "DEFINITIONS."
- 9) CONDUIT INSTALLER SHALL INSTALL PULL STRINGS IN CONDUITS IMMEDIATELY AFTER INSTALLATION. THIS INCLUDES CONDUITS TARGETED FOR IMMEDIATE AND FUTURE USE.
- 10) WHERE A MOUNTING HEIGHT MEASUREMENT IS APPLIED TO A ROUGH-IN, THE MEASUREMENT SHALL BE REFERENCED TO THE CENTER OF THE ROUGH-IN DEVICE, EXCEPT WHERE OTHERWISE DETAILED,
- 11) ROUGH-IN BOXES SHALL BE INSTALLED FLUSH IN WALLS AND CEILINGS.
- 12) PATHWAYS SHALL BE INSTALLED CONCEALED MANNER. EXPOSED CONDUIT SHALL NOT BE PERMITTED IN FINISHED AREAS.
- 13) SURFACE MOUNT BACK BOXES AND MATCHING RACEWAY SHALL BE USED FOR COMMUNICATION TECHNOLOGY DEVICES THAT ARE NOT INSTALLED WITHIN A WALL OR CEILING
- 13) PROVIDE CODE-COMPLIANT FIRE-STOPPING FOR PATHWAYS THROUGH FIRE-RATED WALLS, FLOORS AND CEILINGS.
- ALL CONDUIT PROVIDED FOR COMMUNICATION TECHNOLOGY USE SHALL BE PROVIDED WITH NYLON END-BUSHINGS. BUSHINGS SHALL BE INSTALLED AT EACH END OF THE CONDUIT; AT EACH PULL/JUNCTION/DEVICE BOX; ON CONDUIT STUBS; AT EACH LOCATION WHERE PULLING CABLE THROUGH THE CONDUIT MAY CAUSE THE CABLE TO RUB AGAINST THE END OF A CONDUIT OR ITS END FITTING.
- DEVICES DESIGNATED WITH THE "CH" SUBSCRIPT (COUNTER HEIGHT) SHALL BE CLOSELY COORDINATED IN THE FIELD WITH ARCHITECT, CASEWORK AND FURNITURE VENDORS PRIOR TO
- CASEWORK TO ENSURE FUNCTIONAL CONNECTIVITY. COORDINATE WITH THE ARCHITECT AND THE EQUIPMENT AND CASEWORK DRAWINGS.

16) DEVICES TO BE INSTALLED AT CASEWORK LOCATIONS SHALL BE CLOSELY COORDINATED WITH THE

- 17) ROUGH-IN SHALL BE CLOSELY COORDINATED TO COMPLEMENT THE INTENDED FURNITURE PLAN AND TO ENSURE THE SAFE AND EFFICIENT CONNECTIVITY OF EQUIPMENT.
- 18) MANY COMMUNICATIONS DEVICES ARE INTENDED TO HAVE ADJACENT POWER OR INTEGRAL RECEPTACLES (MULTI-SERVICE) TO SERVE THE SAME EQUIPMENT. CLOSE PROXIMITY OF SEPARTE DEVICES IS CRITICAL FOR USABILITY AND AESTHETICS. COORDINATE THE LOCATION OF SEPARATE DEVICES SO THAT THEY ARE LOCATED ADJACENT AND AT THE SAME ELEVATION.
- 19) TELECOMMUNICATION DEVICE MOUNTING HEIGHT SHALL BE CONSISTENT WITH THE ELECTRICAL OUTLET MOUNTING HEIGHTS FOR THE FACILITY (NEW OR EXISTING) UNLESS OTHERWISE INDICATED ON DRAWINGS. CONTRACTOR SHALL SEEK THE DIRECTION OF THE DESIGNER/ARCHITECT/ENGINEER/CONSULTANT SHOULD DISCREPANCIES BE FOUND WITHIN THE DRAWINGS, SPECIFICATIONS AND
- CONDUITS STUBBED INTO THE CEILING CAVITY SHALL BE MARKED WITH AN INDELIBLE MARKER INDICATING THE CONDUIT'S INTENDED USE. MARK CONDUIT SO AS TO BE READABLE FROM BELOW. LABEL WITHIN 6 INCHES OF THE CONDUIT BUSHING. BELOW OF EXAMPLES OF LABELS TO BE USED. "CAMERA," "ICOM," "DOOR," "SPKR," "MIC," "CLOCK," "VOL," "PANEL," "WAP," "DATA," "PHONE," "COM," "RF," "VP," "INPUT," ETC.
- 21) WHERE SPECIFICATIONS AND/OR DRAWINGS INDICATE THE USE OF SURFACE RACEWAY AND BOXES IN LIEU OF RECESSED ROUGH-IN, THE BOX SIZE AND USABLE RACEWAY CABLE AREA SHALL SUBSTANTIALLY MATCH THAT OF THE DEFAULT STANDARD ROUGH-IN. IN SOME CIRCUMSTANCES THIS MAY REQUIRE THE CONTRACTOR TO PROCURE MATERIALS ONLY AVAILABLE BY SPECIAL ORDER FROM THE MANUFACTURERS.
- 22) LADDER RACK AND OTHER COMMUNICATION TECHNOLOGY CABLING PATHWAYS DEPICTED ON THE ENLARGED FLOOR PLANS SHALL BE PROVIDED AS INDICATED. ADDITIONAL PRODUCTS NECESSARY FOR PROFESSIONAL WIRE MANAGEMENT WITHIN THE MAIN EQUIPMENT ROOM <ER> AND ALL

TELECOMMUNICATION ROOMS <TR> SHALL BE ALSO BE PROVIDED AS NECESSARY.

PROVIDER. PROVIDE CONDUIT FROM THE ELEVATOR CONTROL PANEL TO THE CORRIDOR CEILING SPACE, UNLESS OTHERWISE INDICATED ON THE DRAWINGS.

24) COORDINATE THE TELEPHONE CONNECTION REQUIREMENTS FOR THE FIRE ALARM CONTROL PANEL

23) ELEVATOR TELEPHONE CONNECTIONS. SHALL BE CLOSELY COORDINATED WITH THE ELEVATOR

- (FACP) WITH THE FIRE ALARM INSTALLER. PROVIDE CONDUIT FROM THE FACP TO ACCESSIBLE CORRIDOR CEILING SPACE, UNLESS OTHERWISE INDICATED ON THE DRAWINGS.
- 25) COORDINATE DATA CABLING AND TERMINATION REQUIREMENTS FOR HVAC BUILDING AUTOMATION SYSTEM (BAS), WITH THE BAS PROVIDER.
- PROVIDE A MINIMUM OF TWO (2) 2-INCH DIAMETER THROUGH-THE-WALL CONDUIT SLEEVES FOR USE AS COMMUNICATION AND SECURITY CABLE PATHWAYS INTO EACH SPACE CONTAINING COMMUNICATION AND SECURITY DEVICES. ROUTE CONDUITS FROM ABOVE ACCESSIBLE CEILING TO THE NEAREST HALLWAY/CORRIDOR FEATURING AND ACCESSIBLE CEILING CAVITY.

GENERAL NOTES:

- 1) NOTHING SET FORTH IN THESE DRAWINGS SHALL RELEASE ANY CONTRACTOR FROM HIS RESPONSIBILITY TO PROVIDE APPROPRIATE QUANTITIES, FIELD MEASUREMENTS, DIMENSIONAL STABILITY, INSTALLATION, ANCHORAGE, AND COORDINATION WITH OTHER TRADES; OR RELEASE HIM FROM HIS RESPONSIBILITY TO IDENTIFY AND RESOLVE DEVIATIONS FROM THE REQUIREMENTS OF THE CONTRACT DOCUMENTS, OR FREE HIM OF HIS RESPONSIBILITY TO ALERT DESIGNER TO ERRORS OR OMISSIONS.
- 2) CONTRACTOR SHALL UTILIZE THESE DRAWINGS IN CONJUNCTION WITH THE SPECIFICATIONS TO DETERMINE THE FULL SCOPE, INTENT AND REQUIREMENTS OF THE PROJECT. SPECIFICATIONS AND DRAWINGS ARE INTENDED TO BE COMPLEMENTARY, NOT MUTUALLY EXCLUSIVE. WORK SHOWN ON THE DRAWINGS BUT NOT LISTED IN THE SPECIFICATIONS, AND WORK DESCRIBED IN THE SPECIFICATIONS BUT NOT SHOWN ON THE DRAWINGS SHALL BE INTERPRETED AS THOUGH WORK WERE FULLY DESCRIBED IN BOTH PLACES. THE HIGHER QUANTITY, HIGHER QUALITY, MORE LABOR INTENSIVE AND OVERALL MORE STRINGENT AND MORE COSTLY REQUIREMENT SHALL APPLY UNLESS OTHERWISE CLARIFIED IN WRITING PRIOR TO BID.
- 3) EACH CONTRACTOR SHALL VERIFY IN THE FIELD ALL EXISTING APPLICABLE CONDITIONS AND DIMENSIONS SHOWN ON THE DRAWINGS AND AS PERTINENT TO THE INTENT OF THESE DRAWINGS. ANY DISCREPANCY DISCOVERED SHALL BE BROUGHT TO THE ATTENTION OF THE DESIGNER PRIOR TO THE COMMENCEMENT OF ANY WORK AFFECTED BY, OR RELATED TO, SUCH DISCREPANCY. EACH CONTRACTOR SHALL BE RESPONSIBLE FOR ALL COSTS ASSOCIATED WITH, OR CAUSED BY HIS FAILURE TO COMPLY WITH THIS REQUIREMENT.
- 4) EACH CONTRACTOR SHALL REVIEW ALL PORTIONS OF HIS WORK, BEFORE STARTING THE WORK, TO VERIFY THAT THE WORK WILL NOT PROHIBIT COMPLETION OF THE PROJECT AS INTENDED IN THESE CONSTRUCTION DOCUMENTS. ALL QUESTIONS SHALL BE REFERRED TO THE DESIGNER FOR RESOLUTION
- 5) EACH CONTRACTOR SHALL BE RESPONSIBLE FOR JOB CLEANLINESS. PROJECT AREAS SHALL BE THOROUGHLY CLEANED AND TRASH DISPOSED OF AT THE END OF EACH WORK DAY. OWNER'S FACILITIES SHALL NOT BE USED FOR WASTE DISPOSAL.
- 6) PROVIDE DUST PROTECTION WHEN WORKING IN EXISTING FACILITIES. SEAL OFF ALL WORK AREAS FROM REMAINDER OF THE EXISTING FACILITY TO RETAIN ALL CONSTRUCTION DIRT AND DUST. SEAL EXISTING DOORS WITH TAPE AND PROVIDE DUST-PROOF BARRIERS AS REQUIRED.
- ALL WORK SHALL BE SEQUENCED TO PROVIDE FOR THE OWNER'S CONTINUED USE OF THE EXISTING FACILITY WHEN REQUIRED. OWNER'S ACCESS, EGRESS AND SAFETY SHALL BE MAINTAINED BY EACH CONTRACTOR. THE SEQUENCE OF WORK SHALL BE AS DETERMINED BY THE CONSTRUCTION
- MANAGER. REFER TO THE PROJECT MANUAL FOR FURTHER REQUIREMENTS.

 8) EACH CONTRACTOR SHALL BE RESPONSIBLE FOR PROTECTION OF ALL SURFACES AND FINISHES IN THE INTERIOR OR EXTERIOR OF THE FACILITY. DAMAGED SURFACES OR FINISHES RESULTING FROM THE PERFORMANCE OF THE WORK OR NEGLIGENCE SHALL BE REPAIRED AT NO COST TO THE OWNER BY THE RESPONSIBLE CONTRACTOR. FINISHES AND SURFACES SHALL BE MADE TO MATCH THE EXISTING FINISHES OR SURFACES TO THE SATISFACTION OF THE OWNER AND ARCHITECT/
- 9) "TECHNOLOGY" CONTRACTOR SHALL BE RESPONSIBLE FOR MAINTAINING TELEPHONE, DATA, CENTRAL SOUND, SECURITY CCTV AND ALARM SYSTEM SERVICES IN ALL EXISTING AREAS FOR DURATION OF PROJECT FOR MULTI-PHASED PROJECTS. CONTRACTOR SHALL COLLABORATE WITH OWNER'S TECHNOLOGY PERSONNEL AS NECESSARY AND PROVIDE TEMPORARY WIRING, CROSS-CONNECTS, TERMINATION DEVICES, AND LABOR TO MAINTAIN OPERATION ACCEPTABLE TO THE OWNER. CONTRACTOR SHALL REFER TO THE FRONT END DOCUMENTS OF THE SPECIFICATIONS FOR ADDITIONAL INFORMATION RELATED TO PHASING. ALL PHASING QUESTIONS SHALL BE ADDRESSED
- 10) EACH CONTRACTOR SHALL FIELD VERIFY ALL EXISTING APPLICABLE CONDITIONS AND DIMENSIONS SHOWN ON THE DRAWINGS. AS PERTAINS TO THE INTENT OF THESE DRAWINGS, CONTRACTOR SHALL BRING TO THE ATTENTION OF THE ARCHITECT AND DESIGNER ANY DISCREPANCIES DISCOVERED PRIOR TO THE COMMENCEMENT OF ANY WORK AFFECTED BY OR RELATED TO SUCH DISCREPANCY. EACH CONTRACTOR SHALL BE RESPONSIBLE FOR ALL COSTS ASSOCIATED WITH OR CAUSED BY THAT CONTRACTOR'S FAILURE TO COMPLY WITH THIS REQUIREMENT.

GENERAL CABLING NOTES:

CONSTRUCTION MANAGER.

- 1) ALL PROVIDED CABLE SHALL BE RATED FOR THE ENVIRONMENT INSTALLED.
- 2) ALL INSTALLED CABLING SHALL BE CONTINUOUS AND WITHOUT SPLICES, EXCEPT WHERE OTHERWISE NOTED.
- "ABOVE ACCESSIBLE CEILING" SHALL BE INTERPRETED TO GENERALLY MEAN THE ACCESSIBLE CAVITY ABOVE SUSPENDED CEILING AND BENEATH THE DECK/FLOOR ABOVE. CONDUITS STUBBED ABOVE ACCESSIBLE CEILING SHALL TERMINATE IN A LOCATION IN WHICH A NORMAL HEIGHT PERSON CAN VIEW AND ACCESS WITHOUT STRAIN WHILE STANDING UPRIGHT ON A LADDER OR OTHER VERTICAL LIFT DEVICE,
- 4) COLOR CODING OF CABLING SHALL BE COORDINATED AND APPROVED PRIOR TO PROCUREMENT AND INSTALLATION.
- 5) ALL CABLE IN EXPOSED CEILINGS SHALL BE IN CONDUIT.

PRIOR TO THE CONTRACTOR'S BID SUBMISSION.

SLEEVE AND FIRE-STOPPING NOTES:

- ALL PENETRATIONS THROUGH BUILDING STRUCTURE (WALL AND/OR FLOORS) FOR COMMUNICATIONS
 CABLING SHALL BE SLEEVED.
- 2) ALL SLEEVES THROUGH WALLS OR FLOORS HOLDING A FIRE RATING SHALL BE INSTALLED UTILIZING ONE OF THE APPROVED METHODS FOR A UL LISTED ASSEMBLY.
- 3) APPROVED MANUFACTURERS FOR UL LISTED SLEEVES SHALL BE SPECIFIED TECHNOLOGY SYSTEMS, UNIQUE FIRESTOP PRODUCTS, AND WIREMOLD.
- 4) ALL SLEEVES THROUGH FLOORS SHALL BE FIRESTOPPED TO A RATING EQUAL TO OR HIGHER THAN
- 5) ALL UN-USED SLEEVES THROUGH WALLS OR FLOORS HOLDING A FIRE RATING SHALL BE FIRESTOPPED TO A RATING EQUAL TO OR HIGHER THAN THE WALL OR FLOOR RATING.
- ALL SLEEVES THROUGH WALLS HOLDING A FIRE RATING SHALL BE FIRESTOPPED TO A RATING EQUAL TO OR HIGHER THAN THE WALL RATING.
- 7) ALL PENETRATIONS SHALL BE PART OF THE RE-USABLE PATHWAY SYSTEM; FIRESTOPPED PENETRATIONS SHALL EITHER BE AN ASSEMBLY WITH FIRESTOP MATERIALS BUILT INTO THE ASSEMBLY OR FIRESTOPPED WITH REMOVABLE PUTTY OR FIRESTOP BAGS.

AUDIO-VISUAL SYSTEMS **VOICE AND DATA OUTLET WITH LOCAL INPUT** X = QUANTITY OF (4) PAIR VOICE/DATA CABLES (MIN. 1 VOICE AND 1 DATA CABLE WITHOUT SUBSCRIPT) LI = FUTURE LOCAL INPUT CABLING TO A VIDEO PROJECTOR, TELEVISION, ETC DATA OUTLET WITH LOCAL INPUT X = QUANTITY OF (4) PAIR DATA CABLES (MIN. 2 DATA CABLE WITHOUT SUBSCRIPT) I = FUTURE LOCAL INPUT CABLING TO A VIDEO PROJECTOR, TELEVISION, ETC. VIDEO PROJECTOR CEILING MOUNTED - NETWORK QUANTITY OF TWQ - (4) PAIR DATA CABLES THIS OUTLET WILL ALSO ACCEPT CABLING FROM LOCAL INPUT LOCATIONS Y = MODEL VIDEO PROJECTOR WALL MOUNTED UANTITY OF TWO - (4) PAIR DATA CABLES - THIS OUTLET WILL ALSO ACCEPT LOCAL INPUT CABLES ′ = MODEL FLAT PANEL DISPLAY CEILING MOUNTED - NETWORK QUANTITY OF TWO - (4) PAIR DATA CABLES -THIS OUTLET WILL ALSO ACCEPT LOCAL INPUT CABLES Y = MODEL FLAT PANEL DISPLAY WALL MOUNTED - NETWORK QUANTITY OF TWO - (4) PAIR DATA CABLES - THIS OUTLET WILL ALSO ACCEPT LOCAL INPUT CABLES Y= MODEL / HEIGHT = 60" (UNLESS OTHERWISE NOTES) AUDIO VIDEO (A/V) OUTLET X = SYSTEM Y = MODEL SEE SYTEM DETAILS FOR CONNECTIVITY REQUIREMENTS MICROPHONE INPUT – WALL MOUNT SEE SYTEM DETAILS FOR CONNECTIVITY REQUIREMENTS MICROPHONE INPUT – CEILING MOUNT SEE SYTEM DETAILS FOR CONNECTIVITY REQUIREMENTS SYSEM SPEAKER - RECCESSED CEILING MOUNTED $I \times = SYSTEM$ Y= MODEL **SYSTEM SPEAKER - WALL MOUNTED** X = SYSTEM Y = MODEL SYSTEM SPEAKER - PENDANT MOUNTED X = SYSTEM Y = MODEL SYSTEM SPEAKER - CEILING MOUNTED X = SYSTEM Y = MODEL A/V CONTROL PANEL X = SYSTEMY = TYPE SEE SYTEM DETAILS FOR CONNECTIVITY REQUIREMENTS INTERACTIVE WHITE BOARD A/V SYSTEM CONTROL PANEL

<u> </u>								
	SECURITY/LIFE SAFETY							
Y CAM	VIDEO SURVEILLANCE CAMERA OUTLET WALL MOUNTED QUAINTY OF ONE - (4) PAIR DATA CABLE (UNLESS OTHERWISE NOTED) Y = CAMERA TYPE							
Y CAM	VIDEO SURVEILLANCE CAMERA OUTLET CEILING MOUNTED QUAINTY OF ONE - (4) PAIR DATA CABLE (UNLESS OTHERWISE NOTED) Y = CAMERA TYPE							
CAM	VIDEO SURVEILLANCE CAMERA OUTLET EXTERIOR WALL QUAINTY OF ONE - (4) PAIR DATA CABLE (UNLESS OTHERWISE NOTED) Y = CAMERA TYPE							
SECURE DOOR DENOTES A DOOR WITH CONNECTIVITY FOR STATUS SENSOR(S) AND LOC AND UN-LOCKING CAPABILITIES. X - WHERE UTILIZED WILL BE DEFINED ON SYSTEM DIAGRAM								
DS	DOOR STATUS SENSOR DOOR STATUS SENSOR ALLOWS DOOR MONITORING WITH OR WITHOUT LOCKING PROVISIONS CABLE AS REQUIRED BY SYSTEM							
DR H	DOOR RELEASE DOOR RELEASE SWITCH ALLOWS MANUAL ACTUATION OF AN ELEC. DOOR LOCK. CABLE AS REQUIRED BY SYSTEM							
KP	KEYPAD KEYPAD UTILIZED TO ACTUATE ACCESS TO A SECURE DOOR. CABLE AS REQUIRED BY SYSTEM							
CR	PROXIMITY CARD READER QUANTITY ONE – (4) PAIR DATA CABLE Y = MODEL MAY BE A COMBINATION KEYPAD AND READER; SEE SPECIFICATION.							
PS H	PANIC (DURESS) SWITCH SWITCH UTILIZED TO MANUALLY ACTUATE ALARM AND/OR ACCESS CONTROL SYSTEM.							
ЕНО	ELECTRONIC HOLD OPEN CABLE AS REQUIRED BY SYSTEM							
	ELECTRIC DOOR LOCK/STRIKE REQUIRES 120V POWER							
X SM	SECURITY MONITOR ONE DATA CABLE, PLUS OTHER SPECIAL A/V CABLES AS REQUIRED BY SYSTEM X = TYPE							

DISTRIBUTED SYSTEMS SPEAKER – SUSPENDED CEILING MOUNTED CABLE AS REQUIRED BY SYSTEM V = INTREGAL VOLUME CONTROL Y = MODEL SPEAKER - SOLID CEILING MOUNTED CABLE AS REQUIRED BY SYSTEM V = INTREGAL VOLUME CONTROL Y = MODEL SPEAKER, WALL TYPE CABLE AS REQUIRED BY SYSTEM Y = MODEL SPEAKER, PENDANT CABLE AS REQUIRED BY SYSTEM Y = MODEL SPEAKER, VOLUME CONTROL CABLE AS REQUIRED BY SYSTEM P = PRIORITY OVERRIDE OPTION SPEAKER, HORN TYPE CABLE AS REQUIRED BY SYSTEM HH. Y = MODELVIDEO INTERCOM CALL STATION QUANTITY ONE - (4) PAIR DATA CABLE ACCESS CONTROL SYSTEMS CABLE TO DOOR CONTROLER VIDEO INTERCOM MASTER STATION QUANTITY ONE - (4) PAIR DATA CABLE ACCESS CONTROL SYSTEMS CABLE TO DOOR CONTROLER CLOCK - BATTERY TYPE WALL CLOCK; 12" DIAMETER, UNLESS OTHERWISE NOTED WG = PROVIDE WITH ACCESSORY WIRE GUARD CLOCK - BATTERY TYPE WG = PROVIDE WITH ACCESSORY WIRE GUARD WALL CLOCK; 12" DIAMETER, UNLESS OTHERWISE NOTED DOUBLE SIDED LED CLOCK – CEILING MOUNTED QUANTITY OF ONE - (4) PAIR DATA CABLE PER CLOCK Y = MODELLED CLOCK QUANTITY OF ONE - (4) PAIR DATA CABLE PER CLOCK Y = MODELDOUBLE SIDED LED CLOCK - WALL MOUNTED QUANTITY OF ONE - (4) PAIR DATA CABLE PER CLOCK Y = MODEL

	TELECOMMUNICATIONS
	VOICE OUTLET; STANDARD
▼ ×	X = QUANTITY OF - (4) PAIR VOICE CABLES CABLE WITHOUT SUBSCRIPT)
▼ X	B = BLANK COVER, NO CONNECTORS OR CABLE
Y	
W	VOICE OUTLET; WALL MOUNTED TELEPHONE
w T	QUANTITY OF ONE - (4) PAIR VOICE CABLES CABLE WITHOUT SUBSCRIPT)
	VOICE AND DATA CULTIFIC STANDARD
×	VOICE AND DATA OUTLET; STANDARD
× I	X = QUANTITY OF (4) PAIR VOICE/DATA CABLES (MIN. 1 VOICE AND 1 DATA CABLES (MIN. 1 VOICE AND 1
lacksquare	B = BLANK COVER, NO CONNECTORS OR CABLE
X — F	VOICE AND DATA OUTLET IN OFFICE FURNITURE
X X X F	X = QUANTITY OF (4) PAIR VOICE/DATA CABLES (MIN. 1 VOICE AND 1 DATA CAB
X,_F	WITHOUT SUBSCRIPT)
	F = FURNITURE MOUNTED
X	DATA OUTLET; STANDARD
xY V	X = QUANTITY OF (4) PAIR DATA CABLES (MIN. 1 DATA CABLE WITHOUT SUBSCRIPT)
Y	Y = (B) BLANK COVER: (CH) COUNTER HEIGHT
	WIRELESS LAN ACCESS POINT OUTLET WALL MOUNTED
WAP	QUANTITY OF TWO - (4) PAIR DATA CAT6A CABLES
Y	(),,,,,,,,,,,,,,,,,,,,,,,,,,,,,,,,,,,,,
Y	
WAP	WIRELESS LAN ACCESS POINT OUTLET CEILING MOUNTED
	QUANTITY OF TWO - (4) PAIR DATA CAT6A CABLES
\V/	
χ_Pos	POINT OF SALE DATA OUTLET
\ /	X = QUANTITY OF (4) PAIR VOICE/DATA CABLES (MIN. 1 DATA CABLE WITHOUT
χ POS	SUBSCRIPT)
Y	SEE SYSTEM DIAGRAM FOR ADDITIONAL CABLING REQUIREMENTS
	ABOVE CEILING OUTLET
× 🗪	X = QUANTITY OF (4) PAIR DATA CABLES (MIN. 1 DATA CABLE WITHOUT
$\langle \nabla \rangle$	SUBSCRIPT)
D.10	
BAS	
BAS	QUANTITY OF TWO - (4) PAIR DATA CABLES
∇	COORDIATE OUTLET LOCATION WITH BUIDLING CONTROLS CONTRACTOR
_ FACF	FIRE ALARM CONTROL PANEL
▼	QUANTITY OF TWO - (4) PAIR DATA CABLES
FACP	
<u> </u>	COORDINATE OUTLET LOCATION WITH FIRE ALARM CONTRACTOR
ELE\	
ELEV	QUANTITY OF TWO - (4) PAIR DATA CABLES
lacksquare	COORDINATE OUTLET LOCATION WITH ELEVATOR CONTRACTOR
EMER	
T EIVIER	QUANTITY OF ONE - (4) PAIR VOICE CABLES (UNLESS OTHERWISE NOTED)
EMER	GOVERNMENT OF ONE (4) FAIR VOICE CABLES (SINCESS OFFICIALISE NOTED)
lacksquare	COORDINATE OUTLET LOCATION WITH SECURITY SYSTEM CONTRACTOR
2 SP	SECURITY ALARM PANEL OUTLET
	QUANTITY OF TWO - (4) PAIR DATA CABLES
•	1
2 SP	COORDINATE OUTLET LOCATION WITH SECURITY SYSTEMS CONTRACTOR

SCOPE OF WORK "T" SERIES DRAWINGS BEING ISSUED FOR SCOPE AND COORDINATION. THE SOUND AND SECURITY SYSTEMS TO PART OF A LATER BID PACKAGE. THE ELECTRICAL CONTRACTOR IS RESPONSIBLE FOR PROVIDING ALL OUTLET / JUNCTION BOXES, CONDUITS AND RACEWAY FOR ALL LOW VOLTAGE SYSTEMS. THIS WORK IS DEPICTED ON THE "E" AND "T" FOR COORDINATION PURPOSES, OCCASSIONALLY AN ITEM OF WORK MAY BE SHOWN ON THE E SERIES DRAWINGS AND THE T SERIES DRAWINGS. IN ADDITION, THE SAME WORK MAY BE INCLUDED ON MULTIPLE T SERIES DETAIL SHEETS FOR SIMILAR REASONS. REQUEST A CLARIFICATION FOR ANY ITEMS THAT APPEAR UNCLEAR AS TO QUANTITY OR CONTRACT RESPONSIBILITY. EXAMPLE: ELECRICAL DEVICES ARE SHOWN ON T SERIES DETAIL SHEETS FOR COORDINATION AND SPACING PURPOSES: THE ELECTRICAL OUTLETS AND POWER EQUIPMENT IS THE RESPONSIBILITY OF DIVISION 26. LIKEWISE, SOME TELECOMMUNICATIONS CONDUITS APPEAR ON E SERIES SHEETS FOR SPACE COORDINATION; TELECOMMUNICATIONS PATHWAY AND SPACES ARE COVERED UNDER DIVISION 27. REFER TO DIVISION 26 AND DIVISION 27 SPECIFICATIONS FOR ADDITIONAL INFORMATION. NO LOW VOLTAGE CABLING SHALL RUN EXPOSED IN AREAS OF THE BUILDING THAT DO NOT HAVE CEILINGS (I.E. GYMNASIUMS, LOCKER ROOMS, ETC.)- ALL CONDUITS RUN TO NEAREST ACCESSIBLE CEILING SPACE. **LEGEND NOTES** BASE SYMBOLS ARE UTILIZED TO REFERENCE THE FLOORPLAN LOCATION AND PROPER ROUGH-IN REQUIREMENTS. WHERE SUBSCRIPTS ARE USED WITH THESE SYMBOLS. THEY MODIFY THE REQUIREMENTS ROUGH-IN REQUIREMENTS CAN BE FOUND ON THE "T-7XX" SERIES DRAWINGS. PRIOR TO INSTALLATION OF ROUGH-IN, VERIFY ROUGH-IN SIZE REQUIREMENTS WITH DEVICE SUPPLIER: INCREASE SIZE OF BOX, AS REQUIRED TO ACCOMMODATE THE QUANTITY AND SIZE OF CONDUITS ENTERING (4) ALL 1-GANG AND 2-GANG ROUGH-IN BOXES, RECESS/FLUSH MOUNTED, SHALL BE ASSEMBLED FROM 4" SQUARE BOXES AND SEPARATE TRIM RINGS. DEPTH OF COMPOSITE ASSEMBLY SHALL AS INDICATED,

AVAILABLE BY SPECIAL ORDER FROM THE MANUFACTURERS.

THE PATHWAY TO BE ACCESSIBLE AND REUSABLE.

TYPE AND COLOR AND MOUNTED AT THE SAME HEIGHT.

NOTED. (1D. 1V IS THE SAME AS 2 CABLES).

INSTALLATION

IN APPLICATIONS WHERE THE DRAWINGS AND/OR SPECIFICATIONS REQUIRE THE USE OF SURFACE

LEGEND. CONTRACTOR IS ADVISED THAT THIS MAY REQUIRE PROCUREMENT OF MATERIALS ONLY

COLOR CODING OF CABLING SHALL BE COORDINATED AND APPROVED PRIOR TO PROCUREMENT AND

(8) SYMBOLS AND SUBSCRIPTS MAY DISTINGUISH BETWEEN VOICE (V) AND DATA (D) INTENDED USES.

SYMBOL'S PLACED ON EXTERIOR WALLS WITH A "WP" SUBSCRIPT SHALL BE INSTALLED WITH

(10) WHERE A TELECOMMUNICATIONS OUTLET LOCATION IS ADJACENT TO AN ELECTRICAL OUTLET, THE

WEATHERPROOF HOUSINGS AND THE ROUGH-IN SEALED FROM MOISTURE INGRESS.

RACEWAY AND BOXES IN LIEU OF CONCEALED ROUGH-IN, CONTRACTOR SHALL MATCH THE SIZE OF THE BOX

LISTED ON THE LEGEND: SHALL MATCH THE QUANTITY OF USABLE RACEWAYS: AND SHALL MATCH THE

WHERE FIELD CONDITIONS INVOLVE INACCESSIBLE AREAS THE ROUGH-IN SHALL BE MODIFIED TO ALLOW

MATERIALS AND INSTALLATION FOR VOICE AND DATA USES SHALL BE IDENTICAL UNLESS SPECIFICALLY

MOUNTING HEIGHT WILL BE THE SAME FOR EACH. WHERE MULTIPLE TELECOMMUNICATIONS ARE ADJACENT

(SUCH AS TELECOMMUNICATIONS AND SOUND DEVICES, FACEPLATES SHALL BE COORDINATED TO THE SAME

USABLE RACEWAY CABLE AREA SUBSTANTIALLY, TO QUANTITY AND SIZES OF RACEWAYS LISTED ON THE

	PATHWAY AND SPACES DEVICES
<u> </u>	TELECOMMUNICATION WALL LINING (BACKBOARD)
	8' TALL, 4' WIDTH 3/4" AC PLYWOOD; CUT TO FIT SPACE AS SHOWN PAINTED WITH FIRE RETARDANT WHITE PAINT
$m{m{m{m{m{m{m{m{m{m{m{m{m{$	LADDER RACK
	SIZE AS INDICATED
Ħ	8' MOUNTING HEIGHT WHEN HORIZONTAL, UON
•	FIRE RATED SLEEVE THROUGH WALL
4"	4" DIAMETER UNLESS OTHERWISE NOTED; PROVIDE FIRE STOPPING; ROUTE FROM ROOM TO ACCESSIBLE CEILING NOTE: PROVIDE WATERFALL DEVICE WHEN CABLE DROP IS GREATER THAN 6'
	SLEEVE THROUGH WALL
Н	2" DIAMETER UNLESS OTHERWISE NOTED; PROVIDE FIRE STOPPING; ROUTE FROM ACCESSIBLE CEILING TO ACCESSIBLE CEILING NOTE; NOT ALL SLEEVES WILL BE SHOWN, ONLY ADDITIVE INSTANCES REQUIRED TO ACHIEVE DESIGN GOALS
	FIRE RATED SLEEVE THROUGH FLOOR
\bigcirc	4" DIAMETER UNLESS OTHERWISE NOTED; PROVIDE FIRE STOPPING; ROUTE FROM ROOM TO ACCESSIBLE CEILING NOTE: PROVIDE WATERFALL DEVICE WHEN CABLE DROP IS GREATER THAN 6"
	POKE-THRU – FIRE RATED DEVICE
\odot	SEE ELECTRICAL DRAWINGS FOR POKE-THRU SIZE AND TYPE
•	ADJACENT SYMBOL DENOTES CABLING REQUIREMENTS MODIFIED TO FIT BOX
	FLOOR BOX – FLUSH TO FINISHED FLOOR
\odot	SEE ELECTRICAL DRAWINGS FOR FLOORBOX SIZE AND TYPE
	ADJACENT SYMBOL DENOTES CABLING REQUIREMENTS MODIFIED TO FIT BOX
	FURNITURE WHIP - WALL
_ W	FURNITURE WHIP FROM FIRE RATED POKE THROUGH DEVICE X = [WHERE X REPRESENTS A-C] POKE-THRU SIZE AND TYPE
\odot	
	1 1/4" WHIP FITTING MINIMUM
	TELEPOWER POLE
PP	ADJACENT SYMBOL DENOTES CABLING REQUIREMENTS MODIFIED TO FIT BOX
	JUNCTION/PULL BOX – WALL MOUNTED
J	SIZE AS NOTED OR CALCULATED BY QUANTITY AND SIZE OF CONDUITS
P	NOTE; ALL BOXES SHALL BE MOUNTED SO AS TO ALLOW RE-ENTRY IN A SAFE MANNER
\bigcirc	JUNCTION/PULL BOX – FLOOR MOUNTED
(J)	SIZE AS NOTED OR CALCULATED BY QUANTITY AND SIZE OF CONDUITS
P	NOTE; ALL BOXES SHALL BE MOUNTED SO AS TO ALLOW RE-ENTRY IN A SAFE MANNER
$\overline{\langle \mathcal{I} \rangle}$	JUNCTION/PULL BOX – CEILING MOUNTED
(J)	Toller Ad Moter of additional Attention of the Attention
	SIZE AS NOTED OR CALCULATED BY QUANTITY AND SIZE OF CONDUITS



CROWN POINT COMMUNITY SCHOOL CORPORATION CROWN POINT, INDIANA

GIBRALTAR DESIGN

9102 N. Meridian St., Ste. 300 Indianapolis, IN 46260 Homepage www.GibraltarDesign.com Email info@GibraltarDesign.com Phone 317.580.5777 Fax 317.580.5778

PROJECT
21-113
DATE
1/31/22
COORDINATED BY
BKS
DRAWN BY
TKP
CHECKED BY

PROJECT

21-113
Brian K Scott
BICSI ID # 114038
EXPIRES 12-31-24

RCDD

CHECKED BY
BKS

COPYRIGHT NOTICE:

THE CONCEPTS, DESIGNS, PLANS, DETAILS, ETC, SHOWN ON THIS DOCUMENT ARE THE PROPERTY OF GIBRALTAR DESIGN AND WERE CREATED FOR USE ON THIS SPECIFIC PROJECT. NONE OF THIS INFORMATION SHALL BE USED BY ANY PERSON OR FIRM FOR ANY PURPOSE WITHOUT THE EXPRESS WRITTEN CONSENT OF GIBRALTAR DESIGN. THE OWNER MAY RETAIN COPIES FOR INFORMATION AND REFERENCE IN CONNECTION ONLY WITH THIS PROJECT.

MARK DATE ISSUED FOR
AD-3 2/23/2022 Addendum 3

DRAWING
TELECOMMUNICATIONS
LEGEND

PROJECT
CROWN POINT MACARTHUR ES
ADDITIONS AND RENOVATIONS

SHEET

T001

GENERAL DEMOLITION NOTES:

1 THE CONTRACT DOCUMENTS DO NOT PROPOSE TO SHOW ALL SYSTEMS, MATERIALS, OR EQUIPMENT EXISTING ON THE PROJECT THAT WILL REQUIRE DEMOLITION. DEMOLITION DRAWINGS ARE BASED ON PARTIAL FIELD OBSERVATION. REPORT DISCREPANCIES TO THE CONSULTANT BEFORE DISTURBING EXISTING INSTALLATION.

AND STORE AS DIRECTED BY THE OWNER.

2 REMOVE ALL ABANDONED CABLING AS DEFINED BY THE NEC. ALL REMOVED TECHNOLOGY AND / OR SECURITY DEVICE TO BE

INVENTORIED AND TURNED OVER TO THE OWNER. PROTECT

- 4 IDENTIFY ITEMS TO BE SALVAGED WITH THE OWNER. PROVIDE NON-DESTRUCTIVE REMOVAL OF SYSTEMS, MATERIALS, AND EQUIPMENT FOR REUSE OR SALVAGE AS INDICATED.
- 5 REMOVE ALL COMMUNICATIONS DEBRIS FROM SITE AND LEGALLY DISPOSE OF IT.
- 6 COORDINATE ALL LOW VOLTAGE DEMO ACTIVITY WITH CONSTRUCTION MANAGER, REVIEW DEMO PHASING PLANS.
- 7 CONTRACTOR UNDERSTANDS THAT ADJACENT AREAS NEED TO REMAIN IN OPERATION AND THAT SERVICES TO THESE AREAS NEED TO BE MAINTAINED.
- 8 CONTRACTOR SHALL NOTIFY THE OWNER AND CONSULTANT NO LESS THAN THREE DAYS IN ADVANCE BEFORE COMMENCING ANY DEMOLITION TO INSURE THAT NO ADJACENT OCCUPIED AREAS WILL BE DISRUPTED.
- 9 FIRE STOP ANY SLEEVES WHERE CABLES HAVE BEEN REMOVED.
- 10 CONTRACTOR SHALL BE RESPONSIBLE FOR MAINTAINING TELEPHONE, DATA, CENTRAL SOUND, SECURITY CCTV AND ALARM SYSTEM SERVICES IN ALL EXISTING AREAS FOR DURATION OF PROJECT FOR MULTI-PHASED PROJECTS. CONTRACTOR SHALL COLLABORATE WITH OWNER'S TECHNOLOGY PERSONNEL AS NECESSARY AND PROVIDE TEMPORARY WIRING, CROSS-CONNECTS, TERMINATION DEVICES, AND LABOR TO MAINTAIN OPERATION ACCEPTABLE TO THE OWNER. CONTRACTOR SHALL REFER TO THE SPECIFICATIONS FOR ADDITIONAL INFORMATION RELATED TO

DEMOLITION NOTES:

- (ALL DEMOLITION NOTES MAY NOT BE USED ON THIS SHEET.)
- EXISTING TELECOMMUNICATION OUTLET(S) TO BE REMOVED. REMOVE CABLE BACK TO THE SOURCE. IF OUTLET(S) ARE IN SURFACE RACEWAY REMOVE SURFACE RACEWAY.
- EXISTING WIRELESS ACCESS POINT(S) TO BE REMOVED. REMOVE CABLE BACK TO THE SOURCE. SECURELY STORE IN A LOCATION DESIGNATED BY OWNER.
- 3 EXISTING DATA CABINET TO BE REMOVED. REMOVE FIBER CABLING ASSOCIATED WITH DATA CABINET BACK TO THE SOURCE.
- 4 EXISTING CLOCK TO BE REMOVED. SECURELY STORE IN A
- LOCATION DESIGNATED BY OWNER.
- EXISTING INTERCOM SPEAKER TO BE REMOVED. EXISTING MAIN INTERCOM CABINET, TO REMAIN IN SERVICE
- UNTIL AREA IS DEMO'D. WHEN AREA IS READY TO BE DEMO'D REMOVE INTERCOM CABINET AND FOR ANY INTERCOM SPEAKERS THAT NEED TO REMAIN IN SERVICE IN OTHER
- AREAS WAITING FOR DEMO PULL THE EXISTING SPEAKERS BACK TO THE NEAREST NEW TELECOM ROOM. EXISTING AUDIO/VIDEO SYSTEMS AND DEVICES
- (PROJECTOR, TELEVISION, INTERACTIVE BOARD), AND RELATED MOUNTS AND CABLING, ETC. TO BE REMOVED. SECURELY STORE IN A LOCATION DESIGNATED BY OWNER. NOTE - MOST OF THE CLASSROOM PROJECTORS ARE SITTING ON PORTABLE
- EXISTING SECURITY DEVICES (CAMERAS, CARD READER, CONTROLLER, DOOR INTERCOM ETC.) AND RELATED MOUNTS TO BE REMOVED. REMOVE CABLE BACK TO THE SOURCE.
 - EXISTING SECURITY CAMERA(S) TO REMAIN. CEILING MOUNTED UNITS SHALL BE DISCONNECTED FROM CEILING TILE AND TEMPORARILY SUPPORTED TO STRUCTURE ABOVE
- 10 EXISTING INTERCOM SPEAKER(S) TO REMAIN. DISCONNECT FROM CEILING TILE AND PROVIDE TEMPORARY ABOVE CEILING SUPPORT. (TYPICAL)
- 11 EXISTING WIRELESS ACCESS POINT TO REMAIN. DISCONNECT FROM CEILING TILE AND PROVIDE TEMPORARY ABOVE CEILING SUPPORT. REMOVE THE ABANDONED CABLE TO CABINETS AFTER CUT-OVER TO NEW CABLING.
- 12 EXISTING SECURITY DEVICES (CARD READER, CONTROLLER, DOOR INTERCOM ETC.) TO REMAIN IN SERVICE AND/OR BE RELOCATED INTO NEW DOOR FRAMES.
- 13 EXISTING INCOMING WAN FIBER SERVICE TO REMAIN UNTIL NEW MDF IS BUILT. OWNER IS RESPONSIBLE TO ARRANGE WITH SERVICE PROVIDER TO HAVE THE FIBER RELOCATED.




GIBRALTAR

DESIGN ARCHITECTURE • ENGINEERING • INTERIOR DESIGN

DOUGLAS MACARTHUR **ES ADDITIONS** AND

RENOVATIONS

CROWN POINT COMMUNITY SCHOOL CORPORATION CROWN POINT, INDIANA

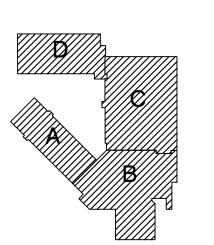

FIRST FLOOR KEY PLAN GIBRALTAR DESIGN

9102 N. Meridian St., Ste. 300 Indianapolis, IN 46260 Homepage www.GibraltarDesign.com Email info@GibraltarDesign.com

Phone 317.580.5777 Fax 317.580.5778 PROJECT 01/31/22 COORDINATED B

DRAWN BY

CHECKED BY

TKP

Bicsi Brian K Scott BICSI ID # 114038 EXPIRES 12-31-24

BKS COPYRIGHT NOTICE: THE CONCEPTS, DESIGNS, PLANS, DETAILS, ETC, SHOWN ON THIS DOCUMENT ARE THE PROPERTY OF GIBRALTAR DESIGN AND WERE CREATED FOR USE ON THIS SPECIFIC PROJECT. NONE OF THIS INFORMATION SHALL BE USED BY ANY PERSON OR FIRM FOR ANY PURPOSE WITHOUT THE EXPRESS WRITTEN CONSENT OF GIBRALTAR DESIGN. THE OWNER MAY RETAIN COPIES FOR INFORMATION AND REFERENCE IN CONNECTION ONLY WITH THIS PROJECT


MARK DATE ISSUED FOR AD 2 2/17/22 ADDENDUM 2 AD 3 2/23/22 ADDENDUM 3

> **OVERALL TELECOMMUNICATIONS** FIRST FLOOR DEMO PLAN

CROWN POINT MACARTHUR ES ADDITIONS AND RENOVATIONS

© GIBRALTAR DESIGN SHEET

TD100

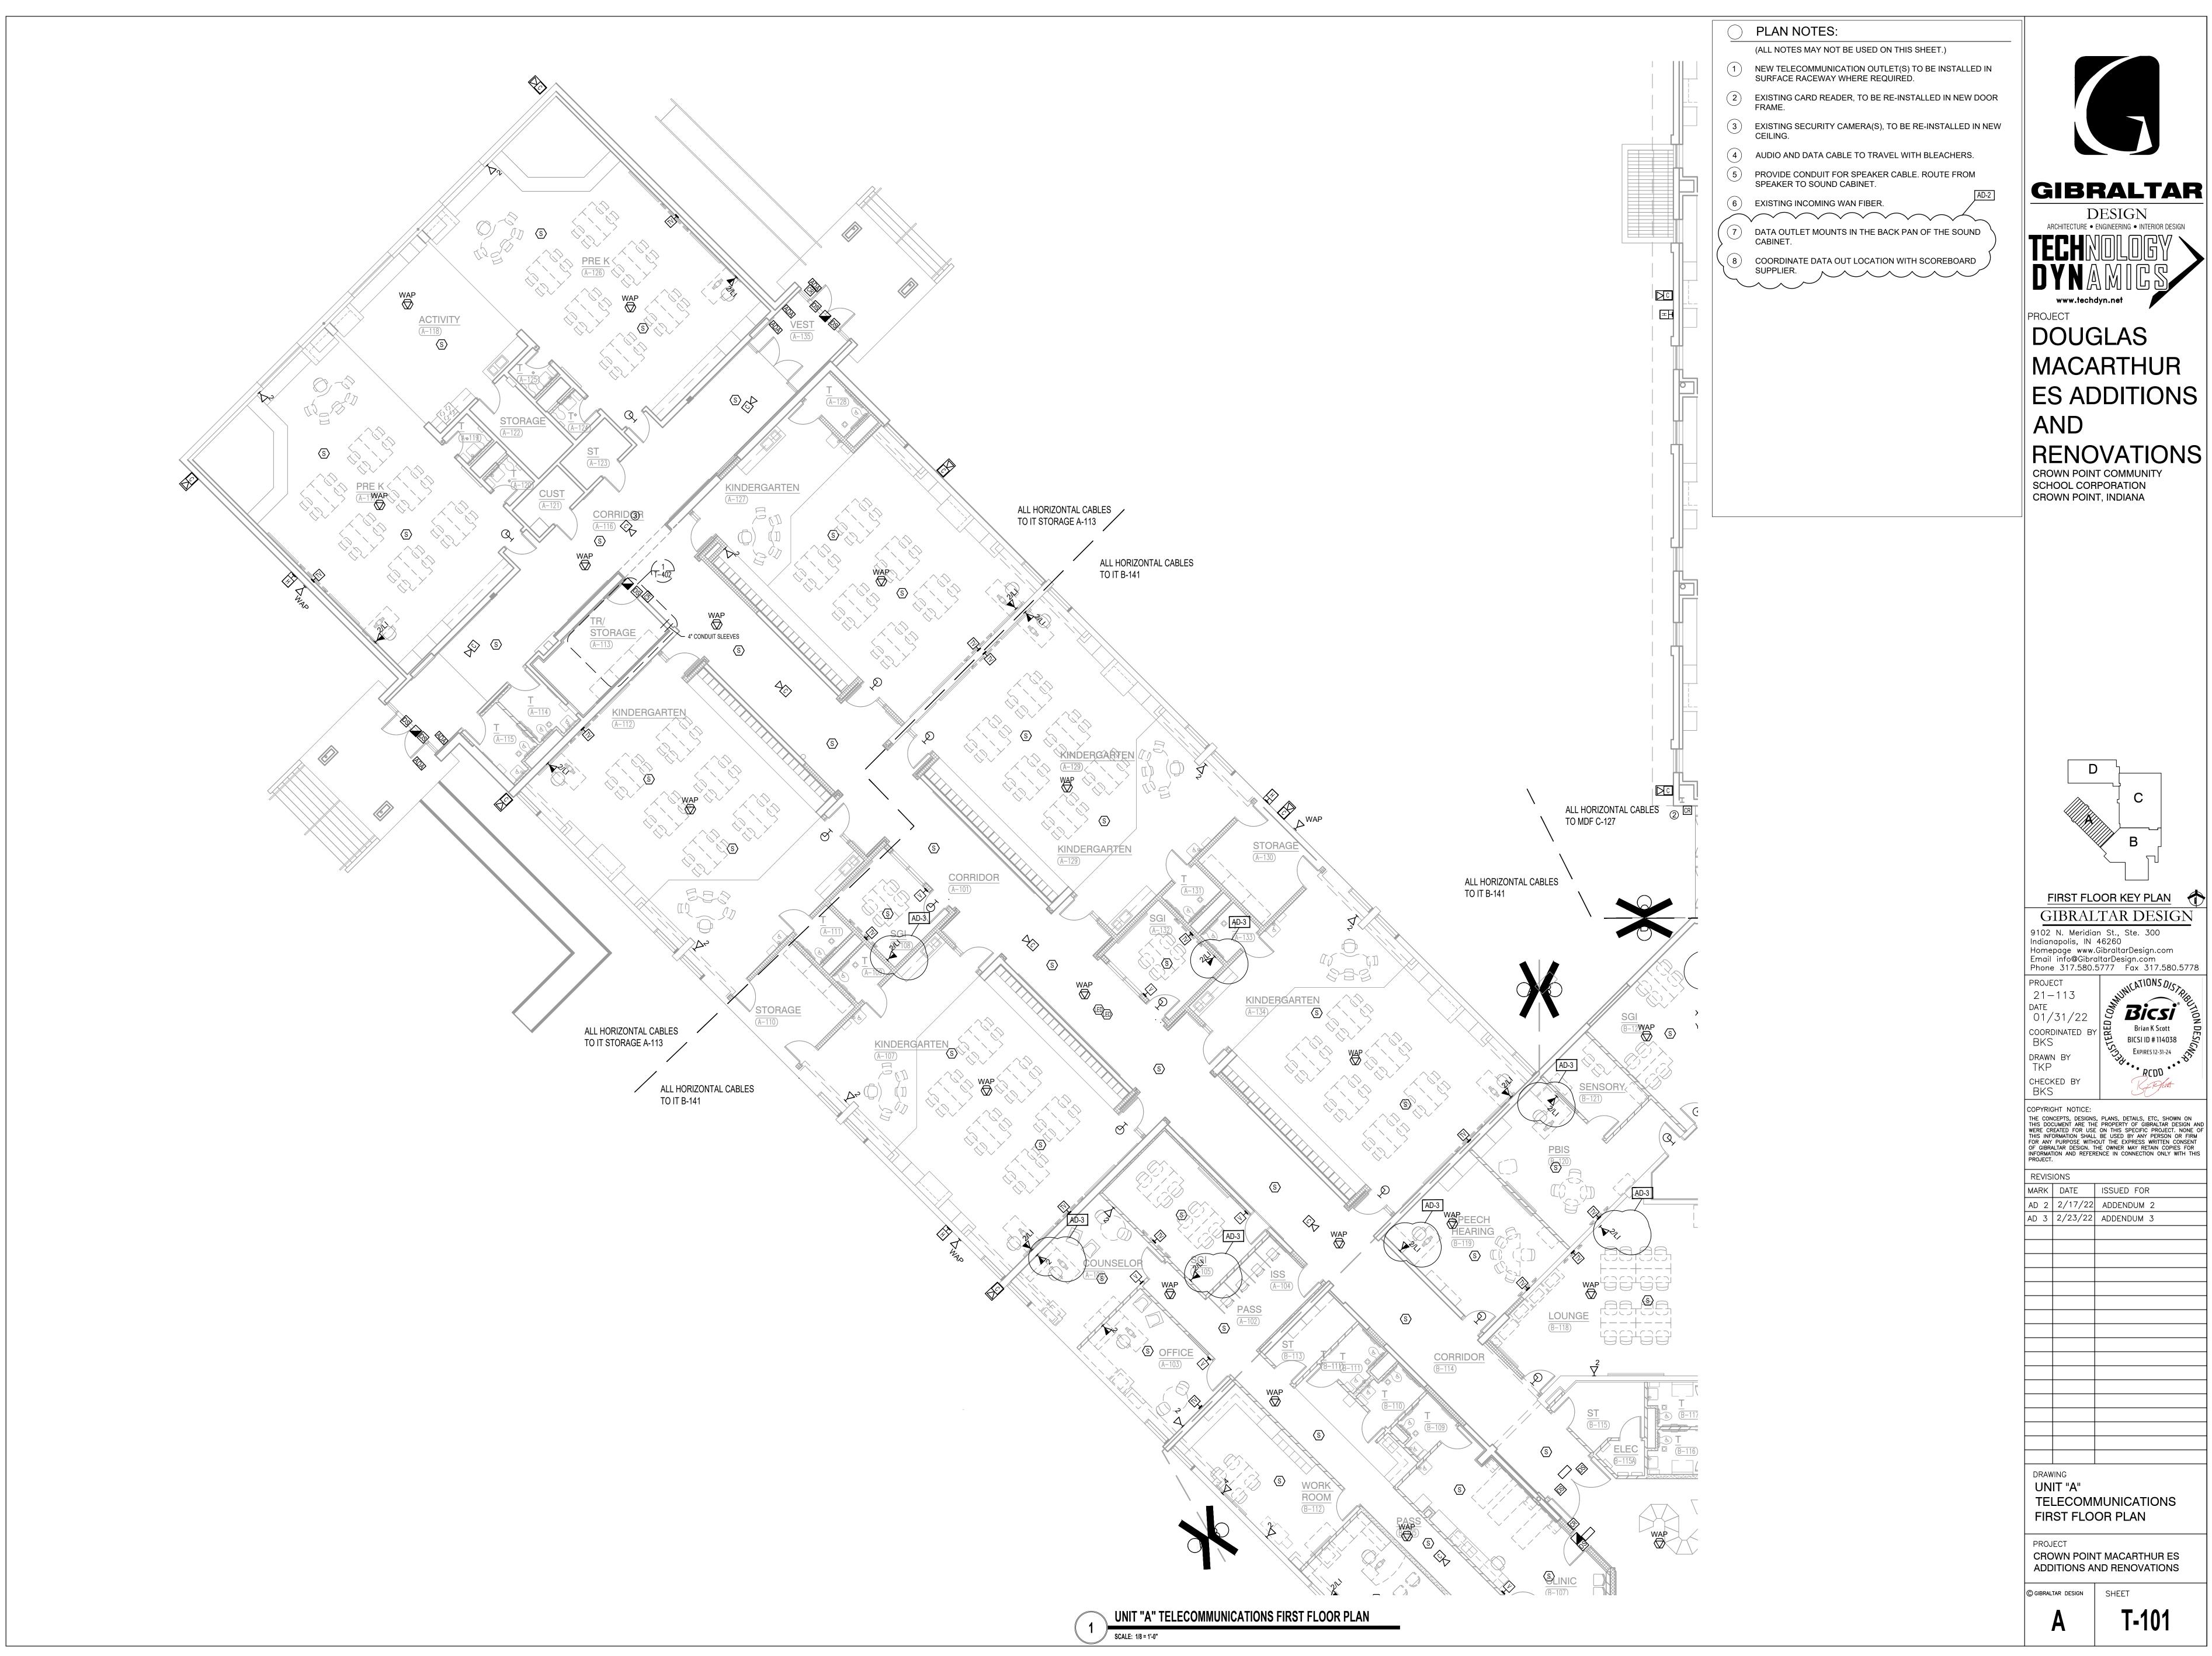

© GIBRALTAR DESIGN SHEET Α


T-101

Bicsi

Brian K Scott

BICSI ID # 114038

EXPIRES 12-31-24

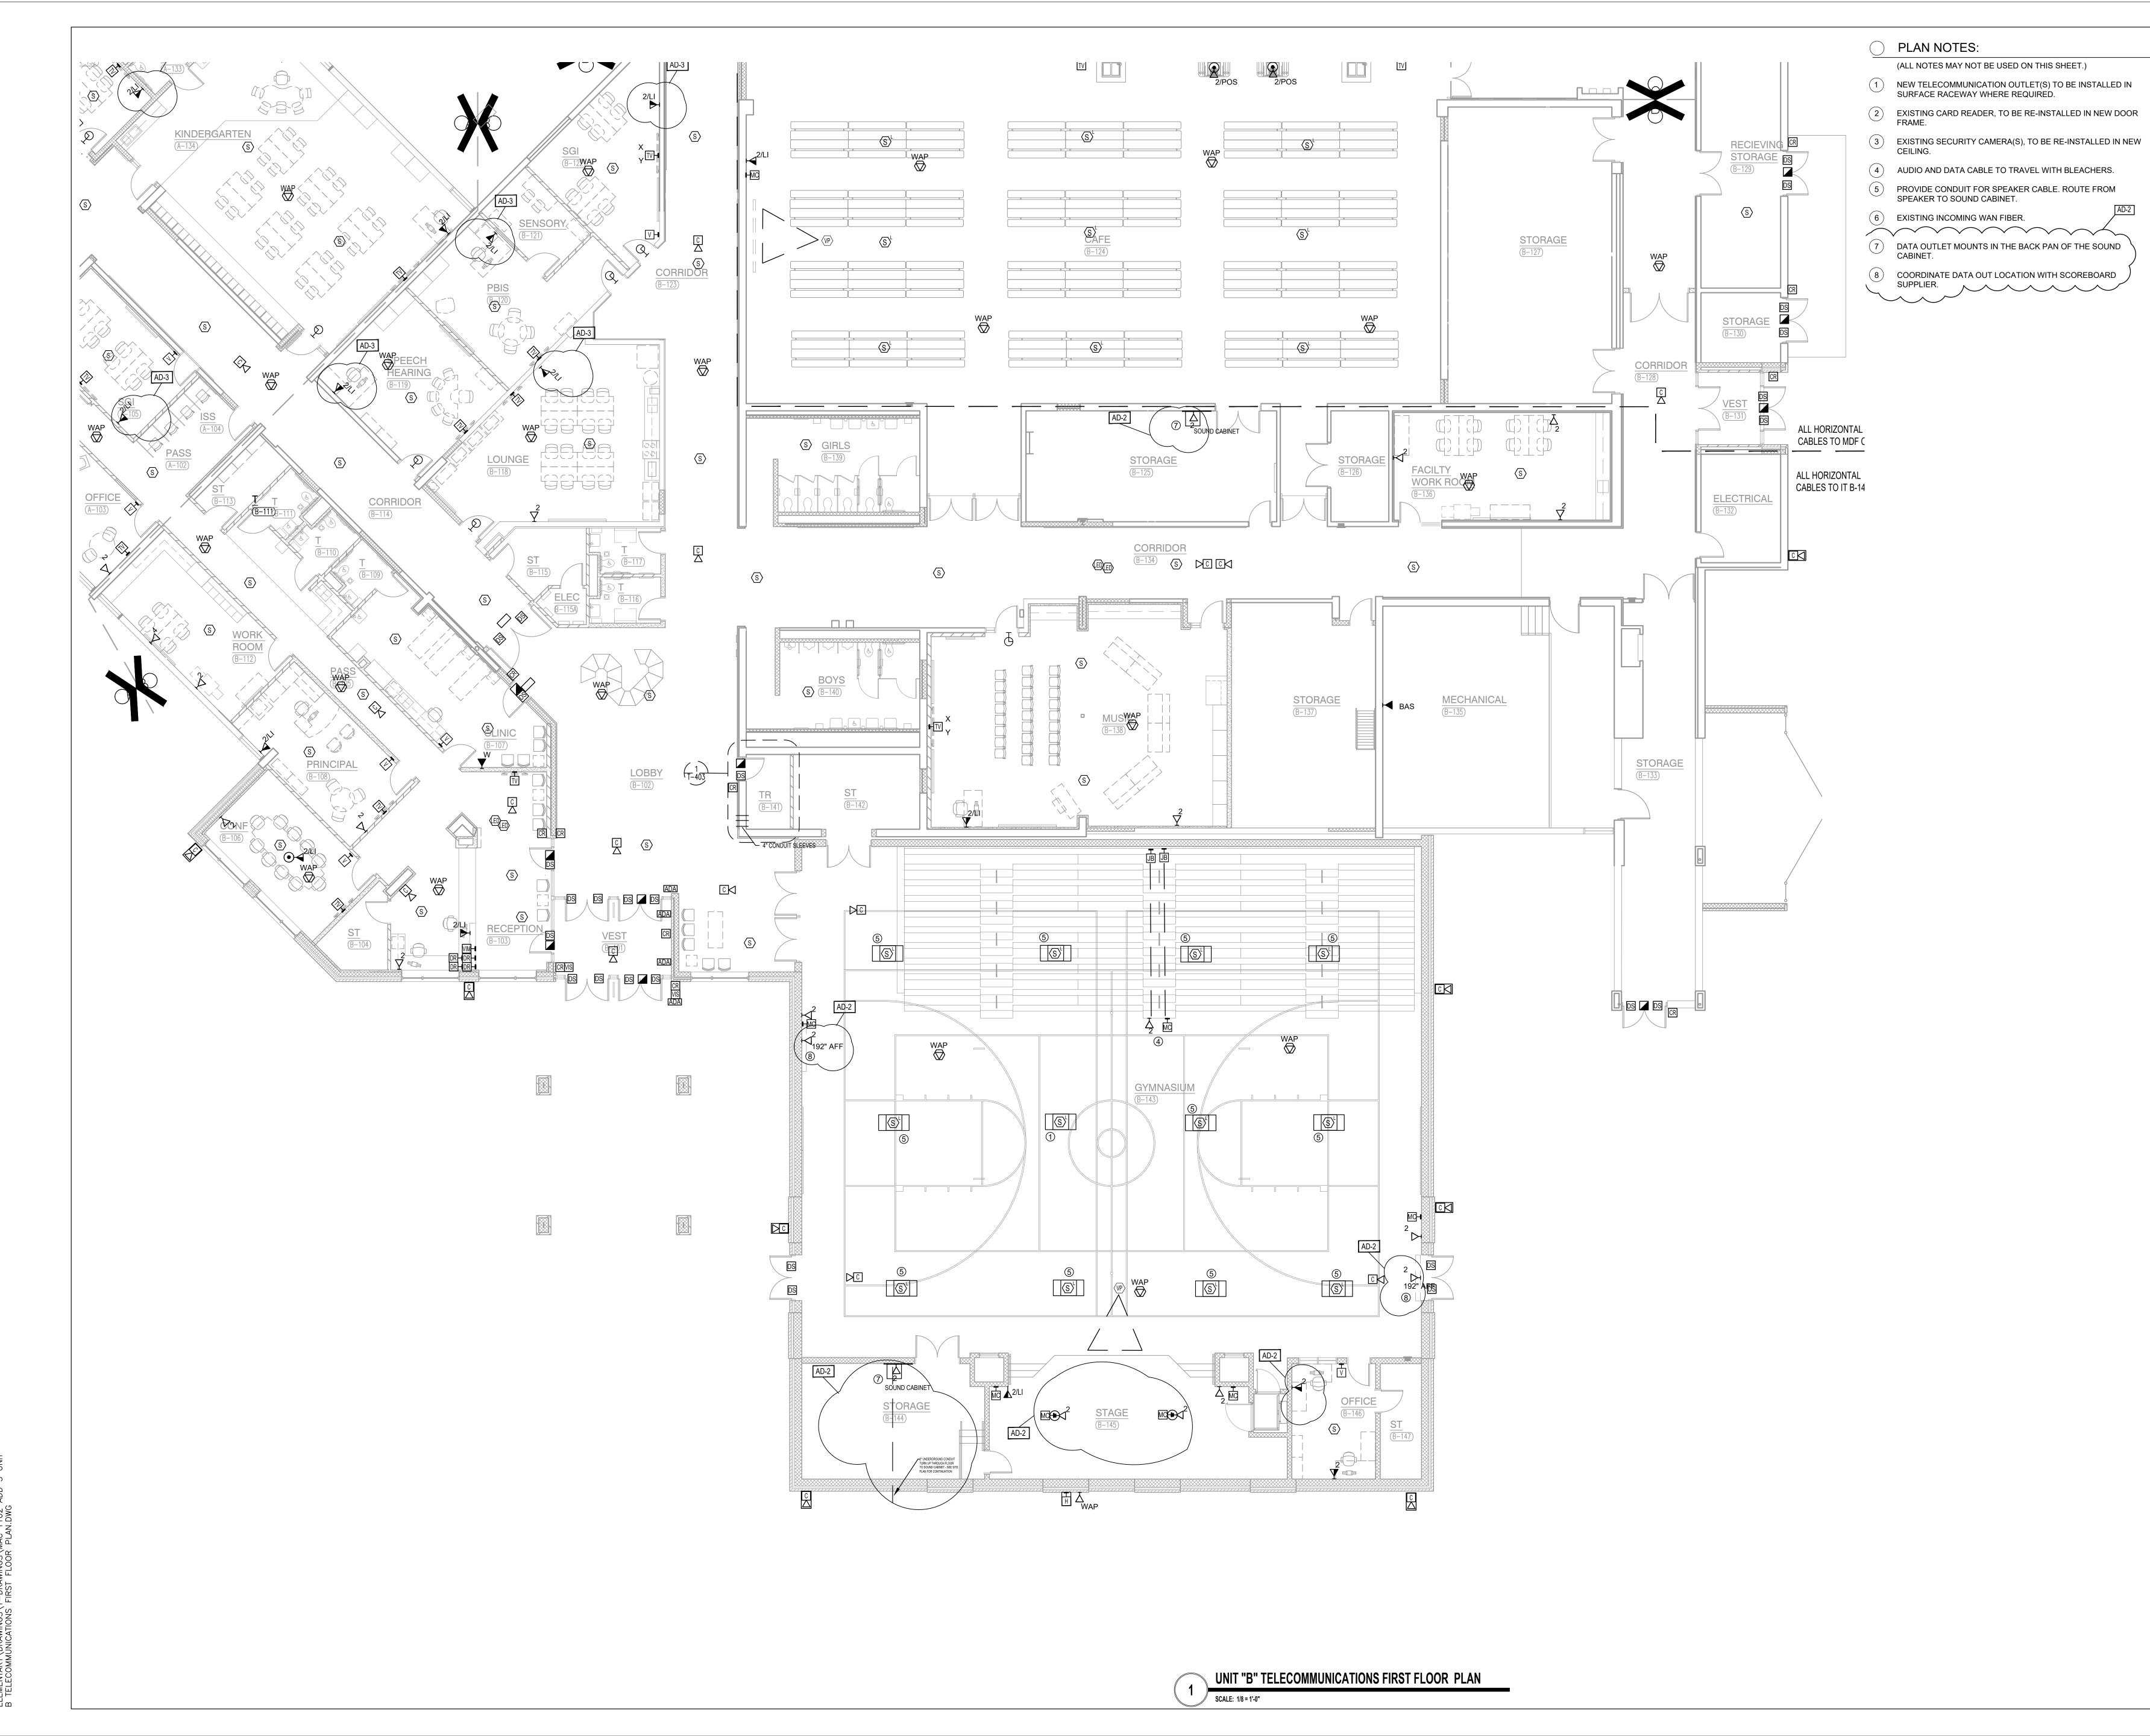

GIBRALTAR
DESIGN


TECHNOLOGY

DYNAMICS

www.techdyn.net

DOUGLAS
MACARTHUR
ES ADDITIONS
AND

RENOVATIONS
CROWN POINT COMMUNITY
SCHOOL CORPORATION
CROWN POINT, INDIANA

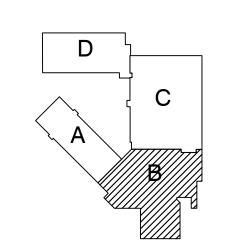

FIRST FLOOR KEY PLAN
GIBRALTAR DESIGN

9102 N. Meridian St., Ste. 300 Indianapolis, IN 46260 Homepage www.GibraltarDesign.com Email info@GibraltarDesign.com Phone 317.580.5777 Fax 317.580.5778

PROJECT
21-113
DATE
01/31/22
COORDINATED BY BKS

COORDINATED BY
BKS

DRAWN BY
TKP

CHECKED BY
BKS

Brian K Scott
BICSI ID # 114038

Expires 12-31-24

RCDD

Bicsi

COPYRIGHT NOTICE:

THE CONCEPTS, DESIGNS, PLANS, DETAILS, ETC, SHOWN ON THIS DOCUMENT ARE THE PROPERTY OF GIBRALTAR DESIGN AND WERE CREATED FOR USE ON THIS SPECIFIC PROJECT. NONE OF THIS INFORMATION SHALL BE USED BY ANY PERSON OR FIRM FOR ANY PURPOSE WITHOUT THE EXPRESS WRITTEN CONSENT OF GIBRALTAR DESIGN. THE OWNER MAY RETAIN COPIES FOR INFORMATION AND REFERENCE IN CONNECTION ONLY WITH THIS PROJECT.

INFORMATION AND REFERENCE IN CONNECTION ONLY WITH THIS PROJECT.

REVISIONS

MARK DATE ISSUED FOR

AD 2 2/17/22 ADDENDUM 2

AD 3 2/23/22 ADDENDUM 3

DRAWING
UNIT "B"
TELECOMMUNICATIONS
FIRST FLOOR PLAN

PROJECT
CROWN POINT MACARTHUR ES
ADDITIONS AND RENOVATIONS

© GIBRALTAR DESIGN SHEET

B SHE

T-102



PLAN NOTES:

(ALL NOTES MAY NOT BE USED ON THIS SHEET.)

1 NEW TELECOMMUNICATION OUTLET(S) TO BE INSTALLED IN SURFACE RACEWAY WHERE REQUIRED.

2 EXISTING CARD READER, TO BE RE-INSTALLED IN NEW DOOR

FRAME.

3 EXISTING SECURITY CAMERA(S), TO BE RE-INSTALLED IN NEW

4 AUDIO AND DATA CABLE TO TRAVEL WITH BLEACHERS.

PROVIDE CONDUIT FOR SPEAKER CABLE. ROUTE FROM SPEAKER TO SOUND CABINET.

EXISTING INCOMING WAN FIBER.

7 DATA OUTLET MOUNTS IN THE BACK PAN OF THE SOUND CABINET.

8 COORDINATE DATA OUT LOCATION WITH SCOREBOARD SUPPLIER.


DESIGN
ARCHITECTURE • ENGINEERING • INTERIOR DESIGN

TECHNOLOGY
DYNAMICS
www.techdyn.net

DOUGLAS
MACARTHUR
ES ADDITIONS
AND

RENOVATIONS
CROWN POINT COMMUNITY

CROWN POINT COMMUNITY SCHOOL CORPORATION CROWN POINT, INDIANA

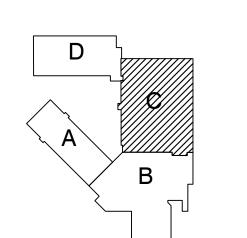

FIRST FLOOR KEY PLAN

GIBRALTAR DESIGN

9102 N. Meridian St., Ste. 300

Bicsi

Brian K Scott

BICSI ID # 114038 Expires 12-31-24

9102 N. Meridian St., Ste. 300
Indianapolis, IN 46260
Homepage www.GibraltarDesign.com
Email info@GibraltarDesign.com
Phone 317.580.5777 Fax 317.580.5778

PROJECT

21-113
DATE
01/31/22
COORDINATED BY
BKS
DRAWN BY
TKP

CHECKED BY

BKS

COPYRIGHT NOTICE:

THE CONCEPTS, DESIGNS, PLANS, DETAILS, ETC, SHOWN ON THIS DOCUMENT ARE THE PROPERTY OF GIBRALTAR DESIGN AND WERE CREATED FOR USE ON THIS SPECIFIC PROJECT. NONE OF THIS INFORMATION SHALL BE USED BY ANY PERSON OR FIRM FOR ANY PURPOSE WITHOUT THE EXPRESS WRITTEN CONSENT OF GIBRALTAR DESIGN. THE OWNER MAY RETAIN COPIES FOR INFORMATION AND REFERENCE IN CONNECTION ONLY WITH THIS PROJECT

PROJECT.

REVISIONS

MARK DATE ISSUED FOR

AD 2 2/17/22 ADDENDUM 2

AD 3 2/23/22 ADDENDUM 3


AD 3 2/23/22 ADDENDUM 3


DRAWING
UNIT "C"
TELECOMMUNICATIONS
FIRST FLOOR PLAN


PROJECT
CROWN POINT MACARTHUR ES
ADDITIONS AND RENOVATIONS


© GIBRALTAR DESIGN SHEET


T-103

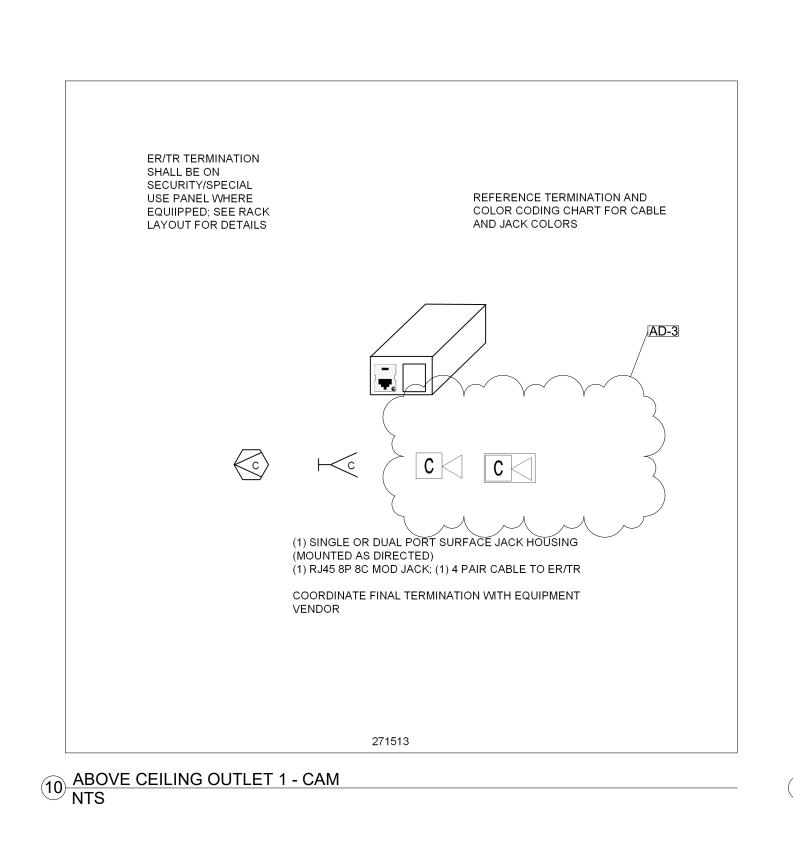


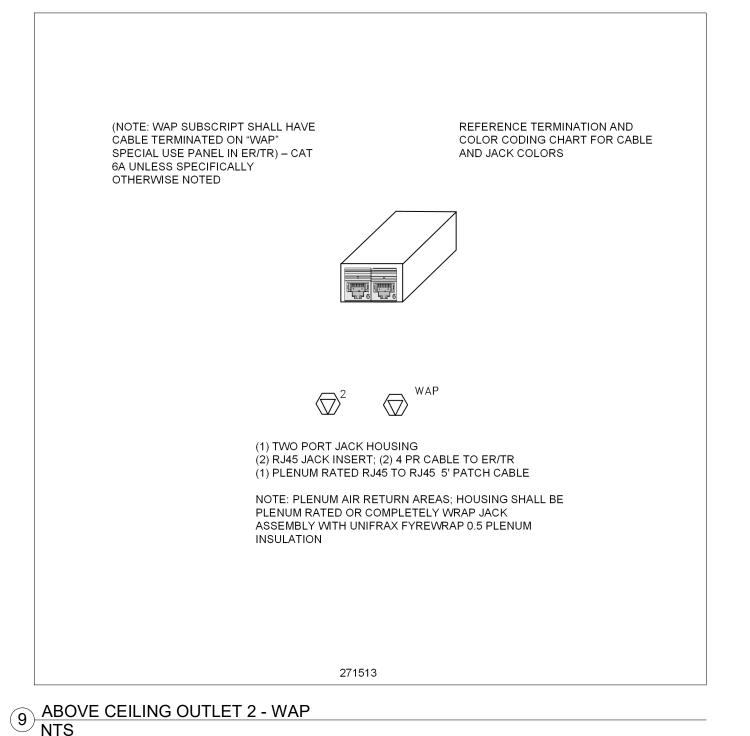


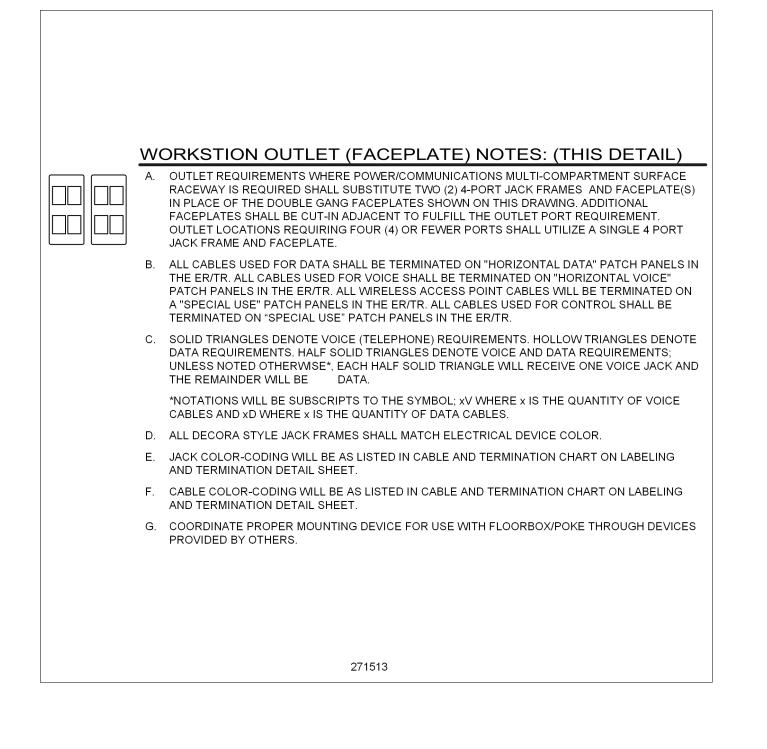


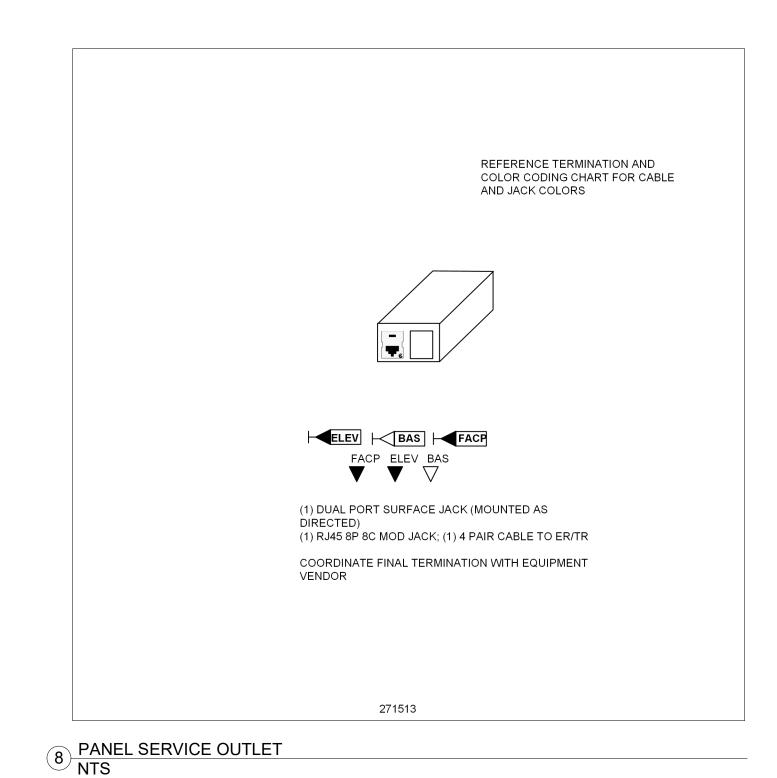


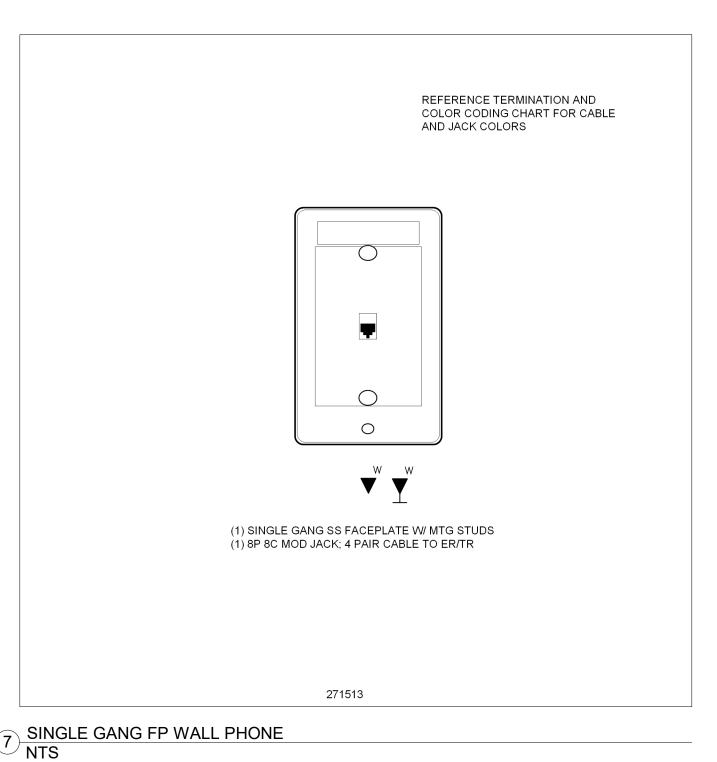


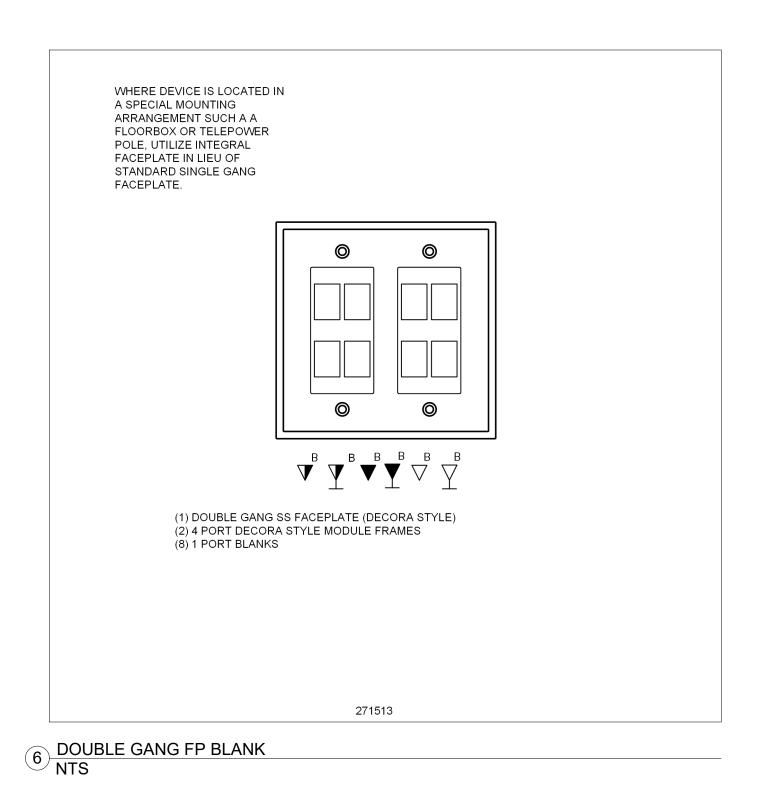


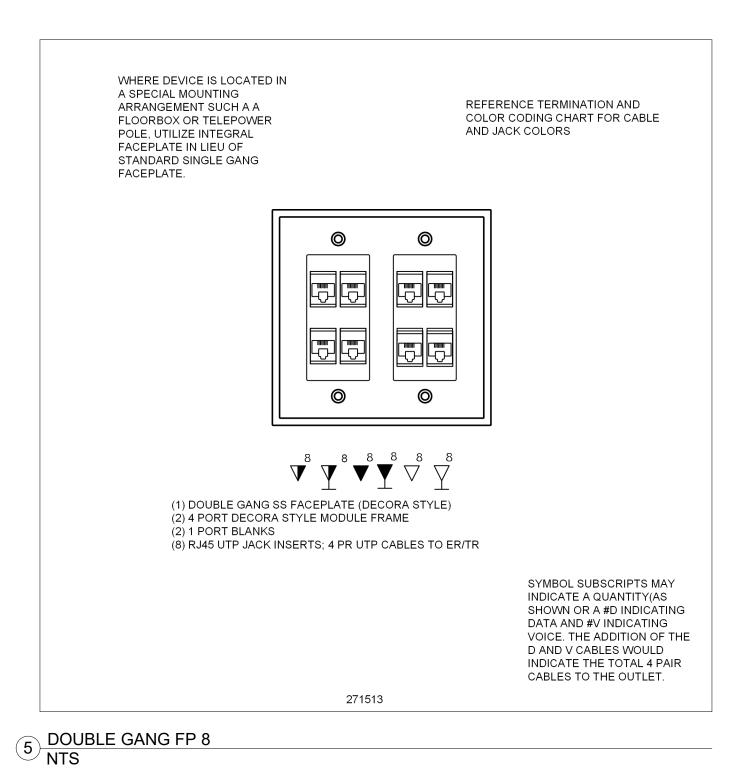

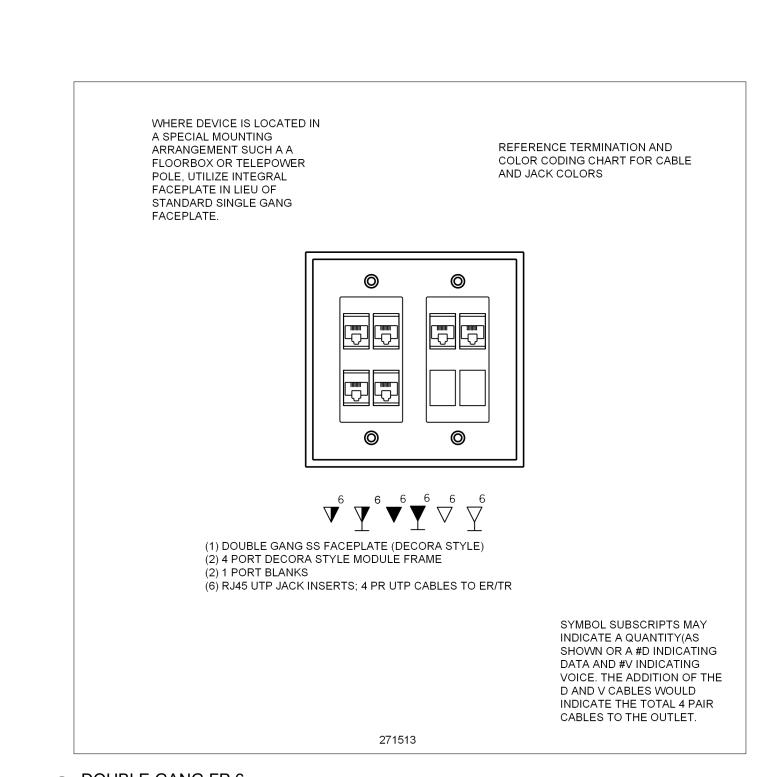

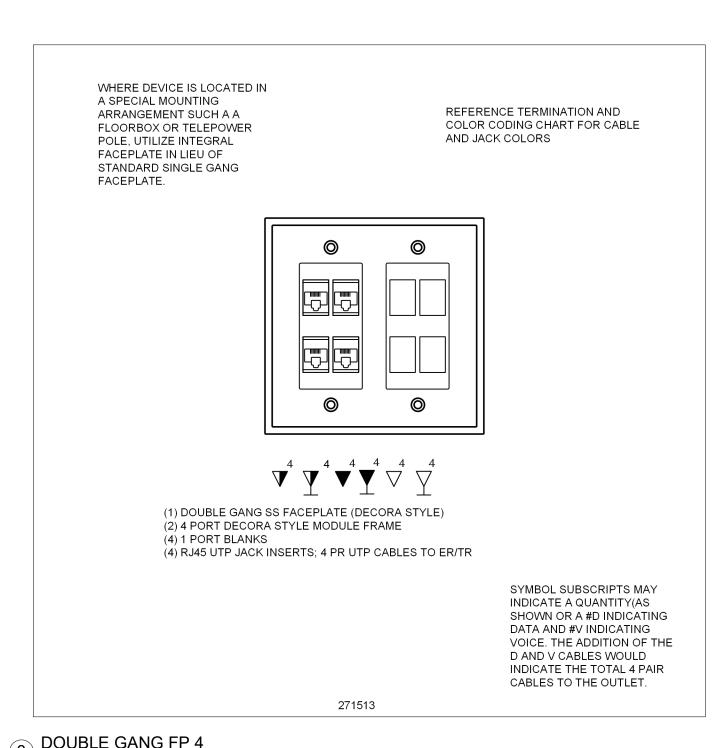

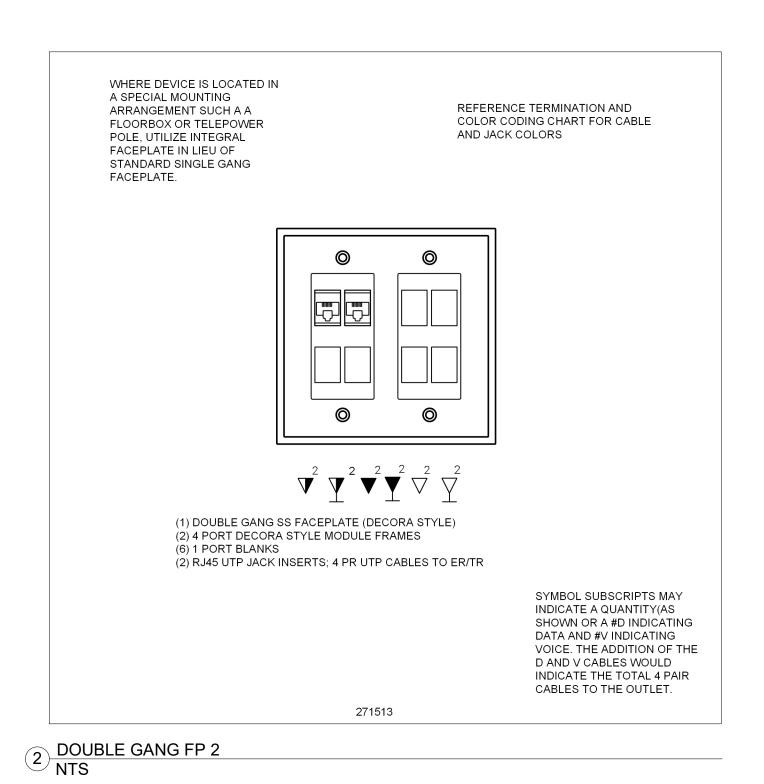

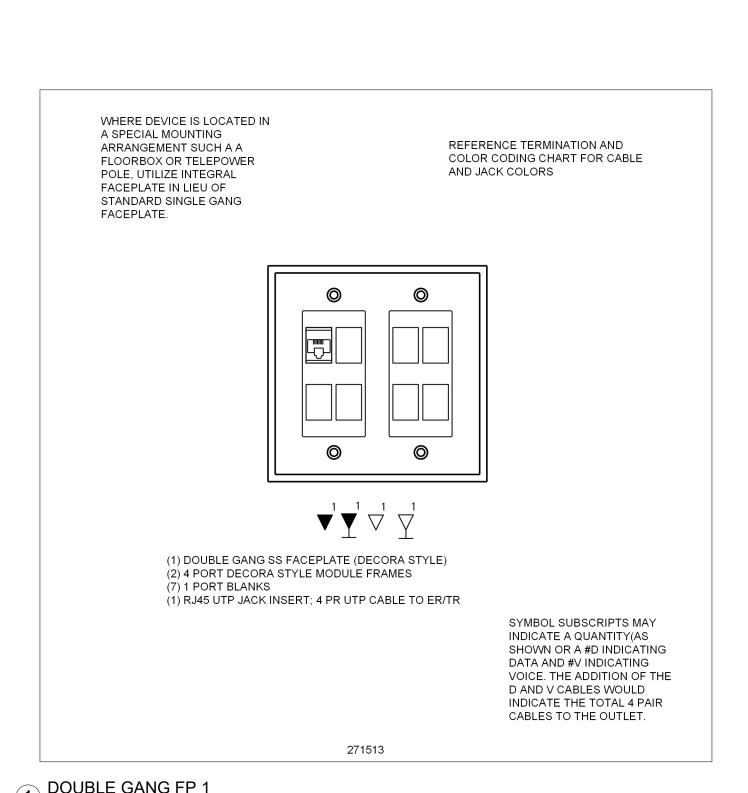



GIBRALTAR

DESIGN

ARCHITECTURE • ENGINEERING • INTERIOR DESIGN

www.techdyn.net

DOUGLAS

ADDITIONS

CROWN POINT COMMUNITY

SCHOOL CORPORATION

CROWN POINT, INDIANA

RENOVATIONS


GIBRALTAR DESIGN


9102 N. Meridian St., Ste. 300 Indianapolis, IN 46260

Homepage www.GibraltarDesign.com Email info@GibraltarDesign.com Phone 317.580.5777 Fax 317.580.5778

AND

MACARTHUR

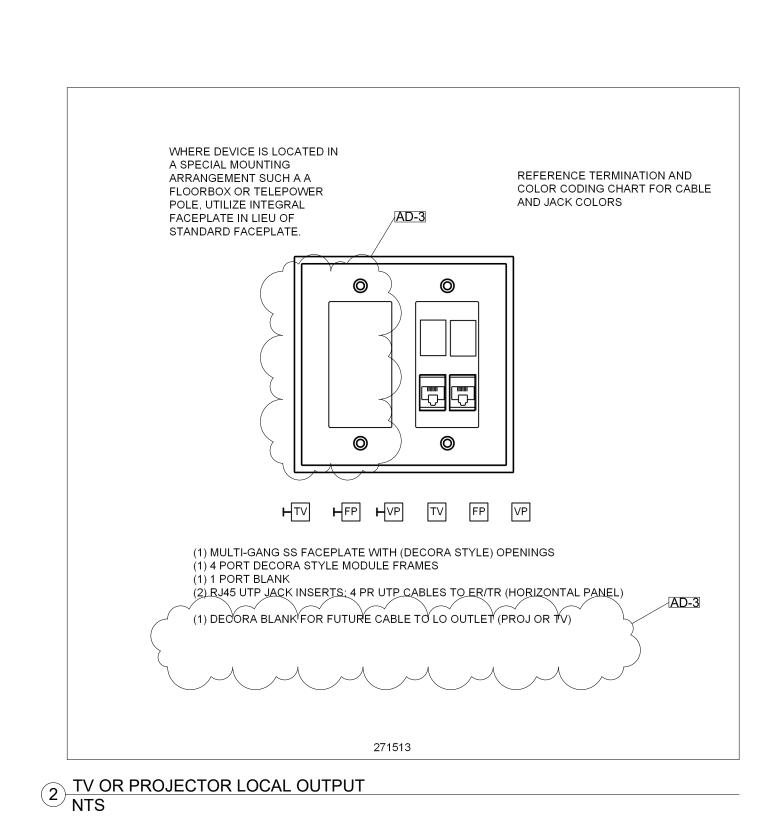

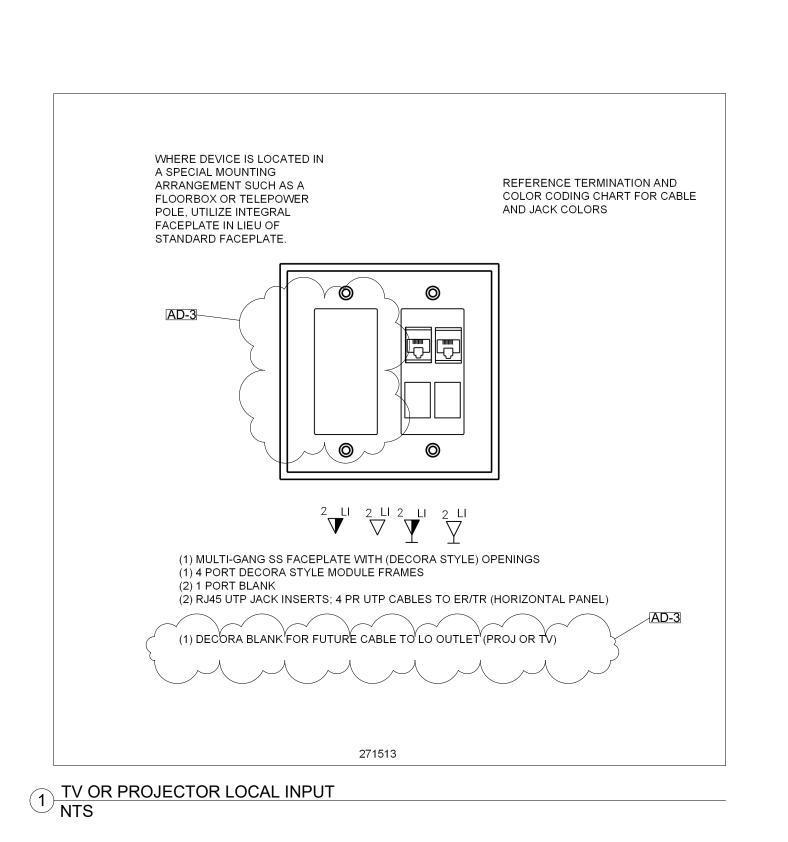

GIBRALTAR
DESIGN
ARCHITECTURE - ENGINEERING - INTERIOR DESIGN
TECHNOLOGY
DYNAMICS
Www.techdyn.net
PROJECT
DOUGLAS
MACARTHUR
ES
ADDITIONS
AND
RENOVATIONS
CROWN POINT COMMUNITY
SCHOOL CORPORATION
CROWN POINT, INDIANA

GIBRALTAR DESIGN

9102 N. Meridian St., Ste. 300 Indianapolis, IN 46260 Homepage www.GibraltarDesign.com Email info@GibraltarDesign.com Phone 317.580.5777 Fax 317.580.5778

PROJECT
21-113
DATE
1/31/22
COORDINATED BY BKS
DRAWN BY TKP
CHECKED BY BKS

COPYRIGHT NOTICE:

THE CONCEPTS, DESIGNS, PLANS, DETAILS, ETC, SHOWN ON THIS DOCUMENT ARE THE PROPERTY OF GIBRALTAR DESIGN AND WERE CREATED FOR USE ON THIS SPECIFIC PROJECT. NONE OF THIS INFORMATION SHALL BE USED BY ANY PERSON OR FIRM FOR ANY PURPOSE WITHOUT THE EXPRESS WRITTEN CONSENT OF GIBRALTAR DESIGN. THE OWNER MAY RETAIN COPIES FOR INFORMATION AND REFERENCE IN CONNECTION ONLY WITH THIS PROJECT.

REVISIONS						
MARK	DATE	ISSUED FOR				
AD-3	2/23/2022	Addendum 3				

DRAWING

OUTLET DETAILS

PROJECT
CROWN POINT MACARTHUR ES
ADDITIONS AND RENOVATIONS

C GIBRALTAR

T502