

**ADDENDUM
NO. 1**

June 23, 2022

Additions and Renovations to Edgewood Intermediate School
7620 E Edgewood Ave.
Indianapolis, IN, 46239

TO: ALL BIDDERS OF RECORD

This Addendum forms a part of and modifies the Bidding Requirements, Contract Forms, Contract Conditions, the Specifications, and the Drawings dated May 23, 2022, by Gibraltar Design. Acknowledge receipt of the Addendum in the space provided on the Bid Form. Failure to do so may subject the Bidder to disqualification.

This Addendum consists of Pages ADD 1 - 1 through ADD 1 - 1 and attached Gibraltar Design Addendum No. 1, dated June 16, 2022, consisting of 2 pages and Drawing Sheets: G-102, G-201, G-302, S-001, SF113, S-302, AD-101, AD-102, AD-103, AD-105, AD-106, AD-109, AD-110, A-110, A-111, A-112, A-113, A-202, A-203, A-410, A-415, A-417, A-430, A-501, A-502, A-711, A-840, A-850.

GENERAL NOTE

Presentation for June 17, 2022 Pre-Bid Conference will be posted on the PlanRoom by on June 23, 2022.

ADDENDUM ONE

Addendum One (AD.01) to the drawings and specifications prepared by Gibraltar Design and The Skillman Corporation for **Edgewood Intermediate School Additions and Renovations** for Franklin Township Community School Corporation, Indianapolis, Indiana.

All Contractors bidding on this project shall read all of the items covered below and shall comply with all of the requirements as set forth, including any necessary refinements or additions generated by this Addendum, and required by the intent of the original contract documents. All Contractors shall acknowledge on their bid form that they have received this Addendum and include the appropriate content of same within their bid proposal.

DRAWINGS

1. Sheet G-102

A. Refer to revised, full-size drawing, included in this Addendum, for revisions.

2. Sheet G-201

A. Refer to revised, full-size drawing, included in this Addendum, for revisions.

3. Sheet G-302

A. Refer to revised, full-size drawing, included in this Addendum, for revisions.

4. Sheet S-001

A. Refer to revised, full-size drawing, included in this Addendum, for the following revisions:

1. Remove the following text from note under 'Structural Legend' about acoustical long span metal deck being ("EPIC WIDECK type WP450A or approved equal").

5. Sheet SF113

A. Refer to revised, full-size drawing, included in this Addendum, for the following revisions:

1. Change roof beams elevations from 113'-6 3/4" to 113'-9 1/4" between grids F and G from Grids 1 to 3.
2. Fill in section cuts along grids F and between grids F and G of area over top existing roof that required new roof deck infill w/20A and 20B/S-302.
3. Layout a dimension string for new beam infill of existing roof with new roof deck.

6. Sheet S-302

A. Refer to revised, full-size drawing, included in this Addendum, for the following revisions:

1. Add Detail 20/S-302 showing roof deck Sections A and B at location of new entry canopy addition.

7. Sheets AD-101, AD-102, AD-105, AD-106

A. Add the Four (4) full-size drawings, included in this Addendum, to the Drawing set.

8. Sheets AD-103, AD-109, AD-110

A. Refer to Four (4) revised, full-size drawings, included in this Addendum, for revisions.

9. Sheets A-110, A-111, A-112, A-113

A. Refer to Four (4) revised, full-size drawings, included in this Addendum, for revisions.

10. Sheets A-202, A-203

A. Refer to Two (2) revised, full-size drawings, included in this Addendum, for revisions.

11. Sheets A-410, A-415, A-417

A. Refer to Three (3) revised, full-size drawings, included in this Addendum, for revisions.

12. Sheet A-430

A. Refer to revised, full-size drawing, included in this Addendum, for revisions.

13. Sheets A-501 and A-502

A. Refer to Two (2) revised, full-size drawings, included in this Addendum, for revisions.

14. Sheet A-711

A. Refer to revised, full-size drawing, included in this Addendum, for revisions.

15. Sheet A-840

A. Refer to revised, full-size drawing, included in this Addendum, for revisions:

16. Sheet A-850

A. Refer to revised, full-size drawing, included in this Addendum, for addition of painted wall graphic on the north and south walls of the gymnasium.

17. Sheet M-113

A. Move thermostat/sensor serving VAV-M1 to corner of corridors M110 and M102 Intersection. (No drawing attached).


Pages 1 through 2, inclusive, and Thirty (30) Full-Size Drawings constitute the total makeup of **Addendum One**.





GIBRALTAR
DESIGN
ARCHITECTURE • ENGINEERING • INTERIOR DESIGN

PROJECT
ADDITIONS AND
RENOVATIONS TO
**EDGEWOOD
INTERMEDIATE
SCHOOL**
FRANKLIN TOWNSHIP COMMUNITY
SCHOOL CORPORATION
INDIANAPOLIS, INDIANA

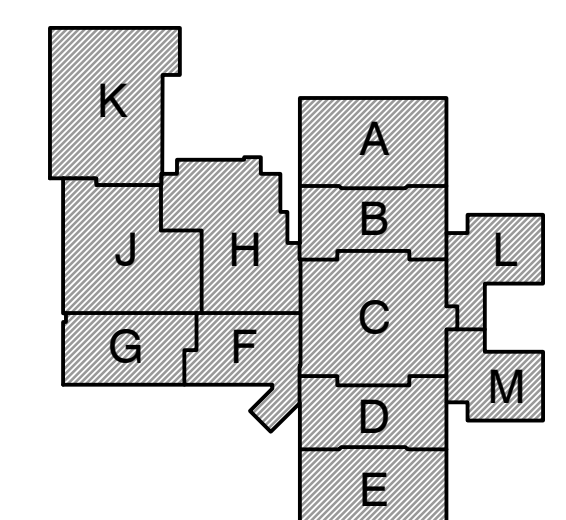


FIRST FLOOR KEY PLAN

GIBRALTAR DESIGN

9102 N. Meridian St., Ste. 300
Indianapolis, IN 46260
Homepage: www.GibraltarDesign.com
Email: info@GibraltarDesign.com
Phone: 317.580.5777 Fax: 317.580.5778

PROJECT: 21-155
DATE: 05/23/22
COORDINATED BY: DJW
DRAWN BY: JRH
CHECKED BY: DJW

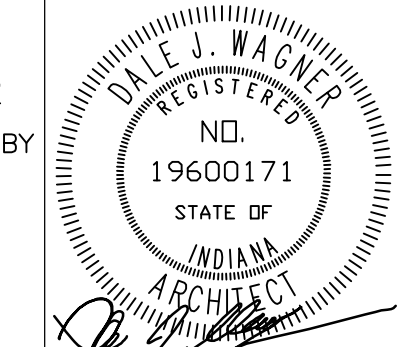

COPYRIGHT NOTICE:
THE CONCEPTS, DESIGNS, PLANS, DETAILS, ETC. SHOWN ON THIS DOCUMENT ARE THE PROPERTY OF GIBRALTAR DESIGN AND WERE CREATED FOR USE ON THIS SPECIFIC PROJECT. NONE OF THIS INFORMATION SHALL BE USED BY ANY PERSON OR FIRM FOR ANY PURPOSE WITHOUT THE EXPRESS WRITTEN CONSENT OF GIBRALTAR DESIGN. THE OWNER MAY RETAIN COPIES FOR INFORMATION AND REFERENCE IN CONNECTION ONLY WITH THIS PROJECT.

REVISIONS

MARK	DATE	ISSUED FOR
AD-1	06/16/22	ADDENDUM NO. 1

DRAWING
FIRST FLOOR LIFE SAFETY PLAN

PROJECT
ADDITIONS AND RENOVATIONS TO
EDGEWOOD INTERMEDIATE SCHOOL

© GIBRALTAR DESIGN SHEET

G-201

LIFE SAFETY GENERAL NOTE:

LIFE SAFETY INFORMATION IS PROVIDED FOR USE BY ALL CONTRACTORS. CONTRACTORS ARE RESPONSIBLE FOR COMPLYING WITH CODE REQUIREMENTS (INCLUDING BUT NOT LIMITED TO: RATED ASSEMBLIES, FIRE PROTECTION, FIRESTOPPING, DAMPERS, AND HARDWARE) INDICATED INCLUDING CONDITIONS WHERE THESE REQUIREMENTS ARE NOT DETAILED. REPORT CONFLICTS OR DISCREPANCIES TO THE ARCHITECT FOR RESOLUTION PRIOR TO STARTING WORK.


Applicable Codes:	2014 Indiana Building Code 2014 Indiana Mechanical Code 2012 Indiana Plumbing Code 2009 Indiana Electrical Code 2010 Indiana Energy Conservation Code ICC/ANSI A-117.1 Standard, 2009 Edition Indianapolis-Marion County Fire Protection Code (MCFPC)
Scope of Project:	The project scope involves construction of two (2) 1-story additions to the existing building; a new multi-gymnasium with ancillary functions and a classroom addition. The additions will add 48,110 sq ft of area to the 1 st floor. An upper level mechanical attic space is also included with the gymnasium addition. The project scope also includes limited renovation of small areas in the existing building.
Code Strategy:	The building is classified as unlimited area, Type VB Construction - based upon sprinkler protection throughout and 60 feet of open space throughout the building. [507.3]
Occupancy Classifications:	Educational use areas for intermediate school students [305.1] Assembly uses accessory to Group E are not considered separate occupancies [303.1.3] Office - accessory occupancy less than 10% of the building area - B Occupancy [304.1, 508.2]
Construction Type:	Type VB (combustible, unprotected) Construction permitted based upon compliance with unlimited area provisions for 1-story E Occupancy buildings. [507.3]
Occupancy Separations:	Occupancy separations not required, based upon classification of assembly uses accessory to an educational occupancy as E Occupancy areas [303.1.3] B Occupancy office areas are not required to be separated based upon compliance as accessory occupancy [508.2]
Building Elements - Fire-resistive Requirements	Building elements, including structural frame and roof are permitted to be of combustible, unprotected construction [Table 601] Exterior walls are permitted to be unenclosed, combustible, since having at least 10 feet of fire separation distance [Table 602]
Incidental Use Separations:	Walls for these areas are required to terminate at the deck or a 1-hour ceiling, with self-closing doors - Boiler and furnace rooms with equipment sized as indicated in Table 509 - Laundry room over 100 sq ft [Table 509, Sec. 509.4.2] Fire and/or smoke dampers are not required in duct penetrations of these separations.
Fire and Smoke Dampers:	None required [717.5]
Occupant Load Factors:	Classrooms 20 of per occupant Gymnasium - sports, PE 50 of per occupant Office 100 of per occupant Storage/Mechanical 300 of per occupant
Egress Corridors:	Egress corridors throughout the building are permitted to be unenclosed based upon automatic sprinkler protection [1018.1]
Panic Hardware:	Panic hardware is required on all means of egress doors serving an occupant load of 50 or more [1008.1.10]
Egress Travel Distance:	The maximum travel distance to an exterior exit is permitted to be a maximum of 250 feet [1016.2]
Automatic Sprinklers:	Automatic sprinklers are required throughout, based upon an E Occupancy fire area exceeding 12,000 sq ft - sprinklers will be provided throughout the building. [905.2.3]
Standpipes:	Class 1 standpipes not required based upon automatic sprinkler protection throughout [905.3.1]
Fire Alarm System:	Fire alarm system required [907.2.3] Manual pull stations are not required based upon initiation of the alarm system by sprinkler water flow.
Smoke Detectors:	Smoke detectors are required for HVAC shutdown for systems delivering in excess of 2,000 cfm [606.1, IMC]
Fire Hydrant:	Fire hydrant required within 600 feet of all portions of the exterior walls of the building [507.5.1, IFC - Sec. 591-406, MCFPC]
Fire Extinguishers:	Fire extinguishers required throughout [Sec. 591-402, MCFPC]

LIFE SAFETY PLAN LEGEND


- DOORS WITH PANIC HARDWARE (PH)
- MAJOR EGRESS ROUTES (--->)
- 2 HOUR CONSTRUCTION (-----)
- 1 HOUR CONSTRUCTION (-----)
- NUMBER PLATE TWO REQUIRED AT ALL EXTERIOR ENTRANCES (△)
- EXISTING DOOR NUMBER TO REMAIN (△)

SQUARE FOOTAGE ANALYSIS


EXISTING FIRST FLOOR	160,727 SQ. FT.
EXISTING SECOND FLOOR	5,819 SQ. FT.
EXISTING TOTAL	166,546 SQ. FT.
NEW FIRST FLOOR	48,873 SQ. FT.
NEW SECOND FLOOR	2,011 SQ. FT.
NEW TOTAL	50,884 SQ. FT.
GRAND TOTAL	217,430 SQ. FT.

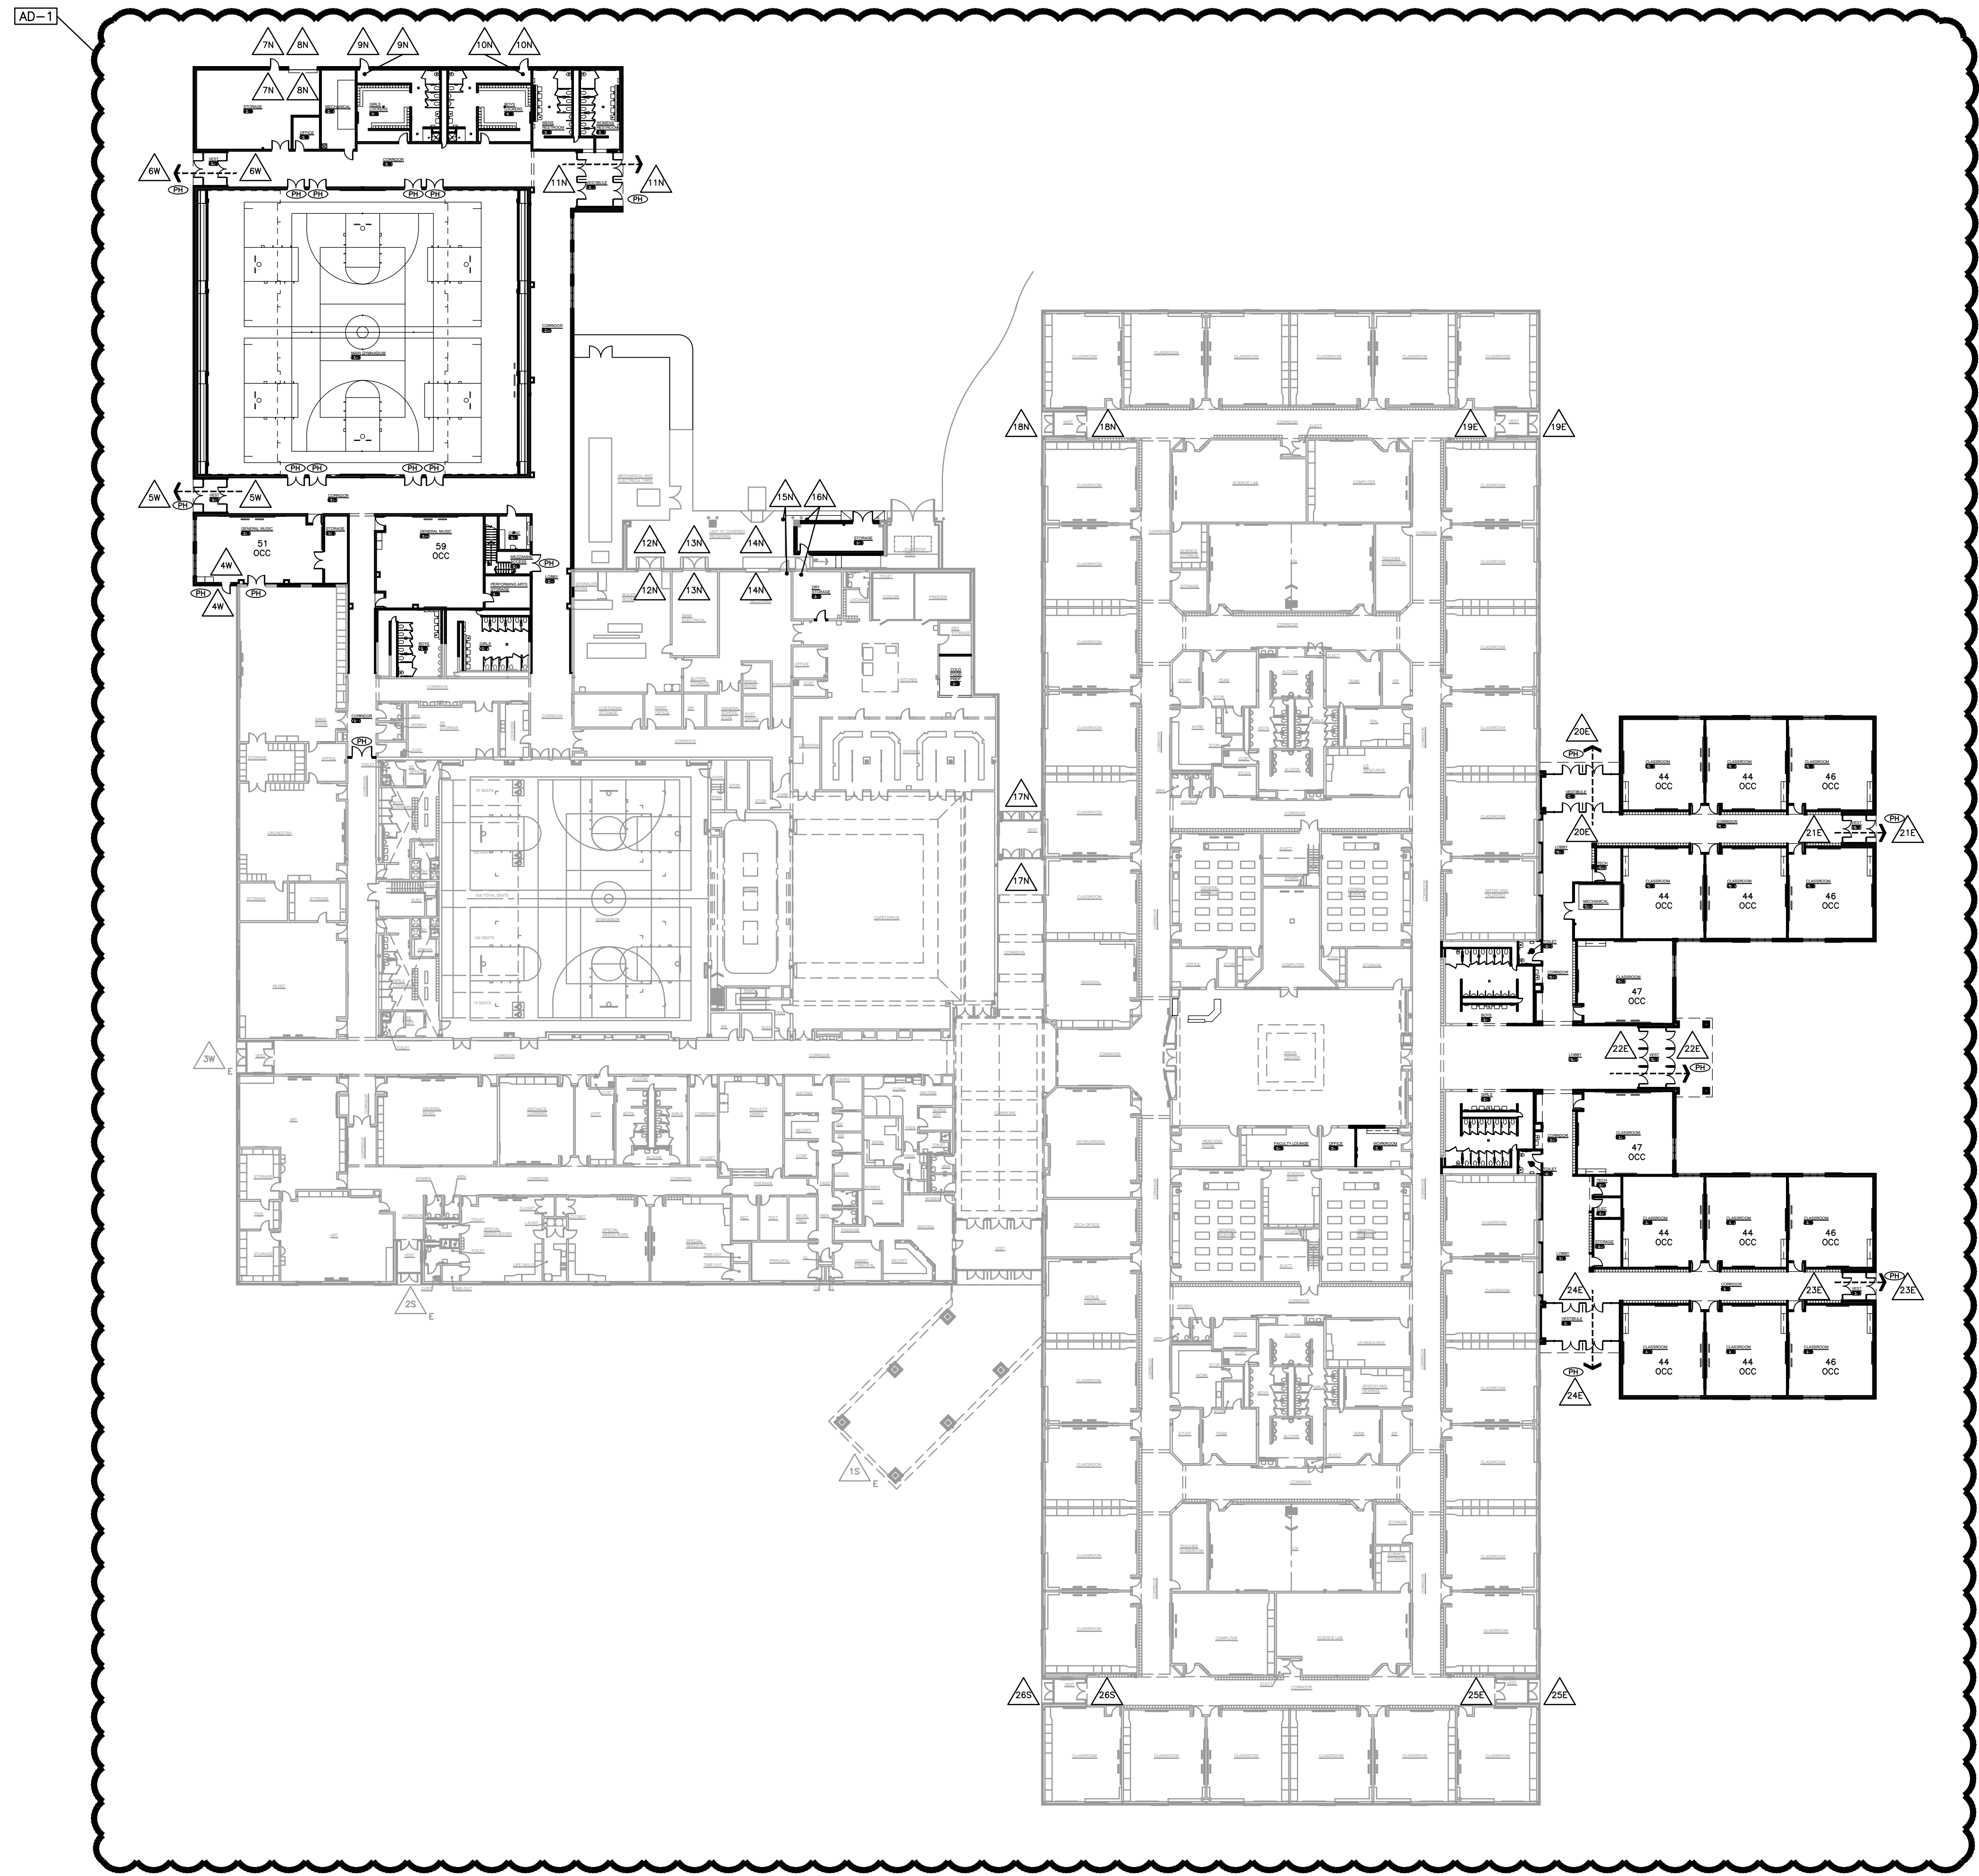

FIRST FLOOR LIFE SAFETY PLAN
SCALE: 1/32" = 1'-0"

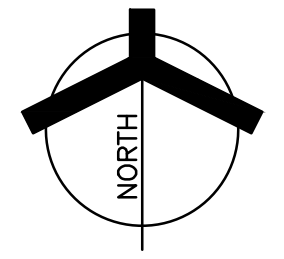


Thursday, 6/16/2022 - 2:29 PM - LAST SAVED BY: JHARRIS
Y:\21-155 FRANKLIN TOWNSHIP CSC-EDGEWOOD IS
ADDITIONS AND RENOVATIONS\21-155 DRAWINGS\02
GEN\G-201.DWG

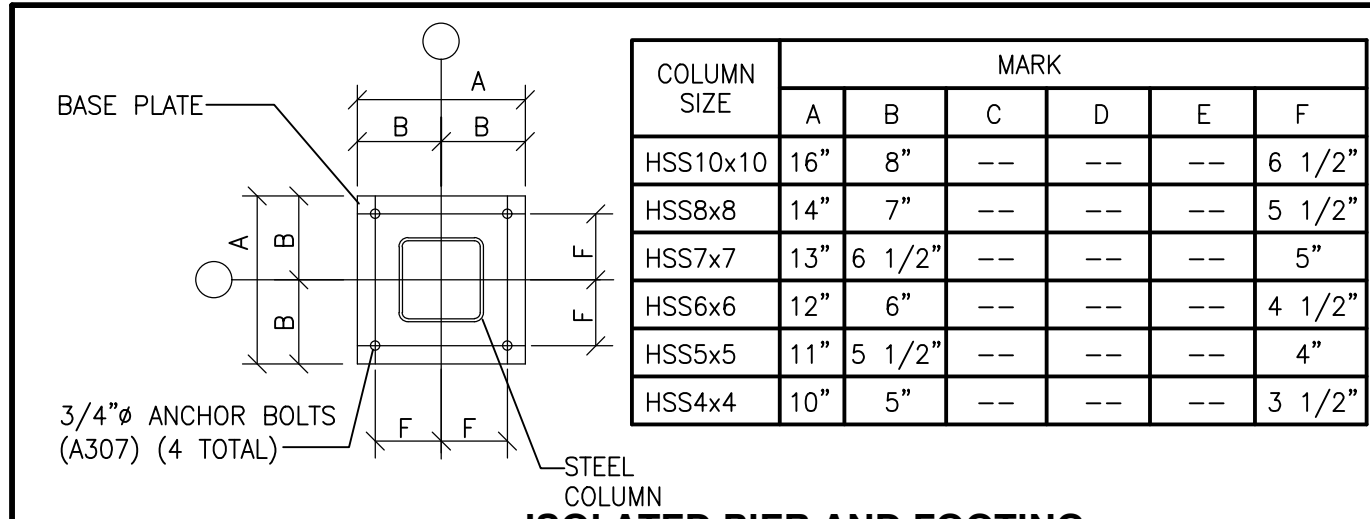

ISOLATED PIER AND FOOTING

COLUMN SIZE	MARK					
	A	B	C	D	E	F
HSS10x10	16"	8"	---	---	---	6 1/2"
HSS8x8	14"	7"	---	---	---	5 1/2"
HSS7x7	13"	6 1/2"	---	---	---	5"
HSS6x6	12"	6"	---	---	---	4 1/2"
HSS5x5	11"	5 1/2"	---	---	---	4"
HSS4x4	10"	5"	---	---	---	3 1/2"

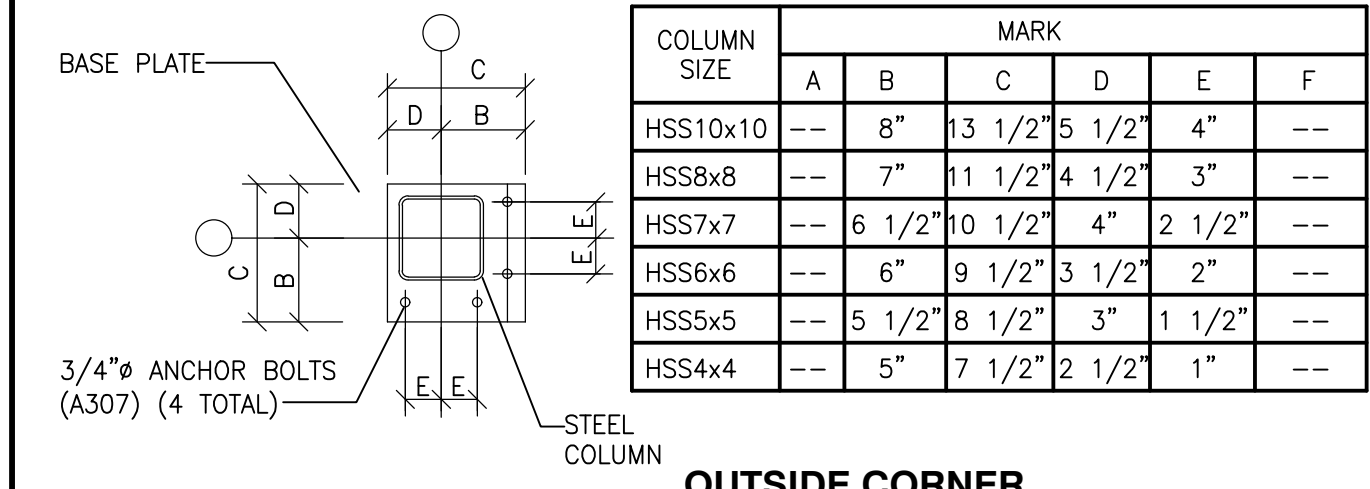

INSIDE CORNER AND ALONG WALL

COLUMN SIZE	MARK					
	A	B	C	D	E	F
HSS10x10	16"	8"	3 1/2"	5 1/2"	4"	6 1/2"
HSS8x8	14"	7"	1 1/2"	4 1/2"	3"	5 1/2"
HSS7x7	13"	6 1/2"	1 1/2"	4"	2 1/2"	5"
HSS6x6	12"	6"	9 1/2"	3 1/2"	2"	4 1/2"
HSS5x5	11"	5 1/2"	8 1/2"	3"	1 1/2"	4"
HSS4x4	10"	5"	7 1/2"	2 1/2"	1"	3 1/2"




OUTSIDE CORNER

COLUMN SIZE	MARK					
	A	B	C	D	E	F
HSS10x10	16"	8"	3 1/2"	5 1/2"	4"	6 1/2"
HSS8x8	14"	7"	1 1/2"	4 1/2"	3"	5 1/2"
HSS7x7	13"	6 1/2"	1 1/2"	4"	2 1/2"	5"
HSS6x6	12"	6"	9 1/2"	3 1/2"	2"	4 1/2"
HSS5x5	11"	5 1/2"	8 1/2"	3"	1 1/2"	4"
HSS4x4	10"	5"	7 1/2"	2 1/2"	1"	3 1/2"



TYPICAL BASE PLATE

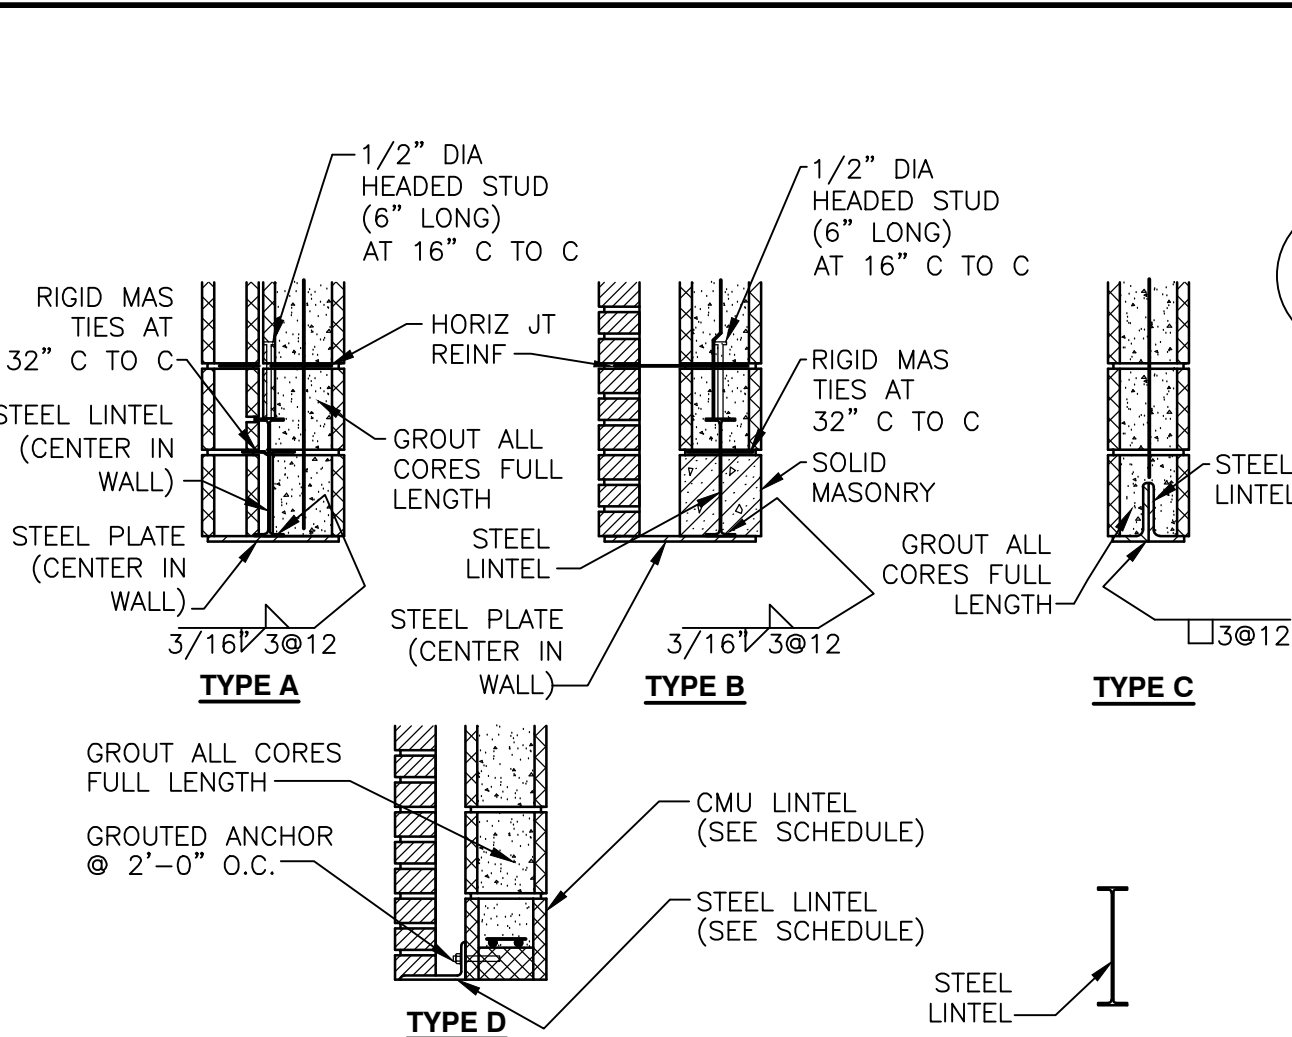


- NOTES:
- TYPE A AND B LINTELS SHALL BEAR ON TWO FULLY GROUTED CORES FULL HEIGHT. TYPE C LINTELS SHALL BEAR ON TWO FULLY GROUTED COURSES OR SOLID MASONRY.
 - ALL LINTELS AT EXTERIOR LOCATIONS OR OTHERWISE SUBJECT TO WEATHER OR CORROSIVE ATMOSPHERE SHALL BE GALVANIZED. SEE SPECIFICATIONS.
 - AT TYPE "A" AND "B" LINTELS, PLATE LENGTH TO BE MASONRY OPENING MINUS 1/4" EACH END (1/2" TOTAL).
 - BEARING PLATE REQUIRED AT END OF SPECIAL LINTEL UNLESS OTHERWISE NOTED.
 - "C" INDICATES COLUMN CONNECTION REQUIRED AT ONE OR BOTH ENDS. SEE PLANS FOR LOCATION.

MARK	SIZE	CONTINUOUS PLATE		ELEVATION	TYPE
		TOP	BOTTOM		
SL-1	W12x22	---	---	3/A-412	E

SPECIAL LINTEL SCHEDULE

SCALE: NTS

BEARING PLATE MARK	SIZE THK x W x L	NUMBER ANCHOR RODS	REMARKS
BP2	1/2" x 6" x 9"	3	CORNER BEAM BEARING
BP3	1/2" x 9" x 1'-2"	4	BEAM BEARING

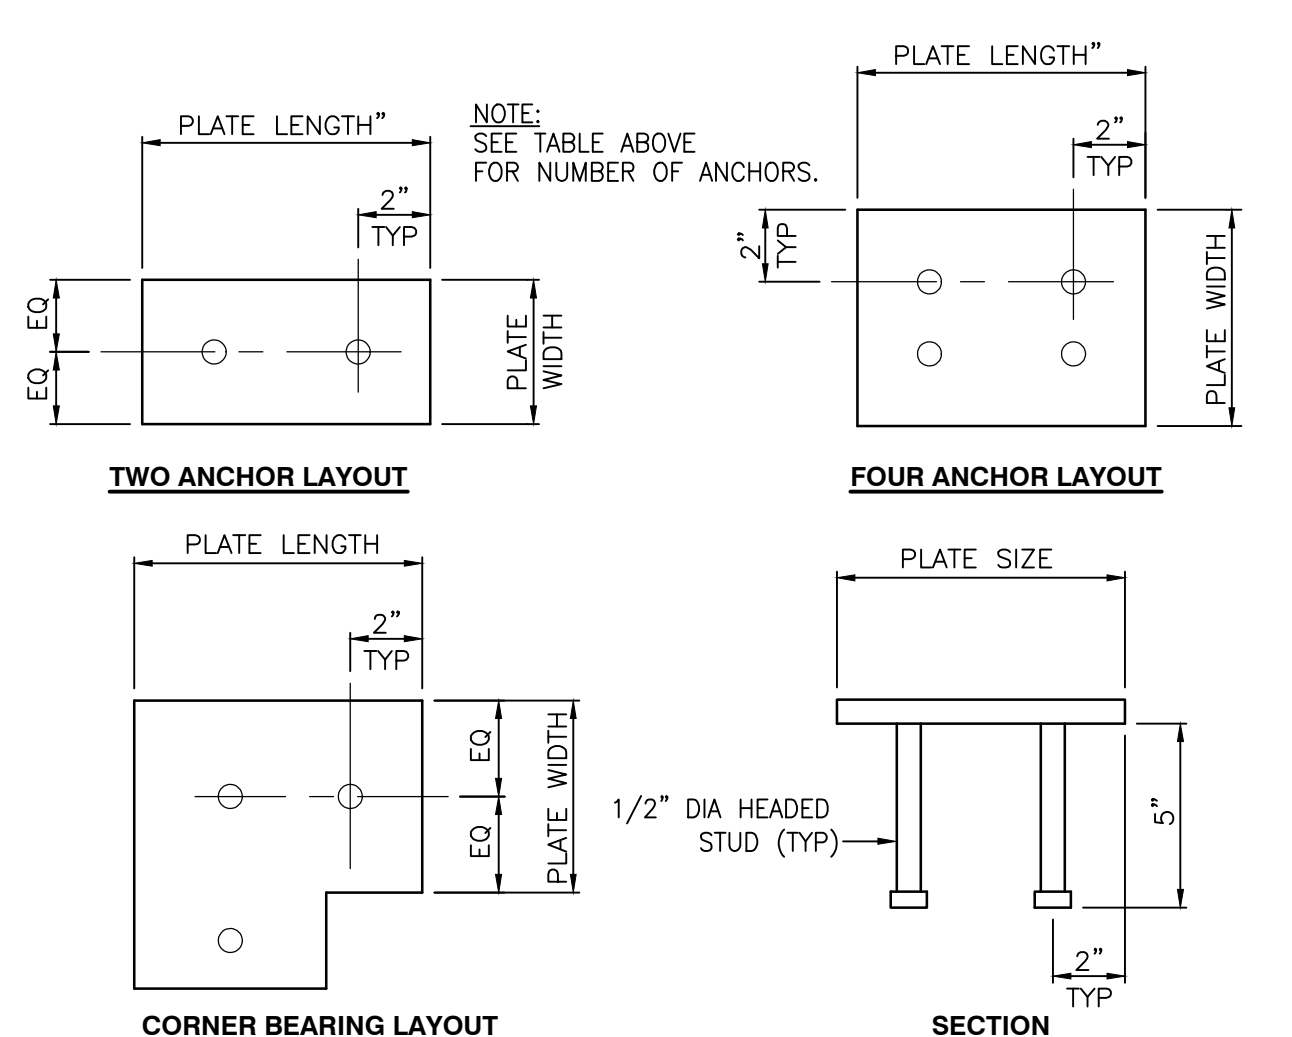

BEARING PLATE SCHEDULE

SCALE: NTS

PANEL MARK	CMU THICKNESS (BACK-UP)	VERTICAL REINFORCING SIZE SPA	TOP OF BOND BEAM ELEVATIONS	REMARKS	DETAIL
PANEL 1	8"	#5 40"	12'-0"	INSP	(SEE ARCH)
PANEL 2	8"	#5 40"	12'-8"	INSP	(SEE ARCH)
PANEL 3	12"	#6 32"	12'-0", 20'-8", 32'-0", 34'-8"	INSP	(SEE ARCH)
PANEL 4	8"	#5 48"	10'-0"	INSP	(SEE ARCH)

- NOTE:
- (INSP) = MASONRY INSPECTION REQUIRED (SEE SPECIFICATIONS).
 - FOR HORIZONTAL JOINT REINFORCING SIZE AND SPACING SEE SPECIFICATIONS.
 - REINFORCING SCHEDULED HERE IN APPLIES TO THAT PORTION OF THE WALL ABOVE THE FOUNDATION WALL. SEE FOUNDATION PLANS FOR FOUNDATION WALL REINFORCING.
 - ALL REINFORCED MASONRY WALLS TO HAVE BOND BEAM AT OR NEAR TOP OF WALL.
 - GROUT CMU WALL SOLID WITH FINE GROUT PER SPECIFICATIONS.


MASONRY WALL PANEL SCHEDULE

SLAB SCHEDULE				FOOTING SCHEDULE			
MARK	DEPTH	REINFORCEMENT	REMARKS	MARK	WIDTH	DEPTH	REINFORCEMENT
4"	4"	WF 6x6 W2.1KW.1	6" DRAINAGE FILL	F24	24"	12"	3-#5 LONGITUDINAL #5 AT 24" O.C. TRANSVERSE
4 1/2"	4 1/2"	WF 6x6 W2.1KW.1	USE 2" - 20GA COMPOSITE DECK				

- NOTE:
- VAPOR BARRIER TO BE PROVIDED DIRECTLY UNDER SLAB AND MAY BE OMITTED FOR EXTERIOR SLABS (15 MIL).
 - SEE SPECIFICATION 0301 FOR FIBER-ADDED REQUIREMENTS.
 - SEE DETAIL FOR CLARIFICATION.





PAD SCHEDULE			
MARK	WIDTH	DEPTH	REINFORCEMENT (1/2 EACH WAY)
P4	4'-0"	*1'-0"	4'-0" 10 - #5
P5	5'-0"	*1'-2"	5'-0" 12 - #5
P6	6'-0"	*1'-6"	6'-0" 14 - #5

* : INDICATES ALL PADS ON EXTERIOR WALL 2'-8" (SEE PLANS)

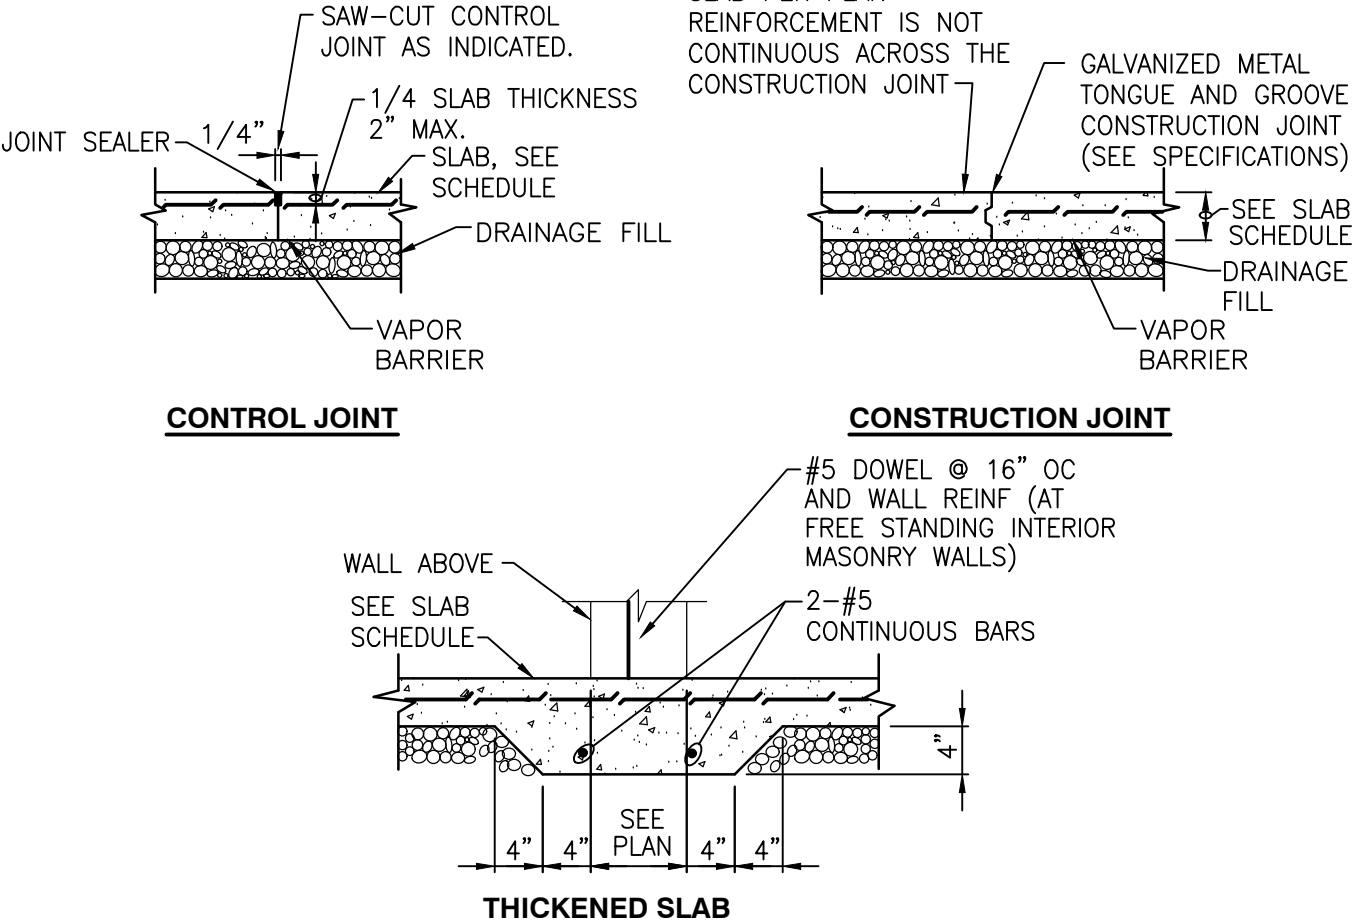


TYPICAL SLAB ON GRADE

SCALE: 3/4" = 1'-0"

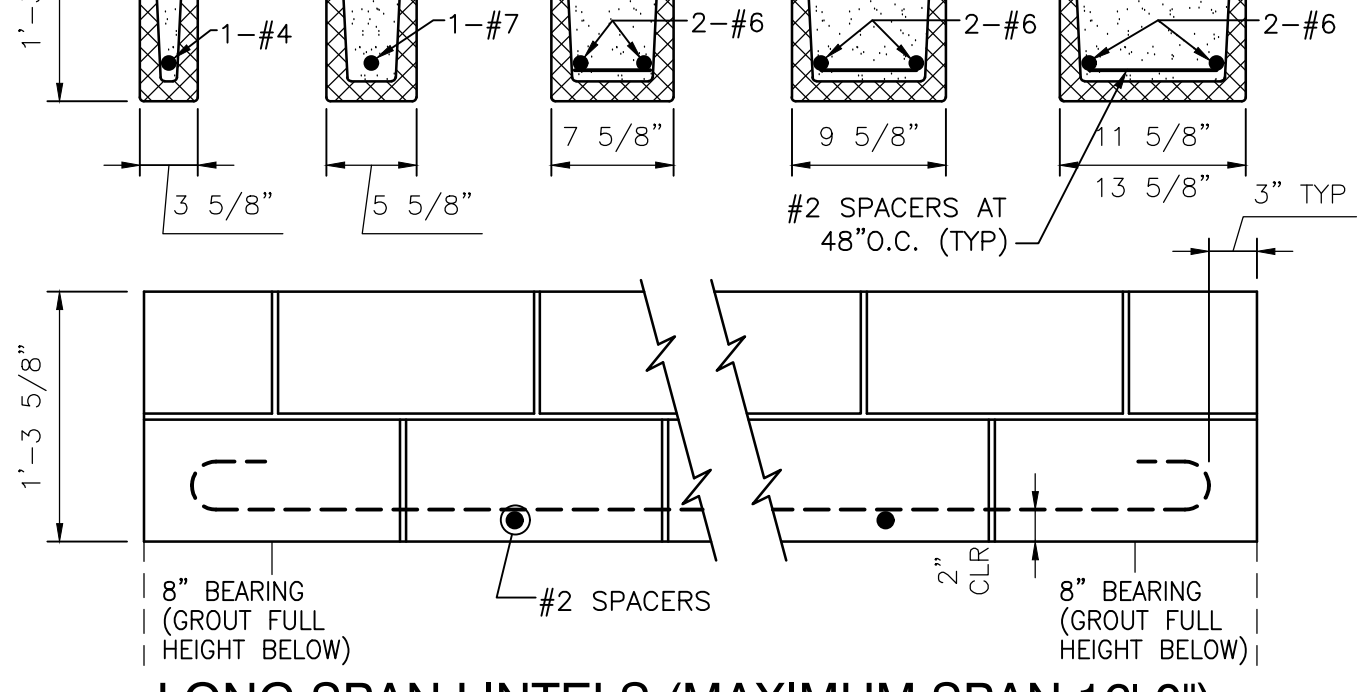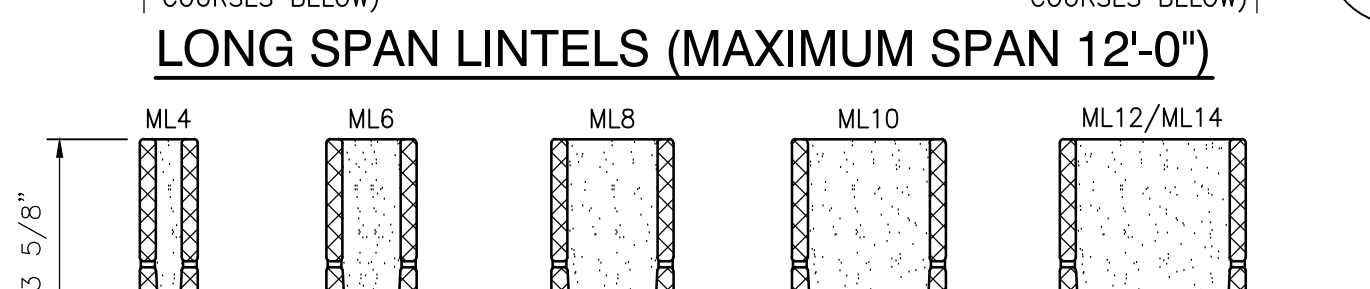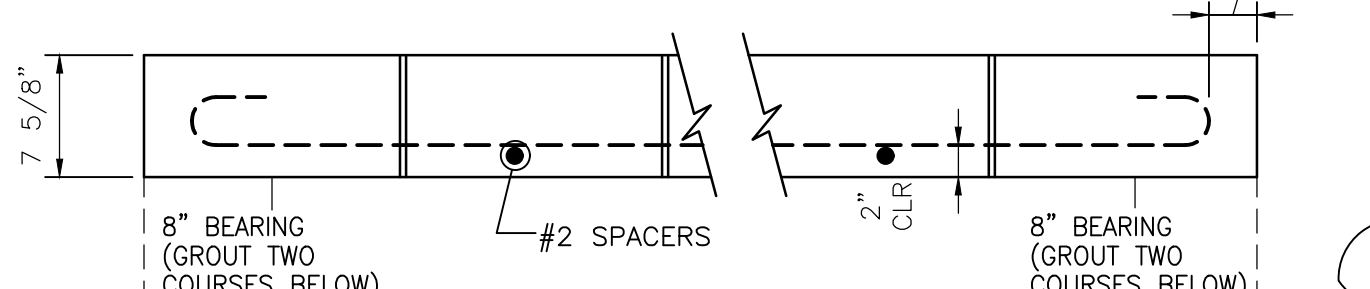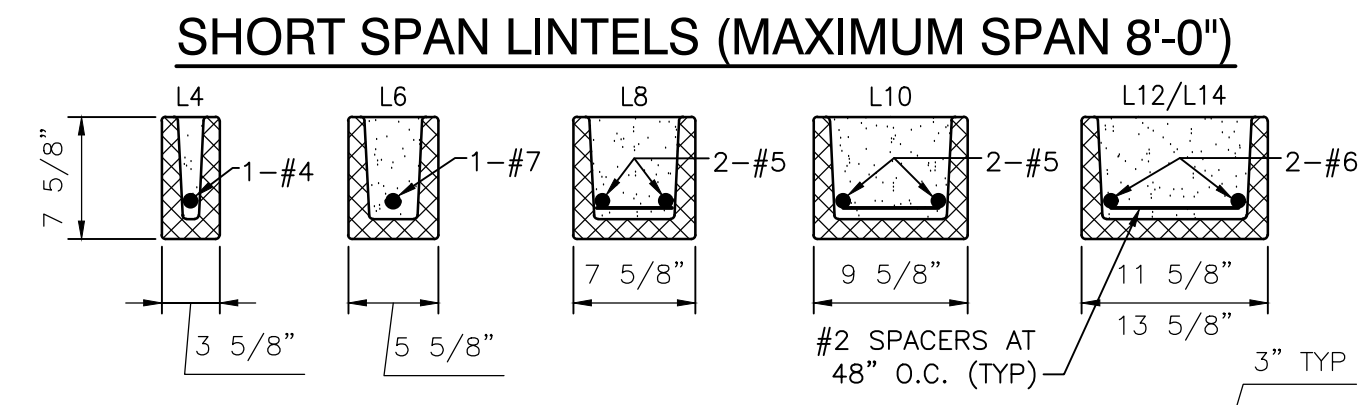

CMU LINTEL SCHEDULE

SCALE: NTS

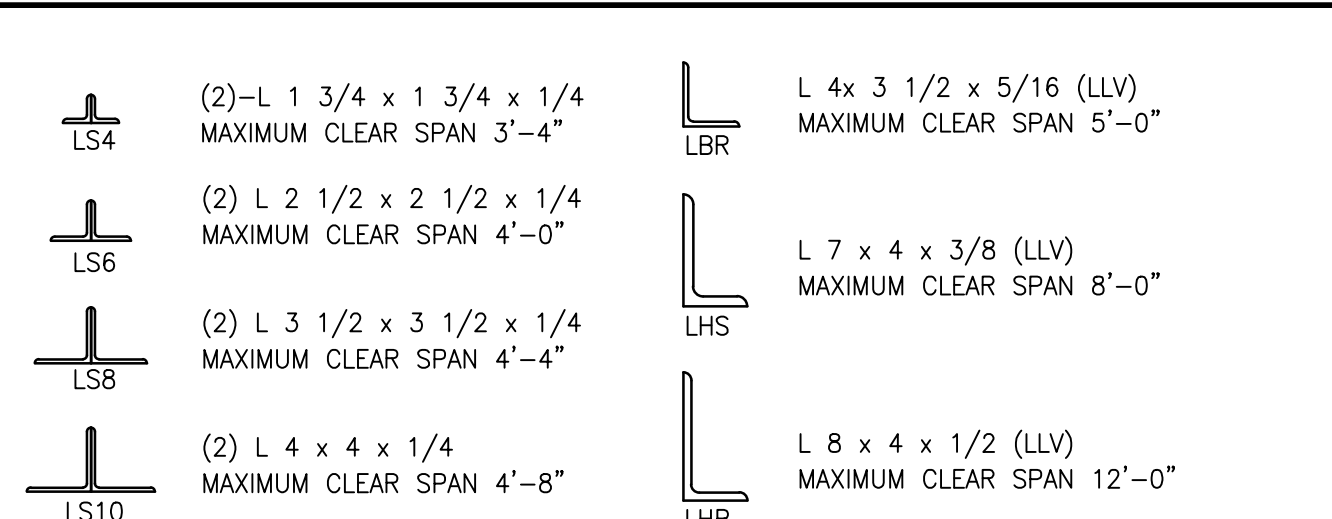


LINTEL NOTES

- LINTELS SHALL BEAR ON SOLID MASONRY OR ON TWO CMU COURSES FULLY GROUTED, UON.
- FURNISH AND INSTALL ALL LOOSE LINTELS REQUIRED FOR ALL OPENINGS IN MASONRY, INCLUDING MECHANICAL AND ELECTRICAL WORK, WHETHER SPECIFICALLY NOTED ON DRAWINGS OR NOT.
- ALL LINTELS AT EXTERIOR LOCATIONS OR OTHERWISE SUBJECT TO WEATHER OR CORROSIVE ATMOSPHERE SHALL BE GALVANIZED.

STEEL LINTEL SCHEDULE

SCALE: NTS

STRUCTURAL LEGEND

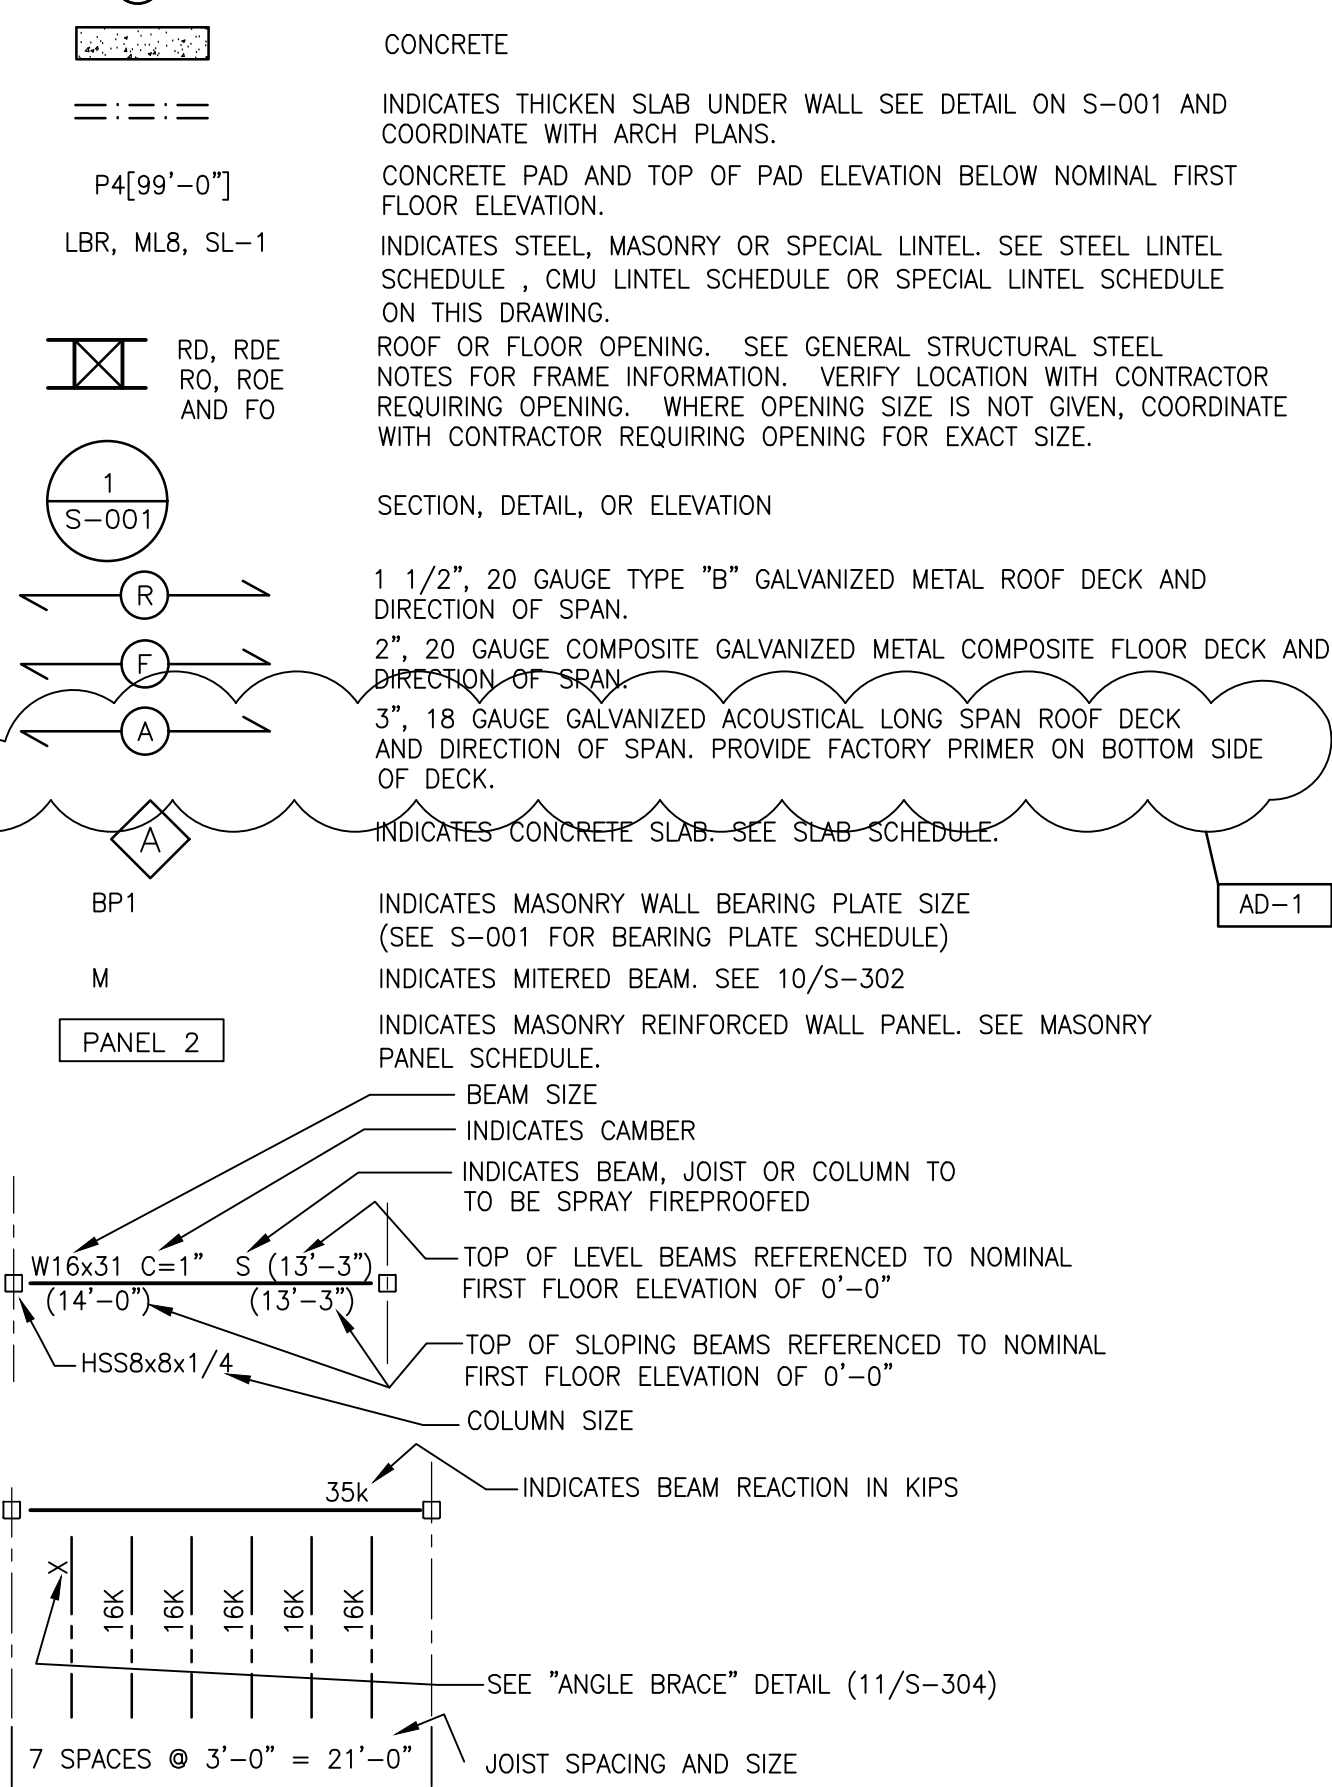

STRUCTURAL ABBREVIATIONS

ALT ARCH	ALTERNATE ARCHITECTURAL	LAT LONG	LATERAL LONGITUDINAL
B/ BM	BOTTOM BEAM	MECH	MECHANICAL
BOBT BRG	BOTTOM BEARING	MIN MAS	MINIMUM MASONRY
CL CMU C TO C	CENTERLINE CONCRETE MASONRY UNIT CENTER TO CENTER	N NO/#	NORTH NOT IN CONTRACT NUMBER
CLR COL	CLEAR/CLEARANCE COLUMN	O.C.	ON CENTER
CONC CONSTR CONTR	CONCRETE CONSTRUCTION CONTRACTOR	O TO O OPNG OPP HD	OUT TO OUT OPENING OPPOSITE HAND
DET DWG	DETAIL DRAWING	P/ PSF	PLATE POUNDS PER SQUARE FOOT
E EA	EAST EACH FACE	REF REINFORC	REFER TO REINFORCING REQUIRED
ELEC EL	ELECTRICAL ELEVATION	S SECT	SOUTH SECTION
EQUIP EW	EQUIPMENT EACH WAY	SHM SPA	SIMILAR SPACE
EXIST EXP	EXISTING EXPANSION	SPEC STD	SPECIFICATIONS STANDARD
FIN FL	FINISH FLOOR	STL STRUCT	STEEL STRUCTURAL
FDN FTG	FOUNDATION FOOTING	T/ TOM	TOP OF MASONRY
GA GC	GAUGE GENERAL CONTRACTOR	TOS THK	TOP OF STEEL THICKNESS
HORIZ HS	HORIZONTAL HIGH STRENGTH	TYP	TYPICAL
HT	HIGH	UON	UNLESS OTHERWISE NOTED
JT	JOINT	VIF VERT	VERIFY IN FIELD VERTICAL
L LLH LLV	ANGLE LONG LEG HORIZONTAL LONG LEG VERTICAL	W W/ WWF	WEST WITH WELED WIRE FABRIC

GENERAL DESIGN NOTES

- BUILDING CODE 2014 INTERNATIONAL BUILDING CODE - (WITH INDIANA ADJUDMENTS)
- DESIGN LOADS:
 ROOF LOADS: DL (PSF) 34
 GENERAL CLASSROOM CORRIDORS OFFICE ENTRY 32 65 32 29
 FLOOR LOADS: DL (PSF) MEZZ/ STORAGE 150
 FLOOR LOADS: LL (PSF) 40
 ROOF LOADS: LL (PSF) GENERAL 20
- SNOW LOAD INFORMATION:
 GROUND SNOW LOAD (Pg) = 20 PSF + DRIFT
 SNOW EXPOSURE FACTOR (Ce) = 0.9
 SNOW LOAD IMPORTANCE FACTOR (Is) = 1.1
 THERMAL FACTOR (T) = 1.0
 FLAT ROOF SNOW LOAD (P) = 28 PSF
- WIND LOAD INFORMATION:
 BASIC WIND SPEED, V wlt = 120 MPH
 WIND IMPORTANCE FACTOR = 1.15
 BUILDING CATEGORY = III
 WIND EXPOSURE = C
 INTERNAL PRESSURE COEFFICIENT (Cp) = ±0.18
- SEISMIC DESIGN DATA:
 BASIC WIND GROUP = II
 SPECTRAL RESPONSE COEFFICIENTS
 Sds = 0.14
 Sd1 = 0.10
 SITE CLASSIFICATION = D
 BASIC SEISMIC-FORCE-RESISTING SYSTEM = 2P
 DESIGN BASE SHEAR (V) = 0.043W
 ANALYSIS PROCEDURE = EQUIVALENT LATERAL FORCE
- VERIFY ALL EXISTING CONDITIONS, WHERE ACTUAL CONDITIONS ARE DIFFERENT THAN INDICATED ON THE DRAWINGS, CONTACT THE ARCHITECT/ENGINEER IMMEDIATELY.

GENERAL FOUNDATION/CONCRETE NOTES

- ALL CONCRETE SHALL BE STONE/GRAVEL AGGREGATE CONCRETE HAVING A MINIMUM COMPRESSIVE STRENGTH AT 28 DAYS AS NOTED IN THE SPECIFICATIONS.
- ALL REINFORCING STEEL SHALL CONFORM TO ASTM A615, GRADE 60 UNLESS NOTED OTHERWISE.
- ALL FOOTINGS AND PADS ARE DESIGNED TO BEAR ON UNDISTURBED SOIL WITH AN ALLOWABLE BEARING CAPACITY OF 2000 PSF.

GENERAL STRUCTURAL STEEL NOTES

- ALL STRUCTURAL STEEL SHALL CONFORM TO THE STANDARD SPECIFICATION FOR STRUCTURAL STEEL, ASTM A992, UNLESS NOTED OTHERWISE.
- ALL JOIST ANCHORS, BEAM BEARING PLATES, LINTELS, METAL DECK ANCHORS, AND METAL BEAMS ARE TO BE FURNISHED BY THE STRUCTURAL METALS CONTRACTOR AND INSTALLED BY THE MASONRY CONTRACTOR.
- PROVIDE CURB ANGLES 3x3x1/4 TO SUPPORT ROOF DECK AT OPENINGS, UNLESS NOTED OTHERWISE.
- STRUCTURAL STEEL FABRICATOR SHALL PROVIDE STEEL FILLS ON BEAM FLANGES WHERE REQUIRED FOR THE BEARING OF METAL DECK.
- STRUCTURAL STEEL FABRICATOR SHALL PROVIDE SUPPORTS FOR METAL DECK AT PERIMETER COLUMNS, BUILDING CORNERS AND ALL OTHER LOCATIONS AS REQUIRED FOR COMPLETE INSTALLATION OF DECK.

GENERAL STEEL DECK NOTES

- METAL DECK MANUFACTURER SHALL PROVIDE 6" WIDE, 22 GAUGE COVER PLATES AT ALL DECK SPLICE LOCATIONS WHERE THE ROOF DECK HAS A CHANGE IN DIRECTION OR SLOPE.
- METAL DECK MANUFACTURER SHALL PROVIDE RECESSED SLUMP PANS TO ACCOMMODATE ROOF DRAINS IN ALL METAL ROOF DECKS.

GENERAL MASONRY NOTES

- ALL CONCRETE MASONRY ASSEMBLAGES ARE DESIGNED FOR AN ULTIMATE COMPRESSIVE STRENGTH f'm = 1500 PSI.
- ALL BEAMS AND LINTELS WHICH BEAR ON MASONRY SHALL BEAR A MINIMUM OF 8 INCHES ONTO MASONRY UNLESS OTHERWISE NOTED.
- BLOCK WALLS SHALL BE LAID UP IN A RUNNING BOND PATTERN UNLESS OTHERWISE NOTED.
- PROVIDE BRACING FOR ALL NON-LOAD BEARING BLOCK PARTITION WALLS PER THE TYPICAL BRACING DETAILS. (4/5-303)
- ALL MASONRY WALLS ON FOUNDATIONS (INTERIOR AND EXTERIOR) SHALL BE REINFORCED WITH #5 AT 48" C TO C UNLESS OTHERWISE NOTED.

GENERAL STEEL JOIST NOTES

- ALL STEEL JOISTS SHALL CONFORM TO THE REQUIREMENTS OF THE STEEL JOIST INSTITUTE. JOIST SUBSTITUTES ARE TO BE EQUAL TO VULCRAFT "VS" SERIES.
- ALL ROOF JOISTS ARE TO BE DESIGNED FOR A NET UPLIFT AS FOLLOWS:
 ALL AREAS: 10PSF
- DESIGN EACH JOIST SEAT FOR A 1 KIP LATERAL LOAD PERPENDICULAR TO THE SEAT DUE TO DIAPHRAGM ACTION, (UNLESS OTHERWISE NOTED - SEE PLANS)

UNDERPINNING NOTES

- EXISTING FOOTING SCHEDULE SHALL BE HAND EXCAVATED IN LENGTHS (PARALLEL TO EXISTING WALL) NOT GREATER THAN SIX (6) FEET AND TO THE WIDTH OF THE EXISTING FOOTING. EXCAVATED AREAS SHALL BE SPACED AT NOT LESS THAN EIGHTEEN (18) FEET ON CENTERS SO THAT NO MORE THAN ONE-THIRD (1/3) OF THE EXISTING FOOTING IS UNDERCUT AT ANY TIME. EXCAVATING SHALL BE DONE FROM THE EXTERIOR OF THE EXISTING FOUNDATION. (SEE 7/5-301)
- UNDERPIN FOOTINGS SHALL BE FORMED AGAINST EARTH EXCEPT FOR EXPOSED SURFACES WHICH SHALL BE FORMED. ALL EARTH SHALL BE REMOVED FROM THE ADJOINING FACE OF UNDERPIN FOOTINGS PRIOR TO PLACING THE ADJACENT SEGMENT.
- THE SPACE (2 INCHES MINIMUM) BETWEEN BOTTOM OF EXISTING FOOTING AND TOP OF UNDERPIN FOOTING SHALL BE PACKED WITH NON-SHRINK GROUT AFTER THE UNDERPIN FOOTING HAS CURED FOR 72 HOURS. NO EXCAVATION OF ADJACENT UNDERPIN SEGMENTS SHALL BE MADE UNTIL NON-SHRINK GROUT IS CURED TO A 2,000 PSI COMPRESSIVE STRENGTH, ACCORDING TO MANUFACTURERS DATA.
- IF THE UNDERPINNING OPERATION RESULTS IN THE UNDERMINING OF THE EXISTING EXTERIOR SLAB, AFTER UNDERPINNING IS COMPLETED, GROUT SHALL BE PUMPED THROUGH CORED HOLES IN THE EXISTING SLAB. GROUTING SHALL BEGIN AT ONE END. GROUT SHALL BE PUMPED INTO THE HOLE UNTIL IT IS FULL OR LUNTLIN. GROUT BEGINS TO SHOW IN THE ADJACENT HOLE. GROUTING SHALL THEN PROCEED AT THE NEXT ADJACENT HOLE.
- UNDERPINNING CONCRETE SHALL BE f'c = 1,500 PSI AT 28 DAYS.
- AS AN ALTERNATIVE TO NOTE 3, EXPANSIVE CEMENT CONCRETE (TYPE K) MAY BE USED, AND THE GROUTING STEP MAY BE OMITTED. IF EXPANSIVE CEMENT CONCRETE IS USED, FORMED SURFACES SHALL BE SECURELY BRACED TO PREVENT MOVEMENT DURING THE CURING.
- THE INSTALLING FOUNDATION CONTRACTOR OR OWNER MUST VERIFY WHAT TYPE OF IN PLACE SHORING AND REPAIRS OR REPLACEMENT OF THE EXISTING BRICK FOUNDATION WALL IS REQUIRED, IN PLACE JACKING OF PORTIONS OF THE HOUSE CURRENTLY BEING SUPPORTED BY THE BRICK FOUNDATION IS TO BE DETERMINED BY THE INSTALLING FOUNDATION REPAIR CONTRACTOR WITH OWNERS APPROVAL. PRIOR TO REMOVAL AND REPLACEMENT WITH CMU. (FIELD VERIFY)



ARCHITECTURE • ENGINEERING • INTERIOR DESIGN

PROJECT ADDITIONS AND RENOVATIONS TO EDGWOOD INTERMEDIATE SCHOOL FRANKLIN TOWNSHIP COMMUNITY SCHOOL CORPORATION INDIANAPOLIS, INDIANA

GENERAL FOUNDATION/CONCRETE NOTES

- ALL CONCRETE SHALL BE STONE/GRAVEL AGGREGATE CONCRETE HAVING A MINIMUM COMPRESSIVE STRENGTH AT 28 DAYS AS NOTED IN THE SPECIFICATIONS.
- ALL REINFORCING STEEL SHALL CONFORM TO ASTM A615, GRADE 60 UNLESS NOTED OTHERWISE.
- ALL FOOTINGS AND PADS ARE DESIGNED TO BEAR ON UNDISTURBED SOIL WITH AN ALLOWABLE BEARING CAPACITY OF 2000 PSF.

GENERAL STRUCTURAL STEEL NOTES

- ALL STRUCTURAL STEEL SHALL CONFORM TO THE STANDARD SPECIFICATION FOR STRUCTURAL STEEL, ASTM A992, UNLESS NOTED OTHERWISE.
- ALL JOIST ANCHORS, BEAM BEARING PLATES, LINTELS, METAL DECK ANCHORS, AND METAL BEAMS ARE TO BE FURNISHED BY THE STRUCTURAL METALS CONTRACTOR AND INSTALLED BY THE MASONRY CONTRACTOR.
- PROVIDE CURB ANGLES 3x3x1/4 TO SUPPORT ROOF DECK AT OPENINGS, UNLESS NOTED OTHERWISE.
- STRUCTURAL STEEL FABRICATOR SHALL PROVIDE STEEL FILLS ON BEAM FLANGES WHERE REQUIRED FOR THE BEARING OF METAL DECK.
- STRUCTURAL STEEL FABRICATOR SHALL PROVIDE SUPPORTS FOR METAL DECK AT PERIMETER COLUMNS, BUILDING CORNERS AND ALL OTHER LOCATIONS AS REQUIRED FOR COMPLETE INSTALLATION OF DECK.

GENERAL STEEL DECK NOTES

- METAL DECK MANUFACTURER SHALL PROVIDE 6" WIDE, 22 GAUGE COVER PLATES AT ALL DECK SPLICE LOCATIONS WHERE THE ROOF DECK HAS A CHANGE IN DIRECTION OR SLOPE.
- METAL DECK MANUFACTURER SHALL PROVIDE RECESSED SLUMP PANS TO ACCOMMODATE ROOF DRAINS IN ALL METAL ROOF DECKS.

GENERAL MASONRY NOTES

- ALL CONCRETE MASONRY ASSEMBLAGES ARE DESIGNED FOR AN ULTIMATE COMPRESSIVE STRENGTH f'm = 1500 PSI.
- ALL BEAMS AND LINTELS WHICH BEAR ON MASONRY SHALL BEAR A MINIMUM OF 8 INCHES ONTO MASONRY UNLESS OTHERWISE NOTED.
- BLOCK WALLS SHALL BE LAID UP IN A RUNNING BOND PATTERN UNLESS OTHERWISE NOTED.
- PROVIDE BRACING FOR ALL NON-LOAD BEARING BLOCK PARTITION WALLS PER THE TYPICAL BRACING DETAILS. (4/5-303)
- ALL MASONRY WALLS ON FOUNDATIONS (INTERIOR AND EXTERIOR) SHALL BE REINFORCED WITH #5 AT 48" C TO C UNLESS OTHERWISE NOTED.

GENERAL STEEL JOIST NOTES

- ALL STEEL JOISTS SHALL CONFORM TO THE REQUIREMENTS OF THE STEEL JOIST INSTITUTE. JOIST SUBSTITUTES ARE TO BE EQUAL TO VULCRAFT "VS" SERIES.
- ALL ROOF JOISTS ARE TO BE DESIGNED FOR A NET UPLIFT AS FOLLOWS:
 ALL AREAS: 10PSF
- DESIGN EACH JOIST SEAT FOR A 1 KIP LATERAL LOAD PERPENDICULAR TO THE SEAT DUE TO DIAPHRAGM ACTION, (UNLESS OTHERWISE NOTED - SEE PLANS)

UNDERPINNING NOTES

- EXISTING FOOTING SCHEDULE SHALL BE HAND EXCAVATED IN LENGTHS (PARALLEL TO EXISTING WALL) NOT GREATER THAN SIX (6) FEET AND TO THE WIDTH OF THE EXISTING FOOTING. EXCAVATED AREAS SHALL BE SPACED AT NOT LESS THAN EIGHTEEN (18) FEET ON CENTERS SO THAT NO MORE THAN ONE-THIRD (1/3) OF THE EXISTING FOOTING IS UNDERCUT AT ANY TIME. EXCAVATING SHALL BE DONE FROM THE EXTERIOR OF THE EXISTING FOUNDATION. (SEE 7/5-301)
- UNDERPIN FOOTINGS SHALL BE FORMED AGAINST EARTH EXCEPT FOR EXPOSED SURFACES WHICH SHALL BE FORMED. ALL EARTH SHALL BE REMOVED FROM THE ADJOINING FACE OF UNDERPIN FOOTINGS PRIOR TO PLACING THE ADJACENT SEGMENT.
- THE SPACE (2 INCHES MINIMUM) BETWEEN BOTTOM OF EXISTING FOOTING AND TOP OF UNDERPIN FOOTING SHALL BE PACKED WITH NON-SHRINK GROUT AFTER THE UNDERPIN FOOTING HAS CURED FOR 72 HOURS. NO EXCAVATION OF ADJACENT UNDERPIN SEGMENTS SHALL BE MADE UNTIL NON-SHRINK GROUT IS CURED TO A 2,000 PSI COMPRESSIVE STRENGTH, ACCORDING TO MANUFACTURERS DATA.
- IF THE UNDERPINNING OPERATION RESULTS IN THE UNDERMINING OF THE EXISTING EXTERIOR SLAB, AFTER UNDERPINNING IS COMPLETED, GROUT SHALL BE PUMPED THROUGH CORED HOLES IN THE EXISTING SLAB. GROUTING SHALL BEGIN AT ONE END. GROUT SHALL BE PUMPED INTO THE HOLE UNTIL IT IS FULL OR LUNTLIN. GROUT BEGINS TO SHOW IN THE ADJACENT HOLE. GROUTING SHALL THEN PROCEED AT THE NEXT ADJACENT HOLE.
- UNDERPINNING CONCRETE SHALL BE f'c = 1,500 PSI AT 28 DAYS.
- AS AN ALTERNATIVE TO NOTE 3, EXPANSIVE CEMENT CONCRETE (TYPE K) MAY BE USED, AND THE GROUTING STEP MAY BE OMITTED. IF EXPANSIVE CEMENT CONCRETE IS USED, FORMED SURFACES SHALL BE SECURELY BRACED TO PREVENT MOVEMENT DURING THE CURING.
- THE INSTALLING FOUNDATION CONTRACTOR OR OWNER MUST VERIFY WHAT TYPE OF IN PLACE SHORING AND REPAIRS OR REPLACEMENT OF THE EXISTING BRICK FOUNDATION WALL IS REQUIRED, IN PLACE JACKING OF PORTIONS OF THE HOUSE CURRENTLY BEING SUPPORTED BY THE BRICK FOUNDATION IS TO BE DETERMINED BY THE INSTALLING FOUNDATION REPAIR CONTRACTOR WITH OWNERS APPROVAL. PRIOR TO REMOVAL AND REPLACEMENT WITH CMU. (FIELD VERIFY)


STRUCTURAL SECTIONS, DETAILS AND NOTES

PROJECT ADDITIONS AND RENOVATIONS TO EDGWOOD INTERMEDIATE SCHOOL



GIBRALTAR
DESIGN
ARCHITECTURE • ENGINEERING • INTERIOR DESIGN


PROJECT
ADDITIONS AND RENOVATIONS TO
EDGEWOOD INTERMEDIATE SCHOOL
FRANKLIN TOWNSHIP COMMUNITY SCHOOL CORPORATION
INDIANAPOLIS, INDIANA

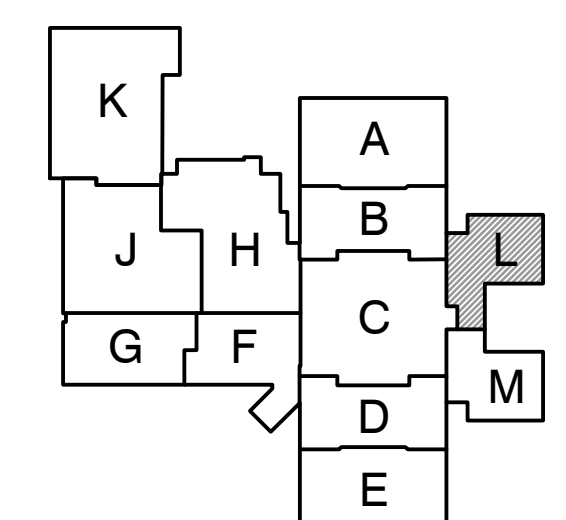

FIRST FLOOR KEY PLAN

GIBRALTAR DESIGN
9102 N. Meridian St., Ste. 300
Indianapolis, IN 46260
Homepage: www.GibraltarDesign.com
Email: info@GibraltarDesign.com
Phone: 317.580.5777 Fax: 317.580.5778

PROJECT: 21-155
DATE: 05/23/22
COORDINATED BY: RM
DRAWN BY: RM
CHECKED BY: RM, DW

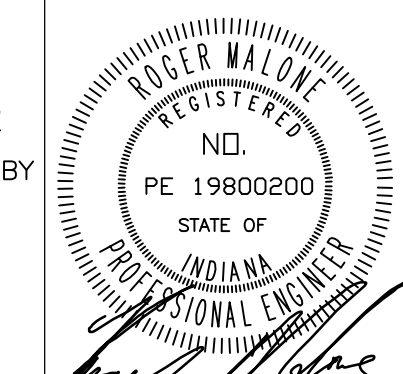

COPYRIGHT NOTICE:
THE CONCEPTS, DESIGNS, PLANS, DETAILS, ETC. SHOWN ON THIS DOCUMENT ARE THE PROPERTY OF GIBRALTAR DESIGN AND WERE CREATED FOR USE ON THIS SPECIFIC PROJECT. NONE OF THIS INFORMATION SHALL BE USED BY ANY PERSON OR FIRM FOR ANY PURPOSE WITHOUT THE EXPRESS WRITTEN CONSENT OF GIBRALTAR DESIGN. THE OWNER MAY RETAIN COPIES FOR INFORMATION AND REFERENCE IN CONNECTION ONLY WITH THIS PROJECT.

MARK	DATE	ISSUED FOR
AD-1	06/16/22	ADDENDUM NO. 1


DRAWING
UNIT "L" ROOF FRAMING PLAN

PROJECT
ADDITIONS AND RENOVATIONS TO
EDGEWOOD INTERMEDIATE SCHOOL


© GIBRALTAR DESIGN SHEET
L SF113

FRAMING PLAN NOTES


















































- SEE DRAWINGS S-001 FOR GENERAL NOTES, STRUCTURAL LEGEND, SCHEDULES AND TYPICAL DETAILS.
- ALL ELEVATIONS ARE REFERENCED FROM A FINISH FLOOR ELEVATION OF 0'-0" PER AREA. SEE PLAN AND VERIFY WITH ARCHITECTURAL FLOOR PLANS.
- TEMPORARY BRACING NEEDED UNTIL ROOF METAL DECK DIAPHRAGM INSTALLED.
- SEE DRAWINGS S-301 THROUGH S-303 FOR STEEL FRAMING DETAILS.
- ROOF AND FLOOR OPENINGS REQUIRED FRAMES. SEE 7/5-302 GENERAL STEEL NOTES. RD, RO AND FO INDICATES FRAME REQUIRED (SEE PLAN)

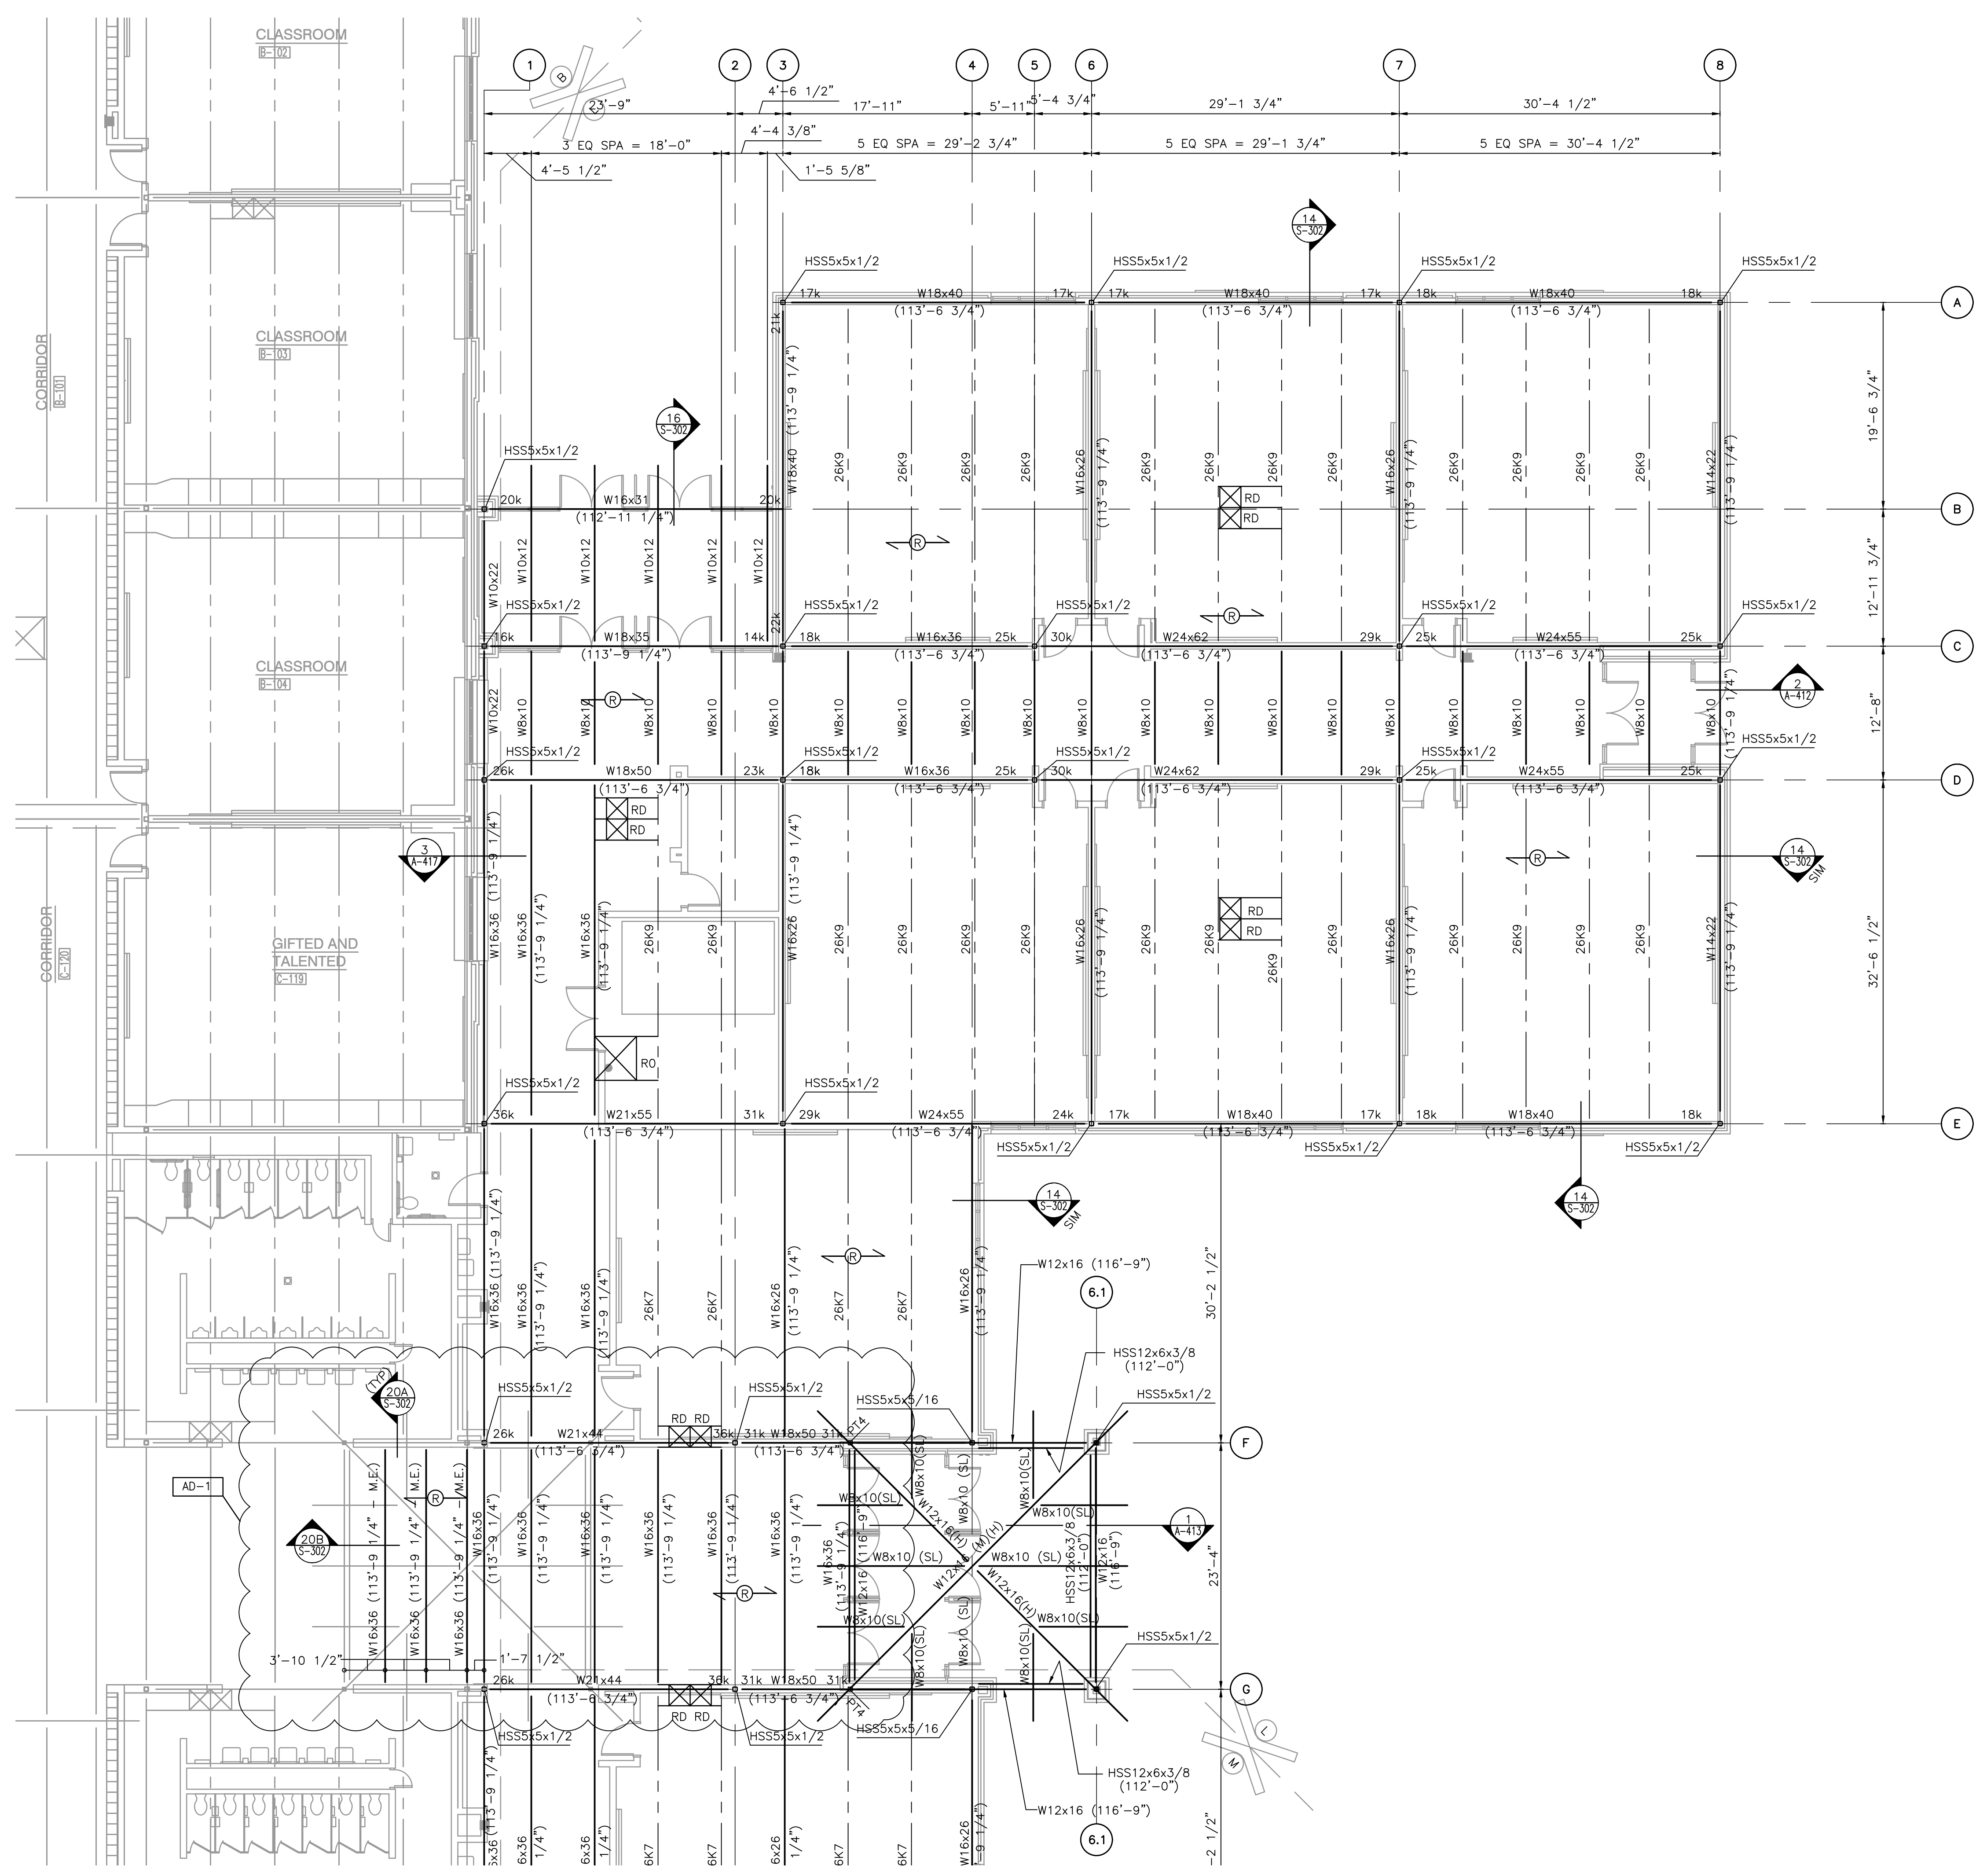

UNIT "L" ROOF FRAMING PLAN
SCALE: 1/8" = 1'-0"

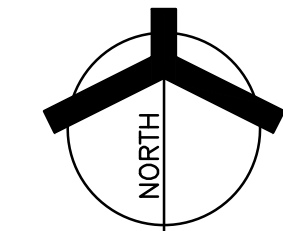

Tuesday, 6/14/2022 - 4:27 PM - LAST SAVED BY: RMALONE
Y:\21-155 FRANKLIN TOWNSHIP CSC-EDGEWOOD IS
ADDITIONS AND RENOVATIONS\21-155 DRAWINGS\04
STRC\SF113.DWG

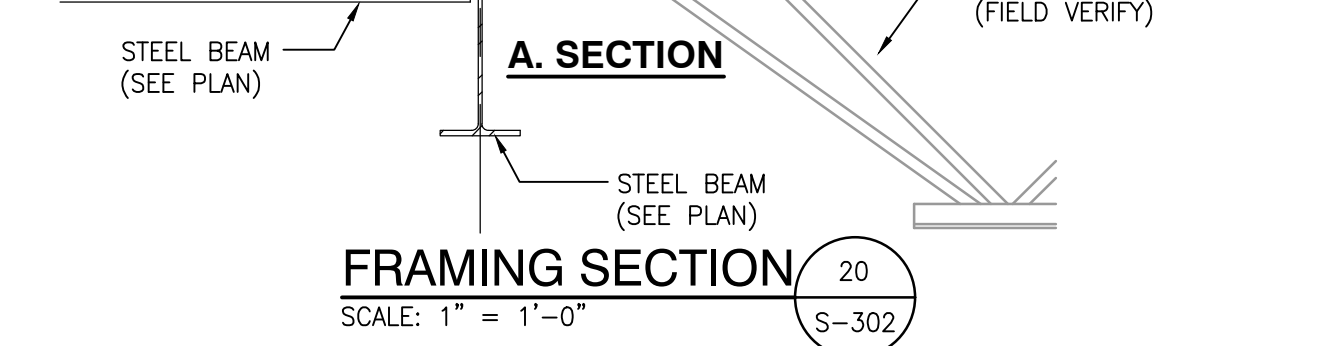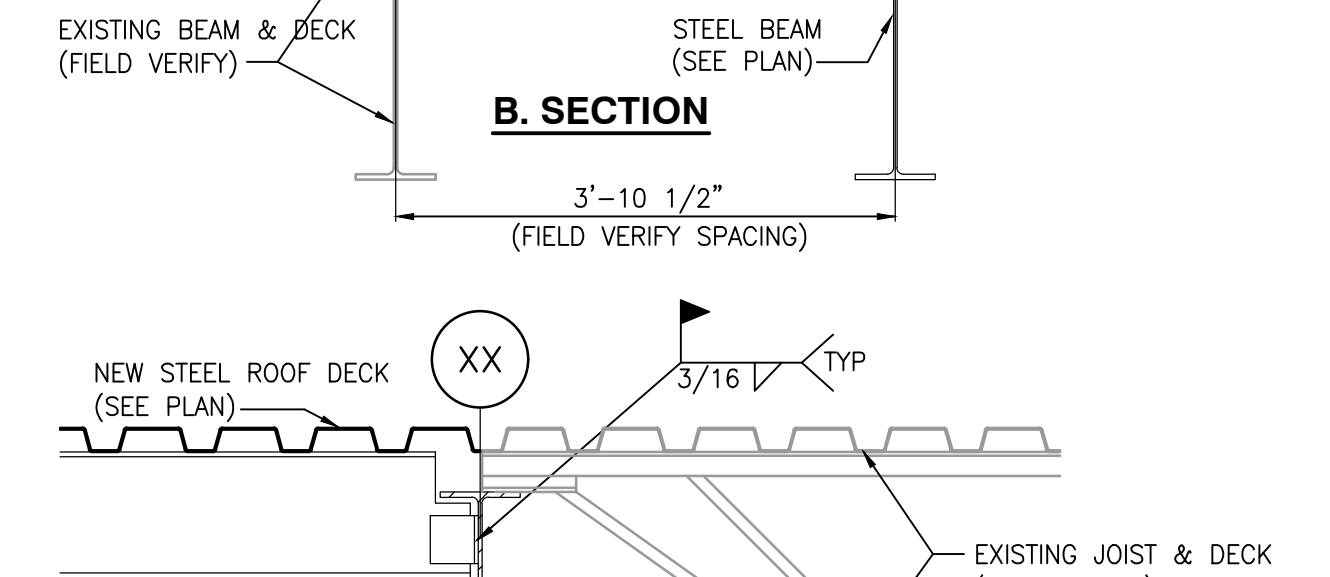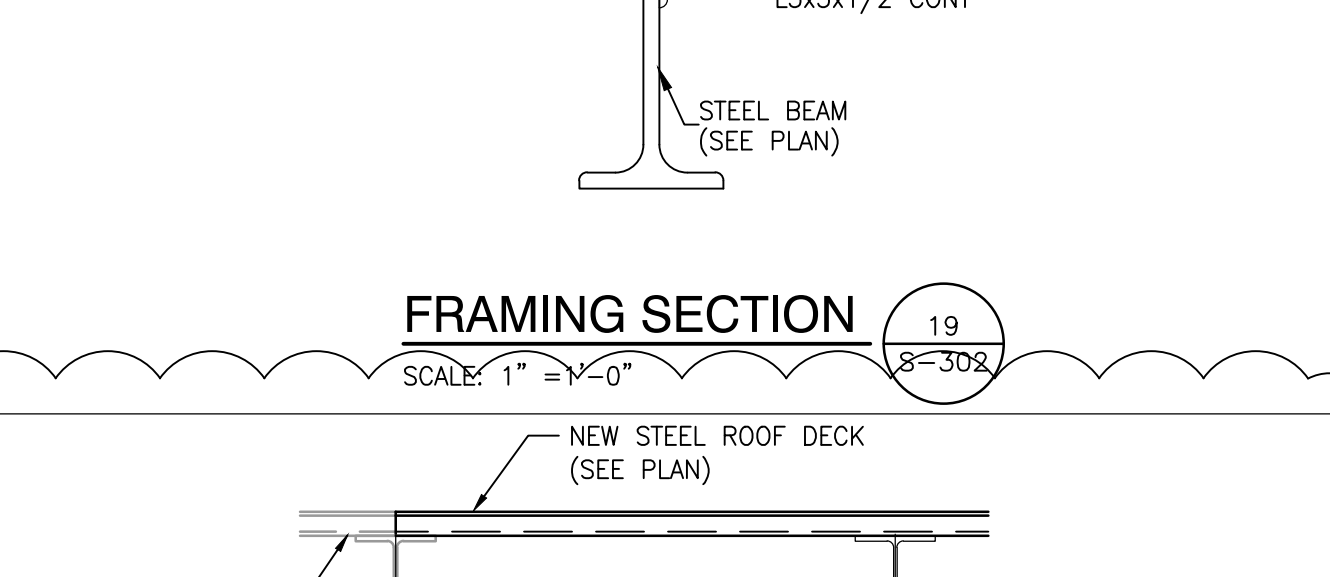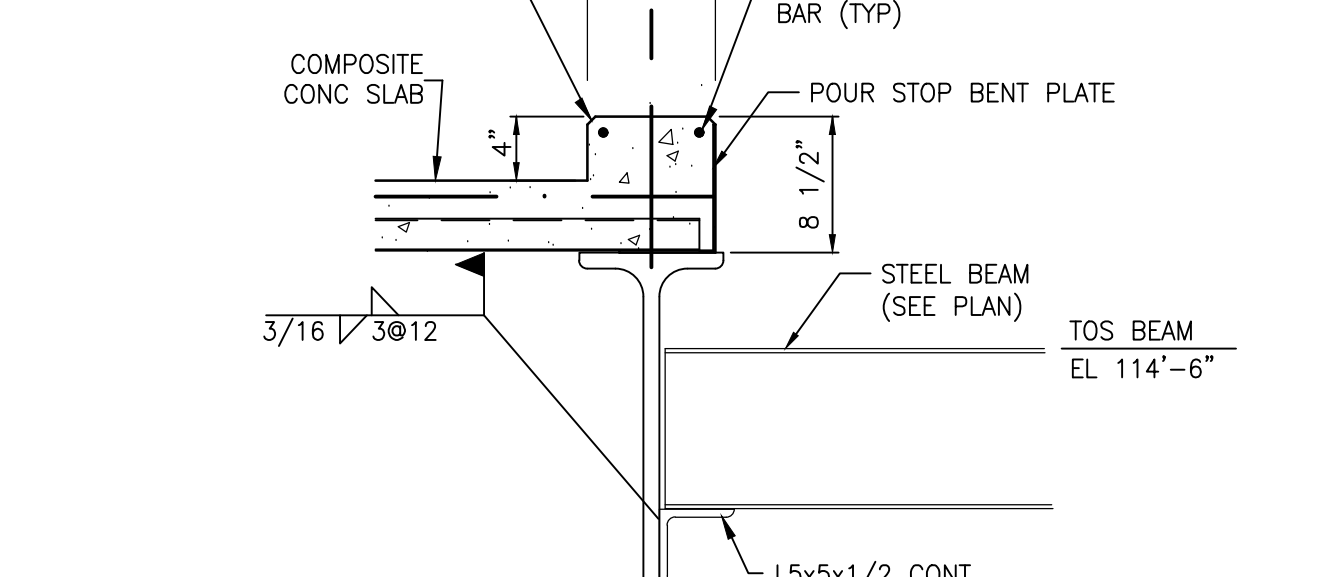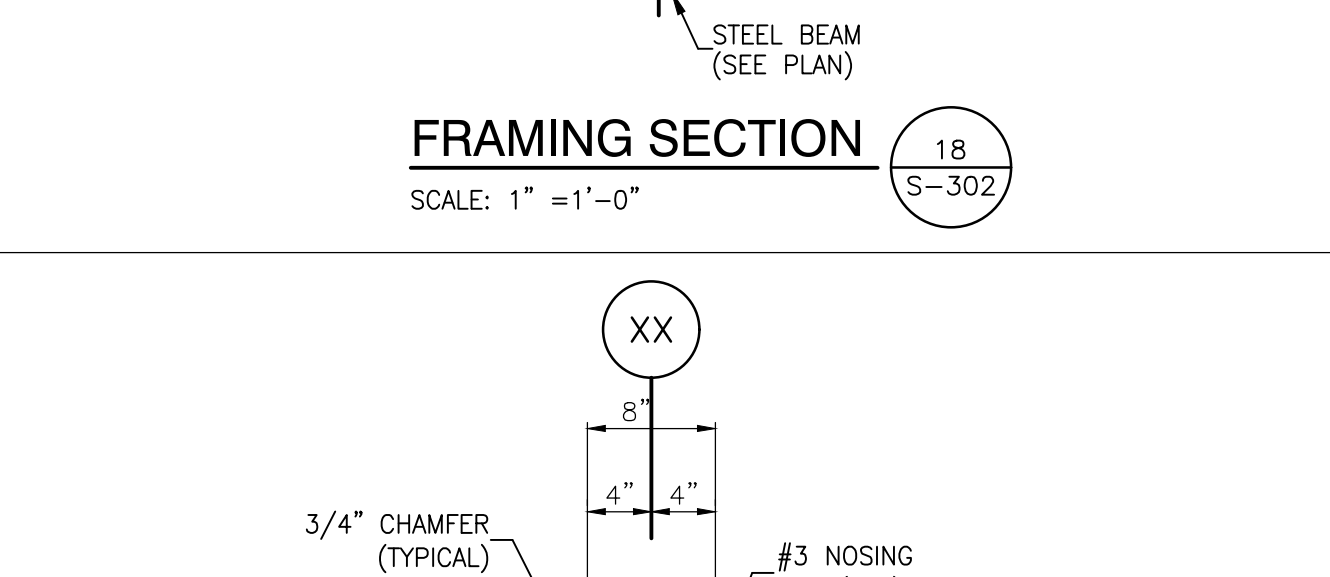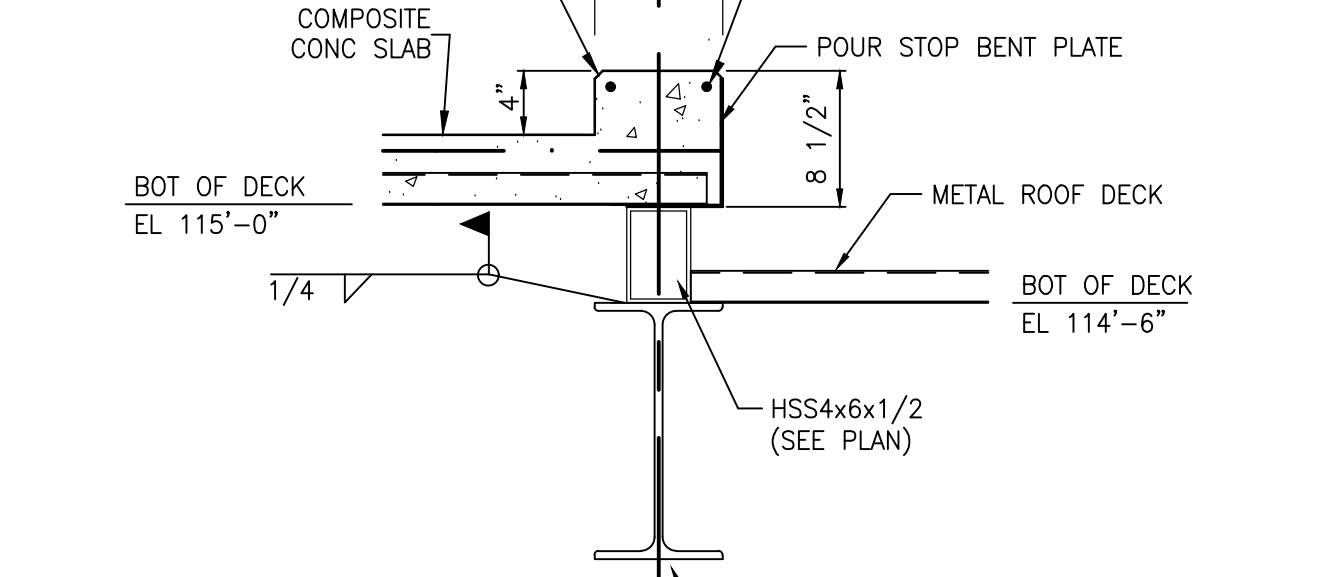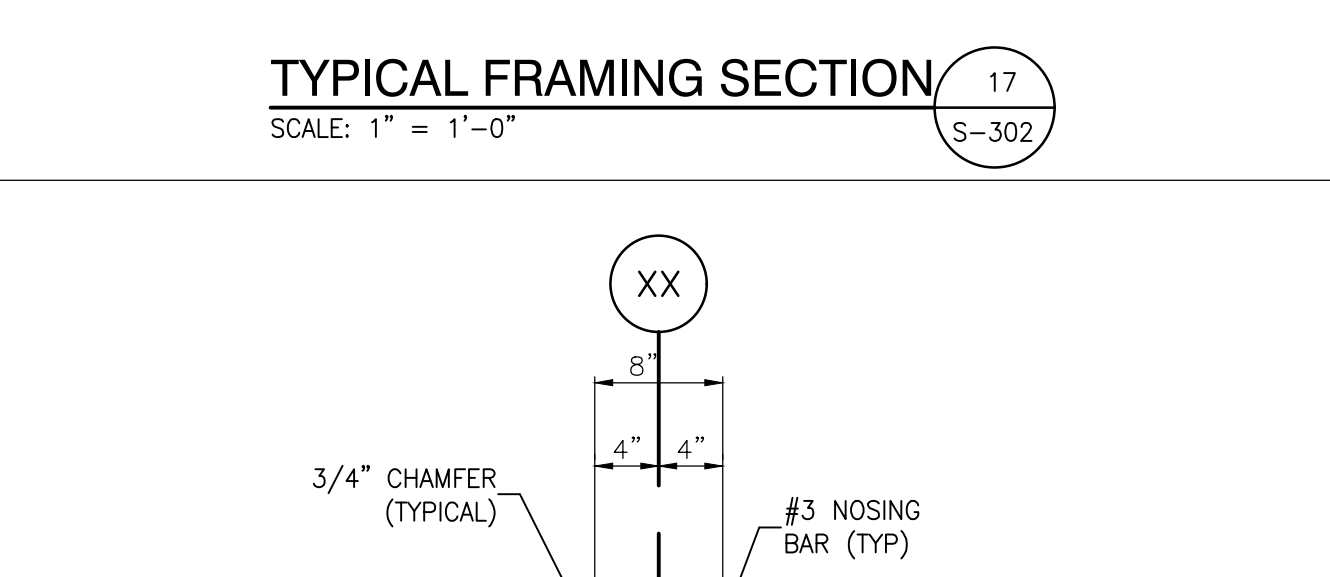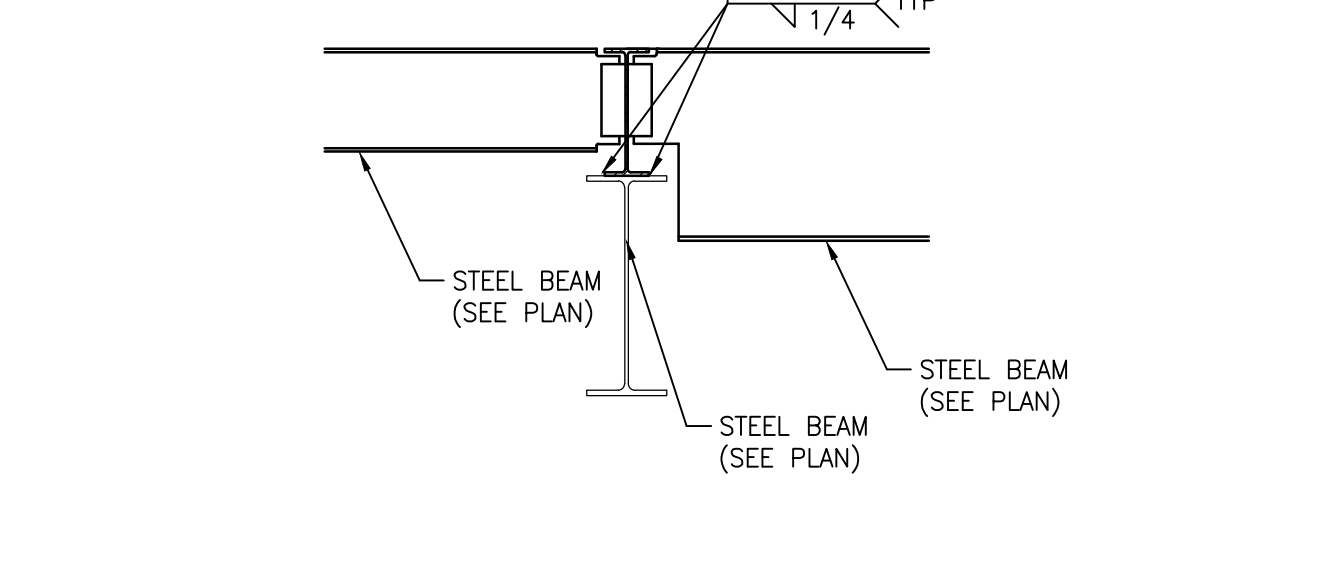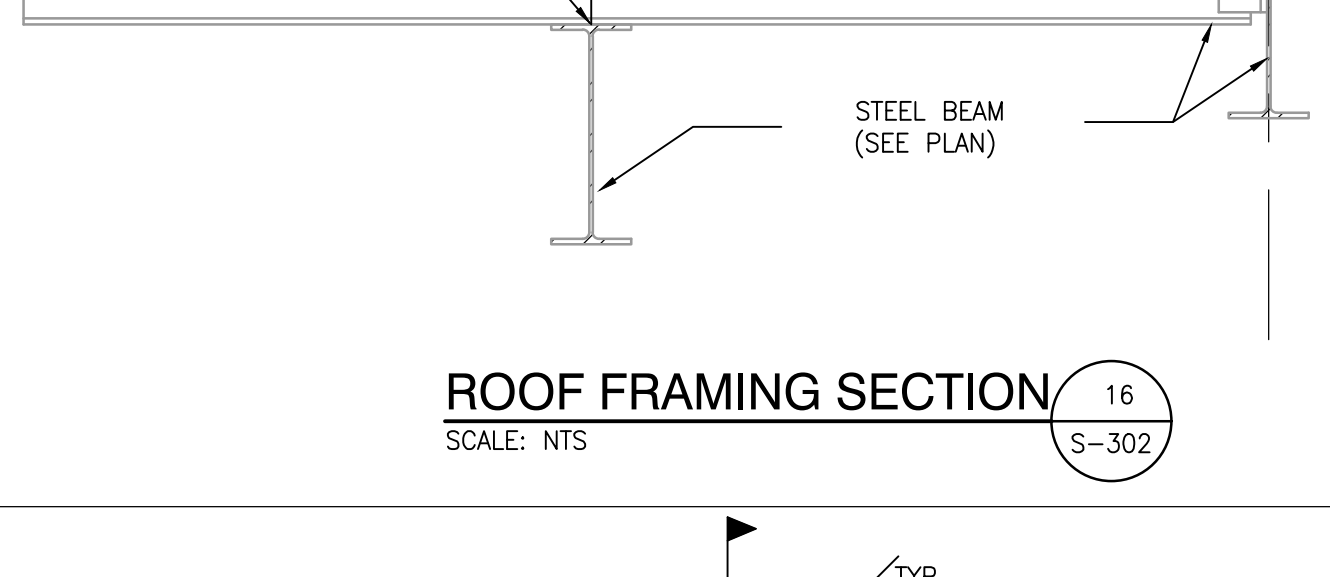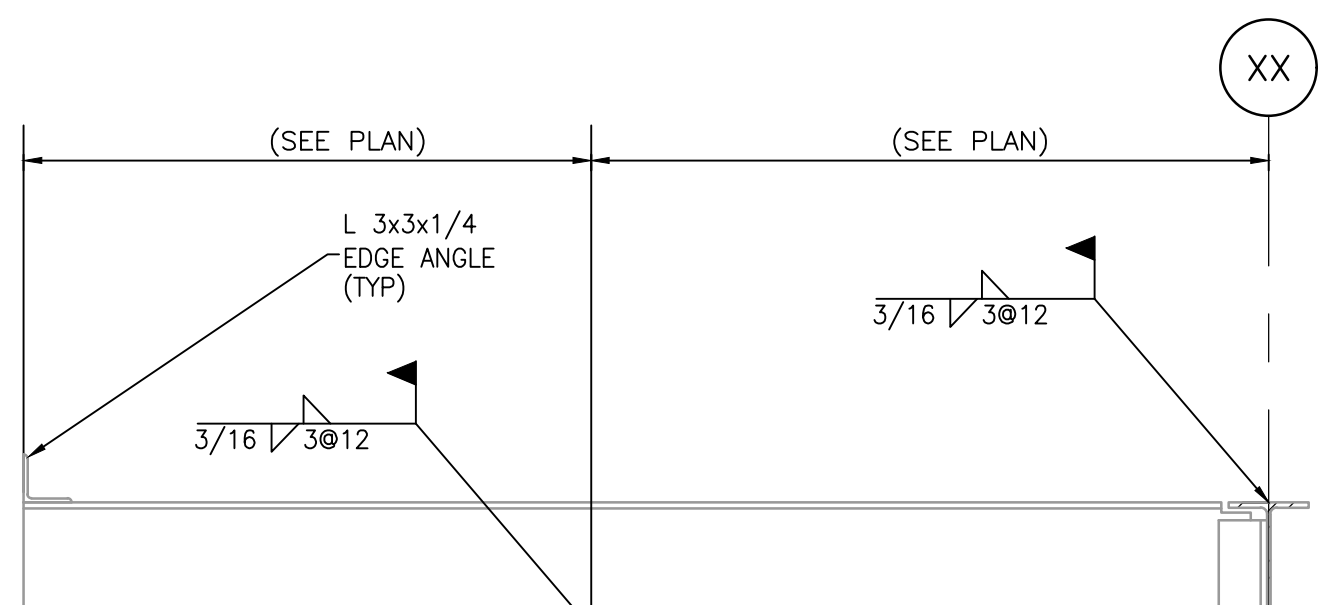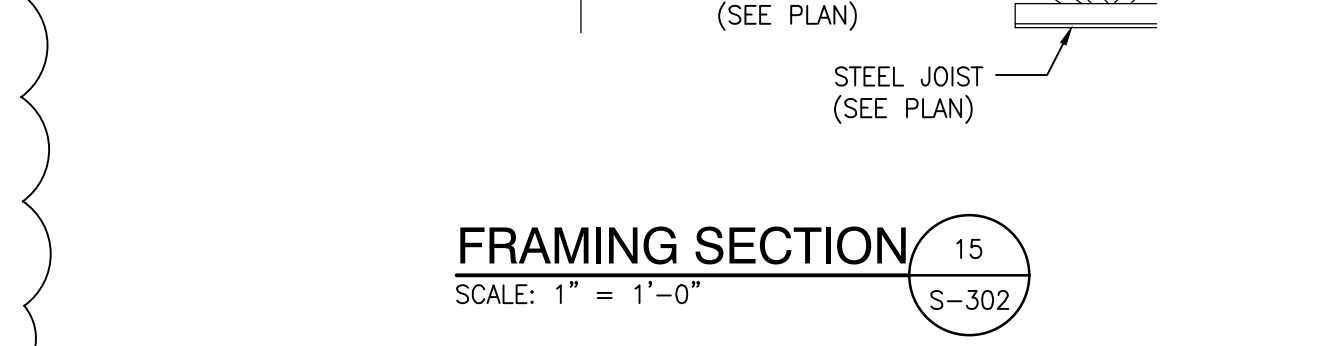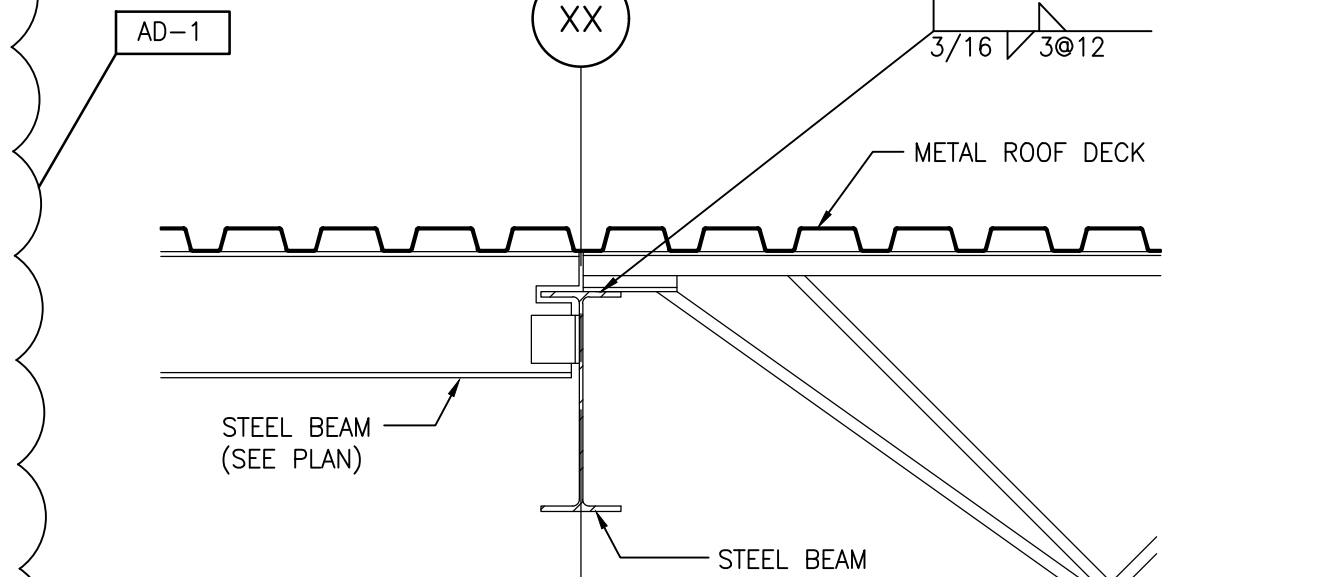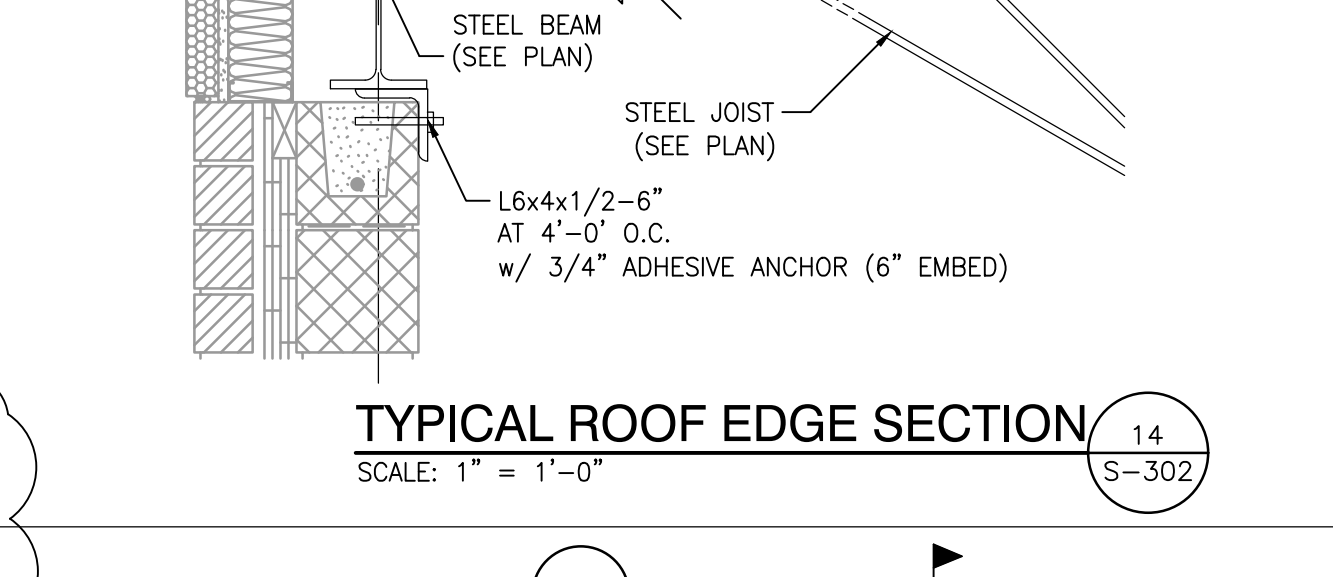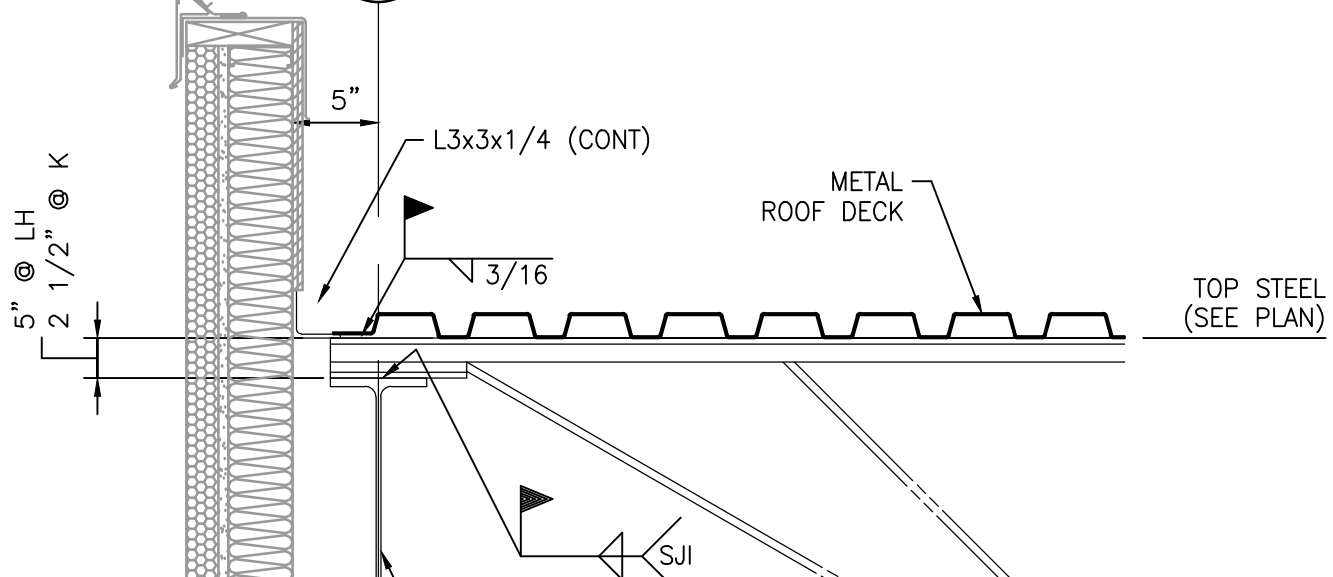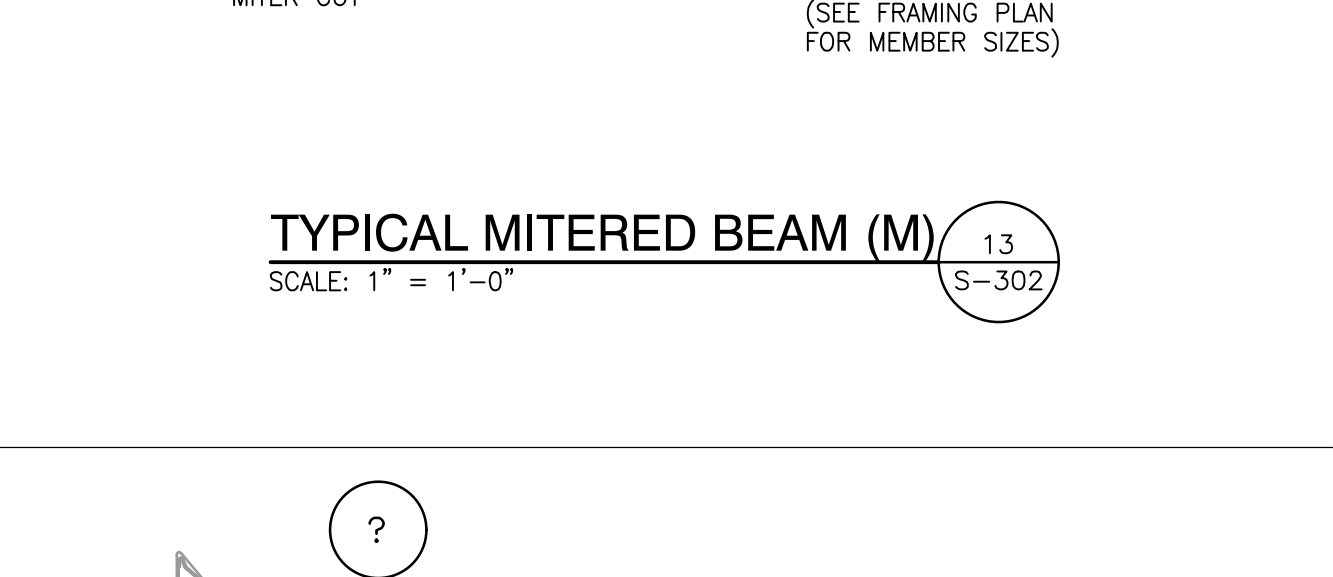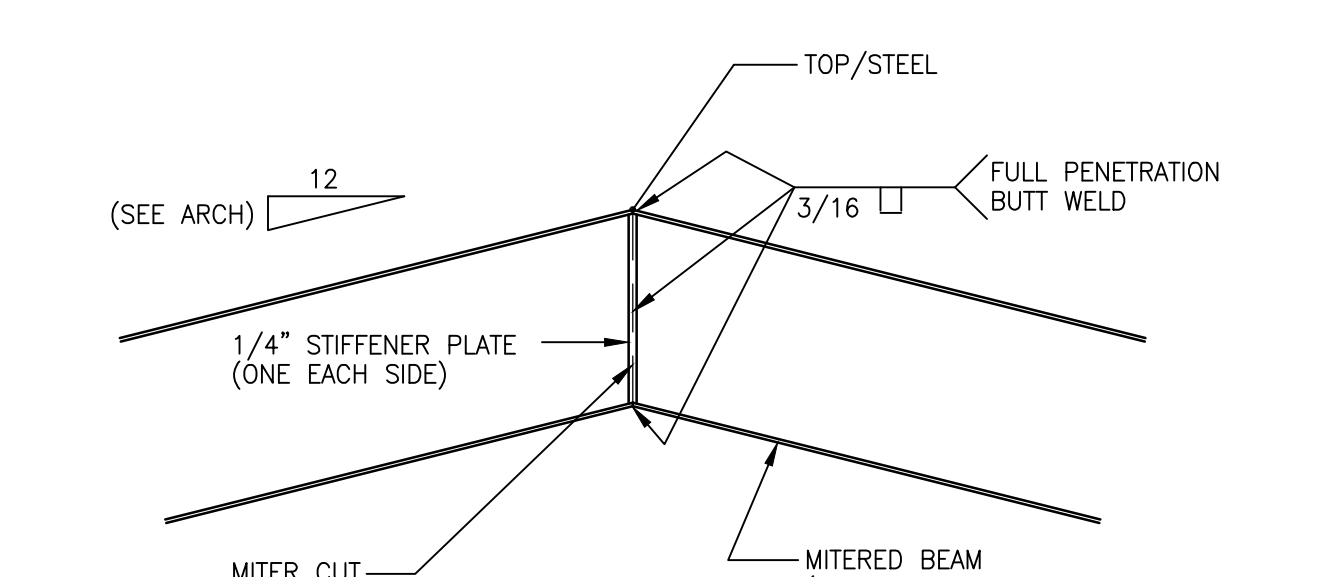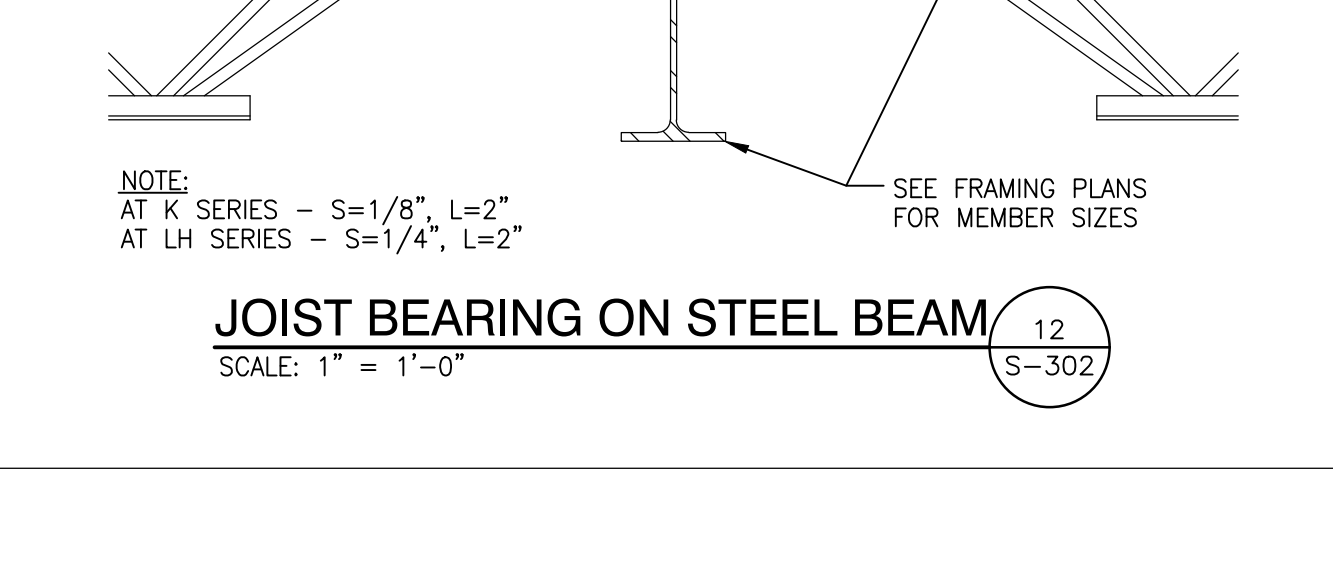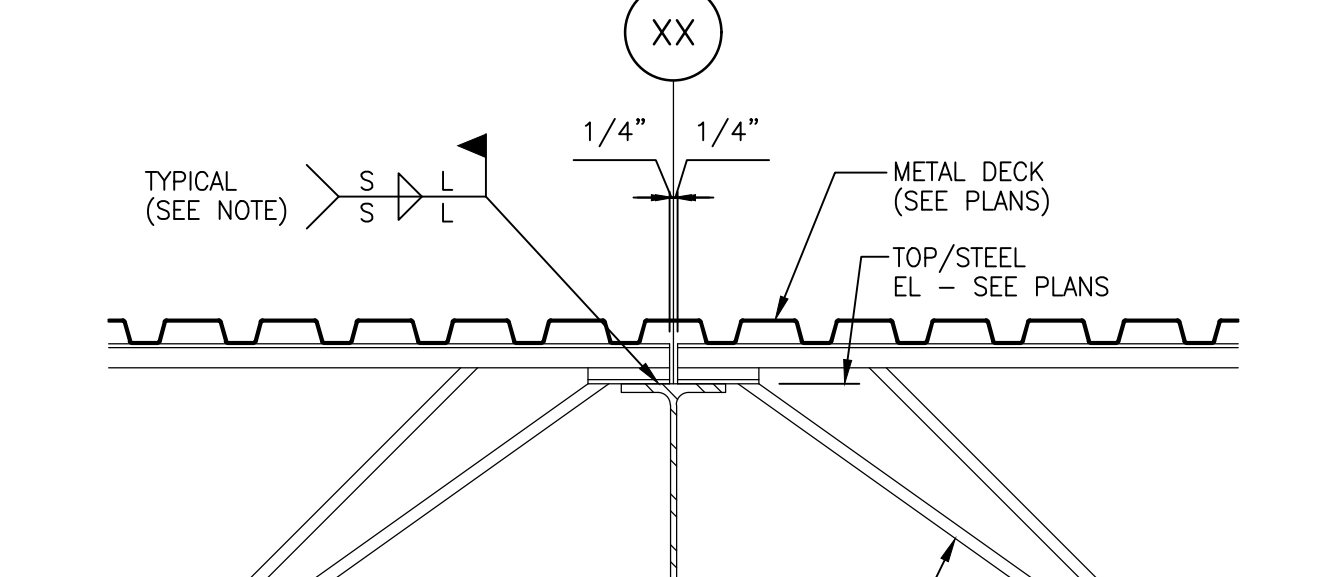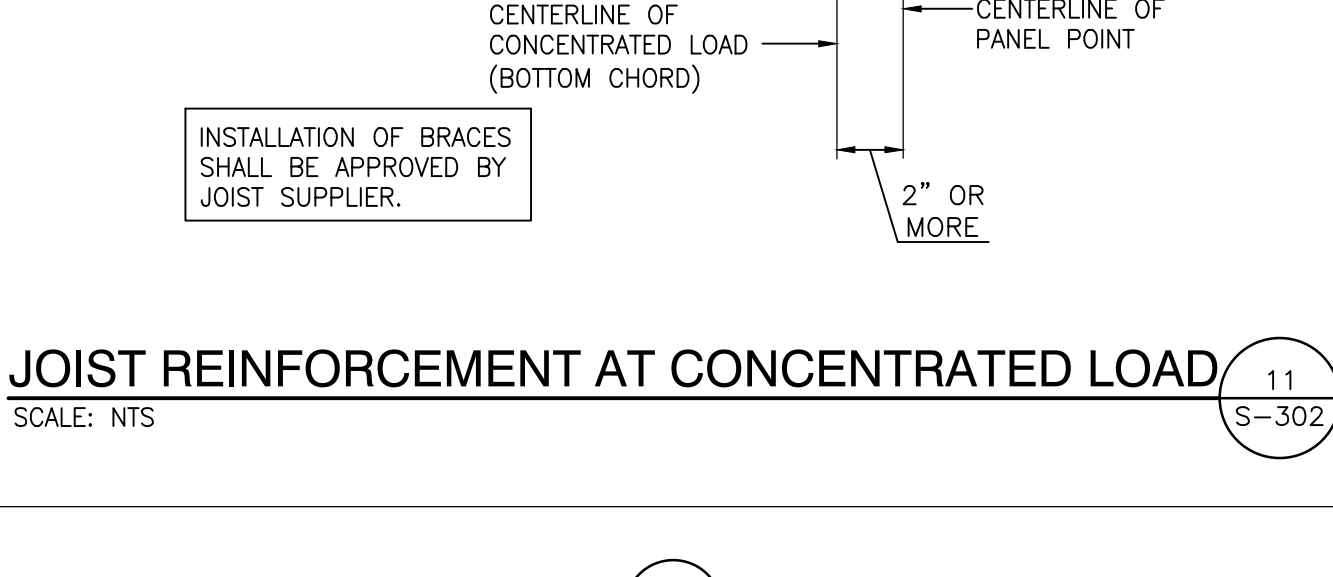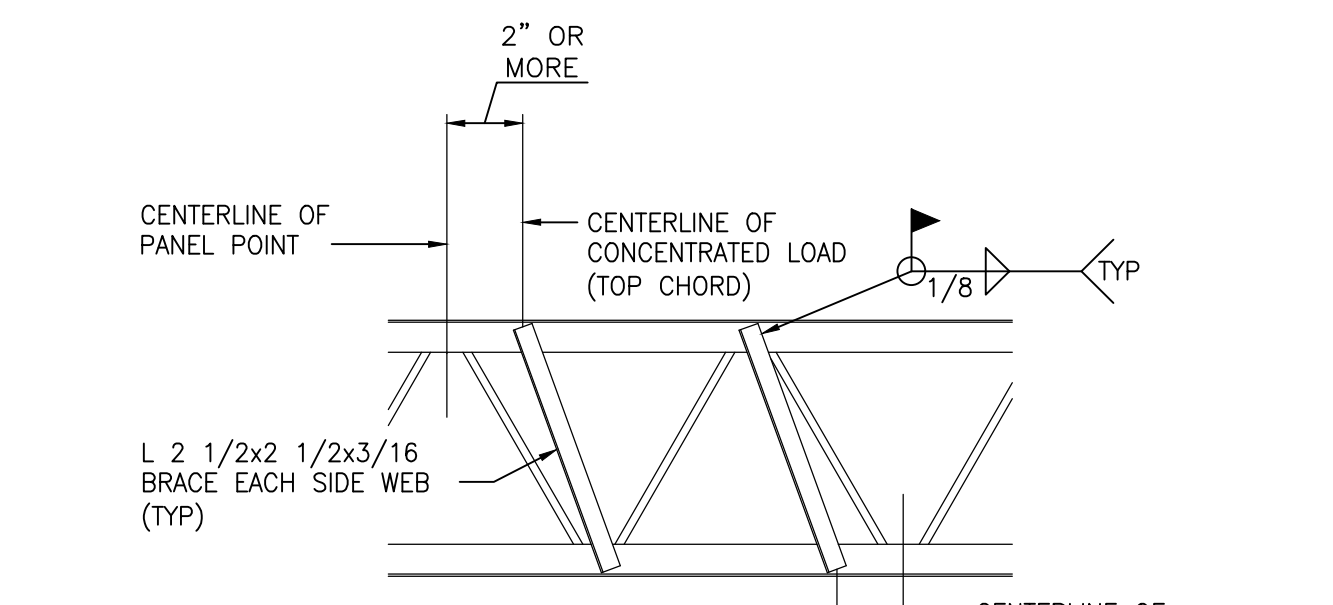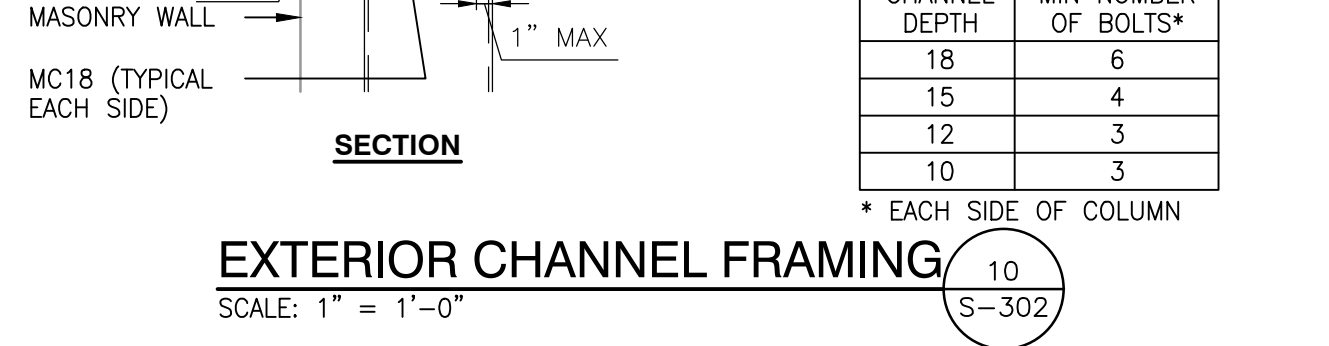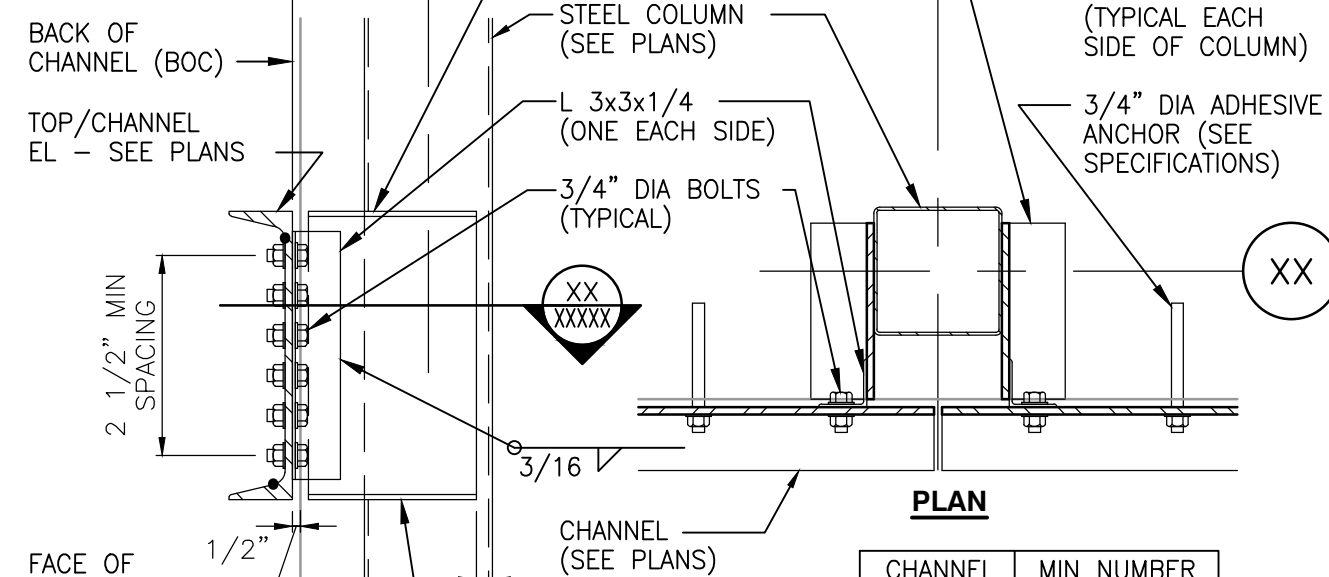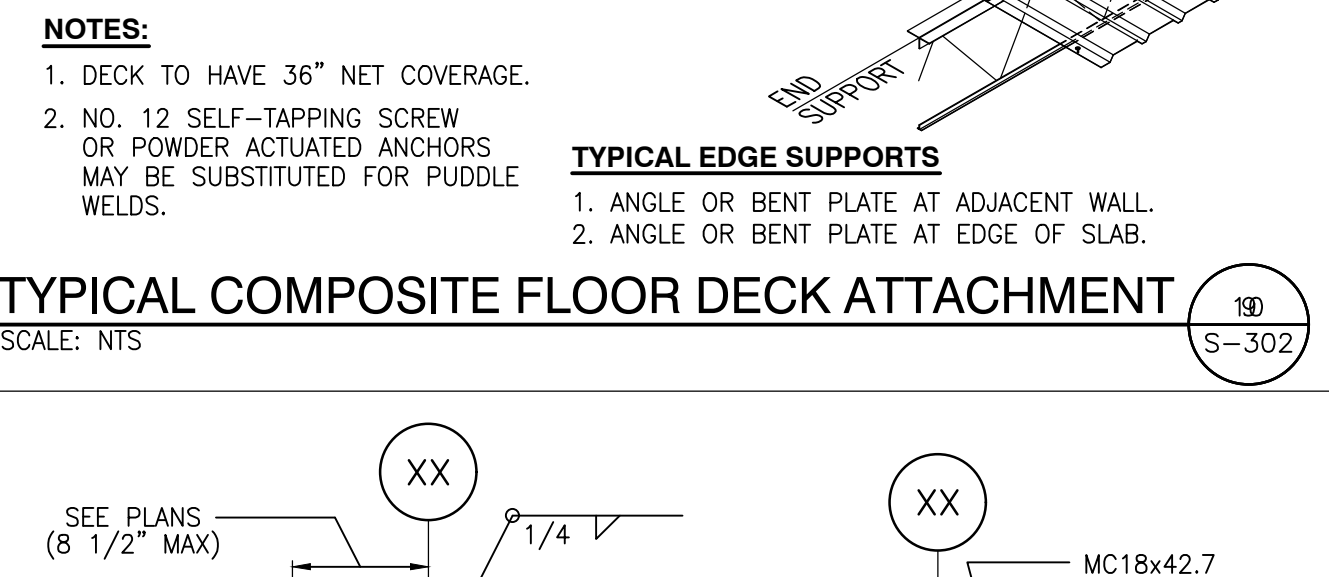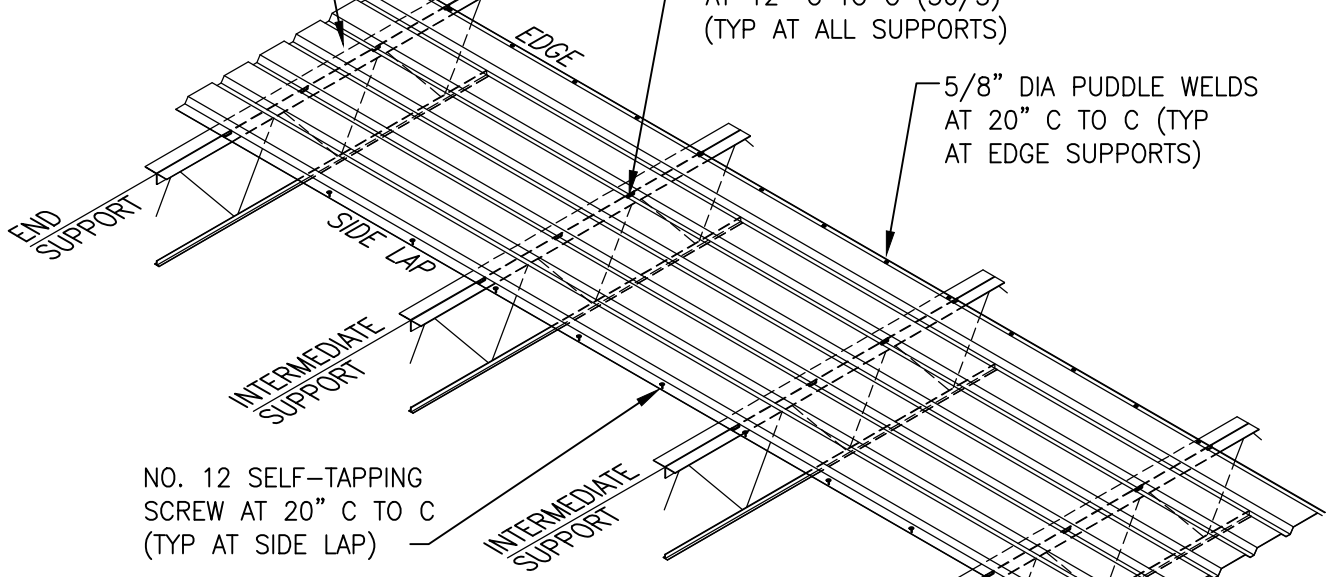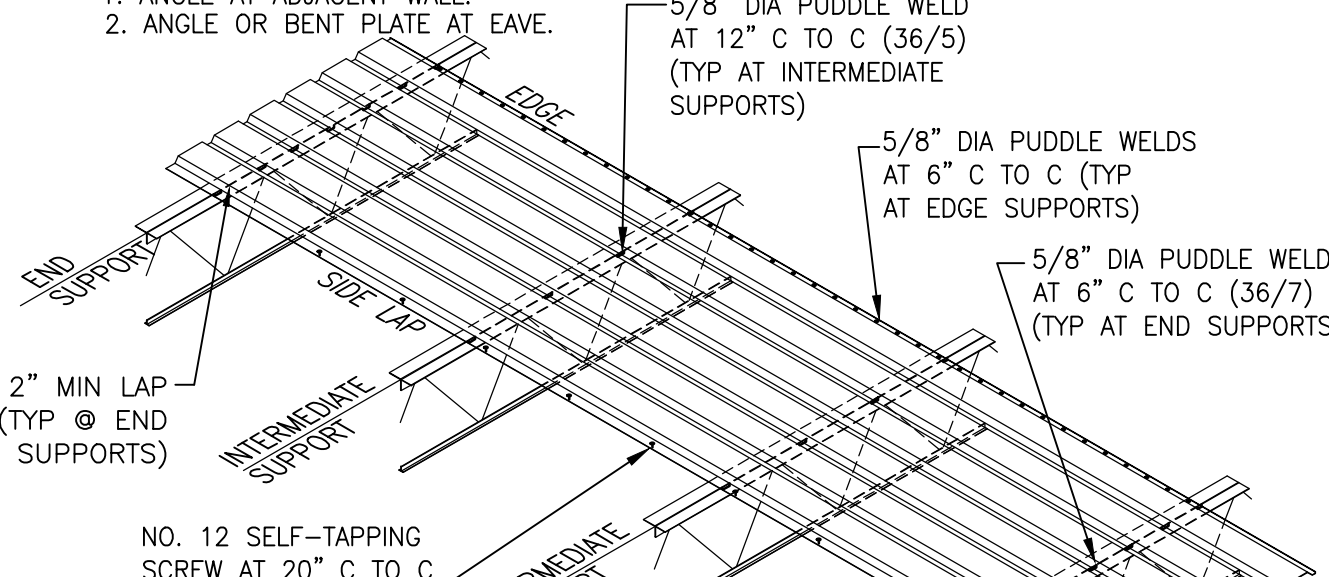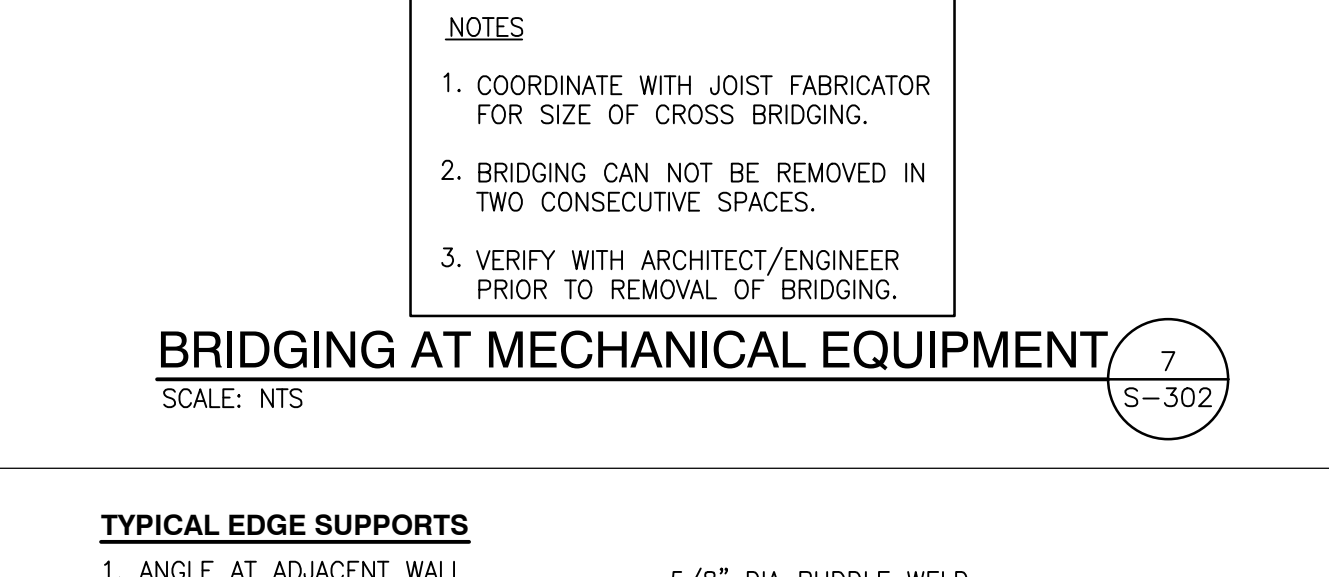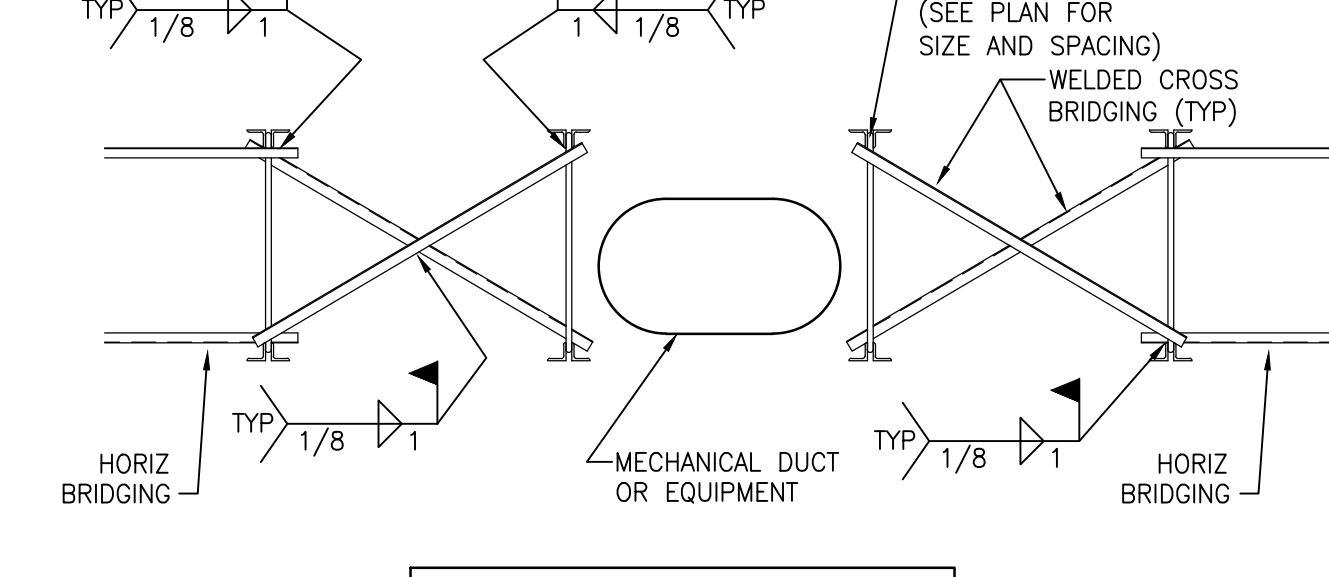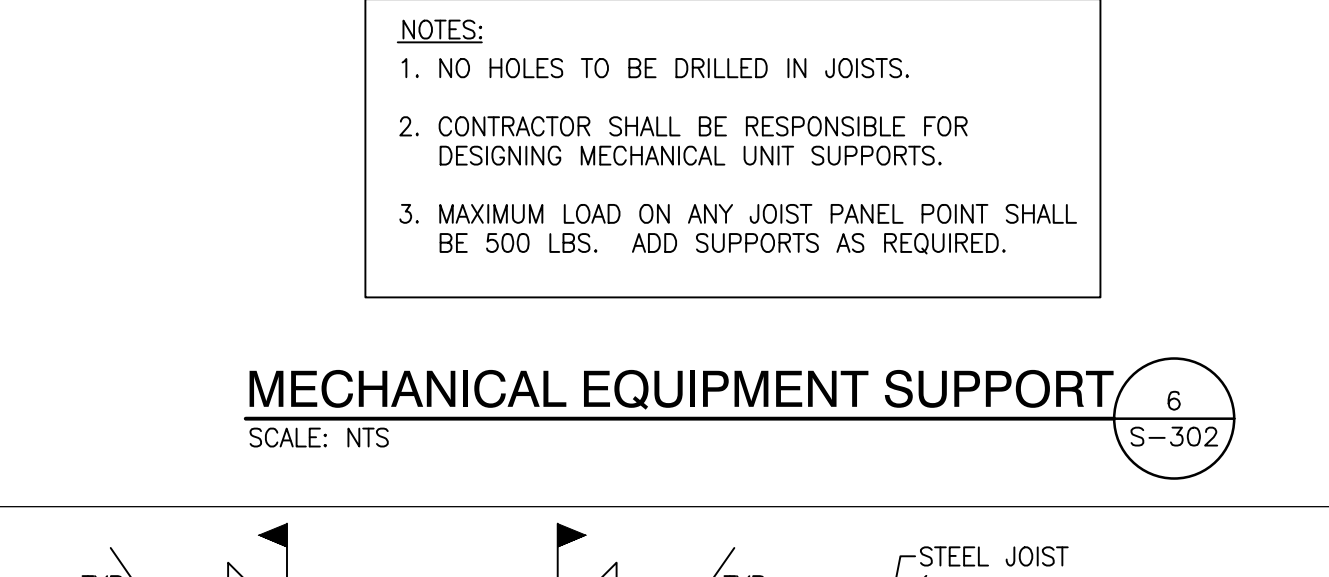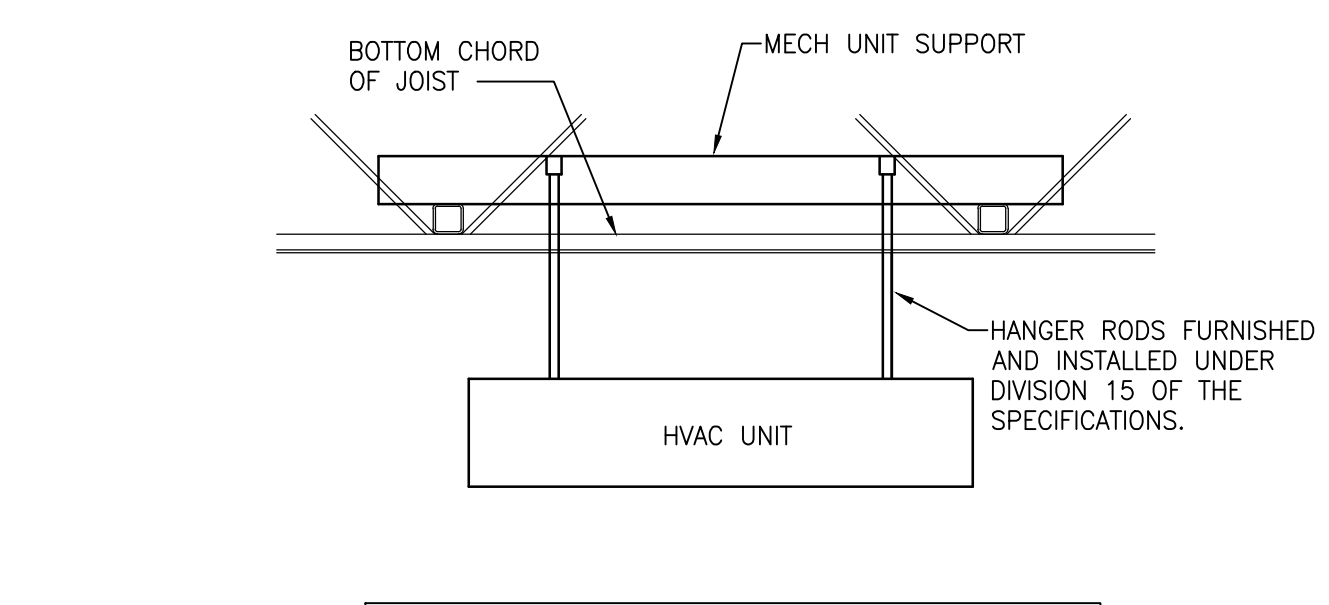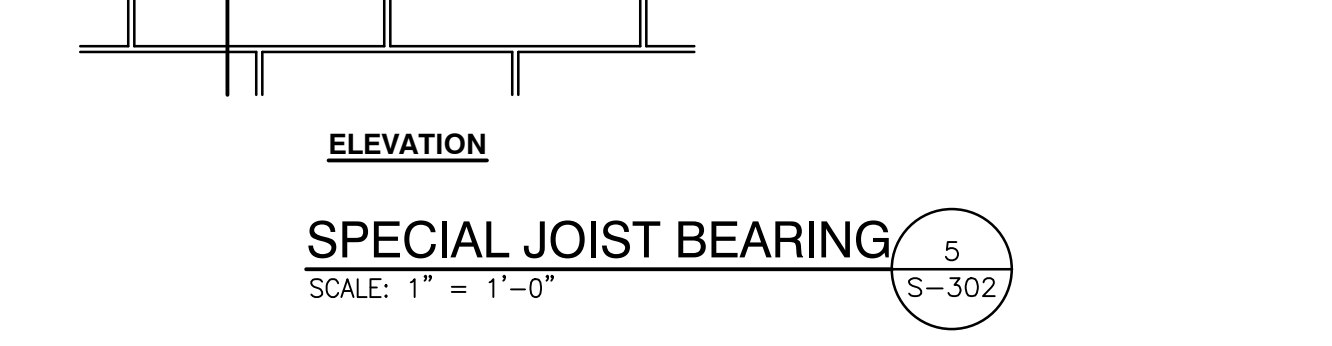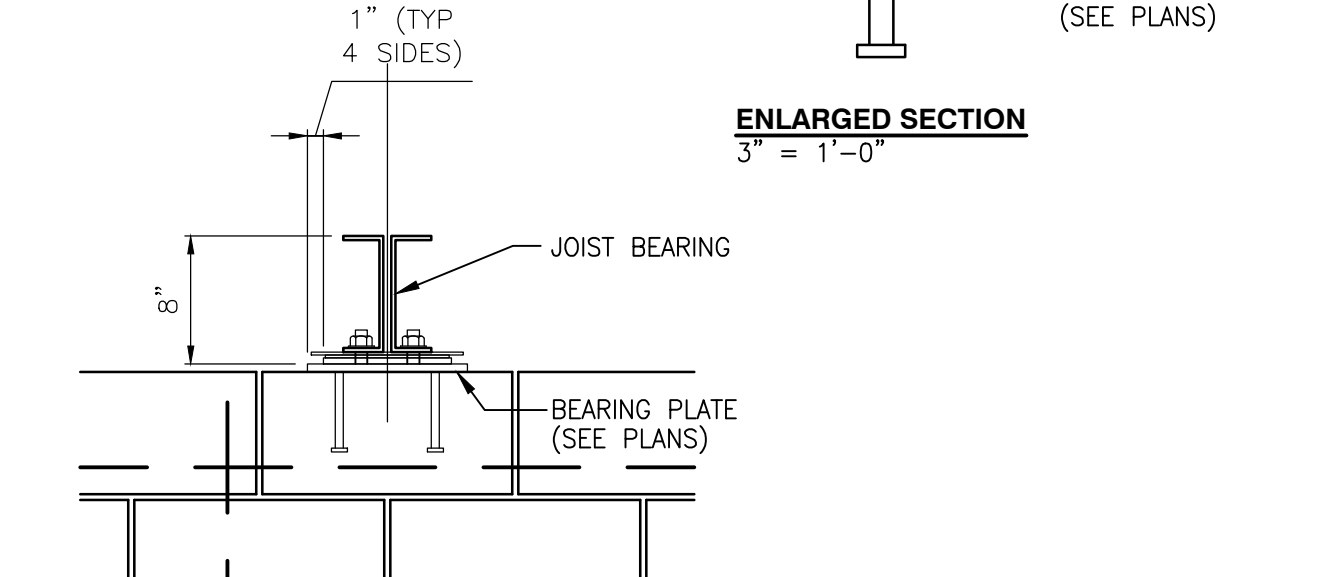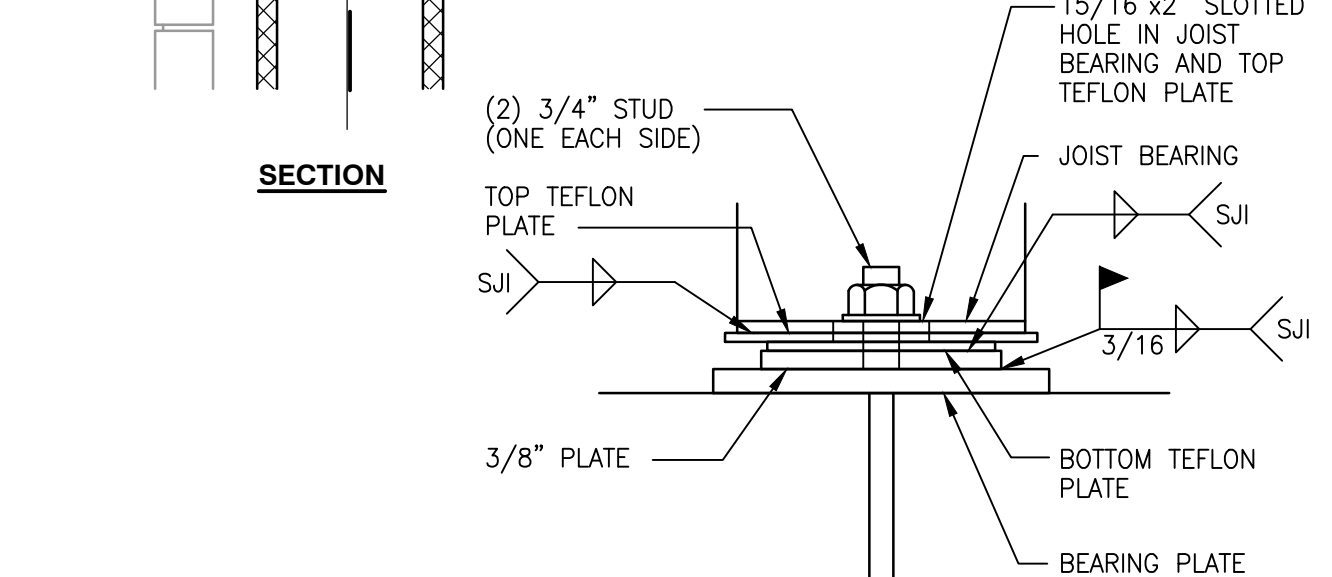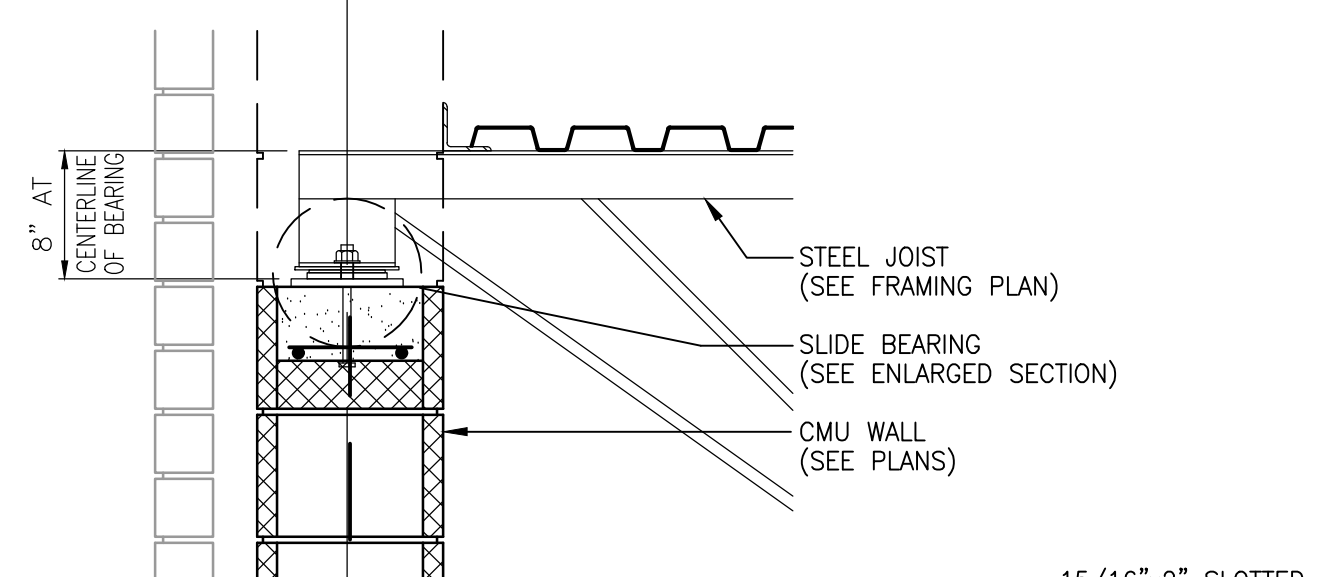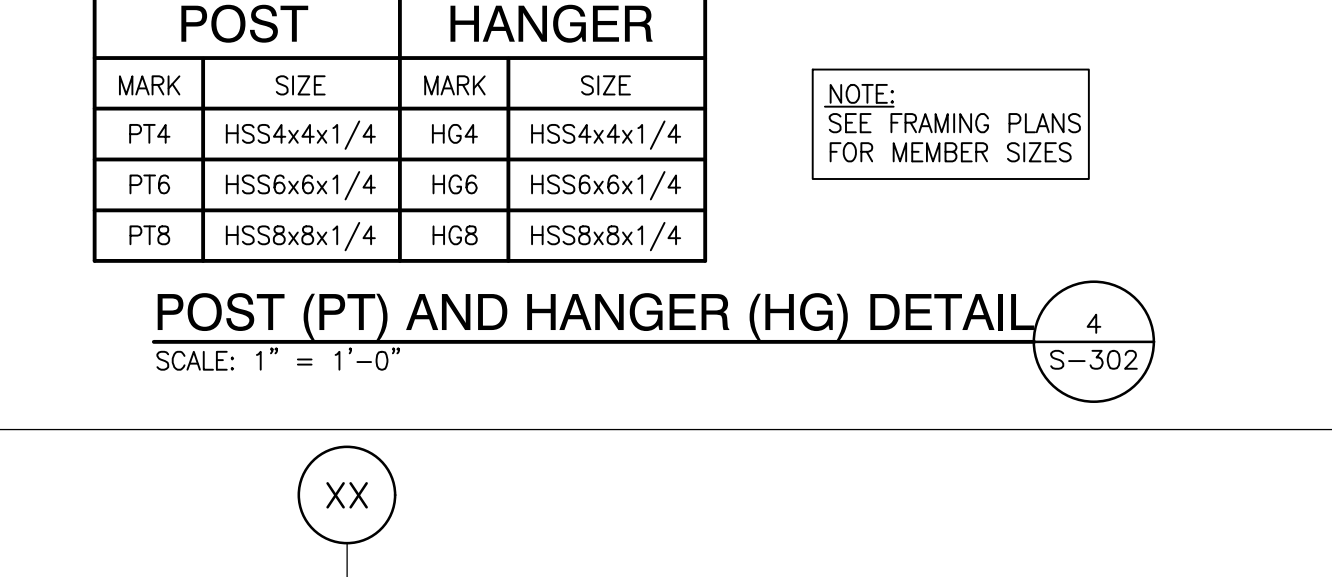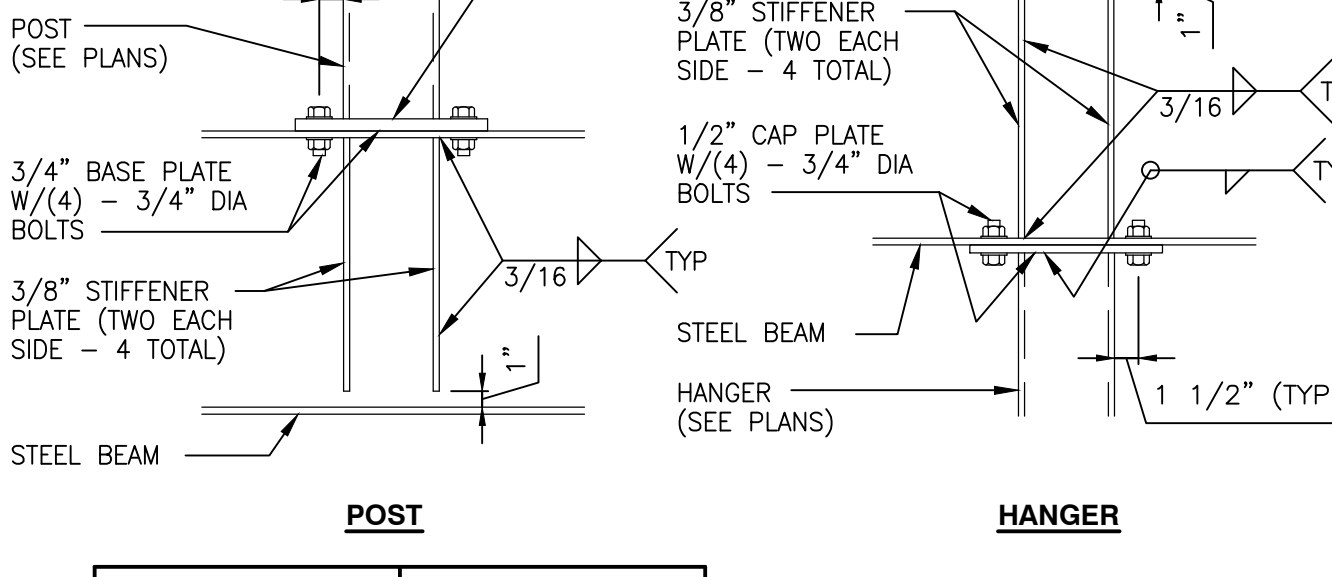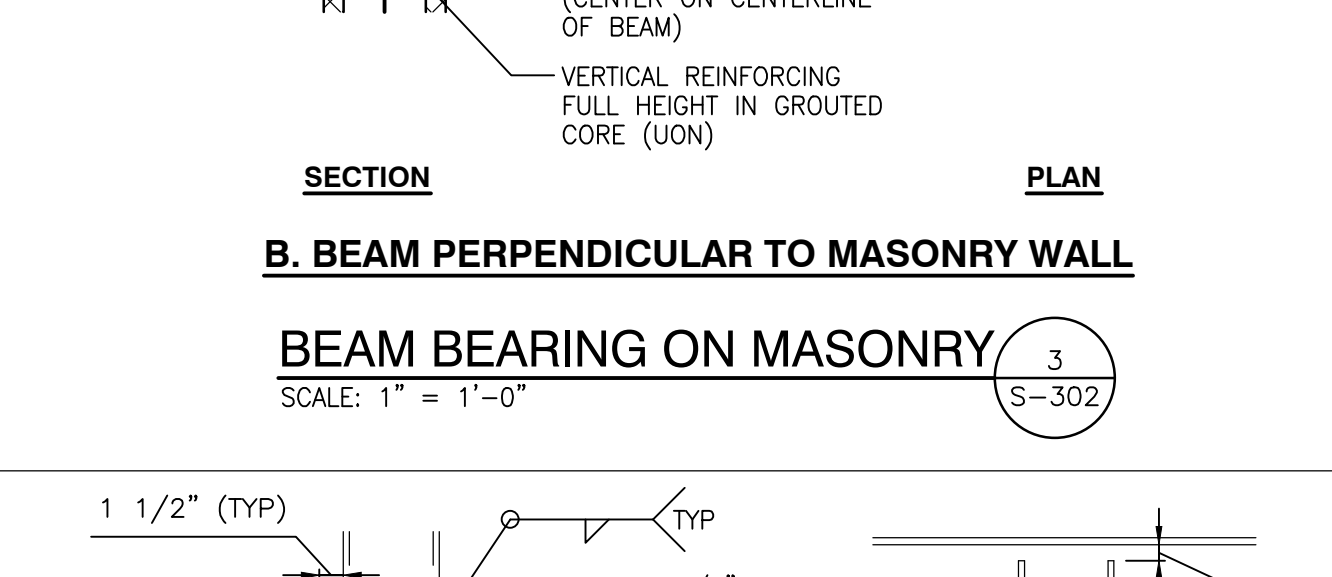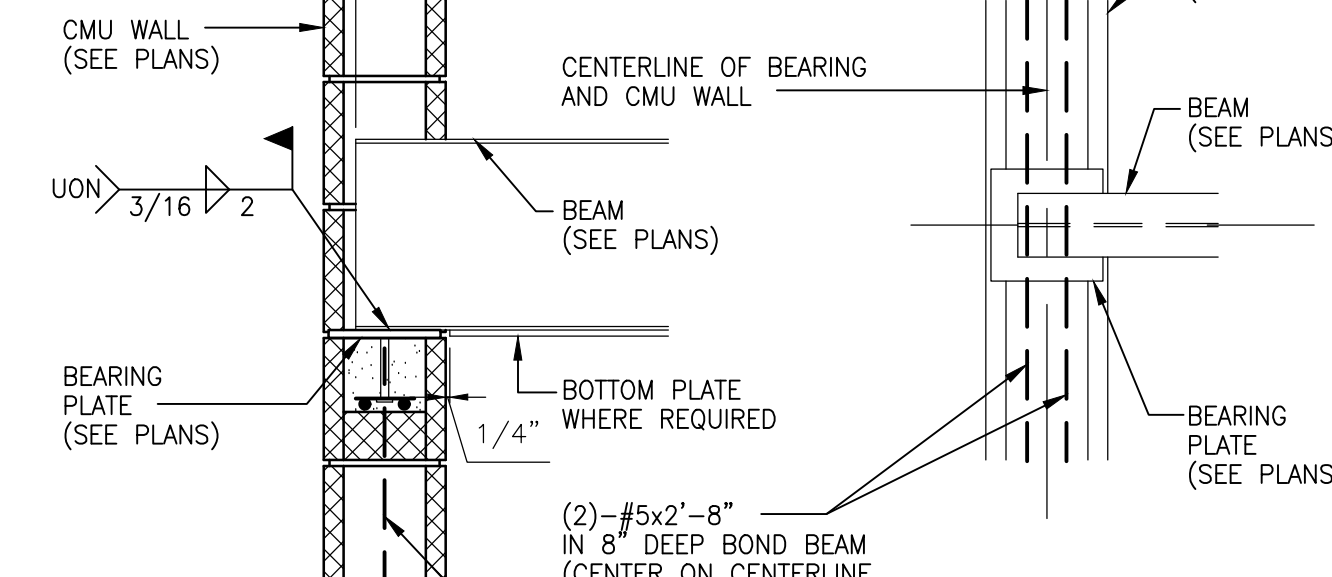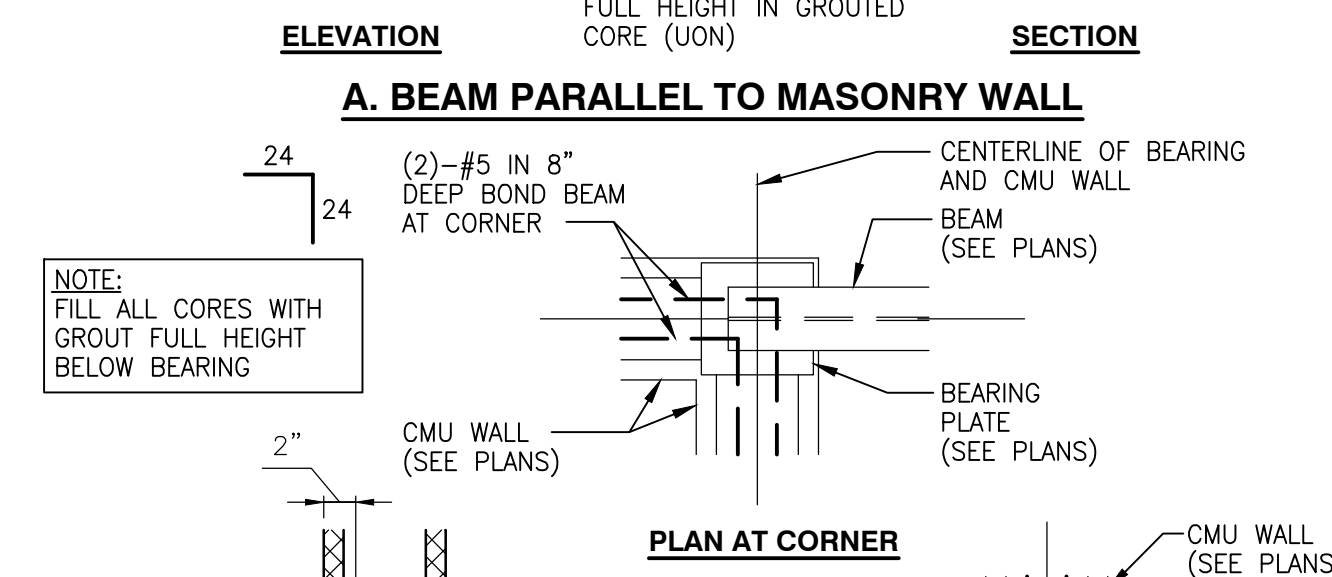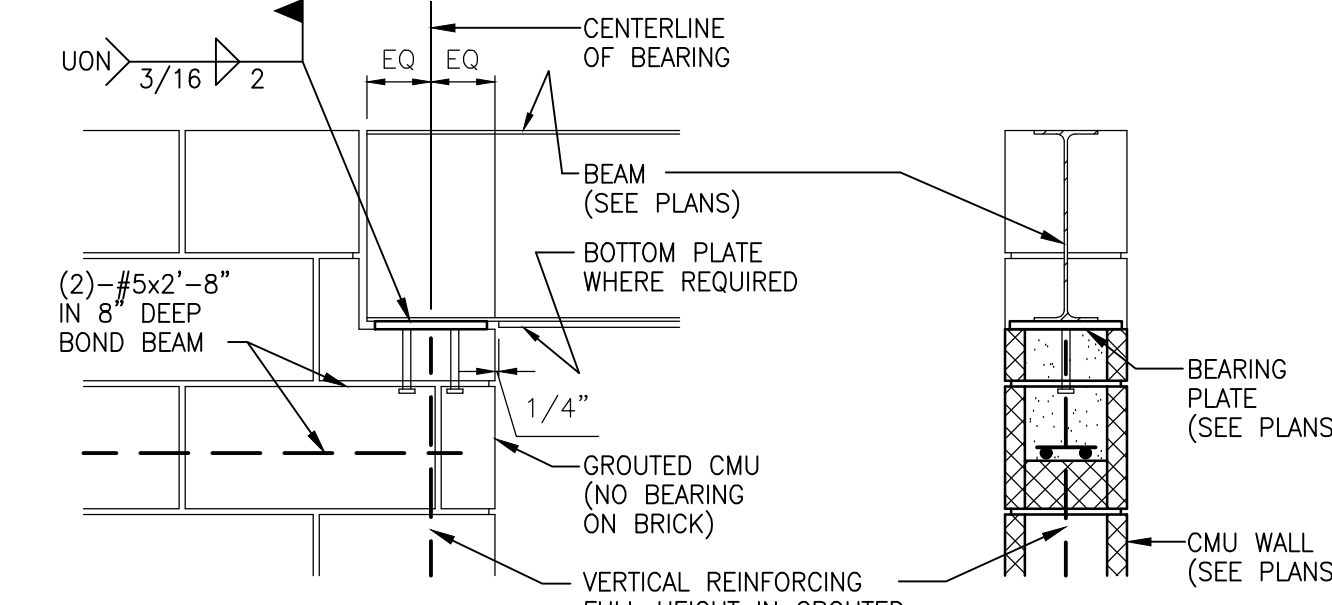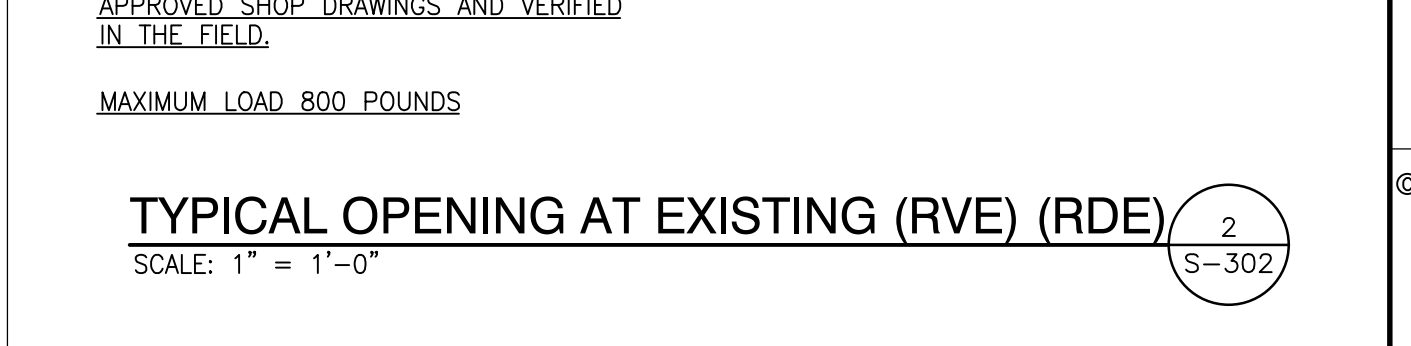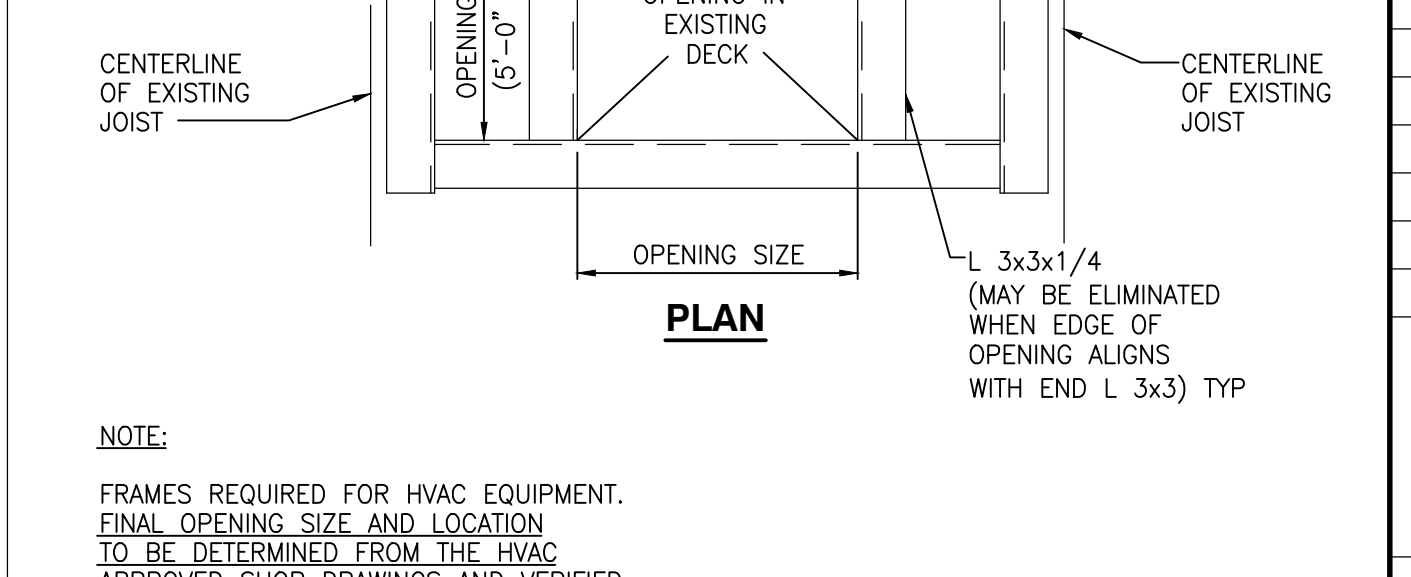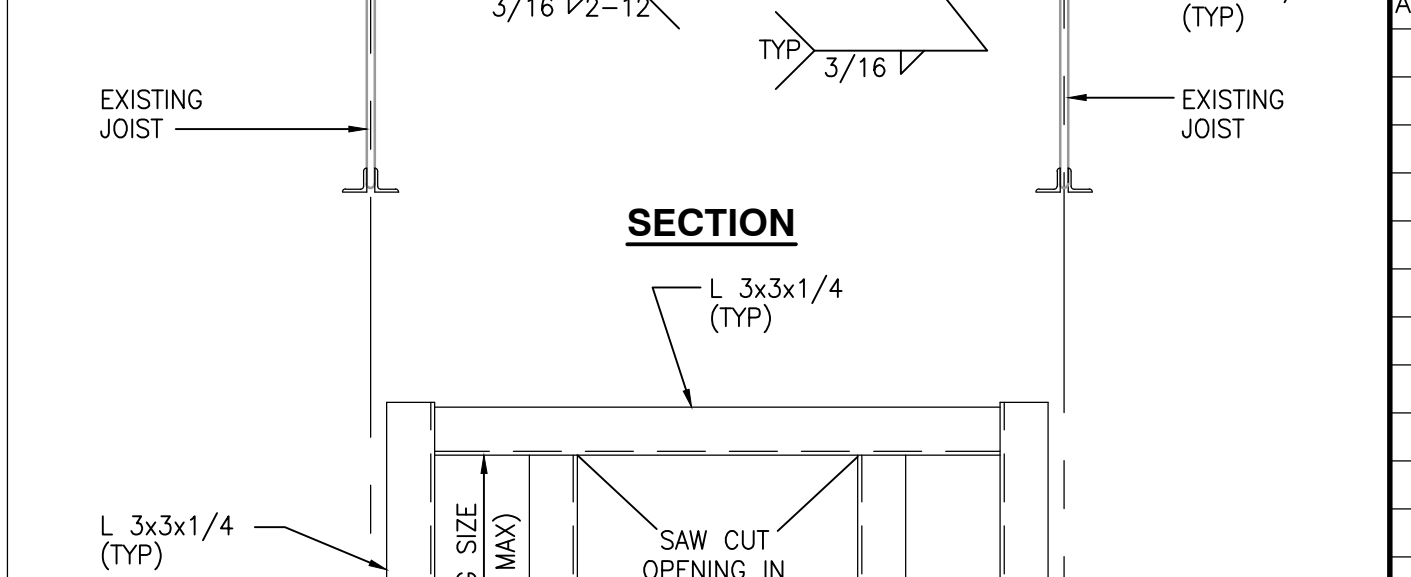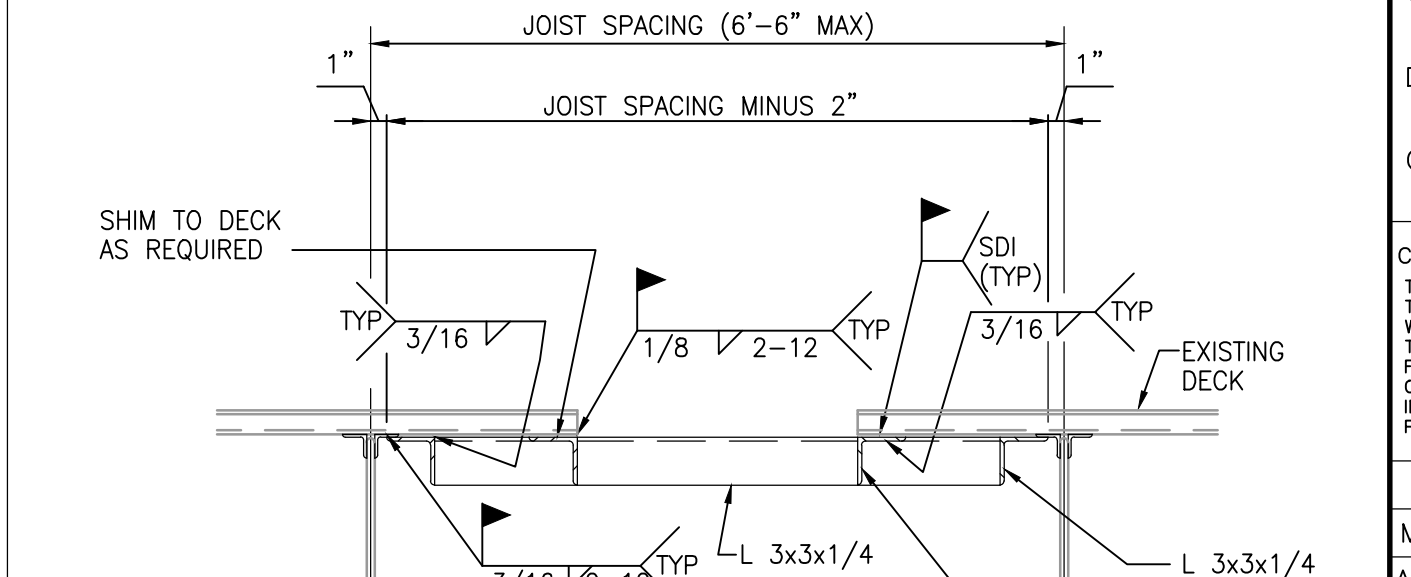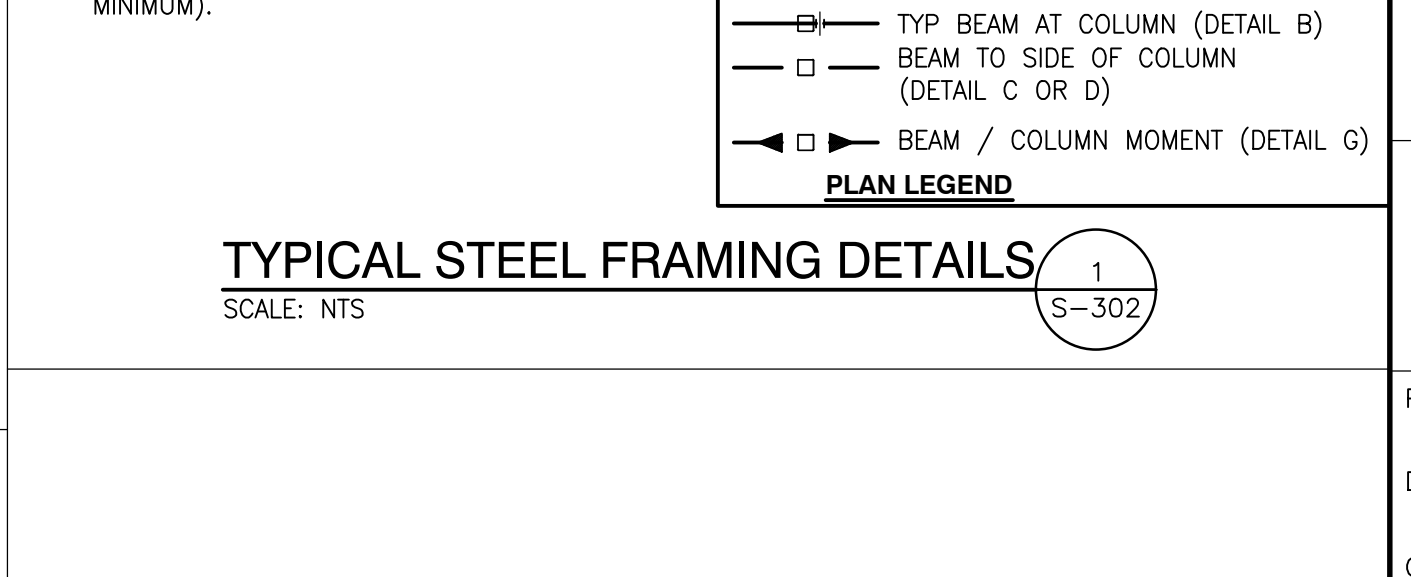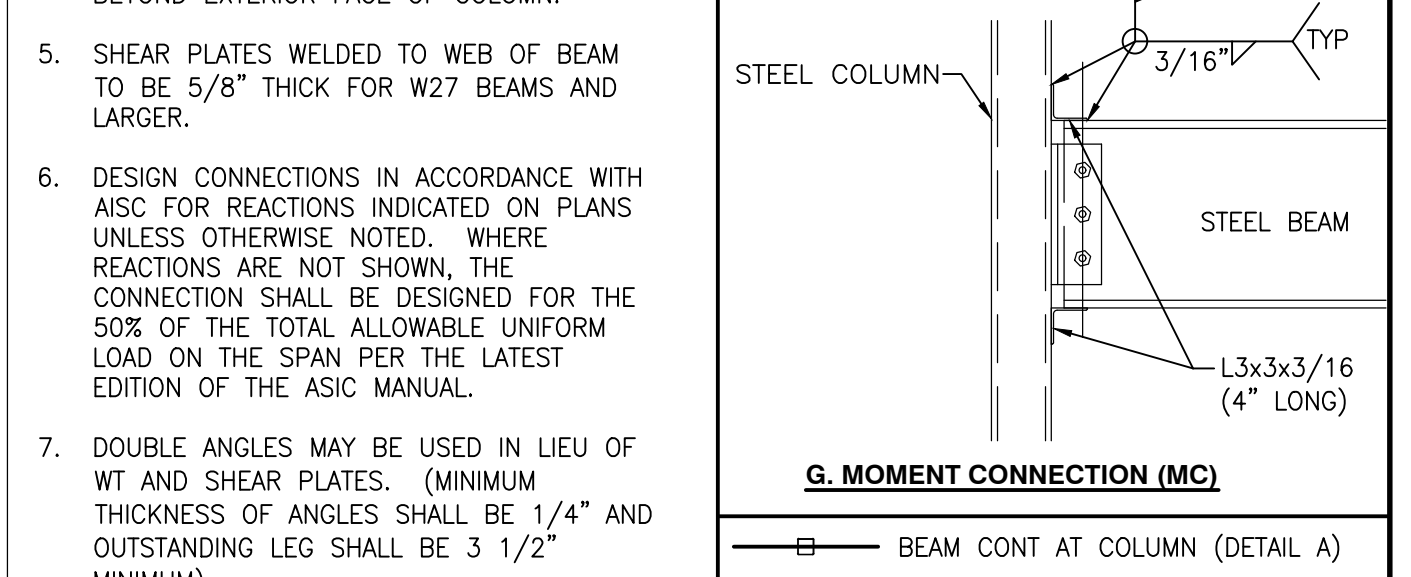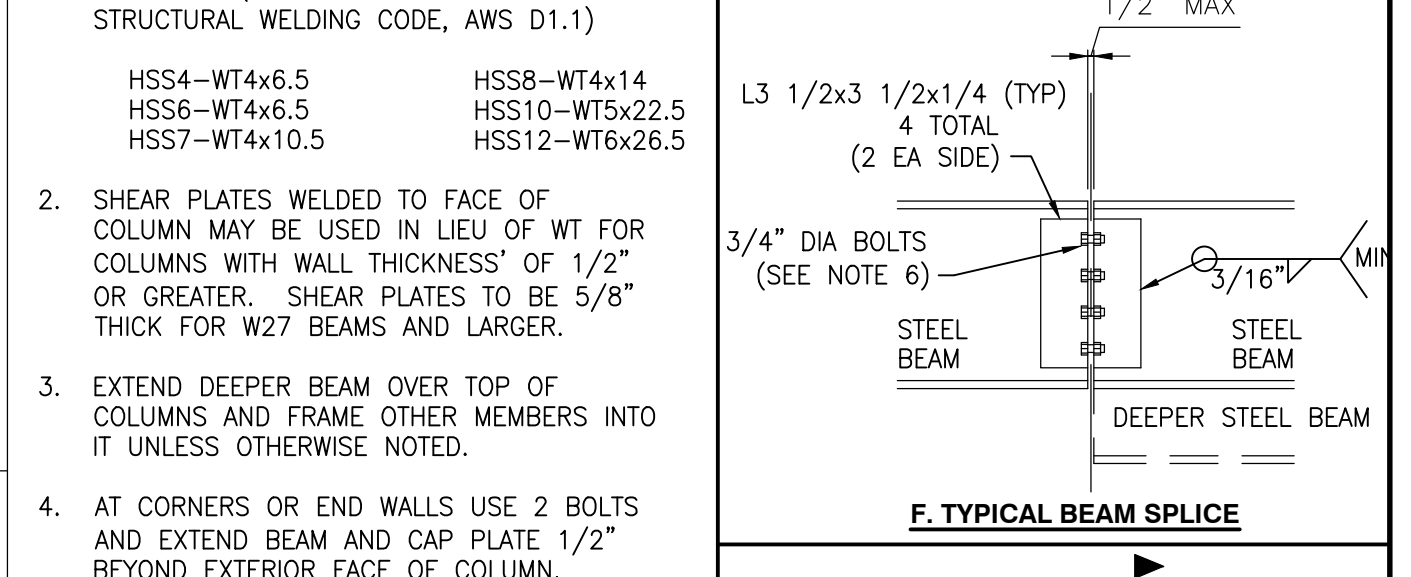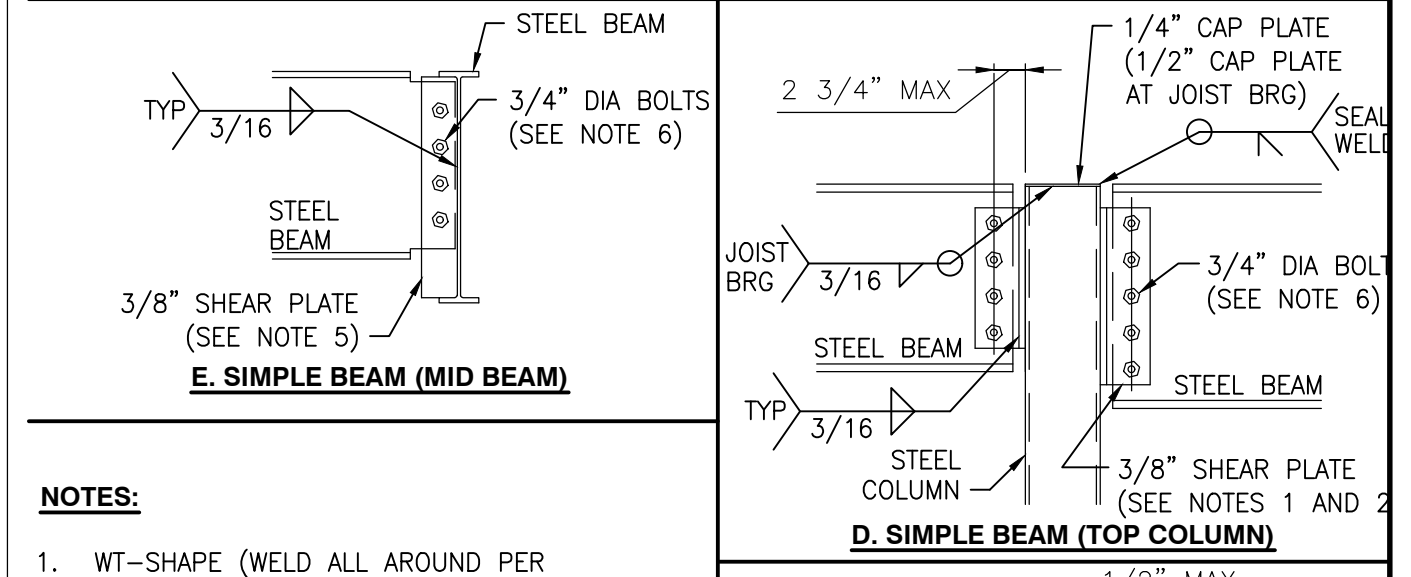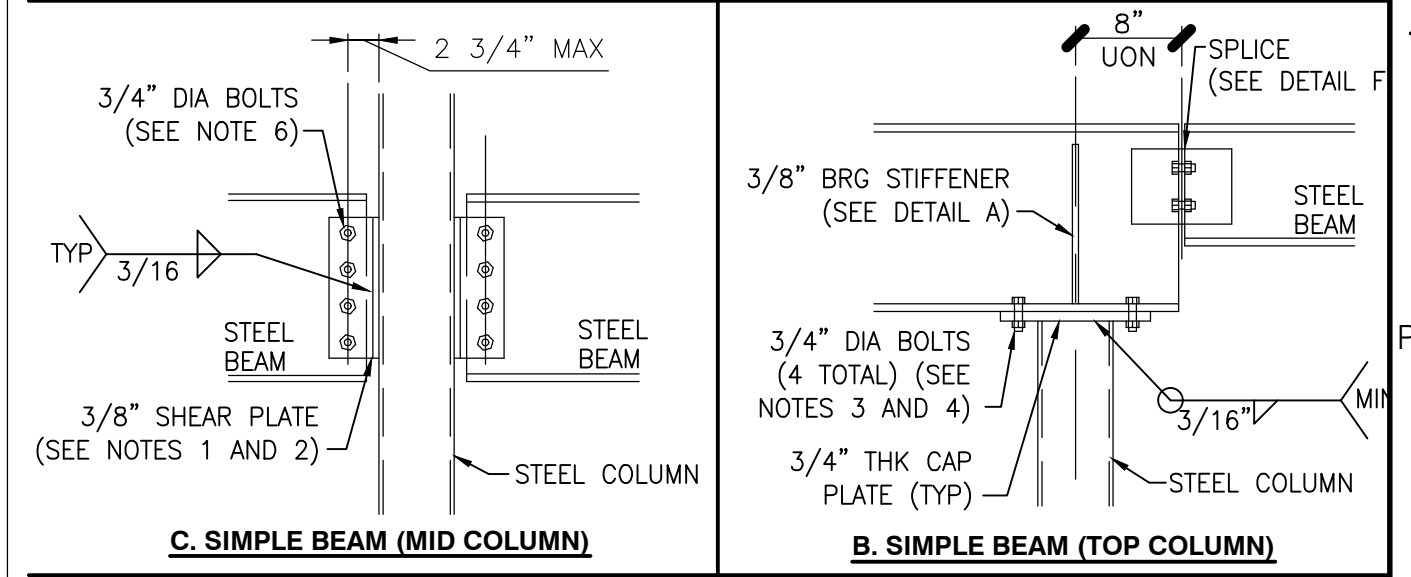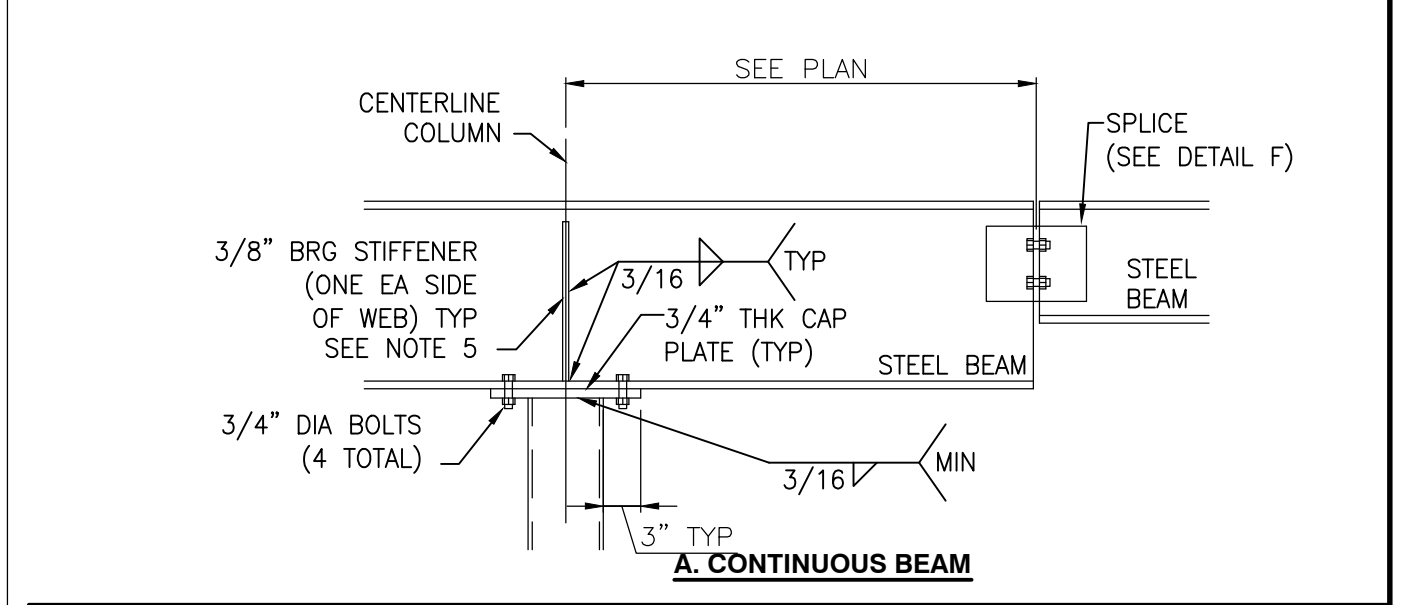

Tuesday, 6/14/2022 - 4:27 PM - LAST SAVED BY: RMALONE
X:\21-1155 FRANKLIN TOWNSHIP CSC-EDGEWOOD IS
STRUC\3-302.DWG

- 35 REMOVE EXISTING MASONRY WALL CONSTRUCTION IN ITS ENTIRETY.
- 36 REMOVE CERAMIC/PORCELAIN TILE FLOORING SYSTEM, INCLUDING BASE.
- 37 REMOVE EXISTING CEILING AS REQUIRED TO ACCOMMODATE PLUMBING AND HVAC MODIFICATIONS. REPLACE TO ORIGINAL CONFIGURATION AFTER PLUMBING AND HVAC WORK IS COMPLETED. REPLACE ANY DAMAGED TILES WITH LIKE KIND AND REPAIR ANY DAMAGES TO EXISTING WALL FINISHES TO MATCH EXISTING. COORDINATE WITH MEP DRAWINGS.
- 38 REMOVE EXISTING WALL-MOUNTED EQUIPMENT, INCLUDING ADA PUSH BUTTON, KNOX BOX, ETC., AND SALVAGE FOR FUTURE USE.
- 39 SAW OUT EXISTING FLOOR SLAB WHERE INDICATED TO ACCOMMODATE NEW UNDER-SLAB PLUMBING LINES. COORDINATE LOCATIONS, EXTENTS, AND PATCHING WITH PLUMBING DRAWINGS.
- 40 REMOVE EXISTING FLOOR FINISH MATERIAL AND PREPARE FOR NEW FINISHES - ALTERNATE.

GENERAL DEMOLITION NOTES:

- A. FOR GENERAL PROJECT NOTES, MATERIAL INDICATIONS LEGEND, SYMBOL LEGEND, ABBREVIATIONS, ETC., REFER TO GI SERIES SHEETS.
- B. UNLESS NOTED OTHERWISE ON THIS SHEET, THE GENERAL CONTRACTOR IS RESPONSIBLE FOR ALL DEMOLITION AND REMOVAL WORK INDICATED ON THIS SHEET.
- C. CONTRACTORS ENCOUNTERING EXISTING MATERIAL WHICH IS SUSPECTED OF CONTAINING ASBESTOS SHALL STOP WORK IMMEDIATELY AND NOTIFY THE OWNER AND THE OWNERS REPRESENTATIVE.
- D. BOLD DASHED LINES INDICATE EXISTING ITEMS TO BE REMOVED UNLESS OTHERWISE NOTED. THE CONTRACTOR SHALL BE RESPONSIBLE FOR FIELD VERIFYING THE EXTENT OF DEMOLITION WORK PRIOR TO BIDDING AND FOR COORDINATING THE EXTENT OF DEMOLITION WITH THE INSTALLATION OF NEW SYSTEMS.
- E. EACH CONTRACTOR SHALL BE RESPONSIBLE FOR ALL DEMOLITION APPLICABLE TO THEIR SCOPE OF WORK AND AS REQUIRED FOR INSTALLATION OF NEW WORK WHETHER OR NOT IT IS SPECIFICALLY INDICATED OR NOTED IN THESE DOCUMENTS.
- F. REMOVE ALL ITEMS AND FINISHES MADE OBSOLETE BY NEW CONSTRUCTION. VERIFY ITEMS DEEMED OBSOLETE WITH ARCHITECT PRIOR TO REMOVAL. REFER TO NEW CONSTRUCTION DRAWINGS FOR DEMOLITION REQUIRED NOT SHOWN ON DEMOLITION PLANS.
- G. EACH CONTRACTOR SHALL BE RESPONSIBLE FOR OFF SITE REMOVAL OF ALL DEMOLITION MATERIALS AND/OR ITEMS UNLESS NOTED OTHERWISE OR DIRECTED BY THE OWNER.
- H. PRIOR TO STARTING DEMOLITION, CONSTRUCT DUST CONTROL BARRIERS AS REQUIRED TO PREVENT THE SPREAD OF DUST INTO SURROUNDING AREAS (WHERE APPLICABLE).
- I. WHERE BUILDING EGRESS IS REQUIRED TO PASS THROUGH DEMOLITION AREAS, PROVIDE APPROVED BARRIERS, ETC. TO ENSURE SAFETY OF THE PUBLIC.
- J. RELOCATED ITEMS SHALL BE CLEANED AND PLACED IN STORAGE, PER OWNERS' DIRECTION, UNTIL ITEMS ARE READY TO BE INSTALLED. IF ITEMS ARE DAMAGED DURING DEMOLITION OR RELOCATION, THEY SHALL BE REPAIRED OR REPLACED WITH NEW ITEMS AS APPROVED.
- K. DEMOLITION SHALL BE PERFORMED WITHOUT DAMAGE TO EXISTING CONSTRUCTION TO REMAIN. WHERE SUCH DAMAGE OCCURS, PATCH, REPAIR, OR RESTORE WALLS, FLOORS, CEILING, ETC. NEATLY TO MATCH EXISTING ADJACENT SURFACE. PROVIDE SHORING, BRACING, OR SUPPORT AS REQUIRED TO PREVENT MOVEMENT OR SETTLEMENT OF EXISTING STRUCTURES.
- L. EACH CONTRACTOR IS RESPONSIBLE FOR CUTTING, PATCHING, AND DISCONNECTION OF ITEMS APPLICABLE TO THEIR SCOPE OF WORK. WHERE EXISTING SERVICES ARE ABANDONED, CAP AT LEAST 1" BEHIND NEW FINISHES AND/OR EXISTING SURFACE AND PATCH AS REQUIRED TO RECEIVE NEW FINISHES OR MATCH EXISTING FINISH.
- M. ON WALLS THAT ARE TO RECEIVE NEW FINISHES, REMOVE AND REINSTALL EXISTING EQUIPMENT TO REMAIN AS REQUIRED FOR INSTALLATION OF NEW FINISHES.
- N. WHERE WALLS OR BULKHEADS ARE REMOVED, PATCH FLOORS, CEILINGS, AND ADJACENT WALLS AS REQUIRED TO MATCH EXISTING OR RECEIVE NEW FINISHES WHERE APPLICABLE. WHERE EXISTING DUCTWORK, PIPING, OR EQUIPMENT IS REMOVED, PATCH OPENINGS AND/OR SURFACES AS REQUIRED TO MATCH ADJACENT SURFACES OR RECEIVE NEW FINISHES WHERE APPLICABLE. REFER TO ALL DEMOLITION DRAWINGS FOR EXTENT OF ITEMS TO BE REMOVED.
- O. OVER CUT NEW OPENINGS IN EXISTING WALL AS REQUIRED FOR NEW CONSTRUCTION. PATCH AND REPAIR WALLS AS REQUIRED TO MATCH EXISTING. WHERE APPLICABLE, TOOTH NEW MASONRY INTO EXISTING MASONRY.
- P. ALL EQUIPMENT AND FURNITURE WHICH ARE CONSIDERED LOOSE FURNISHING SHALL BE REMOVED BY THE OWNER PRIOR TO DEMOLITION.
- Q. MASONRY WALLS TO BE REMOVED SHALL BE REMOVED TO A POINT 2" MINIMUM BELOW THE EXISTING FLOOR SLAB UNLESS SETTING ON A SLAB OR SPECIFICALLY NOTED OTHERWISE. PATCH WITH NEW CONCRETE TO BE FLUSH WITH THE EXISTING FLOOR SLAB.
- R. EACH CONTRACTOR SHALL BE RESPONSIBLE FOR GENERAL REVIEW OF DEMOLITION NOTES AND GENERAL DEMOLITION NOTES AS THEY APPLY TO THEIR SCOPE OF WORK.
- S. THE OWNER SHALL RESERVE THE RIGHT TO CLAIM ANY MATERIALS THAT ARE BEING DEMOLISHED PRIOR TO THE CONTRACTOR DISPOSING OF THEM OFF SITE.
- T. REFER TO THE STRUCTURAL, MECHANICAL, PLUMBING, ELECTRICAL AND TECHNOLOGY DOCUMENTS FOR COMPLETE SCOPE OF DEMOLITION WORK.
- U. "FLOORING" DENOTES FLOOR COVERING MATERIALS INCLUDING BACKING, ADHESIVES, AND BASES DOWN TO BUT EXCLUSIVE OF FLOOR SLABS AND STRUCTURAL MATERIALS UNLESS NOTED OTHERWISE.
- V. DEMOLITION IS TO FOLLOW ESTABLISHED CONSTRUCTION SEQUENCE. REFER TO SPECIFICATIONS AND DRAWINGS FOR REQUIREMENTS AND SPECIAL CONDITIONS.
- W. WHERE APPLICABLE SALVAGE EXISTING MASONRY (FACE BRICK, GLAZED CMU, FACING TILE) AS REQUIRED FOR PATCHING AND INFILL IN RENOVATED AREAS WHERE INDICATED. DISCARD UNUSED PORTION OFF SITE.

DEMOLITION PLAN NOTES:


(ALL PLAN NOTES MAY NOT BE INDICATED ON THIS SHEET.)

- 1 REMOVE SHELVING IN ITS ENTIRETY.
- 2 REMOVE ACOUSTICAL BOARD CEILING SYSTEM IN ITS ENTIRETY.
- 3 REMOVE VINYL BASE IN ITS ENTIRETY.
- 4 REMOVE CASEWORK IN ITS ENTIRETY.
- 5 REMOVE METAL STUD AND GYPSUM BOARD WALL IN ITS ENTIRETY. PATCH AND REPAIR ADJACENT WALL AND FLOOR AS REQUIRED TO ACCEPT NEW FINISHES.
- 6 REMOVE MASONRY WALL CONSTRUCTION AND ATTACHED FINISHES IN ITS ENTIRETY. PATCH/REPAIR ADJACENT FLOOR AND WALL SURFACES AS REQUIRED TO ACCEPT NEW FINISHES.
- 7 REMOVE METAL STUD AND GYPSUM BOARD BULKHEAD IN ITS ENTIRETY. PATCH AND REPAIR WALL AS REQUIRED FOR NEW FINISHES.
- 8 EXISTING STEEL COLUMN TO REMAIN.
- 9 REMOVE EXISTING SLAB AS REQUIRED FOR NEW CONSTRUCTION.
- 10 REMOVE ENTIRE PORTION OF BUILDING IN THIS AREA INCLUDING MASONRY WALLS, STEEL FRAMING, CONCRETE SLAB ON GRADE, ROOFING, CONCRETE FOOTINGS, AND FOUNDATION WALLS AS REQUIRED FOR NEW CONSTRUCTION. COORDINATE WITH STRUCTURAL.
- 11 REMOVE VOID SLAB/STOOP AS REQUIRED FOR NEW CONSTRUCTION. COORDINATE WITH CIVIL.
- 12 REMOVE BRICK CLADDING BACK TO CMU WALL OR STEEL COLUMN (TO REMAIN) WHERE INDICATED.
- 13 REMOVE WINDOW SYSTEM IN ITS ENTIRETY.
- 14 REMOVE ALUMINUM STOREFRONT FRAMING, DOORS, AND HARDWARE IN ITS ENTIRETY.
- 15 REMOVE EXISTING EIFS FASCIA AND SOFFIT ABOVE, STRUCTURAL FRAMING TO REMAIN.
- 16 REMOVE EXISTING DOOR NUMBER IN ITS ENTIRETY.
- 17 REMOVE EXISTING PROJECTION SCREEN AND TURN OVER TO OWNER.
- 18 REMOVE TACK BOARD, MARKER BOARD OR CHALKBOARD IN THEIR ENTIRETY. PATCH WALL AS REQUIRED TO RECEIVE NEW FINISHES.
- 19 REMOVE WOOD DOOR, FRAME AND HARDWARE IN ITS ENTIRETY.
- 20 REMOVE ALL OR PART OF STEEL COLUMN AS NEEDED TO ACCOMMODATE THE PROPOSED PLAN. COORDINATE WITH STRUCTURAL DRAWINGS.
- 21 REMOVE METAL DOOR, FRAME AND HARDWARE IN ITS ENTIRETY.
- 22 REMOVE EXISTING HANDRAIL AND CUT SLAB EDGE AS REQUIRED FOR NEW CONSTRUCTION. SEE SECTION.
- 23 CUT OPENING IN EXISTING CMU AS REQUIRED FOR INSTALLATION OF NEW DOOR AND LINTEL.
- 24 REMOVE EXISTING CMU WALL CONSTRUCTION FROM FLOOR TO ROOF DECK.
- 25 REMOVE EXISTING FLOOR FINISH MATERIAL, INCLUDING BASE, AND PREPARE FOR NEW FINISHES.
- 26 REMOVE EXISTING HIGH DENSITY SHELVING FOR REINSTALLATION.
- 27 REMOVE EXISTING CURB AT DOOR OPENING TO 8" BELOW GUTTER LINE.
- 28 EXISTING BOLLARDS TO REMAIN.
- 29 REMOVE PLUMBING FIXTURE. REMAINING PLUMBING LINES TO BE REUSED OR CAPPED AS NEEDED. COORDINATE WITH PLUMBING DRAWINGS.
- 30 REMOVE TOILET STALL PARTITION ENCLOSURE IN ITS ENTIRETY. PATCH/REPAIR ADJACENT FLOOR AND WALL SURFACES AS REQUIRED TO ACCEPT NEW FINISHES. SALVAGE ATTACHED ACCESSORIES FOR FUTURE USE. COORDINATE WITH OWNER.
- 31 REMOVE EXISTING FABRIC WALL COVERING AND PREPARE WALLS FOR NEW FINISHES.
- 32 REMOVE CABINET HEATER. COORDINATE WITH MECHANICAL TRADES.
- 33 REMOVE EXISTING DIVIDER RAIL AND PREPARE FOR NEW FINISHES.
- 34 REMOVE TOILET ACCESSORIES AND TURN OVER TO OWNER.



GIBRALTAR DESIGN
ARCHITECTURE • ENGINEERING • INTERIOR DESIGN

PROJECT
ADDITIONS AND RENOVATIONS TO
EDGEWOOD INTERMEDIATE SCHOOL
FRANKLIN TOWNSHIP COMMUNITY SCHOOL CORPORATION
INDIANAPOLIS, INDIANA

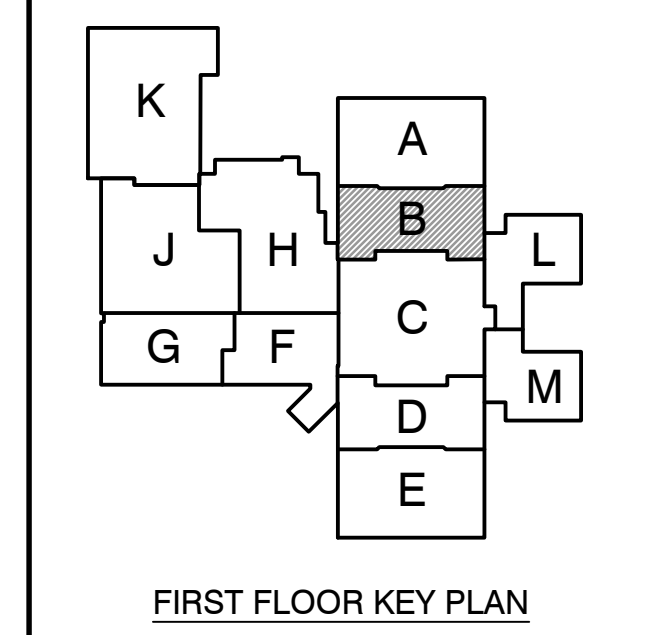

GIBRALTAR DESIGN
9102 N. Meridian St., Ste. 300
Indianapolis, IN 46260
Homepage: www.GibraltarDesign.com
Email: info@GibraltarDesign.com
Phone: 317.580.5777 Fax: 317.580.5778

PROJECT 21-155
DATE 05/23/22
COORDINATED BY DJW
DRAWN BY JRH
CHECKED BY DJW


COPYRIGHT NOTICE:
THE CONCEPTS, DESIGNS, PLANS, DETAILS, ETC. SHOWN ON THIS DOCUMENT ARE THE PROPERTY OF GIBRALTAR DESIGN AND ARE CREATED FOR USE ON THIS SPECIFIC PROJECT. NONE OF THIS INFORMATION SHALL BE USED BY ANY PERSON OR FIRM FOR ANY PURPOSE WITHOUT THE EXPRESS WRITTEN CONSENT OF GIBRALTAR DESIGN. THE OWNER MAY RETAIN COPIES FOR INFORMATION AND REFERENCE IN CONNECTION ONLY WITH THIS PROJECT.

MARK	DATE	ISSUED FOR
AD-1	06/16/22	ADDENDUM NO. 1

DRAWING
UNIT "B" ARCHITECTURAL FIRST FLOOR DEMOLITION PLAN


PROJECT
ADDITIONS AND RENOVATIONS TO
EDGEWOOD INTERMEDIATE SCHOOL

GIBRALTAR DESIGN SHEET
B AD102

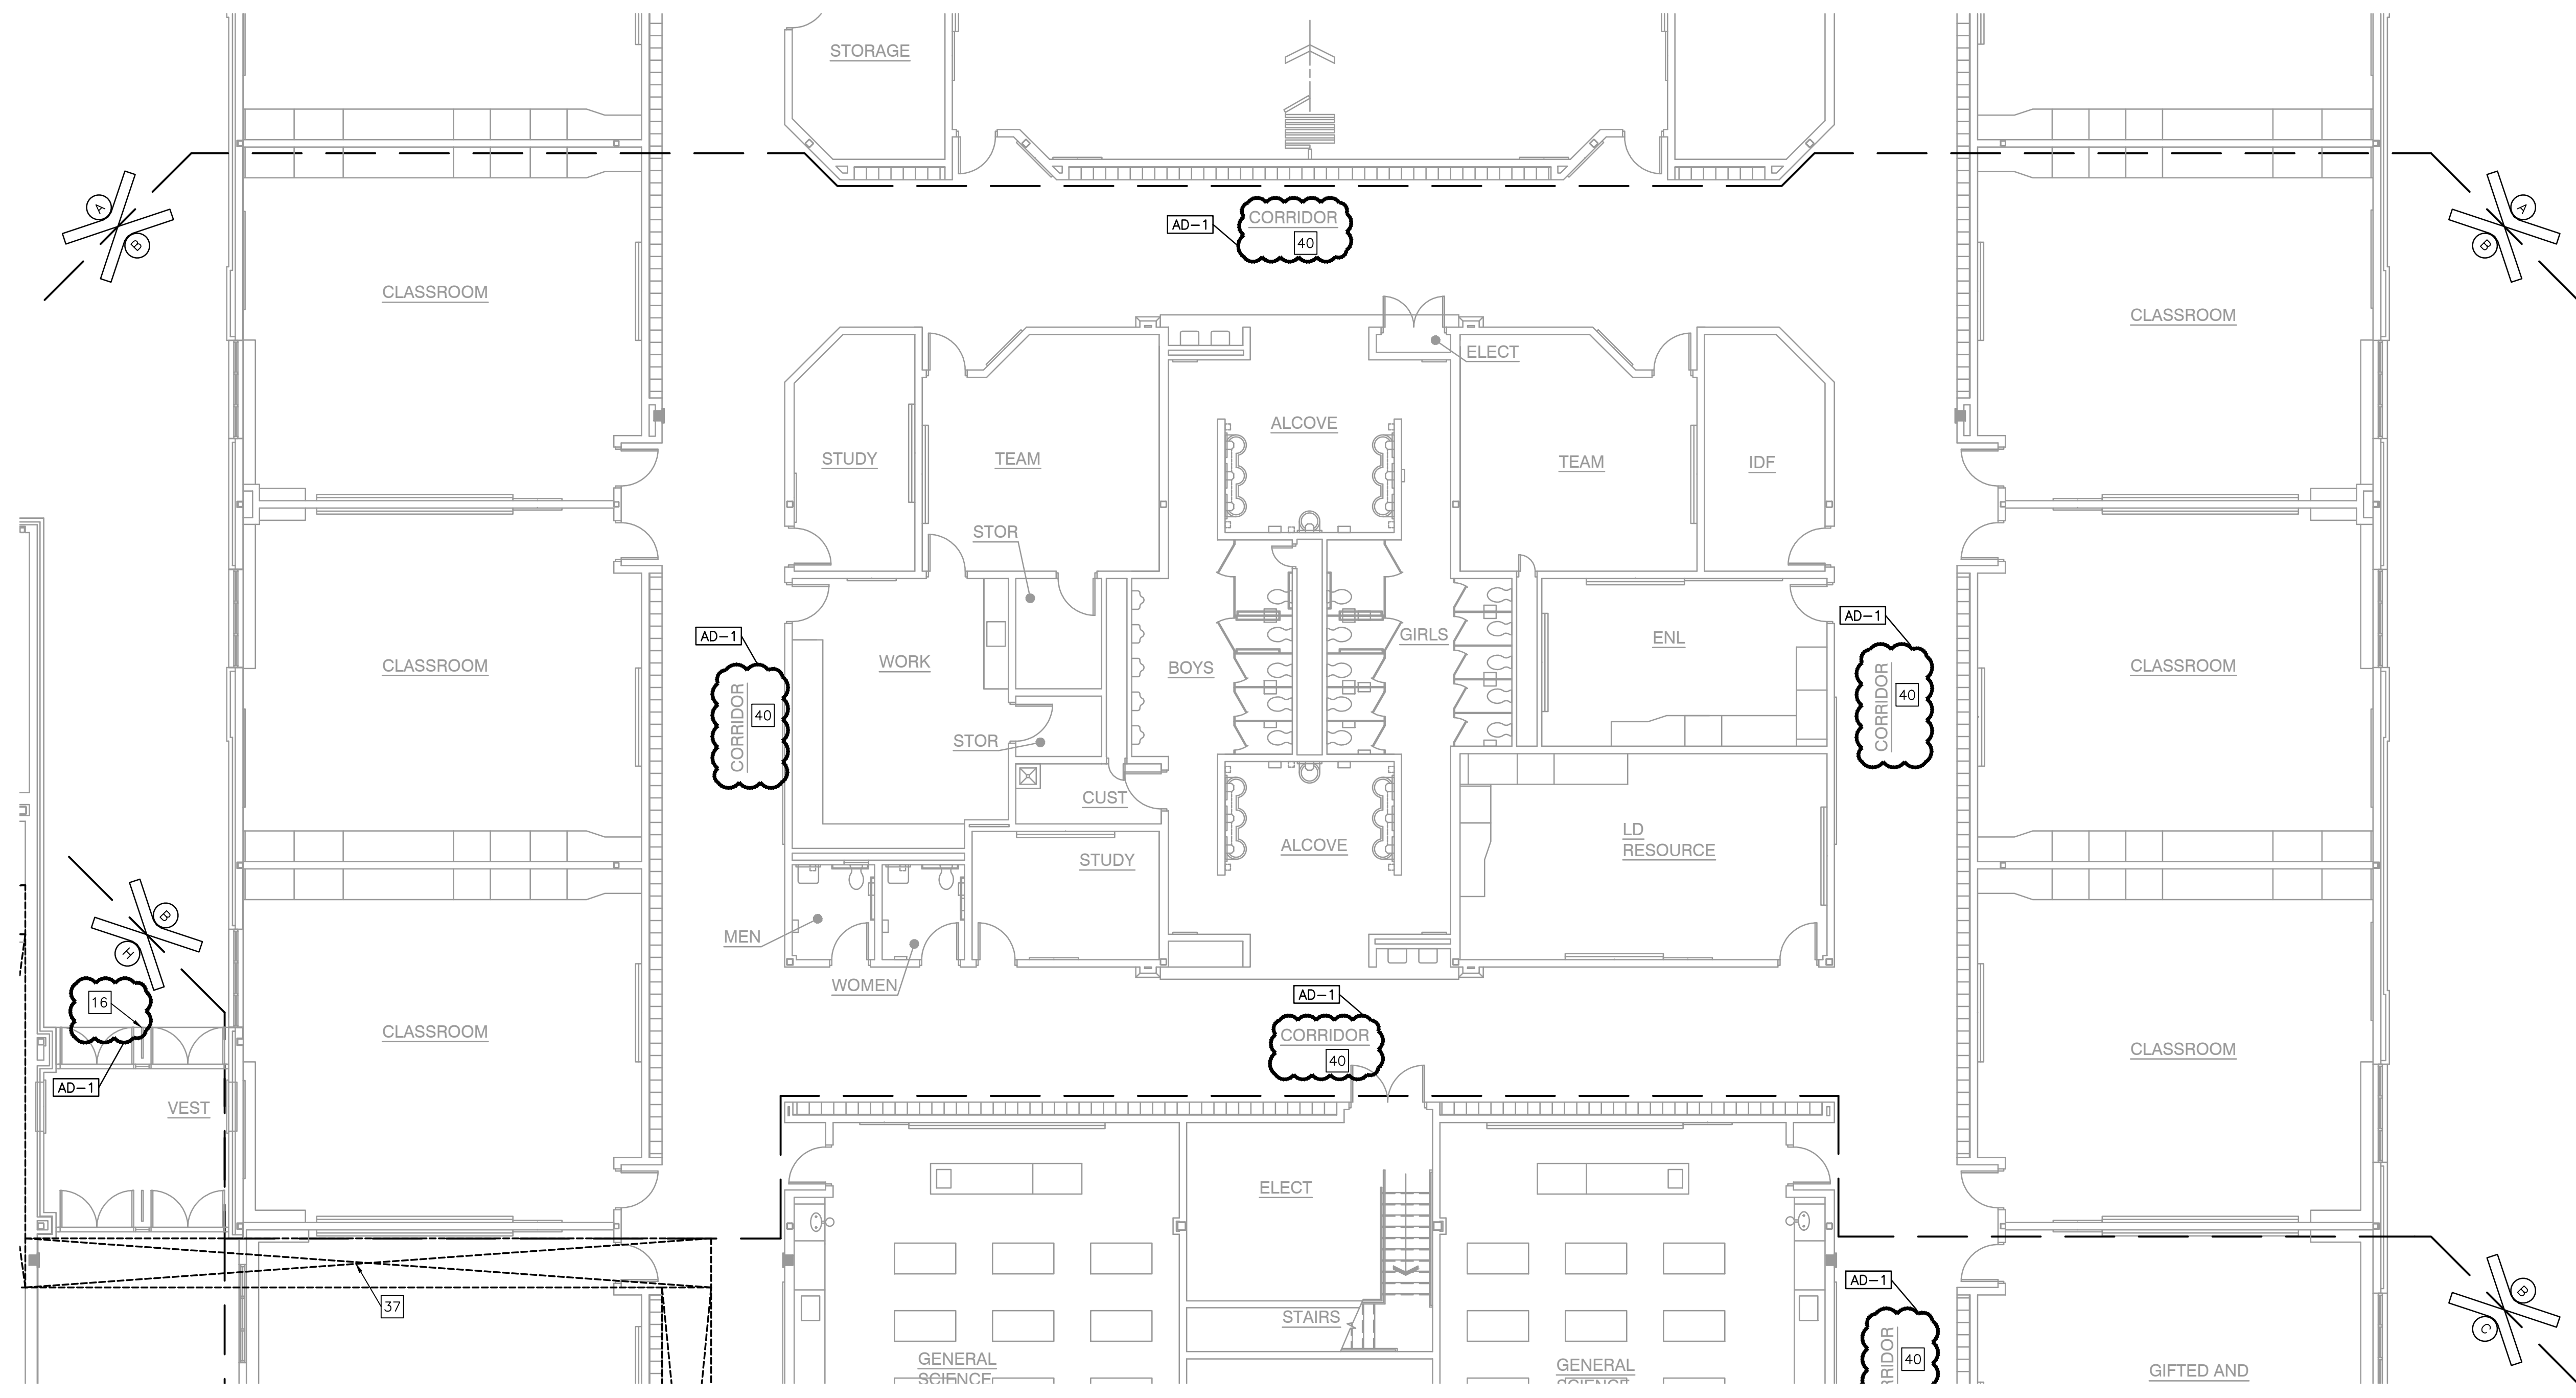

UNIT "B" ARCHITECTURAL FIRST FLOOR DEMOLITION PLAN

SCALE: 1/8" = 1'-0"

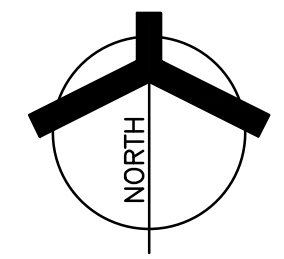


NOTE: THIS SHEET HAS BEEN ADDED AS PART OF ADDENDUM #1 ISSUANCE.

Wednesday, 6/15/2022 - 3:12 PM - LAST SAVED BY: JHARRIS
Y:\21-155 FRANKLIN TOWNSHIP CSC-EDGEWOOD IS ADDITIONS AND RENOVATIONS\21-155 DRAWINGS\05 ARCH\AD102.DWG



GIBRALTAR
DESIGN
ARCHITECTURE • ENGINEERING • INTERIOR DESIGN


PROJECT
ADDITIONS AND RENOVATIONS TO
EDGEWOOD INTERMEDIATE SCHOOL
FRANKLIN TOWNSHIP COMMUNITY SCHOOL CORPORATION
INDIANAPOLIS, INDIANA

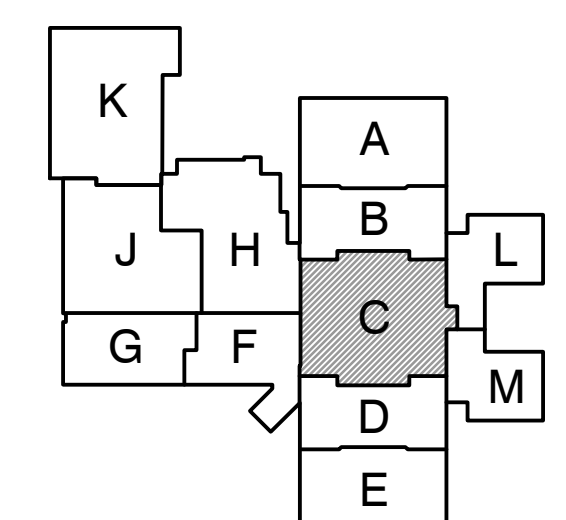

FIRST FLOOR KEY PLAN

GIBRALTAR DESIGN
9102 N. Meridian St., Ste. 300
Indianapolis, IN 46260
Homepage: www.GibraltarDesign.com
Email: info@GibraltarDesign.com
Phone: 317.580.5777 Fax: 317.580.5778

PROJECT 21-155
DATE 05/23/22
COORDINATED BY DJW
DRAWN BY JRH
CHECKED BY DJW

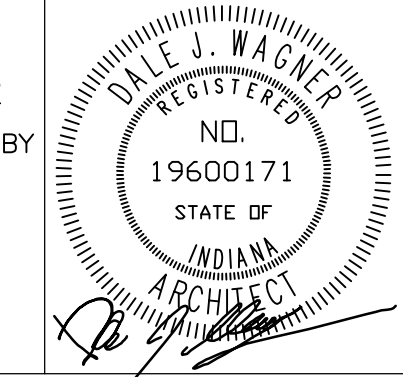

COPYRIGHT NOTICE:
THE CONCEPTS, DESIGNS, PLANS, DETAILS, ETC. SHOWN ON THIS DOCUMENT ARE THE PROPERTY OF GIBRALTAR DESIGN AND WERE CREATED FOR USE ON THIS SPECIFIC PROJECT. NONE OF THIS INFORMATION SHALL BE USED BY ANY PERSON OR FIRM FOR ANY PURPOSE WITHOUT THE EXPRESS WRITTEN CONSENT OF GIBRALTAR DESIGN. THE OWNER MAY RETAIN COPIES FOR INFORMATION AND REFERENCE IN CONNECTION ONLY WITH THIS PROJECT.

REVISIONS	MARK	DATE	ISSUED FOR
AD-1	06/16/22	ADDENDUM NO. 1	

DRAWING
UNIT "C" ARCHITECTURAL FIRST FLOOR DEMOLITION PLAN

PROJECT
ADDITIONS AND RENOVATIONS TO
EDGEWOOD INTERMEDIATE SCHOOL

© GIBRALTAR DESIGN SHEET
C AD103


GENERAL DEMOLITION NOTES:

- A. FOR GENERAL PROJECT NOTES, MATERIAL INDICATIONS LEGEND, SYMBOL LEGEND, ABBREVIATIONS, ETC., REFER TO GI SERIES SHEETS.
- B. UNLESS NOTED OTHERWISE ON THIS SHEET, THE GENERAL CONTRACTOR IS RESPONSIBLE FOR ALL DEMOLITION AND REMOVAL WORK INDICATED ON THIS SHEET.
- C. CONTRACTORS ENCOUNTERING EXISTING MATERIAL WHICH IS SUSPECTED OF CONTAINING ASBESTOS SHALL STOP WORK IMMEDIATELY AND NOTIFY THE OWNER AND THE OWNERS REPRESENTATIVE.
- D. BOLD DASHED LINES INDICATE EXISTING ITEMS TO BE REMOVED UNLESS OTHERWISE NOTED. THE CONTRACTOR SHALL BE RESPONSIBLE FOR FIELD VERIFYING THE EXTENT OF DEMOLITION WORK PRIOR TO BIDDING AND FOR COORDINATING THE EXTENT OF DEMOLITION WITH THE INSTALLATION OF NEW SYSTEMS.
- E. EACH CONTRACTOR SHALL BE RESPONSIBLE FOR ALL DEMOLITION APPLICABLE TO THEIR SCOPE OF WORK AND AS REQUIRED FOR INSTALLATION OF NEW WORK WHETHER OR NOT IT IS SPECIFICALLY INDICATED OR NOTED IN THESE DOCUMENTS.
- F. REMOVE ALL ITEMS AND FINISHES MADE OBSOLETE BY NEW CONSTRUCTION. REFER TO NEW CONSTRUCTION DRAWINGS FOR DEMOLITION REQUIRED NOT SHOWN ON DEMOLITION PLANS.
- G. EACH CONTRACTOR SHALL BE RESPONSIBLE FOR OFF SITE REMOVAL OF ALL DEMOLITION MATERIALS AND/OR ITEMS UNLESS NOTED OTHERWISE OR DIRECTED BY THE OWNER.
- H. PRIOR TO STARTING DEMOLITION, CONSTRUCT DUST CONTROL BARRIERS AS REQUIRED TO PREVENT THE SPREAD OF DUST INTO SURROUNDING AREAS (WHERE APPLICABLE).
- I. WHERE BUILDING EGRESS IS REQUIRED TO PASS THROUGH DEMOLITION AREAS, PROVIDE APPROVED BARRIERS, ETC. TO ENSURE SAFETY OF THE PUBLIC.
- J. RELOCATED ITEMS SHALL BE CLEANED AND PLACED IN STORAGE, PER OWNERS' DIRECTION, UNTIL ITEMS ARE READY TO BE INSTALLED. IF ITEMS ARE DAMAGED DURING DEMOLITION OR RELOCATION, THEY SHALL BE REPAIRED OR REPLACED WITH NEW ITEMS AS APPROVED.
- K. DEMOLITION SHALL BE PERFORMED WITHOUT DAMAGE TO EXISTING CONSTRUCTION TO REMAIN. WHERE SUCH DAMAGE OCCURS, PATCH, REPAIR, OR RESTORE WALLS, FLOORS, CEILING, ETC. NEATLY TO MATCH EXISTING ADJACENT SURFACE. PROVIDE SHORING, BRACING, OR SUPPORT AS REQUIRED TO PREVENT MOVEMENT OR SETTLEMENT OF EXISTING STRUCTURES.
- L. EACH CONTRACTOR IS RESPONSIBLE FOR CUTTING, PATCHING, AND DISCONNECTION OF ITEMS APPLICABLE TO THEIR SCOPE OF WORK. WHERE EXISTING SERVICES ARE ABANDONED, CAP AT LEAST 1" BEHIND NEW FINISHES AND/OR EXISTING SURFACE AND PATCH AS REQUIRED TO RECEIVE NEW FINISHES OR MATCH EXISTING FINISH.
- M. ON WALLS THAT ARE TO RECEIVE NEW FINISHES, REMOVE AND REINSTALL EXISTING EQUIPMENT TO REMAIN AS REQUIRED FOR INSTALLATION OF NEW FINISHES.
- N. WHERE WALLS OR BULKHEADS ARE REMOVED, PATCH FLOORS, CEILING, AND ADJACENT WALLS AS REQUIRED TO MATCH EXISTING OR RECEIVE NEW FINISHES WHERE APPLICABLE. WHERE EXISTING DUCTWORK, PIPING, OR EQUIPMENT IS REMOVED, PATCH OPENINGS AND/OR SURFACES AS REQUIRED TO MATCH ADJACENT SURFACES OR RECEIVE NEW FINISHES WHERE APPLICABLE. REFER TO ALL DEMOLITION DRAWINGS FOR EXTENT OF ITEMS TO BE REMOVED.
- O. OVER CUT NEW OPENINGS IN EXISTING WALL AS REQUIRED FOR NEW CONSTRUCTION. PATCH AND REPAIR WALLS AS REQUIRED TO MATCH EXISTING. WHERE APPLICABLE, TOOTH NEW MASONRY INTO EXISTING MASONRY.
- P. ALL EQUIPMENT AND FURNITURE WHICH ARE CONSIDERED LOOSE FURNISHING SHALL BE REMOVED BY THE OWNER PRIOR TO DEMOLITION.
- Q. MASONRY WALLS TO BE REMOVED SHALL BE REMOVED TO A POINT 2" MINIMUM BELOW THE EXISTING FLOOR SLAB UNLESS SETTING ON A SLAB OR SPECIFICALLY NOTED OTHERWISE. PATCH WITH NEW CONCRETE TO BE FLUSH WITH THE EXISTING FLOOR SLAB.
- R. EACH CONTRACTOR SHALL BE RESPONSIBLE FOR GENERAL REVIEW OF DEMOLITION NOTES AND GENERAL DEMOLITION NOTES AS THEY APPLY TO THEIR SCOPE OF WORK.
- S. THE OWNER SHALL RESERVE THE RIGHT TO CLAIM ANY MATERIALS THAT ARE BEING DEMOLISHED PRIOR TO THE CONTRACTOR DISPOSING OF THEM OFF SITE.
- T. REFER TO THE STRUCTURAL, MECHANICAL, PLUMBING, ELECTRICAL AND TECHNOLOGY DOCUMENTS FOR COMPLETE SCOPE OF DEMOLITION WORK.
- U. "FLOORING" DENOTES FLOOR COVERING MATERIALS INCLUDING BACKING, ADHESIVES, AND BASES DOWN TO BUT EXCLUSIVE OF FLOOR SLABS AND STRUCTURAL MATERIALS UNLESS NOTED OTHERWISE.
- V. DEMOLITION IS TO FOLLOW ESTABLISHED CONSTRUCTION SEQUENCE. REFER TO SPECIFICATIONS AND DRAWINGS FOR REQUIREMENTS AND SPECIAL CONDITIONS.
- W. WHERE APPLICABLE SALVAGE EXISTING MASONRY (FACE BRICK, GLAZED CMU, FACING TILE) AS REQUIRED FOR PATCHING AND INFILL IN RENOVATED AREAS WHERE INDICATED. DISCARD UNUSED PORTION OFF SITE.


DEMOLITION PLAN NOTES:

- (ALL PLAN NOTES MAY NOT BE INDICATED ON THIS SHEET.)
- 1 REMOVE SHELVING IN ITS ENTIRETY.
 - 2 REMOVE ACOUSTICAL BOARD CEILING SYSTEM IN ITS ENTIRETY.
 - 3 REMOVE VINYL BASE IN ITS ENTIRETY.
 - 4 REMOVE CASEWORK IN ITS ENTIRETY.
 - 5 REMOVE METAL STUD AND GYPSUM BOARD WALL IN ITS ENTIRETY. PATCH AND REPAIR ADJACENT WALL AND FLOOR AS REQUIRED TO ACCEPT NEW FINISHES.
 - 6 REMOVE MASONRY WALL CONSTRUCTION AND ATTACHED FINISHES IN ITS ENTIRETY. PATCH/REPAIR ADJACENT FLOOR AND WALL SURFACES AS REQUIRED TO ACCEPT NEW FINISHES.
 - 7 REMOVE METAL STUD AND GYPSUM BOARD BULKHEAD IN ITS ENTIRETY. PATCH AND REPAIR WALL AS REQUIRED FOR NEW FINISHES.
 - 8 EXISTING STEEL COLUMN TO REMAIN.
 - 9 REMOVE EXISTING SLAB AS REQUIRED FOR NEW CONSTRUCTION.
 - 10 REMOVE ENTIRE PORTION OF BUILDING IN THIS AREA INCLUDING MASONRY WALLS, STEEL FRAMING, CONCRETE SLAB ON GRADE, ROOFING, CONCRETE FOOTINGS, AND FOUNDATION WALLS AS REQUIRED FOR NEW CONSTRUCTION. COORDINATE WITH STRUCTURAL.
 - 11 REMOVE VOID SLAB/STOOP AS REQUIRED FOR NEW CONSTRUCTION. COORDINATE WITH CIVIL.
 - 12 REMOVE BRICK CLADDING BACK TO CMU WALL OR STEEL COLUMN (TO REMAIN) WHERE INDICATED.
 - 13 REMOVE WINDOW SYSTEM IN ITS ENTIRETY.
 - 14 REMOVE ALUMINUM STOREFRONT FRAMING, DOORS, AND HARDWARE IN ITS ENTIRETY.
 - 15 REMOVE EXISTING EIFS FASCIA AND SOFFIT ABOVE. STRUCTURAL FRAMING TO REMAIN.
 - 16 REMOVE EXISTING DOOR NUMBER IN ITS ENTIRETY.
 - 17 REMOVE EXISTING PROJECTION SCREEN AND TURN OVER TO OWNER.
 - 18 REMOVE TAG BOARD OR CHALKBOARD OR CHALKBOARD IN THEIR ENTIRETY. PATCH WALL AS REQUIRED TO RECEIVE NEW FINISHES.
 - 19 REMOVE WOOD DOOR, FRAME AND HARDWARE IN ITS ENTIRETY.
 - 20 REMOVE ALL OR PART OF STEEL COLUMN AS NEEDED TO ACCOMMODATE THE PROPOSED PLAN. COORDINATE WITH STRUCTURAL DRAWINGS.
 - 21 REMOVE METAL DOOR, FRAME AND HARDWARE IN ITS ENTIRETY.
 - 22 REMOVE EXISTING HANDRAIL AND CUT SLAB EDGE AS REQUIRED FOR NEW CONSTRUCTION. SEE SECTION.
 - 23 CUT OPENING IN EXISTING CMU AS REQUIRED FOR INSTALLATION OF NEW DOOR AND LINTEL.
 - 24 REMOVE EXISTING CMU WALL CONSTRUCTION FROM FLOOR TO ROOF DECK.
 - 25 REMOVE EXISTING FLOOR FINISH MATERIAL, INCLUDING BASE, AND PREPARE FOR NEW FINISHES.
 - 26 REMOVE EXISTING HIGH DENSITY SHELVING FOR REINSTALLATION.
 - 27 REMOVE EXISTING CURB AT DOOR OPENING TO 8" BELOW GUTTER LINE.
 - 28 EXISTING BOLLARDS TO REMAIN.
 - 29 REMOVE PLUMBING FIXTURE. REMAINING PLUMBING LINES TO BE REUSED OR CAPPED AS NEEDED. COORDINATE WITH PLUMBING DRAWINGS.
 - 30 REMOVE TOILET STALL PARTITION ENCLOSURE IN ITS ENTIRETY. PATCH/REPAIR ADJACENT FLOOR AND WALL SURFACES AS REQUIRED TO ACCEPT NEW FINISHES. SALVAGE ATTACHED ACCESSORIES FOR FUTURE USE. COORDINATE WITH OWNER.
 - 31 REMOVE EXISTING FABRIC WALL COVERING AND PREPARE WALLS FOR NEW FINISHES.
 - 32 REMOVE CABINET HEATER. COORDINATE WITH MECHANICAL TRADES.
 - 33 REMOVE EXISTING DIVIDER RAIL AND PREPARE FOR NEW FINISHES.
 - 34 REMOVE TOILET ACCESSORIES AND TURN OVER TO OWNER.

- 35 REMOVE EXISTING MASONRY WALL CONSTRUCTION IN ITS ENTIRETY.
- 36 REMOVE CERAMIC/PORCELAIN TILE FLOORING SYSTEM, INCLUDING BASE.
- 37 REMOVE EXISTING CEILING AS REQUIRED TO ACCOMMODATE PLUMBING AND HVAC MODIFICATIONS. REPLACE TO ORIGINAL CONFIGURATION AFTER PLUMBING AND HVAC WORK IS COMPLETED. REPLACE ANY DAMAGED TILES WITH LIKE KIND AND REPAIR ANY DAMAGES TO EXISTING WALL FINISHES TO MATCH EXISTING. COORDINATE WITH MEP DRAWINGS.
- 38 REMOVE EXISTING WALL-MOUNTED EQUIPMENT, INCLUDING ADA PUSH BUTTON, KNOX BOX, ETC., AND SALVAGE FOR FUTURE USE.
- 39 SAW OUT EXISTING FLOOR SLAB WHERE INDICATED TO ACCOMMODATE NEW UNDER-SLAB PLUMBING LINES. COORDINATE LOCATIONS, EXTENTS, AND PATCHING WITH PLUMBING DRAWINGS.
- 40 REMOVE EXISTING FLOOR FINISH MATERIAL AND PREPARE FOR NEW FINISHES - ALTERNATE.

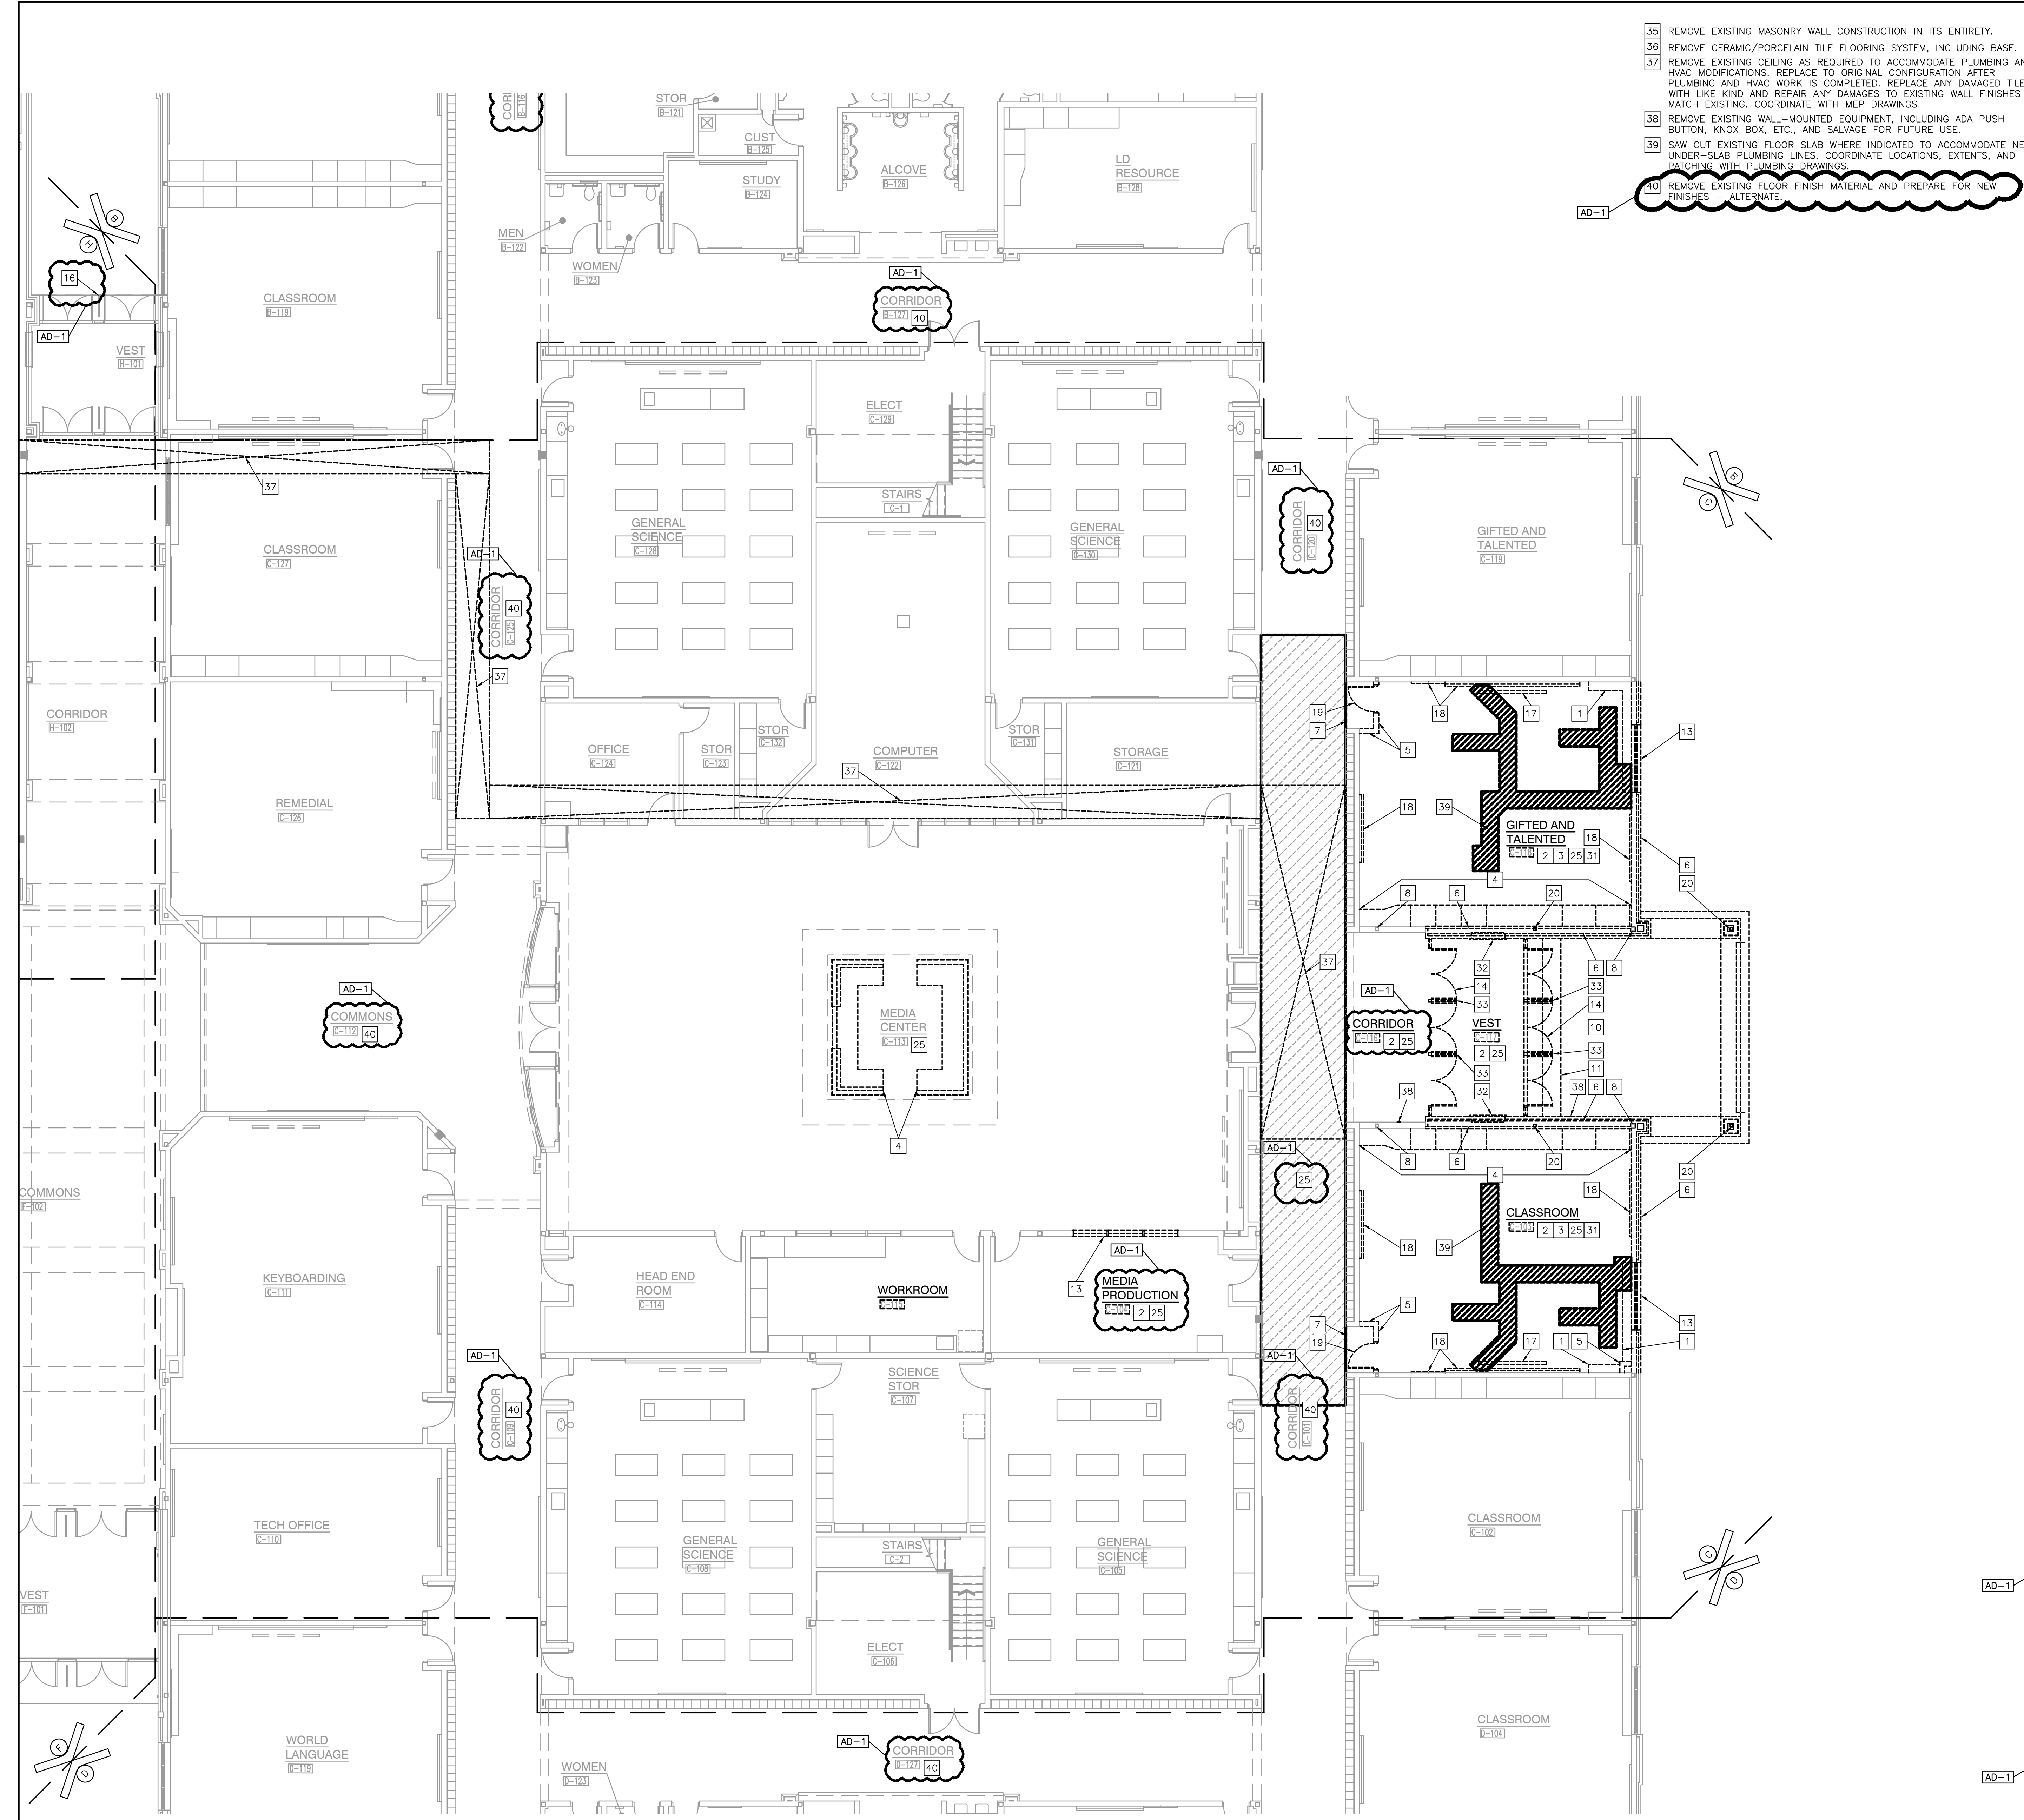

UNIT "C" ARCHITECTURAL FIRST FLOOR DEMOLITION PLAN
SCALE: 1/8" = 1'-0"

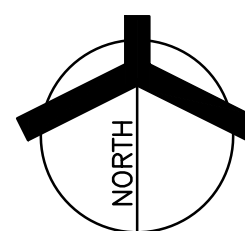

Wednesday, 6/15/2022 - 3:13 PM - LAST SAVED BY: JHARRIS
 Y:\21-155 FRANKLIN TOWNSHIP CSC-EDGEWOOD IS
 ADDITIONS AND RENOVATIONS\21-155 DRAWINGS\05
 ARCH\AD103.DWG

- 35 REMOVE EXISTING MASONRY WALL CONSTRUCTION IN ITS ENTIRETY.
- 36 REMOVE CERAMIC/PORCELAIN TILE FLOORING SYSTEM, INCLUDING BASE.
- 37 REMOVE EXISTING CEILING AS REQUIRED TO ACCOMMODATE PLUMBING AND HVAC MODIFICATIONS. REPLACE TO ORIGINAL CONFIGURATION AFTER PLUMBING AND HVAC WORK IS COMPLETED. REPLACE ANY DAMAGED TILES WITH LIKE KIND AND REPAIR ANY DAMAGES TO EXISTING WALL FINISHES TO MATCH EXISTING. COORDINATE WITH MEP DRAWINGS.
- 38 REMOVE EXISTING WALL-MOUNTED EQUIPMENT, INCLUDING ADA PUSH BUTTON, KNOX BOX, ETC., AND SALVAGE FOR FUTURE USE.
- 39 SAW OUT EXISTING FLOOR SLAB WHERE INDICATED TO ACCOMMODATE NEW UNDER-SLAB PLUMBING LINES. COORDINATE LOCATIONS, EXTENTS, AND PATCHING WITH PLUMBING DRAWINGS.
- 40 REMOVE EXISTING FLOOR FINISH MATERIAL AND PREPARE FOR NEW FINISHES - ALTERNATE.

GENERAL DEMOLITION NOTES:

- A. FOR GENERAL PROJECT NOTES, MATERIAL INDICATIONS LEGEND, SYMBOL LEGEND, ABBREVIATIONS, ETC., REFER TO GI SERIES SHEETS.
- B. UNLESS NOTED OTHERWISE ON THIS SHEET, THE GENERAL CONTRACTOR IS RESPONSIBLE FOR ALL DEMOLITION AND REMOVAL WORK INDICATED ON THIS SHEET.
- C. CONTRACTORS ENCOUNTERING EXISTING MATERIAL WHICH IS SUSPECTED OF CONTAINING ASBESTOS SHALL STOP WORK IMMEDIATELY AND NOTIFY THE OWNER AND THE OWNERS REPRESENTATIVE.
- D. BOLD DASHED LINES INDICATE EXISTING ITEMS TO BE REMOVED UNLESS OTHERWISE NOTED. THE CONTRACTOR SHALL BE RESPONSIBLE FOR FIELD VERIFYING THE EXTENT OF DEMOLITION WORK PRIOR TO BIDDING AND FOR COORDINATING THE EXTENT OF DEMOLITION WITH THE INSTALLATION OF NEW SYSTEMS.
- E. EACH CONTRACTOR SHALL BE RESPONSIBLE FOR ALL DEMOLITION APPLICABLE TO THEIR SCOPE OF WORK AND AS REQUIRED FOR INSTALLATION OF NEW WORK WHETHER OR NOT IT IS SPECIFICALLY INDICATED OR NOTED IN THESE DOCUMENTS.
- F. REMOVE ALL ITEMS AND FINISHES MADE OBSOLETE BY NEW CONSTRUCTION. VERIFY ITEMS DEEMED OBSOLETE WITH ARCHITECT PRIOR TO REMOVAL. REFER TO NEW CONSTRUCTION DRAWINGS FOR DEMOLITION REQUIRED NOT SHOWN ON DEMOLITION PLANS.
- G. EACH CONTRACTOR SHALL BE RESPONSIBLE FOR OFF SITE REMOVAL OF ALL DEMOLITION MATERIALS AND/OR ITEMS UNLESS NOTED OTHERWISE OR DIRECTED BY THE OWNER.
- H. PRIOR TO STARTING DEMOLITION, CONSTRUCT DUST CONTROL BARRIERS AS REQUIRED TO PREVENT THE SPREAD OF DUST INTO SURROUNDING AREAS (WHERE APPLICABLE).
- I. WHERE BUILDING EGRESS IS REQUIRED TO PASS THROUGH DEMOLITION AREAS, PROVIDE APPROVED BARRIERS, ETC. TO ENSURE SAFETY OF THE PUBLIC.
- J. RELOCATED ITEMS SHALL BE CLEANED AND PLACED IN STORAGE, PER OWNERS' DIRECTION, UNTIL ITEMS ARE READY TO BE INSTALLED. IF ITEMS ARE DAMAGED DURING DEMOLITION OR RELOCATION, THEY SHALL BE REPAIRED OR REPLACED WITH NEW ITEMS AS APPROVED.
- K. DEMOLITION SHALL BE PERFORMED WITHOUT DAMAGE TO EXISTING CONSTRUCTION TO REMAIN. WHERE SUCH DAMAGE OCCURS, PATCH, REPAIR, OR RESTORE WALLS, FLOORS, CEILING, ETC. NEATLY TO MATCH EXISTING ADJACENT SURFACE. PROVIDE SHORING, BRACING, OR SUPPORT AS REQUIRED TO PREVENT MOVEMENT OR SETTLEMENT OF EXISTING STRUCTURES.
- L. EACH CONTRACTOR IS RESPONSIBLE FOR CUTTING, PATCHING, AND DISCONNECTION OF ITEMS APPLICABLE TO THEIR SCOPE OF WORK. WHERE EXISTING SERVICES ARE ABANDONED, CAP AT LEAST 1" BEHIND NEW FINISHES AND/OR EXISTING SURFACE AND PATCH AS REQUIRED TO RECEIVE NEW FINISHES OR MATCH EXISTING FINISH.
- M. ON WALLS THAT ARE TO RECEIVE NEW FINISHES, REMOVE AND REINSTALL EXISTING EQUIPMENT TO REMAIN AS REQUIRED FOR INSTALLATION OF NEW FINISHES.
- N. WHERE WALLS OR BULKHEADS ARE REMOVED, PATCH FLOORS, CEILINGS, AND ADJACENT WALLS AS REQUIRED TO MATCH EXISTING OR RECEIVE NEW FINISHES WHERE APPLICABLE. WHERE EXISTING DUCTWORK, PIPING, OR EQUIPMENT IS REMOVED, PATCH OPENINGS AND/OR SURFACES AS REQUIRED TO MATCH ADJACENT SURFACES OR RECEIVE NEW FINISHES WHERE APPLICABLE. REFER TO ALL DEMOLITION DRAWINGS FOR EXTENT OF ITEMS TO BE REMOVED.
- O. OVER CUT NEW OPENINGS IN EXISTING WALL AS REQUIRED FOR NEW CONSTRUCTION. PATCH AND REPAIR WALLS AS REQUIRED TO MATCH EXISTING. WHERE APPLICABLE, TOOTH NEW MASONRY INTO EXISTING MASONRY.
- P. ALL EQUIPMENT AND FURNITURE WHICH ARE CONSIDERED LOOSE FURNISHING SHALL BE REMOVED BY THE OWNER PRIOR TO DEMOLITION.
- Q. MASONRY WALLS TO BE REMOVED SHALL BE REMOVED TO A POINT 2" MINIMUM BELOW THE EXISTING FLOOR SLAB UNLESS SETTING ON A SLAB OR SPECIFICALLY NOTED OTHERWISE. PATCH WITH NEW CONCRETE TO BE FLUSH WITH THE EXISTING FLOOR SLAB.
- R. EACH CONTRACTOR SHALL BE RESPONSIBLE FOR GENERAL REVIEW OF DEMOLITION NOTES AND GENERAL DEMOLITION NOTES AS THEY APPLY TO THEIR SCOPE OF WORK.
- S. THE OWNER SHALL RESERVE THE RIGHT TO CLAIM ANY MATERIALS THAT ARE BEING DEMOLISHED PRIOR TO THE CONTRACTOR DISPOSING OF THEM OFF SITE.
- T. REFER TO THE STRUCTURAL, MECHANICAL, PLUMBING, ELECTRICAL AND TECHNOLOGY DOCUMENTS FOR COMPLETE SCOPE OF DEMOLITION WORK.
- U. "FLOORING" DENOTES FLOOR COVERING MATERIALS INCLUDING BACKING, ADHESIVES, AND BASES DOWN TO BUT EXCLUSIVE OF FLOOR SLABS AND STRUCTURAL MATERIALS UNLESS NOTED OTHERWISE.
- V. DEMOLITION IS TO FOLLOW ESTABLISHED CONSTRUCTION SEQUENCE. REFER TO SPECIFICATIONS AND DRAWINGS FOR REQUIREMENTS AND SPECIAL CONDITIONS.
- W. WHERE APPLICABLE SALVAGE EXISTING MASONRY (FACE BRICK, GLAZED CMU, FACING TILE) AS REQUIRED FOR PATCHING AND INFILL IN RENOVATED AREAS WHERE INDICATED. DISCARD UNUSED PORTION OFF SITE.


DEMOLITION PLAN NOTES:

- (ALL PLAN NOTES MAY NOT BE INDICATED ON THIS SHEET.)
- 1 REMOVE SHELVING IN ITS ENTIRETY.
 - 2 REMOVE ACOUSTICAL BOARD CEILING SYSTEM IN ITS ENTIRETY.
 - 3 REMOVE VINYL BASE IN ITS ENTIRETY.
 - 4 REMOVE CASEWORK IN ITS ENTIRETY.
 - 5 REMOVE METAL STUD AND GYPSUM BOARD WALL IN ITS ENTIRETY. PATCH AND REPAIR ADJACENT WALL AND FLOOR AS REQUIRED TO ACCEPT NEW FINISHES.
 - 6 REMOVE MASONRY WALL CONSTRUCTION AND ATTACHED FINISHES IN ITS ENTIRETY. PATCH/REPAIR ADJACENT FLOOR AND WALL SURFACES AS REQUIRED TO ACCEPT NEW FINISHES.
 - 7 REMOVE METAL STUD AND GYPSUM BOARD BULKHEAD IN ITS ENTIRETY. PATCH AND REPAIR WALL AS REQUIRED FOR NEW FINISHES.
 - 8 EXISTING STEEL COLUMN TO REMAIN.
 - 9 REMOVE EXISTING SLAB AS REQUIRED FOR NEW CONSTRUCTION.
 - 10 REMOVE ENTIRE PORTION OF BUILDING IN THIS AREA INCLUDING MASONRY WALLS, STEEL FRAMING, CONCRETE SLAB ON GRADE, ROOFING, CONCRETE FOOTINGS, AND FOUNDATION WALLS AS REQUIRED FOR NEW CONSTRUCTION. COORDINATE WITH STRUCTURAL.
 - 11 REMOVE VOID SLAB/STOOP AS REQUIRED FOR NEW CONSTRUCTION. COORDINATE WITH CIVIL.
 - 12 REMOVE BRICK CLADDING BACK TO CMU WALL OR STEEL COLUMN (TO REMAIN) WHERE INDICATED.
 - 13 REMOVE WINDOW SYSTEM IN ITS ENTIRETY.
 - 14 REMOVE ALUMINUM STOREFRONT FRAMING, DOORS, AND HARDWARE IN ITS ENTIRETY.
 - 15 REMOVE EXISTING EIFS FASCIA AND SOFFIT ABOVE. STRUCTURAL FRAMING TO REMAIN.
 - 16 REMOVE EXISTING DOOR NUMBER IN ITS ENTIRETY.
 - 17 REMOVE EXISTING PROJECTION SCREEN AND TURN OVER TO OWNER.
 - 18 REMOVE TACK BOARD OR MARKER BOARD OR CHALKBOARD IN THEIR ENTIRETY. PATCH WALL AS REQUIRED TO RECEIVE NEW FINISHES.
 - 19 REMOVE WOOD DOOR, FRAME AND HARDWARE IN ITS ENTIRETY.
 - 20 REMOVE ALL OR PART OF STEEL COLUMN AS NEEDED TO ACCOMMODATE THE PROPOSED PLAN. COORDINATE WITH STRUCTURAL DRAWINGS.
 - 21 REMOVE METAL DOOR, FRAME AND HARDWARE IN ITS ENTIRETY.
 - 22 REMOVE EXISTING HANDRAIL AND CUT SLAB EDGE AS REQUIRED FOR NEW CONSTRUCTION. SEE SECTION.
 - 23 CUT OPENING IN EXISTING CMU AS REQUIRED FOR INSTALLATION OF NEW DOOR AND LINTEL.
 - 24 REMOVE EXISTING CMU WALL CONSTRUCTION FROM FLOOR TO ROOF DECK.
 - 25 REMOVE EXISTING FLOOR FINISH MATERIAL, INCLUDING BASE, AND PREPARE FOR NEW FINISHES.
 - 26 REMOVE EXISTING HIGH DENSITY SHELVING FOR REINSTALLATION.
 - 27 REMOVE EXISTING CURB AT DOOR OPENING TO 8" BELOW GUTTER LINE.
 - 28 EXISTING BOLLARDS TO REMAIN.
 - 29 REMOVE PLUMBING FIXTURE. REMAINING PLUMBING LINES TO BE REUSED OR CAPPED AS NEEDED. COORDINATE WITH PLUMBING DRAWINGS.
 - 30 REMOVE TOILET STALL PARTITION ENCLOSURE IN ITS ENTIRETY. PATCH/REPAIR ADJACENT FLOOR AND WALL SURFACES AS REQUIRED TO ACCEPT NEW FINISHES. SALVAGE ATTACHED ACCESSORIES FOR FUTURE USE. COORDINATE WITH OWNER.
 - 31 REMOVE EXISTING FABRIC WALL COVERING AND PREPARE WALLS FOR NEW FINISHES.
 - 32 REMOVE CABINET HEATER. COORDINATE WITH MECHANICAL TRADES.
 - 33 REMOVE EXISTING DIVIDER RAIL AND PREPARE FOR NEW FINISHES.
 - 34 REMOVE TOILET ACCESSORIES AND TURN OVER TO OWNER.



GIBRALTAR DESIGN
ARCHITECTURE • ENGINEERING • INTERIOR DESIGN

PROJECT
ADDITIONS AND RENOVATIONS TO
EDGEWOOD INTERMEDIATE SCHOOL
FRANKLIN TOWNSHIP COMMUNITY SCHOOL CORPORATION
INDIANAPOLIS, INDIANA

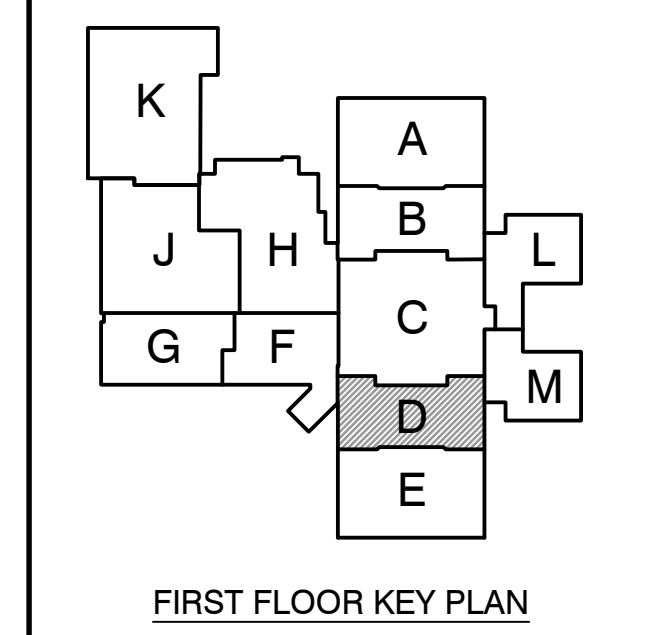

GIBRALTAR DESIGN
9102 N. Meridian St., Ste. 300
Indianapolis, IN 46260
Homepage: www.GibraltarDesign.com
Email: info@GibraltarDesign.com
Phone: 317.580.5777 Fax: 317.580.5778

PROJECT 21-155
DATE 05/23/22
COORDINATED BY DJW
DRAWN BY JRH
CHECKED BY DJW


COPYRIGHT NOTICE:
THE CONCEPTS, DESIGNS, PLANS, DETAILS, ETC. SHOWN ON THIS DOCUMENT ARE THE PROPERTY OF GIBRALTAR DESIGN AND ARE CREATED FOR USE ON THIS SPECIFIC PROJECT. NONE OF THIS INFORMATION SHALL BE USED BY ANY PERSON OR FIRM FOR ANY PURPOSE WITHOUT THE EXPRESS WRITTEN CONSENT OF GIBRALTAR DESIGN. THE OWNER MAY RETAIN COPIES FOR INFORMATION AND REFERENCE IN CONNECTION ONLY WITH THIS PROJECT.

MARK	DATE	ISSUED FOR
AD-1	06/16/22	ADDENDUM NO. 1

DRAWING
UNIT "D" ARCHITECTURAL FIRST FLOOR DEMOLITION PLAN


PROJECT
ADDITIONS AND RENOVATIONS TO
EDGEWOOD INTERMEDIATE SCHOOL

D SHEET
D AD105

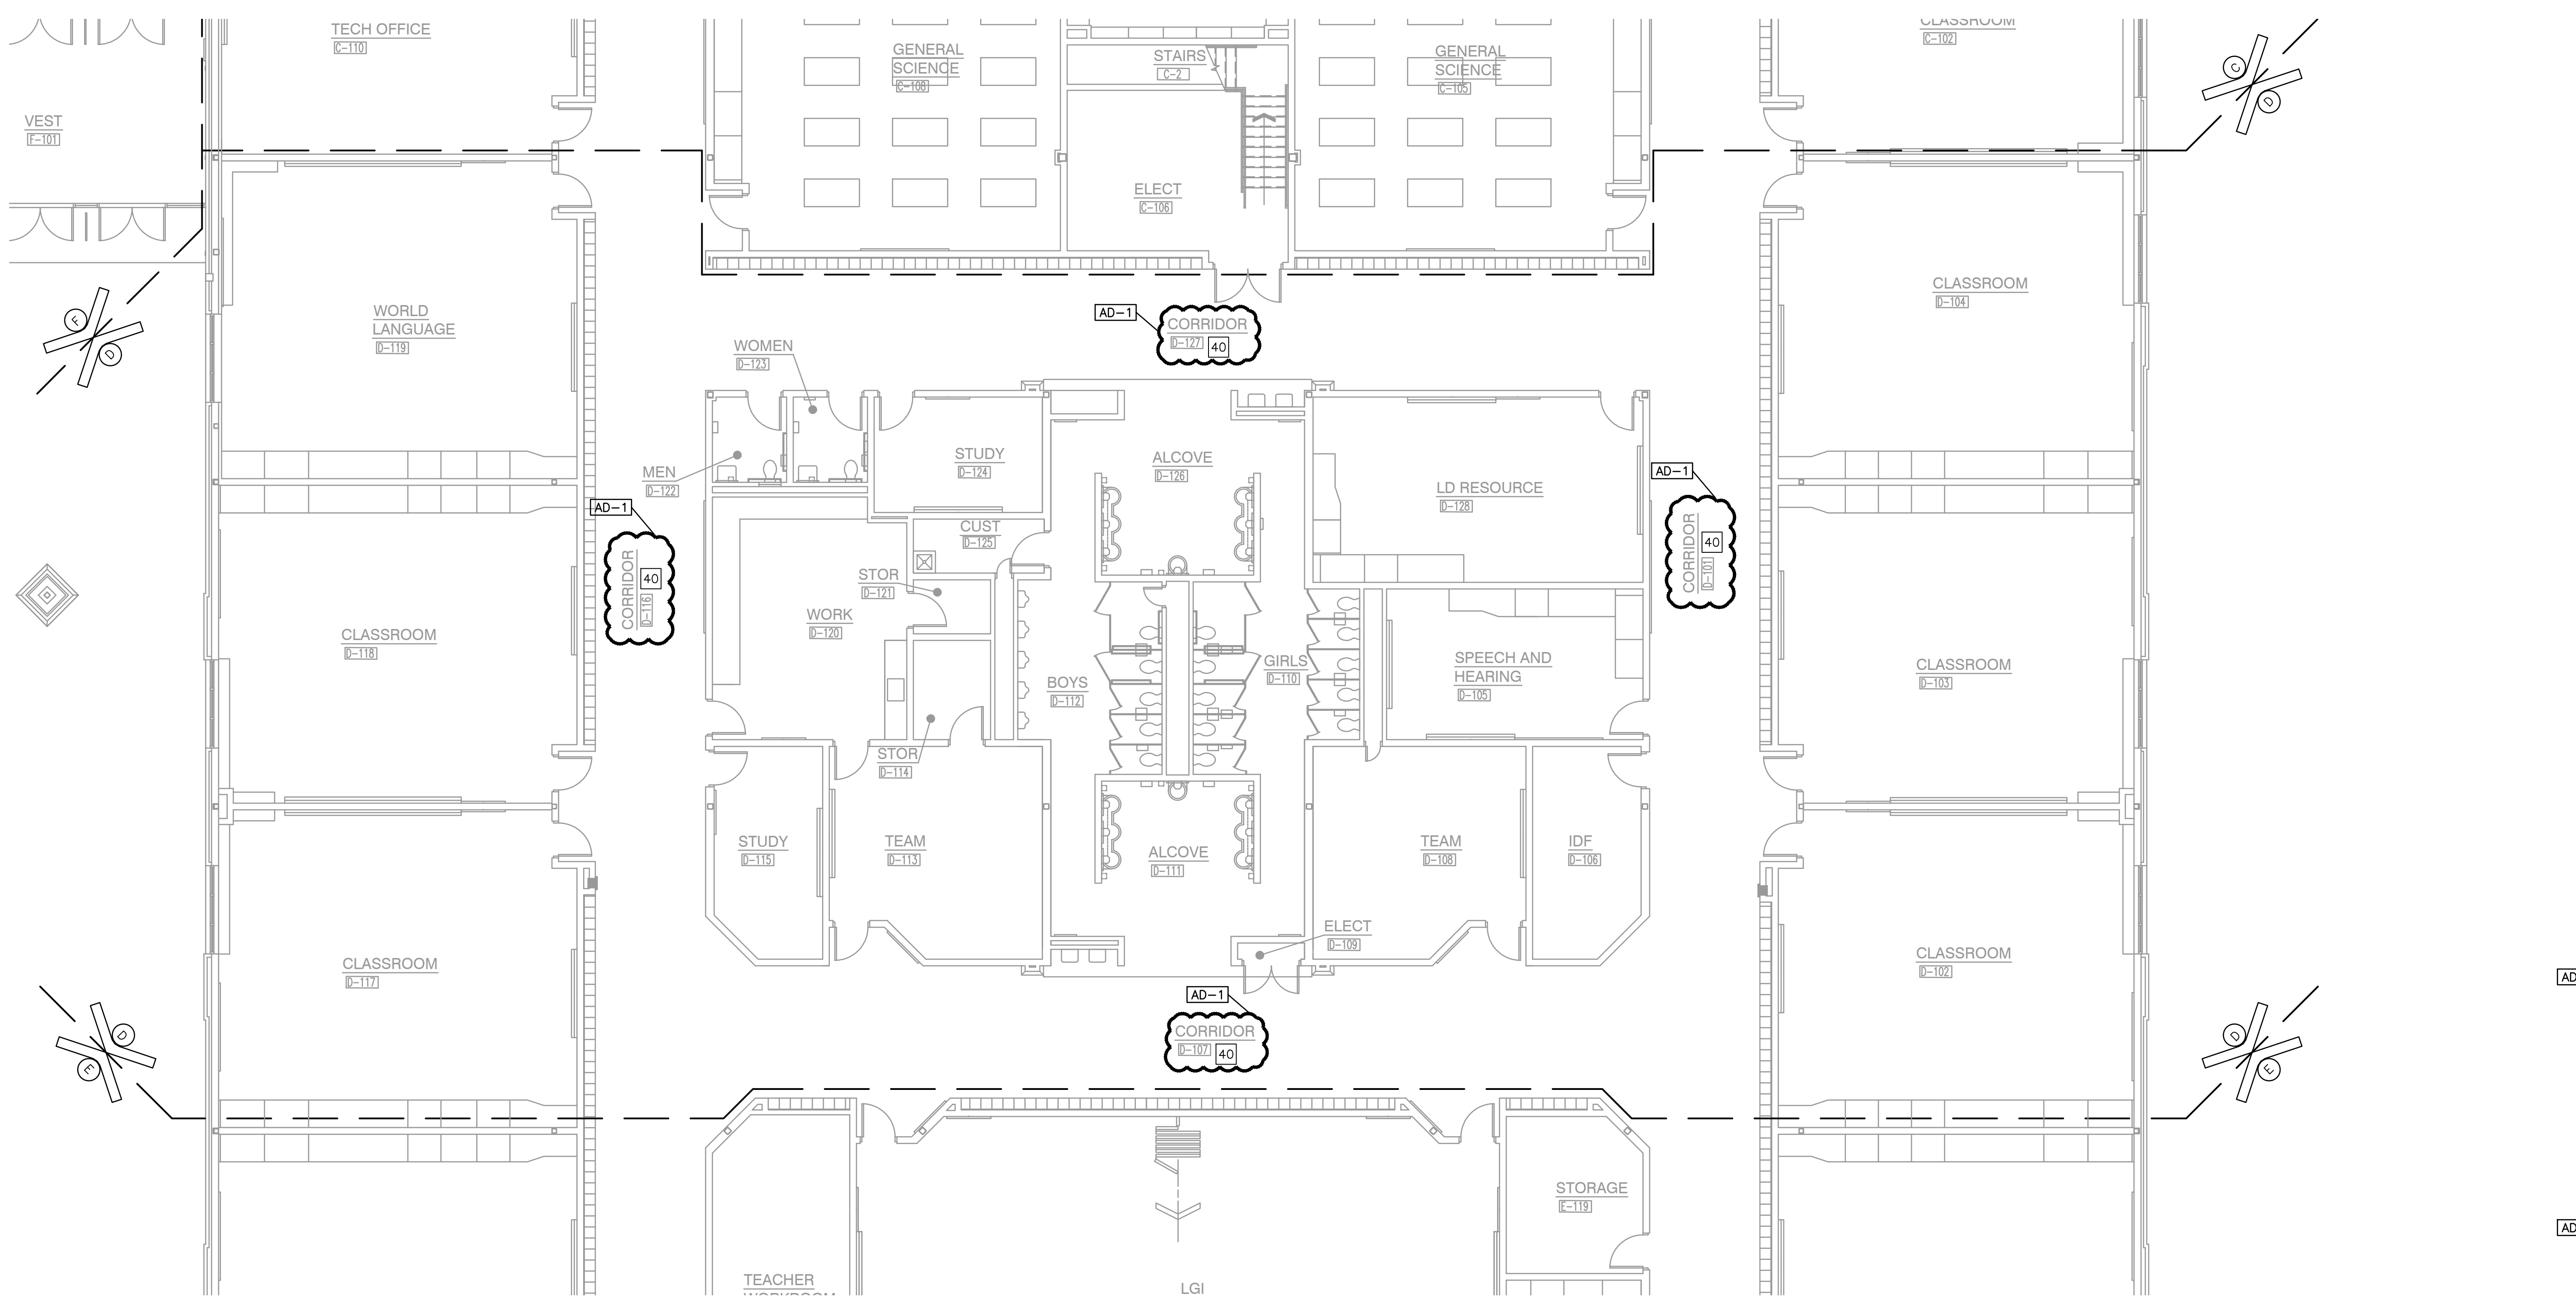

UNIT "D" ARCHITECTURAL FIRST FLOOR DEMOLITION PLAN

SCALE: 1/8" = 1'-0"

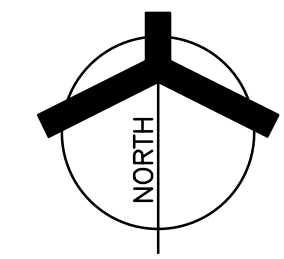


NOTE: THIS SHEET HAS BEEN ADDED AS PART OF ADDENDUM #1 ISSUANCE.

Wednesday, 6/15/2022 - 3:14 PM - LAST SAVED BY: JHARRIS
Y:\21-155 FRANKLIN TOWNSHIP CSC-EDGEWOOD IS ADDITIONS AND RENOVATIONS\21-155 DRAWINGS\05 ARCH\AD105.DWG



GIBRALTAR
DESIGN
ARCHITECTURE • ENGINEERING • INTERIOR DESIGN


PROJECT
ADDITIONS AND RENOVATIONS TO
EDGEWOOD INTERMEDIATE SCHOOL
FRANKLIN TOWNSHIP COMMUNITY SCHOOL CORPORATION
INDIANAPOLIS, INDIANA

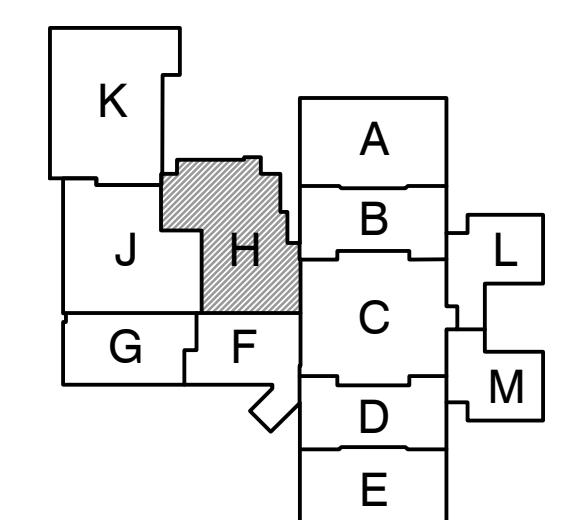

FIRST FLOOR KEY PLAN

GIBRALTAR DESIGN
9102 N. Meridian St., Ste. 300
Indianapolis, IN 46260
Homepage: www.GibraltarDesign.com
Email: info@GibraltarDesign.com
Phone: 317.580.5777 Fax: 317.580.5778

PROJECT
21-155
DATE
05/23/22
COORDINATED BY
DJW
DRAWN BY
JRH
CHECKED BY
DJW

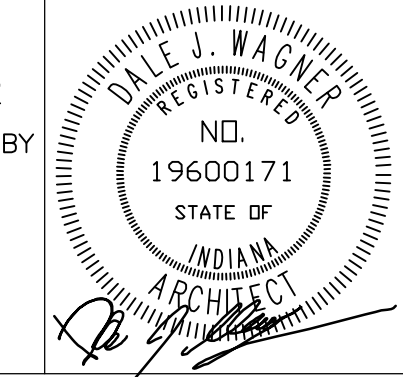

COPYRIGHT NOTICE:
THE CONCEPTS, DESIGNS, PLANS, DETAILS, ETC. SHOWN ON THIS DOCUMENT ARE THE PROPERTY OF GIBRALTAR DESIGN AND WERE CREATED FOR USE ON THIS SPECIFIC PROJECT. NONE OF THIS INFORMATION SHALL BE USED BY ANY PERSON OR FIRM FOR ANY PURPOSE WITHOUT THE EXPRESS WRITTEN CONSENT OF GIBRALTAR DESIGN. THE OWNER MAY RETAIN COPIES FOR INFORMATION AND REFERENCE IN CONNECTION ONLY WITH THIS PROJECT.

REVISIONS	MARK	DATE	ISSUED FOR
AD-1	06/16/22	ADDENDUM NO. 1	

DRAWING
UNIT "H" ARCHITECTURAL FIRST FLOOR DEMOLITION PLAN

PROJECT
ADDITIONS AND RENOVATIONS TO
EDGEWOOD INTERMEDIATE SCHOOL

© GIBRALTAR DESIGN SHEET
AD109


GENERAL DEMOLITION NOTES:

- A. FOR GENERAL PROJECT NOTES, MATERIAL INDICATIONS LEGEND, SYMBOL LEGEND, ABBREVIATIONS, ETC., REFER TO GI SERIES SHEETS.
- B. UNLESS NOTED OTHERWISE ON THIS SHEET, THE GENERAL CONTRACTOR IS RESPONSIBLE FOR ALL DEMOLITION AND REMOVAL WORK INDICATED ON THIS SHEET.
- C. CONTRACTORS ENCOUNTERING EXISTING MATERIAL WHICH IS SUSPECTED OF CONTAINING ASBESTOS SHALL STOP WORK IMMEDIATELY AND NOTIFY THE OWNER AND THE OWNERS REPRESENTATIVE.
- D. BOLD DASHED LINES INDICATE EXISTING ITEMS TO BE REMOVED UNLESS OTHERWISE NOTED. THE CONTRACTOR SHALL BE RESPONSIBLE FOR FIELD VERIFYING THE EXTENT OF DEMOLITION WORK PRIOR TO BIDDING AND FOR COORDINATING THE EXTENT OF DEMOLITION WITH THE INSTALLATION OF NEW SYSTEMS.
- E. EACH CONTRACTOR SHALL BE RESPONSIBLE FOR ALL DEMOLITION APPLICABLE TO THEIR SCOPE OF WORK AND AS REQUIRED FOR INSTALLATION OF NEW WORK WHETHER OR NOT IT IS SPECIFICALLY INDICATED OR NOTED IN THESE DOCUMENTS.
- F. REMOVE ALL ITEMS AND FINISHES MADE OBSOLETE BY NEW CONSTRUCTION. REFER TO NEW CONSTRUCTION DRAWINGS FOR DEMOLITION REQUIRED NOT SHOWN ON DEMOLITION PLANS.
- G. EACH CONTRACTOR SHALL BE RESPONSIBLE FOR OFF SITE REMOVAL OF ALL DEMOLITION MATERIALS AND/OR ITEMS UNLESS NOTED OTHERWISE OR DIRECTED BY THE OWNER.
- H. PRIOR TO STARTING DEMOLITION, CONSTRUCT DUST CONTROL BARRIERS AS REQUIRED TO PREVENT THE SPREAD OF DUST INTO SURROUNDING AREAS (WHERE APPLICABLE).
- I. WHERE BUILDING EGRESS IS REQUIRED TO PASS THROUGH DEMOLITION AREAS, PROVIDE APPROVED BARRIERS, ETC. TO ENSURE SAFETY OF THE PUBLIC.
- J. RELOCATED ITEMS SHALL BE CLEANED AND PLACED IN STORAGE, PER OWNERS' DIRECTION, UNTIL ITEMS ARE READY TO BE INSTALLED. IF ITEMS ARE DAMAGED DURING DEMOLITION OR RELOCATION, THEY SHALL BE REPAIRED OR REPLACED WITH NEW ITEMS AS APPROVED.
- K. DEMOLITION SHALL BE PERFORMED WITHOUT DAMAGE TO EXISTING CONSTRUCTION TO REMAIN. WHERE SUCH DAMAGE OCCURS, PATCH, REPAIR, OR RESTORE WALLS, FLOORS, CEILING, ETC. NEATLY TO MATCH EXISTING ADJACENT SURFACE. PROVIDE SHORING, BRACING, OR SUPPORT AS REQUIRED TO PREVENT MOVEMENT OR SETTLEMENT OF EXISTING STRUCTURES.
- L. EACH CONTRACTOR IS RESPONSIBLE FOR CUTTING, PATCHING, AND DISCONNECTION OF ITEMS APPLICABLE TO THEIR SCOPE OF WORK. WHERE EXISTING SERVICES ARE ABANDONED, CAP AT LEAST 1" BEHIND NEW FINISHES AND/OR EXISTING SURFACE AND PATCH AS REQUIRED TO RECEIVE NEW FINISHES OR MATCH EXISTING FINISH.
- M. ON WALLS THAT ARE TO RECEIVE NEW FINISHES, REMOVE AND REINSTALL EXISTING EQUIPMENT TO REMAIN AS REQUIRED FOR INSTALLATION OF NEW FINISHES.
- N. WHERE WALLS OR BULKHEADS ARE REMOVED, PATCH FLOORS, CEILINGS, AND ADJACENT WALLS AS REQUIRED TO MATCH EXISTING OR RECEIVE NEW FINISHES WHERE APPLICABLE. WHERE EXISTING DUCTWORK, PIPING, OR EQUIPMENT IS REMOVED, PATCH OPENINGS AND/OR SURFACES AS REQUIRED TO MATCH ADJACENT SURFACES OR RECEIVE NEW FINISHES WHERE APPLICABLE. REFER TO ALL DEMOLITION DRAWINGS FOR EXTENT OF ITEMS TO BE REMOVED.
- O. OVER CUT NEW OPENINGS IN EXISTING WALL AS REQUIRED FOR NEW CONSTRUCTION. PATCH AND REPAIR WALLS AS REQUIRED TO MATCH EXISTING. WHERE APPLICABLE, TOOTH NEW MASONRY INTO EXISTING MASONRY.
- P. ALL EQUIPMENT AND FURNITURE WHICH ARE CONSIDERED LOOSE FURNISHING SHALL BE REMOVED BY THE OWNER PRIOR TO DEMOLITION.
- Q. MASONRY WALLS TO BE REMOVED SHALL BE REMOVED TO A POINT 2" MINIMUM BELOW THE EXISTING FLOOR SLAB UNLESS SETTING ON A SLAB OR SPECIFICALLY NOTED OTHERWISE. PATCH WITH NEW CONCRETE TO BE FLUSH WITH THE EXISTING FLOOR SLAB.
- R. EACH CONTRACTOR SHALL BE RESPONSIBLE FOR GENERAL REVIEW OF DEMOLITION NOTES AND GENERAL DEMOLITION NOTES AS THEY APPLY TO THEIR SCOPE OF WORK.
- S. THE OWNER SHALL RESERVE THE RIGHT TO CLAIM ANY MATERIALS THAT ARE BEING DEMOLISHED PRIOR TO THE CONTRACTOR DISPOSING OF THEM OFF SITE.
- T. REFER TO THE STRUCTURAL, MECHANICAL, PLUMBING, ELECTRICAL AND TECHNOLOGY DOCUMENTS FOR COMPLETE SCOPE OF DEMOLITION WORK.
- U. "FLOORING" DENOTES FLOOR COVERING MATERIALS INCLUDING BACKING, ADHESIVES, AND BASES DOWN TO BUT EXCLUSIVE OF FLOOR SLABS AND STRUCTURAL MATERIALS UNLESS NOTED OTHERWISE.
- V. DEMOLITION IS TO FOLLOW ESTABLISHED CONSTRUCTION SEQUENCE. REFER TO SPECIFICATIONS AND DRAWINGS FOR REQUIREMENTS AND SPECIAL CONDITIONS.
- W. WHERE APPLICABLE SALVAGE EXISTING MASONRY (FACE BRICK, GLAZED CMU, FACING TILE) AS REQUIRED FOR PATCHING AND INFILL IN RENOVATED AREAS WHERE INDICATED. DISCARD UNUSED PORTION OFF SITE.

DEMOLITION PLAN NOTES:

- (ALL PLAN NOTES MAY NOT BE INDICATED ON THIS SHEET.)
- 1 REMOVE SHELVING IN ITS ENTIRETY.
 - 2 REMOVE ACOUSTICAL BOARD CEILING SYSTEM IN ITS ENTIRETY.
 - 3 REMOVE VINYL BASE IN ITS ENTIRETY.
 - 4 REMOVE CASEWORK IN ITS ENTIRETY.
 - 5 REMOVE METAL STUD AND GYPSUM BOARD WALL IN ITS ENTIRETY. PATCH AND REPAIR ADJACENT WALL AND FLOOR AS REQUIRED TO ACCEPT NEW FINISHES.
 - 6 REMOVE MASONRY WALL CONSTRUCTION AND ATTACHED FINISHES IN ITS ENTIRETY. PATCH/REPAIR ADJACENT FLOOR AND WALL SURFACES AS REQUIRED TO ACCEPT NEW FINISHES.
 - 7 REMOVE METAL STUD AND GYPSUM BOARD BULKHEAD IN ITS ENTIRETY. PATCH AND REPAIR WALL AS REQUIRED FOR NEW FINISHES.
 - 8 EXISTING STEEL COLUMN TO REMAIN.
 - 9 REMOVE EXISTING SLAB AS REQUIRED FOR NEW CONSTRUCTION.
 - 10 REMOVE ENTIRE PORTION OF BUILDING IN THIS AREA INCLUDING MASONRY WALLS, STEEL FRAMING, CONCRETE SLAB ON GRADE, ROOFING, CONCRETE FOOTINGS, AND FOUNDATION WALLS AS REQUIRED FOR NEW CONSTRUCTION. COORDINATE WITH STRUCTURAL.
 - 11 REMOVE VOID SLAB/STOOP AS REQUIRED FOR NEW CONSTRUCTION. COORDINATE WITH CIVIL.
 - 12 REMOVE BRICK CLADDING BACK TO CMU WALL OR STEEL COLUMN (TO REMAIN) WHERE INDICATED.
 - 13 REMOVE WINDOW SYSTEM IN ITS ENTIRETY.
 - 14 REMOVE ALUMINUM STOREFRONT FRAMING, DOORS, AND HARDWARE IN ITS ENTIRETY.
 - 15 REMOVE EXISTING EIFS FASCIA AND SOFFIT ABOVE. STRUCTURAL FRAMING TO REMAIN.
 - 16 REMOVE EXISTING DOOR NUMBER IN ITS ENTIRETY.
 - 17 REMOVE EXISTING PROJECTION SCREEN AND TURN OVER TO OWNER.
 - 18 REMOVE TAGBOARD OR CHALKBOARD IN THEIR ENTIRETY. PATCH WALL AS REQUIRED TO RECEIVE NEW FINISHES.
 - 19 REMOVE WOOD DOOR, FRAME AND HARDWARE IN ITS ENTIRETY.
 - 20 REMOVE ALL OR PART OF STEEL COLUMN AS NEEDED TO ACCOMMODATE THE PROPOSED PLAN. COORDINATE WITH STRUCTURAL DRAWINGS.
 - 21 REMOVE METAL DOOR, FRAME AND HARDWARE IN ITS ENTIRETY.
 - 22 REMOVE EXISTING HANDRAIL AND CUT SLAB EDGE AS REQUIRED FOR NEW CONSTRUCTION. SEE SECTION.
 - 23 CUT OPENING IN EXISTING CMU AS REQUIRED FOR INSTALLATION OF NEW DOOR AND LUNEL.
 - 24 REMOVE EXISTING CMU WALL CONSTRUCTION FROM FLOOR TO ROOF DECK.
 - 25 REMOVE EXISTING FLOOR FINISH MATERIAL INCLUDING BASE, AND PREPARE FOR NEW FINISHES.
 - 26 REMOVE EXISTING HIGH DENSITY SHELVING FOR REINSTALLATION.
 - 27 REMOVE EXISTING CURB AT DOOR OPENING TO 8" BELOW GUTTER LINE.
 - 28 EXISTING BOLLARDS TO REMAIN.
 - 29 REMOVE PLUMBING FIXTURE. REMAINING PLUMBING LINES TO BE REUSED OR CAPPED AS NEEDED. COORDINATE WITH PLUMBING DRAWINGS.
 - 30 REMOVE TOILET STALL PARTITION ENCLOSURE IN ITS ENTIRETY. PATCH/REPAIR ADJACENT FLOOR AND WALL SURFACES AS REQUIRED TO ACCEPT NEW FINISHES. SALVAGE ATTACHED ACCESSORIES FOR FUTURE USE. COORDINATE WITH OWNER.
 - 31 REMOVE EXISTING FABRIC WALL COVERING AND PREPARE WALLS FOR NEW FINISHES.
 - 32 REMOVE CABINET HEATER. COORDINATE WITH MECHANICAL TRADES.
 - 33 REMOVE EXISTING DIVIDER RAIL AND PREPARE FOR NEW FINISHES.
 - 34 REMOVE TOILET ACCESSORIES AND TURN OVER TO OWNER.

- 35 REMOVE EXISTING MASONRY WALL CONSTRUCTION IN ITS ENTIRETY.
- 36 REMOVE CERAMIC/PORCELAIN TILE FLOORING SYSTEM, INCLUDING BASE.
- 37 REMOVE EXISTING CEILING AS REQUIRED TO ACCOMMODATE PLUMBING AND HVAC MODIFICATIONS. REPLACE TO ORIGINAL CONFIGURATION AFTER PLUMBING AND HVAC WORK IS COMPLETED. REPLACE ANY DAMAGED TILES WITH LIKE KIND AND REPAIR ANY DAMAGES TO EXISTING WALL FINISHES TO MATCH EXISTING. COORDINATE WITH MEP DRAWINGS.
- 38 REMOVE EXISTING WALL-MOUNTED EQUIPMENT, INCLUDING ADA PUSH BUTTON, KNOX BOX, ETC., AND SALVAGE FOR FUTURE USE.
- 39 SAW OUT EXISTING FLOOR SLAB WHERE INDICATED TO ACCOMMODATE NEW UNDER-SLAB PLUMBING LINES. COORDINATE LOCATIONS, EXTENTS, AND PATCHING WITH PLUMBING DRAWINGS.
- 40 REMOVE EXISTING FLOOR FINISH MATERIAL AND PREPARE FOR NEW FINISHES - ALTERNATE.

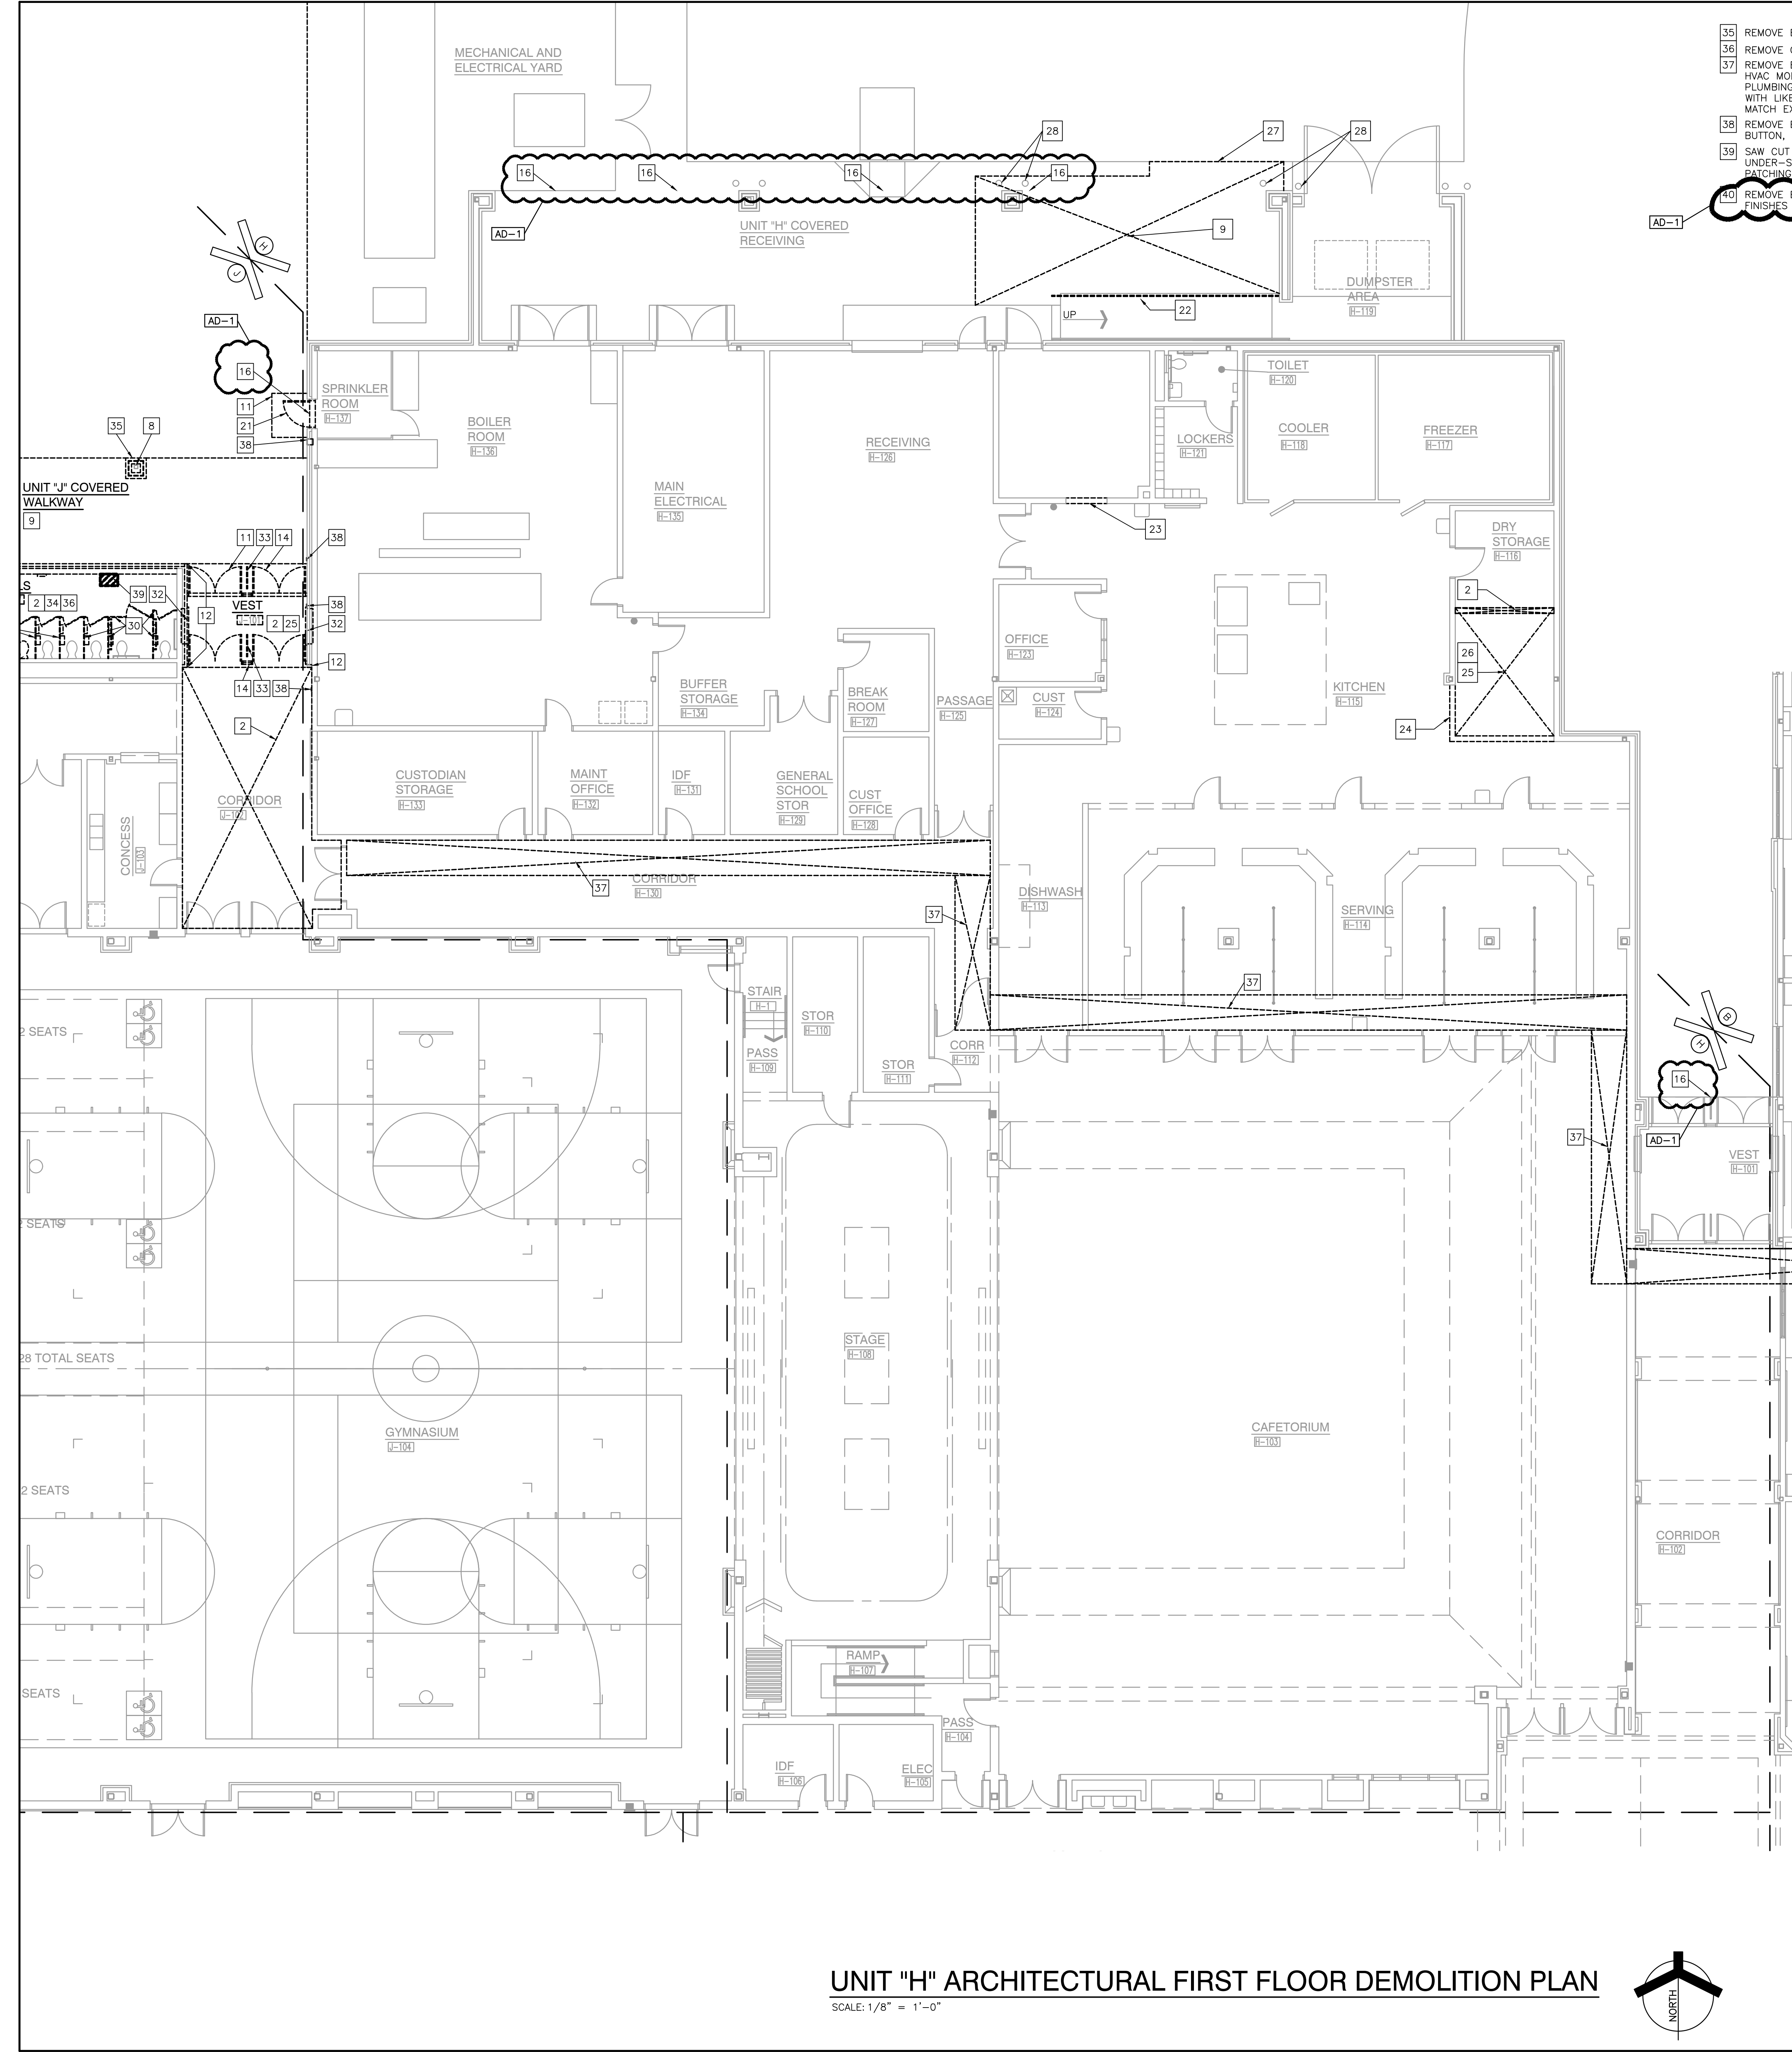


UNIT "H" ARCHITECTURAL FIRST FLOOR DEMOLITION PLAN
SCALE: 1/8" = 1'-0"

Wednesday, 6/15/2022 - 3:17 PM - LAST SAVED BY: JHARRIS
 Y:\21-155 FRANKLIN TOWNSHIP CSC-EDGEWOOD IS
 ADDITIONS AND RENOVATIONS\21-155 DRAWINGS\05
 ARCH\AD109.DWG



GIBRALTAR
DESIGN
ARCHITECTURE • ENGINEERING • INTERIOR DESIGN


PROJECT
ADDITIONS AND RENOVATIONS TO
EDGEWOOD INTERMEDIATE SCHOOL
FRANKLIN TOWNSHIP COMMUNITY SCHOOL CORPORATION
INDIANAPOLIS, INDIANA

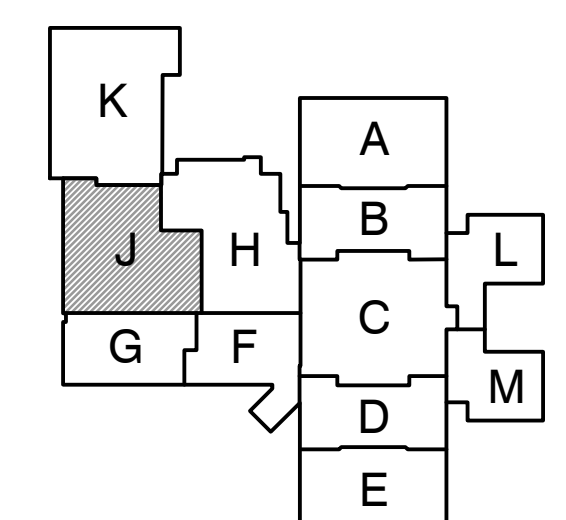

FIRST FLOOR KEY PLAN

GIBRALTAR DESIGN
9102 N. Meridian St., Ste. 300
Indianapolis, IN 46260
Homepage: www.GibraltarDesign.com
Email: info@GibraltarDesign.com
Phone: 317.580.5777 Fax: 317.580.5778

PROJECT
21-155
DATE
05/23/22
COORDINATED BY
DUJ
DRAWN BY
JRH
CHECKED BY
DUJ

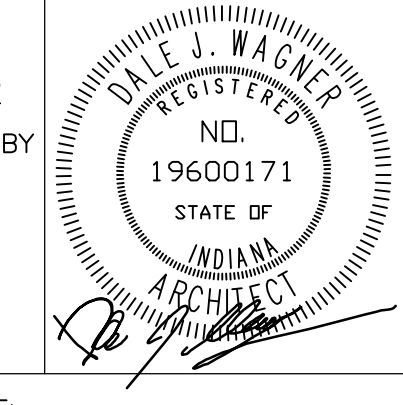

COPYRIGHT NOTICE:
THE CONCEPTS, DESIGNS, PLANS, DETAILS, ETC. SHOWN ON THIS DOCUMENT ARE THE PROPERTY OF GIBRALTAR DESIGN AND WERE CREATED FOR USE ON THIS SPECIFIC PROJECT. NONE OF THIS INFORMATION SHALL BE USED BY ANY PERSON OR FIRM FOR ANY PURPOSE WITHOUT THE EXPRESS WRITTEN CONSENT OF GIBRALTAR DESIGN. THE OWNER MAY RETAIN COPIES FOR INFORMATION AND REFERENCE IN CONNECTION ONLY WITH THIS PROJECT.

REVISIONS

MARK	DATE	ISSUED FOR
AD-1	06/16/22	ADDENDUM NO. 1

DRAWING
UNIT "J" ARCHITECTURAL FIRST FLOOR DEMOLITION PLAN

PROJECT
ADDITIONS AND RENOVATIONS TO
EDGEWOOD INTERMEDIATE SCHOOL

GIBRALTAR DESIGN SHEET
AD110


GENERAL DEMOLITION NOTES:

- FOR GENERAL PROJECT NOTES, MATERIAL INDICATIONS LEGEND, SYMBOL LEGEND, ABBREVIATIONS, ETC., REFER TO GI SERIES SHEETS.
- UNLESS NOTED OTHERWISE ON THIS SHEET, THE GENERAL CONTRACTOR IS RESPONSIBLE FOR ALL DEMOLITION AND REMOVAL WORK INDICATED ON THIS SHEET.
- CONTRACTORS ENCOUNTERING EXISTING MATERIAL WHICH IS SUSPECTED OF CONTAINING ASBESTOS SHALL STOP WORK IMMEDIATELY AND NOTIFY THE OWNER AND THE OWNER'S REPRESENTATIVE.
- BOLD DASHED LINES INDICATE EXISTING ITEMS TO BE REMOVED UNLESS OTHERWISE NOTED. THE CONTRACTOR SHALL BE RESPONSIBLE FOR FIELD VERIFYING THE EXTENT OF DEMOLITION WORK PRIOR TO BIDDING AND FOR COORDINATING THE EXTENT OF DEMOLITION WITH THE INSTALLATION OF NEW SYSTEMS.
- EACH CONTRACTOR SHALL BE RESPONSIBLE FOR ALL DEMOLITION APPLICABLE TO THEIR SCOPE OF WORK AND AS REQUIRED FOR INSTALLATION OF NEW WORK WHETHER OR NOT IT IS SPECIFICALLY INDICATED OR NOTED IN THESE DOCUMENTS.
- REMOVE ALL ITEMS AND FINISHES MADE OBSOLETE BY NEW CONSTRUCTION. VERIFY ITEMS DEEMED OBSOLETE WITH ARCHITECT PRIOR TO REMOVAL. REFER TO NEW CONSTRUCTION DRAWINGS FOR DEMOLITION REQUIRED NOT SHOWN ON DEMOLITION PLANS.
- EACH CONTRACTOR SHALL BE RESPONSIBLE FOR OFF SITE REMOVAL OF ALL DEMOLITION MATERIALS AND/OR ITEMS UNLESS NOTED OTHERWISE OR DIRECTED BY THE OWNER.
- PRIOR TO STARTING DEMOLITION, CONSTRUCT DUST CONTROL BARRIERS AS REQUIRED TO PREVENT THE SPREAD OF DUST INTO SURROUNDING AREAS (WHERE APPLICABLE).
- WHERE BUILDING EGRESS IS REQUIRED TO PASS THROUGH DEMOLITION AREAS, PROVIDE APPROVED BARRIERS, ETC. TO ENSURE SAFETY OF THE PUBLIC.
- RELOCATED ITEMS SHALL BE CLEANED AND PLACED IN STORAGE, PER OWNER'S DIRECTION, UNTIL ITEMS ARE READY TO BE INSTALLED. IF ITEMS ARE DAMAGED DURING DEMOLITION OR RELOCATION, THEY SHALL BE REPAIRED OR REPLACED WITH NEW ITEMS AS APPROVED.
- DEMOLITION SHALL BE PERFORMED WITHOUT DAMAGE TO EXISTING CONSTRUCTION TO REMAIN. WHERE SUCH DAMAGE OCCURS, PATCH, REPAIR, OR RESTORE WALLS, FLOORS, CEILING, ETC. NEATLY TO MATCH EXISTING ADJACENT SURFACE. PROVIDE SHORING, BRACING, OR SUPPORT AS REQUIRED TO PREVENT MOVEMENT OR SETTLEMENT OF EXISTING STRUCTURES.
- EACH CONTRACTOR IS RESPONSIBLE FOR CUTTING, PATCHING, AND DISCONNECTING UTILITIES TO THEIR SCOPE OF WORK. WHERE EXISTING SERVICES ARE ABANDONED, CAP AT LEAST 1" BEHIND NEW FINISHES AND/OR EXISTING SURFACE AND PATCH AS REQUIRED TO RECEIVE NEW FINISHES OR MATCH EXISTING FINISH.
- ON WALLS THAT ARE TO RECEIVE NEW FINISHES, REMOVE AND REINSTALL EXISTING EQUIPMENT TO REMAIN AS REQUIRED FOR INSTALLATION OF NEW FINISHES.
- WHERE WALLS OR BULKHEADS ARE REMOVED, PATCH FLOORS, CEILINGS, AND ADJACENT WALLS AS REQUIRED TO MATCH EXISTING OR RECEIVE NEW FINISHES WHERE APPLICABLE. WHERE EXISTING DUCTWORK, PIPING, OR EQUIPMENT IS REMOVED, PATCH OPENINGS AND/OR SURFACES AS REQUIRED TO MATCH ADJACENT SURFACES OR RECEIVE NEW FINISHES WHERE APPLICABLE. REFER TO ALL DEMOLITION DRAWINGS FOR EXTENT OF ITEMS TO BE REMOVED.
- OVER CUT NEW OPENINGS IN EXISTING WALL AS REQUIRED FOR NEW CONSTRUCTION. PATCH AND REPAIR WALLS AS REQUIRED TO MATCH EXISTING. WHERE APPLICABLE, TOOTH NEW MASONRY INTO EXISTING MASONRY.
- ALL EQUIPMENT AND FURNITURE WHICH ARE CONSIDERED LOOSE FURNISHING SHALL BE REMOVED BY THE OWNER PRIOR TO DEMOLITION.
- MASONRY WALLS TO BE REMOVED SHALL BE REMOVED TO A POINT 2" MINIMUM BELOW THE EXISTING FLOOR SLAB UNLESS SETTING ON A SLAB OR SPECIFICALLY NOTED OTHERWISE. PATCH WITH NEW CONCRETE TO BE FLUSH WITH THE EXISTING FLOOR SLAB.
- EACH CONTRACTOR SHALL BE RESPONSIBLE FOR GENERAL REVIEW OF DEMOLITION NOTES AND GENERAL DEMOLITION NOTES AS THEY APPLY TO THEIR SCOPE OF WORK.
- THE OWNER SHALL RESERVE THE RIGHT TO CLAIM ANY MATERIALS THAT ARE BEING DEMOLISHED PRIOR TO THE CONTRACTOR DISPOSING OF THEM OFF SITE.
- REFER TO THE STRUCTURAL, MECHANICAL, PLUMBING, ELECTRICAL AND TECHNOLOGY DOCUMENTS FOR COMPLETE SCOPE OF DEMOLITION WORK.
- "FLOORING" DENOTES FLOOR COVERING MATERIALS INCLUDING BACKING, ADHESIVES, AND BASES DOWN TO BUT EXCLUSIVE OF FLOOR SLABS AND STRUCTURAL MATERIALS UNLESS NOTED OTHERWISE.
- DEMOLITION IS TO FOLLOW ESTABLISHED CONSTRUCTION SEQUENCE. REFER TO SPECIFICATIONS AND DRAWINGS FOR REQUIREMENTS AND SPECIAL CONDITIONS.
- WHERE APPLICABLE SALVAGE EXISTING MASONRY (FACE BRICK, GLAZED CMU, FACING TILE) AS REQUIRED FOR PATCHING AND INFILL IN RENOVATED AREAS WHERE INDICATED. DISCARD UNUSED PORTION OFF SITE.

DEMOLITION PLAN NOTES:


- (ALL PLAN NOTES MAY NOT BE INDICATED ON THIS SHEET.)
- REMOVE SHELVING IN ITS ENTIRETY.
 - REMOVE ACOUSTICAL BOARD CEILING SYSTEM IN ITS ENTIRETY.
 - REMOVE VINYL BASE IN ITS ENTIRETY.
 - REMOVE CASEWORK IN ITS ENTIRETY.
 - REMOVE METAL STUD AND GYPSUM BOARD WALL IN ITS ENTIRETY. PATCH AND REPAIR ADJACENT WALL AND FLOOR AS REQUIRED TO ACCEPT NEW FINISHES.
 - REMOVE MASONRY WALL CONSTRUCTION AND ATTACHED FINISHES IN ITS ENTIRETY. PATCH/REPAIR ADJACENT FLOOR AND WALL SURFACES AS REQUIRED TO ACCEPT NEW FINISHES.
 - REMOVE METAL STUD AND GYPSUM BOARD BULKHEAD IN ITS ENTIRETY. PATCH AND REPAIR WALL AS REQUIRED FOR NEW FINISHES.
 - EXISTING STEEL COLUMN TO REMAIN.
 - REMOVE EXISTING SLAB AS REQUIRED FOR NEW CONSTRUCTION.
 - REMOVE ENTIRE PORTION OF BUILDING IN THIS AREA INCLUDING MASONRY WALLS, STEEL FRAMING, CONCRETE SLAB ON GRADE, ROOFING, CONCRETE FOOTINGS, AND FOUNDATION WALLS AS REQUIRED FOR NEW CONSTRUCTION. COORDINATE WITH STRUCTURAL.
 - REMOVE VOID SLAB/STOOP AS REQUIRED FOR NEW CONSTRUCTION. COORDINATE WITH CIVIL.
 - REMOVE BRICK CLADDING BACK TO CMU WALL OR STEEL COLUMN (TO REMAIN) WHERE INDICATED.
 - REMOVE WINDOW SYSTEM IN ITS ENTIRETY.
 - REMOVE ALUMINUM STOREFRONT FRAMING, DOORS, AND HARDWARE IN ITS ENTIRETY.
 - REMOVE EXISTING EIFS FASCIA AND SOFFIT ABOVE. STRUCTURAL FRAMING TO REMAIN.
 - REMOVE EXISTING DOOR NUMBER IN ITS ENTIRETY.
 - REMOVE EXISTING PROJECTION SCREEN AND TURN OVER TO OWNER.
 - REMOVE TACK BOARD OR CHALKBOARD IN THEIR ENTIRETY. PATCH WALL AS REQUIRED TO RECEIVE NEW FINISHES.
 - REMOVE WOOD DOOR, FRAME AND HARDWARE IN ITS ENTIRETY.
 - REMOVE ALL OR PART OF STEEL COLUMN AS NEEDED TO ACCOMMODATE THE PROPOSED PLAN. COORDINATE WITH STRUCTURAL DRAWINGS.
 - REMOVE METAL DOOR, FRAME AND HARDWARE IN ITS ENTIRETY.
 - REMOVE EXISTING HANDRAIL AND CUT SLAB EDGE AS REQUIRED FOR NEW CONSTRUCTION. SEE SECTION.
 - CUT OPENING IN EXISTING CMU AS REQUIRED FOR INSTALLATION OF NEW DOOR AND LINTEL.
 - REMOVE EXISTING CMU WALL CONSTRUCTION FROM FLOOR TO ROOF DECK.
 - REMOVE EXISTING FLOOR FINISH MATERIAL, INCLUDING BASE, AND PREPARE FOR NEW FINISHES.
 - REMOVE EXISTING HIGH DENSITY SHELVING FOR REINSTALLATION.
 - REMOVE EXISTING CURB AT DOOR OPENING TO 8" BELOW GUTTER LINE.
 - EXISTING BOLLARDS TO REMAIN.
 - REMOVE PLUMBING FIXTURE. REMAINING PLUMBING LINES TO BE REUSED OR CAPPED AS NEEDED. COORDINATE WITH PLUMBING DRAWINGS.
 - REMOVE TOILET STALL PARTITION ENCLOSURE IN ITS ENTIRETY. PATCH/REPAIR ADJACENT FLOOR AND WALL SURFACES AS REQUIRED TO ACCEPT NEW FINISHES. SALVAGE ATTACHED ACCESSORIES FOR FUTURE USE. COORDINATE WITH OWNER.
 - REMOVE EXISTING FABRIC WALL COVERING AND PREPARE WALLS FOR NEW FINISHES.
 - REMOVE CABINET HEATER. COORDINATE WITH MECHANICAL TRADES.
 - REMOVE EXISTING DIVIDER RAIL AND PREPARE FOR NEW FINISHES.
 - REMOVE TOILET ACCESSORIES AND TURN OVER TO OWNER.

- REMOVE EXISTING MASONRY WALL CONSTRUCTION IN ITS ENTIRETY.
- REMOVE CERAMIC/PORCELAIN TILE FLOORING SYSTEM, INCLUDING BASE.
- REMOVE EXISTING CEILING AS REQUIRED TO ACCOMMODATE PLUMBING AND HVAC MODIFICATIONS. REPLACE TO ORIGINAL CONFIGURATION AFTER PLUMBING AND HVAC WORK IS COMPLETED. REPLACE ANY DAMAGED TILES WITH LIKE KIND AND REPAIR ANY DAMAGES TO EXISTING WALL FINISHES TO MATCH EXISTING. COORDINATE WITH MEP DRAWINGS.
- REMOVE EXISTING WALL-MOUNTED EQUIPMENT, INCLUDING ADA PUSH BUTTON, KNOX BOX, ETC., AND SALVAGE FOR FUTURE USE.
- SAW OUT EXISTING FLOOR SLAB WHERE INDICATED TO ACCOMMODATE NEW UNDER-SLAB PLUMBING LINES. COORDINATE LOCATIONS, EXTENTS, AND PATCHING WITH PLUMBING DRAWINGS.
- REMOVE EXISTING FLOOR FINISH MATERIAL AND PREPARE FOR NEW FINISHES - ALTERNATE.

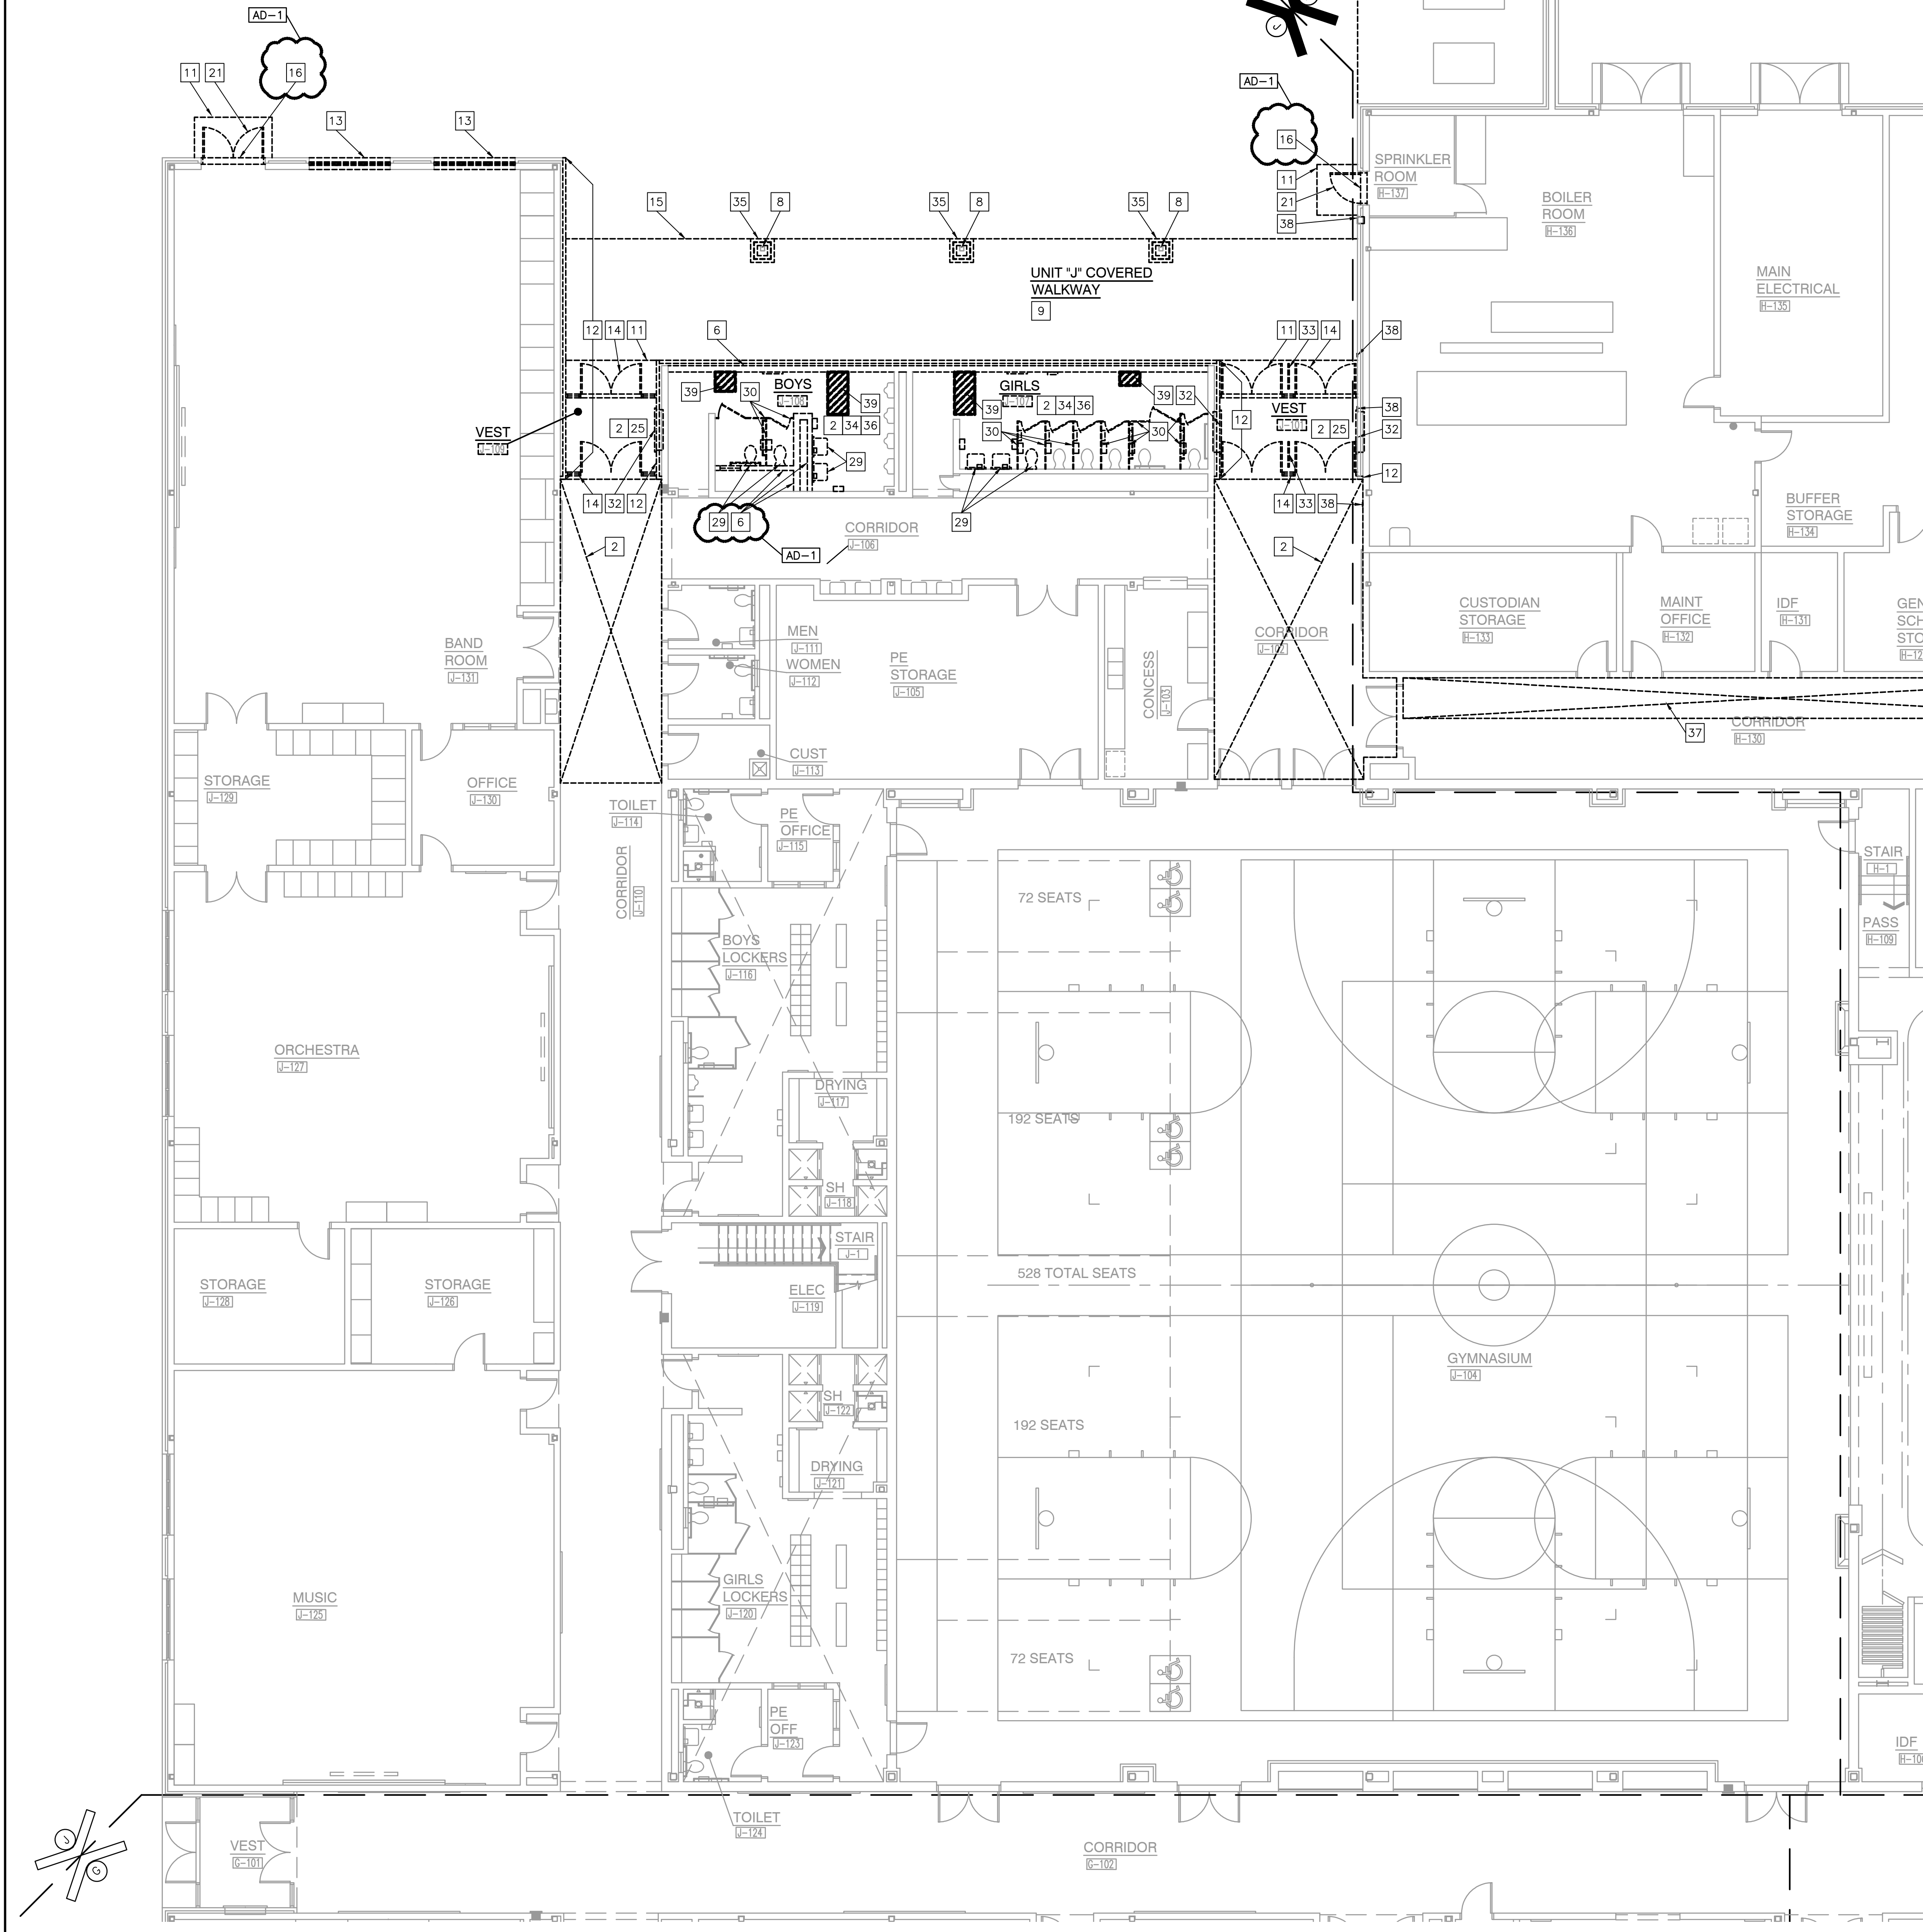


UNIT "J" ARCHITECTURAL FIRST FLOOR DEMOLITION PLAN

SCALE: 1/8" = 1'-0"

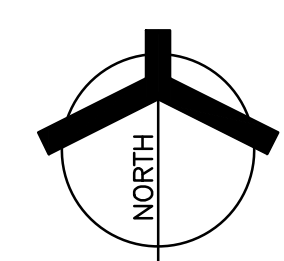


Thursday, 6/16/2022 - 3:58 PM - LAST SAVED BY: JHARRIS
Y:\21-155 FRANKLIN TOWNSHIP CSC-EDGEWOOD IS
ADDITIONS AND RENOVATIONS 21-155 DRAWINGS\05
ARCH\01\CLDING

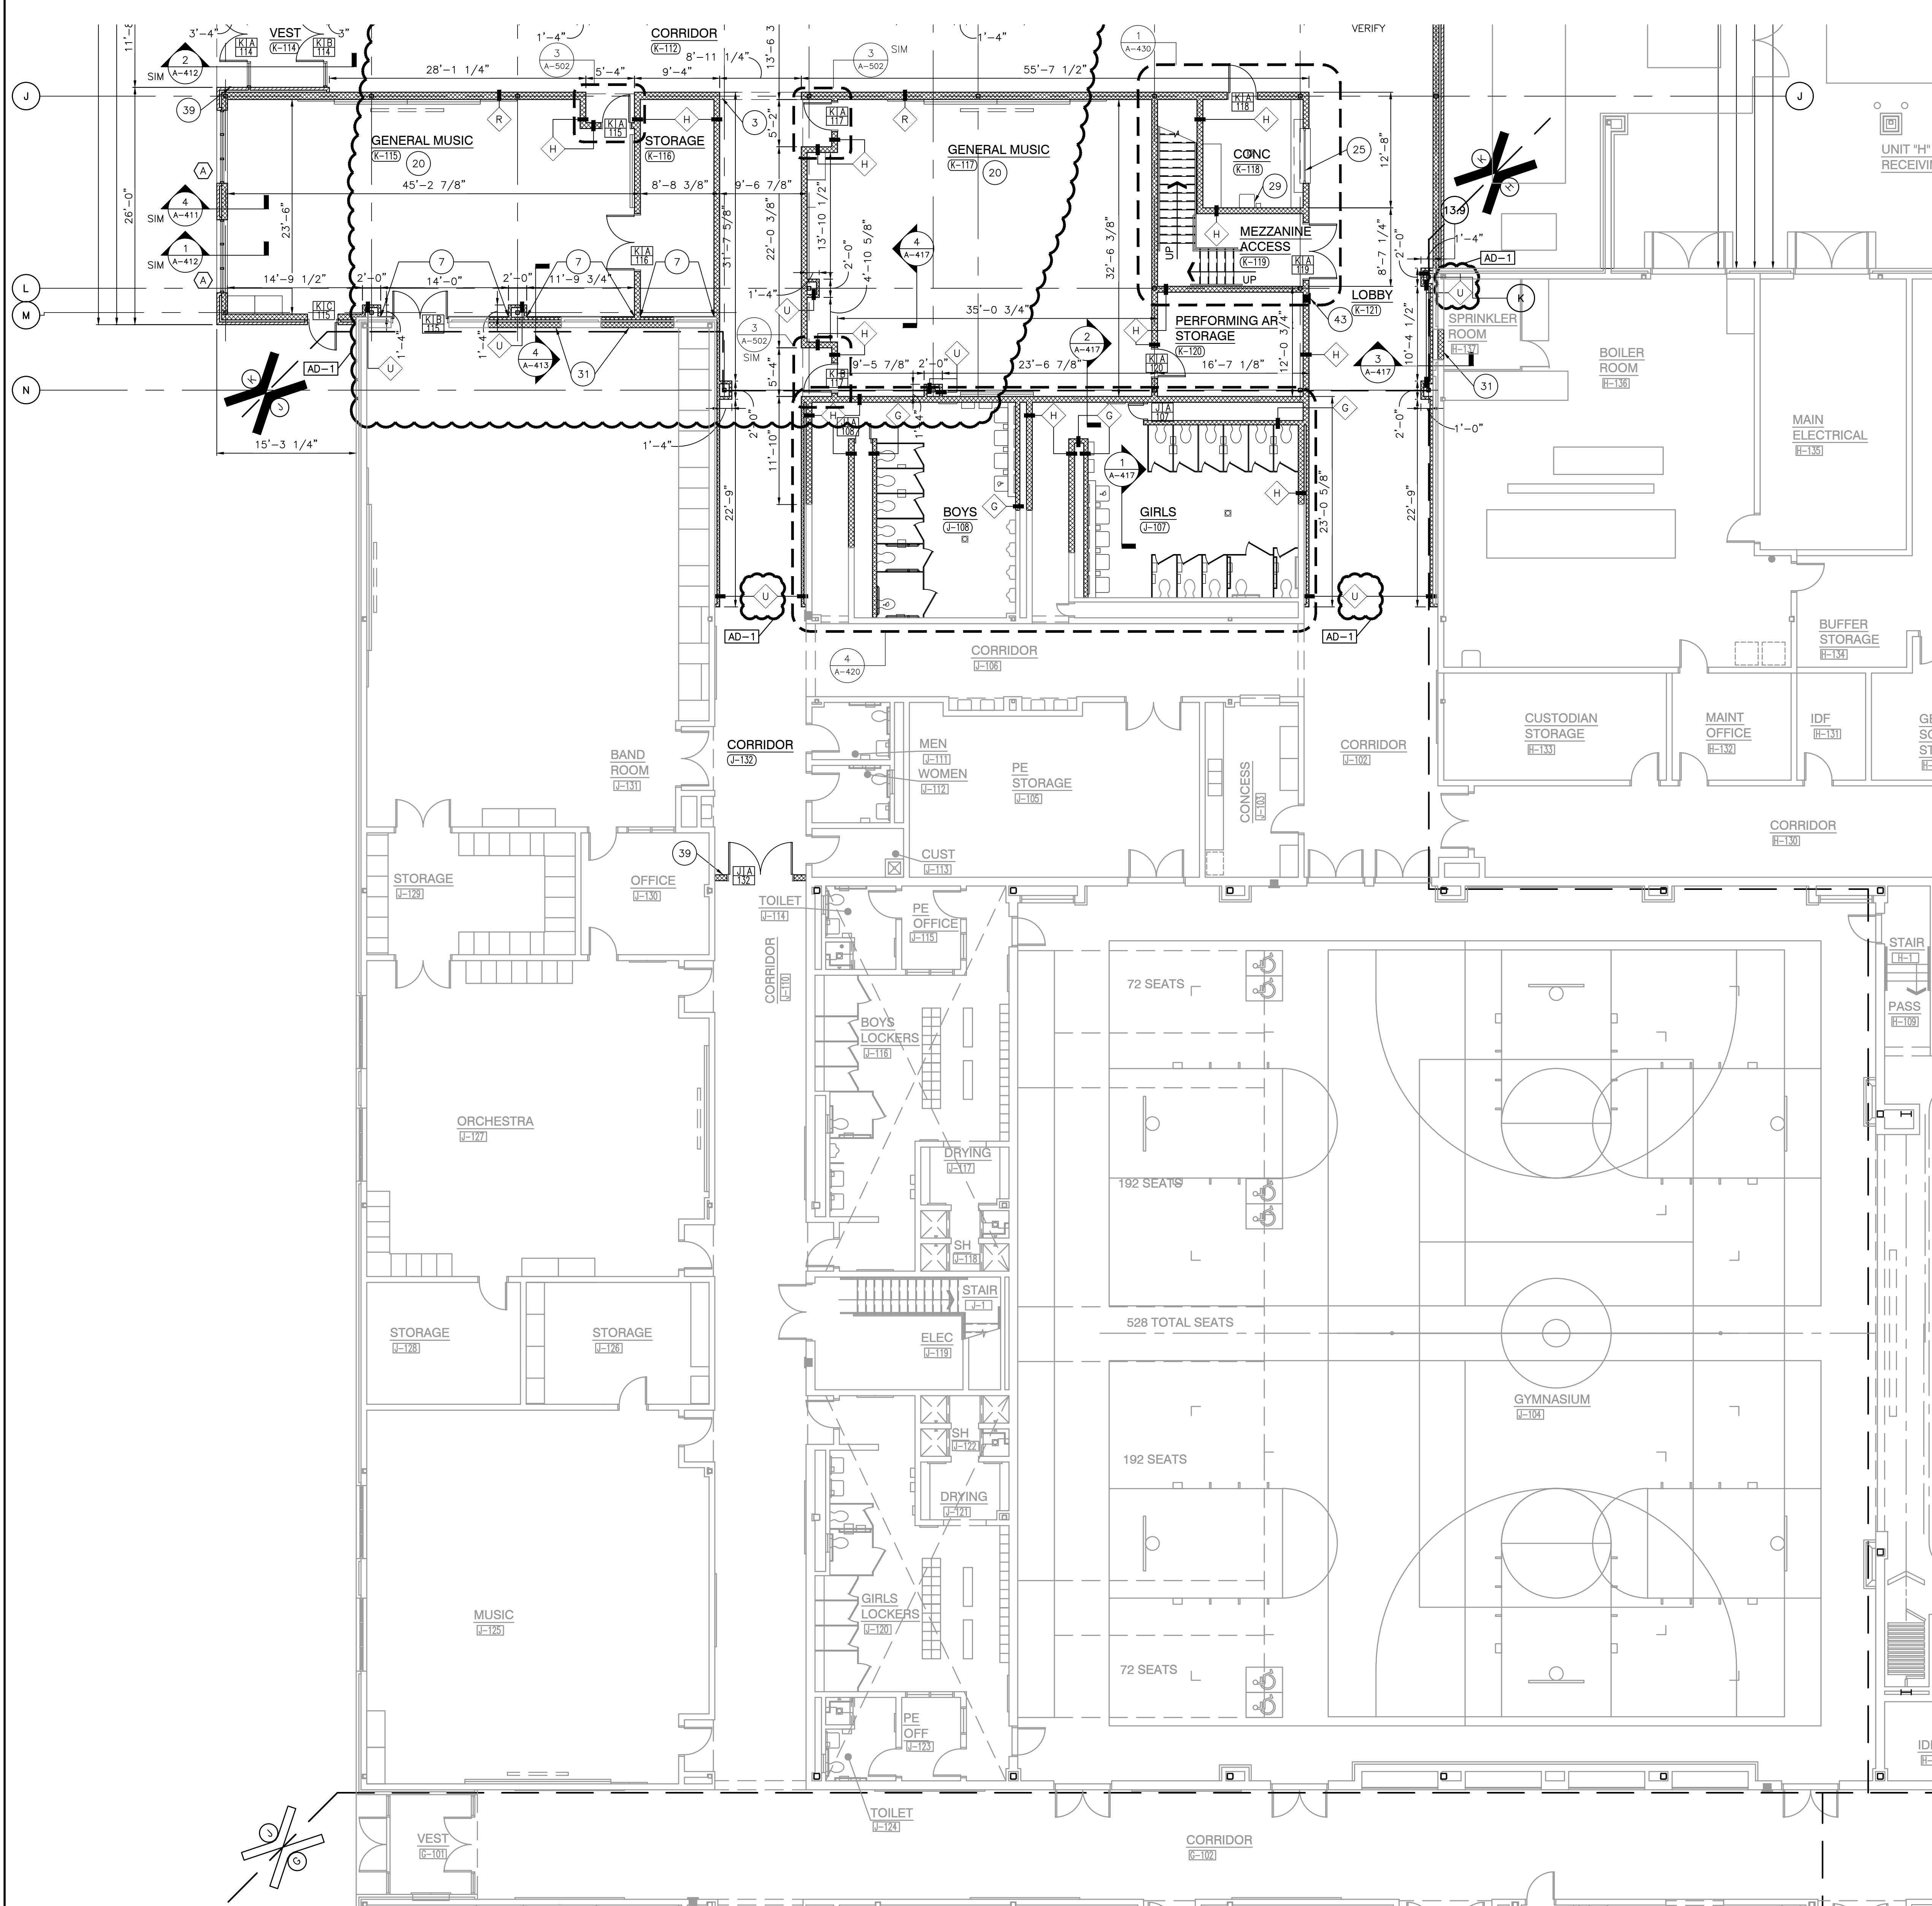

UNIT "J" ARCHITECTURAL FIRST FLOOR PLAN

SCALE: 1/8" = 1'-0"

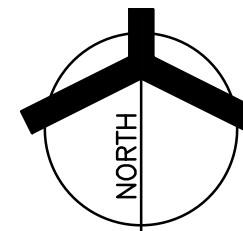

GENERAL PLAN NOTES:

- A. FOR GENERAL PROJECT NOTES, MATERIAL INDICATIONS LEGEND, SYMBOL LEGEND, ABBREVIATIONS, ETC., REFER TO GI SERIES SHEETS.
- B. PLAN DIMENSIONS TO MASONRY WALLS ARE TO FACE OF ROUGH MASONRY. PLAN DIMENSIONS TO STUD WALLS ARE TO FACE OF FINISHED GYPSUM BOARD OR PLASTER. PLAN DIMENSIONS TO STUD WALLS WITH CERAMIC TILE FINISH ARE TO THE FACE OF TILE BACKER BOARD.
- C. ALL CMU WALLS THAT DO NOT LAY OUT IN FULL OR HALF LENGTHS SHOULD BE BALANCED SO AS NOT TO HAVE ANY PIECES LESS THAN 4" IN SIZE EXPOSED TO VIEW.
- D. MASONRY WALLS BEARING ON A THICKENED SLAB AT SLAB DEPRESSIONS REQUIRE CUT MASONRY UNITS SO THAT COURSING BEGINS AT THE FLOOR LINE.
- E. THE BASE FIRST FLOOR ELEVATION INDICATED FOR THE PROJECT IS 100'-0". REFER TO SITE PLAN FOR CORRELATION TO USGS DATUM.
- F. HINGE SIDE OF DOOR JAMB AT CMU WALLS SHALL BE LOCATED 8" MINIMUM FROM ADJACENT WALL AND HINGE SIDE OF DOOR JAMB AT GYPSUM BOARD WALLS SHALL BE LOCATED 4" MINIMUM FROM ADJACENT WALL UNLESS NOTED OTHERWISE.
- G. PROVIDE WOOD BLOCKING (OR METAL STRAPPING WHERE APPLICABLE) AS REQUIRED WITHIN METAL STUD WALLS FOR WALL MOUNTED ITEMS.
- H. REFER TO LIFE SAFETY PLANS REGARDING FIRE RATED WALL LOCATIONS AND OTHER CODE INFORMATION.
- I. INTERIOR CMU WALLS ARE TO BE RUNNING BOND UNLESS NOTED OTHERWISE.
- J. WHERE NEW CMU WALLS INTERSECT EXISTING CMU WALLS AT A CORNER OR ARE ALIGNED WITH EXISTING CMU WALLS, TOOTH NEW CMU INTO EXISTING CMU UNLESS NOTED OTHERWISE.
- K. REFER TO FINISH PLANS FOR LOCATION AND EXTENT OF FINISHED FLOOR AND WALL MATERIAL.
- L. ALL EXPOSED CONCRETE MASONRY UNITS (CMU) CORNERS ARE TO BE BULLNOSED, EXCEPT AT MASONRY BULKHEADS AND EXTERIOR WINDOW JAMBS.
- M. REFER TO DEMOLITION SHEETS FOR ADDITIONAL PATCHING AND REPAIR WORK.

PLAN LEGEND:

- ⊕ INDICATES MISCELLANEOUS CASEWORK ELEVATION SYMBOL - REFER TO A-800 SERIES DRAWINGS FOR ELEVATIONS AND DETAILS.
- ⊖ INDICATES STOREFRONT, CURTAIN WALL, OR WINDOW SYSTEM. REFER TO A-800 SERIES DRAWINGS FOR ELEVATIONS AND DETAILS.
- ◇ INDICATES WALL TYPES REFER TO G-201 FOR WALL THICKNESS, HEIGHT, AND COMPOSITION.
- X-X INDICATES CEILING/BULKHEAD HEIGHT ABOVE FINISHED FLOOR

PLAN NOTES:


(ALL PLAN NOTES MAY NOT BE INDICATED ON THIS SHEET.)

- 1 DISPLAY CASE.
- 2 CMU WALL. REFER TO WALL TYPES FOR ASSEMBLY DETAILS AND FINISH SCHEDULE FOR FINISH INFORMATION.
- 3 GYPSUM BOARD BULKHEAD. SEE REFLECTED CEILING PLANS.
- 4 PORCELAIN TILE TO MATCH EXISTING IN ROOM H-115.
- 5 PATCH AND REPAIR EXISTING CMU (USING BULLNOSE BLOCK) AS REQUIRED TO MATCH EXISTING FINISHES.
- 6 PROVIDE 6" HIGH PORCELAIN BASE.
- 7 PROVIDE SINGLE LAYER OF 5/8" GYPSUM BOARD, ADHERED TO MASONRY WALL CONSTRUCTION.
- 8 INTERIOR DIVIDER RAIL.
- 9 PROVIDE METAL WIRE TIES IN CMU WALL TO EXISTING BRICK AND PROVIDE 1/2" BACKER ROD AND SEALANT IN BREAK FACE VERTICALLY FROM GRADE TO CEILING ABOVE.
- 10 EXTERIOR DIVIDER RAIL.
- 11 THIS ROOM TO RECEIVE NEW VCT TILE FLOOR, VINYL BASE, EPOXY PAINT ON WALLS AND VINYL FACED 2' X 2' CEILING TILE IN GRID SUSPENDED AT 3'-0" A.F.F.
- 12 REMOVE EQUIPMENT MOUNTED ON WALLS AS REQUIRED FOR WALL DEMOLITION AND REPLACE IN SAME LOCATION AFTER NEW FINISHES HAVE BEEN DONE.
- 13 CLEAN EXISTING RAILING AS REQUIRED TO RECEIVE NEW PAINT. PAINT TO MATCH NEW RAILING.
- 14 BUILD NEW FACE BRICK (CUT TO SLOPE) ON EXISTING RAMP.
- 15 POUR NEW CONCRETE SLAB SAME THICKNESS AS EXISTING OVER GRANULAR FILL TO ORIGINAL ELEVATIONS.
- 16 LOUVER. SEE MECHANICAL.
- 17 SLOPE CONCRETE SLAB DOWN TO EXISTING PAVEMENT ELEVATION ON BOTH SIDES OF NEW DOOR.
- 18 MODIFY EXISTING HI-DENSITY DRY STORAGE SHELVING AS REQUIRED FOR NEW WALL LOCATION.
- 19 PUSH PLATE/BUTTON OPERATOR TO ACTIVATE DOOR.
- 20 CASEWORK, MILLWORK, MARKER/TACK BOARDS AND EQUIPMENT. REFER TO 700 SERIES DRAWINGS.
- 21 TYPE "A" METAL LOCKERS.
- 22 COLUMN WITH BRICK CLADDING TO MATCH EXIST. CONDITIONS. SEE ELEVATIONS. REFER TO STRUCTURAL DRAWINGS FOR COLUMN INFORMATION.
- 23 ENTRY CANOPY/OVERHANG ABOVE. REFER TO ELEVATIONS AND SECTIONS FOR ADDITIONAL INFORMATION.
- 24 POWER OPERATED ROLLING DOOR.
- 25 CONCESSIONS COUNTER WITH ROLLING DOOR.
- 26 MOP SINK. SEE PLUMBING.
- 27 RAISED CONCRETE EQUIPMENT PAD. SEE MECHANICAL DRAWINGS.
- 28 POWER OPERATED FOLDING BLEACHERS.
- 29 WALL-MOUNTED SINK. SEE PLUMBING DRAWINGS.
- 30 SUSPENDED AND RETRACTABLE BASKETBALL GOAL.
- 31 INFILLED CMU WALL CONSTRUCTION TO BE FLUSH WITH EXISTING/ADJACENT WALL SYSTEM.
- 32 4" HIGH CONCRETE CURB.
- 33 ALUMINUM LADDER.
- 34 WALL-MOUNTED FIRE EXTINGUISHER. VERIFY LOCATION WITH OWNER.
- 35 AREA OF NEW CONCRETE SIDEWALK. COORDINATE WITH CIVIL.
- 36 INSTALL 8" PVC COATED CHAIN LINK FENCE ENCLOSURE. COORDINATE WITH CIVIL.
- 37 PROVIDE WALL FURRING WITH METAL STUD FRAMING @ 16" O.C. WHERE INDICATED.
- 38 NEW SOLID SURFACE WINDOW STOOL. SEE FINISH LEGEND.
- 39 CARD READER. COORDINATE WITH ELECTRICAL AND TECHNOLOGY DRAWINGS.
- 40 LOCKABLE CONTROL CABINET RECESSED IN WALL ASSEMBLY. COORDINATE WITH ELECTRICAL AND TECHNOLOGY DRAWINGS.
- 41 SAFETY CUSHION WAINSCOT.
- 42 OPENING IN WALL ASSEMBLY FOR DUCTWORK. SEE MECHANICAL.
- 43 SEMI-RECESSED FIRE EXTINGUISHER CABINET.
- 44 WOOD FLOOR INSERT.
- 45 MOTORIZED PROJECTION SCREEN. COORDINATE WITH ELECTRICAL AND TECHNOLOGY DRAWINGS.
- 46 RELOCATED KNOX BOX.
- 47 ALTERNATE - DIVIDER CURTAIN.
- 48 CMU BULKHEAD. SEE STRUCTURAL AND COORDINATE WITH REFLECTED CEILING PLANS.



GIBRALTAR DESIGN
ARCHITECTURE • ENGINEERING • INTERIOR DESIGN

PROJECT
ADDITIONS AND RENOVATIONS TO
EDGEWOOD INTERMEDIATE SCHOOL
FRANKLIN TOWNSHIP COMMUNITY SCHOOL CORPORATION
INDIANAPOLIS, INDIANA

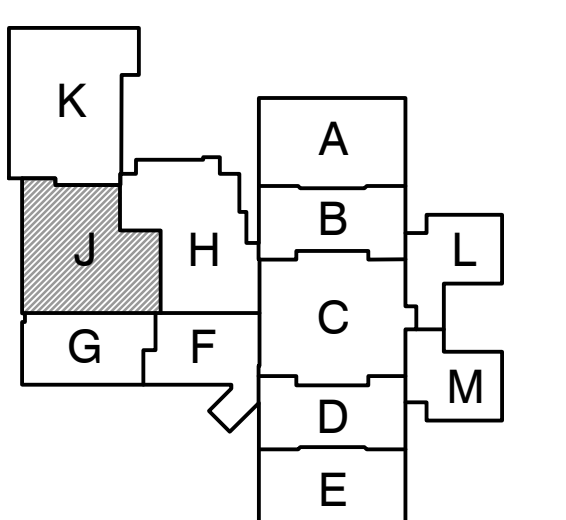

FIRST FLOOR KEY PLAN

GIBRALTAR DESIGN
9102 N. Meridian St., Ste. 300
Indianapolis, IN 46260
Homepage: www.GibraltarDesign.com
Email: info@GibraltarDesign.com
Phone: 317.580.5777 Fax: 317.580.5778

PROJECT: 21-155
DATE: 05/23/22
COORDINATED BY: DJW
DRAWN BY: JRH
CHECKED BY: DJW

COPYRIGHT NOTICE:
THE CONCEPTS, DESIGNS, PLANS, DETAILS, ETC. SHOWN ON THIS DOCUMENT ARE THE PROPERTY OF GIBRALTAR DESIGN AND ARE CREATED FOR USE ON THIS SPECIFIC PROJECT. NONE OF THIS INFORMATION SHALL BE USED BY ANY PERSON OR FIRM FOR ANY PURPOSE WITHOUT THE EXPRESS WRITTEN CONSENT OF GIBRALTAR DESIGN. THE OWNER MAY RETAIN COPIES FOR INFORMATION AND REFERENCE IN CONNECTION ONLY WITH THIS PROJECT.

REVISIONS	MARK	DATE	ISSUED FOR
AD-1	06/16/22	ADDENDUM NO. 1	

MARK	DATE	ISSUED FOR
AD-1	06/16/22	ADDENDUM NO. 1


DRAWING
UNIT "J" ARCHITECTURAL
FIRST FLOOR PLAN

PROJECT
ADDITIONS AND RENOVATIONS TO
EDGEWOOD INTERMEDIATE SCHOOL

GIBRALTAR DESIGN SHEET
A-110


Wednesday, 6/15/2022 - 5:36 PM - LAST SAVED BY: HARRIS
 Y:\21-155 FRANKLIN TOWNSHIP CSC-EDGEWOOD IS
 ADDITIONS AND RENOVATIONS\21-155 DRAWINGS\05
 ARCH\A-110.DWG

Wednesday, 6/15/2022, 5:26 PM - LAST SAVED BY: JHARRIS
 Y:\21-155 FRANKLIN TOWNSHIP CSC-EDGEWOOD IS
 ADDITIONS AND RENOVATIONS\21-155 DRAWINGS\05
 ARCH\A-111.DWG

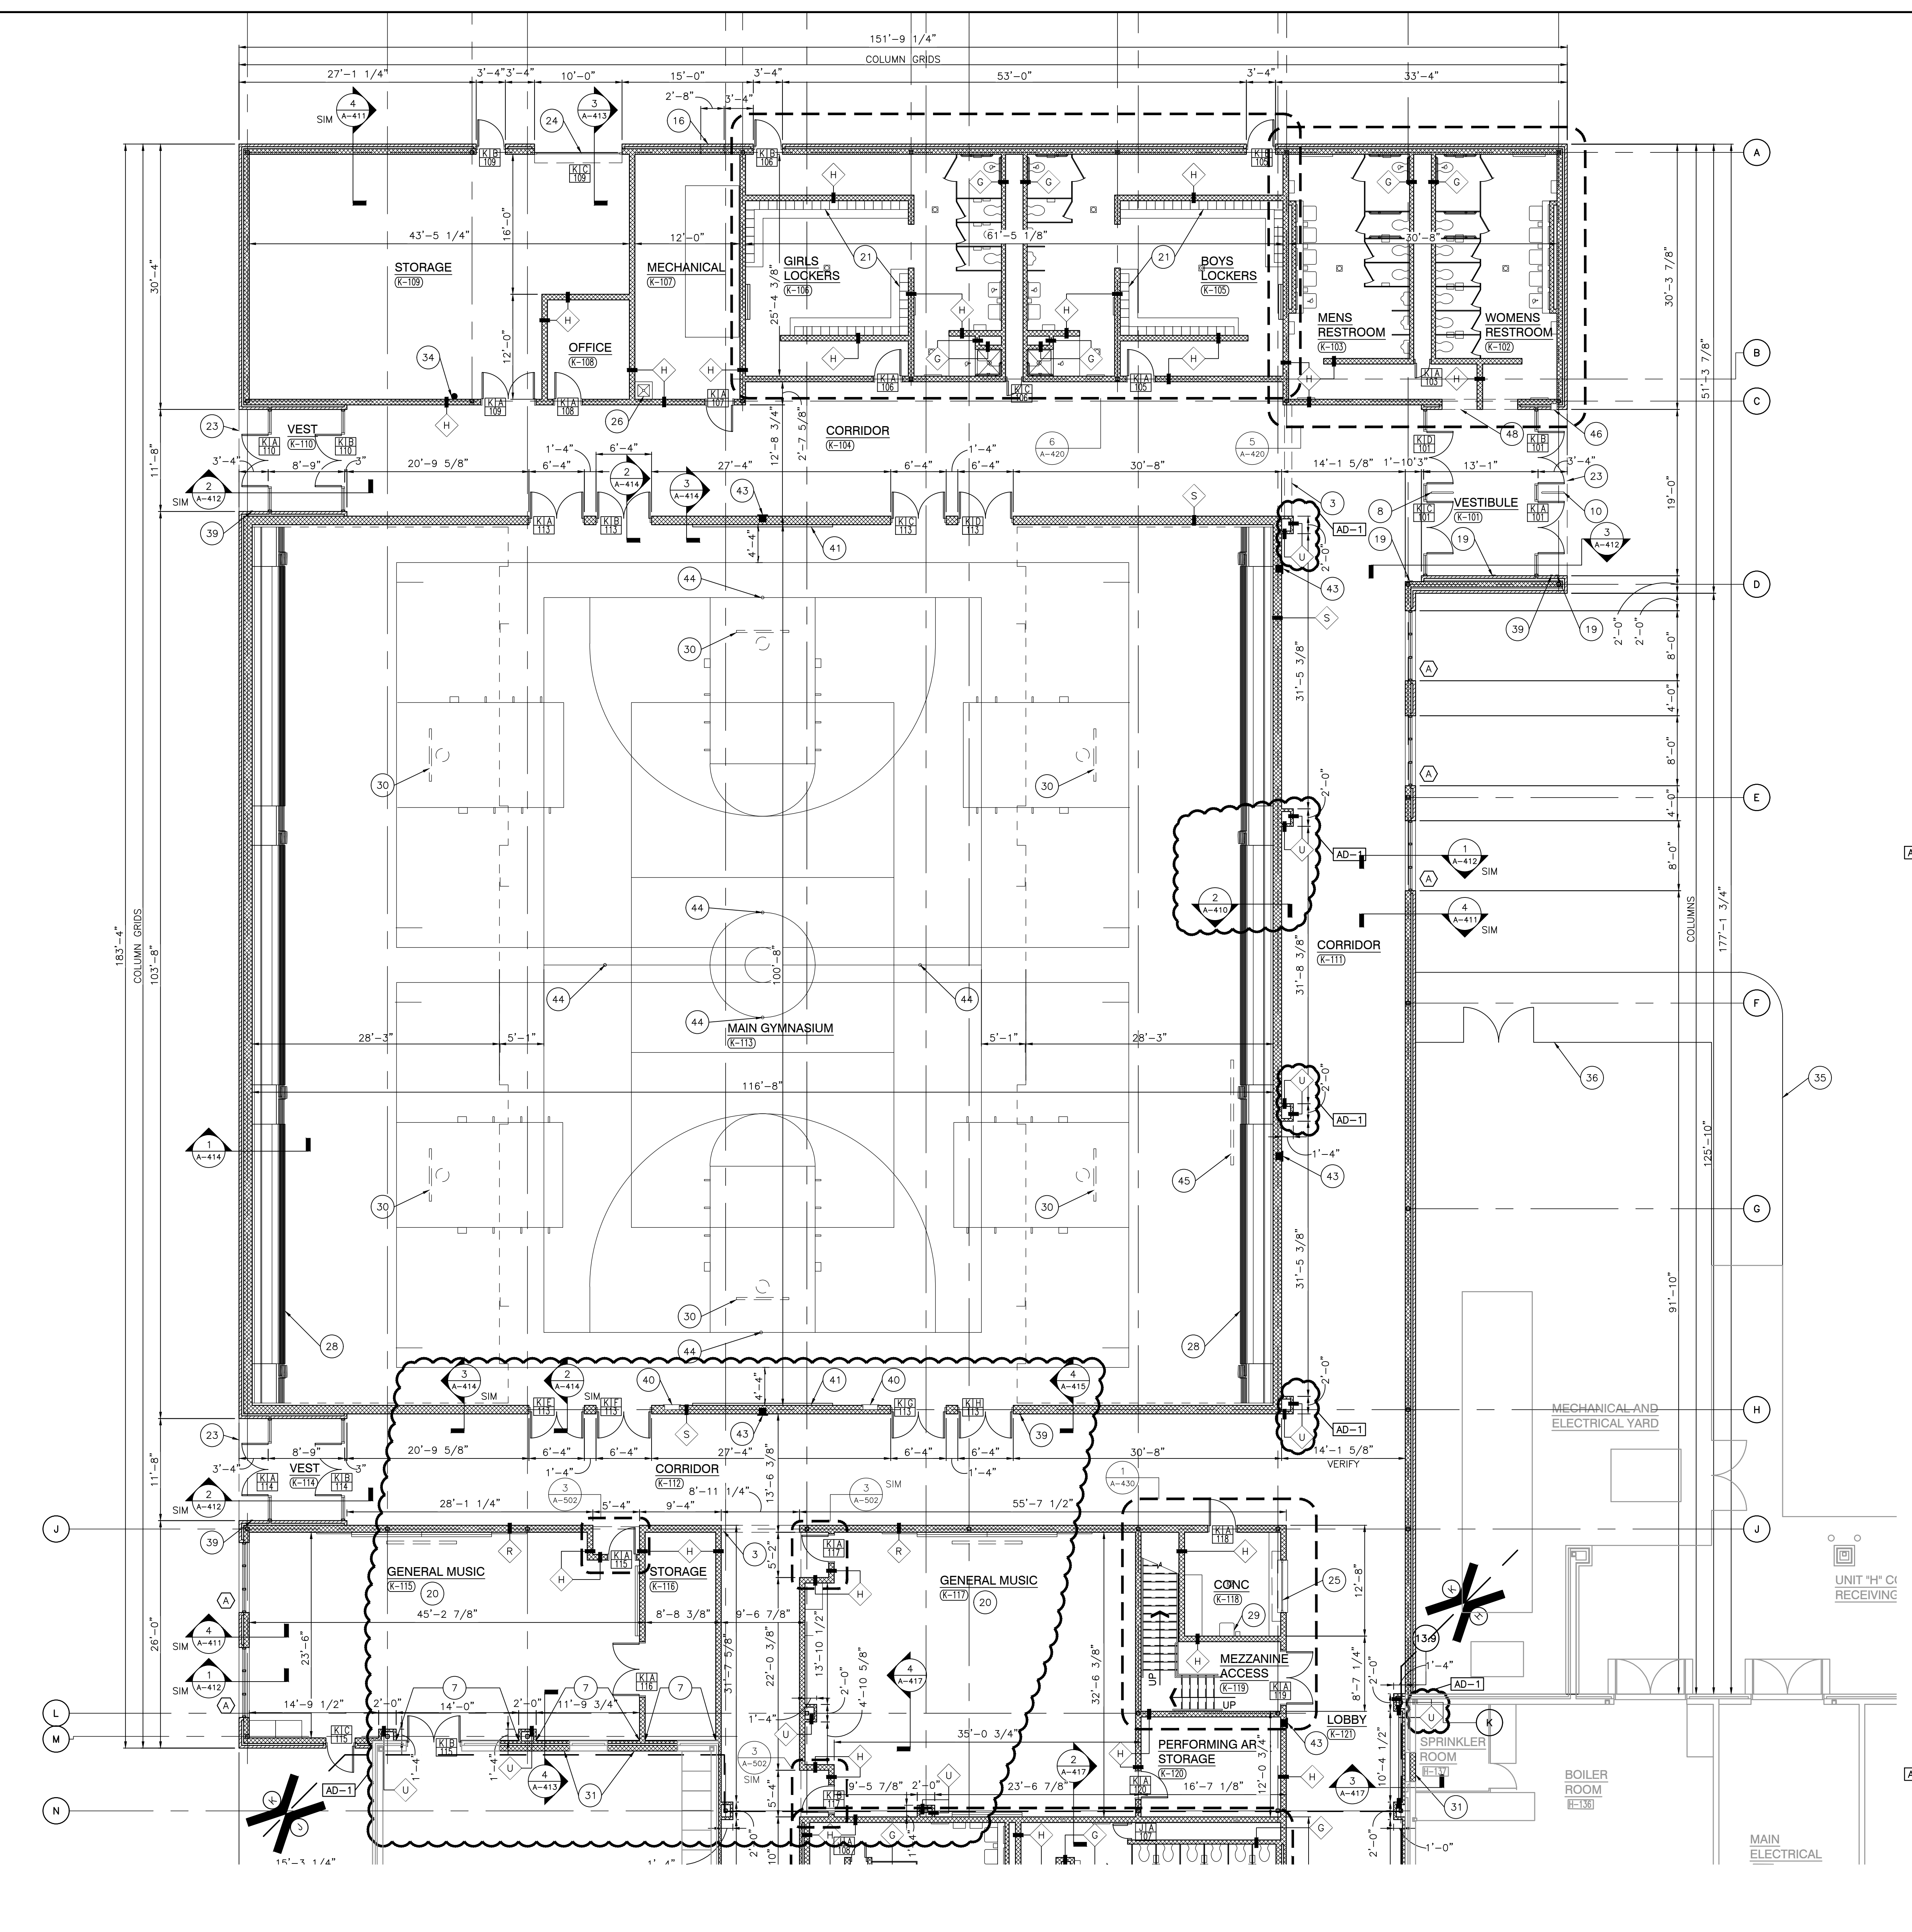

UNIT "K" ARCHITECTURAL FIRST FLOOR PLAN

SCALE: 1/8" = 1'-0"

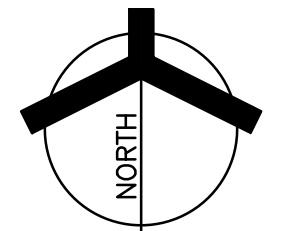

GENERAL PLAN NOTES:

- A. FOR GENERAL PROJECT NOTES, MATERIAL INDICATIONS LEGEND, SYMBOL LEGEND, ABBREVIATIONS, ETC., REFER TO GI SERIES SHEETS.
- B. PLAN DIMENSIONS TO MASONRY WALLS ARE TO FACE OF ROUGH MASONRY. PLAN DIMENSIONS TO STUD WALLS ARE TO FACE OF FINISHED GYPSUM BOARD OR PLASTER. PLAN DIMENSIONS TO STUD WALLS WITH CERAMIC TILE FINISH ARE TO THE FACE OF TILE BACKER BOARD.
- C. ALL CMU WALLS THAT DO NOT LAY OUT IN FULL OR HALF LENGTHS SHOULD BE BALANCED SO AS NOT TO HAVE ANY PIECES LESS THAN 4" IN SIZE EXPOSED TO VIEW.
- D. MASONRY WALLS BEARING ON A THICKENED SLAB AT SLAB DEPRESSIONS REQUIRE CUT MASONRY UNITS SO THAT COURSING BEGINS AT THE FLOOR LINE.
- E. THE BASE FIRST FLOOR ELEVATION INDICATED FOR THE PROJECT IS 100'-0". REFER TO SITE PLAN FOR CORRELATION TO USGS DATUM.
- F. HINGE SIDE OF DOOR JAMB AT CMU WALLS SHALL BE LOCATED 8" MINIMUM FROM ADJACENT WALL AND HINGE SIDE OF DOOR JAMB AT GYPSUM BOARD WALLS SHALL BE LOCATED 4" MINIMUM FROM ADJACENT WALL UNLESS NOTED OTHERWISE.
- G. PROVIDE WOOD BLOCKING (OR METAL STRAPPING WHERE APPLICABLE) AS REQUIRED WITHIN METAL STUD WALLS FOR WALL MOUNTED ITEMS.
- H. REFER TO LIFE SAFETY PLANS REGARDING FIRE RATED WALL LOCATIONS AND OTHER CODE INFORMATION.
- I. INTERIOR CMU WALLS ARE TO BE RUNNING BOND UNLESS NOTED OTHERWISE.
- J. WHERE NEW CMU WALLS INTERSECT EXISTING CMU WALLS AT A CORNER OR ARE ALIGNED WITH EXISTING CMU WALLS, TOOTH NEW CMU INTO EXISTING CMU UNLESS NOTED OTHERWISE.
- K. REFER TO FINISH PLANS FOR LOCATION AND EXTENT OF FINISHED FLOOR AND WALL MATERIAL.
- L. ALL EXPOSED CONCRETE MASONRY UNITS (CMU) EXTERIOR ARE TO BE BULLNOSED, EXCEPT AT MASONRY BULKHEADS AND CORNER WINDOW JAMBS.
- M. REFER TO DEMOLITION SHEETS FOR ADDITIONAL PATCHING AND REPAIR WORK.

PLAN LEGEND:

- ⊙ INDICATES MISCELLANEOUS CASEWORK ELEVATION SYMBOL - REFER TO A-400 SERIES DRAWINGS FOR ELEVATIONS AND DETAILS.
- ⊖ INDICATES STOREFRONT, CURTAIN WALL, OR WINDOW SYSTEM. REFER TO A-400 SERIES DRAWINGS FOR ELEVATIONS AND DETAILS.
- ◊ INDICATES WALL TYPES REFER TO G-201 FOR WALL THICKNESS, HEIGHT, AND COMPOSITION.
- ⊠ INDICATES CEILING/BULKHEAD HEIGHT ABOVE FINISHED FLOOR


PLAN NOTES:

- (ALL PLAN NOTES MAY NOT BE INDICATED ON THIS SHEET.)
- 1 DISPLAY CASE.
 - 2 CMU WALL. REFER TO WALL TYPES FOR ASSEMBLY DETAILS AND FINISH SCHEDULE FOR FINISH INFORMATION.
 - 3 GYPSUM BOARD BULKHEAD. SEE REFLECTED CEILING PLANS.
 - 4 PORCELAIN TILE TO MATCH EXISTING TILE IN ROOM H-115.
 - 5 PATCH AND REPAIR EXISTING CMU (USING BULLNOSE BLOCK) AS REQUIRED TO MATCH EXISTING FINISHES.
 - 6 PROVIDE 6" HIGH PORCELAIN BASE.
 - 7 PROVIDE SINGLE LAYER OF 5/8" GYPSUM BOARD, ADHERED TO MASONRY WALL CONSTRUCTION.
 - 8 INTERIOR DIVIDER RAIL.
 - 9 PROVIDE METAL WIRE TIES IN CMU WALL TO EXISTING BRICK AND PROVIDE 1/2" BACKER ROD AND SEALANT IN BREAK FACE VERTICALLY FROM GRADE TO CEILING ABOVE.
 - 10 EXTERIOR DIVIDER RAIL.
 - 11 THIS ROOM TO RECEIVE NEW VCT TILE FLOOR, VINYL BASE, EPOXY PAINT ON WALLS AND VINYL FACED 2' X 2' CEILING TILE IN GRID SUSPENDED AT 9'-0" A.F.F.
 - 12 REMOVE EQUIPMENT MOUNTED ON WALLS AS REQUIRED FOR WALL DEMOLITION AND REPLACE IN SAME LOCATION AFTER NEW FINISHES HAVE BEEN DONE.
 - 13 CLEAN EXISTING RAILING AS REQUIRED TO RECEIVE NEW PAINT. PAINT TO MATCH NEW RAILING.
 - 14 BUILD NEW FACE BRICK (CUT TO SLOPE) ON EXISTING RAMP.
 - 15 POUR NEW CONCRETE SLAB SAME THICKNESS AS EXISTING OVER GRANULAR FILL TO ORIGINAL ELEVATIONS.
 - 16 LOUVER. SEE MECHANICAL.
 - 17 SLOPE CONCRETE SLAB DOWN TO EXISTING PAVEMENT ELEVATION ON BOTH SIDES OF NEW DOOR.
 - 18 MODIFY EXISTING HI-DENSITY DRY STORAGE SHELVING AS REQUIRED FOR NEW WALL LOCATION.
 - 19 PUSH PLATE/BUTTON OPERATOR TO ACTIVATE DOOR.
 - 20 CASEWORK, MILLWORK, MARKER/TACK BOARDS AND EQUIPMENT. REFER TO 700 SERIES DRAWINGS.
 - 21 TYPE "A" METAL LOCKERS.
 - 22 COLUMN WITH BRICK CLADDING TO MATCH EXIST. CONDITIONS. SEE ELEVATIONS. REFER TO STRUCTURAL DRAWINGS FOR COLUMN INFORMATION.
 - 23 ENTRY CANOPY/OVERHANG ABOVE. REFER TO ELEVATIONS AND SECTIONS FOR ADDITIONAL INFORMATION.
 - 24 POWER OPERATED ROLLING DOOR.
 - 25 CONCESSIONS COUNTER WITH ROLLING DOOR.
 - 26 MOP SINK. SEE PLUMBING.
 - 27 RAISED CONCRETE EQUIPMENT PAD. SEE MECHANICAL DRAWINGS.
 - 28 POWER OPERATED FOLDING BLEACHERS.
 - 29 WALL-MOUNTED SINK. SEE PLUMBING DRAWINGS.
 - 30 SUSPENDED AND RETRACTABLE BASKETBALL GOAL.
 - 31 INFILLED CMU WALL CONSTRUCTION TO BE FLUSH WITH EXISTING/ADJACENT WALL SYSTEM.
 - 32 4" HIGH CONCRETE CURB.
 - 33 ALUMINUM LADDER.
 - 34 WALL-MOUNTED FIRE EXTINGUISHER. VERIFY LOCATION WITH OWNER.
 - 35 AREA OF NEW CONCRETE SIDEWALK. COORDINATE WITH CIVIL.
 - 36 INSTALL 8" PVC COATED CHAIN LINK FENCE ENCLOSURE. COORDINATE WITH CIVIL.
 - 37 PROVIDE WALL FURRING WITH METAL STUD FRAMING @ 16" O.C. WHERE INDICATED.
 - 38 NEW SOLID SURFACE WINDOW STOOL. SEE FINISH LEGEND.
 - 39 CARD READER. COORDINATE WITH ELECTRICAL AND TECHNOLOGY DRAWINGS.
 - 40 LOCKABLE CONTROL CABINET RECESSED IN WALL ASSEMBLY. COORDINATE WITH ELECTRICAL AND TECHNOLOGY DRAWINGS.
 - 41 SAFETY CUSHION WAINSCOT.
 - 42 OPENING IN WALL ASSEMBLY FOR DUCTWORK. SEE MECHANICAL.
 - 43 SEMI-RECESSED FIRE EXTINGUISHER CABINET.
 - 44 WOOD FLOOR INSERT.
 - 45 MOTORIZED PROJECTION SCREEN. COORDINATE WITH ELECTRICAL AND TECHNOLOGY DRAWINGS.
 - 46 RELOCATED KNOX BOX.
 - 47 ALTERNATE - DIVIDER CURTAIN.
 - 48 CMU BULKHEAD. SEE STRUCTURAL AND COORDINATE WITH REFLECTED CEILING PLANS.



GIBRALTAR DESIGN
 ARCHITECTURE • ENGINEERING • INTERIOR DESIGN

PROJECT
 ADDITIONS AND RENOVATIONS TO
EDGEWOOD INTERMEDIATE SCHOOL
 FRANKLIN TOWNSHIP COMMUNITY SCHOOL CORPORATION
 INDIANAPOLIS, INDIANA

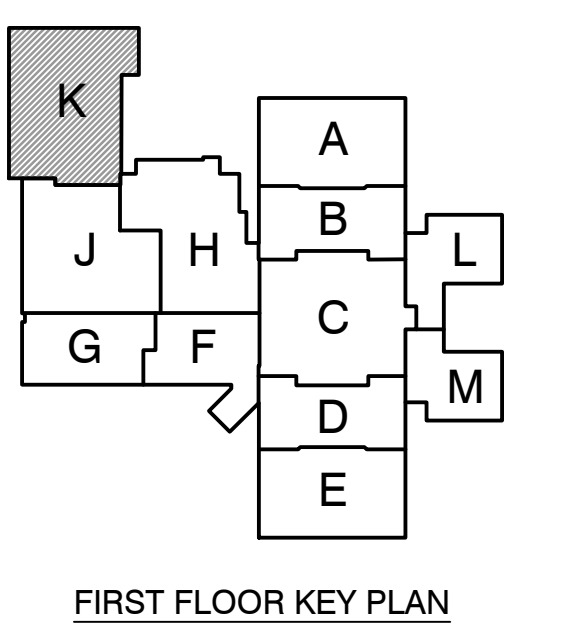

GIBRALTAR DESIGN
 9102 N. Meridian St., Ste. 300
 Indianapolis, IN 46260
 Homepage: www.GibraltarDesign.com
 Email: info@GibraltarDesign.com
 Phone: 317.580.5777 Fax: 317.580.5778

PROJECT
 21-155
 DATE
 05/23/22
 COORDINATED BY
 DJW
 DRAWN BY
 JRH
 CHECKED BY
 DJW

COPYRIGHT NOTICE:
 THE CONCEPTS, DESIGNS, PLANS, DETAILS, ETC. SHOWN ON THIS DOCUMENT ARE THE PROPERTY OF GIBRALTAR DESIGN AND WERE CREATED FOR USE ON THIS SPECIFIC PROJECT. NONE OF THIS INFORMATION SHALL BE USED BY ANY PERSON OR FIRM FOR ANY PURPOSE WITHOUT THE EXPRESS WRITTEN CONSENT OF GIBRALTAR DESIGN. THE OWNER MAY RETAIN COPIES FOR INFORMATION AND REFERENCE IN CONNECTION ONLY WITH THIS PROJECT.


REVISIONS	MARK	DATE	ISSUED FOR
ADDENDUM NO. 1	AD-1	06/16/22	ADDENDUM NO. 1

MARK	DATE	ISSUED FOR
AD-1	06/16/22	ADDENDUM NO. 1


DRAWING
UNIT "K" ARCHITECTURAL FIRST FLOOR PLAN

PROJECT
 ADDITIONS AND RENOVATIONS TO
 EDGEWOOD INTERMEDIATE SCHOOL


GIBRALTAR DESIGN SHEET
A-111

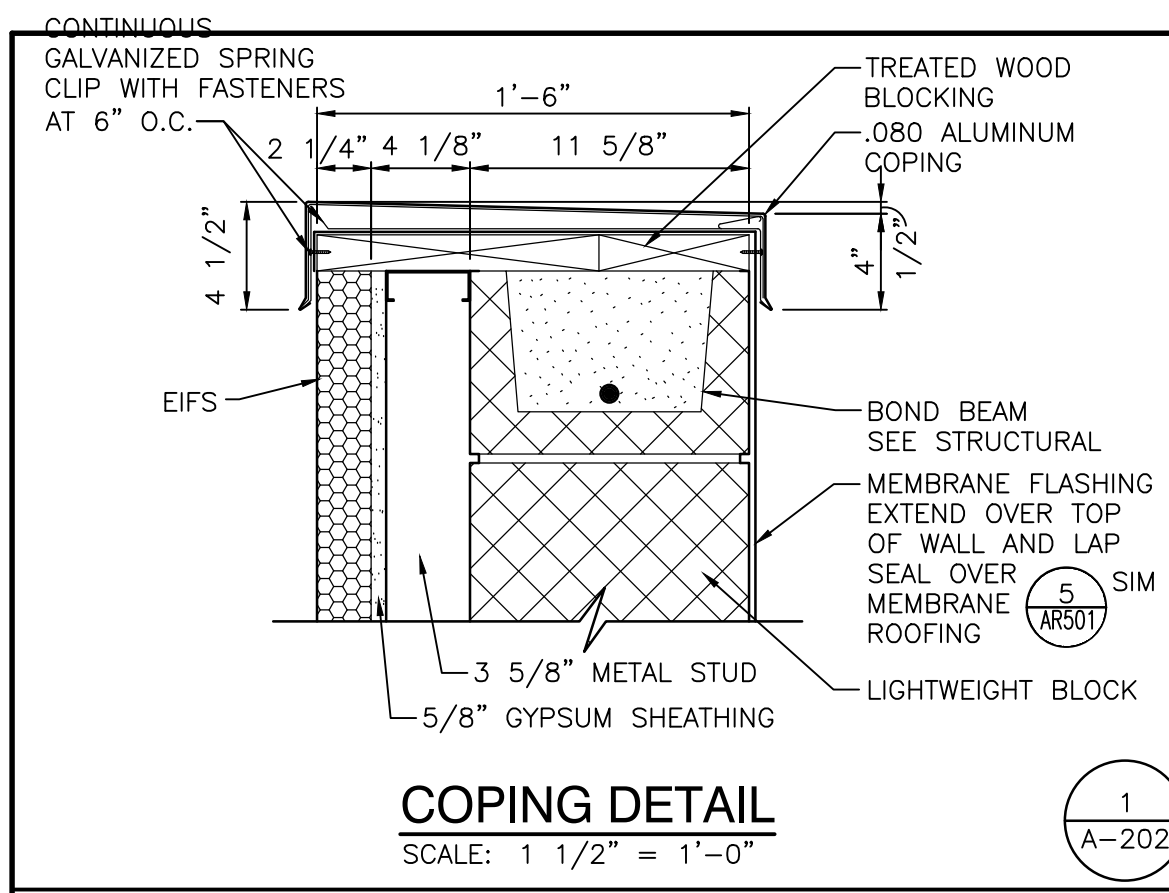


COPING DETAIL
SCALE: 1 1/2" = 1'-0"

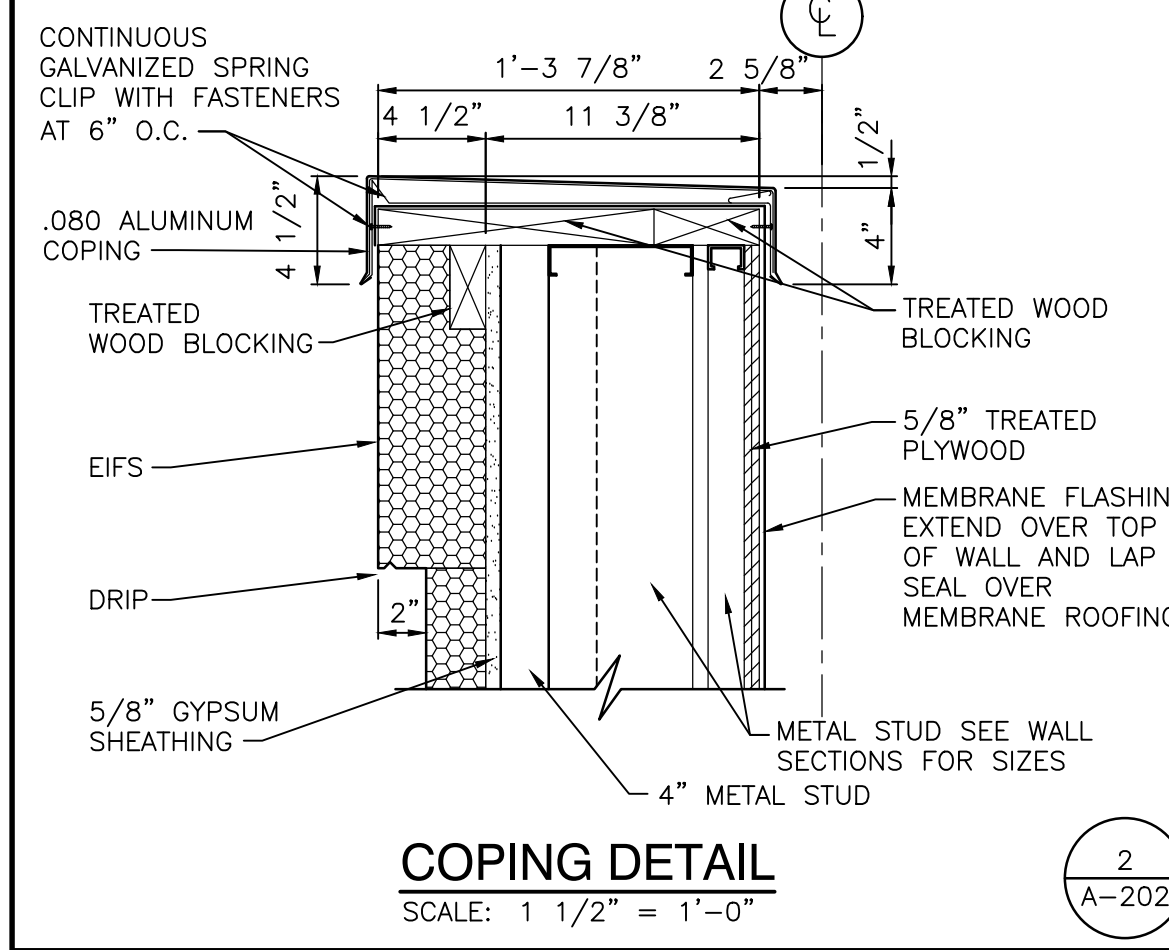


COPING DETAIL
SCALE: 1 1/2" = 1'-0"

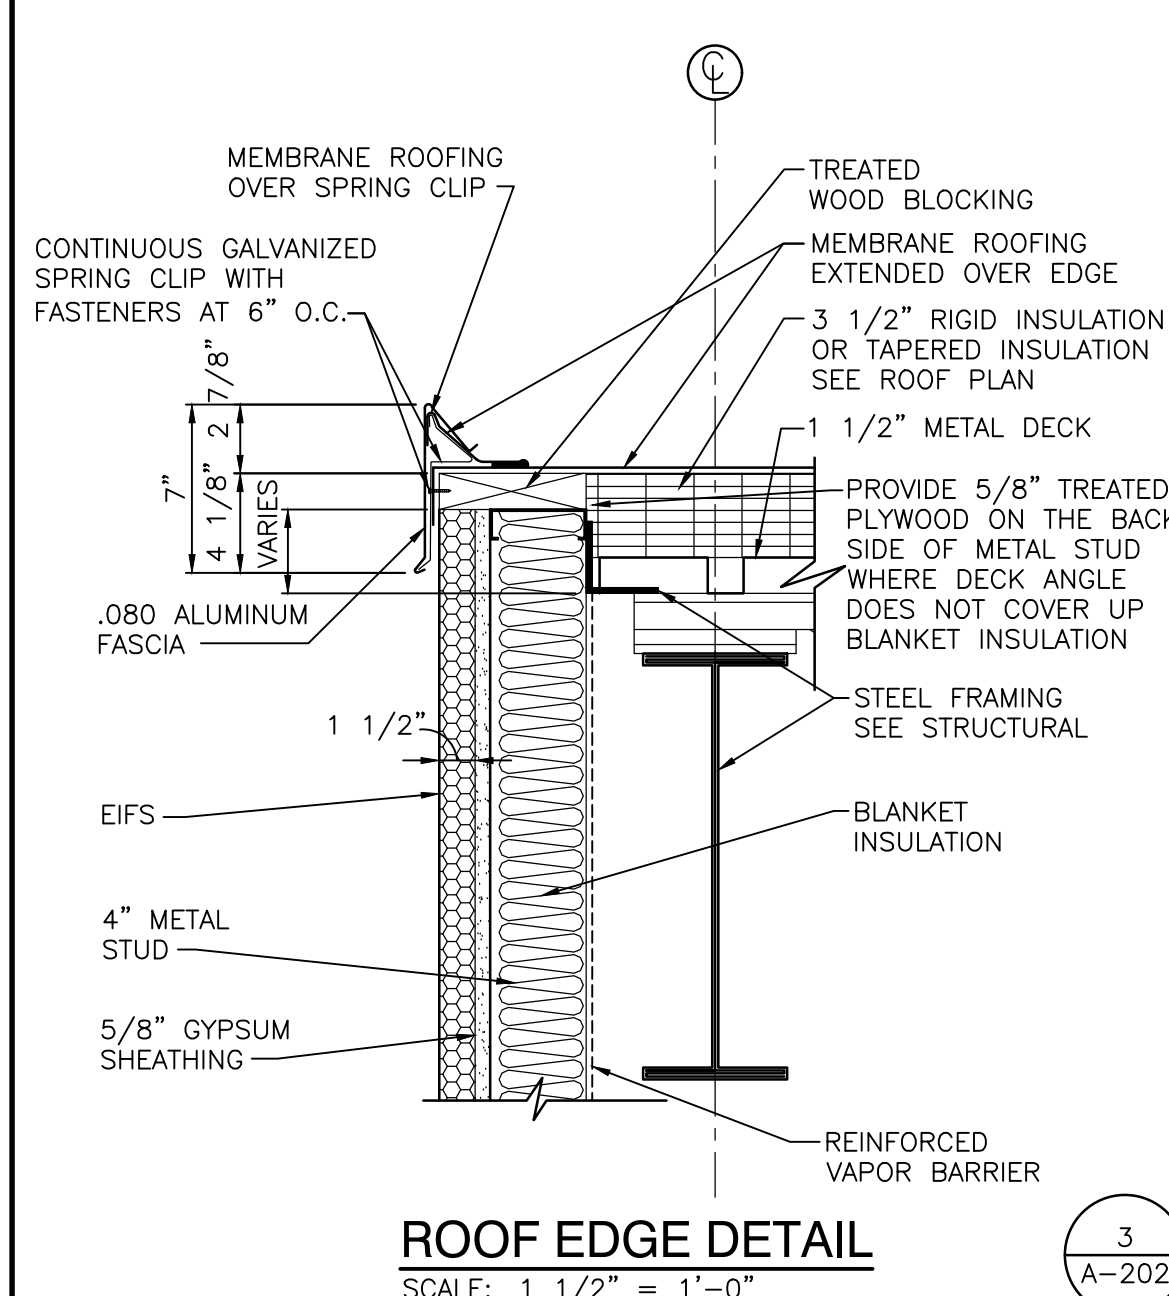


ROOF EDGE DETAIL
SCALE: 1 1/2" = 1'-0"

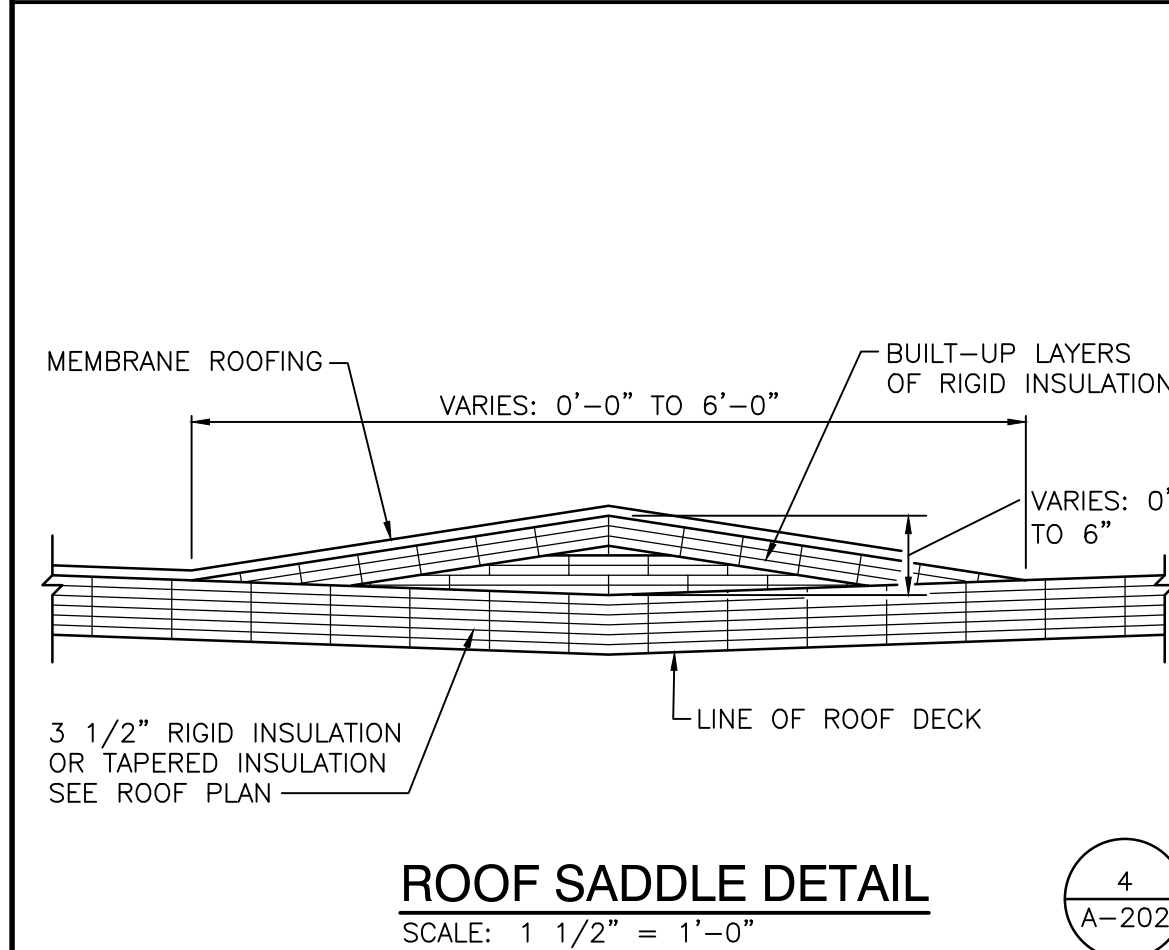

ROOF SADDLE DETAIL
SCALE: 1 1/2" = 1'-0"

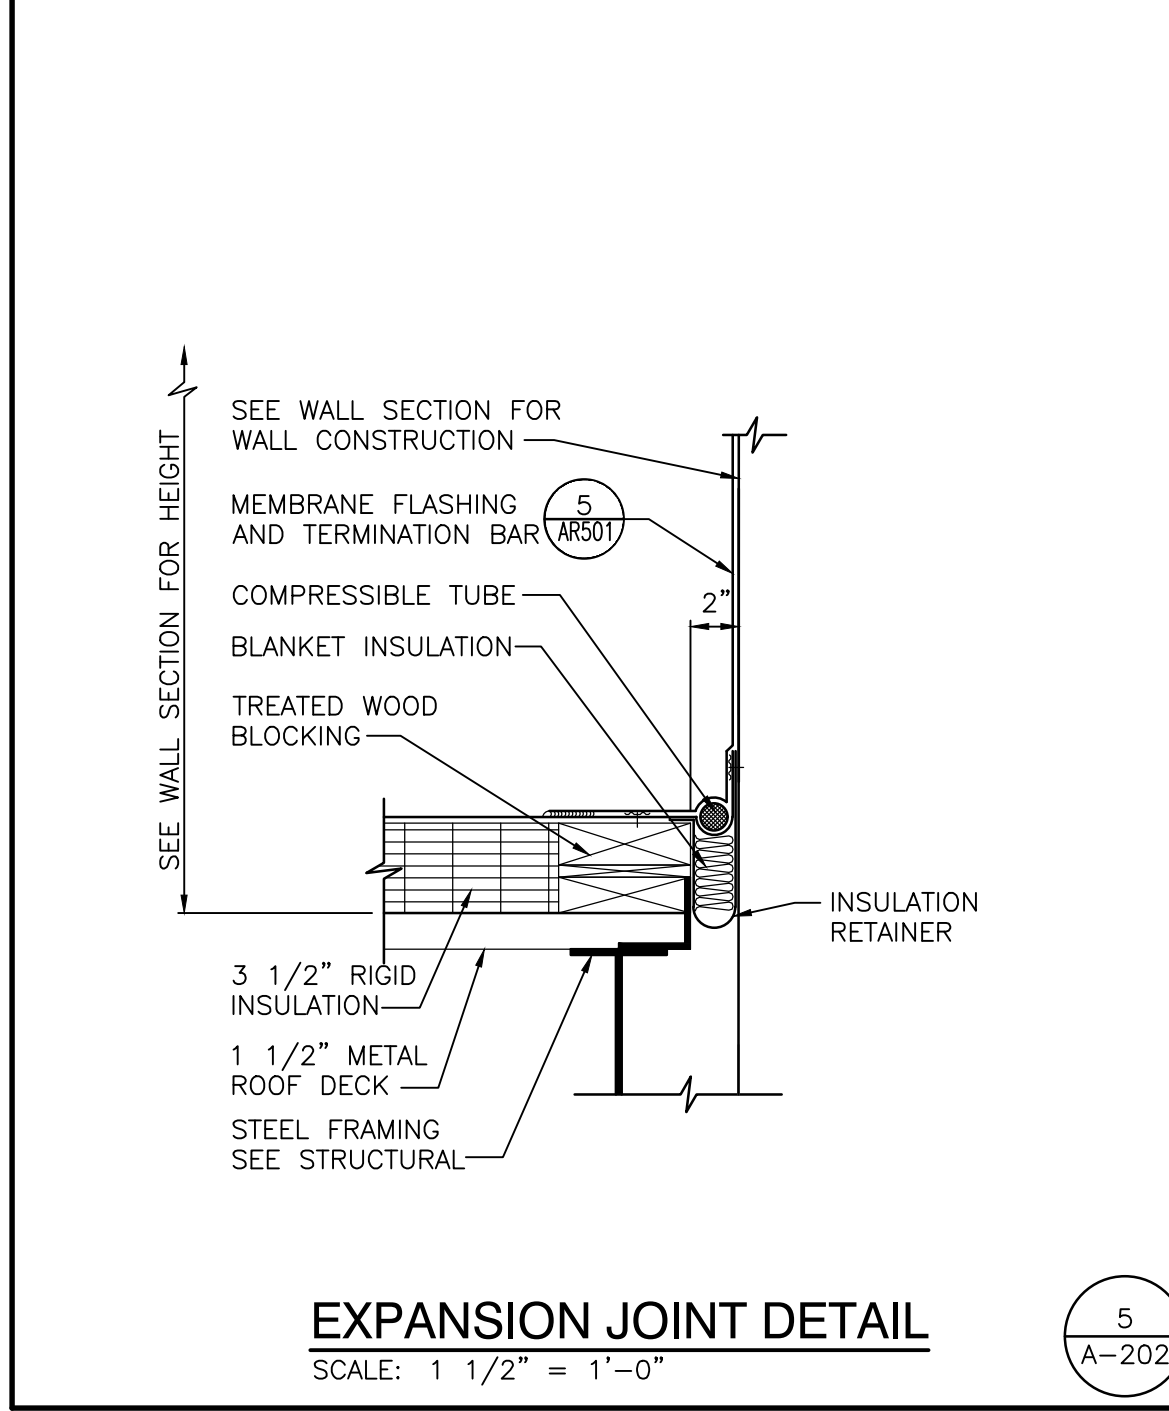


EXPANSION JOINT DETAIL
SCALE: 1 1/2" = 1'-0"

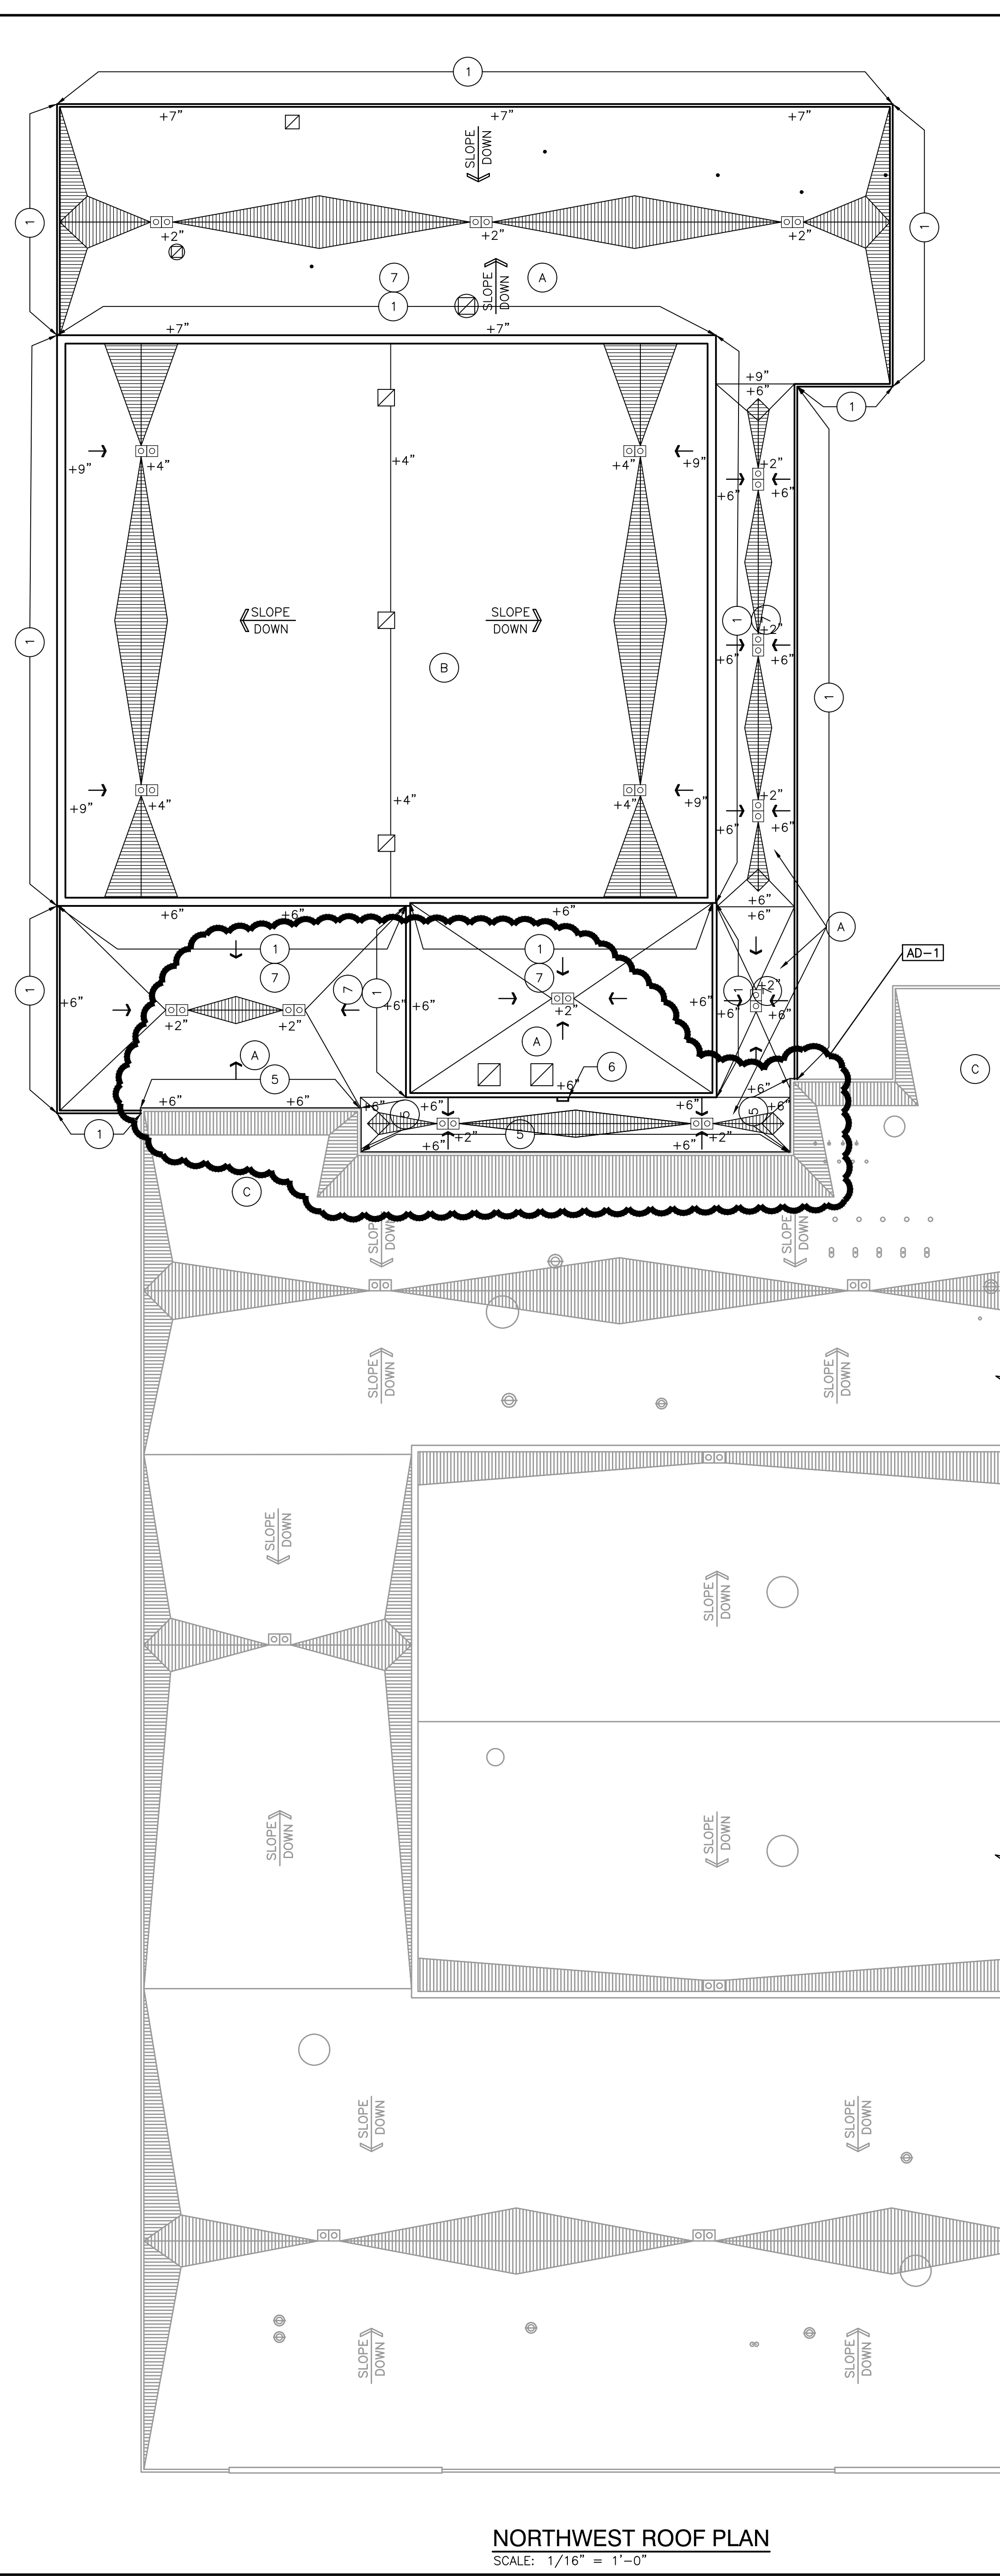


NORTHWEST ROOF PLAN
SCALE: 1/16" = 1'-0"

- ROOF PLAN NOTES:**
(ALL PLAN NOTES MAY NOT BE INDICATED ON THIS SHEET.)
- COPING CAP
 - GUTTER AND SOFFIT
 - GUTTER AND FLASHING
 - ROOF EXPANSION JOINT
 - EXTERIOR ALUMINUM LADDER
 - FLASHING
 - BUILT UP PARAPET WALL AT DEMOLISHED ENTRY CANOPY LOCATION. PARAPET CONSTRUCTION, HEIGHT, COPING, MATERIALS, AND COLORS TO MATCH EXISTING/ADJACENT CONDITIONS.
 - FLASHING

- GENERAL ROOF PLAN NOTES:**
- FOR GENERAL NOTES, MATERIAL INDICATIONS LEGEND, SYMBOL LEGEND, ABBREVIATIONS, ETC. SEE SHEET G101.
 - THERE MAY BE LOCATIONS ON THE EXISTING ROOF WHERE THE EXISTING ROOF DECK MAY NOT BE STRUCTURALLY SOUND. CONTRACTORS SHOULD USE EXTREME CAUTION IN WORKING THESE ROOF AREAS TO MAINTAIN SAFE WORKING CONDITIONS.
 - CONTRACTOR SHALL VERIFY ALL DIMENSIONS, CLEARANCES AND ALL EXISTING FIELD CONDITIONS BEFORE STARTING CONSTRUCTION. COMMENCEMENT OF WORK CONSTITUTES ACCEPTANCE OF CONDITIONS. SHOULD DIFFERENT CONDITIONS BE ENCOUNTERED, CONTACT THE ARCHITECT BEFORE PROCEEDING WITH WORK.
 - THE ROOFING CONTRACTOR SHALL BE RESPONSIBLE FOR THE REPAIR OR REPLACEMENT OF ALL DAMAGE CAUSED BY THE IMPROPER STORAGE OR STACKING OF ROOFING MATERIALS.
 - ALL DIMENSIONS INDICATED ON THE ROOF PLAN ARE APPROXIMATE. THE CONTRACTOR IS RESPONSIBLE FOR OBTAINING ACCURATE FIELD MEASUREMENTS FOR THE EXECUTION OF HIS WORK AND PRIOR TO ANY FABRICATION OF THE VARIOUS MATERIALS.
 - THE ROOF CONTRACTOR SHALL PROTECT ALL ROOF DRAINS, SCUPPERS AND DOWNSPOUTS FROM DEBRIS CREATED DURING DEMOLITION AND/OR NEW CONSTRUCTION. THE ROOF CONTRACTOR SHALL INSPECT AND CLEAR ALL DRAINS, SCUPPERS AND DOWNSPOUTS PRIOR TO COMPLETION OF WORK AND TO ENSURE THAT THEY ARE FREE OF DEBRIS AND ARE FUNCTIONING PROPERLY.
 - ROOF DRAIN LOCATION INDICATE DESIGN INTENT. COORDINATE LOCATIONS WITH STRUCTURAL AND MECHANICAL, ELECTRICAL AND PLUMBING DRAWINGS.
 - LOCATION AND QUANTITY OF ALL ROOF DRAINS, FLUES, VENTS, POWER AND GRAVITY VENTILATORS, ETC., SHALL BE VERIFIED BY THE CONTRACTOR IN THE FIELD.
 - FOR NEW AND/OR EXISTING PLUMBING VENT LOCATIONS REFER TO MECHANICAL ROOF PLANS.
 - EXTEND ALL PLUMBING VENTS SO THAT THE TOP IS A MINIMUM OF 12" ABOVE THE ROOFING MEMBRANE.
 - PROVIDE NEW FLASHING AND TWO PIECE COUNTER-FLASHING WHERE NEW ROOFING ABUTS A NEW OR EXISTING WALL, UNLESS OTHERWISE NOTED OR DETAILED.
 - PROVIDE FLASHING AND SADDLES FOR ALL EQUIPMENT PROVIDED UNDER MECHANICAL.
 - FLASHING OF ALL VENTS, FAN CURBS, MASONRY WALLS, FLUES, DRAINS, FASCIAS, ETC., SHALL BE PERFORMED IN ACCORDANCE WITH THESE SPECIFICATIONS AND DRAWINGS, AND WITH ROOFING MANUFACTURERS STANDARD DETAILS AND SPECIFICATIONS.
 - CONTRACTOR TO PROVIDE CRICKETS AND/OR ROOF SADDLES AS REQUIRED TO PROMOTE POSITIVE DRAINAGE AROUND ALL ROOF TOP PENETRATIONS.
 - SADDLES AND TAPERED INSULATION SYMBOLS INDICATE DESIGN INTENT TO SLOPES TO DRAIN. CONTRACTOR SHALL PROVIDE SUBMITTAL DRAWINGS FOR TAPERED INSULATION AND SADDLES TO ENSURE POSITIVE SLOPE.
 - ALL NEW WOOD BLOCKING AND NAILERS SHALL BE TREATED WOOD.
 - DEMOLITION AND REMOVAL OPERATIONS ARE TO BE PERFORMED CAREFULLY AND ALL PORTIONS OF THE BUILDING SHALL BE PROTECTED DURING THESE OPERATIONS. ITEMS TO BE REUSED AND REINSTALLED ARE TO BE CAREFULLY REMOVED AND STORED. DAMAGES INCURRED DURING REMOVAL OR STORAGE SHALL BE THE CONTRACTOR'S RESPONSIBILITY.
 - REMOVE ALL POWER VENTILATORS, FANS AND GRAVITY VENTILATORS. REPLACE ALL DETERIORATED, LOOSE, OR FAULTY WOOD BLOCKING. REPLACE AND EXTEND CURBS WITH NEW TREATED WOOD BLOCKING WITH TOP AT 12" MINIMUM ABOVE THE NEW ROOFING MEMBRANE. REINSTALL FANS AND VENTILATORS WITH "KORFUND ELASTO-RIB" VIBRATION ELIMINATOR, SET ON THE CURB TOP OF ALL POWER DRIVEN FANS AND VENTS.
 - REMOVE ALL EXISTING ROOF GRAVEL, RESIDUE, AND ALL PROJECTIONS WHICH WOULD PREVENT THE NEW ROOF INSULATION FROM LAYING FLAT OVER THE EXISTING ROOF SURFACES.
 - REMOVE AND CLEAN ROOF DRAIN STRAINERS AND CLAMP RINGS. REINSTALL AFTER NEW ROOF INSULATION AND ROOFING MEMBRANE ARE IN PLACE. ANY BROKEN OR MISSING ROOF DRAIN STRAINER SHALL BE REPLACED WITH A NEW STRAINER.
 - SEE MECHANICAL DRAWINGS FOR LOCATIONS OF ROOF TOP EQUIPMENT TO BE REMOVED.

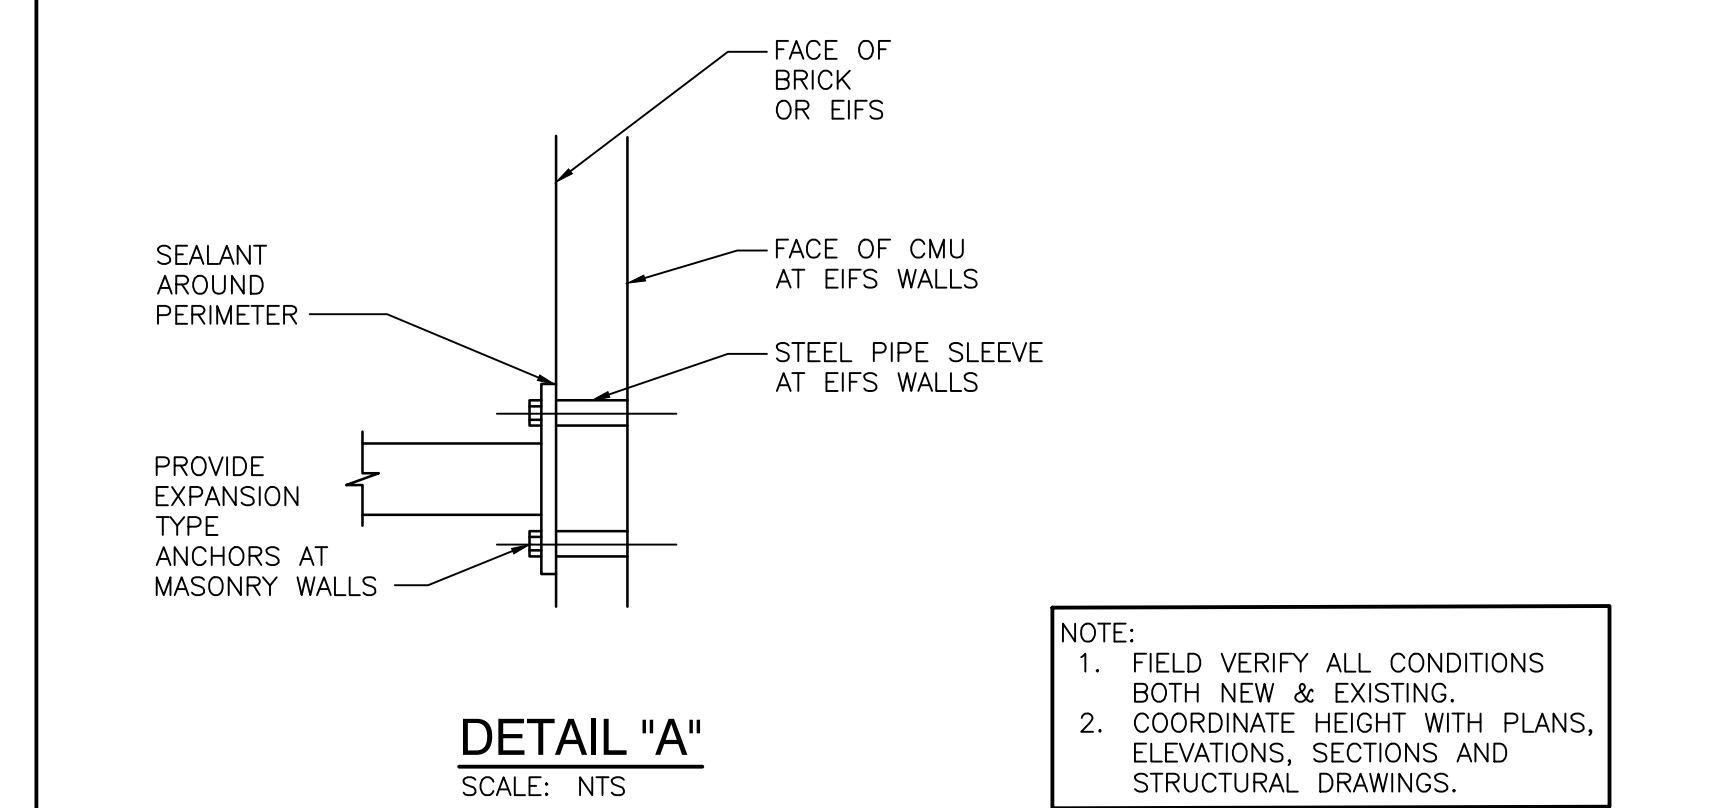


DETAIL "A"
SCALE: NTS

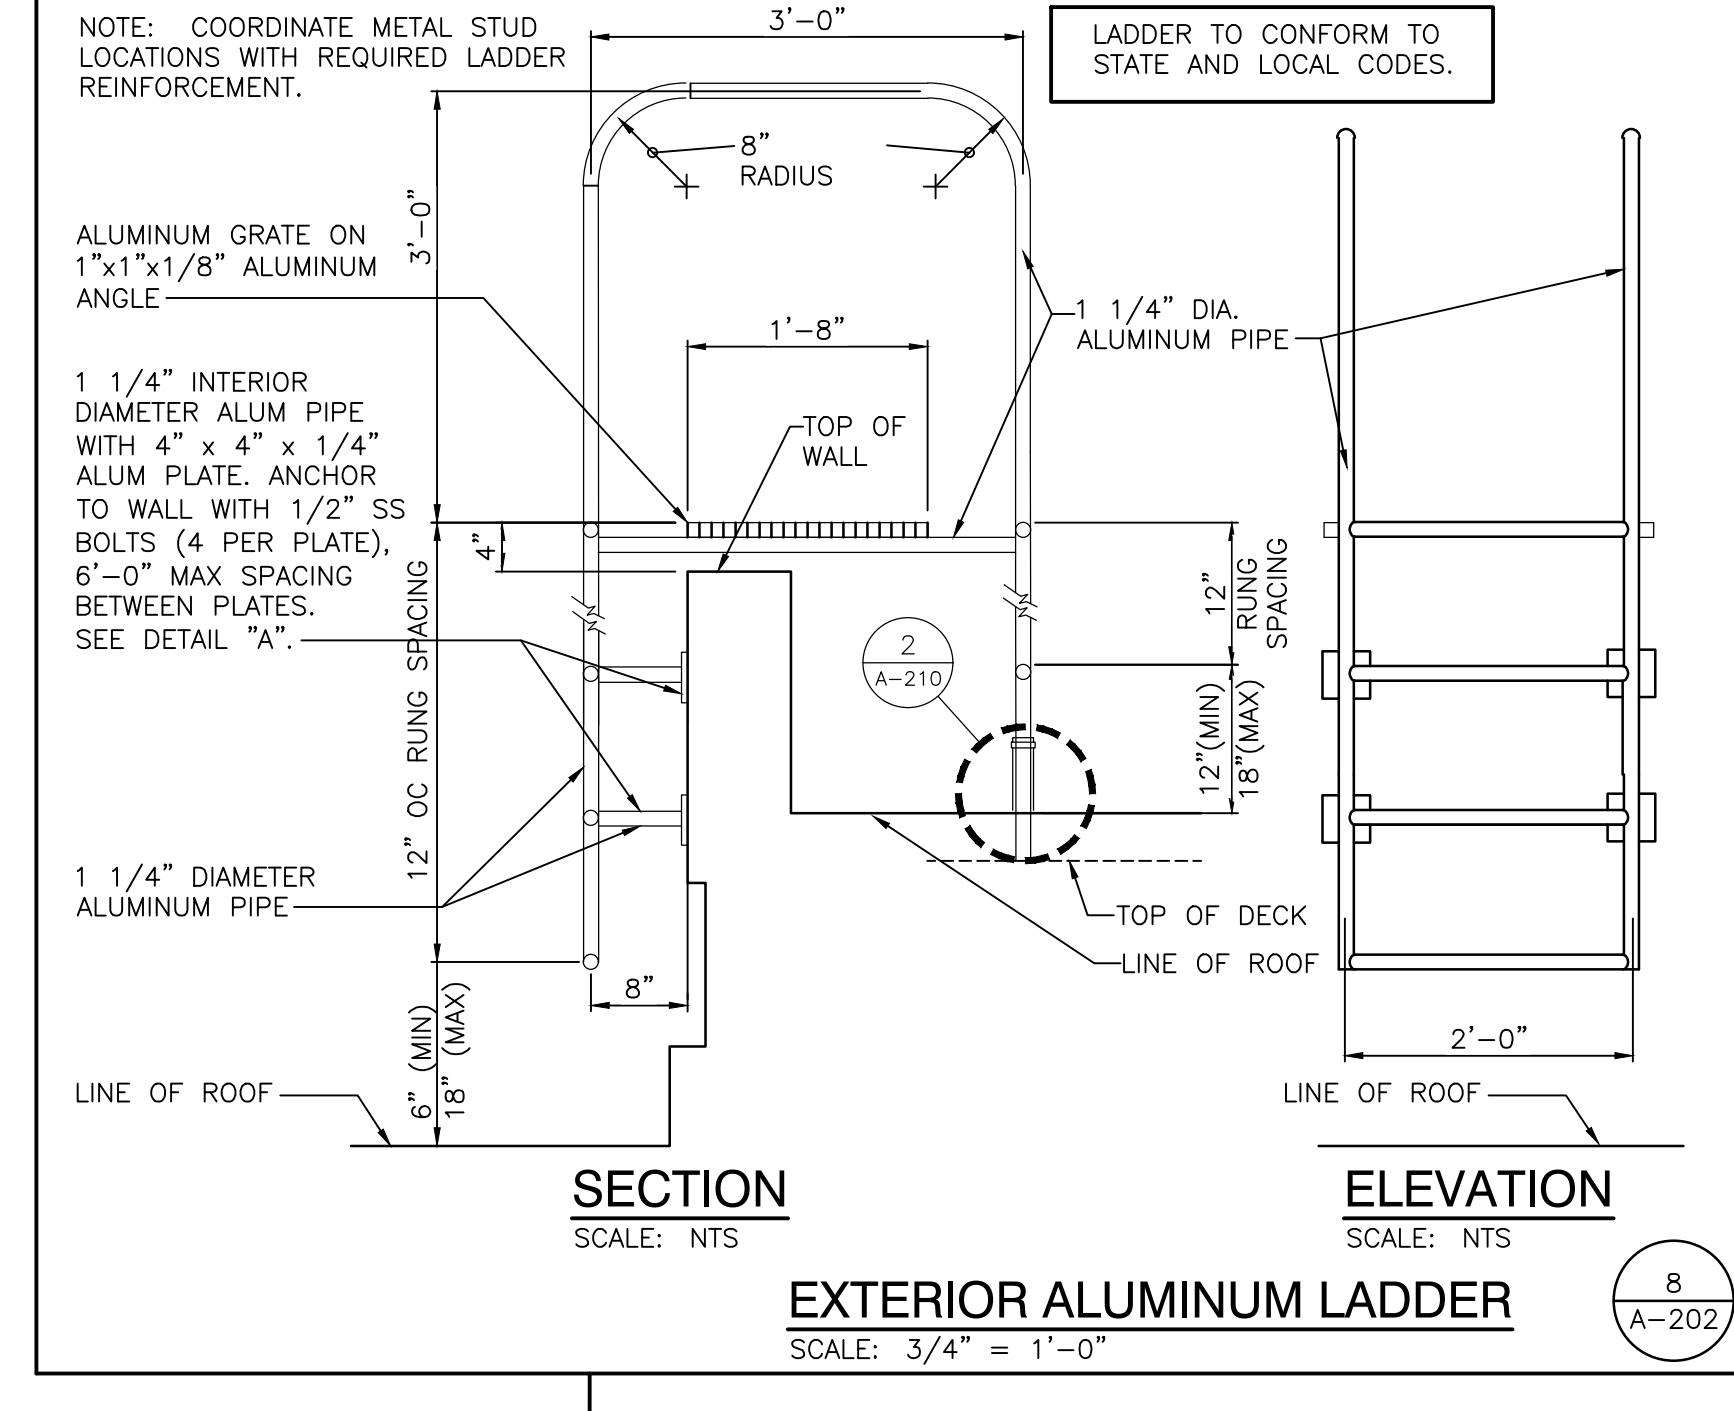


SECTION
SCALE: NTS

ELEVATION
SCALE: NTS

EXTERIOR ALUMINUM LADDER
SCALE: 3/4" = 1'-0"

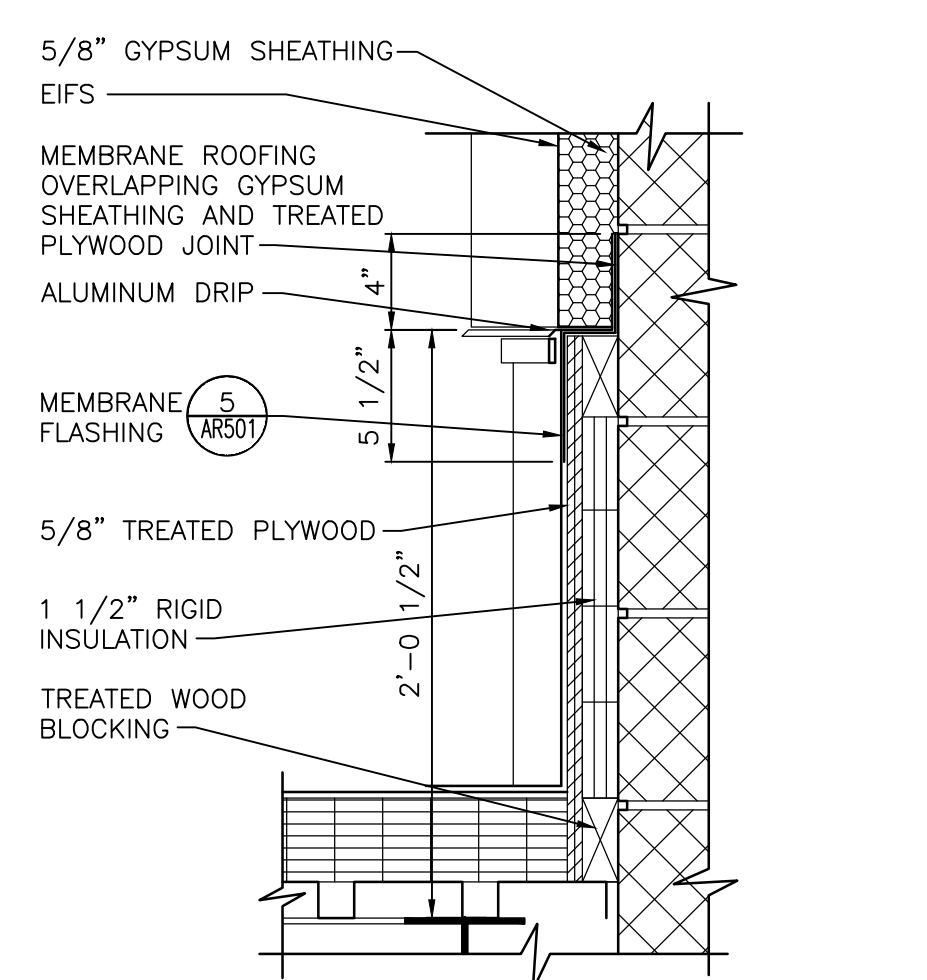

FLASHING DETAIL
SCALE: 1 1/2" = 1'-0"

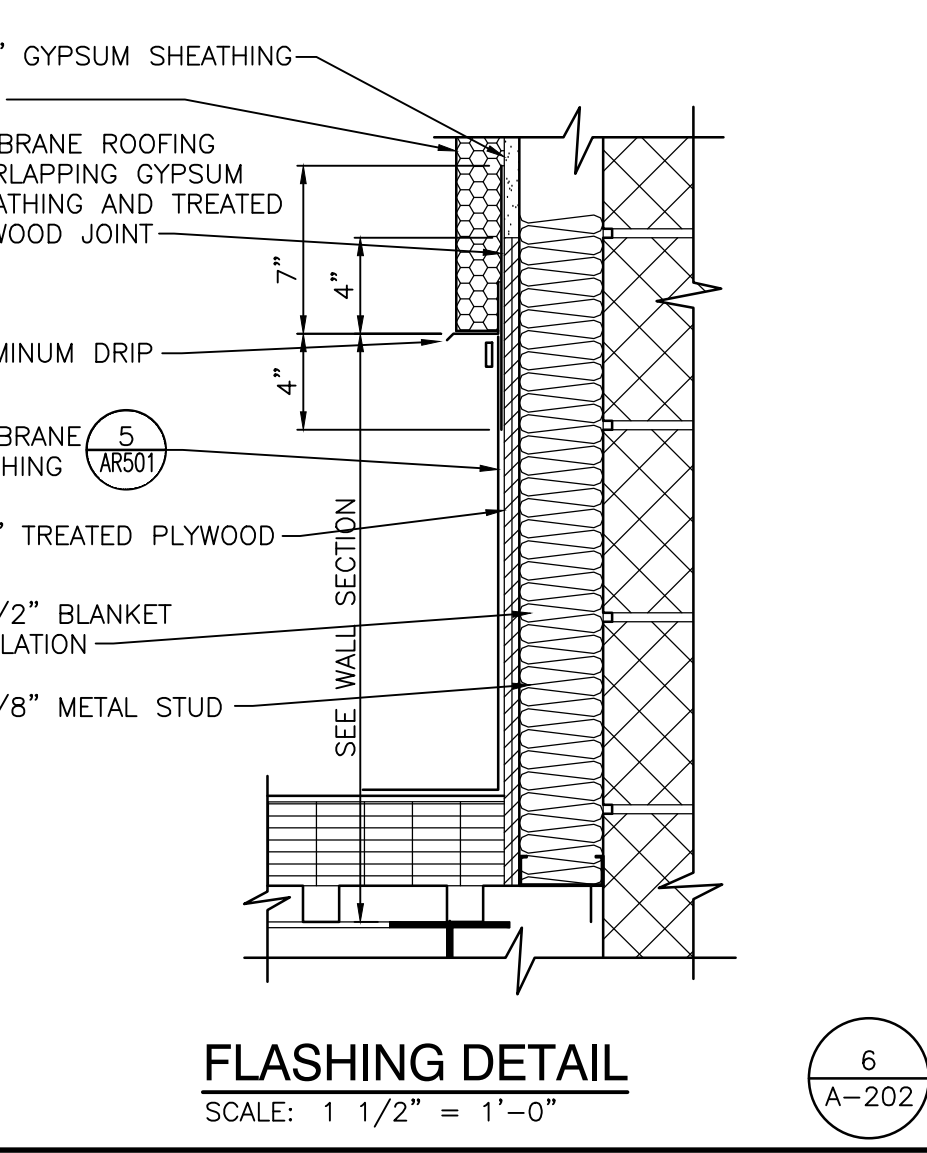

FLASHING DETAIL
SCALE: 1 1/2" = 1'-0"


- ROOF LEGEND:**
- ELEVATION TOP OF NEW ROOF DECK
 - RELIEF VENT
 - EX-HAUST FAN
 - GRAVITY VENT
 - ROOF DRAIN
 - PLUMBING VENT
 - ROOF DRAINAGE SADDLE
 - PENTHOUSE
 - MECHANICAL UNIT
 - ELEVATION TOP OF EXISTING ROOF DECK
 - EXISTING RELIEF VENT
 - EXISTING EX-HAUST FAN
 - EXISTING GRAVITY VENT
 - EXISTING ROOF DRAIN
 - EXISTING PLUMBING VENT
 - EXISTING PITCH POCKET
 - EXISTING ROOF DRAINAGE SADDLE
 - EXISTING PENTHOUSE
 - EXISTING MECHANICAL UNIT
 - EXISTING ROOF HATCH
- INDICATES ROOF SLOPE (1/4" PER 12")
 - - INDICATES ROOF SADDLE SLOPE (1/2" PER 12")
- HATCH PATTERN INDICATES NEW ROOFING SYSTEM.
 HATCH PATTERN INDICATES RE-ROOF OF EXISTING ROOF.
 HATCH PATTERN INDICATES NEW ROOF AND/OR FLASHING MEMBRANE TO OVERLAP AND TIE INTO EXISTING ROOF MEMBRANE AS REQUIRED TO MAINTAIN EXISTING ROOF WARRANTY

- ROOF TYPES:**
- NEW FLAT METAL DECK: PROVIDE NEW ROOF SYSTEM. NEW ROOFING SYSTEM SHALL BE FULLY-ADHERED SINGLE-PLY MEMBRANE OVER 1/2" COVER BOARD OVER TAPERED (1/4" PER FOOT) POLYISOCYANURATE INSULATION WITH MINIMUM 1" THICKNESS AND MINIMUM AVERAGE THICKNESS OF 4".
 - NEW SLOPING METAL DECK: PROVIDE NEW ROOF SYSTEM. NEW ROOFING SYSTEM SHALL BE FULLY-ADHERED SINGLE-PLY MEMBRANE OVER 1/2" COVER BOARD OVER 4" POLYISOCYANURATE INSULATION.
 - EXISTING ROOF SYSTEM SHALL REMAIN EXCEPT AS NOTED. PROTECT FROM ADJACENT ROOF WORK.
 - FIBERGLASS SHINGLE ROOFING ON TWO LAYERS OF #15 FELT ON VENTED ROOF SYSTEM ON SLOPING METAL DECK (6/12 SLOPE).



GIBRALTAR DESIGN
ARCHITECTURE • ENGINEERING • INTERIOR DESIGN

PROJECT
ADDITIONS AND RENOVATIONS TO
EDGEWOOD INTERMEDIATE SCHOOL
FRANKLIN TOWNSHIP COMMUNITY SCHOOL CORPORATION
INDIANAPOLIS, INDIANA

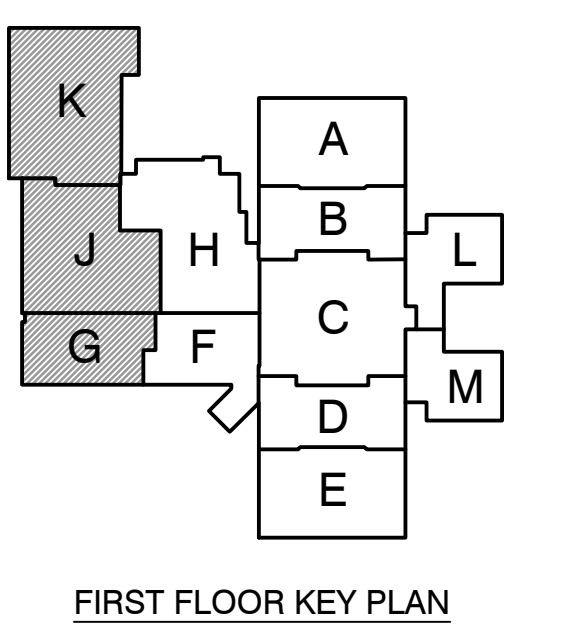

GIBRALTAR DESIGN
9102 N. Meridian St., Ste. 300
Indianapolis, IN 46260
Homepage: www.GibraltarDesign.com
Email: info@GibraltarDesign.com
Phone: 317.580.5777 Fax: 317.580.5778

PROJECT
21-155
DATE
05/23/22
COORDINATED BY
DJW
DRAWN BY
JRH KS
CHECKED BY
DJW






COPYRIGHT NOTICE:
THE CONCEPTS, DESIGNS, PLANS, DETAILS, ETC. SHOWN ON THIS DOCUMENT ARE THE PROPERTY OF GIBRALTAR DESIGN AND ARE CREATED FOR USE ON THIS SPECIFIC PROJECT. NONE OF THIS INFORMATION SHALL BE USED BY ANY OTHER PARTY FOR ANY PURPOSE WITHOUT THE EXPRESS WRITTEN CONSENT OF GIBRALTAR DESIGN. THE OWNER MAY RETAIN COPIES FOR INFORMATION AND REFERENCE IN CONNECTION ONLY WITH THIS PROJECT.

REVISIONS	MARK	DATE	ISSUED FOR
AD-1	06/16/22	ADDENDUM NO. 1	


DRAWING
UNITS "G", "J", AND "K"
ARCHITECTURAL ROOF PLAN

PROJECT
ADDITIONS AND RENOVATIONS TO
EDGEWOOD INTERMEDIATE SCHOOL

Wednesday, 6/15/2022, 4:49 PM - LAST SAVED BY: JHARRIS
Y:\21-155 FRANKLIN TOWNSHIP CSC-EDGEWOOD IS
ADDITIONS AND RENOVATIONS 21-155 DRAWINGS\05
ARCH\A-202.DWG

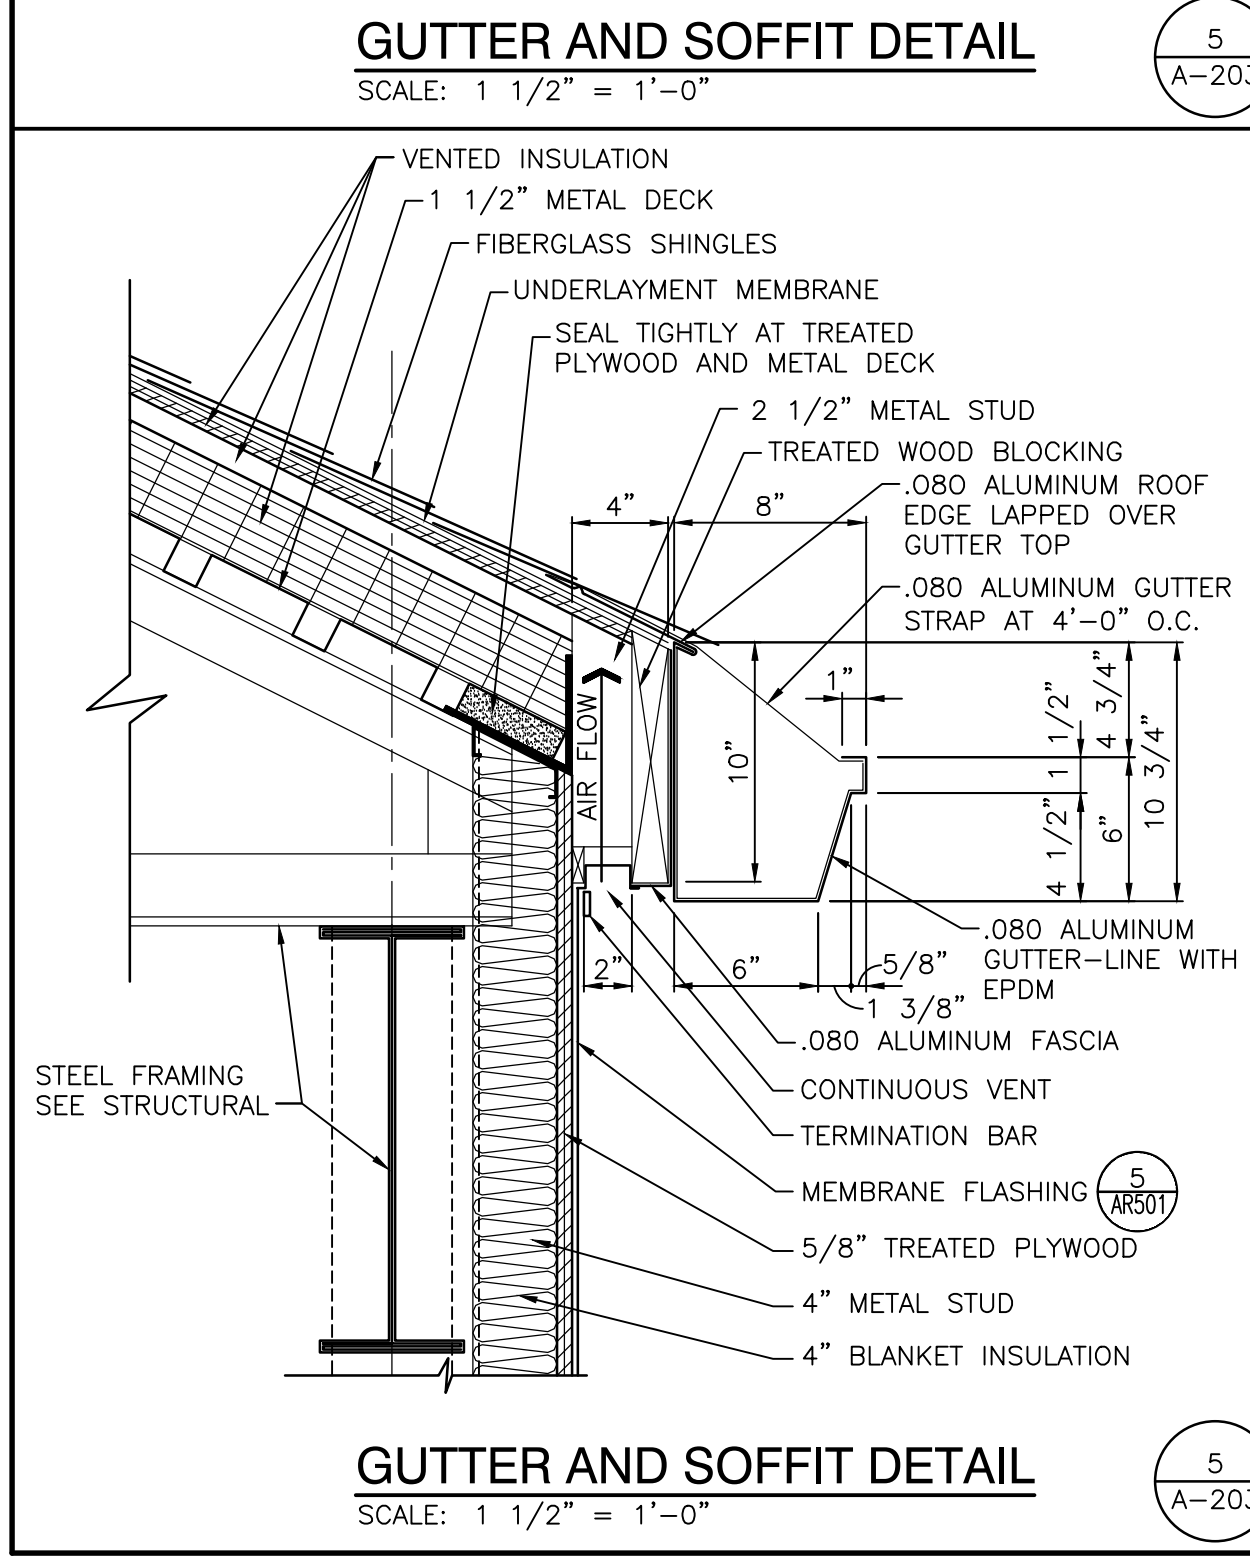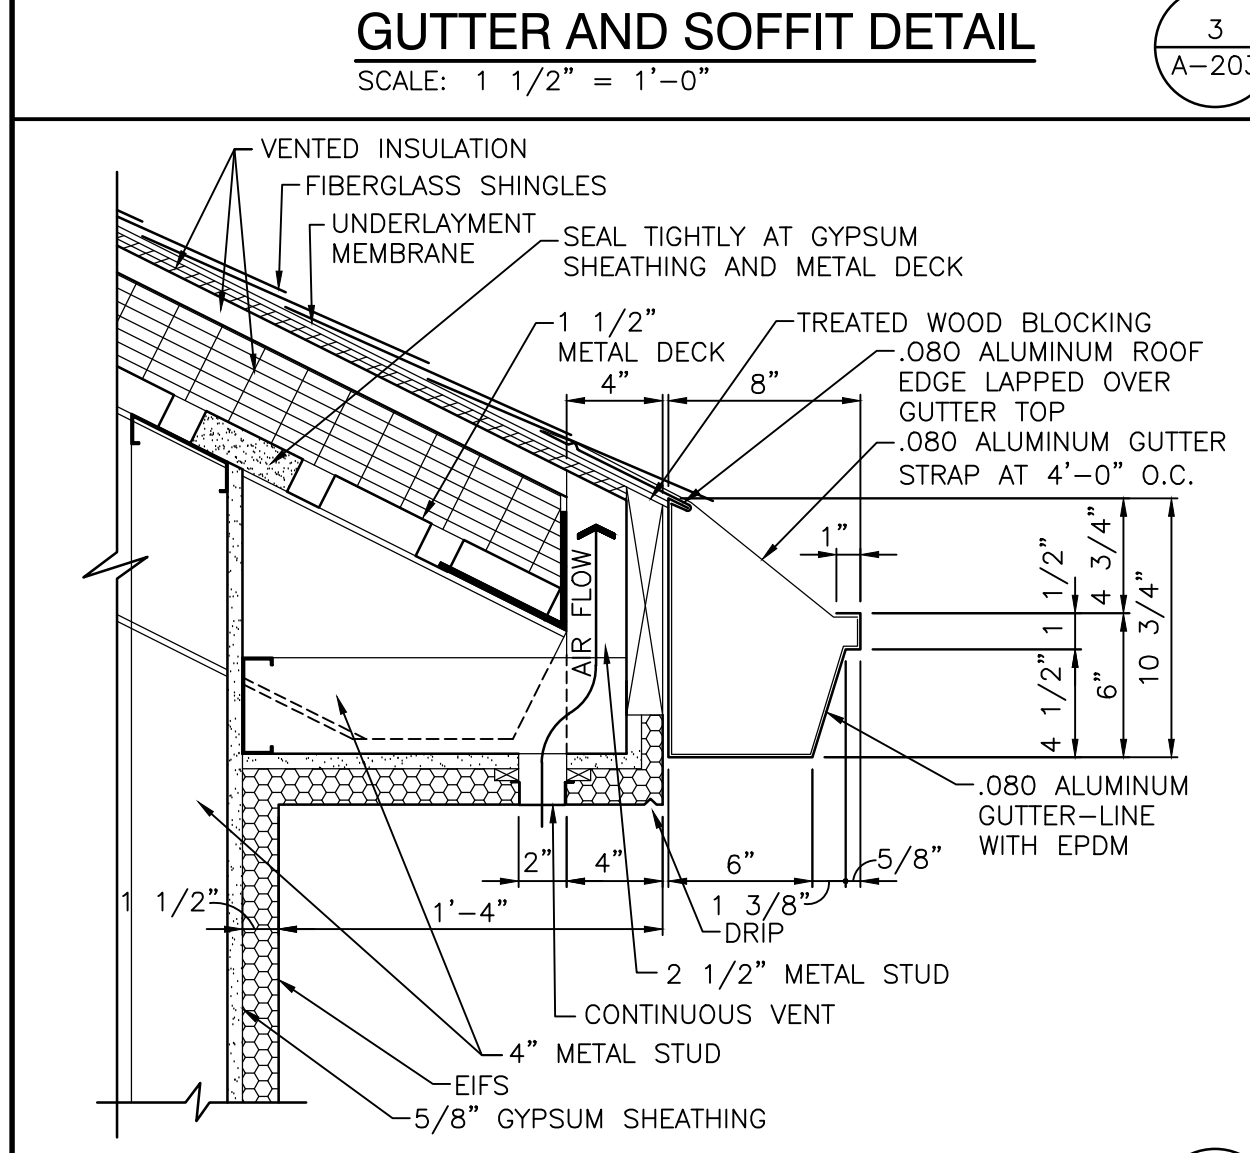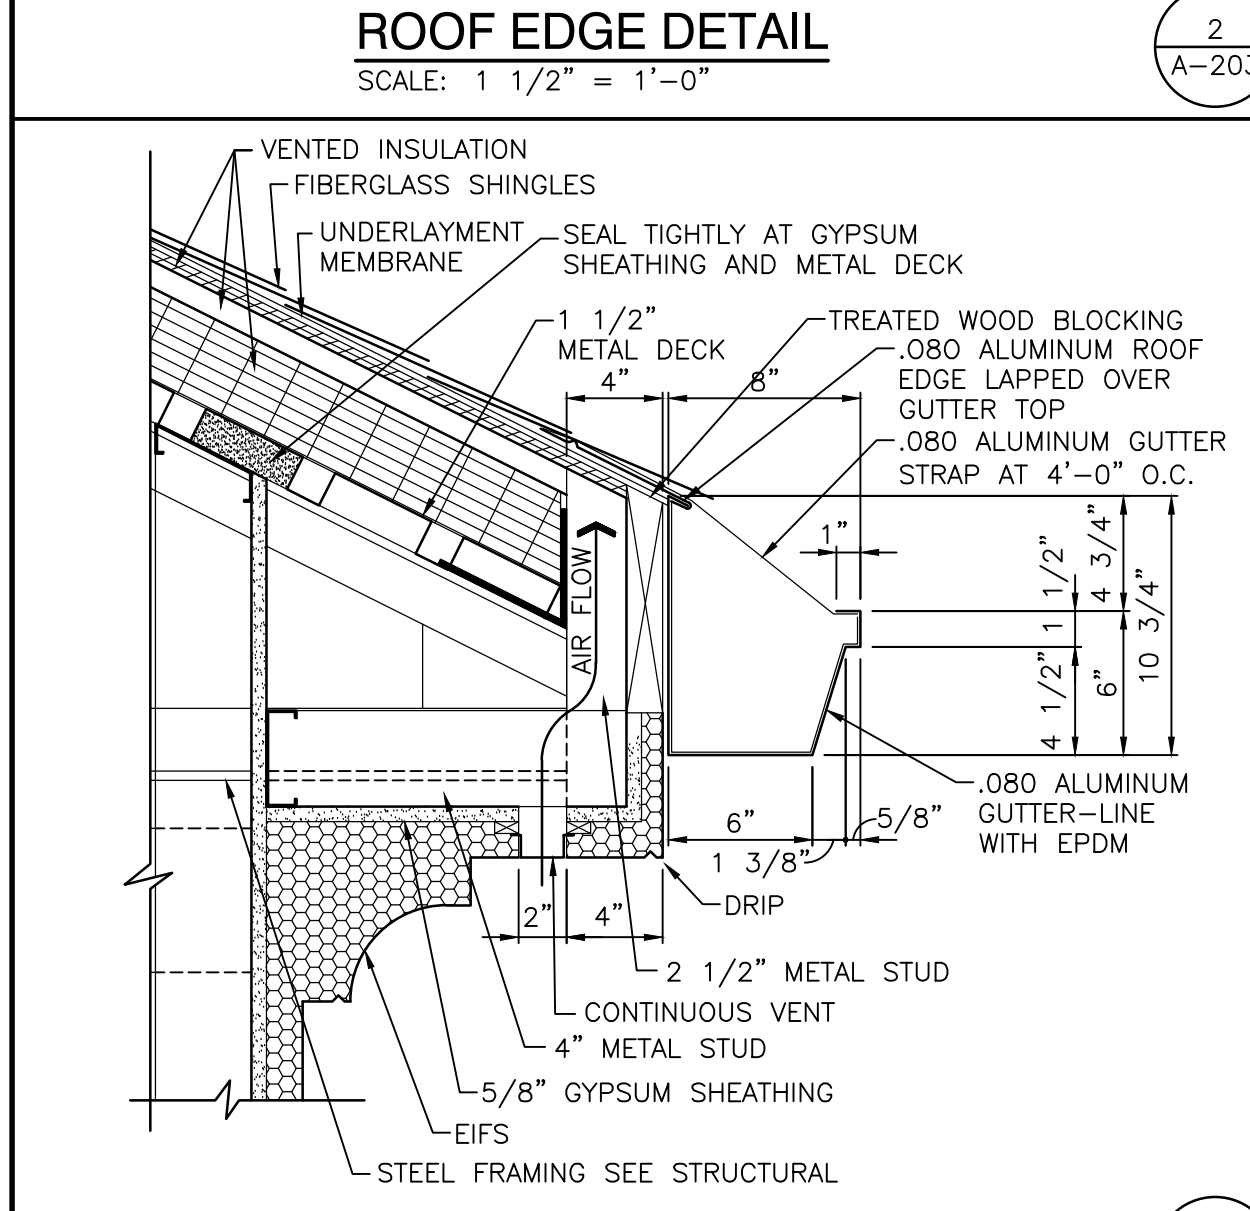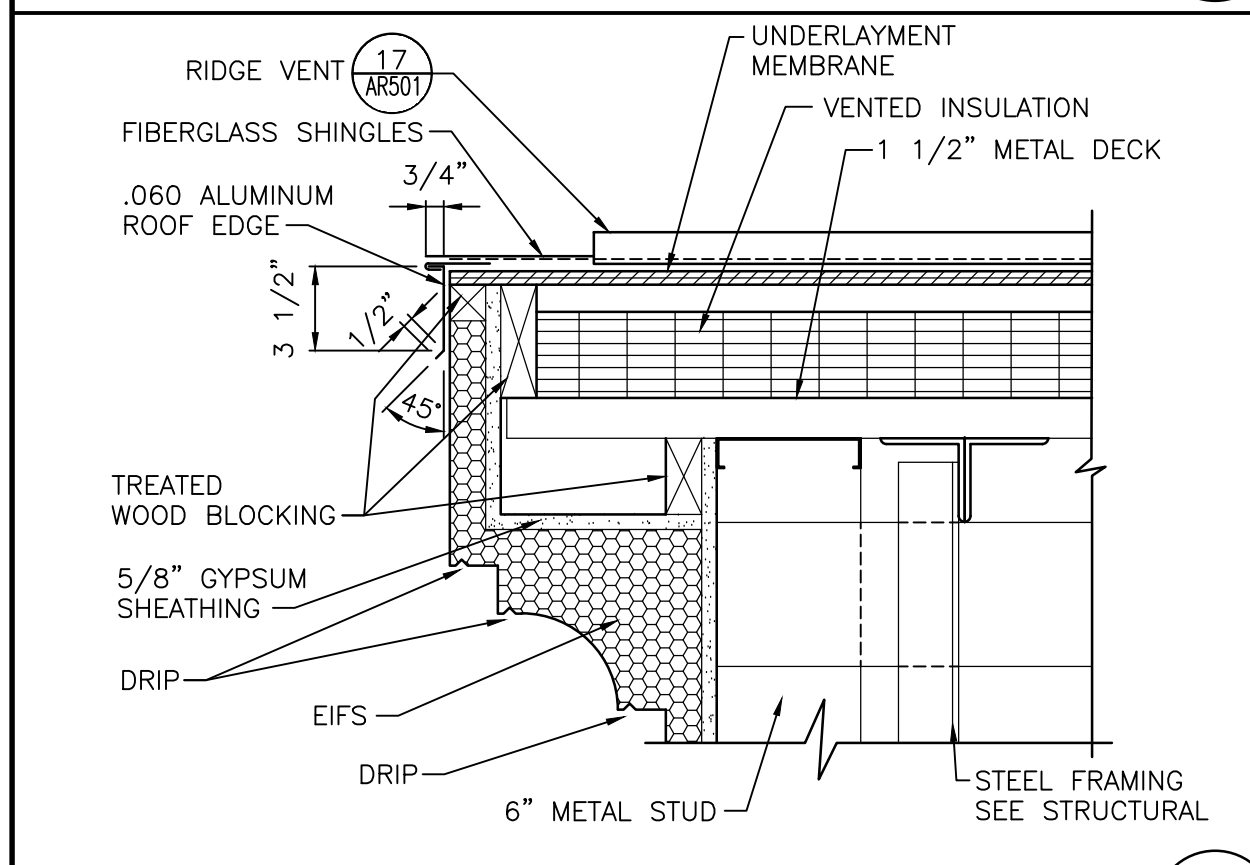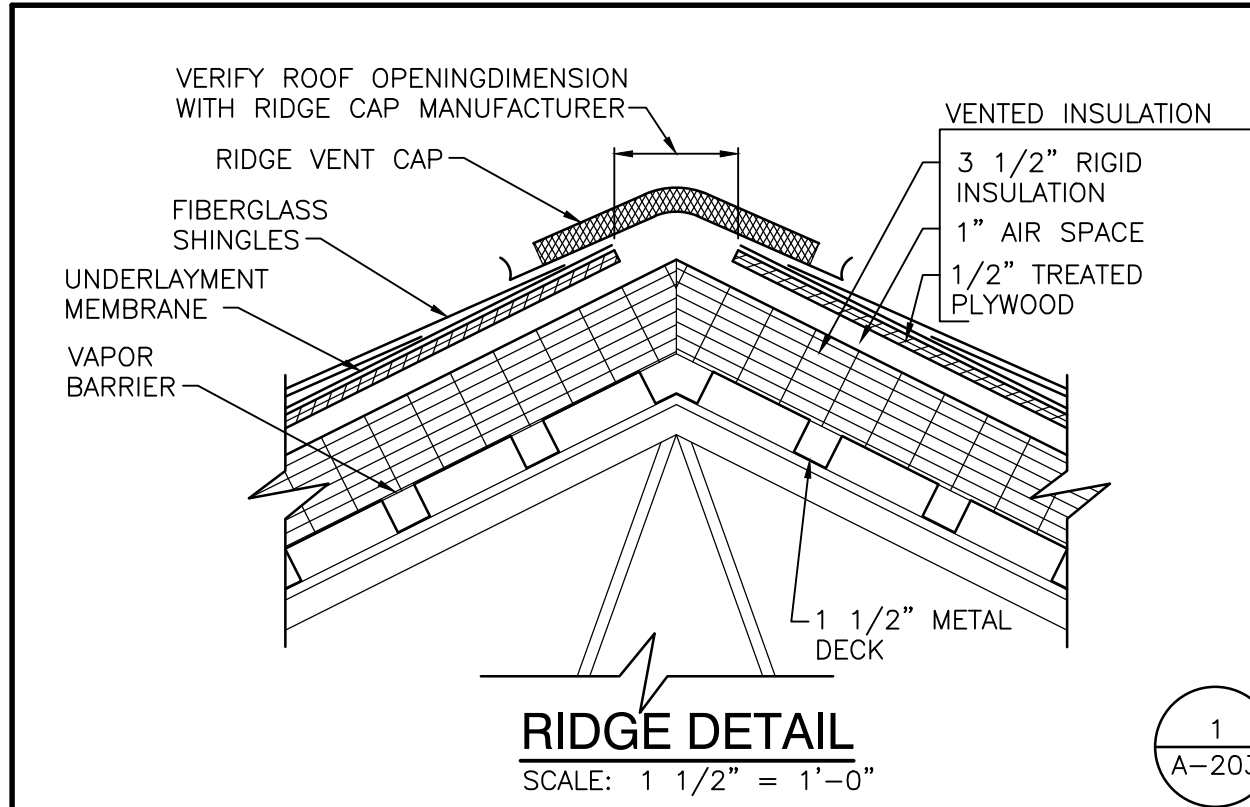


- ROOF PLAN NOTES:**
(ALL PLAN NOTES MAY NOT BE INDICATED ON THIS SHEET.)
- 1 COPING CAP
 - 2 GUTTER AND SOFFIT
 - 3 GUTTER AND SOFFIT
 - 4 GUTTER AND FLASHING
 - 5 ROOF EXPANSION JOINT
 - 6 EXTERIOR ALUMINUM LADDER
 - 7 FLASHING
 - 8 BUILT UP PARAPET WALL AT DEMOLISHED ENTRY CANOPY LOCATION, PARAPET CONSTRUCTION, HEIGHT, COPING, MATERIALS, AND COLORS TO MATCH EXISTING/ADJACENT CONDITIONS.

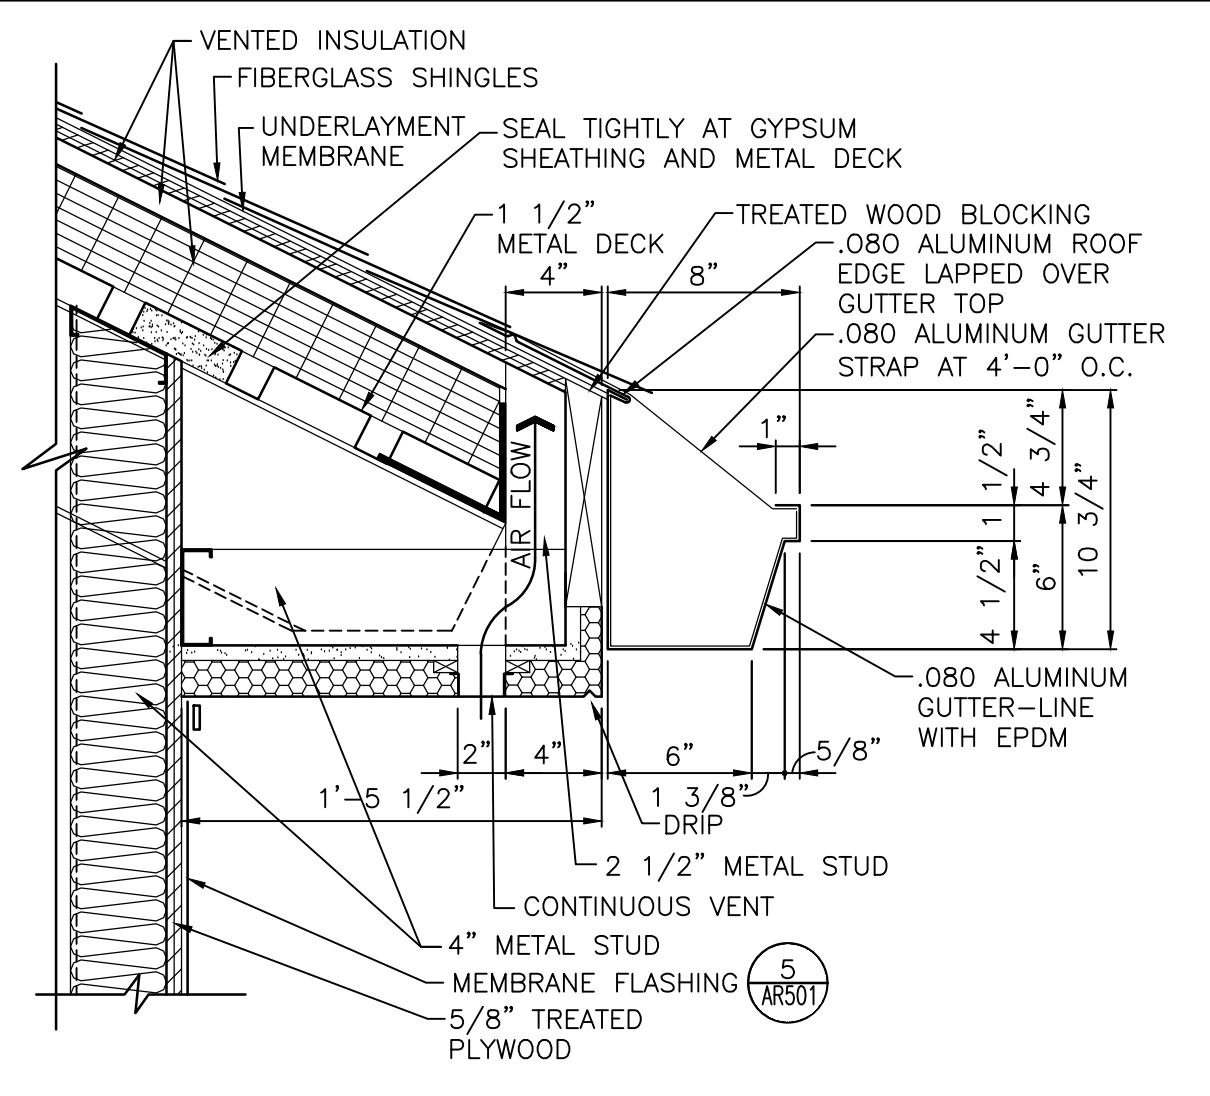

- GENERAL ROOF PLAN NOTES:**
- FOR GENERAL NOTES, MATERIAL INDICATIONS LEGEND, SYMBOL LEGEND, ABBREVIATIONS, ETC. SEE SHEET G1201.
 - THERE MAY BE LOCATIONS ON THE EXISTING ROOF WHERE THE EXISTING ROOF DECK MAY NOT BE STRUCTURALLY SOUND. CONTRACTORS SHOULD USE EXTREME CAUTION IN WORKING THESE ROOF AREAS TO MAINTAIN SAFE WORKING CONDITIONS.
 - CONTRACTOR SHALL VERIFY ALL DIMENSIONS, CLEARANCES AND ALL EXISTING FIELD CONDITIONS BEFORE STARTING CONSTRUCTION. COMMENCEMENT OF WORK CONSTITUTES ACCEPTANCE OF CONDITIONS. SHOULD DIFFERENT CONDITIONS BE ENCOUNTERED, CONTACT THE ARCHITECT BEFORE PROCEEDING WITH WORK.
 - THE ROOFING CONTRACTOR SHALL BE RESPONSIBLE FOR THE REPAIR OR REPLACEMENT OF ALL DAMAGE CAUSED BY THE IMPROPER STORAGE OR STACKING OF ROOFING MATERIALS.
 - ALL DIMENSIONS INDICATED ON THE ROOF PLAN ARE APPROXIMATE. THE CONTRACTOR IS RESPONSIBLE FOR OBTAINING ACCURATE FIELD MEASUREMENTS FOR THE EXECUTION OF HIS WORK AND PRIOR TO ANY FABRICATION OF THE VARIOUS MATERIALS.
 - THE ROOF CONTRACTOR SHALL PROTECT ALL ROOF DRAINS, SCUPPERS AND DOWNSPOUTS FROM DEBRIS CREATED DURING DEMOLITION AND/OR NEW CONSTRUCTION. THE ROOF CONTRACTOR SHALL INSPECT AND CLEAR ALL DRAINS, SCUPPERS AND DOWNSPOUTS PRIOR TO COMPLETION OF WORK AND TO ENSURE THAT THEY ARE FREE OF DEBRIS AND ARE FUNCTIONING PROPERLY.
 - ROOF DRAIN LOCATION INDICATE DESIGN INTENT. COORDINATE LOCATIONS WITH STRUCTURAL AND MECHANICAL, ELECTRICAL AND PLUMBING DRAWINGS.
 - LOCATION AND QUANTITY OF ALL ROOF DRAINS, FLUES, VENTS, POWER AND GRAVITY VENTILATORS, ETC., SHALL BE VERIFIED BY THE CONTRACTOR IN THE FIELD.
 - FOR NEW AND/OR EXISTING PLUMBING VENT LOCATIONS REFER TO MECHANICAL ROOF PLANS.
 - EXTEND ALL PLUMBING VENTS SO THAT THE TOP IS A MINIMUM OF 12" ABOVE THE ROOFING MEMBRANE.
 - PROVIDE NEW FLASHING AND TWO PIECE COUNTER-FLASHING WHERE NEW ROOFING ABUTS A NEW OR EXISTING WALL, UNLESS OTHERWISE NOTED OR DETAILED.
 - PROVIDE FLASHING AND SADDLES FOR ALL EQUIPMENT PROVIDED UNDER MECHANICAL.
 - FLASHING OF ALL VENTS, FAN CURBS, MASONRY WALLS, FLUES, DRAINS, FASCIAS, ETC., SHALL BE PERFORMED IN ACCORDANCE WITH THESE SPECIFICATIONS AND DRAWINGS, AND WITH ROOFING MANUFACTURERS STANDARD DETAILS AND SPECIFICATIONS.
 - CONTRACTOR TO PROVIDE CRICKETS AND/OR ROOF SADDLES AS REQUIRED TO PROMOTE POSITIVE DRAINAGE AROUND ALL ROOF TOP PENETRATIONS.
 - SADDLES AND TAPERED INSULATION SYMBOLS INDICATE DESIGN INTENT TO SLOPES TO DRAIN. CONTRACTOR SHALL PROVIDE SUBMITTAL DRAWINGS FOR TAPERED INSULATION AND SADDLES TO ENSURE POSITIVE SLOPE.
 - ALL NEW WOOD BLOCKING AND NAILERS SHALL BE TREATED WOOD.
 - DEMOLITION AND REMOVAL OPERATIONS ARE TO BE PERFORMED CAREFULLY AND ALL PORTIONS OF THE BUILDING SHALL BE PROTECTED DURING THESE OPERATIONS. ITEMS TO BE REUSED AND REINSTALLED ARE TO BE CAREFULLY REMOVED AND STORED. DAMAGES INCURRED DURING REMOVAL OR STORAGE SHALL BE THE CONTRACTOR'S RESPONSIBILITY.
 - REMOVE ALL POWER VENTILATORS, FANS AND GRAVITY VENTILATORS. REPLACE ALL DETERIORATED, LOOSE, OR FAULTY WOOD BLOCKING. REPLACE AND EXTEND CURBS WITH NEW TREATED WOOD BLOCKING WITH TOP AT 12" MINIMUM ABOVE THE NEW ROOFING MEMBRANE. REINSTALL FANS AND VENTILATORS WITH "KORFUND ELASTO-RIB" VIBRATION ELIMINATOR, SET ON THE CURB TOP OF ALL POWER DRIVEN FANS AND VENTS.
 - REMOVE ALL EXISTING ROOF GRAVEL, RESIDUE, AND ALL PROJECTIONS WHICH WOULD PREVENT THE NEW ROOF INSULATION FROM LAYING FLAT OVER THE EXISTING ROOF SURFACES.
 - REMOVE AND CLEAN ROOF DRAIN STRAINERS AND CLAMP RINGS. REINSTALL AFTER NEW ROOF INSULATION AND ROOFING MEMBRANE ARE IN PLACE, ANY BROKEN OR MISSING ROOF DRAIN STRAINER SHALL BE REPLACED WITH A NEW STRAINER.
 - SEE MECHANICAL DRAWINGS FOR LOCATIONS OF ROOF TOP EQUIPMENT TO BE REMOVED.


- ROOF LEGEND:**
- ELEVATION TOP OF NEW ROOF DECK
 - ELEVATION TOP OF EXISTING ROOF DECK
 - RELIEF VENT
 - EXHAUST FAN
 - GRAVITY VENT
 - ROOF DRAIN
 - PLUMBING VENT
 - ROOF DRAINAGE SADDLE
 - PENTHOUSE
 - MECHANICAL UNIT
 - ELEVATION TOP OF EXISTING RELIEF VENT
 - EXISTING EXHAUST FAN
 - EXISTING GRAVITY VENT
 - EXISTING ROOF DRAIN
 - EXISTING PLUMBING VENT
 - EXISTING PITCH POCKET
 - EXISTING ROOF DRAINAGE SADDLE
 - EXISTING PENTHOUSE
 - EXISTING MECHANICAL UNIT
 - EXISTING ROOF HATCH
- INDICATES ROOF SLOPE (1/4" PER 12")
 - - INDICATES ROOF SADDLE SLOPE (1/2" PER 12")
- HATCH PATTERN INDICATES NEW ROOFING SYSTEM.
 HATCH PATTERN INDICATES RE-ROOF OF EXISTING ROOF.
 HATCH PATTERN INDICATES NEW ROOF AND/OR FLASHING MEMBRANE TO OVERLAP AND TIE INTO EXISTING ROOF MEMBRANE AS REQUIRED TO MAINTAIN EXISTING ROOF WARRANTY

- ROOF TYPES:**
- NEW FLAT METAL DECK; PROVIDE NEW ROOF SYSTEM. NEW ROOFING SYSTEM SHALL BE FULLY-ADHERED SINGLE-PLY MEMBRANE OVER 1/2" COVER BOARD OVER TAPERED (1/4" PER FOOT) POLYISOCYANURATE INSULATION WITH MINIMUM 1" THICKNESS AND MINIMUM AVERAGE THICKNESS OF 4".
 - NEW SLOPING METAL DECK; PROVIDE NEW ROOF SYSTEM. NEW ROOFING SYSTEM SHALL BE FULLY-ADHERED SINGLE-PLY MEMBRANE OVER 1/2" COVER BOARD OVER 4" POLYISOCYANURATE INSULATION.
 - EXISTING ROOF SYSTEM SHALL REMAIN EXCEPT AS NOTED. PROTECT FROM ADJACENT ROOF WORK.
 - FIBERGLASS SHINGLE ROOFING ON TWO LAYERS OF #15 FELT ON VENTED ROOF SYSTEM ON SLOPING METAL DECK (6/12 SLOPE).

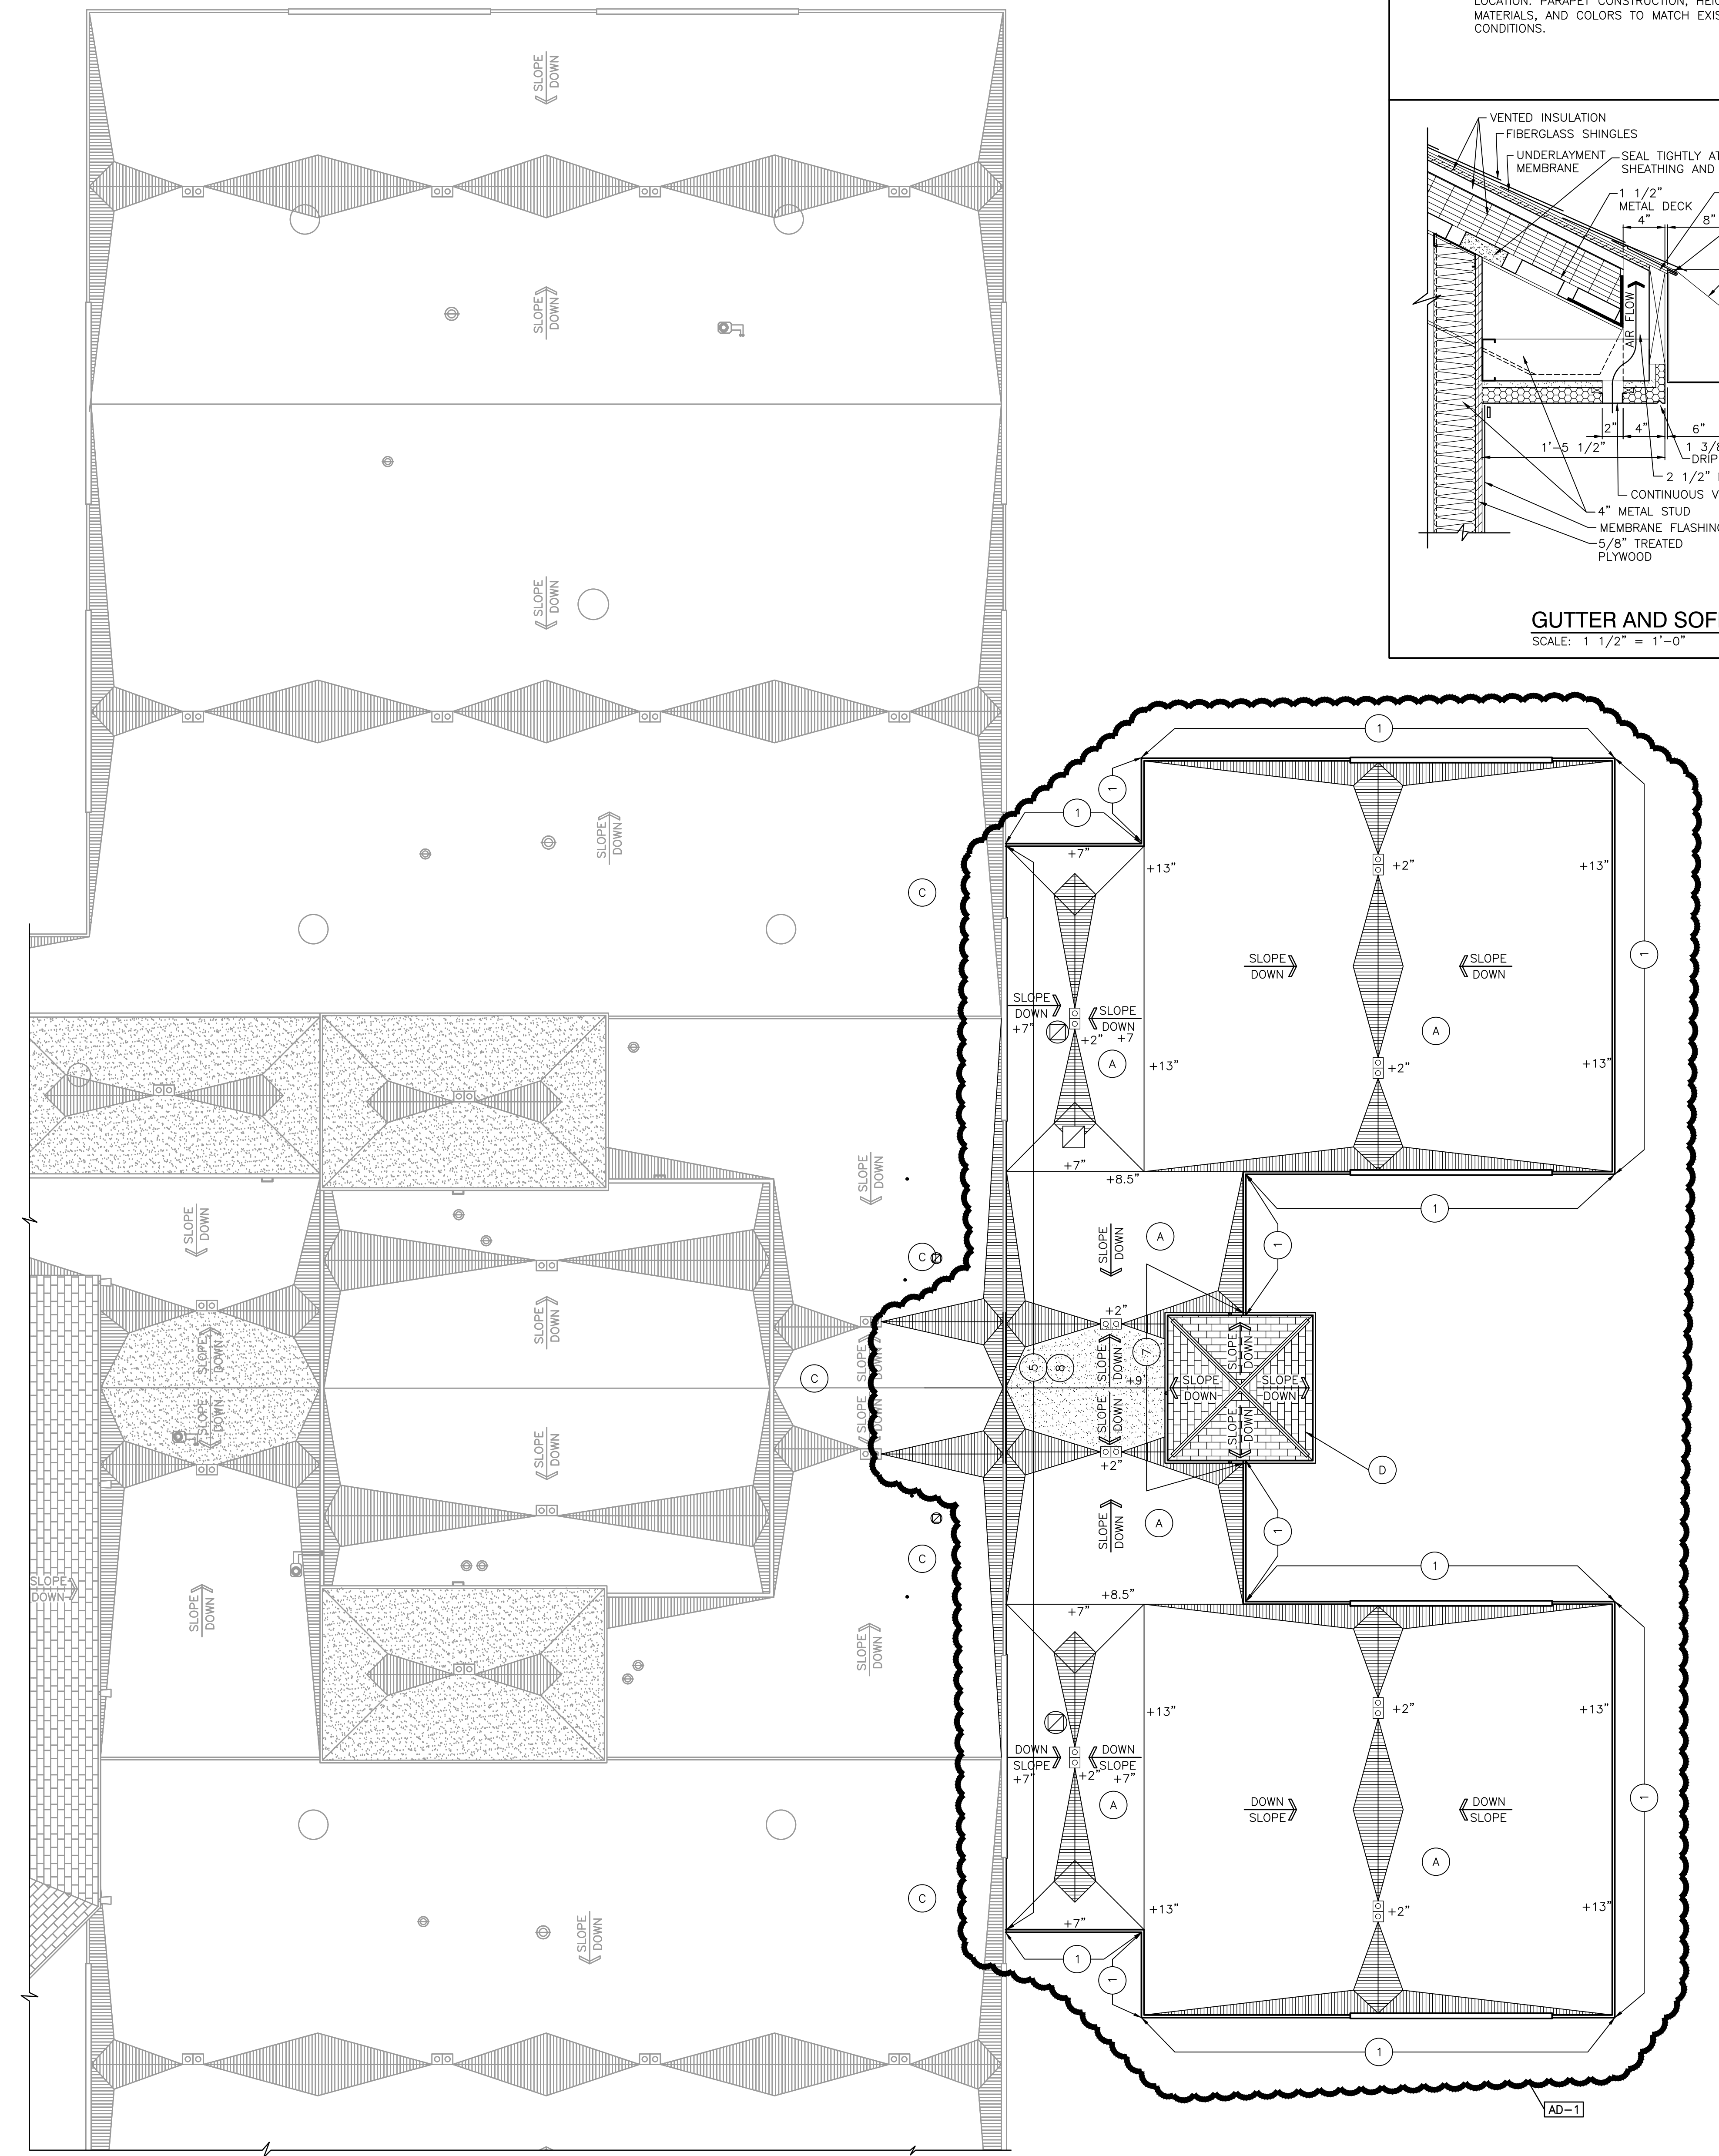

GIBRALTAR DESIGN
ARCHITECTURE • ENGINEERING • INTERIOR DESIGN

PROJECT
ADDITIONS AND RENOVATIONS TO
EDGEWOOD INTERMEDIATE SCHOOL
FRANKLIN TOWNSHIP COMMUNITY SCHOOL CORPORATION
INDIANAPOLIS, INDIANA

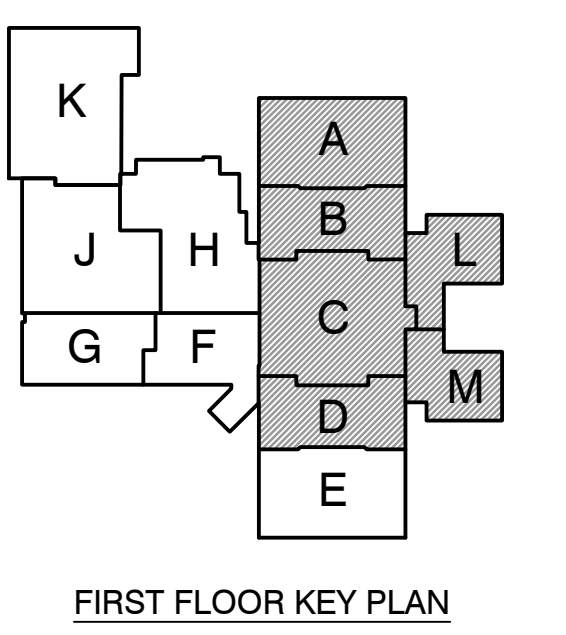

GIBRALTAR DESIGN
9102 N. Meridian St., Ste. 300
Indianapolis, IN 46260
Homepage: www.GibraltarDesign.com
Email: info@GibraltarDesign.com
Phone: 317.580.5777 Fax: 317.580.5778

PROJECT: 21-155
DATE: 05/23/22
COORDINATED BY: DJW
DRAWN BY: JRH KS
CHECKED BY: DJW

REGISTERED ARCHITECT
DIE J. WAGNER
NO. 19600171
STATE OF INDIANA

REVISIONS

MARK	DATE	ISSUED FOR
AD-1	06/16/22	ADDENDUM NO. 1

DRAWING
UNITS "A", "B", "C", "D", "L",
AND "M" ARCHITECTURAL
ROOF PLAN


PROJECT
ADDITIONS AND RENOVATIONS TO
EDGEWOOD INTERMEDIATE SCHOOL

Wednesday, 6/15/2022, 4:57 PM - LAST SAVED BY: HARRIS
Y:\21-155 FRANKLIN TOWNSHIP CSC-EDGEWOOD IS
ADDITIONS AND RENOVATIONS\21-155 DRAWINGS\05
ARCH\A-203.DWG



GIBRALTAR
DESIGN
ARCHITECTURE • ENGINEERING • INTERIOR DESIGN


PROJECT
ADDITIONS AND RENOVATIONS TO
EDGEWOOD INTERMEDIATE SCHOOL
FRANKLIN TOWNSHIP COMMUNITY SCHOOL CORPORATION
INDIANAPOLIS, INDIANA

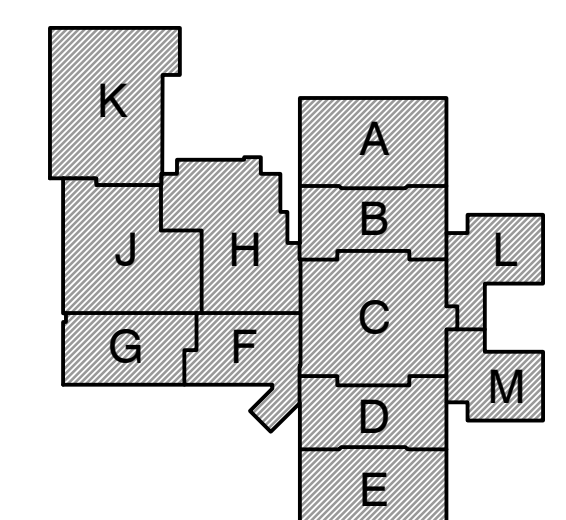

FIRST FLOOR KEY PLAN

GIBRALTAR DESIGN
9102 N. Meridian St., Ste. 300
Indianapolis, IN 46260
Homepage: www.GibraltarDesign.com
Email: info@GibraltarDesign.com
Phone: 317.580.5777 Fax: 317.580.5778

PROJECT: 21-155
DATE: 05/23/22
COORDINATED BY: DJW
DRAWN BY: JRH
CHECKED BY: DJW

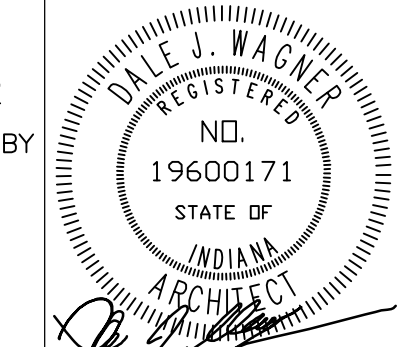

COPYRIGHT NOTICE:
THE CONCEPTS, DESIGNS, PLANS, DETAILS, ETC. SHOWN ON THIS DOCUMENT ARE THE PROPERTY OF GIBRALTAR DESIGN AND WERE CREATED FOR USE ON THIS SPECIFIC PROJECT. NONE OF THIS INFORMATION SHALL BE USED BY ANY PERSON OR FIRM FOR ANY PURPOSE WITHOUT THE EXPRESS WRITTEN CONSENT OF GIBRALTAR DESIGN. THE OWNER MAY RETAIN COPIES FOR INFORMATION AND REFERENCE IN CONNECTION ONLY WITH THIS PROJECT.

MARK	DATE	ISSUED FOR
AD-1	06/16/22	ADDENDUM NO. 1

DRAWING
EXTERIOR ELEVATIONS

PROJECT
ADDITIONS AND RENOVATIONS TO
EDGEWOOD INTERMEDIATE SCHOOL


© GIBRALTAR DESIGN SHEET
A-303

GENERAL ELEVATION NOTES:


- A. REFER TO STRUCTURAL DRAWINGS FOR FOUNDATION WALLS AND FOOTINGS.
- B. REFER TO FLOOR PLANS FOR EXTERIOR WALL SECTIONS CUTS, UNLESS INDICATED OTHERWISE.
- C. FOR LOCATION AND MOUNTING HEIGHTS OF CAMERAS, SPEAKERS, LIGHTS, HORNS, ETC. REFER TO ELECTRICAL AND TECHNOLOGY DRAWINGS.
- D. ALL NEW FACE BRICK SHALL BE MODULAR RUNNING BOND UNLESS NOTED OTHERWISE.
- E. FINISH GRADE INDICATES ON ELEVATIONS ARE FOR DRAWING PURPOSES ONLY. REFER TO CIVIL DRAWINGS FOR ACTUAL GRADES. COORDINATE STEPPED FLASHINGS WITH ACTUAL GRADES AS REQUIRED FOR CELL VENTS TO BE ABOVE GRADE.
- F. STEP BRICK LEDGE DOWN AS REQUIRED FOR LEDGE TO BE BELOW GRADE OR CONCRETE WALK. COORDINATE WITH CIVIL DRAWINGS.
- G. (CJ) INDICATES CONTROL JOINT. REFER TO DETAIL X/A-XXX
- H. (EJ) INDICATED BUILDING EXPANSION JOINT. REFER TO DETAIL X/A-XXX
- I. ALL VERTICAL CONTROL JOINTS IN EXISTING EXTERIOR BRICK WALL TO REMAIN ARE TO BE REMOVED AND PLACED WITH NEW SEALANT AND BACKER ROD.
- J. AT ALL EXISTING WINDOWS TO REMAIN, REMOVE PERIMETER SEALANT AND BACKER ROD AND INSTALL NEW SEALANT AND BACKER ROD.

ELEVATION KEY NOTES:


- (ALL PLAN NOTES MAY NOT BE INDICATED ON THIS SHEET.)
- 1 APPROXIMATE FINISH GRADE, REFER TO CIVIL DRAWINGS.
 - 2 FACE BRICK, MATCH BOND OF EXISTING BRICK - COLOR A.
 - 3 FACE BRICK, MATCH BOND OF EXISTING BRICK - COLOR B.
 - 4 FACE BRICK, SOLDIER COURSE - COLOR A.
 - 5 FACE BRICK, SOLDIER COURSE - COLOR B.
 - 6 CAST STONE SILL.
 - 7 INSET CAST STONE ACCENT.
 - 8 EIFS (COLOR C), REFER TO WALL SECTION DRAWINGS FOR THICKNESS.
 - 9 EIFS (COLOR D), REFER TO WALL SECTION DRAWINGS FOR THICKNESS.
 - 10 EIFS "V" GROOVE REVEAL/JOINT.
 - 11 FIBERGLASS SHINGLE ROOF MATERIAL TO MATCH EXIST.
 - 12 PREFINISHED ALUMINUM GUTTER AND DOWNSPOUT TO DRAIN ONTO EXISTING/ADJACENT ROOF BELOW. REFER TO ROOF PLAN FOR DOWNSPOUT LOCATIONS AND ADDITIONAL INFORMATION.
 - 13 PREFINISHED METAL COPING (COLOR A).
 - 14 WINDOW UNIT, REFER TO WINDOW FRAME ELEVATIONS.
 - 15 PREFINISHED ALUM. STOREFRONT SYSTEM WITH ALUM. DOORS, REFER TO FRAME ELEVATIONS AND DOOR SCHEDULE.
 - 16 SCHEDULED DOOR UNIT, REFER TO DOOR SCHEDULE AND FRAME ELEVATIONS.
 - 17 OVERHEAD DOOR UNIT, INSTALL PER MANUFACTURER RECOMMENDATIONS.
 - 18 WAYFINDING NUMBERS TO BE CENTERED ON ENTRANCE BELOW.
 - 19 32" X 48" LOUVER, COORDINATE WITH MECHANICAL DRAWINGS.
 - 20 ALUMINUM SIGNAGE LETTERS.

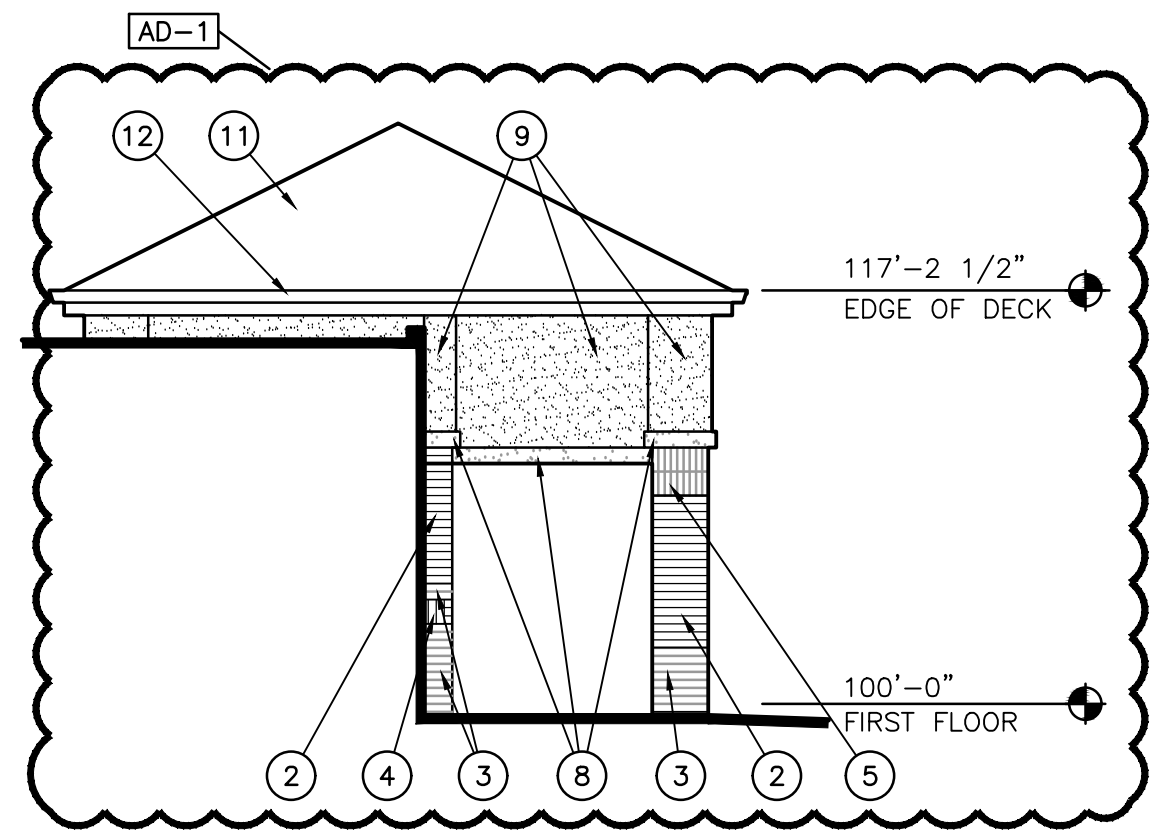


EXTERIOR ELEVATION - 19
SCALE: 1/8" = 1'-0"

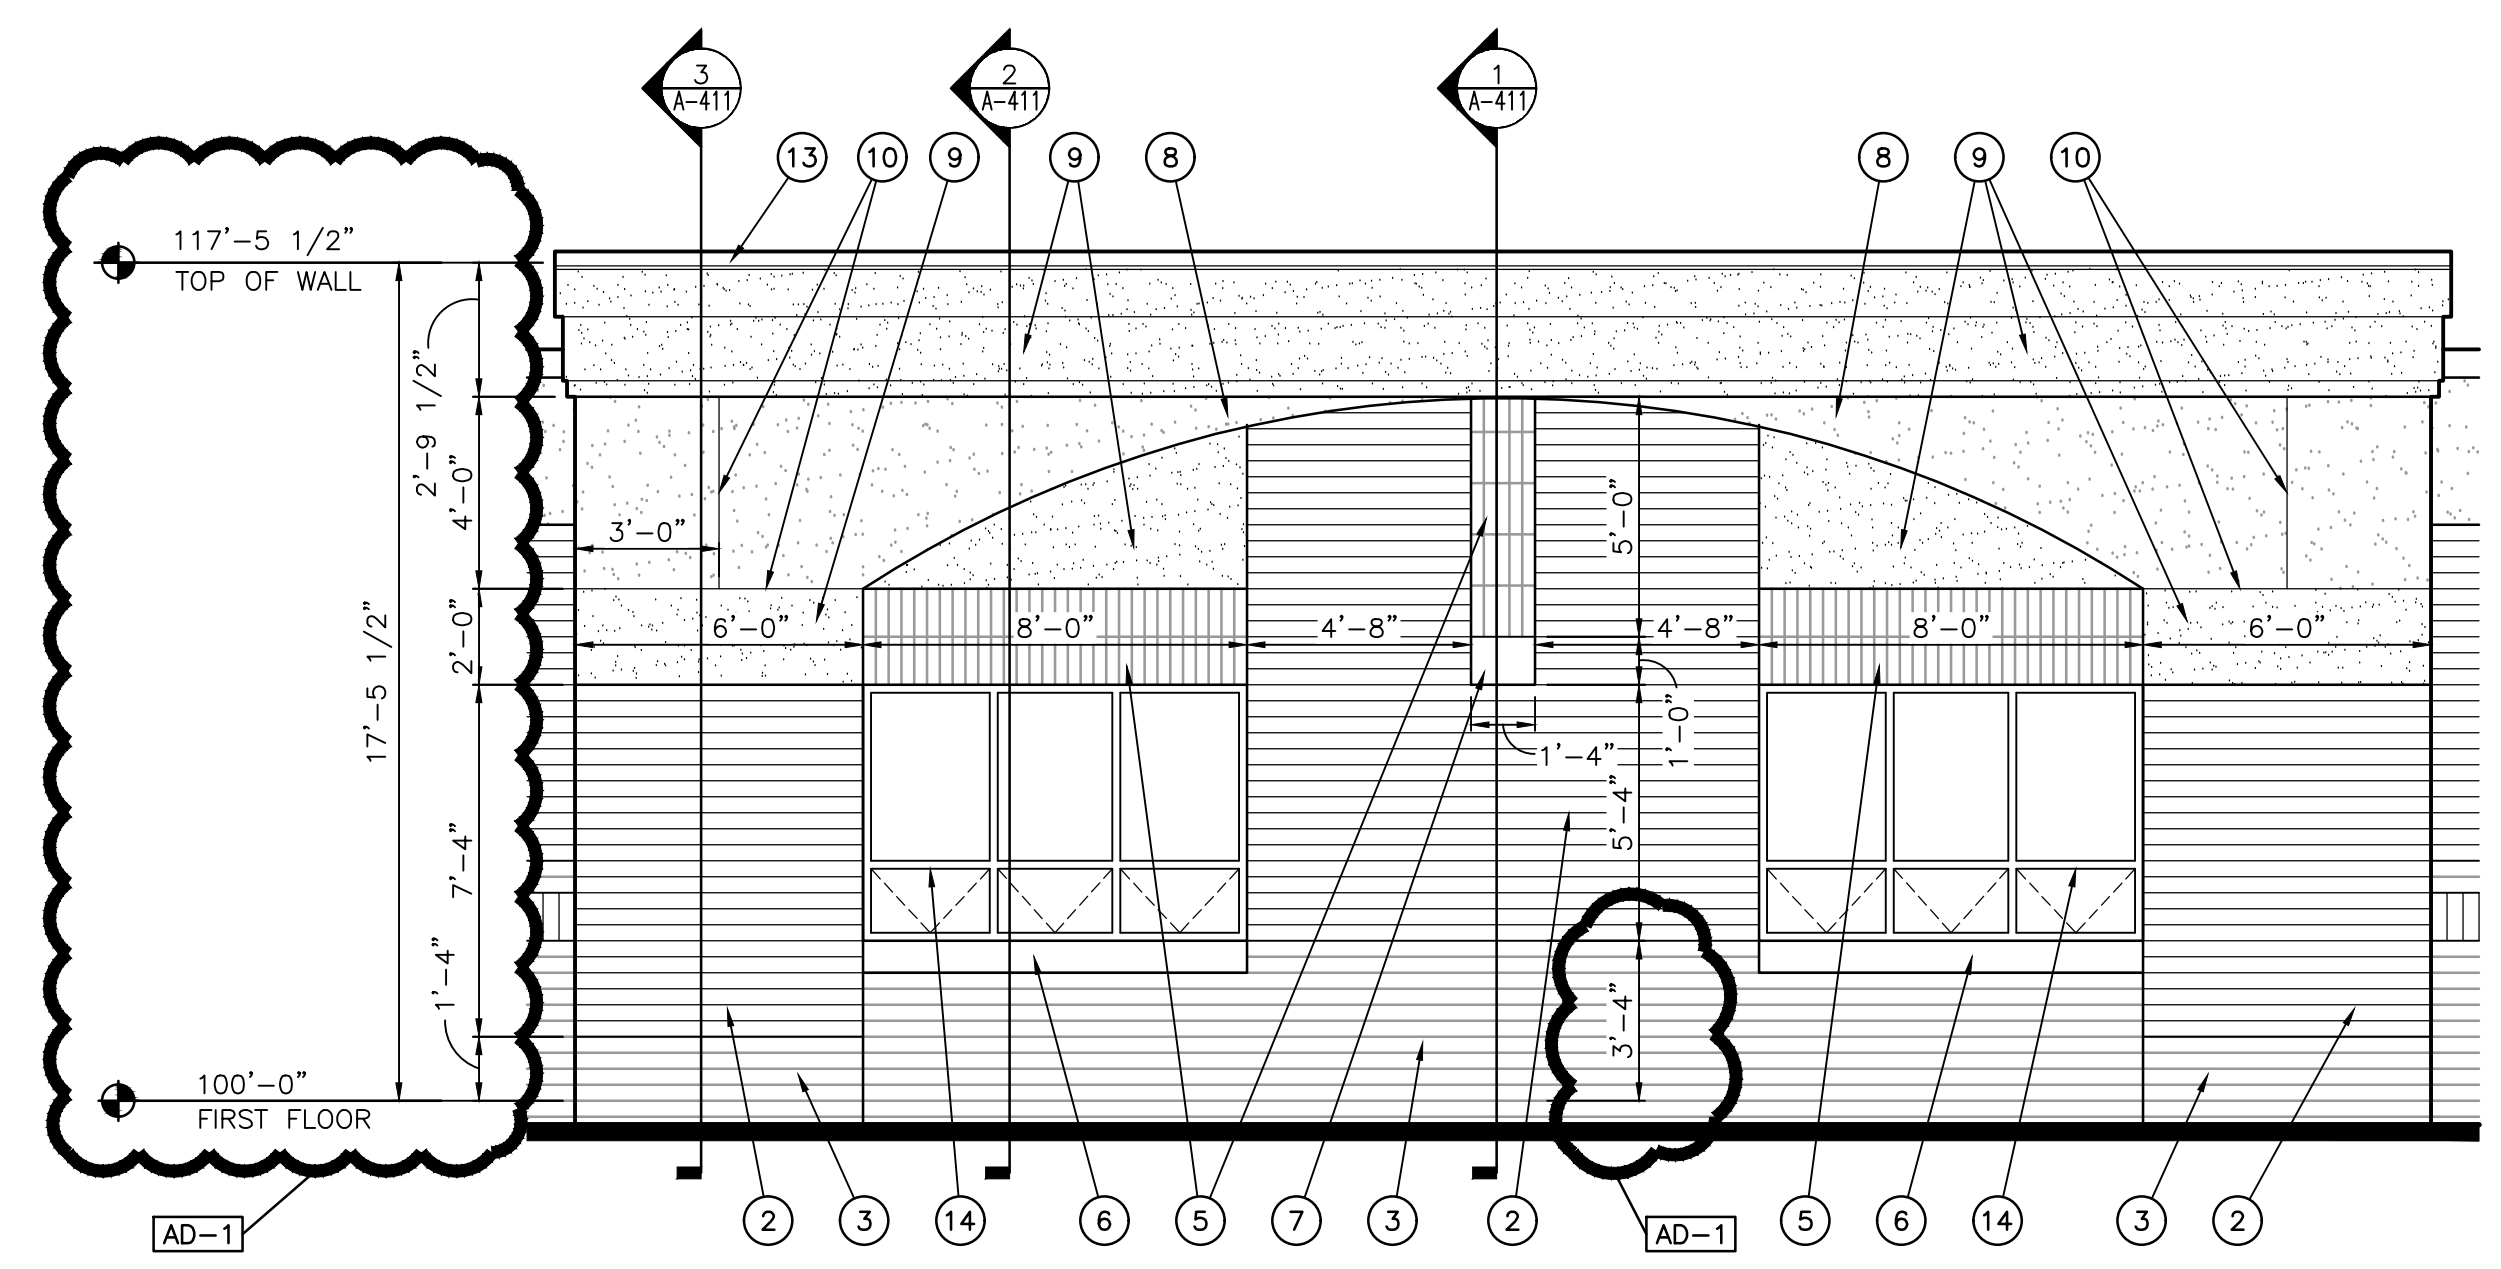


EXTERIOR ELEVATION - 19
SCALE: 1/4" = 1'-0"

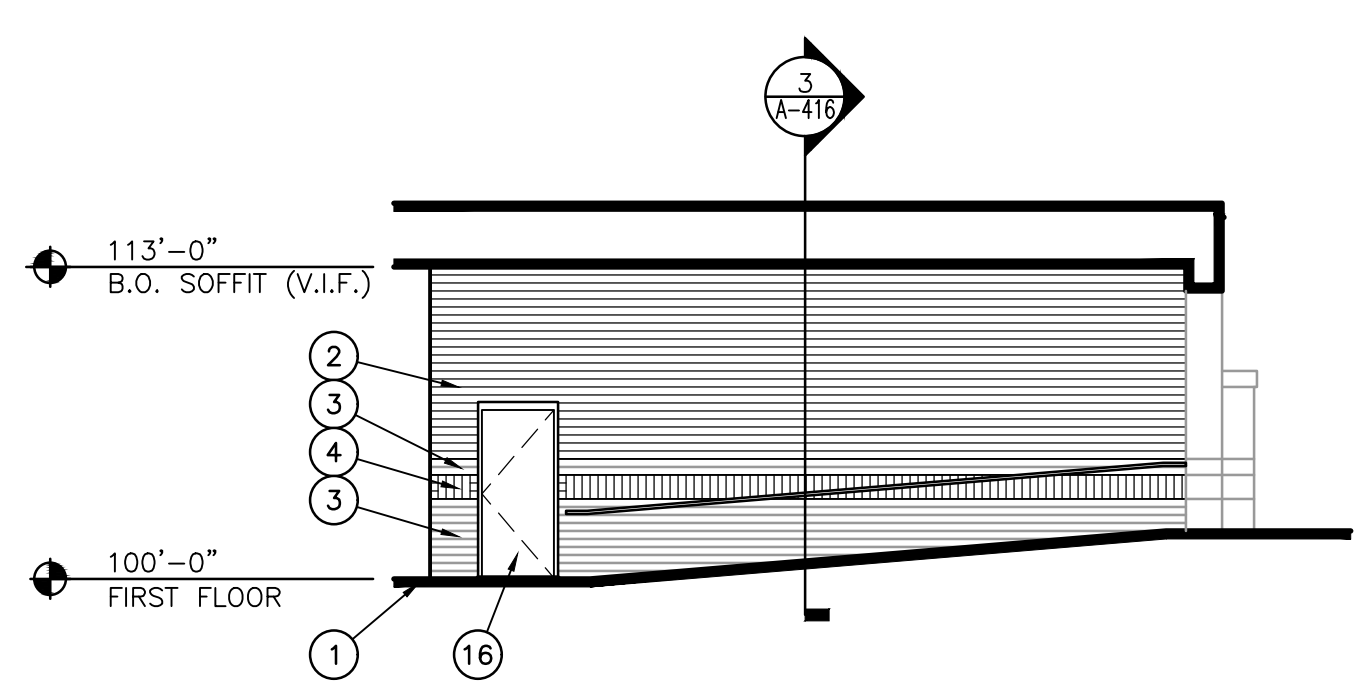


EXTERIOR ELEVATION - 18
SCALE: 1/8" = 1'-0"

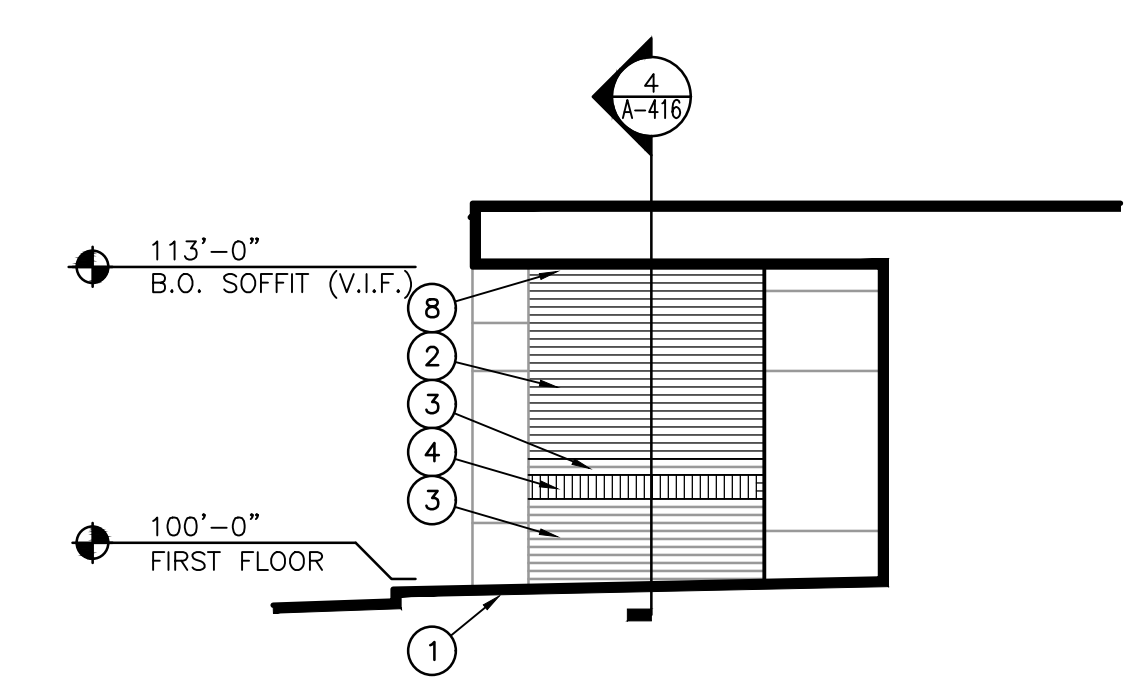

EXTERIOR ELEVATION - 18
SCALE: 1/8" = 1'-0"

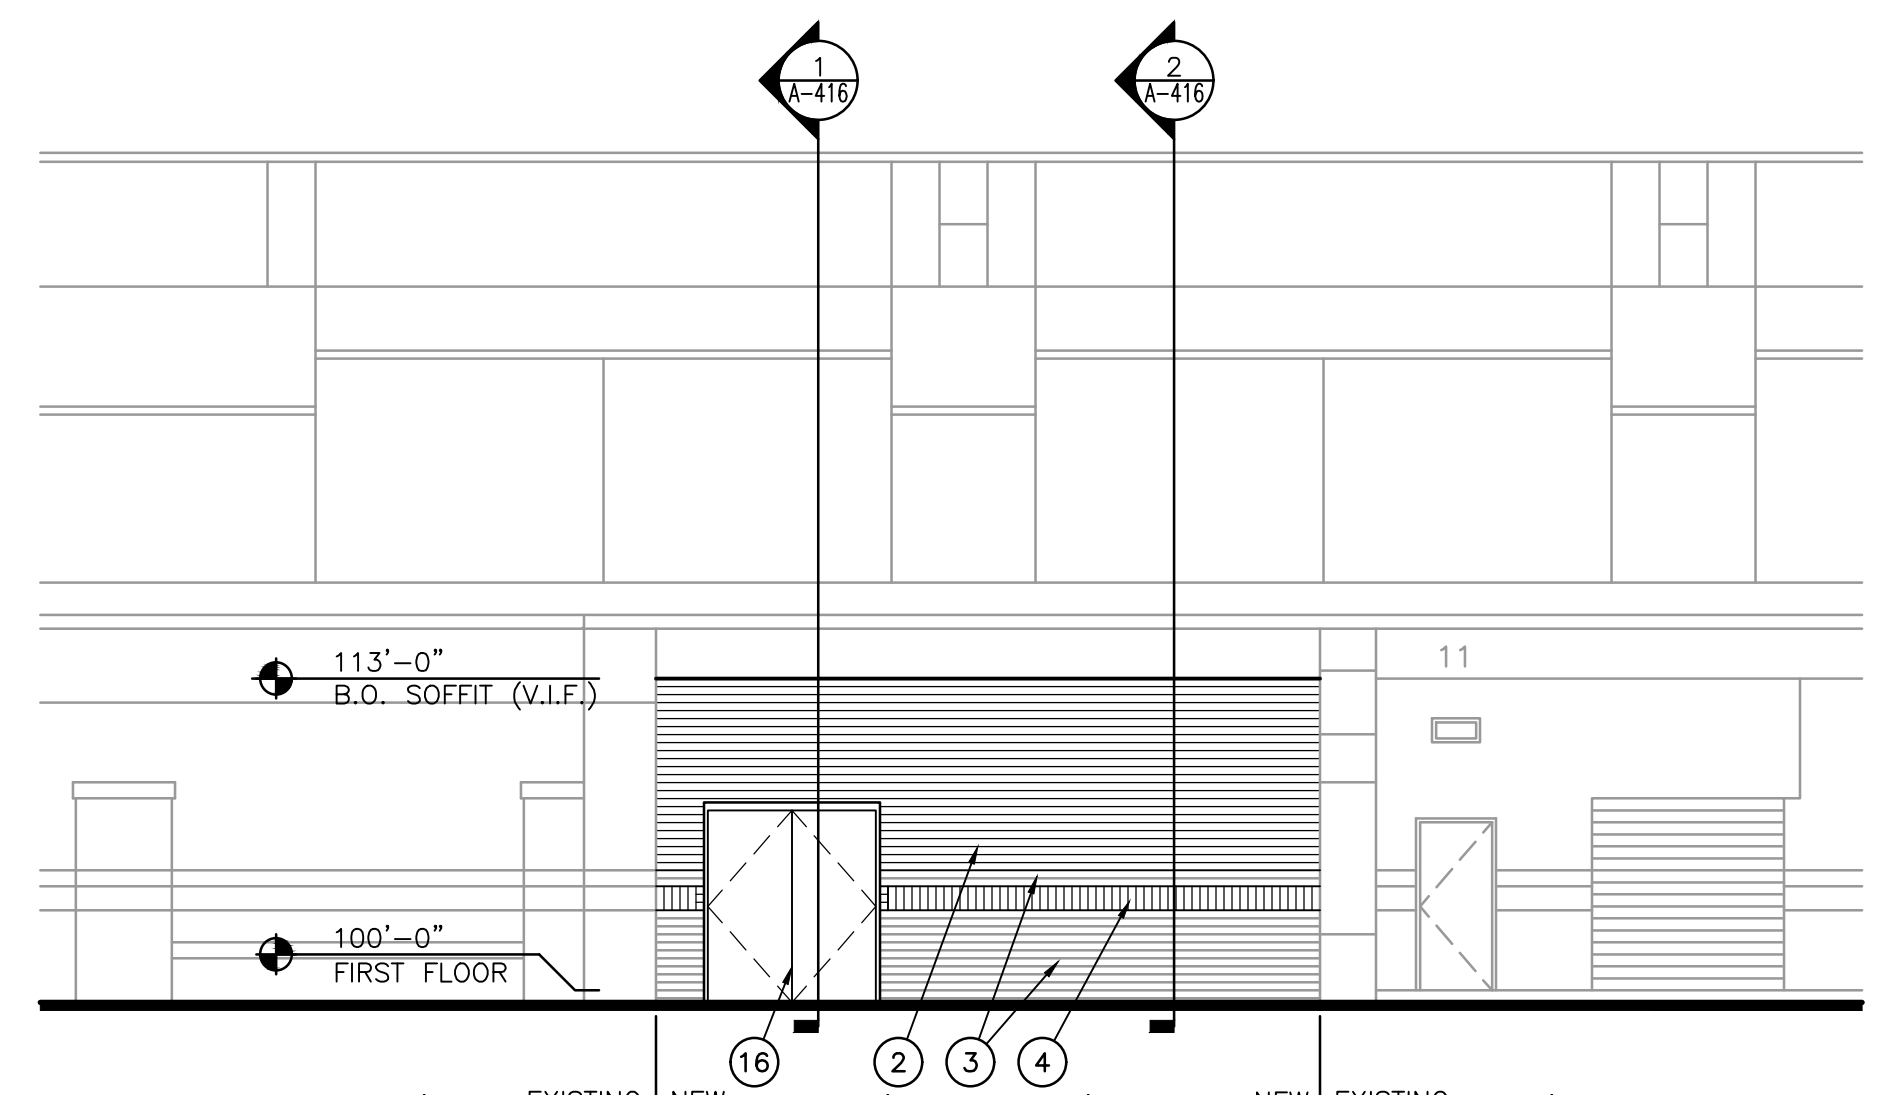


EXTERIOR ELEVATION - 16
SCALE: 1/8" = 1'-0"

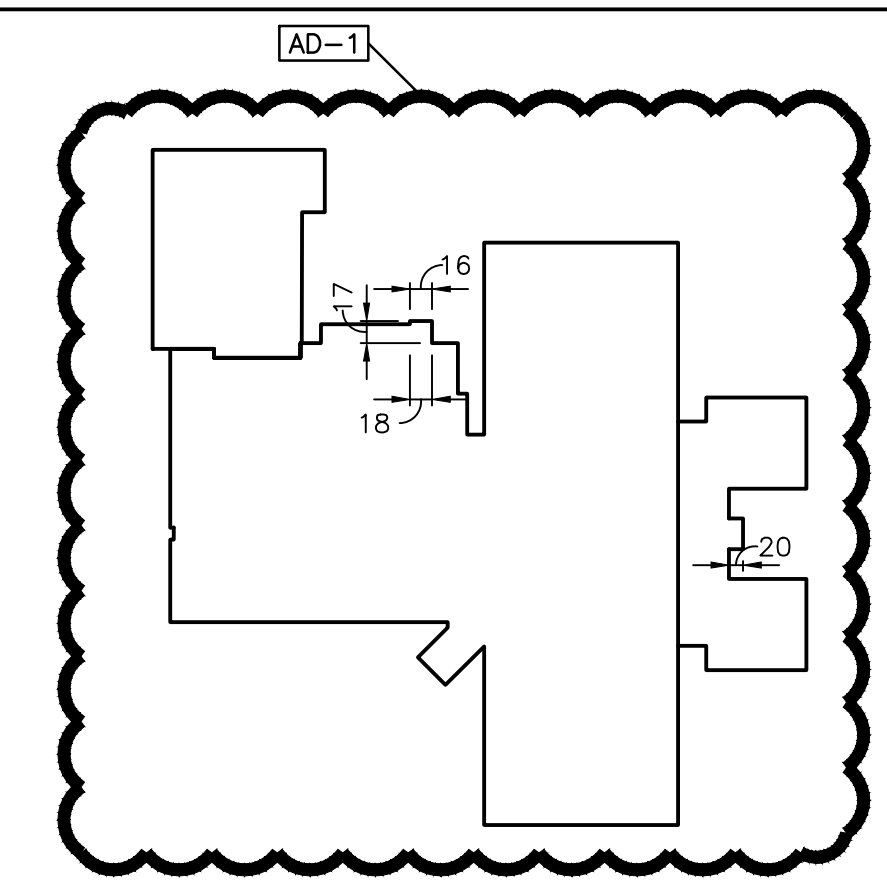


FIRST FLOOR KEY PLAN


Thursday, 6/16/2022 - 12:08 PM - LAST SAVED BY: JHARRIS
 Y:\21-155 FRANKLIN TOWNSHIP CSC-EDGEWOOD IS
 ADDITIONS AND RENOVATIONS\21-155 DRAWINGS\05
 ARCH\A-303.DWG

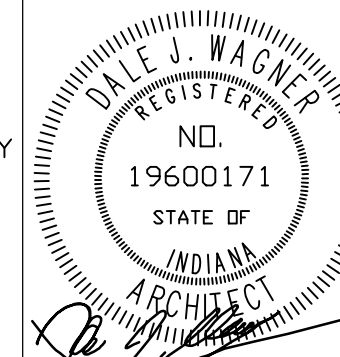


REVISIONS	MARK	DATE	ISSUED FOR
	AD-1	06/16/22	ADDENDUM NO. 1

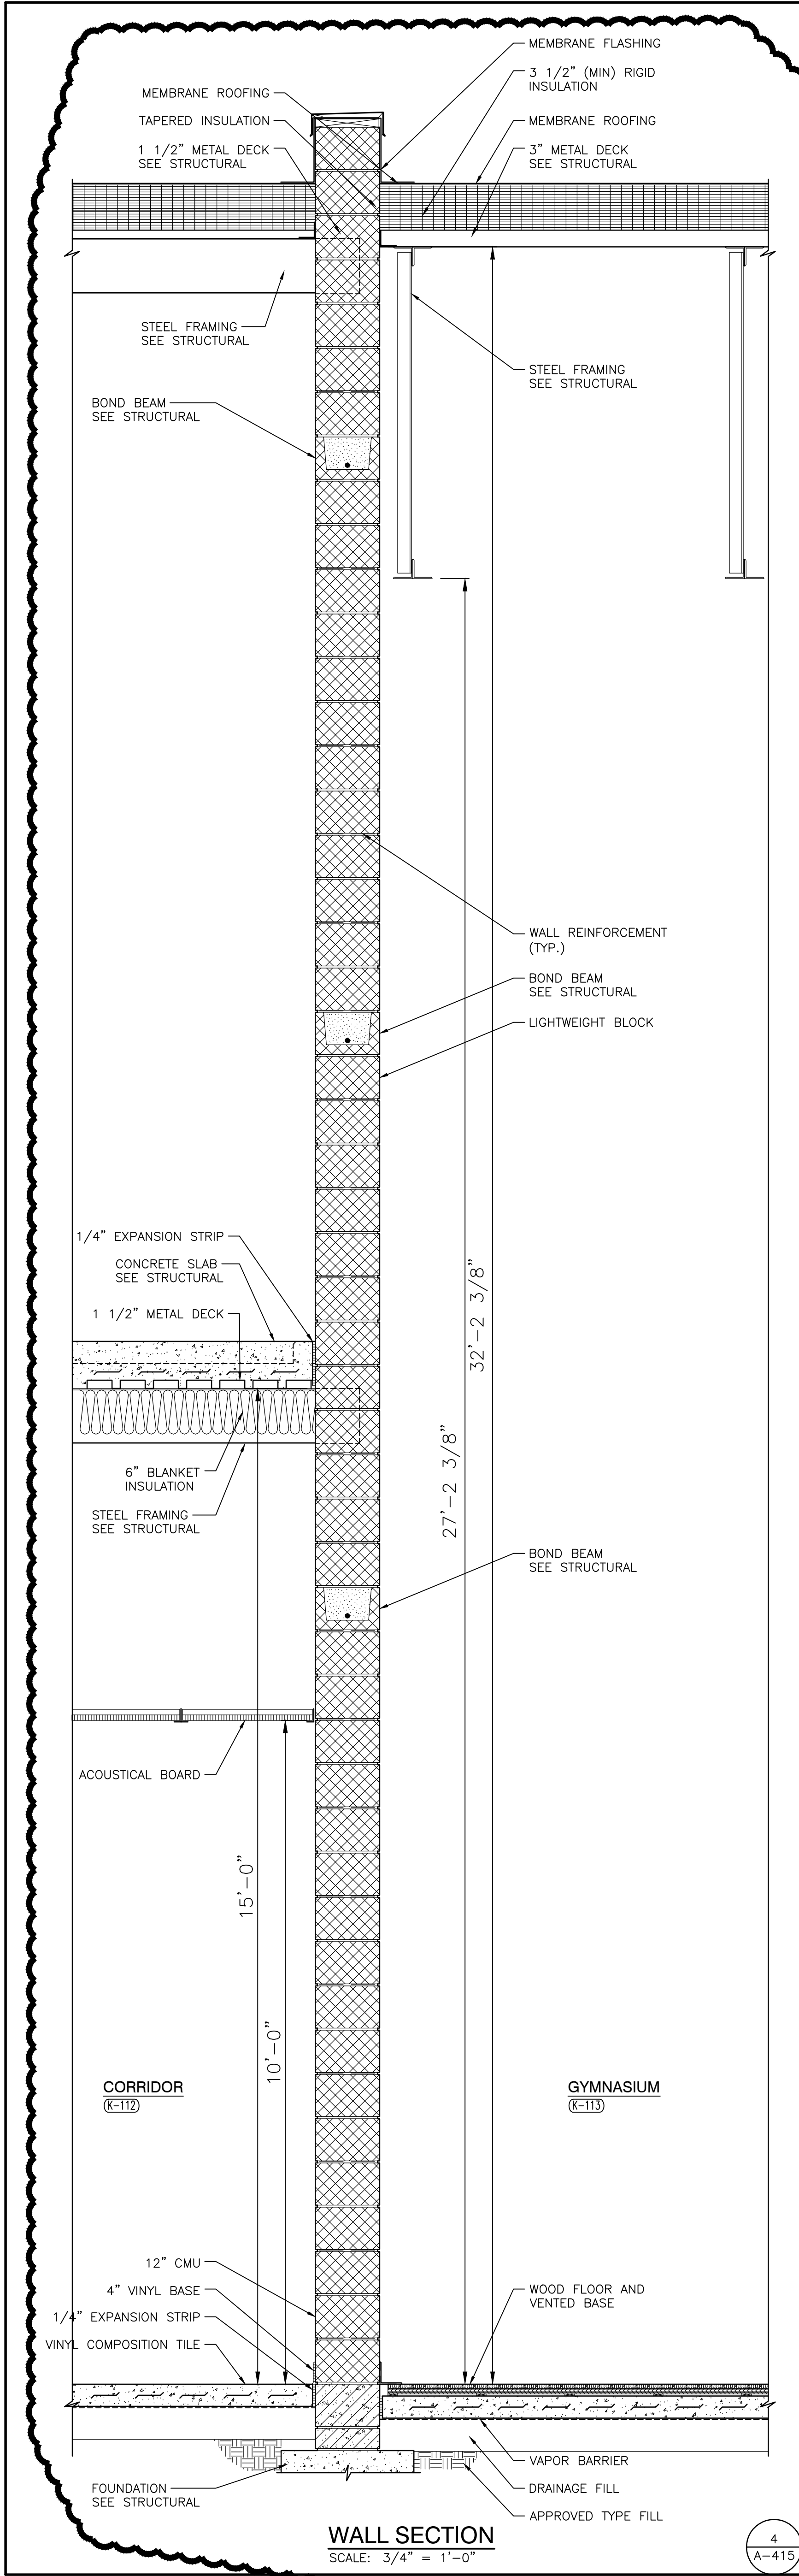


4
A-415

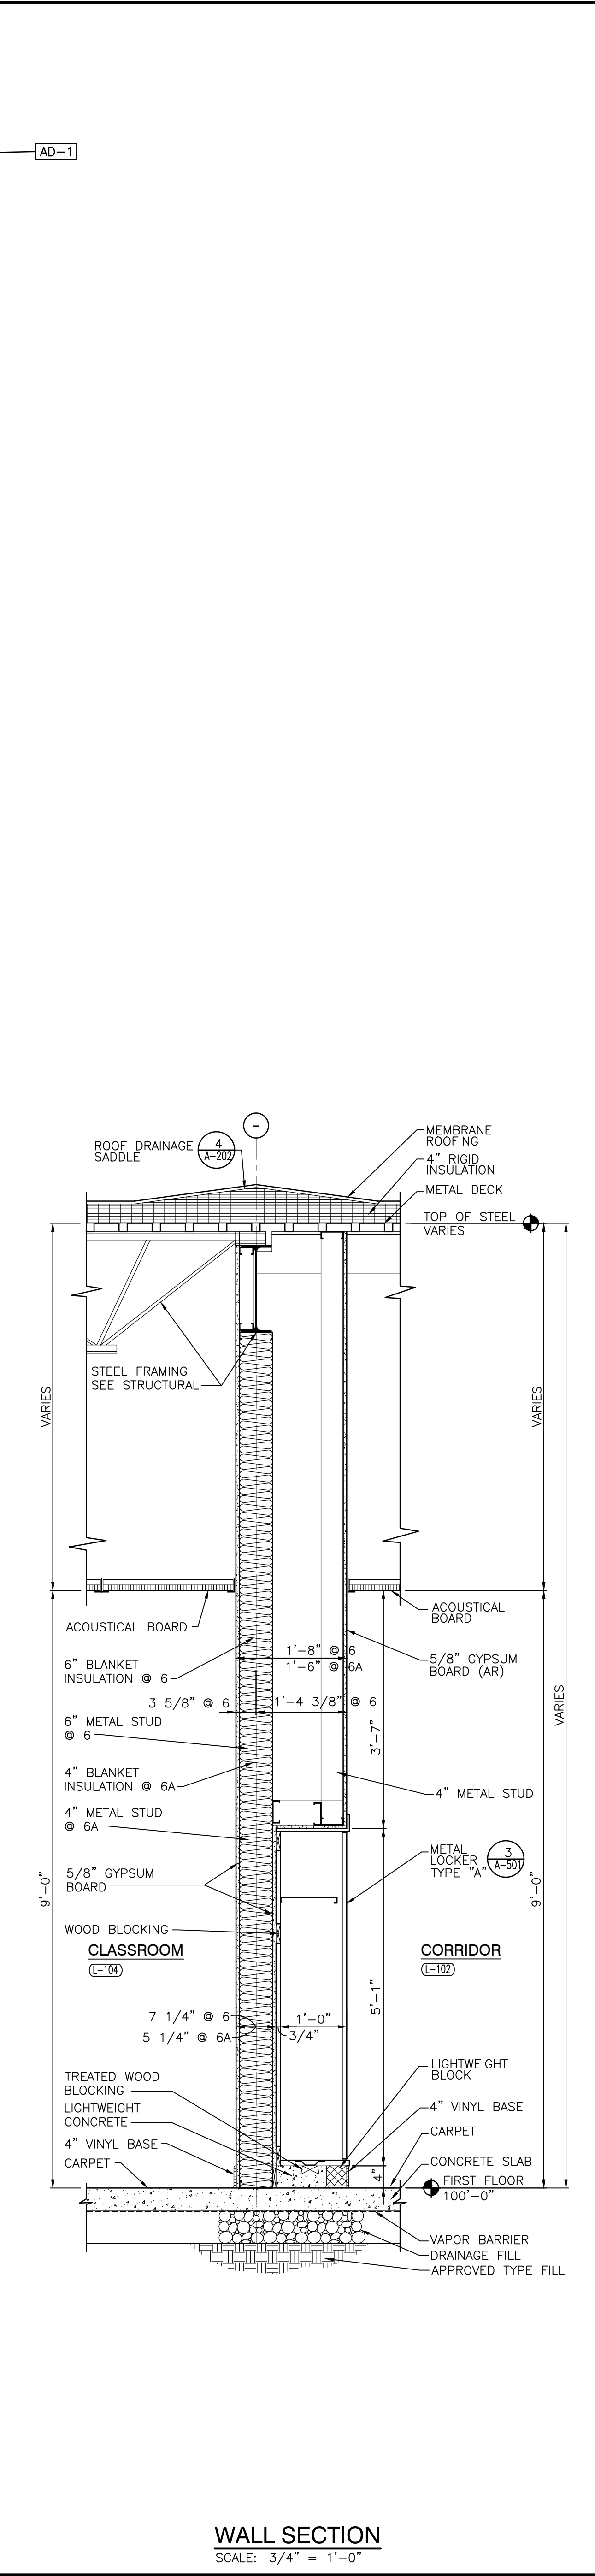

3
A-415

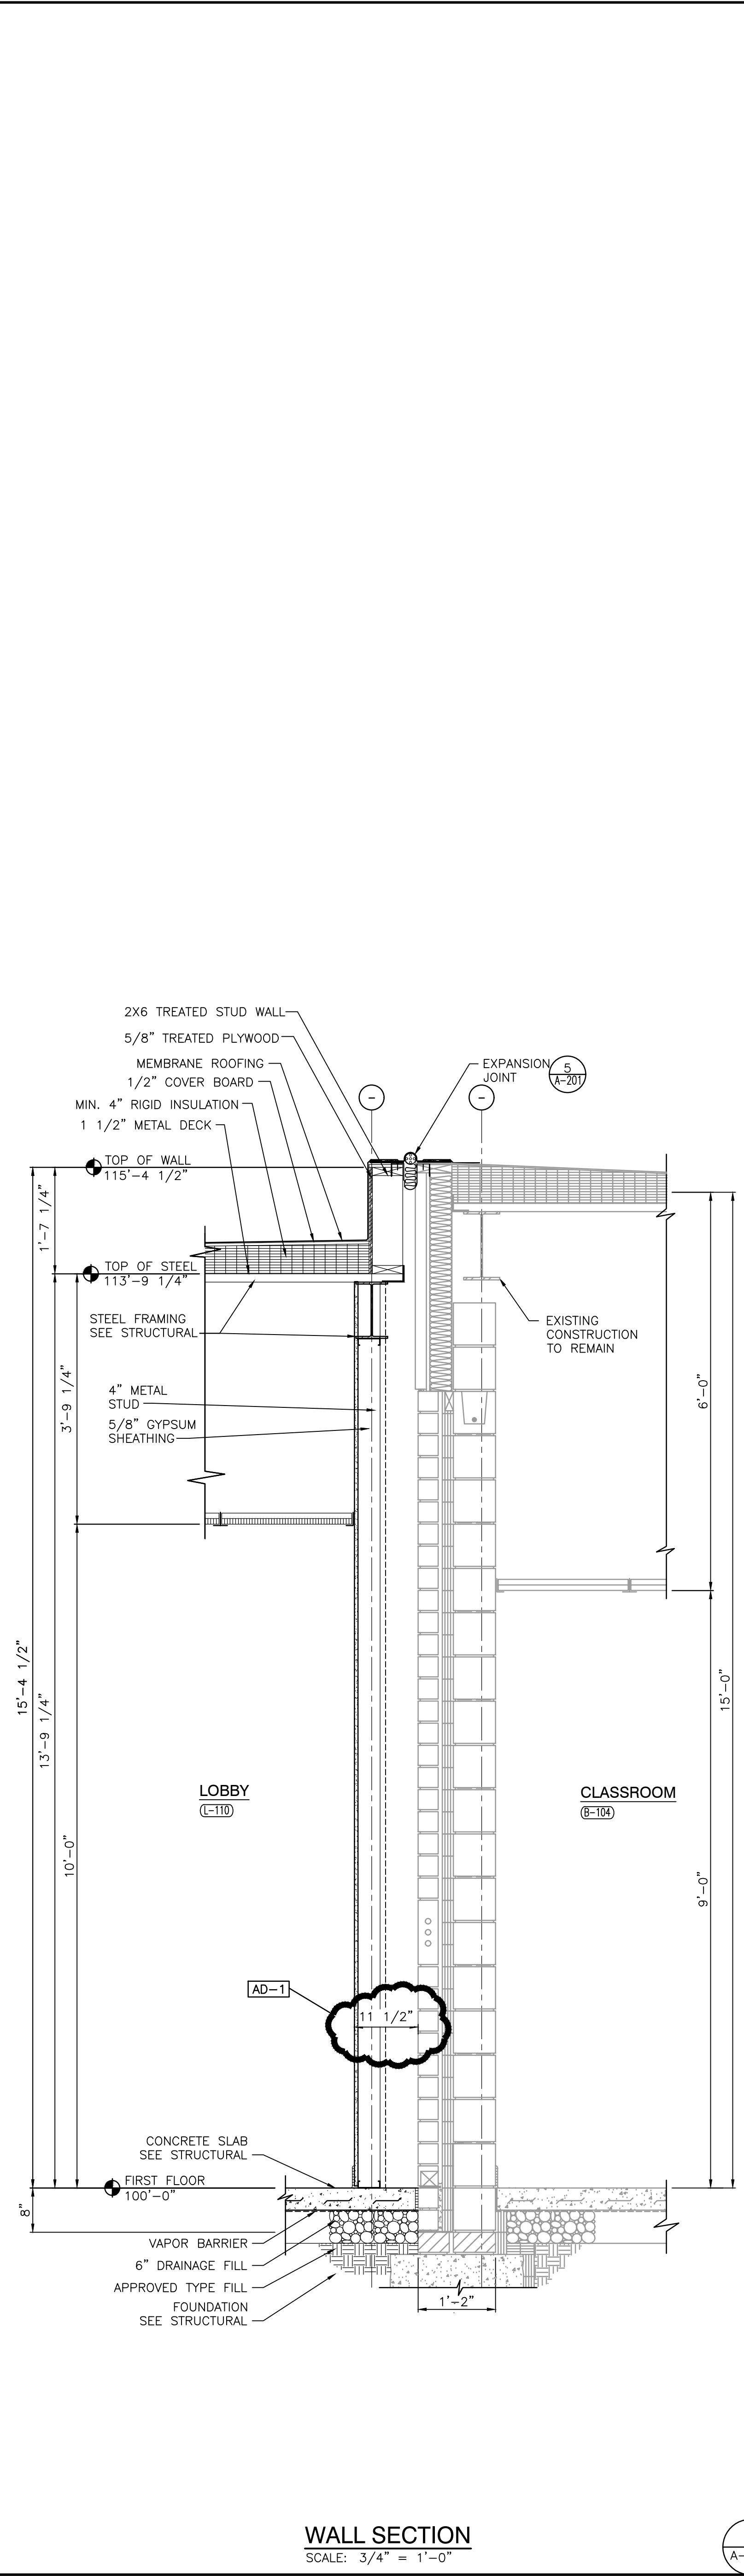

2
A-415

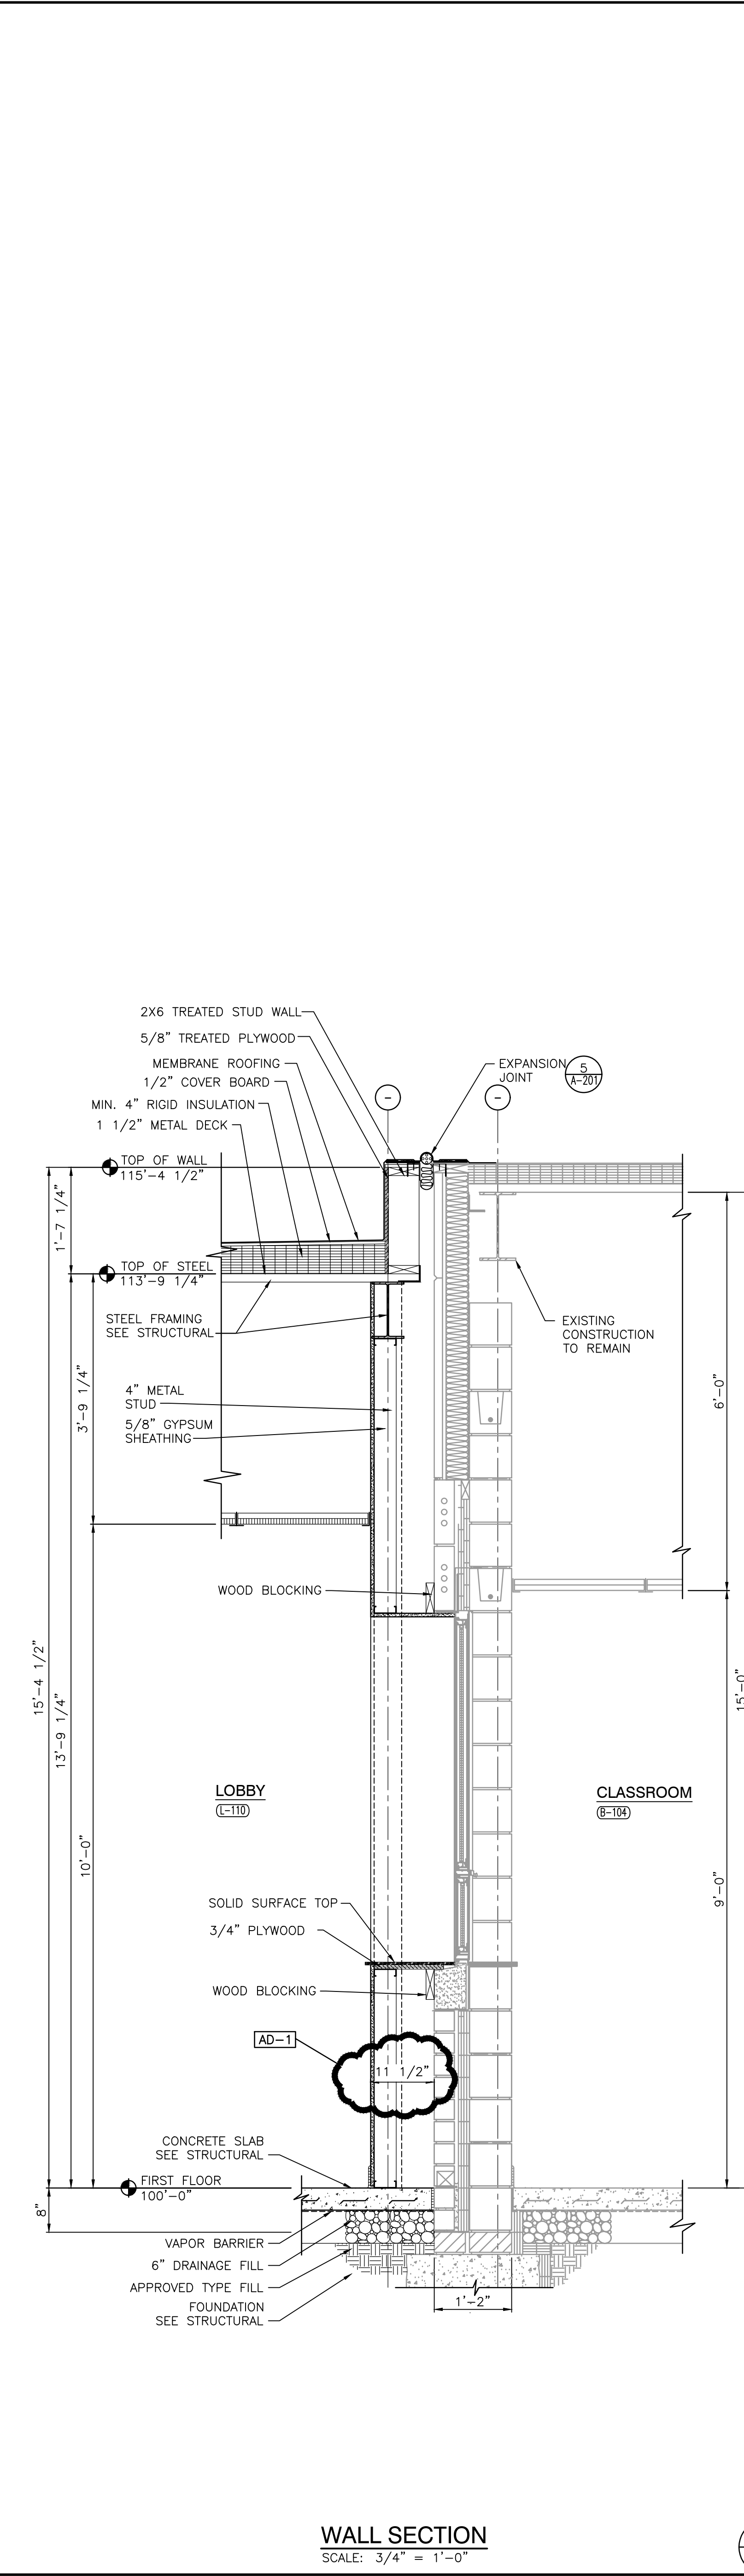

1
A-415

Wednesday, 6/15/2022 - 4:10 PM - LAST SAVED BY: HARRIS
 Y:\21-155 FRANKLIN TOWNSHIP CSC-EDGEWOOD IS
 ADDITIONS AND RENOVATIONS\21-155 DRAWINGS\05
 ARCH\A-415.DWG




GIBRALTAR DESIGN
ARCHITECTURE • ENGINEERING • INTERIOR DESIGN

PROJECT
ADDITIONS AND RENOVATIONS TO
EDGEWOOD INTERMEDIATE SCHOOL
FRANKLIN TOWNSHIP COMMUNITY SCHOOL CORPORATION
INDIANAPOLIS, INDIANA

GIBRALTAR DESIGN

9102 N. Meridian St., Ste. 300
Indianapolis, IN 46260
Homepage: www.GibraltarDesign.com
Email: info@GibraltarDesign.com
Phone: 317.580.5777 Fax: 317.580.5778

PROJECT: 21-155
DATE: 05/23/22
COORDINATED BY: DJW
DRAWN BY: JRH KS
CHECKED BY: DJW

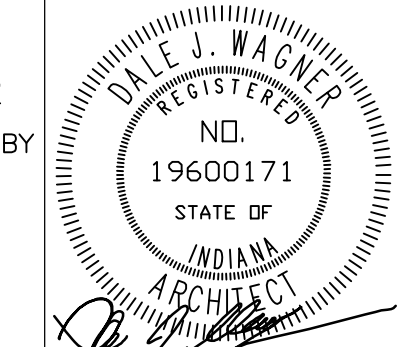





COPYRIGHT NOTICE:
THE CONCEPTS, DESIGNS, PLANS, DETAILS, ETC. SHOWN ON THIS DOCUMENT ARE THE PROPERTY OF GIBRALTAR DESIGN AND WERE CREATED FOR USE ON THIS SPECIFIC PROJECT. NONE OF THIS INFORMATION SHALL BE USED BY ANY PERSON OR FIRM FOR ANY PURPOSE WITHOUT THE EXPRESS WRITTEN CONSENT OF GIBRALTAR DESIGN. THE OWNER MAY RETAIN COPIES FOR INFORMATION AND REFERENCE IN CONNECTION ONLY WITH THIS PROJECT.

REVISIONS	MARK	DATE	ISSUED FOR
	AD-1	06/16/22	ADDENDUM NO. 1

DRAWING
WALL SECTIONS

PROJECT
ADDITIONS AND RENOVATIONS TO
EDGEWOOD INTERMEDIATE SCHOOL

GIBRALTAR DESIGN SHEET
A-417

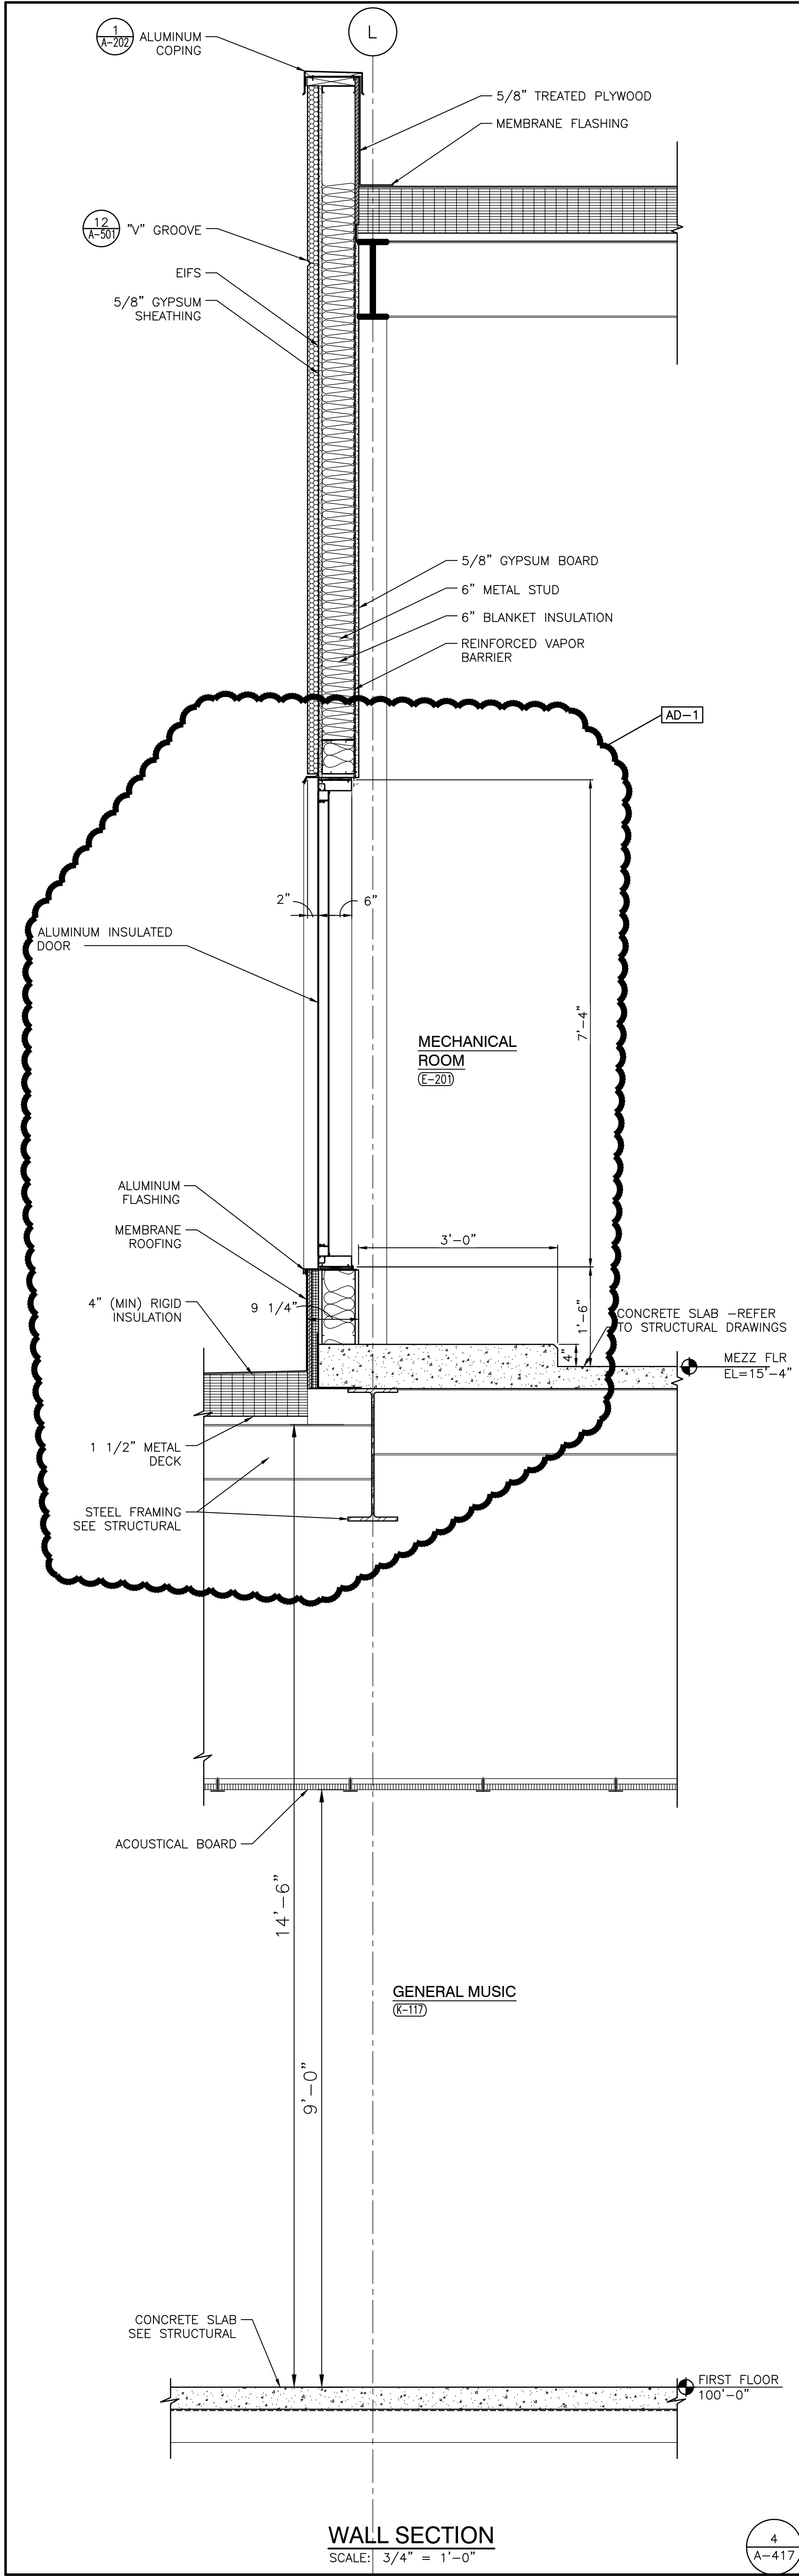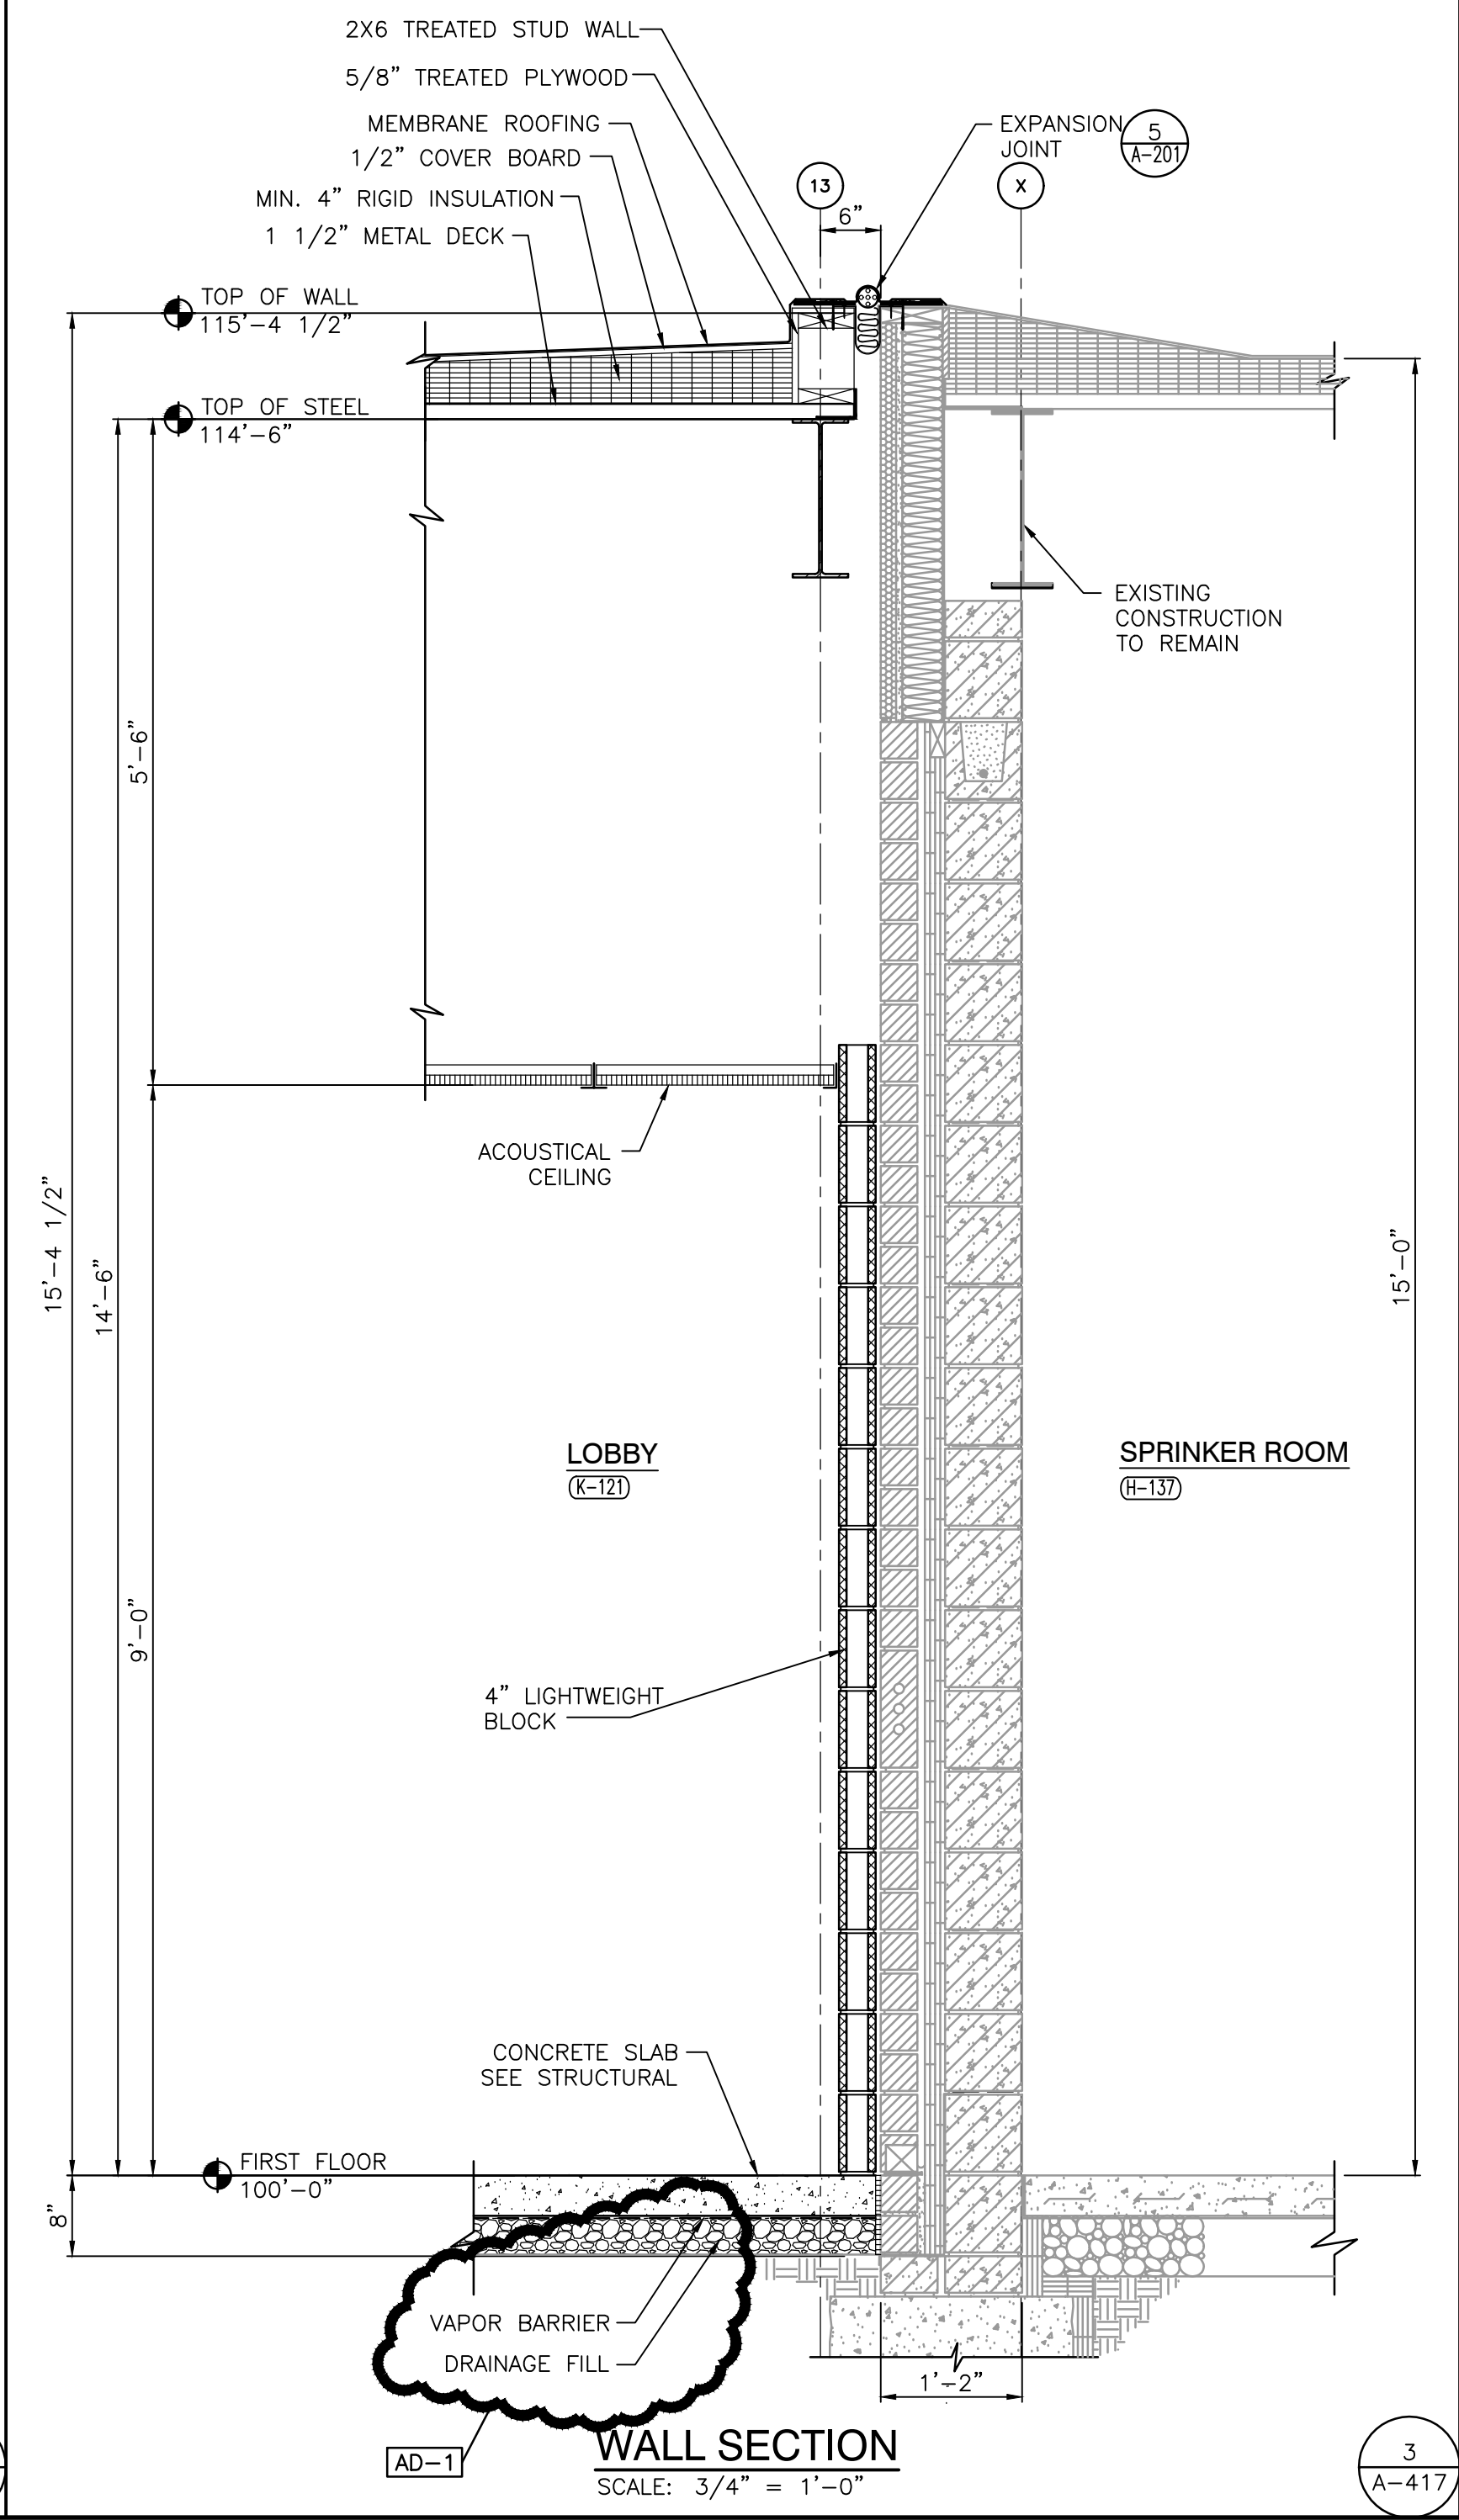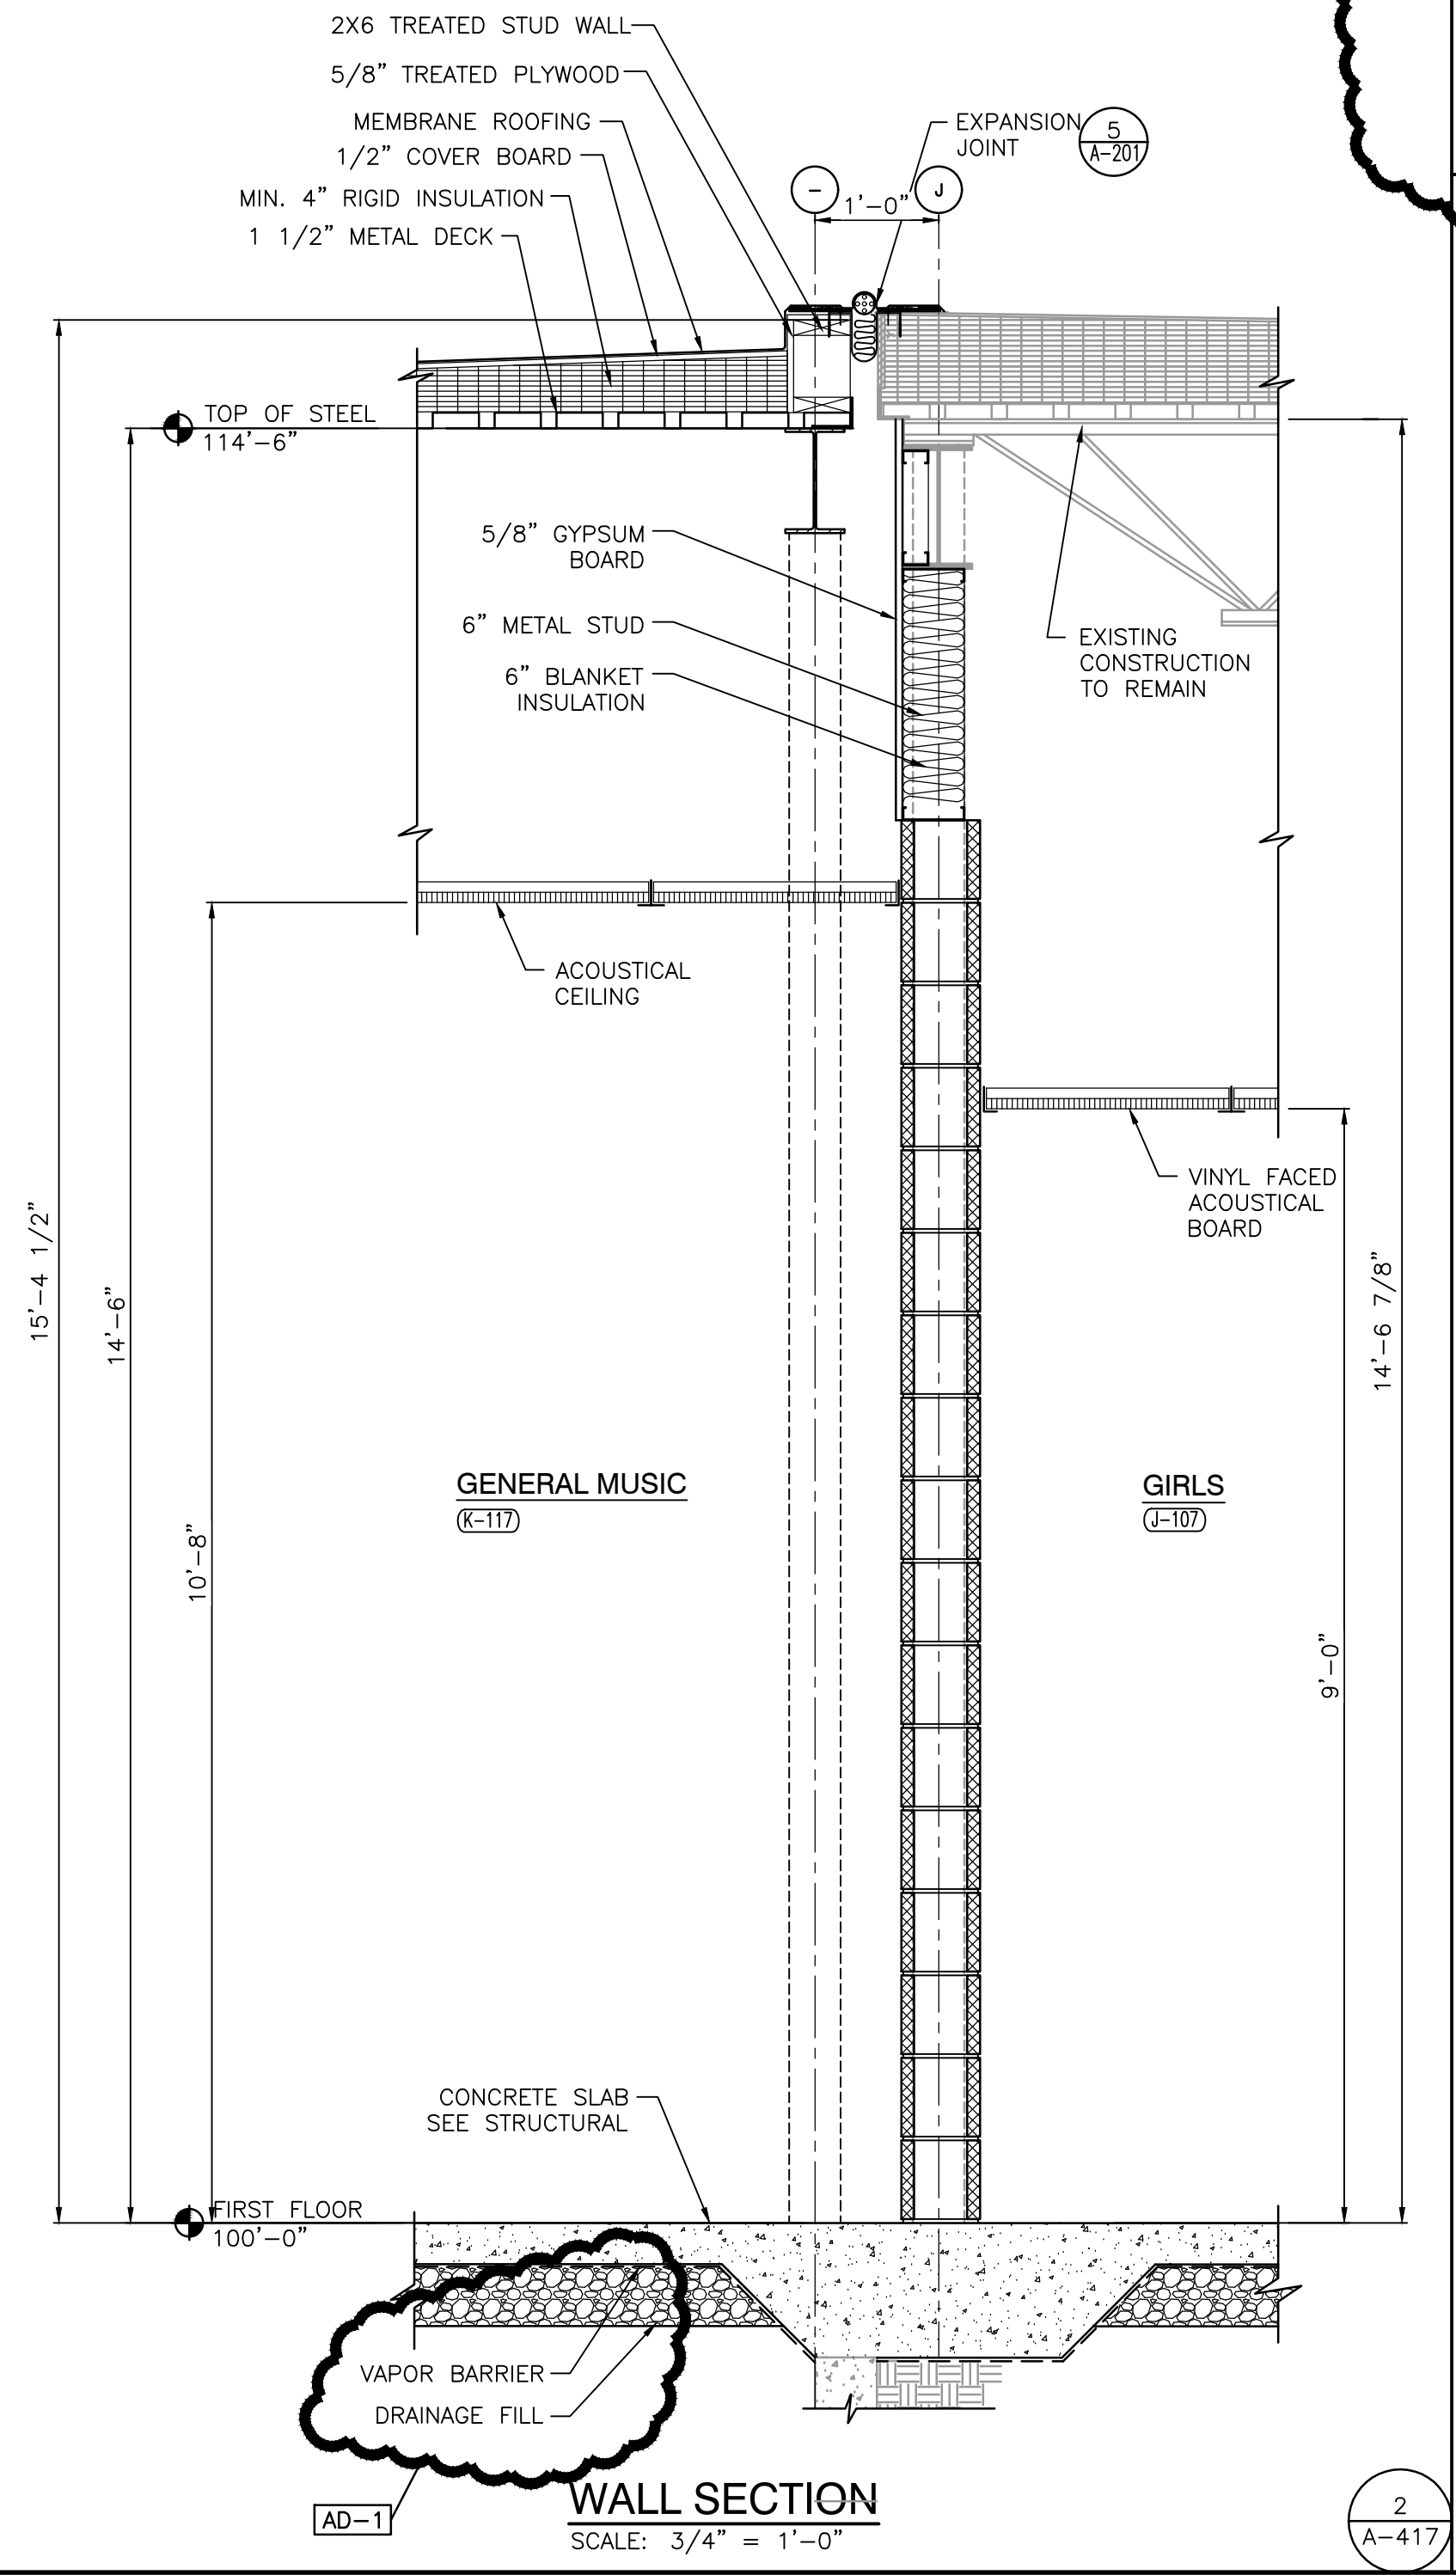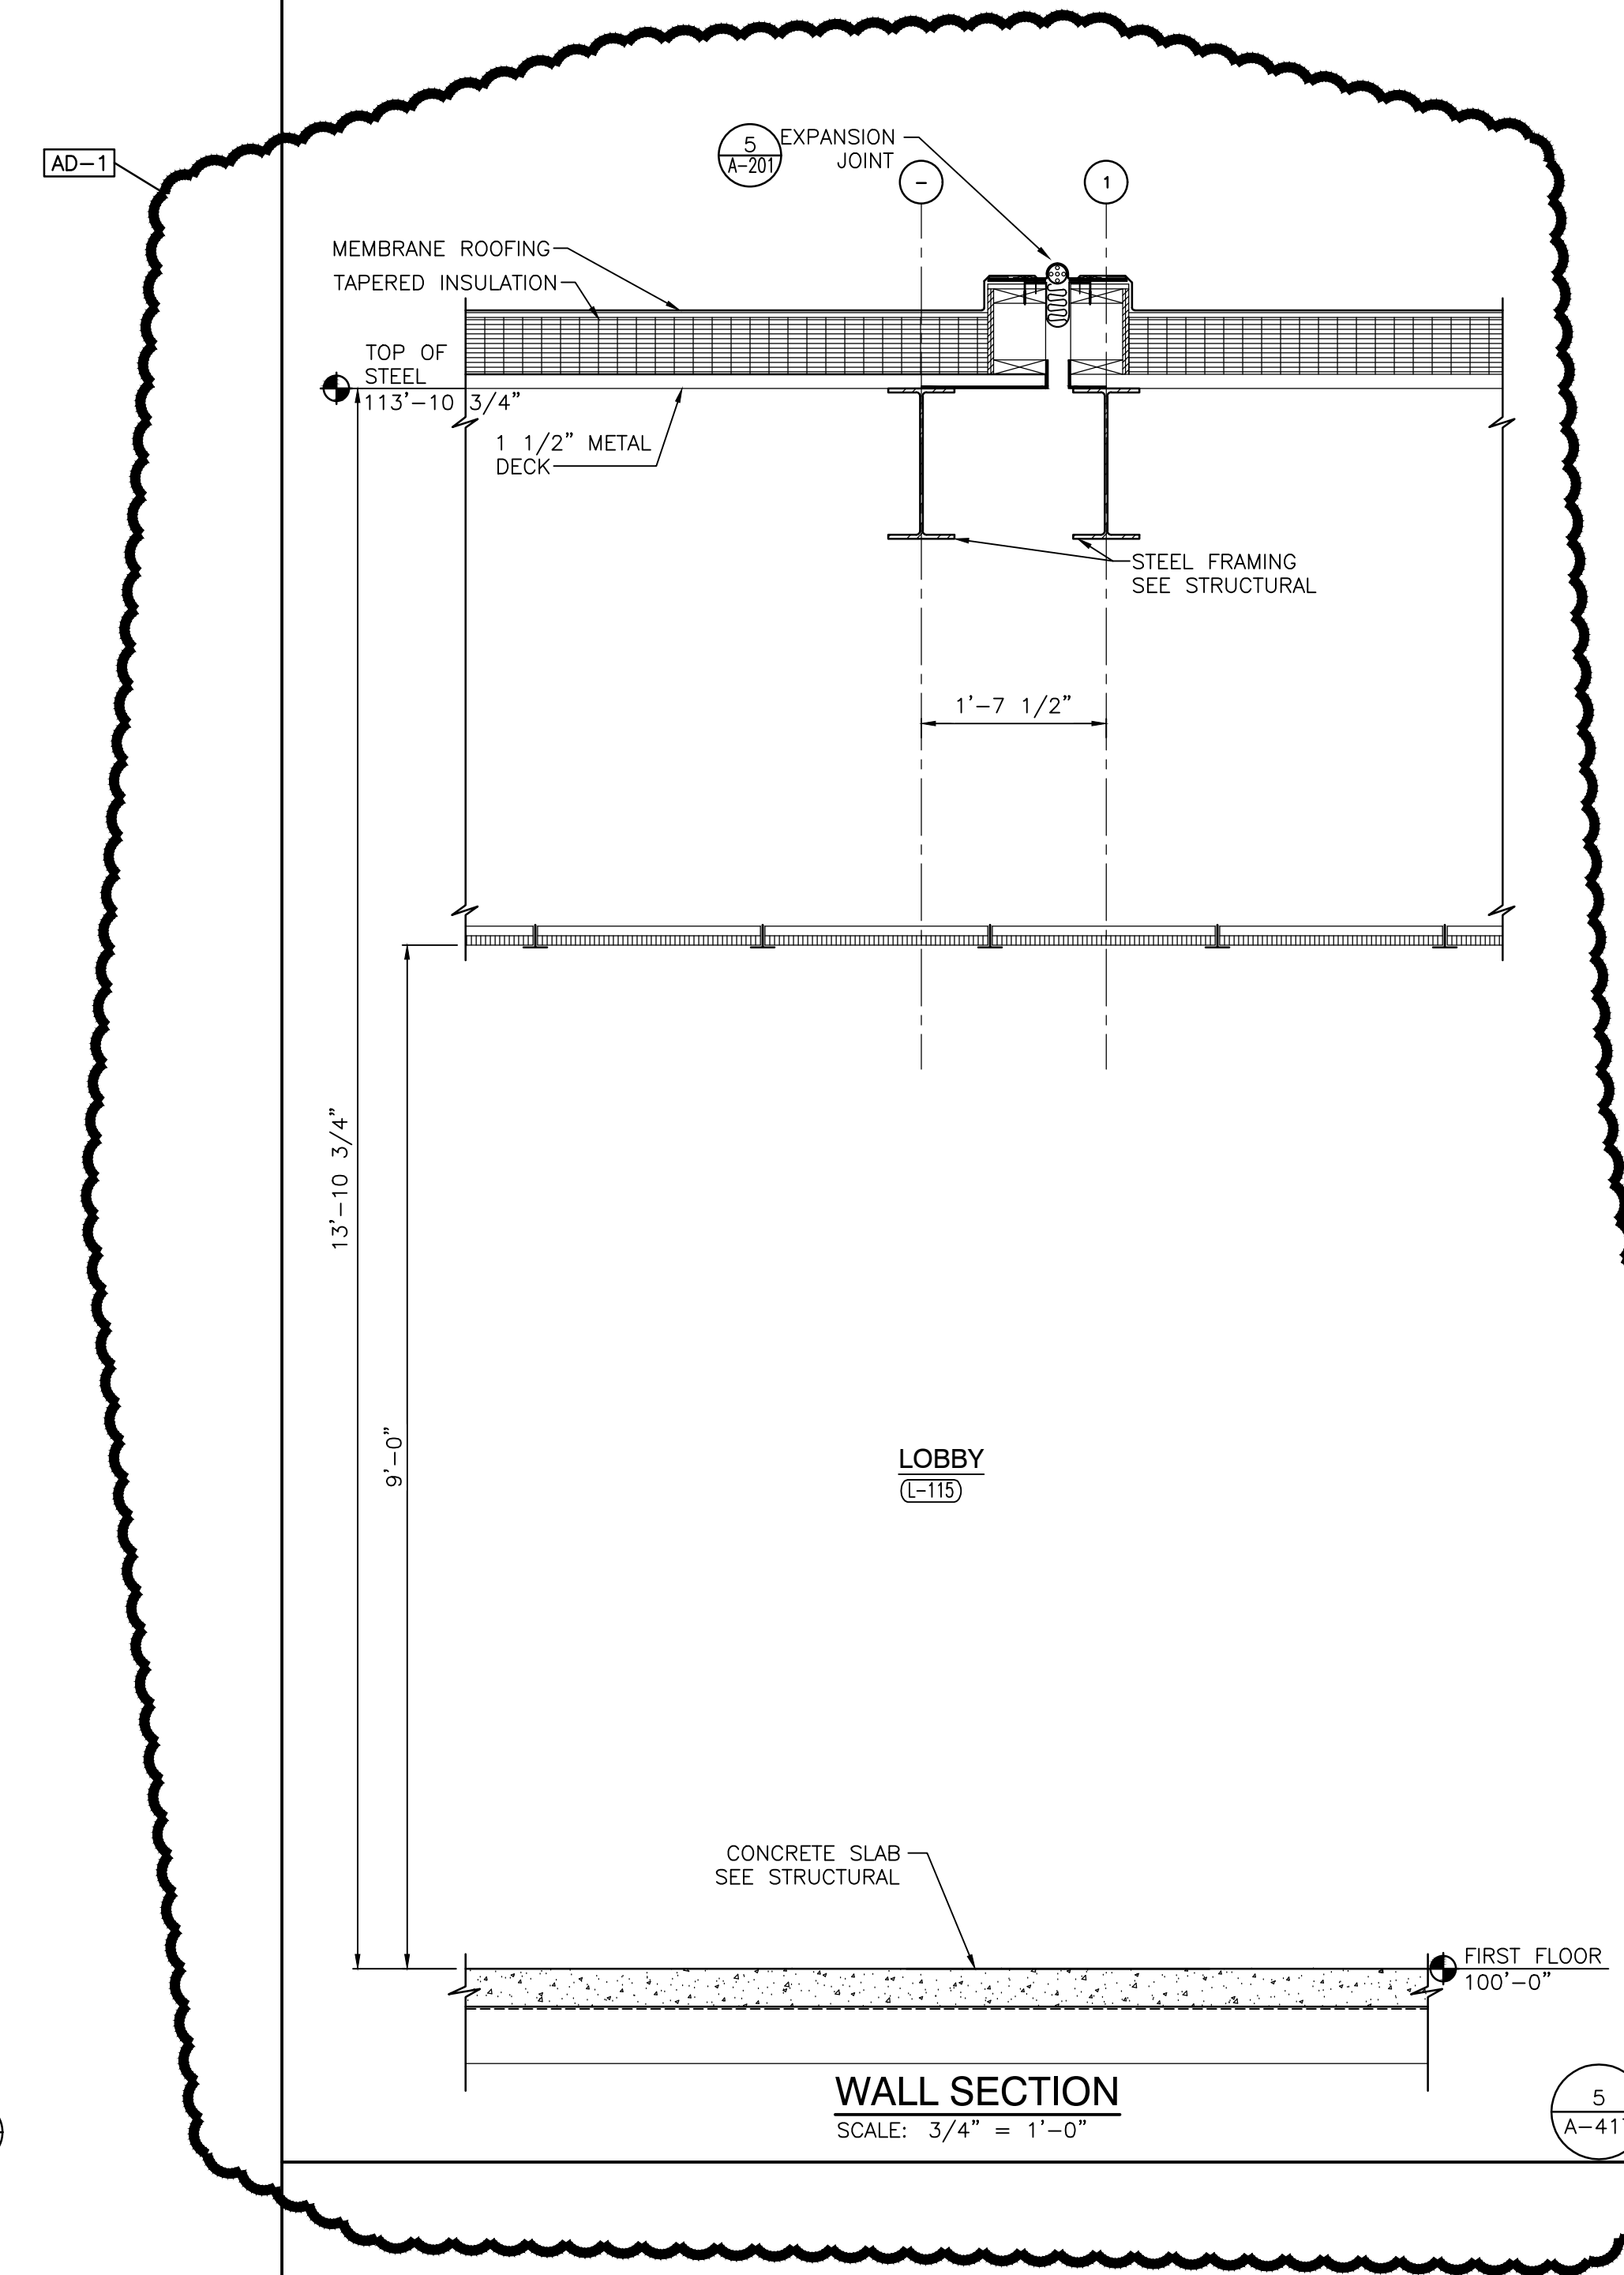


Wednesday, 6/15/2022, 4:22 PM - LAST SAVED BY: KASCHULTZ
 Y:\21-155 FRANKLIN TOWNSHIP CSC-EDGEWOOD IS
 ADDITIONS AND RENOVATIONS\21-155 DRAWINGS\05
 ARCH\A-417.DWG



GIBRALTAR DESIGN
ARCHITECTURE • ENGINEERING • INTERIOR DESIGN

PROJECT
ADDITIONS AND RENOVATIONS TO
EDGEWOOD INTERMEDIATE SCHOOL
FRANKLIN TOWNSHIP COMMUNITY SCHOOL CORPORATION
INDIANAPOLIS, INDIANA

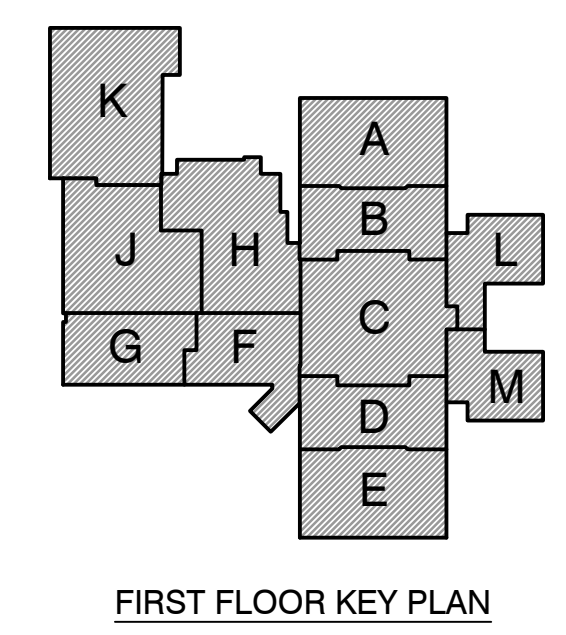

GIBRALTAR DESIGN
9102 N. Meridian St., Ste. 300
Indianapolis, IN 46260
Homepage: www.GibraltarDesign.com
Email: info@GibraltarDesign.com
Phone: 317.580.5777 Fax: 317.580.5778

PROJECT
21-155
DATE
05/23/22
COORDINATED BY
DUJW
DRAWN BY
JRH KS
CHECKED BY
DUJW









COPYRIGHT NOTICE:
THE CONCEPTS, DESIGNS, PLANS, DETAILS, ETC. SHOWN ON THIS DOCUMENT ARE THE PROPERTY OF GIBRALTAR DESIGN AND WERE CREATED FOR USE ON THIS SPECIFIC PROJECT. NONE OF THIS INFORMATION SHALL BE USED BY ANY PERSON OR FIRM FOR ANY PURPOSE WITHOUT THE EXPRESS WRITTEN CONSENT OF GIBRALTAR DESIGN. THE OWNER MAY RETAIN COPIES FOR INFORMATION AND REFERENCE IN CONNECTION ONLY WITH THIS PROJECT.

REVISIONS	MARK	DATE	ISSUED FOR
	AD-1	06/16/22	ADDENDUM NO. 1

DRAWING
ENLARGED STAIR PLANS AND SECTIONS

PROJECT
ADDITIONS AND RENOVATIONS TO
EDGEWOOD INTERMEDIATE SCHOOL

DRAWING SHEET
A-430

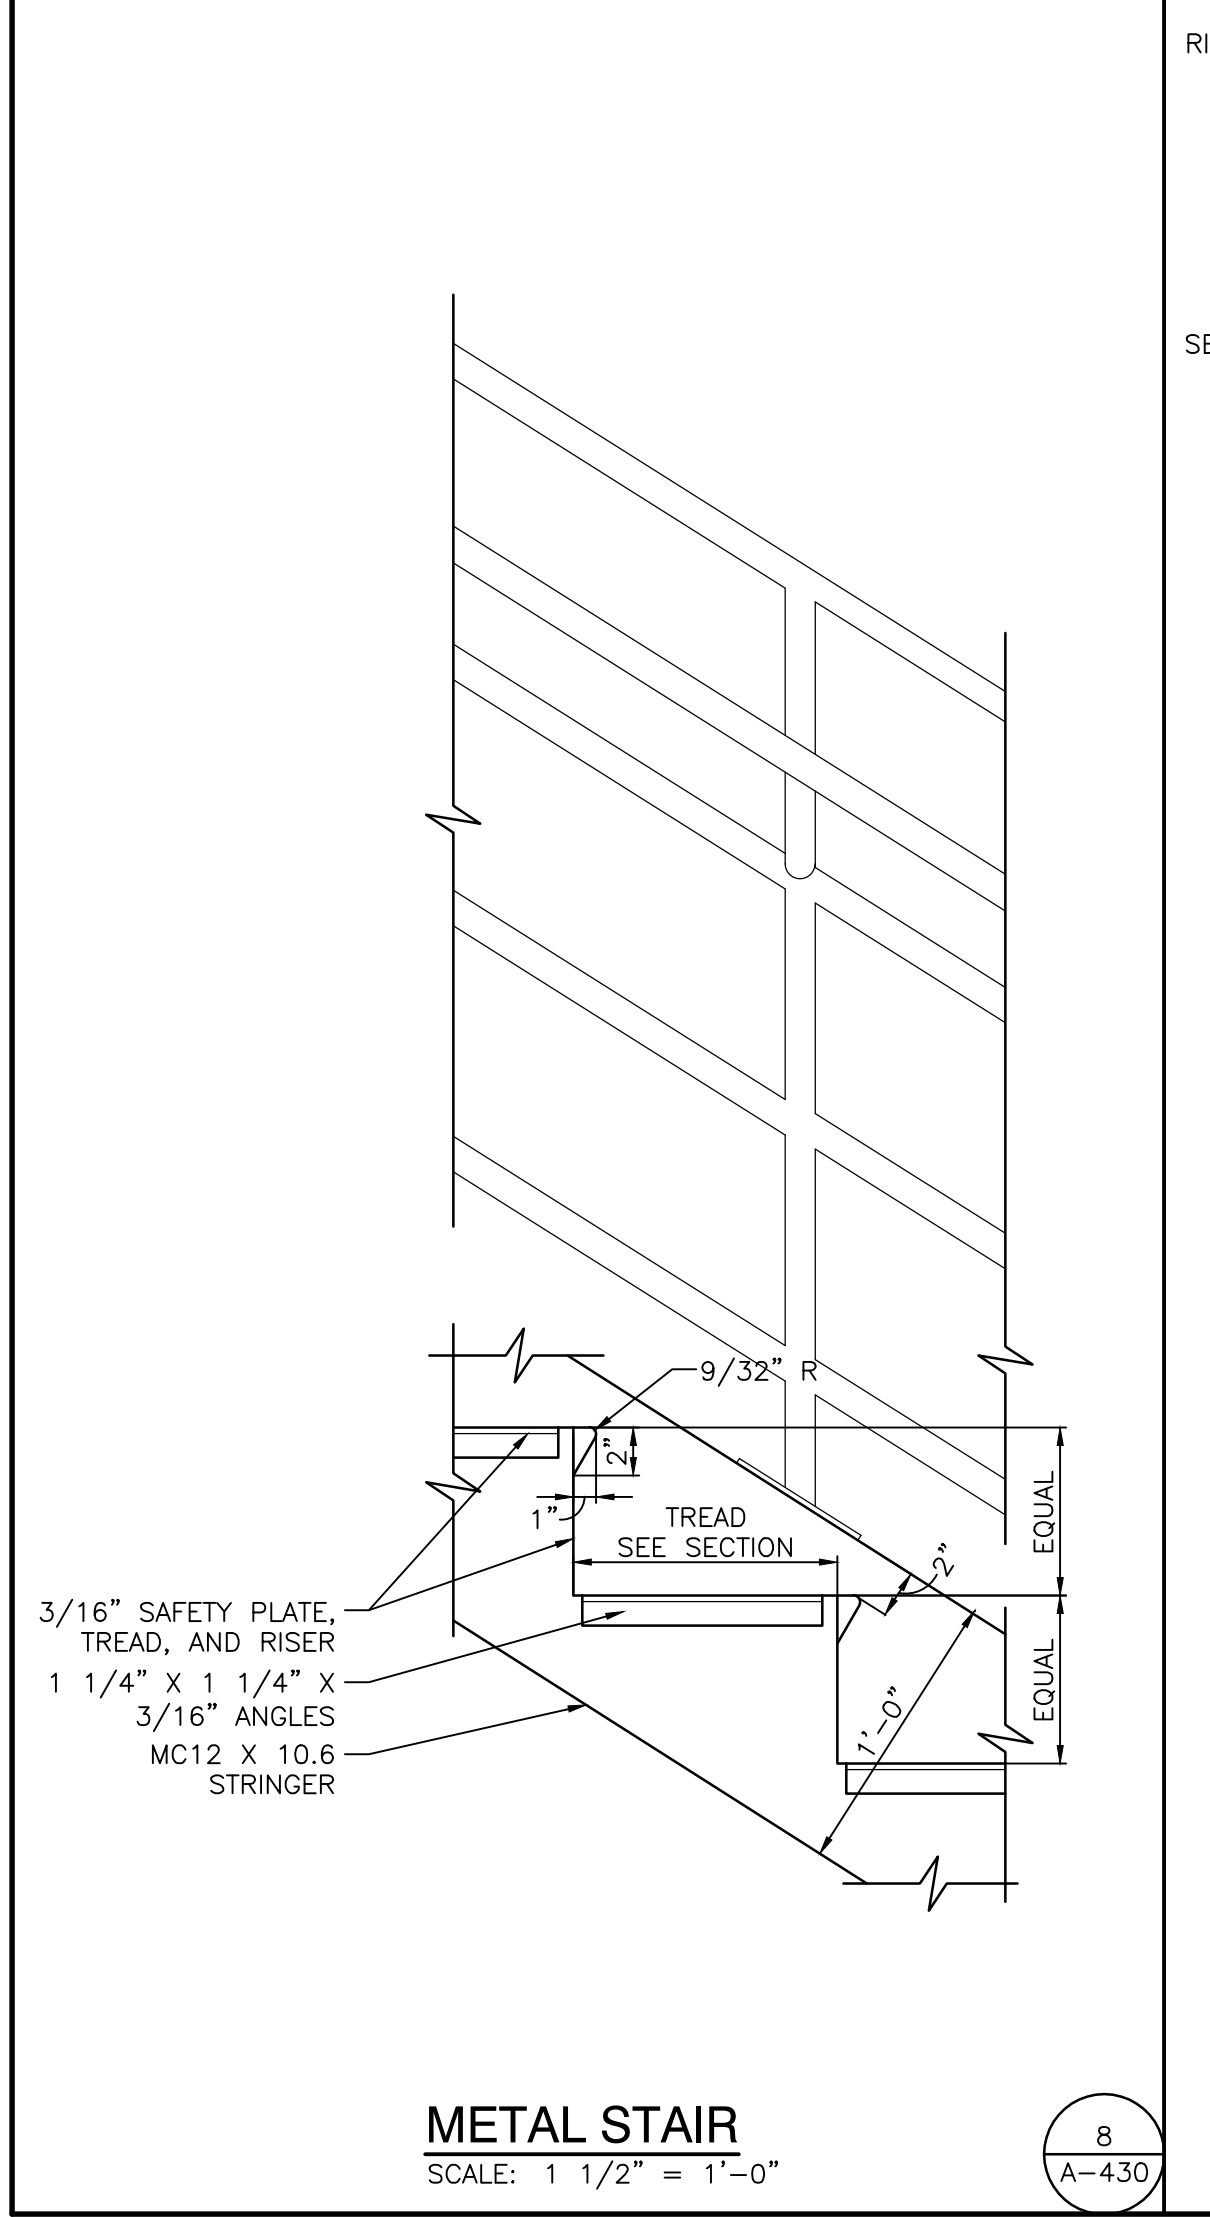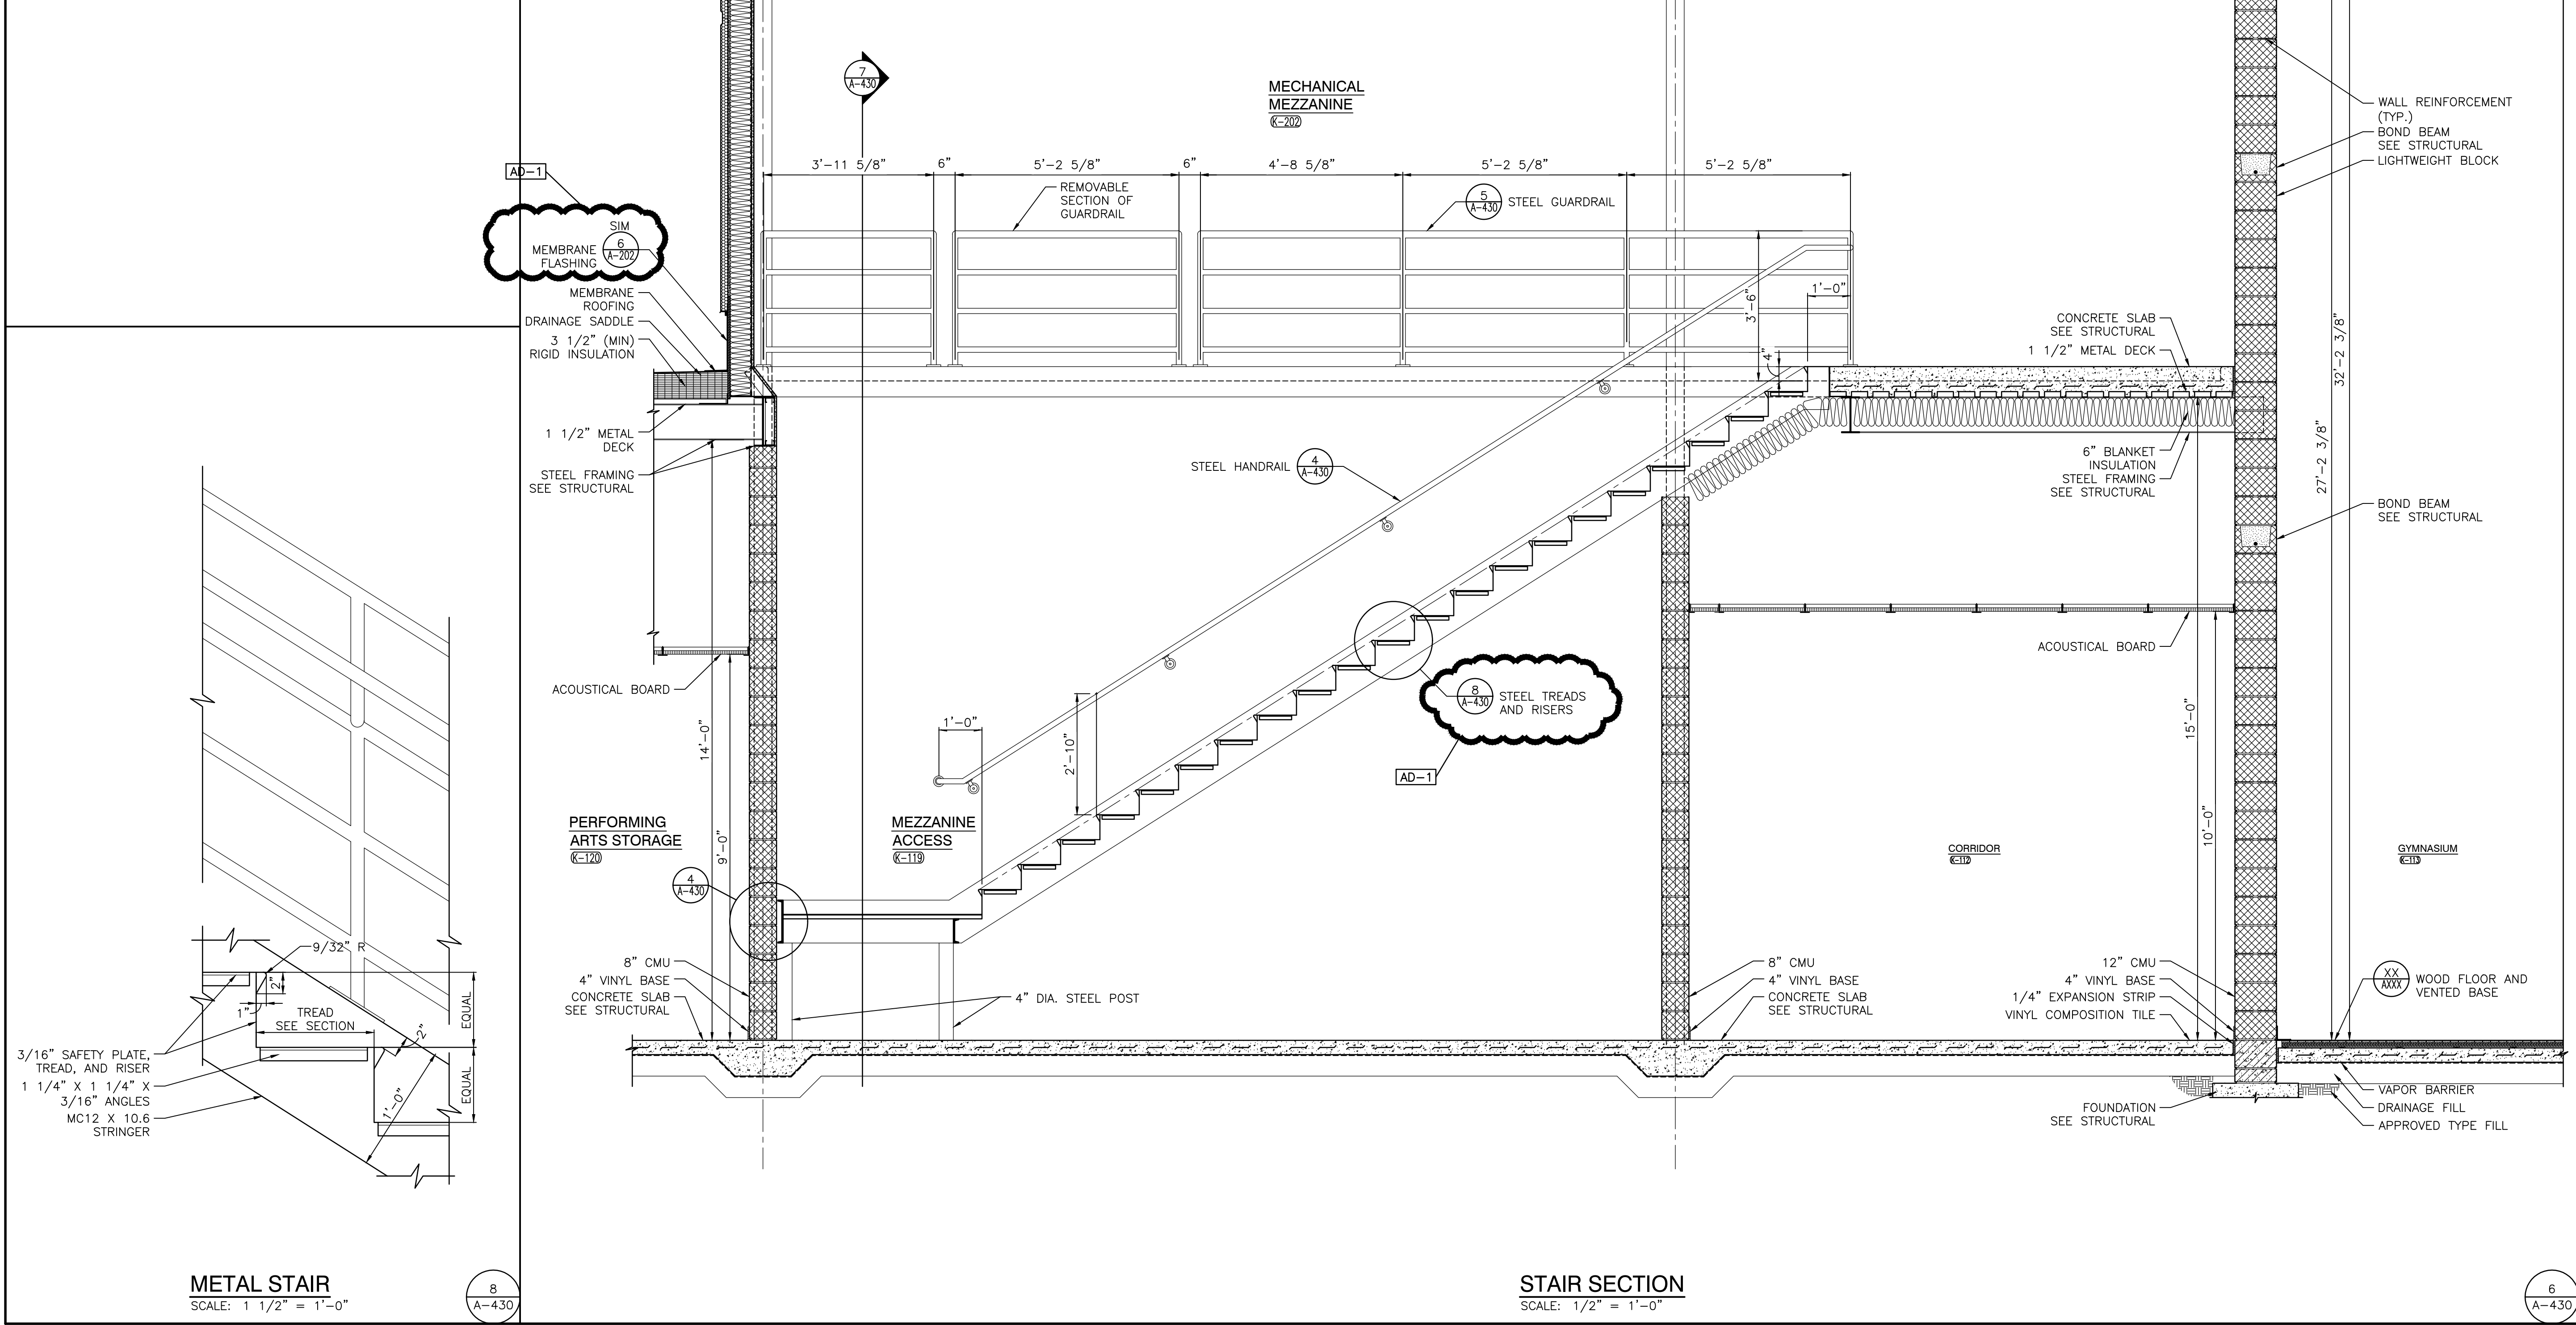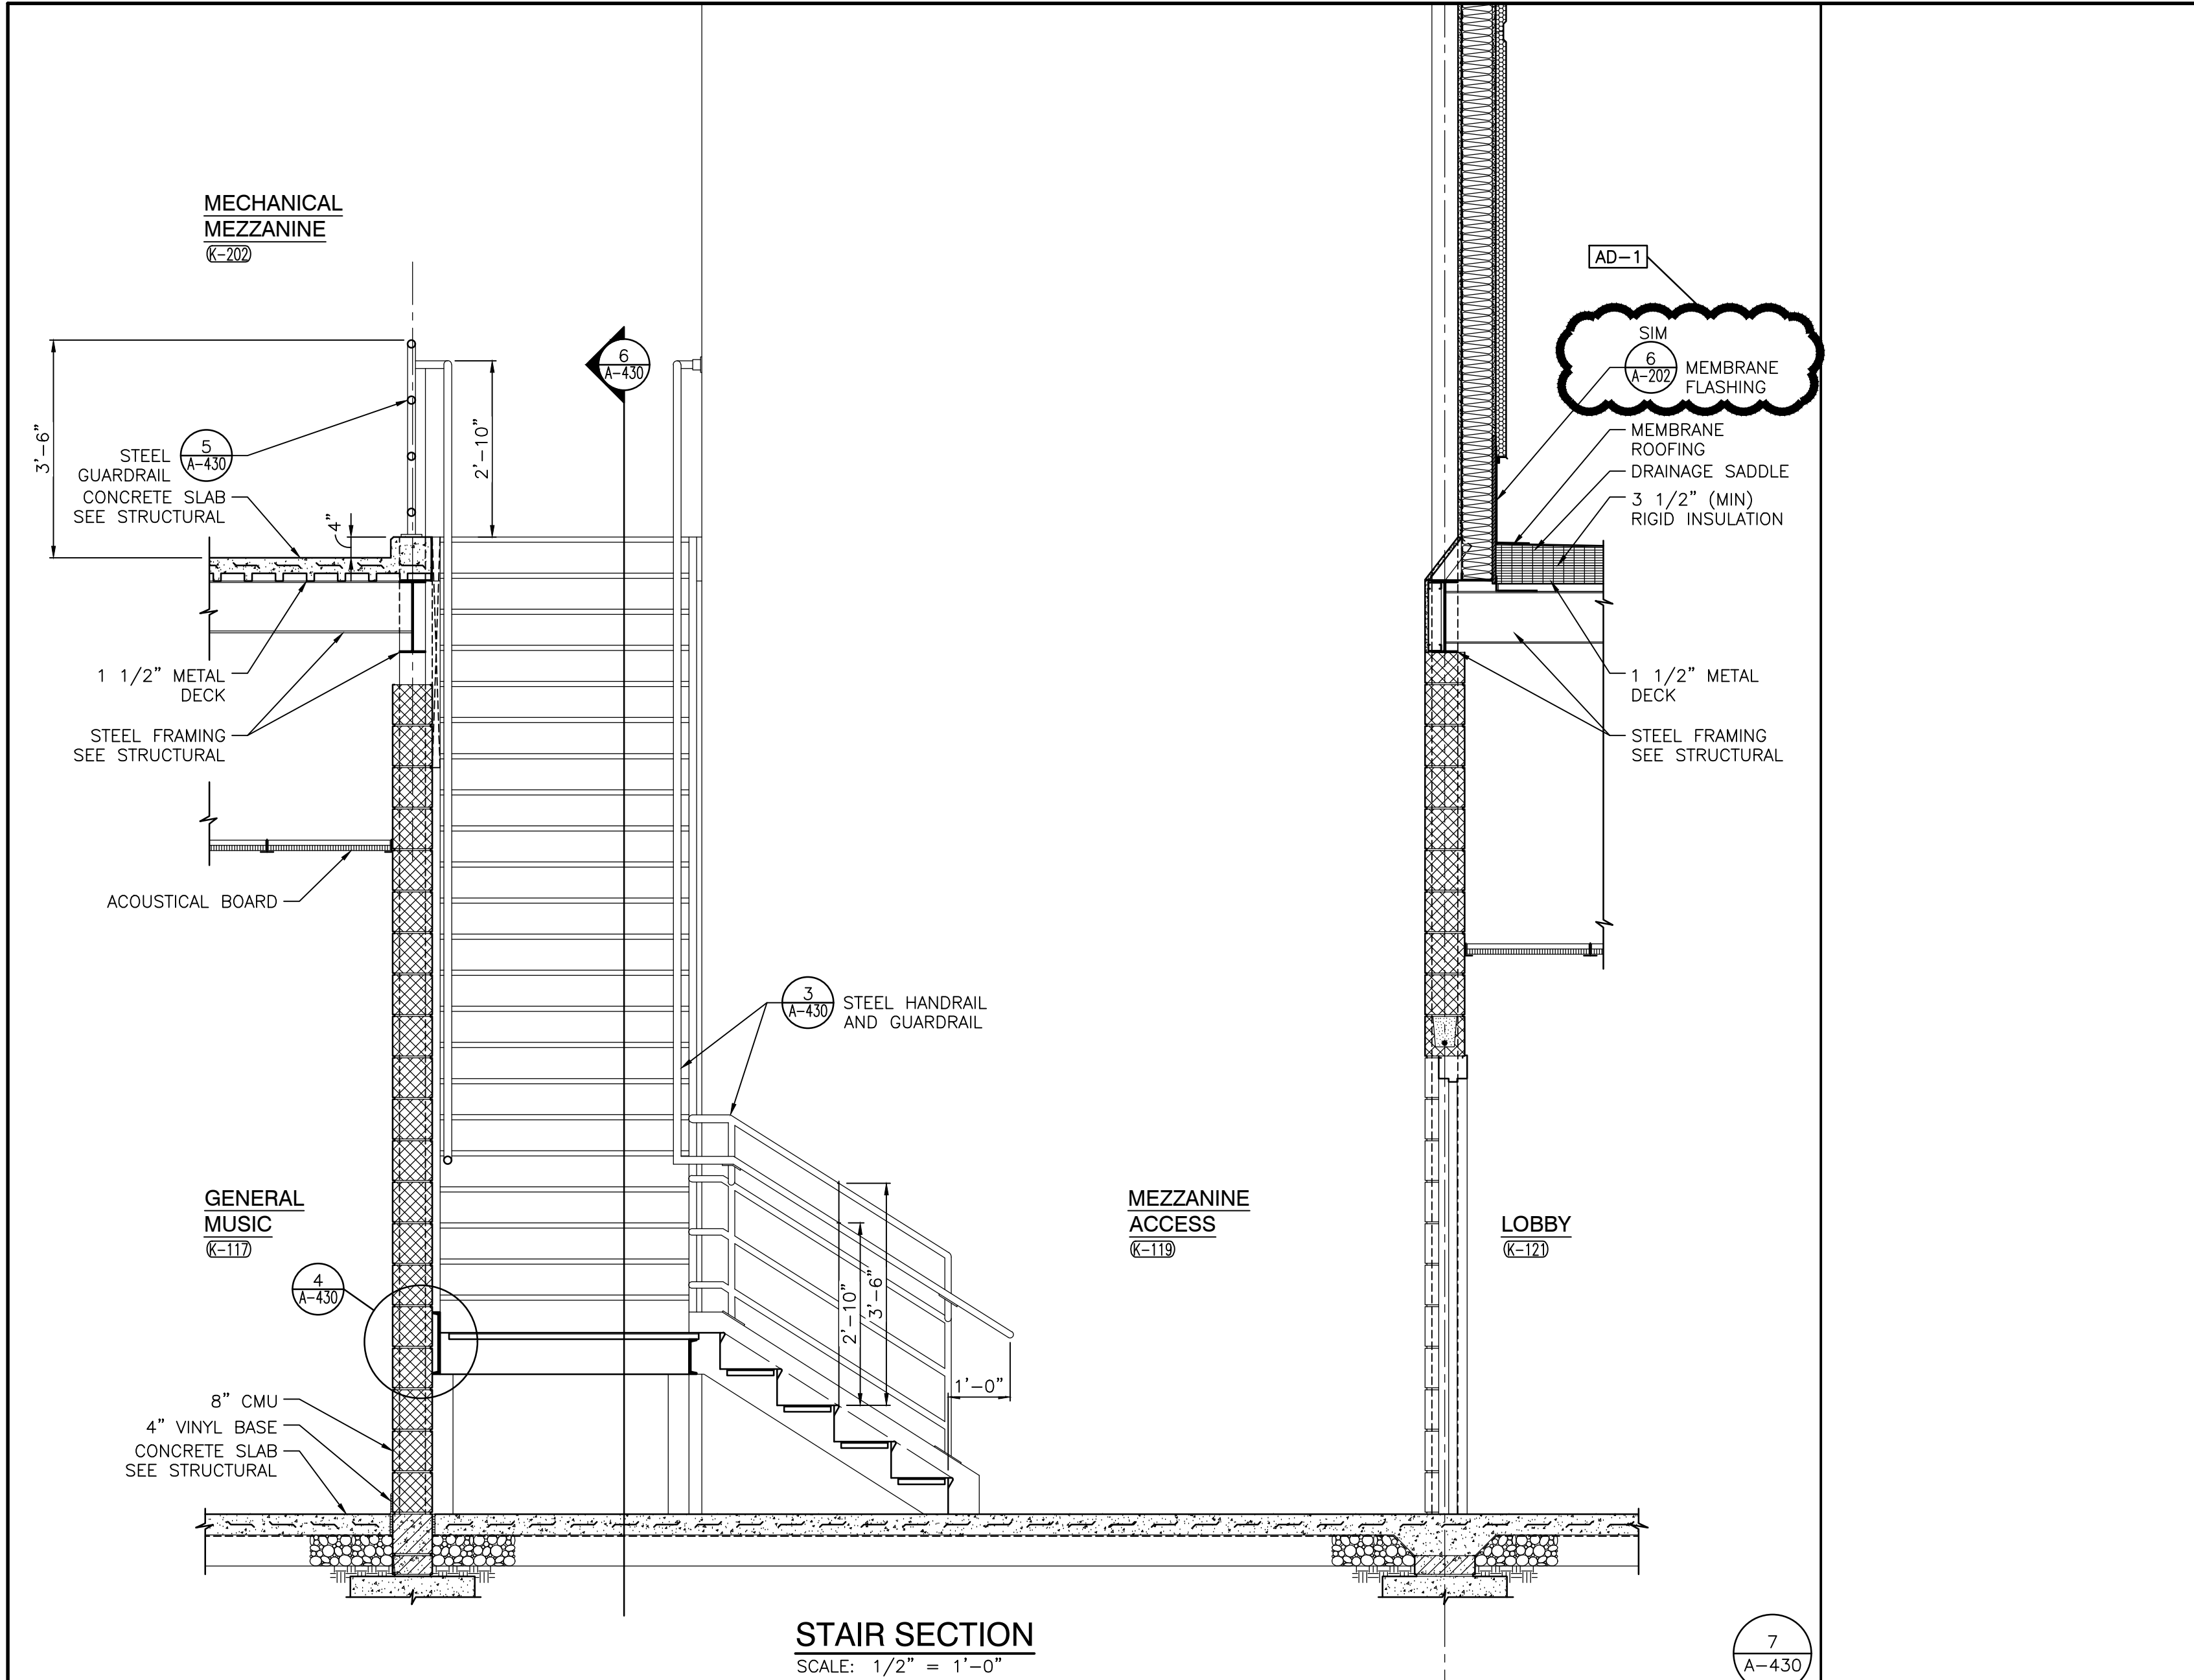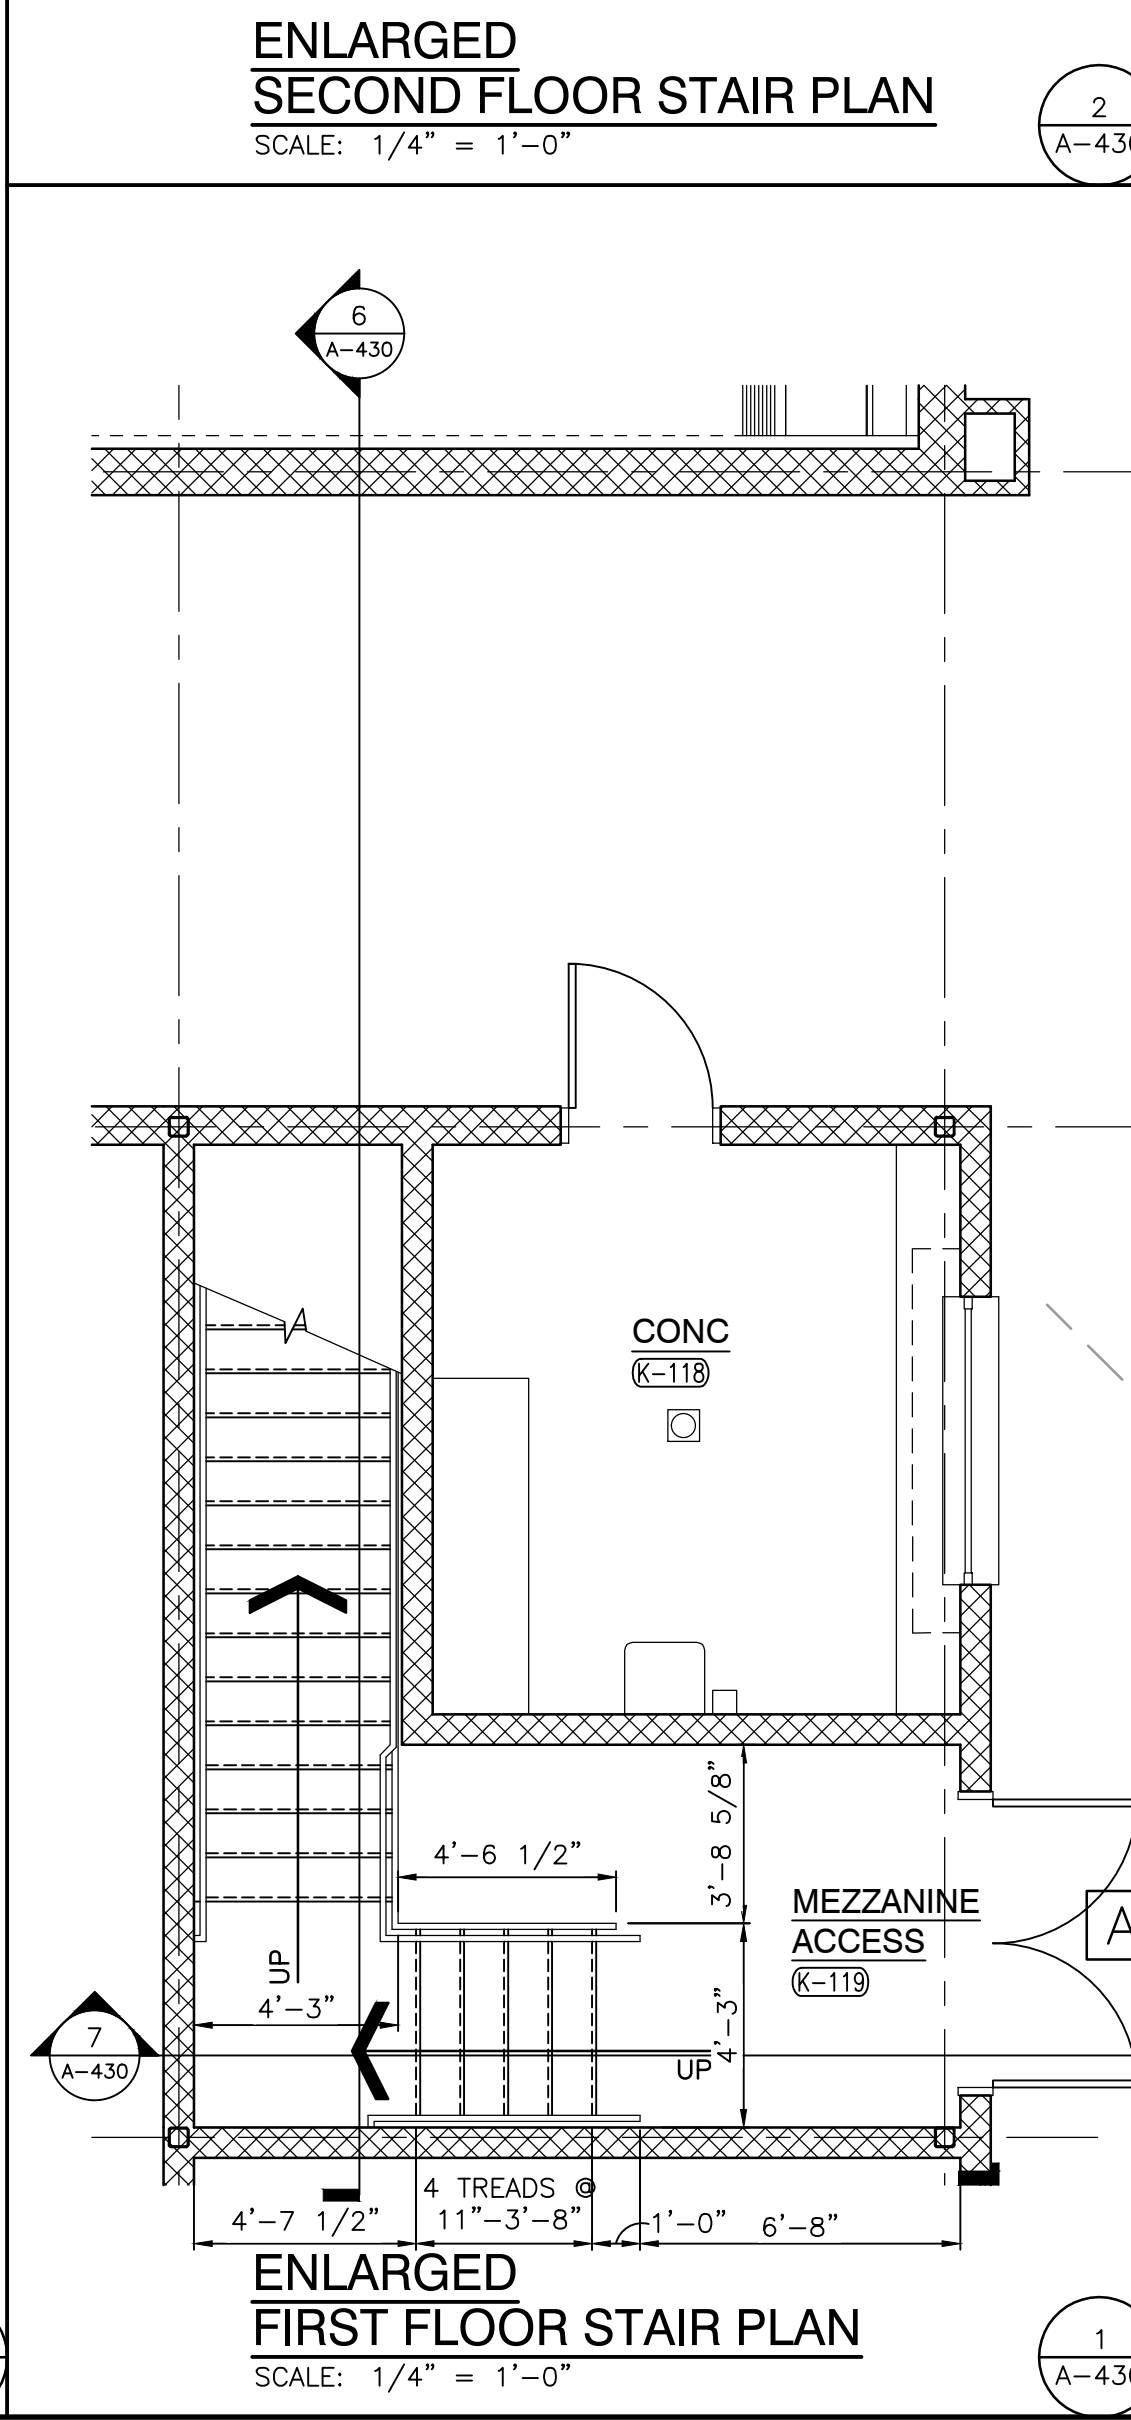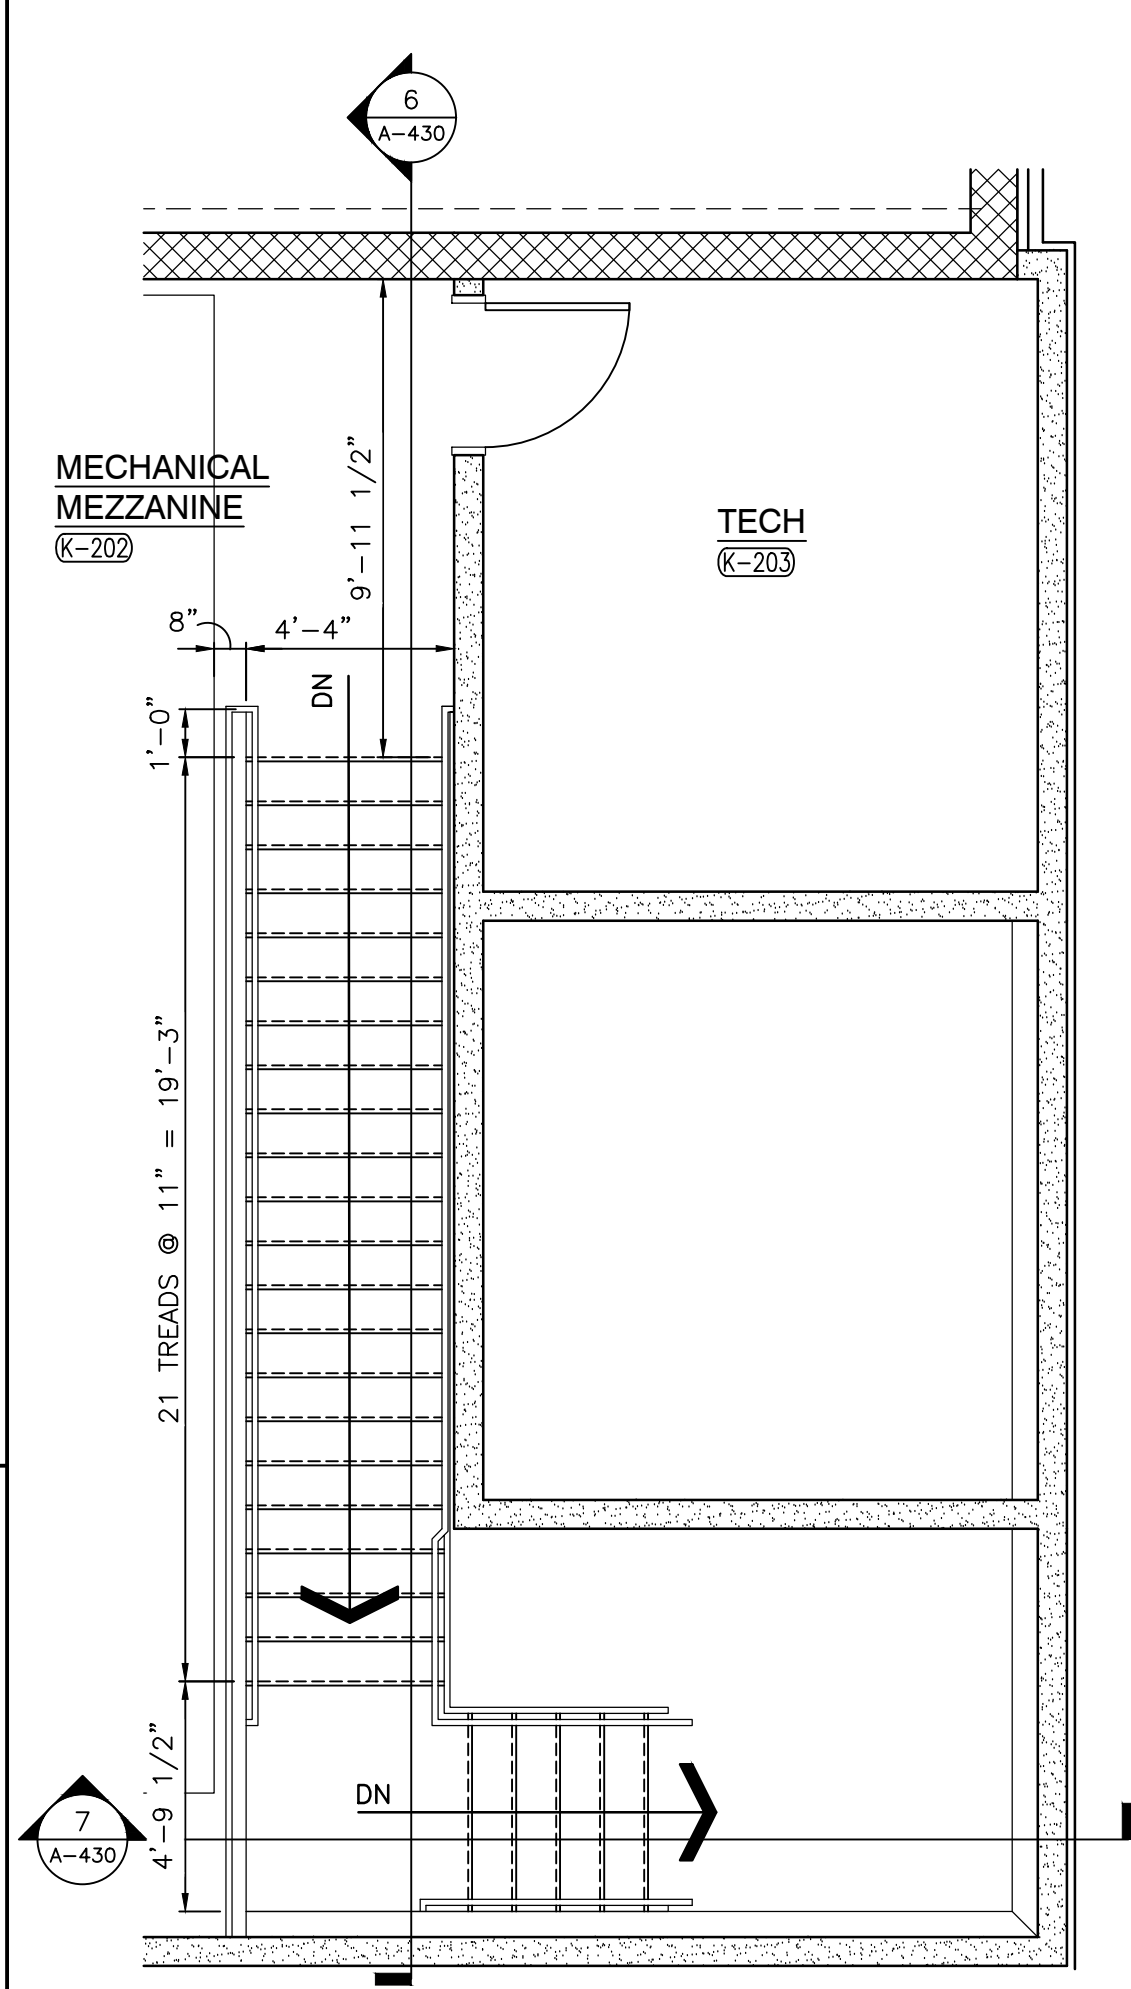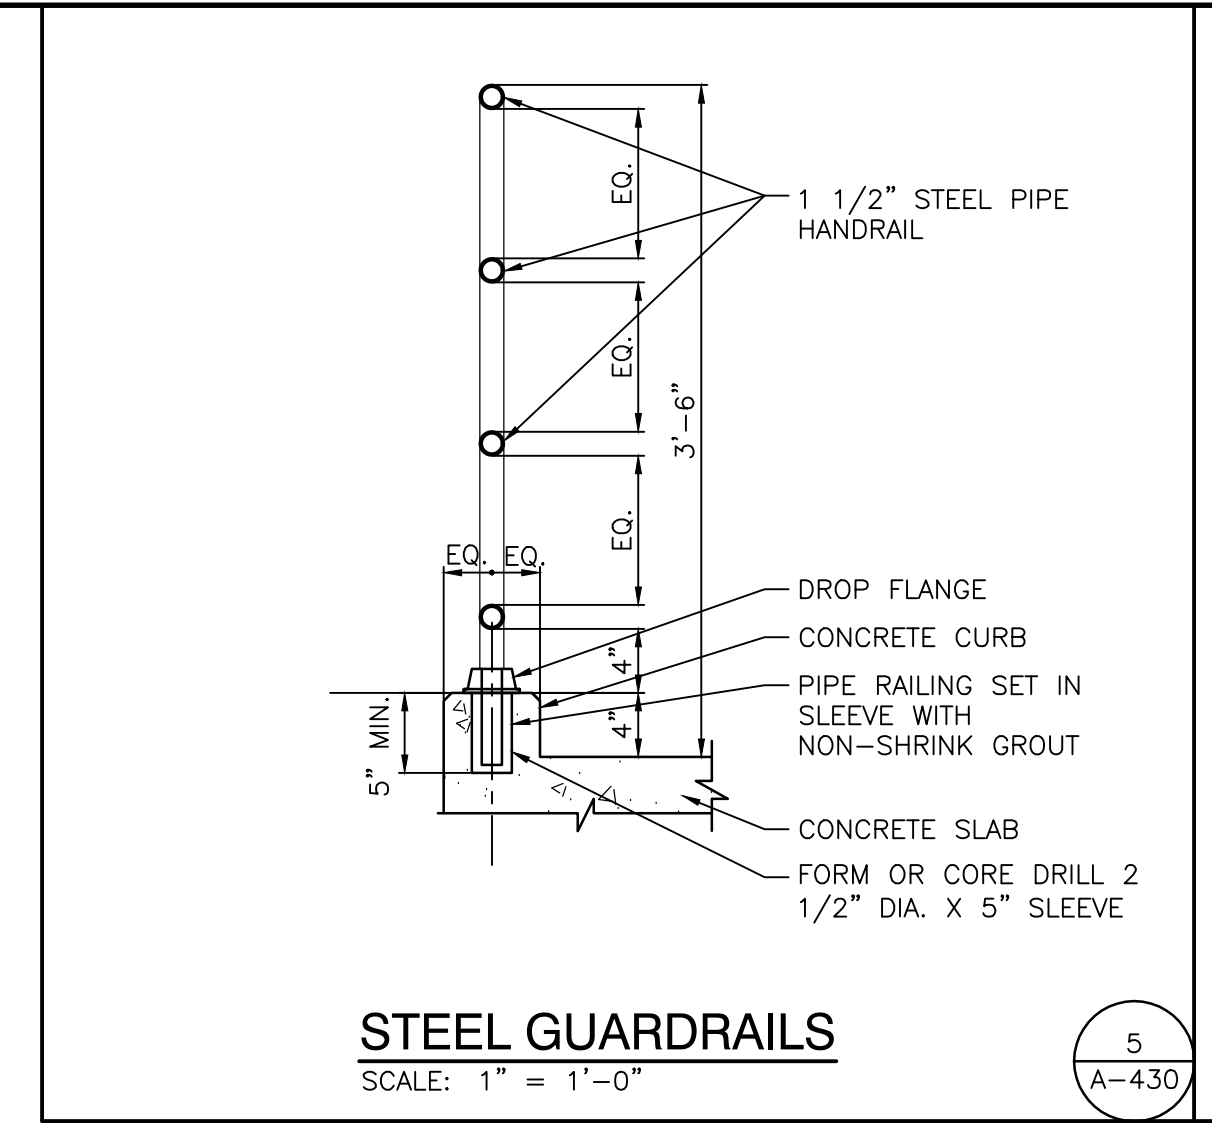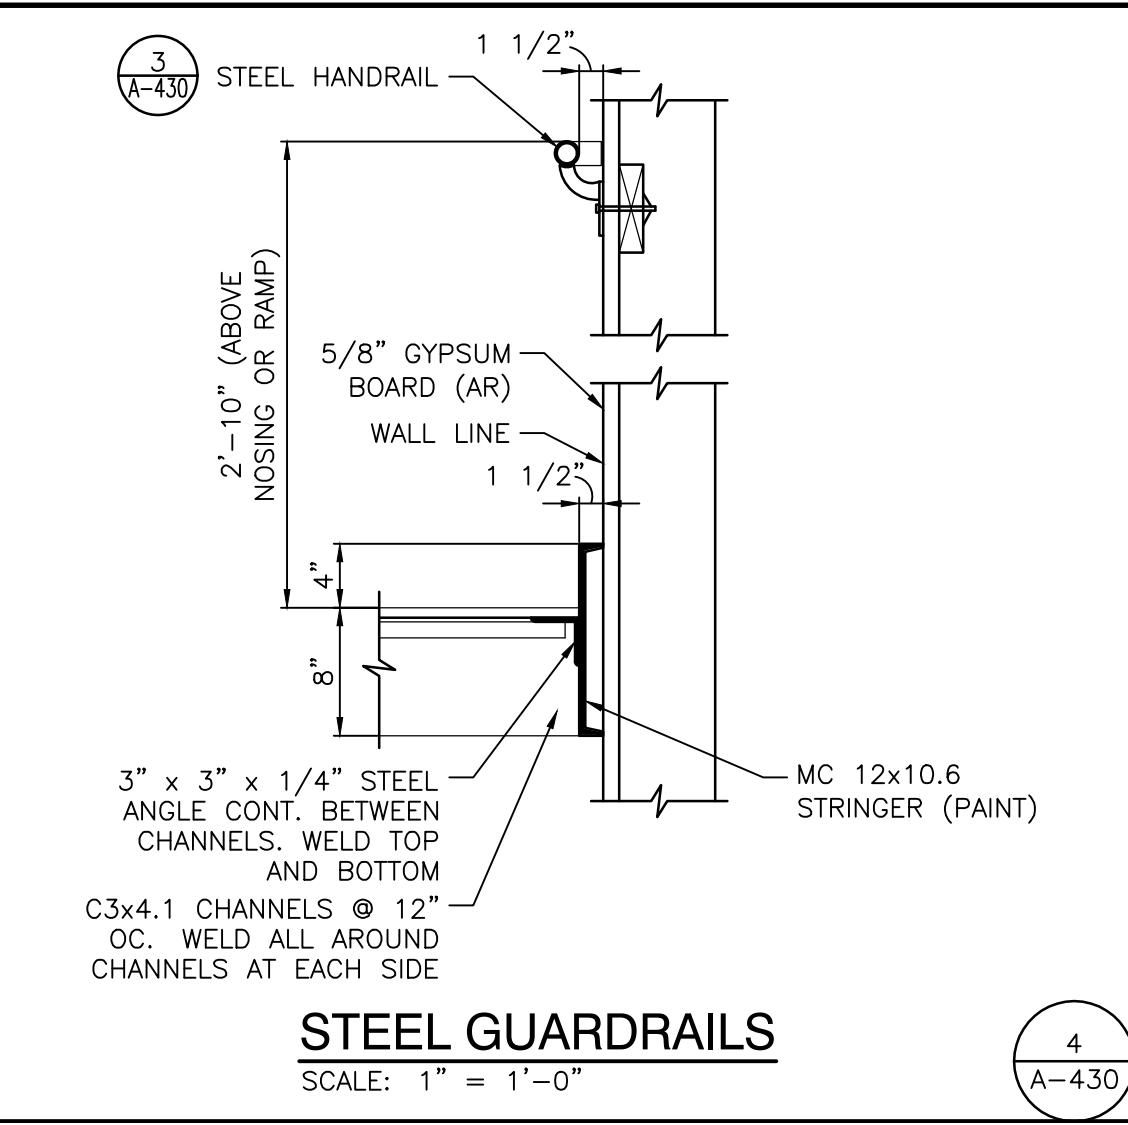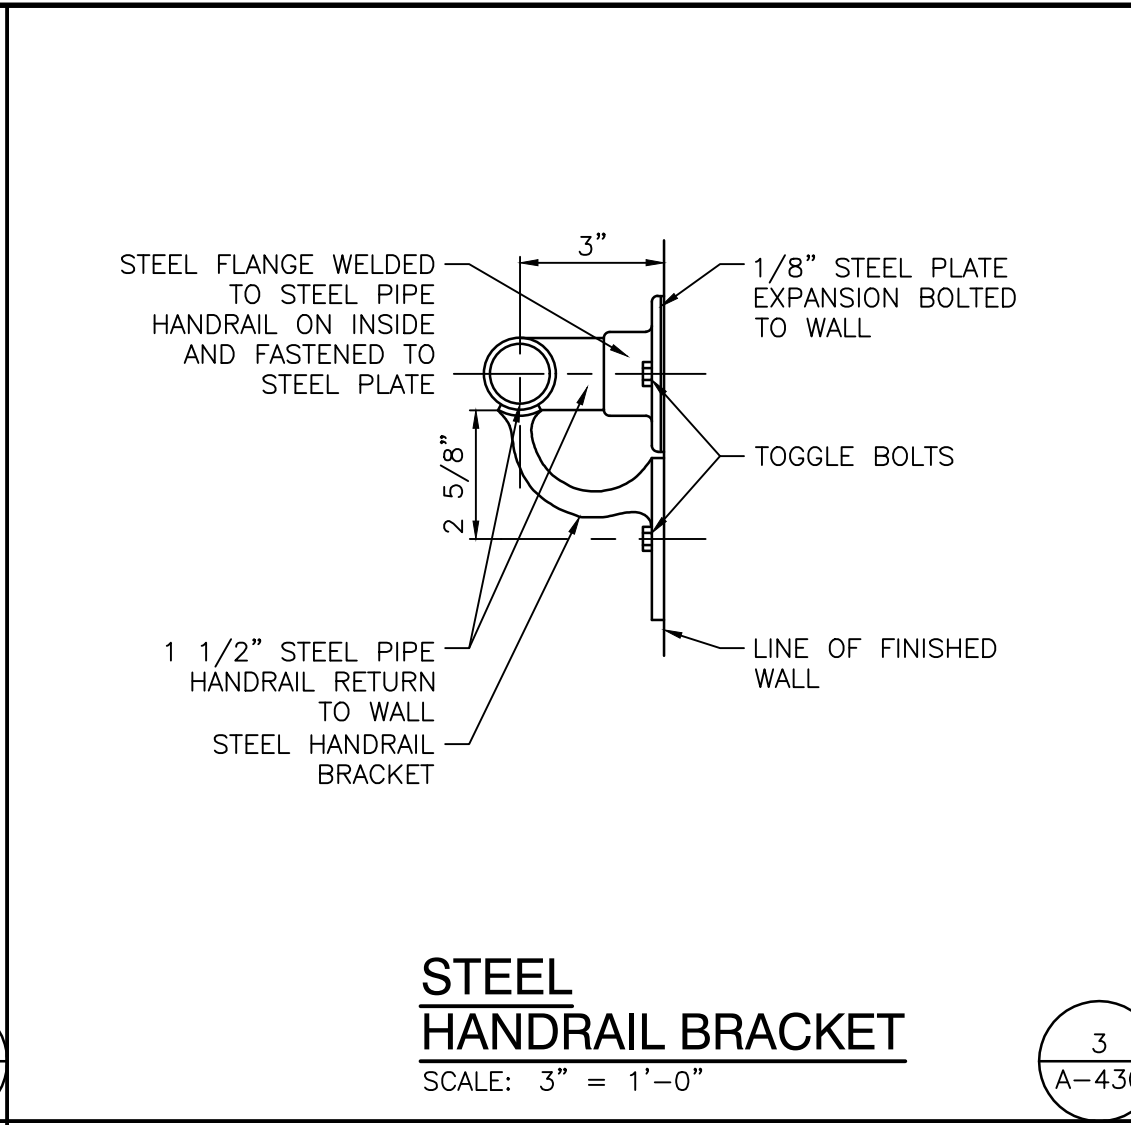


Thursday, 6/16/2022 1:47 PM - LAST SAVED BY: KRSCHULTZ
Y:\21-155 FRANKLIN TOWNSHIP CSC-EDGEWOOD IS
ADDITIONS AND RENOVATIONS\21-155 DRAWINGS\05
ARCH\A-430.DWG



GIBRALTAR
DESIGN
ARCHITECTURE • ENGINEERING • INTERIOR DESIGN

PROJECT
ADDITIONS AND RENOVATIONS TO
EDGEWOOD INTERMEDIATE SCHOOL
FRANKLIN TOWNSHIP COMMUNITY SCHOOL CORPORATION
INDIANAPOLIS, INDIANA

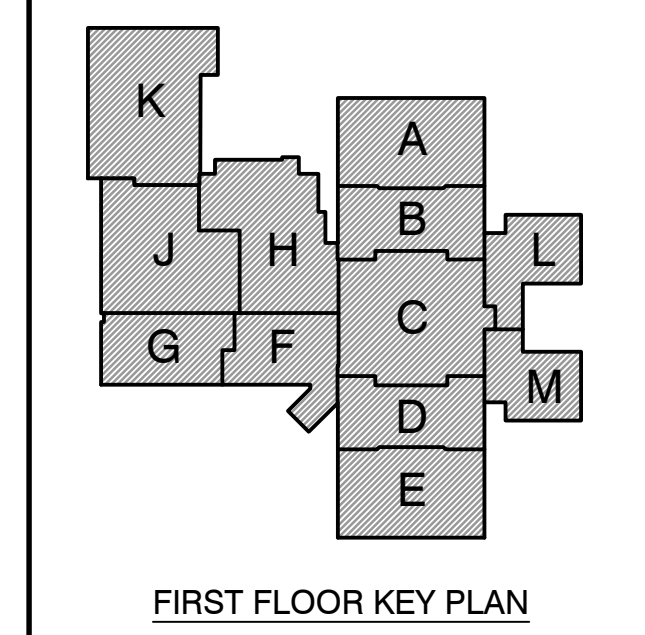

GIBRALTAR DESIGN
9102 N. Meridian St., Ste. 300
Indianapolis, IN 46260
Homepage: www.GibraltarDesign.com
Email: info@GibraltarDesign.com
Phone: 317.580.5777 Fax: 317.580.5778

PROJECT
21-155
DATE
05/23/22
COORDINATED BY
DJW
DRAWN BY
JRH
CHECKED BY
DJW

COPYRIGHT NOTICE:
THE CONCEPTS, DESIGNS, PLANS, DETAILS, ETC. SHOWN ON THIS DOCUMENT ARE THE PROPERTY OF GIBRALTAR DESIGN AND WERE CREATED FOR USE ON THIS SPECIFIC PROJECT. NONE OF THIS INFORMATION SHALL BE USED BY ANY PERSON OR FIRM FOR ANY PURPOSE WITHOUT THE EXPRESS WRITTEN CONSENT OF GIBRALTAR DESIGN. THE OWNER MAY RETAIN COPIES FOR INFORMATION AND REFERENCE IN CONNECTION ONLY WITH THIS PROJECT.































REVISIONS	MARK	DATE	ISSUED FOR
	AD-1	06/16/22	ADDENDUM NO. 1

REVISIONS	MARK	DATE	ISSUED FOR
	AD-1	06/16/22	ADDENDUM NO. 1

DRAWING
TYPICAL DETAILS

PROJECT
ADDITIONS AND RENOVATIONS TO
EDGEWOOD INTERMEDIATE SCHOOL

© GIBRALTAR DESIGN SHEET
A-501

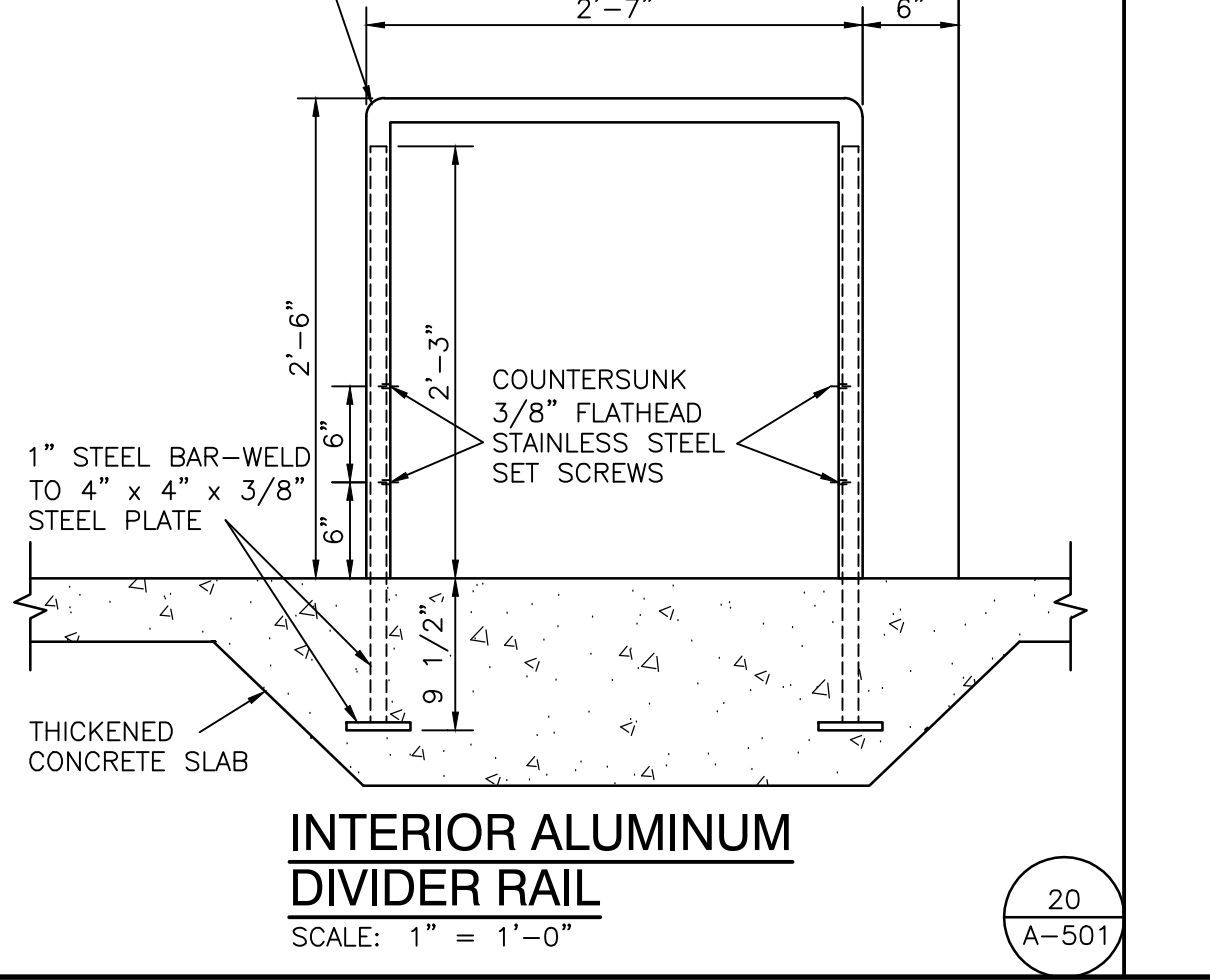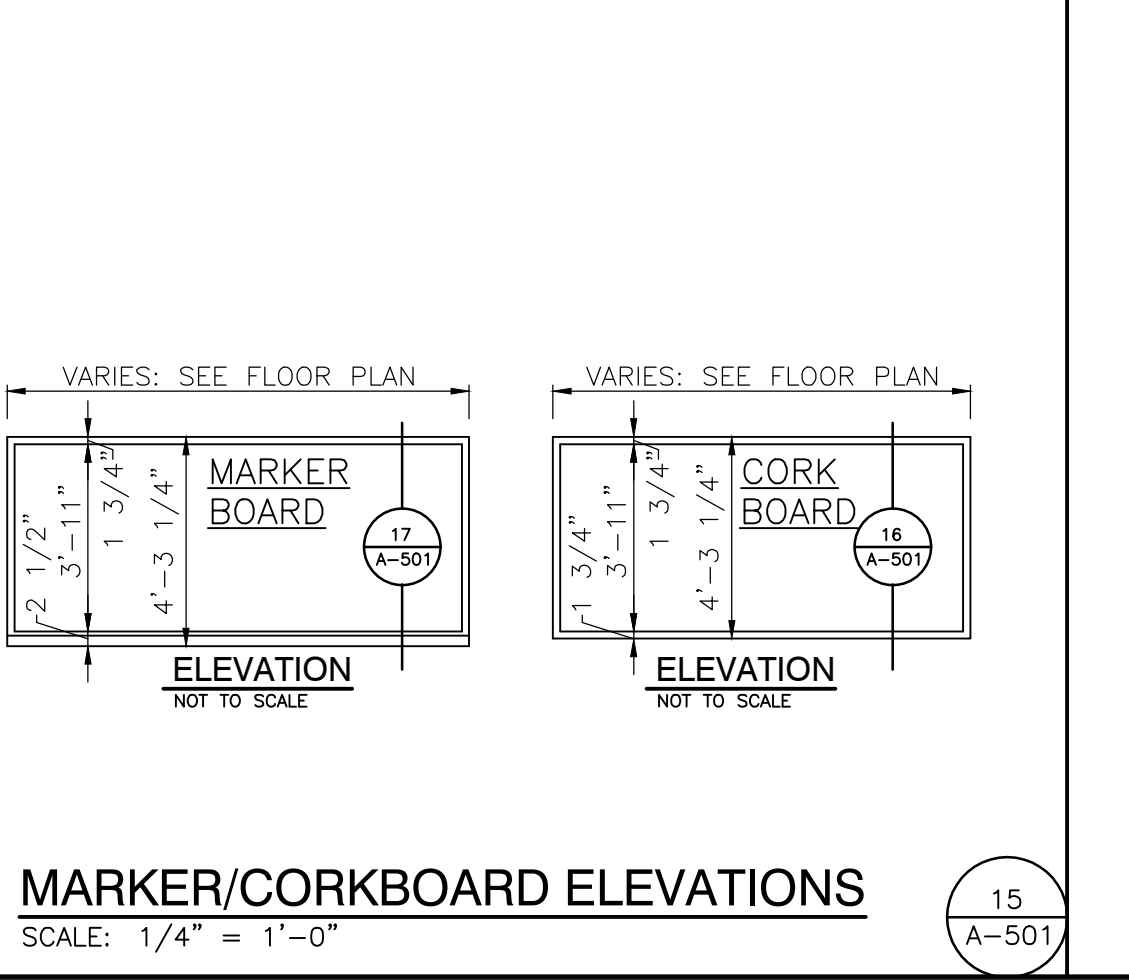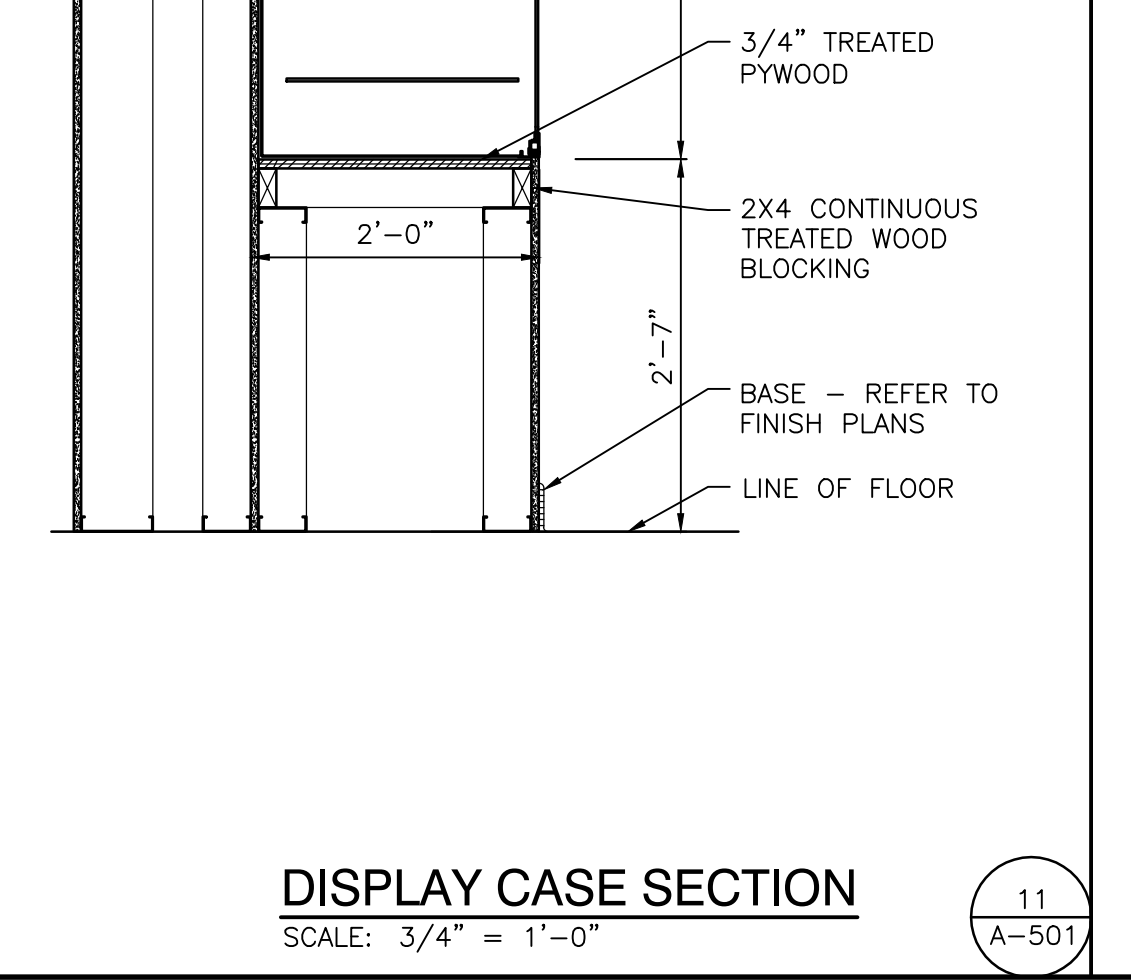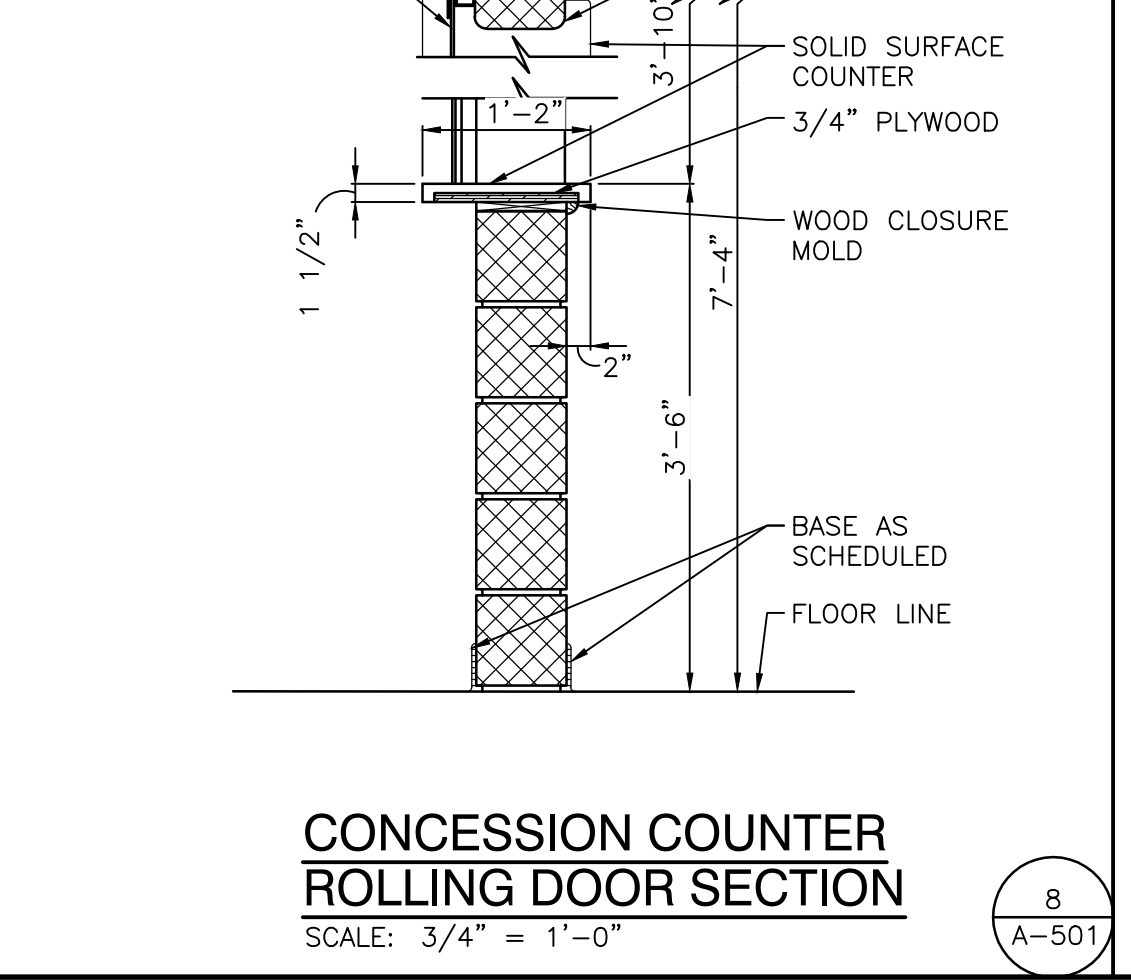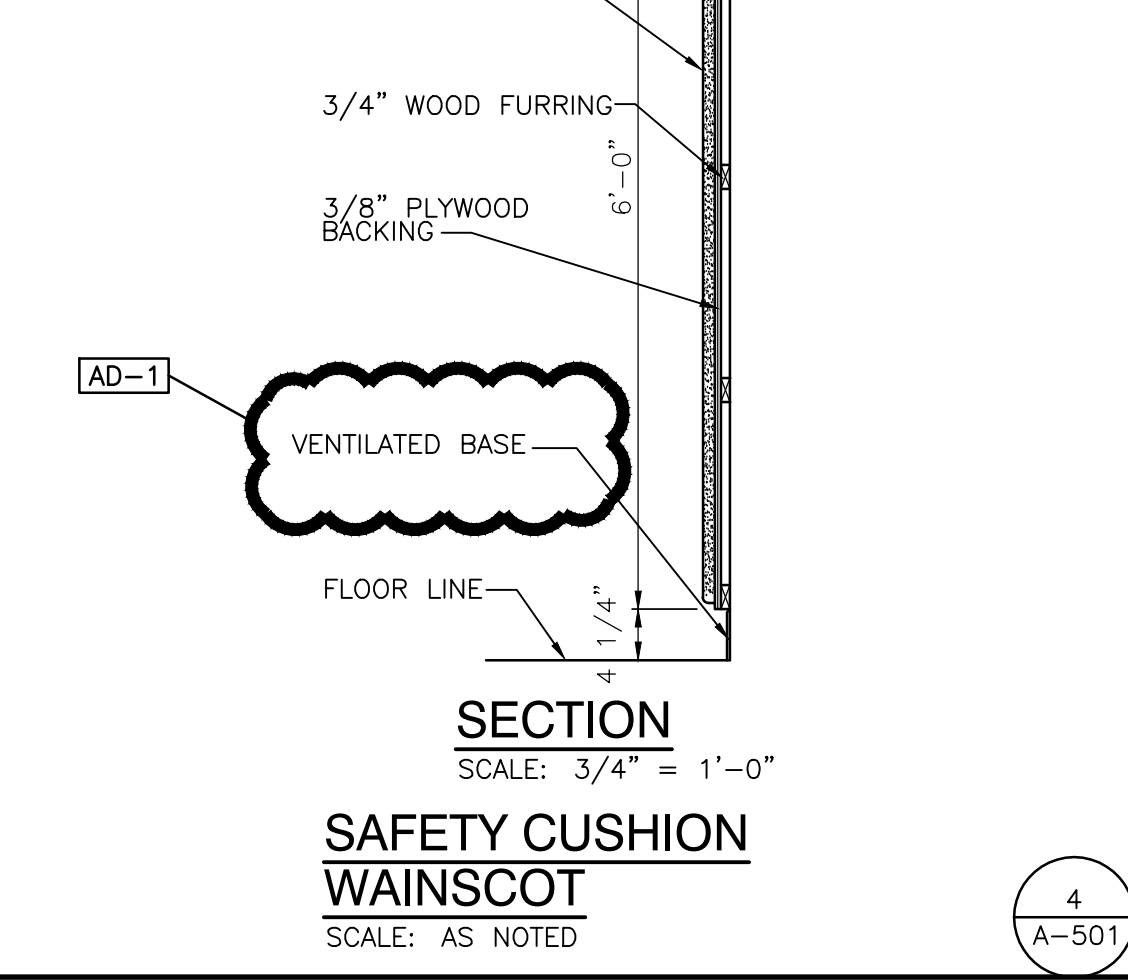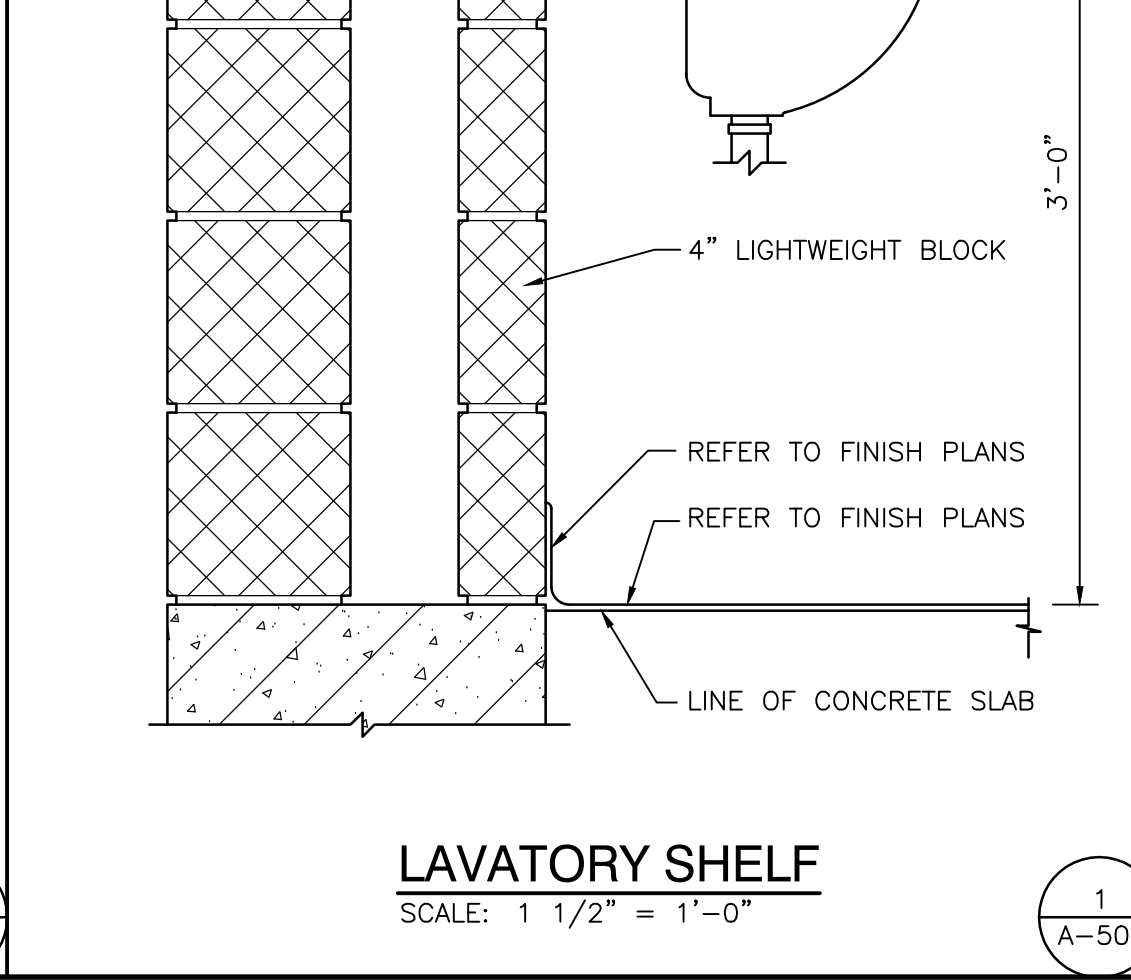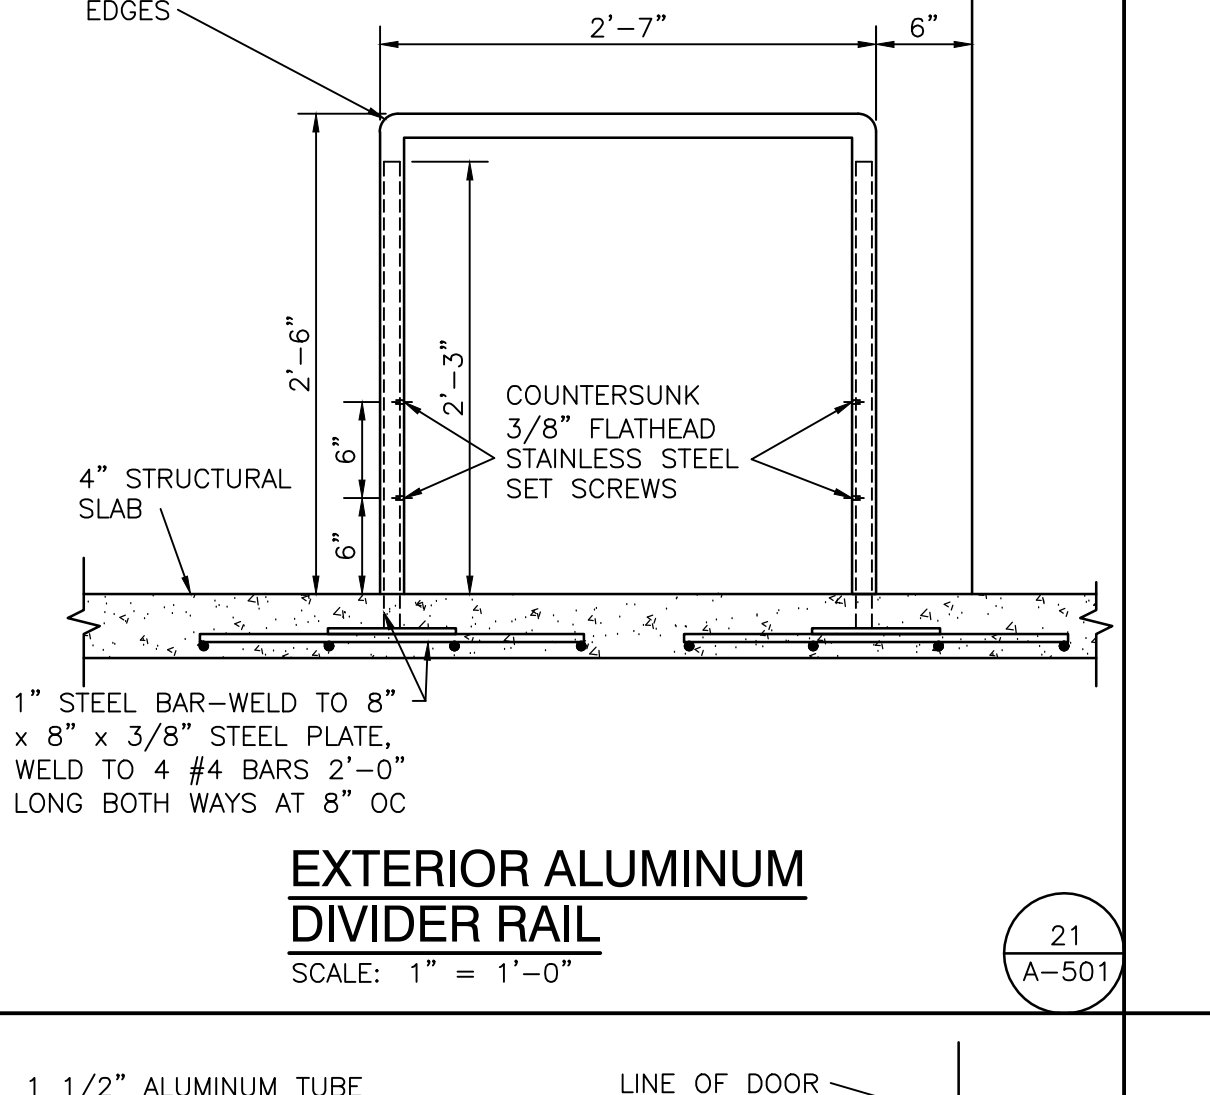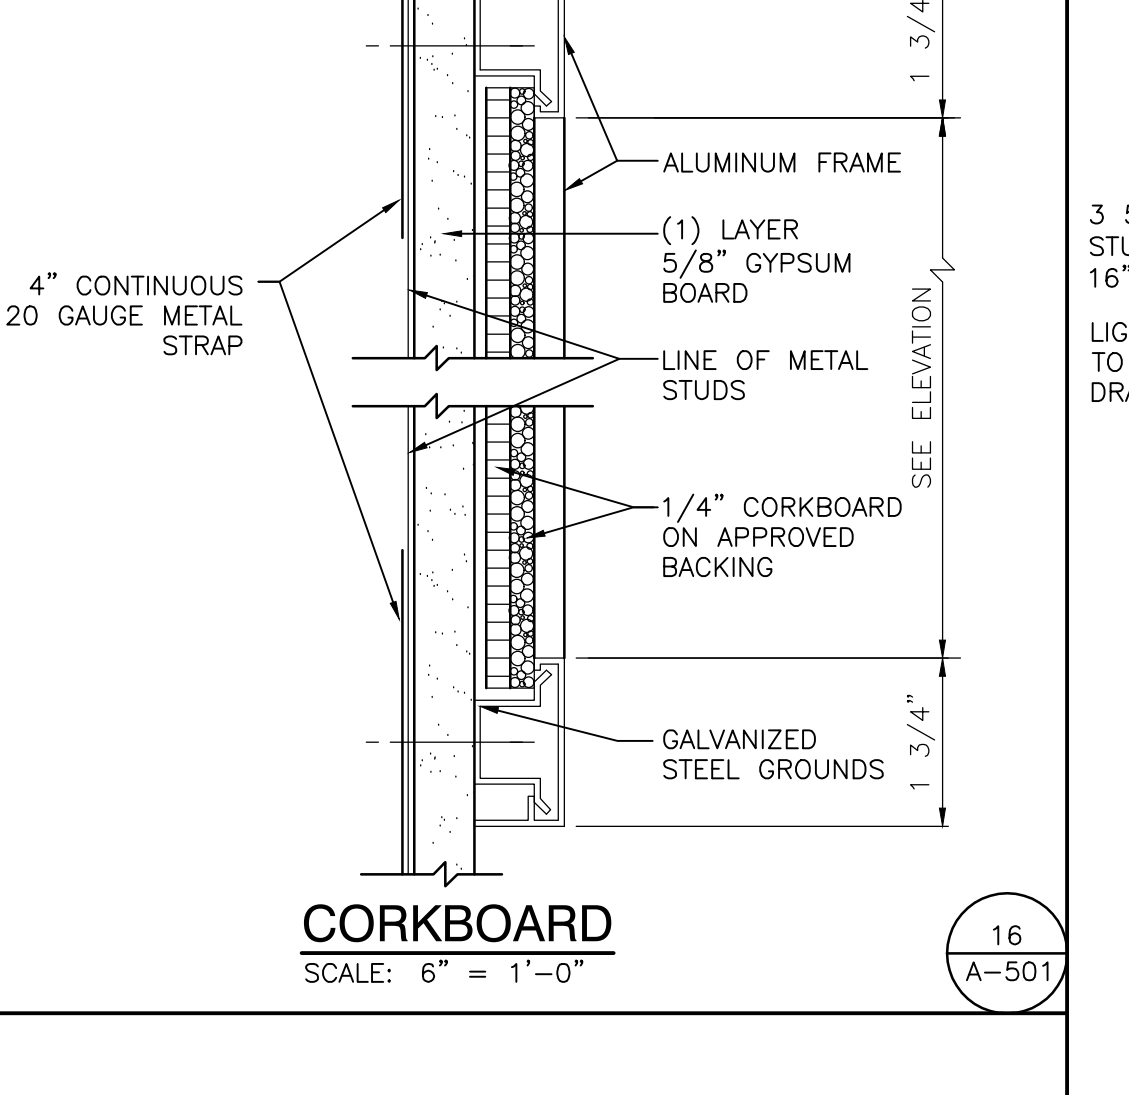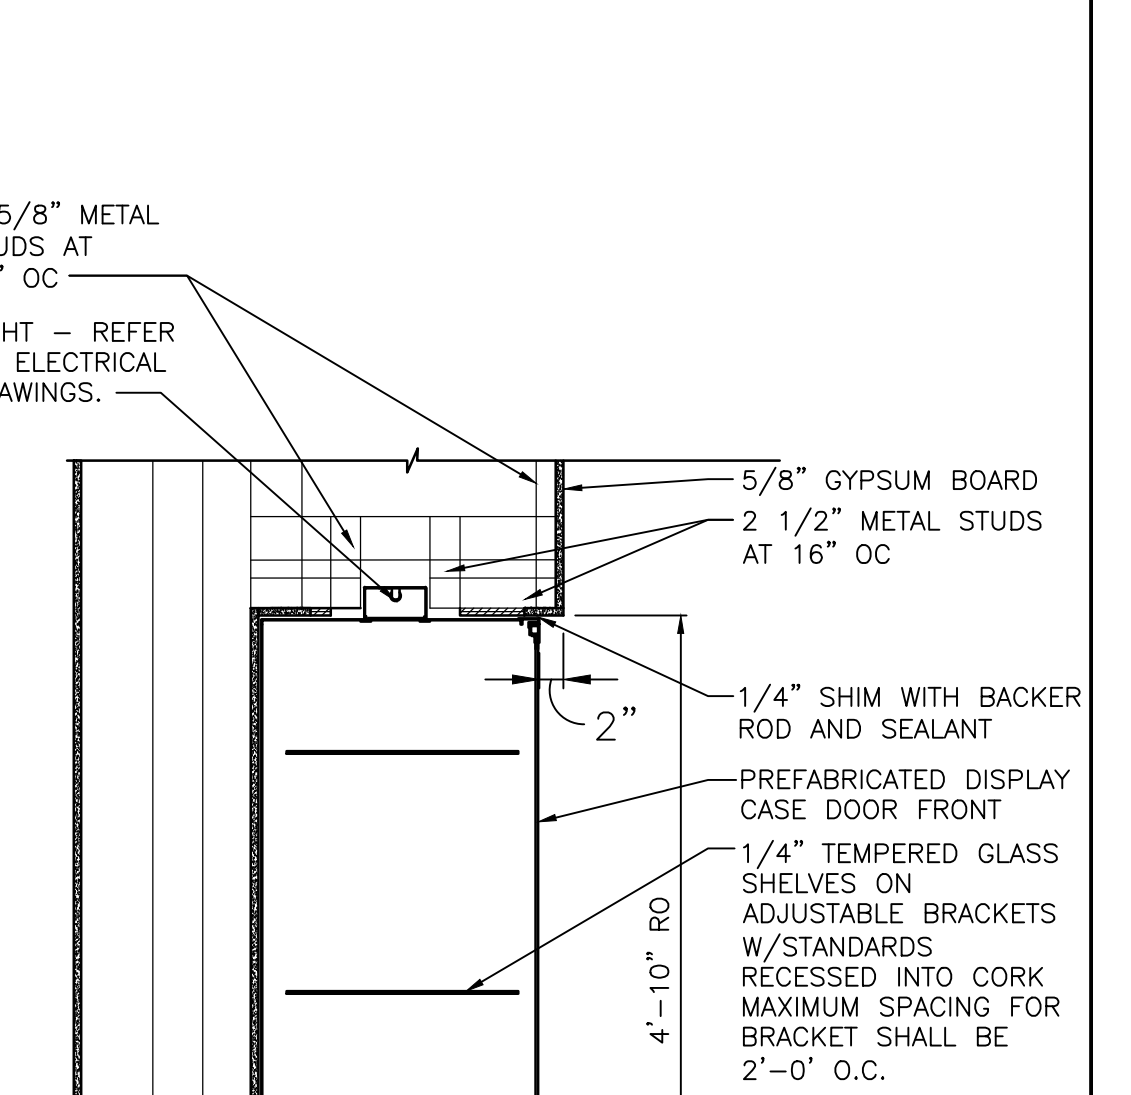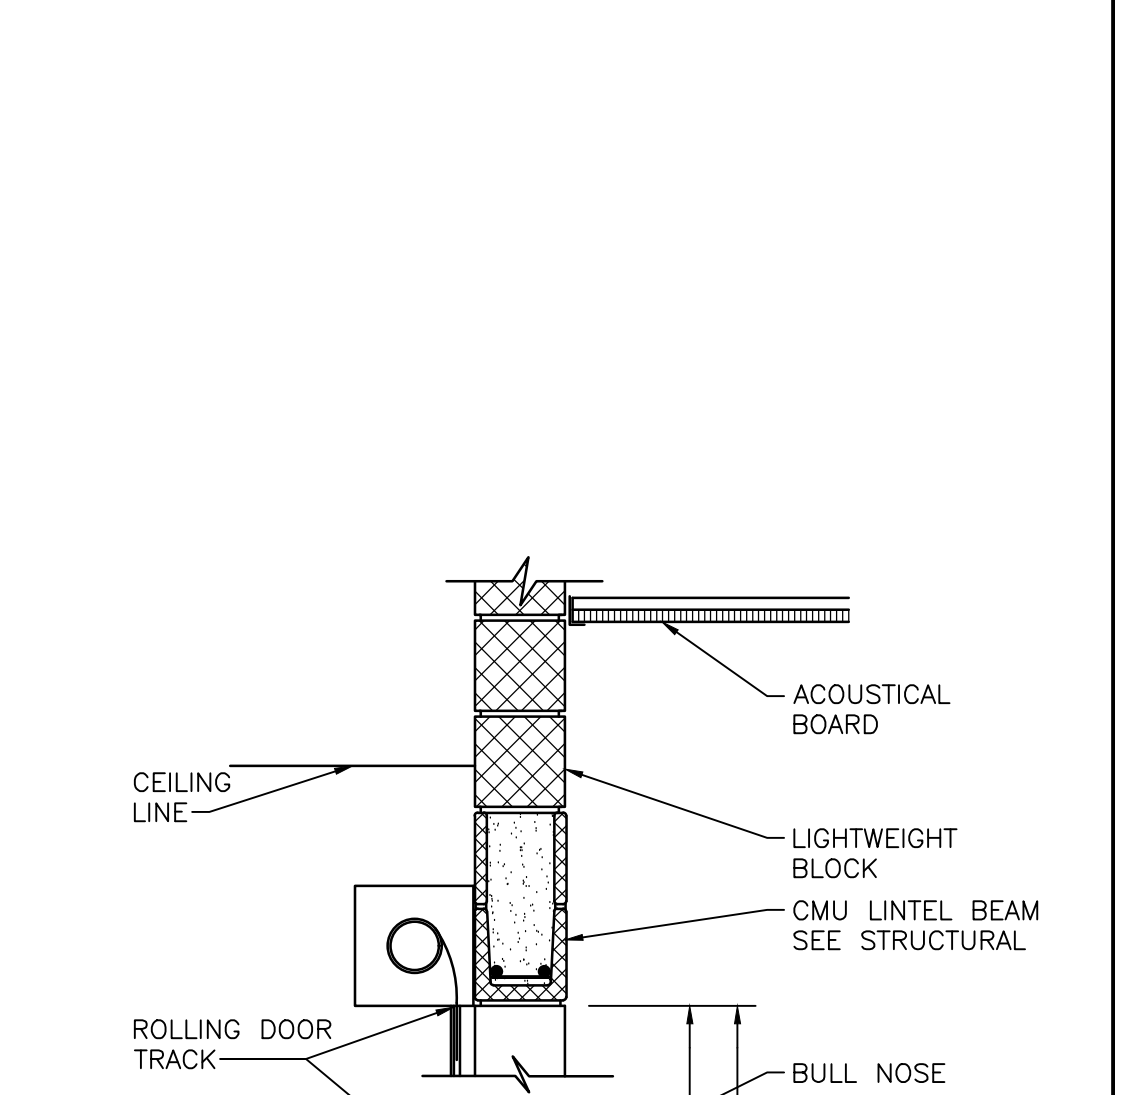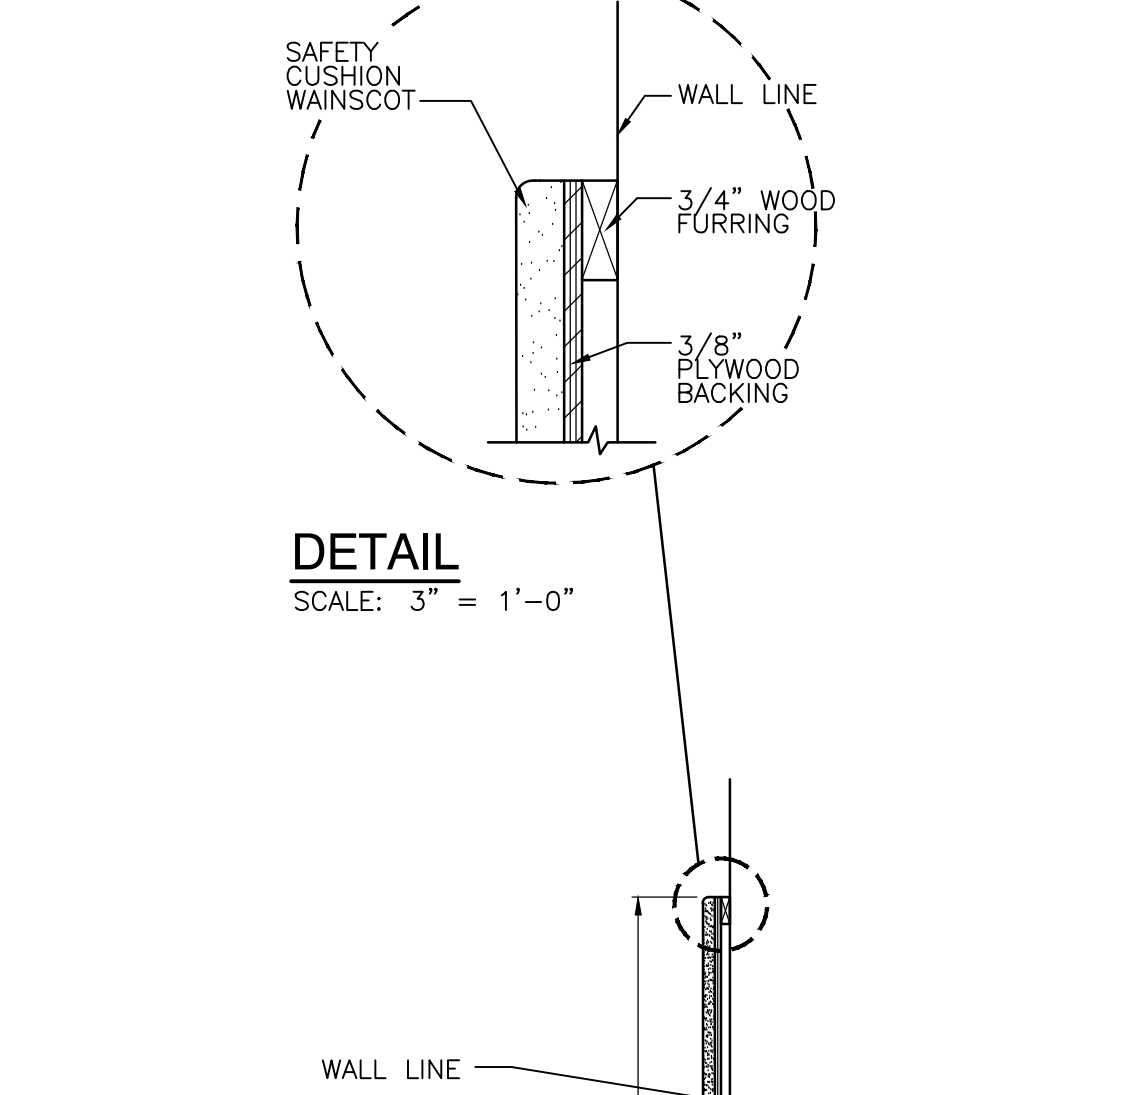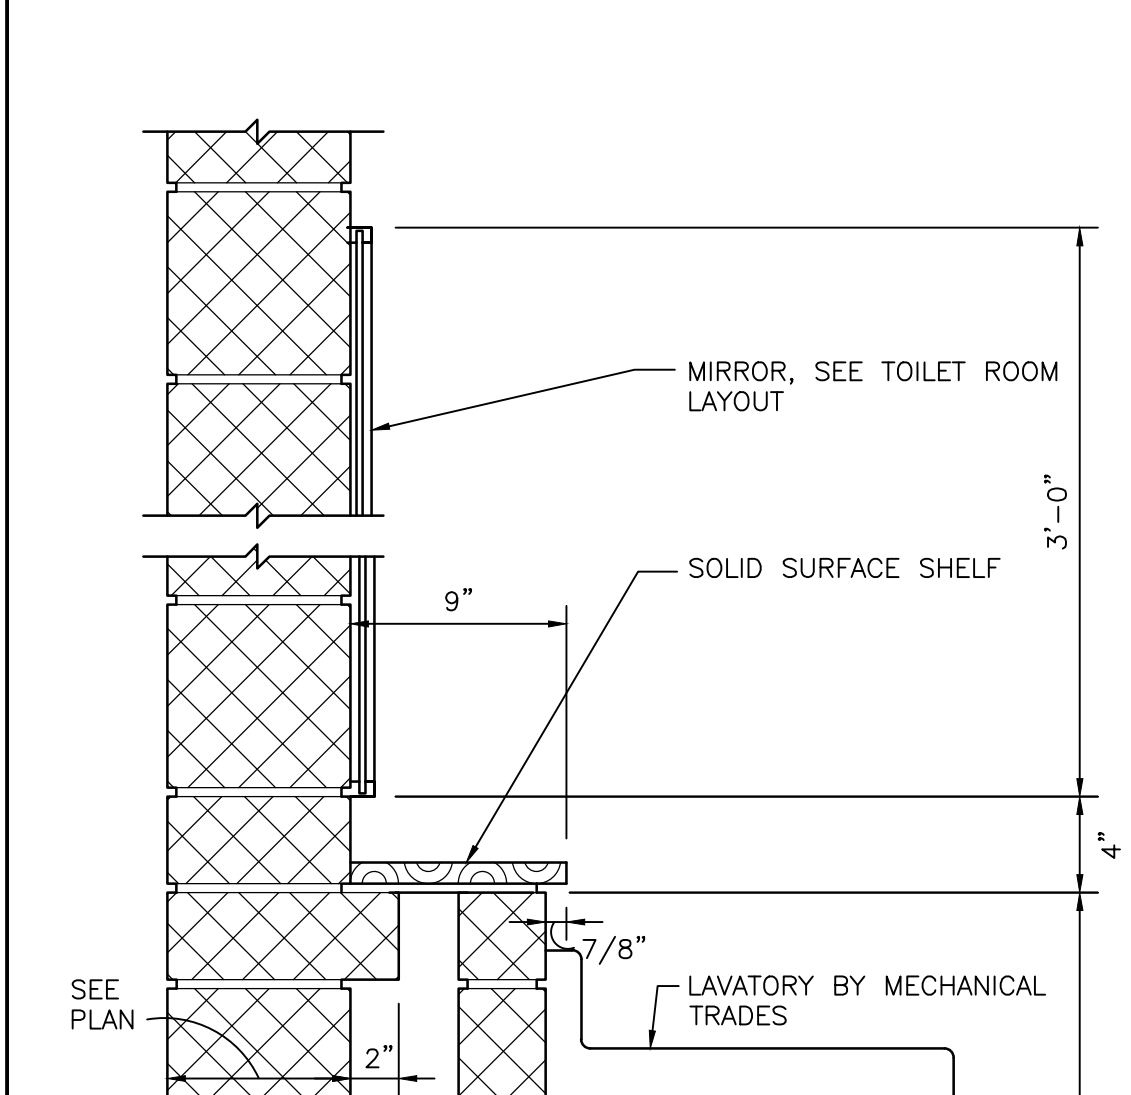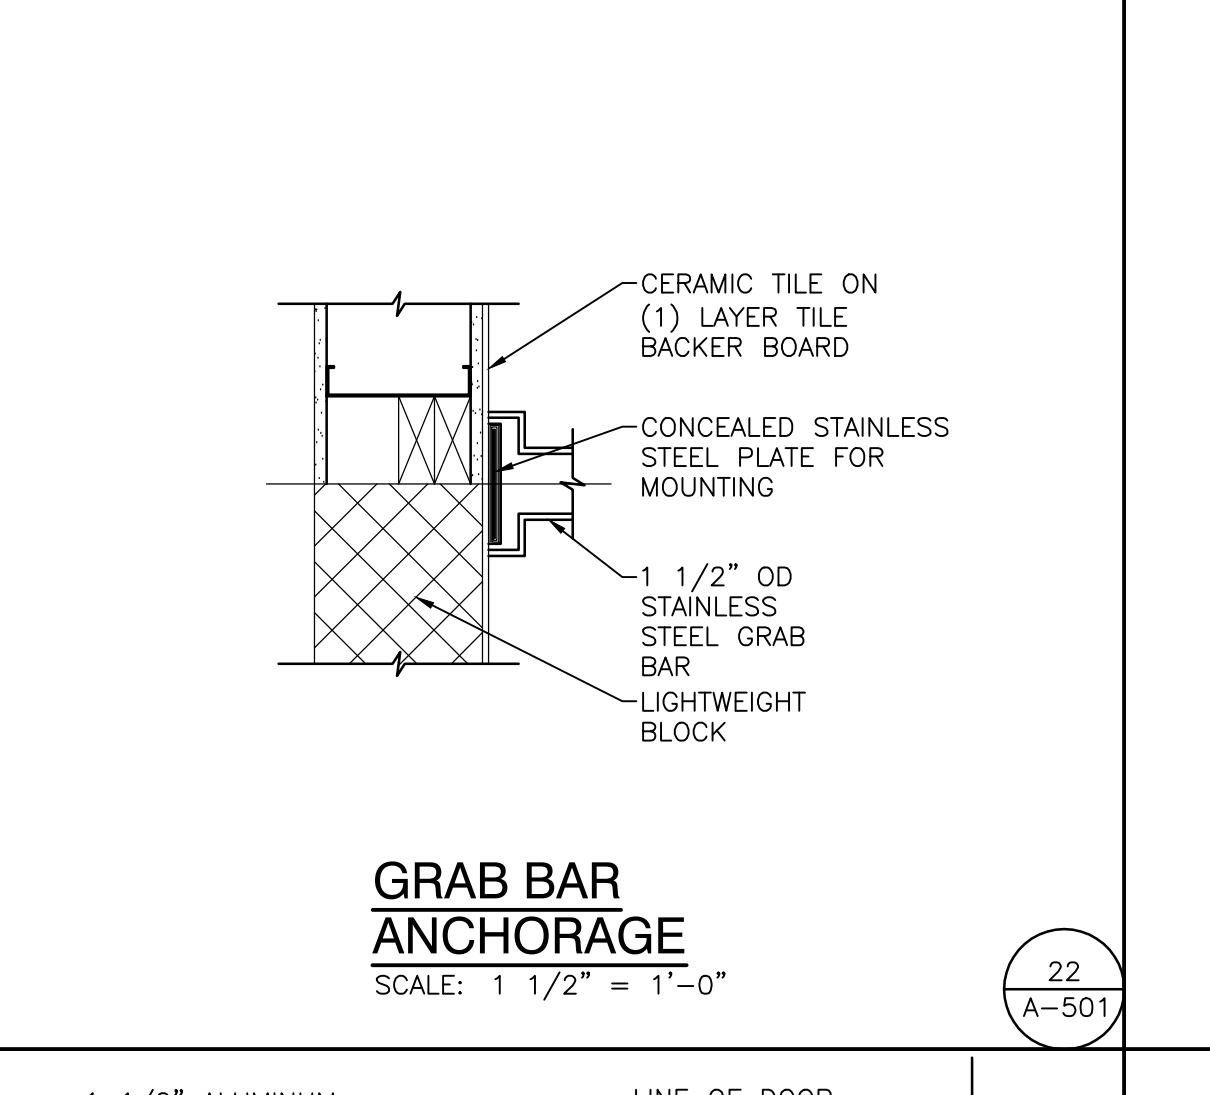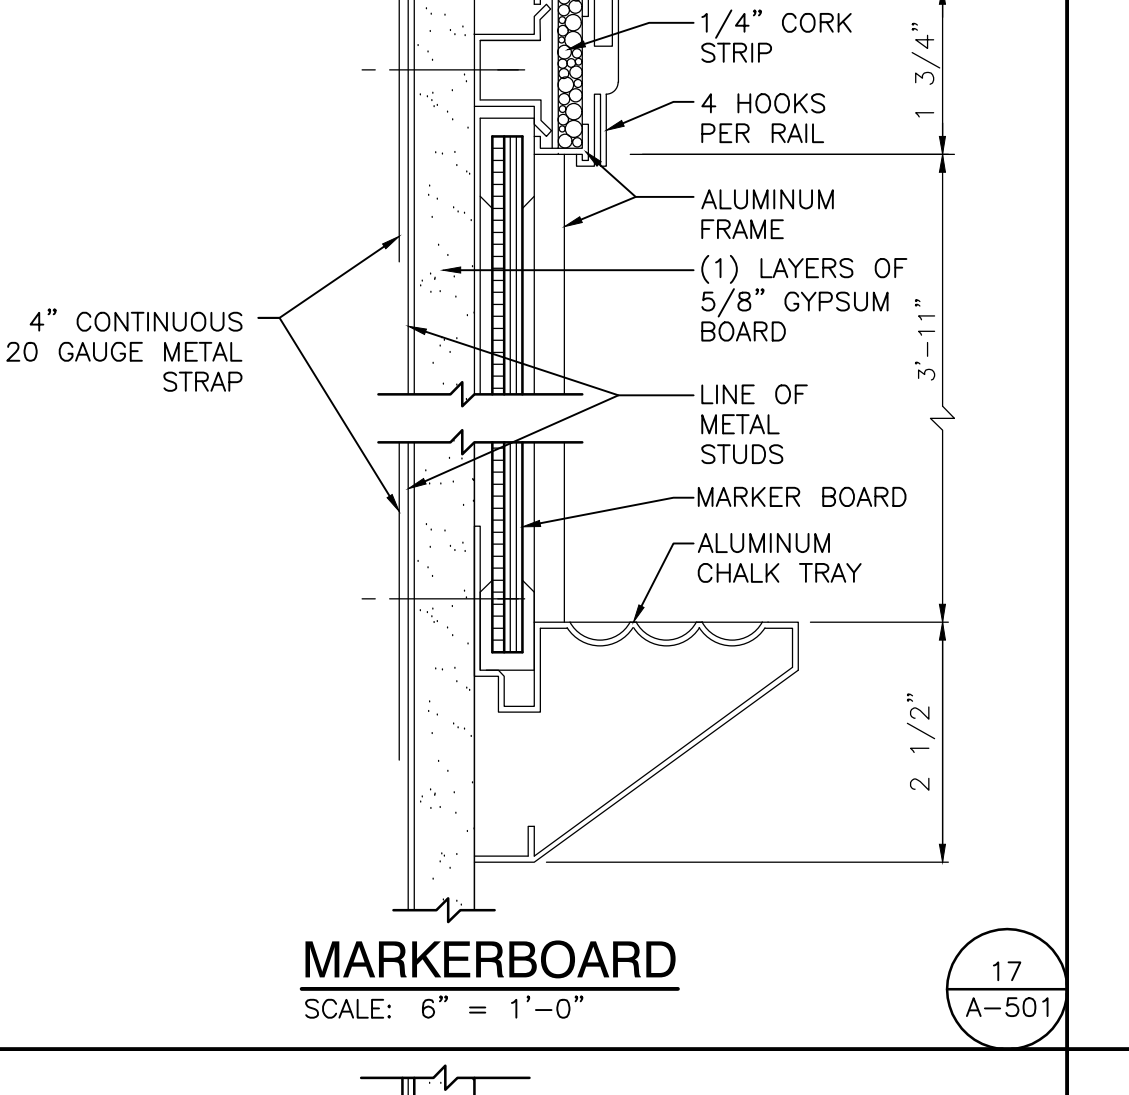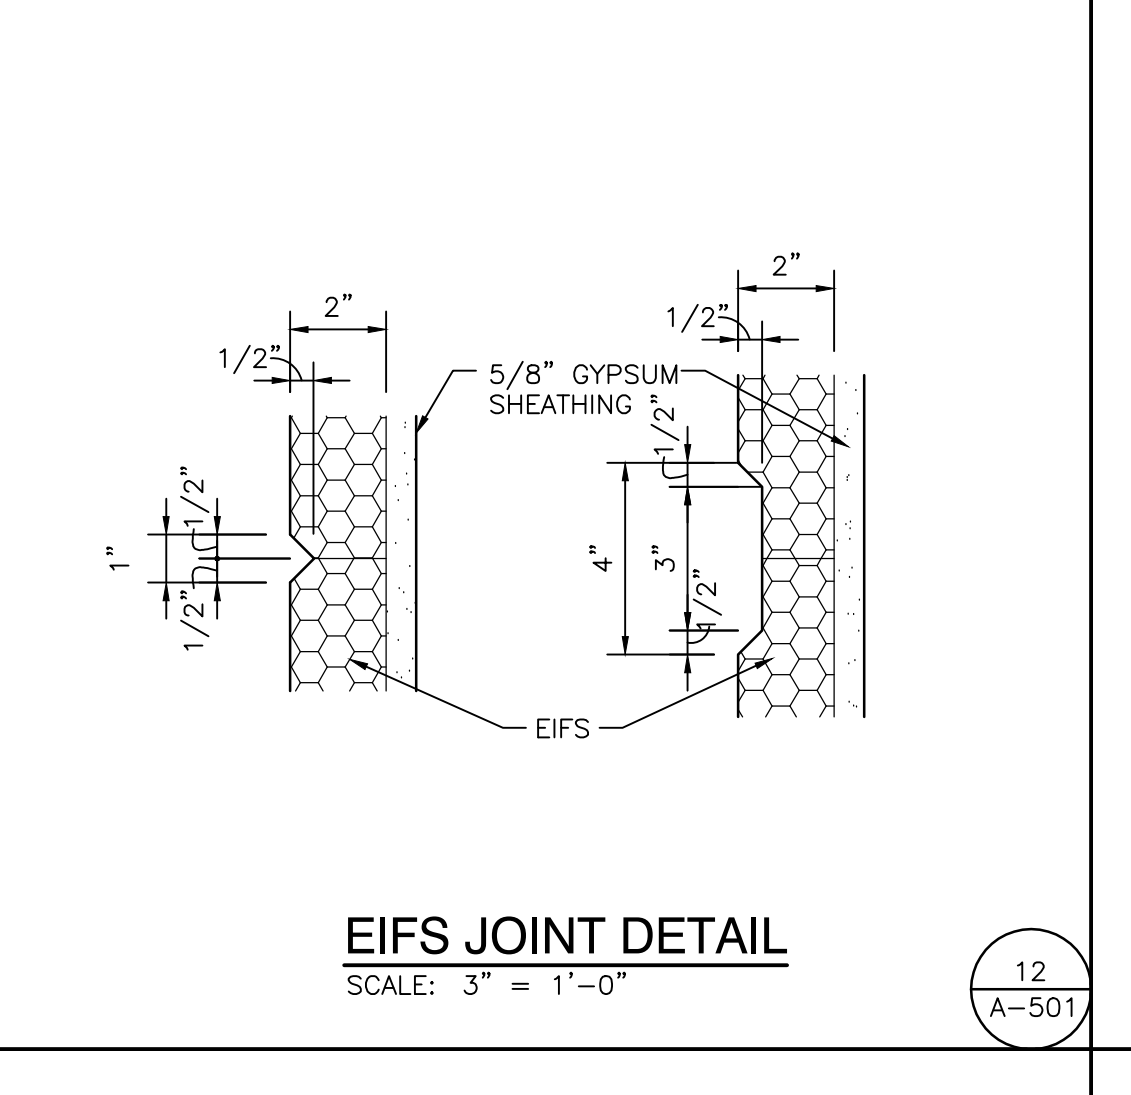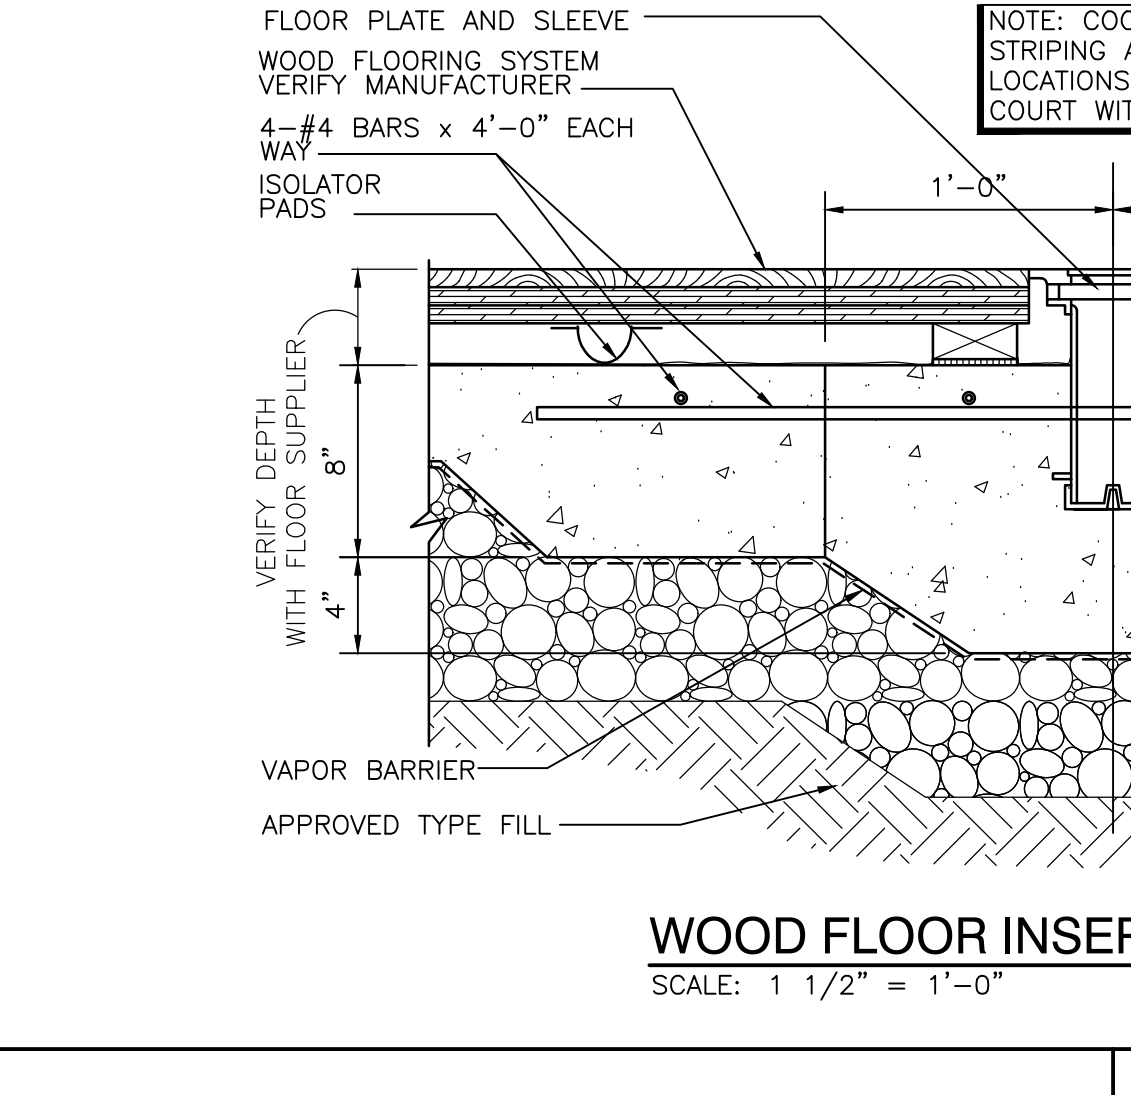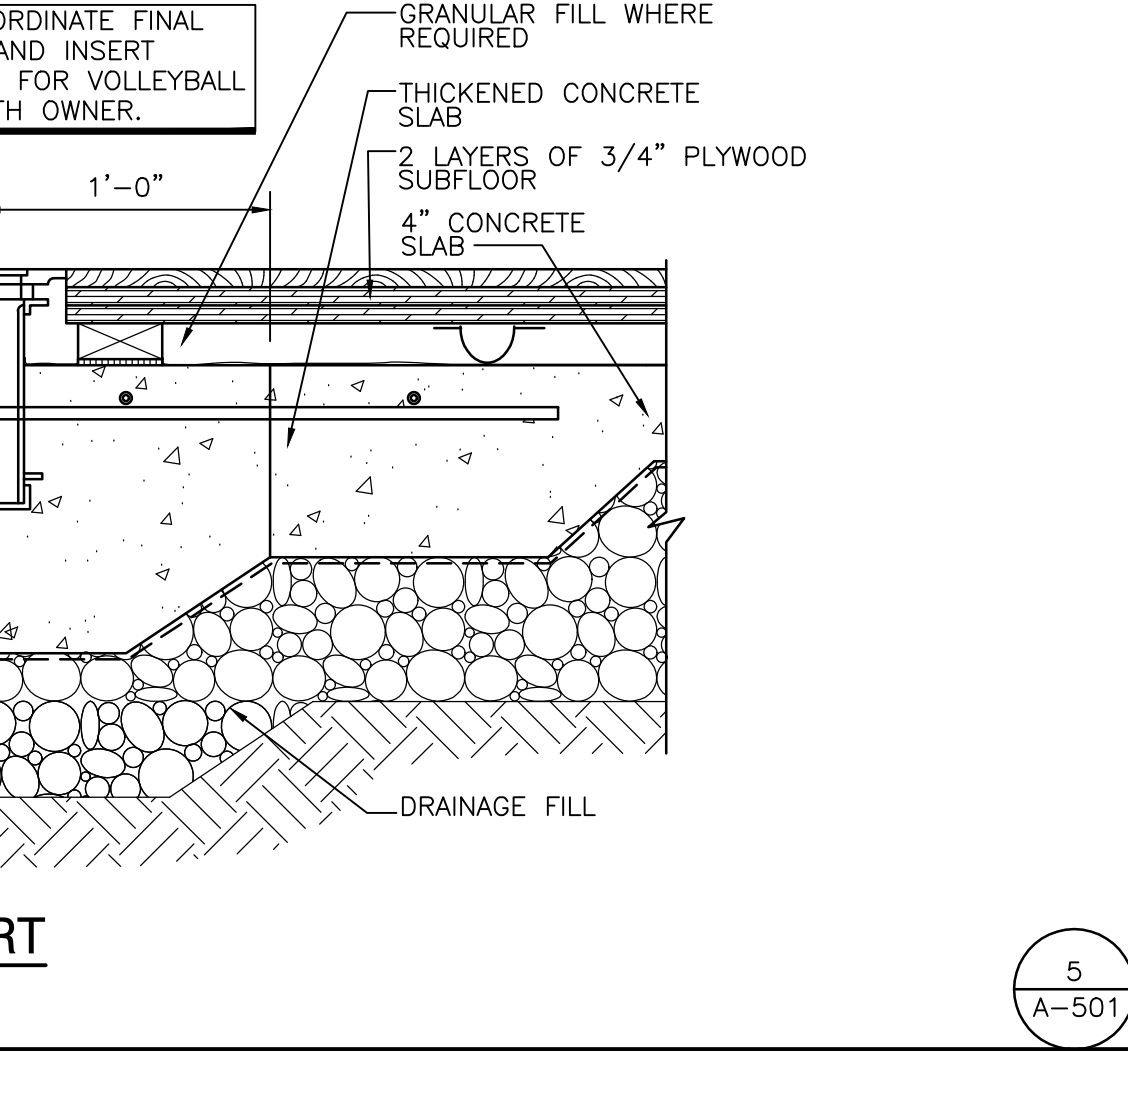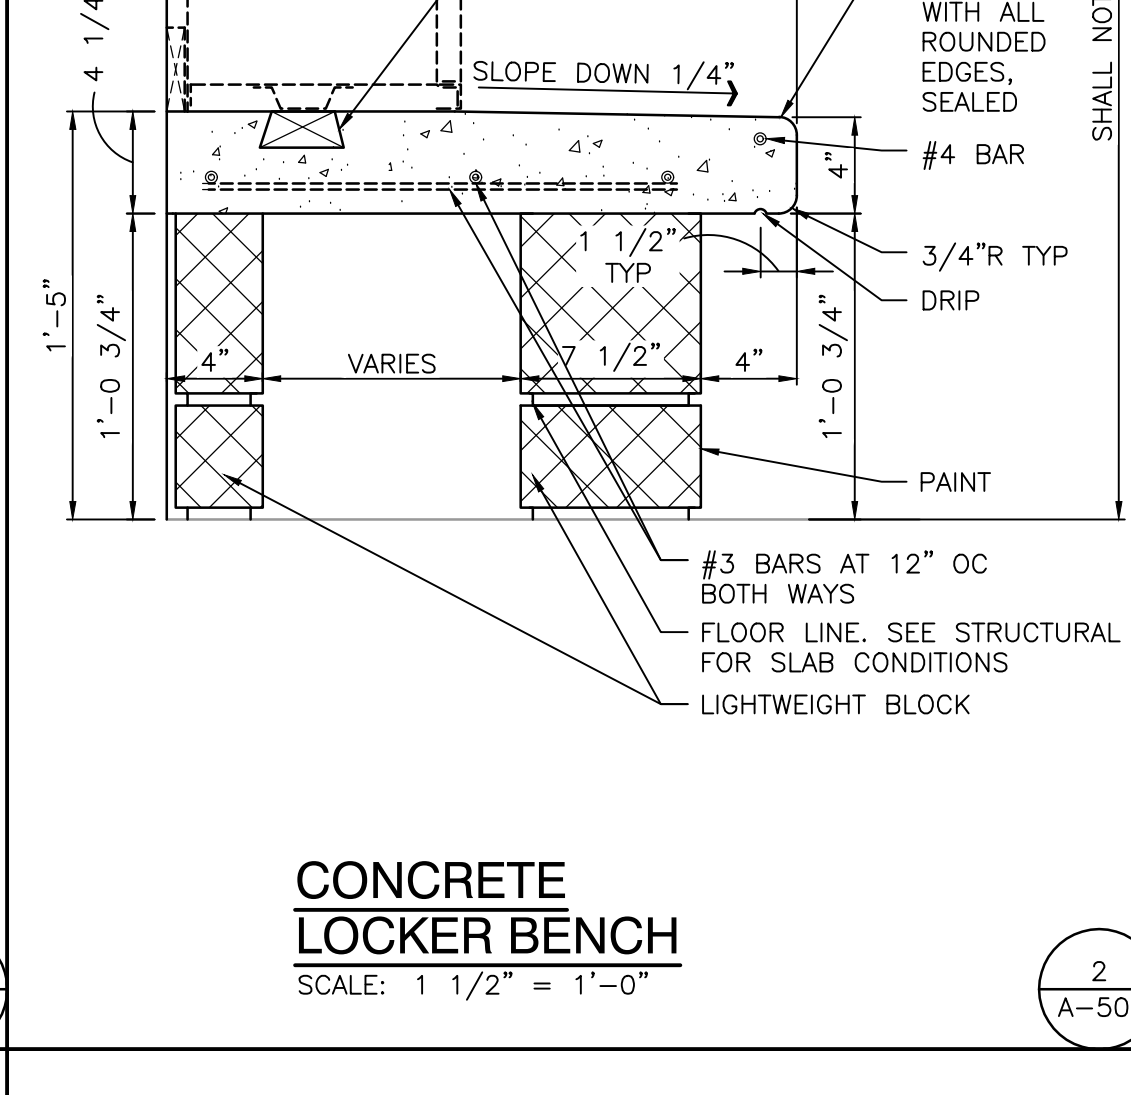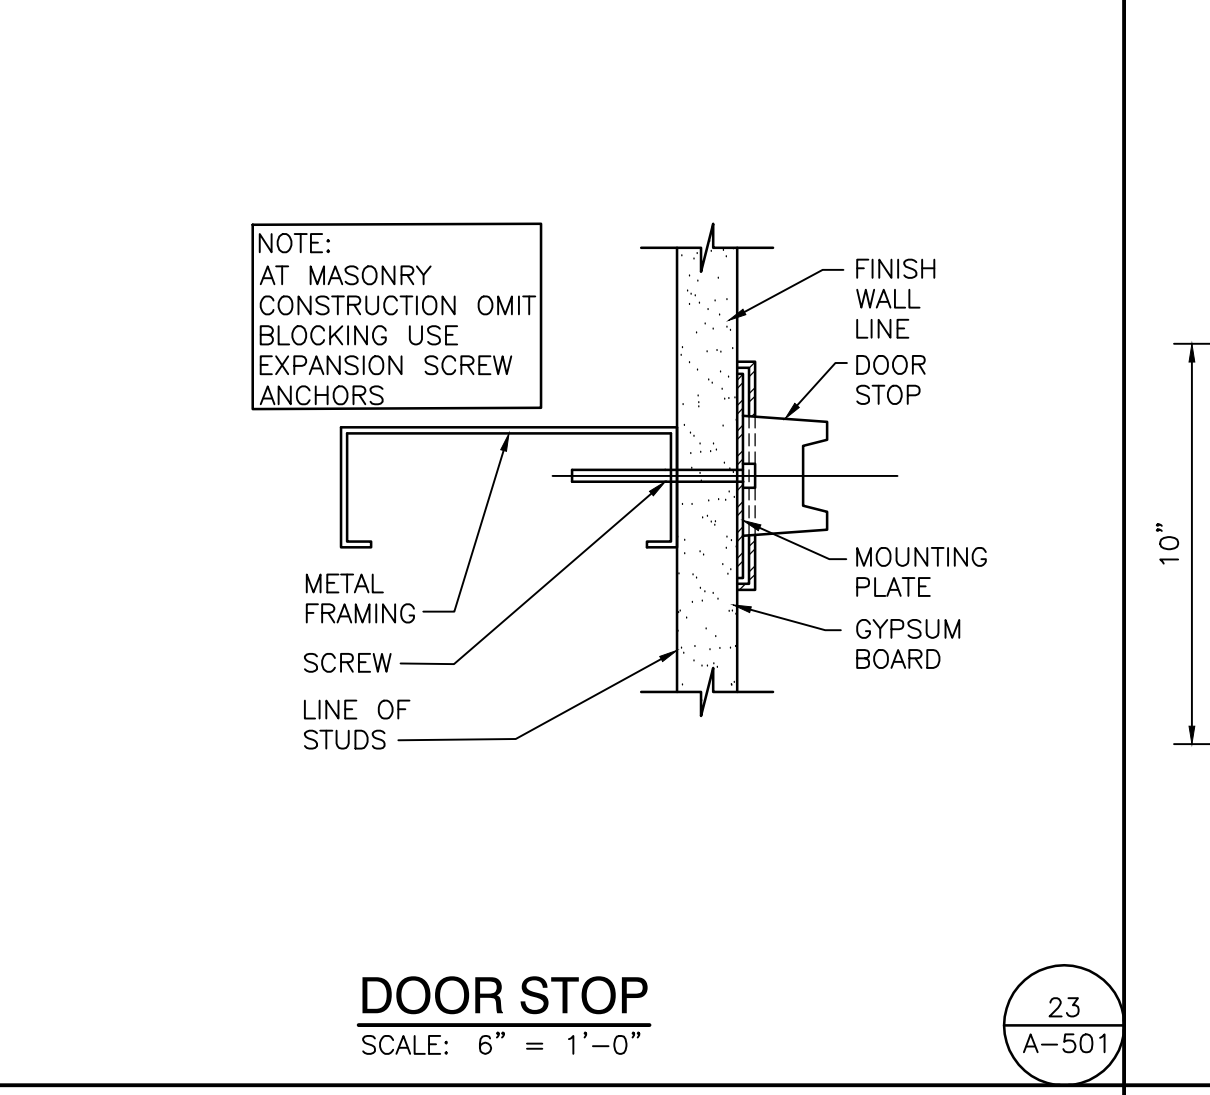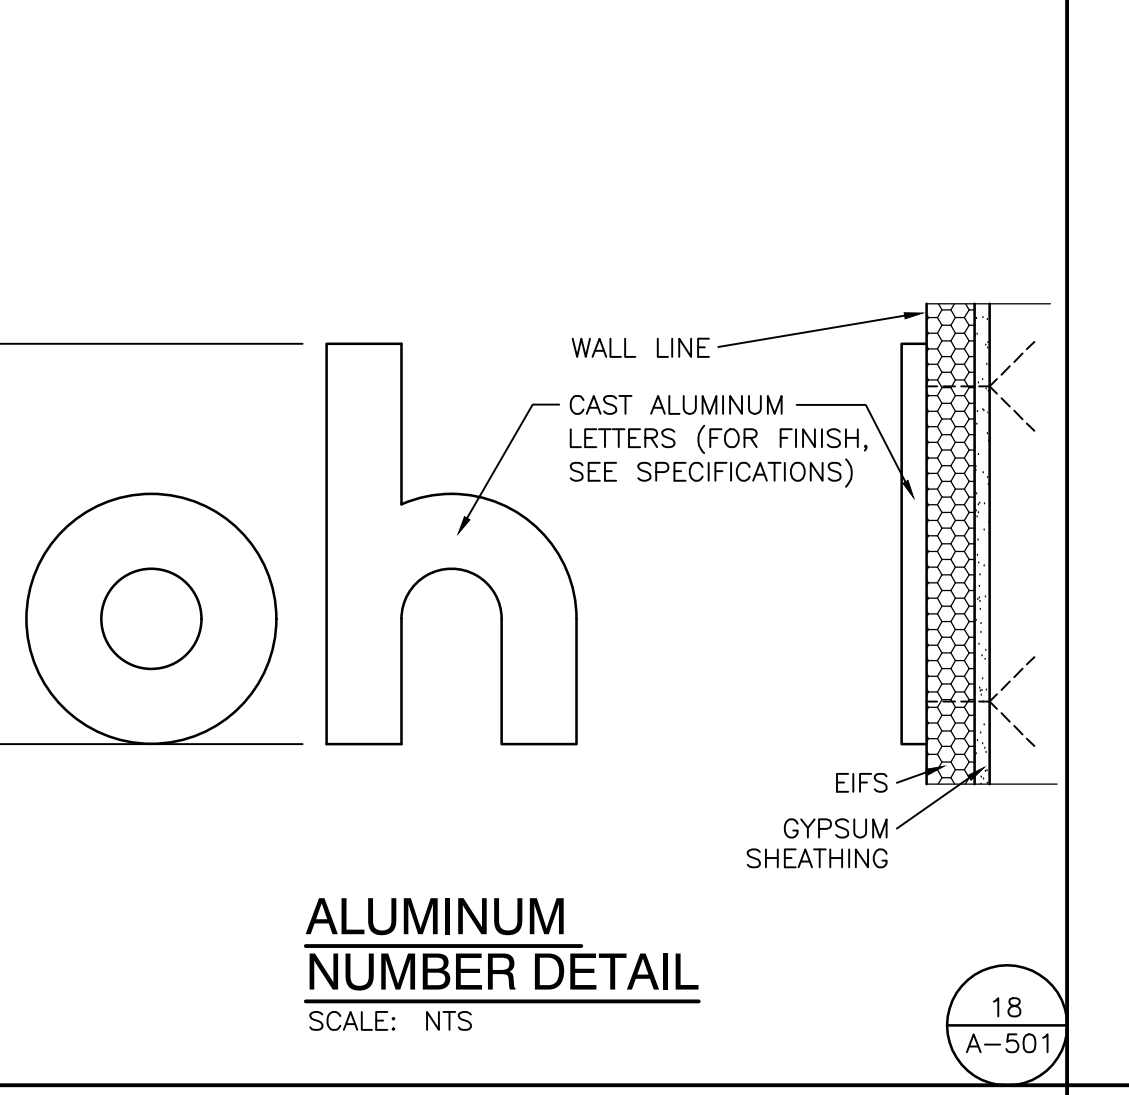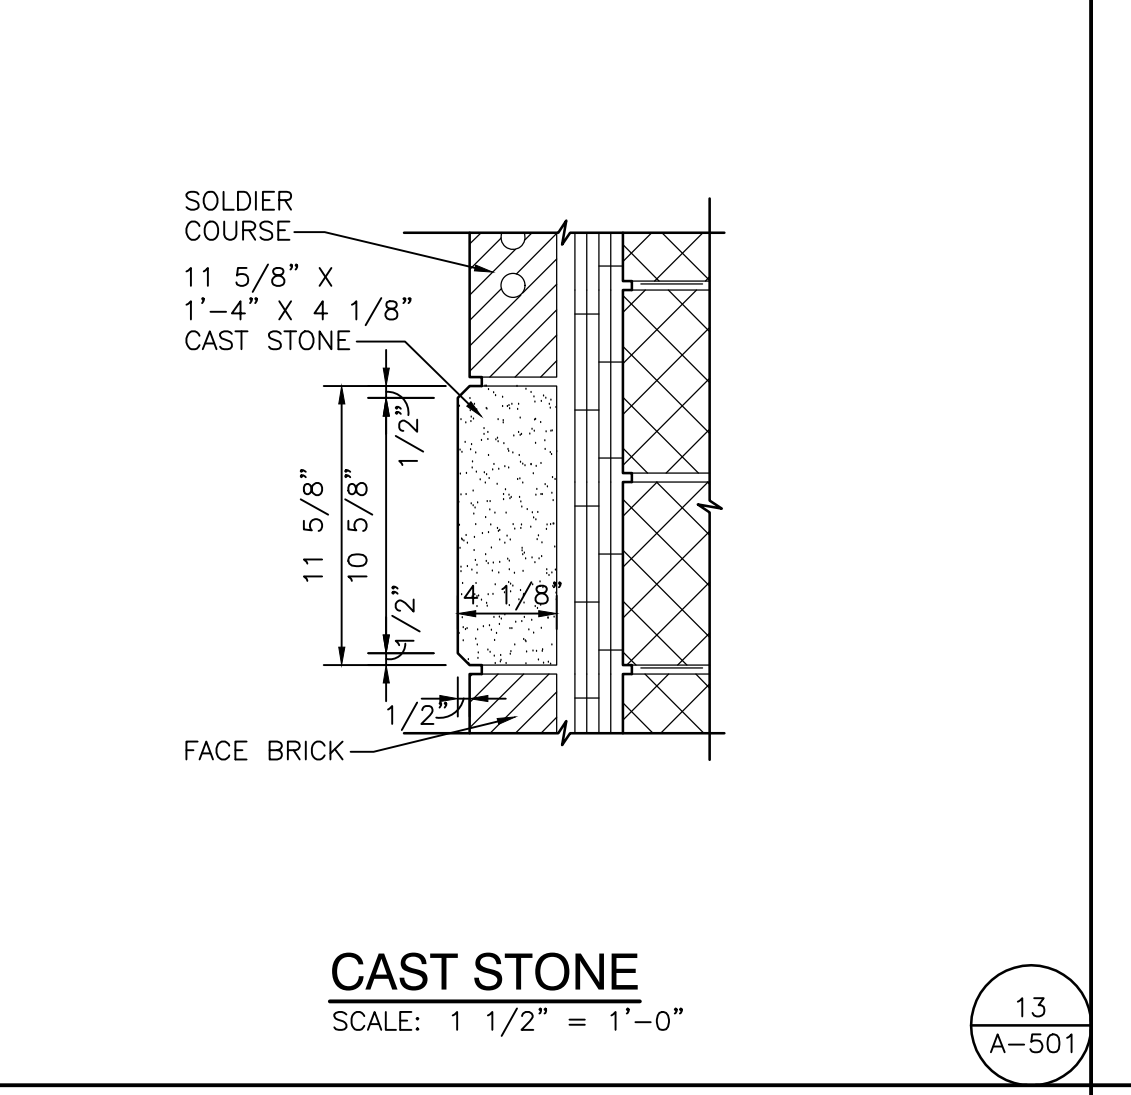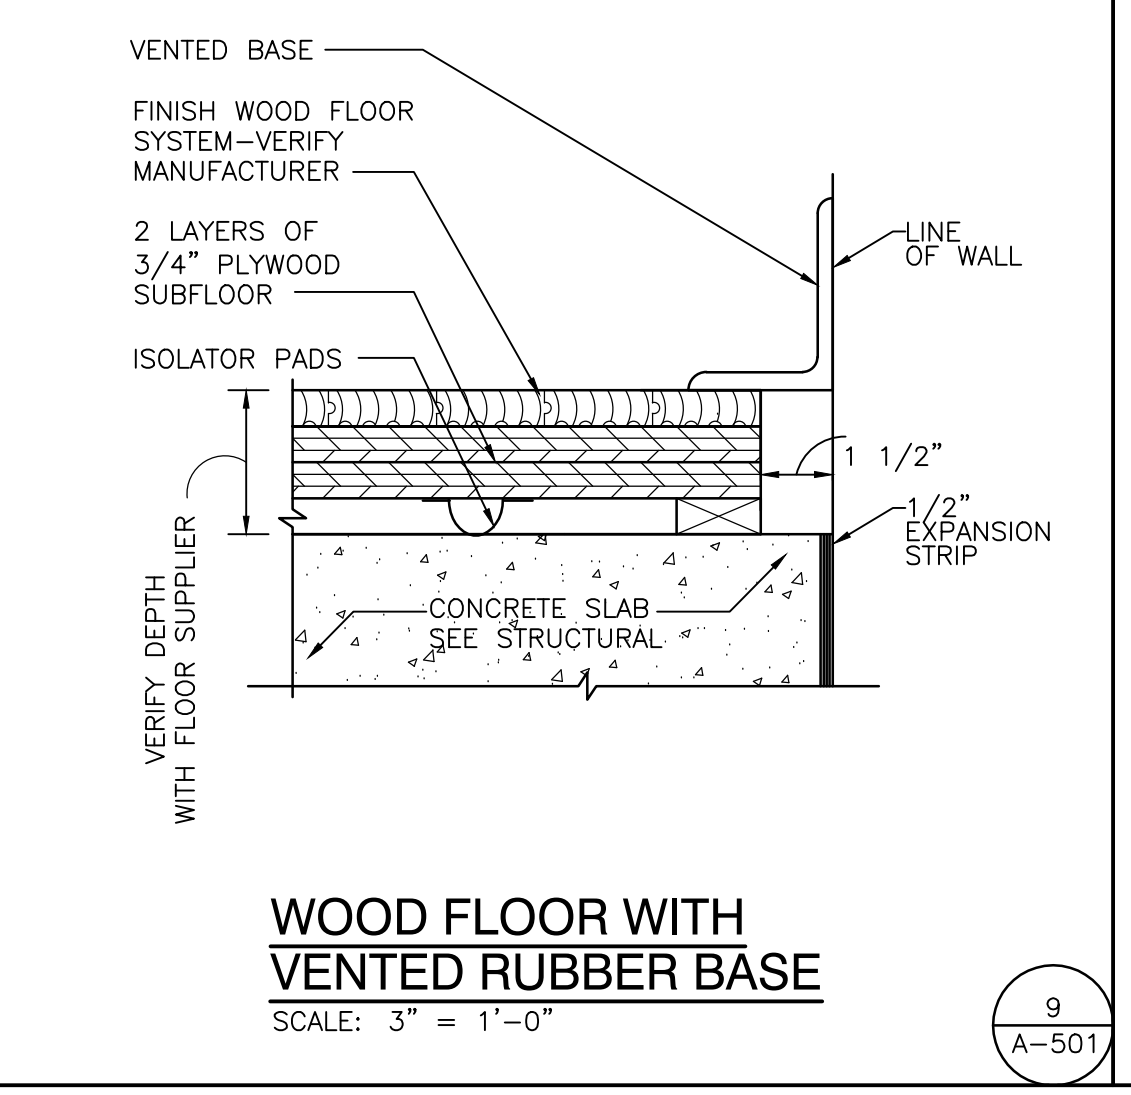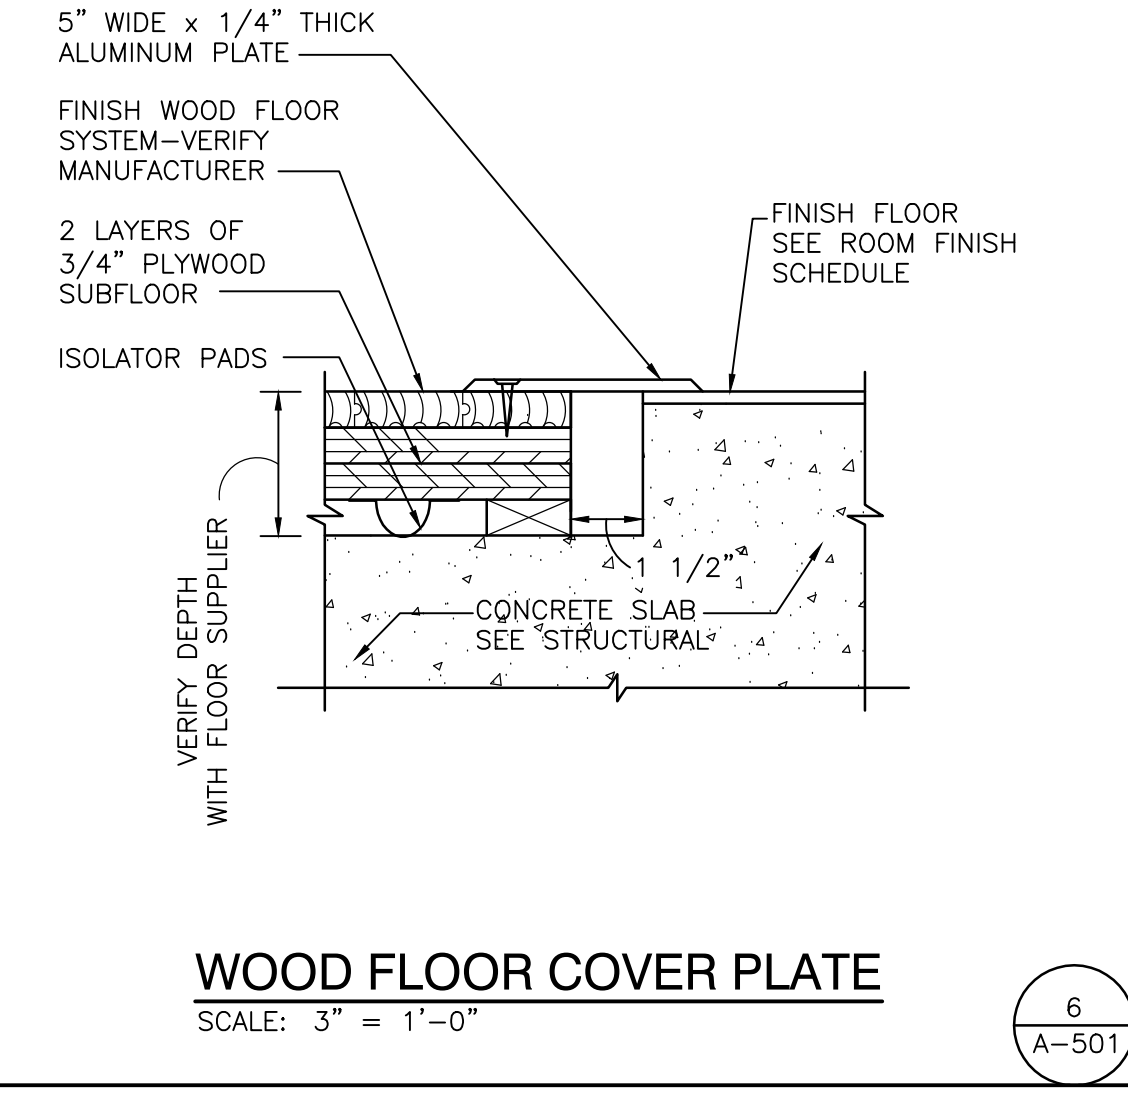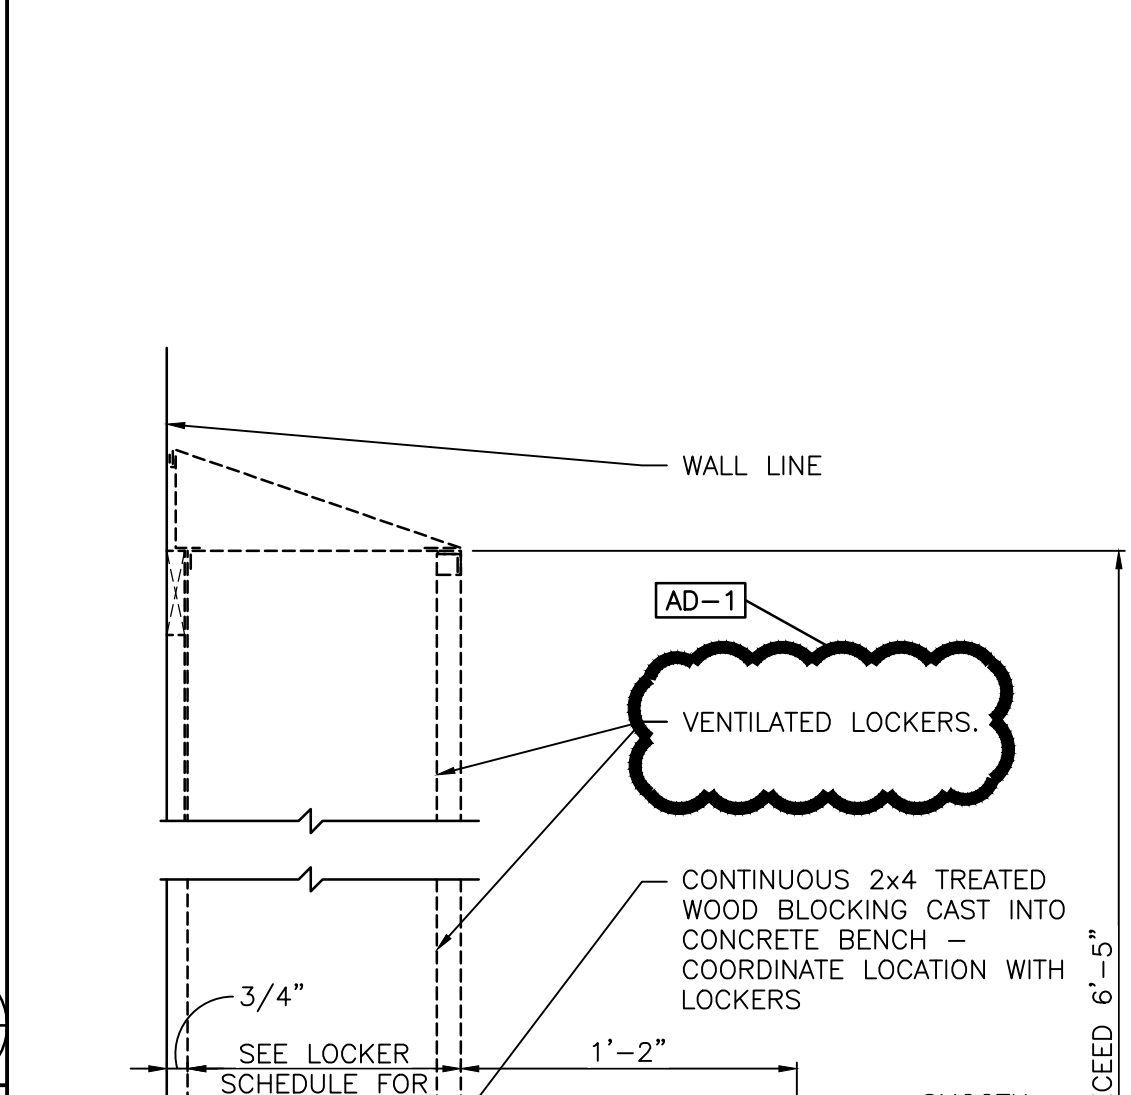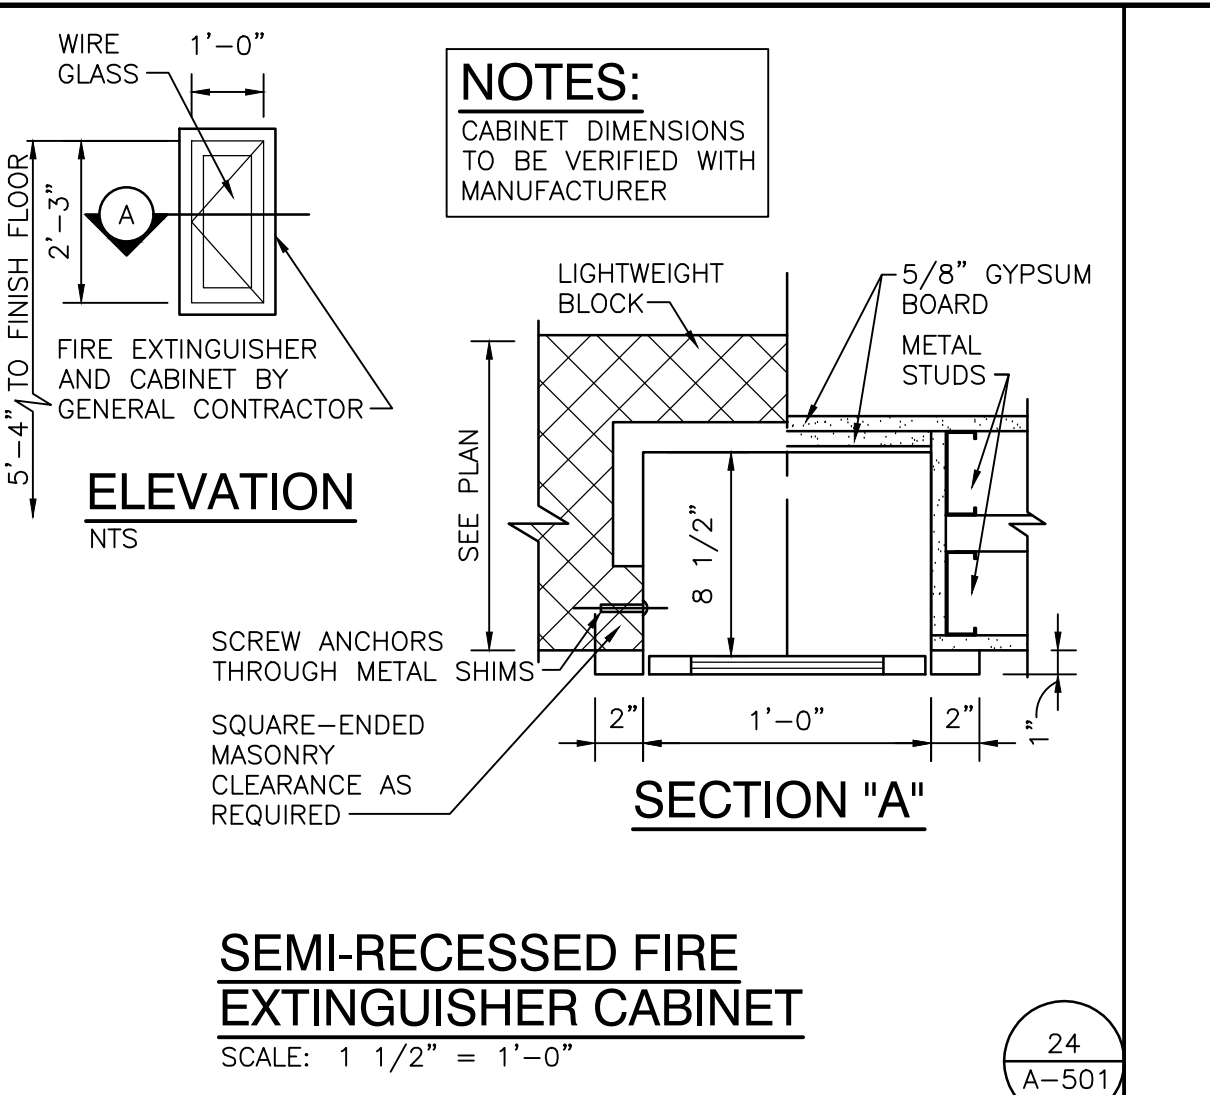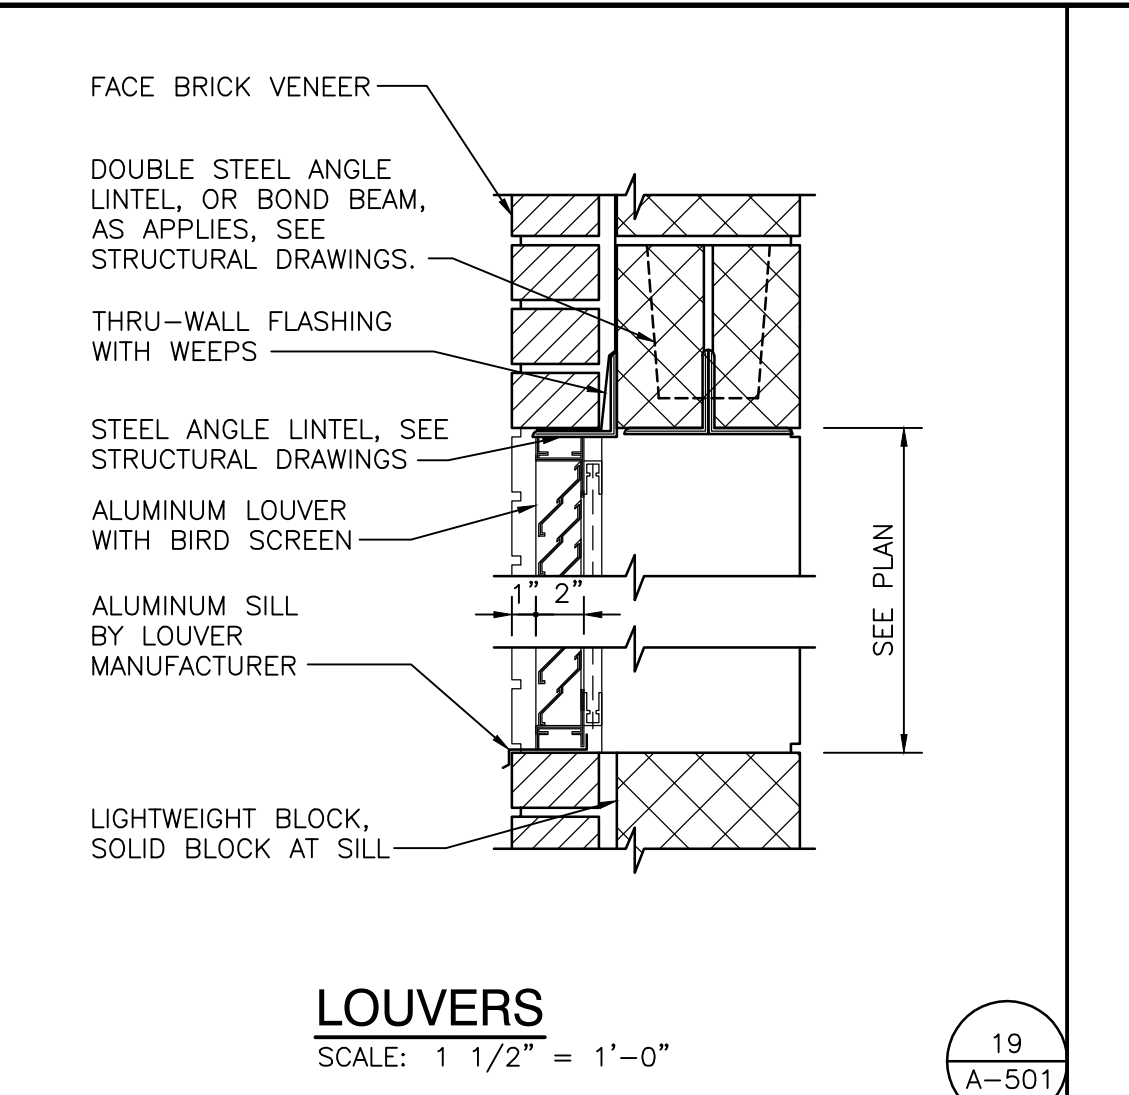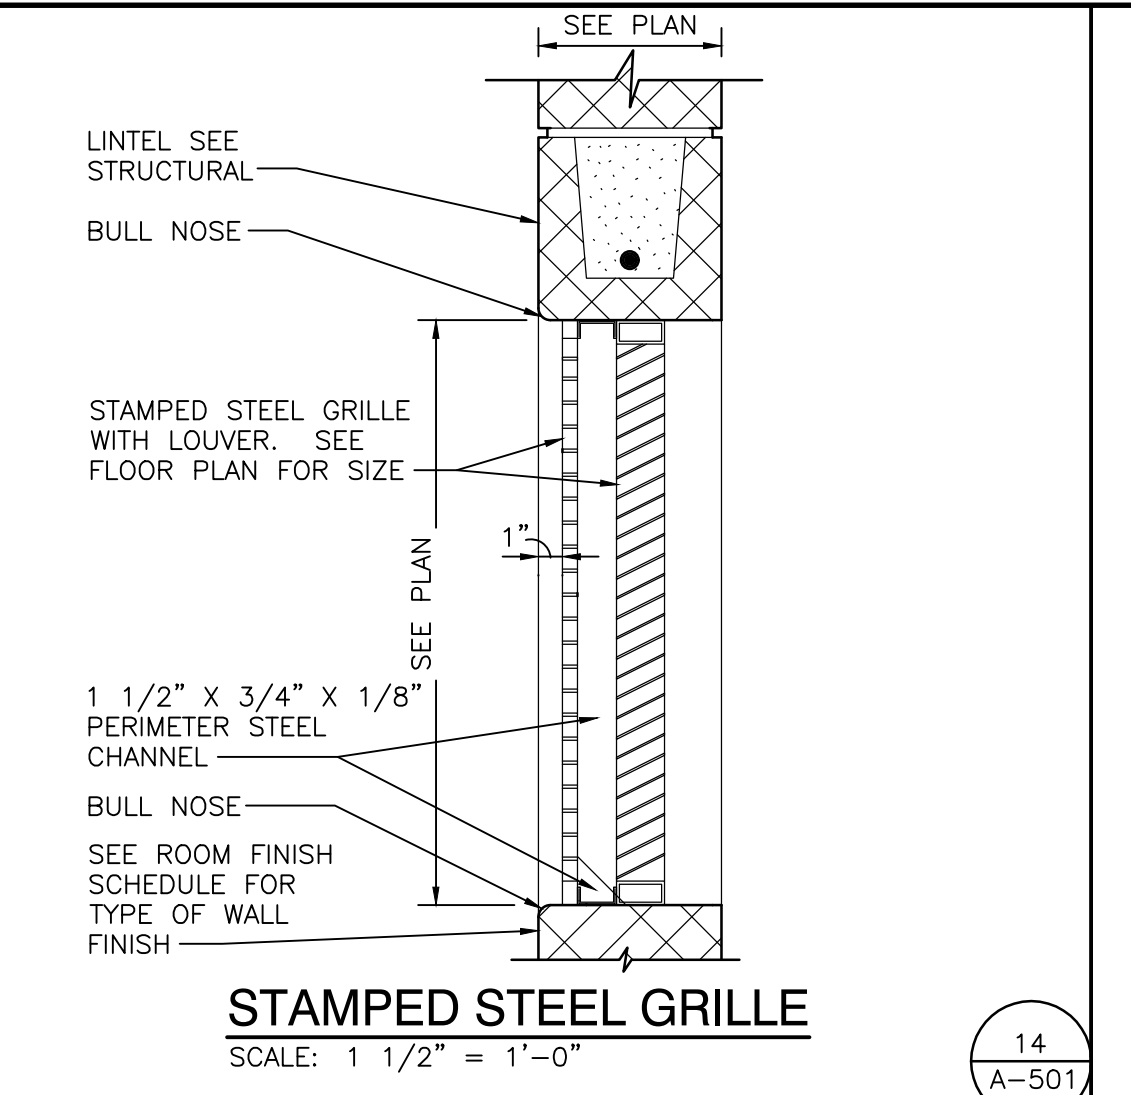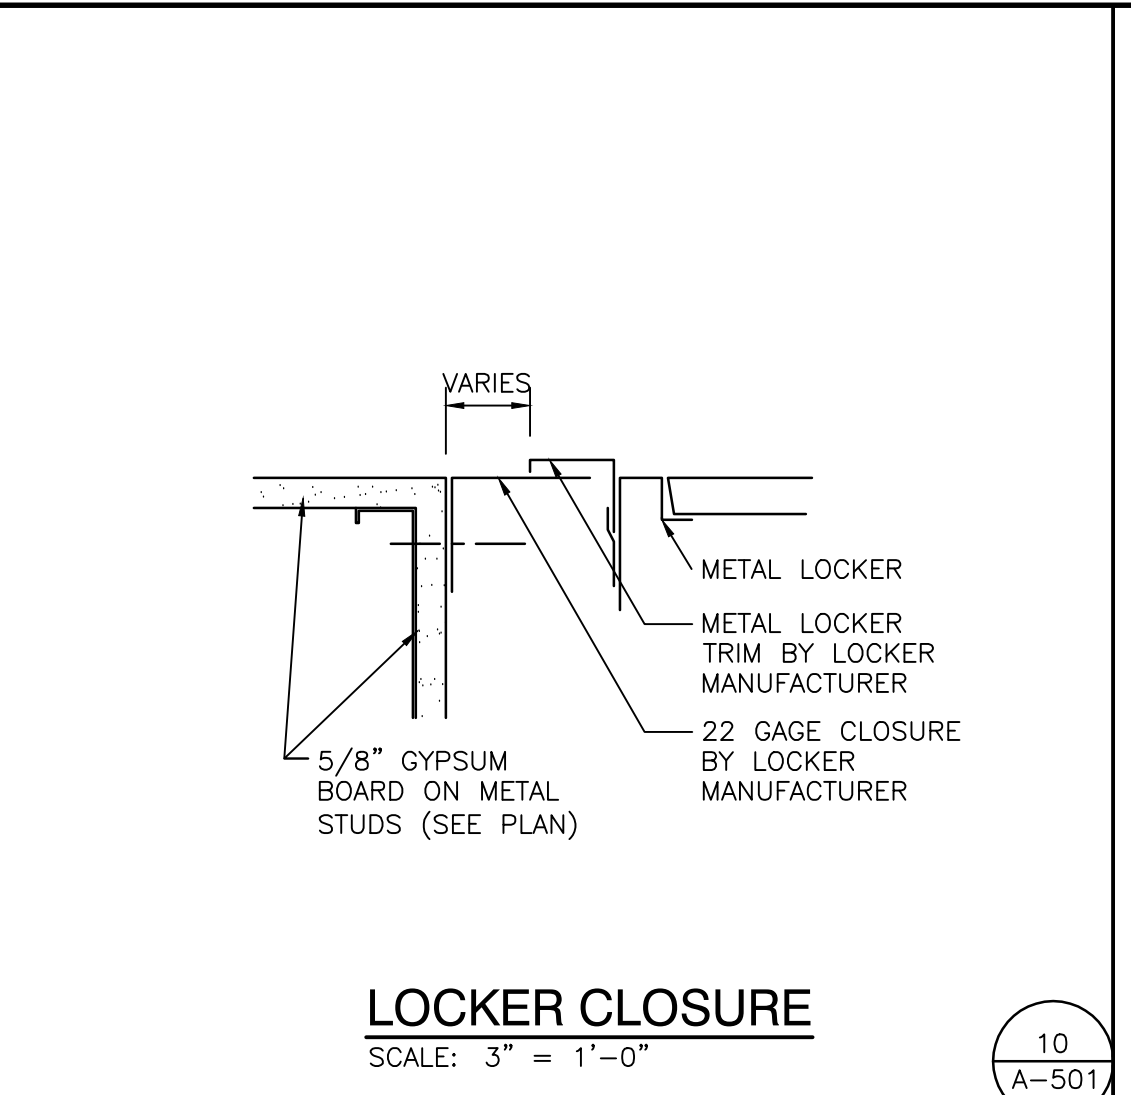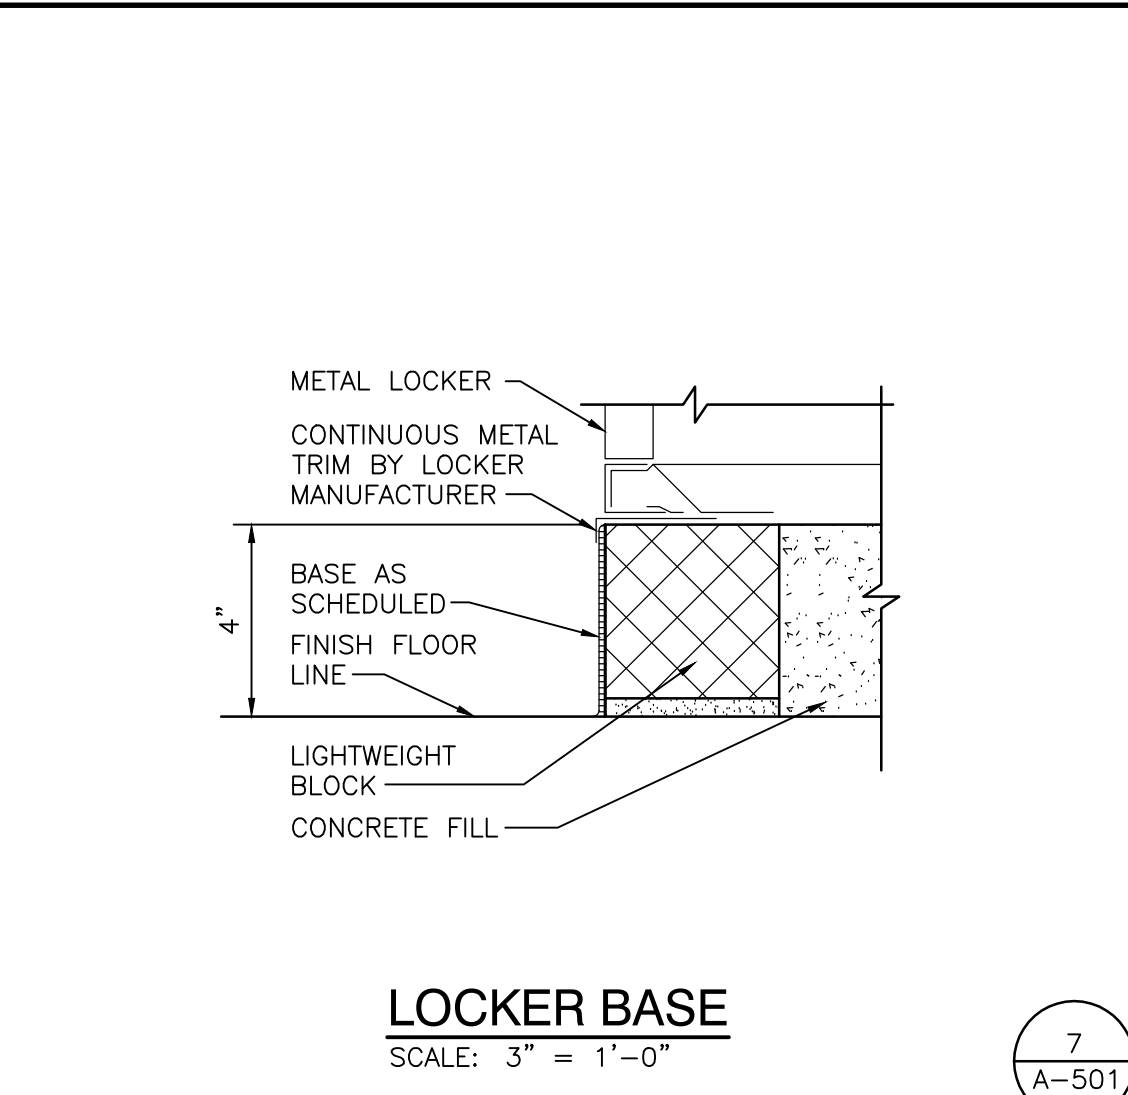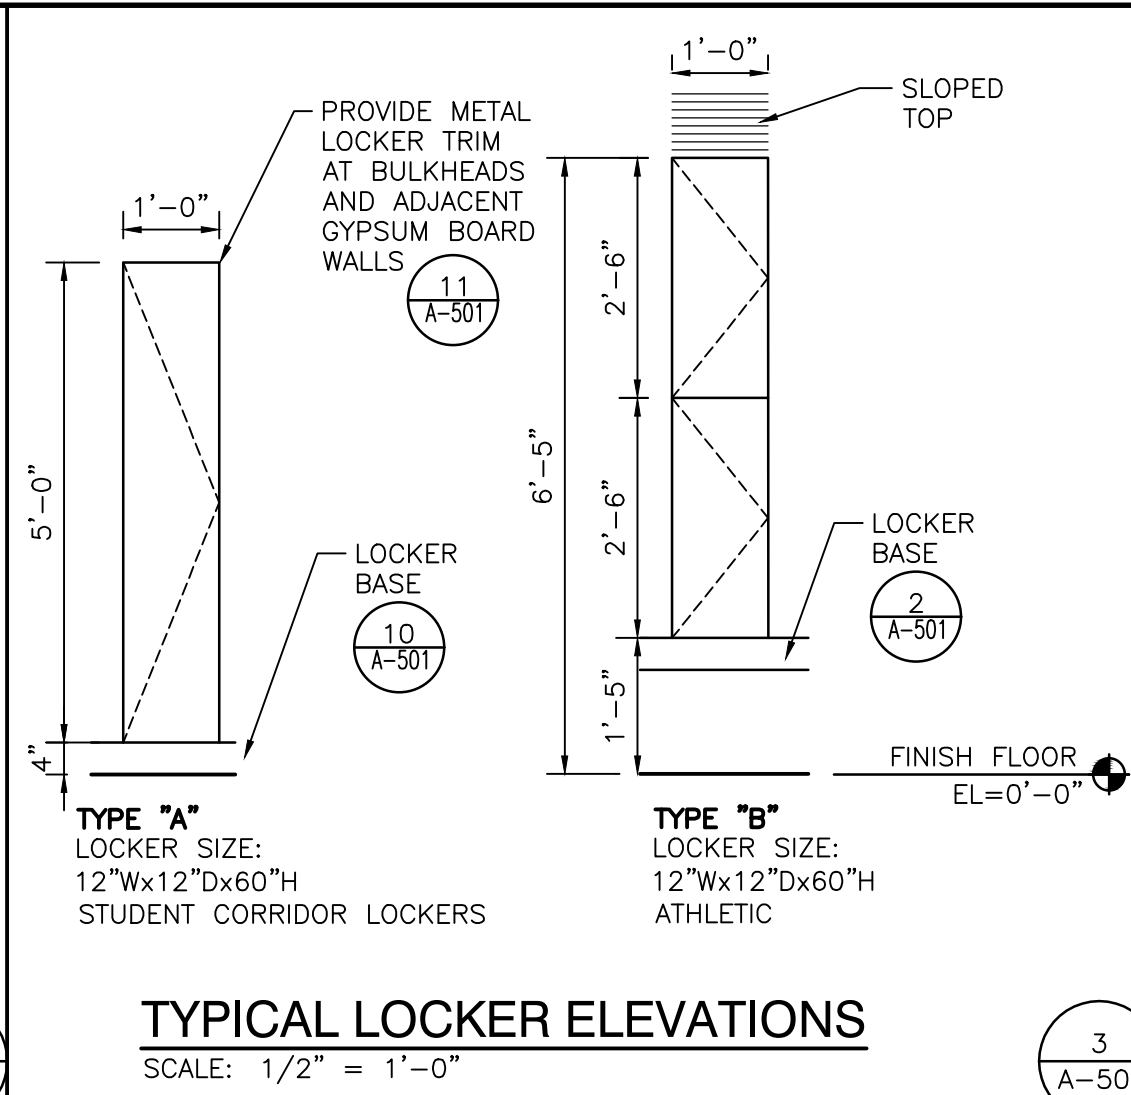

Thursday, 6/16/2022 - 12:49 PM - LAST SAVED BY: JHARRIS
Y:\21-155 FRANKLIN TOWNSHIP CSC-EDGEWOOD IS ADDITIONS AND RENOVATIONS\21-155 DRAWINGS\05 ARCH\A-501.DWG




GIBRALTAR
DESIGN
ARCHITECTURE • ENGINEERING • INTERIOR DESIGN

PROJECT
ADDITIONS AND RENOVATIONS TO
EDGEWOOD INTERMEDIATE SCHOOL
FRANKLIN TOWNSHIP COMMUNITY SCHOOL CORPORATION
INDIANAPOLIS, INDIANA

13 A-502

8 A-502

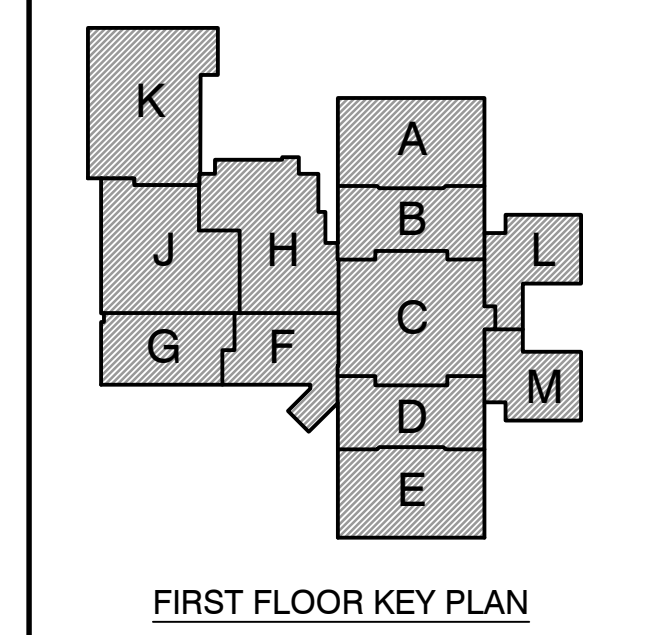

GIBRALTAR DESIGN
9102 N. Meridian St., Ste. 300
Indianapolis, IN 46260
Homepage: www.GibraltarDesign.com
Email: info@GibraltarDesign.com
Phone: 317.580.5777 Fax: 317.580.5778

PROJECT
21-155
DATE
05/23/22
COORDINATED BY
DJW
DRAWN BY
JRH
CHECKED BY
DJW

COPYRIGHT NOTICE:
THE CONCEPTS, DESIGNS, PLANS, DETAILS, ETC. SHOWN ON THIS DOCUMENT ARE THE PROPERTY OF GIBRALTAR DESIGN AND ARE CREATED FOR USE ON THIS SPECIFIC PROJECT. NONE OF THIS INFORMATION SHALL BE USED BY ANY PERSON OR FIRM FOR ANY PURPOSE WITHOUT THE EXPRESS WRITTEN CONSENT OF GIBRALTAR DESIGN. THE OWNER MAY RETAIN COPIES FOR INFORMATION AND REFERENCE IN CONNECTION ONLY WITH THIS PROJECT.

REVISIONS	MARK	DATE	ISSUED FOR
AD-1	06/16/22		ADDENDUM NO. 1

DRAWING
TYPICAL DETAILS

PROJECT
ADDITIONS AND RENOVATIONS TO
EDGEWOOD INTERMEDIATE SCHOOL

1 A-502

9 A-502

5 A-502

6 A-502

7 A-502

4 A-502




 
 
 












12 A-502

11 A-502

10 A-502

15 A-502

14 A-502

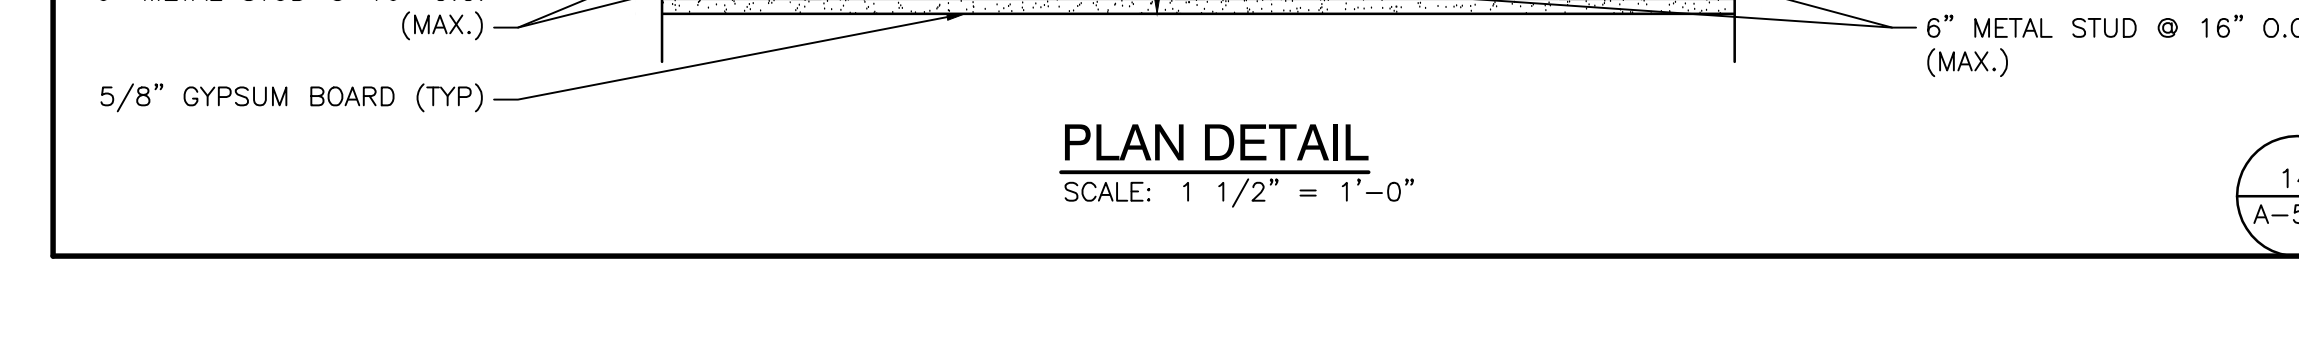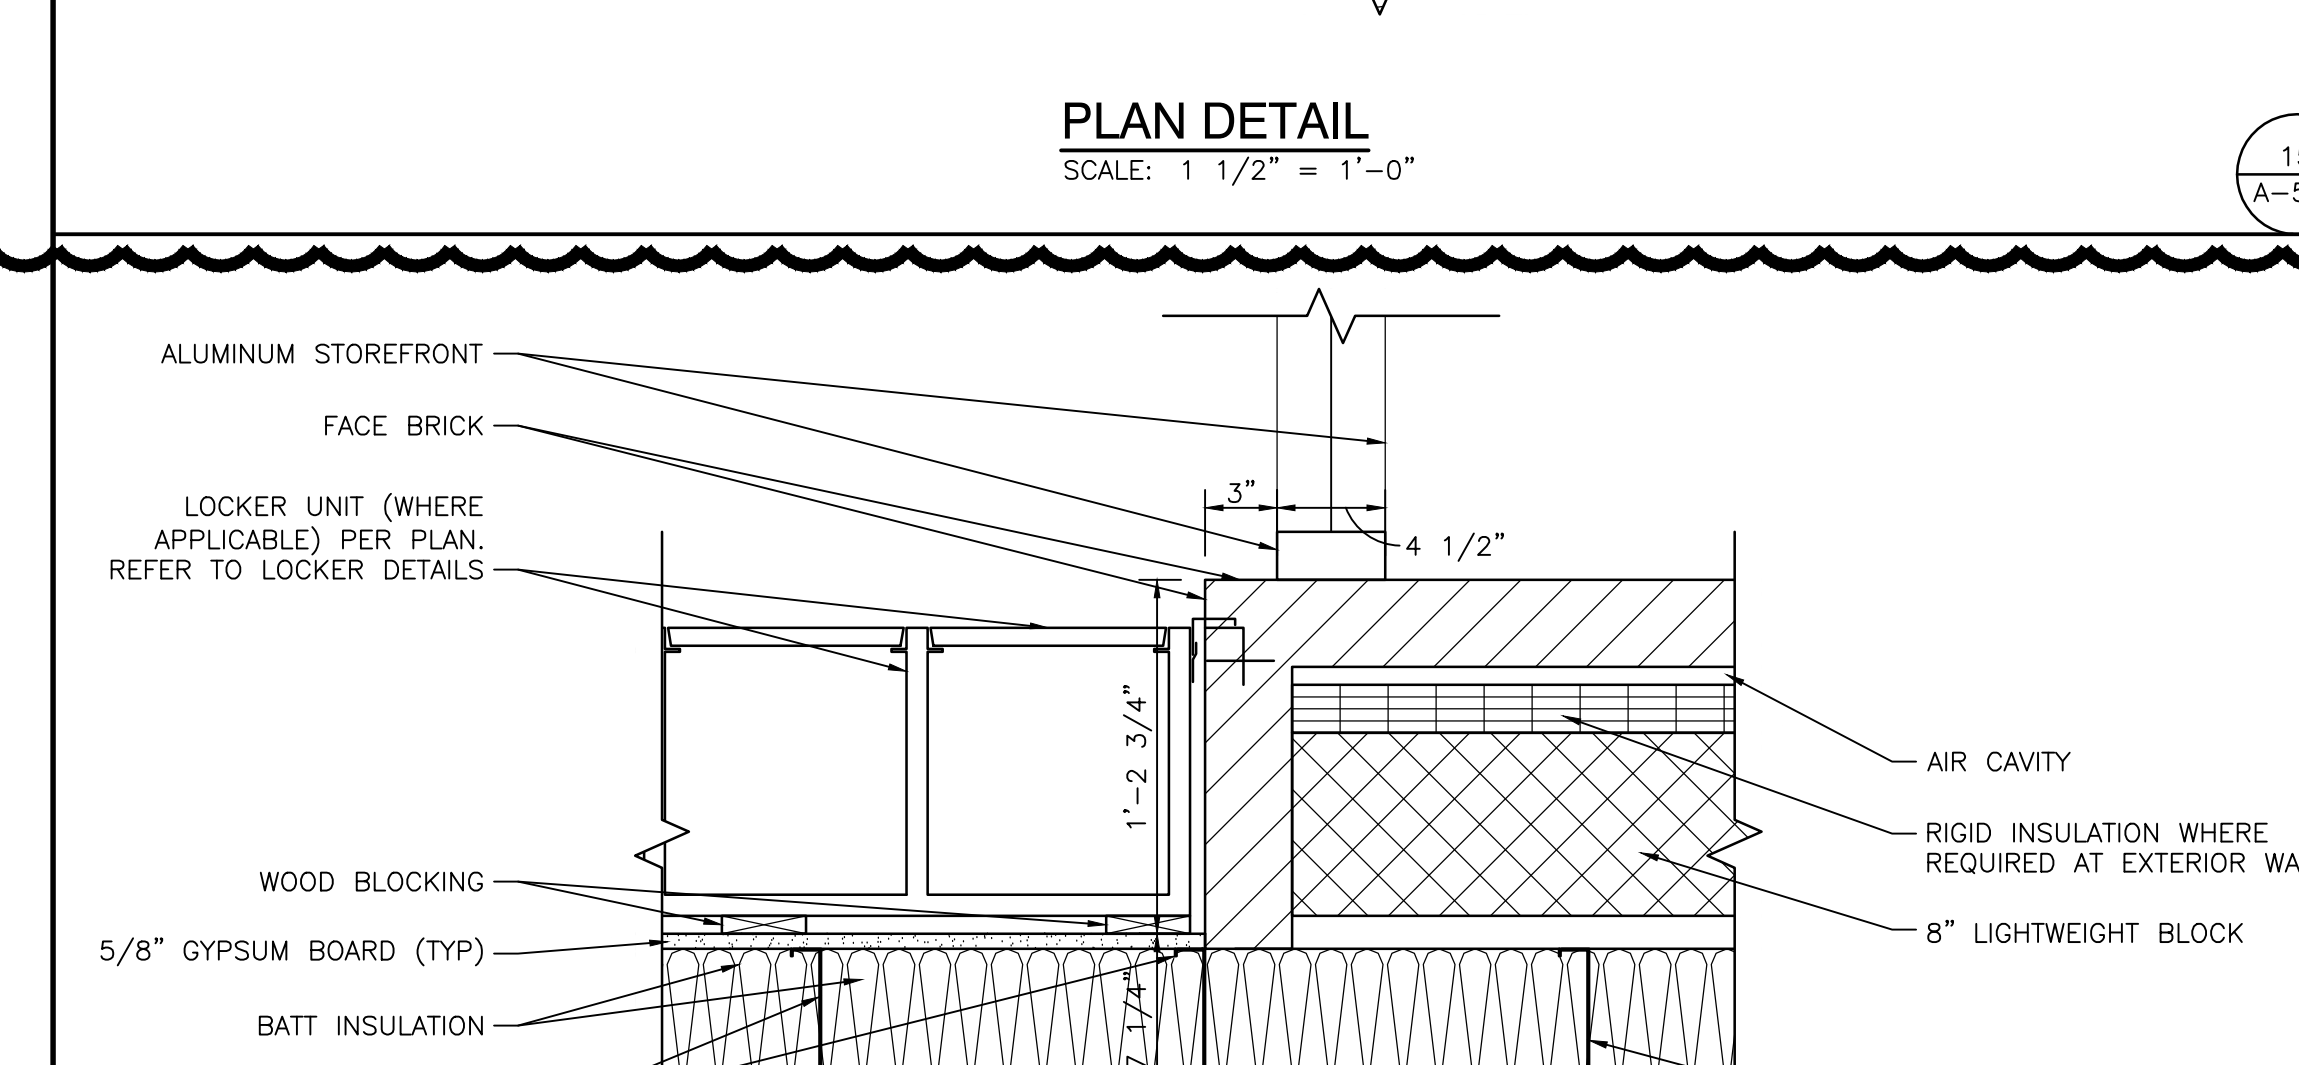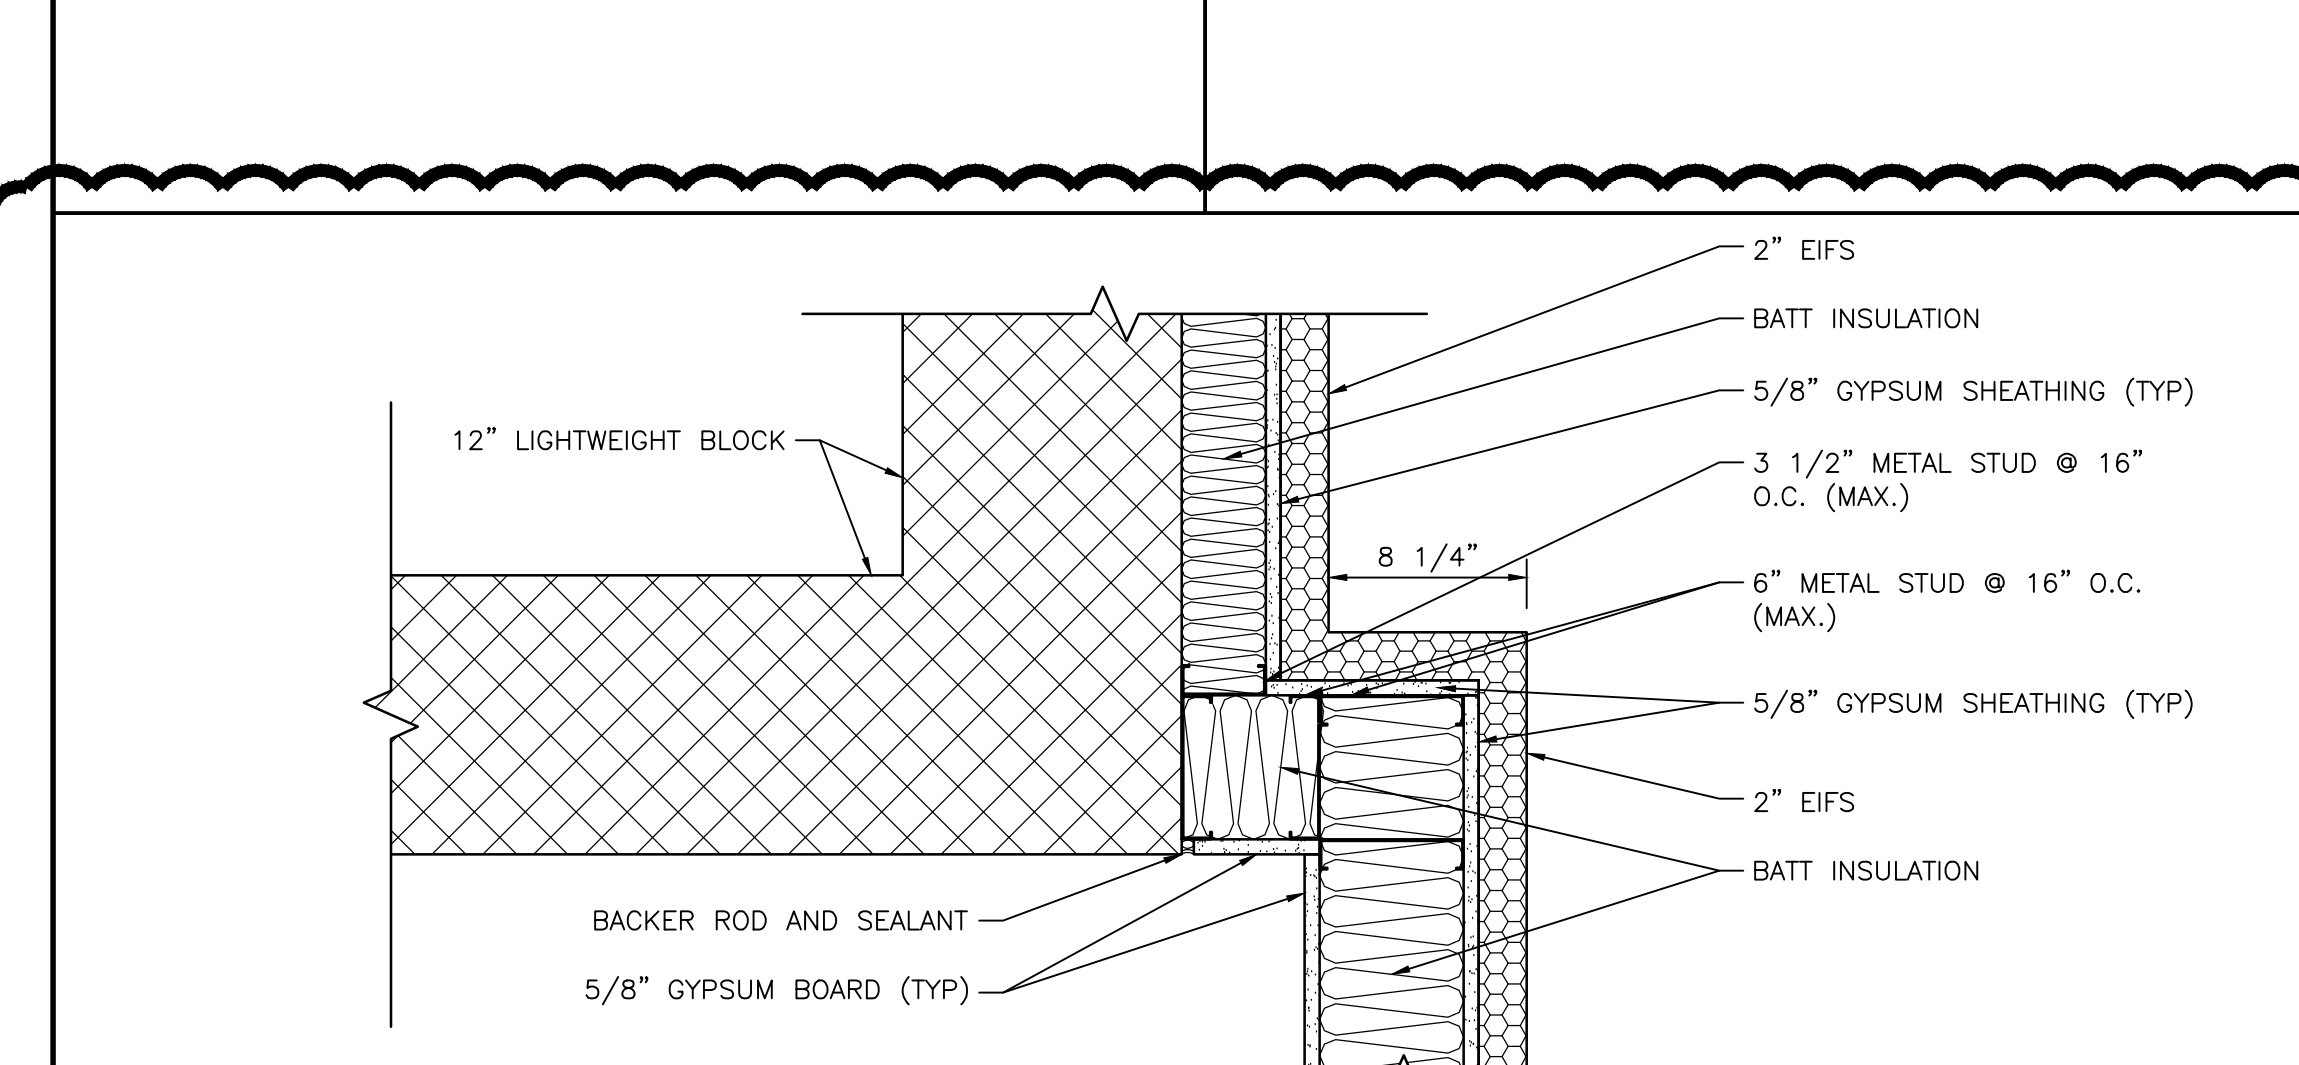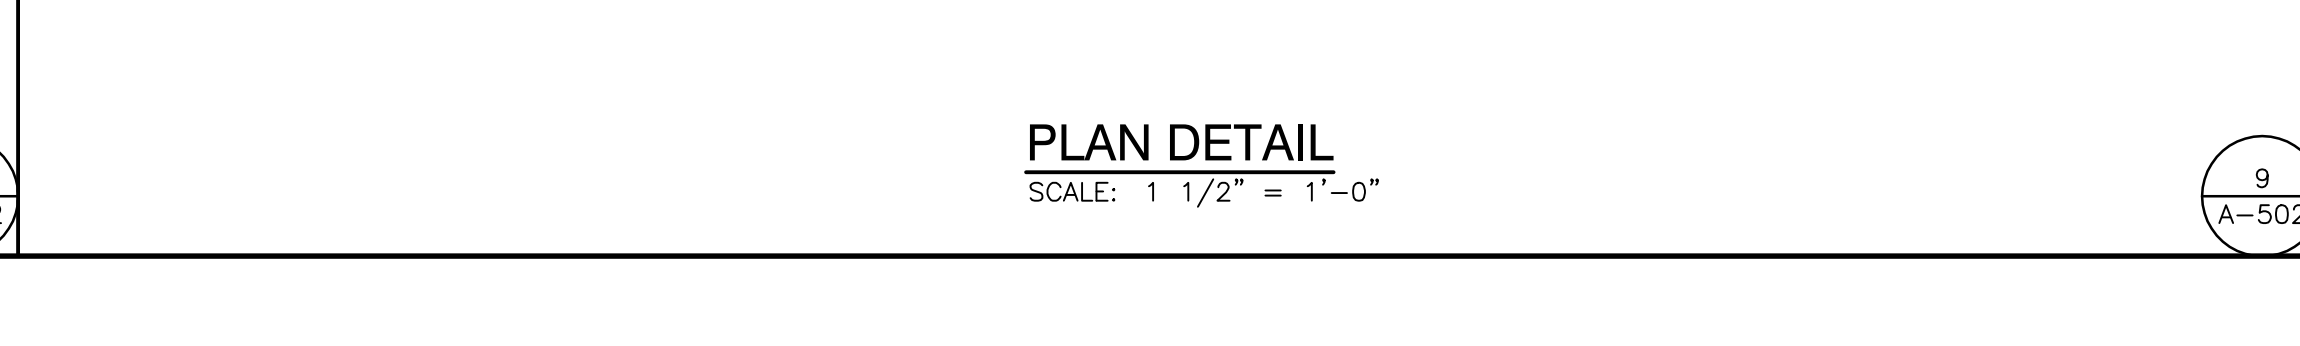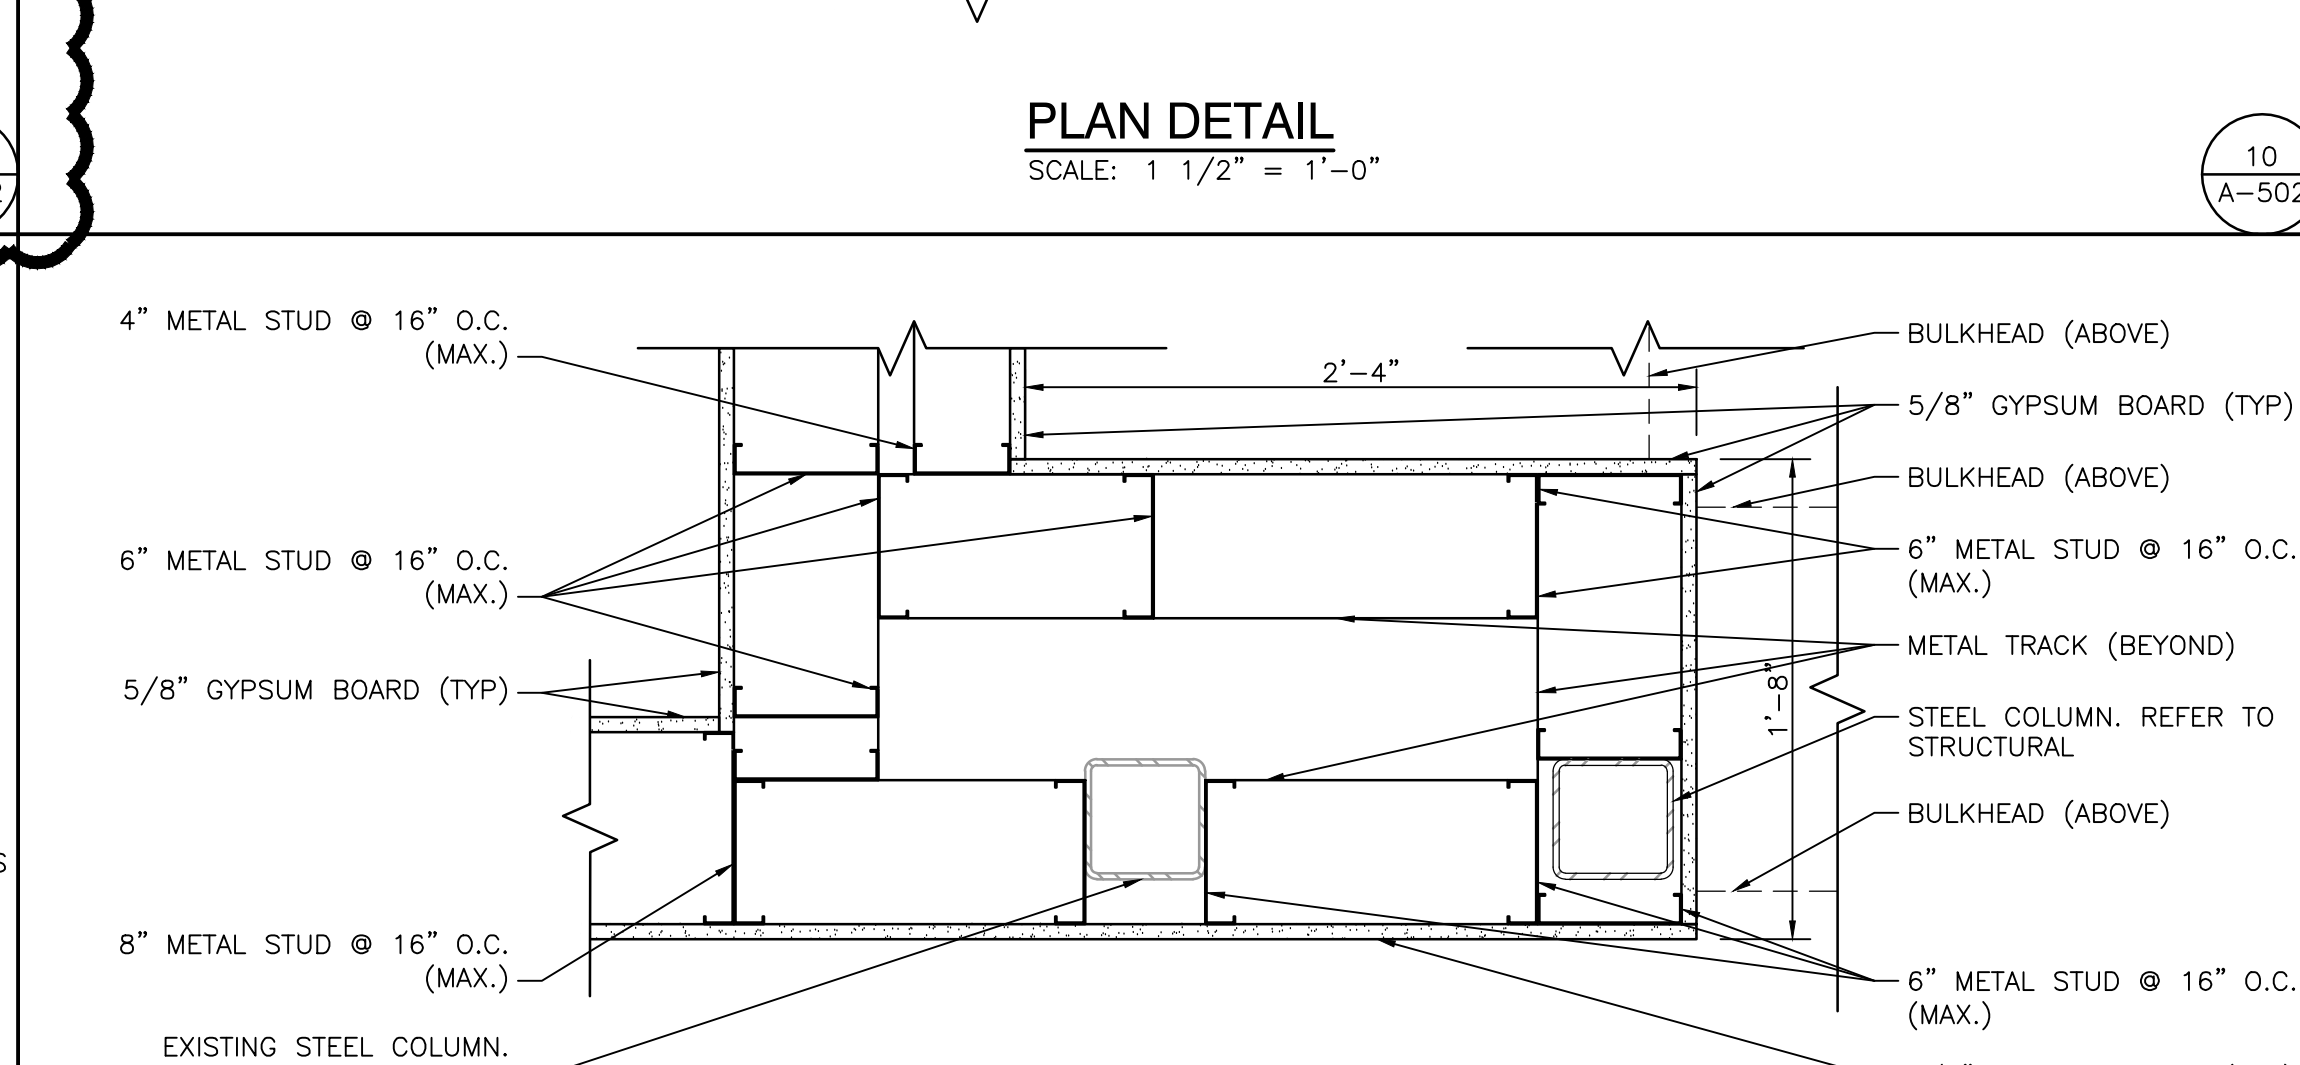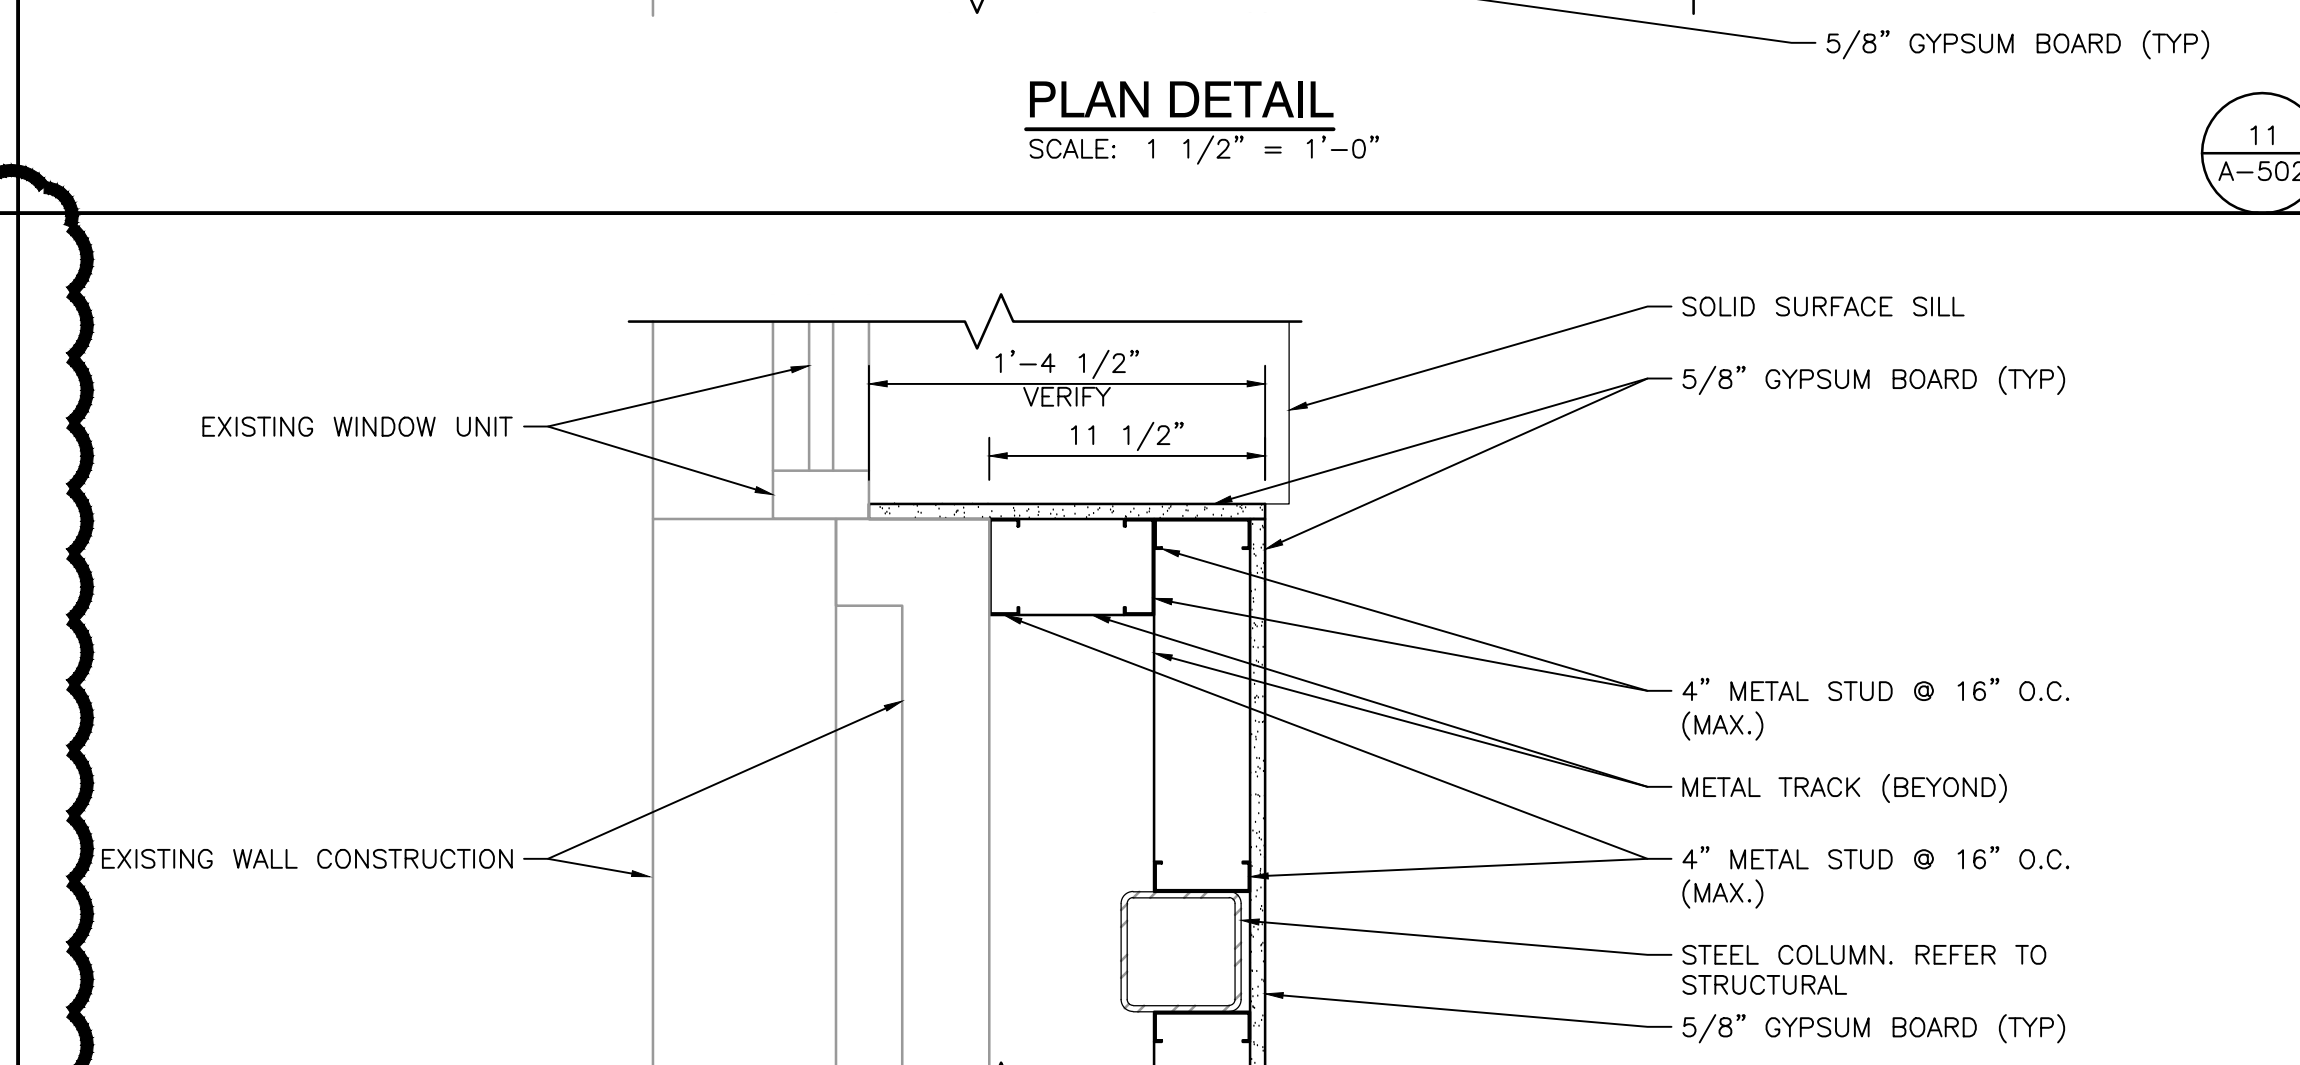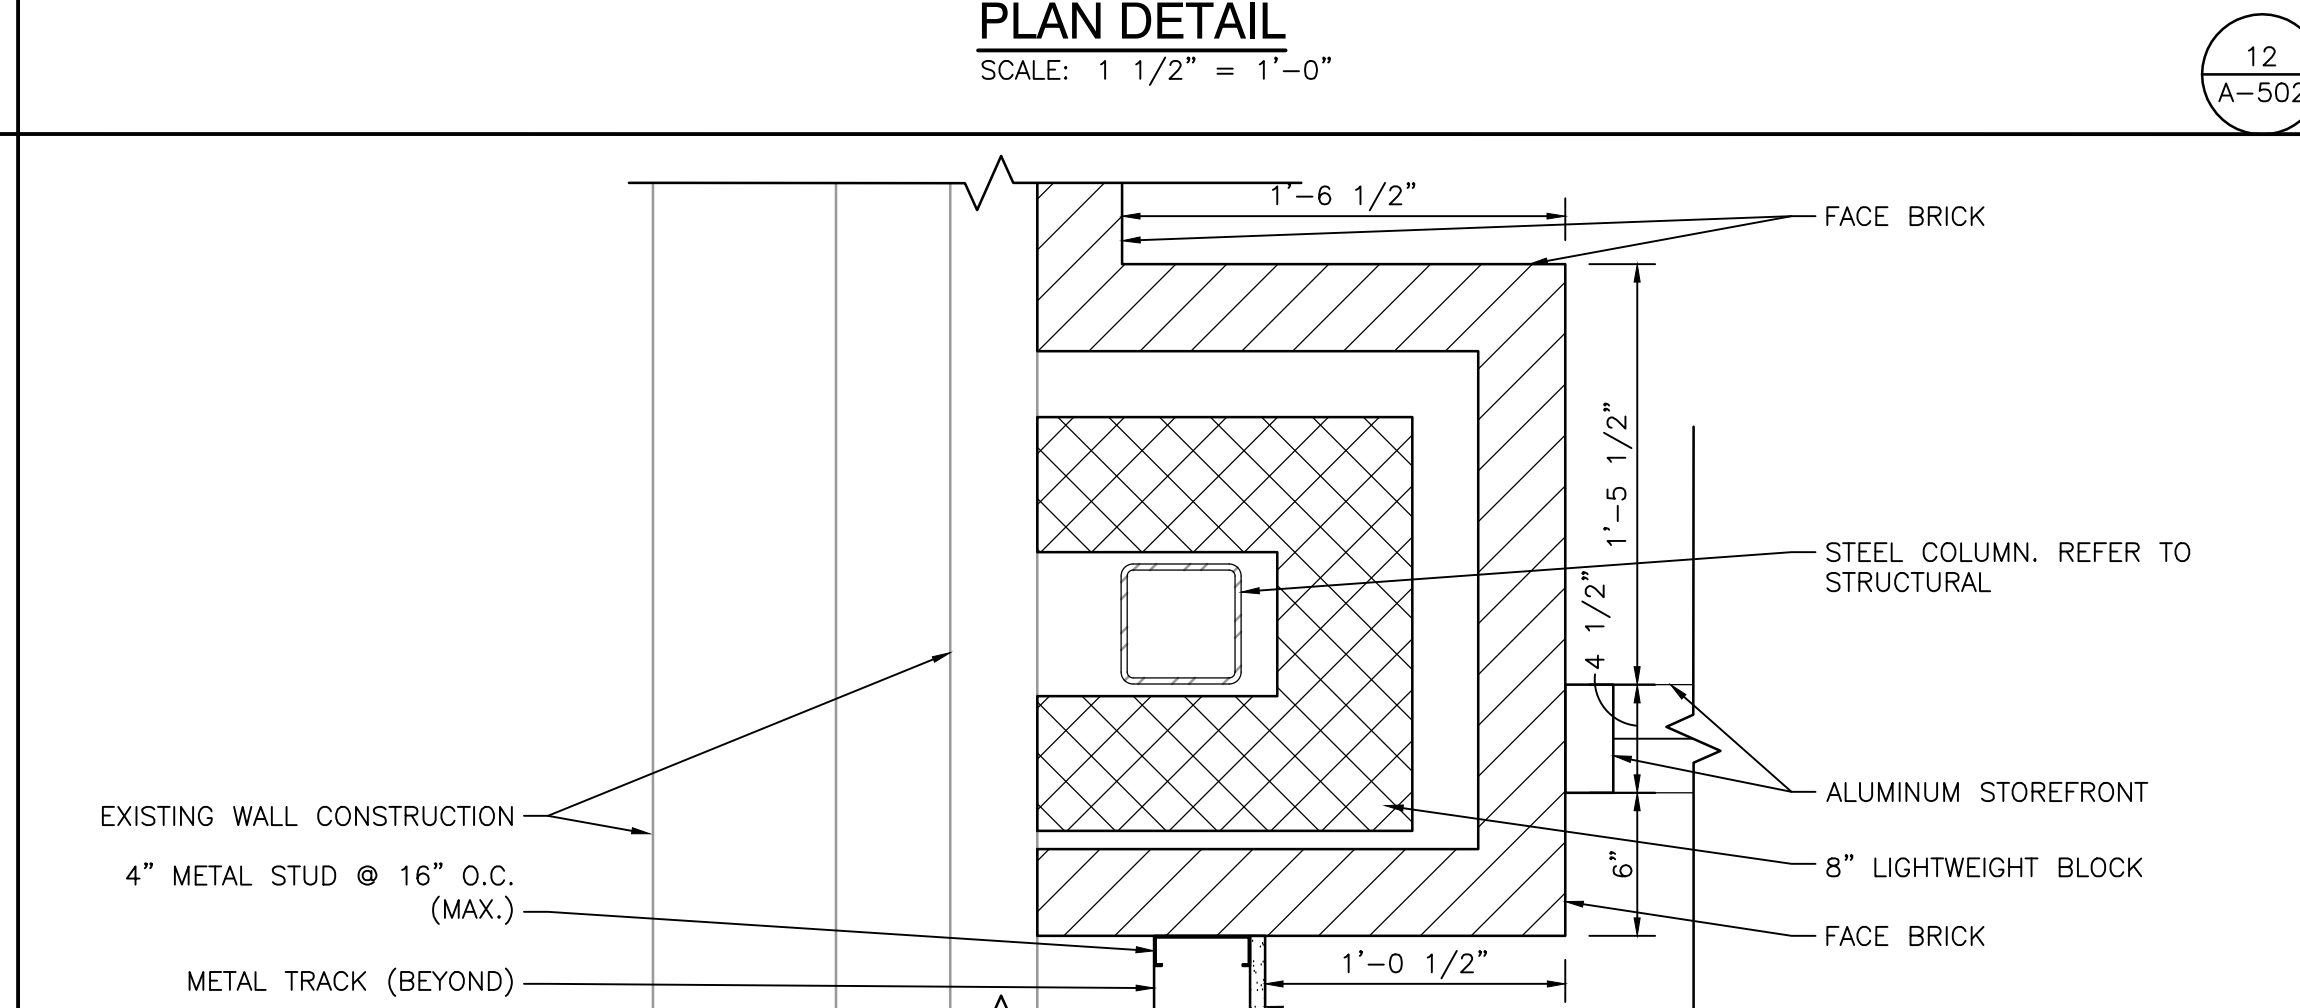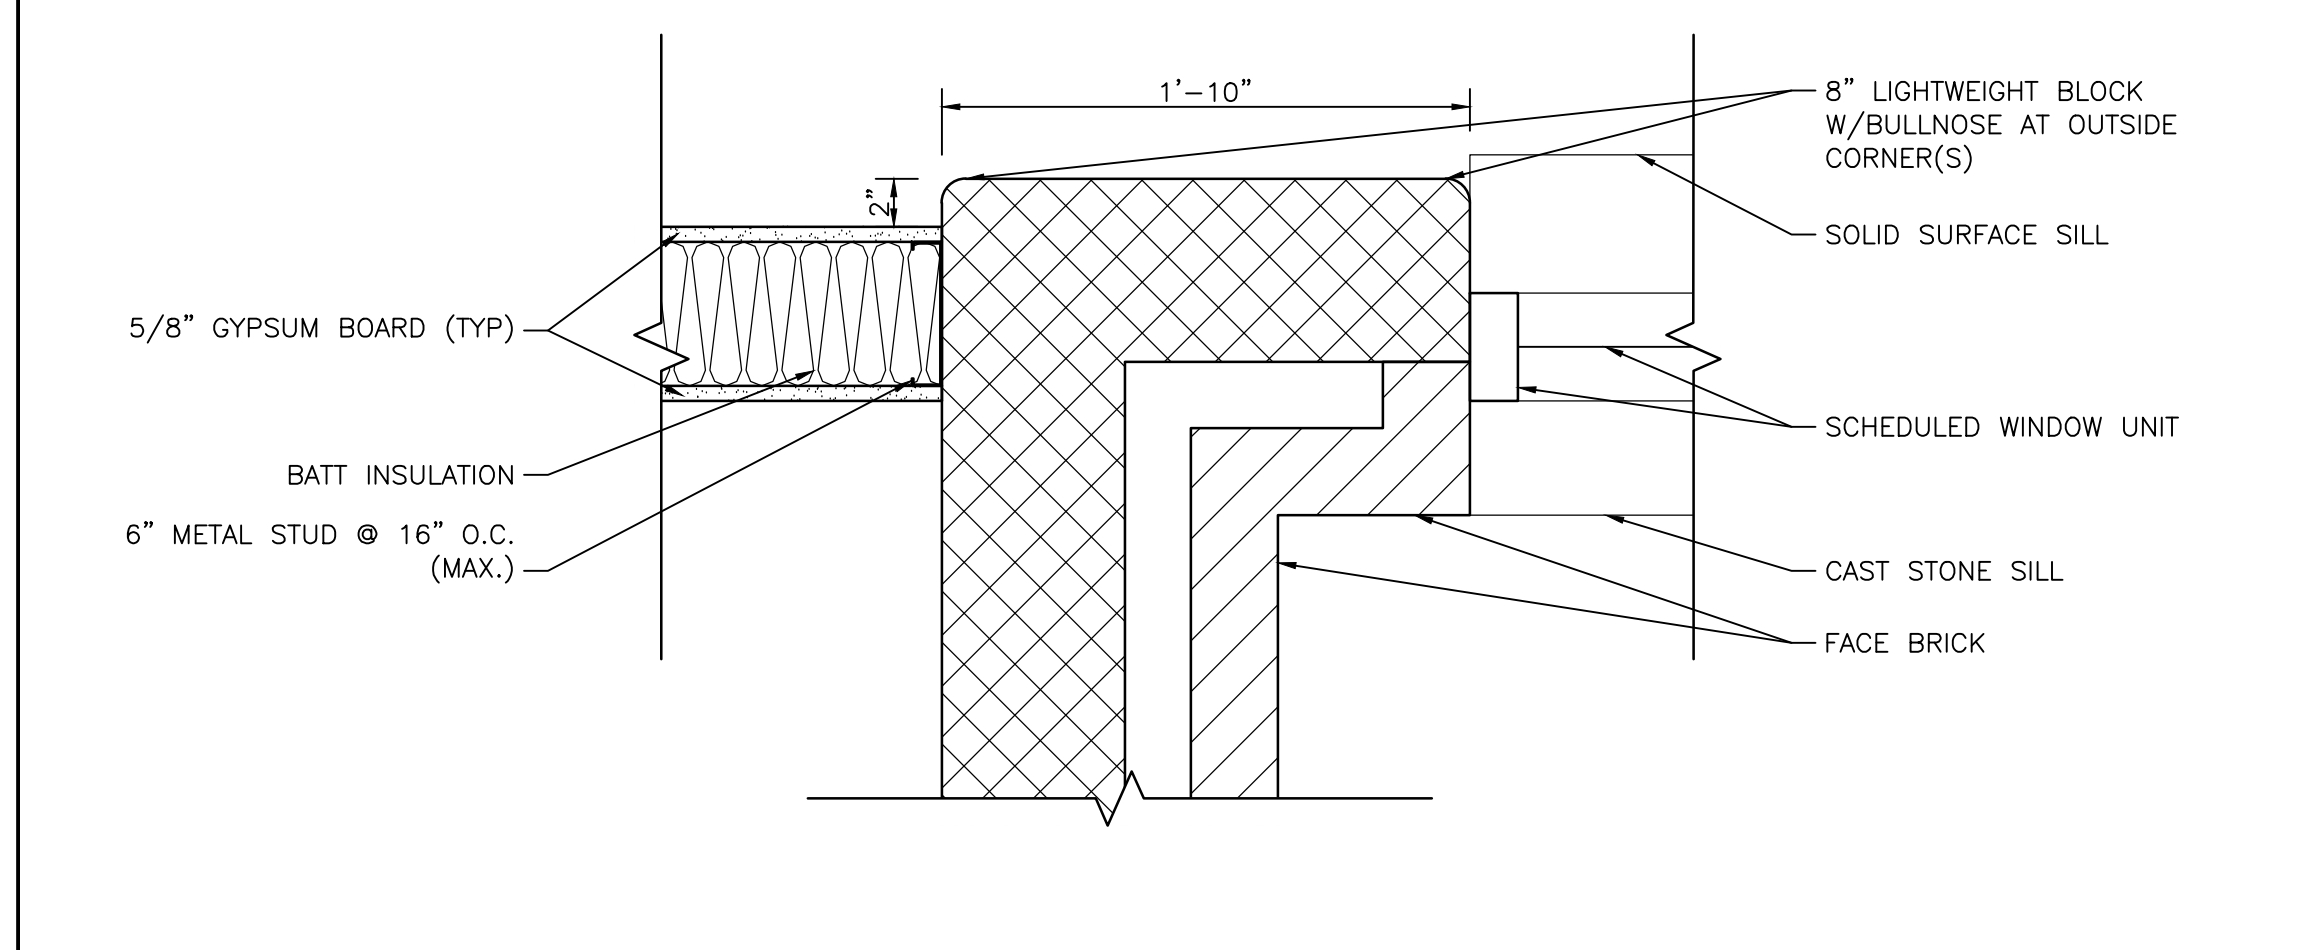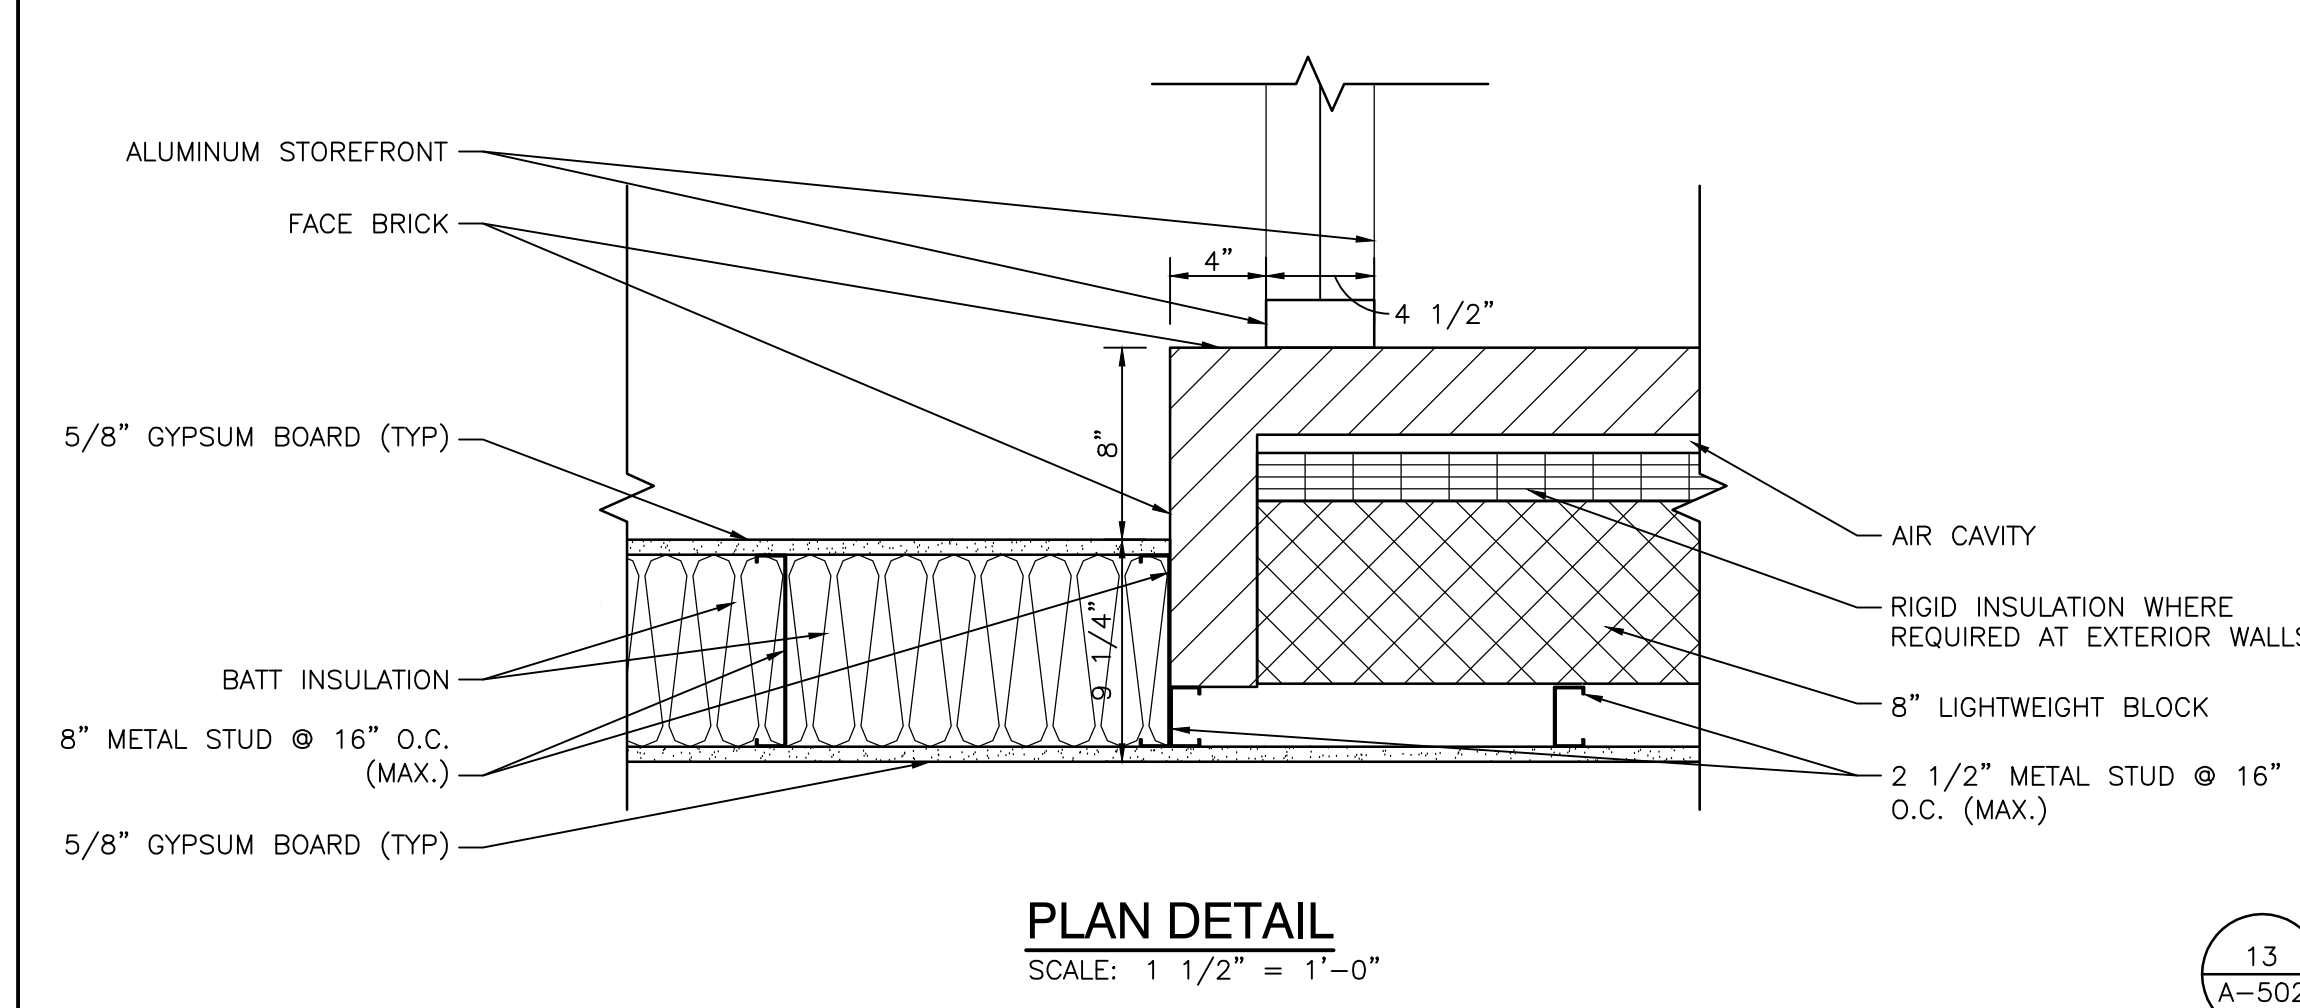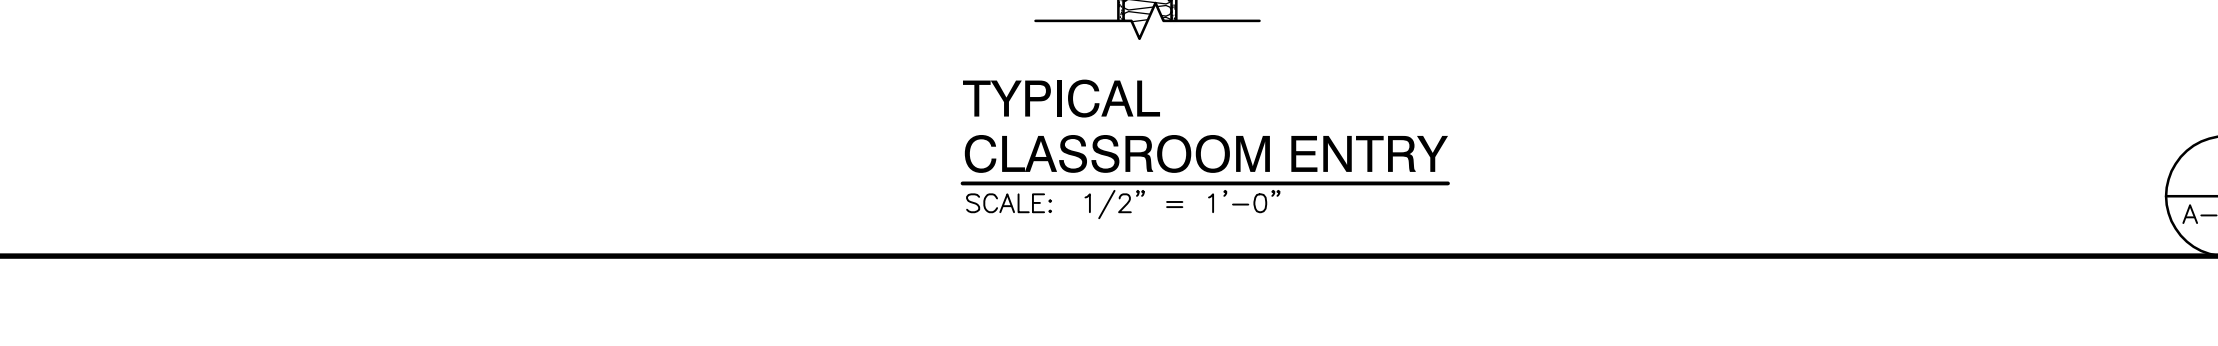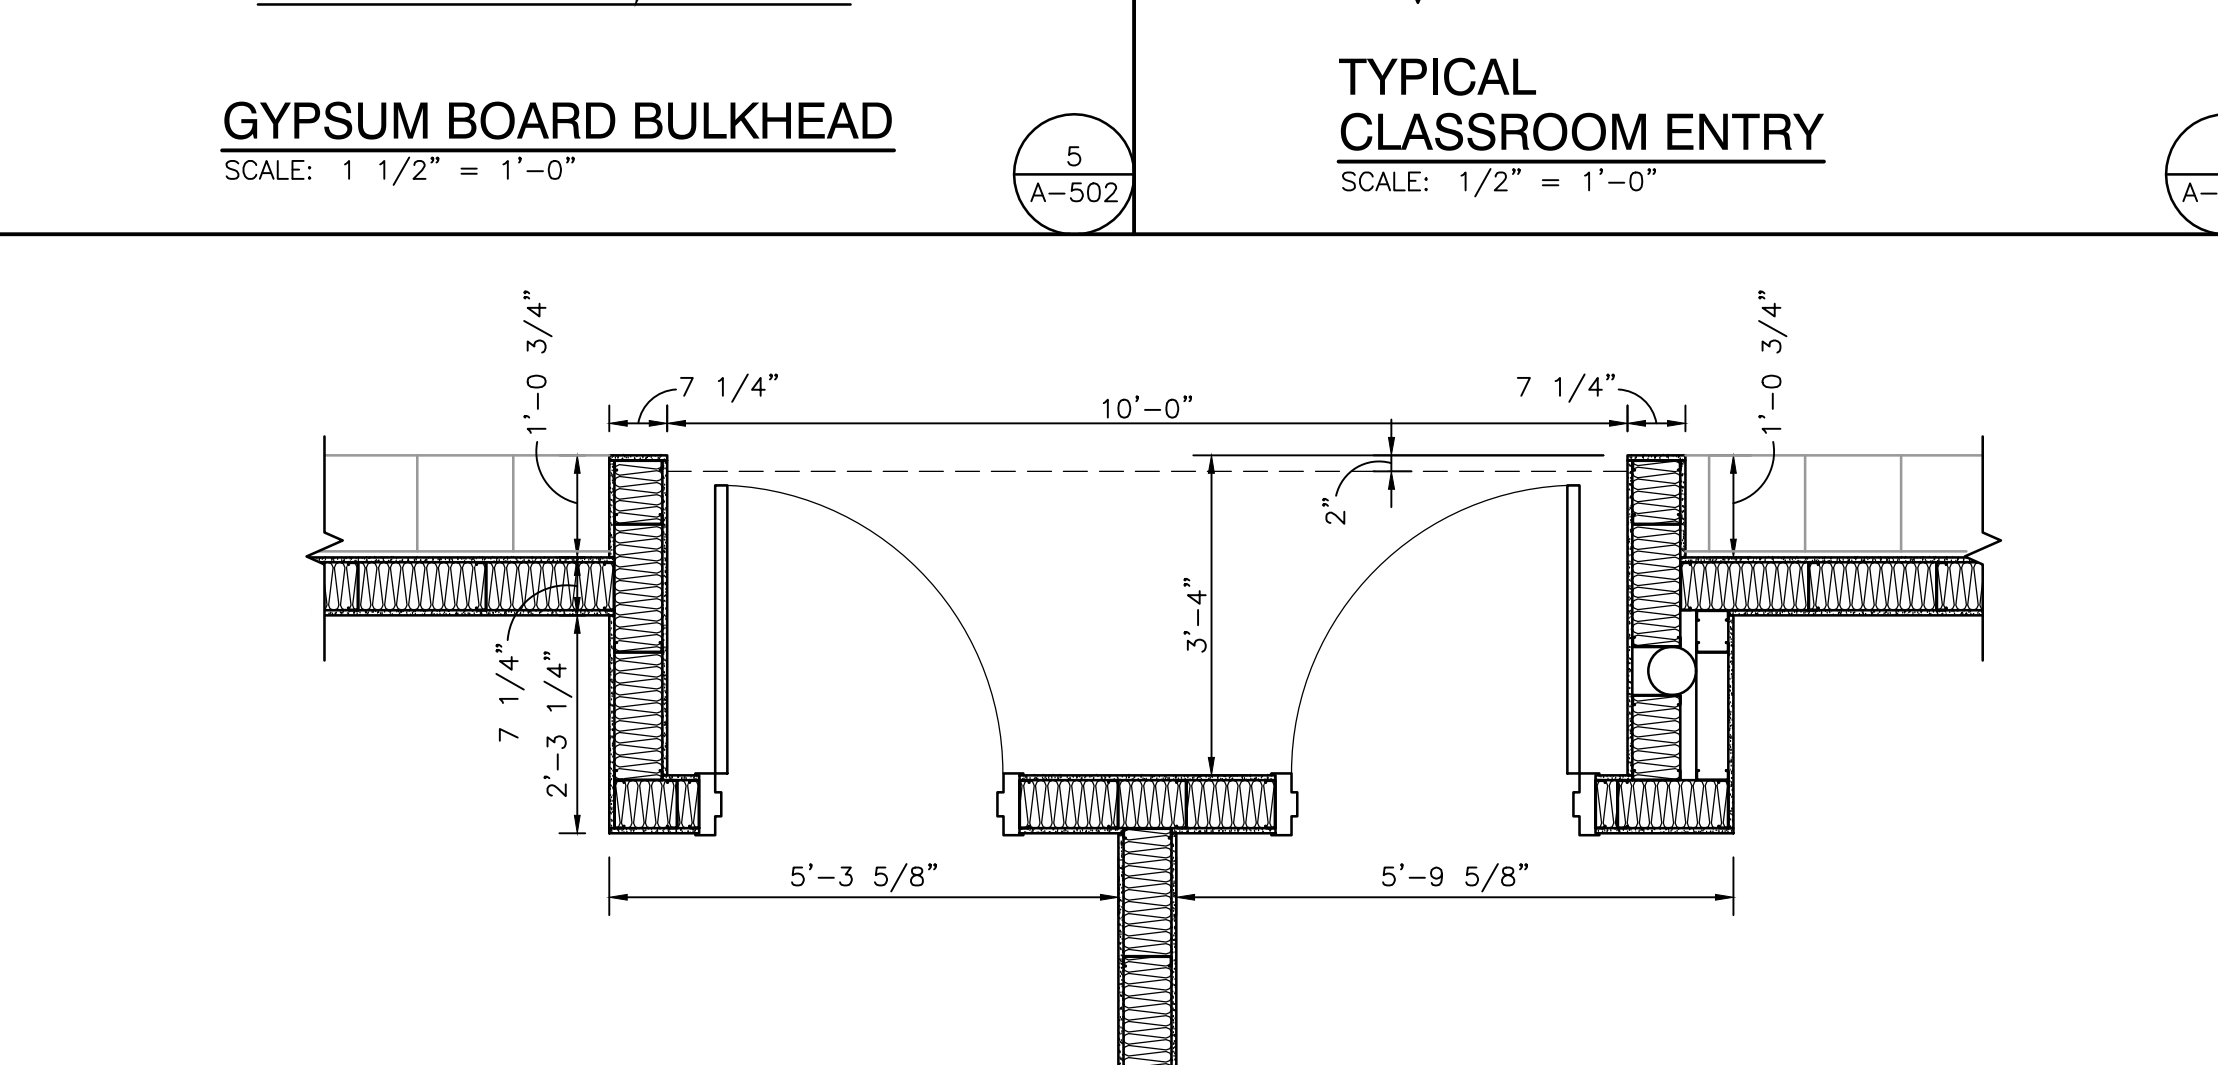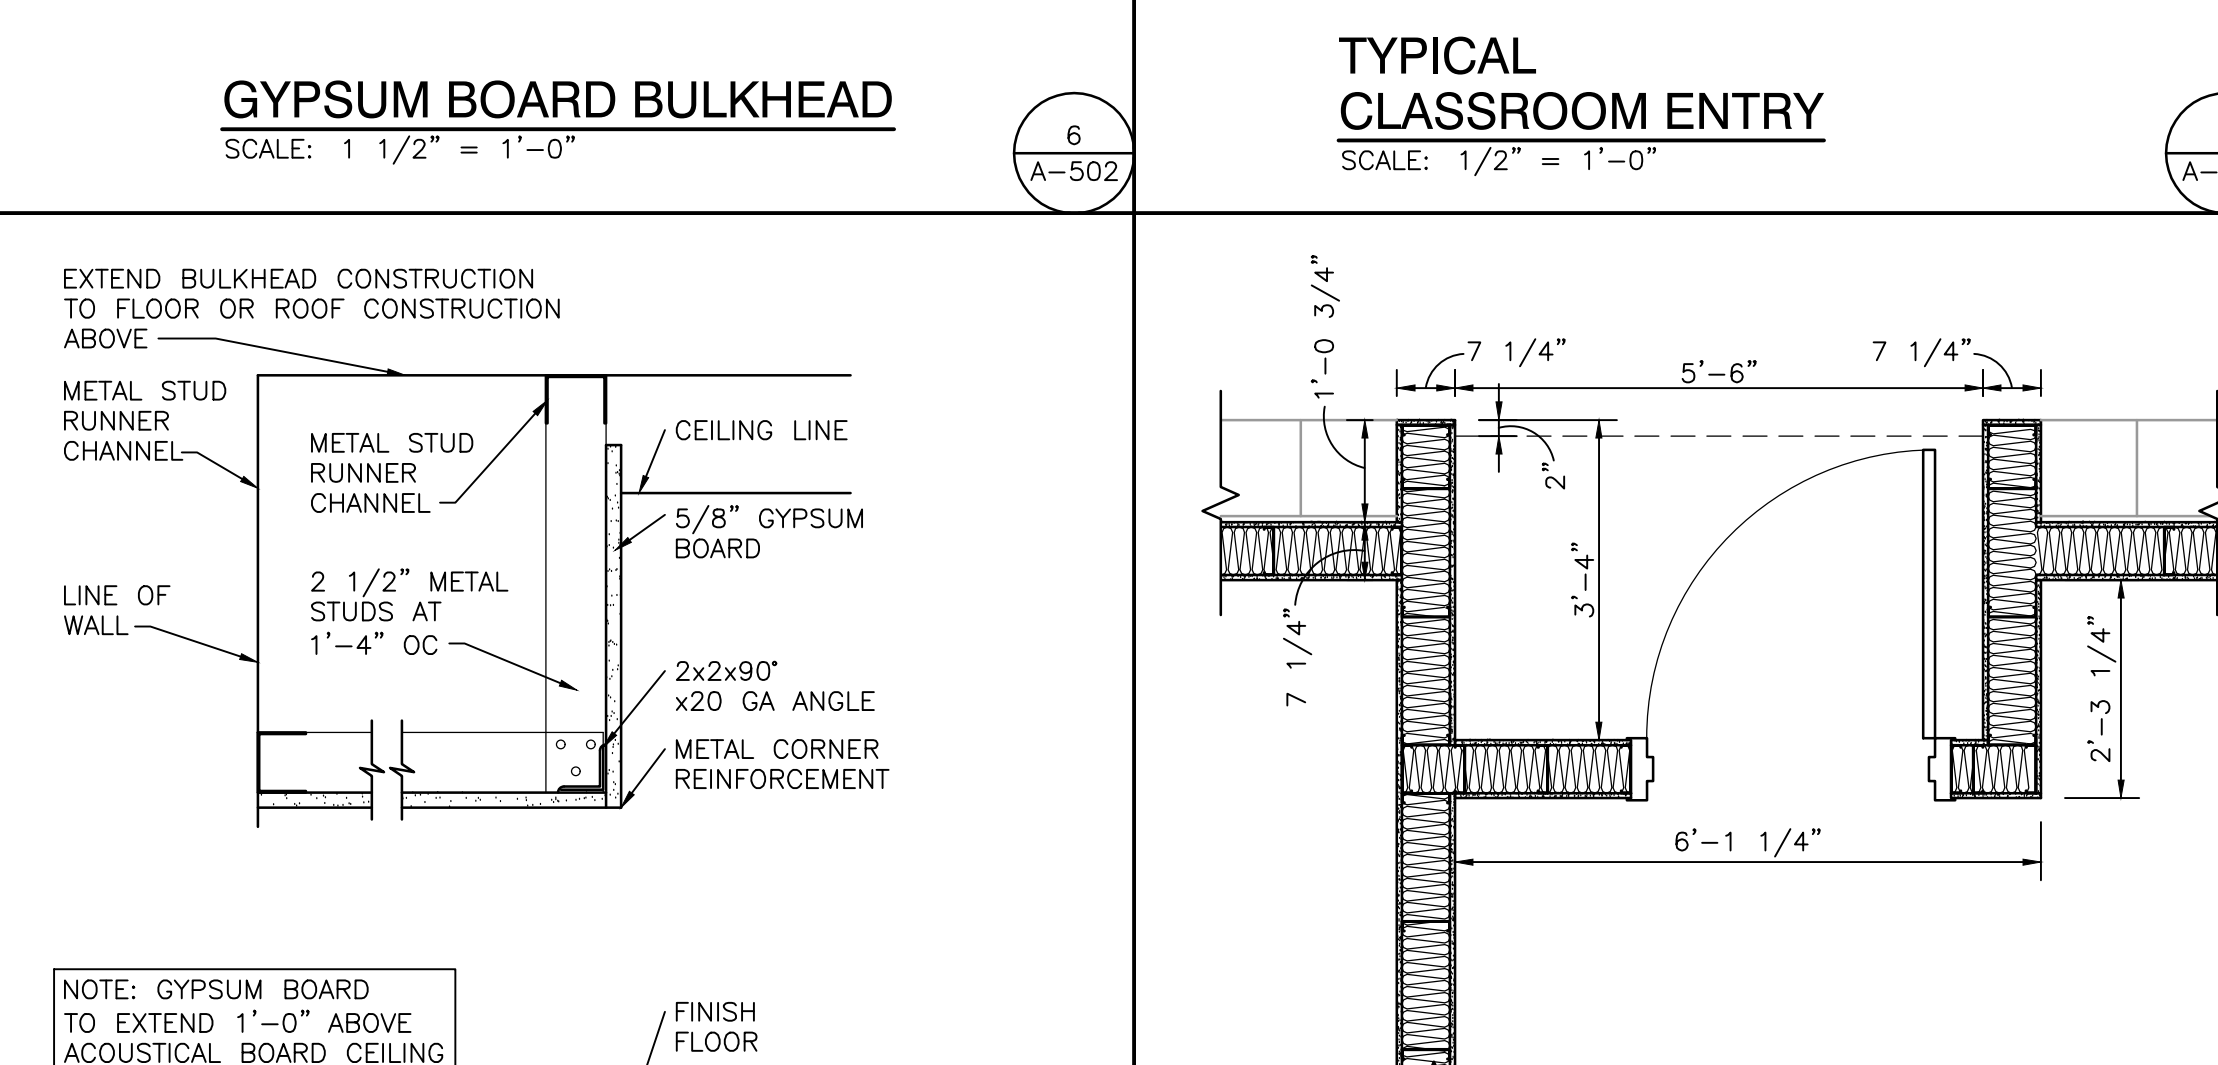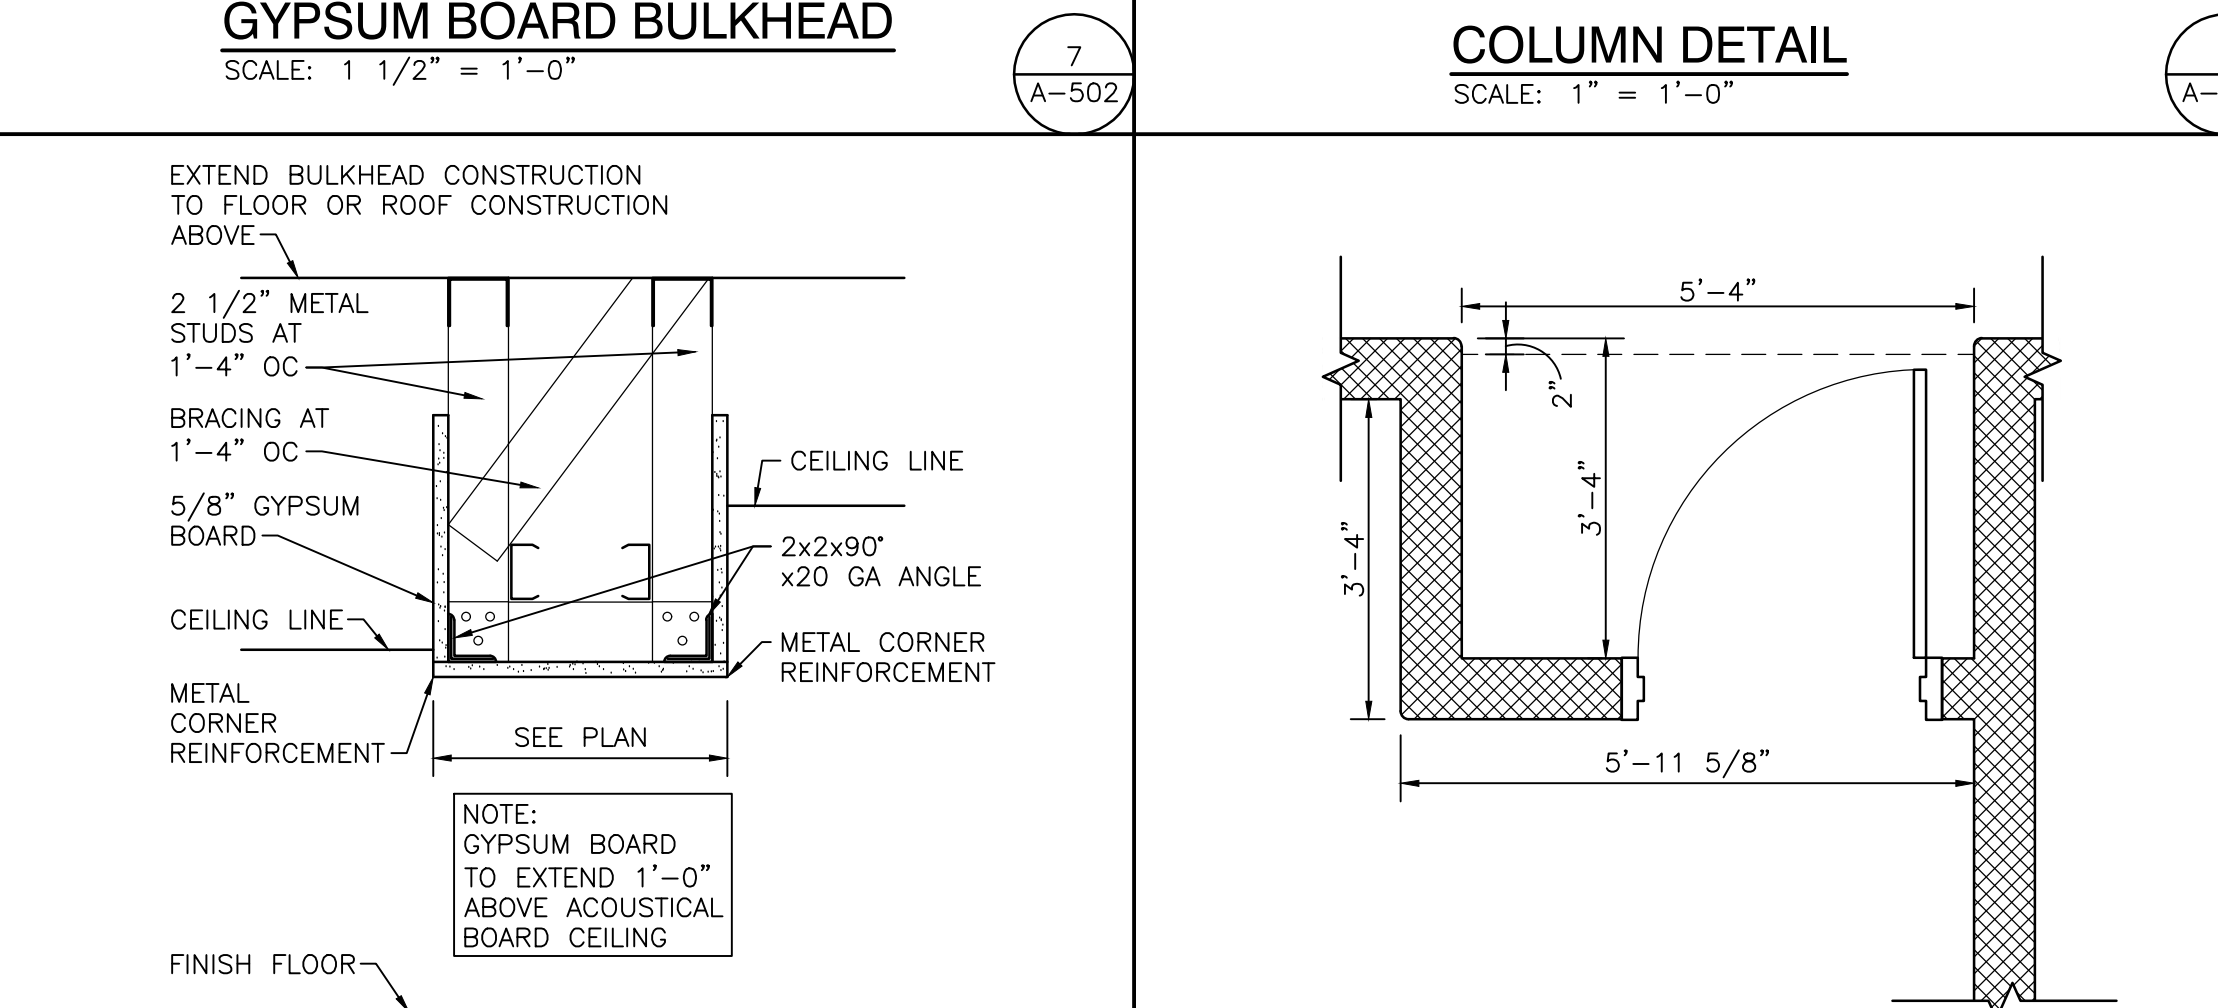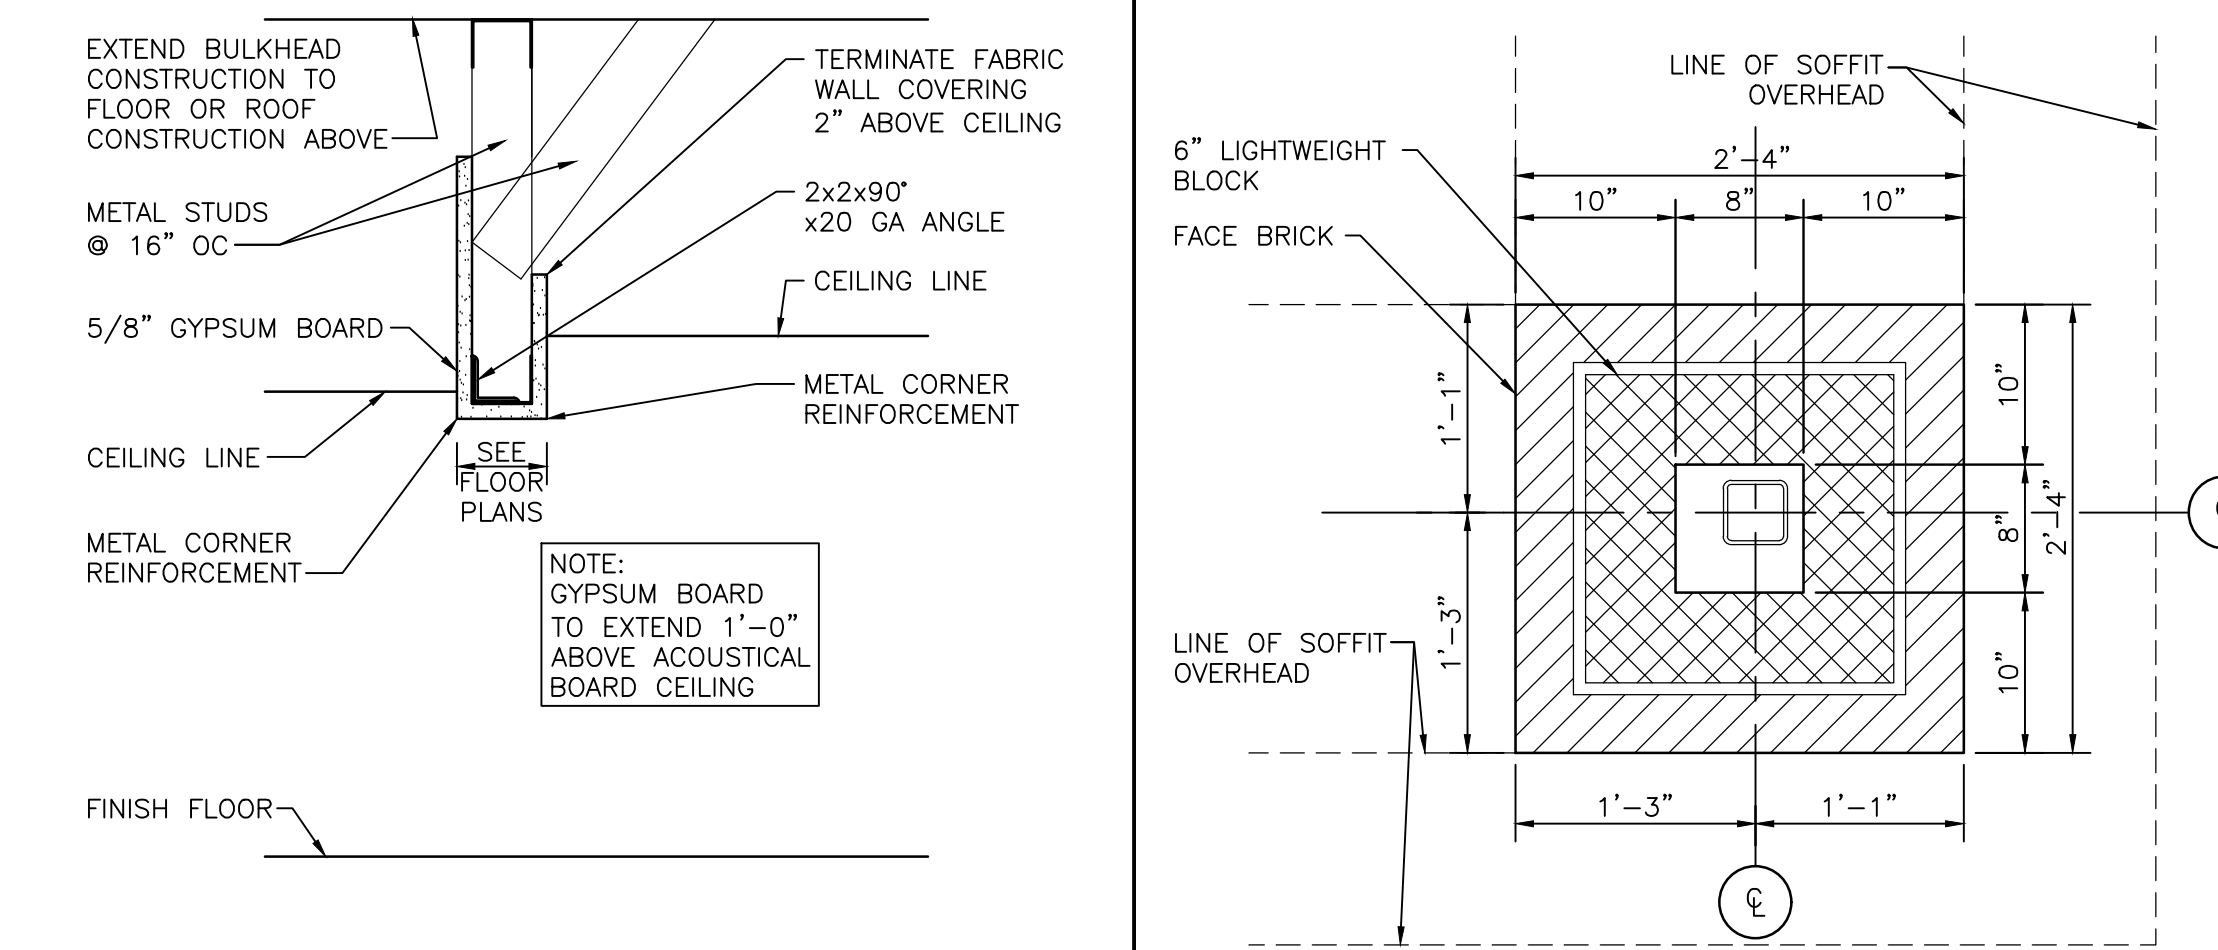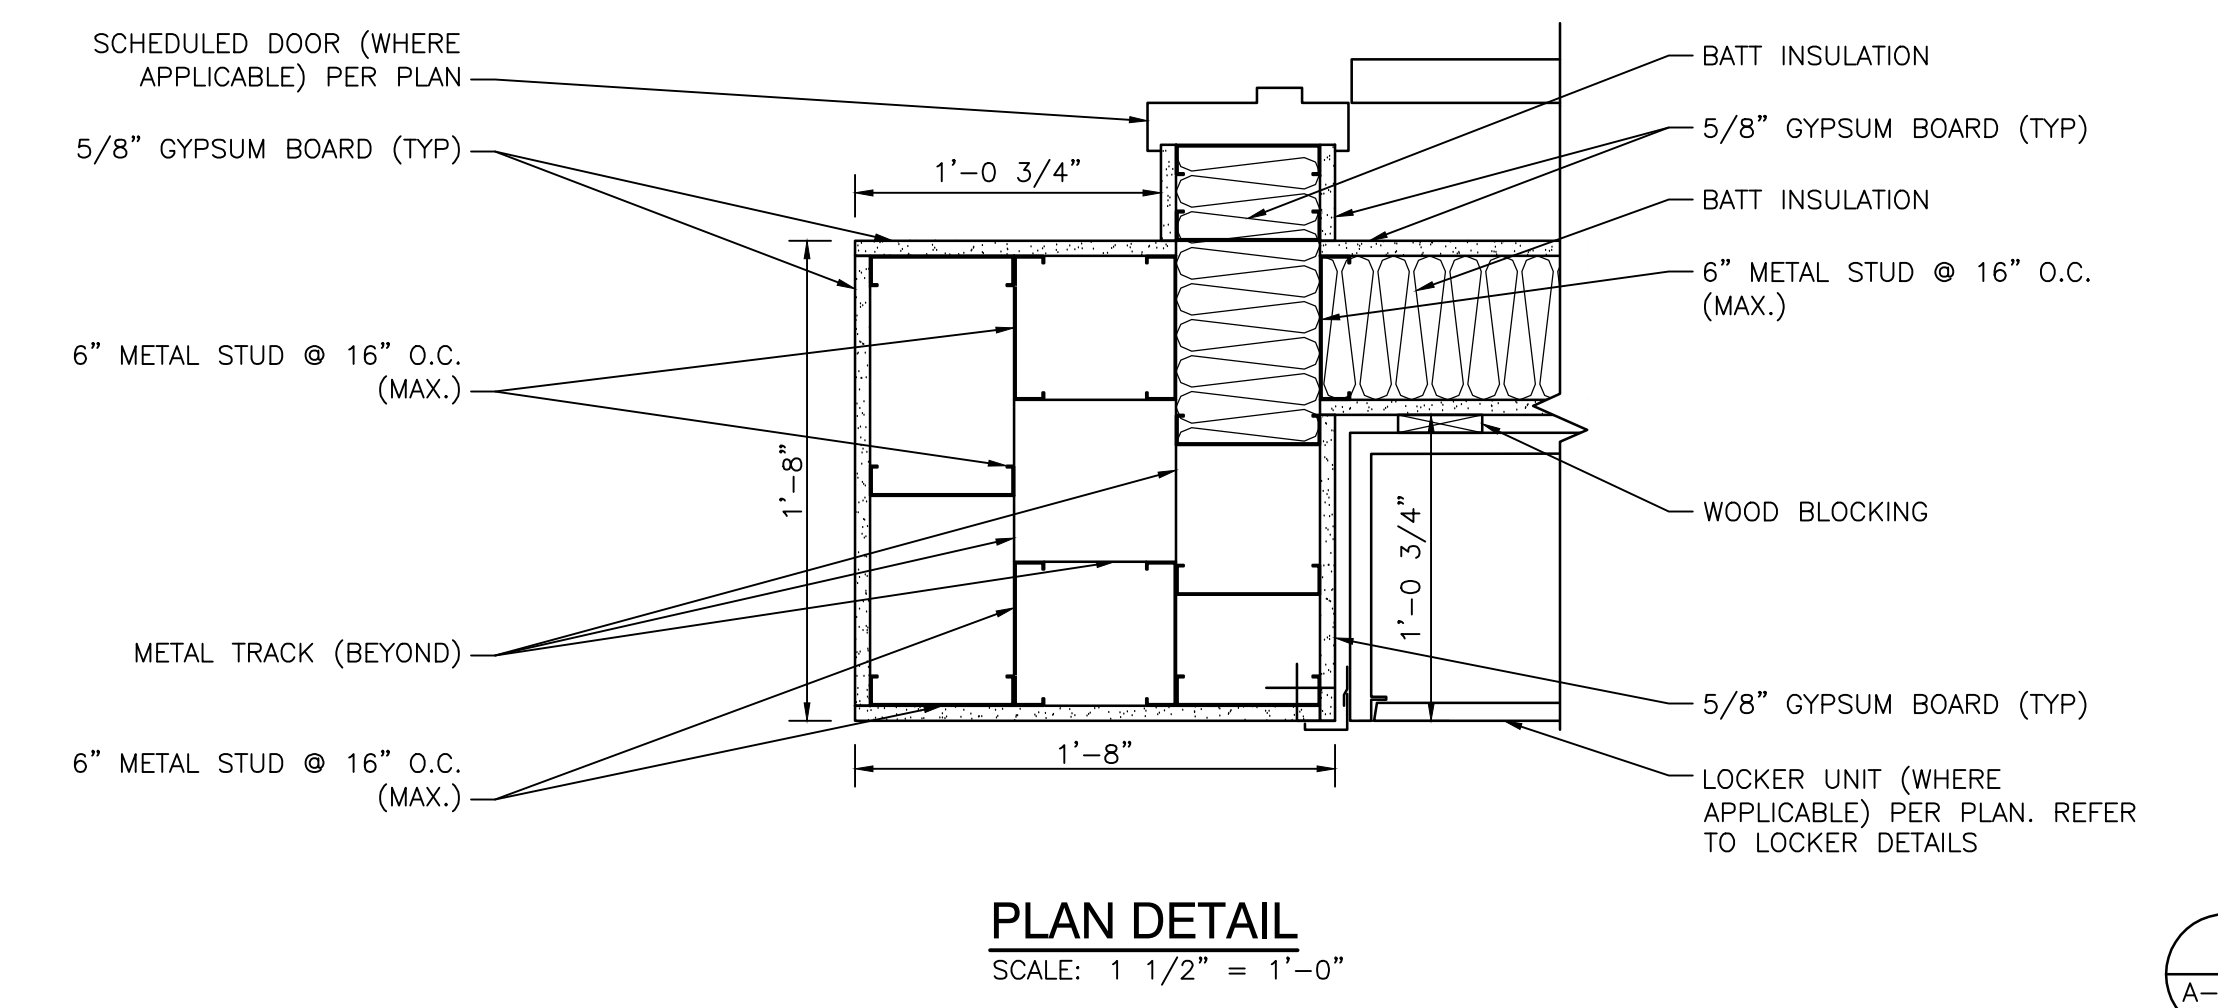


Thursday, 6/16/2022 1:39 PM - LAST SAVED BY: JHARRIS
Y:\21-155 FRANKLIN TOWNSHIP CSC-EDGEWOOD IS
ADDITIONS AND RENOVATIONS 21-155 DRAWINGS\05
ARCH\A-502.DWG



GIBRALTAR DESIGN
ARCHITECTURE • ENGINEERING • INTERIOR DESIGN


PROJECT
ADDITIONS AND RENOVATIONS TO
EDGEWOOD INTERMEDIATE SCHOOL
FRANKLIN TOWNSHIP COMMUNITY SCHOOL CORPORATION
INDIANAPOLIS, INDIANA

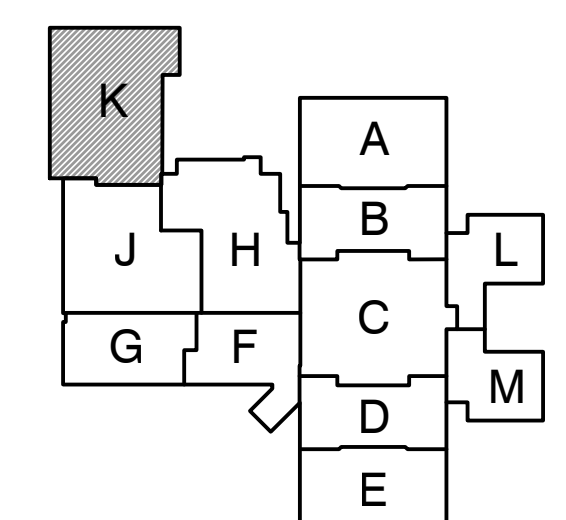

FIRST FLOOR KEY PLAN

GIBRALTAR DESIGN
9102 N. Meridian St., Ste. 300
Indianapolis, IN 46260
Homepage: www.GibraltarDesign.com
Email: info@GibraltarDesign.com
Phone: 317.580.5777 Fax: 317.580.5778

PROJECT: 21-155
DATE: 05/23/22
COORDINATED BY: DJW
DRAWN BY: EKM
CHECKED BY: NAS

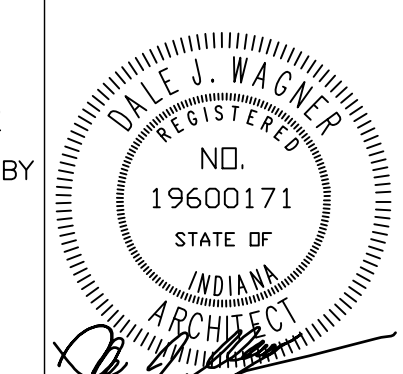

COPYRIGHT NOTICE:
THE CONCEPTS, DESIGNS, PLANS, DETAILS, ETC. SHOWN ON THIS DOCUMENT ARE THE PROPERTY OF GIBRALTAR DESIGN AND ARE NOT TO BE REPRODUCED OR TRANSMITTED IN ANY FORM OR BY ANY MEANS, ELECTRONIC OR MECHANICAL, INCLUDING PHOTOCOPYING, RECORDING, OR BY ANY INFORMATION STORAGE AND RETRIEVAL SYSTEM, WITHOUT THE EXPRESS WRITTEN CONSENT OF GIBRALTAR DESIGN. THE OWNER MAY RETAIN COPIES FOR INFORMATION AND REFERENCE IN CONNECTION ONLY WITH THIS PROJECT.

MARK	DATE	ISSUED FOR
AD-1	06/16/22	ADDENDUM NO.1

DRAWING
UNIT "K" FIRST FLOOR EQUIPMENT PLAN

PROJECT
ADDITIONS AND RENOVATIONS TO
EDGEWOOD INTERMEDIATE SCHOOL

GIBRALTAR DESIGN SHEET
K A-711

GENERAL EQUIPMENT PLAN NOTES:

- A. REFER TO SPECIFICATIONS FOR ADDITIONAL INFORMATION.
- B. FIELD VERIFY ALL DIMENSIONS.
- C. CASEWORK AND/OR MILLWORK INSTALLER TO COORDINATE ELECTRICAL AND PLUMBING WORK. REFER TO ELECTRICAL DRAWINGS AND SCHEDULES FOR ELECTRICAL DEVICE TYPES, HEIGHTS, AND LOCATIONS.
- D. REFER TO G SERIES DRAWINGS FOR MOUNTING HEIGHTS.
- E. REFER TO ARCHITECTURAL FLOOR PLANS FOR REFERENCE TO ENLARGED TOILET ROOM PLANS AND TOILET ROOM ACCESSORIES.

EQUIPMENT PLAN LEGEND:

- (C) INDICATES CASEWORK ELEVATION SYMBOL - REFER TO A-700 SERIES DRAWINGS FOR ELEVATIONS AND DETAILS.
- INDICATES ITEMS TO BE PART OF LOOSE EQUIPMENT PACKAGE BY OWNER. (NOT INCLUDED IN CONSTRUCTION CONTRACT).
- INDICATES BULKHEADS OR OTHER OVERHEAD ITEMS (INCLUDED IN CONSTRUCTION CONTRACTS).
- (CG) INDICATES CORNER GUARD.
- (TB) INDICATES 4" HIGH TACK BOARD LENGTH AS INDICATED, REFER TO MOUNTING HEIGHT DRAWING.
- (MB) INDICATES 4" HIGH MARKER BOARD LENGTH AS INDICATED, REFER TO MOUNTING HEIGHT DRAWING.
- (SMB) INDICATES 4" HIGH MARKER BOARD LENGTH AS INDICATED, WITH STAFF LINES ON HALF OF THE MARKER BOARD, REFER TO MOUNTING HEIGHT DRAWING.
- (TV) TELEVISION MONITOR, REFER TO TECHNOLOGY DRAWINGS.

EQUIPMENT PLAN NOTES:


- (ALL PLAN NOTES MAY NOT BE INDICATED ON THIS PLAN)
- (1) SCOREBOARD, REFER TO ELECTRICAL DRAWINGS FOR POWER.
- (2) COURT MARKINGS AND EQUIPMENT.
- (3) SAFETY CUSHION WAINSCOT.
- (4) PROJECTION SCREEN (ELECTRICALLY OPERATED).
- (5) PROJECTION SCREEN (MOUNTED TO WALL (MANUAL)).
- (6) BLEACHERS, REFER TO BLEACHER KEY NOTES.
- (7) FORWARD FOLD GLASS BASKETBALL BACKSTOP AND SUPPORT FRAMING.
- (8) DIVIDER CURTAIN ALTERNATE.
- (9) DISPLAY CASE UNIT.

OWNER FURNISHED EQUIPMENT PLAN NOTES:

- (50) LOOSE FURNITURE, BY OWNER, INDICATED ON PLAN FOR ELECTRICAL AND TECHNOLOGY COORDINATION.
- (51) COMPUTER/MONITOR, BY OWNER
- (52) PRINTER/COPIER, BY OWNER
- (53) BOOK CART, BY OWNER
- (54) POPCORN MACHINE, BY OWNER
- (55) DISPLAY REFRIGERATOR, BY OWNER
- (56) COFFEE MAKER, BY OWNER
- (57) MICROWAVE, BY OWNER
- (58) HOT DOG WARMER, BY OWNER

BLEACHER KEY NOTES:


- (B) BLEACHERS (2 LOCATIONS)
 1. WALL ATTACHED.
 2. TELESCOPING BLEACHERS.
 3. ELECTRICALLY OPERATED.
 4. SELF CLOSING HANDRAILS.
 5. PROVIDE CLOSURE AS REQUIRED TO FILL GAPS.
- GENERAL BLEACHER NOTE:
LAYOUT OF BLEACHERS IS NOT INTENDED TO RESTRICT THE BLEACHER MANUFACTURER, BUT IS TO PROVIDE DESIGN LAYOUT GUIDELINES. THE MANUFACTURER HAS FLEXIBILITY IN ADA LOCATIONS, AISLE SPACING, SECTIONS, ETC. AS APPROVED BY THE ARCHITECT THROUGH SHOP DRAWING SUBMITTALS.

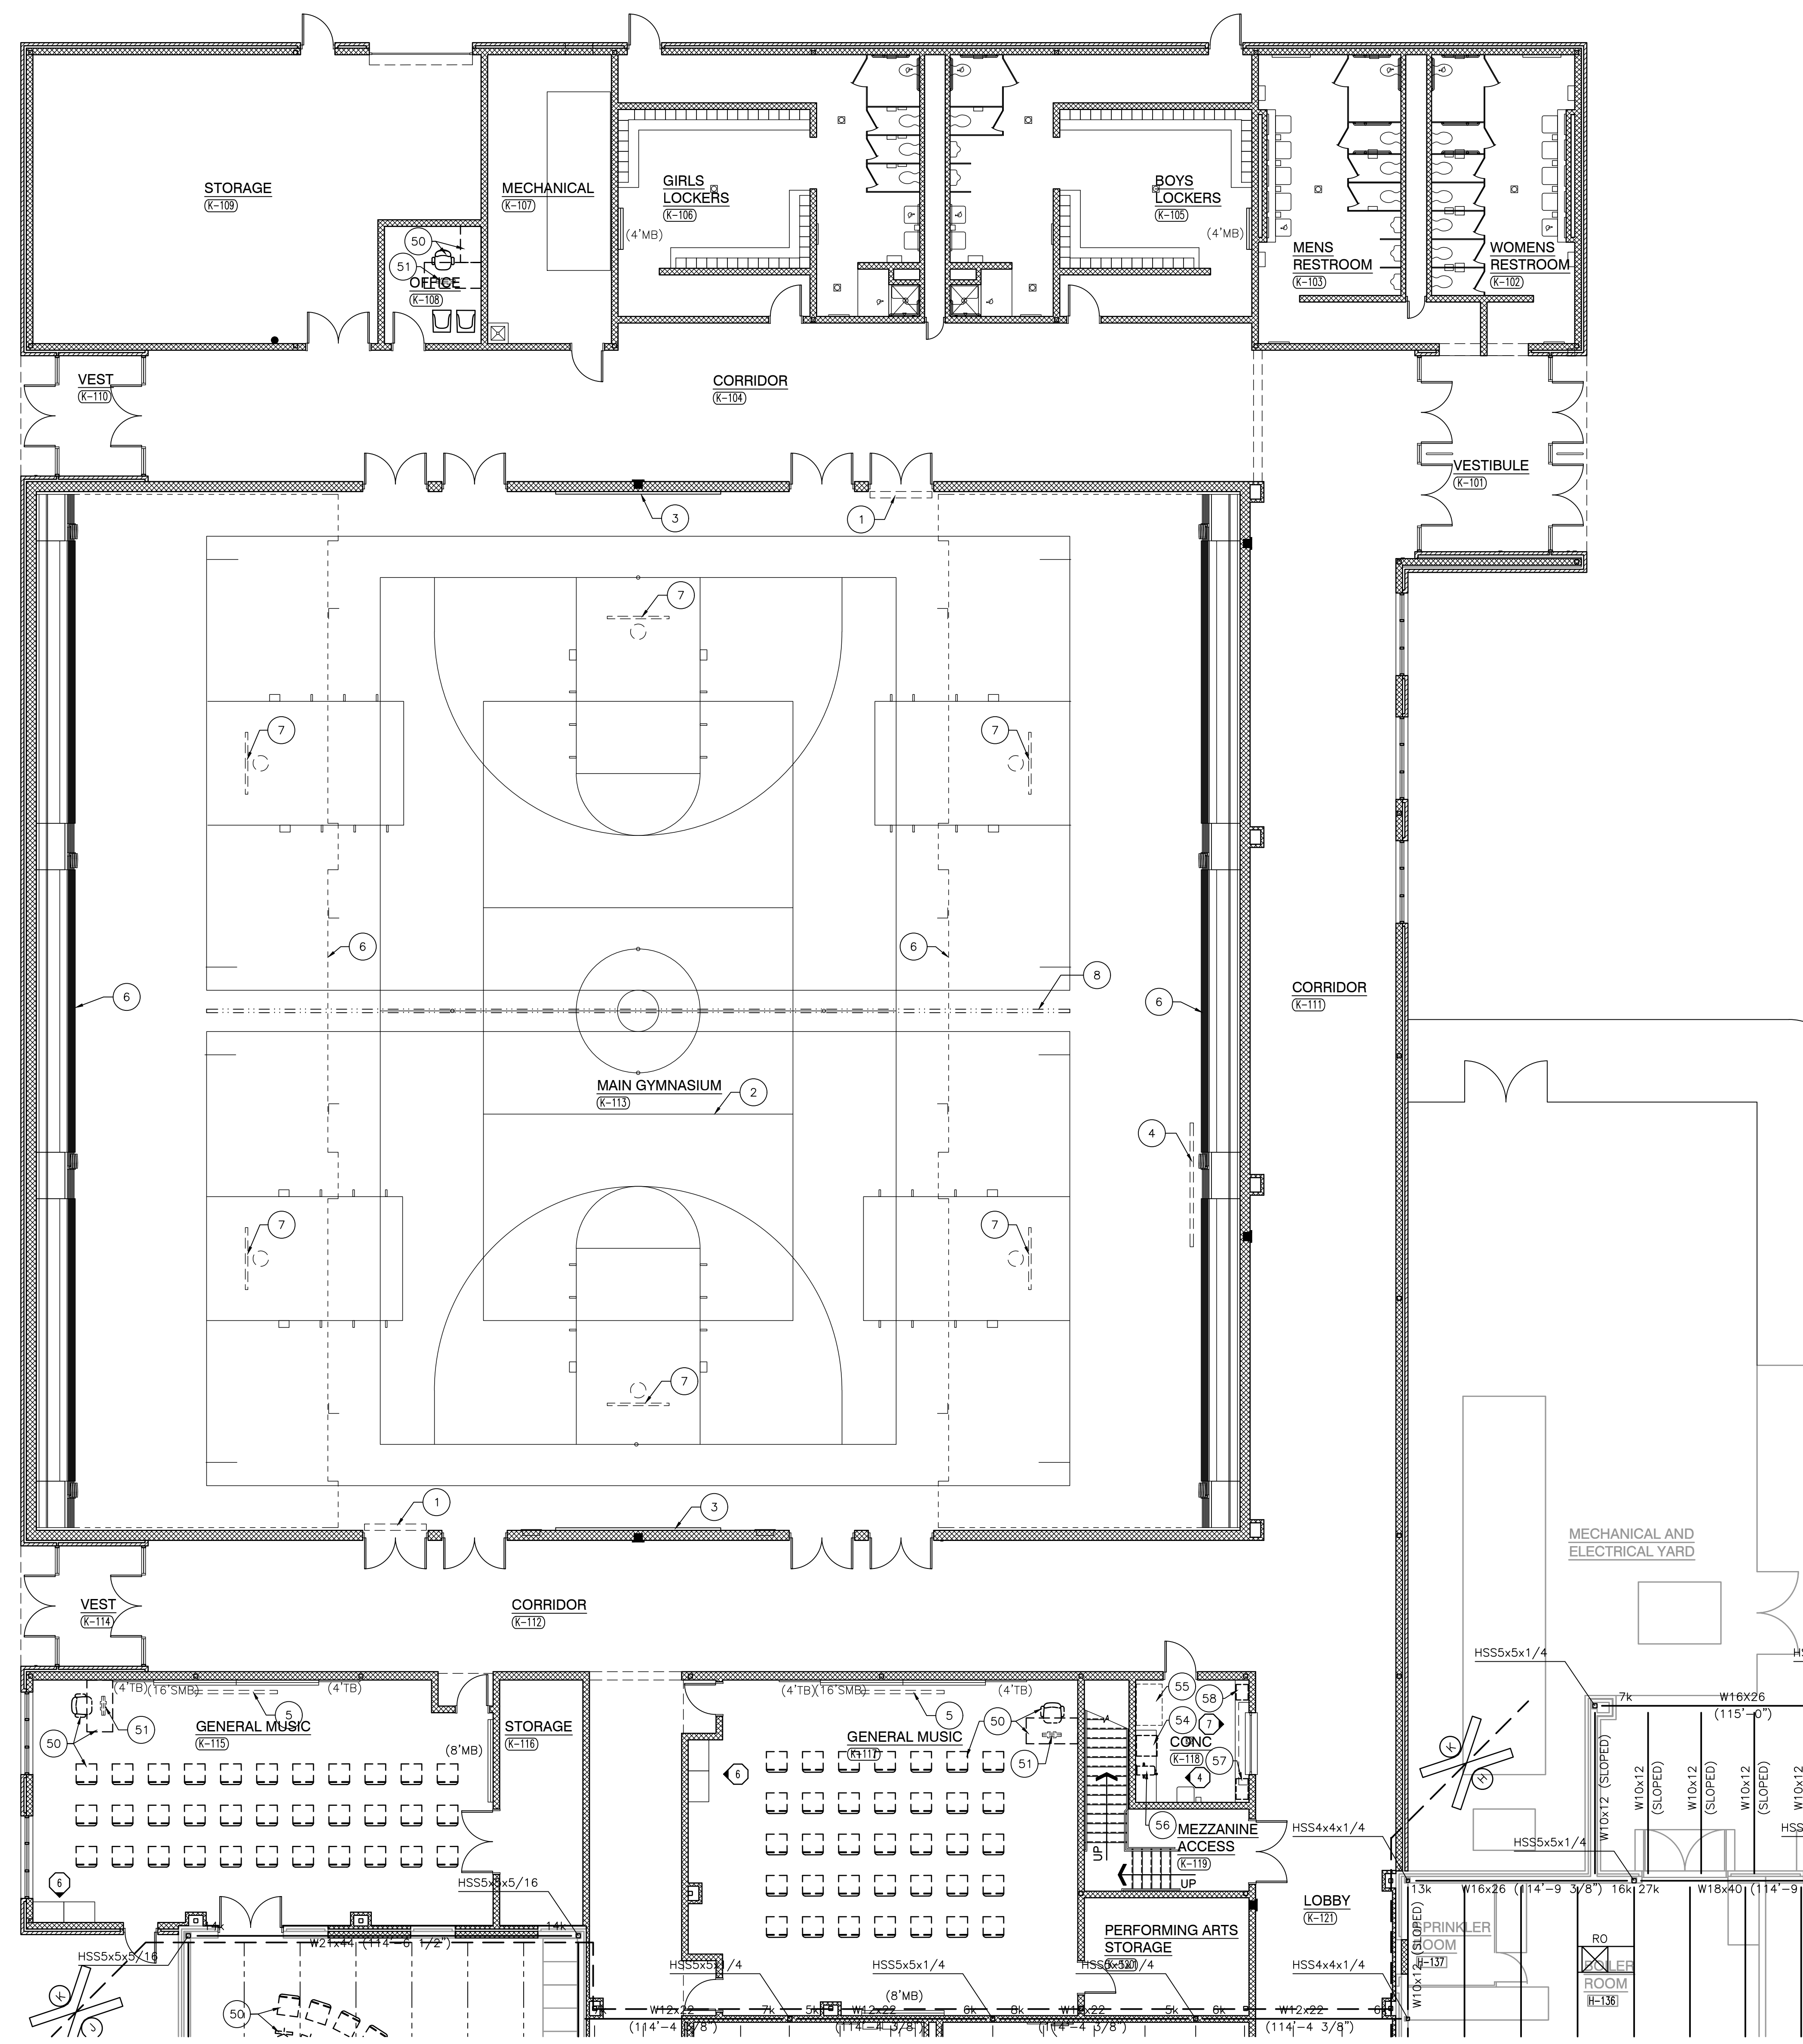


Thursday, 6/16/2022 - 10:21 AM - LAST SAVED BY: ELMQUEEN
 Y:\21-155 FRANKLIN TOWNSHIP CSC-EDGEWOOD IS
 ADDITIONS AND RENOVATIONS\21-155 DRAWINGS\05
 ARCH\A-711.DWG

UNIT "K" FIRST FLOOR EQUIPMENT PLAN

SCALE: 1/8" = 1'-0"

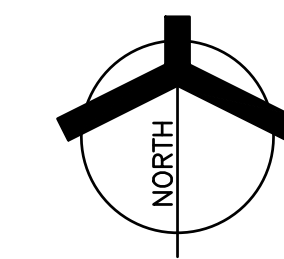

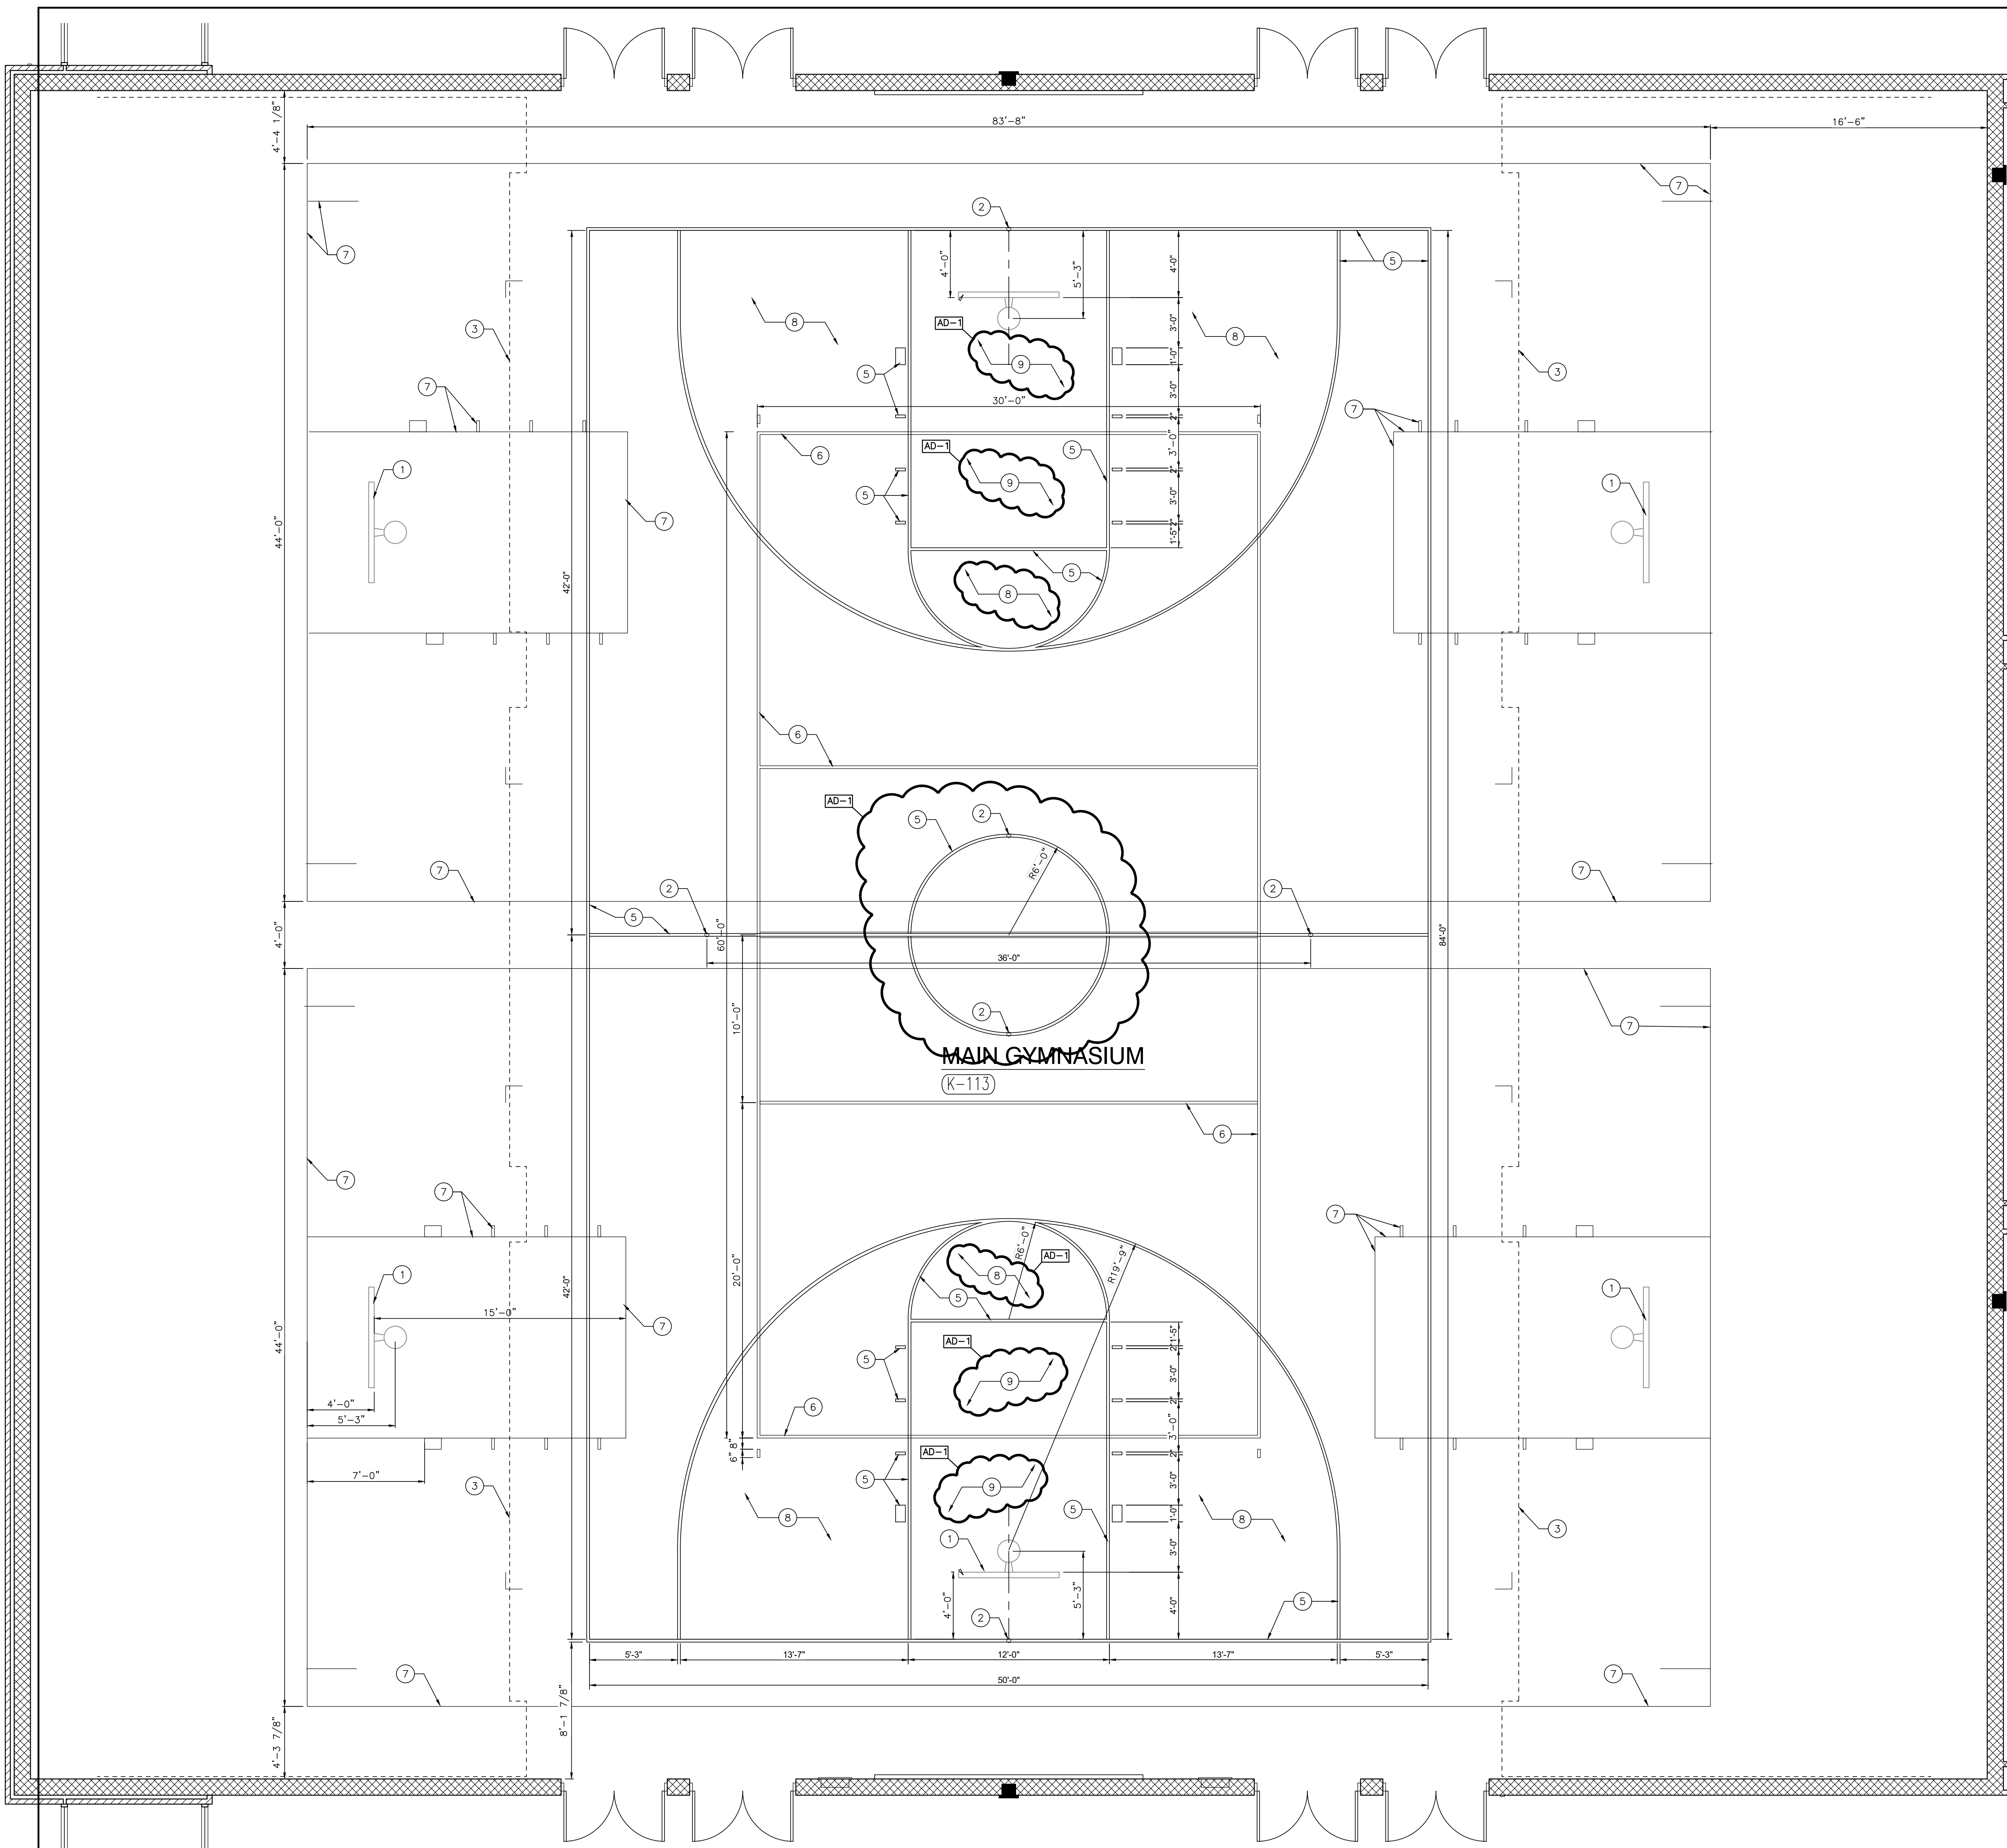

GENERAL COURT MARKING PLAN NOTES:

- A. REFERENCE FINISH LEGEND FOR FINISH INFORMATION.
- B. REFERENCE FLOOR PATTERN PLANS, EQUIPMENT PLANS, INTERIOR ELEVATIONS, REFLECTED CEILING PLANS AND WRITTEN SPECIFICATIONS FOR ADDITIONAL FINISH INFORMATION.
- C. PRIOR TO INSTALLATION OF NEW FINISHES CONTRACTOR SHALL INSPECT ALL SUBSTRATES. IF A SUBSTRATE IS DEEMED UNACCEPTABLE THE CONTRACTOR SHALL TAKE THE NECESSARY STEPS TO RECTIFY THE SITUATION OR CONTACT THE ARCHITECT WITH THE CONCERN. PROCEEDING WITH THE INSTALLATION OF FINISHES WILL BE CONSTRUED THAT THE INSTALLER AND /OR FINISHER HAS ACCEPTED SAID SUBSTRATE. NO CHANGE ORDER WILL BE ISSUED TO RECTIFY CONCEALED, OR UNSATISFACTORY SUBSTRATE ONCE FINISH WORK HAS PROCEEDED.
- D. CONTRACTOR TO PROVIDE AND INSTALL FLOORING TRANSITIONS AS INDICATED ON THE FLOOR PATTERN PLANS. WHERE NONE ARE NOTED, CONTRACTOR SHALL VERIFY REQUIRED TYPE/COLOR WITH ARCHITECT.
- E. VERIFY DIMENSIONS AND LINE THICKNESS SHOWN WITH CURRENT INDIANA HIGH SCHOOL ATHLETIC ASSOCIATION (IHSA) STANDARDS.
- F. PRIMARY FINISH IS CLEAR STAIN COAT.
- G. PROVIDE ACCENT STAIN COLOR WHERE NOTED.
- H. VERIFY FINAL LAYOUT AND FINISH COLOR WITH OWNER PRIOR TO INSTALLATION.

COURT MARKING PLAN NOTES:

- 1 BASKETBALL BACKSTOP REFER TO EQUIPMENT PLANS.
- 2 FLOORPLATE/SLEEVE FOR VOLLEYBALL OR TENNIS NET UPRIGHTS.
- 3 BLEACHERS, REFER TO EQUIPMENT PLANS.


COURT MARKING FINISH NOTES:

- 5 2" MAIN BASKETBALL COURT LINES, BLACK.
- 6 2" VOLLEYBALL COURT LINES, WHITE.
- 7 2" CROSS BASKETBALL COURT LINES, BLUE.
- 8 WHITEWASH WOOD FLOOR.
- 9 PAINTED WOOD FLOOR, BLUE.



GIBRALTAR DESIGN
ARCHITECTURE • ENGINEERING • INTERIOR DESIGN


PROJECT
ADDITIONS AND RENOVATIONS TO
EDGEWOOD INTERMEDIATE SCHOOL
FRANKLIN TOWNSHIP COMMUNITY SCHOOL CORPORATION
INDIANAPOLIS, INDIANA

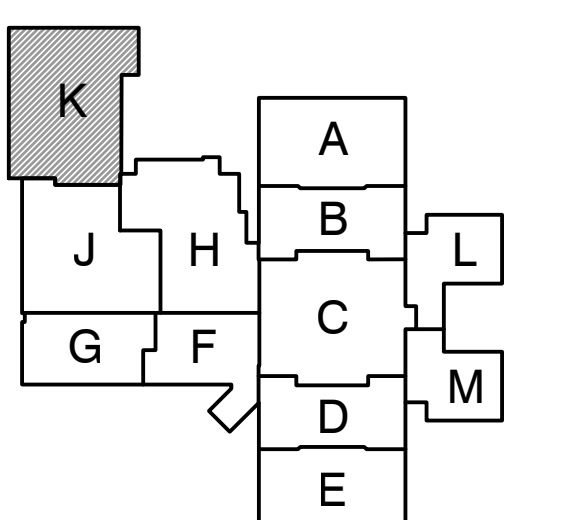

FIRST FLOOR KEY PLAN

GIBRALTAR DESIGN
9102 N. Meridian St., Ste. 300
Indianapolis, IN 46260
Homepage: www.GibraltarDesign.com
Email: info@GibraltarDesign.com
Phone: 317.580.5777 Fax: 317.580.5778

PROJECT: 21-155
DATE: 05/23/22
COORDINATED BY: DJW
DRAWN BY: EKM
CHECKED BY: NAS, DJW

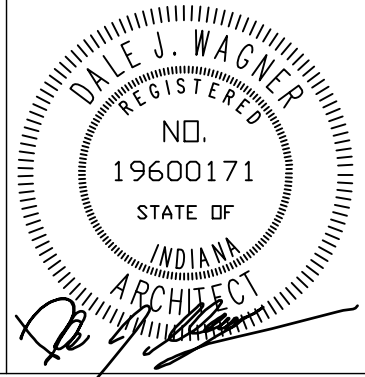

COPYRIGHT NOTICE:
THE CONCEPTS, DESIGNS, PLANS, DETAILS, ETC. SHOWN ON THIS DOCUMENT ARE THE PROPERTY OF GIBRALTAR DESIGN AND WERE CREATED FOR USE ON THIS SPECIFIC PROJECT. NONE OF THIS INFORMATION SHALL BE USED BY ANY PERSON OR FIRM FOR ANY PURPOSE WITHOUT THE EXPRESS WRITTEN CONSENT OF GIBRALTAR DESIGN. THE OWNER MAY RETAIN COPIES FOR INFORMATION AND REFERENCE IN CONNECTION ONLY WITH THIS PROJECT.

REVISIONS	MARK	DATE	ISSUED FOR
AD-1	06/16/22		ADDENDUM NO.1

DRAWING
GYMNASIUM COURT MARKING PLAN

PROJECT
ADDITIONS AND RENOVATIONS TO
EDGEWOOD INTERMEDIATE SCHOOL

© GIBRALTAR DESIGN SHEET
A-840

GYMNASIUM COURT MARKING PLAN
SCALE: 1/4" = 1'-0"

1
A-840

Thursday, 6/16/2022 10:21 AM - LAST SAVED BY: EKM
Y:\21-155 FRANKLIN TOWNSHIP CSC-EDGEWOOD IS
ADDITIONS AND RENOVATIONS\21-155 DRAWINGS\05
ARCH\A-840.DWG



GIBRALTAR
DESIGN
ARCHITECTURE • ENGINEERING • INTERIOR DESIGN

PROJECT
ADDITIONS AND
RENOVATIONS TO
**EDGEWOOD
INTERMEDIATE
SCHOOL**
FRANKLIN TOWNSHIP COMMUNITY
SCHOOL CORPORATION
INDIANAPOLIS, INDIANA

GENERAL INTERIOR ELEVATION NOTES:


- A. REFERENCE FINISH LEGEND FOR FINISH INFORMATION.
- B. REFERENCE FLOOR PATTERN PLANS, EQUIPMENT PLANS, INTERIOR ELEVATIONS, REFLECTED CEILING PLANS AND WRITTEN SPECIFICATIONS FOR ADDITIONAL FINISH INFORMATION.
- C. PRIOR TO INSTALLATION OF NEW FINISHES CONTRACTOR SHALL INSPECT ALL SUBSTRATES. IF A SUBSTRATE IS DEEMED UNACCEPTABLE THE CONTRACTOR SHALL TAKE THE NECESSARY STEPS TO RECTIFY THE SITUATION OR CONTACT THE ARCHITECT WITH THE CONCERN. PROCEEDING WITH THE INSTALLATION OF FINISHES WILL BE CONSTRUED THAT THE INSTALLER AND /OR FINISHER HAS ACCEPTED SAID SUBSTRATE. NO CHANGE ORDER WILL BE ISSUED TO RECTIFY CONCEALED, OR UNSATISFACTORY SUBSTRATE ONCE FINISH WORK HAS PROCEEDED.
- D. PREPARE ALL WALL CONSTRUCTION, NEW AND EXISTING, TO RECEIVE NEW FINISHES AS PER MANUFACTURE'S RECOMMENDED INSTALLATION METHODS AND MATERIALS FOR ALL FINISHES.
- E. ALL EXPOSED METAL SURFACES, SUCH AS GRILLES, FIRE EXTINGUISHER CABINETS, ETC. THAT ARE NOTED TO BE PAINTED, SHALL BE PAINTED WITH ALKYO TYPE PAINT. COLOR TO BE COORDINATED WITH DESIGNER UNLESS OTHERWISE NOTED.
- F. THE CONTRACTOR SHALL BE RESPONSIBLE TO VERIFY THAT ALL NEW INTERIOR WALL AND CEILING FINISHES WILL BE CLASS B MINIMUM, WITH A FLAME SPREAD RATING OF 75 MAXIMUM, AND A SMOKE DEVELOPED INDEX OF 450 MAXIMUM, PER IBC SECTION 803.

INTERIOR ELEVATION NOTES:


- (ALL ELEVATION NOTES MAY NOT BE INDICATED ON THIS PLAN)
- 1) PROJECTION SCREEN, REFER TO EQUIPMENT PLANS.
 - 2) MARKERBOARD, REFER TO EQUIPMENT PLANS.
 - 3) BLEACHERS, REFER TO EQUIPMENT PLANS.
 - 4) BASKETBALL BACKSTOP, REFER TO EQUIPMENT PLANS.
 - 5) SAFETY CUSHION WAINGSCOT, REFER TO EQUIPMENT PLAN.
 - 6) SCOREBOARD, REFER TO EQUIPMENT PLANS.
 - 7) EXPOSED STRUCTURE AND ROOF DECK, PAINT P10.
 - 8) TRANSLUCENT WALL PANEL.
 - 9) DOOR.
 - 10) TACKBOARD, REFER TO EQUIPMENT PLANS.

INTERIOR ELEVATION FINISH NOTES:

- (ALL ELEVATION NOTES MAY NOT BE INDICATED ON THIS PLAN)
- 50) PAINT, P1
 - 51) WALLCOATING, W1
 - 52) WALLCOATING, W2
 - 53) WALLCOATING, W4
 - 54) ACOUSTICAL WALL PANEL, AR-AWP1
 - 55) ACOUSTICAL WALL PANEL, AR-AWP2
 - 56) ACOUSTICAL WALL PANEL, AR-AWP3
 - 57) ACOUSTICAL WALL PANEL, AR-AWP4
 - 58) ACOUSTICAL WALL PANEL, FW-AWP1
 - 59) ACOUSTICAL WALL PANEL, FW-AWP2
 - 60) ACOUSTICAL WALL PANEL, FW-AWP3
 - 61) ACOUSTICAL WALL PANEL, FW-AWP4
 - 62) WALL TILE, WT2
 - 63) WALL TILE, WT3
 - 64) WALL TILE, WT4
 - 65) WALL TILE, WT5
 - 66) WALL TILE, WT1
 - 67) EPOXY BASE, EB
 - 68) VINYL BASE, B1
 - 69) SCHLUTER TRIM, OUTSIDE CORNER OR END OF TILE RUN.
 - 70) PAINT, P2
 - 71) PAINT, P5
 - 72) VINYL BASE, B2
 - 73) ACOUSTICAL WALL PANEL, AR-AWP5

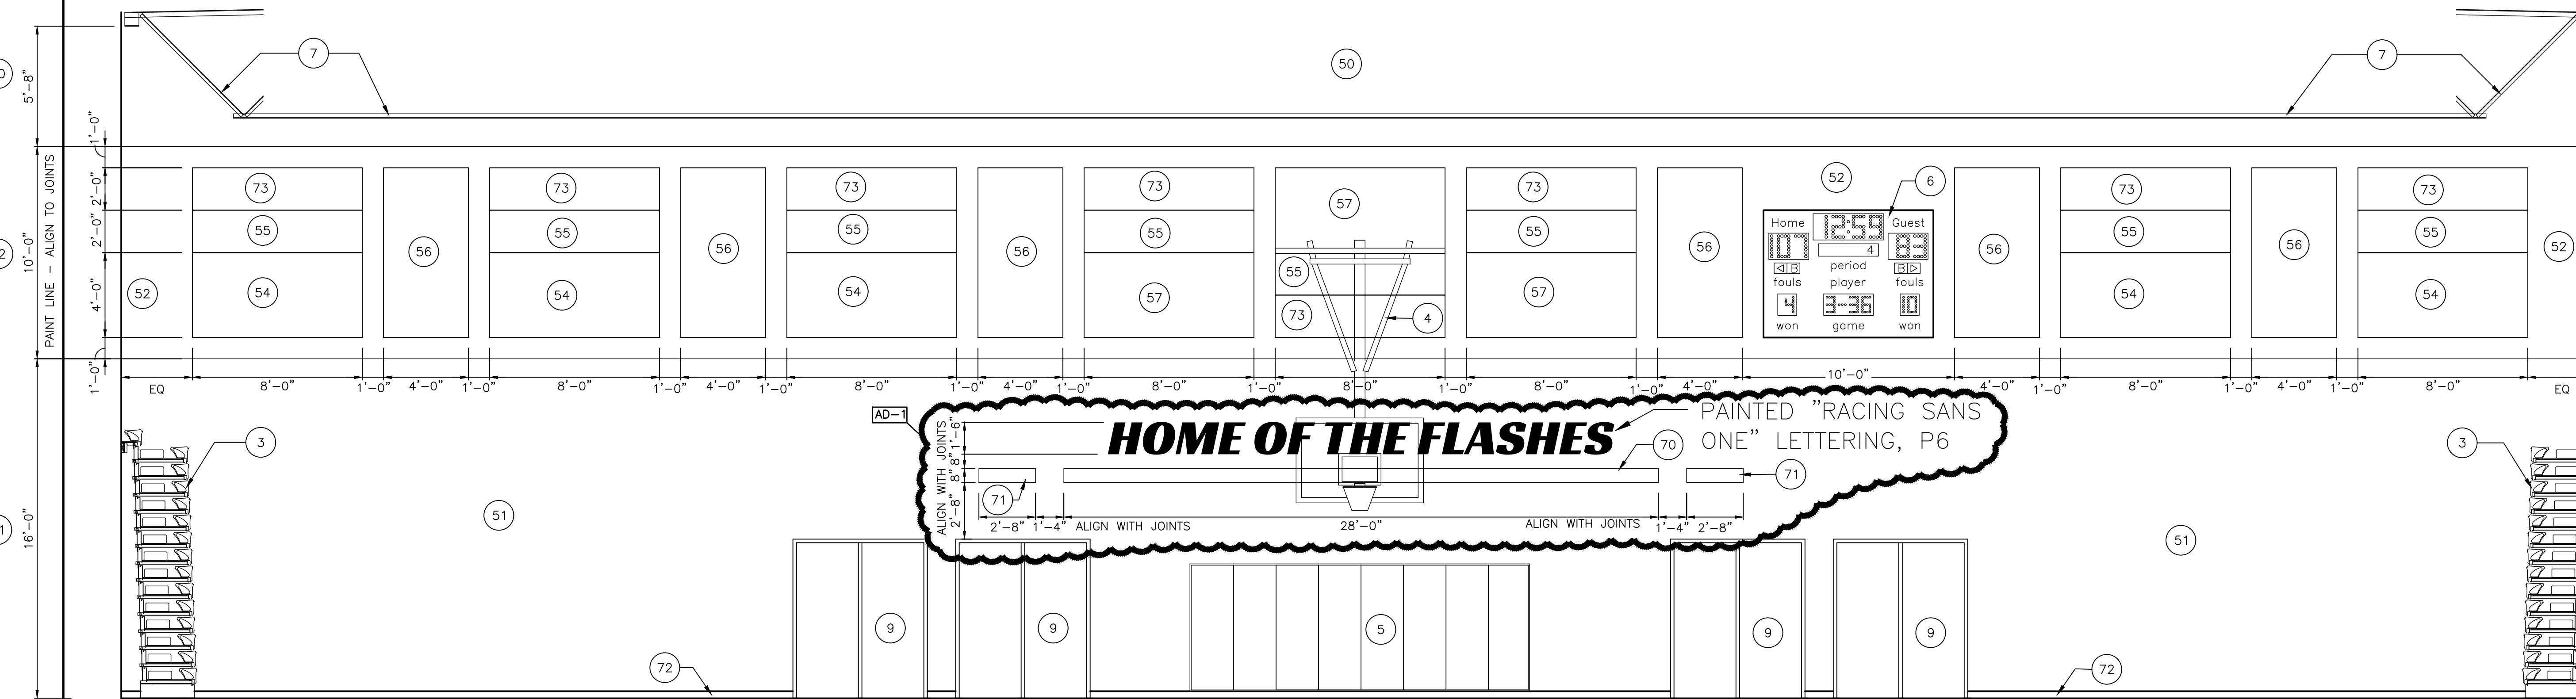


GYMNASIUM NORTH ELEVATION 2
SCALE: 1/4" = 1'-0" A-850

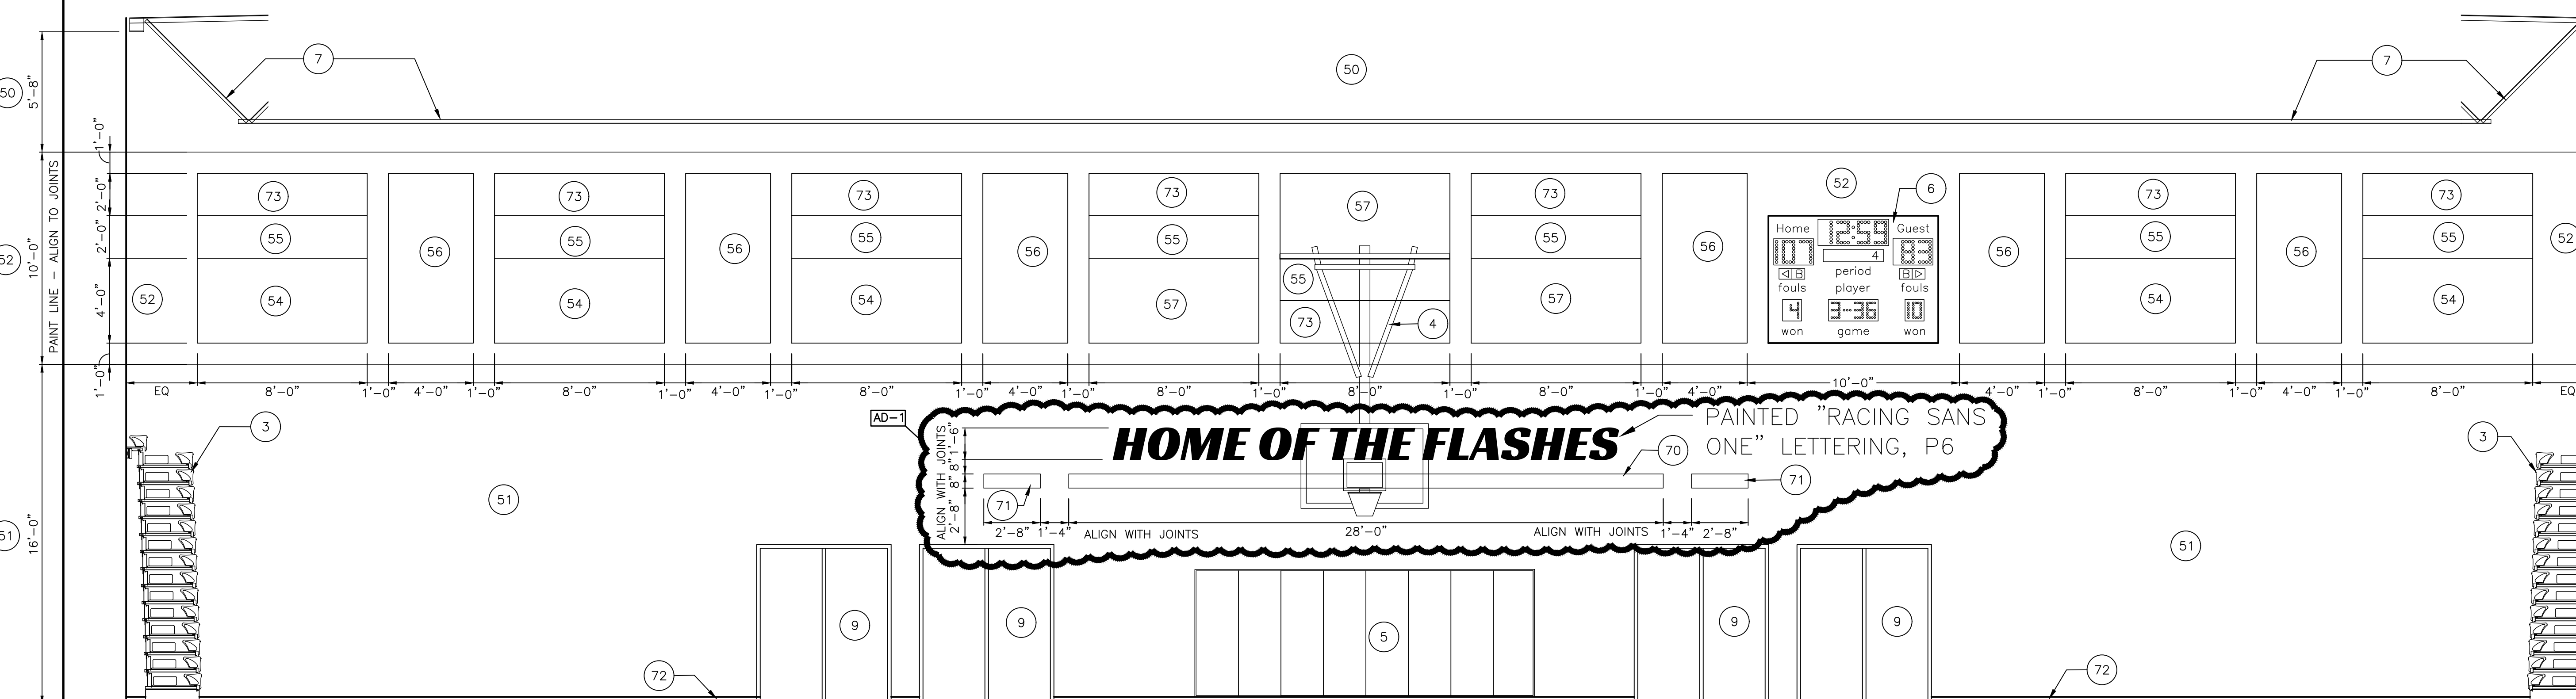

GYMNASIUM SOUTH ELEVATION 1
SCALE: 1/4" = 1'-0" A-850

GIBRALTAR DESIGN
9102 N. Meridian St., Ste. 300
Indianapolis, IN 46260
Homepage www.GibraltarDesign.com
Email info@GibraltarDesign.com
Phone 317.580.5777 Fax 317.580.5778

PROJECT
21-155
DATE
05/23/22
COORDINATED BY
DJW
DRAWN BY
EKM
CHECKED BY
NAS

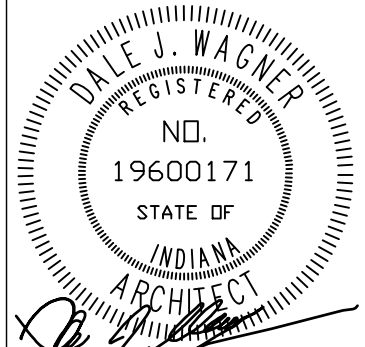

COPYRIGHT NOTICE:
THE CONCEPTS, DESIGNS, PLANS, DETAILS, ETC. SHOWN ON THIS DOCUMENT ARE THE PROPERTY OF GIBRALTAR DESIGN AND WERE CREATED FOR USE ON THIS SPECIFIC PROJECT. NONE OF THIS INFORMATION SHALL BE USED BY ANY PERSON OR FIRM FOR ANY PURPOSE WITHOUT THE EXPRESS WRITTEN CONSENT OF GIBRALTAR DESIGN. THE OWNER MAY RETAIN COPIES FOR INFORMATION AND REFERENCE IN CONNECTION ONLY WITH THIS PROJECT.

REVISIONS	MARK	DATE	ISSUED FOR
AD-1	06/16/22	ADDENDUM NO.1	

DRAWING
INTERIOR ELEVATIONS

PROJECT
ADDITIONS AND RENOVATIONS TO
EDGEWOOD INTERMEDIATE SCHOOL

© GIBRALTAR DESIGN SHEET
A-850

Thursday, 6/16/2022 - 10:21 AM - LAST SAVED BY: ELMWOOD
Y:\21-155 FRANKLIN TOWNSHIP CSC-EDGEWOOD IS
ADDITIONS AND RENOVATIONS\21-155 DRAWINGS\05
ARCH\A-850.DWG