### ADDENDUM NO. 1

**November 14, 2022** 

# JACKSON ELEMENTARY SCHOOL RENOVATIONS Valparaiso, IN 46304

### TO: ALL BIDDERS OF RECORD

This Addendum forms a part of and modifies the Bidding Requirements, Contract Forms, Contract Conditions, the Specifications, and the Drawings dated October 31, 2022 by Gibraltar Design. Acknowledge receipt of the Addendum in the space provided on the Bid Form. Failure to do so may subject the Bidder to disqualification.

This Addendum consists of page ADD 1-1 and attached Addendum No. 1 from Gibraltar Design dated November 9, 2022 and consisting of 4 pages and 29 drawings.



### **ADDENDUM ONE**

**Addendum One (AD.01)** to the drawings and specifications prepared by Gibraltar Design for **Jackson Elementary School Renovations** for Duneland School Corporation, Chesterton, Indiana.

All Contractors bidding on this project shall read all of the items covered below and shall comply with all of the requirements as set forth, including any necessary refinements or additions generated by this Addendum and required by the intent of the original contract documents. All Contractors shall acknowledge on their bid form that they have received this Addendum and include the appropriate content of same within their bid proposal.

### **DRAWINGS**

### 1. Sheet S-001

- A. Refer to revised full size drawing, included in this Addendum, for the following revisions:
  - 1. Add Lintel Schedule.

#### 2. Sheet AD102

- A. Refer to revised full size drawings, included in this Addendum, for the following revisions:
  - 1. Updated demolition in rooms Custodian A-102, Boys A-103 and Girls A-104.

### 3. Sheets A-101 and A-102

- A. Refer to two (2) revised full size drawings, included in this Addendum, for the following revisions:
  - 1. Updated casework throughout to coordinate with Equipment plans.
  - 2. Updated floorplan to include Commons B-125B, Toilet B-119A, and Toilet B-119B.

### 4. Sheets A-401

- A. Refer to revised full size drawing, included in this Addendum, for the following revisions:
  - 1. Updated detail bubble numbers.

#### 5. Sheet A-701

- A. Refer to revised full size drawing, included in this Addendum, for the following revisions:
  - 1. Plan casework length change in classrooms.
  - 2. Note added detail number for roller shades.

### 6. Sheet A-702

- A. Refer to revised full size drawing, included in this Addendum, for the following revisions:
  - 1. Plan casework length change in classrooms.
  - 2. Plan modifications, Commons B-125B.
  - 3. Note added detail number for roller shades.



#### 7. Sheet A-720

- A. Refer to revised full size drawing, included in this Addendum, for the following revisions:
  - 1. Updated Enlarged Restroom detail 3/A-720 to include Toilet B-119A, and Toilet B-119B.

#### 8. Sheet A-730

- A. Refer to revised full size drawing, included in this Addendum, for the following revisions:
  - 1. Note elevation addition and addition of dimensions to elevations.

### 9. Sheets A-802 and A-803

- A. Refer to two (2) revised full size drawings, included in this Addendum, for the following revisions:
  - 1. Note plan finish changes.

#### 10. Sheet A-820

- A. Refer to revised full size drawing, included in this Addendum, for the following revisions:
  - 1. Note change in Carpet C4.

### 11. Sheet A-901

- A. Refer to revised full size drawing, included in this Addendum, for the following revisions:
  - 1. Revise Reflected Ceiling Plan Notes as follows:
    - a. Change note 1 text and add reference to detail 2/A-901.
    - b. Change note 7 text to "Not Used".
    - c. Eliminate note 11 and note 12.
  - 2. Add Detail 2/A-901 Metal Edge Trim Transition and Detail 3/A-901 Roller Shade Detail.

#### 12. Sheet A-902

- A. Refer to revised full size drawing, included in this Addendum, for revisions in the following rooms:
  - 1. Revise Reflected Ceiling Plan Notes as follows:
    - a. Change note 1 text and add reference to detail 2/A-901.
    - b. Change note 7 text to "Not Used".
    - c. Eliminate note 11 and note 12.
  - 2. Add Detail 2/A-901 Metal Edge Trim Transition and Detail 3/A-901 Roller Shade Detail.
  - 3. Updated ceiling plan to include Commons B-125B, Toilet B-119A, and Toilet B-119B.

### 13. Sheet A-903

- A. Refer to revised full size drawing, included in this Addendum, for the following revisions:
  - 1. Revise Reflected Ceiling Plan Notes as follows:
    - a. Change note 1 text and add reference to detail 2/A-901.
    - b. Change note 7 text to "Not Used".
    - c. Eliminate note 11 and note 12.



- 2. Add Note 9 to areas with no new ceilings.
- 3. Add note 1 to cloud ceiling in existing vestibule.

#### 14. Sheet MD101

- A. Refer to revised full size drawing, included in this Addendum, for the following revisions:
  - 1. Revised existing hot water supply and return piping to demo.

### 15. Sheet MD102

- A. Refer to revised full size drawing, included in this Addendum, for the following revisions:
  - 1. Revied existing ductwork in Corridor B-123C and Kindergarten B-123B.
  - 2. Added demo thermostats.
  - 3. Revised existing ductwork to demo ductwork in Learning Center B101B and Learning Center B101A.
  - 4. Revised sheet notes.
  - 5. Added sheet note tags to plans.
  - 6. Added notes for demo return air ductwork.
  - 7. Added demo notes for cabinet heaters.

### 16. Sheet MD104

- A. Refer to revised full size drawing, included in this Addendum, for the following revisions:
  - 1. Added sheet note 2.
  - 2. Clarified demo variable air volume boxes.

#### 17. Sheet MV102

- A. Refer to revised full size drawing, included in this Addendum, for the following revisions:
  - 1. Revised duct take-off in Commons B-147
  - 2. Added ductwork to diffuser in Café Storge B-142, Commons B-161, SGI B-163, Counselor B-168, Calm B-169, and Storage B-134.
  - 3. Added exhaust to Girls B-157, Boys B-158, Toilet B-135, and Toilet B-136.

### 18. Sheet MP101

- A. Refer to revised full size drawing, included in this Addendum, for the following revisions:
  - 1. Clarified thermostat connection to equipment.

#### 19. Sheet MP102

- A. Refer to revised full size drawing, included in this Addendum, for the following revisions:
  - 1. Added thermostats.
  - 2. Added hot water supply and return piping to CH-1.
  - 3. Added sheet note.
  - 4. Added rebalance note for existing VAV boxes.

#### 20. Sheet M-201

- A. Refer to revised full size drawing, included in this Addendum, for the following revisions:
  - 1. Added equipment tags and notes to exhaust fans.



#### 21. Sheet M-402

- A. Refer to revised full size drawing, included in this Addendum, for the following revisions:
  - 1. Added exhaust ductwork and notes.

### 22. Sheet M-601

- A. Refer to revised full size drawing, included in this Addendum, for the following revisions:
  - 1. Revised chiller equipment specialties.

#### 23. Sheet P-001

- A. Refer to revised full size drawing, included in this Addendum, for the following revisions:
  - 1. Revised Plumbing Fixture Schedule S-3 to be undermount sink.

### 24. Sheet EP-102

- A. Refer to revised full size drawing, included in this Addendum, for the following revisions:
  - 1. Added electrical connection device to CH-1 in Corridor B-125.
  - 2. Added electrical connection device to AC-1 in Technology B-133.

#### 25. Sheet EP-104

- A. Refer to revised full size drawing, included in this Addendum, for the following revisions:
  - 1. Added electrical connections to AHJB1 in Mechanical A-201.
  - 2. Added electrical connections to AHJB3 in Mechanical A-201.

### 26. Sheet EP-201

- A. Refer to revised full size drawing, included in this Addendum, for the following revisions:
  - 1. Revised electrical devices to relocated mechanical equipment.

#### 27. Sheet E-602

- A. Refer to revised full size drawing, included in this Addendum, for the following revisions:
  - 1. Revised mechanical connection schedule.
  - 2. Added pump connection schedule.
  - 3. Revised lighting control system notes.

Pages 1 through 4, inclusive, and Twenty-nine (29) Full-Size Drawings, constitute the total makeup of **Addendum One**.



Y:\21-143 Duneland SC - Jackson ES Additions and Renovations\Specs\ADDENDUM ONE\AD01.docx

### STRUCTURAL STEEL NOTES

- 1. Structural steel construction shall conform to the American Institute of Steel Construction Specification for Structural Steel Buildings".
- 2. All structural wide flange members shall be ASTM A992, Fy=50 ksi All plates, channels, bars, angles, and rods shall be ASTM A36, unless noted.
- 4. All rectangular structural tube members shall be ASTM A500, Grade C, Fy = 50 ksi unless noted. 5. All round structural tube members shall be ASTM A500, Grade C, Fy = 46 ksi unless noted.
- 6. All structural pipe members shall be ASTM A53, Grade B, Fy=35 ksi unless noted. . Details for design, fabrication and erection of all structural steel shall be in accordance with the latest AISC Standards, unless otherwise noted or specified.
- 8. Provide temporary erection guying and bracing as required. 9. Unless otherwise shown or noted on the Drawings, provide 8" minimum bearing each end for all
- loose lintels and beams. 10. For loose lintels, masonry shelf angles and other such items generally not shown on the Structural Drawings, refer to the Architectural Drawings. See general notes on lintels this sheet for sizes, reinforcing, etc.
- 11. Steel columns below grade shall be encased in a minimum of 4" concrete or painted with 2 coats of asphaltum paint, unless otherwise shown. 12. Fabricate simple span beams not specifically noted to receive camber so that after erection, any
- minor camber due to rolling or shop assembly be upward. 13. Refer to the Division 5 Structural Steel Specification of the Project Manual for structural steel
- surface preparations and prime painting requirements. 14. The Erector shall shim between parallel roof beams and joists with differential mill and induced cambers for level deck bearing.
- 15. Provide cap plates/end plates to close off exposed, open ends of all tubular members, unless noted. Seal weld with partial penetration square groove welds for watertight condition.

### STEEL CONNECTION NOTES

### 1. Typical beam-to-beam and beam-to-column connections shall be bearing type using A325 bolts, unless

- 2. Shop connections unless otherwise shown, may be either bolted or welded. All field connections shall be bolted unless otherwise shown on the Structural Drawings.
- 3. Connections shall be designed by the Steel Fabricator to support the reactions shown on the framing plan(s). Simple span connections without reactions listed on the Structural Drawings shall be designed by the Steel Fabricator in accordance with Table 3-6 of the AISC "Manual of Steel Construction, 14th Edition". For composite beams where reactions are not indicated, design connections for 75% of the Maximum Total Uniform Load ASD value for the applicable beam size and span given in Table 3-6. For
- non-composite beams, design connections for 50% of the tabulated ASD value. 4. Submit calculations for connections not detailed on the Structural Drawings and not covered by the
- AISC Tables, including but not limited to: A) Column Splices.
- B) Moment Connections.
- C) Bracing Connections including Collectors and Drag Struts.
- D) Skewed Shear Connections. E) Girder and Truss Splices.
- F) Truss-to-Column and Truss-to-Truss Connections.
- G) Truss Web-to-Chord and Web-to-Gusset Connections. H) Compression Ring/Tension Ring, and Raker Beam Connections.
- 5. All beam-to-beam connections shall be double angle, unless shown or noted otherwise. 6. All beam-to-column connections shall be at the column centerline, unless noted otherwise. Shear tab connections to tubes are permitted unless otherwise noted or detailed.
- 7. Typical beam-to-beam, and beam-to-column field-bolted connections may be tightened to the snugtight condition, unless otherwise shown or noted.
- 8. Bolted connections in moment frames, bracing connections, hangers and stub columns, crane connections, and those designated PT (pretensioned) on the Drawings shall be pretensioned joints utilizing tension-control (TC) bolts or direct tension indicators. Holes for PT bolts shall be 1/16" larger than the bolt diameter. All pretensioned joints must be inspected by the Testing Agency.
- 9. Connect bracing members for two components of stress unless otherwise approved by the Structural Engineer of Record. Provide a minimum 2-bolt or welded field connection.
- 10. Locate centerlines of all vertical bracing members on column centerlines in vertical plane and on column and beam centerlines in horizontal plane, unless otherwise shown on the Structural Drawings.
- 11. All welding shall be in conformance with AWS D1.1, using E70XX electrodes, unless shown or noted otherwise. Welding, both shop and field, shall be performed by welders certified for the weld types and positions involved according to the current edition of AWS D1.1. Perform all AESS welds with care to provide a clean, uniform appearance.
- 12. Backup bars required for welded connections shall be continuous.
- 13. Holes in steel shall be drilled or punched. All slotted holes shall be provided with smooth edges. Burning of holes in structural steel shall not be allowed without approval of the Structural Engineer of Record.
- 14. The minimum thickness of all connection material shall be 5/16" unless noted. 15. Continuous bent plate and angle closures, roof edges, diaphragm chords, etc. around perimeter of the floor and roof, as well as around openings shall be welded with a minimum 1/4" fillet weld x 3" long at 12" o.c., top & bottom, unless noted otherwise. Butt weld joints in continuous diaphragm chord for continuity. For continuous perimeter angles and bent plates perpendicular to and connected to the top chords of joists, provide a minimum 3" of 1/4" weld at each joist. Continuous angle and bent plate
- closures may be shop-applied to the supporting structural members only when requested and approved by Structural Engineer of Record. 16. Where steel beams are called to have wood nailers supporting wood floor or roof framing, provide 1/2" diameter carriage bolts spaced at 24" on center and staggered each side of the beam web, unless noted otherwise. Carriage bolts may be over-tightened to compress the rounded head in the nailer to
- facilitate installation of continuous band/rim joists, rafters, trusses, etc. 17. A qualified independent Testing Agency shall be retained to perform inspection and testing of structural steel field weldaments as follows:

WE	ELD IN	ISPE(	CTION	N SCH	IEDUI	LE
WELD TYPE	VT	MT	UT	PT	CRT	COMMENTS
FILLET (SINGLE PASS)	\		-	-	-	ROOT PASS AND FINISHED WELD
FILLET (MULTIPLE PASS)	50%	25%	-	-	-	
FLARE BEVEL/ FLARE V	25%	-	-	-	-	
GROOVE (PARTIAL PENETRATION)	100%	-	100%	-	-	REFERENCE NOTE 'E' BELOW
GROOVE (FULL PENETRATION)	100%	-	100%	-	-	ALL FULL PENE- TRATION WELDS

- A) Test procedures:
- VT = Visual Test (inspection)
- MT = Magnetic Particle Test: ASTM E109, cracks or incomplete fusion or penetration not acceptable. UT = Ultrasonic Test: ASTM E164.
- PT = Penetrant Test: ASTM E165.
- RT = Radiographic Test: ASTM E94 and ASTM E142, min. quality level 2-21.
- B) Acceptance standards in AWS D1.1 shall be followed for each test procedure C) Test procedures may be substituted to meet feasibility requirements of test based upon weld geometry
- or other factors with the approval of the Structural Engineer of Record.
- D) Samples shall occur at random locations; additional tests may be required at locations noted on the
- E) Groove welds include square, bevel, V, U, and J grooves including single and double pass types. F) Partial penetration square groove welds at end seal plates of tubular members do not require inspection. G) Weld Procedure Specifications (WPS) shall be produced and maintained in accordance with AWS D1.1.

The independent Testing Agency shall have access to all WPS's during the course of testing and

- H) For highly-restrained welded joints, especially in thick plates and/or heavy structural shapes, details the welds so that shrinkage occurs as much as possible in the direction the steel was rolled. Refer to the AISC Manual for preferred welded-joint arrangements that reduce the possibility for lamellar tearing. Members scheduled to receive highly-restrained connections shall be tested by the independent
- Testing Agency by Ultrasonic Testing prior to commencing welding. I) In addition to inspection requirements for fillet welds in Table above, 100% of field welding of diagonal bracing members to gusset plates shall be visually inspected (VT).

### **FOUNDATIONS**


- 1. Proofroll slab on grade areas with a medium-weight roller or other suitable equipment to check for pockets of soft material hidden beneath a thin crust of better soil. Any unsuitable materials thus exposed should be removed and replaced with compacted, engineered fill as outlined in the
- specifications. Proofrolling operations shall be monitored by the Geotechnical Testing Agency. 2. All engineered fill beneath slabs and over footings should be compacted to a dry density of at least 93% of the Modified Proctor maximum dry density (ASTM D-1557). All fill which shall be stressed by foundation loads shall be approved granular materials compacted to a dry density of at least 95% (ASTM D-1557).
- Coordinate all fill and compaction operations with the Specifications and the Subsurface Investigation. 3. Compaction shall be accomplished by placing fill in approximate 8" lifts and mechanically compacting each lift to at least the specified minimum dry density. For large areas of fill, field density tests shall be performed for each 3,000 square feet of building area for each lift as necessary to insure adequate compaction is being achieved.
- 4. Column footings and wall footings to bear on firm natural soils or well-compacted engineered fill with allowable bearing pressures of 2,000 PSF and 1,600 PSF for column and wall footings respectively, as outlined in the Subsurface Investigation Report
- It is essential that the foundations be inspected to insure that all loose, soft, or otherwise undesirable material (such as organics, existing uncontrolled fill, etc.) is removed and that the foundations will bear on satisfactory material. The Geotechnical Testing Agency shall inspect the subgrade and perform any necessary tests to insure that the actual bearing capacities meet or exceed the design capacities. The Geotechnical Testing Agency shall verify the bearing capacity at each spread column footing and every 10 feet on center for strip footings prior to placement of concrete.
- 5. Place footings the same day the excavation is performed. If this is not possible, the footings shall be adequately protected against any detrimental change in condition, such as from disturbance, rain, or
- 6. It is the responsibility of the Contractor and each Sub-Contractor to verify the location of all utilities and
- services shown, or not shown; and establish safe working conditions before commencing work. 7. The Contractor shall layout the entire building and field verify all dimensions prior to excavation.

### POST-INSTALLED DOWELS & ANCHOR BOLTS/RODS

- All reinforcing steel and threaded rod anchors to be installed in a 2-part chemical anchoring system shall be treated as follows:
- A. Drill holes larger than bar or rod to be embedded. Coordinate hole diameter with Manufacturer's recommendations.
- B. Holes must be cleaned and prepared in accordance with Manufacturer's recommendations. C. When reinforcing steel is encountered during drilling for installation of anchors; stop drilling, use a
- sensor to locate the reinforcing in the surrounding area and install anchor(s) as close as possible to the original location. Contact the Structural Engineer of Record (SER) for direction when the revised location is more than 2" from the original location, or when the original function of the anchorage is significantly altered. When in doubt, contact the SER for direction.
- D. Drill the hole a minimum of 15 bar diameters or as shown on the plans.
- E. Use a 2-part adhesive anchoring system, Hilti HY-200, or approved equal. F. For anchorage into hollow substrate, use Hilti HY-270, or approved equal.
- G. Reinforcing steel dowels shall be ASTM A615, Grade 60, unless noted.
- H. Anchor rods shall be Hilti HAS-V-36, unless noted. Provide finish as noted on the Drawings. If not noted, provide hot-dip galvanized finish for interior applications. Provide stainless steel finish for all exterior applications, unless noted. 2. When column anchor bolts have been omitted, or damaged by construction operations, the Contractor
- must obtain the written approval of the Structural Engineer of Record prior to repair or replacement. A. As a precaution, the affected column must be guyed and braced after repair for the balance of the erection period.
- B. As an alternate to guying and bracing, the Contractor may at his option, employ a testing agency to perform a tensile pull test to confirm the strength for the repaired or replaced anchor bolt. The tensile proof load must exceed 1.33 x the design load of the original anchor without causing distress of the anchor bolt or the surrounding concrete. Reference the following table for the minimum proof loads: 3/4" diameter: 12.8 kips
- 7/8" diameter: 17.4 kips 1" diameter: 22.7 kips
- 1 1/8" diameter: 28.8 kips 1 1/4" diameter: 35.6 kips
- Note: Values listed above are for ASTM F-1554, Grade 36 material. When higher grade or strength materials are specified, refer to the AISC Steel Design Guide 1, Table 3.1 for minimum allowable loads to be multiplied by 1.33.
- C. When affected anchor bolts are part of a fixed moment resisting column base, such as those in moment-resisting space frames, canopies, or fixed-base installations, the repaired anchor bolts
- must be proof-loaded, or the affected column footing and/or pier replaced in its entirety. D. When affected anchor bolts are part of a braced frame the affected column footing and/or pier must be replaced in its entirety.
- E. Prior to erection, the controlling Contractor must provide written notification to the Steel Erector if there has been a repair, replacement or modification of the anchor bolts for that column.

### LINTEL SCHEDULE

Where lintels are not specifically shown or noted on the Structural or Architectural Drawings, provide the following lintels over all openings and recesses in both interior and exterior non-load-bearing walls. A) Brick: Masonry Opening Up to 5'-0" L5x5x5/16 Over 5'-0" & up to 7'-0" L5x5x3/8

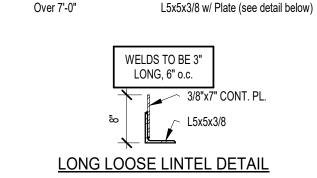

All angles are LLV (long leg vertical), unless noted otherwise. Provide 1" of bearing per foot of span each end with minimum 8". All lintels in exterior walls are to be hot-dip galvanized.

- B) Block: For openings up to 8'-0" long exposed in the finished room, use lintel block filled with grout.
- Grout all exposed joints and reinforce as follows: 1) For 6" thick block: 1 - #5 bar
- 2) For 8" thick block: 2 #5 bars 3) For 10" thick block: 2 - #6 bars

8" bearing on each end.

- 4) For 12" thick block: 2 #6 bars
- C) Block: For openings over 8'-0" & up to 12'-0" long exposed in the finished room, use lintel block filled with grout. Grout all exposed joints and reinforce per the "Long Masonry Lintel Detail" on the Typical
- Masonry Detail Drawing. D) Block (stack bond openings over 4'-0"): See framing plans for steel beam lintels. Where not shown on plan, the criteria in the following table shall be used. Contact Structural Engineer of Record for lintels not
- shown on plan which do not meet this criteria. See architectural drawings for opening quantities, sizes, locations, heights of wall above, etc. WIDTH OF MAX. ALLOW. HEIGHT OPENING OF CMU ABOVE LINTEL ≤ 8'-0" 30'-0" C8x11.5 w/ CONTIN. 8'-0" ≤ 8'-0" W8x13 w/ CONTIN. PL 3/8 x7 ≤ 12'-0" 8'-0"

≤ 8'-0"

≤ 12'-0"

- 40'-0" ≤ 8'-0" W8x28 w/ CONTIN. PL 3/8 x11 ≤ 12'-0" For all new openings in existing load bearing masonry walls not shown in the Structural drawings
- (i.e. for HVAC, Plumbing, etc.).: A. Openings ≥ 8" BUT < 6'-0", use W8x18 lintels w/ 3/8" bottom plates. B. Openings > 6'-0" BUT ≤ 12'-0", use W8x28 lintels w/ 3/8" bottom plates.

W8x13 w/ CONTIN.

PL 3/8 x 9

C. Openings > 12'-0" use W16x40 lintels w/ 3/8" bottom plates. Field verify all existing wall widths. New bottom plate width = (exist. wall width) - 1". All lintels to have min.

## CONCRETE REINFORCING

Reinforcement, other than cold drawn wire for spirals and welded wire fabric, shall have deformed surfaces in accordance with ASTM A305. Reinforcing steel shall conform to ASTM A615, Grade 60, unless noted.

TO BE EMPLOYED, WITHOUT SEGREGATION AND EXCESSIVE BLEEDING.

ADJUSTMENTS TO THE APPROVED MIX DESIGNS MAY BE REQUESTED BY THE

CONTRACTOR WHEN JOB CONDITIONS, WEATHER, TEST RESULTS, OR OTHER

- Welded wire fabric shall conform to ASTM A1064, unless noted. . Where hooks are indicated, provide standard hooks per ACI and CRSI for all bars unless other
- hook dimensions are shown on the plans or details. 5. Reinforcement in footings, walls and beams shall be continuous. Lap bars a minimum of 40 diameters, unless noted otherwise.

**CAST IN PLACE CONCRETE** 

placement of reinforcement not otherwise covered by the Plans and Specifications, shall comply with

1. Details of fabrication of reinforcement, handling and placing of the concrete, construction of forms and

2. Cold weather concreting shall be in accordance with ACI 306. Cold weather is defined as a period

3. Hot weather concreting shall be in accordance with ACI 305. Hot weather is defined as any

below 50F. The Contractor shall maintain a copy of this publication on site.

solar radiation The Contractor shall maintain a copy of this publication on site.

4. A certified Testing Agency shall be retained to perform industry standard testing including

Sample Finishes: See Specifications for sample and mockup requirements, if any.

Division 3 Cast In Place Concrete Specification of the Project Manual.

when for more than 3 successive days the average daily air temperature drops below 40F and stays

combination of the following conditions that tends to impair the quality of the freshly mixed or hardened

concrete: high ambient temperature, high concrete temperature, low relative humidity, wind speed, or

measurement of slump, air temperature, concrete cylinder testing, etc. to ensure conformance with the

final finish as indicated below, and as described in the Division 3 Cast In Place Concrete Specification

Hard Trowel Finish

Rough Swirl Finish

Broom Finish

Float Finish

Float Finish

Floor Tolerances: See the Specifications for specified Ff and FI tolerances. Ff and FI testing shall be

performed by the Testing Agency in accordance with ASTM E-1155. Results, including acceptance or

rejection of the work will be provided to the Contractor and the Architect/Engineer within 48 hours after

straight edge may be used in lieu of Ff and Fl testing. Approval must be obtained in writing prior to the

Rough Form Finish

Rough Form Finish

Rough Form Finish

Smooth Form Finish

data collection. Remedies for out-of-tolerance work shall be in accordance with the Specifications.

When approved by the Structural Engineer of Record, measurement of the gaps beneath a 10-foot

Finishing of Formed Surfaces: Finish formed surfaces as indicated below, and as described in the

7. The Contractor shall consult with the Structural Engineer of Record before starting concrete work to

8. Sawn or tooled control/contraction joints shall be provided in all slabs on grade. For a framed structure,

9. Where vinyl composition tile, vinyl sheets goods, thin-set epoxy terrazzo, or other similar material is the

construction joints with the Finish Flooring Contractor. Submit a dimensioned plan showing joint

10. Unless specifically noted on the Plans, composite and non-composite supported slabs on metal deck,

11. Joints in slabs to receive a finished floor may remain unfilled, unless required by the finish flooring

13. Refer to the Architectural Drawings for chamfer requirements for corners of concrete. Where not

15. Sidewalks, drives, exterior retaining walls, and other site concrete are not indicated on the Structural

indicated, provide 3/4" chamfers on exposed corners of concrete, except those abutting masonry.

14. Refer to the Architectural Drawings for exact locations and dimensions of recessed slabs, ramps, stairs,

Drawings. Refer to the Site/Civil and Architectural Drawings for locations, dimensions, elevations,

CONCRETE MIX CLASSES

4000 PSI

0 - 3 PERCENT

REQUIRED

5" TO 6 1/2"

4000 PSI

517 LB/CU YD

0 - 3 PERCENT

REQUIRED

5" TO 6 1/2"

5" MAXIMUM

70% / 20% / 10%

50% / 30% / 20%

5 - 6 1/2"

0.45

thickened slabs, etc. Slope slabs to drains where shown on the Architectural and Plumbing Drawings.

and supported cast-in-place concrete slabs do not require sawn control joints.

establish a satisfactory placing schedule and to determine the location of construction joints so as to

ioints shall be located on all column lines. If the column spacing exceeds 20'-0", provide intermediate

joints. Exterior slabs, and interior slabs without column shall have joints spaced a maximum of 15'-0"

apart. Layout joints so that maximum aspect ratio (ratio of long side to short side) does not exceed 1.5.

specified finish floor material, the Contractor shall coordinate the locations of control/contraction and

contractor. All exposed slabs shall be filled with sealant specified in Division 7, or as follows: All slabs in

industrial, manufacturing, or warehouse applications subject to wheeled traffic shall be filled with specified

epoxy resin sealant, all other joints shall be filled with specified elastometric sealant. Defer filling of joints

as long as possible, preferably a minimum of 4 to 6 weeks after the slab has been cured. Prior to filling,

remove all debris from the slab joints, the fill in accordance with the manufacturer's recommendations.

12. Refer to the Architectural Drawings for locations and details of reveals (1" maximum depth) in exposed walls.

5. Finishing of Slabs: After screeding, bull floating and floating operations have been completed, apply

the ACI Code requirements of the latest revised date.

Contract Documents. Submit reports to Architect/Engineer.

of the Project Manual.

E. Driving Surfaces

B. Ramps, Stairs, & Sidewalks

beginning of concrete operations

A. Sides of Footings & Pile Caps

C. Surfaces not exposed to public view

minimize the effects of shrinkage in the floor system.

locations and proposed sequence of floor pours.

jointing, and finish details.

**FOOTINGS** 

COMPRESSIVE STRENGTH

AIR CONTENT

AIR CONTENT

SLUMP

INTERIOR CONCRETE SLABS

COMPRESSIVE STRENGTH

WATER-REDUCING ADMIXTURE

NOTE ON FOUNDATIONS PLANS

MIXES CONTAINING TYPE A WRDA

WATER REDUCING ADMIXTURES.

MIXES CONTAINING MID-RANGE WRDA

MIXES CONTAINING HIGH-RANGE WRDA

REF. ACI 306 FOR DEFINITION OF COLD WEATHER.

E CONCRETE, WHICH SHALL BE LIMITED TO 30%.

PORTLAND CEMENT/SLAG/FLY ASH RATIO:

CEMENT/SLAG/FLY ASH OF 70% / 20% / 10%.

ARCHITECT/ENGINEER FOR APPROVAL PRIOR TO USE.

CLASS E EXTERIOR CONCRETE

ALL OTHER CLASSES

SUBSTITUTION RATE ON A POUND-PER-POUND BASIS.

SUBSTITUTION RATES SHALL COMPLY WITH THE FOLLOWING:

MINIMUM CEMENTITIOUS MATERIAL CONTENT

PROVIDE ELEMENT 5 SYSTEM (INTERNAL CURE & CATALYST) PER PLAN

SPECIFIED MINIMUM CEMENTITIOUS MATERIAL CONTENTS ARE BASED ON THE USE OF

INCLUDE AN AIR-ENTRAINING ADMIXTURE FOR ALL CONCRETE EXPOSED TO FREEZING

4. CLASS C FLY ASH MAY BE USED AS A CEMENT SUBSTITUTE WITH A MAXIMUM 20%

AND THAWING IN SERVICE AND FOR ALL CONCRETE EXPOSED TO COLD WEATHER DURING

CONSTRUCTION, BEFORE ATTAINING ITS SPECIFIED DESIGN COMPRESSIVE STRENGTH.

SLAG CEMENT MAY BE USED AS A SUBSTITUTE FOR PORTLAND CEMENT WITH A MAXIMUM

50% SUBSTITUTION RATE ON A POUND-PER-POUND BASIS WITH THE EXCEPTION OF CLASS

WHEN SLAB CEMENT AND FLY ASH ARE USED IN THE SAME CONCRETE MIX, THE MAXIMUM

FOR CONCRETE TO BE CAST DURING COLD WEATHER, THE MAXIMUM SUBSTITUTION RATE

FOR SLAG CEMENT SHALL BE 30%. IF SLAG CEMENT AND FLY ASH ARE USED IN THE SAME

PROPORTION CONCRETE MIXES TO PROVIDE WORKABILITY AND CONSISTENCY TO PERMIT

AND AROUND REINFORCEMENT BY THE METHODS OF PLACEMENT AND CONSOLIDATION

CIRCUMSTANCES WARRANT. THESE REVISED MIX DESIGNS SHALL BE SUBMITTED TO THE

MIX, THE MAXIMUM SUBSTITUTION RATES SHALL COMPLY WITH A RATIO OF PORTLAND

CONCRETE TO BE WORKED READILY INTO THE CORNERS AND ANGLES OF THE FORMS

SLUMP

MAXIMUM WATER/CEMENT RATIO

WATER-REDUCING ADMIXTURE

D. Surfaces exposed to public view

B. Sides of Grade Beams

C. Surfaces to Receive Topping Slab

D. Surfaces to receive thick-set mortar

beds or similar cementitious materials

A. Floor Slabs

- 6. Reinforcement shall be supported and secured against displacement in accordance with the CRSI 'Manual of Standard Practice'. 7. Details of reinforcing steel fabrication and placement shall conform to ACI 315 'Details and Detailing of Concrete Reinforcement' and ACI 315R 'Manual of Engineering and Placing Drawings
- for Reinforced Concrete Structures', unless otherwise indicated. 8. Spread reinforcing steel around small openings and sleeves in slabs and walls, where possible, and where bar spacing will not exceed 1.5 times the normal spacing. Discontinue bars at all large openings where necessary, and provide an area of reinforcement, equal to the interrupted reinforcement, in full length bars, distributing one-half each side of the opening. Where shrinkage and temperature reinforcement is interrupted, add (2) #5 x opening dimension + 4'-0" on each side of the opening. Provide #5 x 4'-0" long diagonal bars in both faces, at each corner of openings
- larger than 12" in any direction. 9. Provide standees for the support of top reinforcement for footings, pile caps, and mats.
- 10. Provide individual high chairs with support bars, as required for the support of top reinforcement for supported slabs. Do NOT provide standees.
- 11. Provide snap-on plastic space wheels to maintain required concrete cover for vertical wall reinforcement. 12. Where walls sit on column footings, provide dowels for the wall. Dowels shall be the same size
- and spacing as the vertical wall reinforcement, unless noted otherwise, with lab splices as shown on the application sections. Install dowels in the footing forms before concrete is placed. Do NOT stick dowels into footings after concrete is placed.
- 13. Field bending of reinforcing steel is prohibited, unless noted on drawings. 14. Minimum concrete cover over reinforcing steel shall be as follows, unless noted otherwise on plan. section or note:

### **GENERAL NOTES**

- The Contractor shall be responsible for complying with all safety precautions and regulations during the work. The Structural Engineer of Record will not advise on, nor issue direction as to safety precautions and programs. The Structural Drawings herein represent the finished structure. The Contractor shall provide all temporary guving and bracing required to erect and hold the structure in proper alignment until all Structural Work and connections have been completed. The investigation, design, safety, adequacy and inspection of erection bracing, shoring, temporary supports, etc. is the sole responsibility of the Contractor.
- 3. The Structural Engineer of Record (SER) shall not be responsible for the methods, techniques and sequences are not specifically shown, similar details of construction shall be used, subject to approval of the SER.
- 4. Drawings indicate general and typical details of construction. Where conditions are not specifically shown, similar details of construction shall be used, subject to approval of the Structural Engineer of Record.
- 5. All structural systems which are to be composed of components to be field erected shall be supervised by the Supplier during manufacturing, delivery, handling, storage, and erection in accordance with the
- Supplier's instructions and requirements. 6. Loading applied to the structure during the process of construction shall not exceed the safe load-
- carrying capacity of the structural members. The live loading used in the design of this structure are indicated in the "Design Criteria Notes." Do not apply any construction loads until structural framing is
- properly connected together and until all temporary bracing is in place. 7. All ASTM and other referenced standards and codes are for the latest editions of these publications, unless otherwise noted.
- 8. Shop drawings and other items shall be submitted to the Structural Engineer of Record (SER) for review prior to fabrication. All Shop Drawings shall be reviewed by the Contractor before submittal. The SER's review is to be fore conformance with the design concept and general compliance with the relevant Contract Documents. The SER's review does not relieve the Contractor of the sole responsibility to review, check, and coordinate the Shop Drawings prior to submission. The Contractor remains solely responsible for errors and omissions associated with the preparation of Shop Drawings
- as they pertain to member sizes, details, dimensions, etc. Submit Shop Drawings in the form of blueline/blackline prints (min. 2 sets/ max. 5 sets) and one reproducible blackline or sepia copy. In no case shall reproductions of the Contract Documents be used as shop drawings. As a minimum, submit the following items for review.
- A. Structural Steel Shop Drawings. 10. Resubmitted Shop Drawings: Resubmitted shop drawings are reviewed only for responses to comments made in the previous submittal.
- 11. When calculations are included in the submittals for components of work designed and certified by a Specialty Structural Engineer (SSE), the review by the Structural Engineer of Record (SER) shall be for conformance with the relevant Contract Documents. The SER's review does not relieve the SSE from responsibility for the design of the system(s) and the coordination with the elements of the structure under the certification of the SER, or other SSE's. The SER's review does not constitute a warranty of
- the accuracy or completeness of the SSE's design. 12. Contractors shall visit the site prior to bid to ascertain conditions which may adversely affect the work
- or cost thereof. 13. No structural member may be cut, notched, or otherwise reduced in strength without written direction
- from the Structural Engineer of Record. 14. When modifications are proposed to structural elements under the design and certification of a Specialty Structural Engineer (SSE), written authorization by the SSE must be obtained and submitted to the Structural Engineer of Record for review, prior to performing the proposed modification.

### **EXISTING CONSTRUCTION**

- 1. The contractor shall field verify the dimensions, elevations, etc. necessary for the proper construction and alignment of the new portions of the work to the existing work. The Contractor shall make all necessary measurements for fabrication and erection of the structural members. Any discrepancy
- shall be immediately brought to the attention of the Structural Engineer of Record. Before proceeding with any work within the existing facility, the Contractor shall familiarize himself with existing structural and other conditions. Any shoring shown or noted on the Plans is a partial and schematic representation of that required. It shall be the Contractor's responsibility to provide all necessary bracing, shoring, and other safeguards to maintain all parts of the work in a safe condition during the progress of demolition and construction, and to protect from damage those portions of the existing work
- which are to remain. Shoring shall remain in place until the structural work is complete, has been inspected by the Testing Agency, and is certified to be in substantial compliance with the Contract Documents. When required by the Specifications or by Plan Note, the Contractor shall submit for the Structural Engineer of Record's review, a "Proposed Shoring Plan," including, but not limited to: plans, sections, details, notes, description of proposed sequence of work, and calculations prepared by, or under the supervision of a Specialty Structural Engineer (SSE). The SSE shall be registered in the State where the project is located.
- 4. Welding to and within an existing facility presents potential hazards including: A. Fire Hazard - Due to the existing construction and building contents. B. Structural Liquefaction - Due to welding across the full section of the structural members.
- Recommendations to prevent these hazards include: A. Fire Hazard - Protect existing combustibles prior to welding. Keep a separate watchman and
- B. Structural Liquefaction weld in small increments. Allow welds to harden before continuing to the
- next increment. C. Do not leave the site until satisfied that no fire hazard exists. D. Preference should be given to the use of beam clamps, mechanical fasteners, or bolted
- connections in lieu of welding within existing facilities, whenever possible. Do not field-drill existing structural members without the written permission of the Structural Engineer of Record.
- **COORDINATION WITH OTHER TRADES** 1. The Contractor shall coordinate and check all dimensions relating to Architectural finishes, mechanical equipment and openings, elevator shafts and overrides, etc. and notify the Architect/Engineer of any
- 2. The Structural Drawings shall be used in conjunction with the Drawings of all other disciplines and the Specifications. The Contractor shall verify the requirements of other trades as to sleeves, chases, hangers, inserts, anchors, holes, and other items to be placed or set in the Structural Work.

discrepancies before proceeding with any work in the area under question.

- 3. There shall be no vertical or horizontal sleeves set, or holes cut or drilled in any beam or column unless it is shown on the Structural Drawings or approved in writing by the Structural Engineer of Record. 4. Mechanical and electrical openings through supported slabs and walls, 8" diameter or larger, not shown on the Structural Drawings must be approved by the Structural Engineer of Record (SER). Openings less
- than 8" in diameter shall have at least 1'-0" clear between openings, unless approved in writing by the SER. Verify locations and dimensions of mechanical and electrical openings through supported slabs and walls shown on the Structural Drawings with the Mechanical and Electrical Contractors. Do not install conduit in supported slabs, slabs on grade, or concrete walls unless explicitly shown or
- noted on the Structural Drawings. roof deck or wood roof sheathing.
- . Do not suspend any items, such as ductwork, mechanical or electrical fixtures, ceilings, etc. from steel 8. The Mechanical Contractor shall verify that mechanical units supported by the steel framing are capable of spanning the distance between the supporting members indicated on the Structural

Drawings. The Mechanical Contractor shall supply additional support framing as required.

9. If drawings and specifications are in conflict, the most stringent restrictions and requirements shall govern.

- SPECIALTY STRUCTURAL ENGINEERING (SSE) 1. A Specialty Structural Engineer is defined as a Professional Engineer licensed in the State of Indiana, not the Structural Engineer of Record, who performs Structural Engineering functions necessary for the structure to be completed and who has shown experience and/or training in the specific speciality.
- 2. It is the Specialty Structural Engineer's responsibility to review the Construction Drawings and Specifications to determine the appropriate scope of engineering. 3. It is the intent of the Drawings and Specifications to provide sufficient information for the Specialty Structural Engineer (SSE) to perform his design and analysis. If the SSE determines there are details, features, or unanticipated project limits which conflict with the engineering requirements as described in
- the project documents, the SSE shall in a timely manner, contact the Structural Engineer of Record for 4. The Specialty Structural Engineer (SSE) shall forward documents to the Structural Engineer of Record for review. Such documents shall bear the stamp of the SSE and include: A) Drawings introducing engineering input, such as defining the configuration or structural capacity of

structural components and/or their assembly into structural systems.

B) Calculations.

TOP OF FOOTINGS

OVER TOP OF PILES

C) Computer printouts which are an acceptable substitute for manual calculations provided they are accompanied by sufficient design assumptions and identified input and output information to permit their proper evaluation. Such information shall bear the stamp of the Specialty Engineer as an indication that said engineer has accepted responsibility for the results. Contractors are referred to the specific technical specification sections and the structural drawings for

those elements requiring Specialty Structural Engineering. Examples of components requiring

A) Structural Steel Connections. When modifications are proposed to elements under the design and certification of the Specialty Structural Engineer (SSE), written authorization by the SSE must be obtained and submitted to the Engineer of Record for review, prior to performing the proposed modification.

Specialty Structural Engineering include, but are not limited to the following:

### MINIMUM COVER FOR REINFORCEMENT **FOOTINGS & BASE SLABS** AT FORMED SURFACES & BOTTOMS BEARING ON CONCRETE WORK MAT AT UNFORMED SURFACES & BOTTOMS IN CONTACT WITH EARTH

SAME AS SLABS

2"



**GIBRALTAR** DESIGN

ARCHITECTURE • ENGINEERING • INTERIOR DESIGN

**PROJECT** 

# **JACKSON ELEMENTARY SCHOOL** -**RENOVATIONS**

DUNELAND SCHOOL CORPORATION CHESTERTON, INDIANA

GIBRALTAR DESIGN 9102 N. Meridian St., Ste. 300 Indianapolis, IN 46260 Homepage www.GibraltarDesign.com Email info@GibraltarDesign.com

PROJECT

21-143

**CHECKED BY** 

**REVISIONS** 

DATE

Phone 317.580.5777 Fax 317.580.5778 10/31/22 COORDINATED BY DRAWN BY

THE CONCEPTS, DESIGNS, PLANS, DETAILS, ETC, SHOWN ON THIS DOCUMENT ARE THE PROPERTY OF GIBRALTAR DESIGN AND WERE CREATED FOR USE ON THIS SPECIFIC PROJECT. NONE OF THIS INFORMATION SHALL BE USED BY ANY PERSON OR FIRM FOR ANY PURPOSE WITHOUT THE EXPRESS WRITTEN CONSENT OF GIBRALTAR DESIGN. THE OWNER MAY RETAIN COPIES FOR


INFORMATION AND REFERENCE IN CONNECTION ONLY WITH THIS

MARK DATE ISSUED FOR AD-1 11.09.2022 ADDENDUM #1

STRUCTURAL NOTES

**PROJECT JACKSON ES - RENOVATIONS** 

© GIBRALTAR DESIGN SHEET

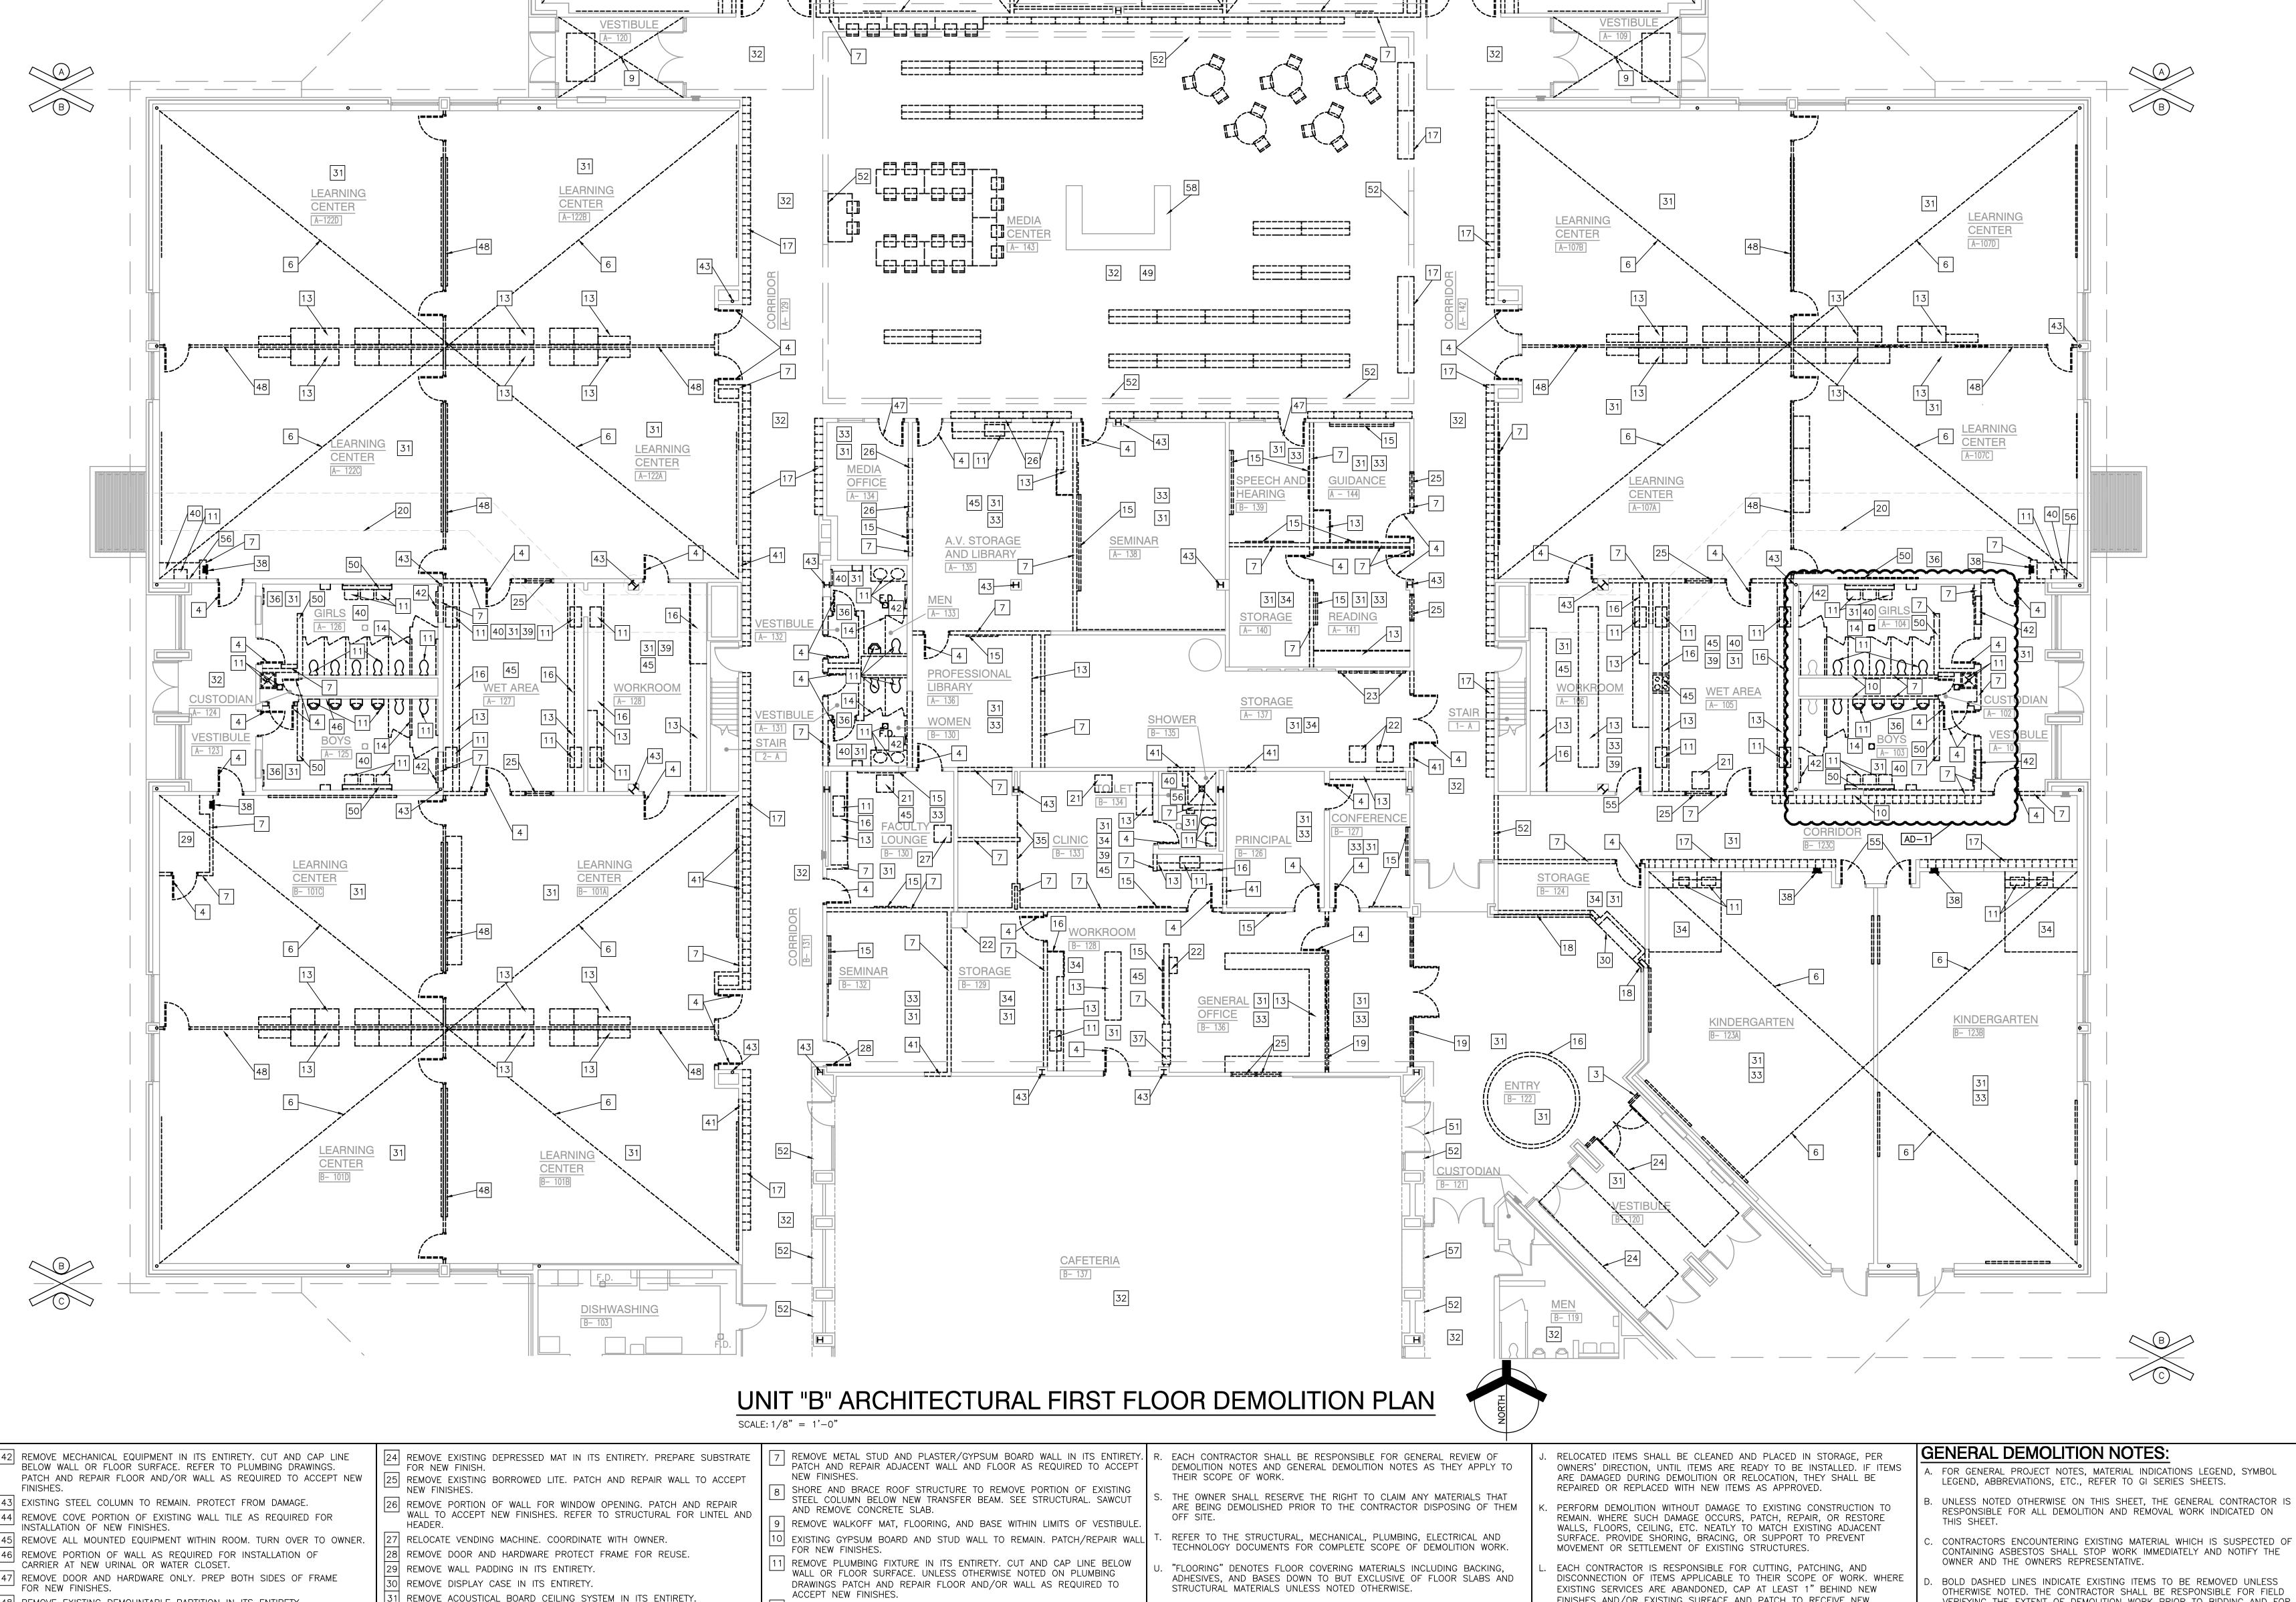

ES LA

- 48 REMOVE EXISTING DEMOUNTABLE PARTITION IN ITS ENTIRETY INCLUDING BUT NOT LIMITED TO WALL PANELS, DOORS, FRAME, AND BORROWED LITES.
- 49 TEMPORARILY REMOVE, STORE AND RELOCATE EXISTING CASEWORK/MILLWORK/SHELVING. PATCH AND PREP FOR NEW
- O REMOVE PARTIAL HEIGHT WALL INCLUDING BUT NOT LIMITED TO TILE, MARBLE COUNTERTOP GYPSUM BOARD/PLASTER, AND METAL STUDS.
- REMOVE CARD READER FROM EXISTING DOOR. PREP FOR NEW HARDWARE. 52 EXISTING BULKHEAD TO REMAIN. PROTECT FROM DAMAGE.
- 3 EXISTING SUP PIT. PROTECT FROM DAMAGE. 54 EXISTING CEILING MOUNTED MECHANICAL EQUIPMENT TO REMAIN. PROTECT FROM DAMAGES.
- 5 REMOVE HOLLOW METAL DOOR AND HARDWARE, FRAME TO REMAIN. 56 REMOVE WALL TILE IN ITS ENTIRETY. PREPARE FOR NEW FINISHES. REMOVE EXISTING CONCRETE PAD FOR CHILLER. ADJUST EXISTING GRADES TO PROVIDE POSITIVE DRAINAGE AWAY FROM LOCATION OF PAD AND BUILDING WITHOUT ANY AREAS OF PONDING. PREPARE
- SUB-GRADE FOR NEW CONCRETE PAD. 58 PROTECT EXISTING MILLWORK TO REMAIN.

- 1 REMOVE ACOUSTICAL BOARD CEILING SYSTEM IN ITS ENTIRETY. TEMPORARILY REMOVE, STORE AND REPLACE CEILING PADS, AND GRID AS REQUIRED FOR MECHANICAL, ELECTRICAL, PLUMBING OR FIRE PROTECTION WORK. REPLACE ALL TILES DAMAGED DURING REMOVAL
- AND REINSTALLATION. 3 REMOVE CARPET FLOORING SYSTEM IN ITS ENTIRETY. PREPARE FLOOR FOR NEW FINISHES.
- A REMOVE VCT/SHEET VINYL FLOORING SYSTEM IN ITS ENTIRETY. PREPARE T REMOVEFORMANN FRASKESND SUPPORT IN ITS ENTIRETY.
- REMOVE TOILET ACCESSORIES AND TURN OVER TO THE OWNER. REMOVE STAFF MAILBOX IN ITS ENTIRETY. REMOVE FIRE EXTINGUISHER AND CABINET AND TURN OVER TO OWNER. PATCH WALL AS REQUIRED FOR NEW AND EXISTING TO BE SMOOTH AND FLUSH WITH NO VISIBLE JOINTS.
- REMOVE WALL COVERING IN ITS ENTIRETY. PREPARE WALL FOR NEW FINISHES. 40 REMOVE CERAMIC TILE FLOORING SYSTEM IN ITS ENTIRETY. PREPARE FLOOR
- ─ FOR NEW FINISHES. [41] REMOVE PORTION OF METAL STUD AND GYPSUM BOARD/PLASTER WALL AS REQUIRED TO INSTALL NEW DOOR.
- SAWCUT AND REMOVE CONCRETE SLAB FOR NEW PLUMBING FIXTURES.
- REFER TO PLUMBING DRAWINGS. 3| REMOVE CASEWORK IN ITS ENTIRETY. PATCH AND REPAIR WALL AND FLOOR $\parallel$ TO ACCEPT NEW FINISHES.
- 14 REMOVE TOILET PARTITIONS IN THEIR ENTIRETY. REMOVE TACK BOARD, MARKER, OR CHALKBOARD IN THEIR ENTIRETY PATCH WALL AS REQUIRED TO RECEIVE NEW FINISHES.
- 6 REMOVE BULKHEAD IN ITS ENTIRETY. REMOVE WOOD CUBBIES IN ITS ENTIRETY. PREPARE WALL FOR NEW
- 8 REMOVE MASONRY WALL (FOR NEW CONSTRUCTION.) PATCH AND REPAIR floor and wall as required to accept new finishes. REMOVE ALUMINUM STOREFRONT IN ITS ENTIRETY. PATCH ADJACENT WALLS DAMAGED DURING REMOVAL WITH NEW GYPSUM BOARD.
- UNDER FLOOR SLAB. REMOVE REFRIGERATOR TURN OVER TO OWNER. REMOVE TECHNOLOGY EQUIPMENT. REFER TO TECHNOLOGY DRAWINGS. 3 REMOVE ELECTRICAL PANELS. REFER TO ELECTRICAL DRAWINGS.

20 APPROXIMATE LOCATION OF ABANDONED 48" DIAMETER CONCRETE PIPE

TO SPECIFICATIONS AND DRAWINGS FOR REQUIREMENTS AND SPECIAL CONDITIONS. W. WHERE APPLICABLE SALVAGE EXISTING MASONRY (FACE BRICK, GLAZED CMU, FACING TILE) FOR PATCHING AND INFILL IN RENOVATED AREAS WHERE

DEMOLITION IS TO FOLLOW ESTABLISHED CONSTRUCTION SEQUENCE. REFER

## DEMOLITION PLAN NOTES:

STRUCTURAL FOR LINTEL.

(ALL PLAN NOTES MAY NOT BE INDICATED ON THIS SHEET.) REMOVE MASONRY AND STUD WALL FOR NEW WINDOW. REFER TO

INDICATED. DISCARD UNUSED PORTION OFF SITE.

- REMOVE INSULATED GLAZING FROM EXISTING ALUMINUM FRAMES. FRAMES REMOVE ALUMINUM DOOR AND FRAME IN ITS ENTIRETY. BEING CAREFUL
- NOT TO HARM EXISTING BRICK MASONRY WALL. 4 REMOVE DOOR AND FRAME IN ITS ENTIRETY. SAWCUT AND REMOVE CONCRETE FLOOR FOR NEW STEEL COLUMNS AND
- ' FOUNDATIONS. REFER TO STRUCTURAL. 6 WITHIN LIMITS SHOWN REMOVE MARKER BOARDS, TACK BOARDS, CASEWORK flooring.
- FINISHES AND/OR EXISTING SURFACE AND PATCH TO RECEIVE NEW FINISHES OR MATCH EXISTING FINISH. M. ON WALLS THAT ARE TO RECEIVE NEW FINISHES, REMOVE AND REINSTALL
- EXISTING EQUIPMENT TO REMAIN FOR INSTALLATION OF NEW FINISHES. . WHERE WALLS OR BULKHEADS ARE REMOVED, PATCH FLOORS, CEILINGS, AND ADJACENT WALLS TO MATCH EXISTING OR RECEIVE NEW FINISHES
- WHERE APPLICABLE. WHERE EXISTING DUCTWORK, PIPING, OR EQUIPMENT REMOVED, PATCH OPENINGS AND/OR SURFACES AS REQUIRED TO MATCH ADJACENT SURFACES OR RECEIVÉ NEW FINISHES WHERE APPLICABLE. REFER TO ALL DEMOLITION DRAWINGS FOR EXTENT OF ITEMS TO REMOVED. OVER CUT NEW OPENINGS IN EXISTING WALL FOR NEW CONSTRUCTION. PATCH AND REPAIR WALLS TO MATCH EXISTING. WHERE APPLICABLE, TOOTH
- NEW MASONRY INTO EXISTING MASONRY. THE OWNER, PRIOR TO DEMOLITION WILL REMOVE ALL EQUIPMENT AND FURNITURE WHICH ARE CONSIDERED LOOSE FURNISHING.
- MASONRY WALLS TO BE REMOVED SHALL BE REMOVED TO A POINT 2" MINIMUM BELOW THE EXISTING FLOOR SLAB UNLESS SETTING ON A SLAB OR SPECIFICALLY NOTED OTHERWISE. PATCH WITH NEW CONCRETE TO BE FLUSH WITH THE EXISTING FLOOR SLAB.
- VERIFYING THE EXTENT OF DEMOLITION WORK PRIOR TO BIDDING AND FOR COORDINATING THE EXTENT OF DEMOLITION WITH THE INSTALLATION OF NEW
- EACH CONTRACTOR SHALL BE RESPONSIBLE FOR ALL DEMOLITION APPLICABLE TO THEIR SCOPE OF WORK AND AS REQUIRED FOR INSTALLATION OF NEW WORK WHETHER OR NOT IT IS SPECIFICALLY
- INDICATED OR NOTED IN THESE DOCUMENTS. REMOVE ALL ITEMS AND FINISHES MADE OBSOLETE BY NEW CONSTRUCTION VERIFY ITEMS DEEMED OBSOLETE WITH ARCHITECT PRIOR TO REMOVAL. REFER TO NEW CONSTRUCTION DRAWINGS FOR DEMOLITION REQUIRED NOT
- SHOWN ON DEMOLITION PLANS. EACH CONTRACTOR SHALL BE RESPONSIBLE FOR OFF SITE REMOVAL OF ALL DEMOLITION MATERIALS AND/OR ITEMS UNLESS NOTED OTHERWISE OR DIRECTED BY THE OWNER.
- CONSTRUCT DUST CONTROL BARRIERS PRIOR TO STARTING DEMOLITION TO PREVENT THE SPREAD OF DUST INTO SURROUNDING AREAS (WHERE APPLICABLE).
- WHERE BUILDING EGRESS IS REQUIRED TO PASS THROUGH DEMOLITION AREAS, PROVIDE APPROVED BARRIERS, ETC. TO ENSURE SAFETY OF THE




DESIGN ARCHITECTURE • ENGINEERING • INTERIOR DESIGN

PROJECT

**JACKSON** ELEMENTARY SCHOOL -RENOVATIONS

**DUNELAND SCHOOL CORPORATION** CHESTERTON, INDIANA

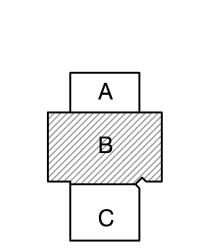

GIBRALTAR DESIGN 1102 N. Meridian St., Ste. 300

ndianapolis, IN 46260

COORDINATED E

Homepage www.GibraltarDesign.com Email info@GibraltarDesign.com Phone 317.580.5777 Fax 317.580.5778

DRAWN BY MMM CHECKED B

NFORMATION AND REFERENCE IN CONNECTION ONLY WITH THE ROJECT


MARK DATE ISSUED FOR AD-1 | 11/09/22 | ADDENDUM NO. 1


UNIT "B" ARCHITECTURAL FIRST FLOOR DEMOLITION

JACKSON ES - RENOVATIONS

GIBRALTAR DESIGN SHEET

AD102 В

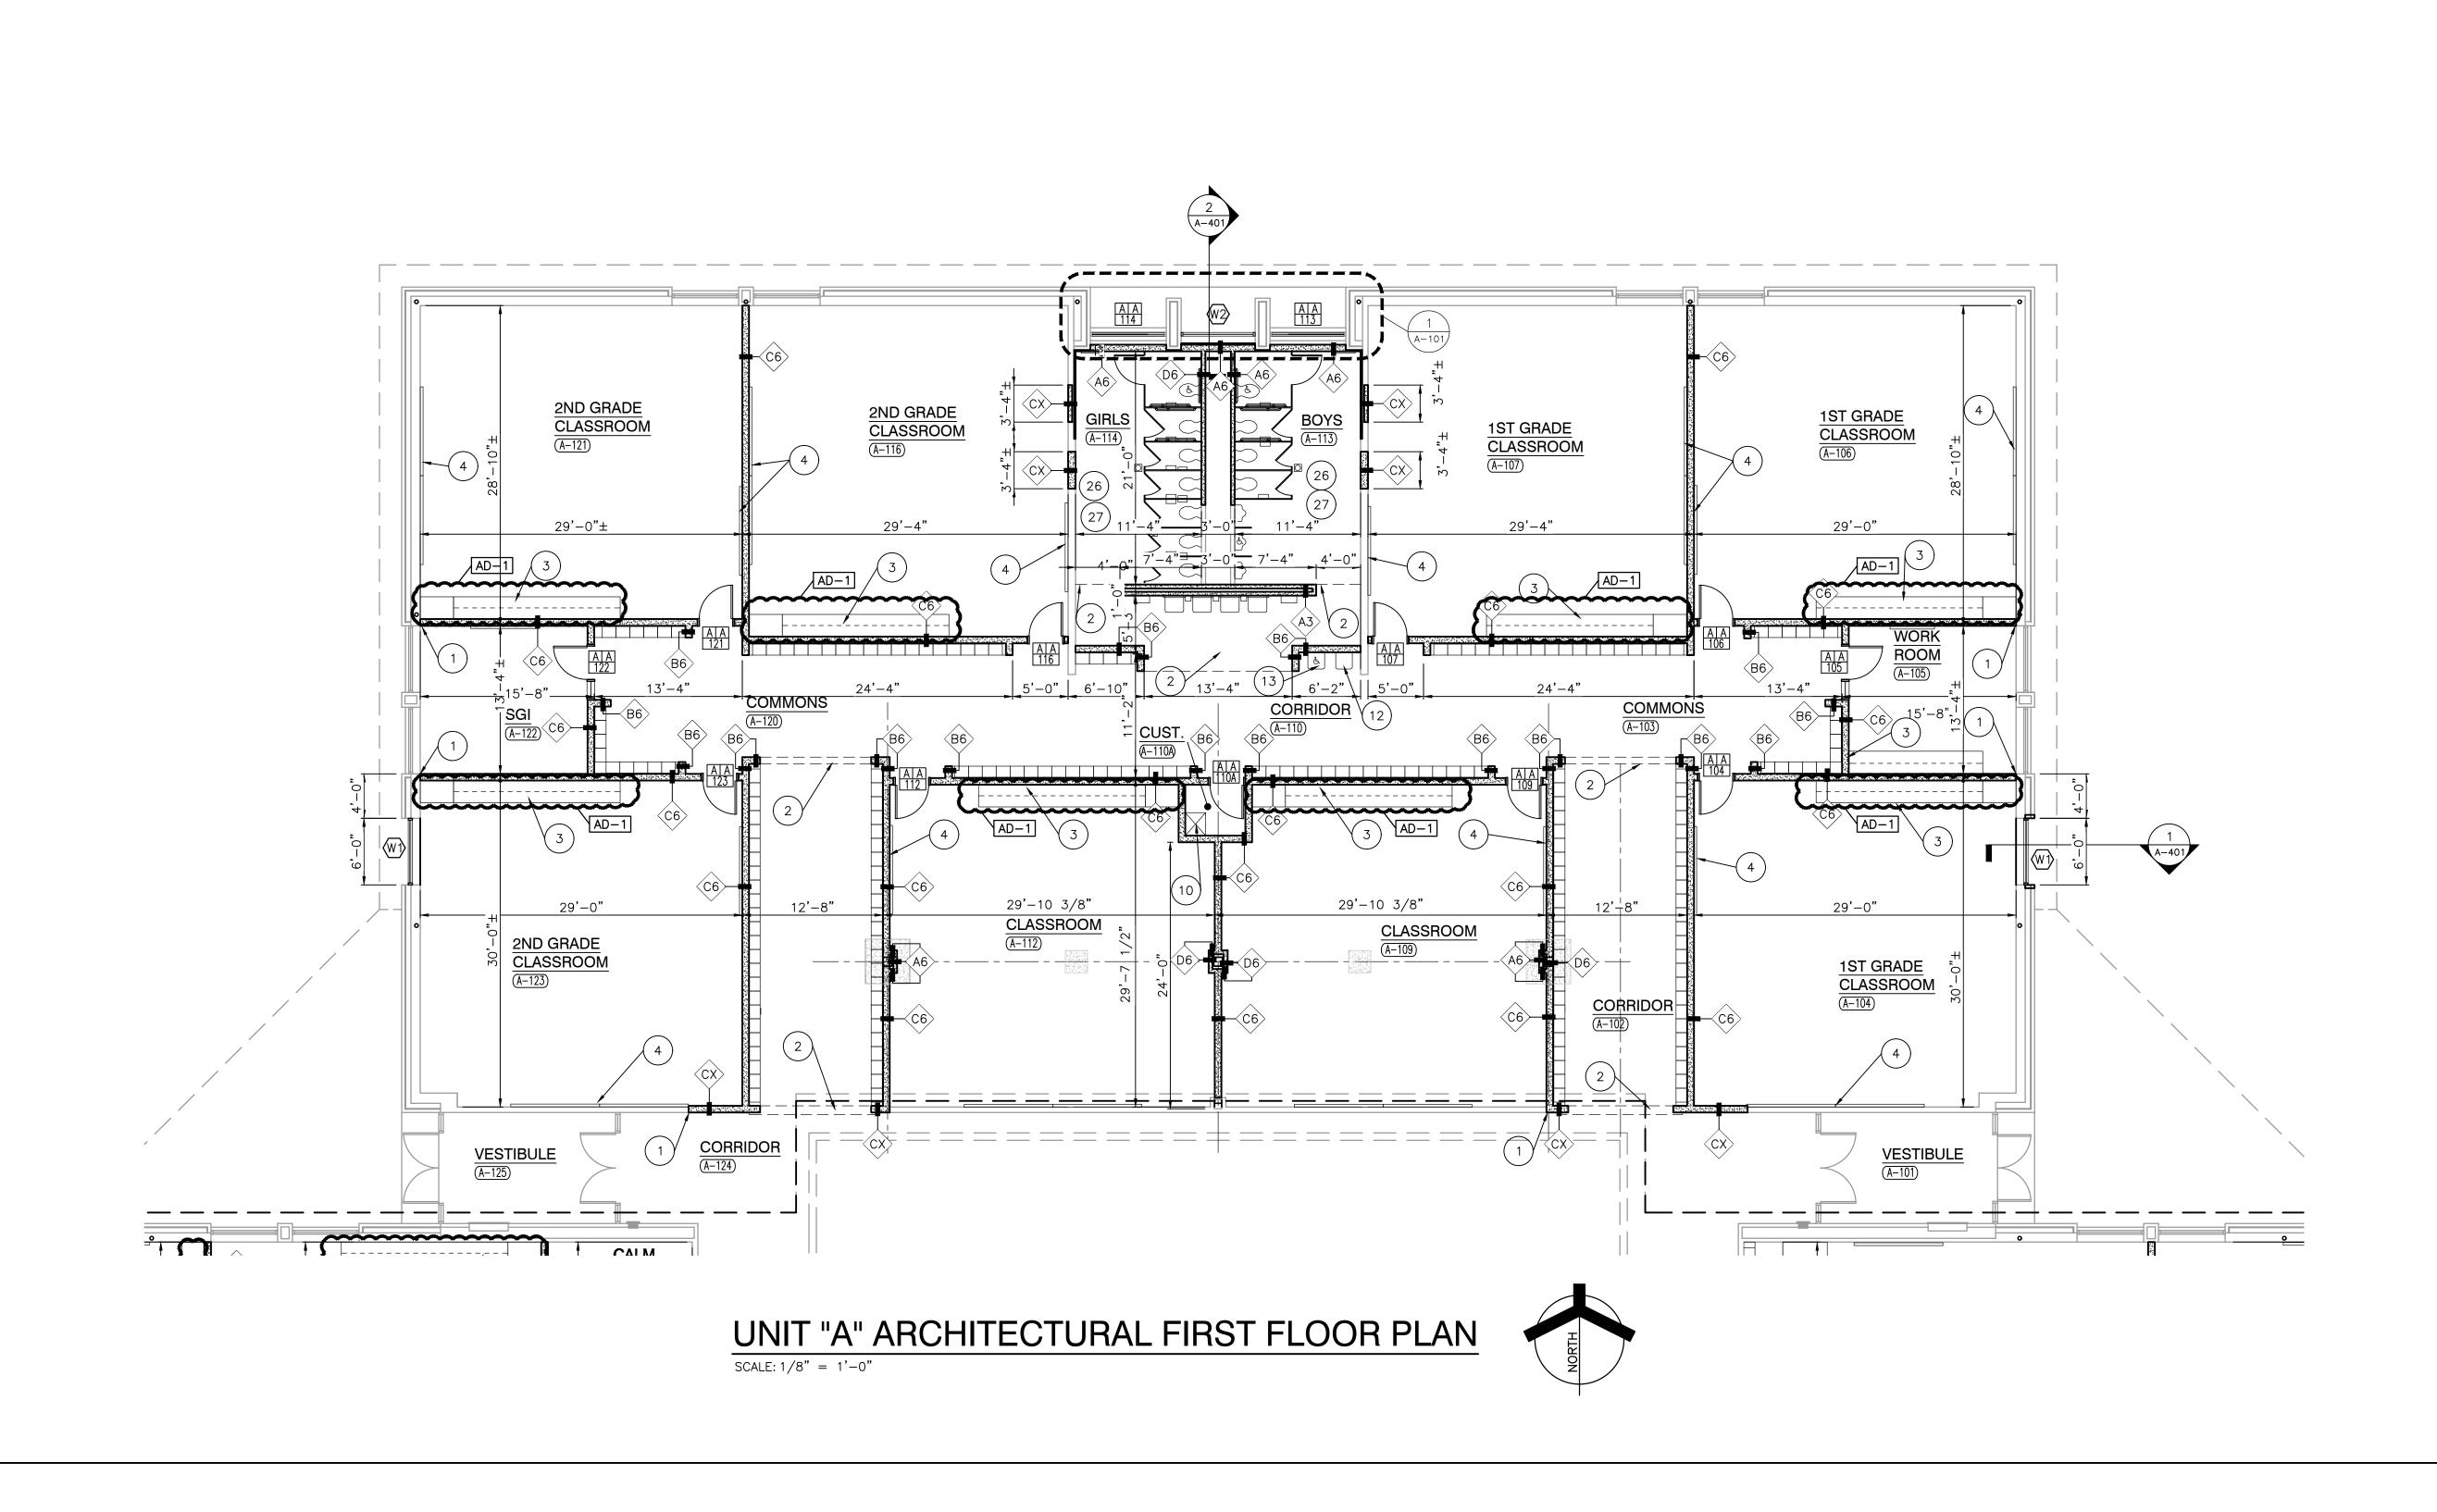

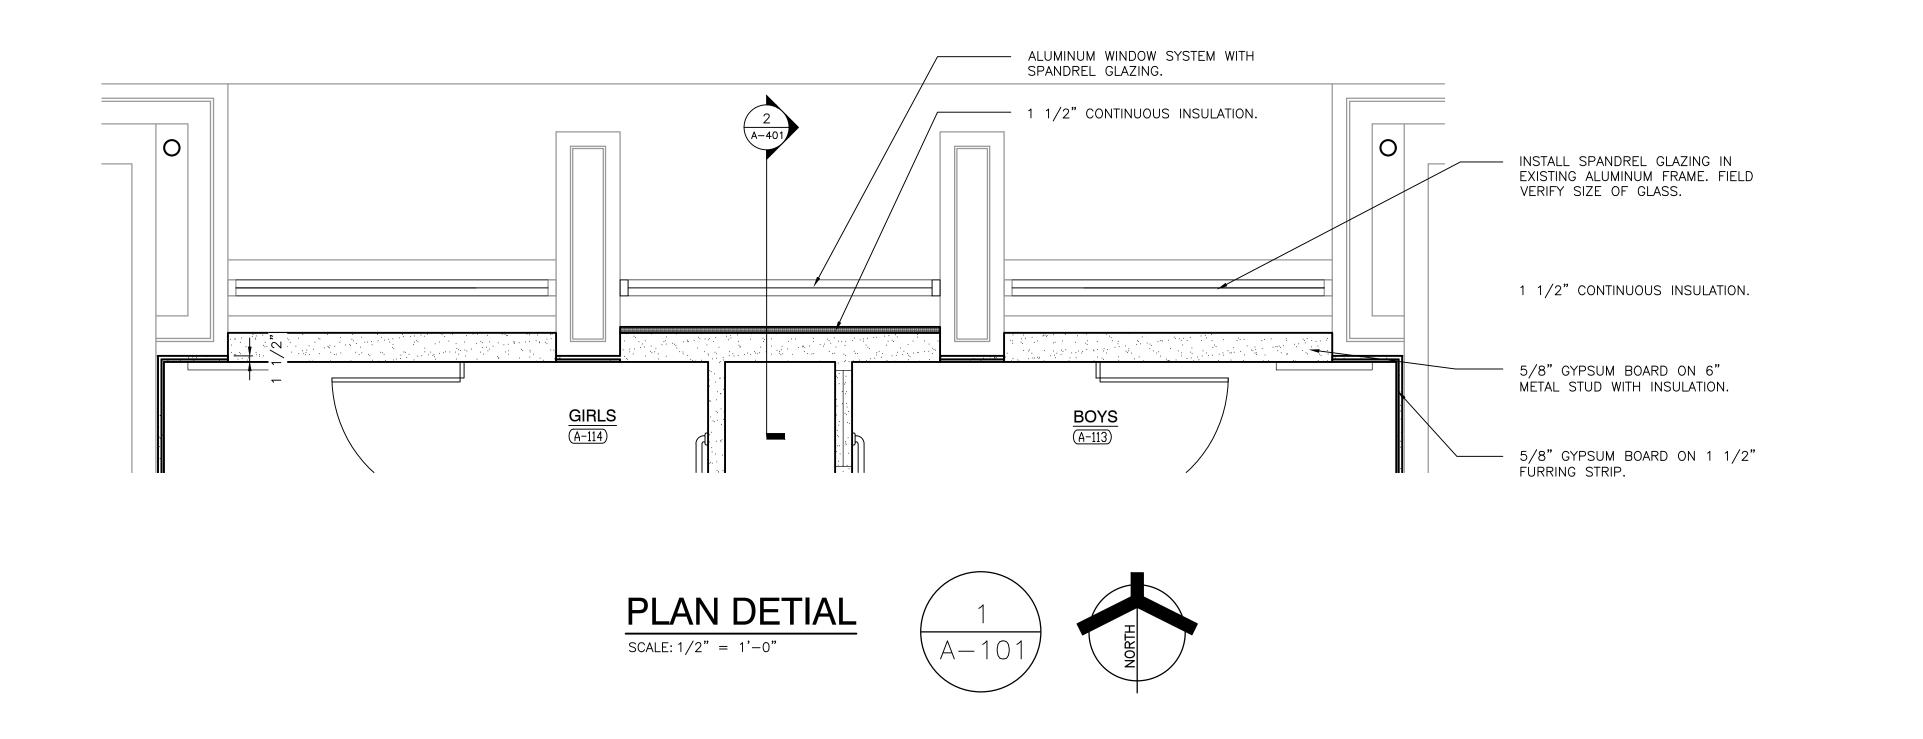

**GENERAL PLAN NOTES:** 

- A. FOR GENERAL PROJECT NOTES, MATERIAL INDICATIONS LEGEND, SYMBOL LEGEND, ABBREVIATIONS, ETC., REFER TO G SERIES SHEETS.
- 3. PLAN DIMENSIONS TO MASONRY WALLS ARE TO FACE OF ROUGH MASONRY. PLAN DIMENSIONS TO STUD WALLS ARE TO FACE OF FINISHED GYPSUM BOARD OR PLASTER. PLAN DIMENSIONS TO STUD WALLS WITH CERAMIC TILE FINISH ARE TO THE FACE OF TILE BACKER BOARD.
- . ALL CMU WALLS THAT DO NOT LAY OUT IN FULL OR HALF LENGTHS SHOULD BE BALANCED SO AS NOT TO HAVE ANY PIECES LESS THAN 4" IN SIZE EXPOSED TO VIEW.
- MASONRY WALLS BEARING ON A THICKENED SLAB AT SLAB DEPRESSIONS REQUIRE CUT MASONRY UNITS SO THAT COURSING BEGINS AT THE FLOOR
- REFER TO SITE PLAN FOR CORRELATION TO USGS DATUM. . HINGE SIDE OF DOOR JAMB AT CMU WALLS SHALL BE LOCATED 8" MINIMUM FROM ADJACENT WALL AND HINGE SIDE OF DOOR JAMB AT GYPSUM BOARD
- WALLS SHALL BE LOCATED 4" MINIMUM FROM ADJACENT WALL UNLESS NOTE PROVIDE WOOD BLOCKING (OR METAL STRAPPING WHERE APPLICABLE) AS
- REQUIRED WITHIN METAL STUD WALLS FOR WALL MOUNTED ITEMS. . REFER TO LIFE SAFETY PLANS REGARDING FIRE RATED WALL LOCATIONS AND OTHER CODE INFORMATION. INTERIOR CMU WALLS ARE TO BE RUNNING BOND UNLESS NOTED OTHERWISE
- ALL EXPOSED CONCRETE MASONRY UNITS (CMU) CORNERS ARE TO BE BULLNOSED, EXCEPT AT MASONRY BULKHEADS AND EXTERIOR WINDOW JAMBS . WHERE NEW CMU WALLS INTERSECT EXISTING CMU WALLS AT A CORNER OR PROJECT ARE ALIGNED WITH EXISTING CMU WALLS, TOOTH NEW CMU INTO EXISTING CMU UNLESS NOTED OTHERWISE.
- REFER TO DEMOLITION SHEETS FOR ADDITIONAL PATCHING AND REPAIR WORK. M. REFER TO FINISH PLANS FOR INTERIOR ELEVATIONS, LOCATION AND EXTENT OF FINISHED FLOOR AND WALL MATERIAL
- N. REFER TO EQUIPMENT PLANS FOR CASEWORK, DISPLAY BOARDS, LOCKERS, AND OTHER ADDITIONAL TYPICAL EQUIPMENT NOTES AND INFORMATION. REFER TO EQUIPMENT PLANS FOR REFERENCE TO ENLARGED TOILET ROOM PLANS AND TOILET ACCESSORIES.

### PLAN LEGEND:

INDICATES STOREFRONT, CURTAIN WALL, OR WINDOW SYSTEM. REFER TO A-600 SERIES DRAWINGS FOR ELEVATIONS AND DETAILS. INDICATES WALL TYPES REFER TO G-201 FOR WALL THICKNESS, HEIGHT, AND COMPOSITION.

### PLAN NOTES:

- (ALL PLAN NOTES MAY NOT BE INDICATED ON THIS SHEET.)
- (1) ALIGN NEW WALL TO EXISTING WALL OR JAMB. (2) DASHED LINE INDICATES TYPICAL BULKHEAD, REFER TO SECTIONS AND REFLECTED CEILING PLANS. (ALL BULKHEADS MAY NOT BE INDICATED ON
- (3) casework and/or millwork (typical), refer to equipment plans. (4) DISPLAY BOARD/PROJECTOR/TV MONITOR (TYP), REFER TO EQUIPMENT PLANS.
- (5) PUSH PAD FOR ADA OPERATOR, REFER TO ELECTRICAL DRAWINGS. (6) CARD/FOB READER, REFER TO ELECTRICAL/TECHNOLOGY DRAWINGS.

(7) AI DEVICE, REFER TO ELECTRICAL/TECHNOLOGY DRAWINGS.

- (8) fire alarm control panel, refer to electrical drawings. (9) FIRE ALARM ANNUNCIATOR PANEL, REFER TO ELECTRICAL DRAWINGS.
- (10) MOP SINK, REFER TO PLUMBING DRAWINGS.
- (11) BRONZE PLAQUE. REFER TO SPECIFICATIONS. (12) electric water cooler with bottle filler and bubbler, refer to PLUMBING DRAWINGS.
- (13) ACCESSIBLE ELECTRIC WATER COOLER WITH BOTTLE FILLER AND BUBBLER
- $\checkmark$  REFER TO PLUMBING DRAWINGS.
- (14) CABINET HEATER, REFER TO MECHANICAL DRAWINGS. (15) UNIT VENTILATOR, REFER TO MECHANICAL DRAWINGS.
- (16) ROOF CONDUCTOR, REFER TO PLUMBING DRAWINGS.
- (17) SEMI-RECESSED FIRE EXTINGUISHER CABINET. —
- (18) KNOX BOX.
- (20) NOT USED. (21) STAFF MAILBOX, REFER TO EQUIPMENT PLANS.
- (22) NOT USED. (23) DOWNSPOUT, REFER TO ROOF PLAN.

(19) CEILING CURTAIN TRACK. —

- (24) DASHED LINE INDICATES NEW PARTIAL DROP CEILING, REFER TO REFLECTED CEILING PLANS.
- (25) NOT USED.
- (26) INSTALL 1/2" TILE BACKER BOARD OVER EXISTING TILE TO REMAIN. NEW WALL CONSTRUCTION TO BE FLUSH WITH FACE OF NEW TILE BACKER BOARD, REFER TO FINISH PLANS AND FINISH LEGEND FOR
- NEW WALL FINISHES. (27) PROVIDE "ARDEX" FLOOR PATCHING AND PREP FLOOR FOR NEW FINISH. (28) PARTIALLY FILL IN RECESSED FLOOR WITH ARDEX. PREP TO RECEIVE NEW FLOOR FINISH. NEW FINIS TO BE FLUSH WITH EXISTING.
- (29) NOT USED. (30) RE-INSTALL PREVIOUSLY REMOVED WATER CLOSETS WITH FOUR (4) NEW
- CARRIER RODS AT EACH.

APPROXIMATE LOCATION OF EXISTING PAD. COORDINATE SIZE WITH

MECHANICAL EQUIPMENT SUPPLIER. REFER TO STRUCTURAL FOR

- (31) RE-INSTALL PREVIOUSLY REMOVED ACCESS PANELS.
- (32) PAINT EXISTING DOOR AND WINDOW FRAME FRONT AND BACK.

REINFORCING REQUIREMENTS.


(33) APPLY FILM TO EXISTING GLAZING. (34) INSTALL NEW CONCRETE EQUIPMENT PAD FOR NEW CHILLER IN

. THE BASE FIRST FLOOR ELEVATION INDICATED FOR THE PROJECT IS 100'-0". GIBRALTAR

> DESIGN ARCHITECTURE • ENGINEERING • INTERIOR DESIGN

# |ELEMENTARY SCHOOL -RENOVATIONS

DUNELAND SCHOOL CORPORATION CHESTERTON, INDIANA

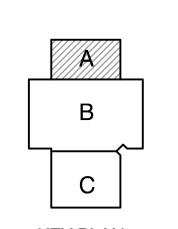

**KEY PLAN** GIBRALTAR DESIGN

9102 N. Meridian St., Ste. 300 ndianapolis, IN 46260 Homepage www.GibraltarDesign.com Email info@GibraltarDesign.com Phone 317.580.5777 Fax 317.580.5778

COORDINATED E

MMM

19600171 STATE OF DRAWN BY CHECKED BY

THE CONCEPTS, DESIGNS, PLANS, DETAILS, ETC, SHOWN ON THIS DOCUMENT ARE THE PROPERTY OF GIBRALTAR DESIGN AND WERE CREATED FOR USE ON THIS SPECIFIC PROJECT. NONE OF THIS INFORMATION SHALL BE USED BY ANY PERSON OR FIRM FOR ANY PURPOSE WITHOUT THE EXPRESS WRITTEN CONSENT OF GIBRALTAR DESIGN. THE OWNER MAY RETAIN COPIES FOR INFORMATION AND REFERENCE IN CONNECTION ONLY WITH THIS PROJECT


REVIS	IONS	
MARK	DATE	ISSUED FOR
AD-1	11/09/22	ADDENDUM NO. 1
DRAV	VING	

UNIT "A" ARCHITECTURAL

FIRST FLOOR PLAN

JACKSON ES - RENOVATIONS

A-101

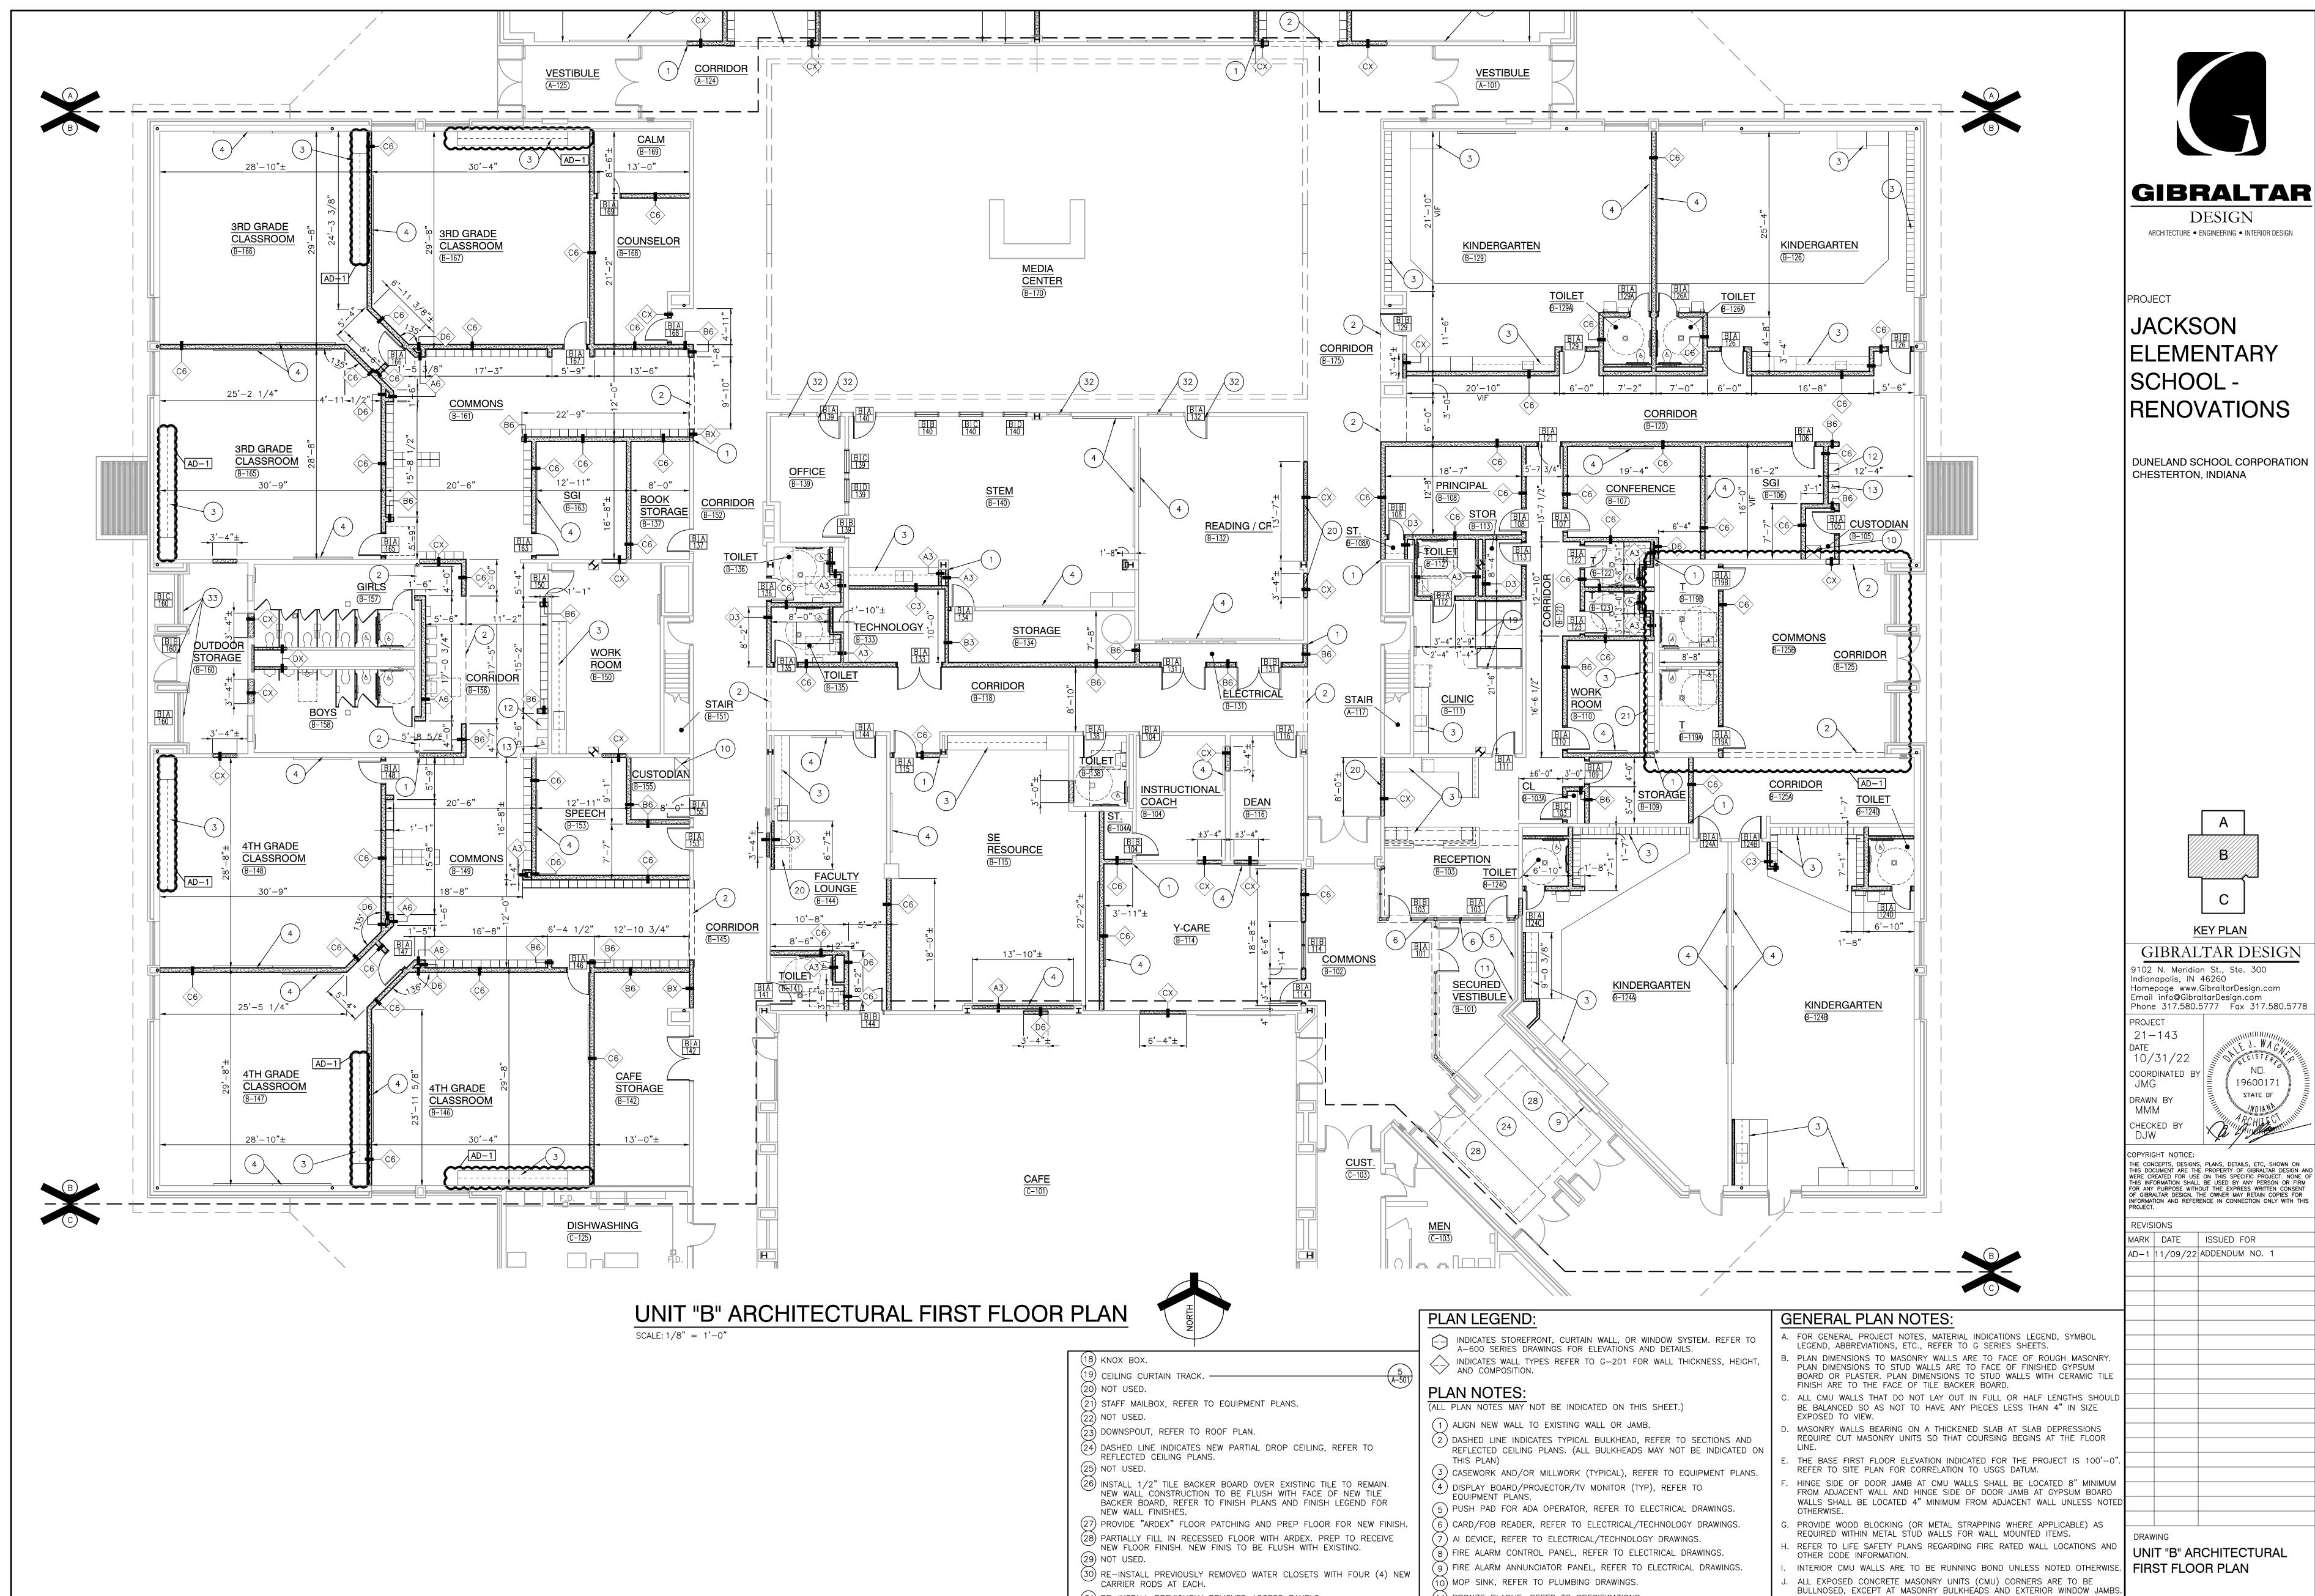

LAS ES RCH\ (31) RE-INSTALL PREVIOUSLY REMOVED ACCESS PANELS. (11) BRONZE PLAQUE. REFER TO SPECIFICATIONS. (12) ELECTRIC WATER COOLER WITH BOTTLE FILLER AND BUBBLER, REFER TO PLUMBING DRAWINGS. (32) PAINT EXISTING DOOR AND WINDOW FRAME FRONT AND BACK. CMU UNLESS NOTED OTHERWISE. (33) APPLY FILM TO EXISTING GLAZING. (13) ACCESSIBLE ELECTRIC WATER COOLER WITH BOTTLE FILLER AND BUBBLER, L. REFER TO DEMOLITION SHEETS FOR ADDITIONAL PATCHING AND REPAIR WORK. REFER TO PLUMBING DRAWINGS. (34) INSTALL NEW CONCRETE EQUIPMENT PAD FOR NEW CHILLER IN APPROXIMATE LOCATION OF EXISTING PAD. COORDINATE SIZE WITH (14) CABINET HEATER, REFER TO MECHANICAL DRAWINGS. MECHANICAL EQUIPMENT SUPPLIER. REFER TO STRUCTURAL FOR (15) UNIT VENTILATOR, REFER TO MECHANICAL DRAWINGS. REINFORCING REQUIREMENTS. (16) ROOF CONDUCTOR, REFER TO PLUMBING DRAWINGS. PLANS AND TOILET ACCESSORIES. (17) SEMI-RECESSED FIRE EXTINGUISHER CABINET. ——

- . WHERE NEW CMU WALLS INTERSECT EXISTING CMU WALLS AT A CORNER OR ARE ALIGNED WITH EXISTING CMU WALLS, TOOTH NEW CMU INTO EXISTING
- M. REFER TO FINISH PLANS FOR INTERIOR ELEVATIONS, LOCATION AND EXTENT OF FINISHED FLOOR AND WALL MATERIAL
- N. REFER TO EQUIPMENT PLANS FOR CASEWORK, DISPLAY BOARDS, LOCKERS, AND OTHER ADDITIONAL TYPICAL EQUIPMENT NOTES AND INFORMATION. D. REFER TO EQUIPMENT PLANS FOR REFERENCE TO ENLARGED TOILET ROOM


KEY PLAN

**DESIGN** 


JACKSON ES - RENOVATIONS

GIBRALTAR DESIGN SHEET В

A-102

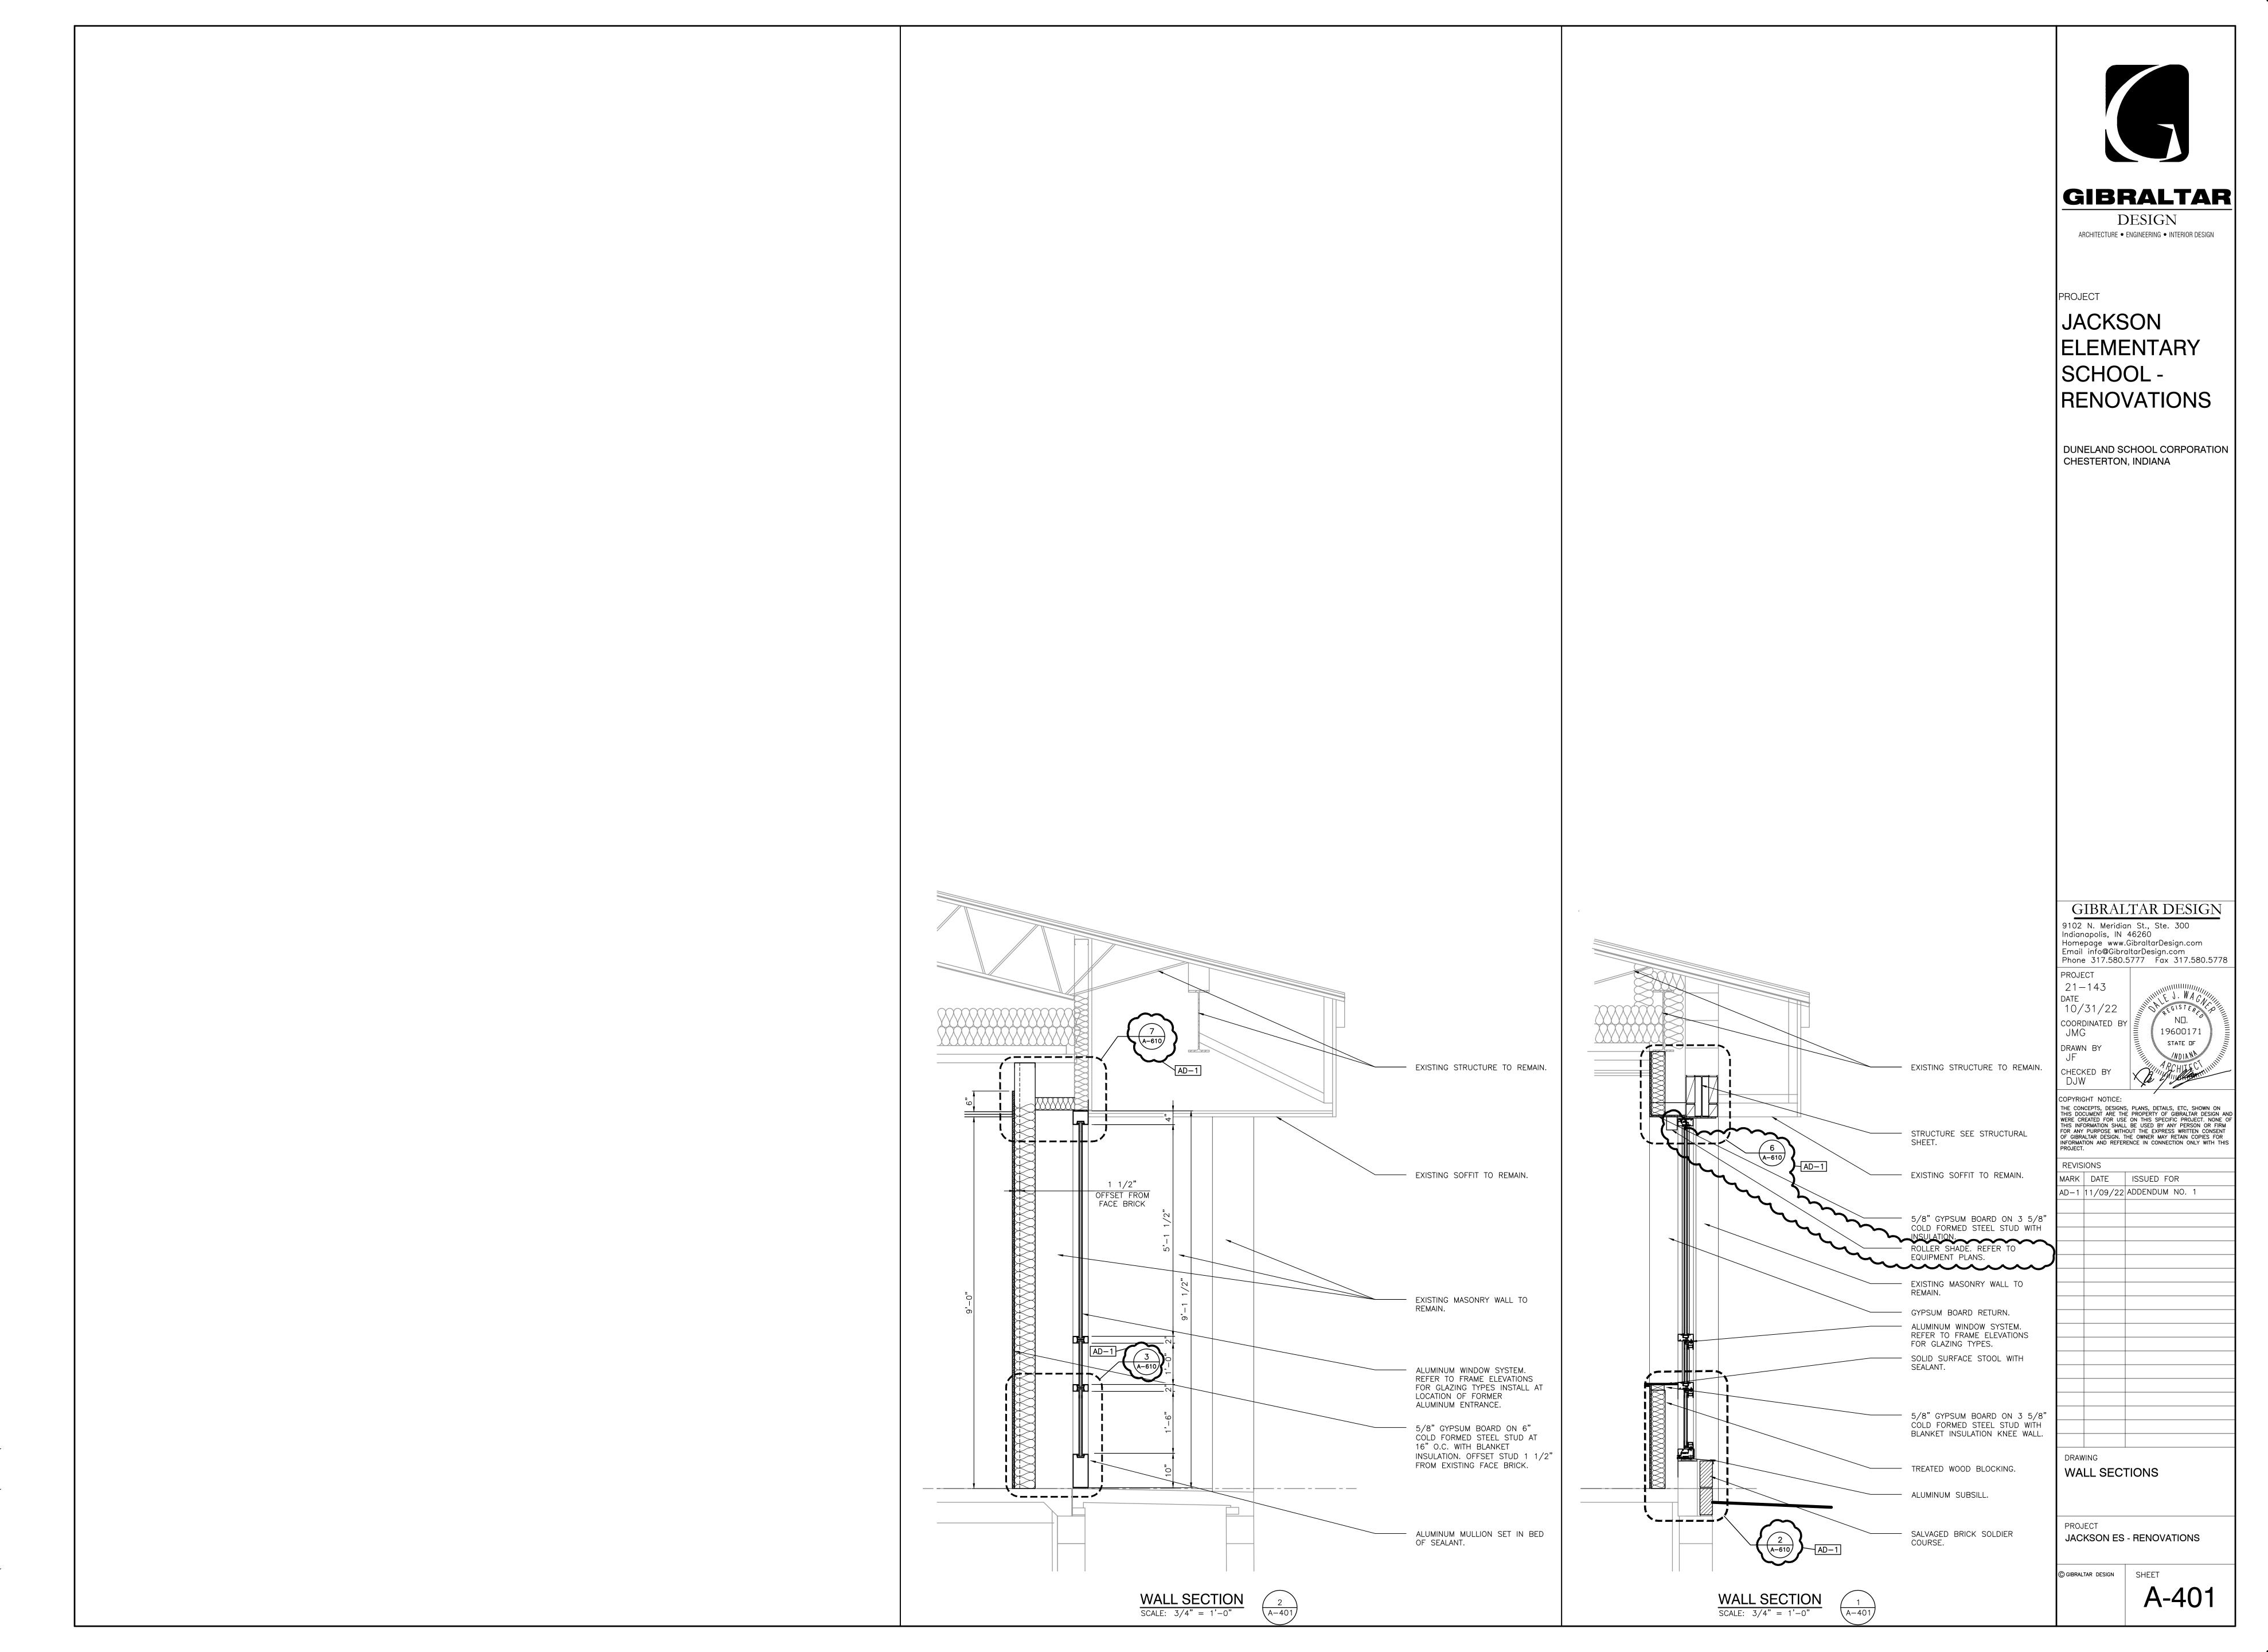

Wednesday, 11/9/2022 — 3:10 PM — LAST SAVED BY:JGRUBE Y:\21—143 DUNELAND SC — JACKSON ES ADDITIONS AND RENOVATIONS\21—143 DRAWINGS\05 ARCH\A—401.DWG

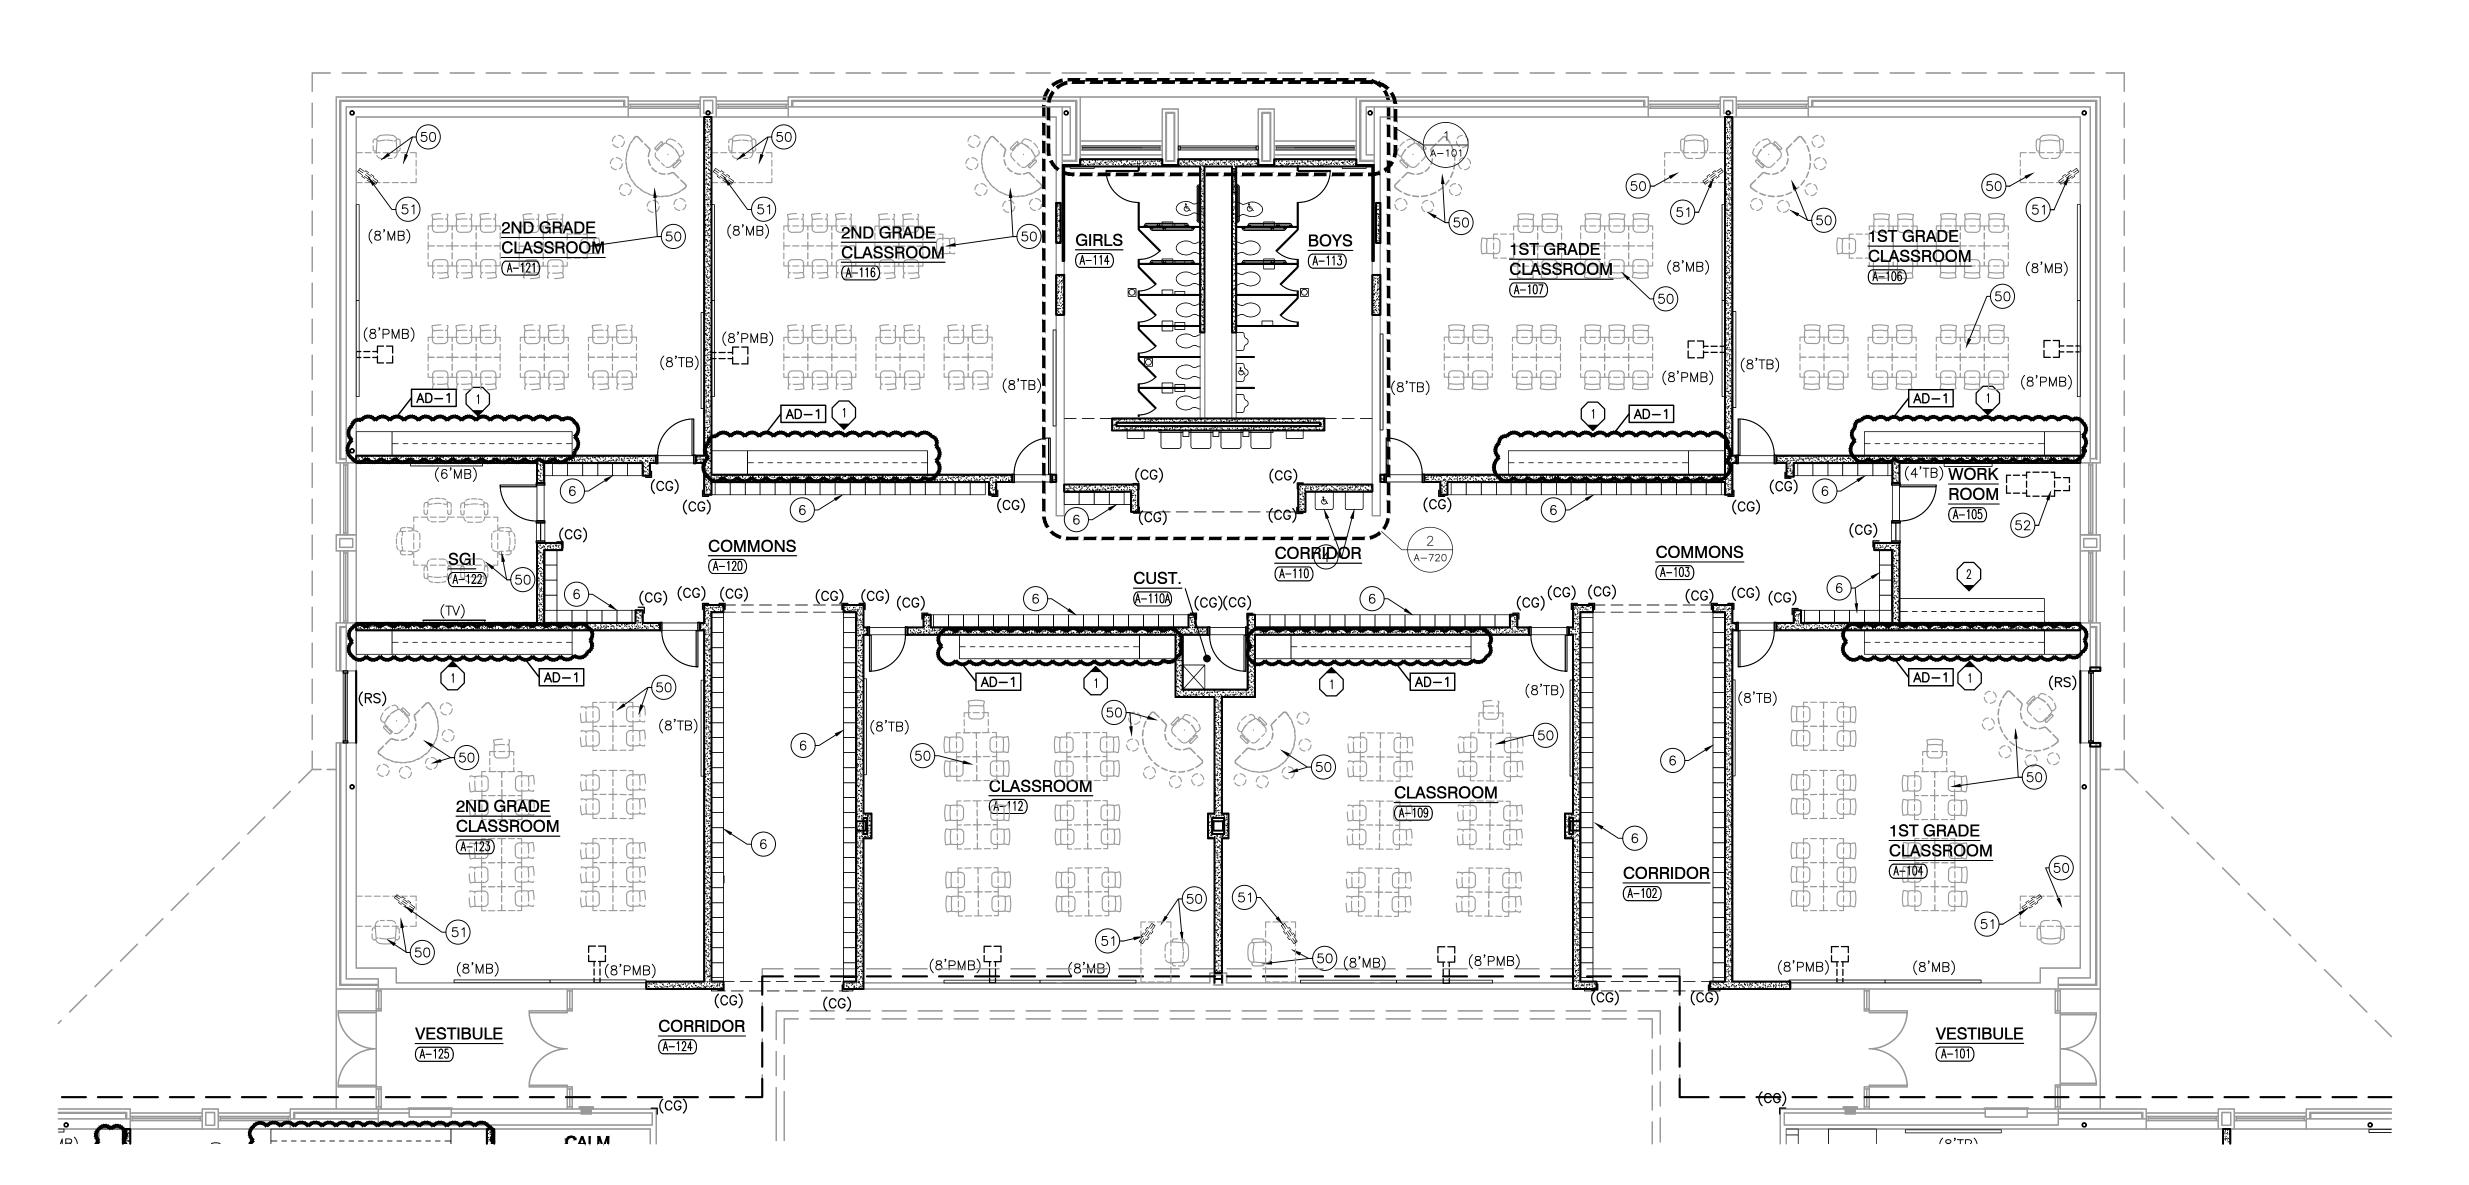

### GENERAL EQUIPMENT PLAN NOTES:

- A. REFER TO SPECIFICATIONS AND FINISH LEGEND FOR ADDITIONAL INFORMATION.
- B. FIELD VERIFY ALL DIMENSIONS.
- . CASEWORK AND/OR MILLWORK INSTALLER TO COORDINATE ELECTRICAL AND PLUMBING WORK. REFER TO ELECTRICAL DRAWINGS AND SCHEDULES FOR ELECTRICAL DEVICE TYPES, HEIGHTS, AND LOCATIONS.
- D. REFER TO G SERIES DRAWINGS FOR MOUNTING HEIGHTS. E. REFER TO EQUIPMENT PLANS FOR REFERENCE TO ENLARGED TOILET ROOM PLANS AND TOILET ROOM ACCESSORIES.

## **EQUIPMENT PLAN LEGEND:**

- -- INDICATES CASEWORK ELEVATION SYMBOL REFER TO A-800 SERIES DRAWINGS FOR ELEVATIONS AND DETAILS.
- ----- INDICATES ITEMS TO BE PART OF LOOSE EQUIPMENT PACKAGE BY OWNER. (NOT INCLUDED IN CONSTRUCTION CONTRACT).
- --- INDICATES BULKHEADS OR OTHER OVERHEAD ITEMS (INCLUDED IN ONSTRUCTION CONTRACTS).
- (7 CG) INDICATES CORNER GUARD.
- (TB) INDICATES 4' HIGH TACK BOARD LENGTH AS INDICATED, REFER TO MOUNTING HEIGHT DRAWING. ————
- (MB) INDICATES 4' HIGH MARKER BOARD LENGTH AS INDICATED, REFER TO MOUNTING HEIGHT DRAWING. ----
- (PMB) INDICATES 4' HIGH PROJECTABLE MARKER BOARD. REFER TO MOUNTING HEIGHT DRAWING. ——
- (TV) TELEVISION MONITOR, REFER TO TECHNOLOGY DRAWING. (RS) INDICATES ROLLER SHADE.

# **EQUIPMENT PLAN NOTES:**

- (ALL PLAN NOTES MAY NOT BE INDICATED ON THIS PLAN) (1) CUBICLE CURTAIN AND TRACK (1'-0" RADIUS AT CORNER). —
- (2) NOT USED
- (3) PAPER TOWEL AND SOAP DISPENSER, OFCI. (4) DRINKING FOUNTAIN, REFER TO PLUMBING DRAWINGS.
- (5) NOT USED (6) LOCKERS, SEE DETAILS. —
- (7) SINK IN CASEWORK, REFER TO CASEWORK AND PLUMBING DRAWINGS.

# OWNER FURNISHED EQUIPMENT

### PLAN NOTES:

- 50) LOOSE FURNITURE, BY OWNER, INDICATED ON PLAN FOR ELECTRICAL AND TECHNOLOGY COORDINATION.
- (51) COMPUTER/MONITOR, BY OWNER
- (52) PRINTER/COPIER, BY OWNER
- (53) REFRIGERATOR WITH ICE MAKER, BY OWNER
- (54) SHELVING, BY OWNER. (55) FILE CABINET, BY OWNER.
- (56) MICROWAVE, BY OWNER.
- (57) VENDING MACHINE, BY OWNER.
- (58) CLINIC COTS, BY OWNER.
- (59) KILN, BY OWNER.
- (60) PIANO, BY OWNER.
- (61) CHANGING TABLE, BY OWNER.




DESIGN ARCHITECTURE • ENGINEERING • INTERIOR DESIGN

PROJECT

JACKSON ELEMENTARY SCHOOL -RENOVATIONS

DUNELAND SCHOOL CORPORATION CHESTERTON, INDIANA

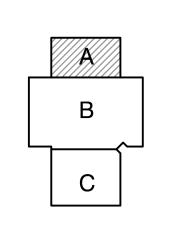

**KEY PLAN** GIBRALTAR DESIGN 9102 N. Meridian St., Ste. 300

Indianapolis, IN 46260
Homepage www.GibraltarDesign.com
Email info@GibraltarDesign.com
Phone 317.580.5777 Fax 317.580.5778

10/31/22 COORDINATED BY MMM

COPYRIGHT NOTICE:

19600171 STATE OF DRAWN BY CLN, AB CHECKED BY DJW

THE CONCEPTS, DESIGNS, PLANS, DETAILS, ETC, SHOWN ON THIS DOCUMENT ARE THE PROPERTY OF GIBRALTAR DESIGN AND WERE CREATED FOR USE ON THIS SPECIFIC PROJECT. NONE OF THIS INFORMATION SHALL BE USED BY ANY PERSON OR FIRM FOR ANY PURPOSE WITHOUT THE EXPRESS WRITTEN CONSENT OF GIBRALTAR DESIGN. THE OWNER MAY RETAIN COPIES FOR INFORMATION AND REFERENCE IN CONNECTION ONLY WITH THIS PROJECT.

MARK DATE ISSUED FOR AD-1 | 11/09/22 | ADDENDUM NO. 1


UNIT "A" FIRST FLOOR

EQUIPMENT PLAN


JACKSON ES - RENOVATIONS

A-701


sday, 11/9/2022 — 3:11 PM — LAST SAVED BY:CN —143 DUNELAND SC — JACKSON ES ADDITIONS AND ATIONS\21—143 DRAWINGS\05 ARCH\A—701.DWG

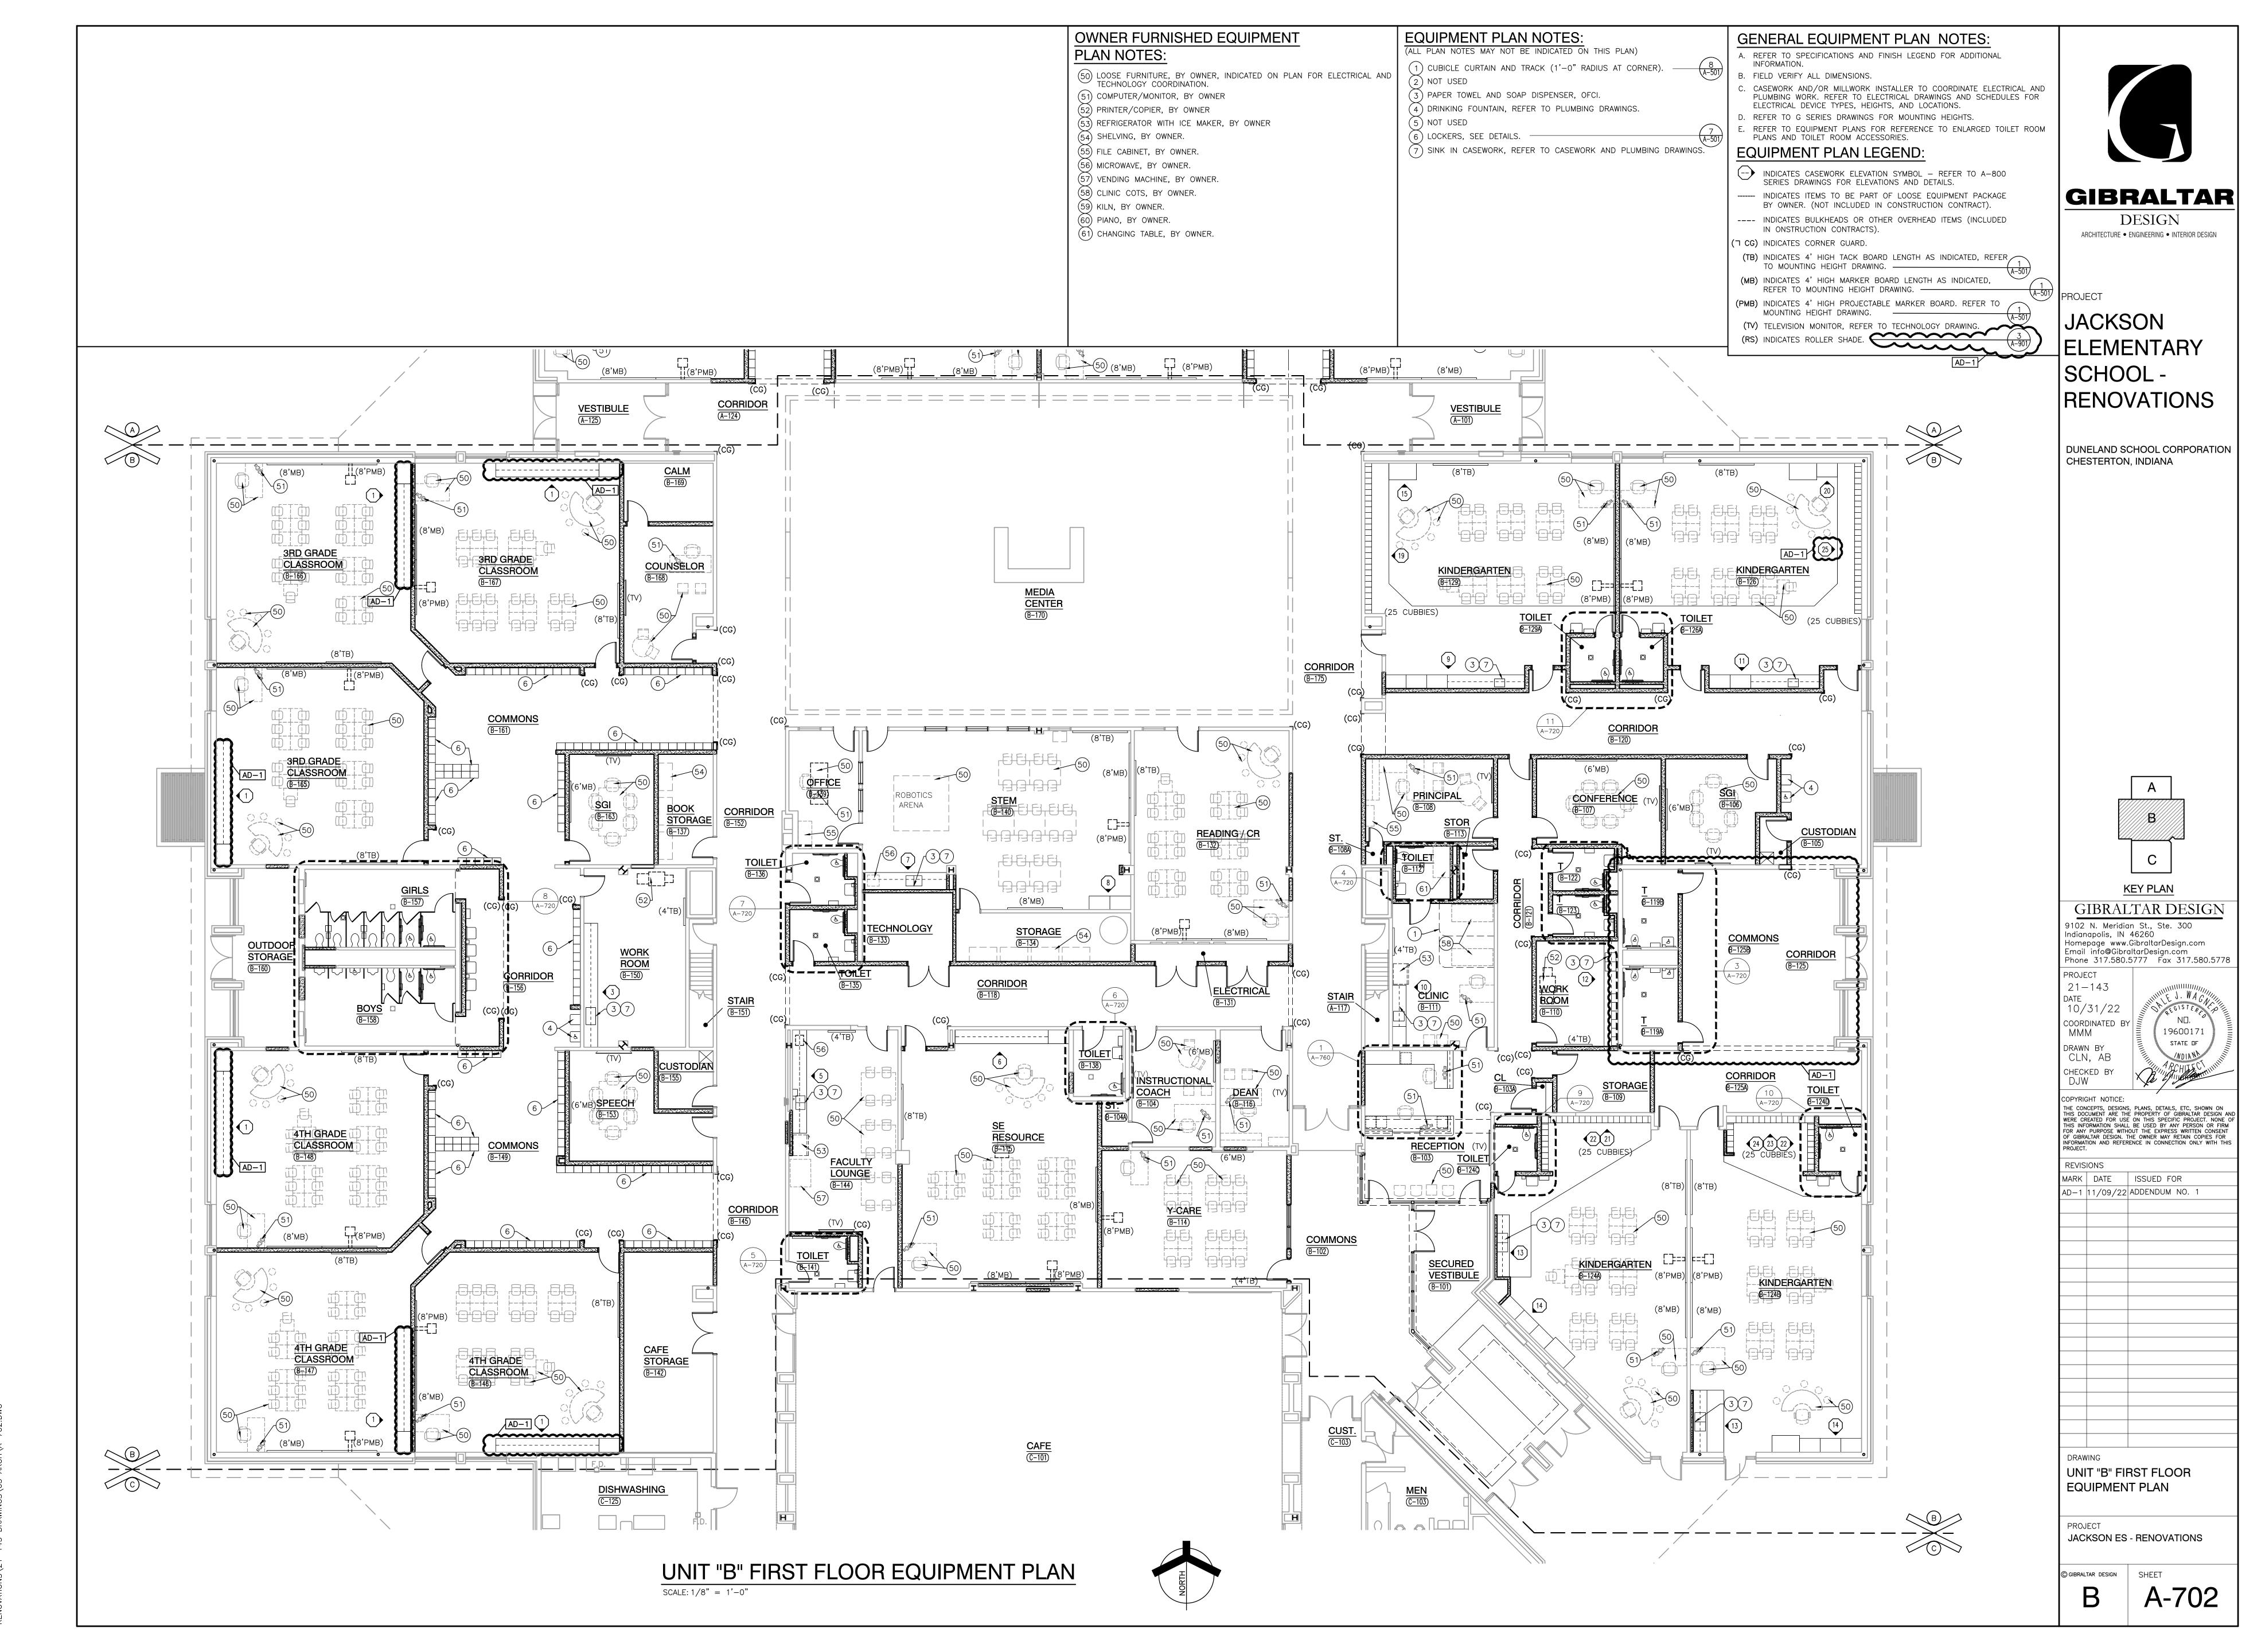


Wednesday, 11/9/2022 - 9:15 AM - LAST SAVED BY:CNELSO Y:\21-143 DUNELAND SC - JACKSON ES ADDITIONS AND BENOVATIONS\21-143 DRAWINGS\05 ARCH\A-703 DWG

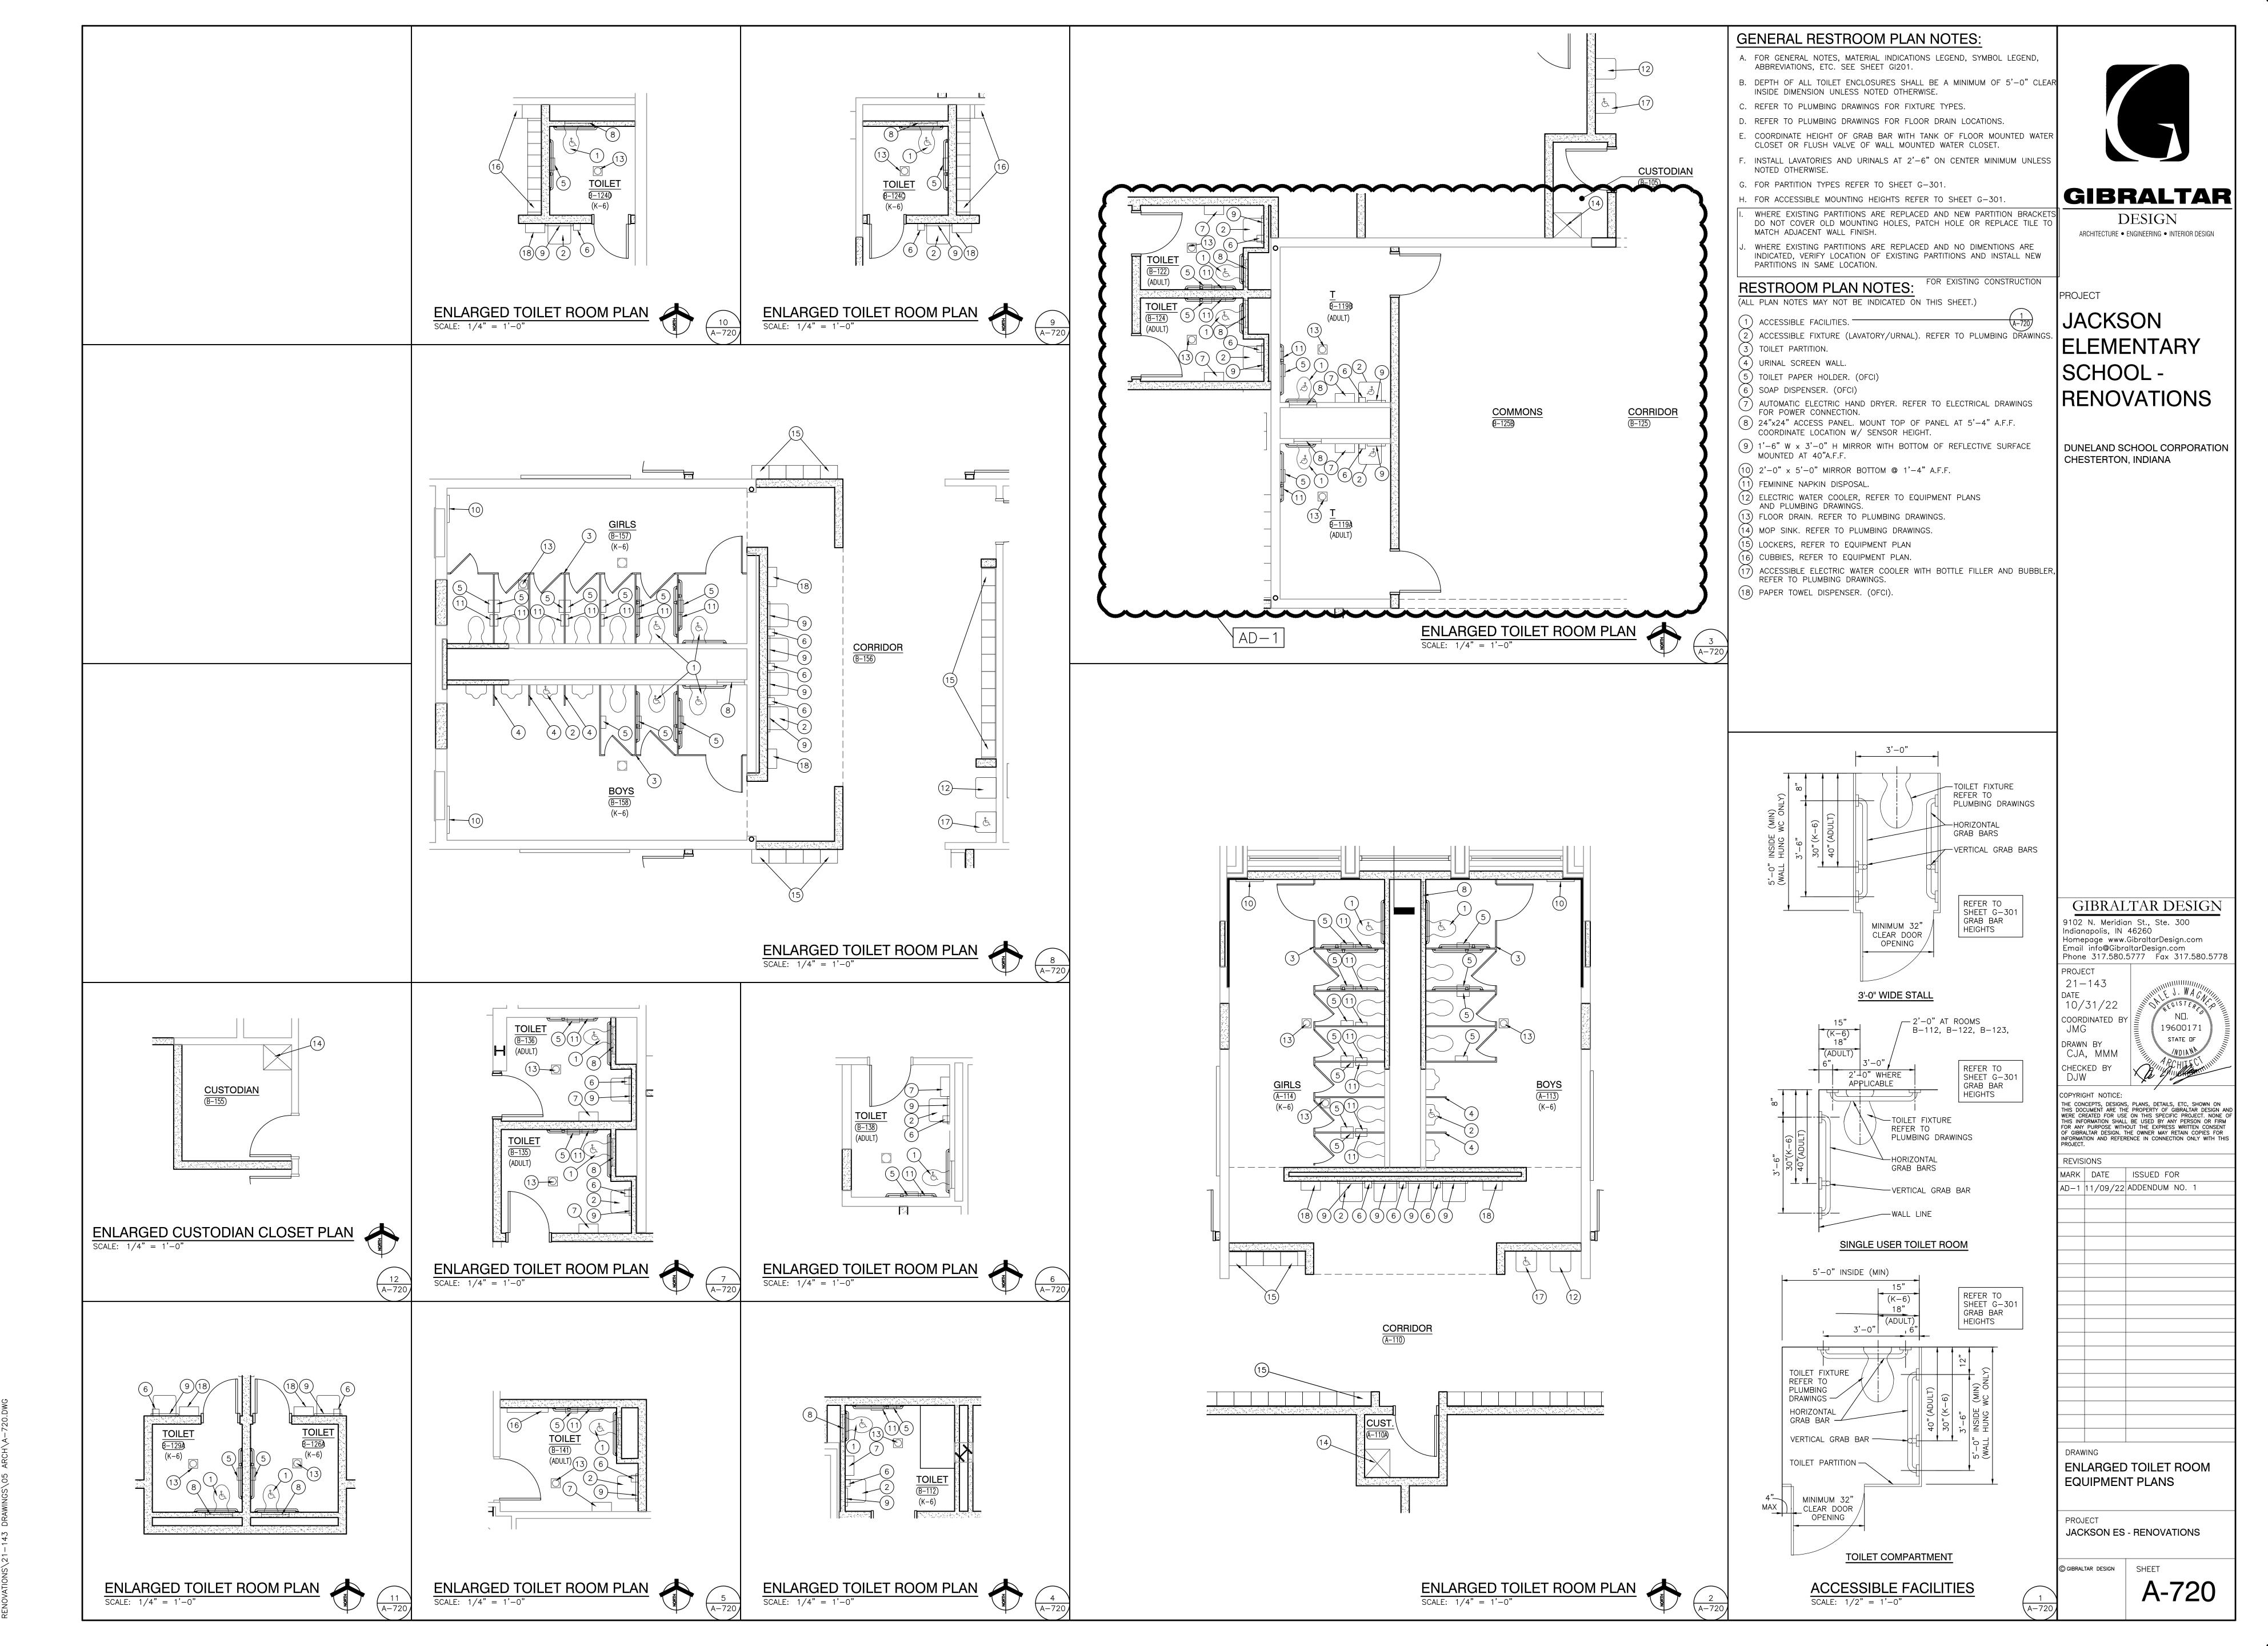


Wednesday, 11/9/2022 — 3:12 PM — LAST SAVED BY:MMINER Y:\21-143 DUNELAND SC — JACKSON ES ADDITIONS AND RENOVATIONS\21-143 DRAWINGS\05 ARCH\A-720.DWG

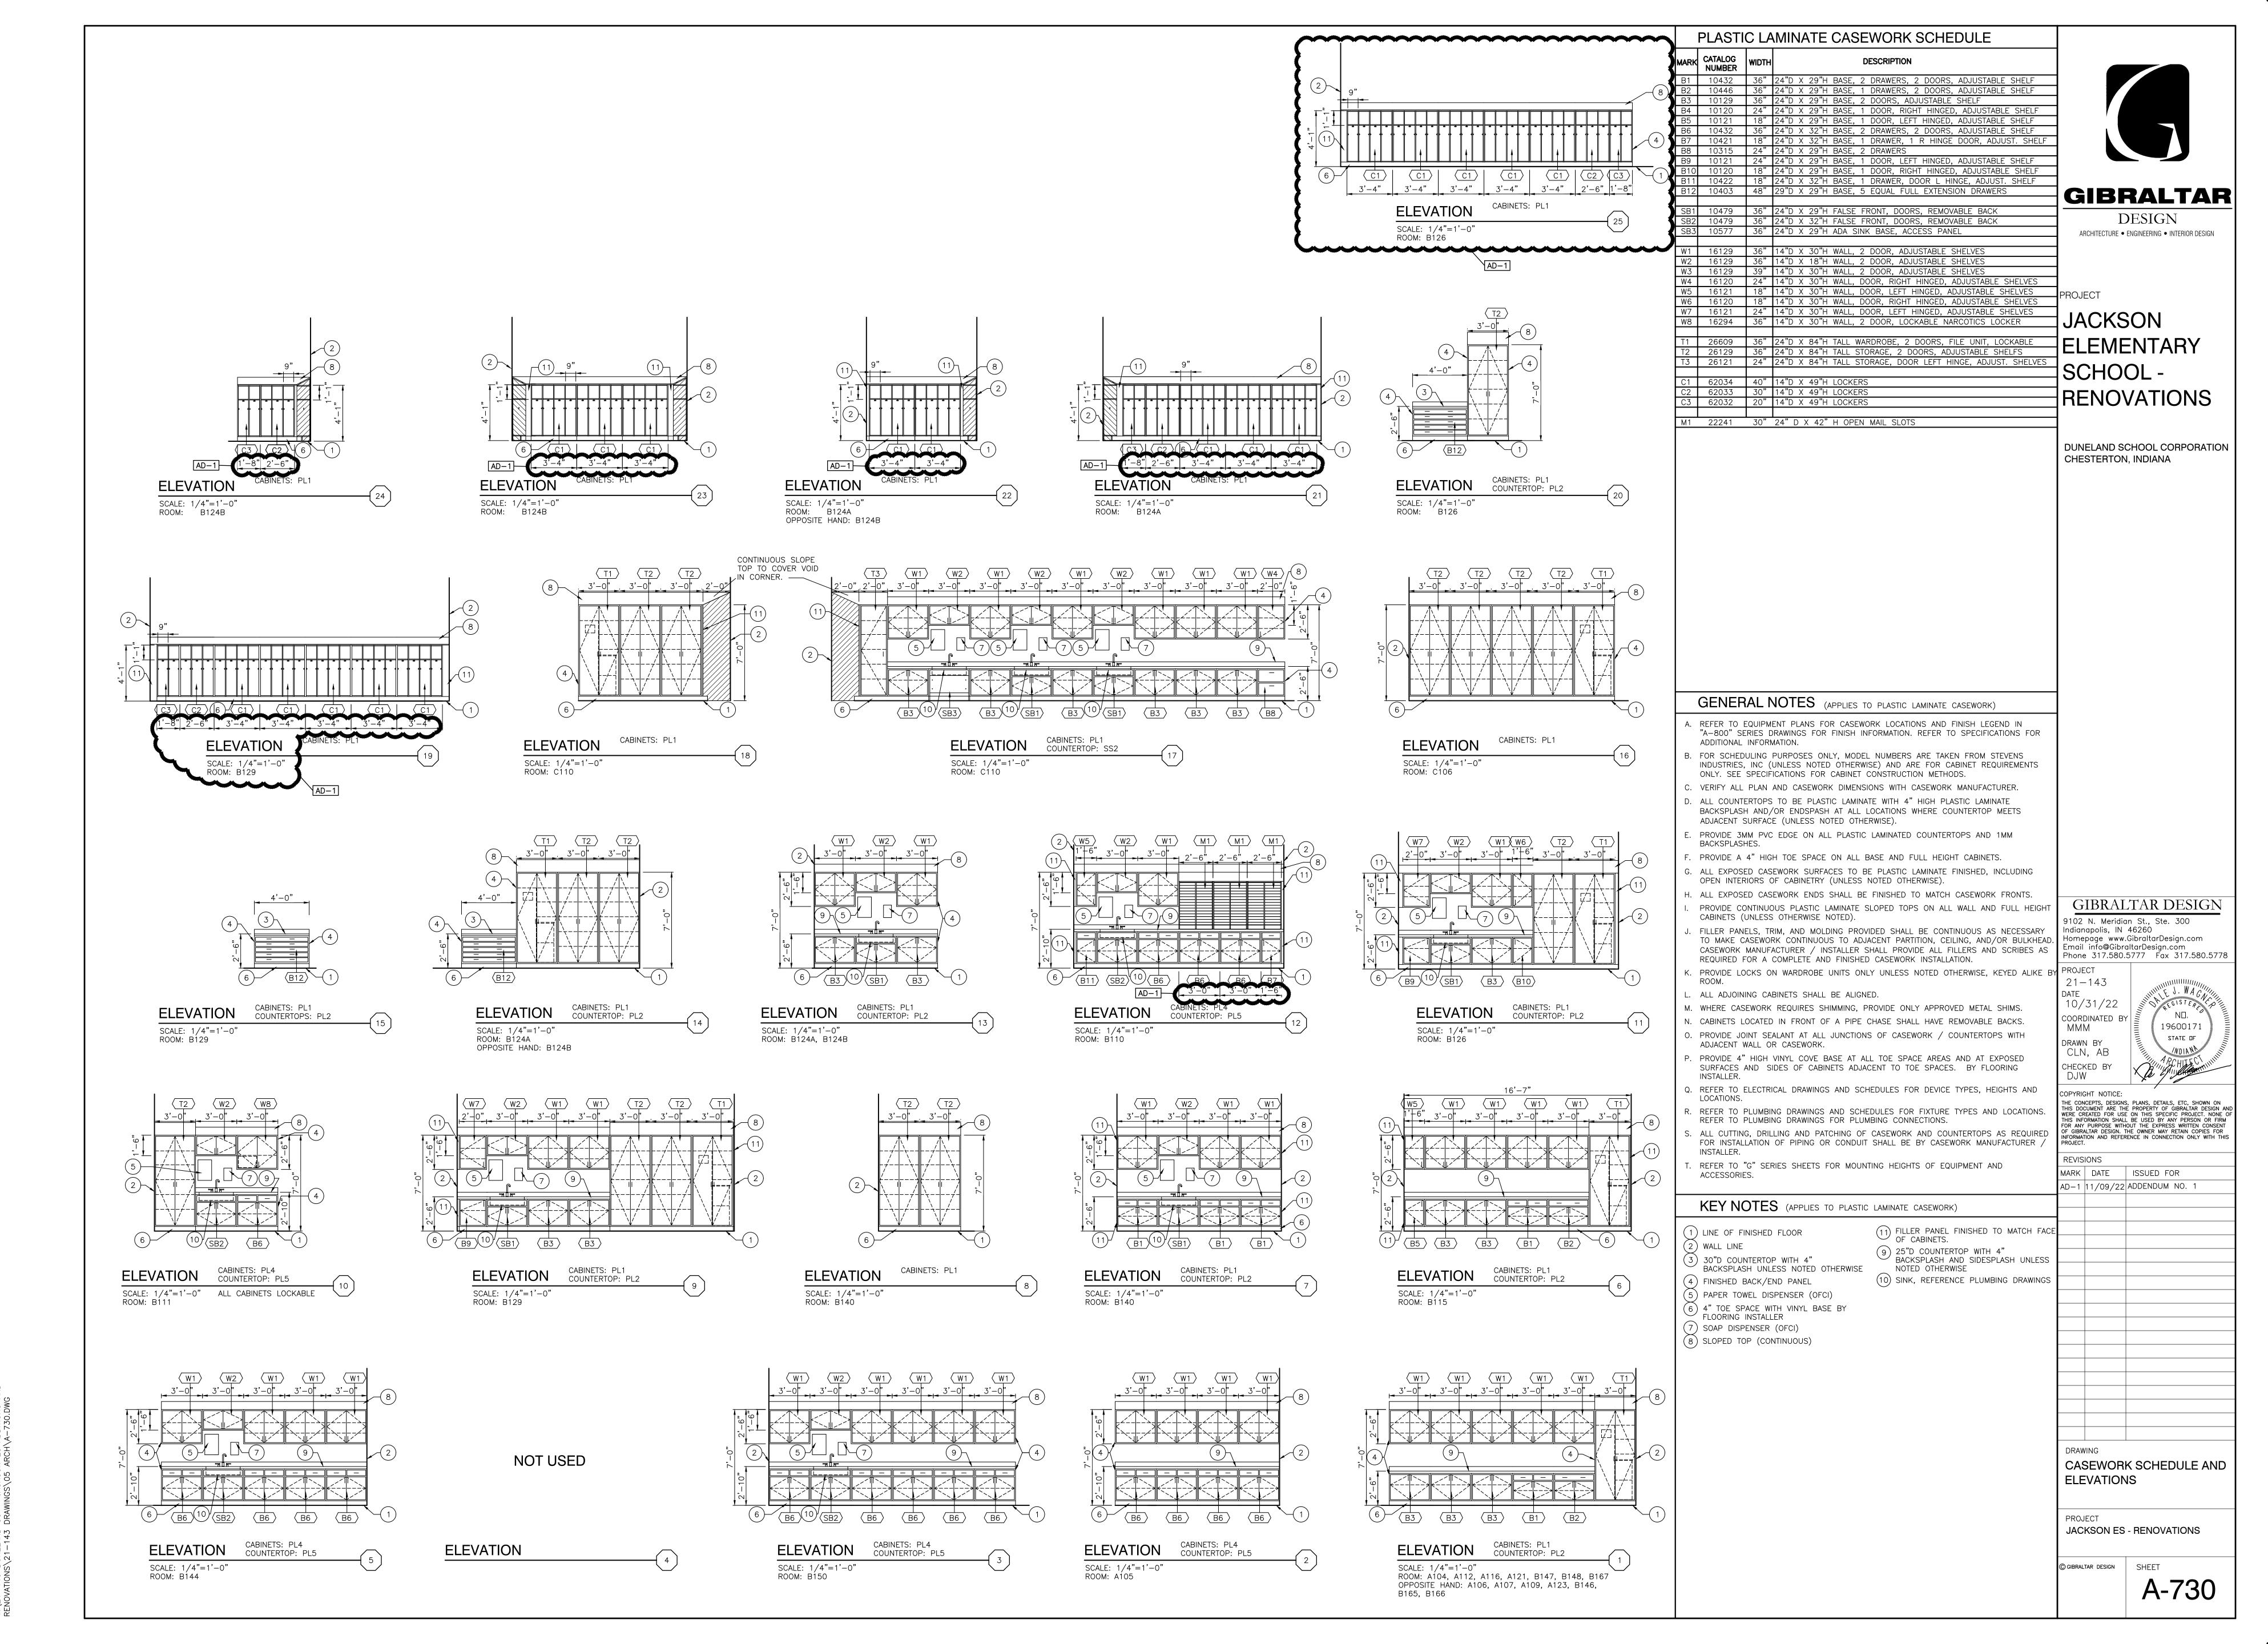

Tuesday, 11/8/2022 — 12:33 PM — LAST SAVED BY:ABUSCH Y:\21—143 DUNELAND SC — JACKSON ES ADDITIONS AND RENOVATIONS\21—143 DRAWINGS\05 ARCH\A—730.DWG

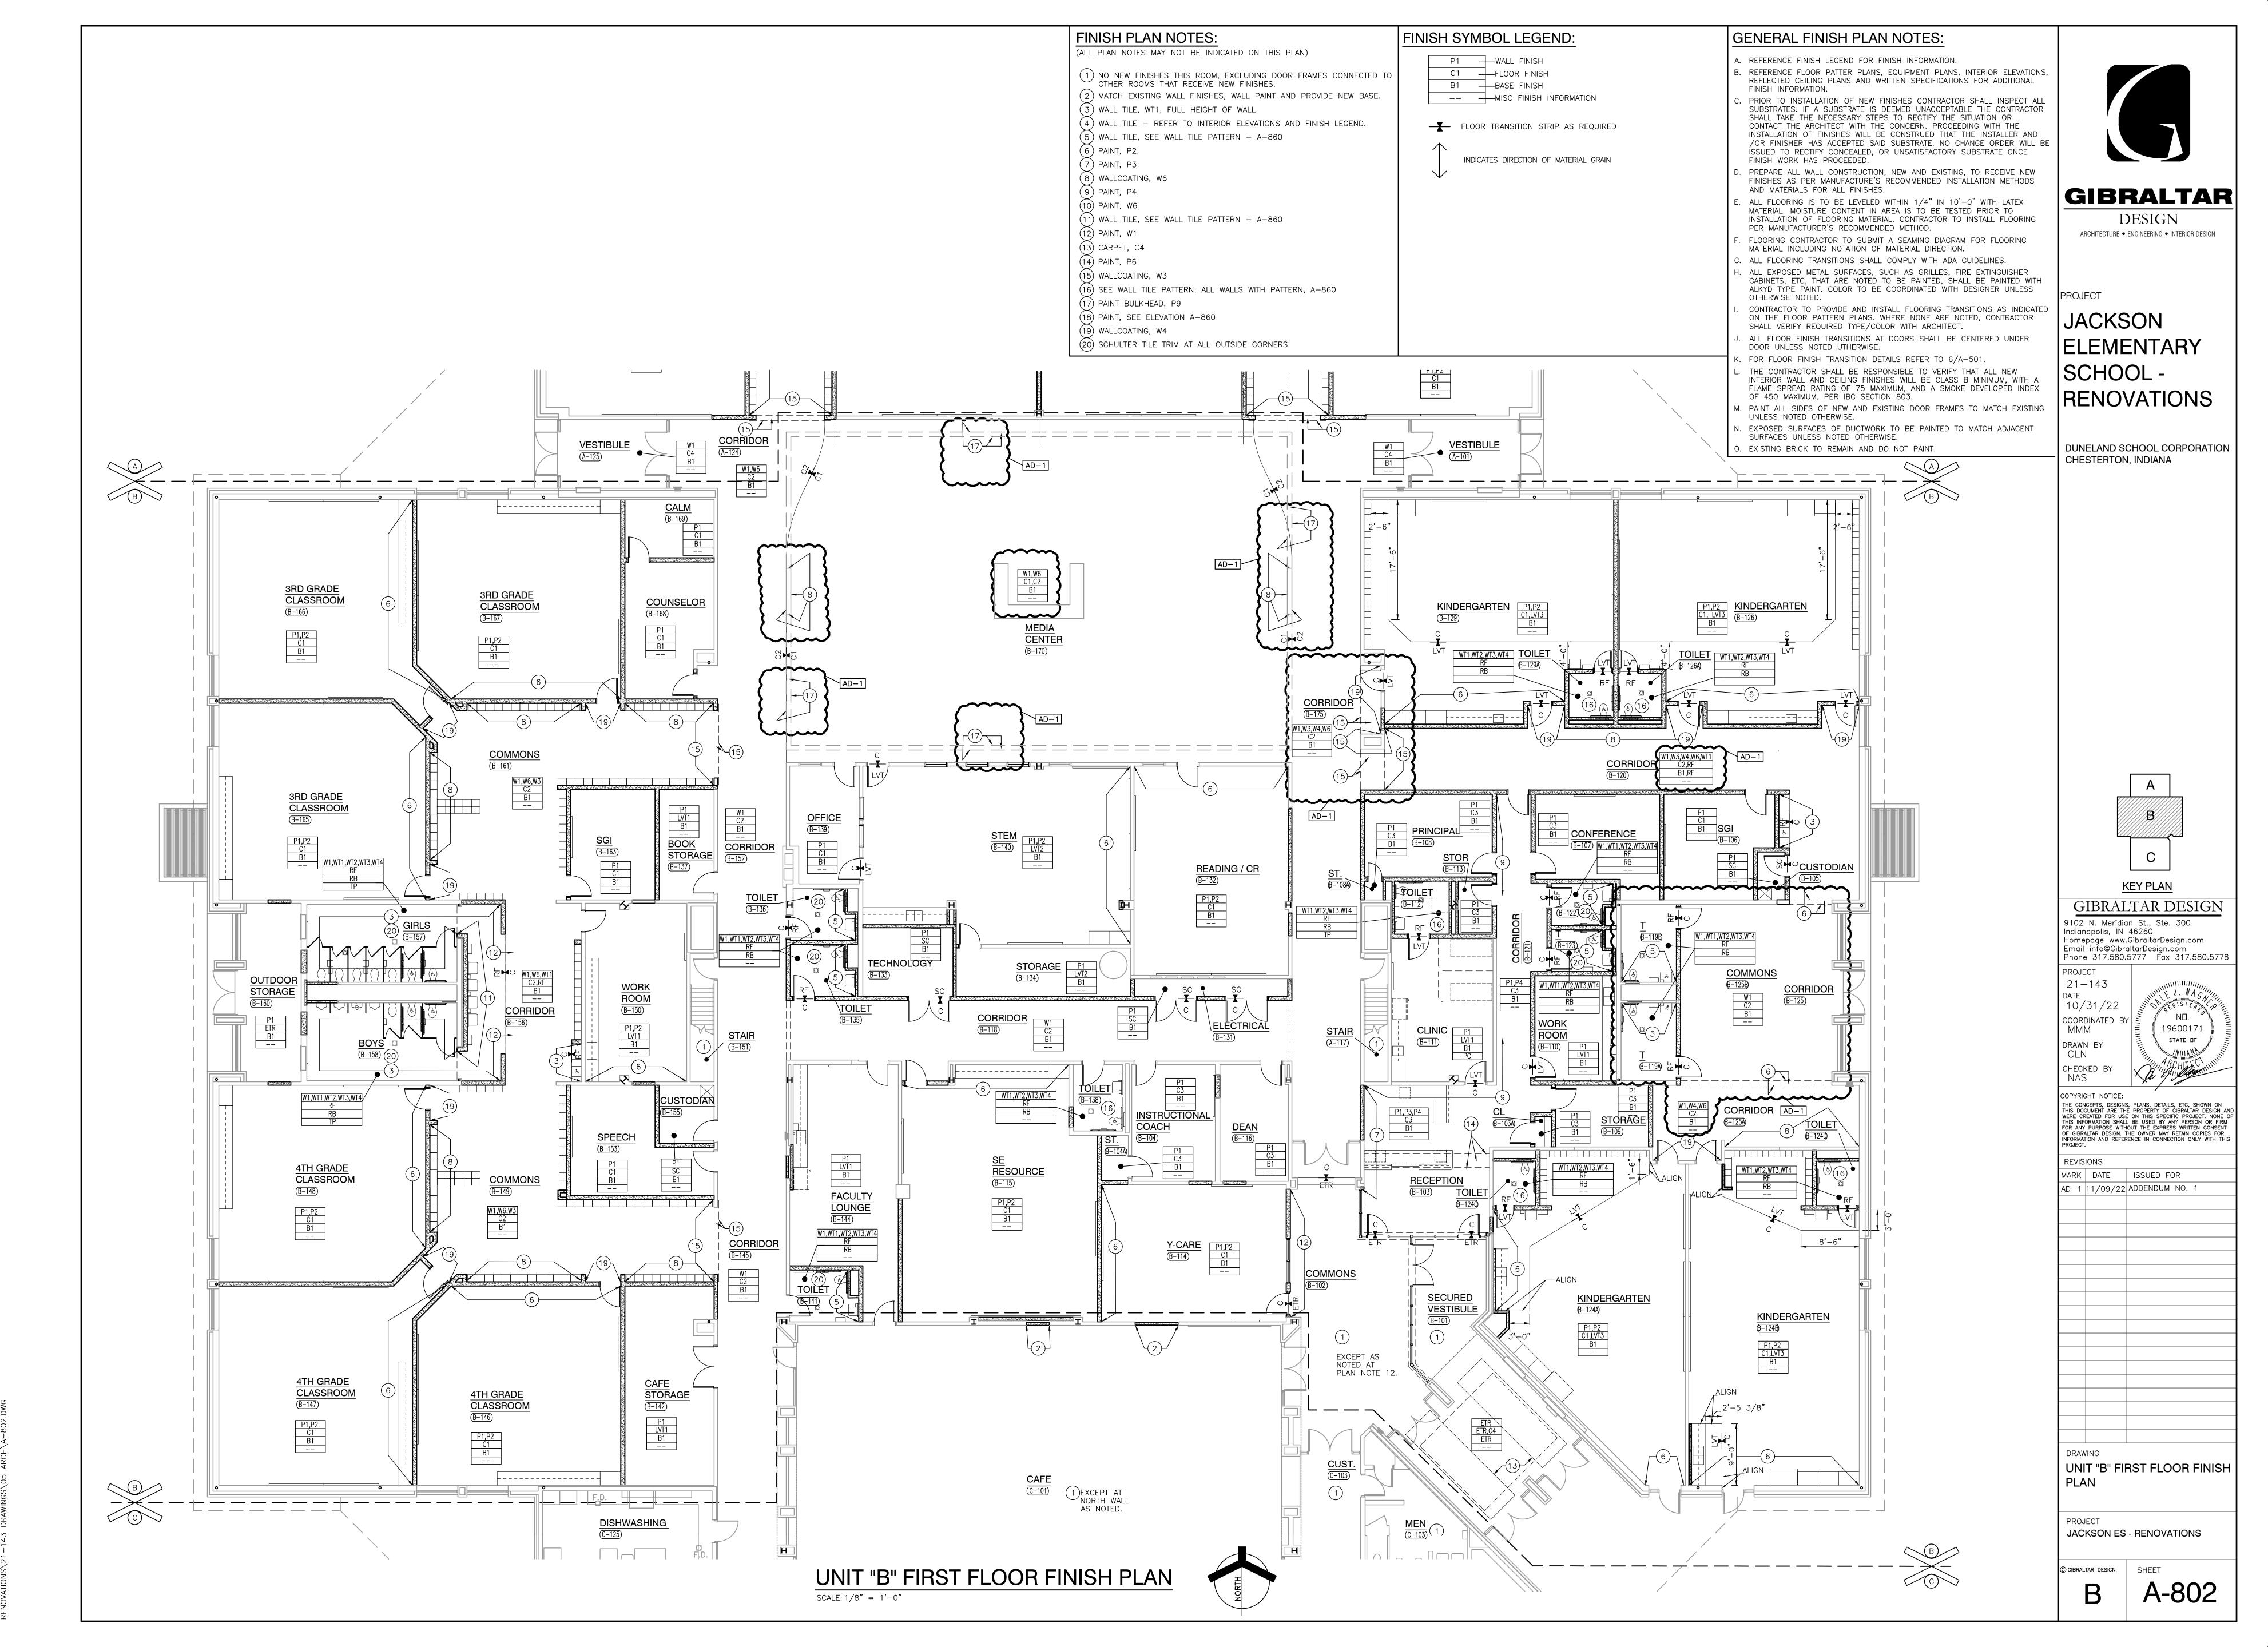

Wednesday, 11/9/2022 - 9:49 AM - LAST SAVED BY:CNE Y:\21-143 DUNELAND SC - JACKSON ES ADDITIONS AND

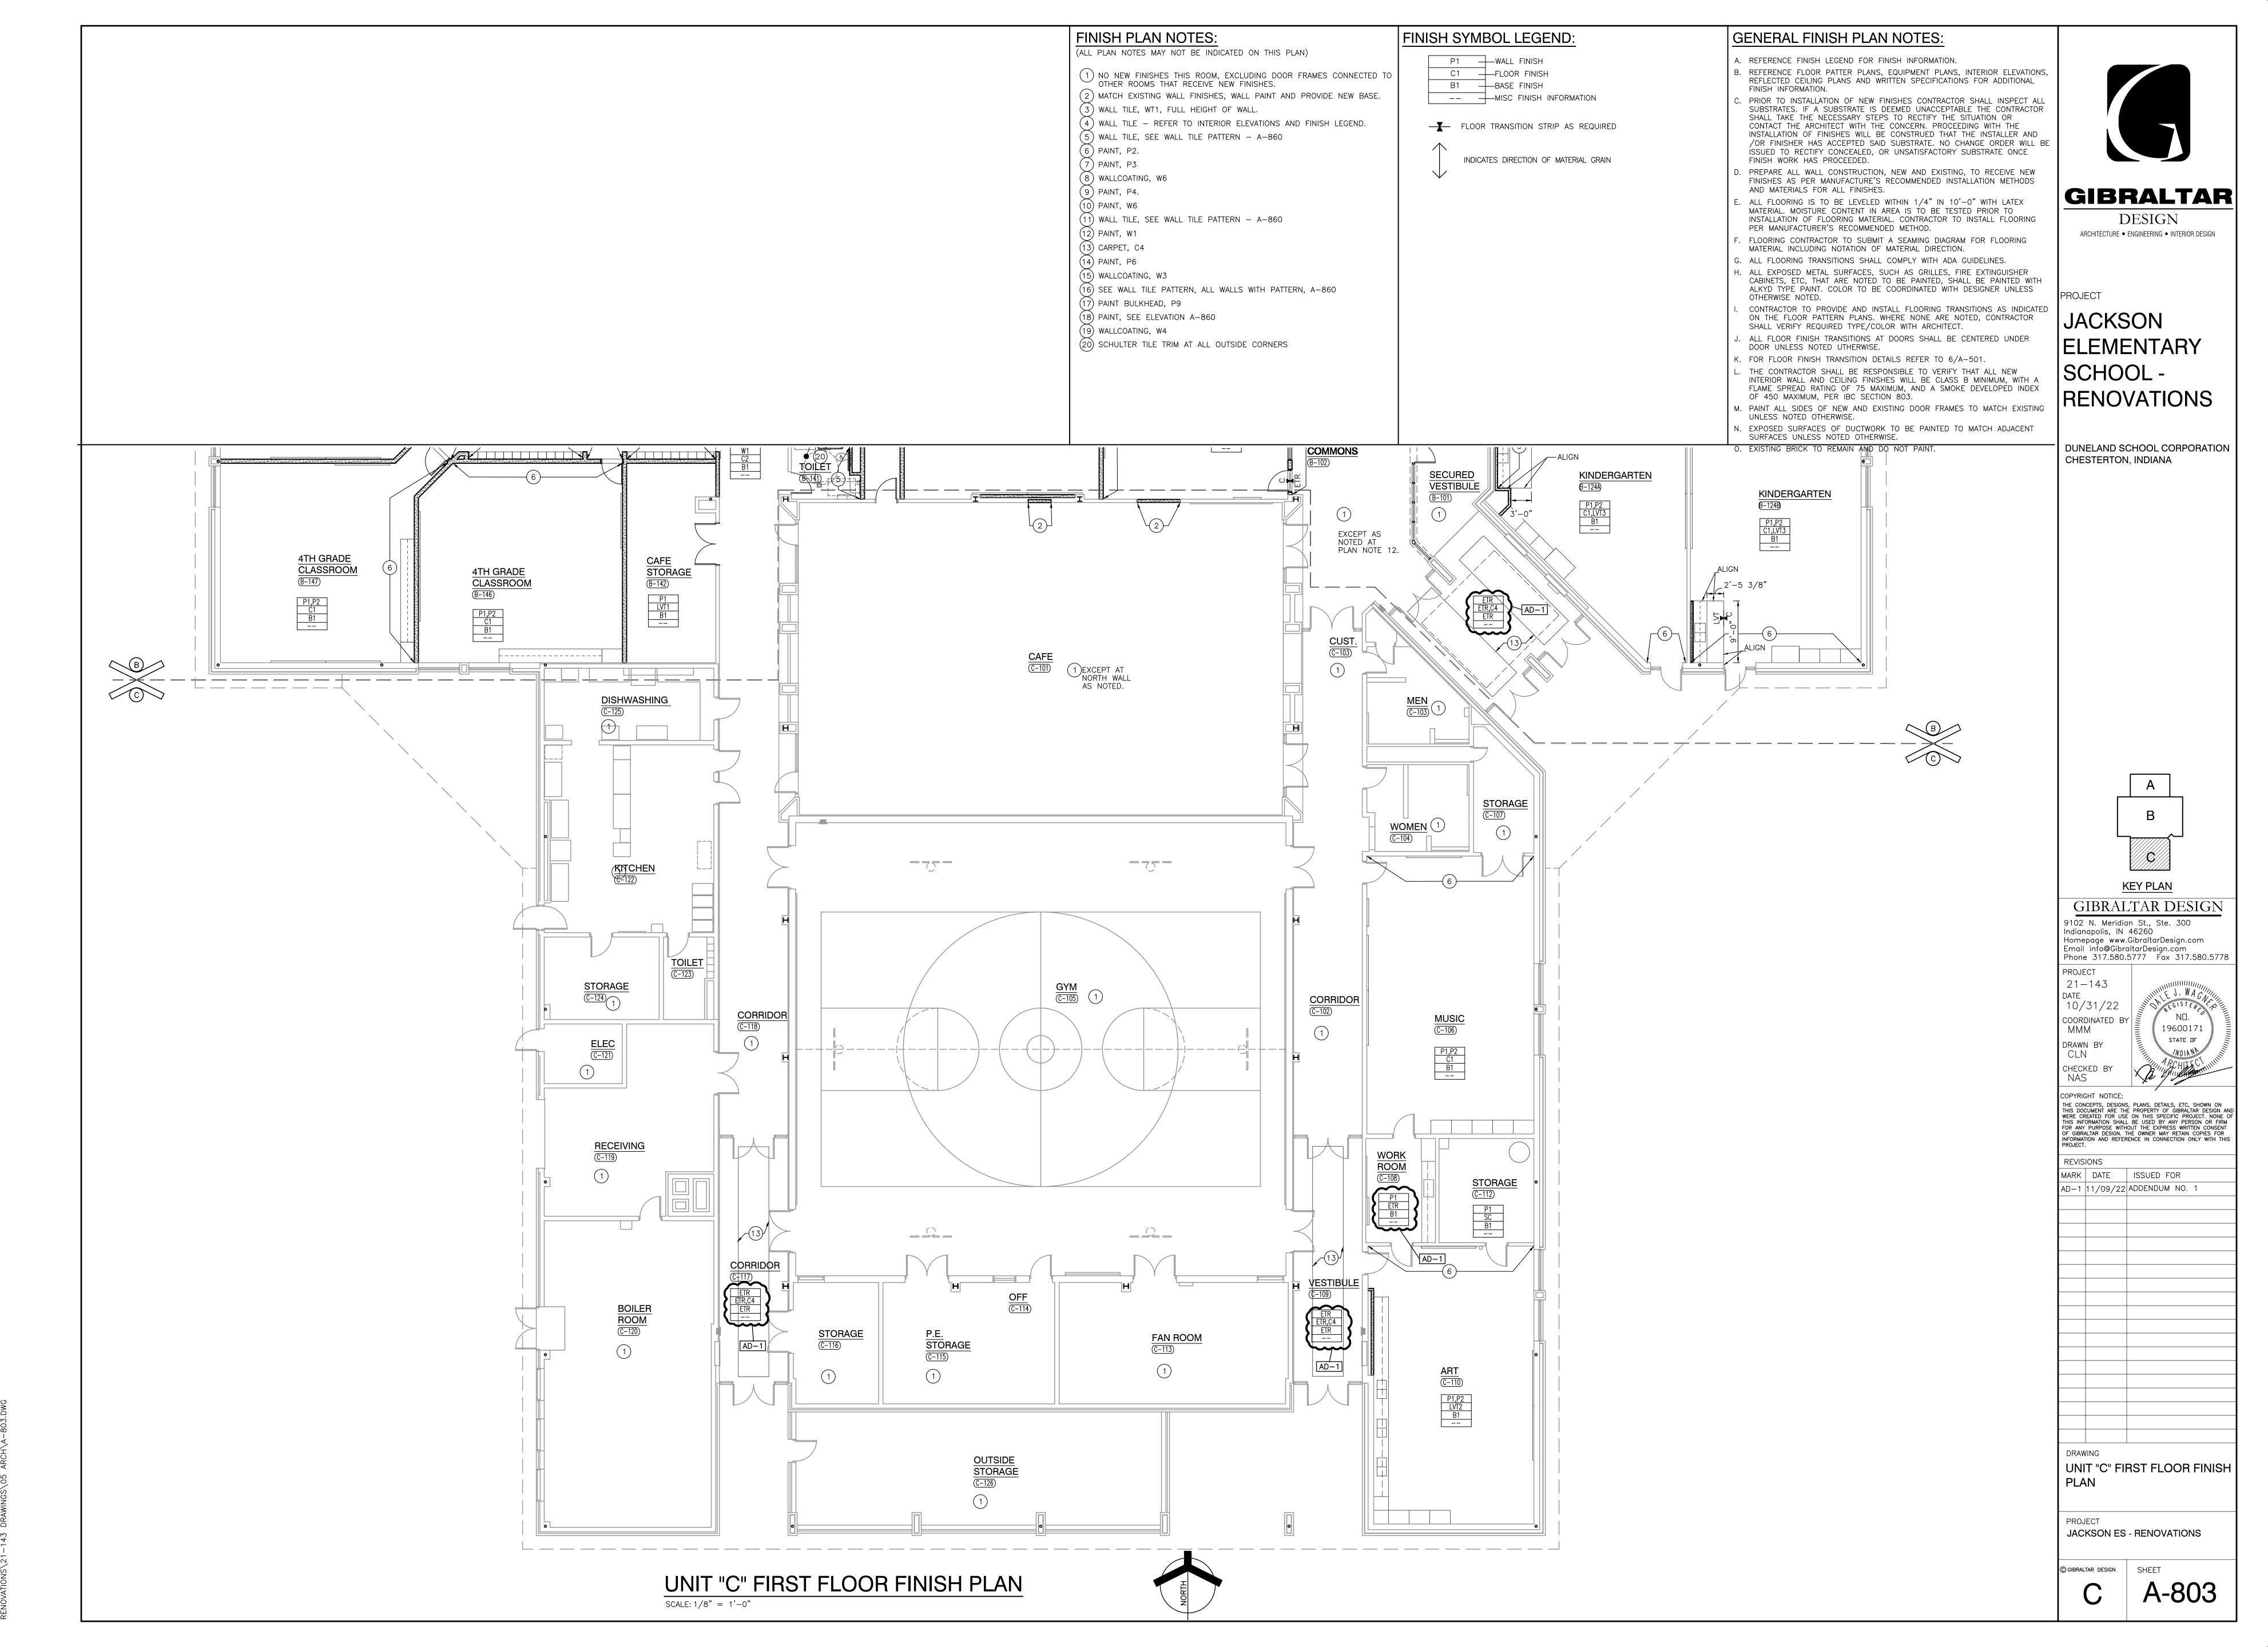

Wednesday, 11/9/2022 - 9:52 AM - LAST SAVED BY:CNELS Y:\21-143 DUNELAND SC - JACKSON ES ADDITIONS AND

E				FINISH LE	GLIND			
E	MARK	DESCRIPTION	MANUFACTURER	PATTERN/FINISH	NUMBER/COLOR	SIZE	COMMENTS	
E		1				_		
	B1	VINYL	TARKETT		BURGUNDY 85	4" COVE		
	B2	VINYL	TARKETT			4" COVE	MATCH EXISTING	
	RB	RESINOUS EPOXY	SHERWIN WILLIAMS	RESUFLOR DECO QUARTZ	MORNING FOG BC23	5" COVE		
OOR MATERIALS		!		<u> </u>	<u> </u>	-		
1	C1a	CARPET TILE	TARKETT	CRAYON 01957	FIREFLIES 48006	24" X 24"	INSTALL: MONOLITHIC	
	C1b	CARPET TILE	MANNINGTON	ALL STAR — GAMETIME III	ROBINSON (ROBI)	24" X 24"	INSTALL: MONOLITHIC	
C2	C2a	CARPET TILE	TARKETT	AFTERMATH II 03026	FIREWORKS 23514	24" X 24"	INSTALL: VERTICAL ASHLAR	
(	C2b	CARPET TILE	MANNINGTON	ALL STAR — HALFTIME	ROBINSON (ROBI)	24" X 24"	INSTALL: MONOLITHIC	
(3 <b>–</b>	C3a	CARPET TILE	TARKETT	APPLAUSE III 02803	FOOTHILL 28521	24" X 24"	INSTALL: MONOLITHIC	GIBRALTA
	C3b	CARPET TILE	MANNINGTON	GOOGIE – PHENOMENA	HELMETRON 13634	24" X 24"	INSTALL: VERTICAL ASHLAR	GIBRALIA
C4 <b>—</b>	C4a C4b	WALK OFF CARPET TILE WALK OFF CARPET TILE	TARKETT &	ASSERTIVE ACTION 04837 FORCE	CHROMIUM 26201 } KINETIC 11360	24" X 24" 18" X 36"	INSTALL: QUARTER TURN INSTALL: HORIZONTAL BRICK ASHLAR	DESIGN
	C4D	WALK OIT CARFET TILL	WANTINGTON	TORGE	KINETIC 11300	18 × 30	INSTALL. HUNIZONTAL BINGN ASTILAN	ARCHITECTURE ● ENGINEERING ● INTERIOR DESIGN
1) (74	LVT1a	LUXURY VINYL TILE	TARKETT	CONTOUR	COLOR POP SAND DOLLAR PCOP C147	18" X 18"	INSTALL: VERTICAL ASHLAR	
I V I I	LVT1b	LUXURY VINYL TILE	MANNINGTON	ACTIVE LINES - GRID	ZING CHAROAL 207	18" X 18"	NON-BEVELED EDGE. INSTALL: BLOCKED	
LVIZ <b>—</b>	LVT2a	LUXURY VINYL TILE	TARKETT	CONTOUR	COLOR POP SEA SALT PCOP C145	18" X 18"	INSTALL: VERTICAL ASHLAR	
L	LVT2b	LUXURY VINYL TILE	MANNINGTON	ACTIVE LINES - CRISSCROSS	FLASH 101	18" X 18"	NON-BEVELED EDGE. INSTALL: BLOCKED	
1 1 1 3 -	LVT3a	LUXURY VINYL TILE	TARKETT	CONTOUR	COLOR POP MALT PCOP C146	18" X 18"	INSTALL: VERTICAL ASHLAR	PROJECT PROJECT
<u>l</u> l	LVT3b	LUXURY VINYL TILE	MANNINGTON	ACTIVE LINES — GRID	ZING 201	18" X 18"	NON-BEVELED EDGE. INSTALL: BLOCKED	
	RF	RESINOUS EPOXY	SHERWIN WILLIAMS	RESUFLOR DECO QUARTZ	MORNING FOG BC23			JACKSON
	SC	SEALED CONCRETE			——			
								ELEMENTARY
WALL MATERIALS								
	P1	PAINT	SHERWIN WILLIAMS		REPOSE GRAY SW 7015			SCHOOL -
	P2	PAINT	SHERWIN WILLIAMS		ACIER SW 9170			
	P3	PAINT	SHERWIN WILLIAMS		GAUNTLET GRAY SW 7019			RENOVATIONS
	<u>P4</u>	PAINT	SHERWIN WILLIAMS		TAUPE TONE SW 7633			
	P5 P6	PAINT PAINT	SHERWIN WILLIAMS SHERWIN WILLIAMS		CUSTOM TO MATCH EXISTING CUSTOM COLOR	 	* SEE NOTE 1	
	P7	PAINT	SHERWIN WILLIAMS		HIGH REFLECTIVE WHITE SW 7757		SEE NOTE 1	
ſ	P8	PAINT	SHERWIN WILLIAMS		URBANE BRONZE SW 7048			DUNELAND SCHOOL CORPORATI
F	P9	PAINT	SHERWIN WILLIAMS		CUSTOM COLOR		* SEE NOTE 2	CHESTERTON, INDIANA
	W1	WALLCOATING	SHERWIN WILLIAMS		REPOSE GRAY SW 7015			
	W2	NOT USED	CHEDWIN WILLIAMS		OALINITI ET ODAY CW7040			
	W3 W4	WALLCOATING WALLCOATING	SHERWIN WILLIAMS SHERWIN WILLIAMS		GAUNTLET GRAY SW7019 TAUPE TONE SW 7633	<u> </u>		
	W5	NOT USED	STILITWIN WILLIAMS		TAUFE TONE SW 7000			
	W6	WALLCOATING	SHERWIN WILLIAMS		CUSTOM COLOR		* SEE NOTE 1	
1	W7	WALLCOATING	SHERWIN WILLIAMS		HIGH REFLECTIVE WHITE SW 7757			
	WT1	CERAMIC WALL TILE	AMERICAN OLEAN	COLOR STORY	CALM 0035	6" X 6"		
	WT2	CERAMIC WALL TILE	AMERICAN OLEAN	COLOR STORY	STABLE 0055	3" X 6"		<del></del>
i	WT3 WT4	CERAMIC WALL TILE CERAMIC WALL TILE	AMERICAN OLEAN  AMERICAN OLEAN	COLOR STORY COLOR STORY	STORM GRAY 0040 PASSION 0019	3" X 6" 3" X 6"		<del></del>
<u>_</u>	vv 1 <del>' †</del>	OLIVAIVIIO WALL TILE	AWLINICAN OLEAN	OULUN STURT	I YOOLON OOTA	J A 0		<del></del>
ASEWORK AND MI	ILLWORK	•			•		•	
	PL1	PLASTIC LAMINATE	PIONITE		APPEARS LTKATRE WP115	T		<del></del>
	PL2	PLASTIC LAMINATE	NEVAMAR		BLUE LUNARIA LU3001T			
	PL3	PLASTIC LAMINATE	WILSONART		5TH AVEELM 7966K-12			
	PL4	PLASTIC LAMINATE	NEVAMAR		VOUS TEMPEST VS6002-T			
F	PL5	PLASTIC LAMINATE	NEVAMAR		WINTER GRRAY MATRIX MR6005T			
		00110 0115 = 1 = 1			T. W. D. 50.			
<b>!</b> ?	SS1	SOLID SURFACE	WILSONART		TUMBLED STONE 9220CE			
	SS2	SOLID SURFACE	WILSONART		WHITE STONE 9208CS	<b>-</b>		
S	SS3	SOLID SURFACE	WILSONART		BEIGE TRAVERTINE 9236SS			
S		l	I	<u> </u>	1	1	1	
		WINDOW ROLLER SHADE	MECHO		T	T	Ī	<del> </del>
// SCELLANEOUS	RS1							
/IISCELLANEOUS	RS1 CG1	CORNER GUARD	l	•	<u> </u>			<del></del>
/IISCELLANEOUS	RS1 CG1 L1	CORNER GUARD LOCKERS	LYON		TAUPE GY835-3N			1
MISCELLANEOUS  F				 ORANGE PEEL TEXTURE	TAUPE GY835-3N SHALE	 		
MISCELLANEOUS  F	CG1 L1	LOCKERS	LYON					
/IISCELLANEOUS  F  C  L	CG1 L1 TP1 PC	LOCKERS TOILET PARTITION PRIVACY CURTAIN	LYON HINDY HIDERS MAHARAM	ORANGE PEEL TEXTURE	SHALE			
ISCELLANEOUS  F  C  L	CG1 L1 TP1	LOCKERS TOILET PARTITION	LYON HINDY HIDERS	ORANGE PEEL TEXTURE	SHALE			

## ETR = EXISTING TO REMAIN

NOTE 1 SHERWIN WILLIAMS 062018 DUNELAND'S MAROON — CUSTOM MANUAL MATCH INTERIOR SUPER PAINT SEMI GLOSS LATEX IFC 8012NP

CCE\*COLORANT 0Z 32 64 128 W1-WHITE - 10 1 1 L1-BLUE - 58 1 -R2-MAROON - 38 1 1 R3-MAGENTA 6 20 - -

NOTE 2 SHERWIN WILLIAMS 703287 DUNELAND'S GOLD — CUSTOM MANUAL MATCH INTERIOR SUPER PAINT EG—SHEL ACRYLIC LATEX IFC 8012NP

CCE\*COLORANT OZ 32 64 128 W1-WHITE 2 22 - 1 R4-NEW RED - 14 1 1 Y1-YELLOW 8 27 - 1

NOTE 3 IT IS INTENDED THAT FLOORING (CARPET AND LVT) WITH MULTIPLE MANUFACTURE OPTIONS, SHOULD BE BID AS "A" OR "B" PACKAGE ONLY.

GIBRALTAR DESIGN 9102 N. Meridian St., Ste. 300 Indianapolis, IN 46260
Homepage www.GibraltarDesign.com
Email info@GibraltarDesign.com
Phone 317.580.5777 Fax 317.580.5778

PROJECT 10/31/22 coordinated by MMM DRAWN BY

CLN CHECKED BY NAS COPYRIGHT NOTICE:

19600171 STATE OF

THE CONCEPTS, DESIGNS, PLANS, DETAILS, ETC, SHOWN ON THIS DOCUMENT ARE THE PROPERTY OF GIBRALTAR DESIGN AND WERE CREATED FOR USE ON THIS SPECIFIC PROJECT. NONE OF THIS INFORMATION SHALL BE USED BY ANY PERSON OR FIRM FOR ANY PURPOSE WITHOUT THE EXPRESS WRITTEN CONSENT OF GIBRALTAR DESIGN. THE OWNER MAY RETAIN COPIES FOR INFORMATION AND REFERENCE IN CONNECTION ONLY WITH THIS PROJECT.


MARK DATE ISSUED FOR AD-1 11/09/22 ADDENDUM NO. 1

FINISH LEGEND

PROJECT


JACKSON ES - RENOVATIONS

A-820

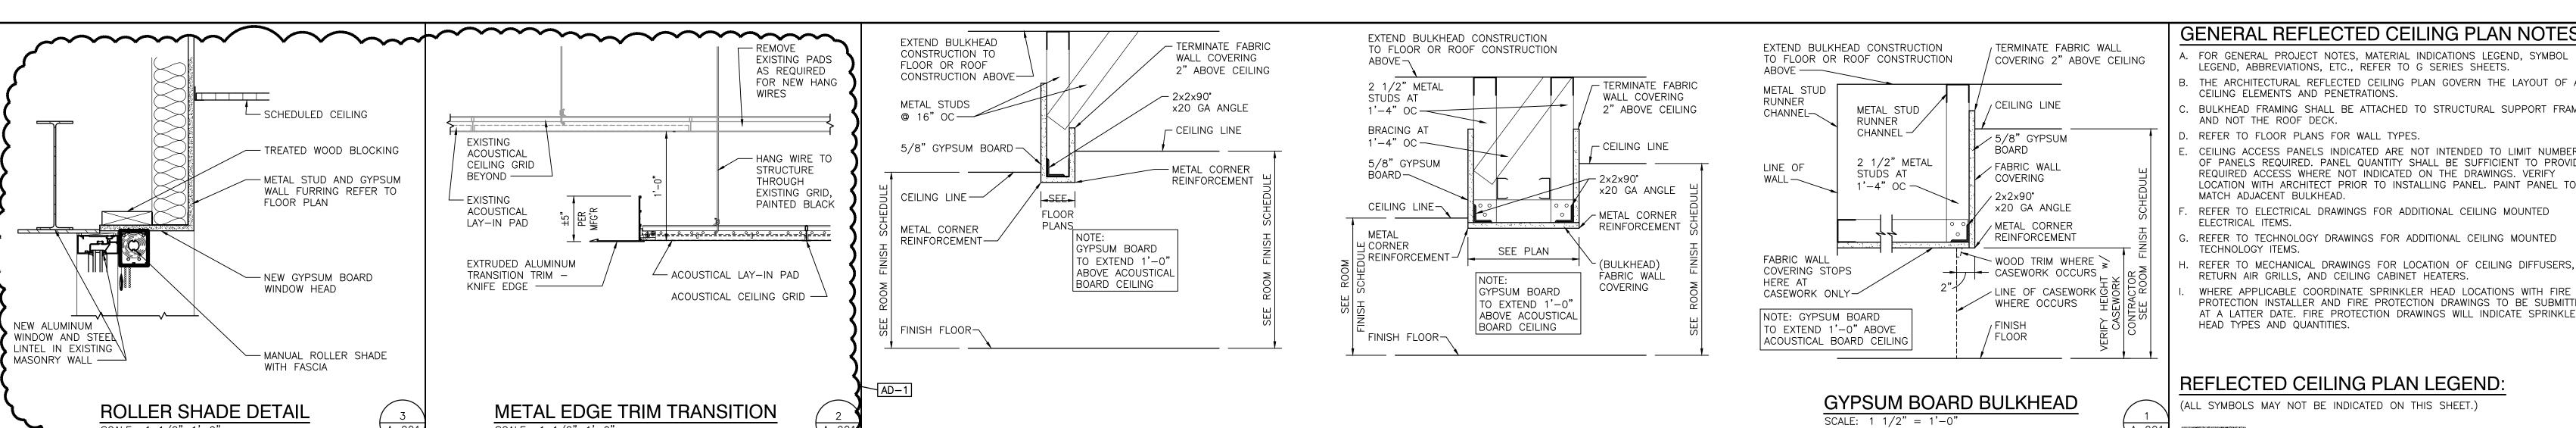

SCALE: 1 1/2 = 1 -0


- 3:15 PM — LAST SAVED BY:JC : — JACKSON ES ADDITIONS ANI AWINGS\05 ARCH\A—901.DWG

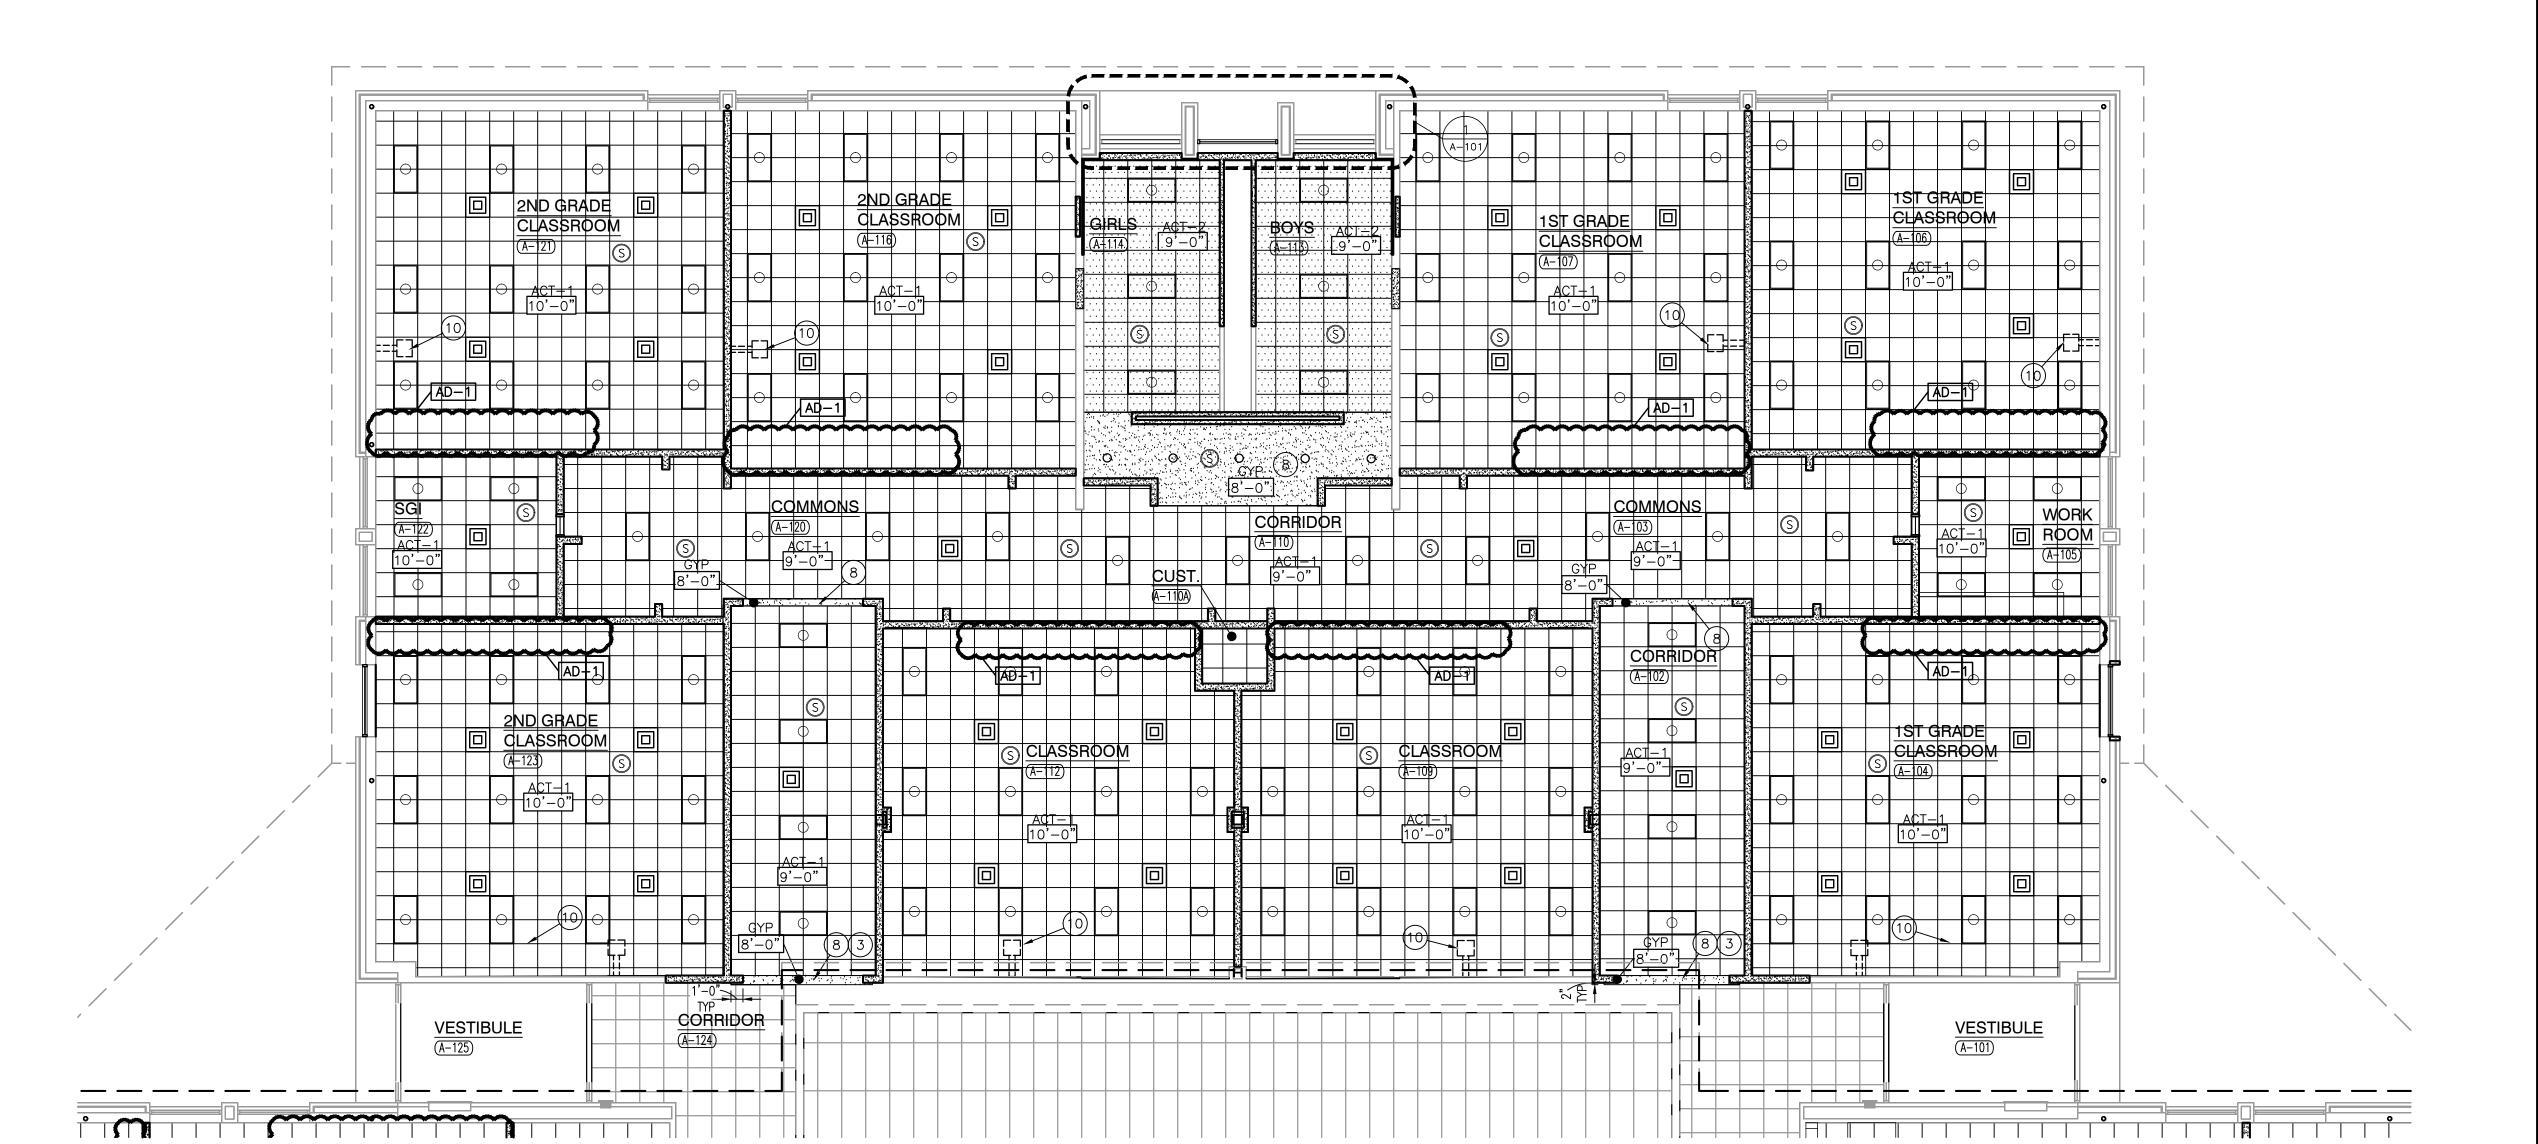



- FOR GENERAL PROJECT NOTES, MATERIAL INDICATIONS LEGEND, SYMBOL LEGEND, ABBREVIATIONS, ETC., REFER TO G SERIES SHEETS.
- . THE ARCHITECTURAL REFLECTED CEILING PLAN GOVERN THE LAYOUT OF ALL CEILING ELEMENTS AND PENETRATIONS.
- . BULKHEAD FRAMING SHALL BE ATTACHED TO STRUCTURAL SUPPORT FRAMING AND NOT THE ROOF DECK. REFER TO FLOOR PLANS FOR WALL TYPES.
- CEILING ACCESS PANELS INDICATED ARE NOT INTENDED TO LIMIT NUMBER OF PANELS REQUIRED. PANEL QUANTITY SHALL BE SUFFICIENT TO PROVIDE REQUIRED ACCESS WHERE NOT INDICATED ON THE DRAWINGS. VERIFY LOCATION WITH ARCHITECT PRIOR TO INSTALLING PANEL. PAINT PANEL TO MATCH ADJACENT BULKHEAD.
- REFER TO ELECTRICAL DRAWINGS FOR ADDITIONAL CEILING MOUNTED
- ELECTRICAL ITEMS. REFER TO TECHNOLOGY DRAWINGS FOR ADDITIONAL CEILING MOUNTED TECHNOLOGY ITEMS.
- RETURN AIR GRILLS, AND CEILING CABINET HEATERS. WHERE APPLICABLE COORDINATE SPRINKLER HEAD LOCATIONS WITH FIRE PROTECTION INSTALLER AND FIRE PROTECTION DRAWINGS TO BE SUBMITTED AT A LATTER DATE. FIRE PROTECTION DRAWINGS WILL INDICATE SPRINKLER HEAD TYPES AND QUANTITIES.

### REFLECTED CEILING PLAN LEGEND: (ALL SYMBOLS MAY NOT BE INDICATED ON THIS SHEET.)

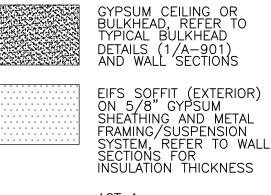

 $\sqrt{A-901}$ 

2'-0" x 2'-0" ACOUSTICAL BOARD CEILING SEE PLANS AND FINISH LEGEND FOR TYPE ACT 2 VINYL FACED CEILING 2'-0" x 2'-0" ACOUSTICAL BOARD CEILING

⊗I EXIT LIGHT 1x4 LIGHT FIXTURE

LINEAR LIGHT FIXTURE

SYSTEM, REFER TO WALL PENDANT LIGHT FIXTURE SECTIONS FOR PENDANT LIGHT FIXTURE

> SUPPLY AIR DIFFUSER LINEAR SUPPLY AIR DIFFUSER

> > CEILING SPEAKER

(OS) OCCUPANCY SENSOR

DUNELAND SCHOOL CORPORATION -O WALL SCONCE LIGHT FIXTURE | CHESTERTON, INDIANA

RENOVATIONS

GIBRALTAR

DESIGN

ARCHITECTURE • ENGINEERING • INTERIOR DESIGN

PROJECT

**JACKSON** 

SCHOOL -

ELEMENTARY

**REFLECTED CEILING PLAN NOTES:** (ALL PLAN NOTES MAY NOT BE INDICATED ON THIS SHEET.) O DAINT EVICTING SEILING SEIL TO SEILAND SEILING SEILI

- CEILING PADS. (3) MODIFY EXISTING GRID AND ACOUSTICAL CEILING PADS AS REQUIRED TOR INSTALLATION OF NEW BULKHEAD. (4) REMOVE, STORE, AND REINSTALL EXISTING CEILING GRID AND ACOUSTICAL CEILING PANELS AS REQUIRED FOR MECHANICAL, ELECTRICAL, AND PLUMBING WORK. REPLACE ANY GRID AND PANELS DAMAGED IN THE PROCESS WITH MATCHING GRID AND PANELS. DOCUMENT EXISTING DAMAGE
- AND REVIEW WITH ARCHITECT PRIOR TO START OF WORK. (5) TIE-IN AND EXTEND TO EXISTING CEILING GRID.

(b) LED LIGHTING TO REMAIN. 8) NEW GYPSUM BOARD BULKHEAD. (9) EXISTING CEILING SYSTEM TO REMAIN. UNLESS NOTED

OTHERWISE FOR MECHANICAL ELECTRICAL PLUMBING AND FIRE PROTECTION.

(10) PROJECTION SCREEN, REFER TO EQUIPMENT PLANS AND ELECTRICAL/TECHNOLOGY DRAWINGS. COORDINATE FINAL LOCATION WITH OWNER


# GENERAL REFLECTED CEILING PLAN FINISH NOTES:

(ALL PLAN NOTES MAY NOT BE INDICATED ON THIS SHEET.) A. UNLESS NOTED OTHERWISE, GYPSUM BOARD BULKHEADS ARE TO BE

PAINTED PX. . UNLESS NOTED OTHERWISE, ALL EXPOSE STEEL STRUCTURE, METAL DECK, MECHANICAL AND ELECTRICAL ITEMS TO BE PAINTED PX.

### REFLECTED CEILING PLAN FINISH NOTES: (ALL PLAN NOTES MAY NOT BE INDICATED ON THIS SHEET.)

- 1 PAINT EXPOSED STRUCTURE AND DECK PX.
- 2 PAINT BULKHEAD PX ON ALL EXPOSED SIDES. 3 BULKHEAD TO RECEIVE SAME PAINT AS ADJACENT WALLS, REFER TO
- FINISH PLANS AND INTERIOR ELEVATIONS. 4 BULKHEAD TO RECEIVE SAME WALL COVERING AS ADJACENT WALLS, REFER TO FINISH PLANS AND INTERIOR ELEVATIONS.

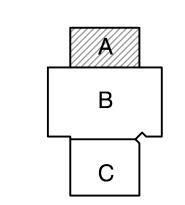

**KEY PLAN** GIBRALTAR DESIGN

9102 N. Meridian St., Ste. 300 ndianapolis, IN 46260 Homepage www.GibraltarDesign.com Email info@GibraltarDesign.com Phone 317.580.5777 Fax 317.580.5778

PROJECT COORDINATED B MMM

19600171 STATE OF DRAWN BY NOTA NAME CJA CHECKED BY

DJW COPYRIGHT NOTICE: THE CONCEPTS, DESIGNS, PLANS, DETAILS, ETC, SHOWN ON THIS DOCUMENT ARE THE PROPERTY OF GIBRALTAR DESIGN AND WERE CREATED FOR USE ON THIS SPECIFIC PROJECT. NONE OF THIS INFORMATION SHALL BE USED BY ANY PERSON OR FIRM FOR ANY PURPOSE WITHOUT THE EXPRESS WRITTEN CONSENT OF GIBRALTAR DESIGN. THE OWNER MAY RETAIN COPIES FOR INFORMATION AND REFERENCE IN CONNECTION ONLY WITH THIS PROJECT.


MARK	DATE	ISSUED FOR
AD-1	11/09/22	ADDENDUM NO. 1


UNIT "A" FIRST FLOOR REFLECTED CEILING PLAN

JACKSON ES - RENOVATIONS


A-901

UNIT "A" REFLECTED CEILING PLAN SCALE: 1/8" = 1'-0"

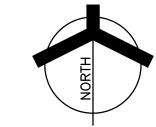

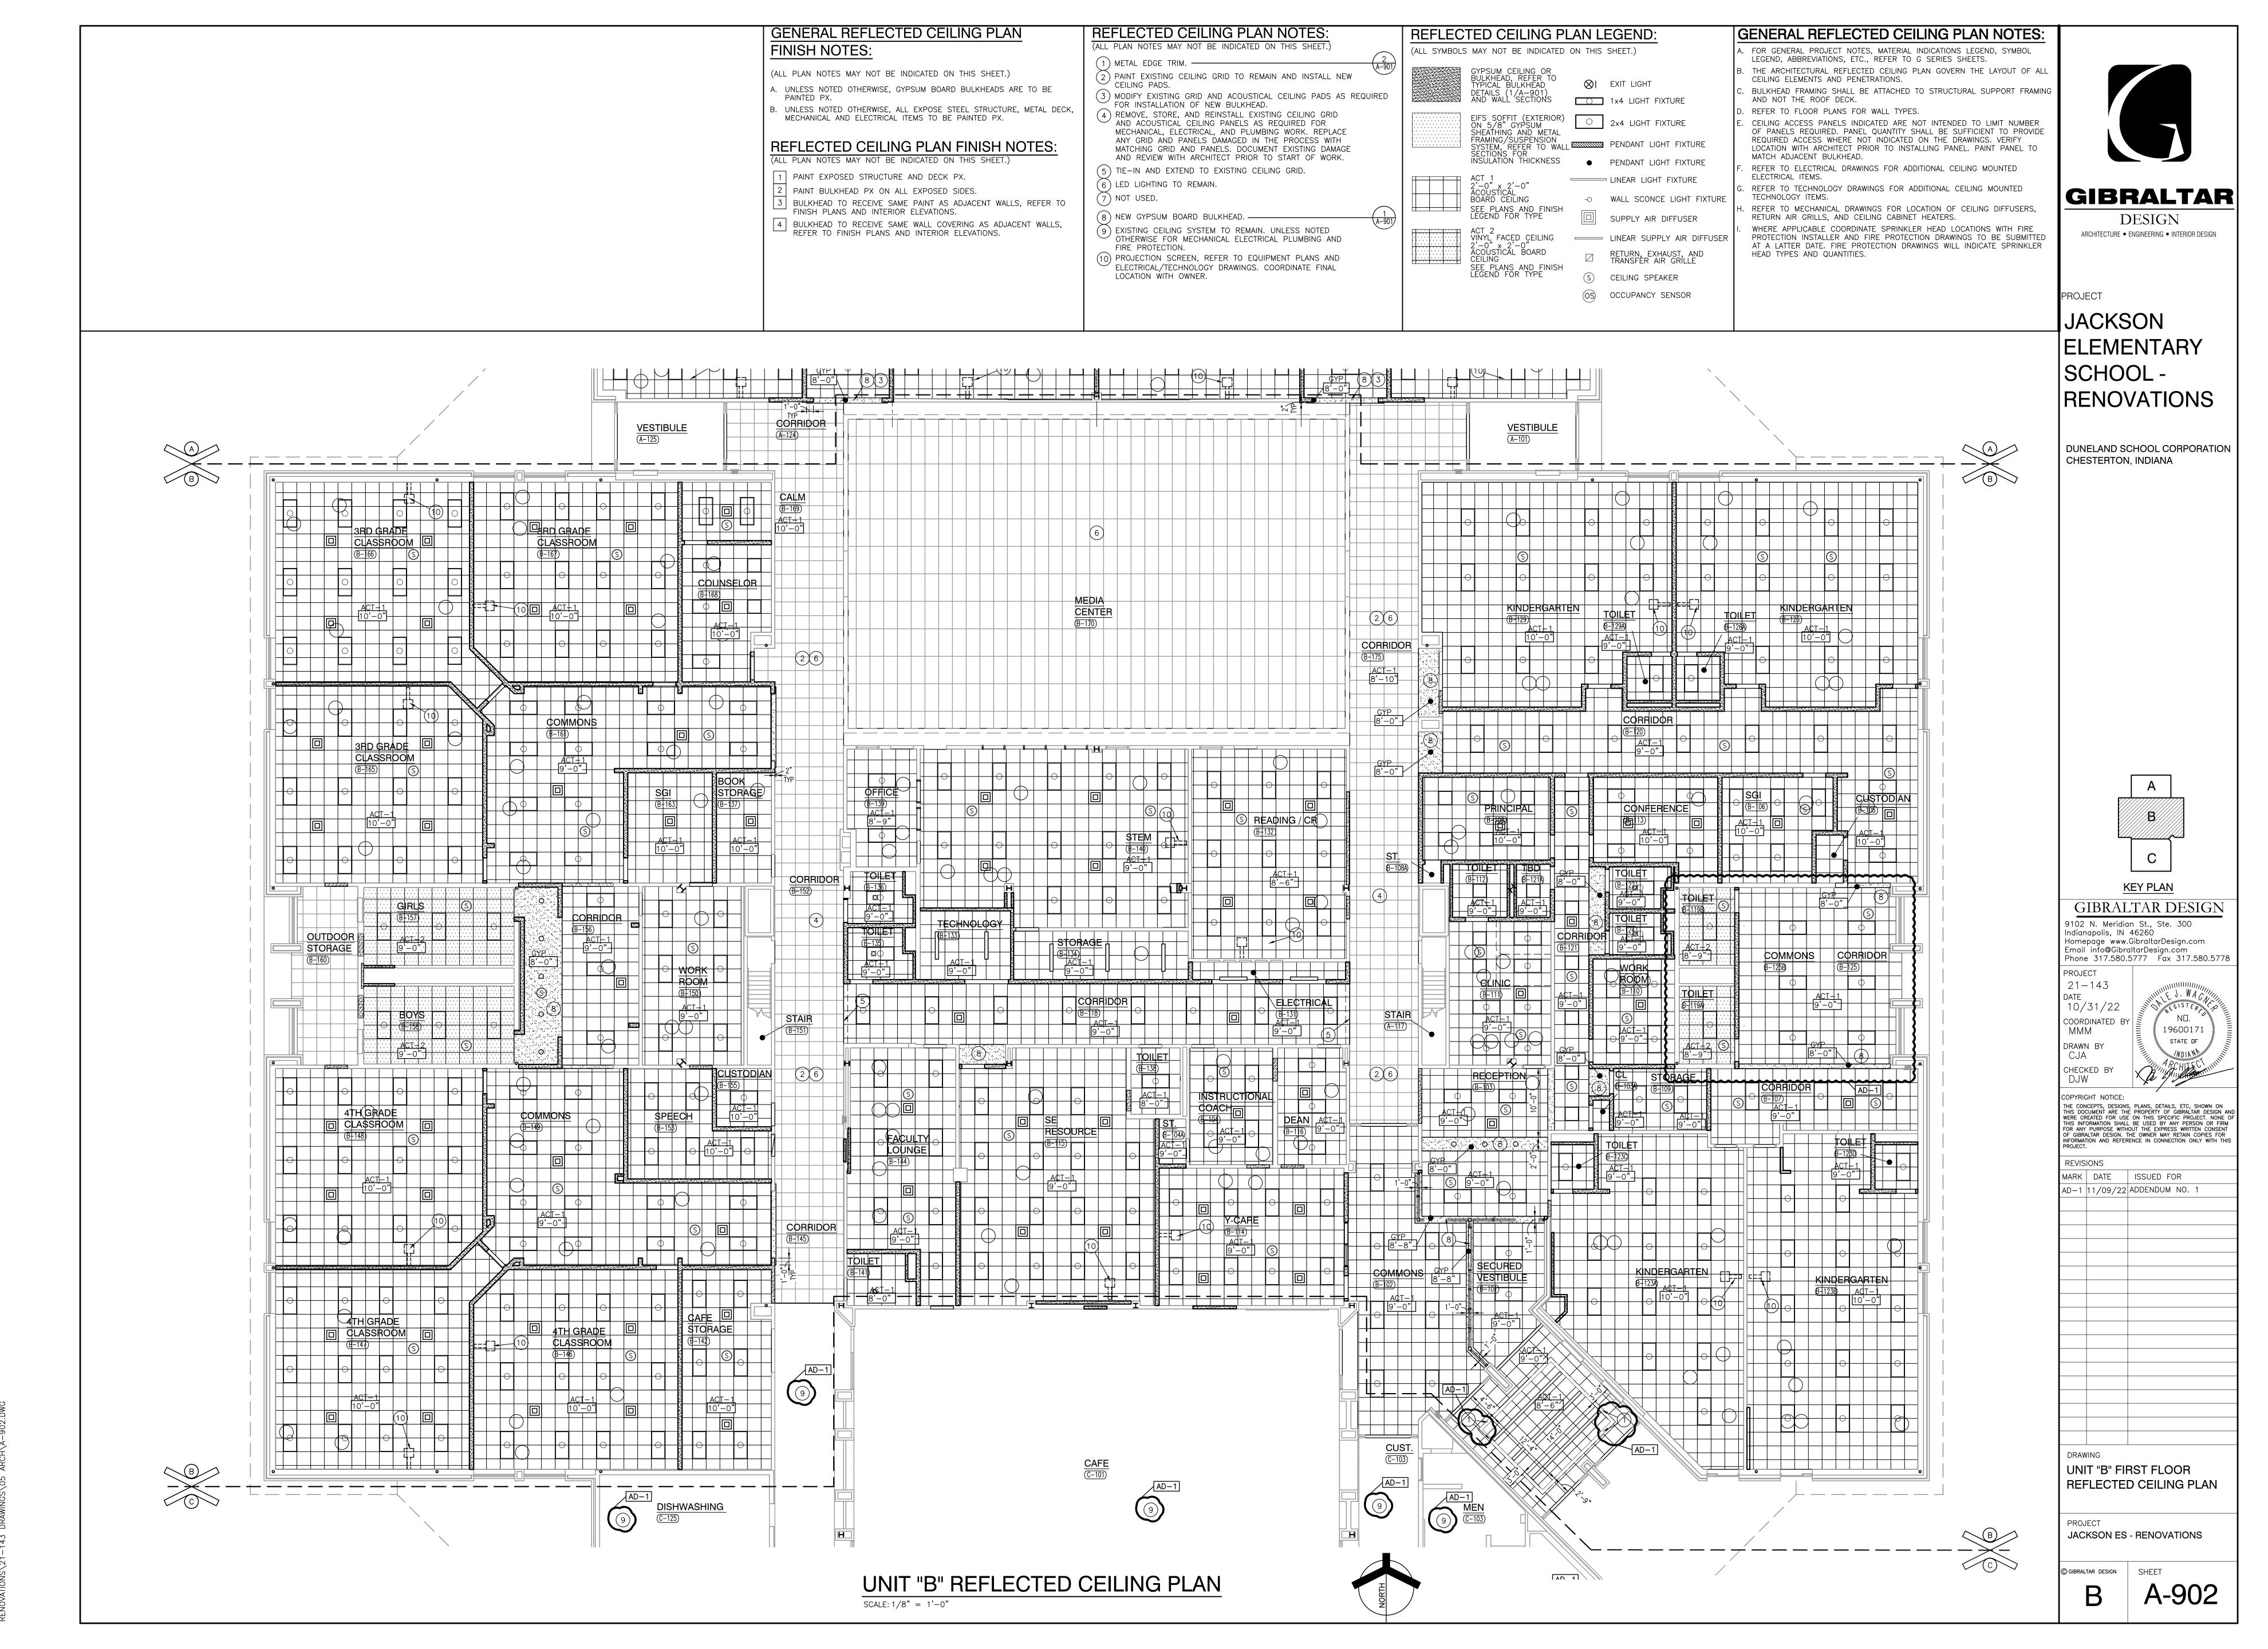

Wednesday, 11/9/2022 - 3:15 PM - LAST SAVED BY:MMINER Y:\21-143 DUNELAND SC - JACKSON ES ADDITIONS AND

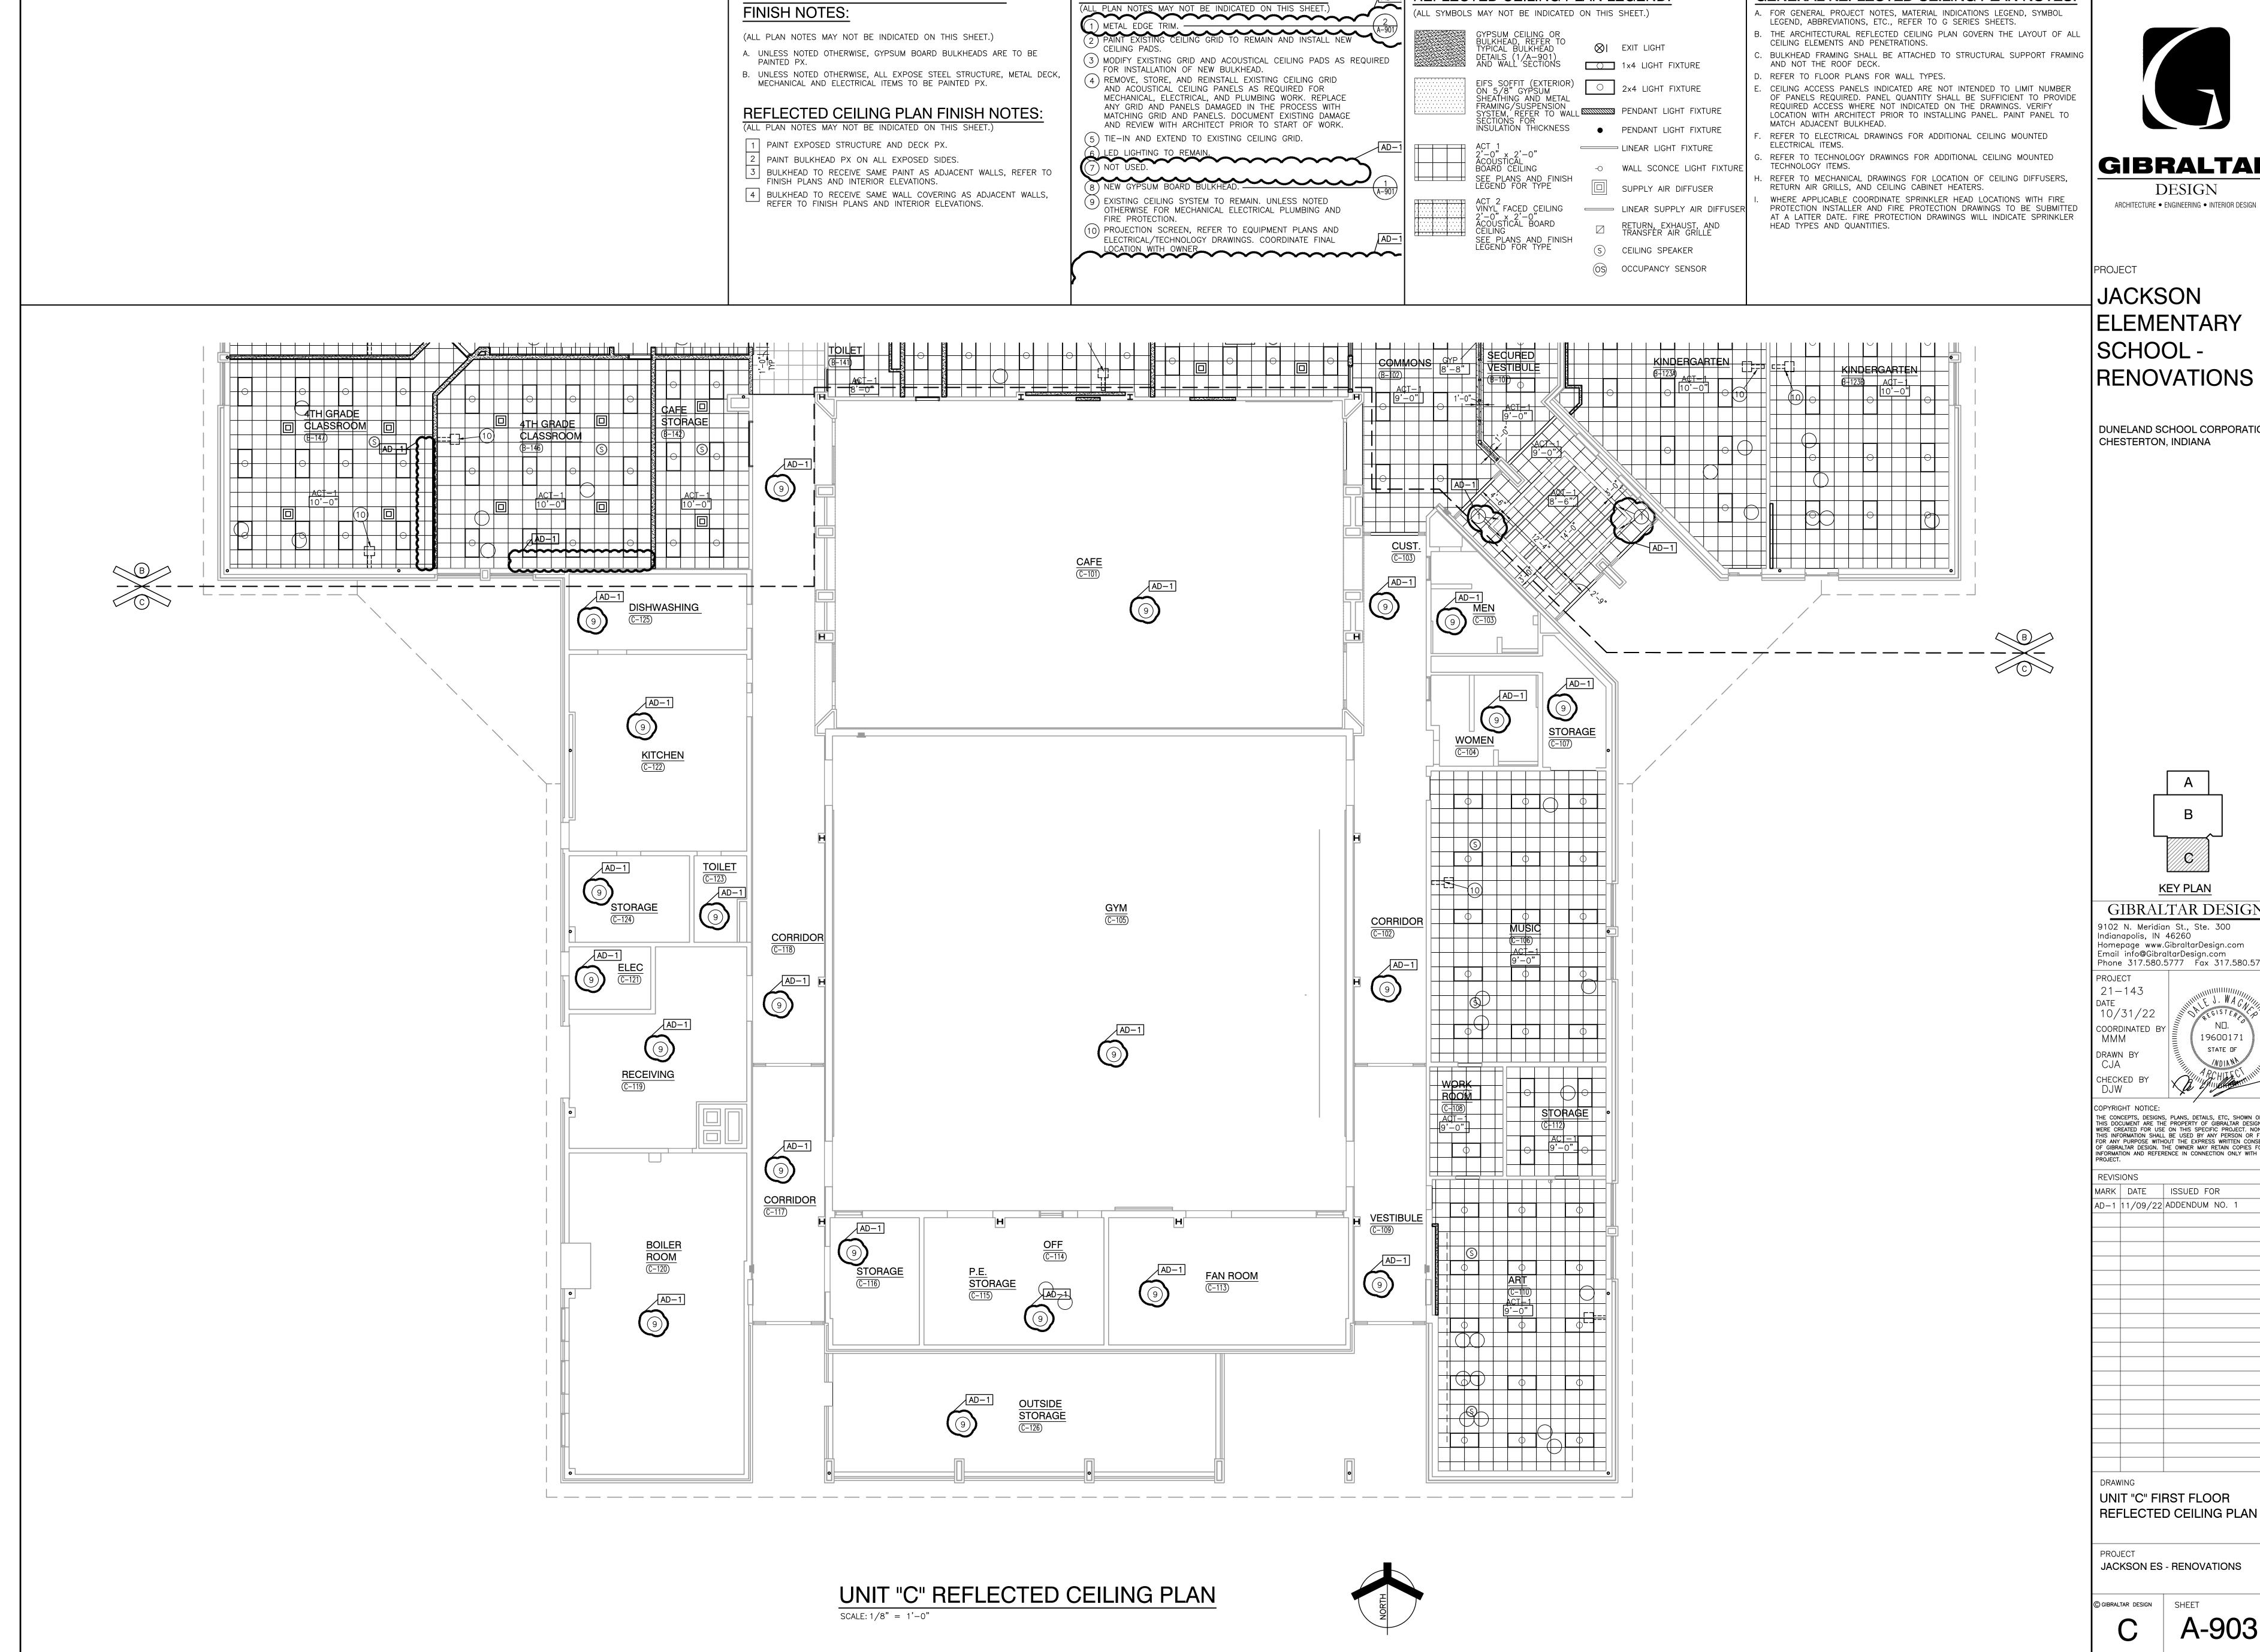

REFLECTED CEILING PLAN NOTES:

REFLECTED CEILING PLAN LEGEND:

GENERAL REFLECTED CEILING PLAN

GIBRALTAR DESIGN

GENERAL REFLECTED CEILING PLAN NOTES:

**JACKSON** ELEMENTARY SCHOOL -RENOVATIONS

DUNELAND SCHOOL CORPORATION CHESTERTON, INDIANA

KEY PLAN

GIBRALTAR DESIGN 9102 N. Meridian St., Ste. 300

Indianapolis, IN 46260
Homepage www.GibraltarDesign.com
Email info@GibraltarDesign.com
Phone 317.580.5777 Fax 317.580.5778

THE CONCEPTS, DESIGNS, PLANS, DETAILS, ETC, SHOWN ON THIS DOCUMENT ARE THE PROPERTY OF GIBRALTAR DESIGN AND WERE CREATED FOR USE ON THIS SPECIFIC PROJECT. NONE OF THIS INFORMATION SHALL BE USED BY ANY PERSON OR FIRM FOR ANY PURPOSE WITHOUT THE EXPRESS WRITTEN CONSENT OF GIBRALTAR DESIGN. THE OWNER MAY RETAIN COPIES FOR INFORMATION AND REFERENCE IN CONNECTION ONLY WITH THIS PROJECT.

MARK DATE ISSUED FOR AD-1 | 11/09/22 | ADDENDUM NO. 1

UNIT "C" FIRST FLOOR

JACKSON ES - RENOVATIONS

A-903



- REMOVE EXISTING SUPPLY AIR DIFFUSER AND ASSOCIATED SUPPLY AIR DUCTWORK COMPLETE AS REQUIRED.
- 2. REMOVE EXISTING RETURN AIR GRILLE AND ASSOCIATED RETURN AIR DUCTWORK COMPLETE AS REQUIRED.

REMOVE EXISTING EXHAUST GRILLE AND ASSOCIATED

EXHAUST DUCTWORK COMPLETE AS REQUIRED.

4. REMOVE EXISTING PROGRAMMABLE THERMOSTAT AND ASSOCIATED CONTROL WIRING COMPLETE AS REQUIRED. EXISTING SURFACE MOUNTED RACEWAY TO REMAIN FOR

NEW CONTROL WIRING INSTALLATION.

5. REMOVE EXISTING CABINET HEATER AND ASSOCIATED HOT WATER PIPING, VALVES, CONTROLS, ELECTRICAL CONNECTIONS, ETC. COMPLETE AS REQUIRED.



GIBRALTAR DESIGN




ARCHITECTURE • ENGINEERING • INTERIOR DESIGN

(219) 924-8400
www.milliesengineeringgroup
PROJECT
JACKSON

ELEMENTARY
SCHOOL RENOVATIONS

DUNELAND SCHOOL CORPORATION CHESTERTON, INDIANA

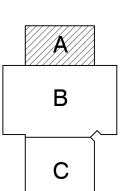

KEY PLAN

GIBRALTAR DESIGN
9102 N. Meridian St., Ste. 300
Indianapolis, IN 46260
Homepage www.GibraltarDesign.com
Email info@GibraltarDesign.com
Phone 317.580.5777 Fax 317.580.5778

Phone 317.580.5777
PROJECT
21-143
PATE
10/31/22

21-143
DATE
10/31/22
COORDINATED
JC
DRAWN BY
KS

CHECKED BY

DJ

COPYRIGHT NOTICE:

THE CONCEPTS, DESIGNS, PLANS, DETAILS, ETC, SHOWN ON THIS DOCUMENT ARE THE PROPERTY OF GIBRALTAR DESIGN AND WERE CREATED FOR USE ON THIS SPECIFIC PROJECT. NONE OF THIS INFORMATION SHALL BE USED BY ANY PERSON OR FIRM FOR ANY PURPOSE WITHOUT THE EXPRESS WRITTEN CONSENT OF GIBRALTAR DESIGN. THE OWNER MAY RETAIN COPIES FOR INFORMATION AND REFERENCE IN CONNECTION ONLY WITH THIS PROJECT

REVISIONS

MARK DATE ISSUED FOR

AD-1 11/09/22 ADDENDUM NO. 1

DRAWING


UNIT "A" MECHANICAL
FIRST FLOOR DEMOLITION
PLAN


PROJECT

JACKSON ES ADDITIONS & RENOVATIONS

Copyright © 2022 Millies Engineering Group

© GIBRALTAR DESIGN SHEET

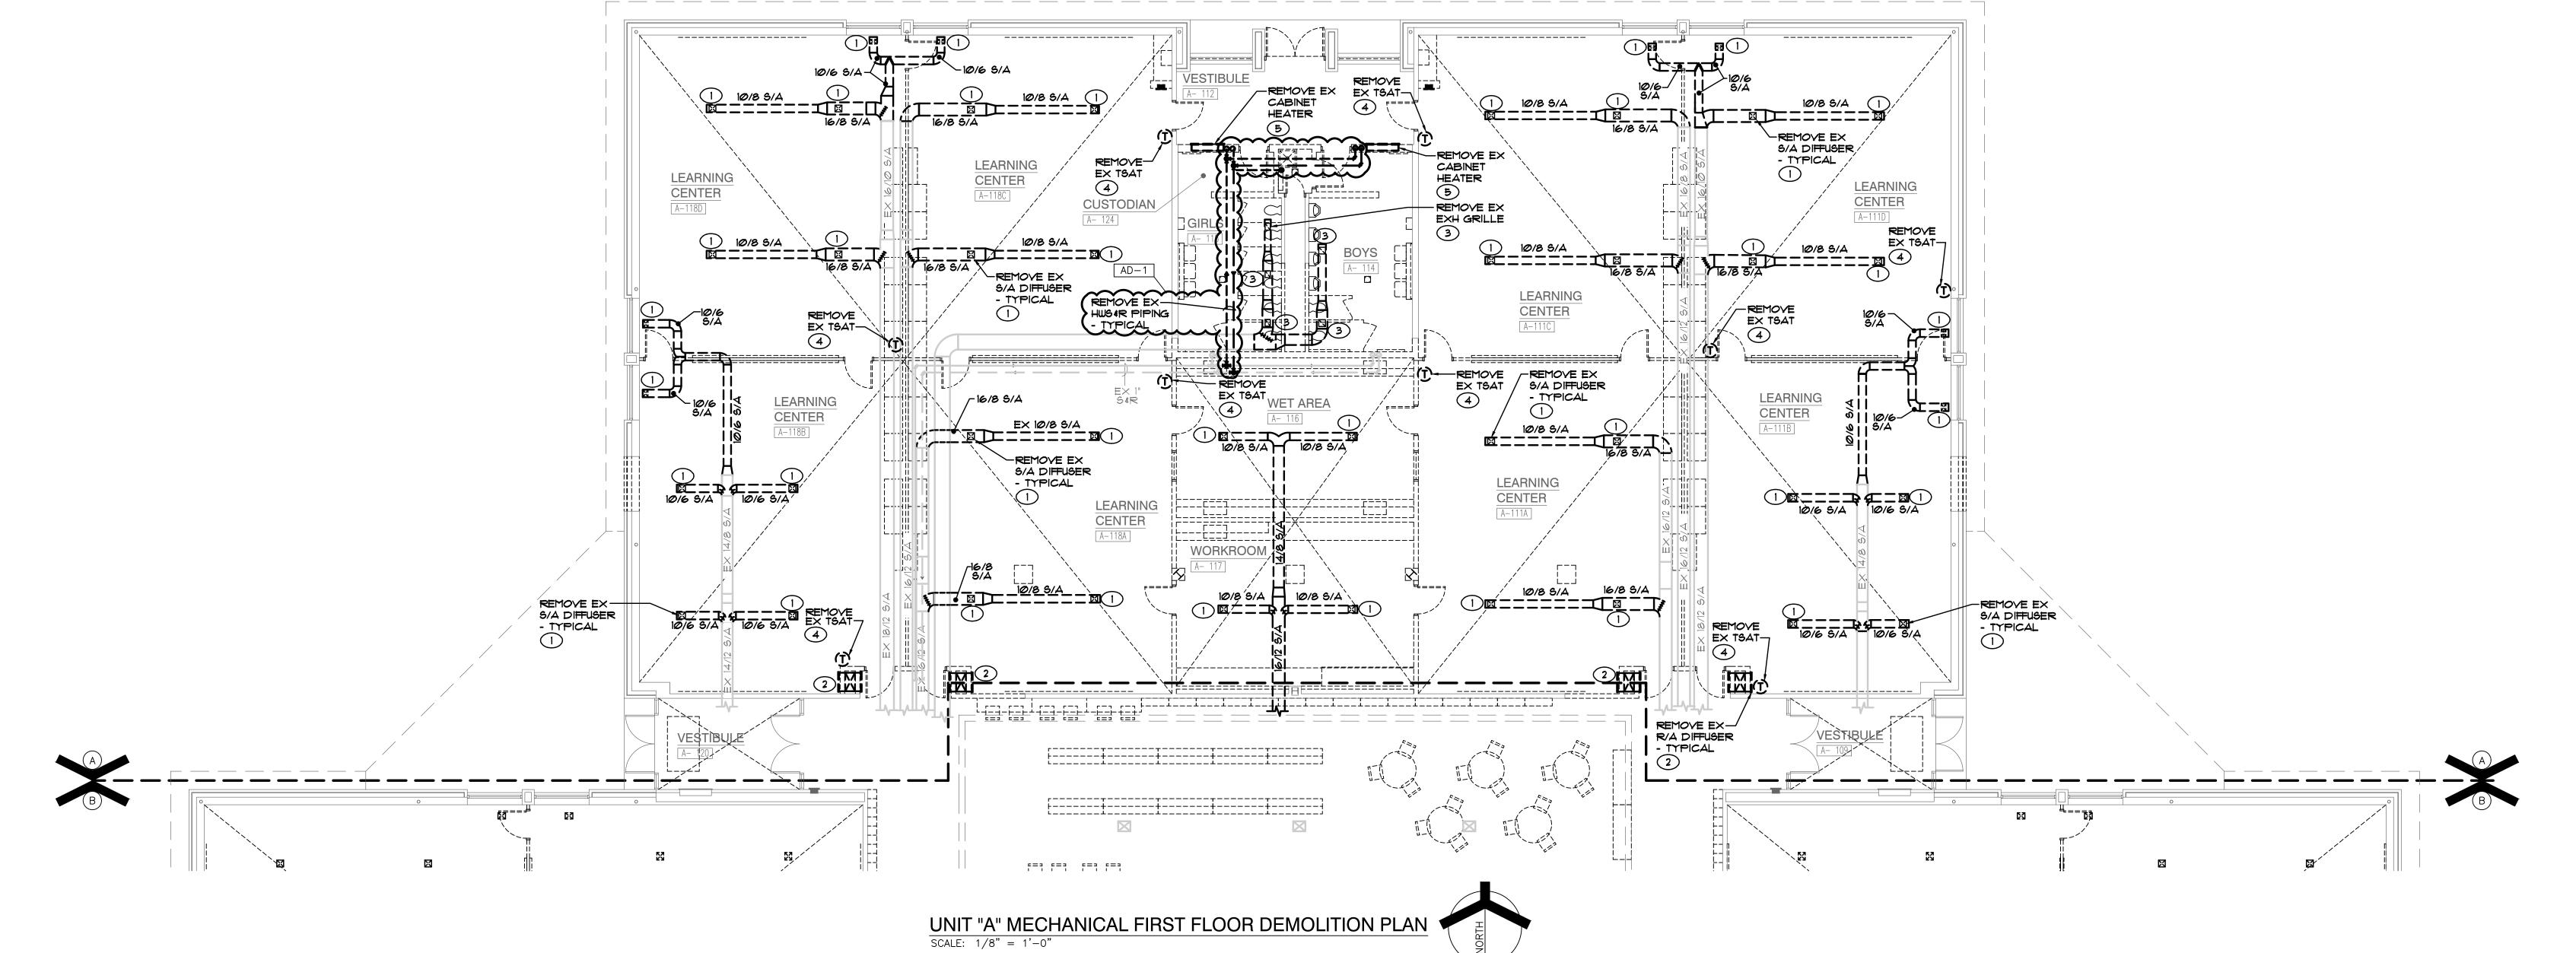

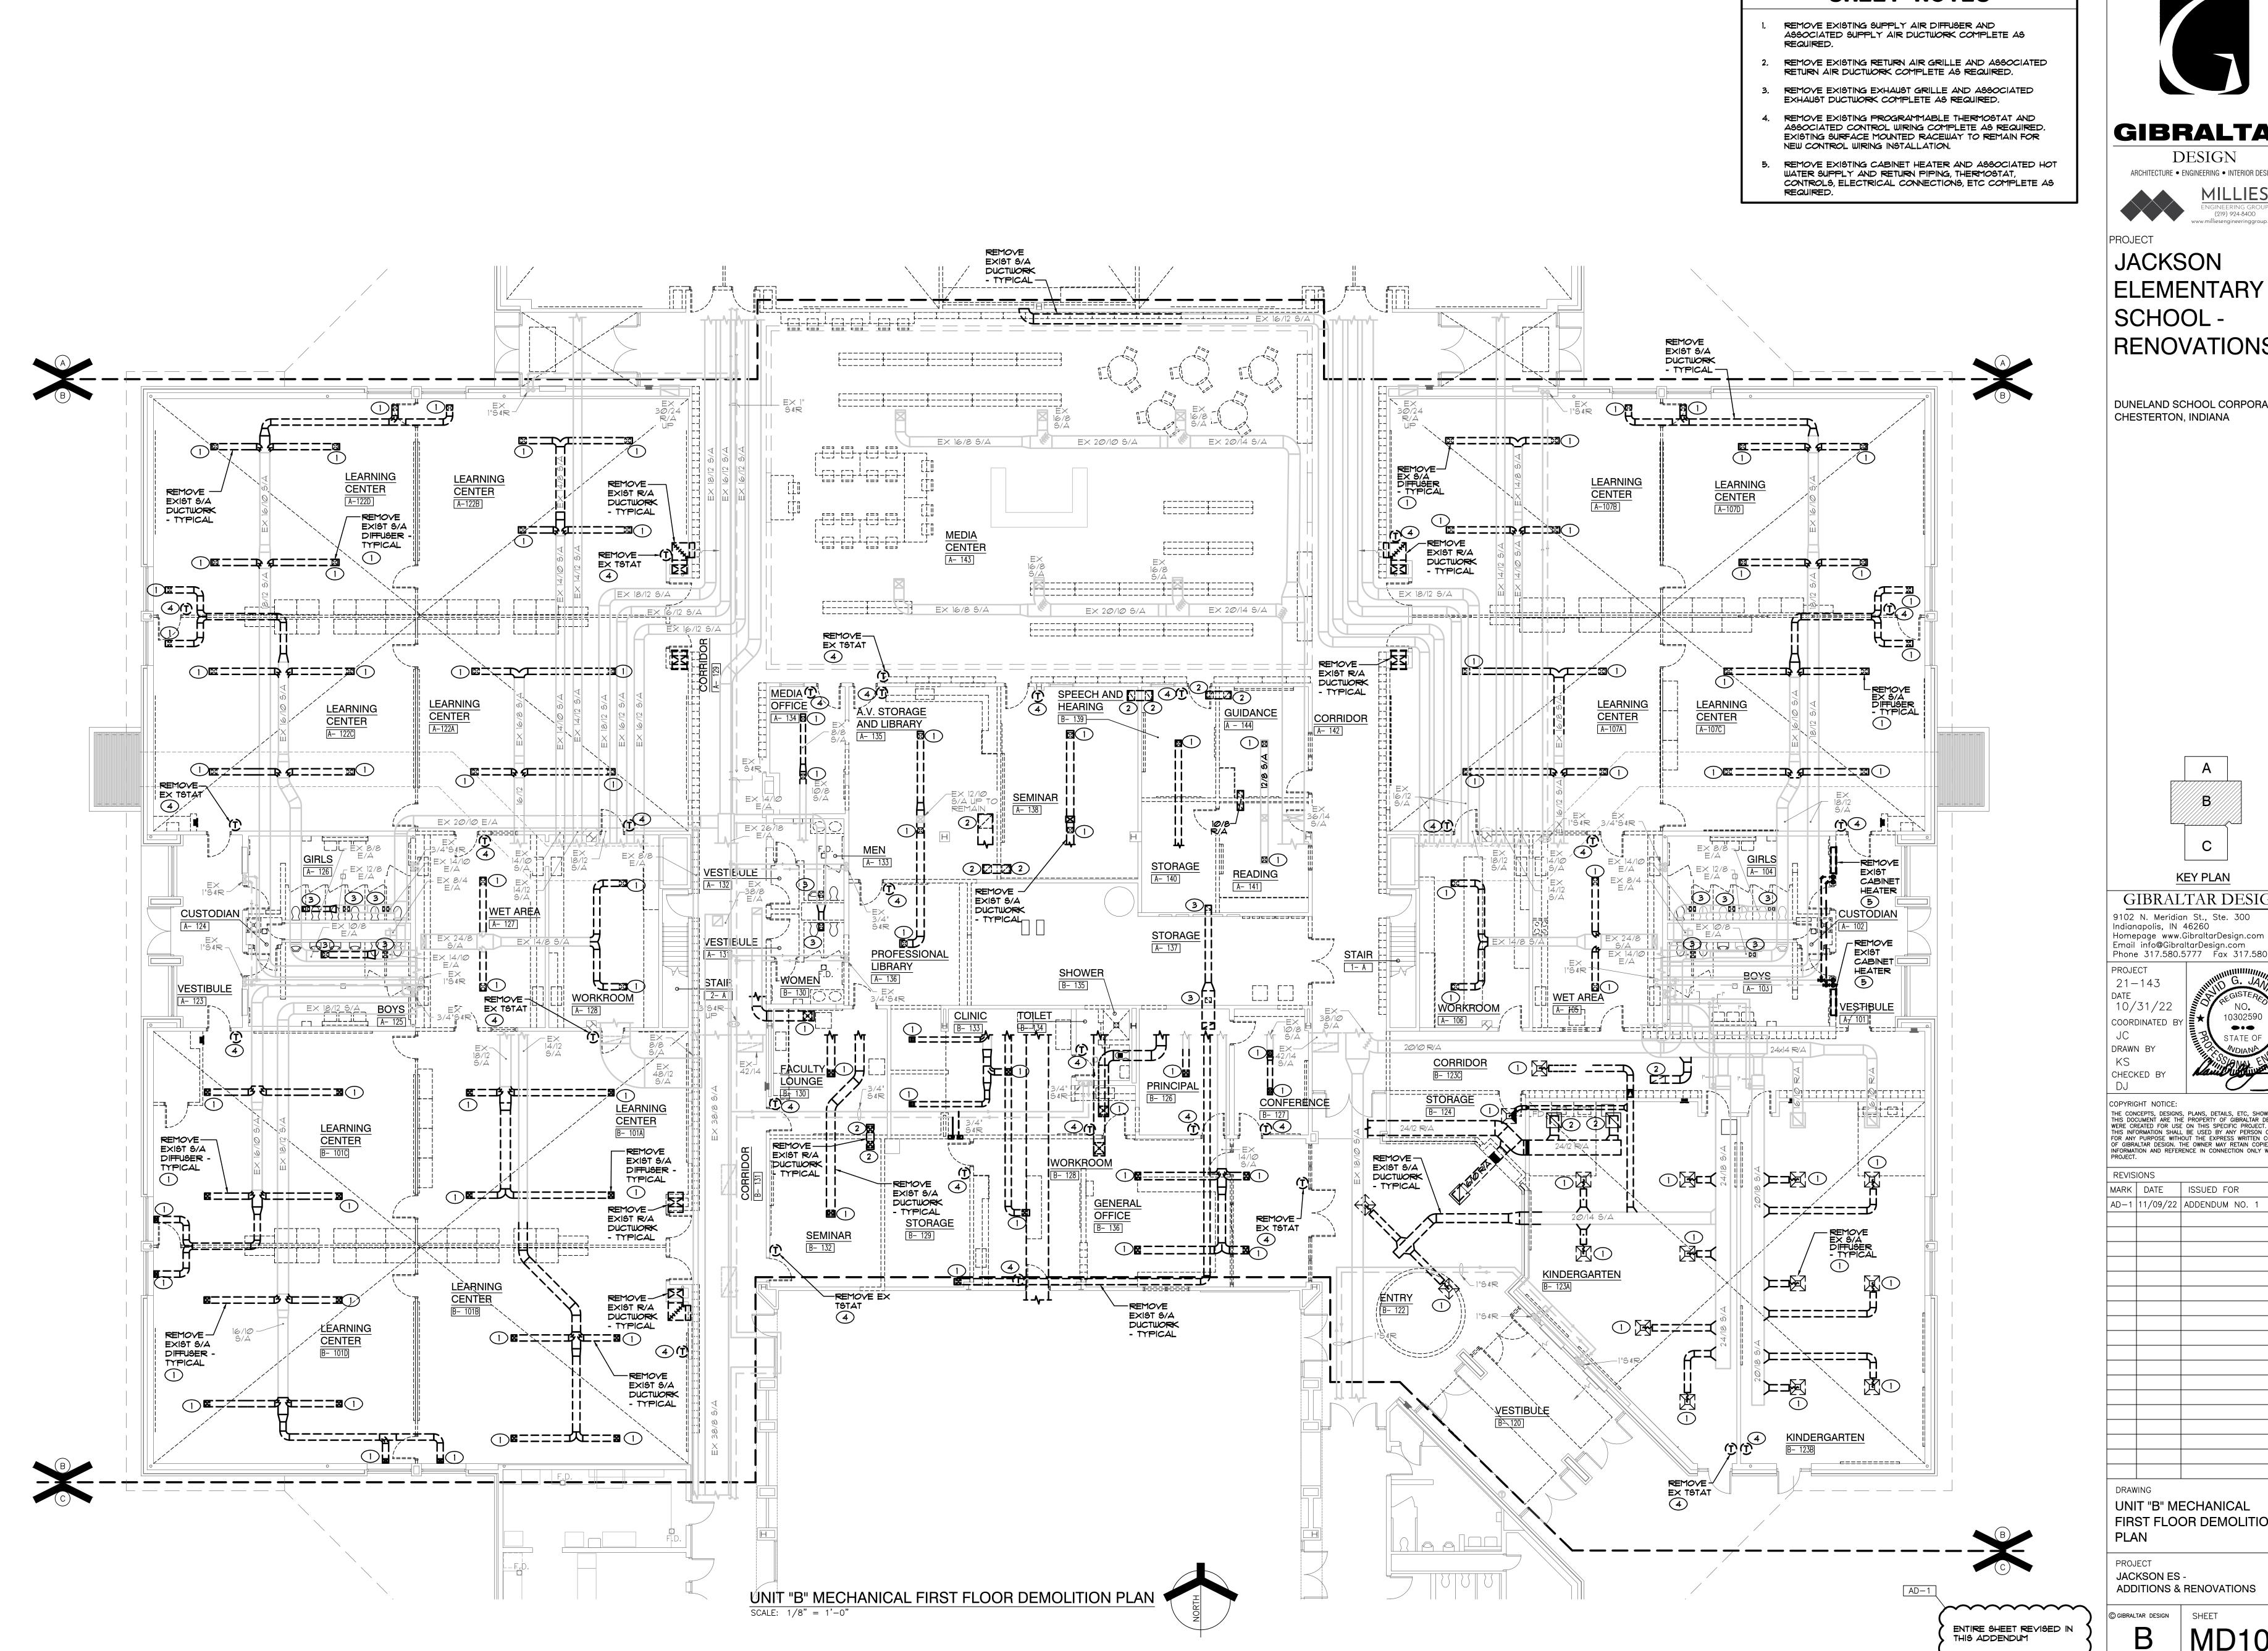




**GIBRALTAR** 

DESIGN ARCHITECTURE • ENGINEERING • INTERIOR DESIGN

**MILLIES** (219) 924-8400

**JACKSON** ELEMENTARY SCHOOL -RENOVATIONS

DUNELAND SCHOOL CORPORATION CHESTERTON, INDIANA

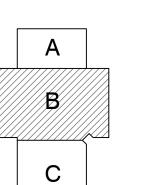

GIBRALTAR DESIGN 9102 N. Meridian St., Ste. 300


Phone 317.580.5777 Fax 317.580.5778

MARK DATE ISSUED FOR AD-1 11/09/22 ADDENDUM NO. 1

UNIT "B" MECHANICAL FIRST FLOOR DEMOLITION

**ADDITIONS & RENOVATIONS** 

MD102

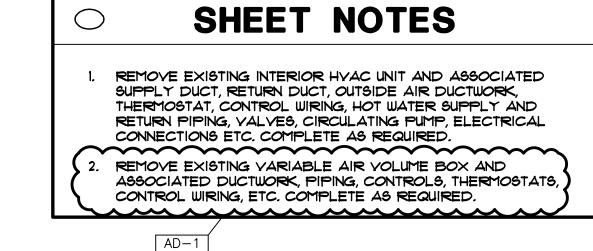

12 "×1Ø"


EX HWS &R — TO REMAIN 36 "X14"





JACKSON ELEMENTARY SCHOOL -RENOVATIONS

DUNELAND SCHOOL CORPORATION CHESTERTON, INDIANA

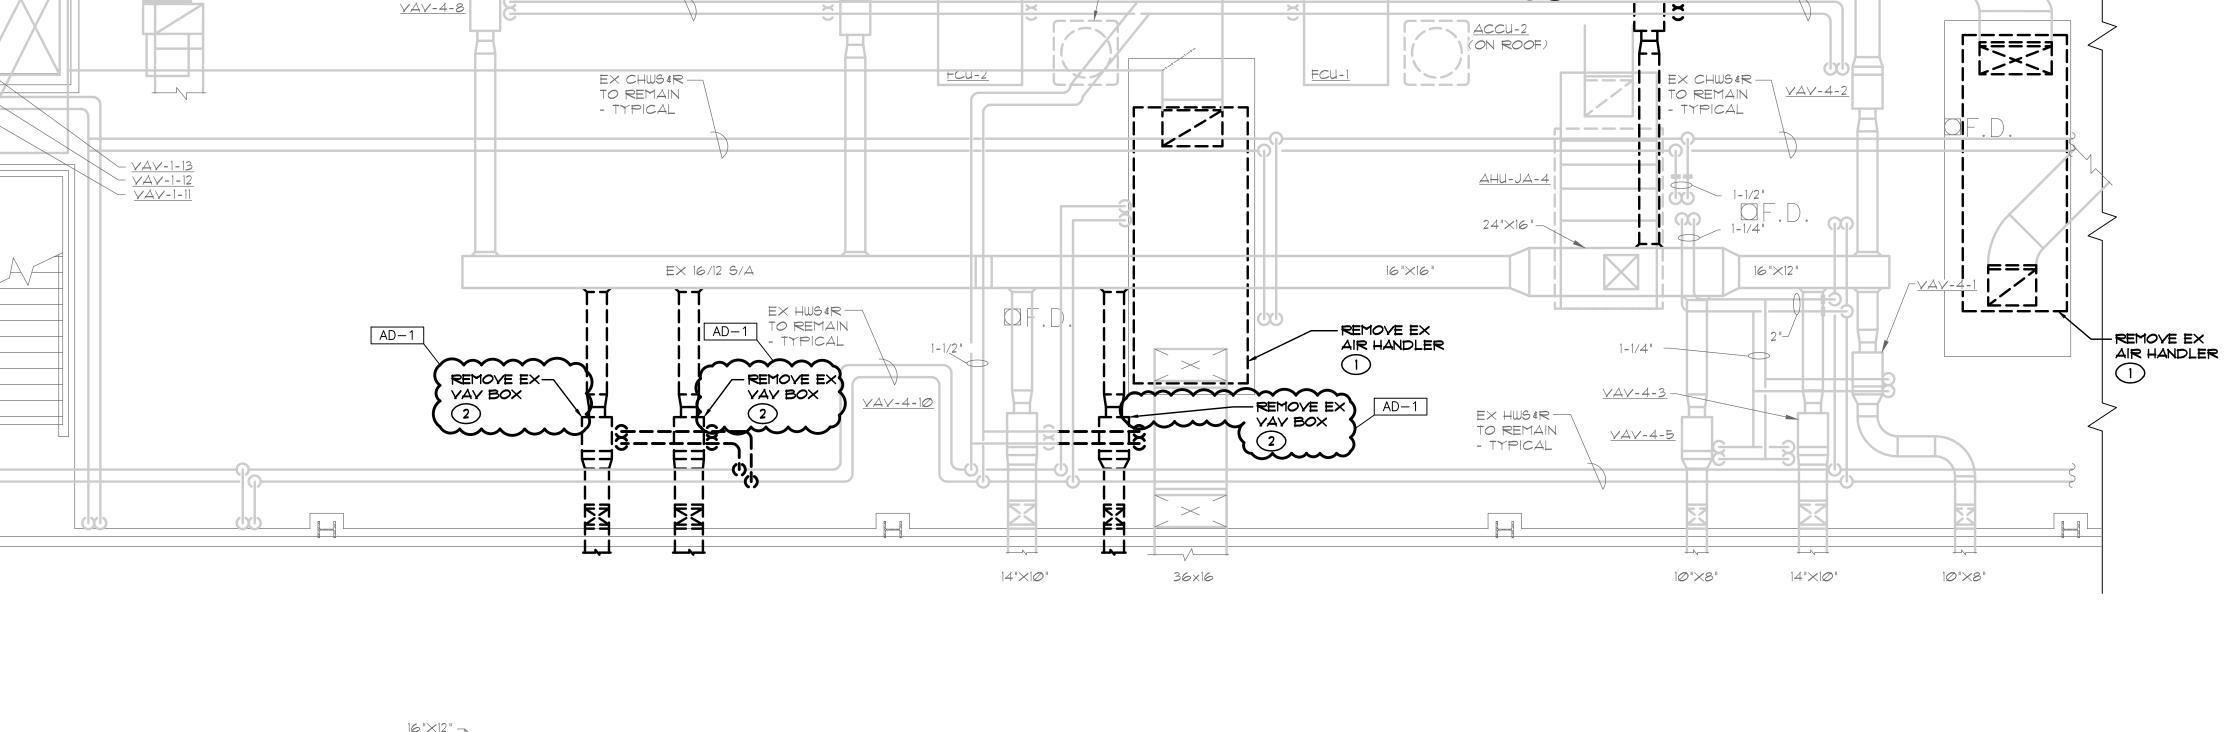

<u>ACCU-3</u> (ON ROOF) 16"×12"


REMOVE EX-VAY BOX

12 "×1Ø"

10"×8"

EX HWS&R —

TO REMAIN - TYPICAL 18"×14"

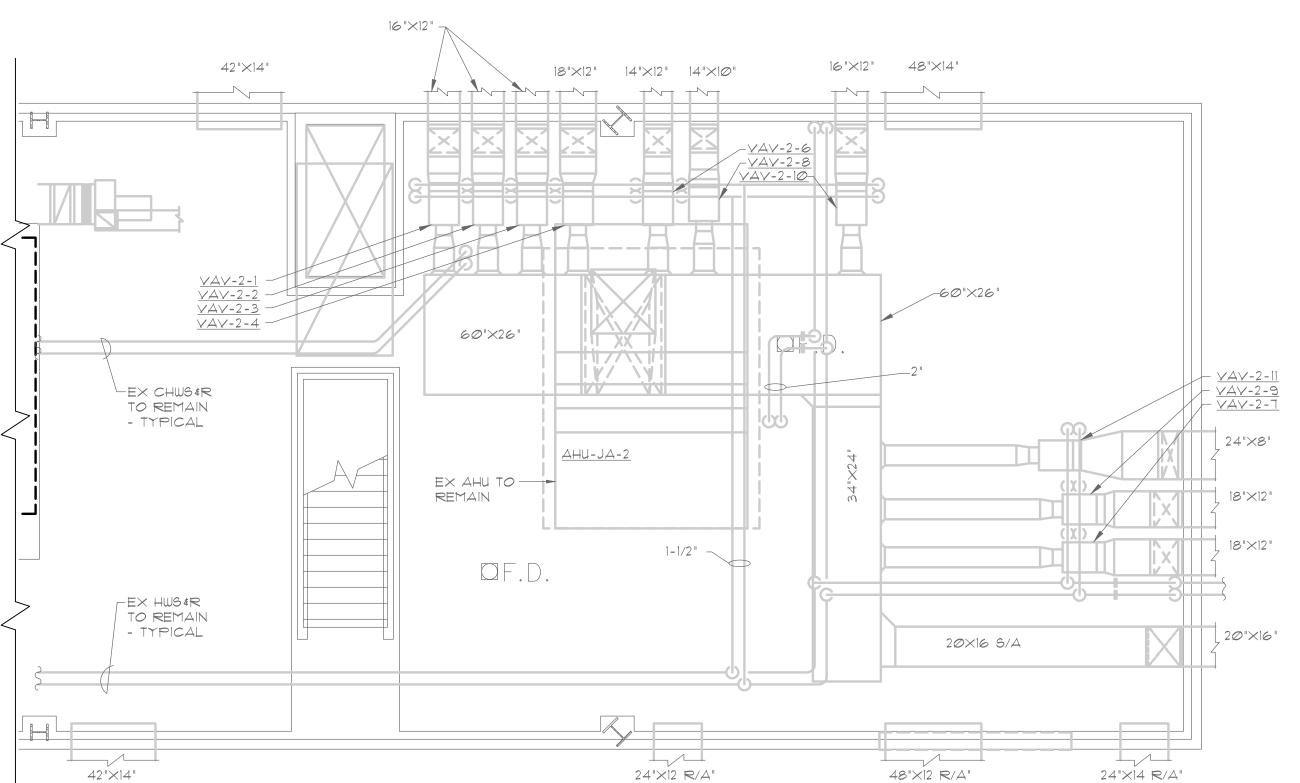

14"×10" 14"×12"

<u> AHU-JA-1</u>

1-1/2"

<u>VAV-1-9</u>

<u>VAV-1-7</u> - <u>VAV-1-2</u> -

60"×26"

- <u>VAV-1-3</u>

16"×12" 14"×12"

EX HWS&R TO REMAIN - TYPICAL

24"×8" —

<u>VAV-1-5</u> <u>VAV-1-6</u> 18"×12" 16"×12" 16"×12"

26"×20"

— EX AHU TO REMAIN

DF.D.

EX HWS&R —

TO REMAIN

- TYPICAL



MEZZANINE MECHANICAL DEMOLITION PLANS

SCALE: 1/4" = 1'-0"

THIS DOO WERE CR THIS INFO FOR ANY OF GIBRA	CUMENT ARE THE REATED FOR USE ORMATION SHALI PURPOSE WITH ALTAR DESIGN. TON AND REFER	S, PLANS, DETAILS, ETC, SHOWN ON E PROPERTY OF GIBRALTAR DESIGN AND E ON THIS SPECIFIC PROJECT. NONE OF LIBE USED BY ANY PERSON OR FIRM OUT THE EXPRESS WRITTEN CONSENT THE OWNER MAY RETAIN COPIES FOR RENCE IN CONNECTION ONLY WITH THIS
REVIS	IONS	
MARK	DATE	ISSUED FOR
AD-1	11/09/22	ADDENDUM NO. 1

10/31/22 COORDINATED

DRAWN BY

CHECKED BY

COPYRIGHT NOTICE:

GIBRALTAR DESIGN

9102 N. Meridian St., Ste. 300 Indianapolis, IN 46260 Homepage www.GibraltarDesign.com Email info@GibraltarDesign.com Phone 317.580.5777 Fax 317.580.5778

DRAW	/ING	
ME	ZZANIN	E MECHANI
DE	MOLITIC	N PLANS


PROJECT

JACKSON ES ADDITIONS & RENOVATIONS

Copyright © 2022 Millies Engineering Group

© GIBRALTAR DESIGN SHEET

MD104

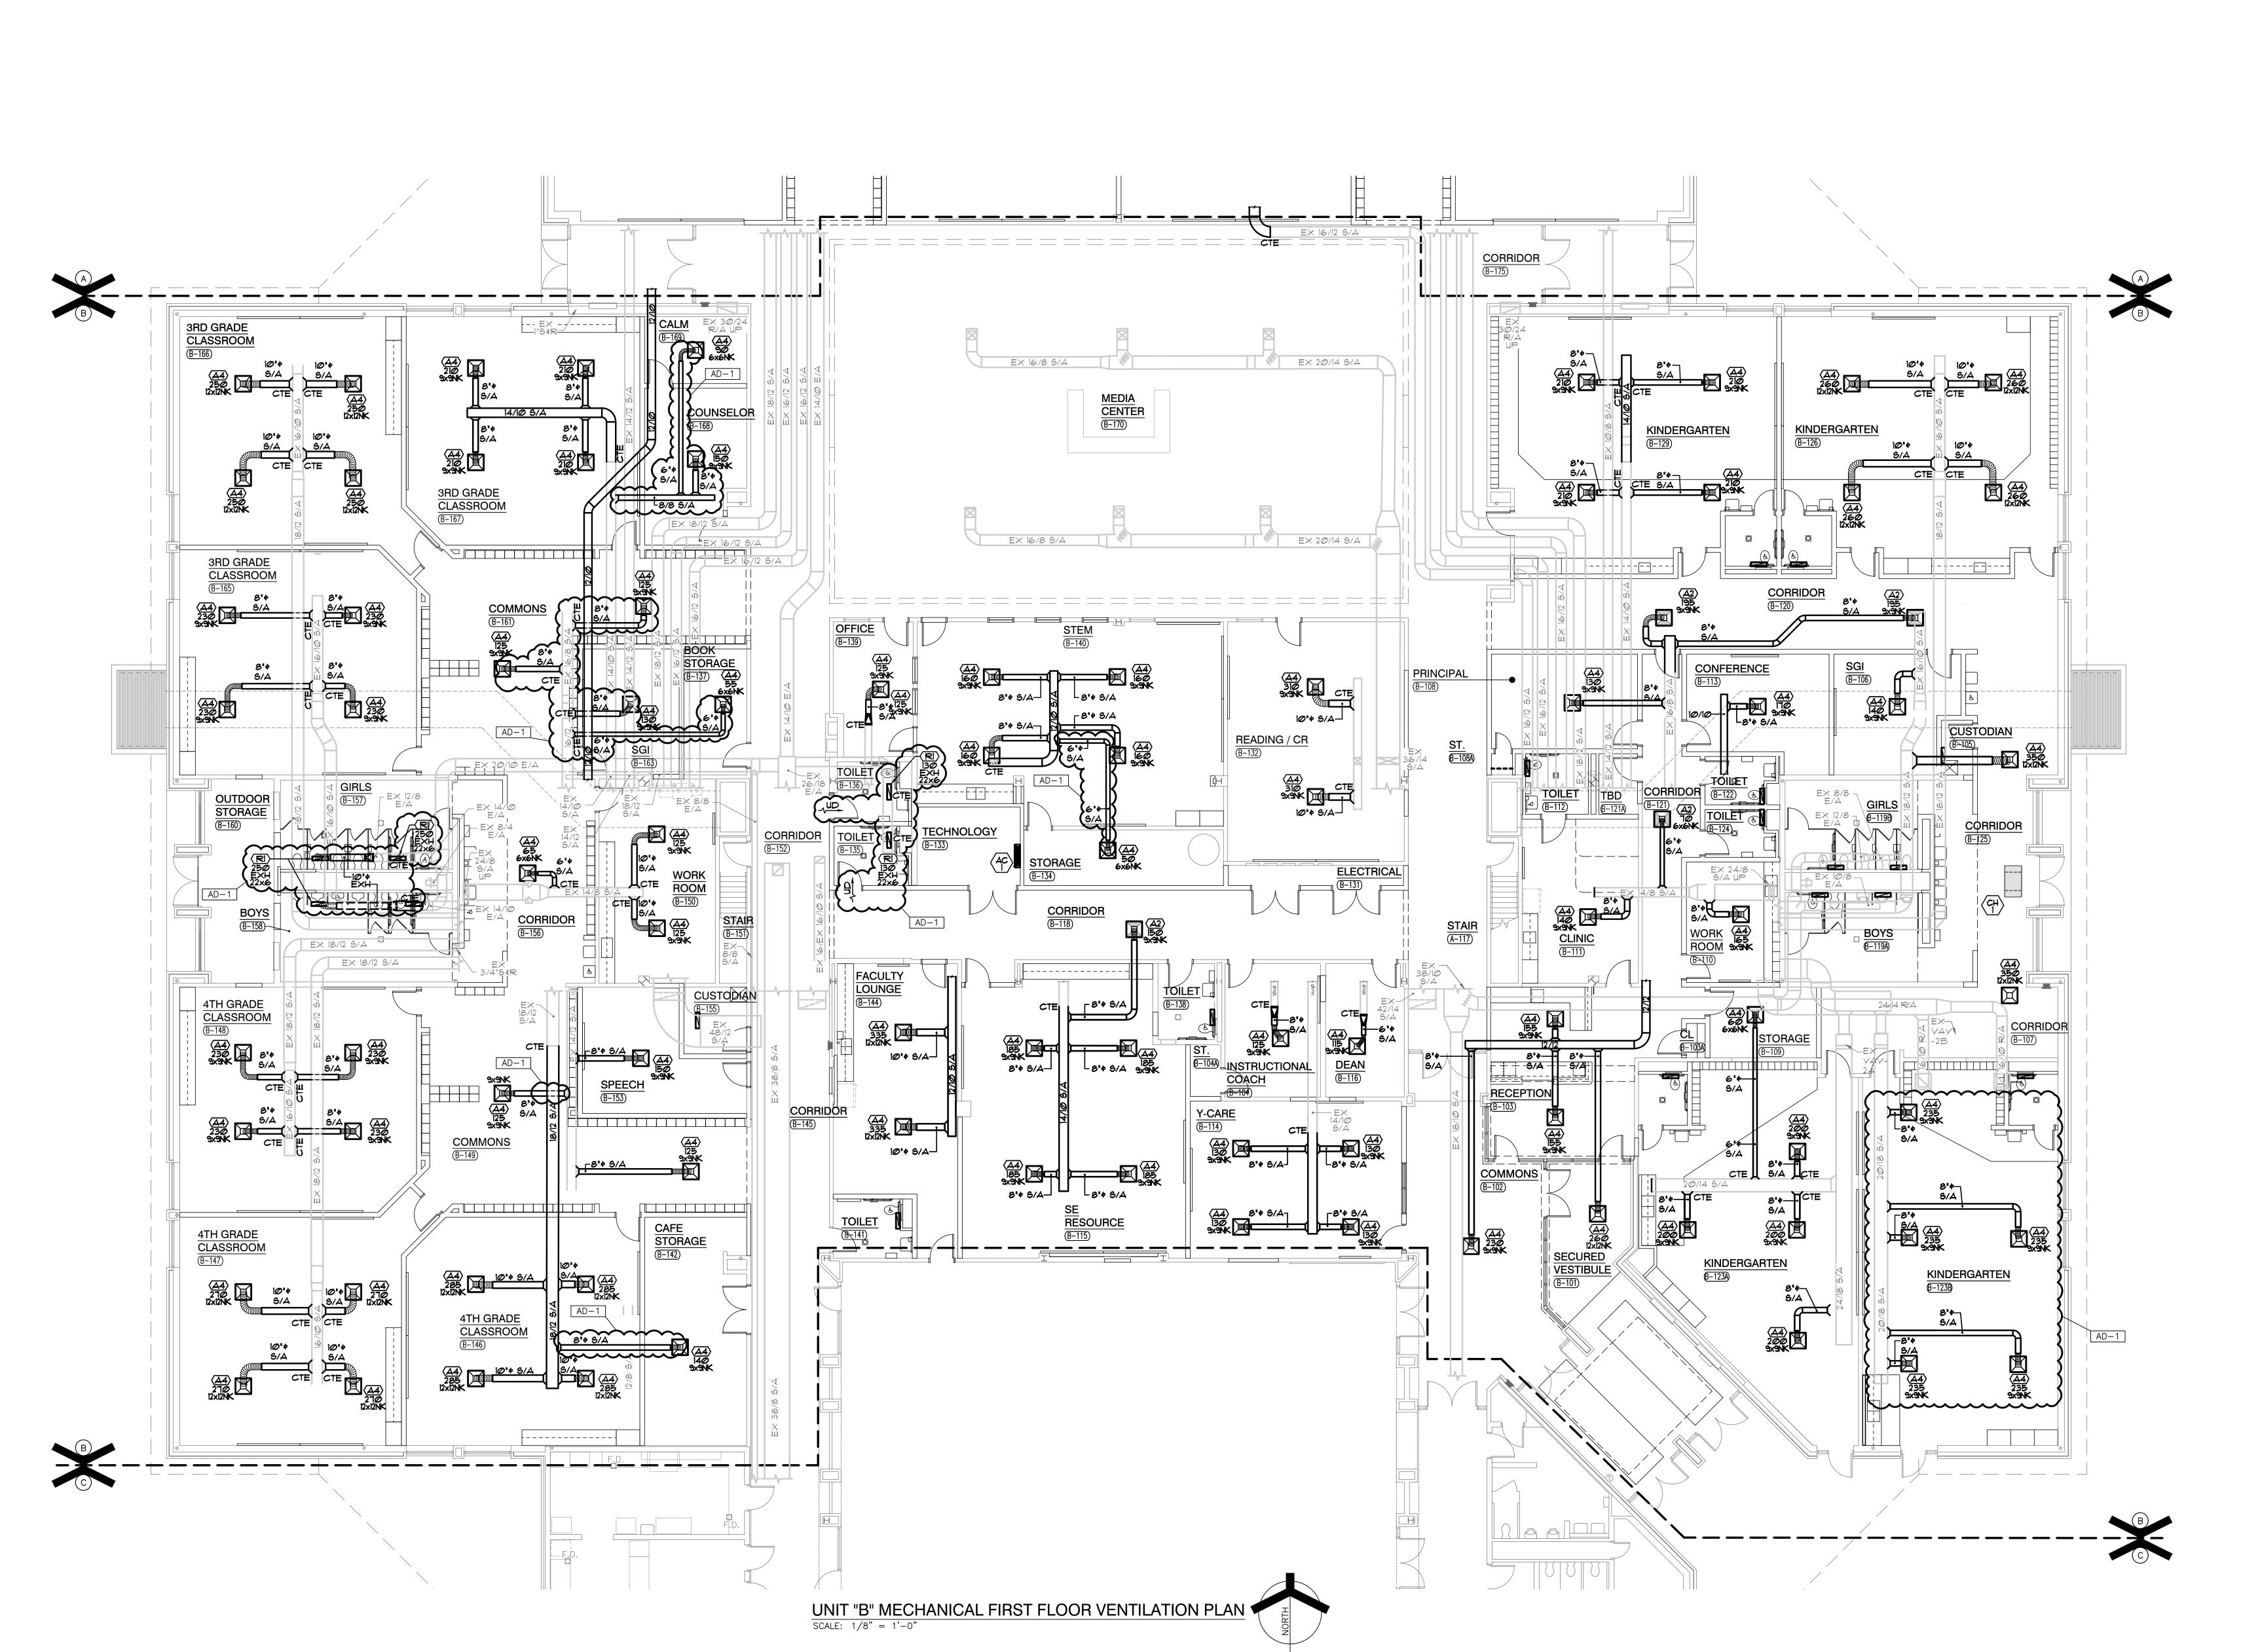



GIBRALTAR


DESIGN

ARCHITECTURE • ENGINEERING • INTERIOR DESIGN

ENG www.milli

JACKSON ELEMENTARY SCHOOL -RENOVATIONS

DUNELAND SCHOOL CORPORATION CHESTERTON, INDIANA

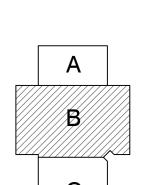

KEY PLAN

GIBRALTAR DESIGN
9102 N. Meridian St., Ste. 300
Indianapolis, IN 46260
Homepage www.GibraltarDesign.com
Email info@GibraltarDesign.com
Phone 317.580.5777 Fax 317.580.5778

PROJECT
21-143
DATE
10/31/22
COORDINATED BY
JC
DRAWN BY

COORDINATED BY

JC

DRAWN BY

KS

CHECKED BY

DJ

COPYRIGHT NOTICE:

COPYRIGHT NOTICE:

THE CONCEPTS, DESIGNS, PLANS, DETAILS, ETC, SHOWN ON THIS DOCUMENT ARE THE PROPERTY OF GIBRALTAR DESIGN AND WERE CREATED FOR USE ON THIS SPECIFIC PROJECT. NONE OF THIS INFORMATION SHALL BE USED BY ANY PERSON OR FIRM FOR ANY PURPOSE WITHOUT THE EXPRESS WRITTEN CONSENT OF GIBRALTAR DESIGN. THE OWNER MAY RETAIN COPIES FOR INFORMATION AND REFERENCE IN CONNECTION ONLY WITH THIS PROJECT.

REVISIONS

MARK	DATE	ISSUED FO	R	
AD-1	11/09/22	ADDENDUM	NO.	1
DDAM	/INIC			


DRAWING

UNIT "B" MECHANICAL
FIRST FLOOR

FIRST FLOOR
VENTILATION PLAN

PROJECT
JACKSON ES ADDITIONS & RENOVATIONS

B MV102

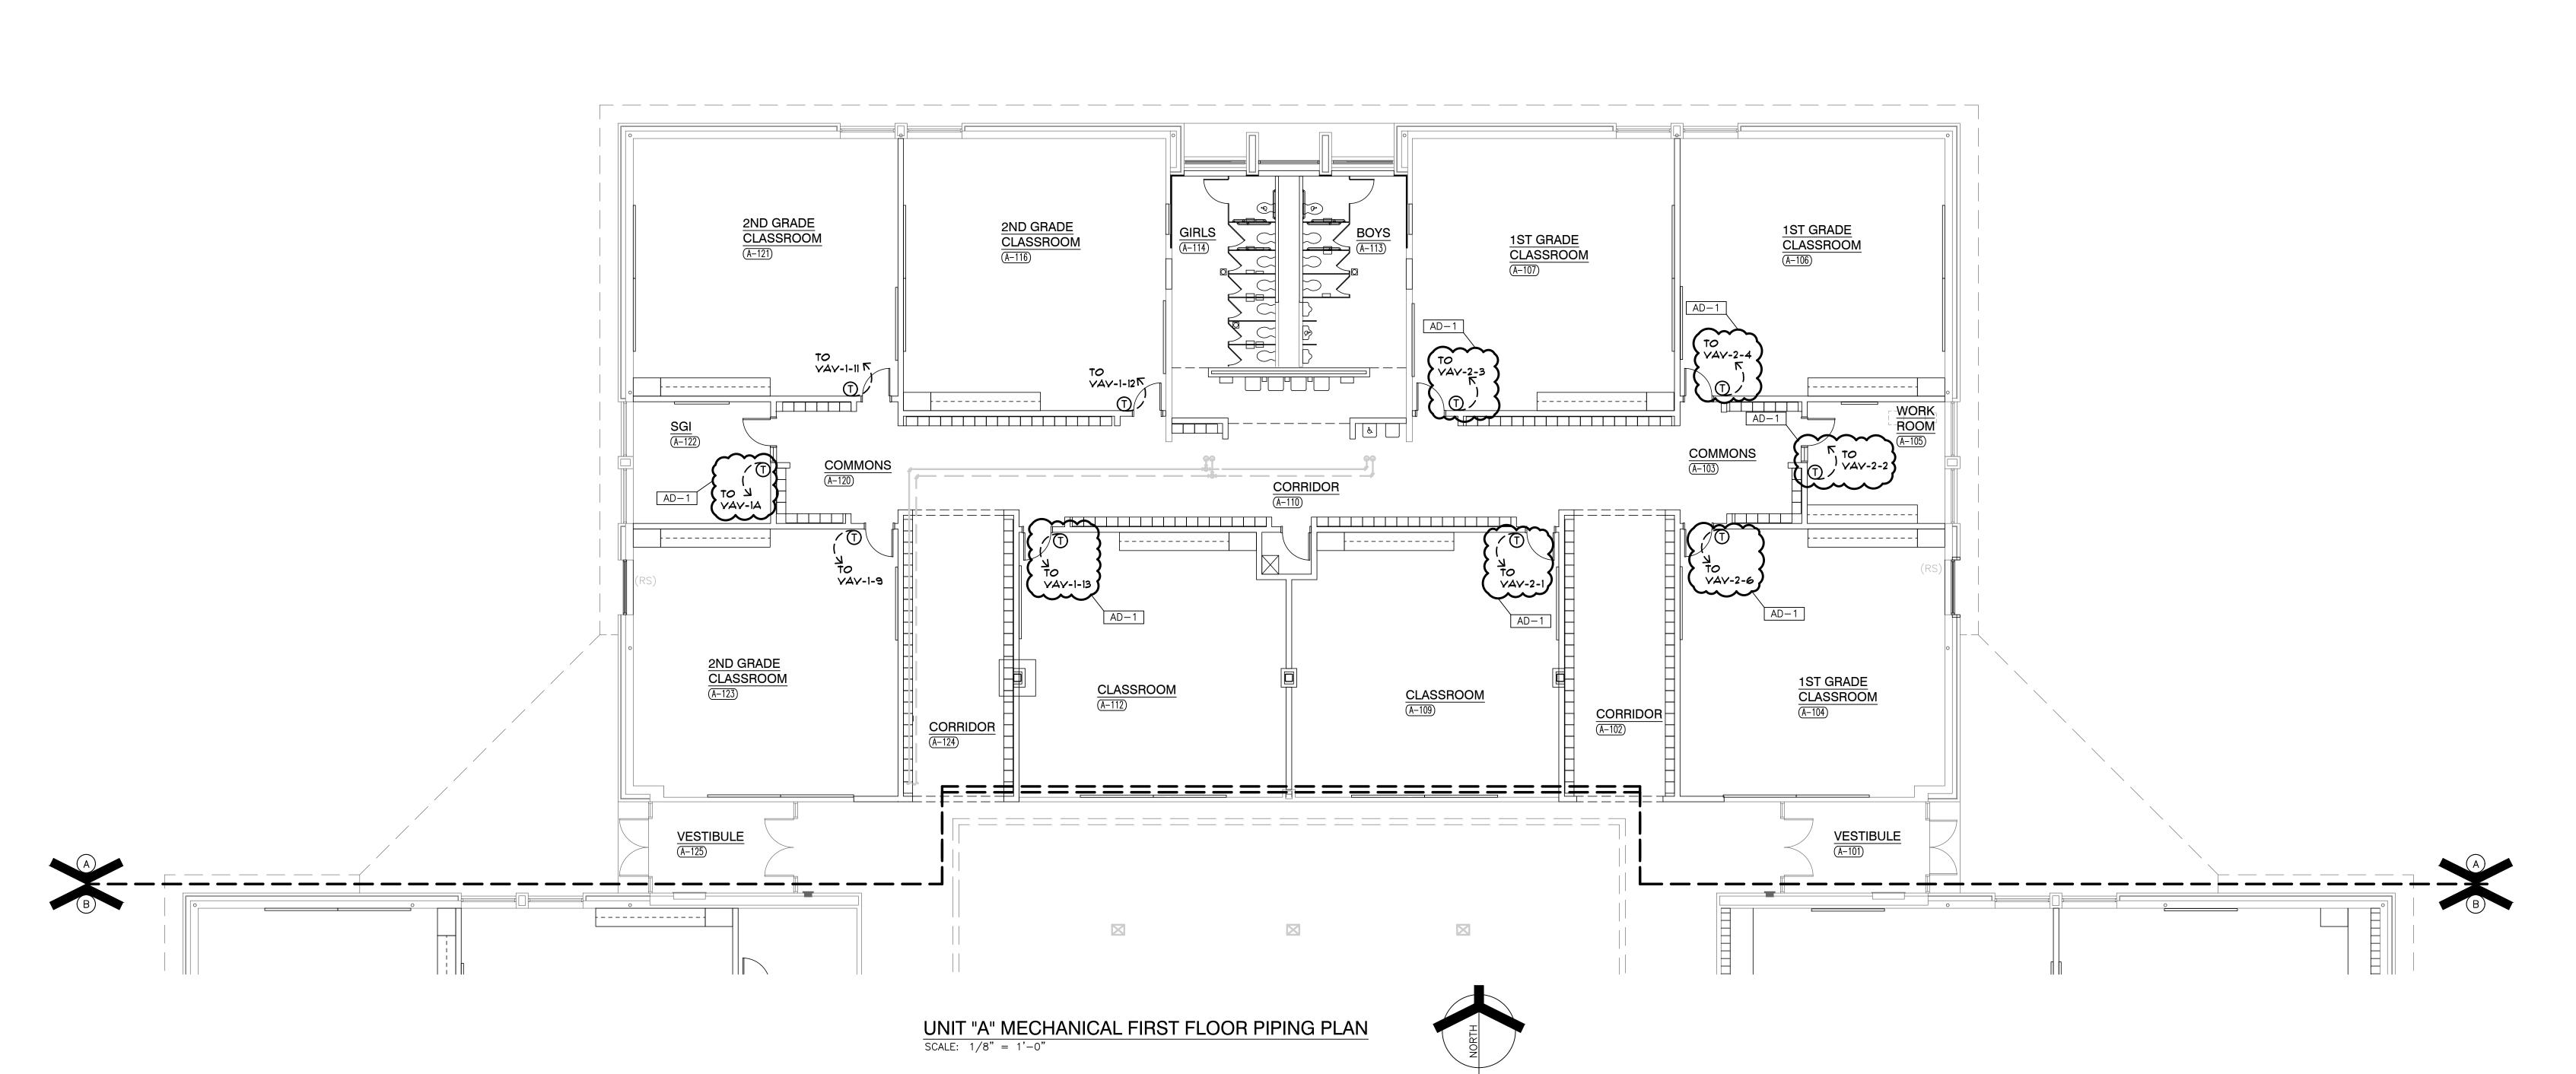




GIBRALTAR

DESIGN ARCHITECTURE • ENGINEERING • INTERIOR DESIGN



JACKSON ELEMENTARY SCHOOL -RENOVATIONS

DUNELAND SCHOOL CORPORATION CHESTERTON, INDIANA

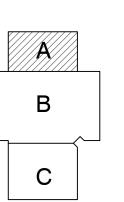

KEY PLAN

GIBRALTAR DESIGN 9102 N. Meridian St., Ste. 300 Indianapolis, IN 46260 Homepage www.GibraltarDesign.com Email info@GibraltarDesign.com Phone 317.580.5777 Fax 317.580.5778

COORDINATED DRAWN BY

CHECKED BY COPYRIGHT NOTICE:

THE CONCEPTS, DESIGNS, PLANS, DETAILS, ETC, SHOWN ON THIS DOCUMENT ARE THE PROPERTY OF GIBRALTAR DESIGN AND WERE CREATED FOR USE ON THIS SPECIFIC PROJECT. NONE OF THIS INFORMATION SHALL BE USED BY ANY PERSON OR FIRM FOR ANY PURPOSE WITHOUT THE EXPRESS WRITTEN CONSENT OF GIBRALTAR DESIGN. THE OWNER MAY RETAIN COPIES FOR INFORMATION AND REFERENCE IN CONNECTION ONLY WITH THIS PROJECT.

MARK	DATE	ISSUED FOR
AD-1	11/09/22	ADDENDUM NO.


UNIT "A" MECHANICAL

FIRST FLOOR PIPING PLAN

JACKSON ES -ADDITIONS & RENOVATIONS

© GIBRALTAR DESIGN SHEET MP101

Copyright © 2022 Millies Engineering Group

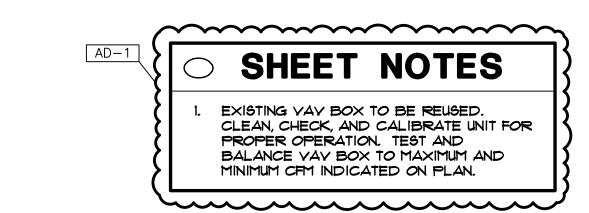





DESIGN

ARCHITECTURE • ENGINEERING • INTERIOR DESIGN

ENGINEERING GRG (219) 924-8400 www.milliesengineeringgr

JACKSON
ELEMENTARY
SCHOOL RENOVATIONS

DUNELAND SCHOOL CORPORATION CHESTERTON, INDIANA

A B C

KEY PLAN

GIBRALTAR DESIGN

9102 N. Meridian St., Ste. 300
Indianapolis, IN 46260
Homepage www.GibraltarDesign.com
Email info@GibraltarDesign.com
Phone 317.580.5777 Fax 317.580.5778

PROJECT
21-143
DATE
10/31/22
COORDINATED BY
JC
DRAWN BY
KS
CHECKED BY

COPYRIGHT NOTICE:

THE CONCEPTS, DESIGNS, PLANS, DETAILS, ETC, SHOWN ON THIS DOCUMENT ARE THE PROPERTY OF GIBRALTAR DESIGN AND WERE CREATED FOR USE ON THIS SPECIFIC PROJECT. NONE OF THIS INFORMATION SHALL BE USED BY ANY PERSON OR FIRM FOR ANY PURPOSE WITHOUT THE EXPRESS WRITTEN CONSENT OF GIBRALTAR DESIGN. THE OWNER MAY RETAIN COPIES FOR INFORMATION AND REFERENCE IN CONNECTION ONLY WITH THIS PROJECT.

REVISIONS

MARK DATE ISSUED FOR

AD-1 11/09/22 ADDENDUM NO. 1

DRAWING
UNIT "B" MECHANICAL


FIRST FLOOR PIPING PLAN


PROJECT


JACKSON ES ADDITIONS & RENOVATIONS

SHEET

B MP102

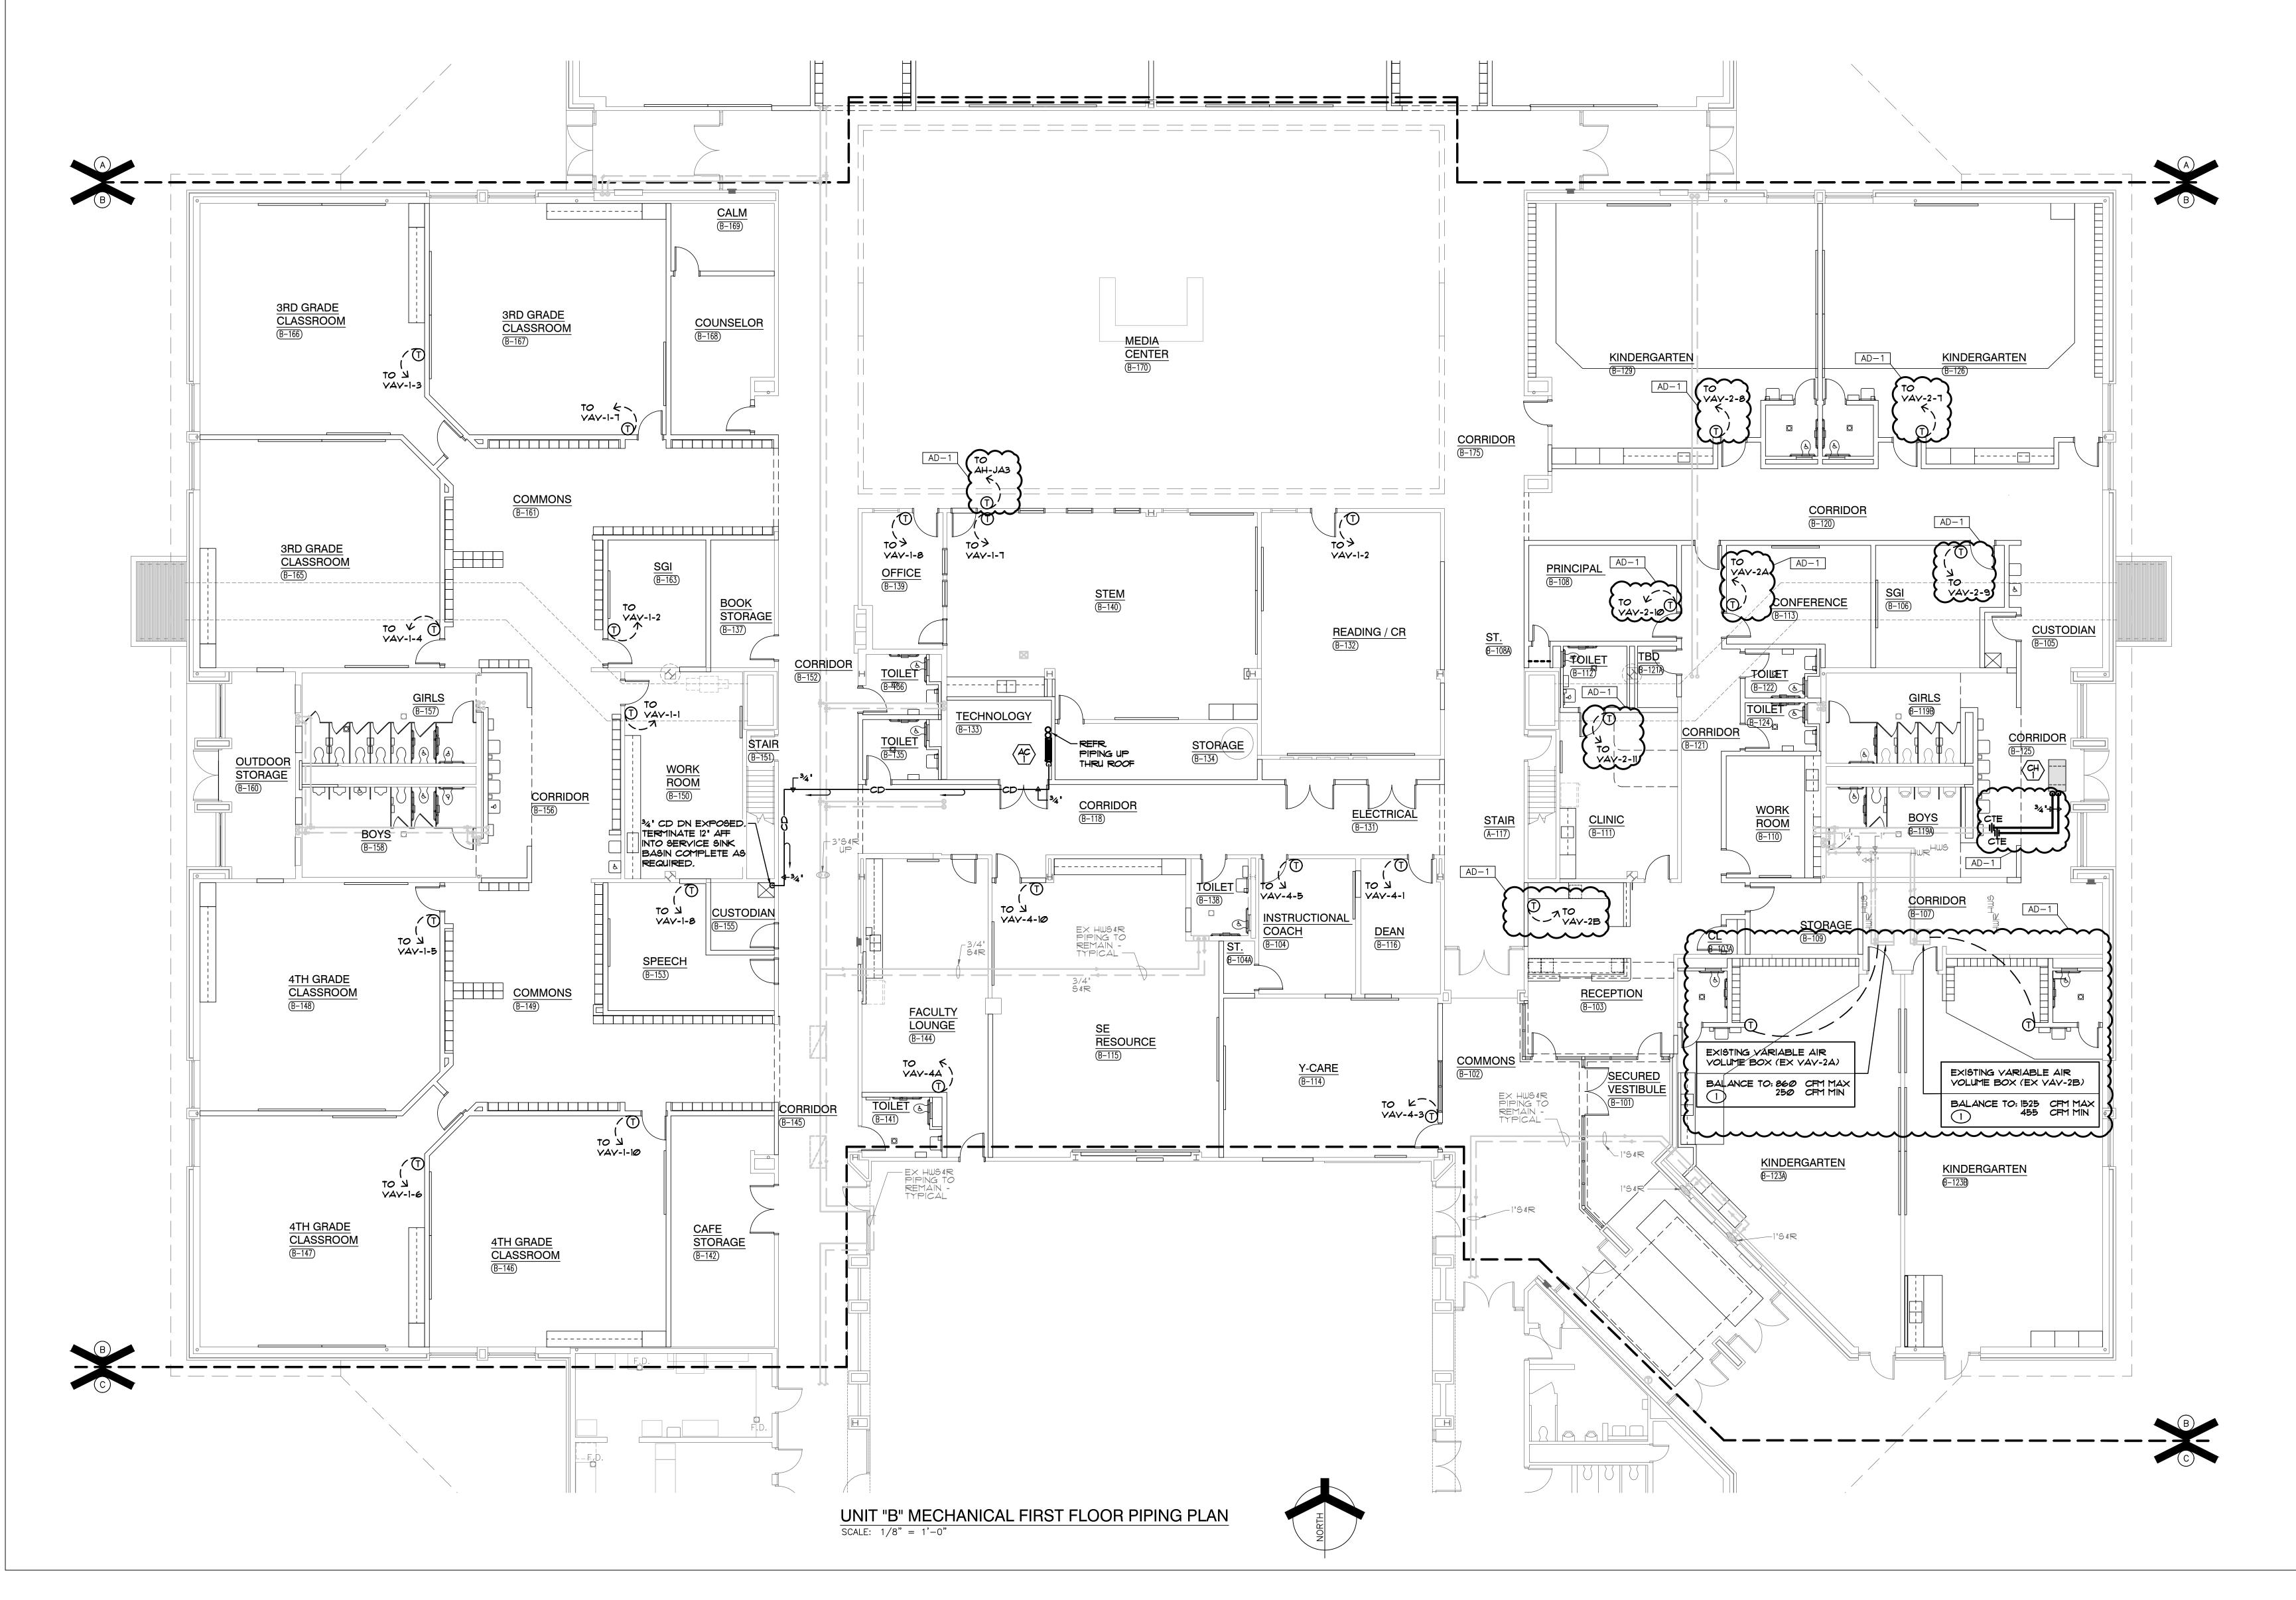

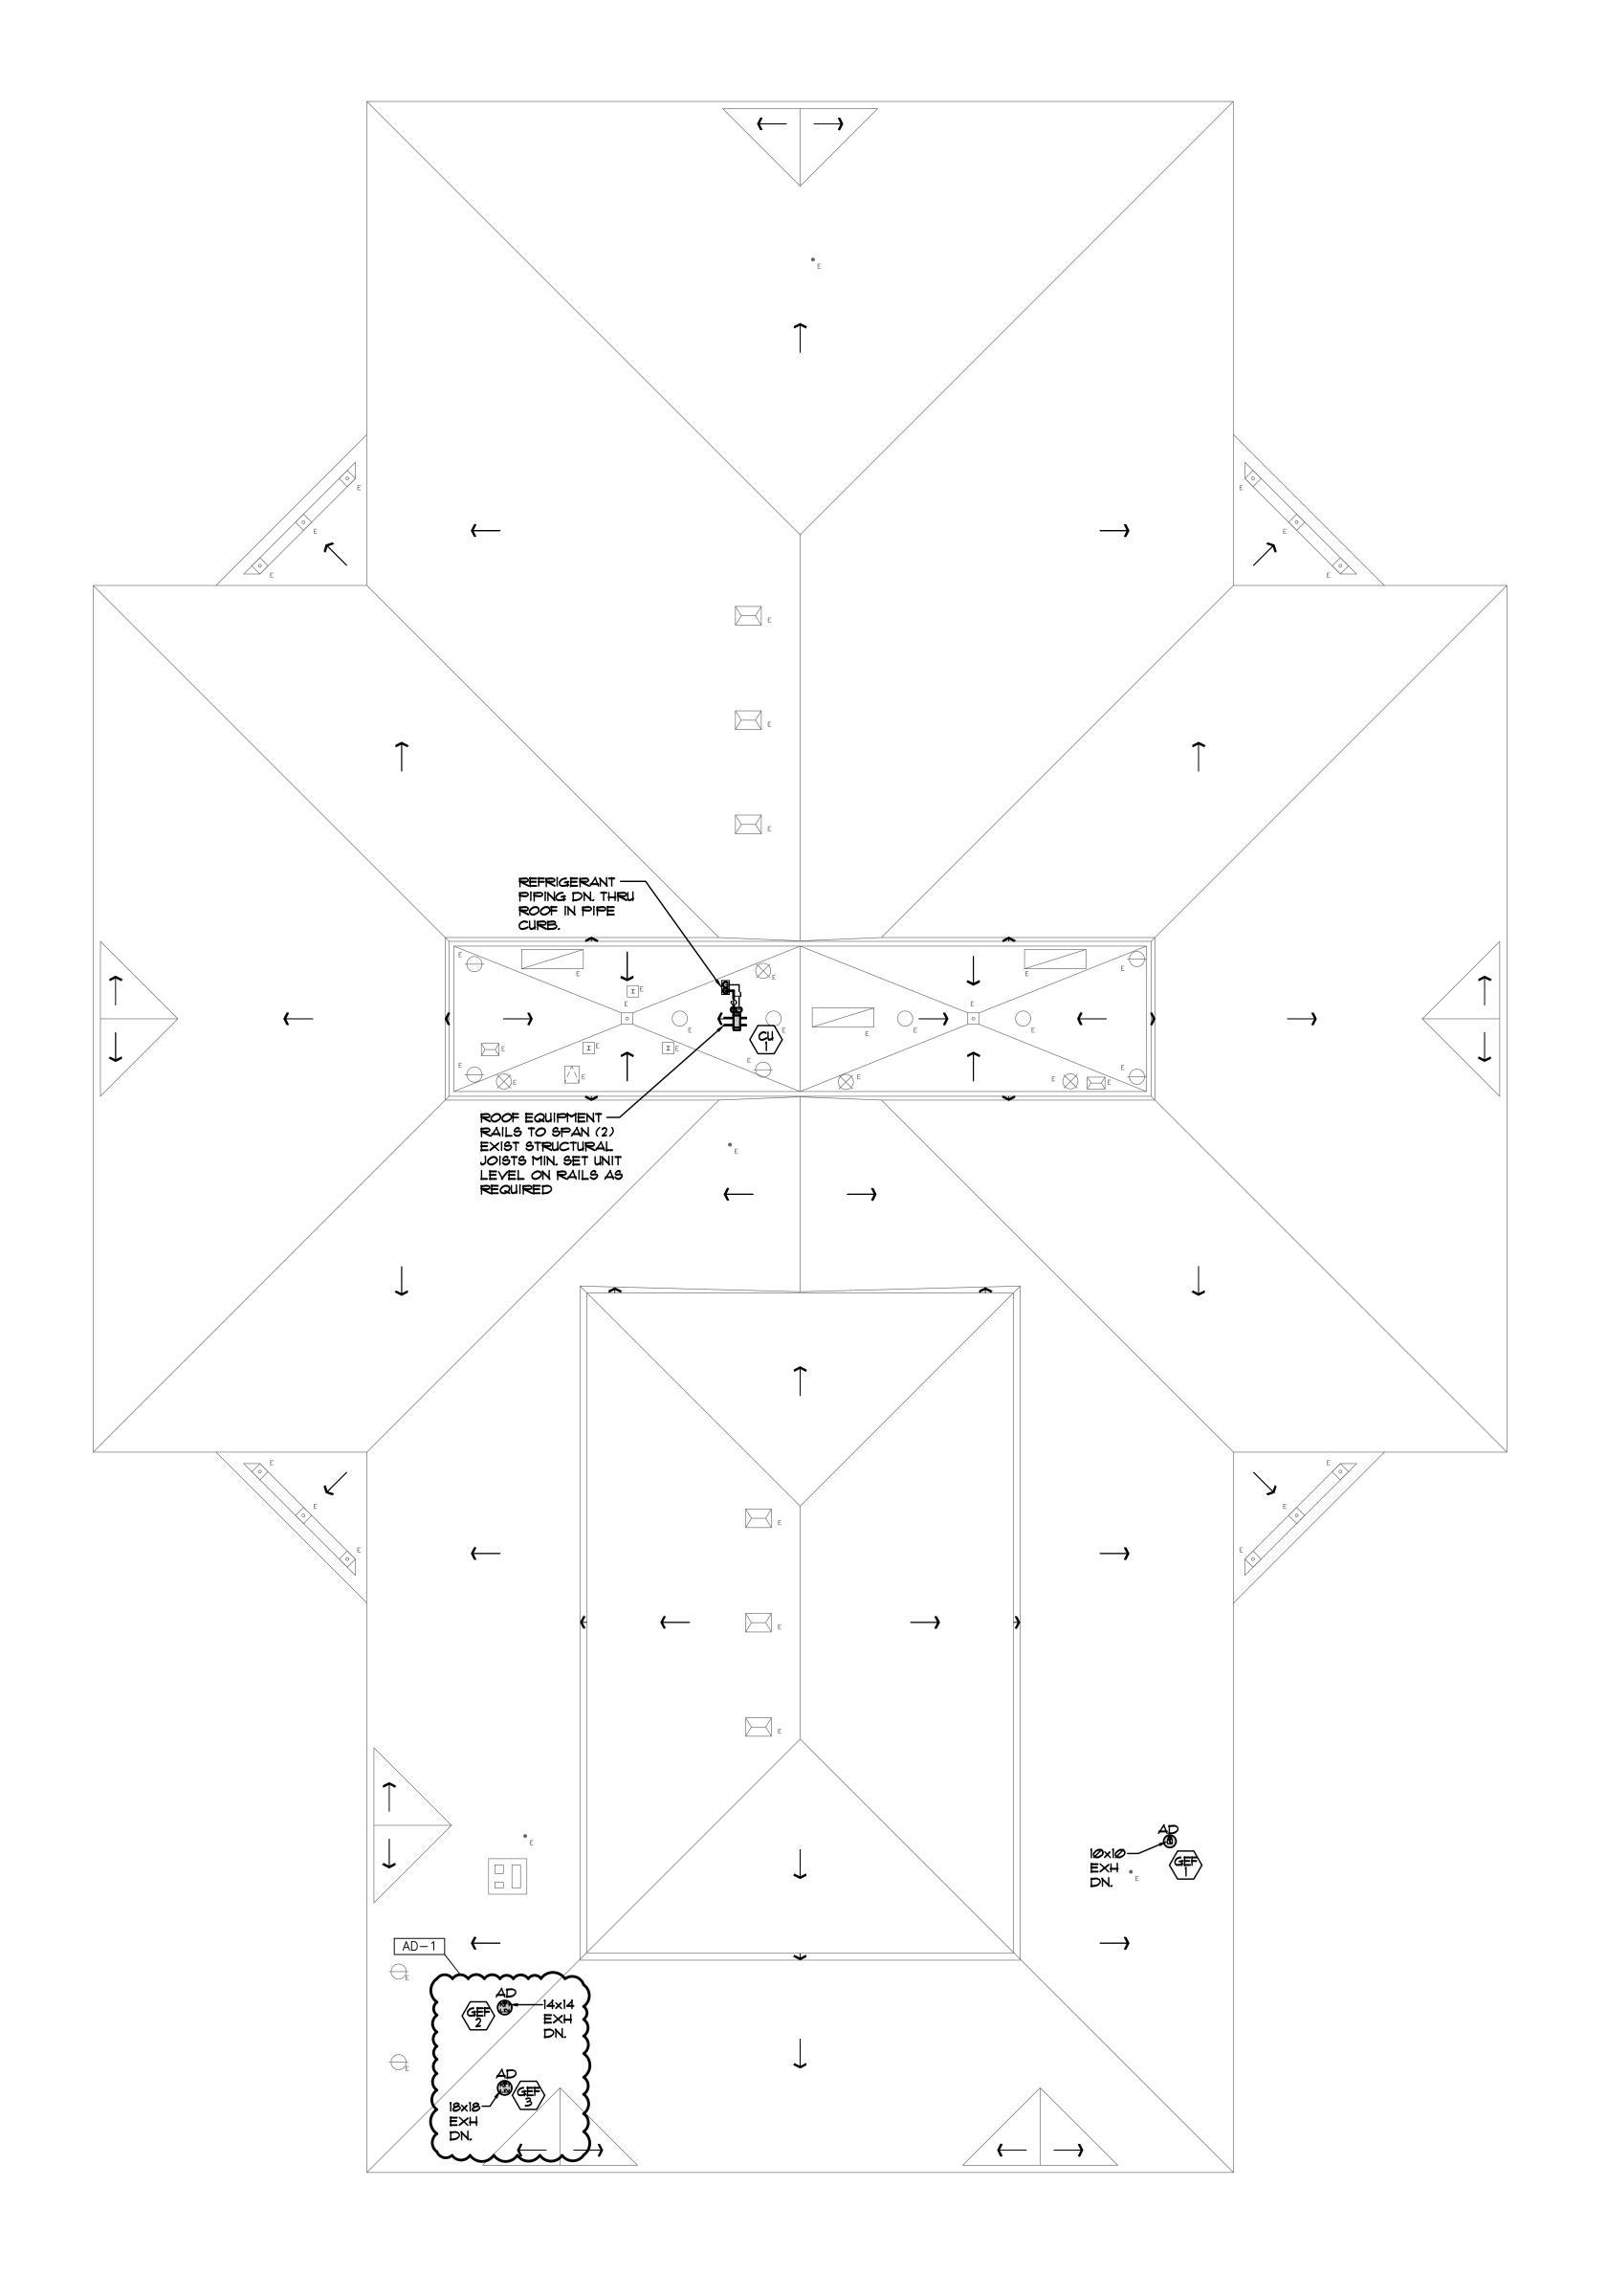

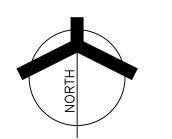



GIBRALTAR

DESIGN ARCHITECTURE • ENGINEERING • INTERIOR DESIGN



JACKSON ELEMENTARY SCHOOL -RENOVATIONS

DUNELAND SCHOOL CORPORATION CHESTERTON, INDIANA

GIBRALTAR DESIGN 9102 N. Meridian St., Ste. 300 Indianapolis, IN 46260 Homepage www.GibraltarDesign.com Email info@GibraltarDesign.com Phone 317.580.5777 Fax 317.580.5778

COORDINATED DRAWN BY

CHECKED BY

COPYRIGHT NOTICE: THE CONCEPTS, DESIGNS, PLANS, DETAILS, ETC, SHOWN ON THIS DOCUMENT ARE THE PROPERTY OF GIBRALTAR DESIGN AND WERE CREATED FOR USE ON THIS SPECIFIC PROJECT. NONE OF THIS INFORMATION SHALL BE USED BY ANY PERSON OR FIRM FOR ANY PURPOSE WITHOUT THE EXPRESS WRITTEN CONSENT OF GIBRALTAR DESIGN. THE OWNER MAY RETAIN COPIES FOR INFORMATION AND REFERENCE IN CONNECTION ONLY WITH THIS PROJECT.

REVIS	IONS			
MARK	DATE	ISSUED FO	)R	
AD-1	11/09/22	ADDENDUM	NO.	1

OVERALL MECHANICAL ROOF HVAC PLAN

JACKSON ES -ADDITIONS & RENOVATIONS


Copyright © 2022 Millies Engineering Group


© GIBRALTAR DESIGN SHEET

M-201

OVERALL MECHANICAL ROOF HVAC PLAN

SCALE: 1/16" = 1'-0"

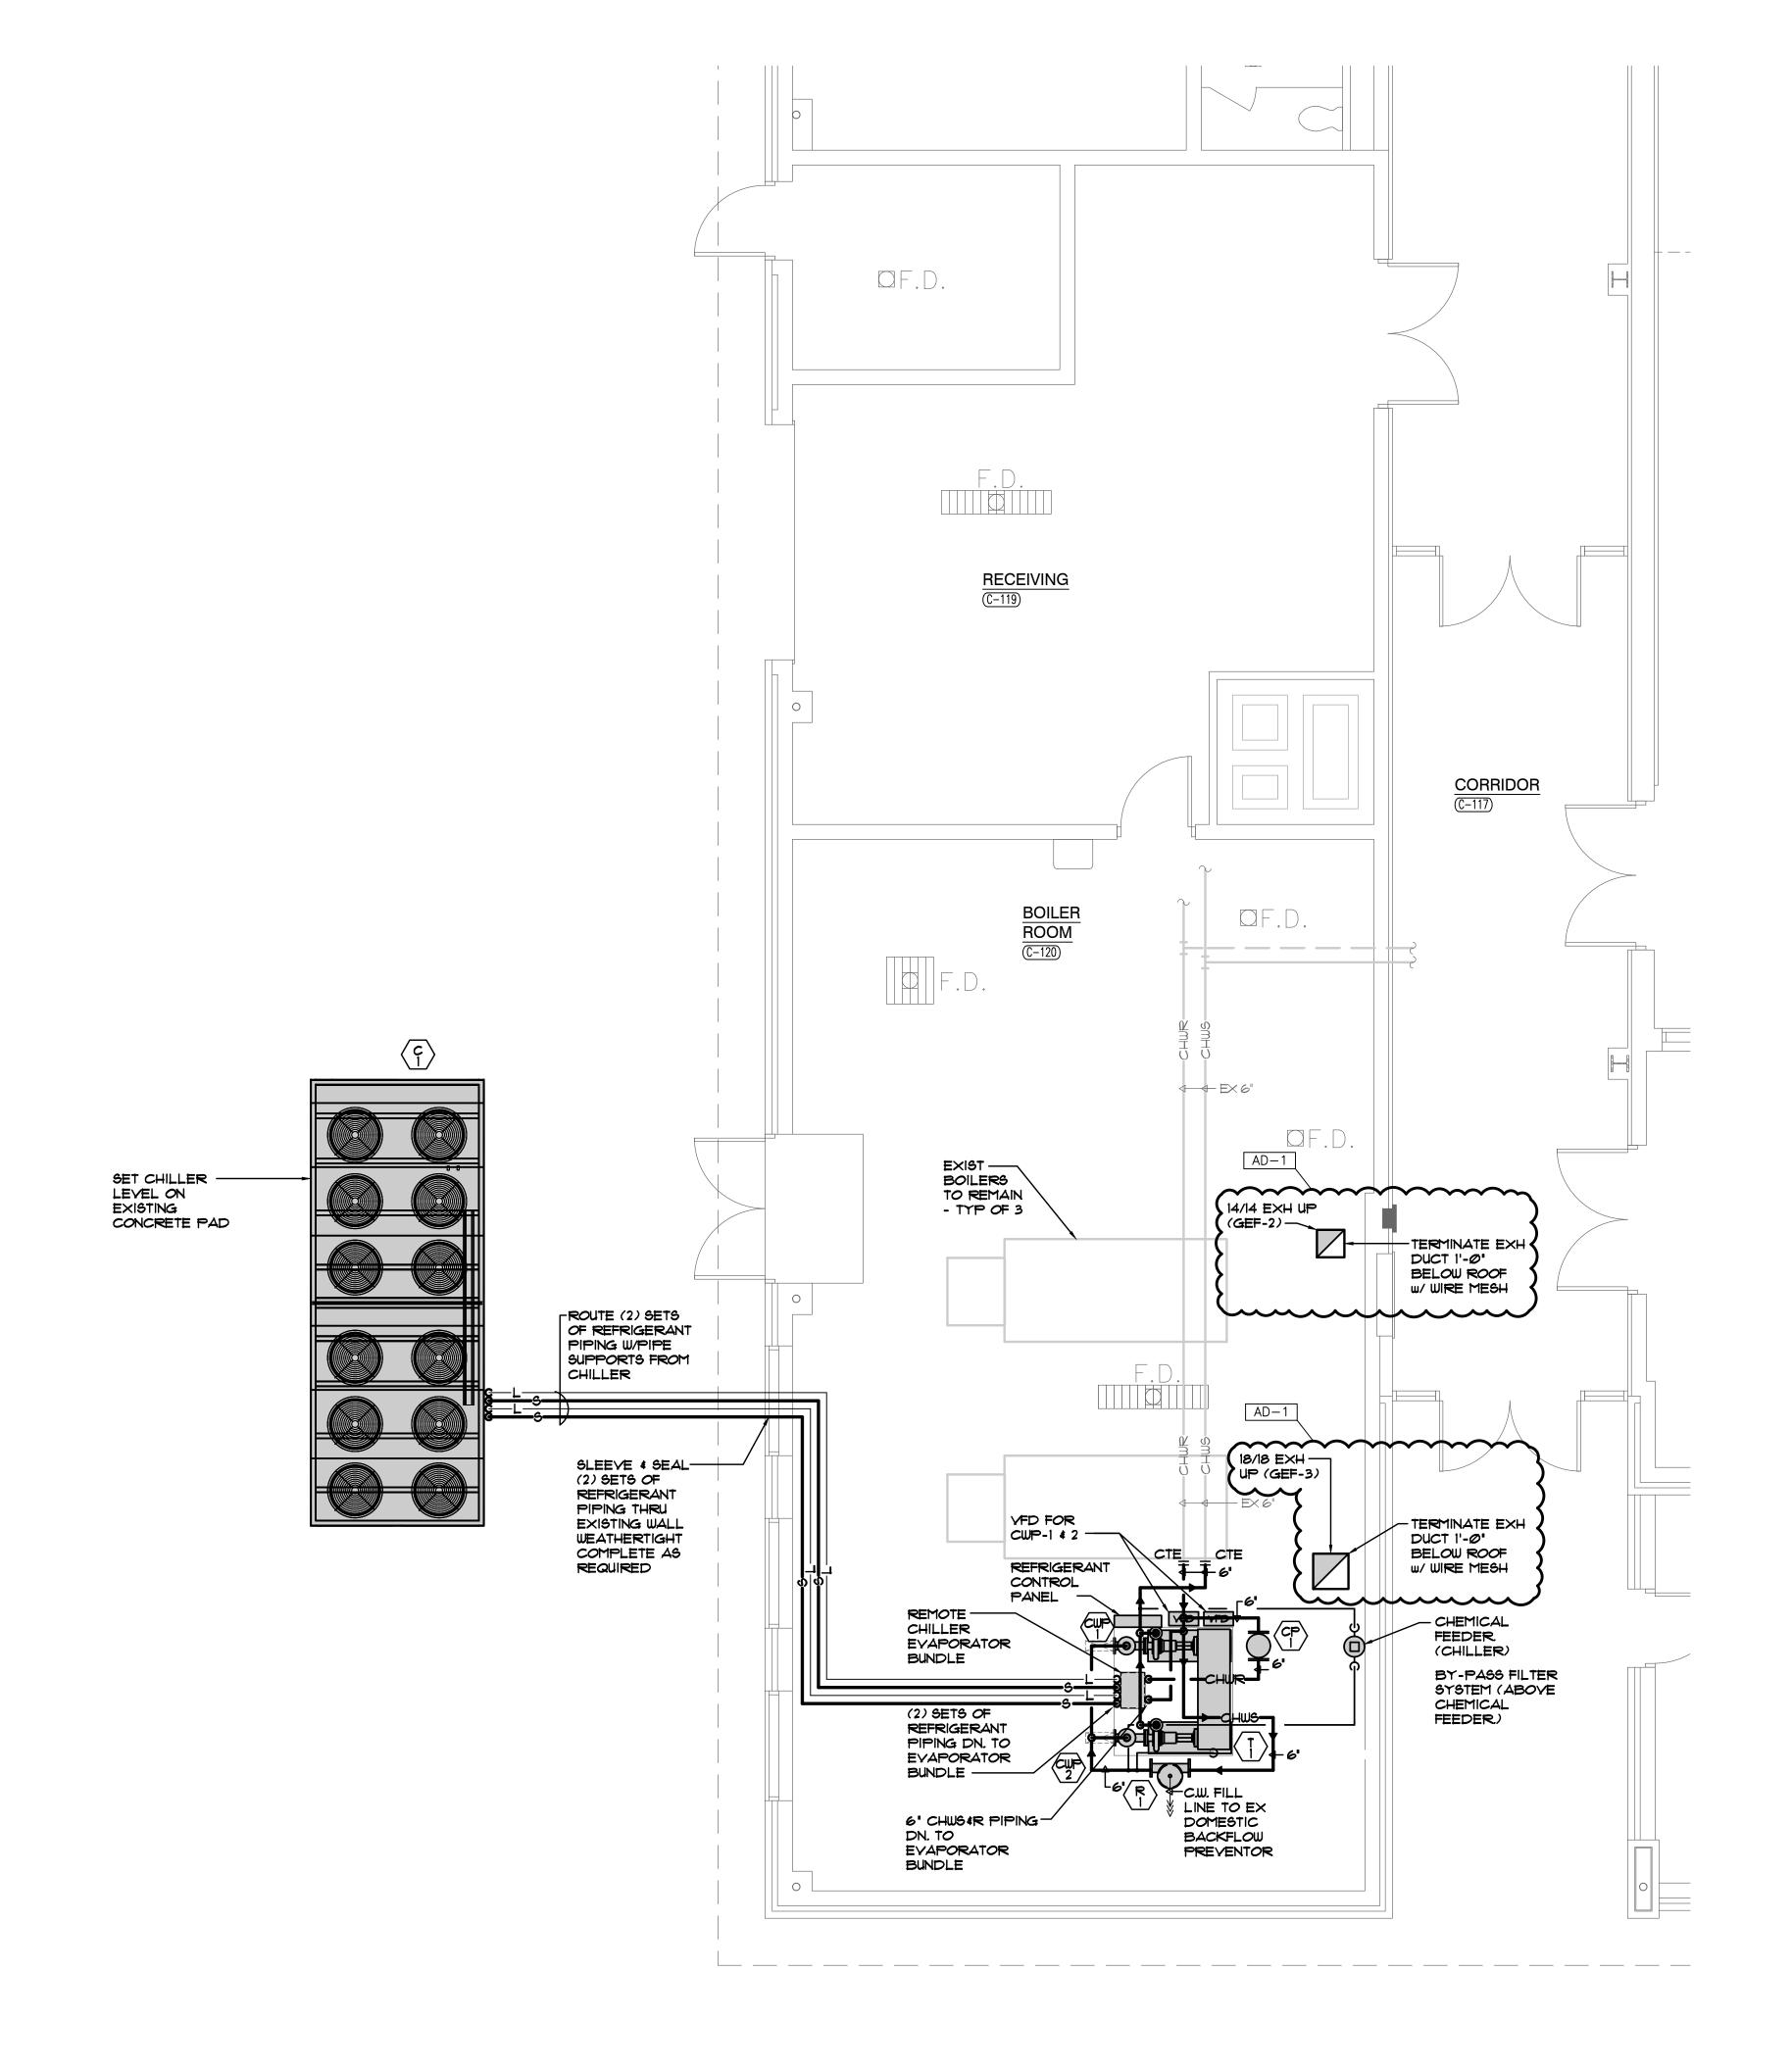

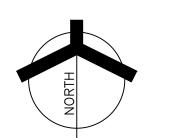

GIBRALTAR DESIGN



JACKSON ELEMENTARY SCHOOL -RENOVATIONS

DUNELAND SCHOOL CORPORATION CHESTERTON, INDIANA

GIBRALTAR DESIGN 9102 N. Meridian St., Ste. 300 Indianapolis, IN 46260 Homepage www.GibraltarDesign.com Email info@GibraltarDesign.com Phone 317.580.5777 Fax 317.580.5778

COORDINATED DRAWN BY

CHECKED BY

COPYRIGHT NOTICE: THE CONCEPTS, DESIGNS, PLANS, DETAILS, ETC, SHOWN ON THIS DOCUMENT ARE THE PROPERTY OF GIBRALTAR DESIGN AND WERE CREATED FOR USE ON THIS SPECIFIC PROJECT. NONE OF THIS INFORMATION SHALL BE USED BY ANY PERSON OR FIRM FOR ANY PURPOSE WITHOUT THE EXPRESS WRITTEN CONSENT OF GIBRALTAR DESIGN. THE OWNER MAY RETAIN COPIES FOR INFORMATION AND REFERENCE IN CONNECTION ONLY WITH THIS

REVIS	IONS	
MARK	DATE	ISSUED FOR
AD-1	11/09/22	ADDENDUM NO. 1

DRAWING ENLARGED MECHANICAL BOILER ROOM PLAN

JACKSON ES -ADDITIONS & RENOVATIONS


© GIBRALTAR DESIGN SHEET

Copyright © 2022 Millies Engineering Group

M-402


ENLARGED MECHANICAL BOILER ROOM PLAN

SCALE: 1/4" = 1'-0"

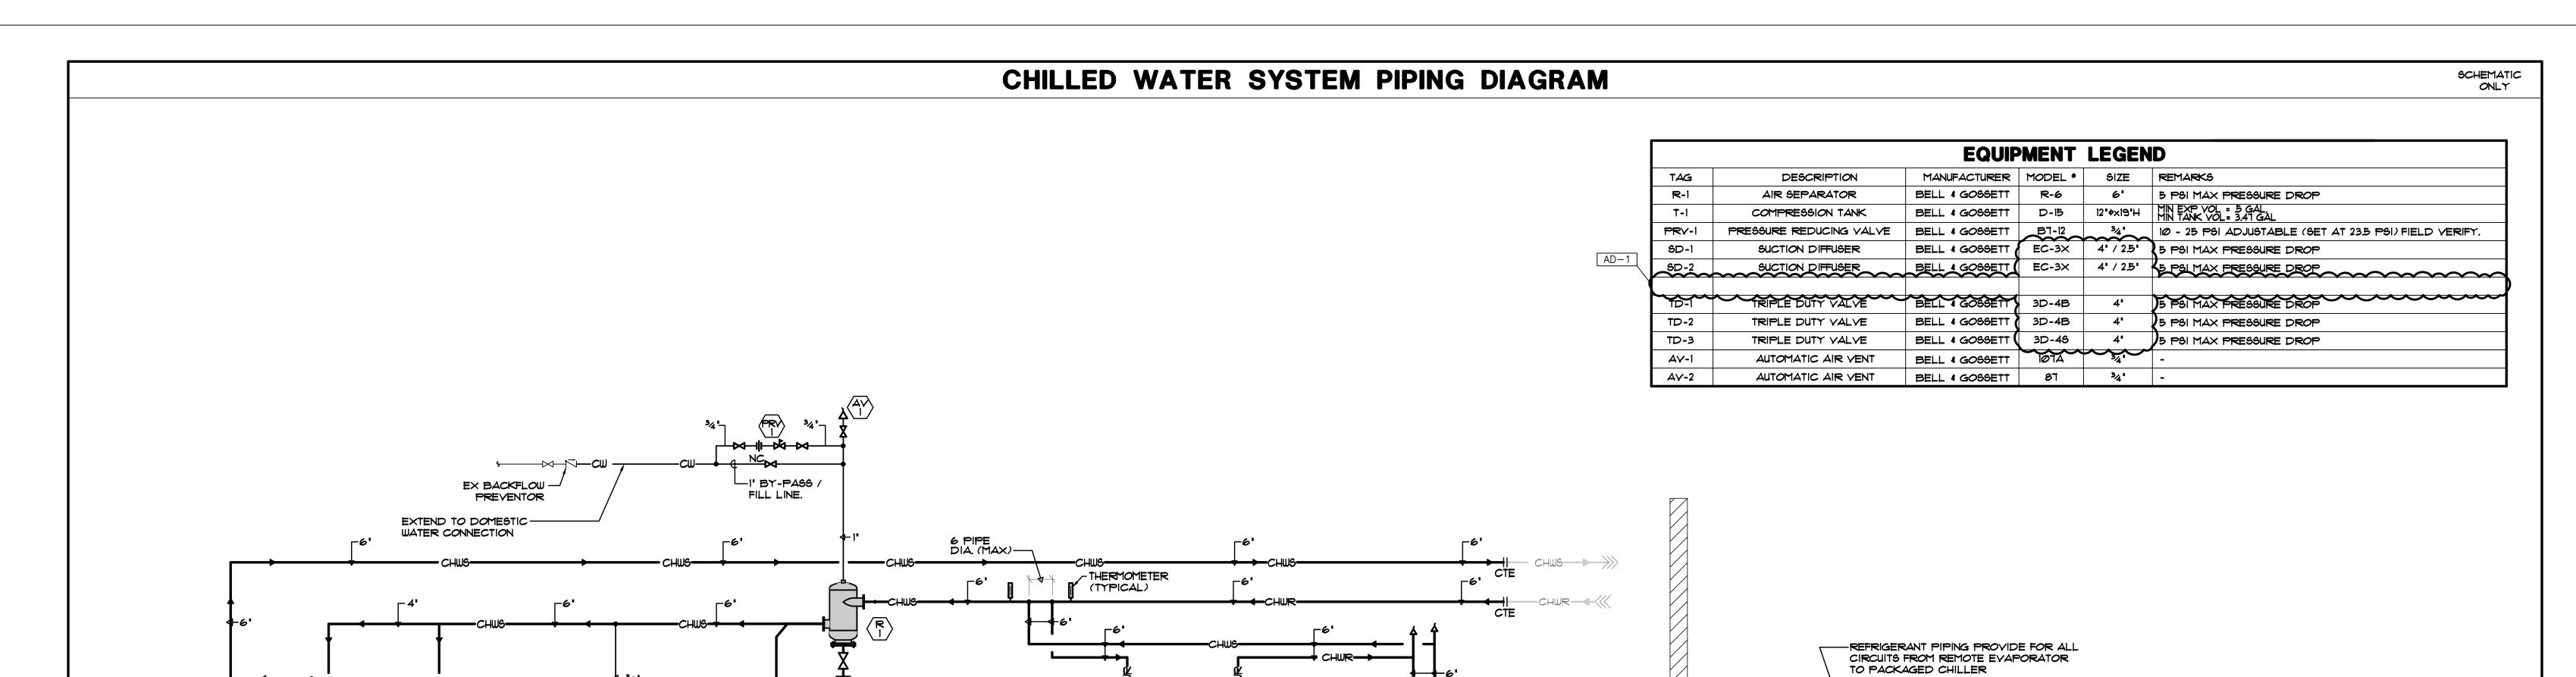

PROVIDE DRAIN VALVES-

WITH 1" HOSE CONNECTION AT LOW POINT.

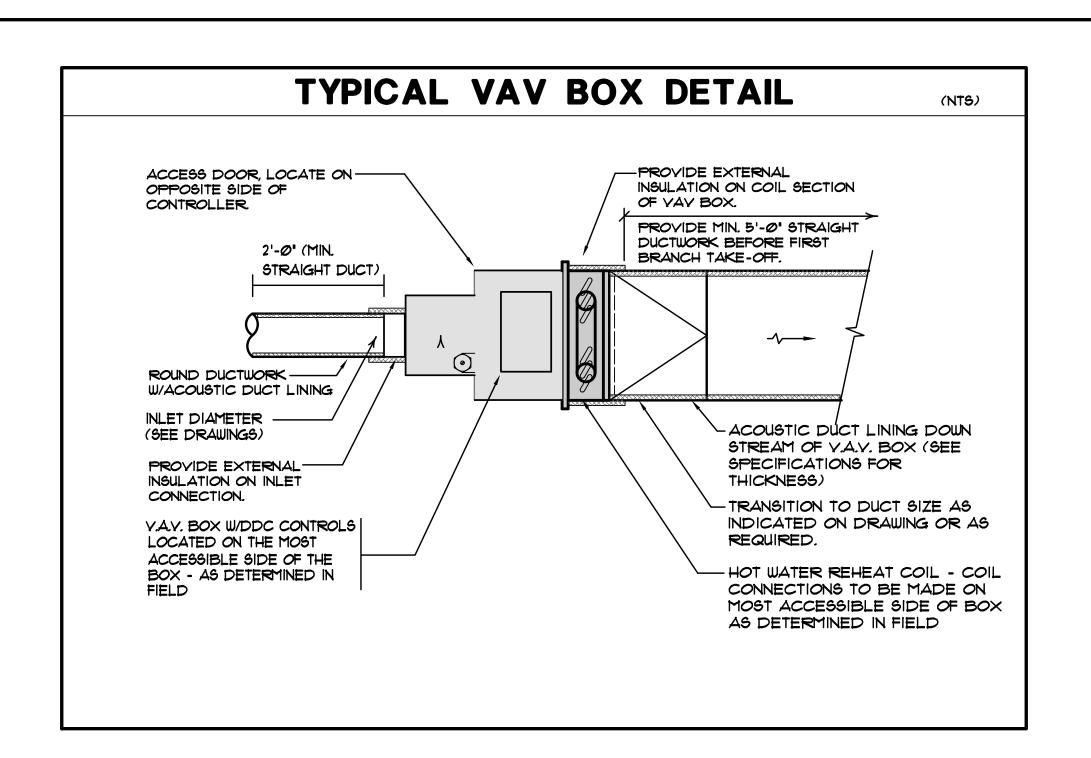

- POT FEEDER LOCATE

DRAIN VALVE W 3/4" — HOSE CONNECTION

BASE MOUNTED ----

END SUCTION PUMP

SET PUMP LEVEL ON EXISTING CONCRETE EQUIPMENT PAD -


MECHANICAL ROOM FLOOR

4'-0" A.F.F. (MAX) (SEE

- PRESSURE GAUGE (TYPICAL)

LEVEL ON EXIST

SUPPORT RACK

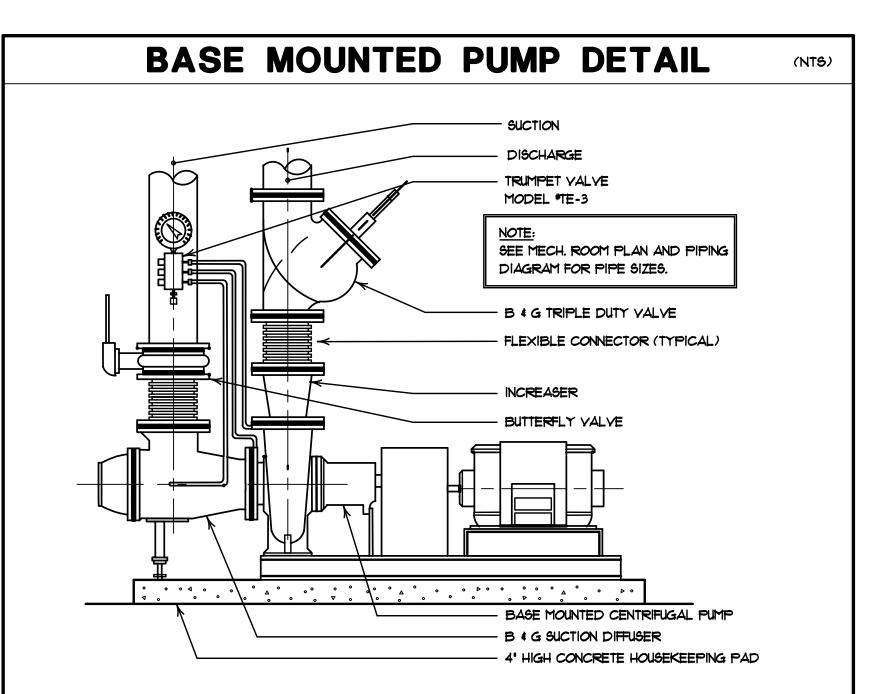

LISET CHILLER BUNDLE LEVEL ON EXIST CONCRETE PAD

(2) SETS OF

(2) SETS OF ---


DN. TO REMOTE EVAPORATOR

CHILLER

EVAPORATOR

REFRIGERANT PIPING

REFRIGERANT

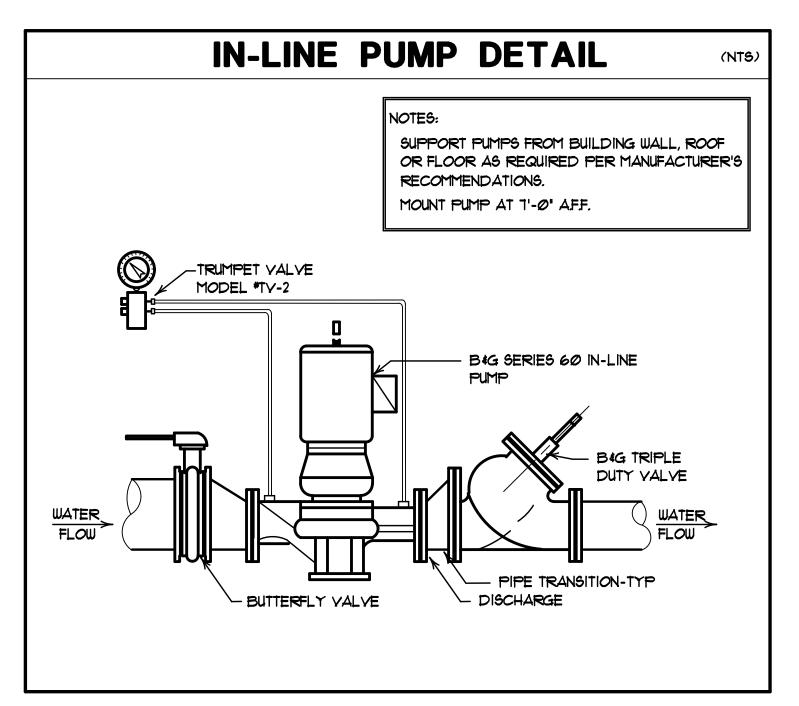

-PROVIDE CHILLER

— SET CHILLER LEVEL ON EXISTING GRADE

CONCRETE PAD

WITH SOUND ATTENUATION.

PACKAGED CHILLER UNIT



DESIGN

ARCHITECTURE • ENGINEERING • INTERIOR DESIGN

ENGINEERING (219) 924-www.milliesengineer

JACKSON
ELEMENTARY
SCHOOL RENOVATIONS

DUNELAND SCHOOL CORPORATION CHESTERTON, INDIANA

GIBRALTAR DESIGN
9102 N. Meridian St., Ste. 300
Indianapolis, IN 46260
Homepage www.GibraltarDesign.com
Email info@GibraltarDesign.com
Phone 317.580.5777 Fax 317.580.5778

Phone 317.580.5777

PROJECT

21-143

DATE

10/31/22

COORDINATED BY

JC

DRAWN BY

KS

CHECKED BY

D.I

COPYRIGHT NOTICE:

THE CONCEPTS, DESIGNS, PLANS, DETAILS, ETC, SHOWN ON THIS DOCUMENT ARE THE PROPERTY OF GIBRALTAR DESIGN AND WERE CREATED FOR USE ON THIS SPECIFIC PROJECT. NONE OF THIS INFORMATION SHALL BE USED BY ANY PERSON OR FIRM FOR ANY PURPOSE WITHOUT THE EXPRESS WRITTEN CONSENT OF GIBRALTAR DESIGN. THE OWNER MAY RETAIN COPIES FOR INFORMATION AND REFERENCE IN CONNECTION ONLY WITH THIS PROJECT.

REVISIONS

MARK DATE ISSUED FOR

AD-1 11/09/22 ADDENDUM NO. 1

DRAWING

MECHANICAL DIAGRAMS

PROJECT

JACKSON ES ADDITIONS & RENOVATIONS

© GIBRALTAR DESIGN SHEET

& DETAILS

M-601

Copyright © 2022 Millies Engineering Group

					PLUMBING FIXTURE	SCHEDULE		
TAG	FIXTURE/EQUIPMENT	FIXTURE/EQUIPMENT	FIXTURE/EQUIPMENT	ACCEPTABLE	FIXTURE YALVE/FAUCET	FIXTURE VALVE/FAUCET	ACCEPTABLE	ACCESSORIES/REMARKS
NO.	TYPE	DESCRIPTION	MANUFACTURER AND MODEL NO.	MANUF.	TYPE	TYPE	MANUF.	(SEE SPECIFICATIONS FOR ADDITIONAL INFORMATION)
WC-1	WATER CLOSET	VITREOUS CHINA, WALL MOUNTED	AMERICAN STANDARD *3351.101	NOTE #1	BATTERY SENSOR FLUSH VALVE	SLOAN "G2 OPTIMA" *SII6-16	NOTE #5	BEMIS #2155-C SEAT
WC-2	WATER CLOSET	VITREOUS CHINA, WALL MOUNTED	AMERICAN STANDARD #3351.101	NOTE #	BATTERY SENSOR FLUSH VALVE	SLOAN "G2 OPTIMA" *8111-1.6	NOTE #5	BEMIS *2155-C SEAT
UR-1	URINAL	.125 GAL PER FLUSH, VITREOUS CHINA, WALL MOUNTED, ADA	ZURN *Z5755-U	NOTE #	BATTERY SENSOR FLUSH VALVE	ZURN *ZER6003AY-ULF-CPM	NOTE #5	-
L-1	LAVATORY	VITREOUS CHINA, WALL MOUNTED, 20"x18", ADA	AMERICAN STANDARD #0355.012	NOTE #	0.5 GPM-ELECTRONIC BATTERY SENSOR, 4" CE	ENTERSAN *EBF-650-BDT	NOTE *6	PROVIDED WITH THERMOSTATIC MIXING VALVE. MCGUIRE #PW-2150-WC 1-1/2" PROWRAP, MCQUIRE #H2167CCLK SUPPLIES
S-1	SINK	TWO COMPARTMENT STAINLESS STEEL SINK, 33"x19"x6"	ELKAY *LRADQ-3319	NOTE *2	2 HANDLE, HIGH GOOSENECK	ELKAY *LKD2442BHC	NOTE *6	MCGUIRE #B-8912-C9DF P-TRAP, MCGUIRE #H2167CCLK SUPPLIES, JOSAM #61030 SOLIDS INTERCEPTOR
S-2	SINK	1-COMPARTMENT STAINLESS STEEL SINK, 22'x19-1/2'x6-1/2'	ELKAY *LRADQ-2219 AD-1	NOTE *3	2 HANDLE, HIGH GOOSENECK	CHICAGO FAUCET CO. #50-317XKABCP	NOTE *6	MCGUIRE #B-8912-C9DF P-TRAP, MCGUIRE #H2167CCLK SUPPLIES
S-3	SINK	TWO COMPARTMENT UNDERMOUNT, 31-3/4" × 16-1/2" × 5-3/8"	ELKAY *ELUHAD321655	NOTE *3	2 HANDLE, HIGH GOOSENECK	CHICAGO FAUCET CO. #50-317XKABCP	NOTE *4	MCGUIRE #B-8912-C9DF P-TRAP, MCGUIRE #H2167CCLK SUPPLIES, JOSAM #61030 SOLIDS INTERCEPTOR
FD-1	FLOOR DRAIN	CAST IRON BODY, ADJUSTABLE 6'X6' NICKEL BRONZE TOP	WADE *1100-G6	NOTE #3	-	-	-	VANDALPROOF SCREWS
TW-1	TEMPERED WATER VALVE	TEMPERED WATER VALVE	BRADLEY *559-4000A TMV	NOTE #4	-	-	-	YALVE RATED AT 2 GPM ● 5 PSI PRESSURE DROP (MIN. FLOW Ø.5 GPM)
MB-1	MOP BASIN	MOLDED STONE, 24"x24"x10"H	MUSTEE *63M	NOTE #4	WALL MOUNTED SERVICE FAUCET	CHICAGO FAUCET CO. *897-CP	NOTE *6	W/ 3/4" HOSE THREAD, VACUUM BREAKER, WALL BRACE
-	-	-	-	-	-	-	-	-

NOTE \*1: AMERICAN STANDARD, KOHLER, ZURN, SLOAN

NOTE #2: JUST

NOTE #3: ZURN, JOSAM, J.R. SMITH, MIFAB

NOTE \*6: ZURN, DELTA, T&S BRASS, CHICAGO FAUCET CO.

NOTE #5: ZURN, TOTO

NOTE \*4: LEONARD, POWERS, LAWLER

			PLUMBII	NG EQUI	PMENT SCHEDULE								
TAG	4G FIXTURE/EQUIPMENT FIXTURE/EQUIPMENT		FIXTURE/EQUIPMENT	ACCEPTABLE	ACCESSORIES/REMARKS		ELECTRICAL D				7		
NO.	TYPE	DESCRIPTION	MANUFACTURER AND MODEL NO.	MANUF.	(SEE SPECIFICATIONS FOR ADDITIONAL INFORMATION)	HP	KW	FLA	AMPS	MOCP	YOLT	PH	HZ.
EWC-1	ELECTRIC WATER COOLER	ELECTRIC WALL MOUNTED W/ BOTTLE FILLER	ELKAY *LZS&WSLP	NOTE #	-	-	-	-	-	-	120	1	60
-	-	-	-	-	-	-	-	-	-	-	-	-	-
-	-	-	-	-	-	-	-	-	-	-	-	-	-

NOTE \* 1: OASIS, HAWS, SUNROC

### GENERAL NOTES

- A. WORK SHALL COMPLY WITH LOCAL, MUNICIPAL, AND STATE PLUMBING CODES.
- B. THE SCOPE OF WORK SPECIFIED HEREIN AND IN THE SPECIFICATIONS SHALL BE COORDINATED WITH THE CONSTRUCTION MANAGER -REFER TO THE SCOPE OF WORK FOR EACH TRADE. ANY DISCREPANCIES BETWEEN THE CONSTRUCTION DOCUMENTS AND CONSTRUCTION MANAGERS SCOPE SHALL BE BROUGHT TO THE ATTENTION OF THE ARCHITECT/ENGINEER FOR CLARIFICATION. THE ARCHITECT/ENGINEER'S DECISION SHALL BE FINAL.
- C. LAYOUT IS DIAGRAMMATIC. INSTALL PIPING AND EQUIPMENT TO MEET ACTUAL FIELD CONDITIONS. REVIEW PROJECT SPECIFICATIONS BEFORE STARTING ANY WORK, SUBMIT SHOP DRAWINGS OF WORK AS PER SPECIFICATIONS.
- D. COORDINATE PHASING OF WORK AND PROVIDE TEMPORARY PIPING AND SERVICES AS REQUIRED FOR THE IMPLEMENTATION OF WORK WHILE MAINTAINING SERVICES TO PORTIONS OF BUILDING TO REMAIN OCCUPIED.
- I. FIELD VERIFY IF EXISTING ASBESTOS WILL BE ENCOUNTERED PRIOR TO STARTING ANY WORK. IF ASBESTOS IS PRESENT, THE OWNER WILL PROVIDE FOR THE REMOVAL OF ANY MATERIAL CONTAINING ASBESTOS. SEE SPECIFICATIONS FOR FURTHER REQUIREMENTS.
- . LAYOUT WORK TO AVOID CONFLICTS BETWEEN DUCTWORK, LIGHTING, CEILINGS, PIPING AND BUILDING STRUCTURE.
- G. SCHEDULE WORK TO AVOID DOWNTIME AND INCONVENIENCE TO OWNER, OWNER'S EXISTING FACILITY SHALL REMAIN IN OPERATION AT TIMES. REQUIRED SHUTDOWN OF EXISTING UTILITIES SHALL BE SCHEDULED WITH OWNER'S OPERATING PERSONNEL. NOTIFY OWNER'S
- REPRESENTATIVE 48 HOURS IN ADVANCE PRIOR TO ANY SHUTDOWN OF EXISTING PLUMBING SYSTEMS. 4. VERIFY LOCATION AND ELEVATION OF PLUMBING EQUIPMENT, FIXTURES, PIPING, PANELS, ETC. EXPOSED WITHIN OCCUPIED SPACES
- BEFORE THE START OF ANY ROUGH-IN OR INSTALLATION.
- COORDINATE EQUIPMENT ELECTRICAL REQUIREMENTS (YOLTAGES, PHASE, LOAD, ETC.) BEFORE ORDERING ANY EQUIPMENT.
- VISIT SITE PRIOR TO BIDDING TO DETERMINE FIELD CONDITIONS. VERIFY EXISTING INTERIOR PLUMBING SYSTEMS TO VERIFY QUANTITIES AND LOCATIONS OF EXISTING SYSTEMS TO DETERMINE EXTENT OF NEW AND DEMOLITION WORK. YERIFY EXISTING INTERIOR STORM AND SANITARY PIPING SYSTEMS AS TO ROUTING, SIZE AND INVERT ELEVATION PRIOR TO ANY INSTALLATION OF NEW AND REMOVAL OF ANY
- COORDINATE NEW INSTALLATIONS WITH EXISTING SYSTEMS. ANY EXISTING CONDUIT, PIPING, DUCTWORK, EQUIPMENT, ETC., SHALL BE REWORKED AS REQUIRED TO AVOID CONFLICTS WITH THE INSTALLATION OF THE NEW PLUMBING SYSTEMS. NO EXTRAS WILL BE ALLOWED AFTER BIDDING FOR ANY REWORK OF EXISTING FIELD CONDITIONS TO RESOLVE ANY CONFLICTS OR NOT FULLY UNDERSTANDING THE SCOPE OF THE WORK REQUIRED. EXISTING EQUIPMENT, FIXTURES AND PIPING, ETC., SHALL BE REMOVED AS NOTED ON DRAWINGS AND AS REQUIRED TO MEET NEW SCOPE OF WORK.
- REMOVE EXISTING EQUIPMENT, FIXTURES, PIPING, ETC. PRESENTLY SERVING AREAS THAT ARE BEING RENOVATED AND THAT ARE NOT REQUIRED TO STAY IN SERVICE. NO EQUIPMENT, FIXTURES, PIPING, SUPPORTS, HANGERS, ETC, IS TO BE LEFT ABANDONED. VERIFY QUANTITY, LOCATION AND ELEVATION OF EXISTING TO BE REMOVED IN FIELD. REMOVE EXISTING ABANDONED EQUIPMENT, FIXTURES AND PIPING IN AREAS THAT ARE TO BE RENOVATED.
- M. EXISTING INFORMATION IDENTIFIED ON THE CONTRACT DOCUMENTS IS SCHEMATIC ONLY AS AN AID TO THE CONTRACTOR PROPERLY ADDRESS EXISTING CONDITIONS FOR A COMPLETE AND PROPER INSTALLATION OF NEW SYSTEMS. EXISTING EQUIPMENT NOT IDENTIFIED SHALL BE REPORTED IN WRITTEN FORM FOR REVIEW AS TO WHETHER THE EQUIPMENT SHALL REMAIN AND BE RECONNECTED TO THE NEW SERVICES, BE RELOCATED, BE ABANDONED, ETC.
- . ANY HIDDEN CONDITIONS IDENTIFIED THROUGH THE COURSE OF CONSTRUCTION SHALL BE IMMEDIATELY REPORTED IN WRITTEN FORM FOR REVIEW AND DIRECTION. FAILURE TO DO SO SHALL MAKE THE CONTRACTOR RESPONSIBLE FOR ANY REQUIRED CHANGES AND COSTS TO CORRECT SAID HIDDEN CONDITION.
- D. REMOYED PIPING IS TO BE TERMINATED PROPERLY BACK TO EXISTING MAINS, CAP PIPING WATERTIGHT, PROYIDE ADDITIONAL PIPING AS REQUIRED TO MAINTAIN CONTINUITY OF EXISTING SYSTEMS MODIFIED DUE TO REMOVAL OF PORTION OF SYSTEMS.
- P. PROVIDE FINISHING OF EXISTING CEILING, FLOOR, AND WALL SURFACES AT LOCATIONS AFFECTED BY REMOVAL OF EXISTING MATERIALS AND EQUIPMENT SO THAT NEW FINISH WILL MATCH EXISTING IN SURROUNDING AREAS.
- Q. REMOVE EXISTING CEILINGS REQUIRED FOR INSTALLATION OF NEW WORK, REINSTALL CEILING UPON COMPLETION OF WORK, REPLACE DAMAGED CEILING MATERIALS TO MATCH EXISTING.
- R. PROVIDE AND INSTALL PLENUM WRAP, TESTED TO UL 84 AND UL 910, ON ALL EXISTING PVC PIPING IN NEW OR EXISTING RETURN AIR
- CEILING PLENUMS. 3. PROVIDE CUTTING, TRENCHING AND PATCHING OF EXISTING FLOOR SLAB REQUIRED FOR THE INSTALLATION OF NEW UNDERGROUND
- CUT OR CHANNEL INTO EXISTING WALL CONSTRUCTIONS AS REQUIRED FOR INSTALLATION OF NEW PIPING WITHIN EXISTING WALLS. PATCH
- WALL SURFACES AND FINISH AS REQUIRED TO MATCH EXISTING CONDITIONS. PROVIDE ROUGH-IN AND FINAL CONNECTIONS TO PLUMBING EQUIPMENT AND FIXTURES. SET FIXTURES/EQUIPMENT AND FURNISH AND
- INSTALL NECESSARY FITTINGS, TRAPS, STOPS, ETC. AS REQUIRED.
- Y. PLUMBING PIPING ROUTING TO BE FIELD COORDINATED WITH NEW AND EXISTING HYAC DUCTWORK, HYAC PIPING, FIRE PROTECTION PIPING, ELECTRICAL AND STRUCTURE TO ENSURE NO CONFLICTS WILL OCCUR DUE TO INTERFERENCE.
- W. PIPING, EQUIPMENT, ETC. SHALL NOT BE SUPPORTED FROM THE BOTTOM CHORD OF ENGINEERED JOISTS WITHOUT WRITTEN APPROVAL FROM THE STRUCTURAL ENGINEER.
- X. ISOLATION VALVES SHALL BE INSTALLED OVER ACCESSIBLE CEILINGS. WHEN ISOLATION VALVES ARE INSTALLED OVER INACCESSIBLE CEILING AREAS, IT SHALL BE THE RESPONSIBILITY OF THIS CONTRACTOR TO FURNISH AND INSTALL 12" X 12" (MINIMUM) CEILING ACCESS
- DOORS, TYPE TO BE VANDALPROOF, TAMPERPROOF ASSEMBLIES, INSTALLATION TO BE COORDINATED WITH GENERAL CONTRACTOR.
- Y. REFER TO ARCHITECTURAL INTERIOR ELEVATIONS FOR FINAL MOUNTING HEIGHTS OF PLUMBING FIXTURES.
- . PROTECT NEW AND EXISTING DRAIN OPENINGS AND SANITARY LINES DURING CONSTRUCTION TO PREVENT BLOCKAGE. ROD-OUT EXISTING SANITARY PIPING. PIPING SHALL BE FREE OF BLOCKAGE.
- AA. REPAIR AND/OR REPLACE DAMAGED PIPE INSULATION THAT OCCURS AS THE RESULT OF THIS CONSTRUCTION.
- AB. VIDEOTAPE EXISTING SANITARY MAIN TO CONFIRM EXISTING BRANCH SANITARY CONNECTION POINTS, INVERTS AND CONDITION OF PIPING AS REQUIRED TO COMPLETE WORK, PROVIDE REPORT INDICATING CONNECTION POINT LOCATIONS, INVERTS, AND ANY DEFICIENCIES IN EXISTING SANITARY PIPING SYSTEM PRIOR TO STARTING WORK.

### SYMBOL LIST

EXISTING UNDERGROUND SANITARY PIPING EXISTING COLD WATER PIPING

EXISTING HOT WATER PIPING EXISTING HOT WATER RECIRCULATION PIPING

EXISTING PIPING EXISTING PIPING TO BE REMOVED (ABOVE GROUND) OR CAPPED AND ABANDONED IN PLACE (UNDERGROUND)

NEW UNDERGROUND SANITARY SEWER

------ NEW COLD WATER PIPING NEW HOT WATER PIPING

CLEANOUT

----- NEW HOT WATER RECIRCULATION PIPING NEW YENT PIPING

> PIPE DOWN PIPE UP SHUT-OFF YALVE CHECK YALVE

HOSE BIBB/SILL COCK BALANCING COCKMANUAL

FLOW CONTROL YALVE SHEET NOTE TAG

CO

CTE CONNECT TO EXISTING CW COLD WATER ELECTRIC WATER COOLER EXISTING FLOOR CLEANOUT FLOOR DRAIN

FLOOR SINK HOT WATER HOT WATER RECIRCULATION LAYATORY MOP BASIN

SILL COCK TEMPERED WATER URINAL

VENT THROUGH ROOF WATER CLOSET

**GIBRALTAR** DESIGN

ARCHITECTURE • ENGINEERING • INTERIOR DESIGN

**JACKSON** ELEMENTARY SCHOOL -**RENOVATIONS** 

DUNELAND SCHOOL CORPORATION CHESTERTON, INDIANA

GIBRALTAR DESIGN 9102 N. Meridian St., Ste. 300 Indianapolis, IN 46260 Homepage www.GibraltarDesign.com

Email info@GibraltarDesign.com Phone 317.580.5777 Fax 317.580.5778 PROJECT 10/31/22

10302590 COORDINATED ••• DRAWN BY MDG CHECKED BY

COPYRIGHT NOTICE: THE CONCEPTS, DESIGNS, PLANS, DETAILS, ETC, SHOWN ON THIS DOCUMENT ARE THE PROPERTY OF GIBRALTAR DESIGN AND WERE CREATED FOR USE ON THIS SPECIFIC PROJECT. NONE OF THIS INFORMATION SHALL BE USED BY ANY PERSON OR FIRM FOR ANY PURPOSE WITHOUT THE EXPRESS WRITTEN CONSENT OF GIBRALTAR DESIGN. THE OWNER MAY RETAIN COPIES FOR INFORMATION AND REFERENCE IN CONNECTION ONLY WITH THIS PROJECT.

REVISIONS MARK DATE ISSUED FOR | AD-1 | 11/09/22 | ADDENDUM NO. 1


DRAWING

PLUMBING SCHEDULE. NOTES, SYMBOLS & **ABBREVIATIONS** 

PROJECT JACKSON ES -**ADDITIONS & RENOVATIONS** 

© GIBRALTAR DESIGN SHEET

Copyright © 2022 Millies Engineering Group

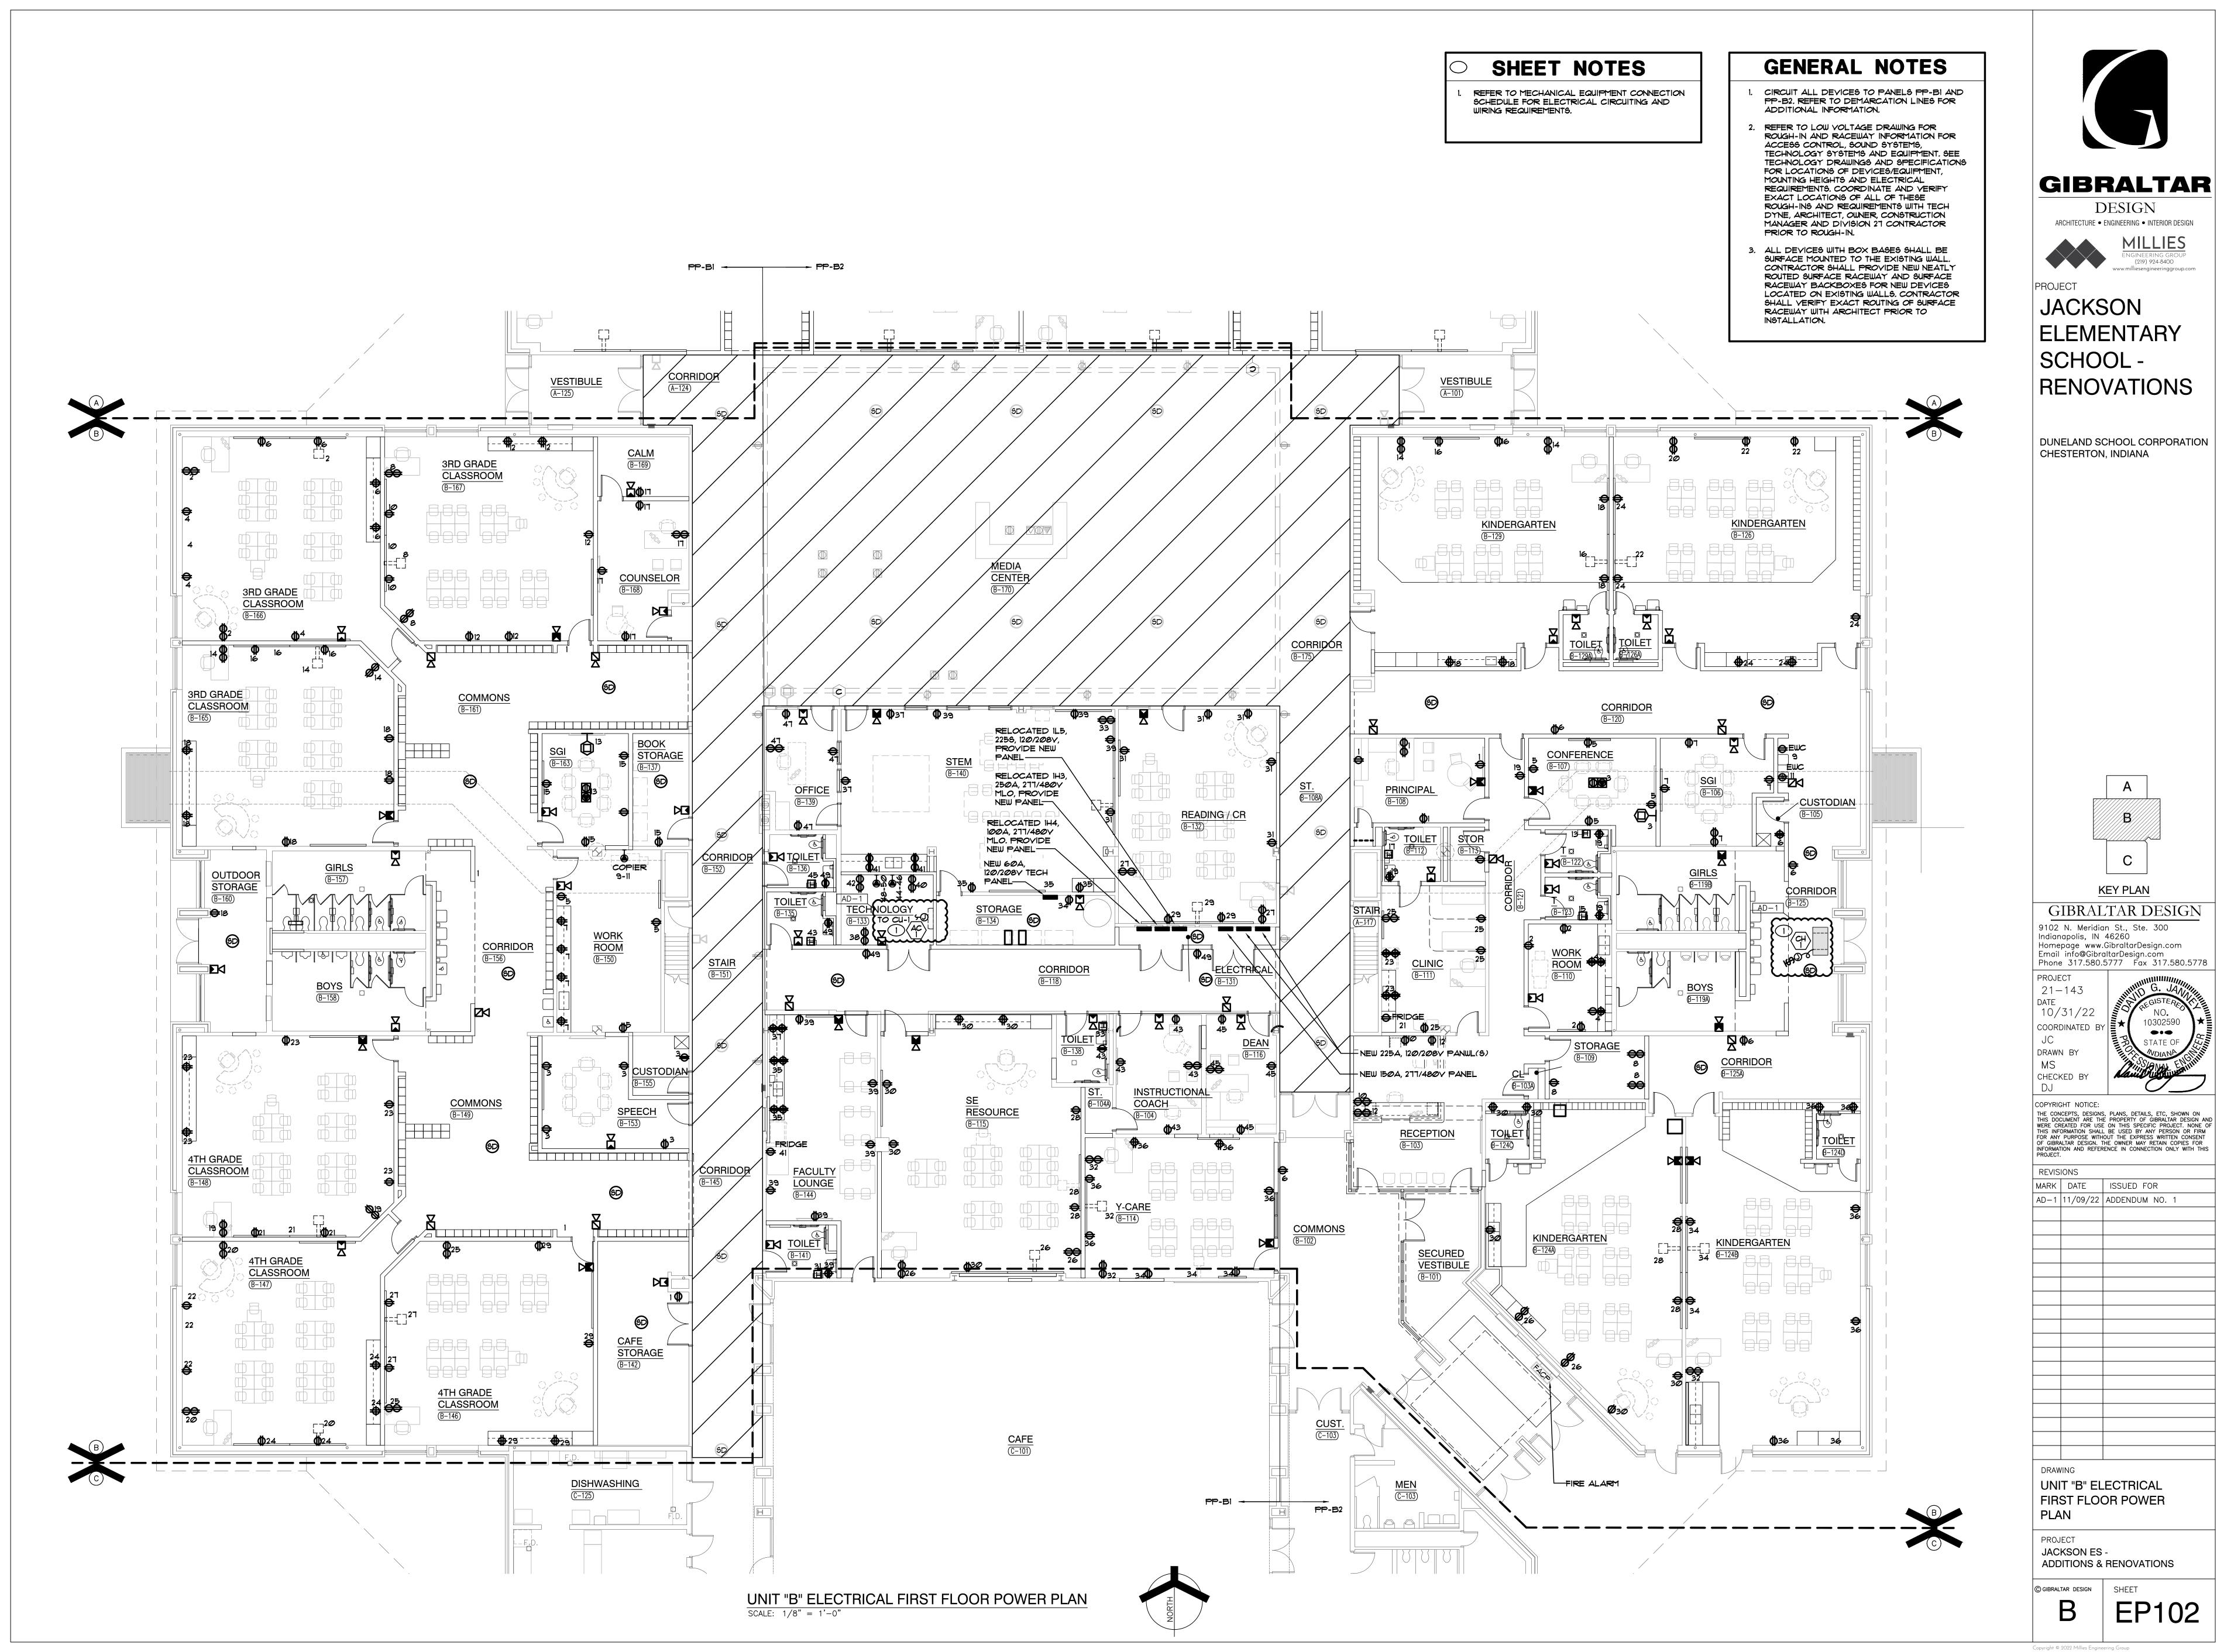

REVISIONS										
MARK	DATE	ISSUED FOR								
AD-1	11/09/22	ADDENDUM NO. 1								

SHEET NOTES REFER TO MECHANICAL EQUIPMENT CONNECTION FOR ADDITIONAL CIRCUITING AND WIRING INFORMATION. MECHANICAL EQUIPMENT ØF.D. 1 QF.D.




GIBRALTAR DESIGN

ARCHITECTURE • ENGINEERING • INTERIOR DESIGN



JACKSON ELEMENTARY SCHOOL -RENOVATIONS

DUNELAND SCHOOL CORPORATION CHESTERTON, INDIANA

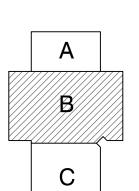

KEY PLAN

GIBRALTAR DESIGN

9102 N. Meridian St., Ste. 300 Indianapolis, IN 46260 Homepage www.GibraltarDesign.com Email info@GibraltarDesign.com Phone 317.580.5777 Fax 317.580.5778

COORDINATED DRAWN BY

CHECKED BY

COPYRIGHT NOTICE:

THE CONCEPTS, DESIGNS, PLANS, DETAILS, ETC, SHOWN ON THIS DOCUMENT ARE THE PROPERTY OF GIBRALTAR DESIGN AND WERE CREATED FOR USE ON THIS SPECIFIC PROJECT. NONE OF THIS INFORMATION SHALL BE USED BY ANY PERSON OR FIRM FOR ANY PURPOSE WITHOUT THE EXPRESS WRITTEN CONSENT

OF GIBRA	ALTAR DESIGN. <sup>-</sup> FION AND REFER	IOUT THE EXPRESS WRITTEN CONSENTHE OWNER MAY RETAIN COPIES FOF RENCE IN CONNECTION ONLY WITH T
REVIS	IONS	
MARK	DATE	ISSUED FOR
AD-1	11/09/22	ADDENDUM NO. 1

DRAWING ELECTRICAL MEZZANINE POWER PLAN


PROJECT

JACKSON ES ADDITIONS & RENOVATIONS

© GIBRALTAR DESIGN SHEET

Copyright © 2022 Millies Engineering Group

EP104

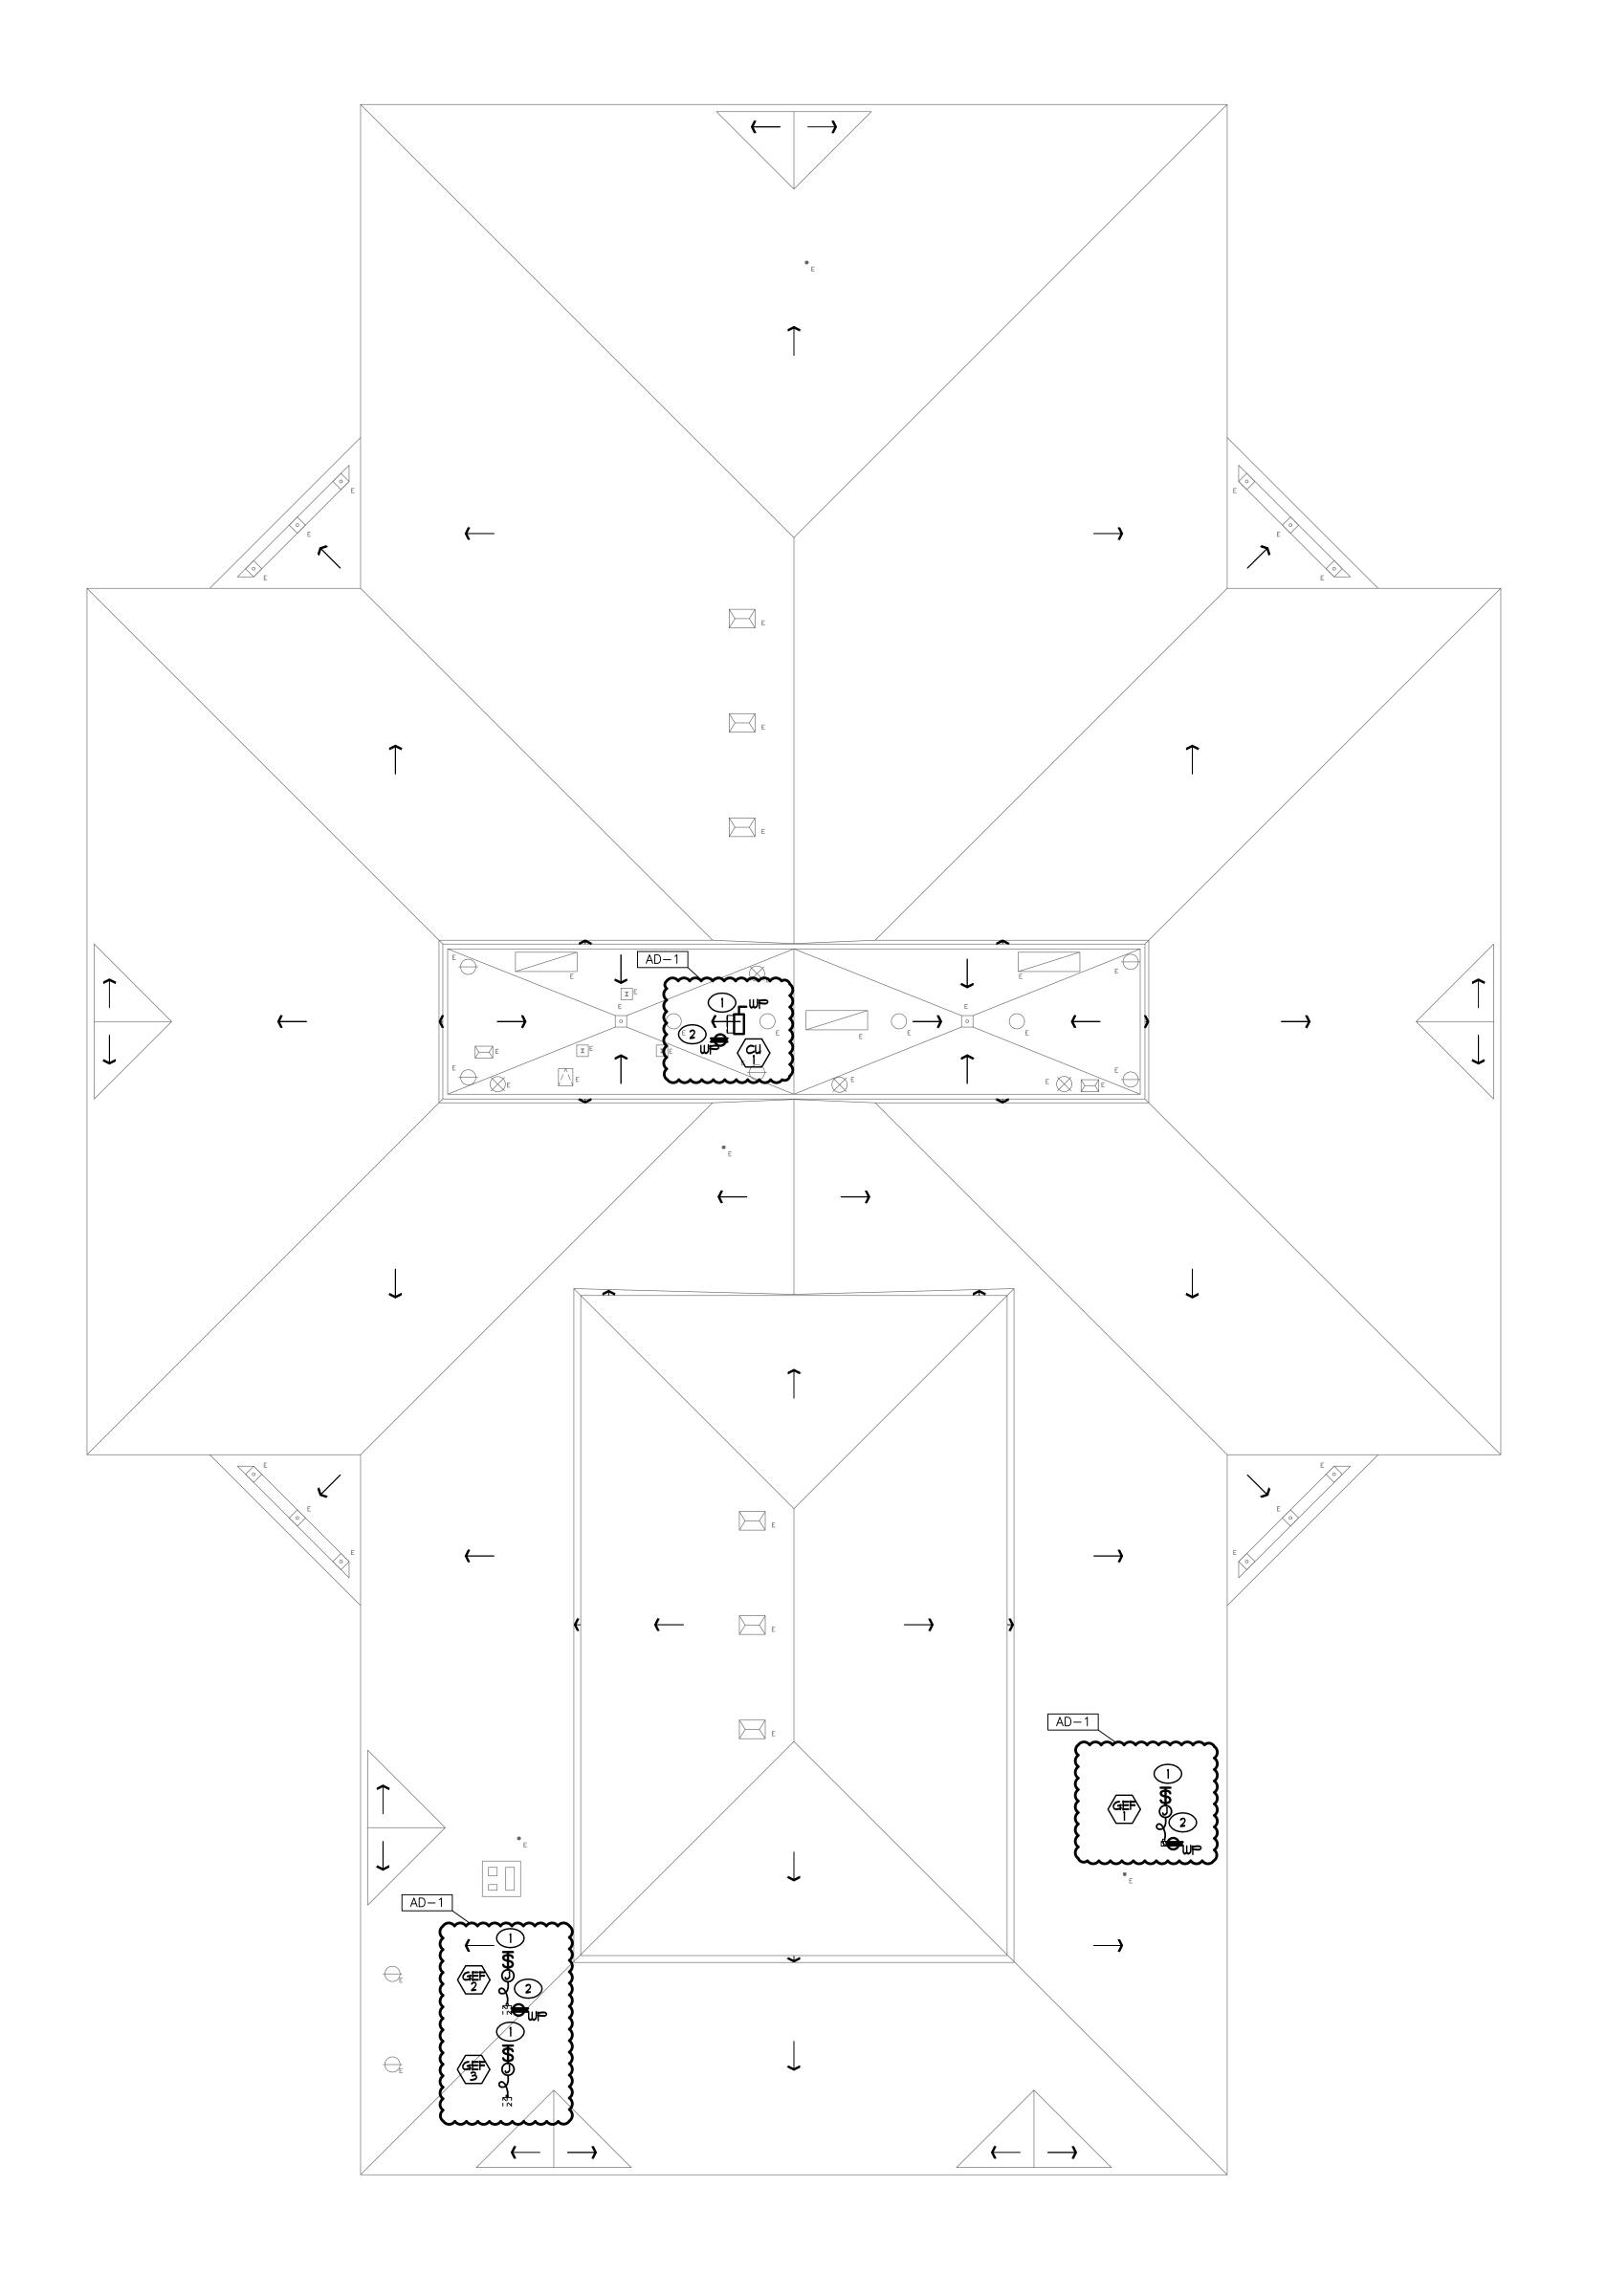



# SHEET NOTES

- REFER TO MECHANICAL EQUIPMENT CONNECTION FOR ADDITIONAL CIRCUITING AND WIRING INFORMATION.
- . LOCATE WEATHERPROOF GFI TYPE RECEPTACLE ON UNIT IN AN APPROVED MANNER.




GIBRALTAR

DESIGN ARCHITECTURE • ENGINEERING • INTERIOR DESIGN



JACKSON ELEMENTARY SCHOOL -RENOVATIONS

DUNELAND SCHOOL CORPORATION CHESTERTON, INDIANA

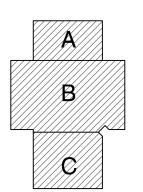

KEY PLAN

GIBRALTAR DESIGN

9102 N. Meridian St., Ste. 300 Indianapolis, IN 46260 Homepage www.GibraltarDesign.com Email info@GibraltarDesign.com Phone 317.580.5777 Fax 317.580.5778

COORDINATED DRAWN BY

AUTHOR CHECKED BY

COPYRIGHT NOTICE: THE CONCEPTS, DESIGNS, PLANS, DETAILS, ETC, SHOWN ON THIS DOCUMENT ARE THE PROPERTY OF GIBRALTAR DESIGN AND WERE CREATED FOR USE ON THIS SPECIFIC PROJECT. NONE OF THIS INFORMATION SHALL BE USED BY ANY PERSON OR FIRM FOR ANY PURPOSE WITHOUT THE EXPRESS WRITTEN CONSENT OF GIBRALTAR DESIGN. THE OWNER MAY RETAIN COPIES FOR INFORMATION AND REFERENCE IN CONNECTION ONLY WITH THIS PROJECT.

REVISI	ONS		
MARK	DATE	ISSUED FOR	
AD-1	11/09/22	ADDENDUM NO	). 1

OVERALL ELECTRICAL POWER ROOF PLAN

JACKSON ES -ADDITIONS & RENOVATIONS

© GIBRALTAR DESIGN SHEET

Copyright © 2022 Millies Engineering Group

**EP201** 



MECHANICAL EQUIPMENT CONNECTION SCHEDULE																		
TAG	DESCRIPTION			LOAD			MOCP	VOLT	PHASE	PANEL	CKT. NO.	FUSED SWITCH	FEEDER		START	ER BY:	LOCATION REMARKS	
		WATTS		HP MCA		FLA AMPS					C/B	CABLE			EC.			
C-1	GRADE MOUNTED AIR COOLED CHILLER W/ REMOTE INTERIOR BUNDLE	212582	-	256	-	-	300	480	3	MSB	-	300A/3P	4 *35Ø 4 1 *4 GRD	3"	×	-		
4H-JBI	INTERIOR CENTRAL STATION AIR HANDLING UNIT	8512	-	10	-	-	15	480	3	MSB	-	15A/3P	4 412 4 1 412 GRD	3/4'	×	-		
-	HOT WATER HEATING / CHILLED WATER COOLING - SZVAV	-	-	-	-	-	-	-	-	-	-	-	-	-	-	-		
H-JB2	INTERIOR CENTRAL STATION AIR HANDLING UNIT	28Ø26	-	34	-	-	60	480	3	MSB	-	60A/3P	4 % 4 1 40	1"	×	-		
-	HOT WATER HEATING / CHILLED WATER COOLING - SZYAY	-	-	-	-	-	-	-	-	-	-	-	-	-	-	-		
H-JA3	INTERIOR CENTRAL STATION AIR HANDLING UNIT	8512	-	10	-	-	15	480	3	MSB	-	15A/3P	4 #12 4 1 #12 GRD	3/4'	×	-		
-	HOT WATER HEATING / CHILLED WATER COOLING - SZYAY	-	-	-	-	-	-	-	-	-	-	-	-	-	×	-		
CH-I	RECESSED CEILING MOUNTED HOT WATER CABINET HEATER	168	-	-	-	1.4	-	120	1	MSB	-	20A/IP	2 41 41 GRD	3/4"	×	-		
GEF-I	GENERAL ROOF MOUNTED EXHAUST FAN - C112-STORAGE	528	1/6	-	-	-	-	120	1	-	-	20A/IP	2 41 41 GRD	3/4"	×	-		
GEF-2	GENERAL ROOF MOUNTED EXHAUST FAN - C120-BOILER ROOM	1176	1/2	-	-	-	-	120	1	-	-	20A/IP	2 41 41 GRD	3/4"	×	-		
GEF-3	GENERAL ROOF MOUNTED EXHAUST FAN - C120-BOILER ROOM	1920	1	-	-	-	-	120	1	-	-	20A/IP	2 41 41 GRD	3/4"	×	-		
C-1/CU-1	WALL MTD AC UNIT / ROOF MOUNTED CONDENSING UNIT	3328	-	16	-	-	20	208	1	-	-	20A/IP	3 #12 4 1 #12 GRD	3/4'	×	-		

	PUMP EQUIPMENT CONNECTION SCHEDULE														
TAG	DESCRIPTION	LOAD WATTS	TP.	MOCP	<b>YO</b> LT	PHASE	PANEL	CKT. NO.	FUSED SWITCH C/B	FEEDER CABLE	O	START	ED BY:	LOCATION	REMARKS
CP-I	CHILLER PUMP	3986	3	-	480	3	-	-	20A/3P	4 #12 \$ 1 #12 GRD	3/4"	-	-	-	-
CWP-1	CHILLED WATER DISTRIBUTION PUMP	6311	5	-	480	3	-	-	20A/3P	4 #12 4 1 #12 GRD	3/4"	-	-	-	-
CWP-2	CHILLED WATER DISTRIBUTION PUMP	6311	5	-	480	3		-	20A/3P	4 #12 4 1 #12 GRD	3/4"				

## LIGHTING CONTROL SYSTEM NOTES

1. UNLESS NOTED OTHERWISE, THE LIGHTING CONTROL SYSTEM SHALL BE A STAND ALONE SENSORSWITCH WIRED SYSTEM COMPLETE WITH OCCUPANCY SENSORS, POWER PACKS, EMERGENCY ACCESSORIES, ETC. SYSTEM TO BE PROVIDED WITH COMPONENTS AND ACCESSORIES AS REQUIRED TO PROVIDE FUNCTIONALITY PER THE

2. LIGHTING CONTROL EQUIPMENT WILL BE CONSIDERED FROM THE FOLLOWING MANUFACTURERS: EATON CONTROLS, LEVITON, WATTSTOPPER OR HUBBELL CONTROLS, THE SUBMITTED LIGHTING CONTROL SYSTEM SHALL PROVIDE FULL LIGHTING CONTROL FUNCTIONALITY AS SPECIFIED. 3. BECAUSE OF DIFFERENCES BETWEEN MANUFACTURERS, DIAGRAMS SHOWN ARE DIAGRAMMATIC AND MAY NOT

AND ACCESSORIES REQUIRED FOR A COMPLETE AND PROPERLY OPERATING SYSTEM AS SHOWN ON

SHOW ALL PARTS AND ACCESSORIES REQUIRED. CONTRACTOR SHALL COORDINATE ALL REQUIREMENTS WITH LIGHTING CONTROL MANUFACTURER AND CONTRACT DOCUMENTS, CONTRACTOR SHALL PROVIDE ALL PARTS

- CONTRACT DOCUMENTS. VERIFY ALL CONDITIONS AND REQUIREMENTS, COMPLETE AS REQUIRED. 4. NO EXTRAS SHALL BE ALLOWED AFTER BIDDING FOR NOT FULLY UNDERSTANDING THE SCOPE OF WORK
- INVOLVED OR TO FULLY ACCOMPLISH THE SWITCHING SCHEME SHOWN ON THE CONTRACT DOCUMENTS. 5. PROVIDE 12 HOURS OF FACTORY COMMISSIONING AND 6 HOURS FACTORY TRAINING FOR THE OWNER'S
- BUILDING STAFF. 6. UL924 BYPASS DEVICES SHALL BE PROVIDED FOR ALL FIXTURES WITH AN EMERGENCY SOURCE OF POWER
- SIGNAL, COMPLETE AS REQUIRED. 7. ALL LOW YOLTAGE CABLING SHALL BE PLENUM RATED. CABLING ROUTED IN CONCEALED AREAS SHALL BE ROUTED NEATLY EXPOSED WITHIN J-HOOKS, CABLING LOCATED IN EXPOSED CEILINGS SHALL BE CONCEALED IN NEATLY ROUTED CONDUIT. LOW YOLTAGE CABLING INSTALLATION SHALL FULLY MEET LOCAL CODE REQUIREMENTS.

THAT IS SWITCHED. THE UL924 BYPASS SHALL PROVIDE BYPASS FOR BOTH THE POWER AND CONTROL

# LIGHTING FIXTURE GENERAL NOTES

- INTERIOR FIXTURES, EXTERIOR FIXTURES AND POLE FINISHES AND COLORS TO BE SELECTED BY ARCHITECT. THE ARCHITECT MAY, AT THEIR DISCRETION, CHOOSE A CUSTOM COLOR AT NO ADDITIONAL CHARGE.
- 2. PENDANT FIXTURES SPECIFIED ON THIS PROJECT SHALL BE CAREFULLY COORDINATED WITH CONTRACT DOCUMENTS AND FIXTURE MANUFACTURER AS EACH PENDANT FIXTURE IS A CUSTOM MANUFACTURED FIXTURE. PROVIDE PENDANT EMERGENCY SECTIONS AND EMERGENCY CIRCUITS AS SHOWN. COORDINATE WITH FIXTURE MANUFACTURER AND PROVIDE ADDITIONAL ACCESSORIES FOR A COMPLETE AND PROPER INSTALLATION. PROVIDE PROPER FIXTURE LENGTH, FEEDS, SINGLE AND DUAL CIRCUITING AND SUSPENSION LENGTH AS SHOWN ON DRAWINGS. PROVIDE FABRICATION DRAWINGS FOR REVIEW AS PART OF THE SHOP DRAWING SUBMITTAL PROCESS.
- 3. SHADED FIXTURES SHALL HAVE AN EMERGENCY SOURCE OF POWER AS SPECIFIED.

AD-1

- 4. EXTERIOR LIGHTING POLES SHALL BE PROVIDED WITH STRAIGHT SQUARE ALUMINUM POLES WITH CAST BASE COVERS AND VIBRATION DAMPENERS. THE POLES SHALL BE SIZED PROPERLY TO SUPPORT FIXTURE WEIGHT AT 100 MPH WIND WITH A 1.3 GUST FACTOR, MINIMUM POLE SIZE TO BE 5" SQUARE. PROVIDE ADDITIONAL MOUNTING ACCESSORIES AS REQUIRED FOR A COMPLETE AND PROPER INSTALLATION.
- 5. FOR EXTERIOR POLE MOUNTED LIGHTING, PROVIDE FACTORY MOUNTED HOUSE SIDE SHIELDS INTEGRAL TO THE FIXTURE AS SPECIFIED. ADDITIONALLY, PROVIDE CUSTOM FABRICATED POLE MOUNTED HOUSE SIDE SHIELDING AS REQUIRED TO CONTROL LIGHT TRESPASS AND COMPLY WITH LOCAL REQUIREMENTS.
- 6. CAREFULLY COORDINATE MOUNTING REQUIREMENTS FOR FIXTURES WITH CONTRACT DOCUMENTS AND FIXTURE MANUFACTURER. PROVIDE APPROPRIATE MOUNTING FRAMES FOR LAY-IN OR GYPSUM CEILINGS. VERIFY CEILING REQUIREMENTS WITH FINAL ARCHITECTURAL REFLECTED CEILING PLAN.
- 1. VERIFY FIXTURE MOUNTING HEIGHTS WITH ARCHITECT PRIOR TO ROUGH-IN.
- 8. FOR FIXTURES INSTALLED IN CASEWORK, VERIFY FIXTURE FIT WITH CASEWORK SHOP DRAWINGS PRIOR TO ORDERING.
- 9. PROVIDE CUSTOM ANTI-SWAY BRACING FOR PENDANT TO ELIMINATE PENDANT MOVEMENT DUE TO AIR MOVEMENT OR ENVIRONMENTAL CAUSES.
- 10. COORDINATE LOCATIONS OF INTERIOR AND EXTERIOR LIGHTING FIXTURES WITH FINAL ARCHITECTURAL DRAWINGS, FIXTURES THAT ARE NOT INSTALLED IN THE CORRECT LOCATION SHALL BE RELOCATED AND REINSTALLED IN THE CORRECT LOCATION AT NO ADDITIONAL CHARGE.
- 11. FIXTURES SHALL BE PROVIDED WITH ESCUTCHEON PLATES AS REQUIRED TO COVER EXISTING HOLES FROM REMOVED FIXTURES. CANOPY CEILING AROUND NEW FIXTURES SHALL BE REFINISHED TO MATCH EXISTING SURROUNDING CANOPY CEILING SURFACES.
- 12. PROVIDE 5000K COLOR TEMPERATURE IN SPECIAL EDUCATION SPACES AS SPECIFIED.
- 13. FIXTURES SHALL BE CAREFULLY COORDINATED WITH MANUFACTURER TO DELIVER THE SPECIFIED PRODUCT IN SUFFICIENT TIME TO MEET PROJECT DEADLINES, EQUIPMENT DELIVERY LEAD TIME SHALL NOT BE HELD AS A VALID REASON FOR REQUESTING LUMINAIRE SUBSTITUTION UNLESS LUMINAIRE LEAD TIME FROM SPECIFIED MANUFACTURER IS IN EXCESS OF 14 WEEKS. IT SHALL BE THE SOLE RESPONSIBILITY OF THE ELECTRICAL CONTRACTOR TO DETERMINE NECESSARY EQUIPMENT LEAD TIMES, DELIVER SUBMITTALS FOR REVIEW IN A TIMELY FASHION, AND PLACE ORDERS ACCORDINGLY TO ENSURE TIMELY DELIVERY.
- 14. EVALUATION OF APPROVED EQUALS SHALL BE AT THE SOLE DISCRETION OF THE ARCHITECT AND ENGINEER IF THE PRODUCT SUBMITTED DURING THE REVIEW PROCESS IS NOT JUDGED AS AN EQUAL BY THE REVIEWING ENGINEER, THE CONTRACTOR SHALL PROVIDE THE PRODUCT SPECIFIED.
- 15. CAREFULLY COORDINATE VOLTAGES OF FIXTURES PRIOR TO ORDERING FIXTURES.
- 16. APPROVED EQUALS WILL BE CONSIDERED FROM THE FOLLOWING VENDORS: KSA LIGHTING (630.307.6955), FORCE CHICAGO (312.986.1515) OR PG ENLIGHTEN
- 17. CAREFULLY VERIFY COLOR TEMPERATURE OF FIXTURES WITH ARCHITECT PRIOR TO ORDERING.

		INTERIO	OR LIGHTING LUMINA	AIRE :	SCHEDU	JLE	
TAG	SYMBOL	DESCRIPTION	MANUFACTURER SERIES DR CATALDG NUMBER	VOLTAGE/ BALLAST	LAMPS/CROSS SECTION	MOUNTING	REMARKS
ДД	0	2' X 4' LED DIRECT/INDIRECT FIXTURE	LITHONIA *2BLT4-40L-ADP-GZI-LP840 COLUMBIA *LCAT24-40-LW-G-EDI-U DAY-BRITE *2FGXG40L840-4-RS-UNY-DIM	MY YOLT 0-10Y DIM -	LED 1 4000K MAX 32 W MIN 4000 LM	RECESSED LAY-IN	- - -
<b>AA</b> 1	•	2' X 4' LED DIRECT/INDIRECT FIXTURE	LITHONIA *2BLT4-48L-ADP-GZI-LP840 COLUMBIA *LCAT24-40-ML-G-EDI-U DAY-BRITE *2FGXG48L840-4-R5-UNY-DIM	MV YOLT Ø-1ØY DIM -	LED 4000K MAX 38 W MIN 4800 LM	RECESSED LAY-IN	- - - -
<b>4</b> <i>A</i> 2	0	2' X 4' LED DIRECT/INDIRECT FIXTURE	LITHONIA *2BLT4-60L-ADP-GZI-LP840 COLUMBIA *LCAT24-40-VL-G-EDI-U DAY-BRITE *2FGXG60L840-4-RS-UNV-DIM	MY YOLT 0-10Y DIM -	LED 1 4000K MAX 48 W MIN 6000 LM	RECESSED LAY-IN	- - - -
AB	0	2' × 2' LED DIRECT/INDIRECT FIXTURE	LITHONIA *2BLT2-48L-ADP-GZI-LP840 COLUMBIA *LCAT22-40-VL-G-EDI-U DAY-BRITE *2FGXG48L840-2-RS-UNV-DIM	MY VOLT 0-10Y DIM - -		RECESSED LAY-IN	- - - -
AB1	0	2' X 2' LED DIRECT/INDIRECT FIXTURE	LITHONIA *2BLT2-4ØL-ADP-GZI-LP84Ø COLUMBIA *LCAT22-4Ø-HL-G-EDI-U DAY-BRITE *2FGXG4ØL84Ø-2-RS-UNV-DIM	MV VOLT Ø-1ØV DIM - -	LED 1 4000K MAX 32 W MIN 4000 LM	RECESSED LAY-IN	- - - -
CA	0	6' DIAMETER LED DOWNLIGHT WITH SEMI-SPECULAR ALZAK REFLECTOR, IRIDESCENT FREE FINISH, & WHITE FLANGE	LITHONIA *LDN6-40-15-LO6-AR-LSS-MVOLT -GZIØ-XX PRESCOLITE *LTR-SLI5L-DMI / *LTR-6RD-T-SL4ØK8MD LIGHTOLIER *6RN / *Z6RDLI584ØWOCDZIØU	MY VOLT Ø-10Y DIM - -		RECESSED LAY-IN/ DRYWALL	-VERIFY TRIM FINISH WITH ARCHITECT
FA		LINEAR LED FIXTURE FOR DISPLAY CASE WITH 45 DEG. EXTRUSION AND CONTINUOUS LENGTHS AS SHOWN	OPTIC ARTS *LL12-HO-4IK-X-X-X-X-X Q-TRAN *SW 24-5,0-DRY-40K / VEVE-FR ACOLYTE *RB-90-SW5265-5,040 PROVIDE WITH POWER SUPPLIES AND ALL ACCESSORIES AS REUQIRED	MY YOLT MLY DIM -	LED 4000K MAX 4.5W/FT MIN 440 LM/FT	SURFACE	-VERIFY FINISH WITH ARCHITECT -COORDINATE MOUNTING WITH CASEWORK
FAI		LED 4' WIDE CONTINUOUS LINEAR SLOT FIXTURE	MARK *\$L4L-LOP-X-FLP-X-80CRI-40K-800LMF -MINI-MVOLT NULITE *RG4-09-L40-UNV-D-X-X-FRF-XX- FINELITE *HP4-R-D-X-V-840-F-96LG-UNV -SC-FC-10-X-FE-X	120/277 VOL 0-10V DIM		RECESSED LAY-IN/ DRYWALL	-PROVIDE LENGTHS AS SHOWN ON DRAWINGS -VERIFY FINISH WITH ARCHITECT -COORDINATE EMERGENICIRCUITS AND SWITCHING WITH PLANS
PA	<b>□</b>	4', LED INDUSTRIAL FIXTURE WITH WIREGUARD AND SAFETY CHAINS	LITHONIA *CLX-L48-7000LM-SEF-FDL-MYOLT -GZI0-40K-80CRI-XX-XX COLUMBIA *MPS4-40XL-FW-EDI-U-MPSWG4 DAY-BRITE *FSS470L840-UNV-DIM-FSSWG4	MY VOLT Ø-10Y DIM -		'Y' CHAIN SUSPEND -	-COORD LOCATIONS WITH DUCTWORK & PIPING
×A	⊗ ⊗	SINGLE FACE EXIT, AC ONLY	LITHONIA *LE-S-X-I-R-X DUAL-LITE *SE-S-R-X CHLORIDE *55L-3-X-R	120 VOLT - - -	LED MAX 3W - -	CEILING/ WALL - -	-VERIFY FINISH WITH ARCHITECT -PROVIDE WITH ARROWS AS REQUIRED
ХВ	•	DUAL FACE EXIT AC ONLY	LITHONIA *LE-5-X-2-R-X DUAL-LITE *SE-D-R-X CHLORIDE *55L-3-X-R	120 YOLT - - -	LED MAX 3W - -	CEILING/ WALL - -	-VERIFY FINISH WITH ARCHITECT -PROVIDE WITH ARROWS AS REQUIRED
×c	⊗ 🌣		LITHONIA *LE-6-X-1-R-X DUAL-LITE *SE-6-R-X CHLORIDE *55L-3-X-R	120 YOLT - - -	LED MAX 3W - -	CEILING/ WALL - -	-VERIFY FINISH WITH ARCHITECT -PROVIDE WITH ARROWS AS REQUIRED
EM		FIXTURE ON EMERGENCY LIFE SAFETY GENERATOR CIRCUIT WITH UL924 BYPASSES AS REQUIRED	-	MV VOLT	-	IN FIXTURE/ REMOTE	-
NL		CONSTANT HOT, UNSWITCHED NIGHT LIGHT FIXTURE					



**GIBRALTAR** 

ARCHITECTURE • ENGINEERING • INTERIOR DESIGN

DESIGN

JACKSON **ELEMENTARY** SCHOOL -RENOVATIONS

DUNELAND SCHOOL CORPORATION CHESTERTON, INDIANA

GIBRALTAR DESIGN 9102 N. Meridian St., Ste. 300 Indianapolis, IN 46260 Homepage www.GibraltarDesign.com Email info@GibraltarDesign.com

Phone 317.580.5777 Fax 317.580.5778

PROJECT 10/31/22 COORDINATED E

MS

REVISIONS

••• DRAWN BY CHECKED BY

10302590

COPYRIGHT NOTICE: THE CONCEPTS, DESIGNS, PLANS, DETAILS, ETC, SHOWN ON THIS DOCUMENT ARE THE PROPERTY OF GIBRALTAR DESIGN AND WERE CREATED FOR USE ON THIS SPECIFIC PROJECT. NONE OF THIS INFORMATION SHALL BE USED BY ANY PERSON OR FIRM FOR ANY PURPOSE WITHOUT THE EXPRESS WRITTEN CONSENT OF GIBRALTAR DESIGN. THE OWNER MAY RETAIN COPIES FOR INFORMATION AND REFERENCE IN CONNECTION ONLY WITH THIS PROJECT

MARK	DATE	ISSUED FOR
AD-1	11/09/22	ADDENDUM NO. 1

DRAWING

ELECTRICAL SCHEDULES & NOTES

JACKSON ES -ADDITIONS & RENOVATIONS

© GIBRALTAR DESIGN SHEET

Copyright © 2022 Millies Engineering Group

E-602