

ADDENDUM NO. 2

September 5, 2023

LOWELL HIGH SCHOOL SITE, BLEACHERS, AND TURF/DRAINAGE
Lowell, IN 46356

TO: ALL BIDDERS OF RECORD

This Addendum forms a part of and modifies the Bidding Requirements, Contract Forms, Contract Conditions, the Specifications, and the Drawings dated August 7, 2023 by Gibraltar Design. Acknowledge receipt of the Addendum in the space provided on the Bid Form. Failure to do so may subject the Bidder to disqualification.

This Addendum consists of Pages ADD 2-1 and attached Addendum No. 2 from Gibraltar Design dated August 31, 2023 and consisting of 4 pages, Specification Section 26 05 73 - Electrical Systems Studies, and 26 drawings.

A. SPECIFICATION SECTION 00 00 20 - TABLE OF CONTENTS

1. Add:

Specification Section 26 05 73 - Electrical Systems Studies

B. SPECIFICATION SECTION 01 12 00 - MULTIPLE CONTRACT SUMMARY

H. BID CATEGORY NO. 2 - ELECTRICAL

1. Add:

Specification Section 26 05 73 - Electrical Systems Studies

ADDENDUM TWO

Addendum Two (AD.02) to the drawings and specifications prepared by Gibraltar Design for **Lowell High School Site, Bleachers and Turf/Drainage** for Tri-Creek School Corporation, Lowell, Indiana.

All Contractors bidding on this project shall read all of the items covered below and shall comply with all of the requirements as set forth, including any necessary refinements or additions generated by this Addendum and required by the intent of the original contract documents. All Contractors shall acknowledge on their bid form that they have received this Addendum and include the appropriate content of same within their bid proposal.

SPECIFICATIONS

1. Specification Section 26 05 73

Electrical Systems Studies

- A. Add Specification Section 26 05 73, Electrical Systems Studies, included in this Addendum, to the Project Manual.

DRAWINGS

For each sheet listed in this Addendum, refer to attached full size drawing sheet(s) for revisions, unless noted otherwise.

1. Sheet C-2.2A

- A. Revise Plan Notes 2 and 10
- B. Remove demoed Long Jump and Pole Vault from plan.

2. Sheet C-2.2B

- A. Revise the boarder of artificial turf soccer field.
- B. Revise concrete slab under covered players' bench and aluminum bleacher next to players' bench.
- C. Remove portion of fencing from scope of work at the South end of Soccer Field.

3. Sheet C-2.2D

- A. Added notes clarifying fencing and windscreens.

4. Sheet C-5.3

- A. Revise Detail 9/C-5.3
- B. Add detail 10/C-5.3

5. Sheet A-402

- A. Revise Section 2/A-402

**6. Sheet ES101**

- A. Revised some of the demolition plan notes.
- B. Note to relocate some existing panelboards.
- C. Note to remove existing feeder to existing incoming electrical service panelboard in the North Star Building.

7. Sheet ES102

- A. New location for relocated transformer #3.
- B. Replace Existing Panel "DPSH1" with new Panel "DPSH1".
- C. New location for some of the panelboards, dry type transformers, lighting relays and timeclocks.
- D. New routing for some of the feeders.
- E. New Panelboards and transformer for North Star Building.
- F. New Panelboards and transformer for North Star Building.
- G. New Panelboards and transformer for the Maintenance Storage Building.

8. Sheet ES103

- A. Modifications to the lighting for the flagpole.
- B. New location for relocated transformer #3.
- C. Showing location for New Panel "SDP" and relocated panelboards near relocated transformer #3.
- D. Modifications to some of the Feeders.

9. Sheet ES104

- A. Modifications to the lighting for the flagpole.
- B. Modification to the location of the receptacles for the batting cages.

10. Sheet ES105

- A. Modifications to the lighting for the flagpole.
- B. Modification to the location of the receptacle for the batting cages.

11. Sheet ES106

- A. Modifications to the lighting for the flagpole.
- B. Added panelboards and transformer for the Maintenance Storage Building.
- C. Added feeder to the Maintenance Storage Building.

12. Sheet ES107

- A. Modifications to the location of the power receptacles for the ball machines at the tennis courts.
- B. Modified some of the circuiting and feeders.

13. Sheet ES108

- A. Revised enlarge plan tags.
- B. Revised conduit notes.

**14. Sheet ES110**

- A. Revised existing lights to be removed and relocated.

15. Sheet ES111

- A. Revised lighting layout.
- B. Revised exterior lighting luminaire schedule.

16. Sheet ES112

- A. Revised lighting layout.

17. Sheet ES114

- A. Added note for sign feeder size.

18. Sheet ED102

- A. Revised sheet notes to new sheets numbers.
- B. Revised enlarged plan tags.
- C. Revised existing panel to be demolished.

19. Sheet E-101

- A. Clarification: Add Plan Note 5, which reads as follows: Intercept existing emergency circuit serving the existing emergency lights in the existing pressbox being replaced and extend to the new emergency lights in the new pressbox. Apply Plan Note 5 to the new press box.

20. Sheet E-103

- A. Revised new panel.

21. Sheet E-104

- A. See New Sheet E-104, included in this addendum, showing the locations of the new panelboards and transformers to be provided.

22. Sheet E-601

- A. Clarification: Relays RL-1 and RL-2 shall be provided in High School in Tech Room TT119 next to the Electrical Room TE121.

23. Sheet E-603

- A. Add Panel Schedule for the New Panel "DPHS1", which replaces the Existing Panel "DPHS1".
- B. Modifications to some of the Panel Schedules.

24. Sheet E-604

- A. Modifications to some of the Panel Schedules.

25. Sheet E-605

- A. See New Sheet E-605, included in this addendum, which includes New Panel Schedules.

26. Sheet E-606

- A. See New Sheet E-606, included in this addendum, which includes New Panel Schedules.

**27. Sheet E-701**

- A. Noted to replace Existing Panel "DPSH1" with New Panel "DPHS1".
- B. Added some Demolition Plan Notes and modified some demolition plan notes shown on diagram.

28. Sheet E-702

- A. Adding New Panels for the North Star Building, Community Building and the Maintenance Storage Building.

Pages 1 through 4, inclusive, Specification Section 26 05 73, and twenty-six (26) full-size drawings, constitute the total makeup of **Addendum Two**.

**GIBRALTAR**

DESIGN



Y:\23-112 Tri-Creek SC - Lowell HS Site Improvements\Specs\Addendum 2\23-112_AD02.docx

SECTION 26 05 73

ELECTRICAL SYSTEMS STUDIES

1 General

1.1 Summary

- A. Provide a Fault Current Study, Protective Device Evaluation Study, Protective Device Coordination Study, Arc-Flash Hazard Analysis and Shock Hazard Analysis for the electrical distribution systems from all power sources rated 50 volts or greater

1.2 Related Sections:

- 1. Section 26 05 00 - Basic Electrical Requirements.
- 2. Section 26 05 13 – Medium voltage Cables.
- 3. Section 26 12 00 - Medium voltage Transformers.
- 4. Section 26 22 00 – Transformers.
- 5. Section 26 24 16 - Panelboards.
- 6. Section 26 24 17 – Existing Switchboards and Panelboards
- 7. Section 26 28 13 - Low Voltage Cartridge Fuses.

1.3 Submittals

- A. Submit documentation of the analysis with the shop drawing submittals for the switchboards, transformers and panelboards. These shop drawings will not be reviewed without this documentation.
- B. Qualification Data: For Electrical System Study specialist.
- C. Preliminary Submittal: Submit an electronic copy in PDF format only of the complete Electrical System Study with recommendations to lower the Arc Flash Hazard levels. This submittal shall accompany product data submittals for electrical equipment
- D. As-Built Submittal: Submit the following just prior to substantial completion:
 - 1. Four copies of the study in 8-1/2" x 11" hard cover three ring binders with drawings and diagrams folded to fit the format. Sections shall be tabbed and drawings shall be in a clear sleeve folded so that title-block is clearly visible.

2. Compact disk containing report in PDF format and complete set of SKM backup files (project data, libraries and output files) for project. All tables within the report shall also be submitted in MS Excel format. Disk shall be in a sleeve within the bound report.
- E. Upon approval of the As-Built Submittal the Arc Flash Hazard Labels shall be printed and installed on the associated equipment
- F. Electrical System Study Report contents:
 1. Table of Contents
 2. Introduction
 3. Findings and Recommendations:
 - a. Identify on a line by line basis all locations with a greater than Category 2 hazard level and include an accompanying recommendation to lower the incident energy to achieve a PPE category 2 or lower.
 - b. Identify on a line by line basis any Overcurrent Protective Device coordination issue and include an accompanying recommendation to improve coordination.
 - c. Identify any protective devices that appear to have inadequate interrupting capacity.
 4. Table of Calculated Arc Flash Data (Per Contract Documents)
 5. Table of Calculated Arc Flash Data (Per implemented Recommendations)
 6. Single - Line Drawings (D-Size):
 - a. Narrative description and schedule of drawings.
 - b. Accurate detailed Single-Line and shall at a minimum include the following information:
 - 1) Electrical Structure.
 - 2) Voltage at each point.
 - 3) Bolted short circuit current available at each point in the system.
 - 4) Horsepower of major motors. (50 Hp and above.)
 - 5) Plant standard names of all panels and equipment.
 - 6) Room numbers for location of all panels and equipment.
 - 7) Arc Flash Incident Energy Levels at each point in Cal/cm2.

- 8) Transformer Sizes
 - 9) Show calculated X/R ratios and equipment interrupting rating (1/2 cycle) fault currents.
7. Feeder and Transformer Data
 8. Summary of Calculated Fault Currents – “Dapper” Unbalanced Fault Report. Include separate reports for each scenario.
 9. Coordination Curves, Device Settings (Per Contract Documents.) – Device Settings and Curves shall be on facing pages.
 10. Coordination Curves, Device Settings (Per Implemented Recommendations.) – Device Settings and Curves shall be on facing pages.

1.4 Study Requirements

A. System Data

1. Provide electrical distribution system one-line diagrams, equipment and overcurrent protective device information including catalog numbers, current ratings, voltage ratings, and interrupting ratings, bus numbers, cable sizes and lengths, TCC curves, research data, tabulations, calculations, conclusions, and recommendations summarized in a report format.

B. Fault Current Study and Protective Device Evaluation Study

1. Perform a fault current study for the electrical distribution system. Identify all power sources (normal and alternative). The available fault current shall be calculated based on 3-phase bolted short-circuit current and phase to ground/neutral short-circuit current at all significant points in the electrical system. The fault current analysis will also consider actual utility provided fault current data (or infinite bus if unavailable), power contribution from motors with 50HP or greater and back-up power systems (i.e., power generators and UPS). Provide fault current calculations in accordance with ANSI/IEEE C37 that include system impedances, X/R ratio, asymmetry factor, KVA, asymmetrical and symmetrical fault currents, calculation methods and assumptions. NOTE: The use of Utility provided Minimum, Actual, and Maximum (or infinite bus if unavailable), or approximations of three utility scenarios can be used to calculate available short-circuit current on the secondary side of utility transformers. This is a good method for determining the worst-case short-circuit current through the transformer. The frequency of when the utility provided short-circuit currents are subjected to the electrical system (due to load switching) should also be considered when using the Utility Data.
2. Protective device evaluation study shall be performed to

determine the adequacy of circuit breakers, switches, automatic transfer switches, and fuses by tabulating and comparing the short-circuit ratings of these devices with the calculated fault currents. Appropriate multiplying factors based on system X/R ratios and protective device rating standards shall be applied. Any problem areas or inadequacies in the equipment due to short-current shall be promptly brought to the Engineer's attention.

C. Protective Device Coordination Study

1. Perform a protective device coordination study to insure selective coordination. Provide time current curves which graphically indicate the coordination of devices. Tabulate recommended device manufacturers, ratings, settings, etc. Any devices that are identified as uncoordinated shall be noted and recommendations provided to obtain the required selective coordination. Study should include tabulations of relay and circuit breaker trip settings, fuse selection and commentary regarding it; and recommend size for power fuses and recommended settings for ground fault relays and for all adjustable trip relays.

D. Arc-Flash Hazard Analysis

1. Perform a Shock and Arc-Flash hazard analysis and Arc-Flash energy calculations in accordance with the latest edition of NFPA 70E, Standard for Electrical Safety in the Workplace. The Incident Energy level and Arc-Flash Protection Boundary will be determined using the available fault current (based on provided utility data, and power back-up fault current). The criteria for Arc-Flash Protection Boundary will be determined using the available fault current (based on provided utility data, and power back-up fault current). The criteria for Arc-Flash calculations shall be based on the IEEE 1584 calculation model which has been incorporated into NFPA 70E.
2. The Electrical Hazard Analysis shall include all voltage classes of equipment from the service entrance down to 50 volts as required by NFPA 70E Article 110.8(B)(1), Article 130.3 and OSHA CFR 1910.132.
3. The completed study shall include:
 - a. Name or description of each point assessed
 - b. Voltage exposure level at each location
 - c. Available bolted fault current
 - d. Hazard Risk Category
 - e. Arc-Flash Protection Boundary
 - f. Working Distance
 - g. Incident Energy (in cal/cm²)
 - h. Required PPE
 - i. Components or equipment that have insufficient AIC for available fault current, or are over-dutied

- j. Assessment date
- k. Commentary regarding results and how to lower hazards if reasonably attainable
- 4. Arc-Flash Analysis is NOT required when all of the following conditions exist:
 - a. The circuit is rated 240 volts or less
 - b. The circuit is supplied by one transformer
 - c. The transformer supplying the circuit is rated less than 125 kVA
- 5. Shock Hazard Analysis
Perform a Shock Hazard Analysis in accordance with NFPA 70E Article 130.2(A). The completed study will determine:
 - a. Voltage exposure at each location
 - b. Shock Protection Boundaries
 - (1) Limited Approach
 - (2) Restricted Approach
 - (3) Prohibited Approach
 - c. Required PPE
- 6. Warning Labels
 - a. Label all equipment that will be worked on while energized with Warning Labels.
 - b. Provide detailed warning labels for each piece of equipment that conform to the approved Arc-Flash Hazard Analysis and meet NEC Article 110.16 and NFPA 70E Article 130.3(C). Components of the warning label should include:
 - (1) System Voltage
 - (2) Available Fault Current
 - (3) Hazard Risk Category
 - (4) Incident Energy
 - (5) Arc-Flash Protection Boundary
 - (6) Shock Approach Boundaries
 - (7) Required PPE
 - (8) Equipment ID
 - (9) Date of Assessment
 - (10) Name of company who completed the study
 - (11) Calculation method used.
 - c. Provide Warning Labels that meet ANSI Z535.4, Product Safety Signs and Labels requirements
 - (1) Label Size
 - (2) Label Color
 - (3) Font Size
 - (4) Use appropriate "Signal" words (where required)
 - (i) WARNING for HRC 4 or less
 - (ii) DANGER for over HRC 4
 - (iii) DANGER for components or equipment that have insufficient AIC for available fault

- current, or are over-dutied
- (5) Label Material
 - (i) Self Adhesive, capable of adhering to a variety of material:
 - (a) Stainless
 - (b) Painted enamel
 - (c) Powder coated metal
 - (d) Polypropylene
 - (e) Textured ABS Plastic
 - (ii) Glossy polyester material
 - (iii) Chemical and oil resistant
 - (iv) Approved for indoor use
 - (v) Approved for temperature variations (as required)
 - (vi) UV Protected (as required)
 - (vii) Approved for outdoor use (as required)
- (6) Production of Warning Labels
 - (i) Commercially available Engineering software generated
 - (ii) Pre-printed label stock
 - (iii) Customized label stock
- (7) Provide an electronic file of Warning Label data for reference or to re-print labels if one should be damaged during normal day to day operations.

1.5 Quality Assurance And References:

- A. The systems analysis shall be performed by an entity experienced in the application of computer software used for studies, having performed successful studies of similar magnitude on electrical distribution systems using similar devices.
- B. A Professional Engineer (P.E.) licensed in the State where the Project is located, shall be responsible for the study. All elements of the study shall be performed under the direct supervision and control of the engineer.
- C. System studies shall comply with the latest editions of all applicable national and local standards, codes, and laws including but not limited to:
 - 1. IEEE 141 – Recommended Practice for Electric Power Distribution for Industrial Plants (Red Book).
 - 2. IEEE 242 – Recommended Practice for Protection and Coordination of Industrial and Commercial Power Systems (Buff Book)
 - 3. IEEE 399 – Recommended Practice for Power System Analysis (Brown Book)
 - 4. IEEE 620 – Guide for the Presentation of Thermal Limit Curves for Squirrel Cage Induction Machines.

5. IEEE 1015 – Recommended Practice for Applying Low-Voltage Circuit Breakers Used in Industrial and Commercial Power Systems (Blue Book).
6. IEEE 1584 – Guide for Performing Arc-Flash Hazard Calculations
7. IEEE C37.010 – Application Guide for AC High-Voltage Circuit Breakers Rated on a Symmetrical Current Basis (ANSI).
8. IEEE C37.20.1 – IEEE Standard for Metal-Enclosed Low-Voltage Power Circuit Breaker Switchgear (ANSI).
9. IEEE C37.46 – American National Standard Specifications for Power Fuses and Fuse Disconnecting (ANSI).
10. IEEE C57.12.00 – General Requirements for Liquid-Immersed Distribution, Power and Regulating Transformers (ANSI).
11. IEEE C57.96 – Guide for Loading Dry-Type Distribution and Power Transformers (ANSI).
12. ICEA P-32-382 - Short-Circuit Characteristics of Insulated Cable.
13. ICEA P-45-482 – Short-Circuit Performance of Metallic Shielding & Sheaths.
14. NEMA MG1 – Motors and Generators
15. OSHA – CFR 1910
16. NFPA 70 – National Electrical Code
17. NFPA 70E – Standard for Electrical Safety in the Workplace
18. ANSI Z535.4 – Product Safety Signs and Labels
19. CSA Z462 – Workplace Electrical Safety Standard

1.6 Scheduling

- A. The individual or company performing the studies shall be approved by the design engineer prior to any work being performed.
- B. All Preliminary studies shall be completed and submitted with the equipment submittals.
- C. Prior to the release of equipment to manufacturing, all studies and equipment submittals must be reviewed and approved.
- D. At the time of substantial completion, the As-Built studies shall be completed and incorporate all field changes, conductor lengths, etc. Labels shall not be produced or installed until the final study has been reviewed and approved.
- E. Install Arc Flash Hazard labels throughout the facility.

2 Products

2.1 Software Program Requirements

- A. Calculations shall be prepared using current version of Power Tools software obtained from SKM Systems Analysis, Inc. (No equals.)
- B. Shall be capable in complying with applicable codes and standards (NFPA 70, IEEE 399, NFPA 70E, IEEE 1584, Z462, etc.)
- C. Shall be capable of plotting time current characteristic curves as part of its output and identify overcurrent protective device settings and ratings.
- D. Shall be capable of performing Arc-Flash hazard calculations to NFPA 70E, IEEE 1584, and Z462 calculation models.

3 Execution

3.1 Examination:


- A. Examine all project submittals with overcurrent protective devices and field settings for performance with the potential fault current ratings, protective device coordination and lowest Hazard Risk Category.

3.2 Installation:

- A. All equipment and protective devices shall be installed by the contractor in accordance with all applicable national and local standards, codes, and laws and the approved fault current study and protective device coordination study.
- B. Overcurrent Protection Device (OCPD) Management
 - 1. The calculated Arc-Flash hazard levels in the facility electrical distribution system are dependent on the fault clearing times of the actual fuse types (UL Classifications) and circuit breaker types and their trip settings installed in the system. All maintenance changes to OCPDs must be recorded in writing, i.e., red-lined drawings. In order to maintain the integrity of the Arc-Flash Study, all changes to OCPDs will require future re-calculation of incident energy levels to determine new hazards levels.
 - 2. OCPD coordination in the electrical distribution system is dependent on the fuses, circuit breakers and trip settings currently installed, and recommended.
 - 3. All future maintenance and replacement of fuses and circuit breakers shall be the same make and model number. OCPD can be upgraded as long as the replacement device has the same or greater current limiting capabilities, and has a short circuit clearing time that is equal-to, or faster than the OCPD being replaced.
- C. Equipment shall be field marked with Arc-Flash and Shock hazard analysis data (warning labels) by the contractor in accordance with applicable codes and standards.


1. Warning Labels shall be applied in a location visible to Qualified Workers
2. Warning Labels shall be applied to clean, dry surfaces, free from oil and grease that would cause the label to unintentionally come off.

END OF SECTION

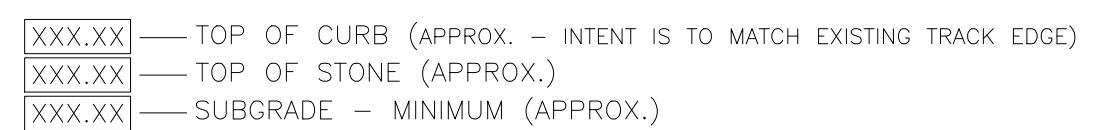

© GIBRALTAR DESIGN SHEET

C-2.2A

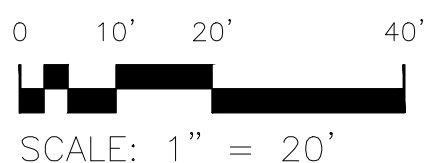


XXX.XX	— TOP OF CURB (APPROX. - INTENT IS TO MATCH EXISTING TRACK EDGE)
XXX.XX	— TOP OF STONE (APPROX.)
XXX.XX	— SUBGRADE - MINIMUM (APPROX.)


TRI-CREEK SCHOOL CORPORATION

© GIBRALTAR DES

C-2.2B

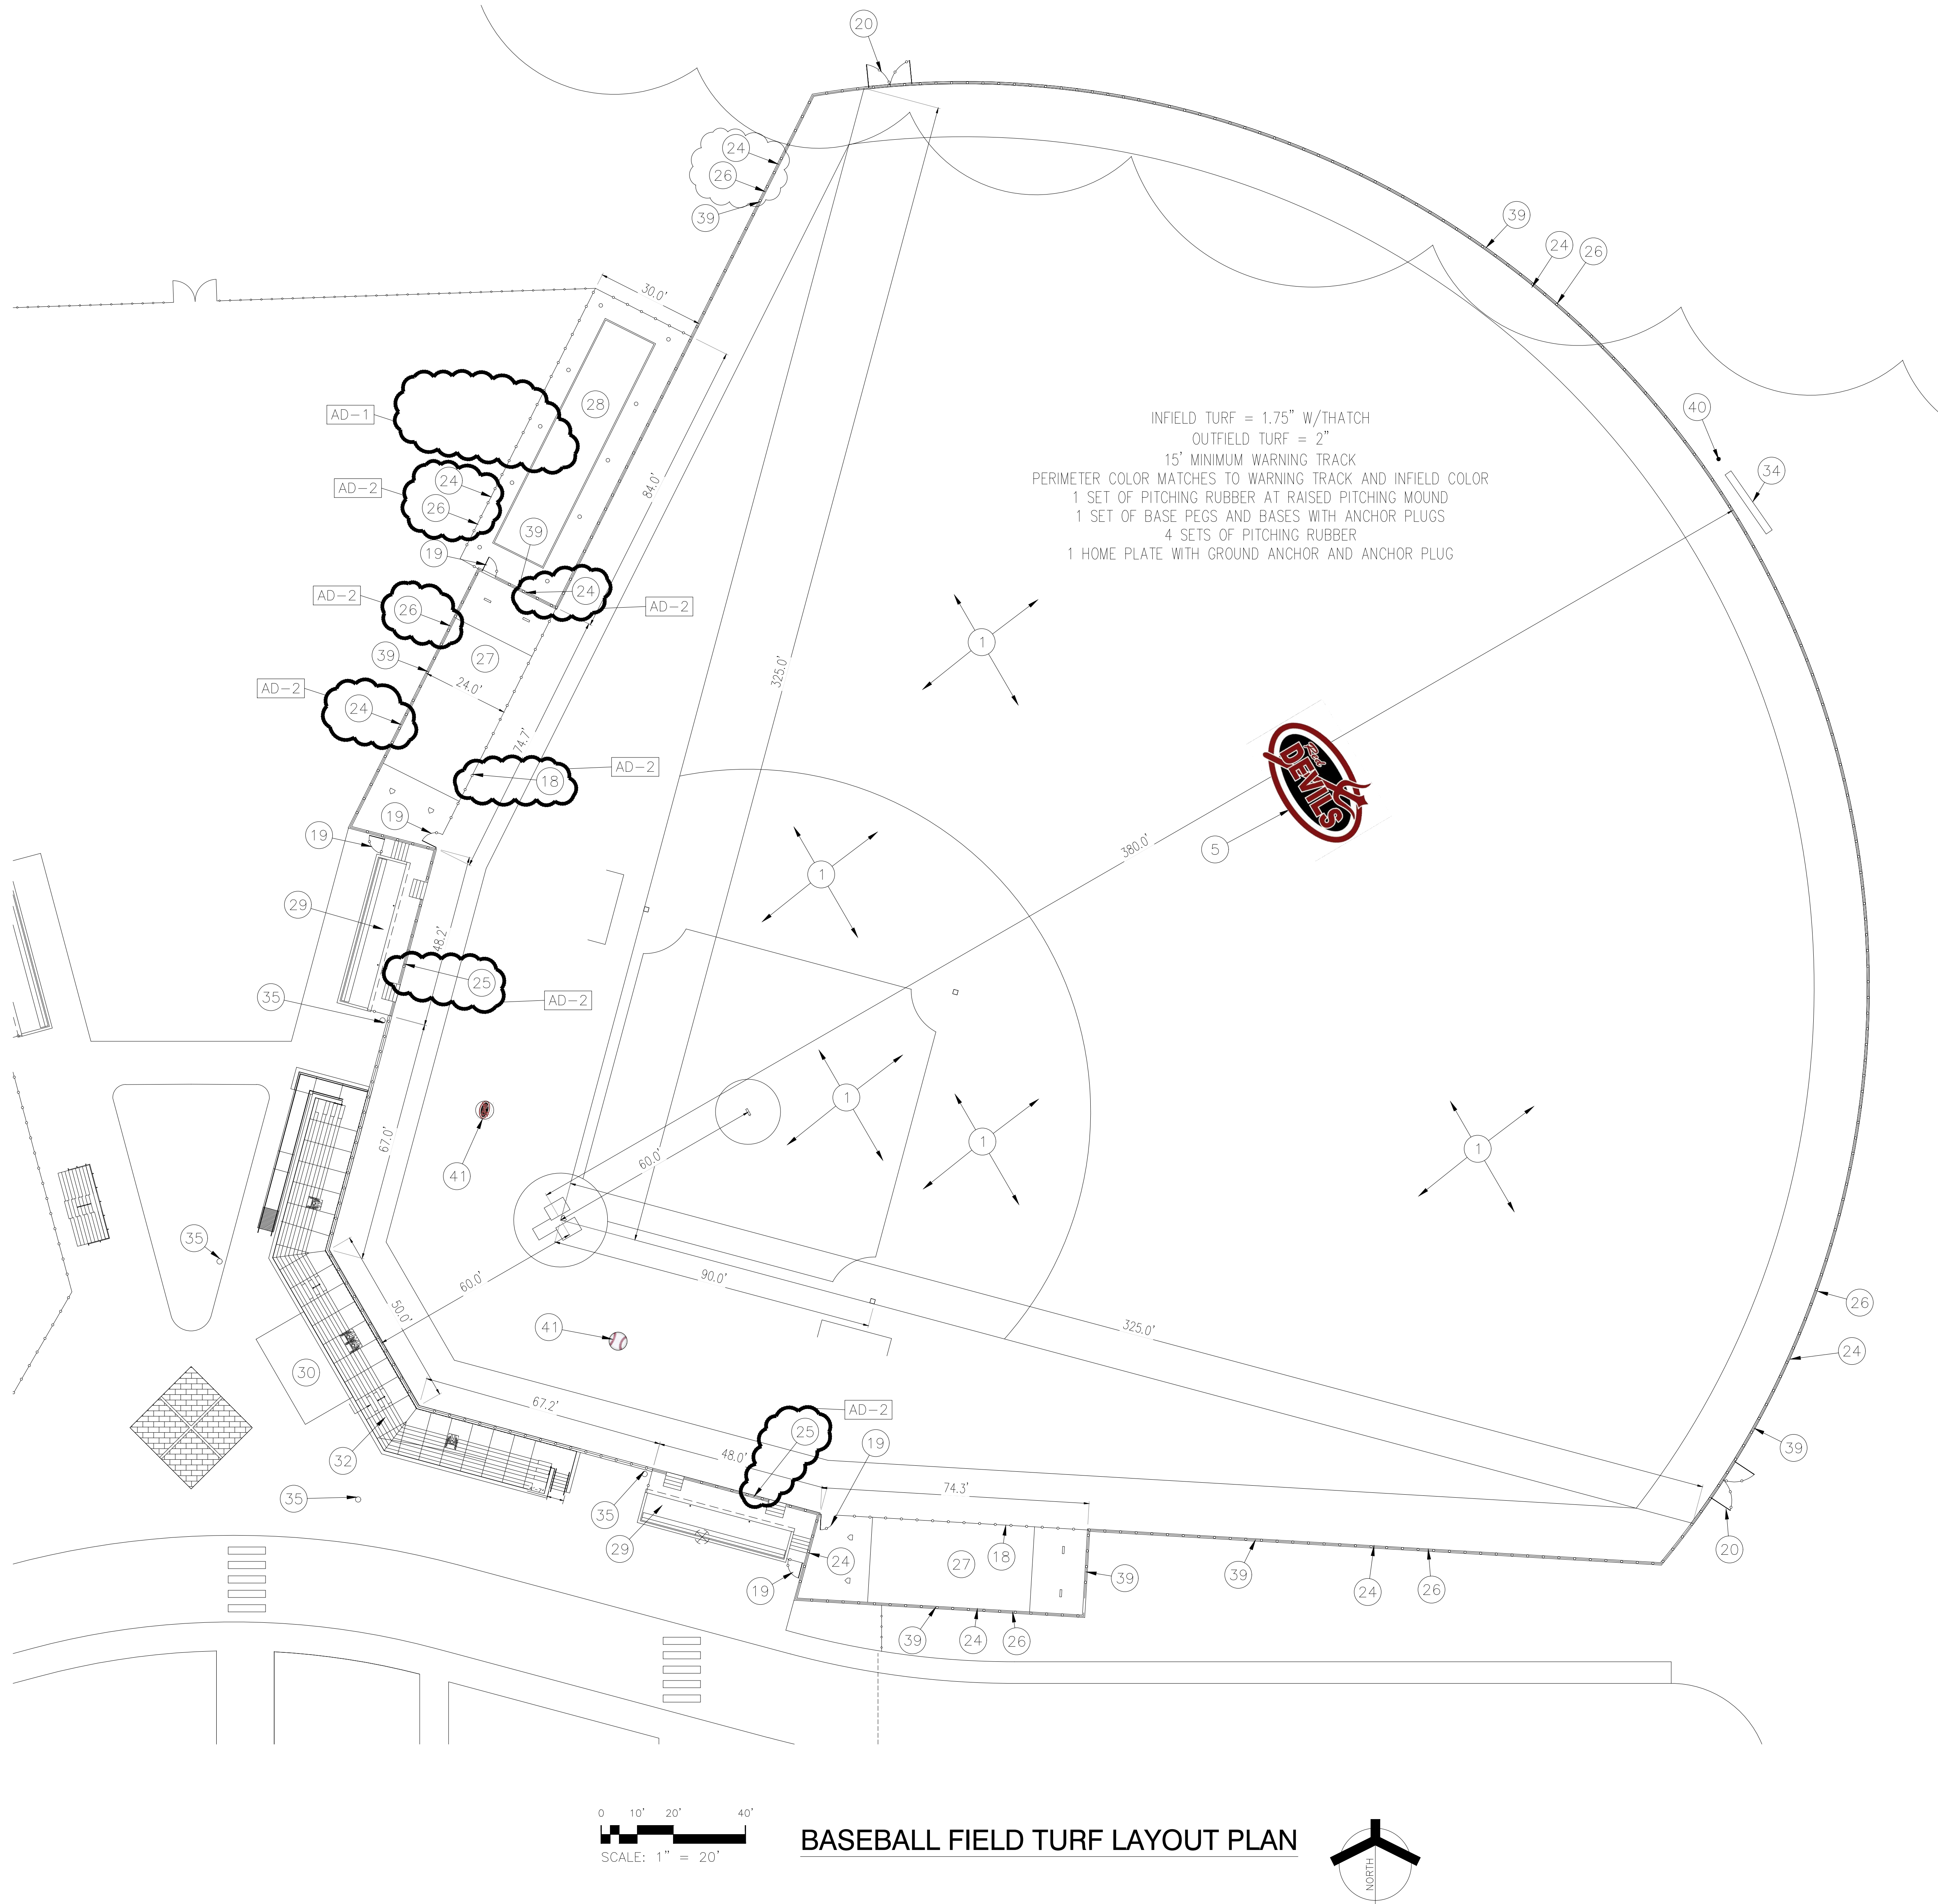

BASEBALL FIELD TURF LAYOUT PLAN

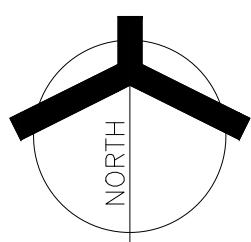

GENERAL PLAN NOTES:

- A. CONTRACTOR IS TO PROVIDE TOTAL ARTIFICIAL TURF REPLACEMENT COMPLETE, NEW TURF, NEW INFILL, NEW 2X4, PERIMETER TREATED WOOD BLOCKING, AND NEW LOGOS/TEXT AS INDICATED.
- B. CONTRACTOR IS TO MATCH ALL EXISTING LINework, PLAYER BOXES, PERIMETER BAND, ETC.
- C. CONTRACTOR IS REQUIRED TO MATCH THE EXISTING GRADES TO THE GREATEST DEGREE POSSIBLE.
- D. CONTRACTOR IS TO COORDINATE AND PROVIDE FOR SUB-TURF ACCESS TO ANY EXISTING VALVES, HAND-HOLES OR UTILITY BOXES AS REQUIRED.

PLAN NOTES:

- 1 PROVIDE NEW SYNTHETIC TURF AND SUB-BASE DRAINAGE SYSTEM. AD-2
- 2 NEW TURF TEXT, TEXT IS "LOWELL", COLOR TO BE CUSTOM RED WITH WHITE BORDER.
- 3 NEW TRACK SURFACE ON EXISTING ASPHALT. - PROTECT AS REQUIRED.
- 4 NEW FOOTBALL GOALPOST REFER TO DETAILS.
- 5 NEW INLAID TURF -LOGO- OWNER WILL PROVIDE NEW LOGO, REFER TO SPECIFICATIONS.
- 6 INFILL EXISTING GRASS AREA WITH NEW ASPHALT AND TRACK SURFACE.
- 7 END LINES AND SIDELINES - CONTINUOUS LINES 6" WIDE TYPICAL AND OTHER LINES ARE 4" TYPICAL.
- 8 STOP ALL YARD LINES INSIDE BOUNDARIES 4" FOR EACH SIDE LINE TYPICAL.
- 9 INBOUNDS LINES SHALL BE 24" LONG, 4" WIDE, TYPICAL. AD-2
- 10 6" - 8" WIDE BORDER AROUND FIELD WITH 12" - 16" WIDE PLAYERS AREA ON BOTH SIDES OF FIELD. BORDER AND PLAYERS BOX TO BE CUSTOM RED COLOR. PLAYERS BOX TO HAVE 6" WHITE BORDER, THE 6" BORDER IN FRONT OF THE PLAYERS BOX IS TO BE WHITE IN LIEU OF THE CUSTOM RED.
- 11 YARD LINE NUMBERS TO BE 24" WIDTH AND MINIMUM 4" WIDE LINES FOR EACH NUMBER AND INCLUDE MATCHING DIRECTIONAL ARROW - TYPICAL.
- 12 PROVIDE CONCRETE CURB ON FOOTBALL FIELD PERIMETER OF TRACK CONDITION AND AT FIELD ENDS FOR NEW ARTIFICIAL TURF.
- 13 CONTRACTOR TO INSTALL/CONNECT TURF DRAINAGE SYSTEM DIRECTLY TO MANHOLE INDICATED, DESIGN OF TIE-IN AND DRAINAGE DESIGN AND LAYOUT TO BE PROVIDED AS REQUIRED PER SPECIFICATIONS.
- 14 NEW LONG JUMP REFER TO SITE DETAILS AND SPECIFICATIONS.
- 15 NEW POLE VAULT REFER TO SITE DETAILS AND SPECIFICATIONS.
- 16 NEW SCOREBOARD IN EXISTING LOCATION.
- 17 NEW DELAY OF GAME CLOCK IN EXISTING LOCATION.
- 18 NEW 3' BLACK VINYL COATED FENCE.
- 19 NEW 10' GATE.
- 20 NEW 10' DOUBLE GATE.
- 21 NEW HOME GRANDSTAND AND PRESS BOX, REFER TO ARCHITECTURAL.
- 22 RELOCATED VISITOR BLEACHERS, REFER TO ARCHITECTURAL.
- 23 NEW STORAGE BUILDING UNDER GRANDSTANDS REFER TO ARCHITECTURAL.
- 24 NEW 6' BLACK VINYL COATED FENCE.
- 25 NEW 2' BLACK VINYL COATED FENCE.
- 26 WINDSCREEN ON CHAIN LINK FENCE.
- 27 TURF BULLEEN.
- 28 BATTING CAGE AND CONCRETE SLAB.
- 29 SUNKEN DUGOUT REFER TO ARCHITECTURAL.
- 30 MASONRY PRESS BOX REFER TO ARCHITECTURAL.
- 31 VARSITY SOFTBALL GRANDSTAND REFER TO ARCHITECTURAL.
- 32 VARSITY BASEBALL GRANDSTAND REFER TO ARCHITECTURAL.
- 33 SOCCER GRANDSTAND REFER TO ARCHITECTURAL.
- 34 NEW SCOREBOARD REFER TO SPECIFICATIONS.
- 35 BACKSTOP POLE AND NETTING.
- 36 NEW 10' BLACK VINYL COATED FENCE.
- 37 NEW COVERED PLAYERS BENCHES WITH NEW CONCRETE SLAB.
- 38 NEW 20 PERSON BLEACHER WITH CONCRETE PAD.
- 39 PROVIDE CONCRETE CURB ON FIELD PERIMETER FOR NEW ARTIFICIAL TURF.
- 40 FLAG POLE, REFER TO ELECTRICAL FOR LIGHTING.
- 41 NEW INLAID TURF -LOGO- AT NEXT BATTER BOX, OWNER WILL PROVIDE NEW LOGO, REFER TO SPECIFICATIONS.

SYMBOL LEGEND:

XXX.XX — TOP OF CURB (APPROX. - INTENT IS TO MATCH EXISTING TRACK EDGE)
 XXX.XX — TOP OF STONE (APPROX.)
 XXX.XX — SUBGRADE - MINIMUM (APPROX.)

GIBRALTAR
DESIGN

ARCHITECTURE • ENGINEERING • INTERIOR DESIGN

PROJECT

LOWELL HIGH SCHOOL SITE, BLEACHERS, & TURF/DRAINAGE

TRI-CREEK SCHOOL CORPORATION

GIBRALTAR DESIGN

9102 N. Meridian St., Ste. 300
Indianapolis, IN 46260
Homepage www.GibraltarDesign.com
Email info@GibraltarDesign.com
Phone 317.580.5777 Fax 317.580.5778

PROJECT
23-112
DATE
08/04/23
COORDINATED BY
DTB JPB

DRAWN BY
DTB

CHECKED BY
DTB JPB

COPYRIGHT NOTICE:

THE CONCEPTS, DESIGNS, PLANS, DETAILS, ETC., SHOWN ON THIS DOCUMENT ARE THE PROPERTY OF GIBRALTAR DESIGN AND WERE CREATED FOR USE ON THIS SPECIFIC PROJECT. NONE OF THIS INFORMATION SHALL BE USED BY ANY PERSON OR FIRM FOR ANY PURPOSE WITHOUT THE EXPRESS WRITTEN CONSENT OF GIBRALTAR DESIGN. THE OWNER MAY RETAIN COPIES FOR INFORMATION AND REFERENCE IN CONNECTION ONLY WITH THIS PROJECT.

REVISIONS		
MARK	DATE	ISSUED FOR
AD-1	08/18/23	ADDENDUM NO. 1
AD-2	08/31/23	ADDENDUM NO. 2

DRAWING


BASEBALL FIELD TURF LAYOUT PLAN

PROJECT
LOWELL HIGH SCHOOL - SITE AND
STADIUM IMPROVEMENTS

© GIBRALTAR DESIGN


SHEET

C-2.2D

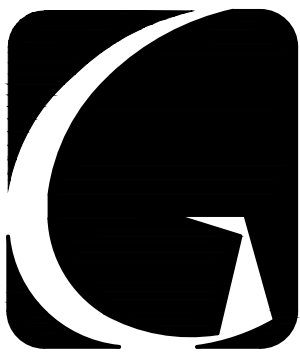


GIBALTAR
DESIGN
ARCHITECTURE • ENGINEERING • INTERIOR DESIGN

PROJECT
LOWELL HIGH SCHOOL SITE, BLEACHERS, & TURF/DRAINAGE
TRI-CREEK SCHOOL CORPORATION

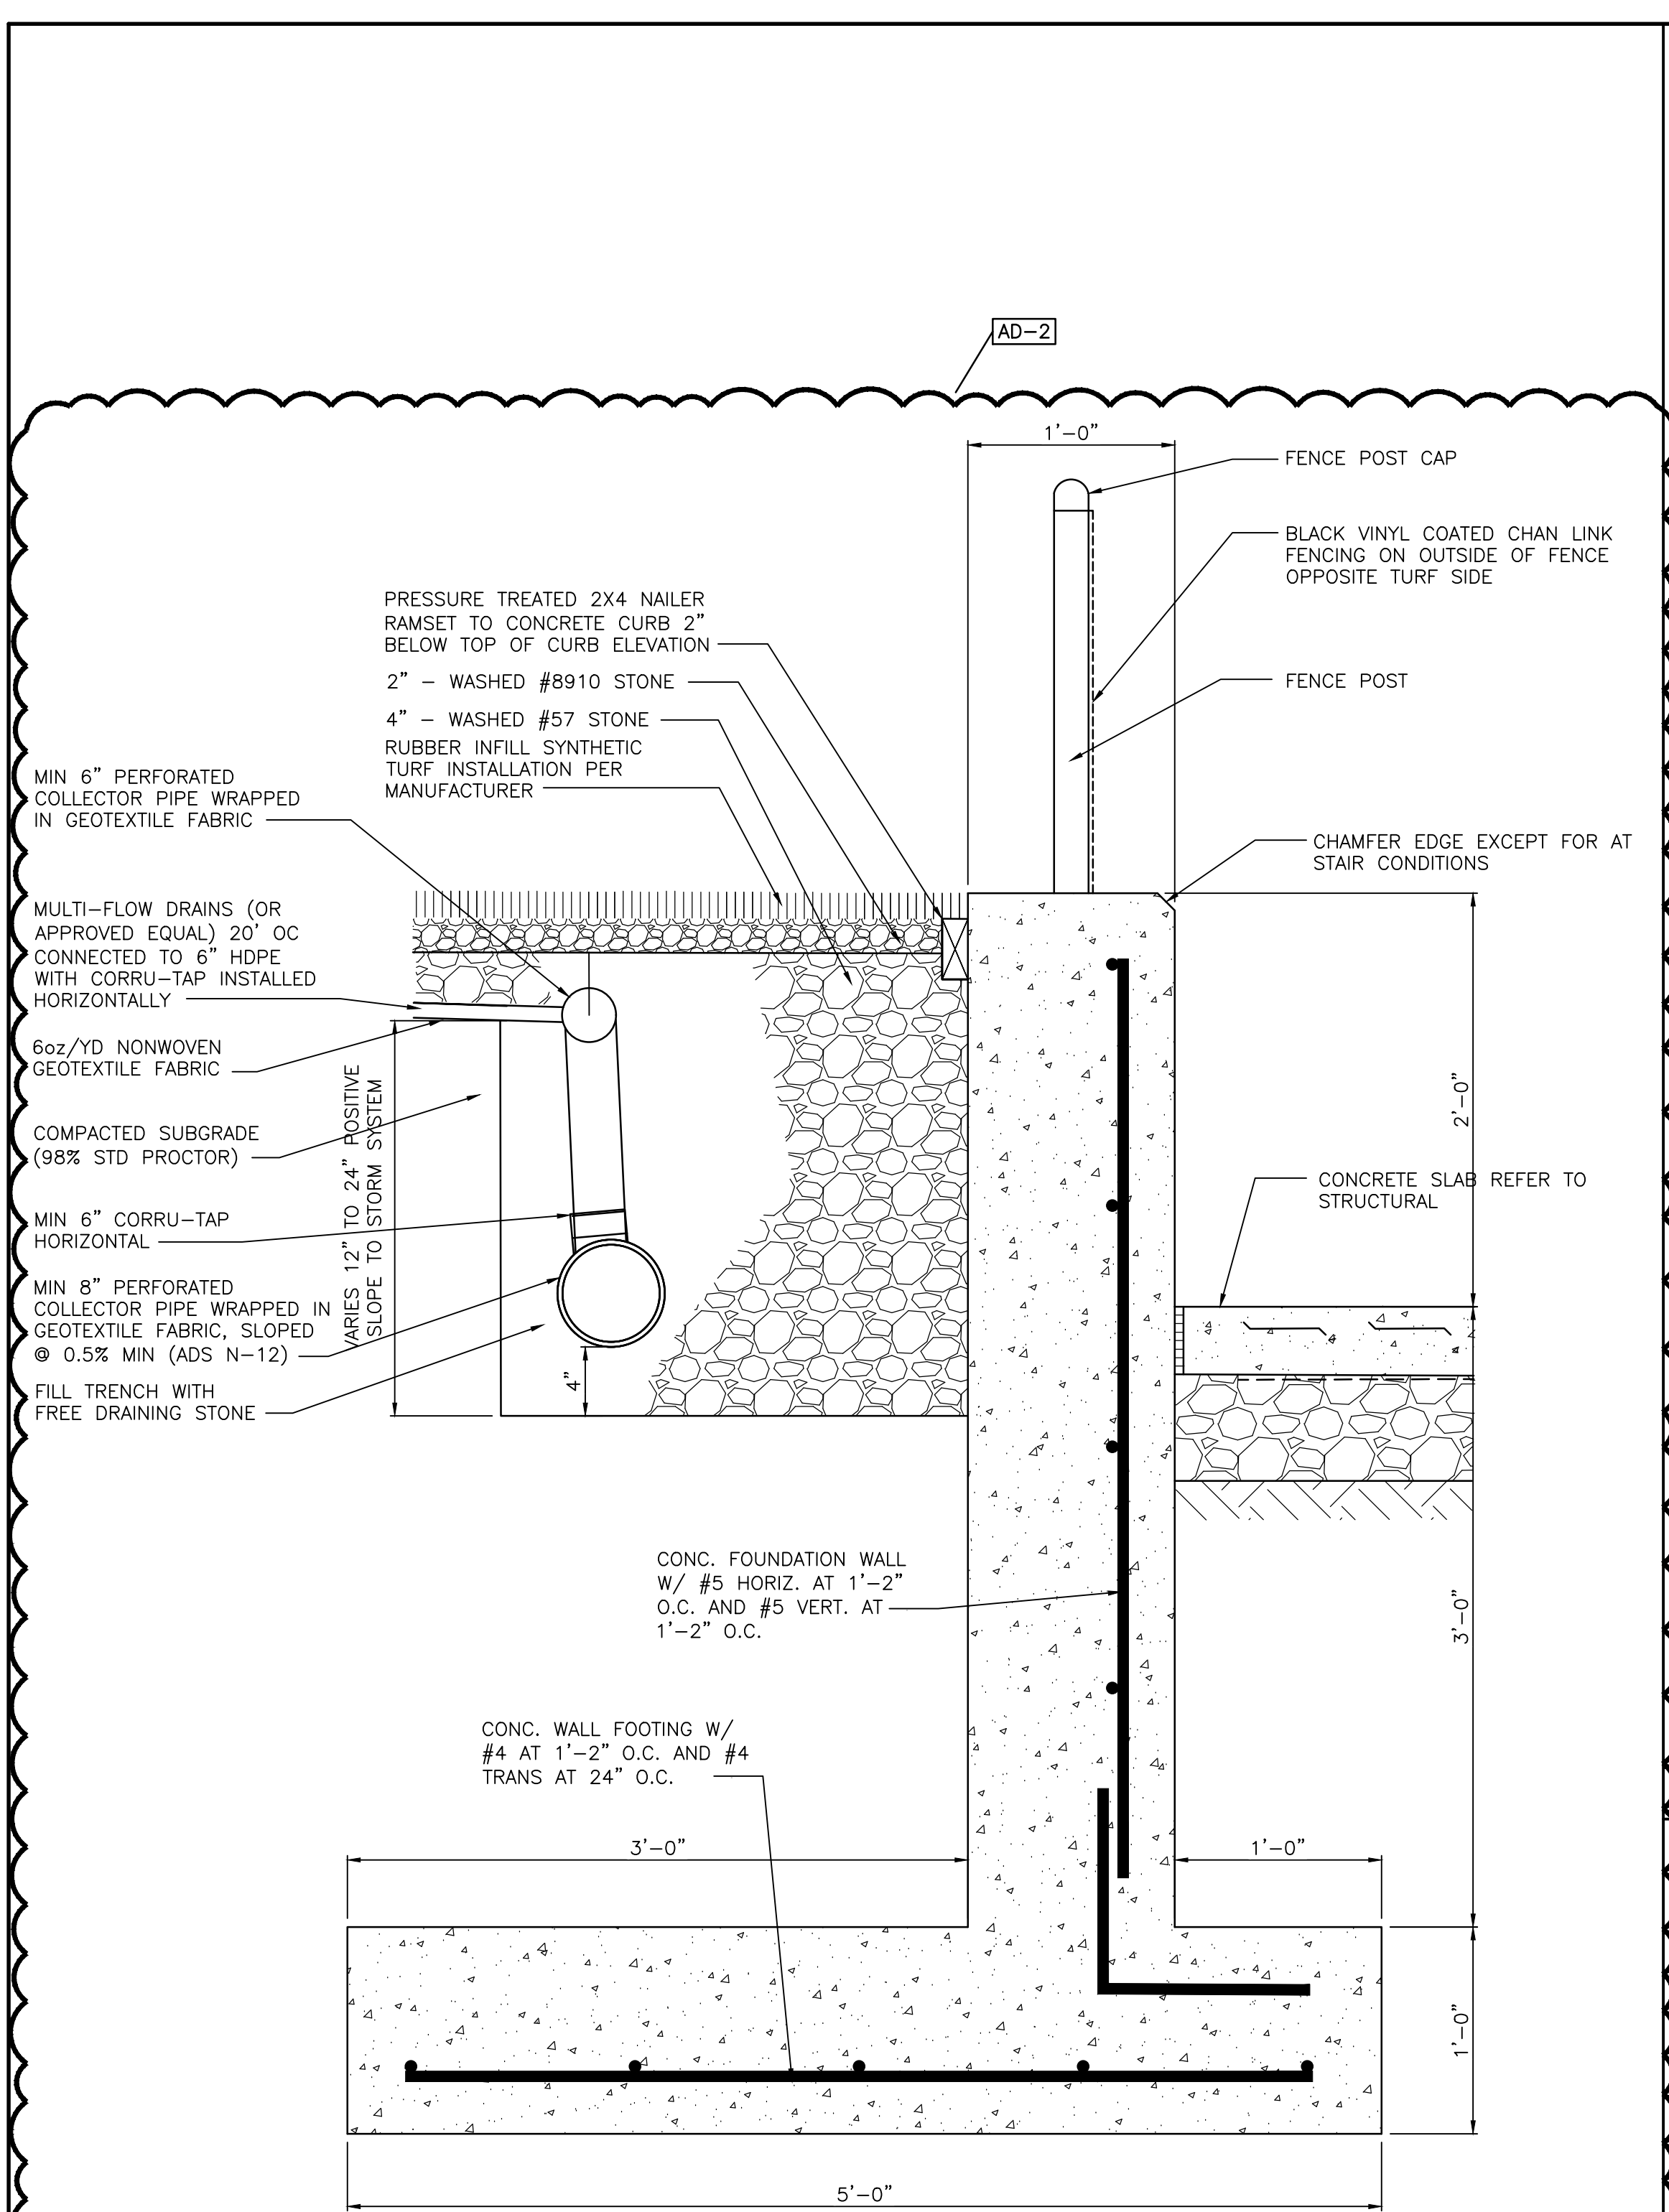


**NAILER CURB/RETAINING WALL SECTION
AT VARSITY BB & SB DUGOUTS**
SCALE: 1 1/2" = 1'-0"

10
C-5.3

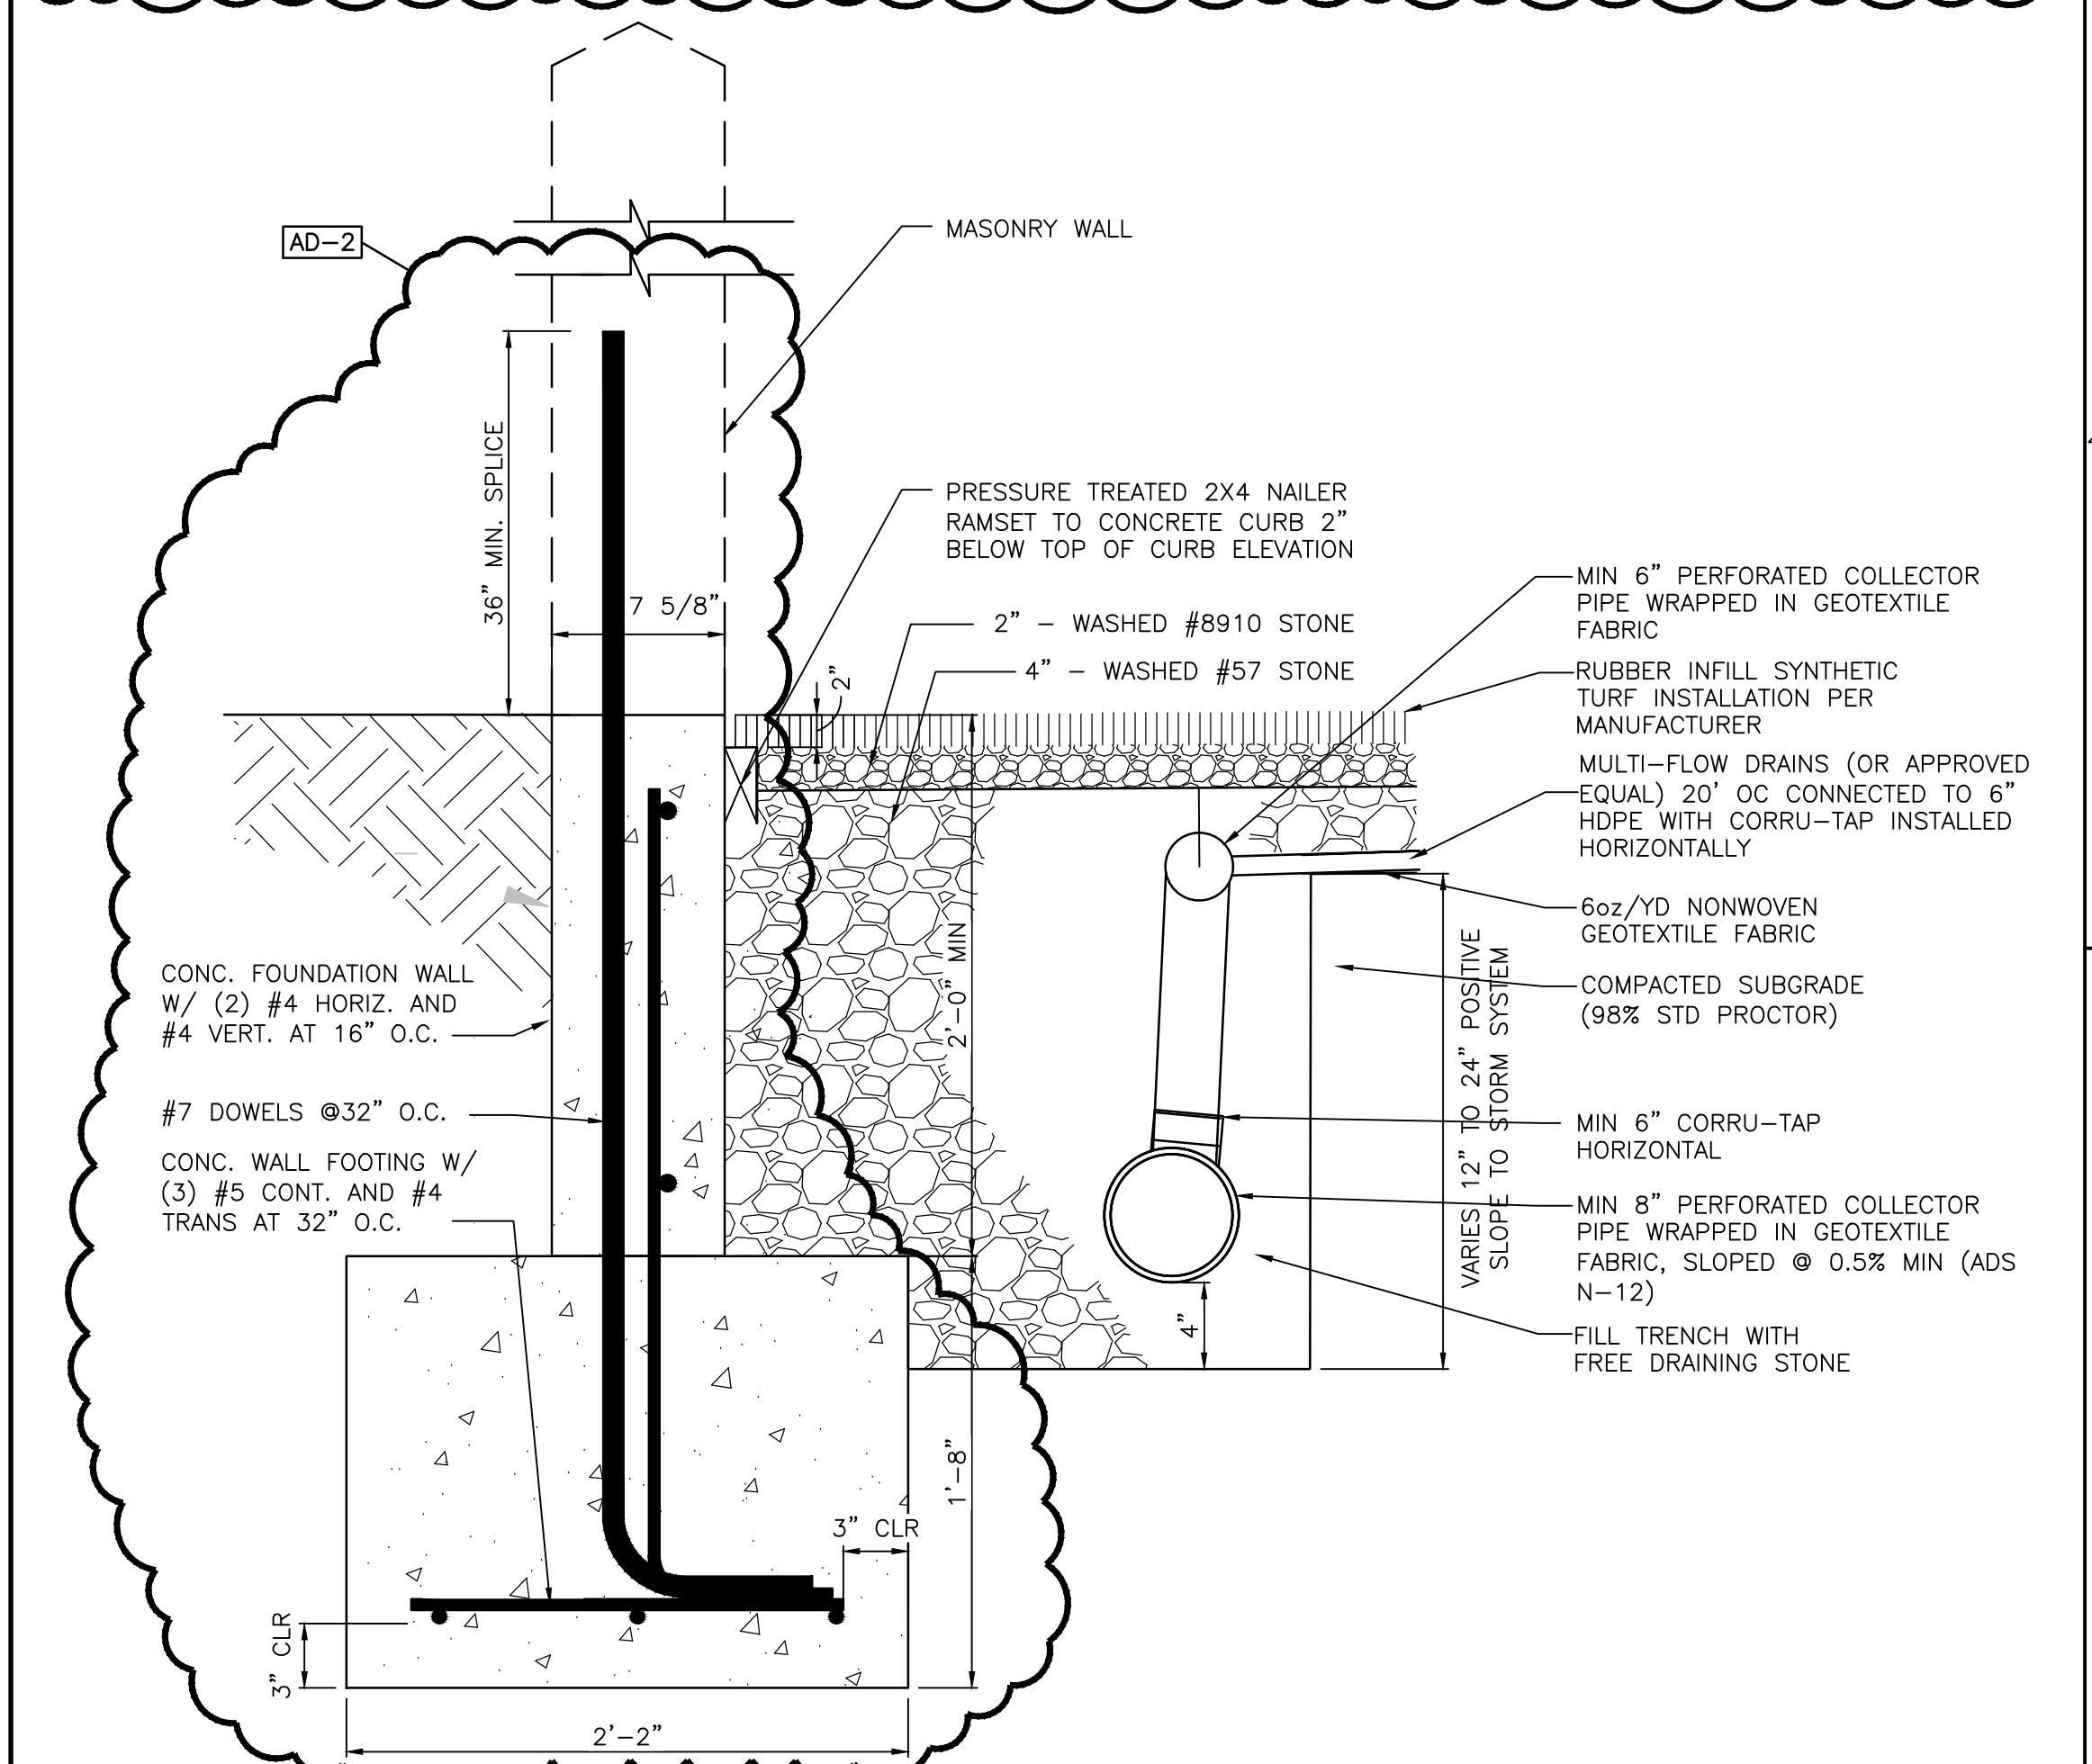


**NAILER CURB SECTION
AT SOCCER GRANDSTAND MASONRY WALL**
SCALE: 1 1/2" = 1'-0"

9
C-5.3

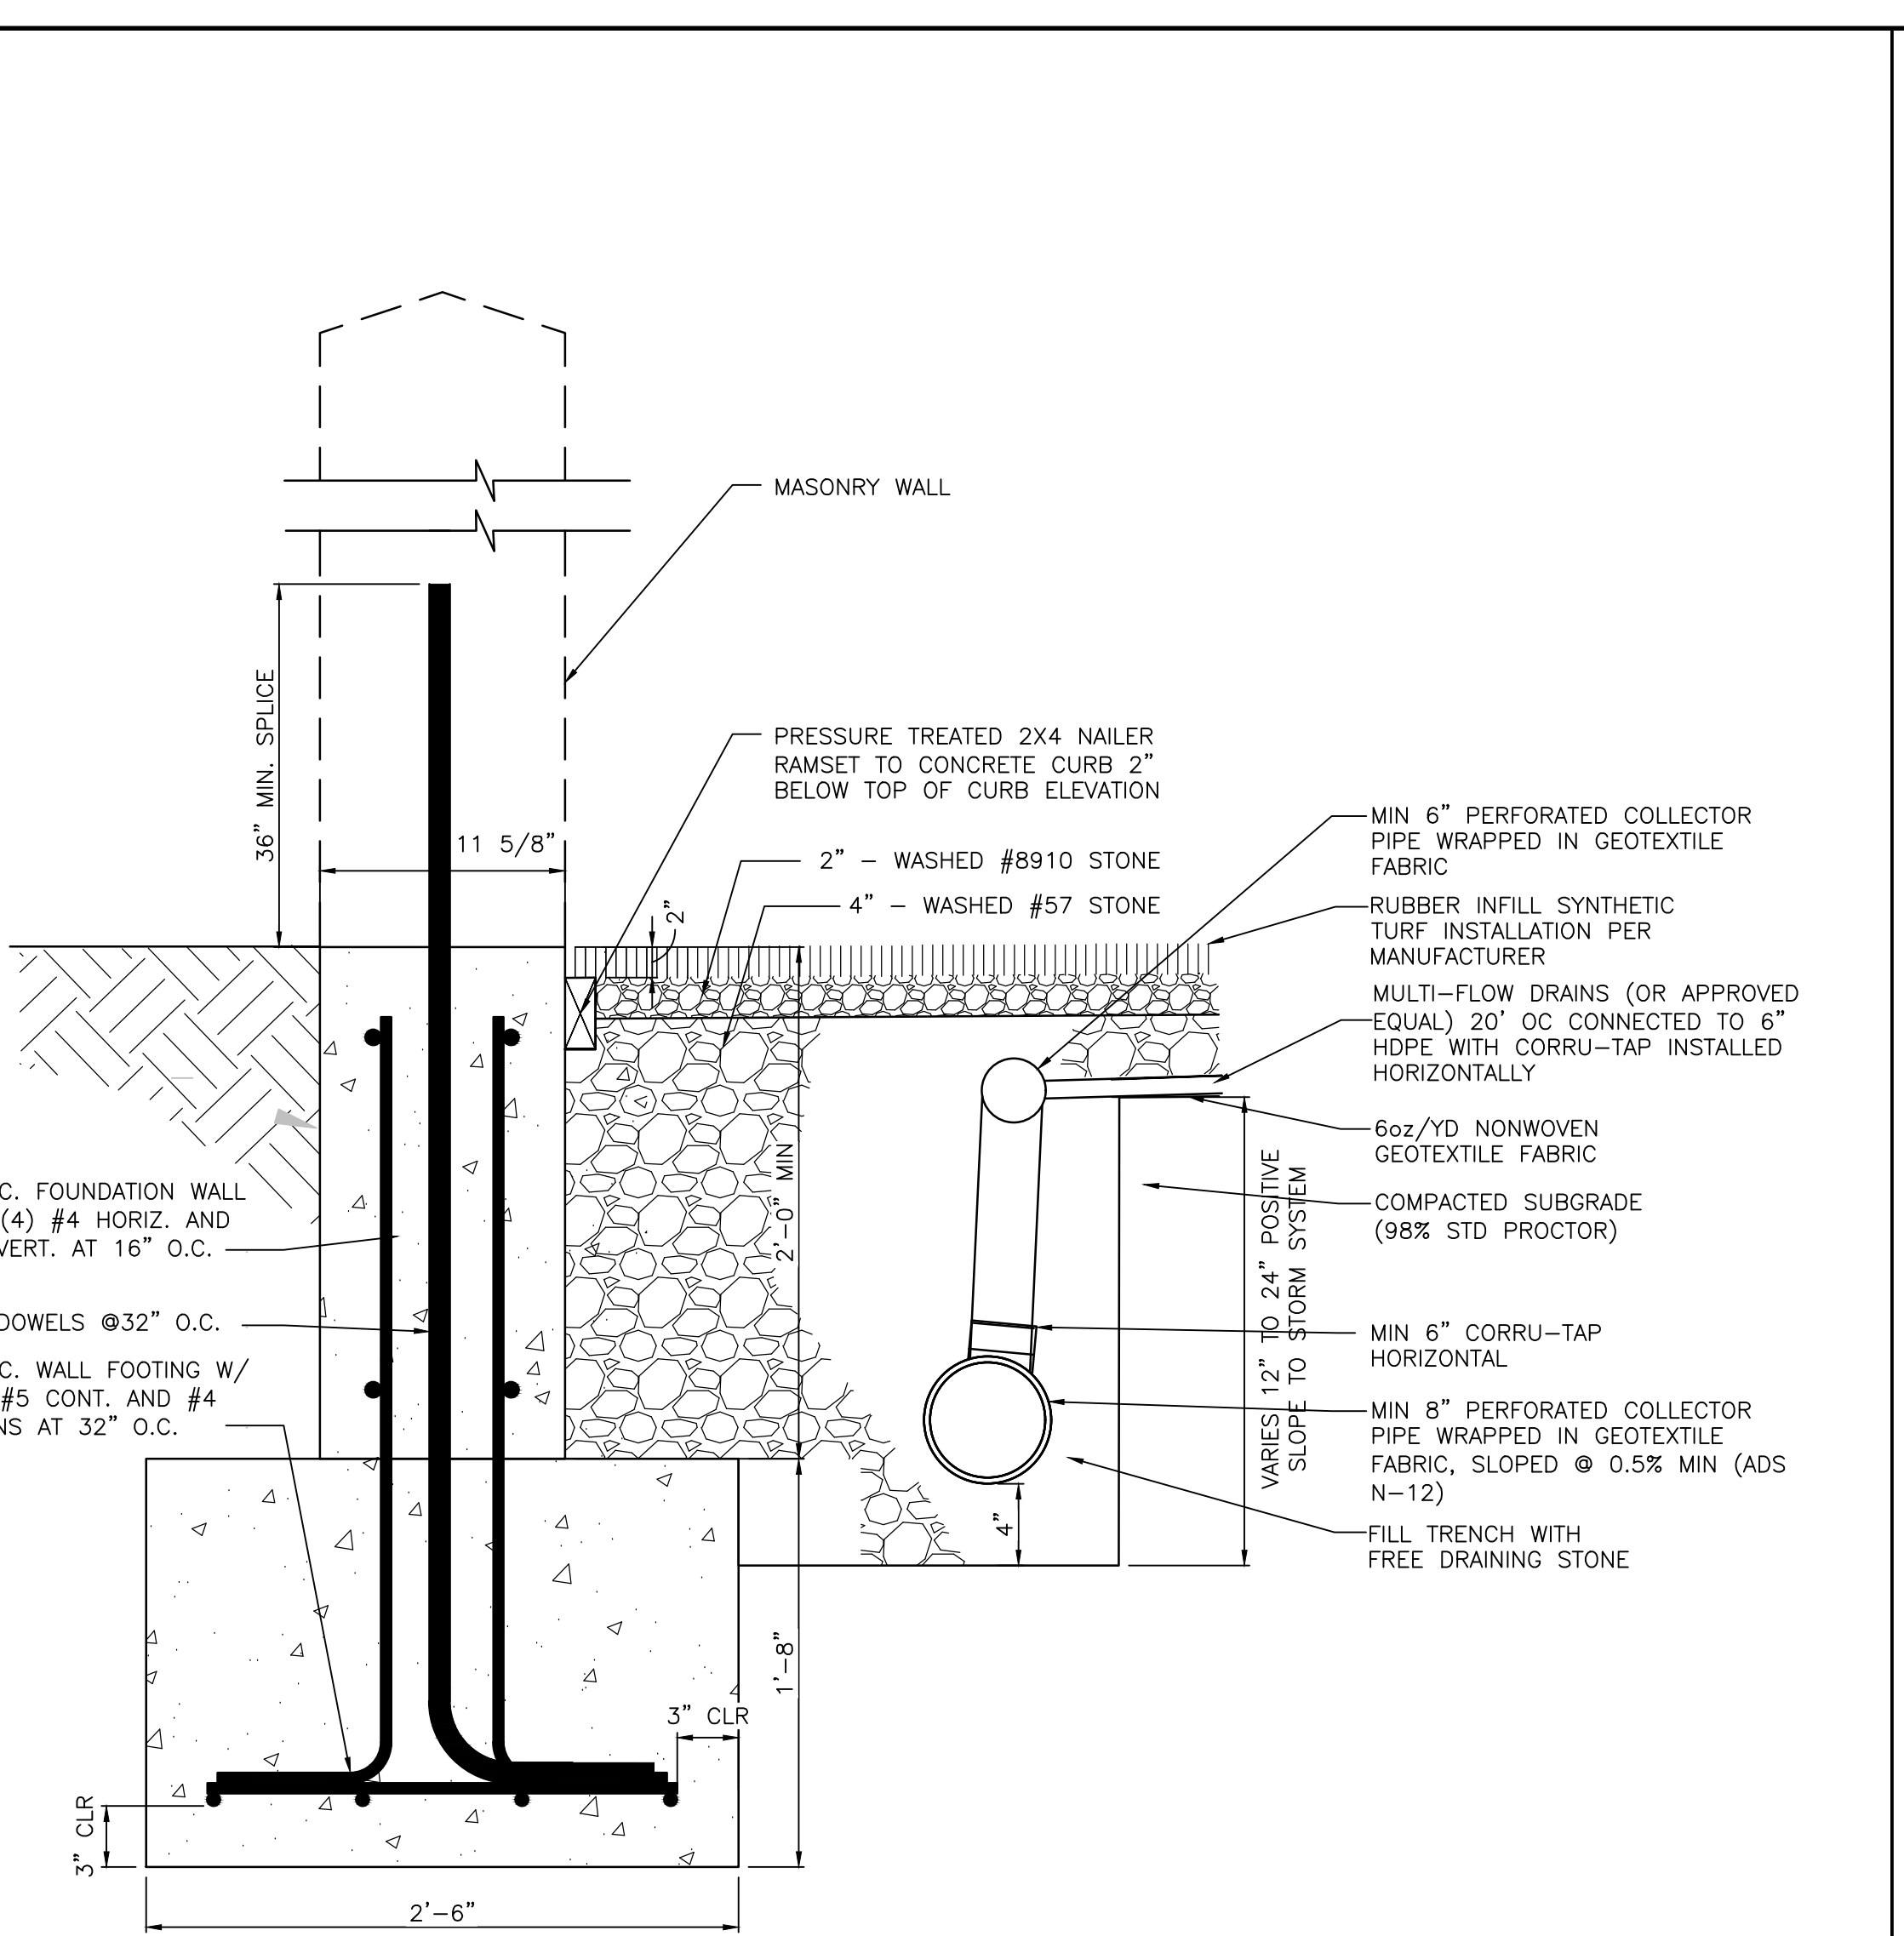


**NAILER CURB SECTION
AT BB/SB BACKSTOP MASONRY WALL**
SCALE: 1 1/2" = 1'-0"

8
C-5.3

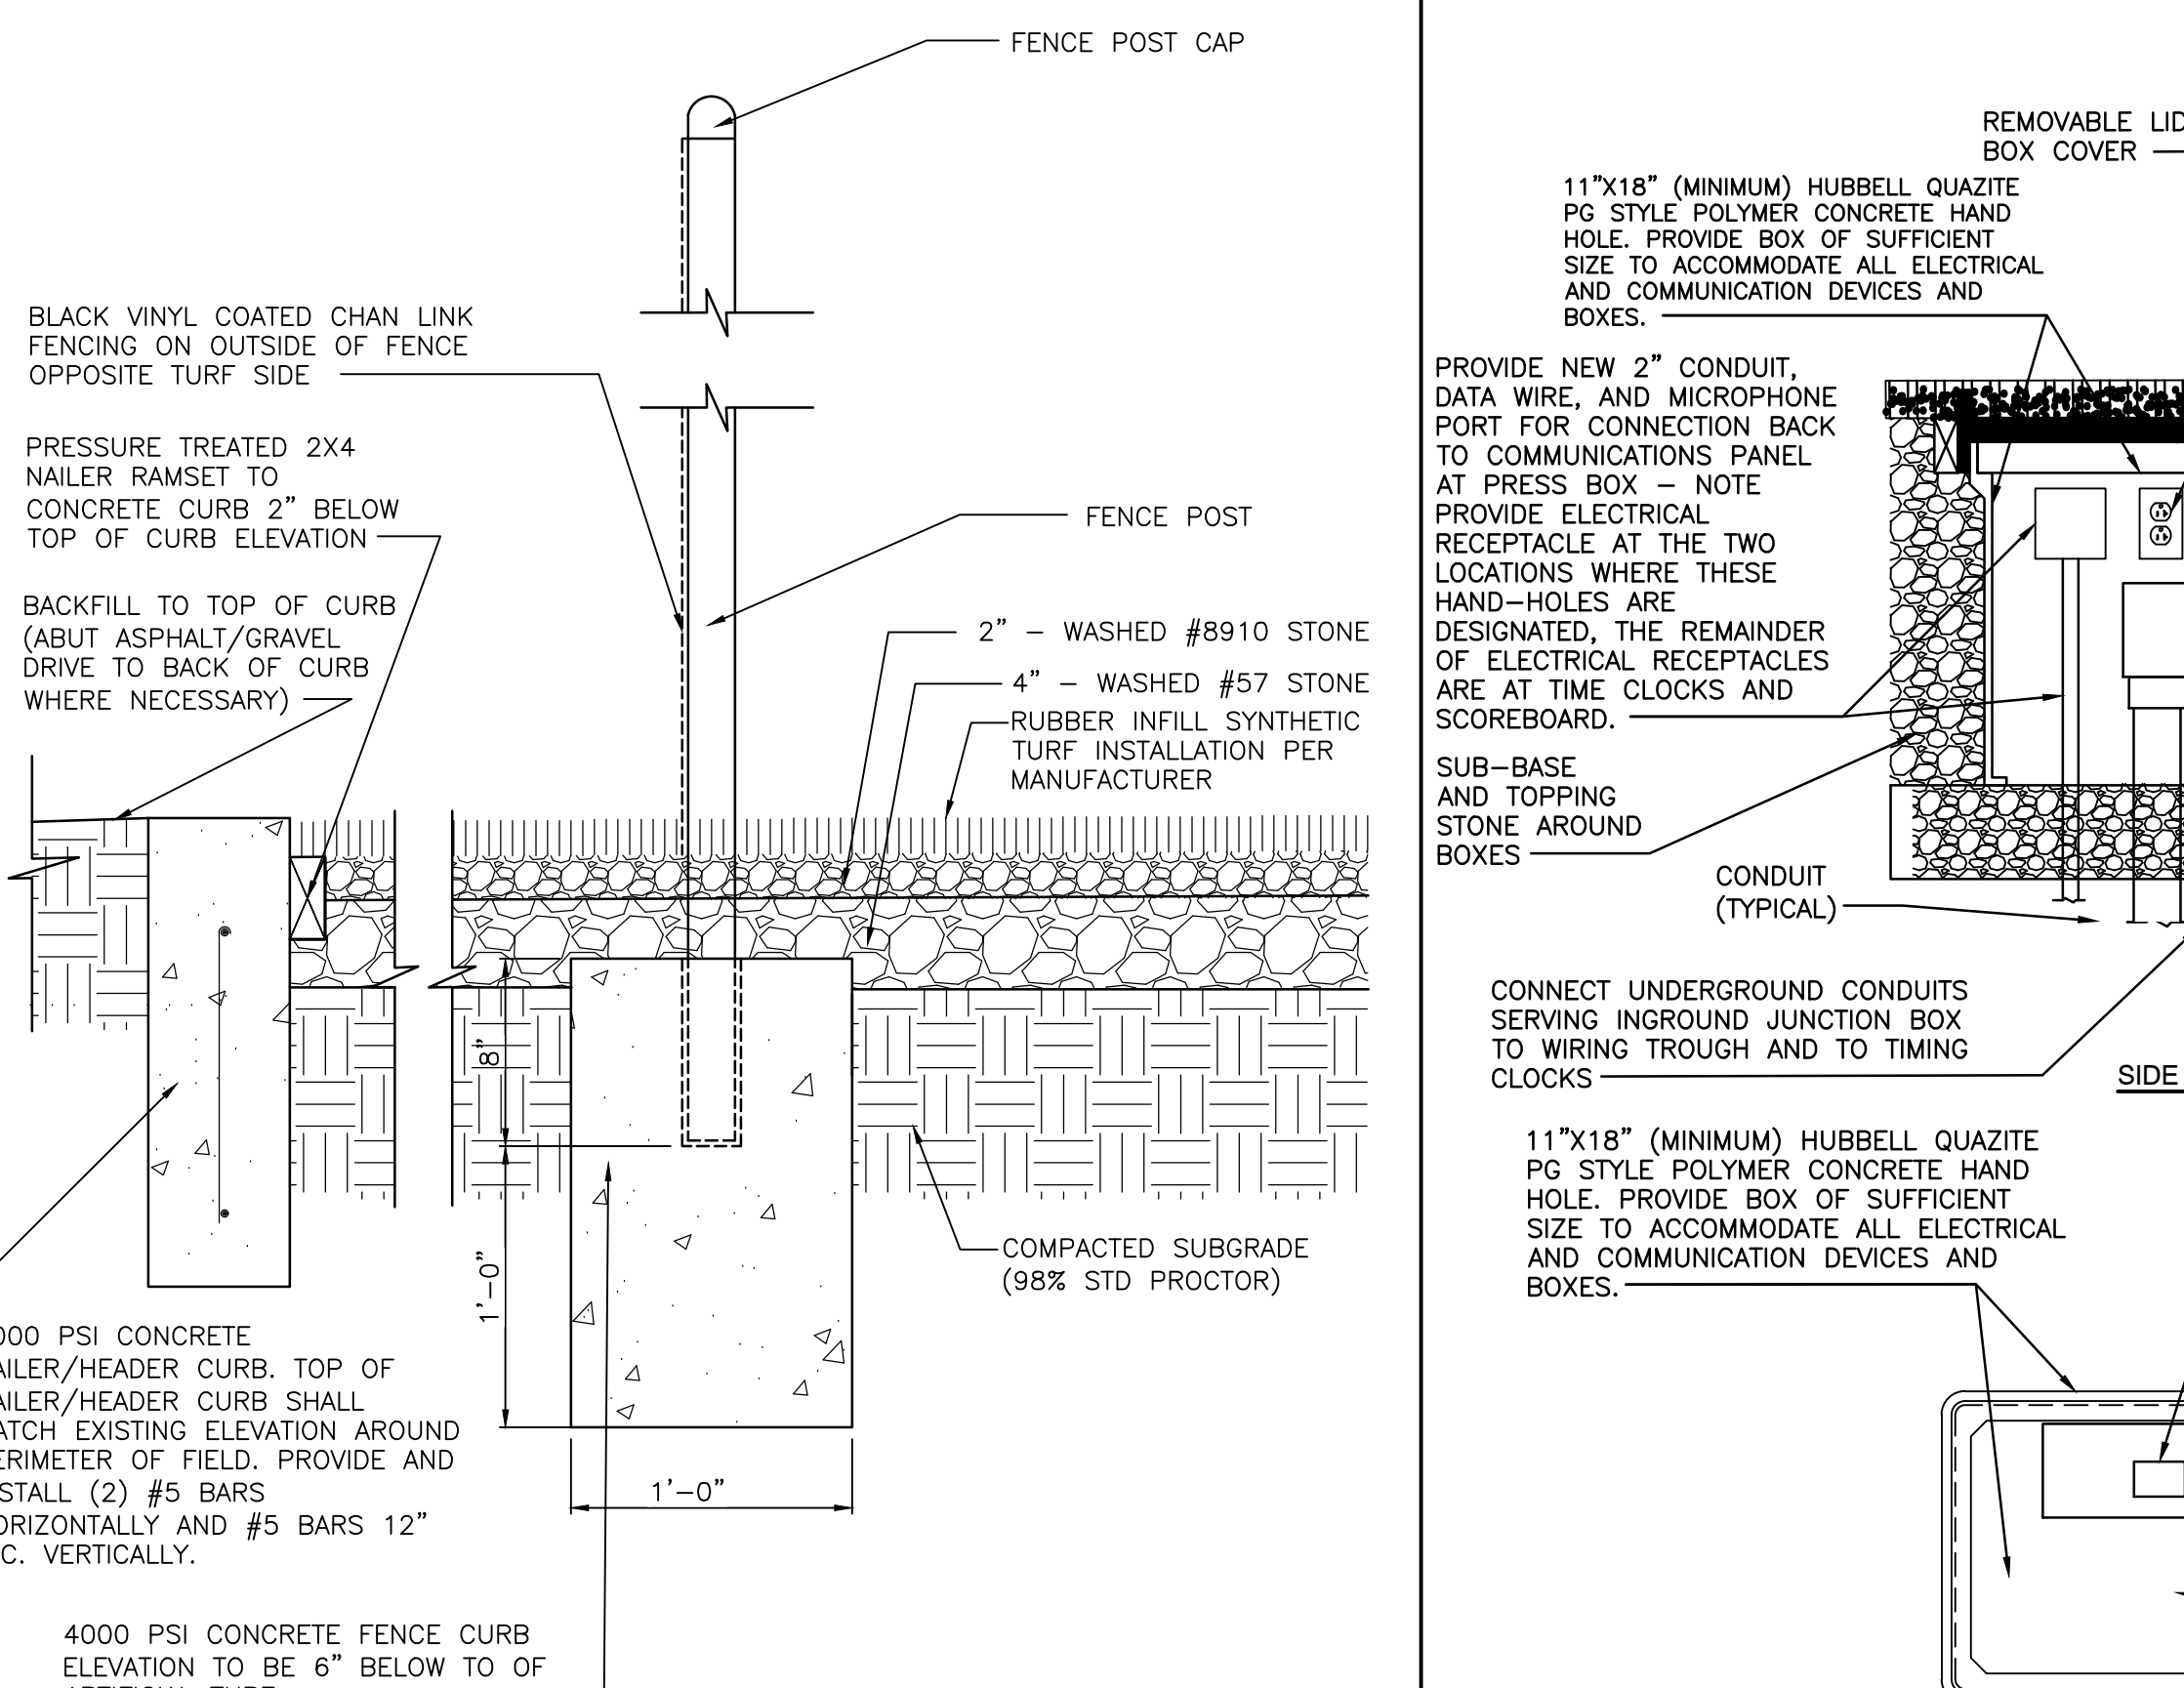


FENCE POST DETAIL AT BULL PEN FENCE
SCALE: 1 1/2" = 1'-0"

7
C-5.3

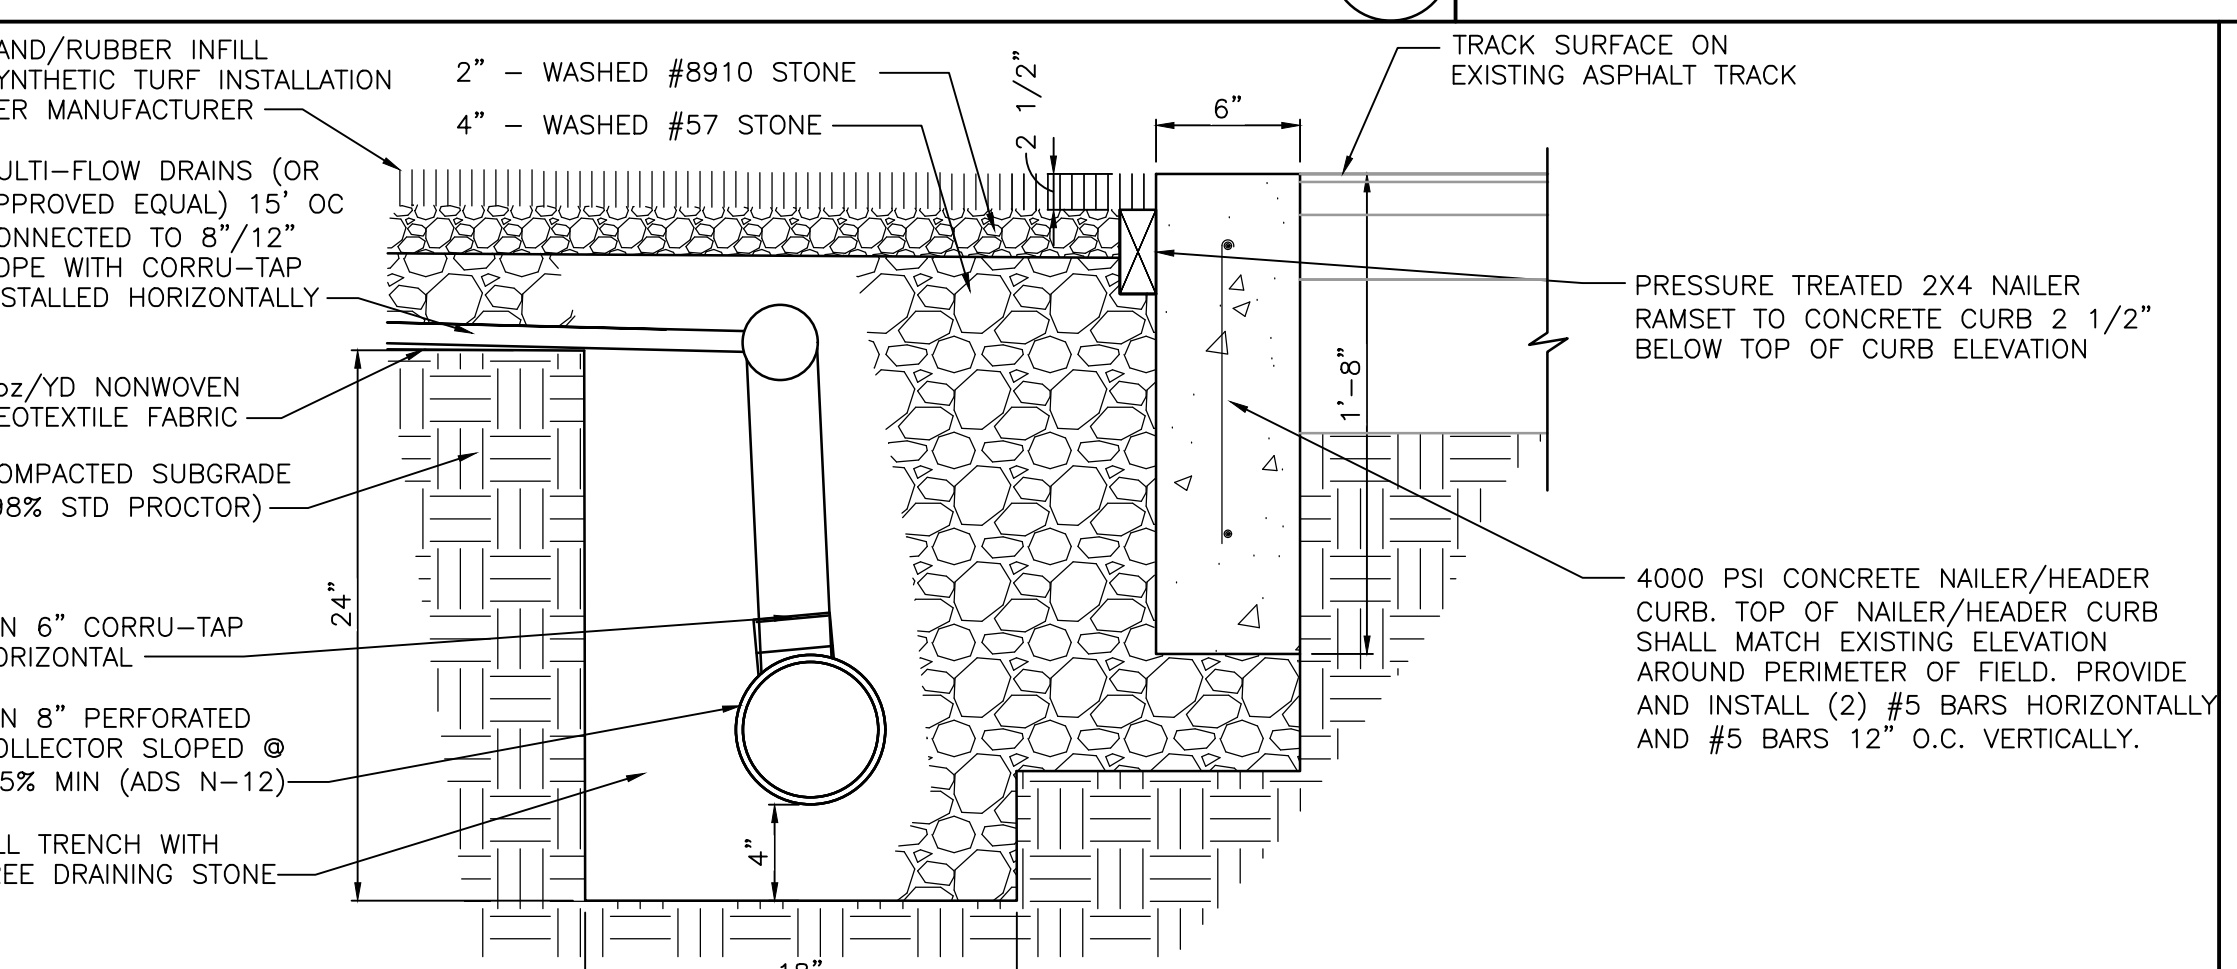


TAFT NAILER CURB SECTION AT FOOTBALL FIELD AND TRACK
SCALE: 1 1/2" = 1'-0"

6
C-5.3

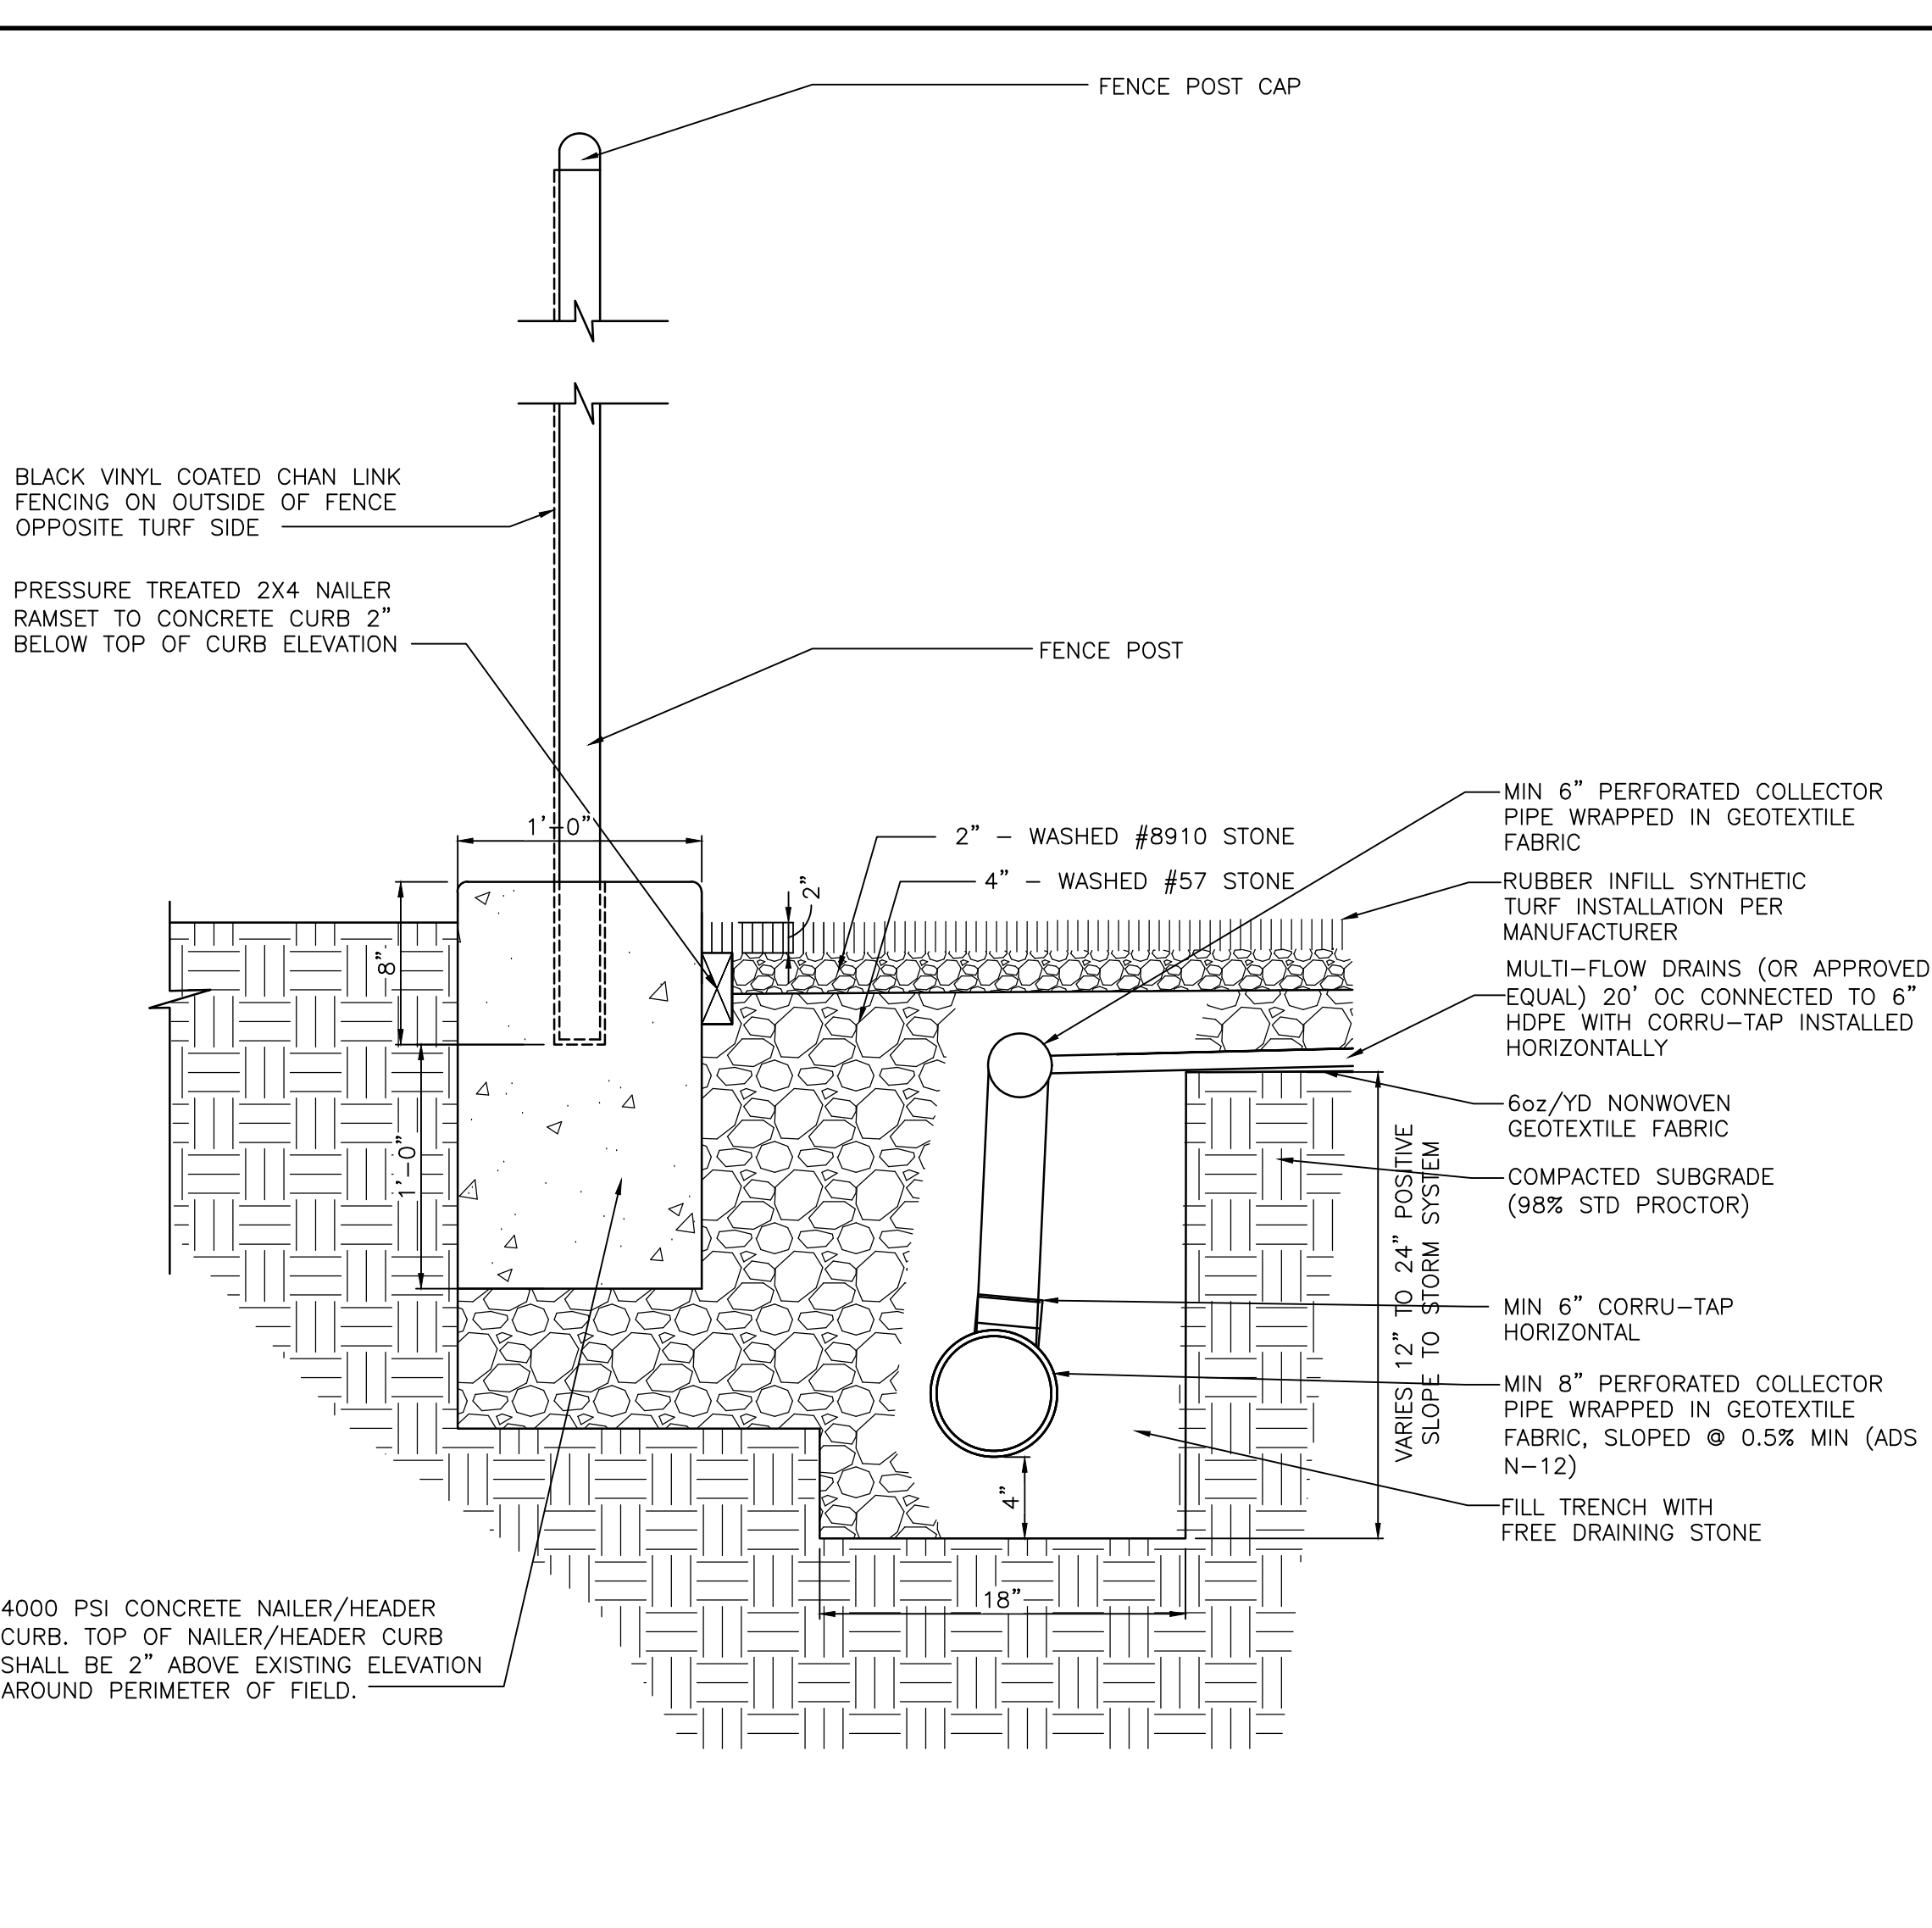


TYPICAL FENCE POST DETAIL
SCALE: 1 1/2" = 1'-0"

5
C-5.3

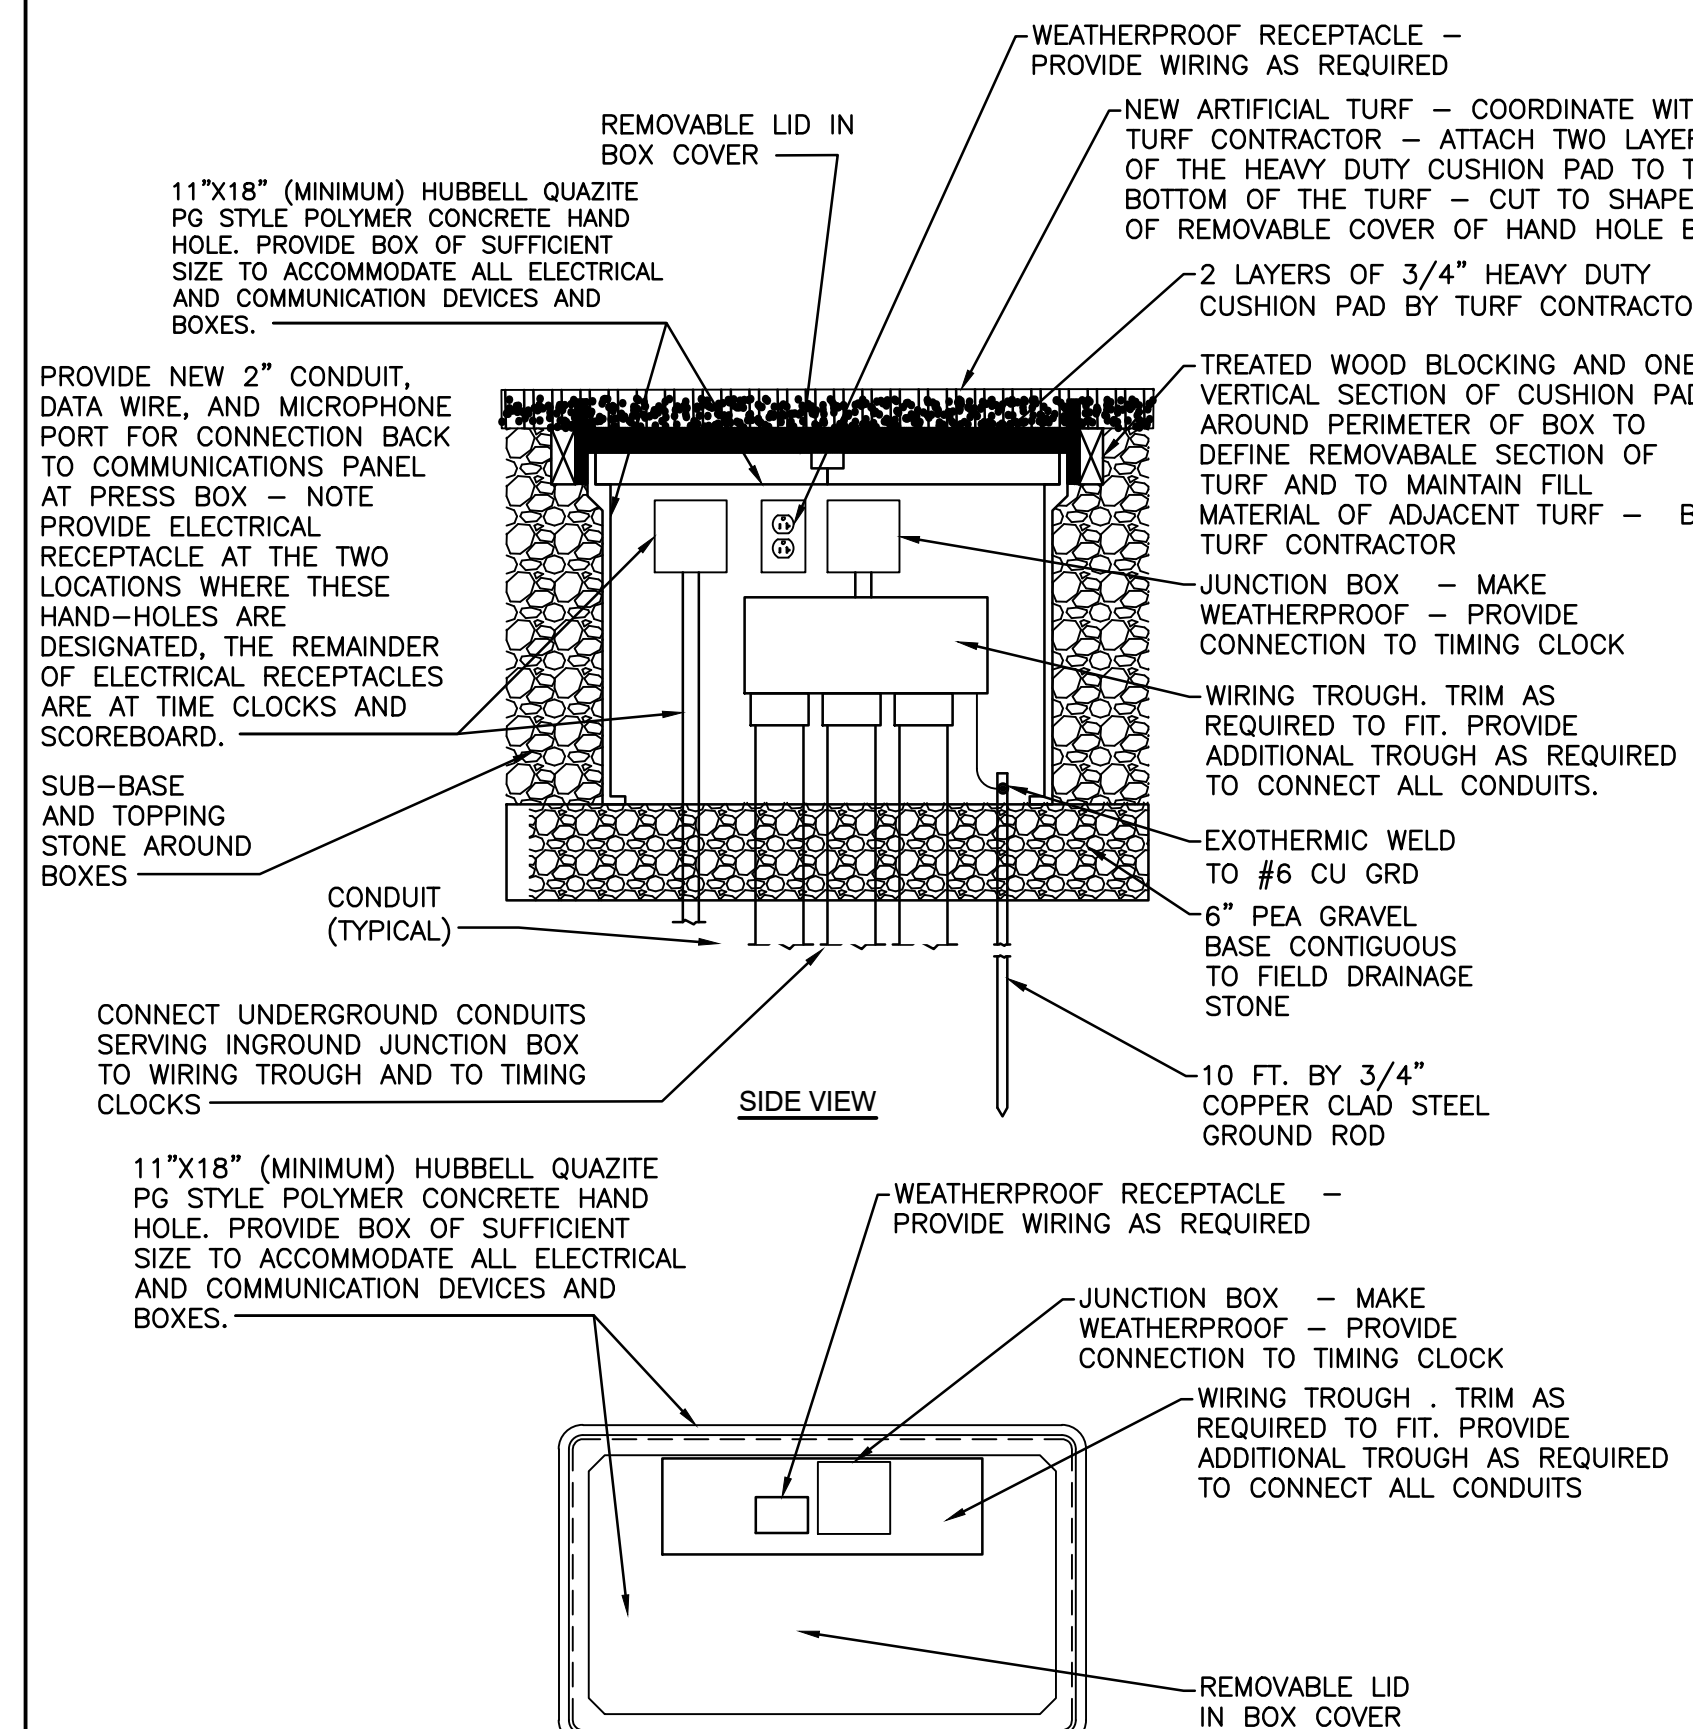


TYPICAL HAND HOLE BOX
SCALE: NTS

3
C-5.3

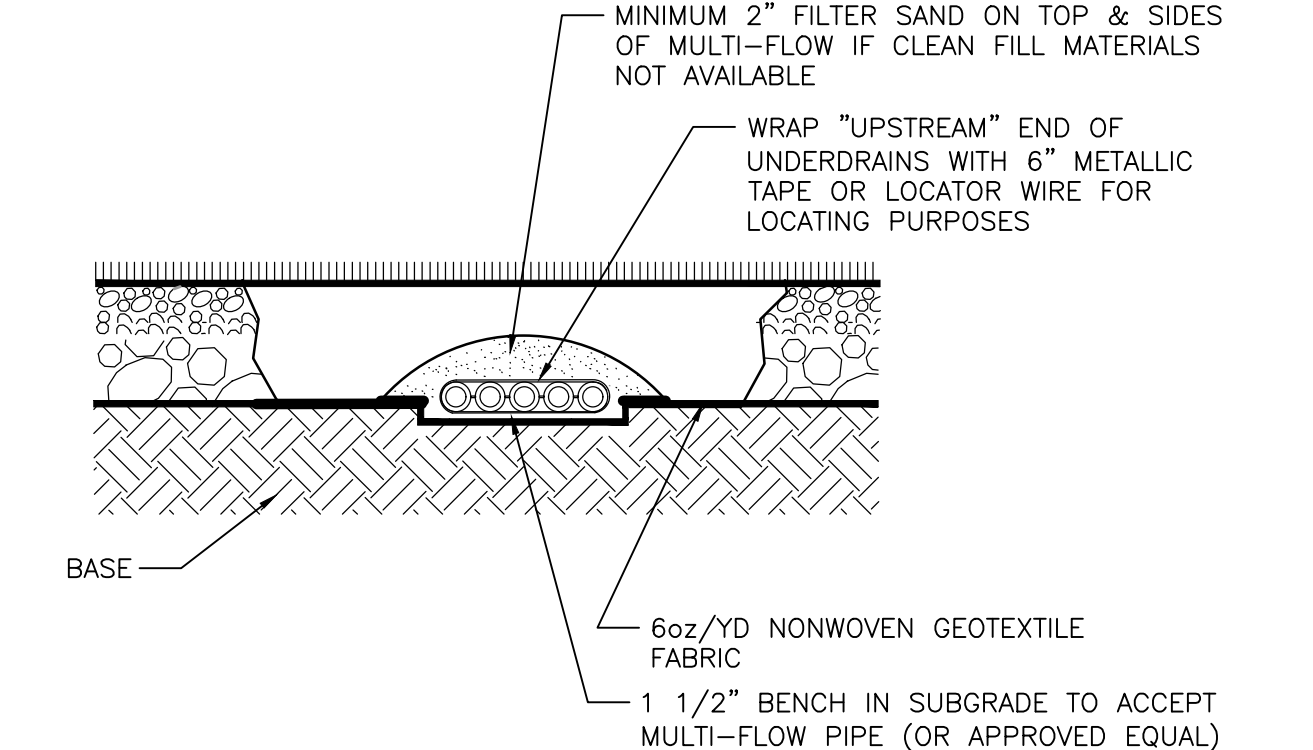

12\"/>

4
C-5.3

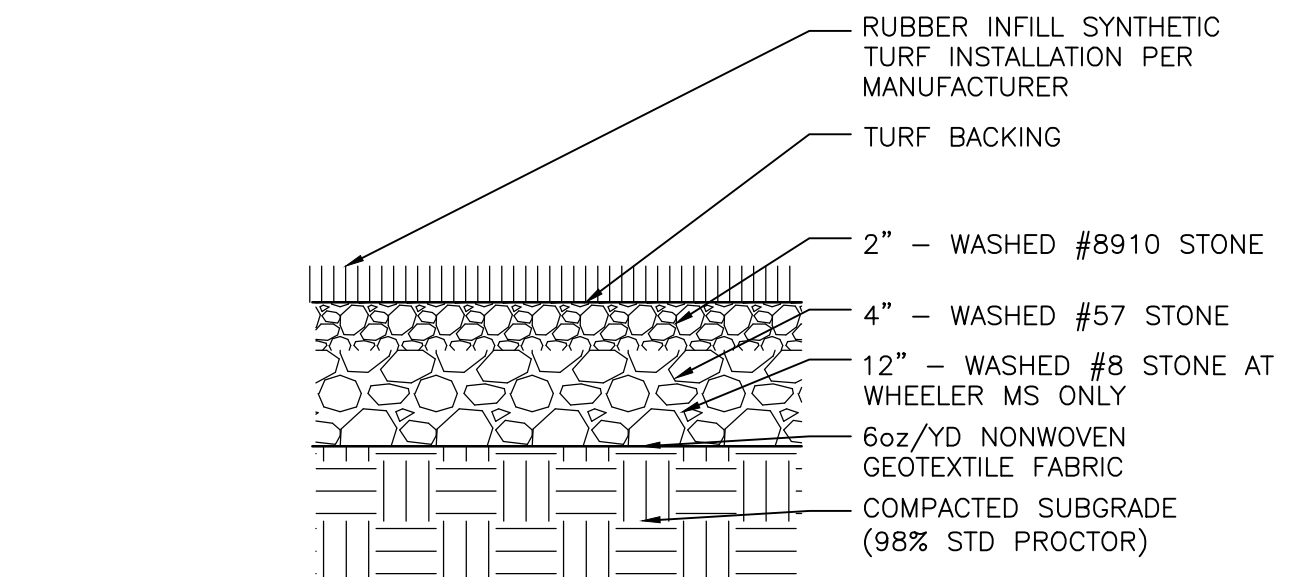


TYPICAL TURF SECTION
SCALE: 1 1/2" = 1'-0"

2
C-5.3

GIBALTAR DESIGN
9102 N. Meridian St., Ste. 300
Indianapolis, IN 46260
Homepage: www.GibraltarDesign.com
Email: info@GibraltarDesign.com
Phone: 317.580.5777 Fax: 317.580.5778

PROJECT
23-112
DATE
08/04/23
COORDINATED BY
DTB JPB
DRAWN BY
DTB
CHECKED BY
DTB JPB

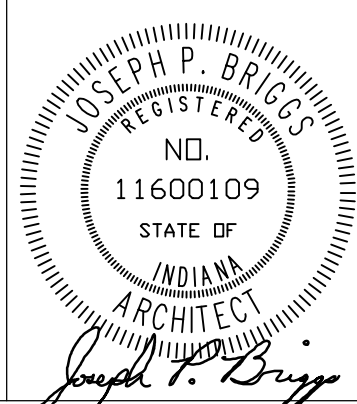

COPYRIGHT NOTICE:
THE CONCEPTS, DESIGNS, PLANS, DETAILS, ETC., SHOWN ON THIS DOCUMENT ARE THE PROPERTY OF GIBALTAR DESIGN AND WERE CREATED FOR USE ON THIS SPECIFIC PROJECT. NONE OF THIS INFORMATION SHALL BE USED BY ANY PERSON OR FIRM FOR ANY PURPOSE WITHOUT THE EXPRESS WRITTEN CONSENT OF GIBALTAR DESIGN. THE OWNER MAY RETAIN COPIES FOR INFORMATION AND REFERENCE IN CONNECTION ONLY WITH THIS PROJECT.


REVISIONS
MARK DATE ISSUED FOR
AD-2 08/31/23 ADDENDUM NO. 2

DRAWING
ARTIFICIAL TURF DETAILS

PROJECT
LOWELL HIGH SCHOOL - SITE AND STADIUM IMPROVEMENTS

GIBALTAR DESIGN SHEET


C-5.3

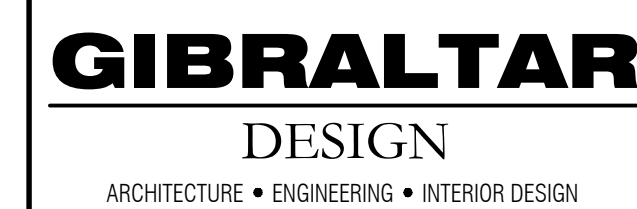


PROJECT

**LOWELL HIGH
SCHOOL SITE,
BLEACHERS, &
TURF/DRAINAGE**


TRI-CREEK SCHOOL CORPORATION

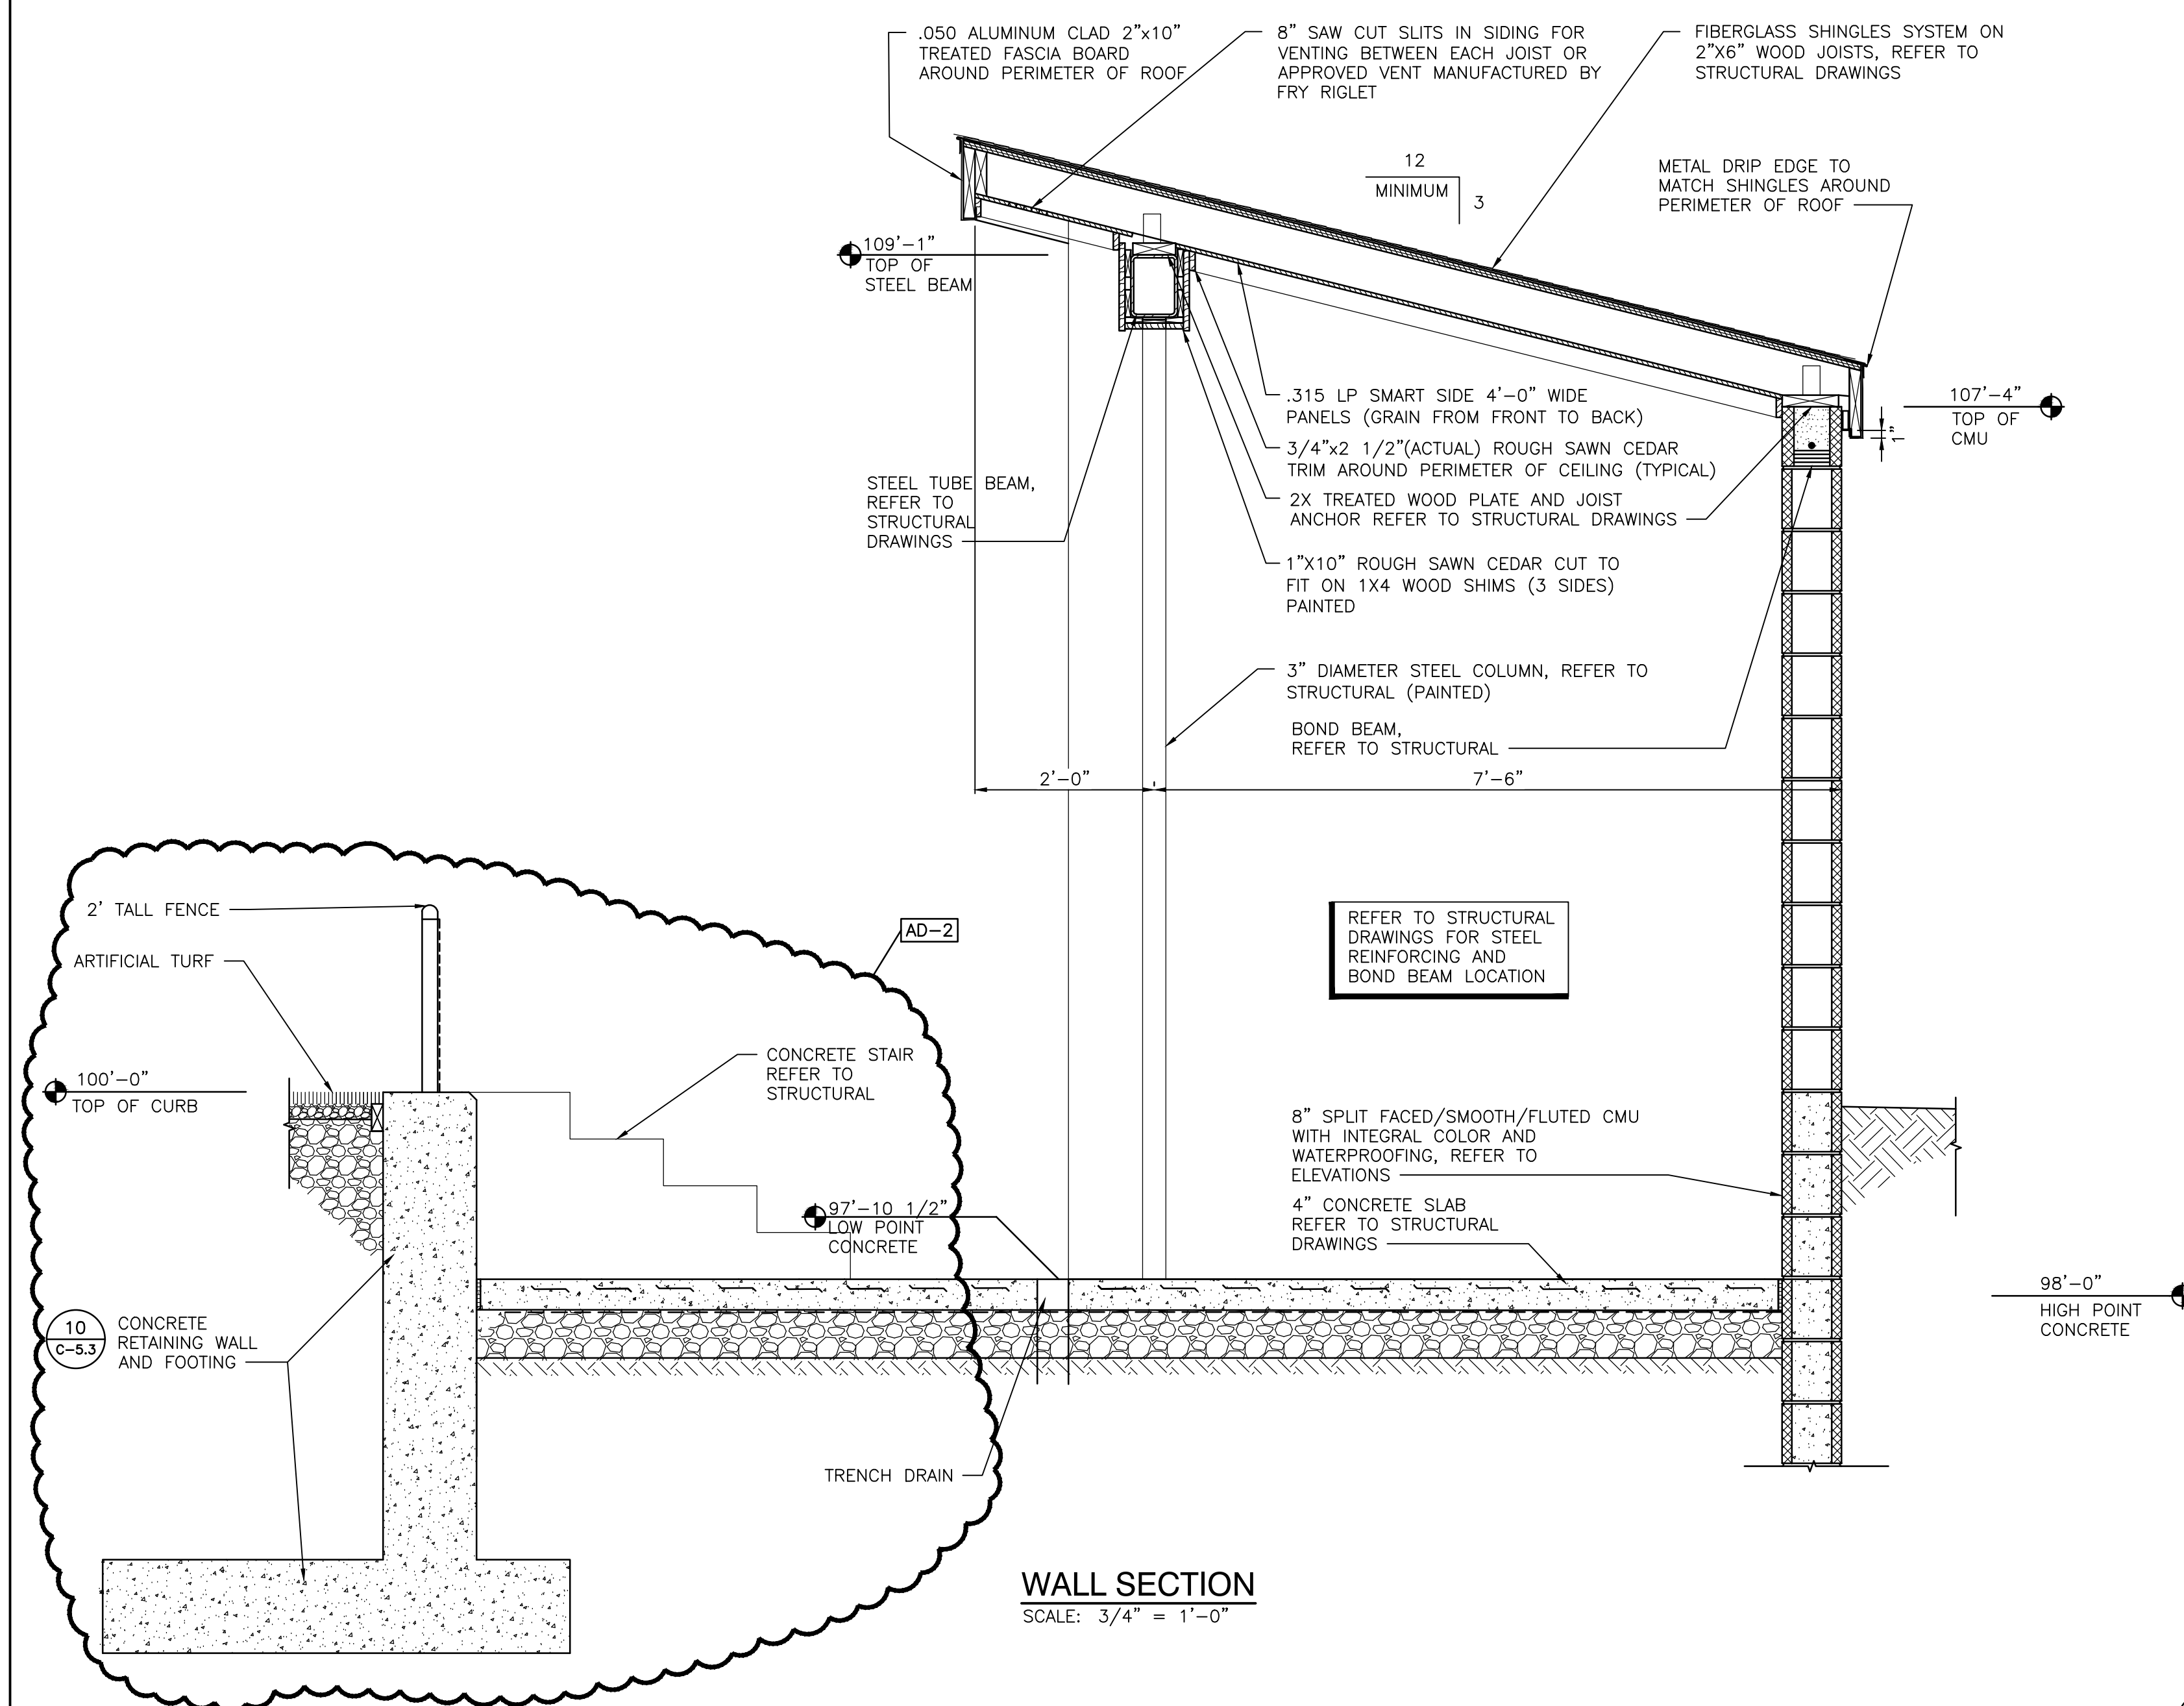

2
A-40

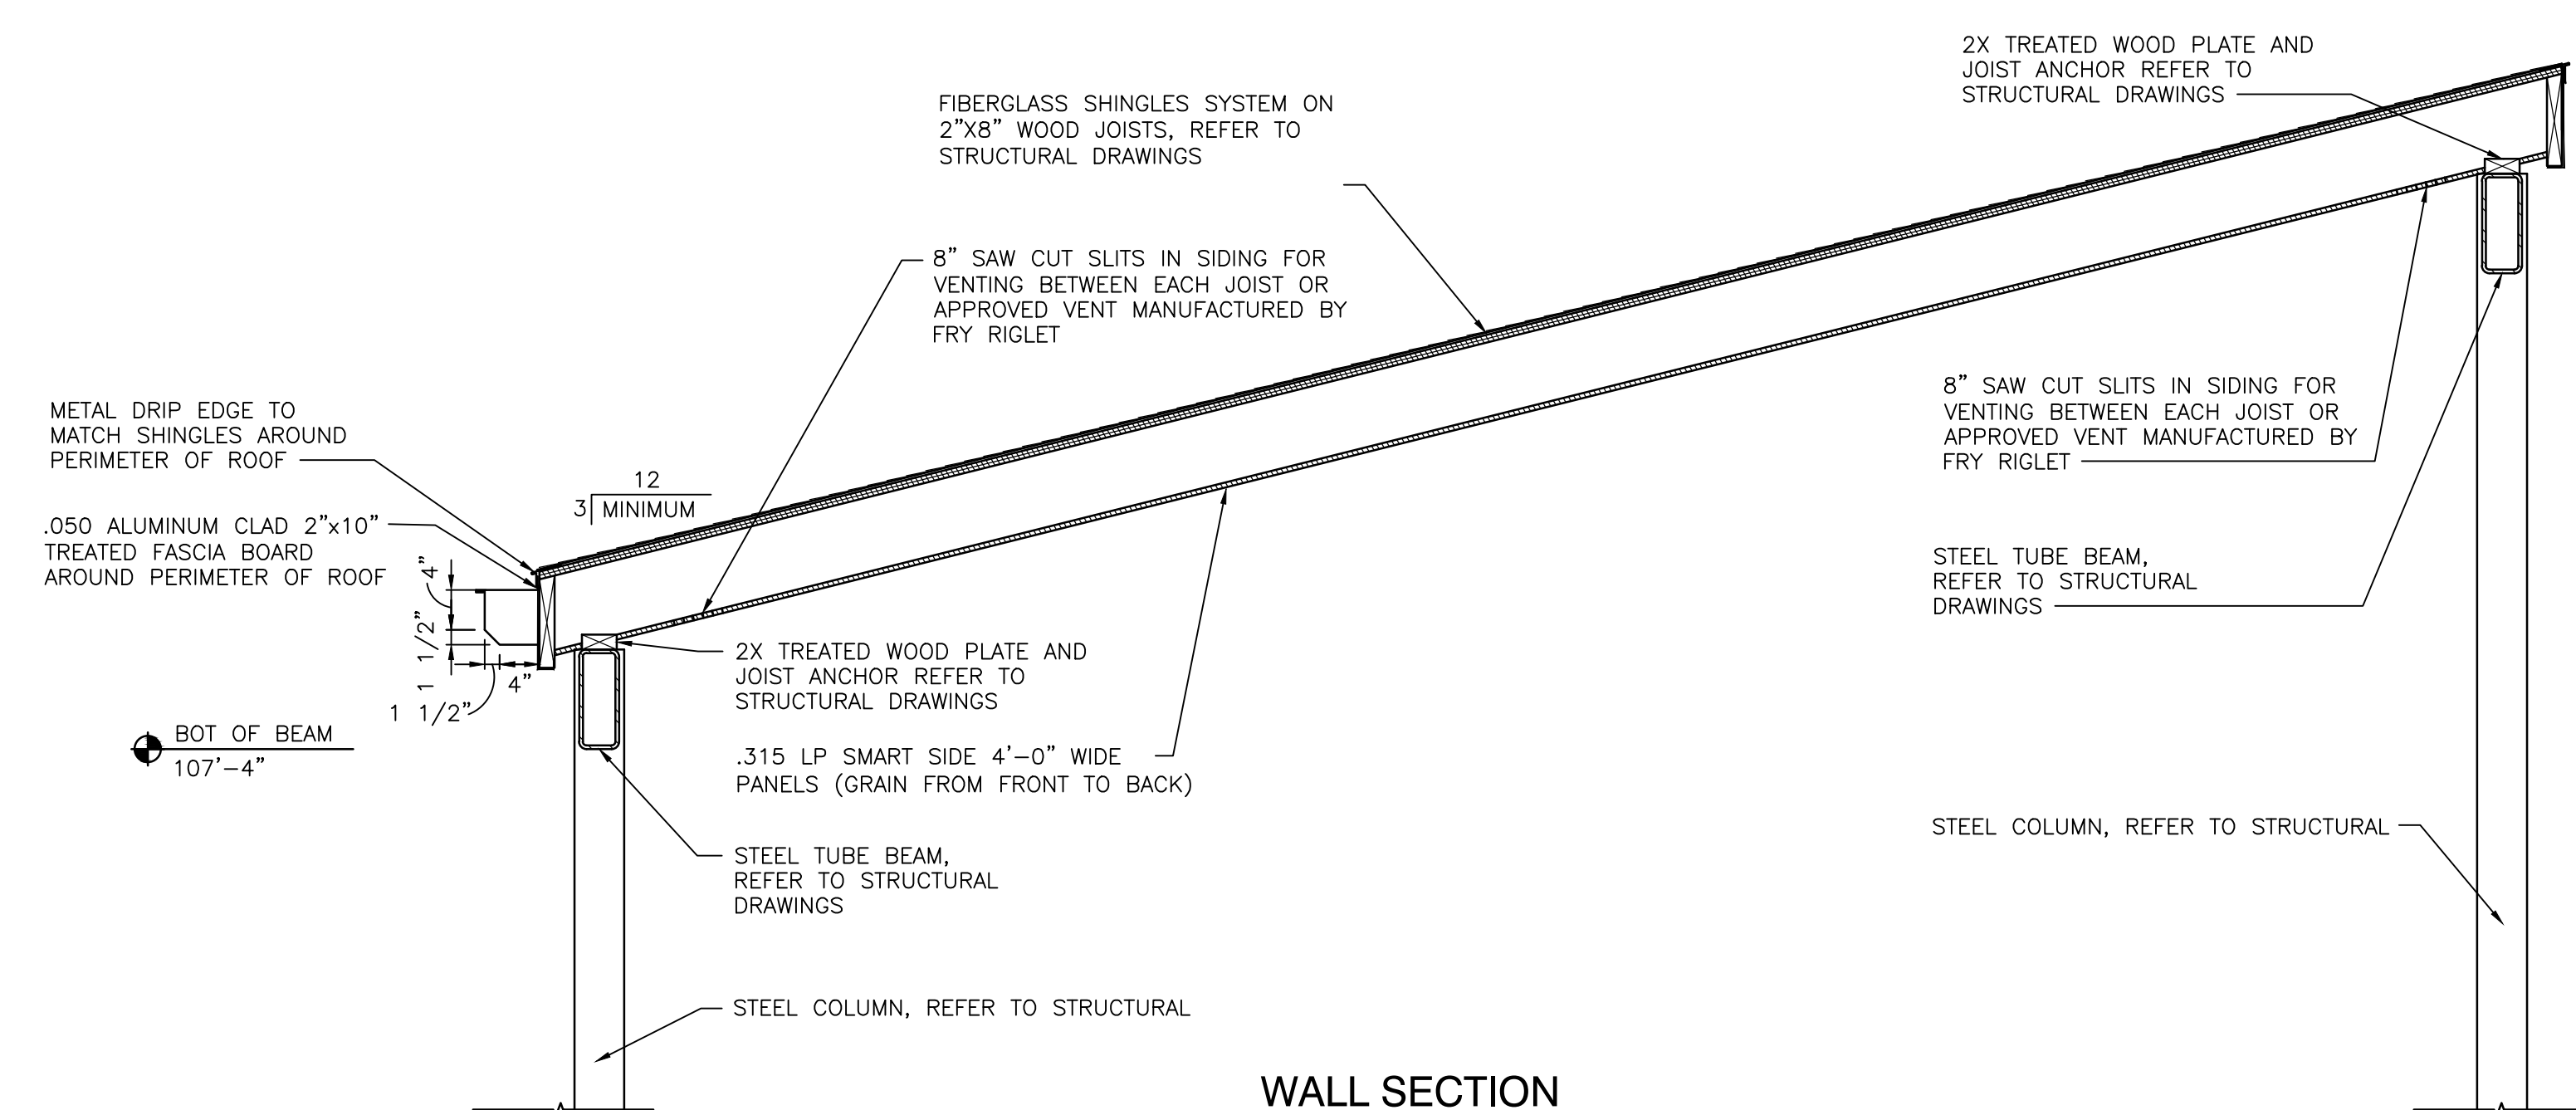

WALL SECTION
SCALE: 3/4" = 1'-0"

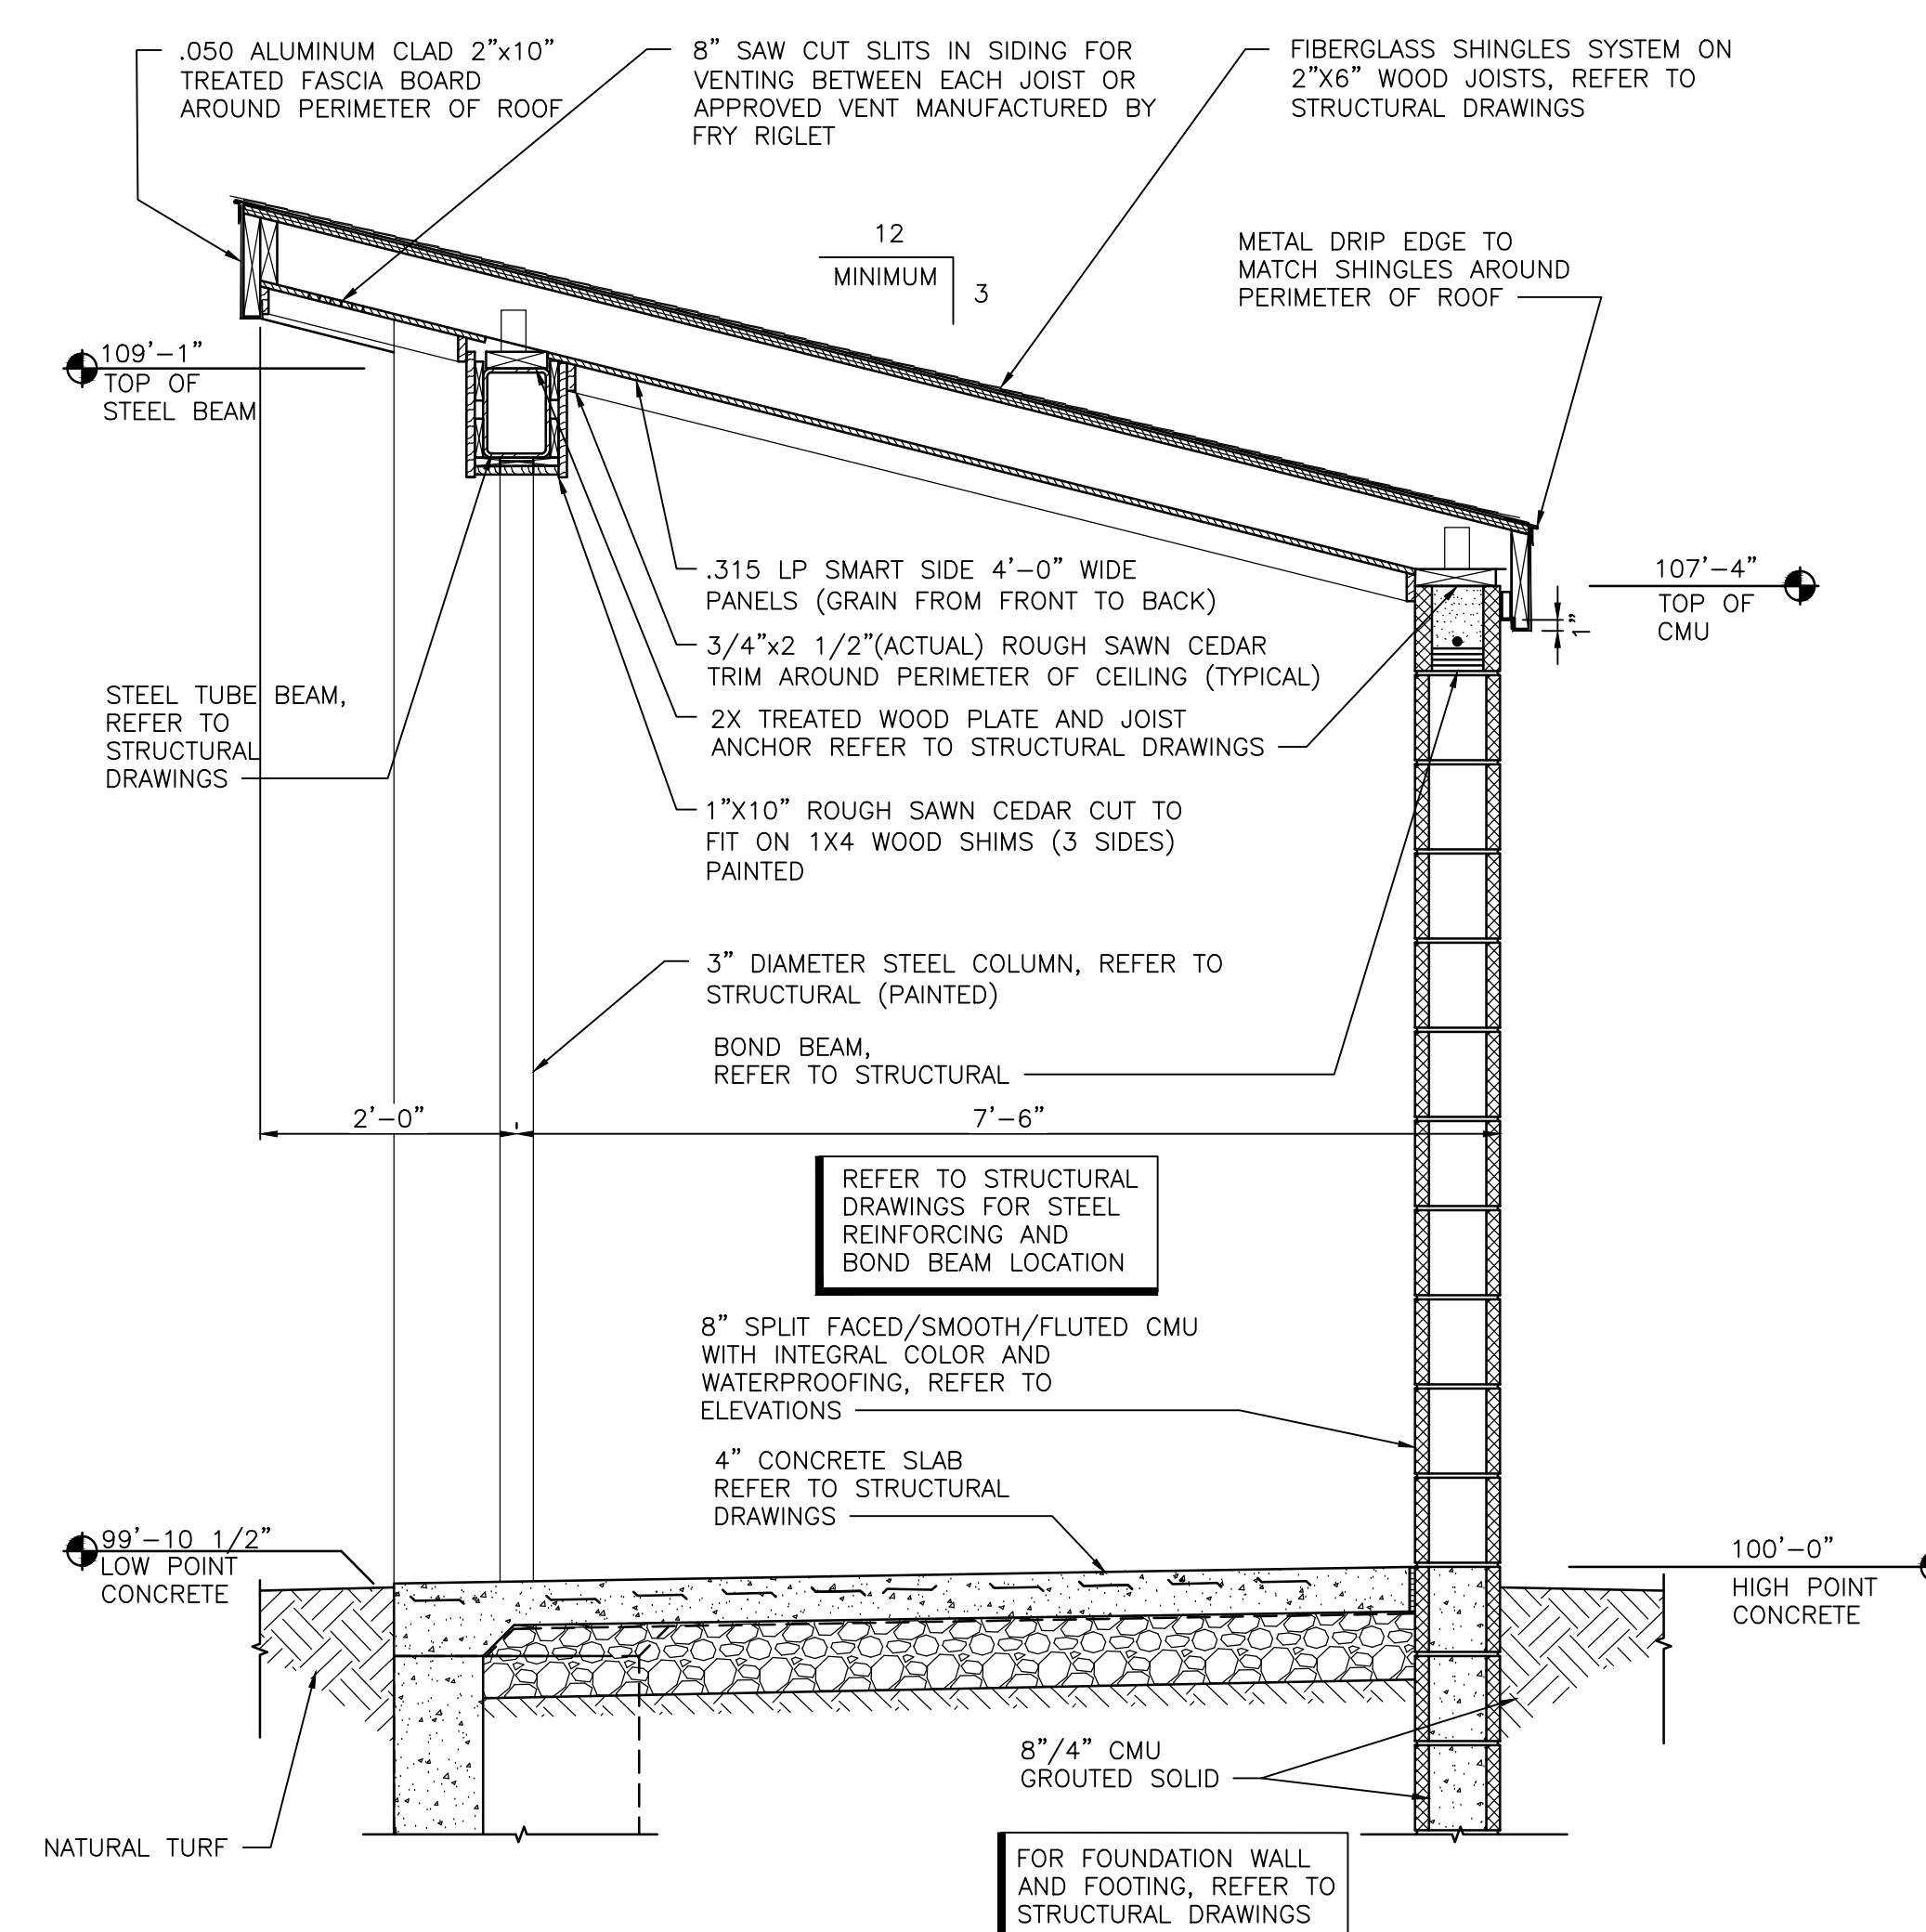

WALL SECTION
SCALE: 3/4" = 1'-0"

GIBRALTAR DESIGN

9102 N. Meridian St., Ste. 300
Indianapolis, IN 46260
Homepage www.GibraltarDesign.com
Email info@GibraltarDesign.com
Phone 317.580.5777 Fax 317.580.5778

PROJECT 23-112	
DATE 08/04/23	
COORDINATED BY DTB JPB	
DRAWN BY DTB	
CHECKED BY DTB JPB	

COPYRIGHT NOTICE:
THE CONCEPTS, DESIGNS, PLANS, DETAILS, ETC., SHOWN ON
THIS DOCUMENT ARE THE PROPERTY OF GIBRALTAR DESIGN AND
WERE CREATED FOR USE ON THIS SPECIFIC PROJECT. NONE OF
THIS INFORMATION SHALL BE USED BY ANY PERSON OR FIRM
FOR ANY PURPOSE WITHOUT THE EXPRESS WRITTEN CONSENT
OF GIBRALTAR DESIGN. THE OWNER MAY RETAIN COPIES FOR
INFORMATION AND REFERENCE IN CONNECTION ONLY WITH THIS
PROJECT.

[illegible]

DRAWING
WALL SECTIONS


PROJECT
LOWELL HIGH SCHOOL - SITE AND
STADIUM IMPROVEMENTS

© GIBALTAR DESIGN

$$\frac{1}{A-40}$$

3
A-402

Friday, 9/1/2023 - 4:37 PM - LAST SAVED BY: DBURNS
Y:\23-112 TRI-CREEK SC - LOWELL HS SITE
IMPROVEMENTS\2X-XXX DRAWINGS\05 ARCH\A-402.DWG

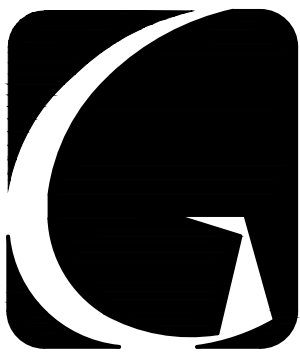

GIBALTAR
DESIGN
ARCHITECTURE • ENGINEERING • INTERIOR DESIGN

PROJECT
LOWELL HIGH SCHOOL SITE, BLEACHERS, & TURF/DRAINAGE
TRI-CREEK SCHOOL CORPORATION

GENERAL NOTES:

1. FOR ADDITIONAL GENERAL ELECTRICAL NOTES, SEE GENERAL ELECTRICAL PROJECT NOTES ON SHEET E-001.
2. SEE E-600 SHEETS FOR ELECTRICAL DETAILS AND SCHEDULES.
3. SEE E-700 SHEETS FOR ELECTRICAL DISTRIBUTION DIAGRAM.

DEMOLITION PLAN NOTES: (THESE NOTES APPLY TO THIS SHEET ONLY)

- 1 EXISTING PAD MOUNTED TRANSFORMER #4, FOOTBALL FIELD LIGHTING PANEL "FFLDP", ELECTRICAL EQUIPMENT SHALL REMAIN, UNLESS OTHERWISE NOTED.
- 2 EXISTING EMERGENCY GENERATOR, AUTOMATIC TRANSFER SWITCH AND PANELS SHALL REMAIN, UNLESS OTHERWISE NOTED.
- 3 REPLACE EXISTING FOOTBALL FIELD PANEL "FFLDP" WITH NEW PANEL "FFLDP".
- 4 EXISTING PAD MOUNTED TRANSFORMER #3 SHALL BE RELOCATED. SEE SITE PLAN SHEETS ES100 AND ES102. SEE SITE PLAN SHEETS ES100 AND ES102 FOR ADDITIONAL INFORMATION AND FEEDER MODIFICATION INFORMATION.
- 5 REMOVE EXISTING FOOTBALL FIELD LIGHTING FIXTURES, CROSS ARMS, ETC. AND REMOVE ASSOCIATED FEEDERS BACK TO THE SOURCE, UNLESS OTHERWISE NOTED. EXISTING EMERGENCY LIGHTING FIXTURES, CIRCUITING, ETC. SHALL REMAIN. PREPARE EXISTING FOOTBALL FIELD LIGHTING POLES FOR NEW LIGHTING FIXTURES. CROSS ARMS, CIRCUITING, CONTROLS, ETC. IN ADDITION, REMOVE EXISTING FOOTBALL FIELD LIGHTING CONTROLS AND ALL ASSOCIATED CONDUIT AND WIRE, UNLESS OTHERWISE NOTED.
- 6 RELOCATE EXISTING SOCCER FIELD LIGHTING POLES AND PREPARE FOR NEW LIGHTING FIXTURES, CROSSARMS, WIRING, ETC. SEE SHEET ES106 FOR NEW LOCATIONS, CIRCUITING AND CONTROLS. REMOVE SOCCER FIELD LIGHTING FIXTURES, CROSSARMS, WIRING, POLE BASES AND CONTROLS. REMOVE ASSOCIATED FEEDERS BACK TO THE SOURCE, UNLESS OTHERWISE NOTED.
- 7 RELOCATE EXISTING TENNIS COURT LIGHTING POLES AND PREPARE FOR NEW LIGHTING FIXTURES, CROSSARMS, WIRING, ETC. SEE SHEET ES107 FOR NEW LOCATIONS, CIRCUITING AND CONTROLS. REMOVE TENNIS COURT LIGHTING POLE BASES AND CONTROLS. REMOVE ASSOCIATED FEEDERS BACK TO THE SOURCE, UNLESS OTHERWISE NOTED.
- 8 REMOVE EXISTING DISTRIBUTION PANELBOARD "SDP" AND ASSOCIATED FEEDER FROM EXISTING PAD MOUNTED TRANSFORMER #3. REMOVE EXISTING BRANCH CIRCUIT FEEDERS, INCLUDING FEEDER TO THE EXISTING RED BARN BEING REMOVED. INTERCEPT ANY EXISTING FEEDER SERVING EXISTING EQUIPMENT THAT MAY REMAIN AND EXTEND TO NEW PANEL "SDP".
- 9 REMOVE TENNIS COURT LIGHTING CONTROLS AND REMOVE ASSOCIATED WIRING.
- 10 RELOCATE EXISTING PANELBOARDS AND EXTEND ALL BRANCH CIRCUITS SERVING LIGHTS, EQUIPMENT, ETC THAT REMAINS TO THE RELOCATED PANELS.
- 11 REMOVE EXISTING FEEDER TO THE EXISTING INCOMING ELECTRICAL SERVICE PANELBOARD IN THE NORTH STAR BUILDING, UNLESS OTHERWISE NOTED.
- 12 DISCONNECT ELECTRICAL SERVICE TO THE EXISTING FOOTBALL FIELD PRESSBOX BEING REMOVED AND REMOVE EXISTING FEEDER BACK TO THE SOURCE. INTERCEPT EXISTING EMERGENCY LIGHTING CIRCUIT SERVING THE EXISTING FOOTBALL FIELD PRESSBOX AND EXTEND TO THE NEW FOOTBALL FIELD PRESSBOX.

GIBALTAR DESIGN

9102 N. Meridian St., Ste. 300
Indianapolis, IN 46260
Homepage: www.GibraltarDesign.com
Email: info@GibraltarDesign.com
Phone: 317.580.5777 Fax: 317.580.5778

PROJECT
23-112
DATE
08/04/23
COORDINATED BY
PCB
DRAWN BY
PCB JVC
CHECKED BY
JPB



COPYRIGHT NOTICE:
THE CONCEPTS, DESIGNS, PLANS, DETAILS, ETC. SHOWN ON THIS DOCUMENT ARE THE PROPERTY OF GIBALTAR DESIGN AND WERE CREATED FOR USE ON THIS SPECIFIC PROJECT. NONE OF THIS INFORMATION SHALL BE USED BY ANY PERSON OR FIRM FOR ANY PURPOSE WITHOUT THE EXPRESS WRITTEN CONSENT OF GIBALTAR DESIGN. THE OWNER MAY RETAIN COPIES FOR INFORMATION AND REFERENCE IN CONNECTION ONLY WITH THIS PROJECT.

REVISIONS		
MARK	DATE	ISSUED FOR
AD-2	08/31/23	ADDENDUM NO. 2


DRAWING
ELECTRICAL DEMOLITION SITE PLAN


PROJECT
LOWELL HIGH SCHOOL - SITE AND STADIUM IMPROVEMENTS

© GIBALTAR DESIGN SHEET
ES101

ELECTRICAL DEMOLITION SITE PLAN

SCALE: 1" = 50'-0"

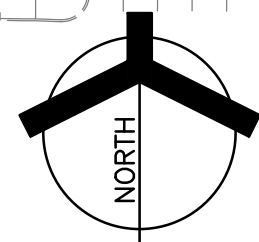


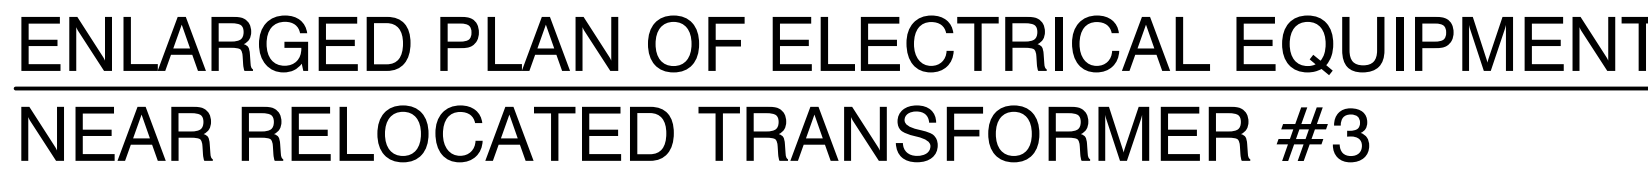

1. ALL WORK SHOWN ON THIS SHEET IS NEW AND BY THE ELECTRICAL TRADES, UNLESS OTHERWISE INDICATED.
2. COORDINATE LOCATIONS OF UNDERGROUND CONDUITS, HANDHOLES AND MANHOLES WITH OTHER SITE UTILITIES, UNDERGROUND DRAINS SERVICES, STRUCTURES AND FINAL GRADING.
3. NOT ALL UTILITIES HAVE BEEN SHOWN. VERIFY LOCATIONS AND ROUTING OF ALL NEW AND EXISTING UTILITIES PRIOR TO ANY NEW WORK.
4. FOR ADDITIONAL GENERAL ELECTRICAL NOTES, SEE GENERAL ELECTRICAL PROJECT NOTES ON SHEET E-001.
5. SEE E-600 SHEETS FOR ELECTRICAL DETAILS AND SCHEDULES.
6. SEE E-700 SHEETS FOR ELECTRICAL DISTRIBUTION DIAGRAMS.

① PROVIDE THE APPROPRIATE GALVANIZED STRUCTURAL STEEL CHANNELS SUPPORT FOR THE ELECTRICAL EQUIPMENT SHOWN. VERIFY EXACT LOCATION OF ALL EQUIPMENT WITH ARCHITECT AND CONSTRUCTION MANAGER PRIOR TO ROUGHING-IN.

① PROVIDE THE APPROPRIATE GALVANIZED STRUCTURAL STEEL CHANNELS SUPPORT FOR THE ELECTRICAL EQUIPMENT SHOWN. VERIFY EXACT LOCATION OF ALL EQUIPMENT WITH ARCHITECT AND CONSTRUCTION MANAGER PRIOR TO ROUGHING-IN.

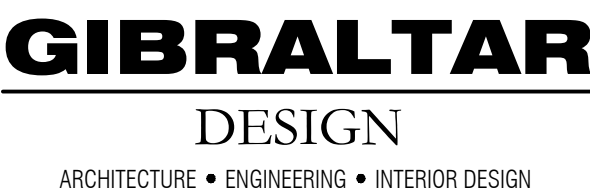

**LOWELL HIGH
SCHOOL SITE,
BLEACHERS, &
TURF/DRAINAGE**

TRI-CREEK SCHOOL CORPORATION

9102 N. Meridian St., Ste. 300
Indianapolis, IN 46260
Homepage www.GibraltarDesign.com
Email info@GibraltarDesign.com
Phone 317.580.5777 Fax 317.580.5778

COPYRIGHT NOTICE: THE CONCEPTS, DESIGNS, PLANS, DETAILS, ETC., SHOWN ON THIS DOCUMENT ARE THE PROPERTY OF GIBRALTAR DESIGN AND WERE CREATED FOR USE ON THIS SPECIFIC PROJECT. NONE OF THIS INFORMATION SHALL BE USED BY ANY PERSON OR FIRM FOR ANY PURPOSE WITHOUT THE EXPRESS WRITTEN CONSENT OF GIBRALTAR DESIGN. THE OWNER MAY RETAIN COPIES FOR INFORMATION AND REFERENCE IN CONNECTION ONLY WITH THIS PROJECT.

REVISIONS		
MARK	DATE	ISSUED FOR
AD-2	08/31/23	ADDENDUM NO. 2


DRAWING
ELECTRICAL SITE PLAN

PROJECT
LOWELL HIGH SCHOOL - SITE AND
STADIUM IMPROVEMENTS

GIBRALTAR DESIGN

SHEET

ES102

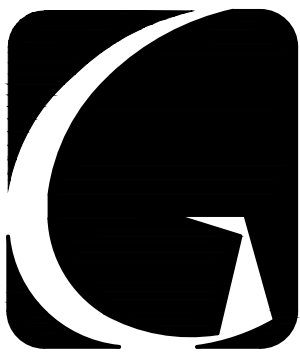

GIBRALTAR
DESIGN
ARCHITECTURE • ENGINEERING • INTERIOR DESIGN

PROJECT

**LOWELL HIGH
SCHOOL SITE,
BLEACHERS, &
TURF/DRAINAGE**
TRI-CREEK SCHOOL CORPORATION

SITE PLAN NOTES - GENERAL

1. ALL WORK SHOWN ON THIS SHEET IS NEW AND BY THE ELECTRICAL TRADES, UNLESS OTHERWISE INDICATED.
2. RELOCATE OR REMOVE ANY OR ALL EXISTING SERVICES, POLES, ETC., AS MAY BE REQUIRED TO ACCOMMODATE NEW CONSTRUCTION, UNLESS OTHERWISE INDICATED.
3. COORDINATE WITH DUKE ENERGY AND ALL FEES AND OTHER COSTS NOT BORNE BY THE POWER COMPANY TO PROVIDE ADDITIONAL WORK THAT IS NOT SHOWN ON THE DRAWINGS OR ADDRESSED IN THE SPECIFICATIONS TO PROVIDE THE NEW INCOMING PRIMARY ELECTRICAL SERVICES NOTED WILL BE COVERED AN ALLOWANCE.
4. COORDINATE LOCATIONS OF UNDERGROUND CONDUITS, HANDHOLES AND MANHOLES WITH OTHER SITE UTILITIES, UNDERGROUND DRAINS, SERVICES, STRUCTURES AND FINAL GRADING.
5. NOT ALL UTILITIES HAVE BEEN SHOWN. VERIFY LOCATIONS AND ROUTING OF ALL NEW AND EXISTING UTILITIES PRIOR TO ANY NEW WORK.
6. FOR ADDITIONAL GENERAL ELECTRICAL NOTES, SEE GENERAL ELECTRICAL PROJECT NOTES ON SHEET E-001.
7. SEE E-600 SHEETS FOR ELECTRICAL DETAILS AND SCHEDULES.
8. SEE E-700 SHEETS FOR ELECTRICAL DISTRIBUTION DIAGRAMS.

ELECTRICAL SITE PLAN NOTES: (THESE NOTES APPLY TO THIS SHEET ONLY)

- 1 FLUSH IN-GROUND JUNCTION BOX.
- 2 EXISTING FOOTBALL LIGHTING POLE AND EXISTING EMERGENCY LIGHTING FIXTURES SHALL REMAIN. MODIFY EXISTING FOOTBALL LIGHTING POLE AS NECESSARY TO PROVIDE THE NEW FOOTBALL FIELD LIGHTS, CROSSARMS, WIRING, ETC. TO PROVIDE A COMPLETE AND OPERATIONAL LIGHTING SYSTEM. CONNECT NEW FOOTBALL LIGHTS TO THE NEW FOOTBALL FIELD LIGHTING CONTROLS WITH THE NEW CIRCUITS INDICATED.
- 3 REMOVE THE EXISTING CONTROLS AND ALL ASSOCIATED WIRING. PROVIDE NEW FOOTBALL FIELD LIGHTING CONTROLS AS SHOWN.
- 4 PROVIDE A GFI TYPE DUPLEX RECEPTACLE WITH "WEATHERPROOF-IN-USE" COVER AT THE BASE OF THE FOOTBALL SCOREBOARD AND CONNECT TO CIRCUIT INDICATED.
- 5 FLUSH IN-GROUND PULL BOX.
- 6 PROVIDE A 1P-30 AMP NEMA 3R DISCONNECT FOR THE SCOREBOARD CONNECT IT TO THE SCOREBOARD AND CIRCUIT INDICATED (FBL1-6) VERIFY EXACT REQUIREMENTS WITH ARCHITECT AND SCOREBOARD INSTALLER/ SUPPLIER PRIOR TO ROUGHING IN OR PROVIDING ANY CONDUITS AND WIRES. PROVIDE A GROUND ROD AND THE APPROPRIATE GROUNDING FOR SCOREBOARD.
- 7 PROVIDE A 1P-30 AMP NEMA 3R DISCONNECT FOR THE GAME CLOCK AND CONNECT TO CIRCUIT INDICATED (FBL2-8). VERIFY EXACT REQUIREMENTS WITH ARCHITECT AND DELAY-OF-GAME TIMER INSTALLER/ SUPPLIER PRIOR TO ROUGHING IN OR PROVIDING ANY CONDUITS AND WIRES. PROVIDE A GROUND ROD AND THE APPROPRIATE GROUNDING FOR DELAY-OF-GAME TIMER.
- 8 PROVIDE A 1P-30 AMP NEMA 3R DISCONNECT FOR THE GAME CLOCK AND CONNECT TO CIRCUIT INDICATED (FBL2-8). VERIFY EXACT REQUIREMENTS WITH ARCHITECT AND DELAY-OF-GAME TIMER INSTALLER/ SUPPLIER PRIOR TO ROUGHING IN OR PROVIDING ANY CONDUITS AND WIRES. PROVIDE A GROUND ROD AND THE APPROPRIATE GROUNDING FOR DELAY-OF-GAME TIMER.
- 9 PROVIDE THE APPROPRIATE GALVANIZED STRUCTURAL STEEL CHANNEL SUPPORTS AND CONCRETE PAD FOR THE NEW PANELBOARDS, DISCONNECTS AND TRANSFORMERS LOCATED NEAR THE FOOTBALL FIELD BLEACHERS. VERIFY EXACT LOCATION WITH THE ARCHITECT AND OWNER PRIOR TO ROUGHING-IN.
- 10 PROVIDE A FLUSH IN-GROUND BOX FOR POWER, COMMUNICATIONS AND TECHNOLOGY DEVICES AND EQUIPMENT. SEE DETAIL ON SHEET E-501.
- 11 PROVIDE A DUPLEX POWER RECEPTACLE IN THE FLUSH IN-GROUND WEATHERTIGHT BOX.
- 12 PROVIDE A 1 1/2" CONDUIT AND A 1" CONDUIT ROUTED FROM THE IN-GROUND WEATHERTIGHT BOX TO THE FOOTBALL PRESS BOX FOR FUTURE USE.
- 13 TYPE SL-1 LIGHTING FIXTURE MOUNTED ON TOP OF SCOREBOARD FRAME TO ILLUMINATE THE FLAG.
- 14 REPLACE EXISTING PANEL "FFLDP" WITH NEW PANEL "FFLDP" WITH NEW PANEL "FFLDP". INTERCEPT EXISTING CIRCUITS SERVING EQUIPMENT THAT REMAIN AND EXTEND TO NEW PANEL "FFLDP".

GIBRALTAR DESIGN

9102 N. Meridian St., Ste. 300
Indianapolis, IN 46260
Homepage: www.GibraltarDesign.com
Email: info@GibraltarDesign.com
Phone: 317.580.5777 Fax: 317.580.5778

PROJECT

23-112

DATE

08/04/23

COORDINATED BY

PCB

DRAWN BY

PCB JVC

CHECKED BY

JPB

COPYRIGHT NOTICE:

THE CONCEPTS, DESIGNS, PLANS, DETAILS, ETC., SHOWN ON THIS DOCUMENT ARE THE PROPERTY OF GIBRALTAR DESIGN AND ARE NOT TO BE REPRODUCED OR USED IN ANY MANNER OR FOR ANY PURPOSE WITHOUT THE EXPRESS WRITTEN CONSENT OF GIBRALTAR DESIGN. THE OWNER MAY RETAIN COPIES FOR INFORMATION AND REFERENCE IN CONNECTION ONLY WITH THIS PROJECT.

REVISIONS

MARK

DATE

ISSUED FOR

AD-2 08/31/23

ADDENDUM NO. 2

DRAWING

ENLARGED ELECTRICAL

PLAN OF FOOTBALL FIELD

PROJECT


LOWELL HIGH SCHOOL - SITE AND

STADIUM IMPROVEMENTS

© GIBRALTAR DESIGN

SHEET

ES103

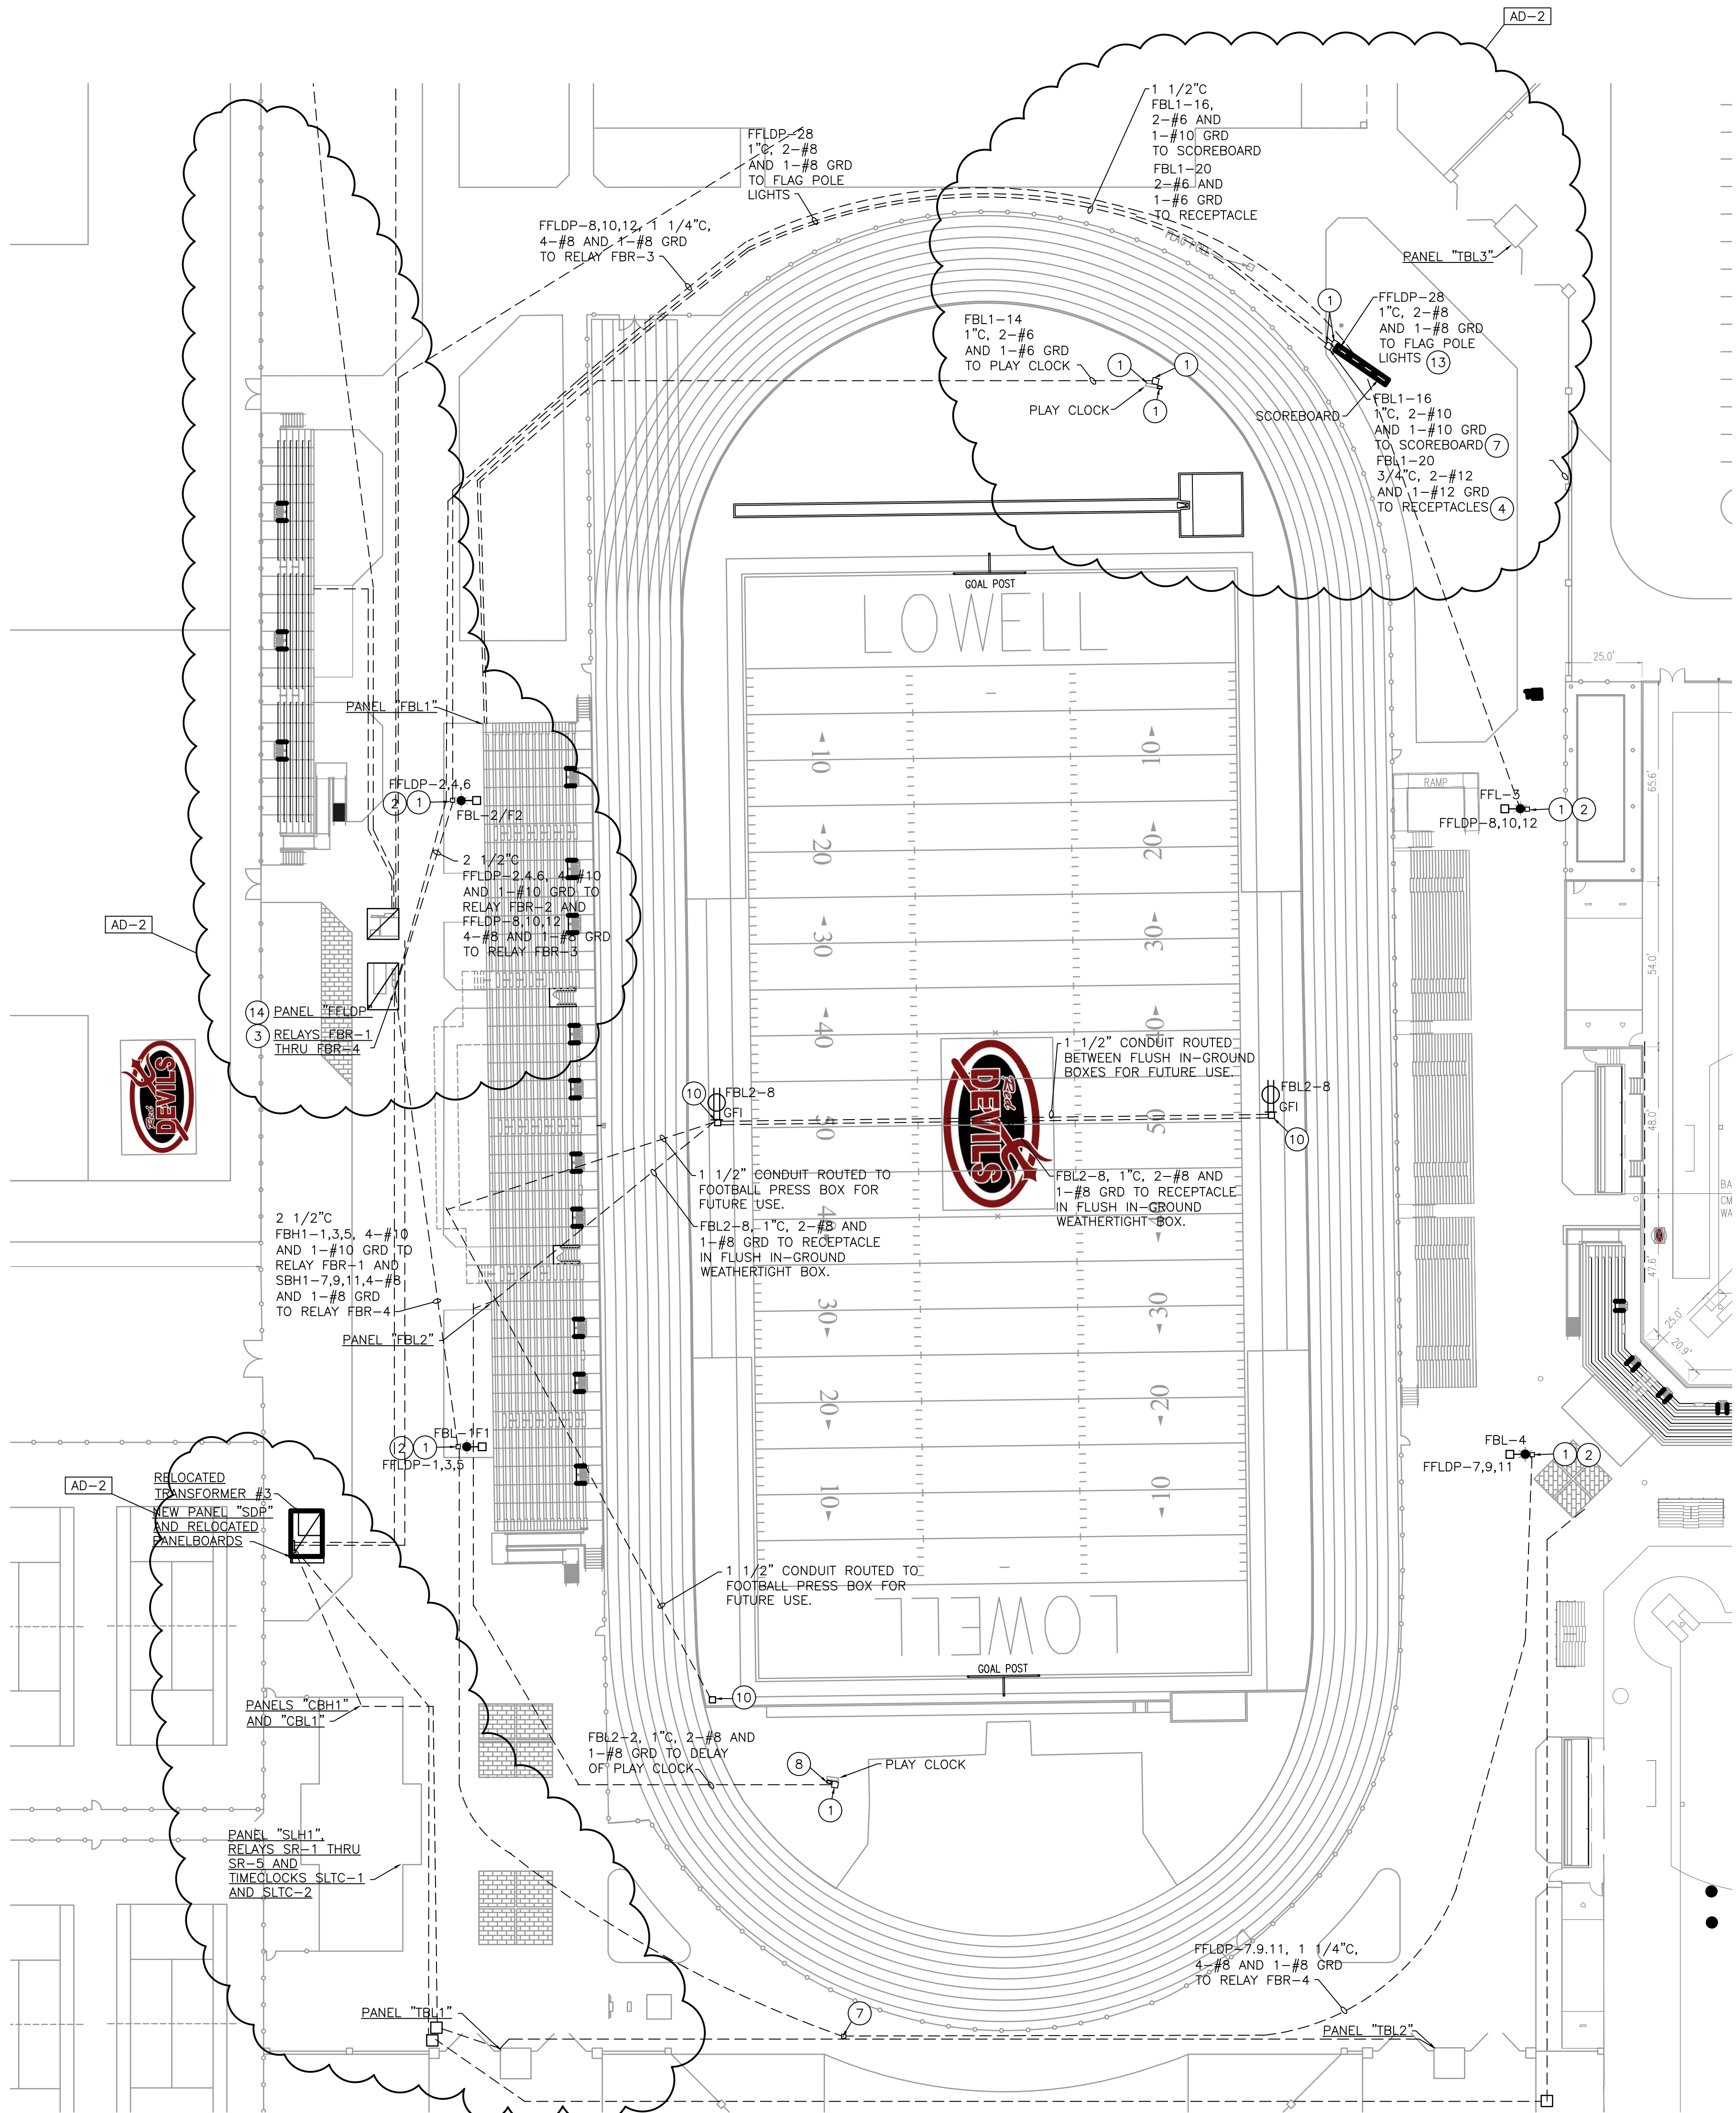



PROJECT

**LOWELL HIGH
SCHOOL SITE,
BLEACHERS, &
TURF/DRAINAGE**

TRI-CREEK SCHOOL CORPORATION

GIBALTAR DESIGN
9102 N. Meridian St., Ste. 300
Indianapolis, IN 46260
Homepage www.GibraltarDesign.com
Email info@GibraltarDesign.com
Phone 317.580.5777 Fax 317.580.5778

PROJECT 23-112	
DATE 08/04/23	
COORDINATED BY PCB	
DRAWN BY PCB JVC	
CHECKED BY JPB	

COPYRIGHT NOTICE: 01

THE CONCEPTS, DESIGNS, PLANS, DETAILS, ETC. SHOWN ON THIS DOCUMENT ARE THE PROPERTY OF GIBRALTAR DESIGN AND WERE CREATED FOR USE ON THIS SPECIFIC PROJECT. NONE OF THIS INFORMATION SHALL BE USED BY ANY PERSON OR FIRM FOR ANY PURPOSE WITHOUT THE EXPRESS WRITTEN CONSENT OF GIBRALTAR DESIGN. THE OWNER MAY RETAIN COPIES FOR INFORMATION AND REFERENCE IN CONNECTION ONLY WITH THIS PROJECT.

REVISIONS		
MARK	DATE	ISSUED FOR
AD-2	08/31/23	ADDENDUM NO. 2


DRAWING
ENLARGED ELECTRICAL
PLAN OF BASEBALL FIELDS

PROJECT
LOWELL HIGH SCHOOL - SITE AND
STADIUM IMPROVEMENTS


 GIBRALTAR DESIGN

- ① FLUSH IN-GROUND JUNCTION BOX.
- ② PEDOC (1P184T SERIES) 1/8" HIGH PEDESTAL WITH BASE, HINGED TOP (WEATHERPROOF-IN-USE) AND WEATHERPROOF 20 AMP GFI TYPE RECEPTACLE. VERIFY EXIST LOCATION WITH OWNER, ARCHITECT AND CONSTRUCTION MANAGER PRIOR TO ROUGHING-IN.
- ③ TYPE SL-1 LIGHTING FIXTURE MOUNTED ON TOP OF SCOREBOARD FRAME TO ILLUMINATE THE FLAG.
- ④ PROVIDE A 3P-30 AMP WEATHERPROOF DISCONNECT AND CONNECT CIRCUIT INDICATED TO THE SCOREBOARD.
- ⑤ PROVIDE A GFI TYPE DUPLEX RECEPTACLE WITH "WEATHERPROOF-IN-USE" COVER AT THE BASE OF THE FOOTBALL SCOREBOARD AND CONNECT TO CIRCUIT INDICATED.
- ⑥ 1 1/4" WEATHERSCOREBOARD CONTROL CABLES ROUTED TO HOME TEAM DUGOUT. VERIFY WITH SCOREBOARD MANUFACTURER AND OWNER THE TYPE OF CABLE AND ELECTRICAL REQUIREMENTS REQUIRED BEFORE ROUGHING-IN.


1. ALL WORK SHOWN ON THIS SHEET IS NEW AND BY THE ELECTRICAL TRADES, UNLESS OTHERWISE INDICATED.
2. COORDINATE LOCATIONS OF UNDERGROUND CONDUITS, HANDHOLES AND MANHOLES WITH OTHER SITE UTILITIES, UNDERGROUND DRAINS, SERVICES, STRUCTURES AND FINAL GRADING.
3. NOT ALL UTILITIES HAVE BEEN SHOWN. VERIFY LOCATIONS AND ROUTING OF ALL NEW AND EXISTING UTILITIES PRIOR TO ANY NEW WORK.
4. FOR ADDITIONAL GENERAL ELECTRICAL NOTES, SEE GENERAL ELECTRICAL PROJECT NOTES ON SHEET E-001.
5. SEE E-600 SHEETS FOR ELECTRICAL DETAILS AND SCHEDULES.
6. SEE E-700 SHEETS FOR ELECTRICAL DISTRIBUTION DIAGRAMS.
7. COORDINATE EXACT SPORT LIGHTING POLE LOCATIONS WITH SPORTS LIGHTING CONTRACTOR, CONSTRUCTION MANAGER AND ALL UNDERGROUND UTILITIES PRIOR TO ROUGH-IN. SEE CIVIL DRAWINGS.

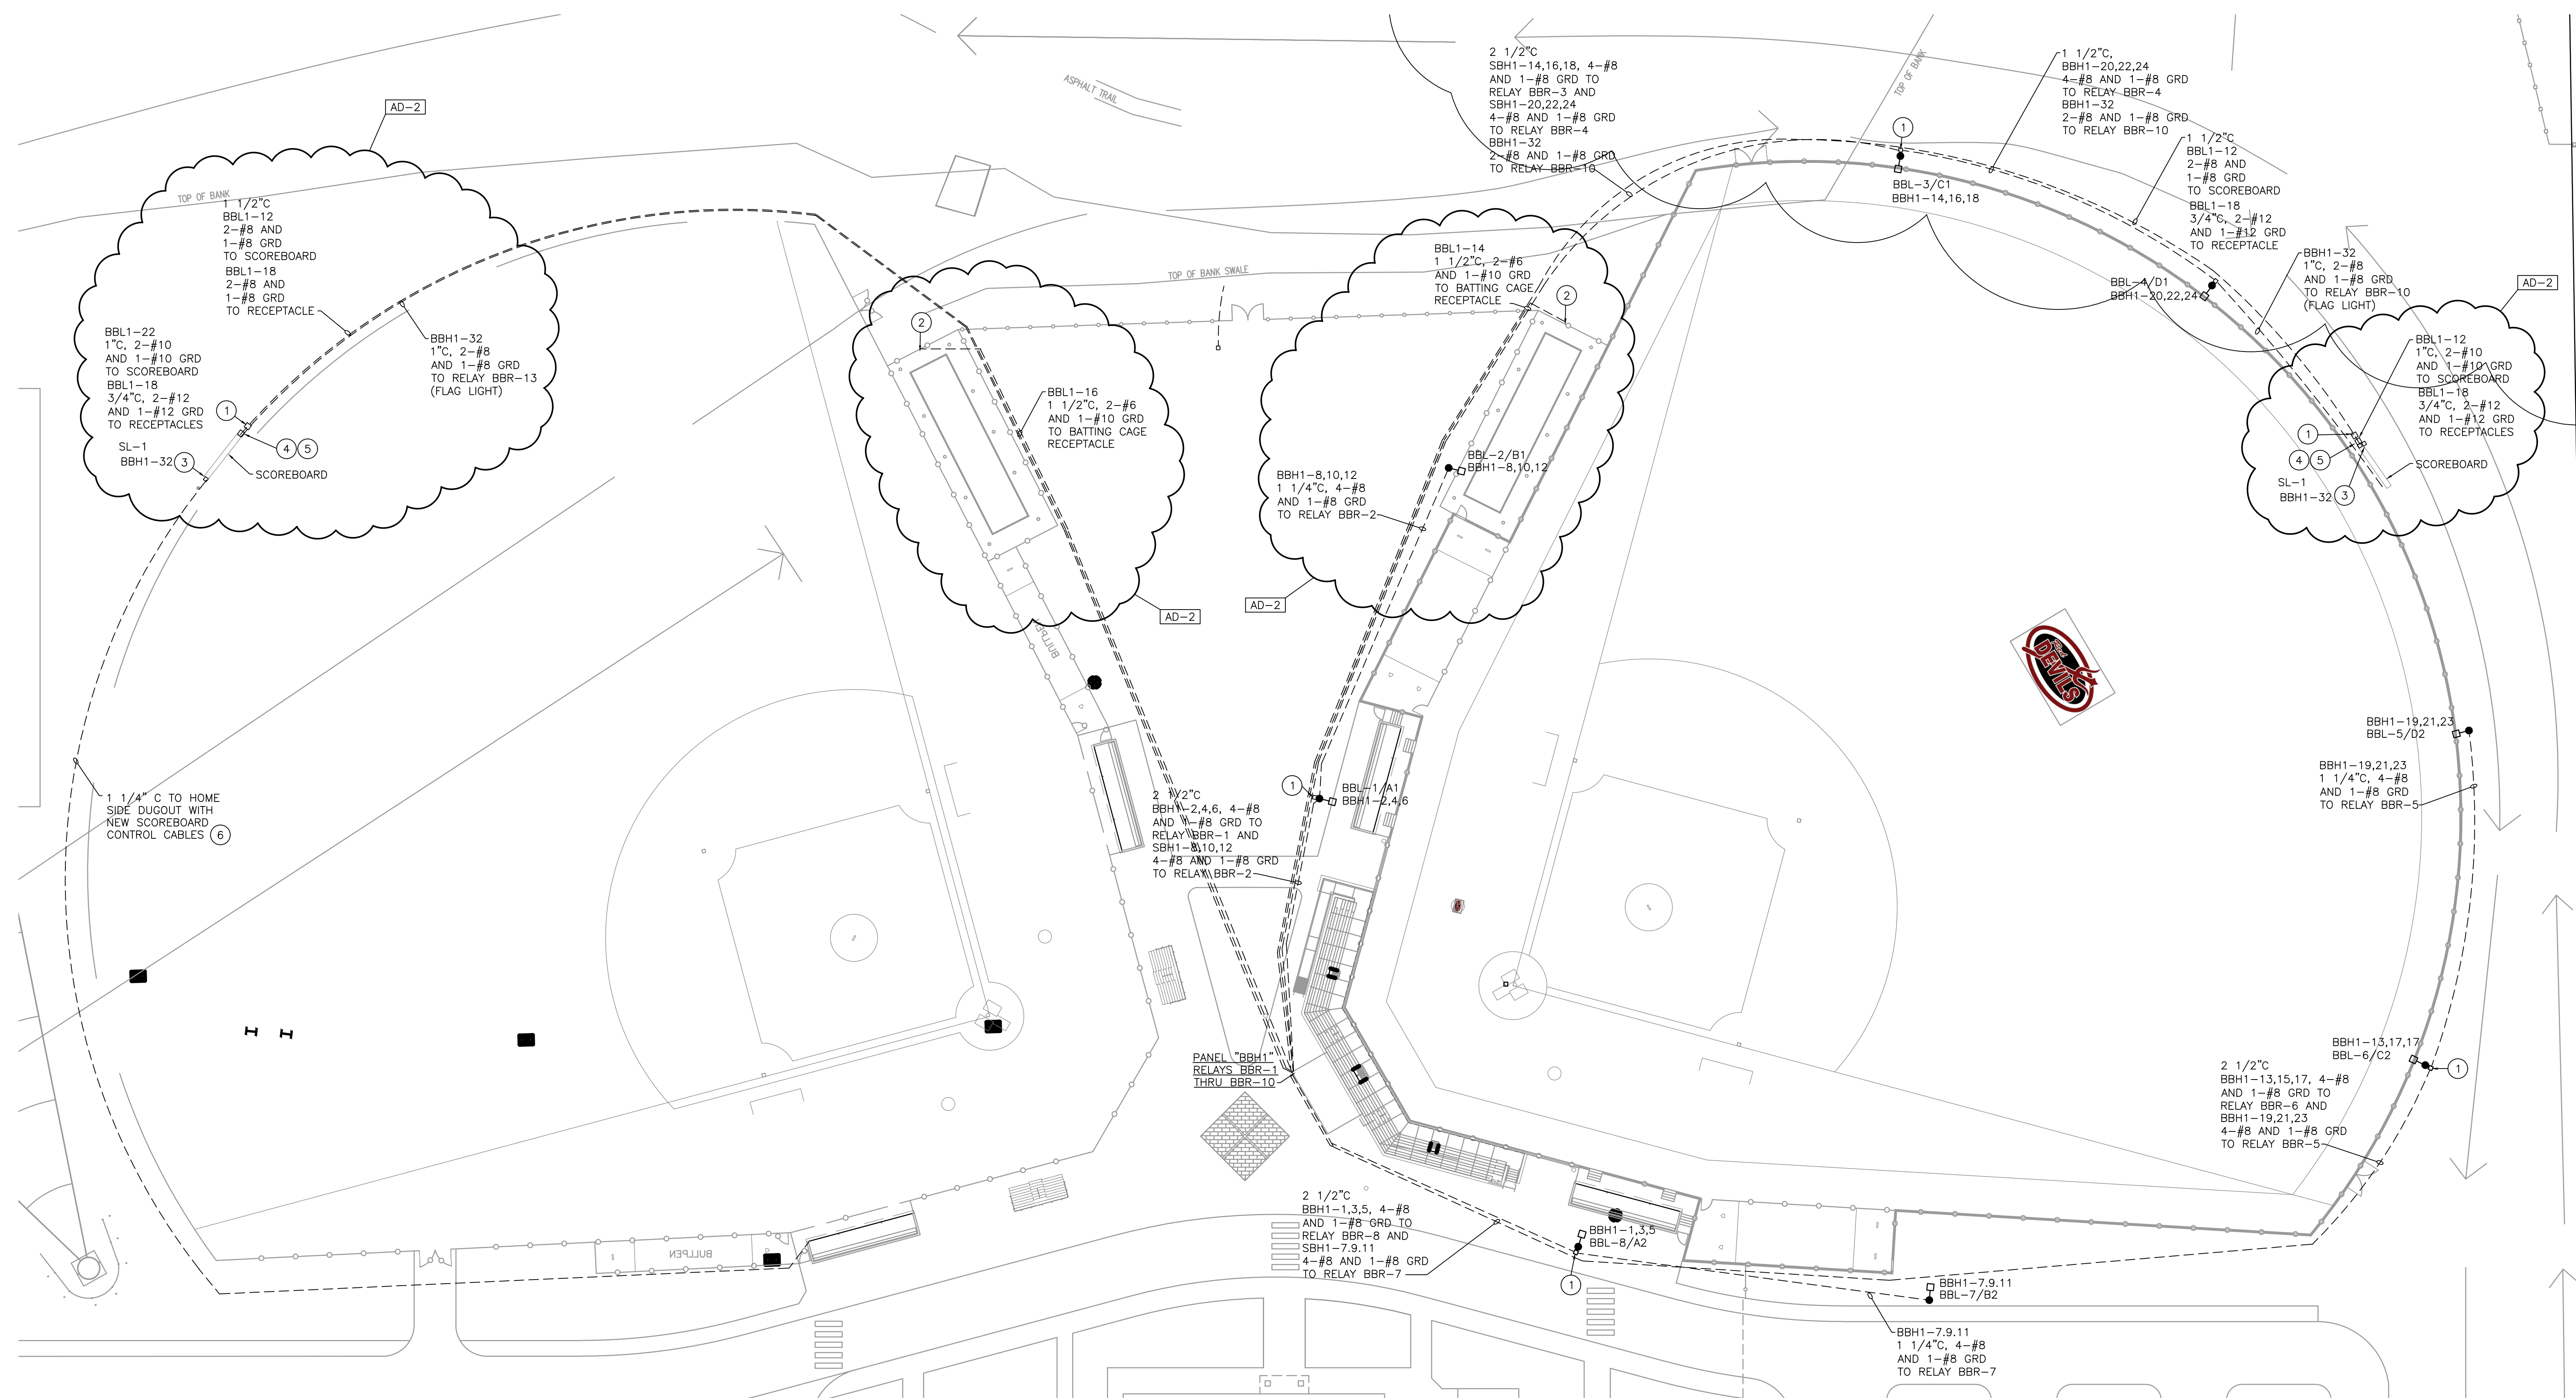

SCALE: 1" = 30'-0"

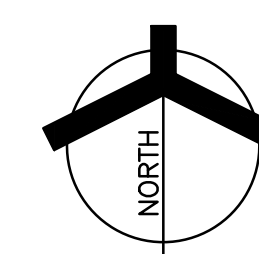

Thursday, 8/31/2023 - 3:00 PM - LAST SAVED BY: JCHAMBERS
X:\23-112 TRI-CREEK SC - LOWELL HS SITE
IMPROVEMENTS\2X-XXX DRAWINGS\09 ELEC\ES104.DWG

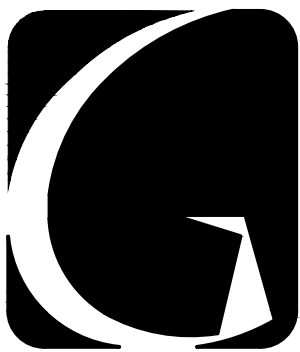

GIBALTAR
DESIGN
ARCHITECTURE • ENGINEERING • INTERIOR DESIGN


PROJECT
**LOWELL HIGH
SCHOOL SITE,
BLEACHERS, &
TURF/DRAINAGE**
TRI-CREEK SCHOOL CORPORATION

SITE PLAN NOTES - GENERAL

1. ALL WORK SHOWN ON THIS SHEET IS NEW AND BY THE ELECTRICAL TRADES, UNLESS OTHERWISE INDICATED.
2. COORDINATE LOCATIONS OF UNDERGROUND CONDUITS, HANDHOLES AND MANHOLES WITH OTHER SITE UTILITIES, UNDERGROUND DRAINS, SERVICES, STRUCTURES AND FINAL GRADING.
3. NOT ALL UTILITIES HAVE BEEN SHOWN. VERIFY LOCATIONS AND ROUTING OF ALL NEW AND EXISTING UTILITIES PRIOR TO ANY NEW WORK.
4. FOR ADDITIONAL GENERAL ELECTRICAL NOTES, SEE GENERAL ELECTRICAL PROJECT NOTES ON SHEET E-001.
5. SEE E-600 SHEETS FOR ELECTRICAL DETAILS AND SCHEDULES.
6. SEE E-700 SHEETS FOR ELECTRICAL DISTRIBUTION DIAGRAMS.
7. COORDINATE EXACT SPORT LIGHTING POLE LOCATIONS WITH SPORTS LIGHTING CONTRACTOR, CONSTRUCTION MANAGER AND ALL UNDERGROUND UTILITIES PRIOR TO ROUGHING-IN. SEE CIVIL DRAWINGS.


ELECTRICAL SITE PLAN NOTES:
(THESE NOTES APPLY TO THIS SHEET ONLY)

- 1 FLUSH IN-GROUND JUNCTION BOX.
- 2 PEDOC (1P18HT SERIES)18" HIGH PEDESTAL WITH BASE, HINGED TOP (WEATHERPROOF-IN-USE) AND WEATHERPROOF 20 AMP GFI TYPE RECEPTACLE. VERIFY EXACT LOCATION WITH OWNER, ARCHITECT AND CONSTRUCTION MANAGER PRIOR TO ROUGHING-IN.
- 3 TYPE SL-1 LIGHTING FIXTURE MOUNTED ON TOP OF SCOREBOARD FRAME TO ILLUMINATE THE FLAG.
- 4 PROVIDE A 3P-30 AMP WEATHERPROOF DISCONNECT AND CONNECT CIRCUIT INDICATED TO THE SCOREBOARD.
- 5 PROVIDE A GFI TYPE DUPLEX RECEPTACLE WITH "WEATHERPROOF-IN-USE" COVER AT THE BASE OF THE FOOTBALL SCOREBOARD AND CONNECT TO CIRCUIT INDICATED.
- 6 FLUSH IN-GROUND PULL BOX.
- 7 1 1/4" C WITH SCOREBOARD CONTROL CABLES ROUTED TO HOME TEAM DUGOUT. VERIFY WITH SCOREBOARD MANUFACTURER AND OWNER THE TYPE OF CABLE AND ELECTRICAL REQUIREMENTS REQUIRED BEFORE ROUGHING-IN.

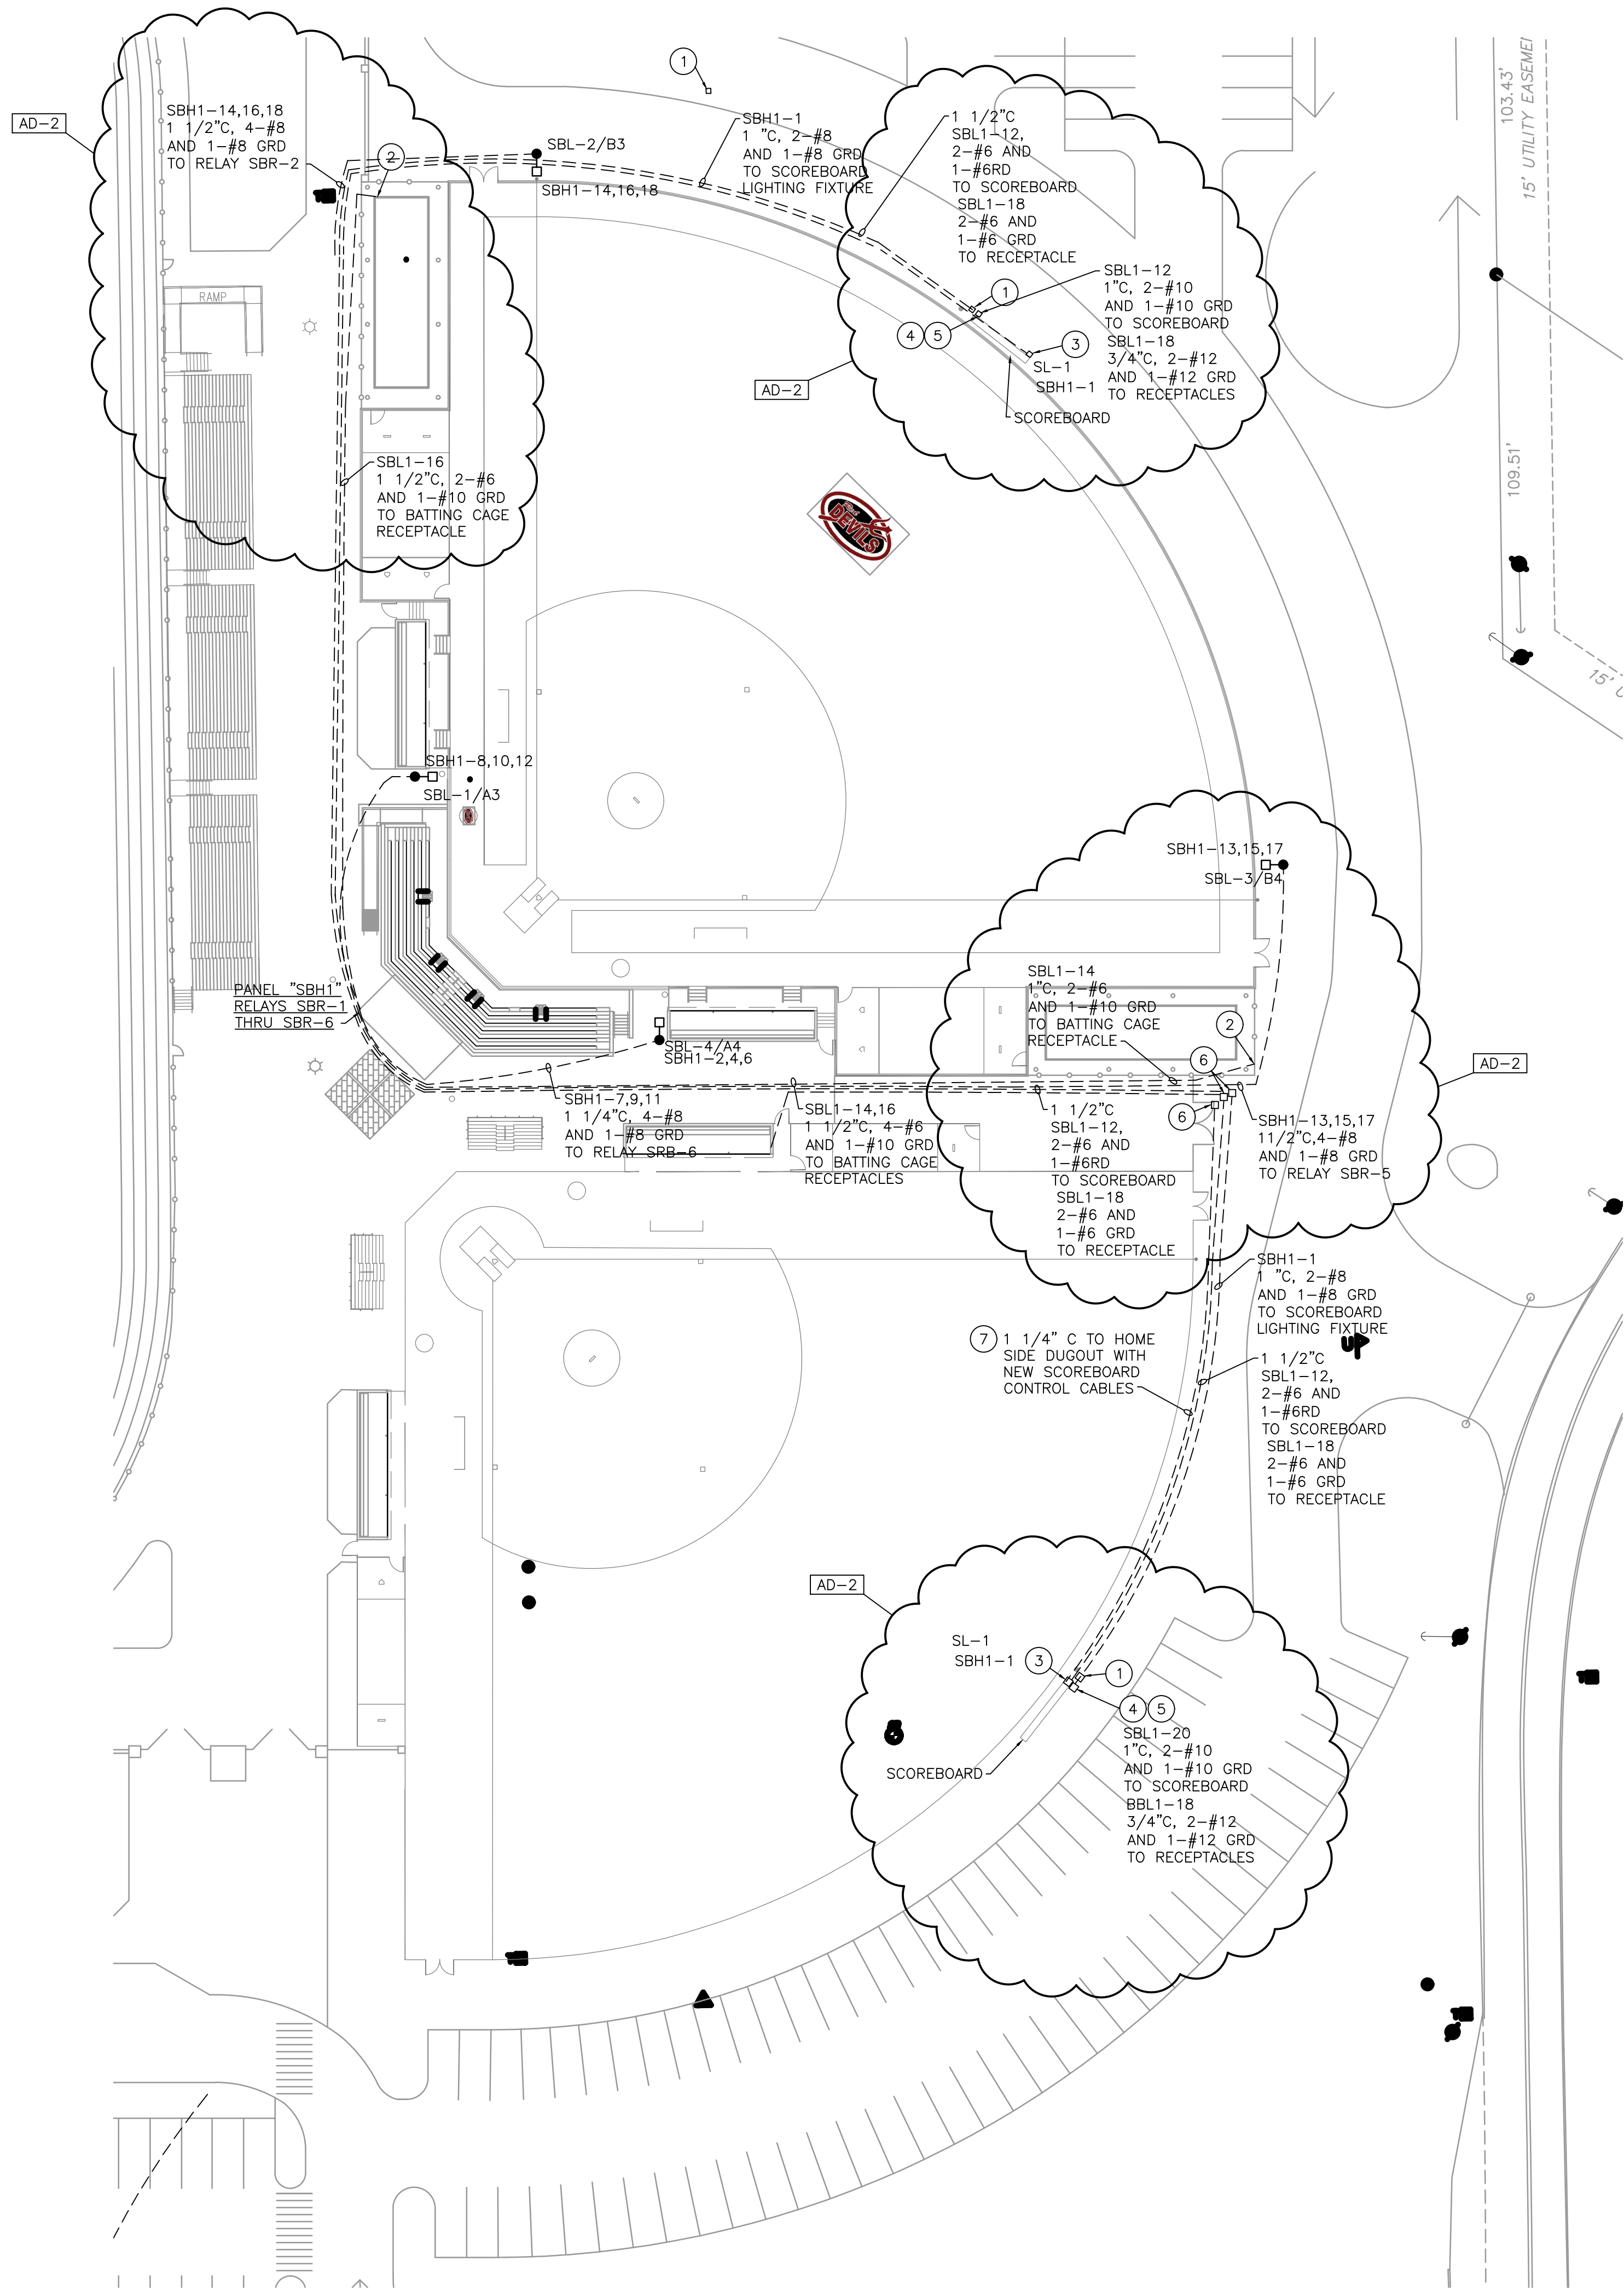


ENLARGED ELECTRICAL PLAN OF SOFTBALL FIELDS

SCALE: 1" = 30'-0"

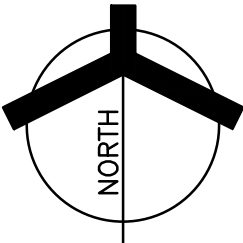

GIBALTAR DESIGN
9102 N. Meridian St., Ste. 300
Indianapolis, IN 46260
Homepage: www.GibraltarDesign.com
Email: info@GibraltarDesign.com
Phone: 317.580.5777 Fax: 317.580.5778

PROJECT
23-112
DATE
08/04/23
COORDINATED BY
PCB
DRAWN BY
PCB JVC
CHECKED BY
JPB

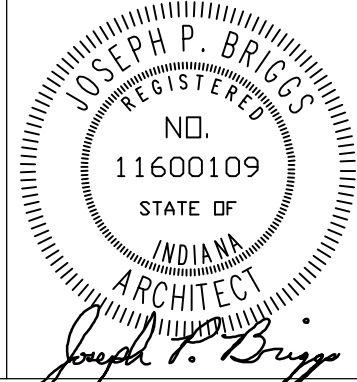


COPYRIGHT NOTICE:
THE CONCEPTS, DESIGNS, PLANS, DETAILS, ETC., SHOWN ON THIS DOCUMENT ARE THE PROPERTY OF GIBALTAR DESIGN AND WERE CREATED FOR USE ON THIS SPECIFIC PROJECT. NONE OF THIS INFORMATION SHALL BE USED BY ANY PERSON OR FIRM FOR ANY PURPOSE WITHOUT THE EXPRESS WRITTEN CONSENT OF GIBALTAR DESIGN. THE OWNER MAY RETAIN COPIES FOR INFORMATION AND REFERENCE IN CONNECTION ONLY WITH THIS PROJECT.

REVISIONS		
MARK	DATE	ISSUED FOR
AD-2	08/31/23	ADDENDUM NO. 2

DRAWING
**ENLARGED ELECTRICAL
PLAN OF SOFTBALL FIELDS**

PROJECT
**LOWELL HIGH SCHOOL - SITE AND
STADIUM IMPROVEMENTS**

© GIBALTAR DESIGN SHEET
ES105

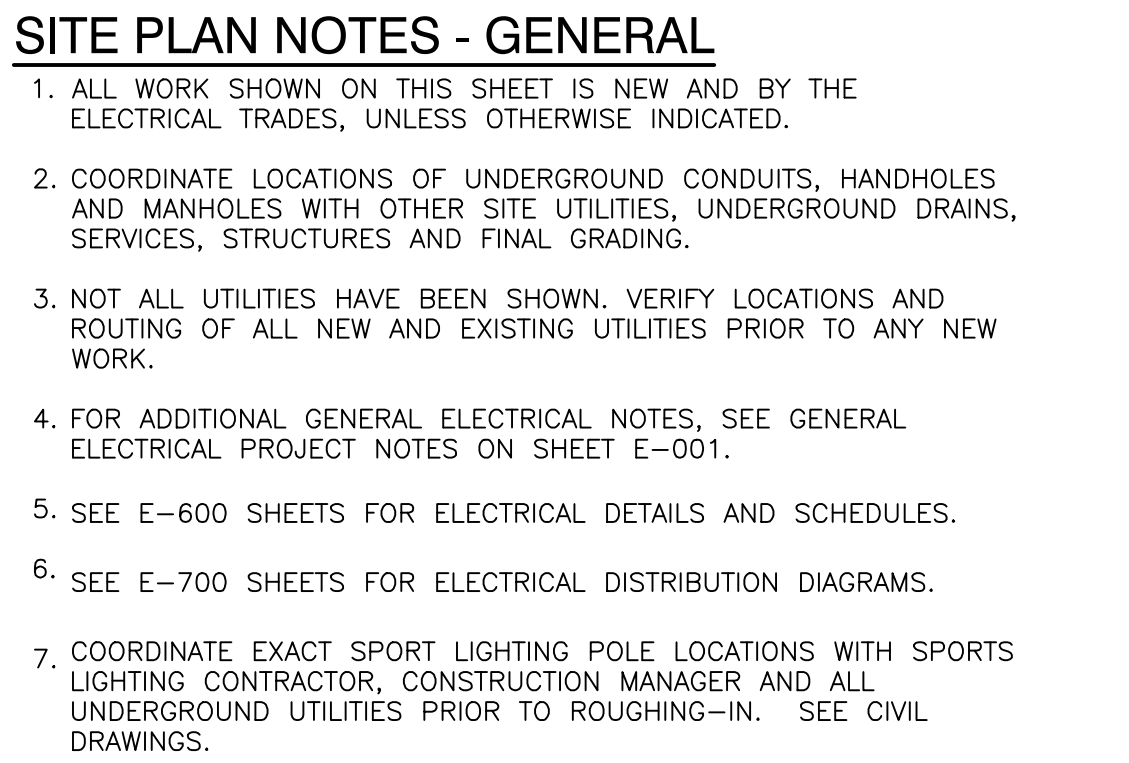

- ① RELOCATED SOCCER FIELD LIGHTING POLE WITH NEW LIGHTING FIXTURES, CROSS ARMS, WIRING AND POLES. PROVIDE NEW CONCRETE BASES FOR THE RELOCATED SOCCER FIELD LIGHTING POLES. CONNECT NEW LIGHTING FIXTURES TO NEW CIRCUITS AND CONTROLS AS SHOWN.
- ② PROVIDE NEW PANELS "SF1H" AND "SF1L", TRANSFORMER AND SOCCER FIELD LIGHTING CONTROL RELAY CABINET "SFRC1".
- ③ FLUSH IN-GROUND JUNCTION BOX.
- ④ TYPE SL-1 LIGHTING FIXTURE MOUNTED ON TOP OF SCOREBOARD FRAME TO ILLUMINATE THE FLAG.
- ⑤ PROVIDE A 3P-30 AMP WEATHERPROOF DISCONNECT AND CONNECT CIRCUIT INDICATED TO THE SCOREBOARD.
- ⑥ PROVIDE A GFI TYPE DUPLEX RECEPTACLE WITH "WEATHERPROOF-IN-USE" COVER AT THE BASE OF THE FOOTBALL SCOREBOARD AND CONNECT TO CIRCUIT INDICATED.
- ⑦ VERIFY EXACT LOCATION WITH THE ARCHITECT AND CONSTRUCTION MANAGER PRIOR TO ROUGH-IN.



GIBALTAR
DESIGN
ARCHITECTURE • ENGINEERING • INTERIOR DESIGN


PROJECT

**LOWELL HIGH
SCHOOL SITE,
BLEACHERS, &
TURF/DRAINAGE**

TRI-CREEK SCHOOL CORPORATION

GIBALTAR DESIGN
9102 N. Meridian St., Ste. 300
Indianapolis, IN 46260
Homepage www.GibraltarDesign.com
Email info@GibraltarDesign.com
Phone 317.580.5777 Fax 317.580.5778

PROJECT
23-112
DATE
08/04/23
COORDINATED BY
PCB
DRAWN BY
PCB JVC
CHECKED BY
JPB



JOSEPH P. BRIGGS
REGISTERED
NO.
11600109
STATE OF
INDIANA
ARCHITECT

Joseph P. Briggs

THE CONCEPTS, DESIGNS, PLANS, DETAILS, ETC., SHOWN ON THIS DOCUMENT ARE THE PROPERTY OF GIBRALTAR DESIGN AND WERE CREATED FOR USE ON THIS SPECIFIC PROJECT. NONE OF THIS INFORMATION SHALL BE USED BY ANY PERSON OR FIRM FOR ANY PURPOSE WITHOUT THE EXPRESS WRITTEN CONSENT OF GIBRALTAR DESIGN. THE OWNER MAY RETAIN COPIES FOR INFORMATION AND REFERENCE IN CONNECTION ONLY WITH THIS PROJECT.


REVISIONS		
MARK	DATE	ISSUED FOR
AD-2	08/31/23	ADDENDUM NO. 2

DRAWING
ENLARGED ELECTRICAL
PLAN OF SOCCER FIELD

PROJECT
LOWELL HIGH SCHOOL - SITE AND
STADIUM IMPROVEMENTS


© GIBRALTAR DESIGN SHEET
ES106

ENLARGED ELECTRICAL PLAN OF SOCCER FIELD

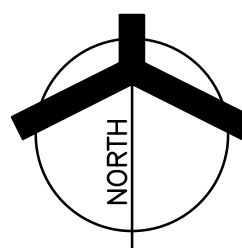


Thursday, 8/31/2023 - 3:01 PM - LAST SAVED BY: JCHAMBERS
Y:\23-112 TRI-CREEK SC - LOWELL HS SITE
IMPROVEMENTS\2X-XXX DRAWINGS\09 ELEC\ES106.DWG

Thursday, 8/31/2023 - 3:01 PM - LAST SAVED BY: CHAMBERS
Y:\23-112 TRI-CREEK SC - LOWELL HS SITE
IMPROVEMENTS\23-XXX DRAWINGS\09 ELEC\ES107.DWG

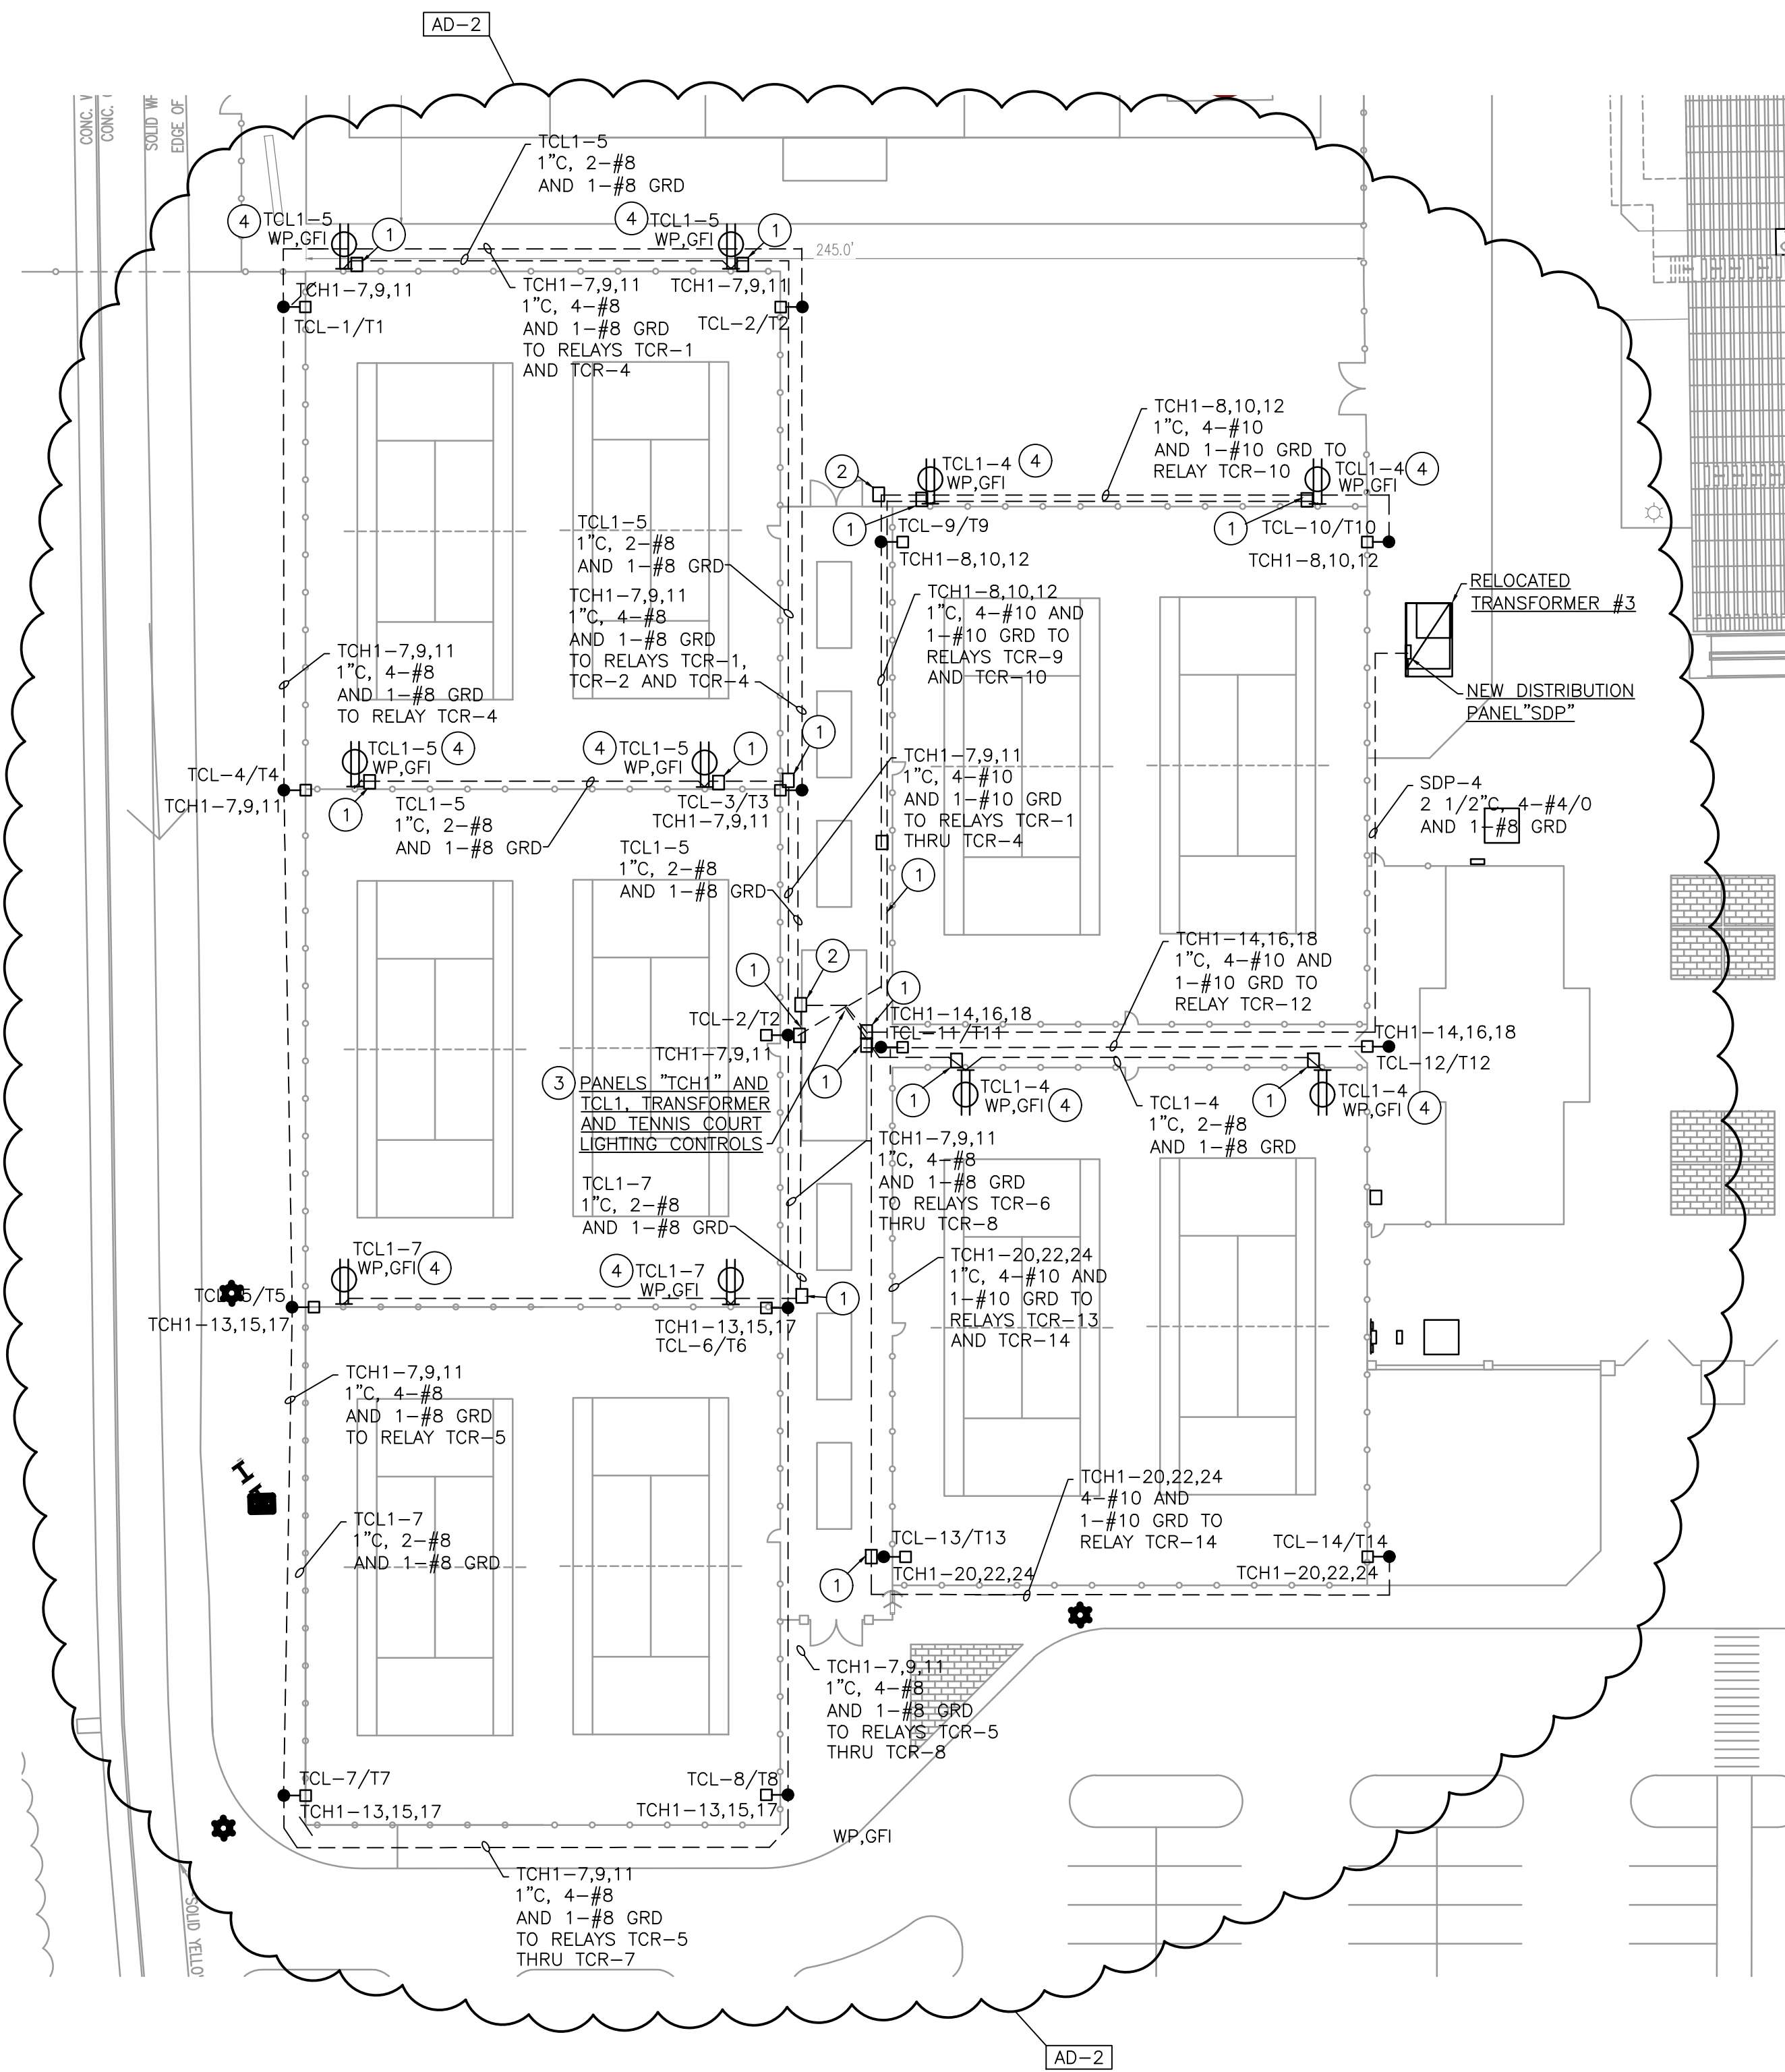

ENLARGED ELECTRICAL PLAN OF TENNIS COURTS

SCALE: 1" = 30'-0"

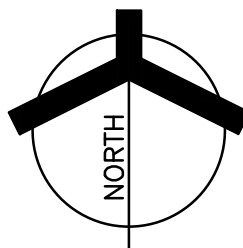

SITE PLAN NOTES - GENERAL

1. ALL WORK SHOWN ON THIS SHEET IS NEW AND BY THE ELECTRICAL TRADES, UNLESS OTHERWISE INDICATED.
2. RELOCATE OR REMOVE ANY OR ALL EXISTING SERVICES, POLES, ETC., AS MAY BE REQUIRED TO ACCOMMODATE NEW CONSTRUCTION, UNLESS OTHERWISE INDICATED.
3. COORDINATE WITH DUKE ENERGY AND ALL FEES AND OTHER COSTS NOT BORNE BY THE POWER COMPANY TO PROVIDE ADDITIONAL WORK THAT IS NOT SHOWN ON THE DRAWINGS OR ADDRESSED IN THE SPECIFICATIONS TO PROVIDE THE NEW INCOMING PRIMARY ELECTRICAL SERVICES NOTED WILL BE COVERED AN ALLOWANCE.
4. COORDINATE LOCATIONS OF UNDERGROUND CONDUITS, HANDHOLES AND MANHOLES WITH OTHER SITE UTILITIES, UNDERGROUND DRAINS, SERVICES, STRUCTURES AND FINAL GRADING.
5. NOT ALL UTILITIES HAVE BEEN SHOWN. VERIFY LOCATIONS AND ROUTING OF ALL NEW AND EXISTING UTILITIES PRIOR TO ANY NEW WORK.
6. FOR ADDITIONAL GENERAL ELECTRICAL NOTES, SEE GENERAL ELECTRICAL PROJECT NOTES ON SHEET E-001.
7. SEE E-600 SHEETS FOR ELECTRICAL DETAILS AND SCHEDULES.
8. SEE E-700 SHEETS FOR ELECTRICAL DISTRIBUTION DIAGRAMS.
9. COORDINATE EXACT SPORT LIGHTING POLE LOCATIONS WITH ARCHITECT AND UNDERGROUND UTILITIES. SEE CIVIL DRAWINGS.

ELECTRICAL SITE PLAN NOTES:
(THESE NOTES APPLY TO THIS SHEET ONLY)

- 1 FLUSH IN-GROUND JUNCTION BOX.
- 2 FLUSH IN-GROUND PULL BOX.
- 3 PROVIDE THE APPROPRIATE GALVANIZED STRUCTURAL STEEL CHANNEL SUPPORTS FOR THE ELECTRICAL PANELS, DISCONNECTS, TRANSFORMERS, LIGHTING RELAY PANELS, TIMECLOCKS, ETC.
- 4 VERIFY EXACT LOCATION OF RECEPTACLES FOR THE BALL MACHINES WITH THE OWNER AND CONSTRUCTION MANAGER PRIOR TO ROUGHING-IN.



GIBRALTAR
DESIGN
ARCHITECTURE • ENGINEERING • INTERIOR DESIGN

PROJECT

**LOWELL HIGH
SCHOOL SITE,
BLEACHERS, &
TURF/DRAINAGE**

TRI-CREEK SCHOOL CORPORATION

GIBRALTAR DESIGN

9102 N. Meridian St., Ste. 300
Indianapolis, IN 46260
Homepage www.GibraltarDesign.com
Email info@GibraltarDesign.com
Phone 317.580.5777 Fax 317.580.5778

PROJECT

23-112

DATE

08/04/23

COORDINATED BY

PCB

DRAWN BY

PCB JVC

CHECKED BY

JPB

COPYRIGHT NOTICE:
THE CONCEPTS, DESIGNS, PLANS, DETAILS, ETC., SHOWN ON THIS DOCUMENT ARE THE PROPERTY OF GIBRALTAR DESIGN AND WERE CREATED FOR USE ON THIS SPECIFIC PROJECT. NONE OF THIS INFORMATION SHALL BE USED BY ANY PERSON OR FIRM FOR ANY PURPOSE WITHOUT THE EXPRESS WRITTEN CONSENT OF GIBRALTAR DESIGN. THE OWNER MAY RETAIN COPIES FOR INFORMATION AND REFERENCE IN CONNECTION ONLY WITH THIS PROJECT.

REVISIONS

MARK	DATE	ISSUED FOR
AD-2	08/31/23	ADDENDUM NO. 2

DRAWING

**ENLARGED ELECTRICAL
PLAN OF TENNIS COURTS**


PROJECT

**LOWELL HIGH SCHOOL - SITE AND
STADIUM IMPROVEMENTS**

© GIBRALTAR DESIGN

SHEET

ES107

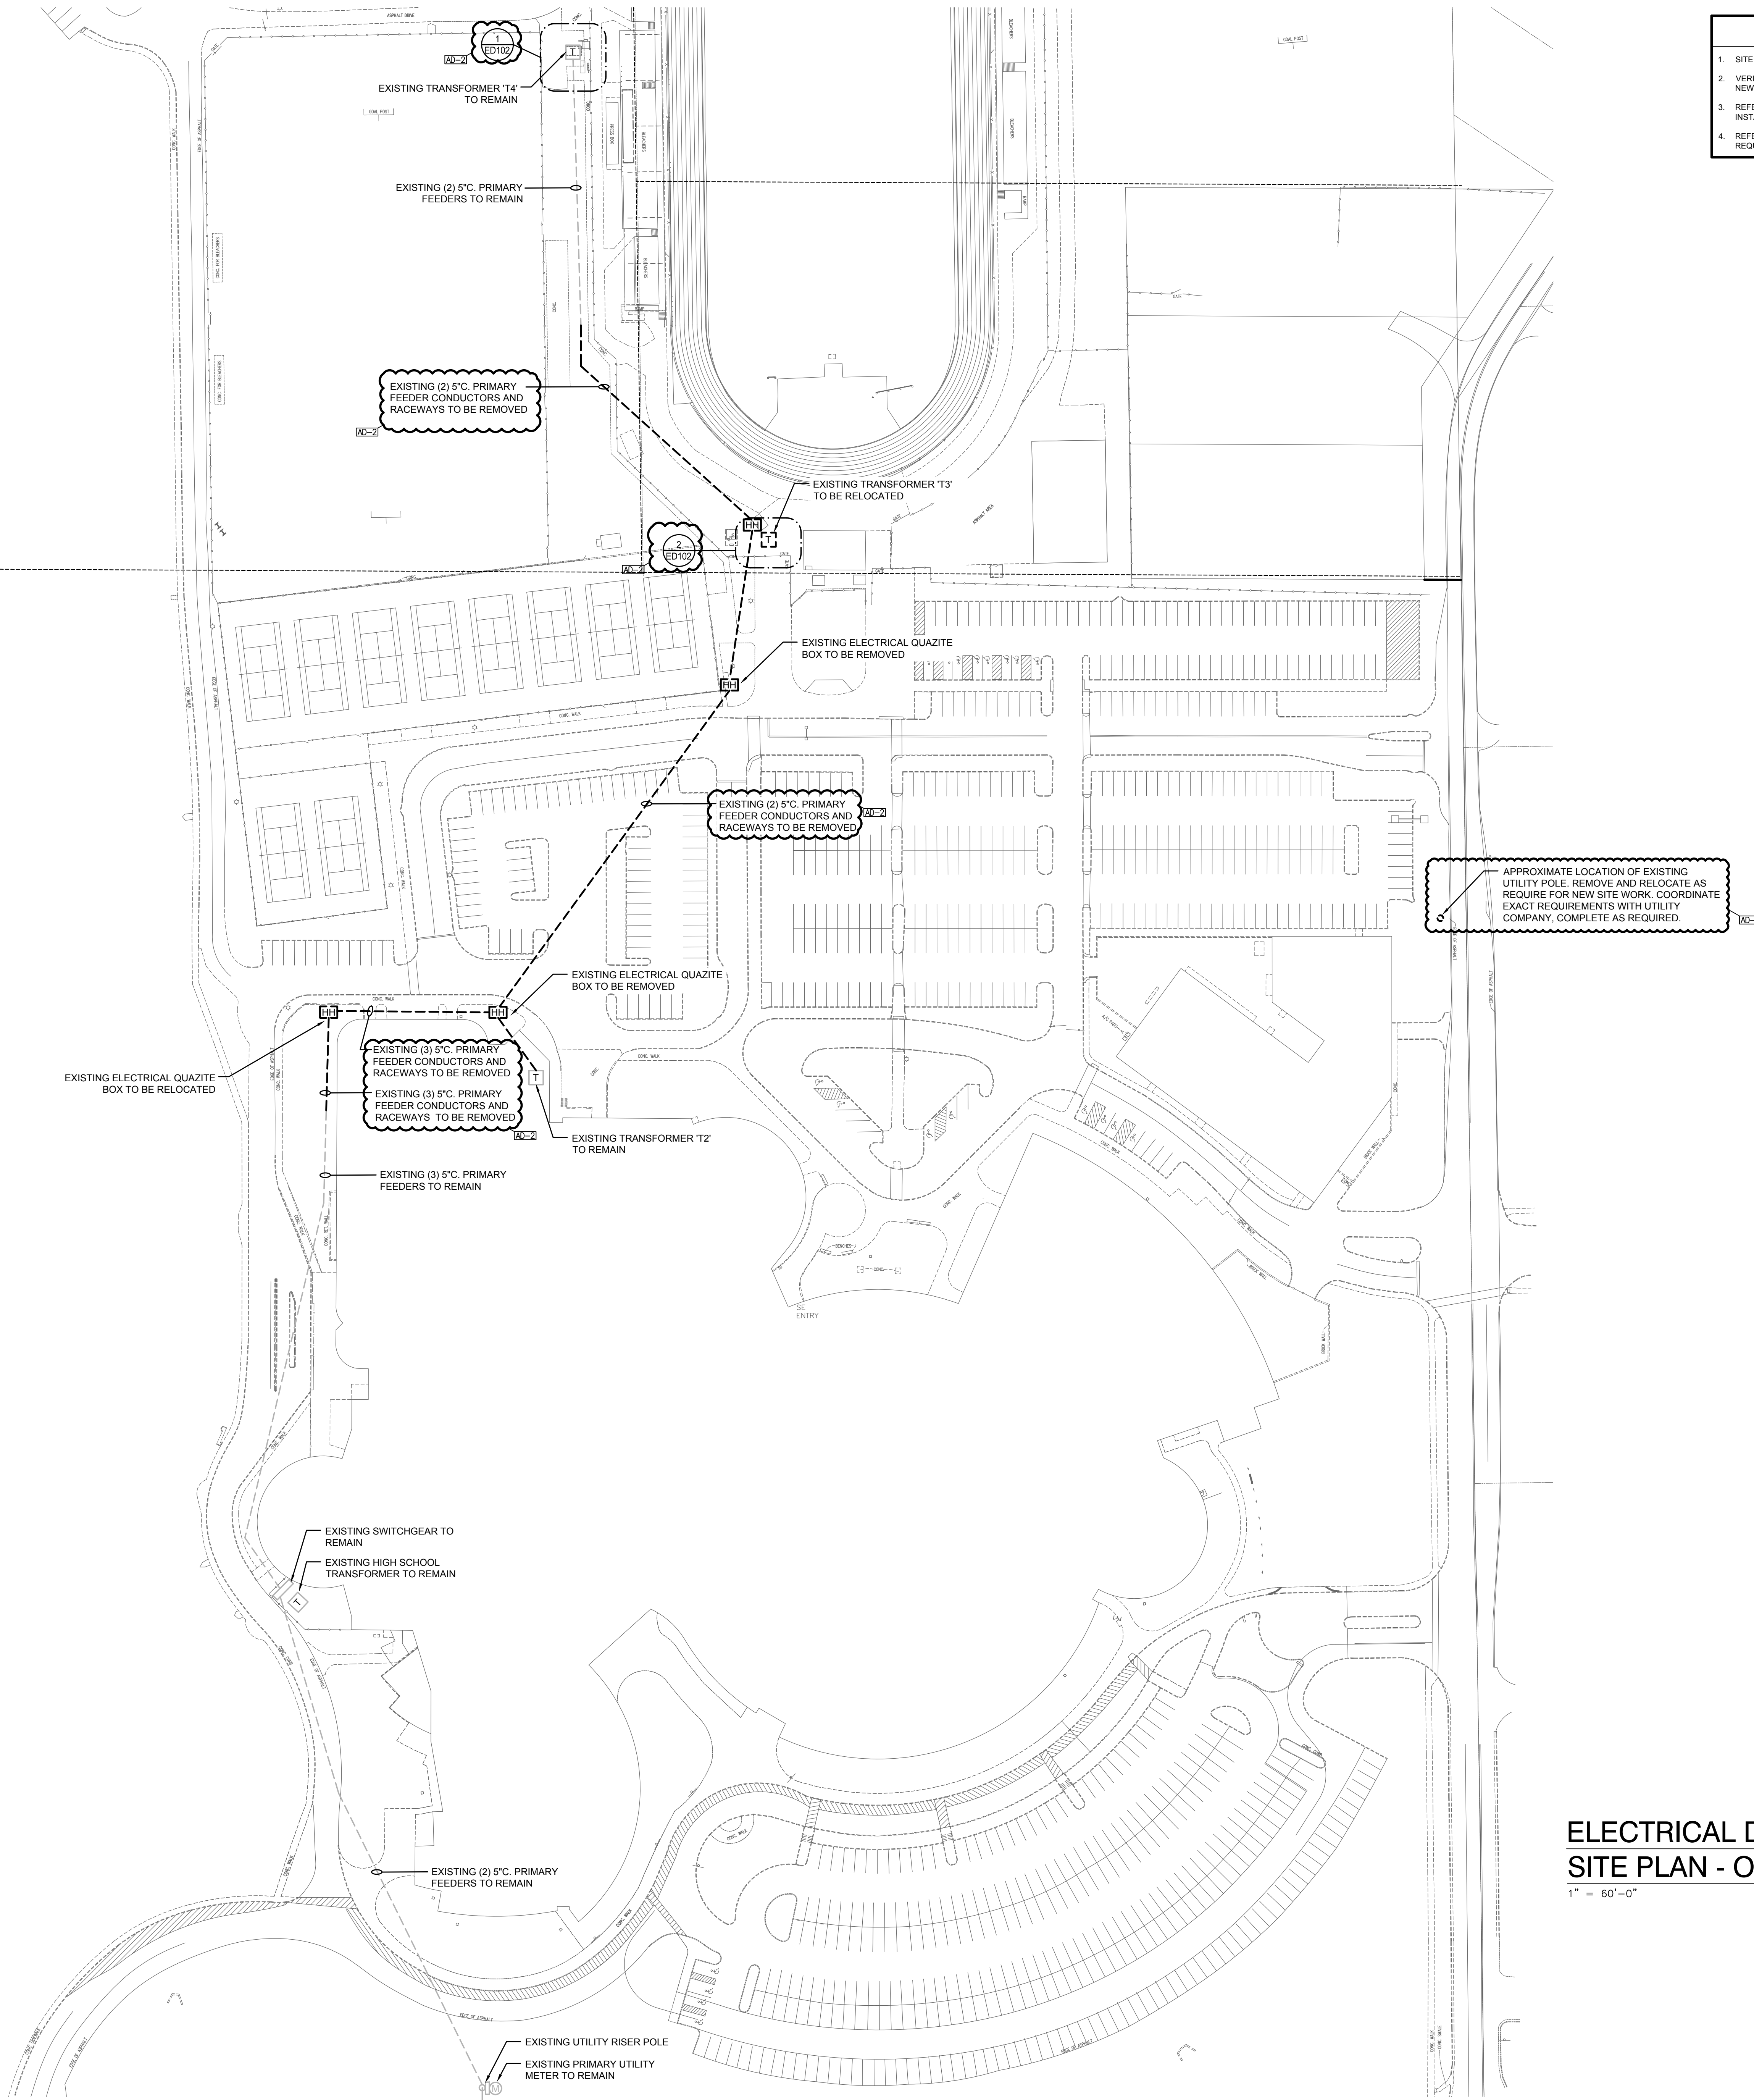

- GENERAL NOTES**
1. SITE SHALL BE PROVIDED WITH HANDHOLES AS REQUIRED.
 2. VERIFY NEW AND EXISTING SITE CONDITIONS IN FIELD, AND WITH NEW SITE PLANS, MODIFY CONDUIT ROUTING AS REQUIRED.
 3. REFER TO TRENCH DETAIL FOR UNDERGROUND CONDUIT INSTALLATION REQUIREMENTS.
 4. REFER TO TECHNOLOGY PLANS FOR ADDITIONAL RACEWAY REQUIREMENTS.




GIBRALTAR
DESIGN
ARCHITECTURE • ENGINEERING • INTERIOR DESIGN



PROJECT
LOWELL HIGH SCHOOL SITE, BLEACHERS, & TURF/DRAINAGE
TRI-CREEK SCHOOL CORPORATION

GIBRALTAR DESIGN
9102 N. Meridian St., Ste. 300
Indianapolis, IN 46260
Homepage: www.GibraltarDesign.com
Email: info@GibraltarDesign.com
Phone: 317.580.5777 Fax: 317.580.5778

PROJECT: 23-112
DATE: 08/04/23
COORDINATED BY: DJ
DRAWN BY: JC, AG
CHECKED BY: SM

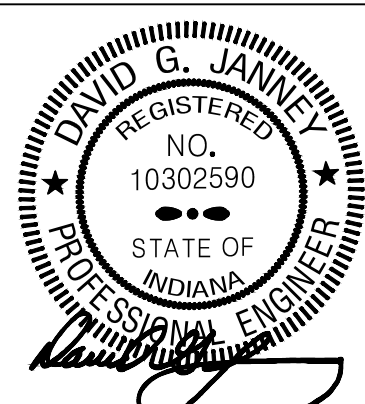


COPYRIGHT NOTICE:
THE CONCEPTS, DESIGNS, PLANS, DETAILS, ETC., SHOWN ON THIS DOCUMENT ARE THE PROPERTY OF GIBRALTAR DESIGN AND WERE CREATED FOR USE ON THIS SPECIFIC PROJECT. NONE OF THIS INFORMATION SHALL BE USED BY ANY PERSON OR FIRM FOR ANY PURPOSE WITHOUT THE EXPRESS WRITTEN CONSENT OF GIBRALTAR DESIGN. THE OWNER MAY RETAIN COPIES FOR INFORMATION AND REFERENCE IN CONNECTION ONLY WITH THIS PROJECT.

REVISIONS		
MARK	DATE	ISSUED FOR
AD-1	08/18/23	ADDENDUM NO. 01
AD-2	08/31/23	ADDENDUM NO. 02

**ELECTRICAL DEMOLITION
SITE PLAN - OVERALL**



1" = 60'-0"

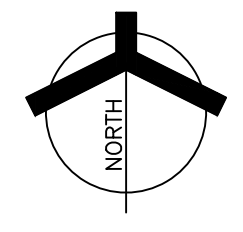

DRAWING
**ELECTRICAL DEMOLITION
SITE PLAN - OVERALL**

PROJECT
**LOWELL HIGH SCHOOL SITE,
BLEACHERS, & TURF/DRAINAGE**

© GIBRALTAR DESIGN SHEET
ES108

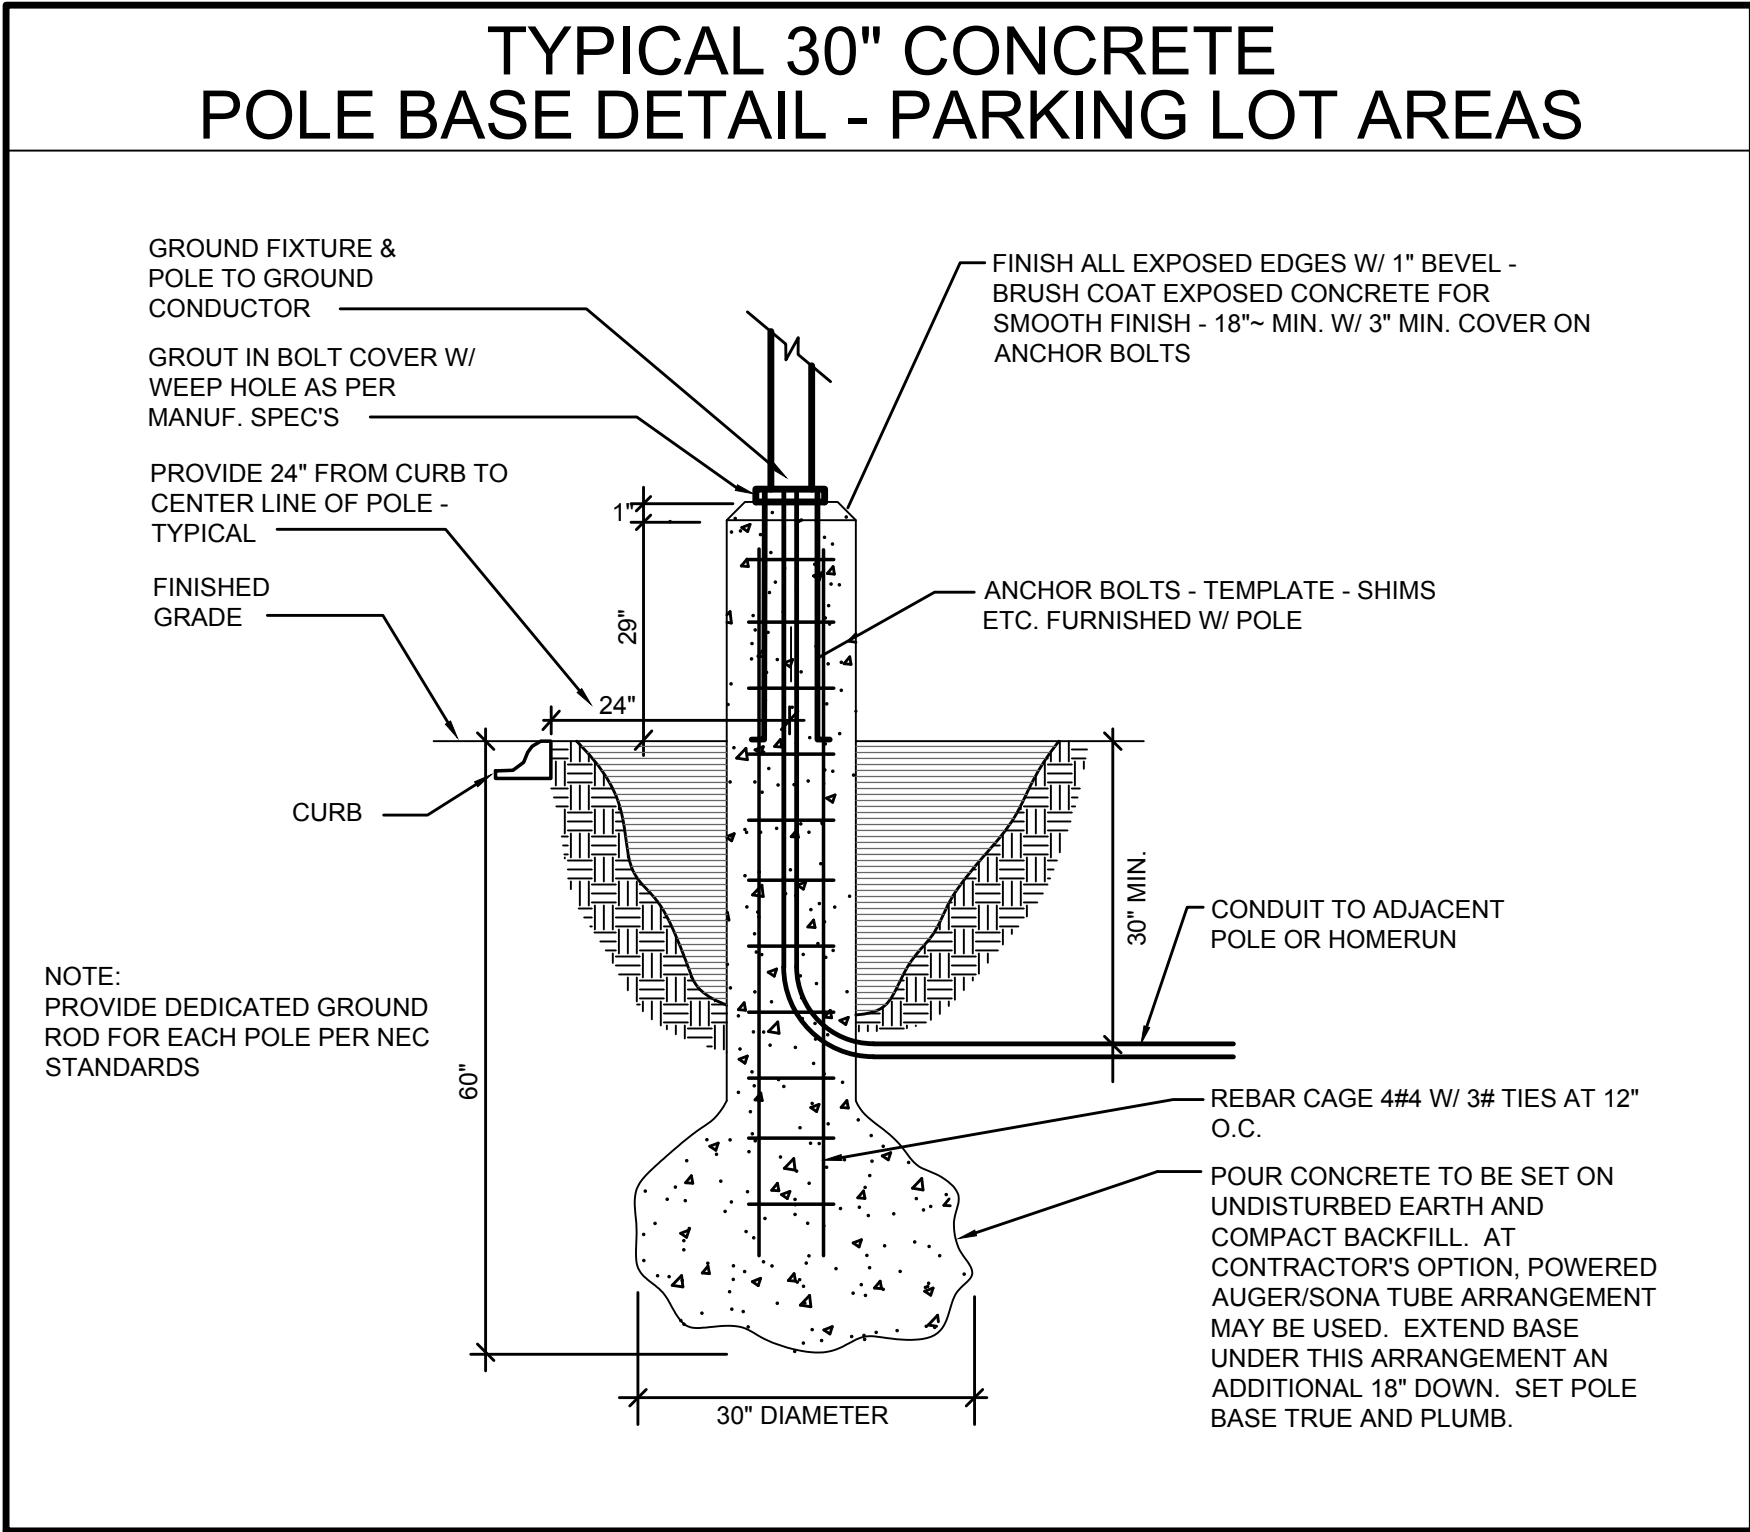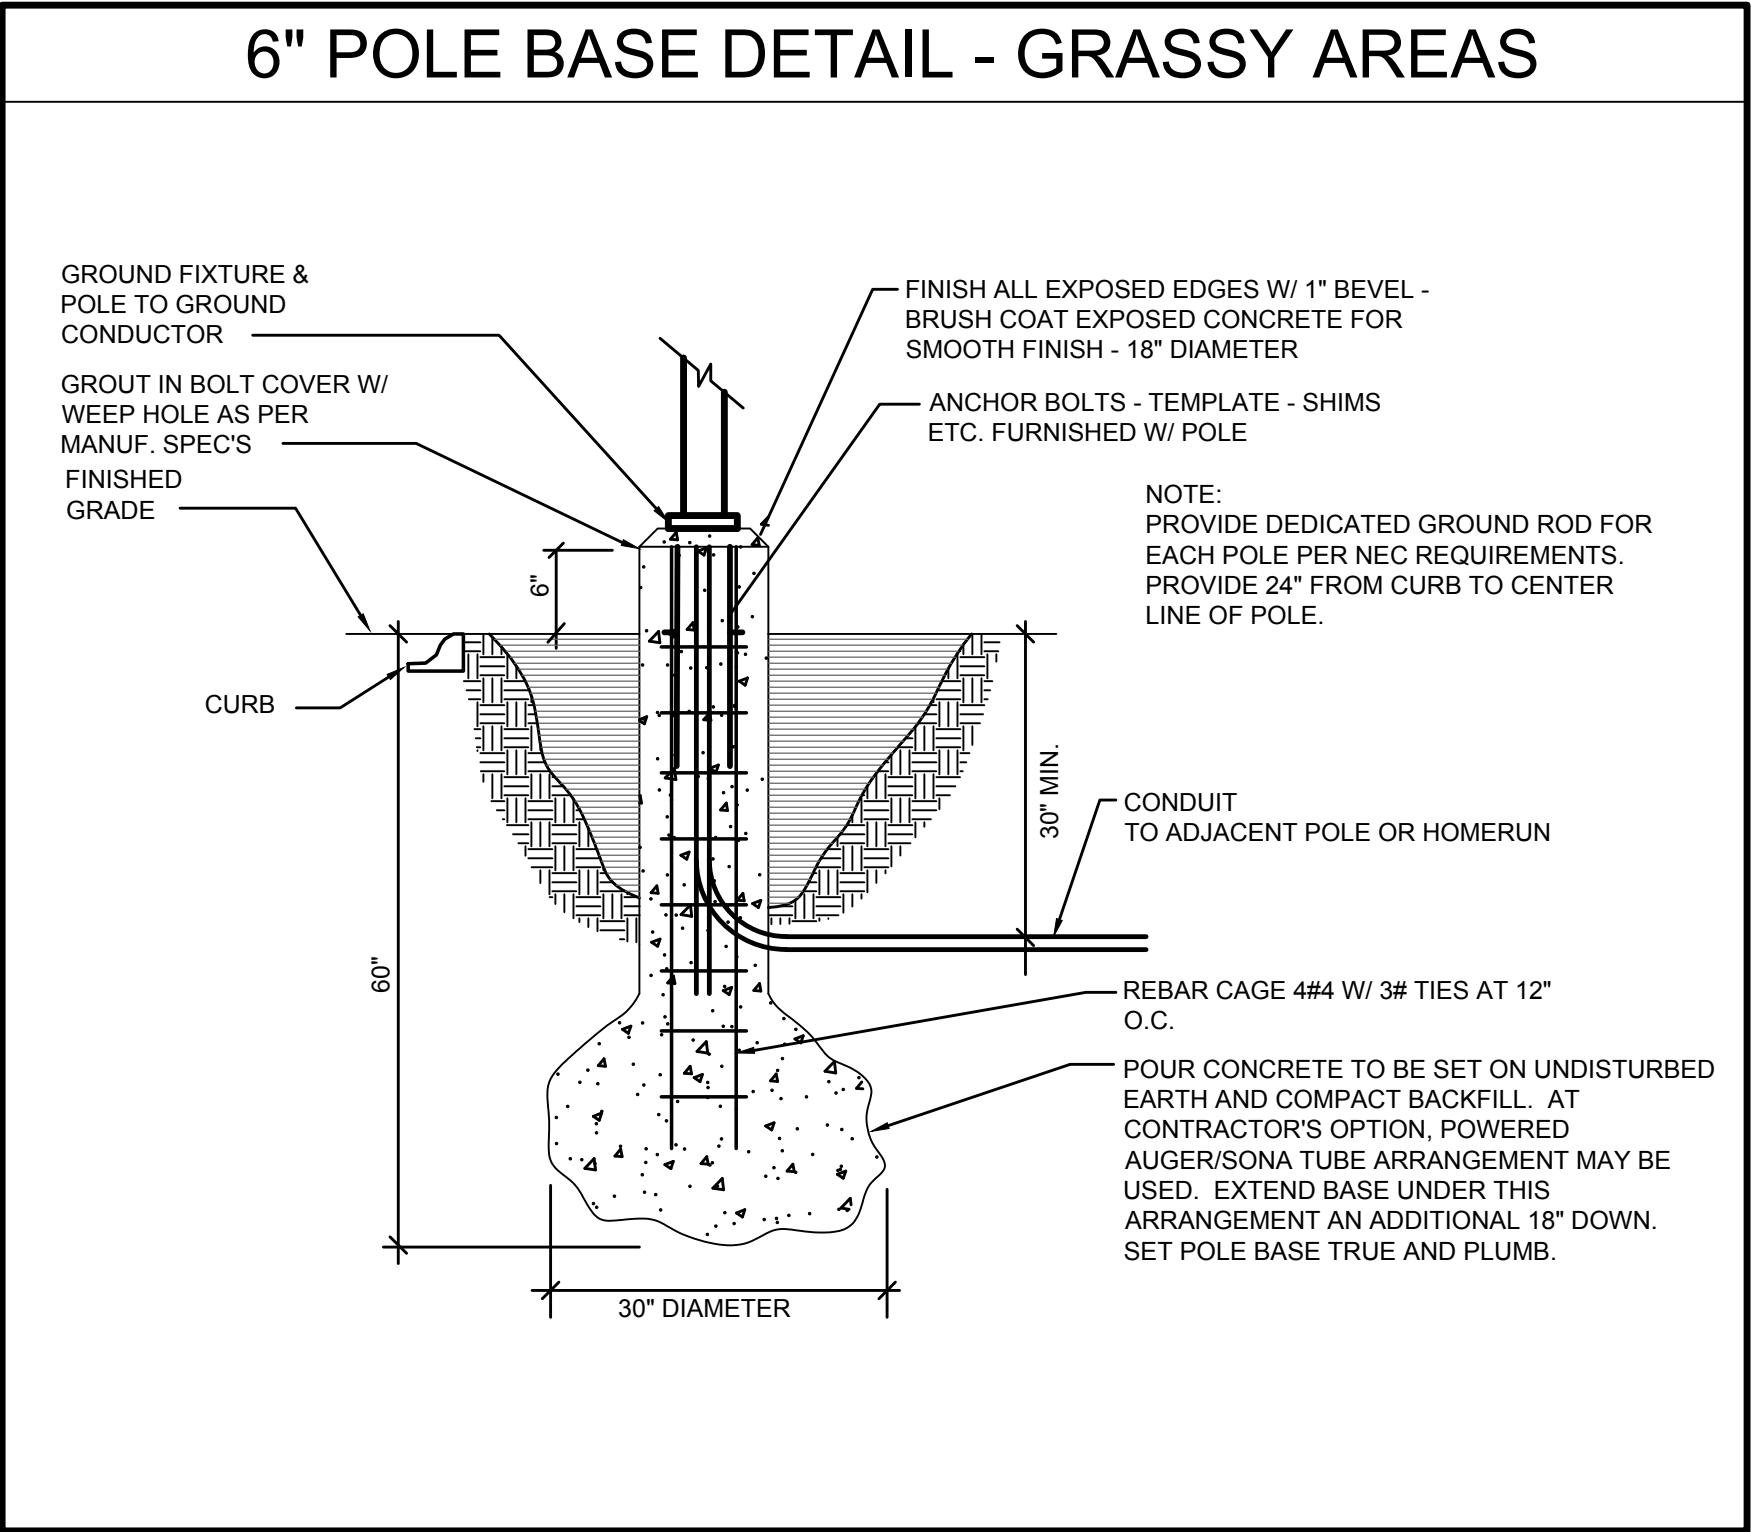


EXTERIOR LIGHTING LUMINAIRE SCHEDULE


TAG	SYMBOL	DESCRIPTION	MANUFACTURER SERIES OR CATALOG NUMBER	VOLTAGE/ BALANCE	LAMPS/CROSS SECTION	MOUNTING	REMARKS
EA		EXTERIOR LED DUAL-HEAD FIXTURE MOUNTED ON A ROUND, TAPERED STEEL POLE	LITHONIA #DSX2 LED P6 40K 80CRI T3M XVOLT XXX MCGRAW-EDISON #GALN SERIES HUBBELL #VP-2 SERIES GARDCO #P34 SERIES	480 VOLT	LED 4000K MIN 40000 LM MAX 341 W	POLE MTD 30'-0" AFG	-COORD. FINISH WITH ARCHITECT
EB		EXTERIOR LED FIXTURE MOUNTED ON A ROUND, TAPERED STEEL POLE	LITHONIA #DSX2 LED P6 40K 80CRI T3M XVOLT XXX MCGRAW-EDISON #GALN SERIES HUBBELL #VP-2 SERIES GARDCO #P34 SERIES	480 VOLT	LED 4000K MIN 22000 LM MAX 341 W	POLE MTD 30'-0" AFG	-COORD. FINISH WITH ARCHITECT
EC		EXTERIOR LED FIXTURE MOUNTED ON A STRAIGHT, ROUND STEEL POLE	LITHONIA #DSX0 LED P6 40K 80CRI T3M XVOLT MCGRAW-EDISON #GALN SERIES HUBBELL #VP-1 SERIES GARDCO #P26 SERIES	480 VOLT	LED 4000K MIN 15000 LM MAX 137 W	POLE MTD 25'-0" AFG	-COORD. FINISH WITH ARCHITECT
ED		EXTERIOR LED WALL MOUNTED SCONCE	LITHONIA #DSX0 LED P6 40K 80CRI T3M XVOLT MCGRAW-EDISON #GALN SERIES HUBBELL #VP-1 SERIES GARDCO #P26 SERIES	120/277 VOLT	LED 4000K MIN 900 LM MAX 10 W	WALL MTD 8'-0" AFG TO CENTER	-COORD. FINISH WITH ARCHITECT
EF		EXTERIOR SIGNAGE LED FLOOD FIXTURE	LITHONIA #DSXF1 LED P2 40K HMF MVOLT THK UBV XXX OR APPROVED EQUAL	120/277 VOLT	LED 4000K MIN 5000 LM MAX 42 W	IN-GRADE	-COORD. FINISH WITH ARCHITECT
EG		EXTERIOR LED DUAL-HEAD FIXTURE MOUNTED ON A ROUND, TAPERED STEEL POLE	LITHONIA #DSX0 LED P6 40K 80CRI T3M XVOLT XXX MCGRAW-EDISON #GALN SERIES HUBBELL #VP-2 SERIES GARDCO #P34 SERIES	480 VOLT	LED 4000K MIN 15000 LM MAX 137 W	POLE MTD 25'-0" AFG	-COORD. FINISH WITH ARCHITECT

- ### SHEET NOTES
- CIRCUIT NEW SITE LIGHTING TO PANEL INDICATED VIA NEW LIGHTING CONTROL RELAYS. COORDINATE EXACT REQUIREMENTS IN FIELD.
 - RECONNECT EXISTING SITE LIGHTING CIRCUITRY AS REQUIRED DUE TO DEMOLITION OF EXISTING SITE LIGHTING FIXTURES. VERIFY EXACT CONDITIONS IN FIELD.
 - NEW MOTORIZED GATE. PROVIDE 120V POWER CONNECTION AND CIRCUIT TO PANEL INDICATED VIA 2 #8 & 1 #10 GRD. - 3/4". PROVIDE ADDITIONAL 1" WITH PULL STRING TO COMMUNITY BUILDING IT CLOSET FOR ACCESS CONTROL WIRING BY OTHERS.

- ### GENERAL NOTES
- SITE LIGHTING CONDUCTORS SHALL BE #8 AWG MINIMUM AND SIZED TO MEET NEC VOLTAGE DROP REQUIREMENTS.
 - SITE SHALL BE PROVIDED WITH HANDHOLES AS REQUIRED.
 - VERIFY NEW AND EXISTING SITE CONDITIONS IN FIELD, AND WITH NEW SITE PLANS. MODIFY CONDUIT ROUTING AS REQUIRED.
 - REFER TO TRENCH DETAIL FOR UNDERGROUND CONDUIT INSTALLATION REQUIREMENTS.
 - REFER TO TECHNOLOGY PLANS FOR LOCATIONS OF POLE MOUNTED CAMERAS AND WIRELESS ACCESS EQUIPMENT. COORDINATE LOADING REQUIREMENTS WITH FINAL POLE SELECTION PRIOR TO ORDERING.

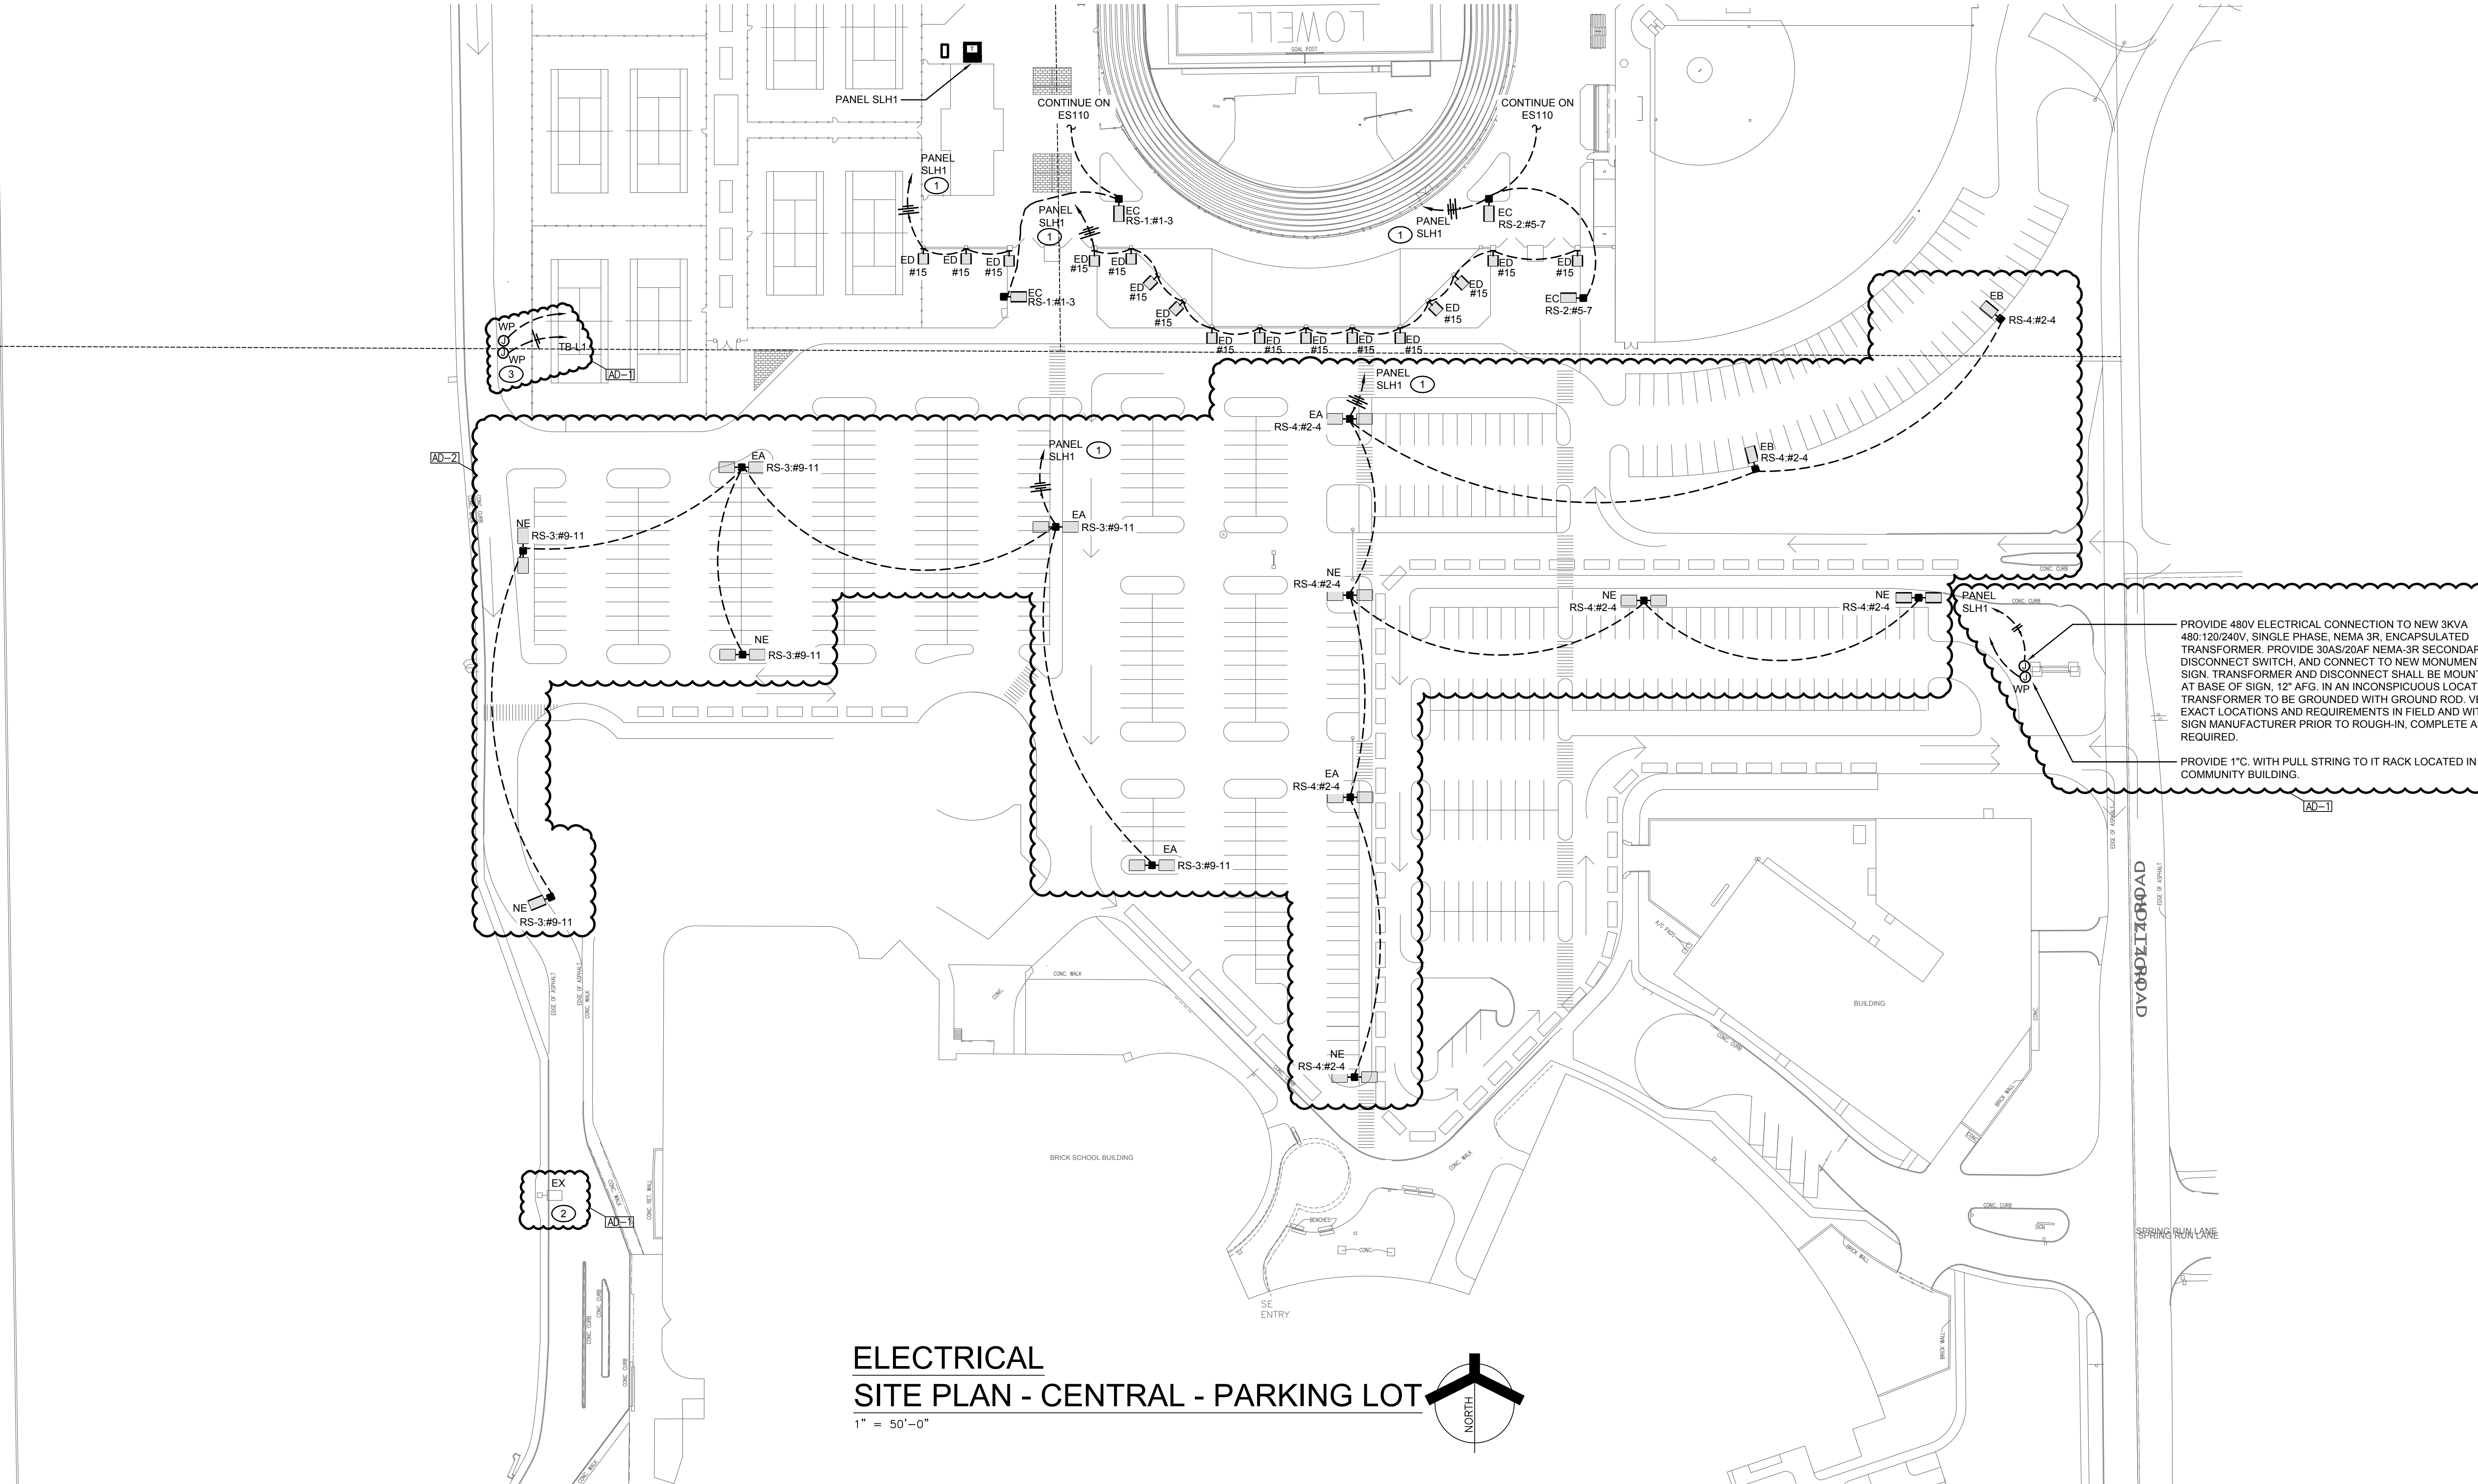

ELECTRICAL SITE PLAN - CENTRAL - PARKING LOT

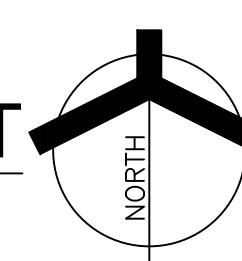

GIBRALTAR DESIGN
ARCHITECTURE • ENGINEERING • INTERIOR DESIGN

MILLIES
ENGINEERING GROUP
(219) 924-8400
www.milliesengineeringgroup.com

PROJECT
LOWELL HIGH SCHOOL SITE, BLEACHERS, & TURF/DRAINAGE
TRI-CREEK SCHOOL CORPORATION

GIBRALTAR DESIGN
9102 N. Meridian St., Ste. 300
Indianapolis, IN 46260
Homepage: www.GibraltarDesign.com
Email: info@GibraltarDesign.com
Phone: 317.580.5777 Fax: 317.580.5778

PROJECT
23-112
DATE
08/04/23
COORDINATED BY
DJ
DRAWN BY
JC, AG
CHECKED BY
SM

COPYRIGHT NOTICE:
THE CONCEPTS, DESIGNS, PLANS, DETAILS, ETC. SHOWN ON THIS DOCUMENT ARE THE PROPERTY OF GIBRALTAR DESIGN AND WERE CREATED FOR USE ON THIS SPECIFIC PROJECT. NONE OF THIS INFORMATION SHALL BE USED BY ANY PERSON OR FIRM FOR ANY PURPOSE WITHOUT THE EXPRESS WRITTEN CONSENT OF GIBRALTAR DESIGN. THE OWNER MAY RETAIN COPIES FOR INFORMATION AND REFERENCE IN CONNECTION ONLY WITH THIS PROJECT.

REVISIONS	MARK	DATE	ISSUED FOR
AD-1	08/18/23	ADDENDUM NO. 01	
AD-2	08/31/23	ADDENDUM NO. 02	

DRAWING
ELECTRICAL SITE PLAN - CENTER - PARKING LOT

PROJECT
LOWELL HIGH SCHOOL SITE, BLEACHERS, & TURF/DRAINAGE


© GIBRALTAR DESIGN SHEET
ES111

SHEET NOTES


- EXISTING SITE LIGHTING TO REMAIN. INTERCEPT EXISTING CIRCUITRY, AND EXTEND TO NEW BREAKER IN NEW PANEL SFH1.
- CIRCUIT NEW SITE LIGHTING TO PANEL INDICATED VIA NEW LIGHTING CONTROL RELAYS. COORDINATE EXACT REQUIREMENTS IN FIELD.
- NEW MOTORIZED GATE: PROVIDE 120V POWER CONNECTION AND CIRCUIT TO PANEL INDICATED VIA 2 #6 & 1 #10 GND. -3/4" PROVIDE ADDITIONAL 1" WITH PULL STRING TO NORTHSTAR BUILDING IT CLOSEST FOR ACCESS CONTROL WIRING BY OTHERS.

GENERAL NOTES

- SITE LIGHTING CONDUCTORS SHALL BE #8 AWG MINIMUM AND SIZED TO MEET NEC VOLTAGE DROP REQUIREMENTS.
- SITE SHALL BE PROVIDED WITH HANDHOLES AS REQUIRED.
- VERIFY NEW AND EXISTING SITE CONDITIONS IN FIELD, AND WITH NEW SITE PLANS. MODIFY CONDUIT ROUTING AS REQUIRED.
- REFER TO TRENCH DETAIL FOR UNDERGROUND CONDUIT INSTALLATION REQUIREMENTS.
- REFER TO TECHNOLOGY PLANS FOR LOCATIONS OF POLE MOUNTED CAMERAS AND WIRELESS ACCESS EQUIPMENT. COORDINATE LOADING REQUIREMENTS WITH FINAL POLE SELECTION PRIOR TO ORDERING.

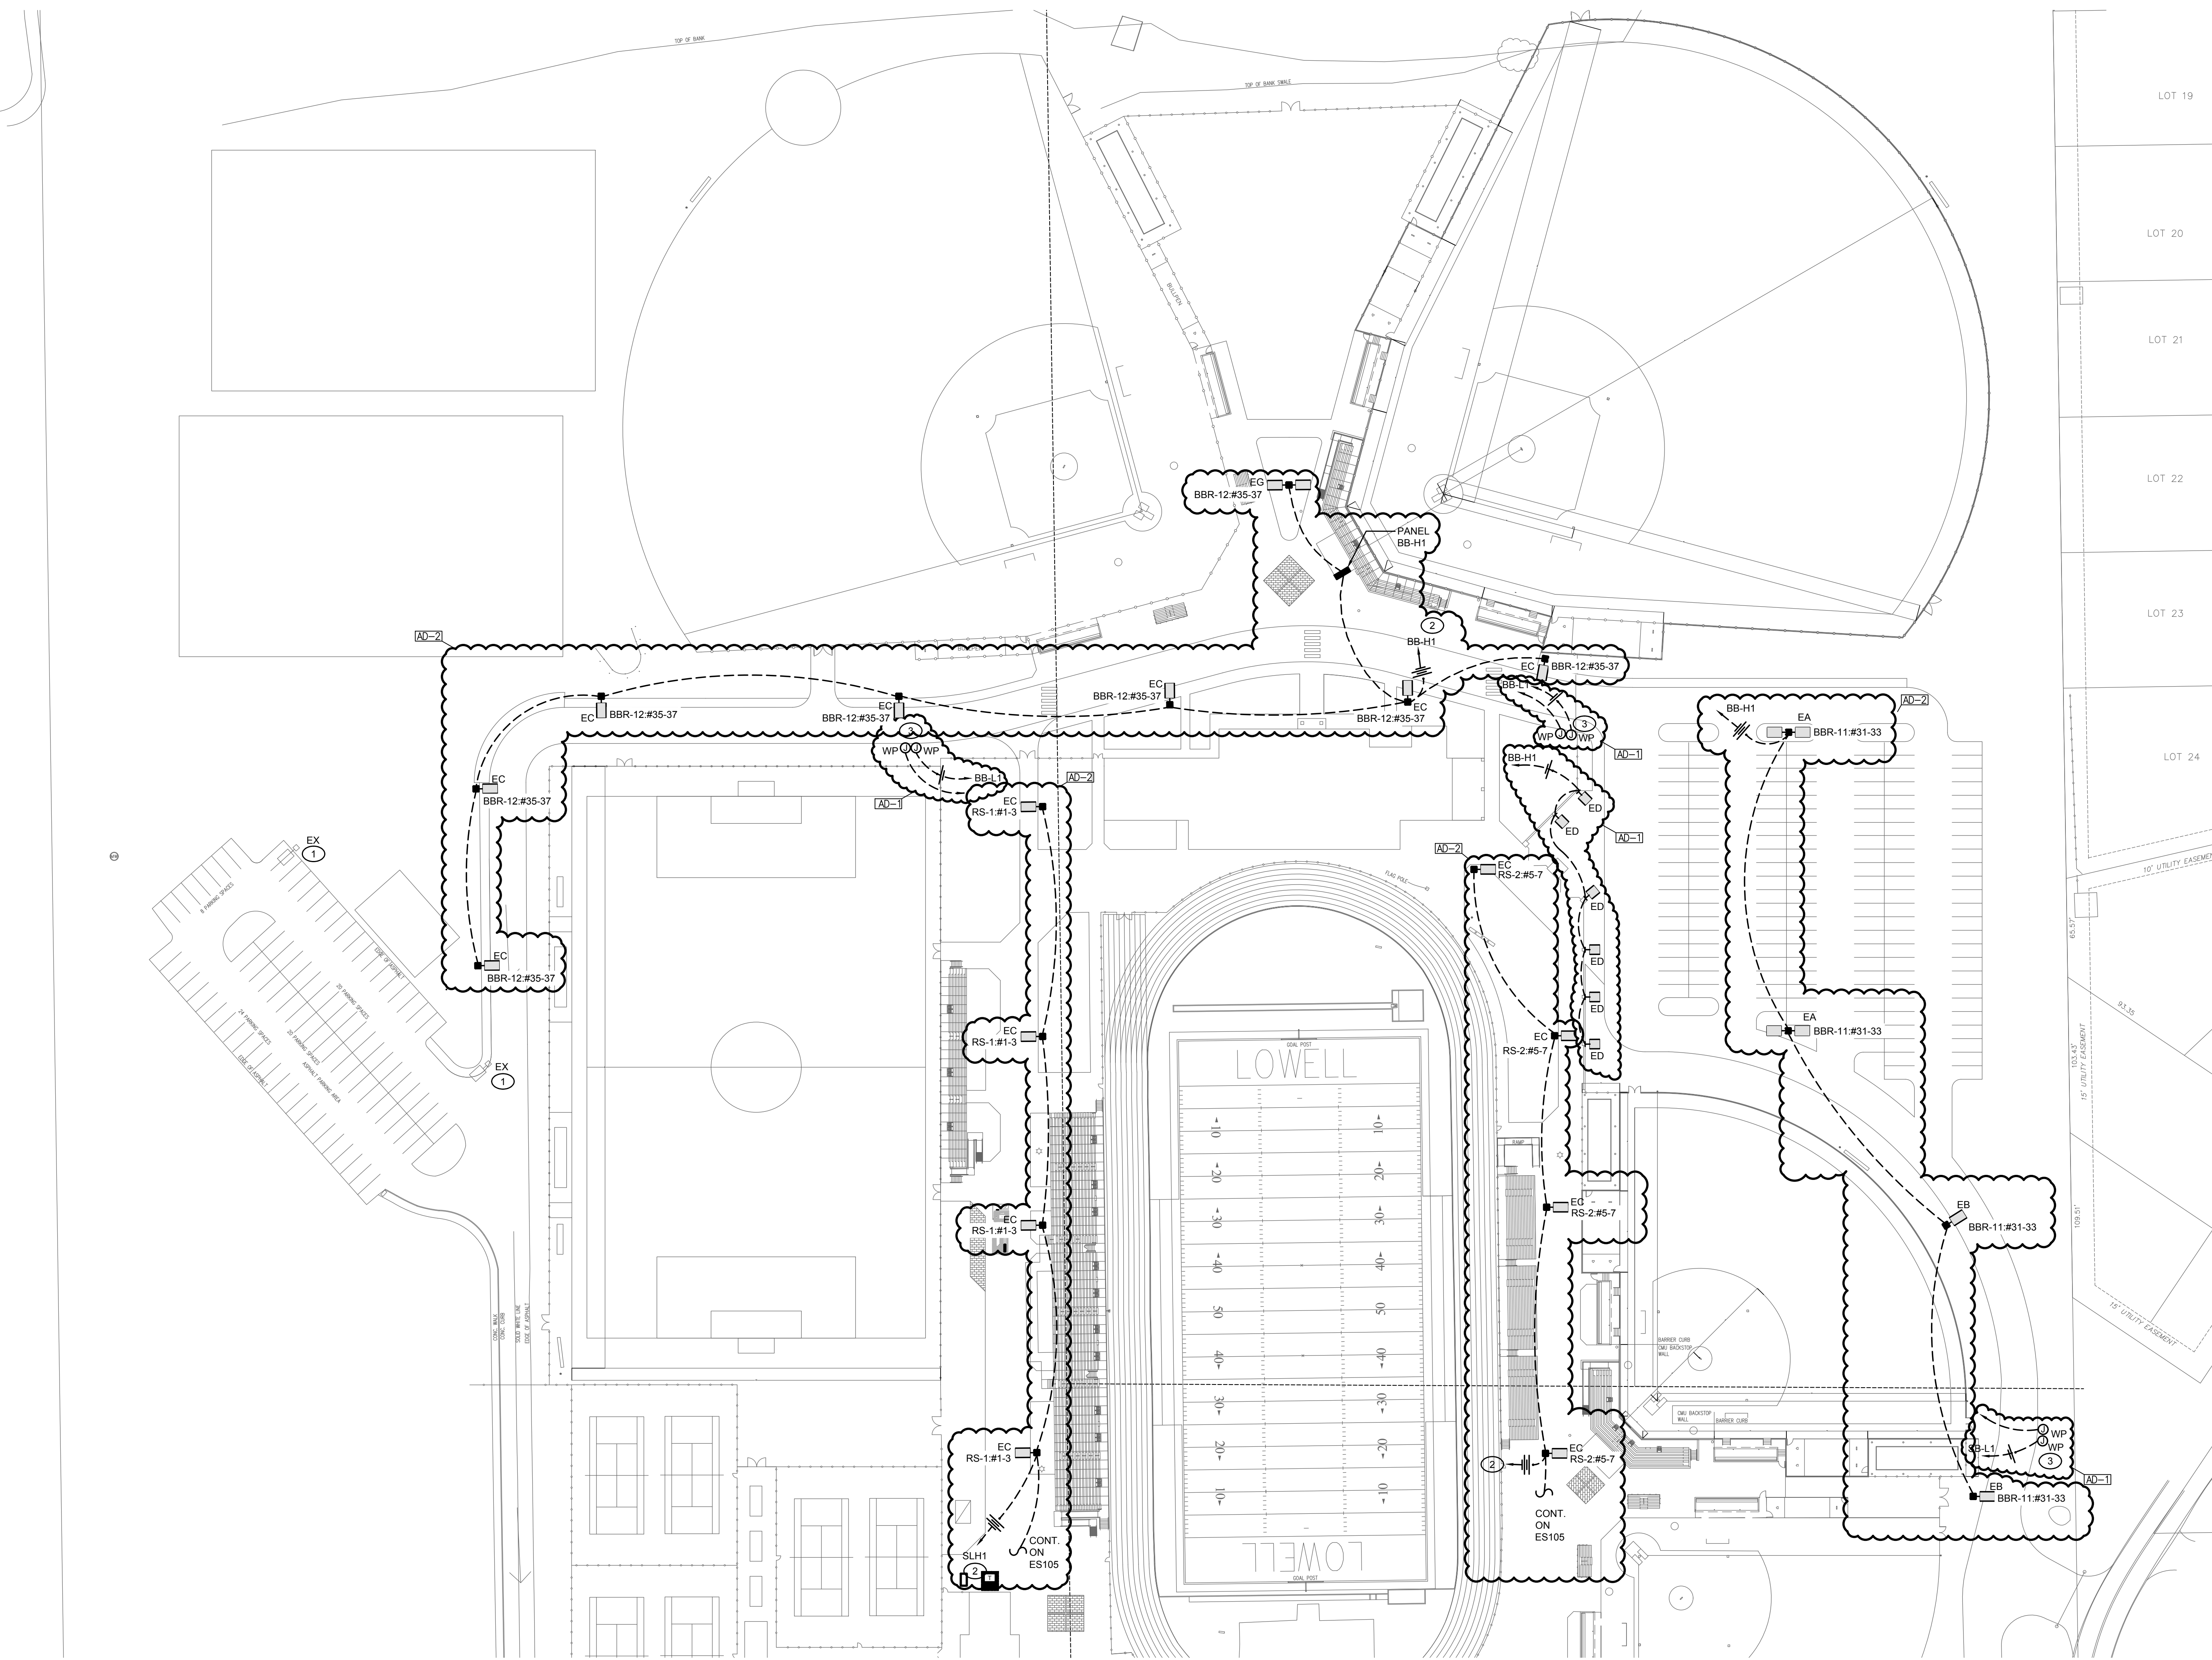

ELECTRICAL
SITE PLAN - NORTH - PARKING LOT
1" = 50'-0"

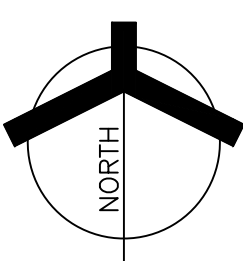


GIBALTAR
DESIGN
ARCHITECTURE • ENGINEERING • INTERIOR DESIGN

MILLIES
ENGINEERING GROUP
(219) 924-8400
www.milliesengineeringgroup.com

PROJECT
LOWELL HIGH SCHOOL SITE, BLEACHERS, & TURF/DRAINAGE
TRI-CREEK SCHOOL CORPORATION

GIBALTAR DESIGN
9102 N. Meridian St., Ste. 300
Indianapolis, IN 46260
Homepage: www.GibraltarDesign.com
Email: info@GibraltarDesign.com
Phone: 317.580.5777 Fax: 317.580.5778

PROJECT
23-112
DATE
08/04/23
COORDINATED BY
DJ
DRAWN BY
JC, AG
CHECKED BY
SM

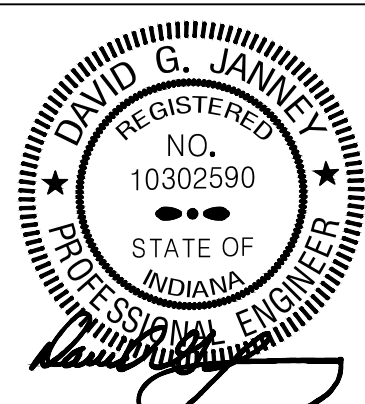

COPYRIGHT NOTICE:
THE CONCEPTS, DESIGNS, PLANS, DETAILS, ETC., SHOWN ON THIS DOCUMENT ARE THE PROPERTY OF GIBALTAR DESIGN AND WERE CREATED FOR USE ON THIS SPECIFIC PROJECT. NONE OF THIS INFORMATION SHALL BE USED BY ANY PERSON OR FIRM FOR ANY PURPOSE WITHOUT THE EXPRESS WRITTEN CONSENT OF GIBALTAR DESIGN. THE OWNER MAY RETAIN COPIES FOR INFORMATION AND REFERENCE IN CONNECTION ONLY WITH THIS PROJECT.


REVISIONS		
MARK	DATE	ISSUED FOR
AD-1	08/18/23	ADDENDUM NO. 01
AD-2	08/31/23	ADDENDUM NO. 02

DRAWING
ELECTRICAL SITE PLAN - NORTH - PARKING LOT

PROJECT
LOWELL HIGH SCHOOL SITE, BLEACHERS, & TURF/DRAINAGE

© GIBALTAR DESIGN SHEET
ES112

1. VERIFY EXISTING ROUTING IN FIELD PRIOR TO SITE DEMOLITION WORK.
2. REINSTALL RELOCATED TRANSFORMER. PROVIDE NEW CONCRETE PAD AND TRANSFORMER GROUNDING PER SPECIFICATION REQUIREMENTS.
3. INTERCEPT EXISTING UNDERGROUND PRIMARY FEEDERS AND MODIFY AS REQUIRED. EXTEND AS INDICATED TO NEW HAND HOLE LOCATION. VERIFY EXACT CONDITIONS AND REQUIREMENTS IN FIELD.

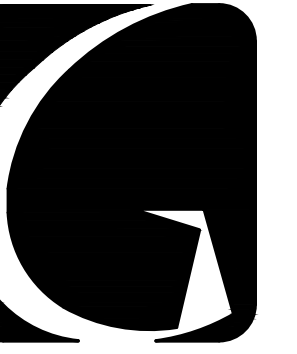


DESIGN
ARCHITECTURE • ENGINEERING • INTERIOR DESIGN



MILLIES
ENGINEERING GROUP
(219) 924-8400
milliesengineeringgroup.com



LOWELL HIGH SCHOOL SITE, BLEACHERS, & TURF/DRAINAGE

TRI-CREEK SCHOOL CORPORATION

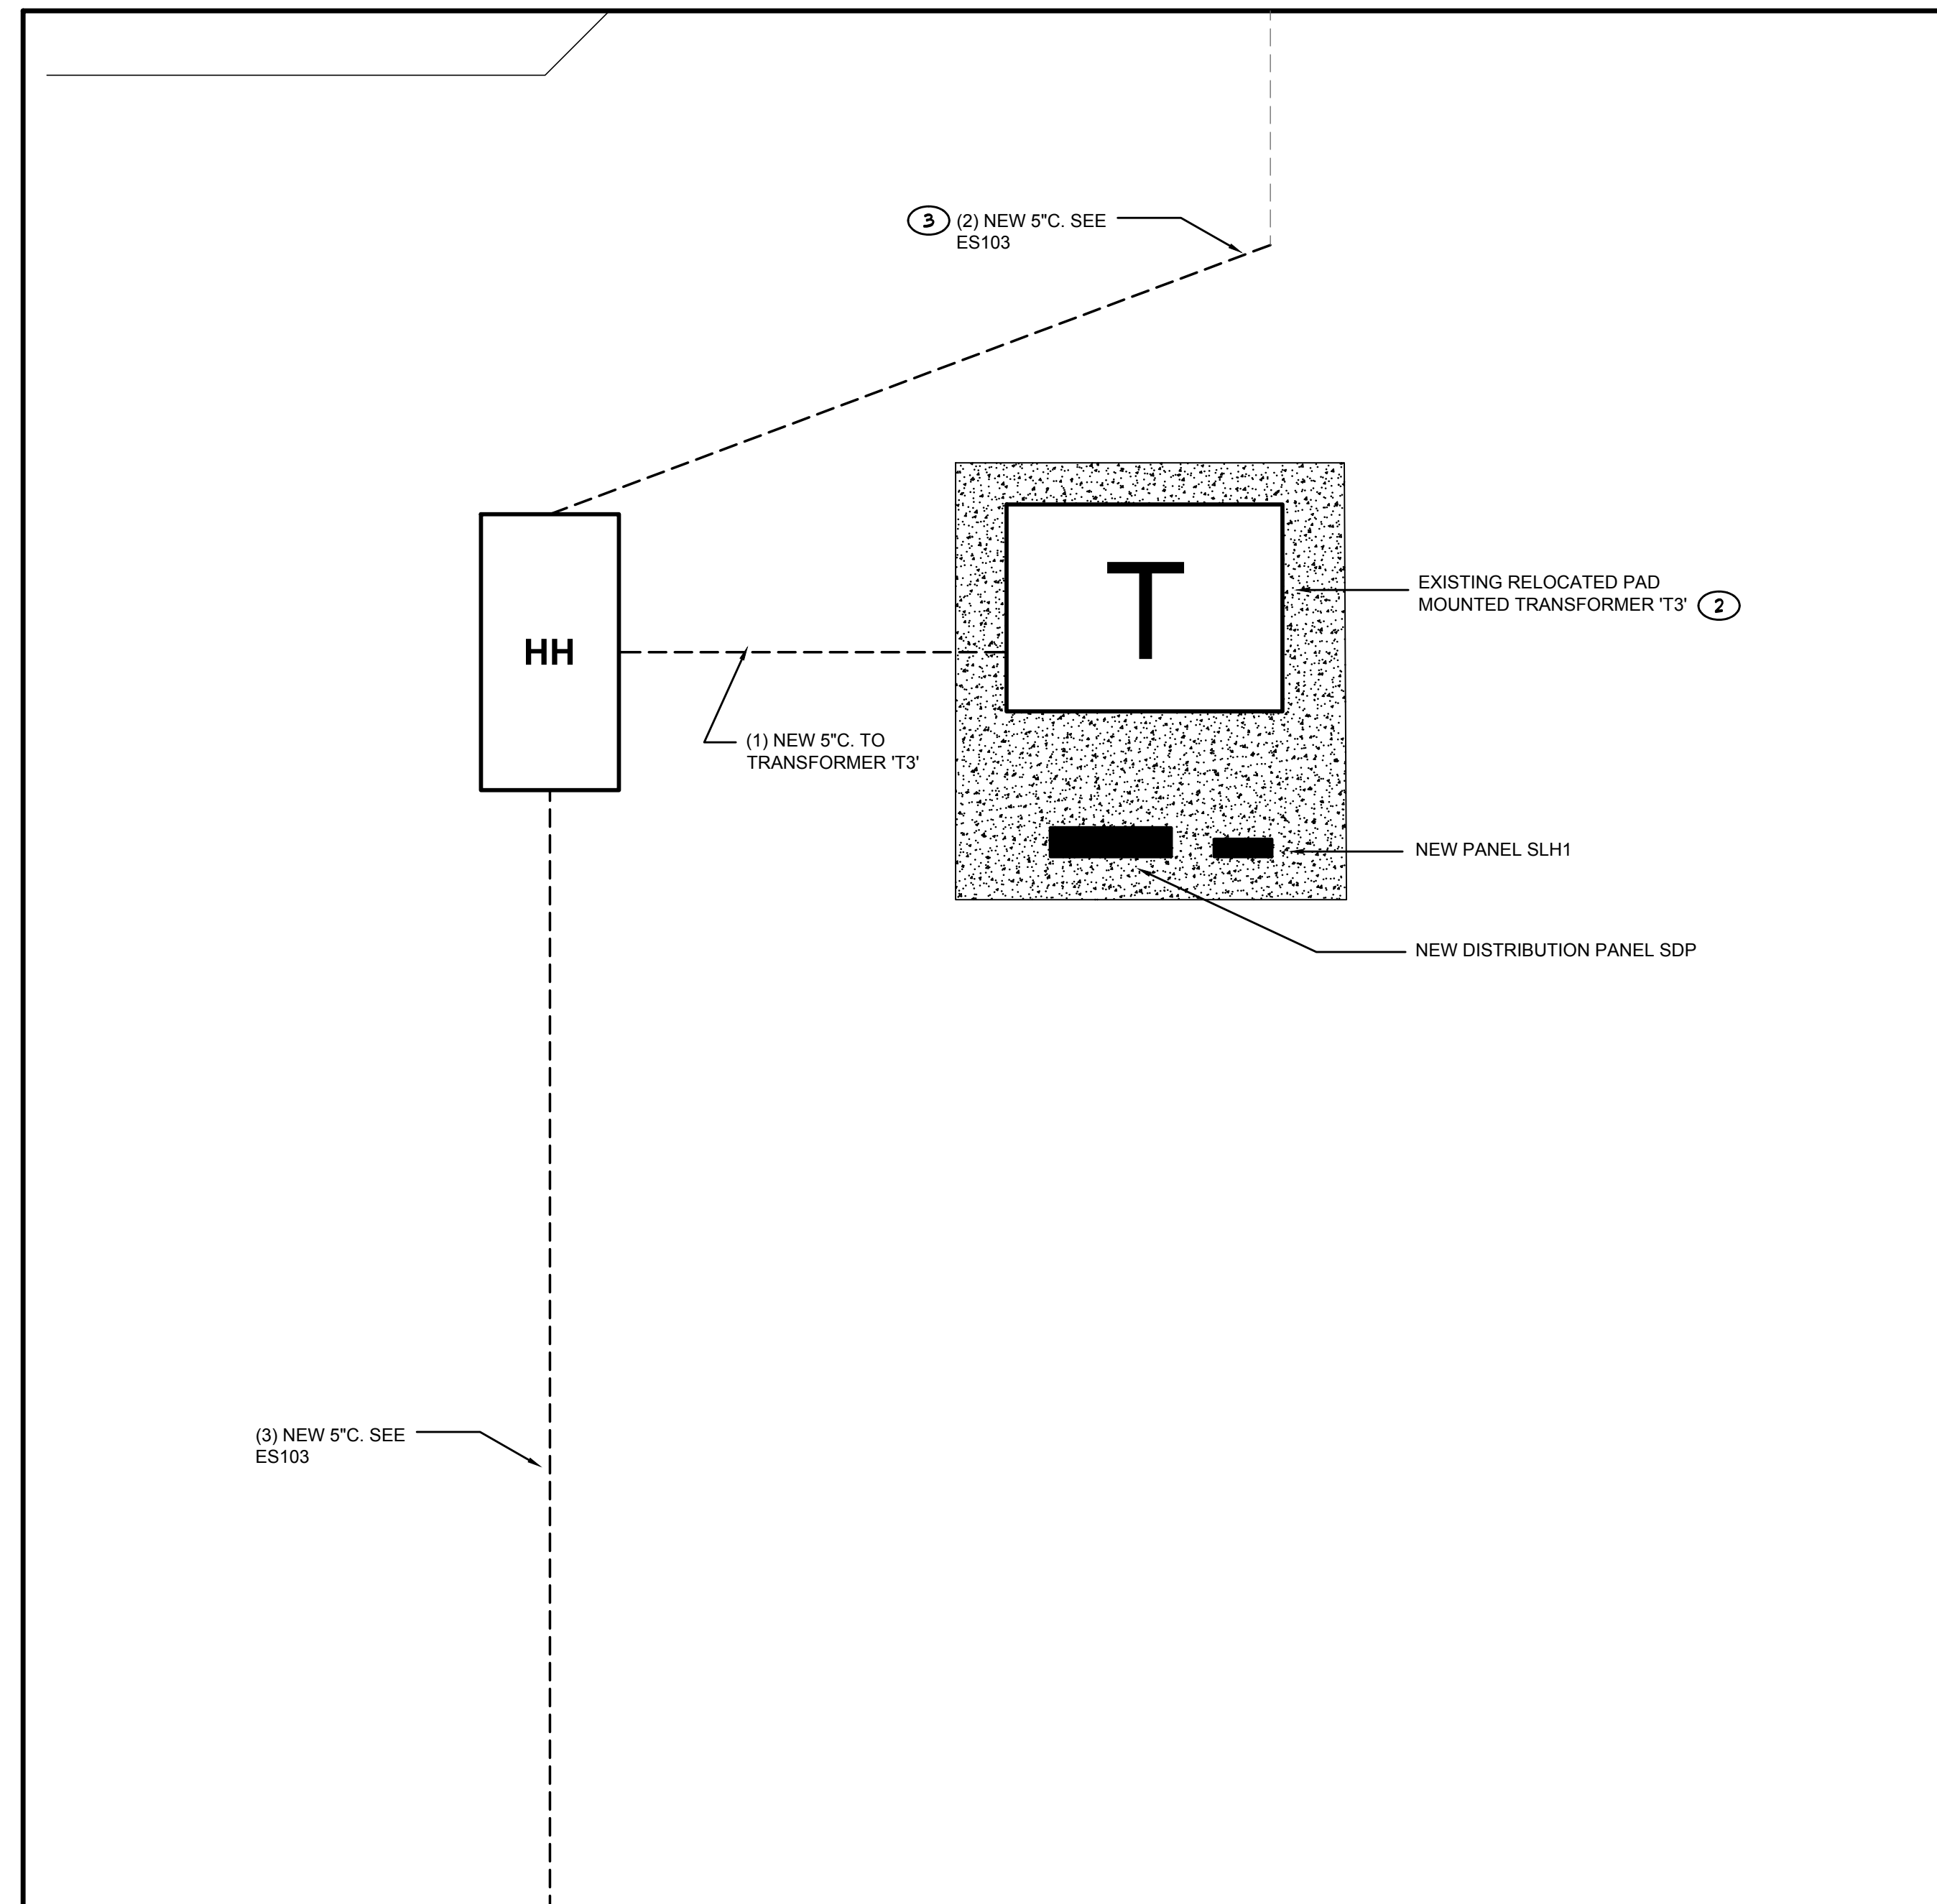


2 TRANSFORMER T3 PLAN

E-103 $1/4" = 1'-0"$

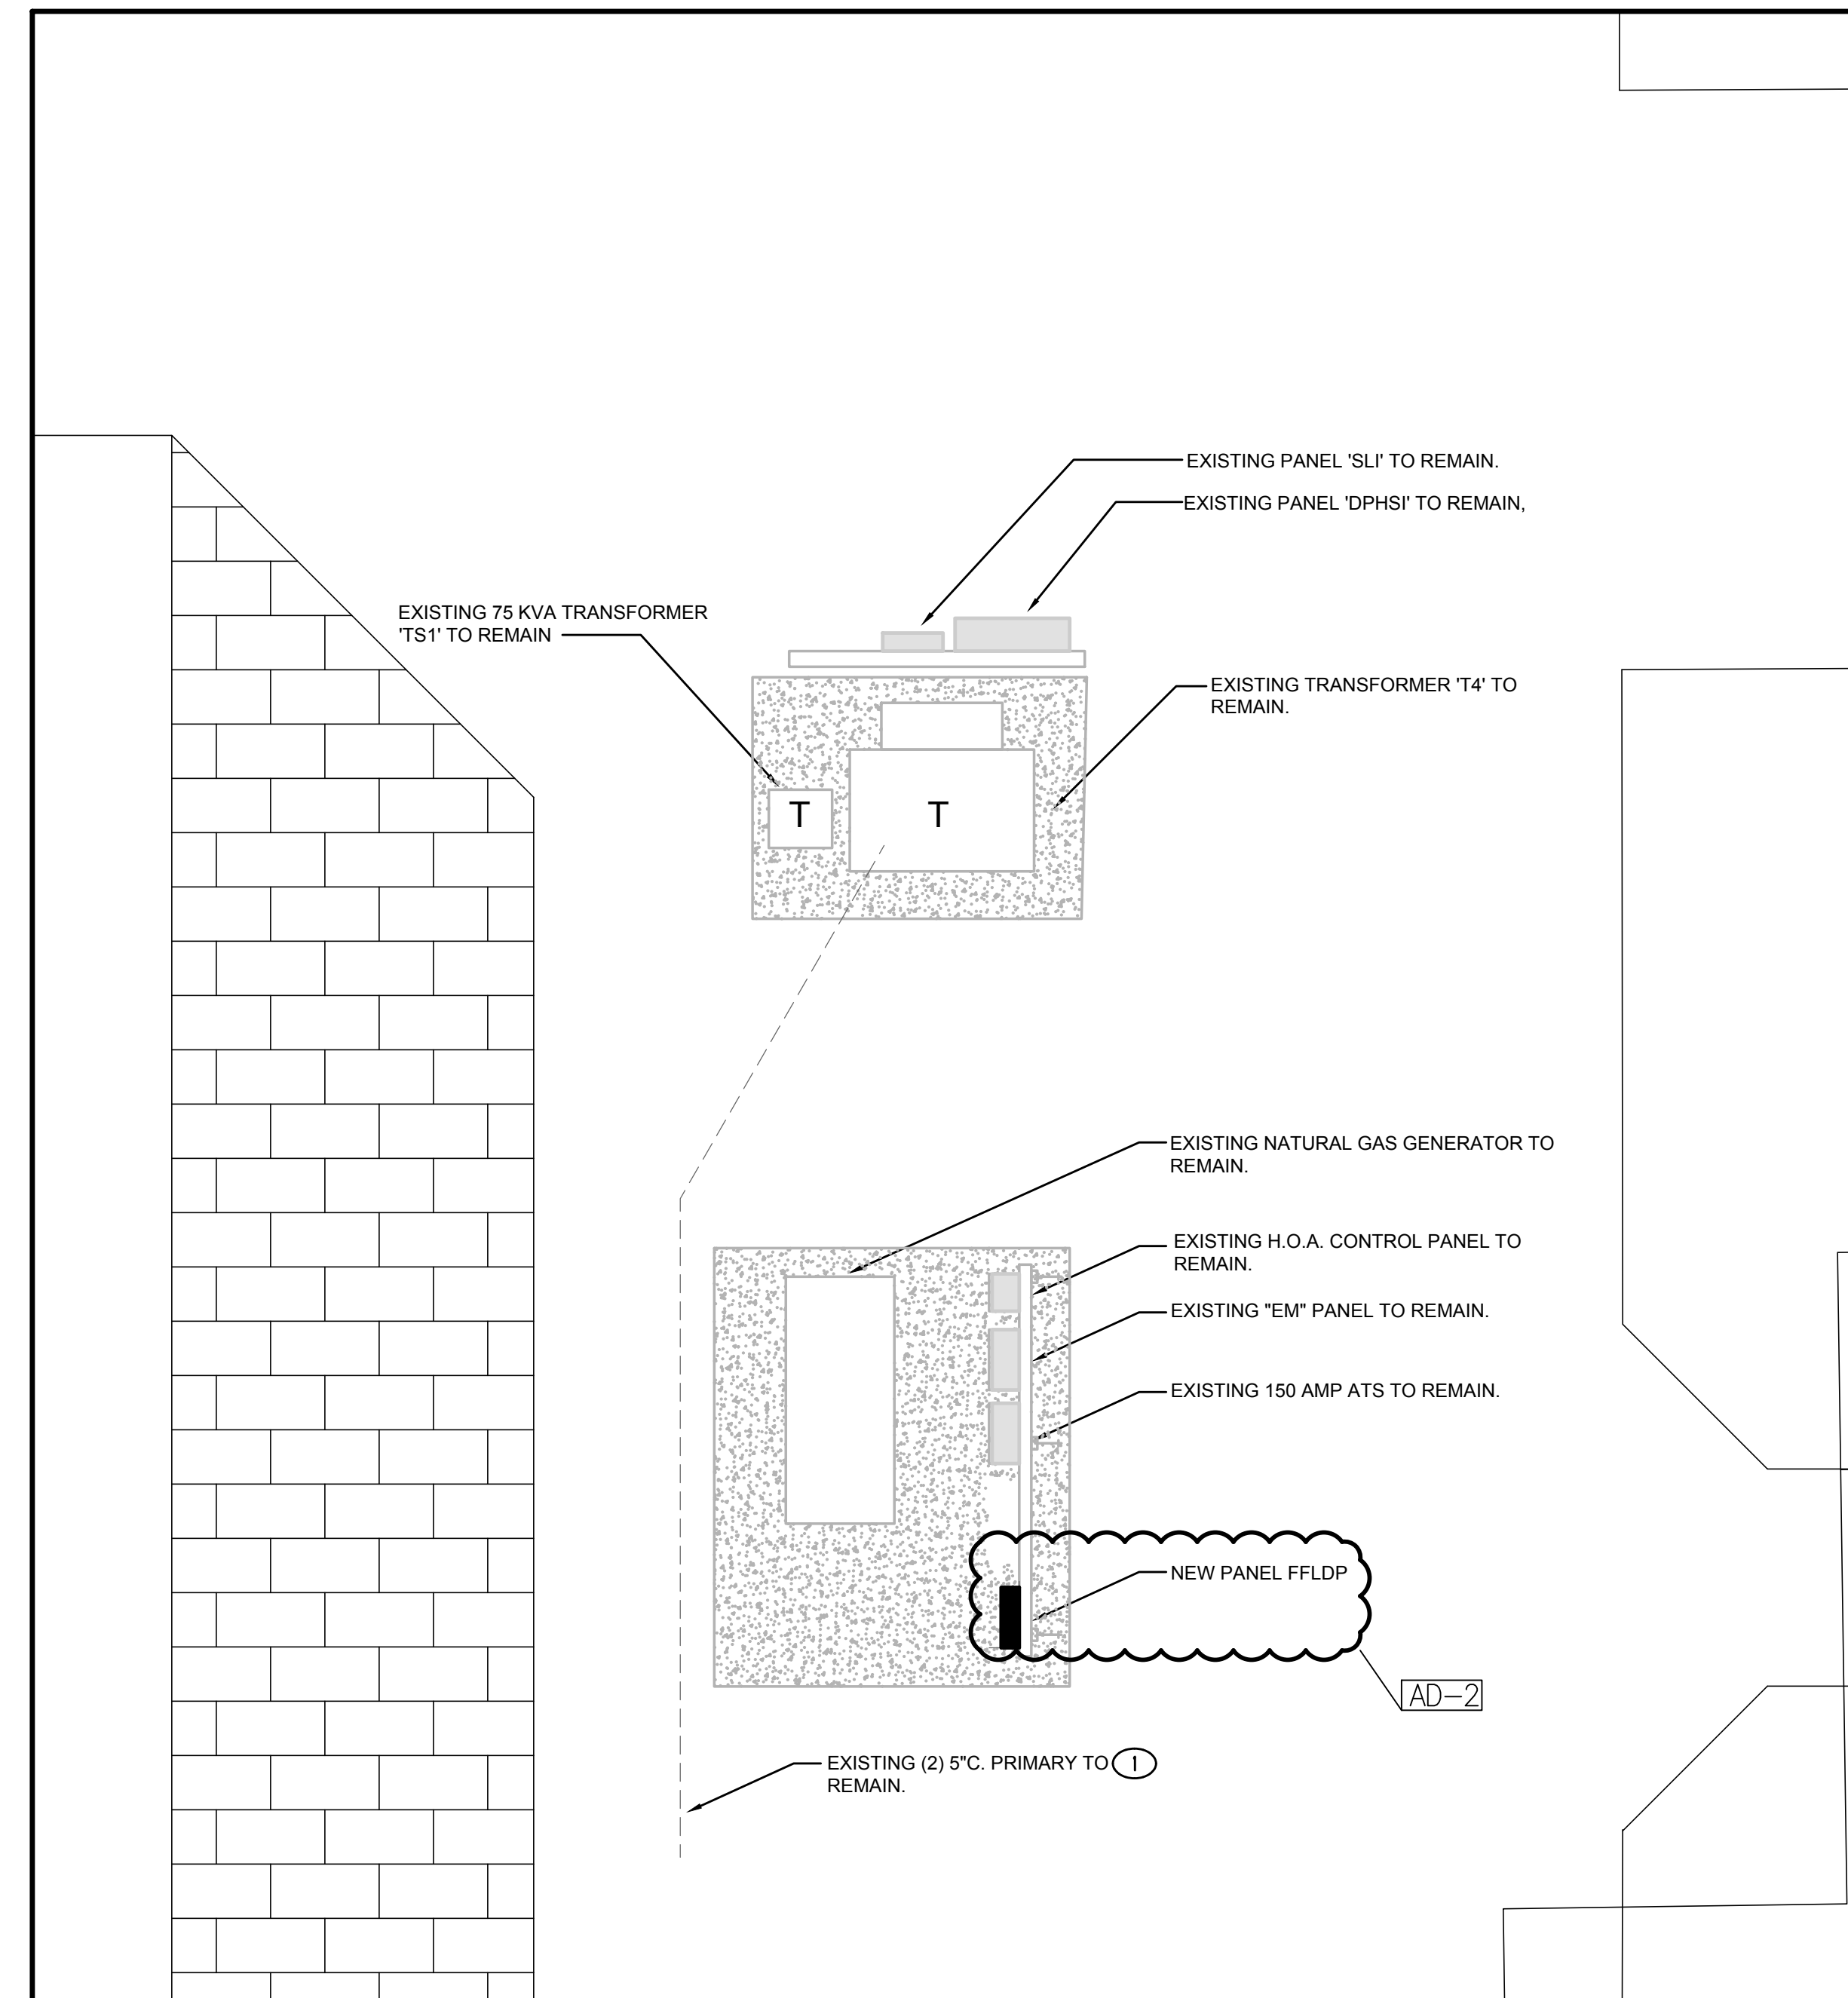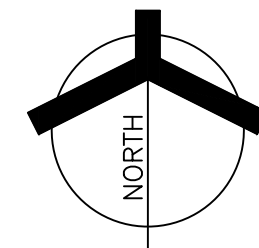

1 TRANSFORMER T4 PLAN
E-103 1/4" = 1'-0"

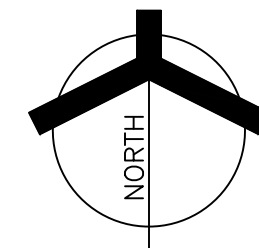

9102 N. Meridian St., Ste. 300
Indianapolis, IN 46260
Homepage www.GibraltarDesign.com
Email info@GibraltarDesign.com
Phone 317.580.5777 Fax 317.580.5778

CHECKED BY
SM

THE CONCEPTS, DESIGNS, PLANS, DETAILS, ETC. SHOWN ON THIS DOCUMENT ARE THE PROPERTY OF GIBRALTAR DESIGN AND WERE CREATED FOR USE ON THIS SPECIFIC PROJECT. NONE OF THIS INFORMATION SHALL BE USED BY ANY PERSON OR FIRM FOR ANY PURPOSE WITHOUT THE EXPRESS WRITTEN CONSENT OF GIBRALTAR DESIGN. THE OWNER MAY RETAIN COPIES FOR INFORMATION AND REFERENCE IN CONNECTION ONLY WITH THIS PROJECT.


[illegible]

DRAWING

TRANSFORMER PLAN

PROJECT
LOWELL HIGH SCHOOL SITE,
BLEACHERS, & TURF/DRAINAGE

GIBRALTAR DESIGN
SHEET
E-103

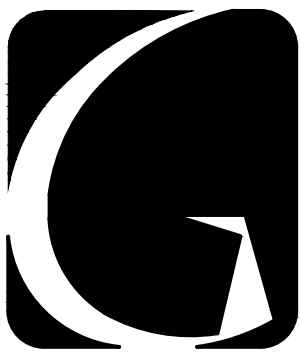

GIBALTAR
DESIGN
ARCHITECTURE • ENGINEERING • INTERIOR DESIGN

PROJECT

**LOWELL HIGH
SCHOOL SITE,
BLEACHERS, &
TURF/DRAINAGE**


TRI-CREEK SCHOOL CORPORATION

GENERAL NOTES:

1. FOR ADDITIONAL GENERAL ELECTRICAL NOTES, SEE GENERAL ELECTRICAL PROJECT NOTES ON SHEET E-001.
2. SEE E-600 SHEETS FOR ELECTRICAL DETAILS AND SCHEDULES.
3. SEE E-700 SHEETS FOR ELECTRICAL DISTRIBUTION DIAGRAMS.
4. PANELBOARDS PROVIDED IN SITE DEVELOPMENT PROJECT. BRANCH CIRCUIT WIRING, OTHER EQUIPMENT AND OTHER ELECTRICAL CONNECTIONS SHALL BE PROVIDED IN STADIUM PROJECT.



ELECTRICAL PLAN NOTES:
(THESE NOTES APPLY TO THIS SHEET ONLY)

1. PROVIDE ELECTRICAL PANELS AND TRANSFORMER AS SHOWN. VERIFY EXACT LOCATION WITH ARCHITECT AND CONSTRUCTION MANAGER PRIOR TO ROUGHING-IN.
2. PROVIDE SITE LIGHTING PANELBOARDS, RELAYS AND TIMECLOCKS AS SHOWN, AS WELL AS ALL OF THE BRANCH CIRCUITING.
3. TORK DZS400BP FOUR CHANNEL TIMECLOCK SLTC-1. CHANNEL ONE CONTROLS RELAY SR-1 (WEST WALKWAY LIGHTS), CHANNEL TWO CONTROLS SR-2 (EAST WALKWAY LIGHTS), CHANNEL THREE CONTROLS RELAY SR-3 (SOUTHWEST PARKING LOT LIGHTS) AND CHANNEL FOUR CONTROLS RELAY SR-4 (SOUTHEAST PARKING LOT LIGHTS). (CIRCUIT SLH1-13). TORK DZS200BP TWO CHANNEL TIMECLOCK SLTC-2. CHANNEL ONE CONTROLS RELAY SR-5 (ATHLETIC FIELD ENTRANCE SIGN) AND CHANNEL TWO IS A SPARE. (CIRCUIT SLH1-15).
4. REMOVE EXISTING ELECTRICAL EQUIPMENT IN THIS ROOM. REMOVE EXISTING FEEDERS TO EXISTING PANELBOARDS AND TRANSFORMER IN THIS ROOM. BRANCH CIRCUIT WIRING SHALL BE REMOVED IN STADIUM PROJECT.
5. REMOVE EXISTING PANEL "AL2" AND REMOVE ASSOCIATED FEEDER. BRANCH CIRCUIT WIRING SHALL BE REMOVED IN STADIUM PROJECT.

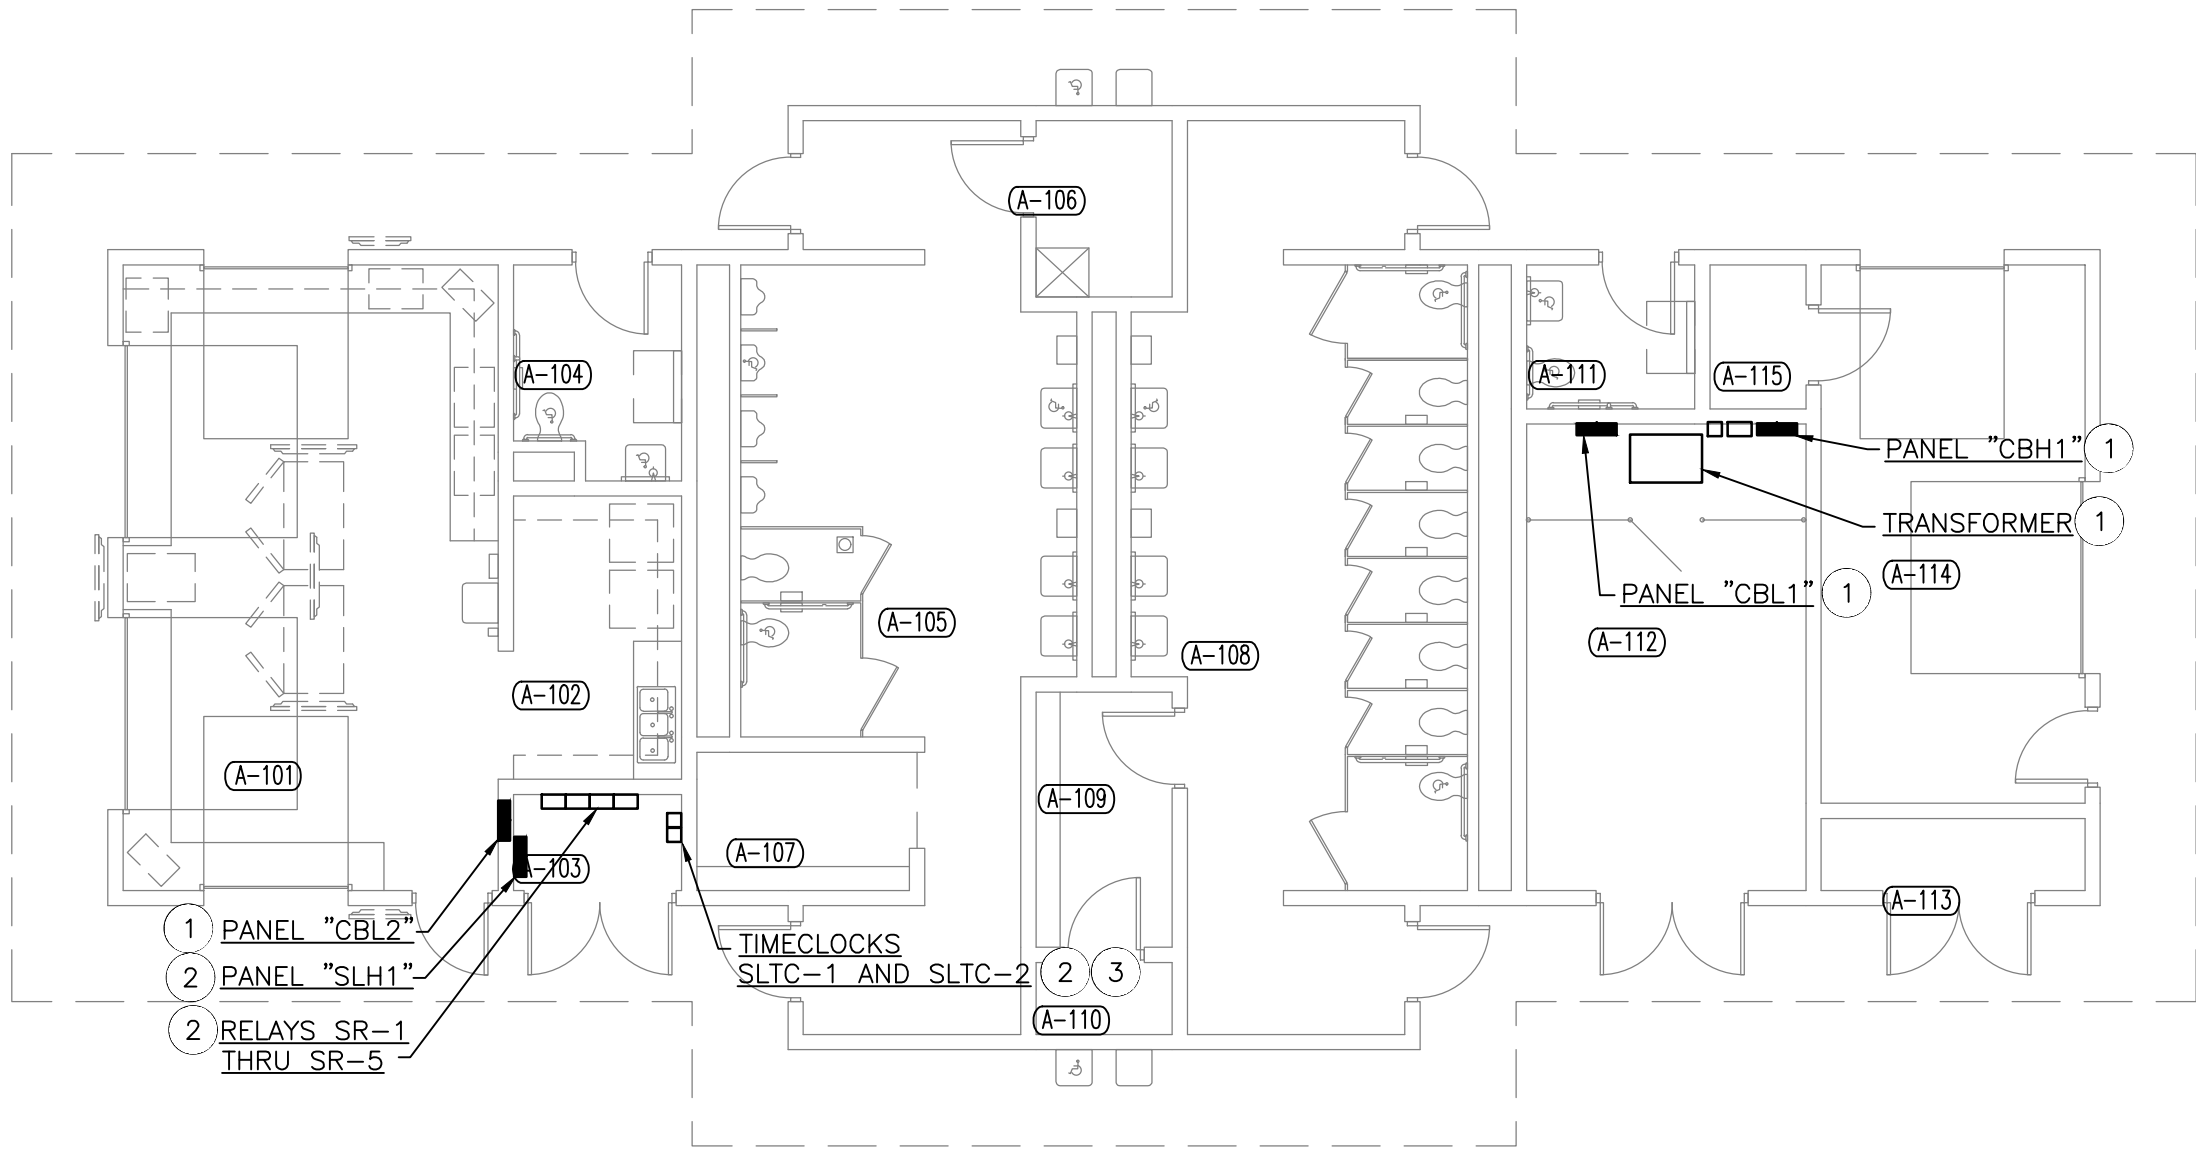



COMMUNITY BUILDING FIRST FLOOR ELECTRICAL POWER PLAN

SCALE: 1/8" = 1'-0"

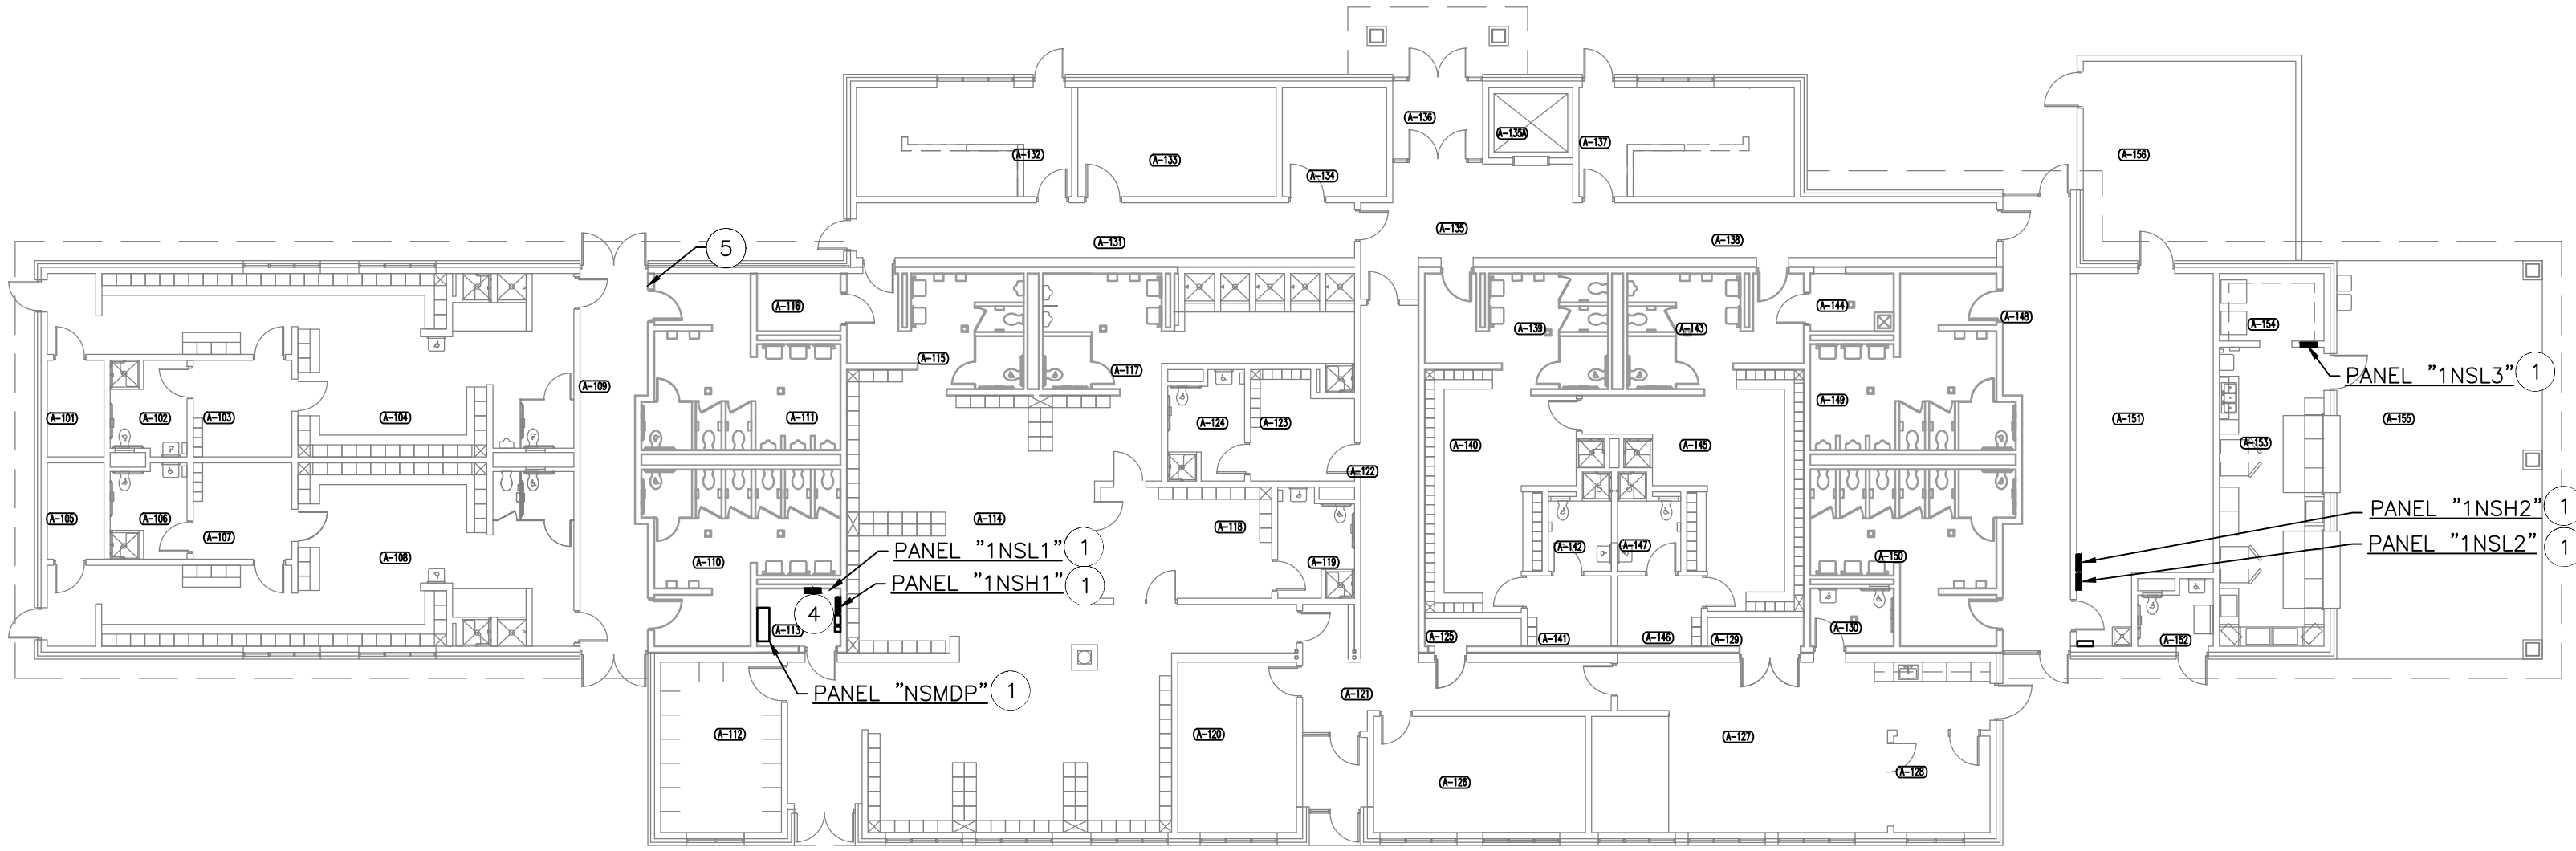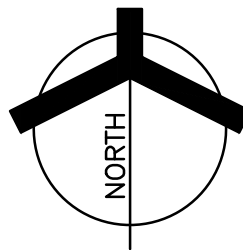


NORTH STAR BUILDING FIRST FLOOR ELECTRICAL POWER PLAN

SCALE: 1/16" = 1'-0"

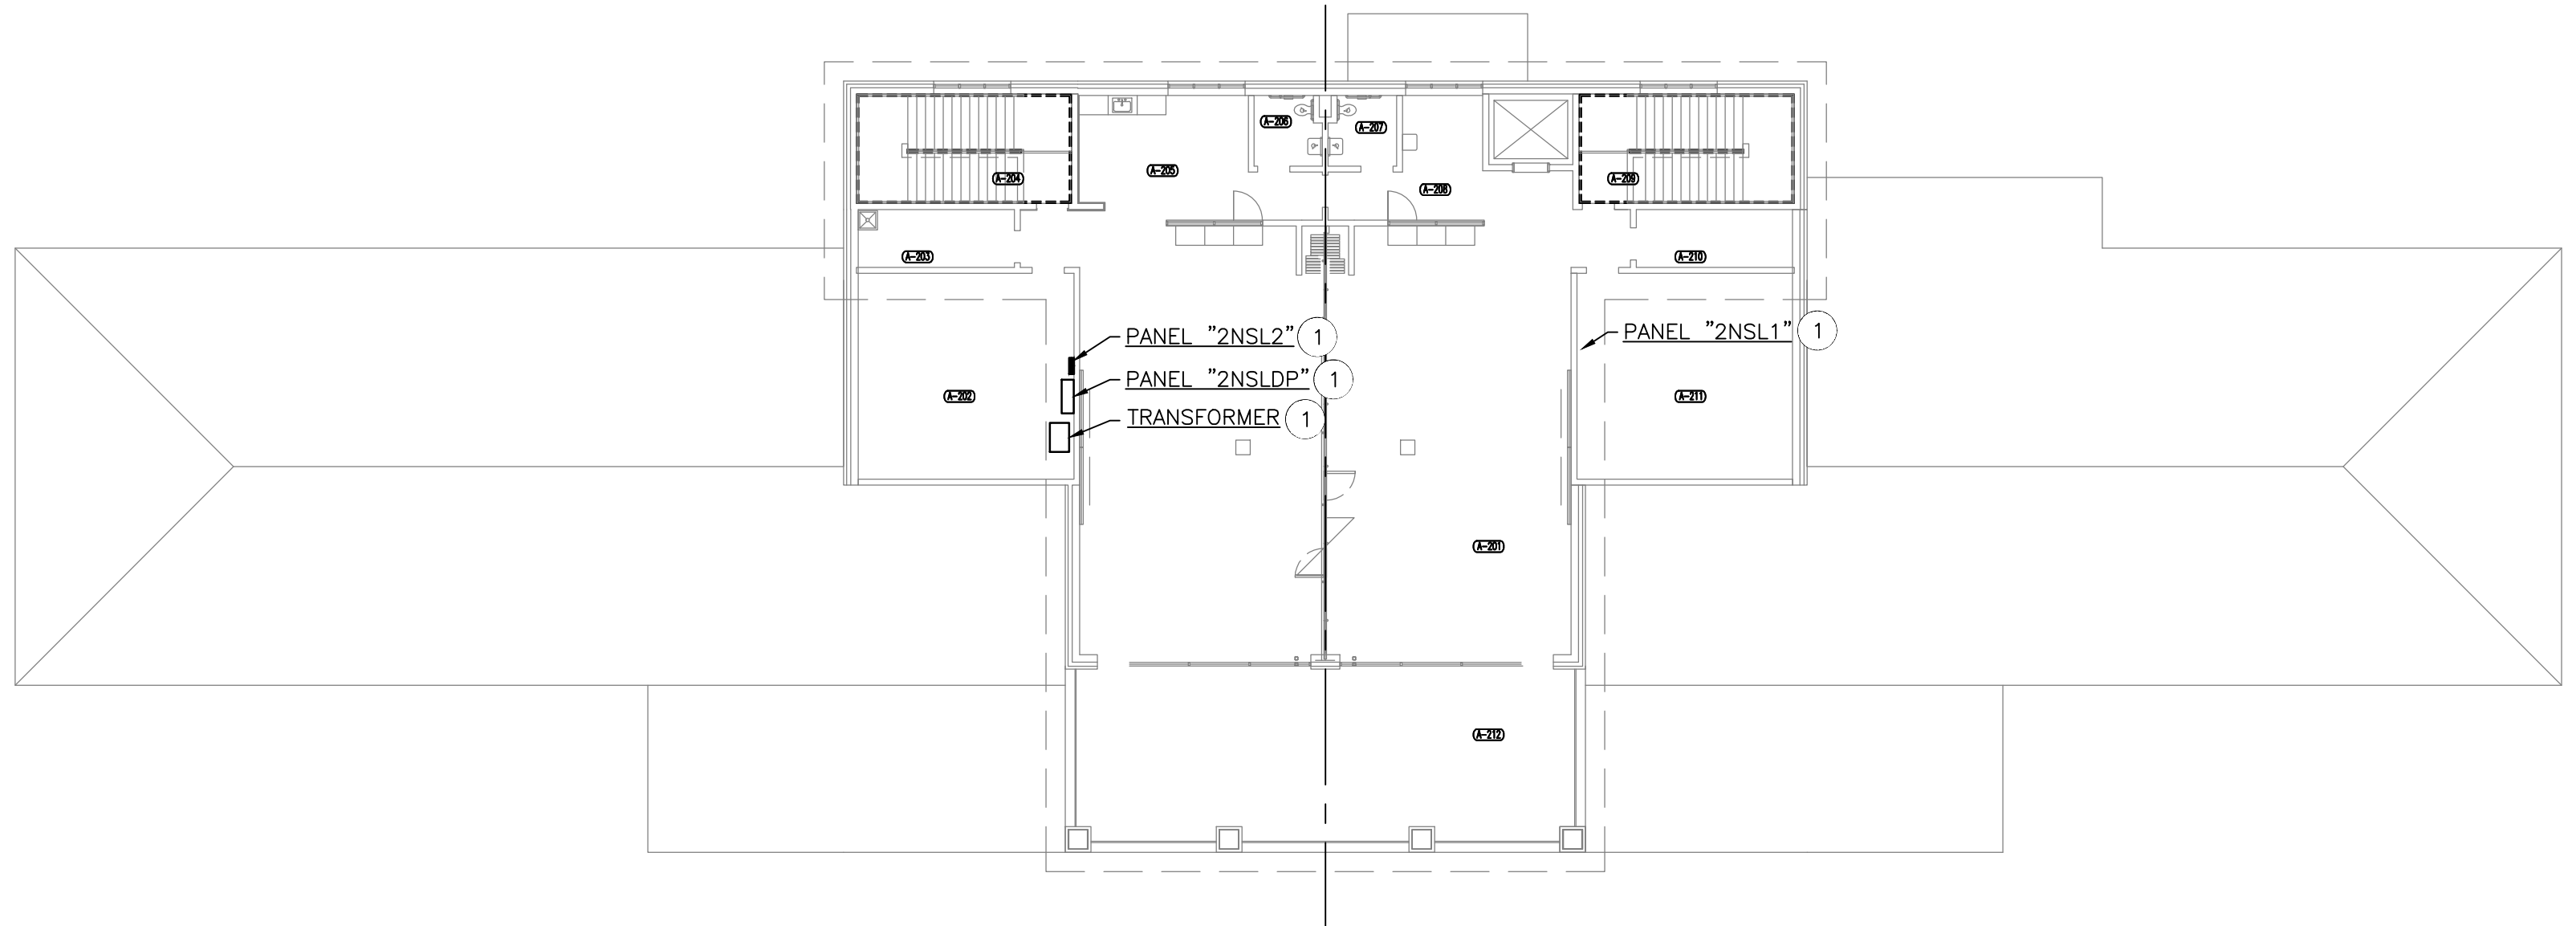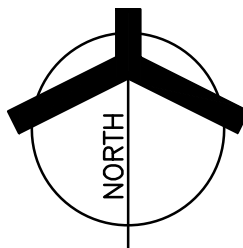

NORTH STAR BUILDING SECOND FLOOR ELECTRICAL POWER PLAN


SCALE: 1/16" = 1'-0"

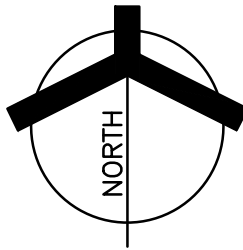

GIBALTAR DESIGN

9102 N. Meridian St., Ste. 300
Indianapolis, IN 46260
Homepage: www.GibraltarDesign.com
Email: info@GibraltarDesign.com
Phone: 317.580.5777 Fax: 317.580.5778

PROJECT
23-112
DATE
08/04/23
COORDINATED BY
PCB
DRAWN BY
PCB
CHECKED BY
JPB

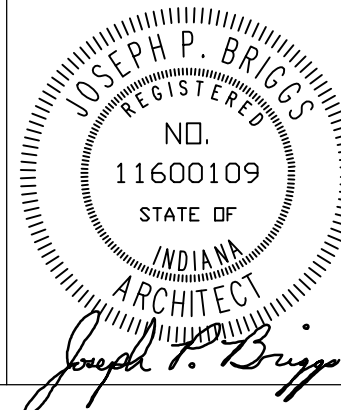

COPYRIGHT NOTICE:
THE CONCEPTS, DESIGNS, PLANS, DETAILS, ETC., SHOWN ON THIS DOCUMENT ARE THE PROPERTY OF GIBALTAR DESIGN AND WERE CREATED FOR USE ON THIS SPECIFIC PROJECT. NONE OF THIS INFORMATION SHALL BE USED BY ANY PERSON OR FIRM FOR ANY PURPOSE WITHOUT THE EXPRESS WRITTEN CONSENT OF GIBALTAR DESIGN. THE OWNER MAY RETAIN COPIES FOR INFORMATION AND REFERENCE IN CONNECTION ONLY WITH THIS PROJECT.

REVISIONS

MARK	DATE	ISSUED FOR
AD-2	08/31/23	ADDENDUM NO. 2 (ENTIRE SHEET)

DRAWING

**COMMUNITY BUILDING AND
NORTH STAR BUILDING
ELECTRICAL POWER PLANS**

PROJECT

**LOWELL HIGH SCHOOL - SITE AND
STADIUM IMPROVEMENTS**

© GIBALTAR DESIGN

SHEET

E-104

[illegible]

LOWELL HIGH SCHOOL ATHLETIC FIELDS PANELBOARD SCHEDULE

MARK & TYPE

"TBLT"

TYPE: SQ D NO OR APPROVED EQUAL.

120/240V, 1 PH, 3W

60 AMP MAIN BREAKER

NEMA 1

FLUSH MOUNTED

DESCRIPTION

CIR POLE TRIP

1 1 20

LIGHTS

3 1 20

RECEPTACLE

5 1 20

SPARE

7 1 20

SPARE

9 1 20

SPACE

11 1 20

SPACE

TOTAL CONNECTED LOAD (KVA)

TOTAL DEMAND LOAD (KVA)

REMARKS

BRANCH CIRCUITS SHALL BE CIRCUIT BREAKERS.

CIRCUIT BREAKERS SHALL HAVE MINIMUM 22,000 AMP INTERRUPTING CAPACITY - TYPE QBOV-H.

IN ADDITION TO SPECIFIED PANEL LABELING INCLUDE ENGRAVE LABELING ON PANEL

"FED FROM PANEL "TBLT" IN BASEBALL PRESSBOX"

DESCRIPTION

LTS REC EQUIP A B HEAT A/C FUTR POLE TRIP CIR DESCRIPTION

1 1 20

2 1 20

3 1 20

Thursday, 8/31/2023 - 2:52 PM - LAST SAVED BY: CHAMBERS
Y:\23-112 TRI-CREEK SC - LOWELL HS SITE
IMPROVEMENTS\23-XXX DRAWINGS\09 ELEC\ - E-605.DWG

LOWELL HIGH SCHOOL NORTH STAR BUILDING PANELBOARD SCHEDULE																				
MARK & TYPE		REMARKS																		
"INSLDP"		BRANCH CIRCUITS SHALL BE CIRCUIT BREAKERS.																		
TYPE: 90 D 1 LINE OR APPROVED EQUIV.		CIRCUIT BREAKERS SHALL HAVE MINIMUM 65,000 AMP INTERRUPTING CAPACITY.																		
277/480V, 3 PH, 4W		RATED FOR SERVICE ENTRANCE.																		
600 AMP MAIN LUGS																				
NEMA 1																				
SURFACE MOUNTED																				
DESCRIPTION	CR	POLE	TRIP	LTS	REC	EQUIP	A	B	C	HEAT	A/C	FUTR	POLE	TRIP	CR	DESCRIPTION				
PANEL "INSH1"	1	3	200	8.00		6.10	14.10							3	200	2	PANEL "INSH1"			
				8.00		6.10	18.10													
						6.10	14.10													
				6.00		6.10		18.10		12.10										
						18.10				18.10										
CHILLER	3	3	200			34.00	34.00													
						34.00		34.00												
				0.10	36.78	6.40	43.28							3	225	4	150 KVA TRANSFORMER (PANEL "2NSLDP")			
				32.58		4.20		36.78												
						34.00				34.00										
				42.24		9.00				51.24										
SPARE	5	3	70			9.42	9.42													
						7.48	7.48							3	100	6	ELEVATOR			
						9.42		9.42												
						7.48		7.48												
						9.42			9.42											
						7.48			7.48											
SPARE	7	3	200																	
						9.42								3	100	8	SPARE			
						7.48														

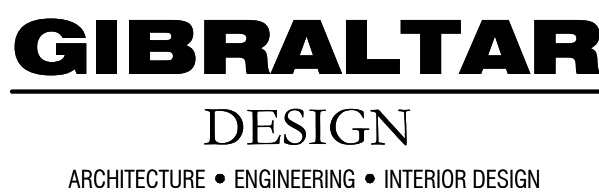

LOWELL HIGH SCHOOL SITE, BLEACHERS, & TURF/DRAINAGE

[illegible][illegible][illegible]


E-606

PROJECT

**LOWELL HIGH
SCHOOL SITE,
BLEACHERS, &
TURF/DRAINAGE**

TRI-CREEK SCHOOL CORPORATION

- 1 REMOVE EXISTING DISTRIBUTION PANEL "SDP". INTERCEPT ANY EXISTING FEEDERS SERVING EQUIPMENT, THAT REMAINS, AND EXTEND TO THE NEW DISTRIBUTION PANEL "SDP", UNLESS OTHERWISE NOTED.
- 2 REMOVE EXISTING FEEDER TO THE RED BARN BEING REMOVED.
- 3 REMOVE EXISTING FEEDER TO EXISTING FOOTBALL FIELD PANEL "FFLD" AND PREPARE EXISTING FOOTBALL FIELD PANEL FOR NEW FEEDER FROM NEW DISTRIBUTION PANEL "SDP".
- 4 REMOVE EXISTING FEEDERS TO THE TENNIS COURT LIGHTING PANEL.
- 5 REMOVE THE EXISTING FEEDER TO PANEL "AH1" IN THE NORTH STAR BUILDING.
- 6 RELOCATE THE EXISTING PAD MOUNTED TRANSFORMER. SEE SHEETS ES101, ES102 AND ES108.
- 7 SEE SHEETS ED101 AND ES08 FOR INFORMATION ON EXISTING FEEDER FROM EXISTING TRANSFORMER #2 TO EXISTING TRANSFORMER #3, WHICH IS BEING RELOCATED.
- 8 REMOVE EXISTING FEEDER FROM EXISTING TRANSFORMER #3, WHICH IS BEING RELOCATED TO EXISTING TRANSFORMER #4. SEE SHEET ES101, ES102 AND ES108.
- 9 EXISTING DISTRIBUTION PANEL "DPH51" SHALL BE REPLACED WITH NEW PANEL "DPH51". INTERCEPT EXISTING CIRCUITS SERVING EQUIPMENT THAT REMAINS AND EXTEND TO NEW PANEL "DPH51". PROVIDE NEW FEEDER AS SHOWN ON THE NEW POWER DISTRIBUTION DIAGRAM.
- 10 RELOCATE EXISTING PANEL. INTERCEPT EXISTING BRANCH CIRCUIT SERVING EXISTING LIGHTS, EQUIPMENT, ETC. THAT REMAINS AND EXTEND TO RELOCATED PANEL. PROVIDE NEW FEEDER TO CONNECT TO NEW PANEL "SDP".
- 11 REMOVE BRANCH CIRCUITS AND LIGHTING CONTROLS TO THE SOCCER FIELD LIGHTS.
- 12 REMOVE EXISTING PANELS "AH1", "AL1", "AL2" AND TRANSFORMER. DISCONNECT EXISTING BRANCH CIRCUITS FROM EXISTING PANELS "AH1" AND "AL2". DISCONNECT AND REMOVE PRIMARY AND SECONDARY FEEDER TO EXISTING 480V-120/208V TRANSFORMER.

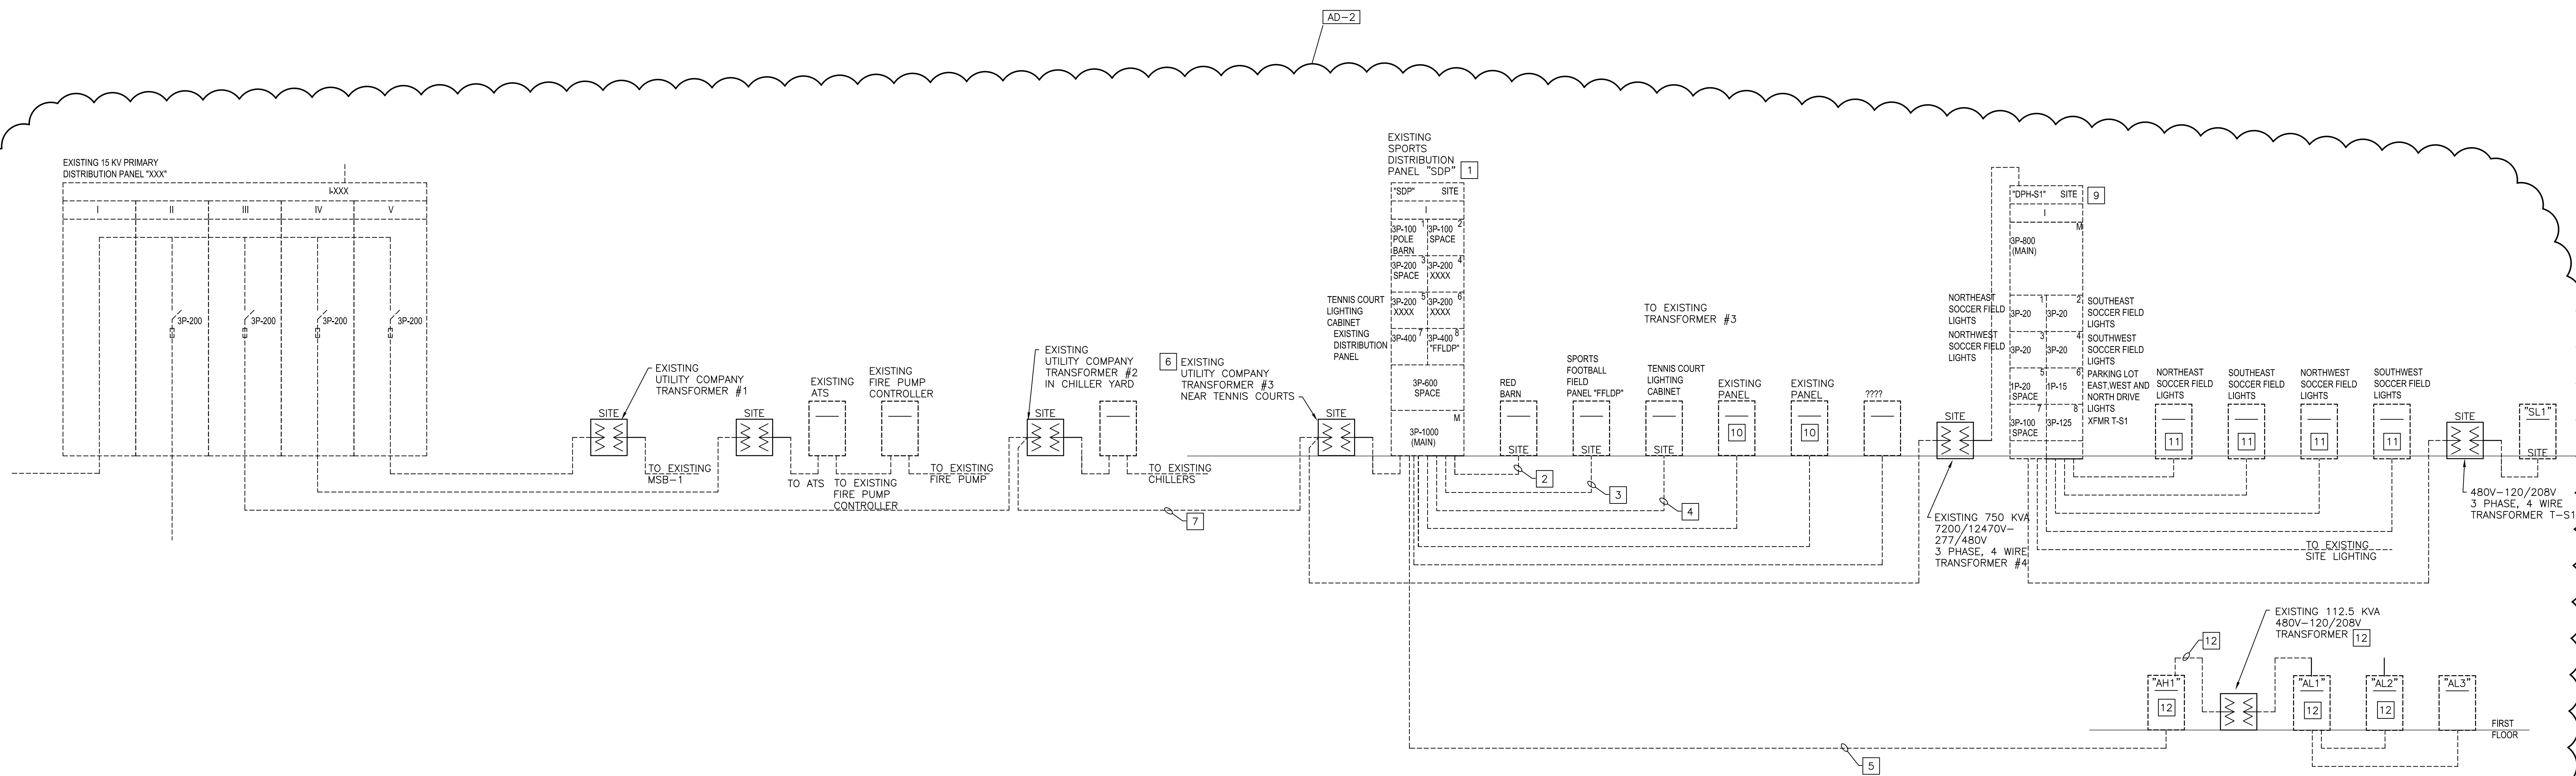

SCALE: NOT TO SCALE

----- EXISTING TO REMAIN, UNLESS OTHERWISE NOTED

_____ NEW

9102 N. Meridian St., Ste. 300
Indianapolis, IN 46260
Homepage www.GibraltarDesign.com
Email info@GibraltarDesign.com
Phone 317.580.5777 Fax 317.580.5778

COPYRIGHT NOTICE:
THE CONCEPTS, DESIGNS, PLANS, DETAILS, ETC., SHOWN ON THIS DOCUMENT ARE THE PROPERTY OF GIBRALTAR DESIGN AND WERE CREATED FOR USE ON THIS SPECIFIC PROJECT. NONE OF THIS INFORMATION SHALL BE USED BY ANY PERSON OR FIRM FOR ANY PURPOSE WITHOUT THE EXPRESS WRITTEN CONSENT OF GIBRALTAR DESIGN. THE OWNER MAY RETAIN COPIES FOR INFORMATION AND REFERENCE IN CONNECTION ONLY WITH THIS PROJECT.

[illegible]

PROJECT
LOWELL HIGH SCHOOL - SITE AND
STADIUM IMPROVEMENTS

© GIBRALTAR DESIGN
SHEET
E-701

