

September 18, 2023

LOWELL MIDDLE SCHOOL GRADE 5-8 IMPROVEMENTS Lowell, IN 46356

TO: ALL BIDDERS OF RECORD

This Addendum forms a part of and modifies the Bidding Requirements, Contract Forms, Contract Conditions, the Specifications, and the Drawings dated August 11, 2023 by Gibraltar Design. Acknowledge receipt of the Addendum in the space provided on the Bid Form. Failure to do so may subject the Bidder to disqualification.

This Addendum consists of Pages ADD 3-1 through ADD 3-2 and attached Addendum No. 3 from Gibraltar Design dated September 15, 2023 and consisting of 7 pages, Specification Section 07 42 63 - Metal Panel Siding - Field Assembled, Revised Specification Section 27 51 23 - School Intercommunications Systems, and 52 drawings.

A. <u>SPECIFICATION SECTION 00 00 20 - TABLE OF CONTENTS</u>

1. **Add:**

Specification Section 07 42 63 - Metal Panel Siding - Field Assembled

B. <u>SPECIFICATION SECTION 01 12 00 - MULTIPLE CONTRACT SUMMARY</u>

BID CATEGORY NO. 1 - GENERAL TRADES

1. **Add:**

<u>Clarification No. 22:</u> The Bid Category No. 1 Contractor shall provide all cleaning of the existing acoustical ceiling grid as indicated on the Construction Documents.

C. <u>BID CATEGORY NO. 3 - ROOFING/METAL COMPOSITES</u>

1. **Delete:**

Specification Section 05 40 00 - Cold Formed Metal Framing

2. Add:

Specification Section 07 42 63 - Metal Panel Siding - Field Assembled

D. BID CATEGORY NO. 4 - METAL STUDS/DRYWALL AND ACOUSTICS

1. Add:

Specification Section 05 40 00 - Cold Formed Metal Framing

J. BID CATEGORY NO. 10 - ELECTRICAL/TECHNOLOGY

1. Replace:

Specification Section 27 51 23 - School Intercommunication Systems with the attached revised Specification Section



ADDENDUM THREE

Addendum Three (AD.03) to the drawings and specifications prepared by Gibraltar Design for Lowell Middle School – Grade 5-8 Improvements for Tri-Creek School Corporation, Lowell, Indiana.

All Contractors bidding on this project shall read all of the items covered below and shall comply with all of the requirements as set forth, including any necessary refinements or additions generated by this Addendum and required by the intent of the original contract documents. All Contractors shall acknowledge on their bid form that they have received this Addendum, Addendum One and Addendum Two, and include the appropriate content of same within their bid proposal.

SPECIFICATIONS

1. Specification Section 00 01 10 Table of Contents

- A. Add new Specification Section to Division 7, Section 07 42 63 Metal Panel Siding Field Assembled.
- B. In Division 12: Delete Section 12 25 00 Roller Shades from the TOC.

2. Specification Section 04 20 00 Unit Masonry

- A. Add Sub-Paragraph 2.11.A.1a. substitution at Contractors Option:
 - "a. Substitution Product: Xci CG Insulation Panels by Hunter Panels, Portland, Maine. Note that Air and Vapor Barrier System in Specification is required in order to provide the equal system of the specification."

3. Specification Section 05 31 23 Steel Roof Deck

Add Paragraph 2.1.E to read: "E. Versa Dek"

4. Specification Section 07 42 44 Composite Metal Panels

Add Paragraph 2.1.A.5. to read: "5. Alfrex FR Metal Composite Material."

- 5. Specification Section 07 42 63 Metal Panel Siding Field Assembled
 - A. Add Specification Section 07 42 63, Metal Panel Siding Field Assembled, included with this addendum, to the Project Manual.

6. Specification Section 09 65 13 Resilient Flooring

- A. Revise Paragraph 1.1.A. to read: "A. Resilient Tile Flooring."
- B. Revised Paragraph 2.2. to read as follows:

"2.2 Vinyl Composition Tile Flooring Matrials.

- A. Acceptable Manufacturers:
 - 1. Armstrong World Industries, Inc. Lancaster, PA.
 - 2. Mannington Resilient Floors, Salem, New Jersey.
- B. Vinyl Composition Tile: ASTM F1066; Composition 1, Class 2, through pattern tile; 12 inches by 12 inches size, 1/8 inch thick; color and pattern as selected by the Architect. Refer to Finish Legend for Basis of Design."

AD.03-2

7. Specification Section 09 65 65

- A. Add Paragraph 2.1.B.3. to read: "3. Tarkett Sports, Calhoun, GA; POLYTURF Plus; 11 mm."
- 8. Specification Section 09 66 67 **Rubber Sports Flooring**
 - A. Delete Paragraphs 2.1.A.1.b. and 2.1.2.a.2. in their entirety. No impact rubber flooring is required.

9. Specification Section 09 84 00 **Acoustical Wall Panels**

A. Add Paragraphs 2.1.A.1. and 1a. to read:

"1. Additional acceptable manufacturers:

a. Cardinal Acoustics, Columbus OH; Cardinal Complete Panel, matching design and aesthetics of basis of design panel."

10. Specification Section 10 21 15 **Solid Phenolic Toilet Partitions**

A. Add Sub-Paragraph 2.1.A.4. as acceptable manufacturer:

"4. Scranton Products, Scranton, PA; Hiny Hiders Solid Plastic."

11. Specification Section 11 66 23 **Athletic Equipment**

A. Delete Paragraphs 1.1.C. and 2.3 in their entirety. Volleyball equipment shall be provided by owner, installed by contractor.

12. Specification Section 12 25 00 **Roller Shades**

A. Delete Specification Section in its entirety.

13. Specification Section 23 31 00 Ductwork

A. Add Paragraphs 2.3. K., Acceptable Manufacturers to read:

"K. Pro-Fab Sheet Metal."

B. Add Paragraphs 2.5. K., Acceptable Manufacturers to read: "K. Pro-Fab Sheet Metal."

14. Specification Section 23 31 16 **Fabric Duct System**

A. Add Paragraphs 2.1. A.4., Acceptable Manufacturers to read:

"4. Elite Equipment Company; Prihoda North American Fabric Duct."

15. Specification Section 27 51 23 **School Intercommunications Systems**

A. Replace specification section with new specification section included in this addendum.



Seamless Rubber Sports Floor Covering



DRAWINGS

16. Sheet G-101v1

- A. Refer to revised full size sheet included in this addendum for revisions.
 - 1. Updated the Exterior Graphic Image.

17. Sheet G-101v2

- A. Refer to revised full size sheet included in this addendum for revisions.
 - 1. Updated the Exterior Graphic Image.

18. Sheet G-102v1

- A. Refer to revised full size sheet included in this addendum for revisions.
 - 1. Updated sheet list to remove the Landscape heading include sheet A-502

19. Sheet G-102v2


- A. Refer to revised full size sheet included in this addendum for revisions.
 - 1. Updated sheet list to remove sheet PD-208

20. Sheet C-2.0

- A. Refer to revised full size sheet included in this addendum for revisions.
 - 1. The sidewalk at handicap ramp on west side of school has been given flared corners.
 - 2. The curving sidewalk on west side of school has been removed
 - 3. The sidewalk on west side of proposed gymnasium addition has been modified to remove bend in sidewalk.
 - 4. Existing communication tower has been identified with a callout.
 - 5. Stair callout now references detail sheet that shows stair detail.
 - 6. Hard play area on east side of school has been expanded and given dimensions.
 - 7. Callouts for lighted masonry signs at entrances of site have been added.
 - 8. A note regarding protection of solar equipment has been added

21. Sheet C-3.0

- A. Refer to revised full size sheet included in this addendum for revisions.
 - 1. grades around new flared corners of sidewalk near handicap ramp on west side of school have had grades moved to match new flared corners.
 - 2. grades for curved sidewalk on west side of school have been removed along with the curved sidewalk.
 - 3. grades for sidewalk near west entrance to new gymnasium building addition have been modified to match new layout of sidewalk
 - 4. grades around new hard play area on east side of school have been modified to reflect expanded size of the hard play area

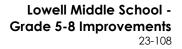



22. Sheet C-5.0

A. Refer to revised full size sheet included in this addendum for revisions.

- 1. silt fence has been added around new hard play area on east side of school
- 2. basket insert inlet protection has been added for existing open grate manholes around the new hard play area on east side of school

23. Sheet S-202

A. Refer to revised full size sheet included in this addendum for revisions.

- 1. Clarity Provided for Screen Wall Support, Acoustic Deck Description in Framing Plan
- 2. Notes Changed

24. Sheet S-411

- A. Refer to revised full size sheet included in this addendum for revisions.
 - 1. Detail 2/S-411 Regarding Acoustic Deck Has Changed

25. Sheet S-412

- A. Refer to revised full size sheet included in this addendum for revisions.
 - 1. Section 10 has been added.

26. Sheet AD-104

- A. Refer to revised full size sheet included in this addendum for revisions.
 - 1. Changed note 45 to note 54

27. Sheet AD-108

- A. Refer to revised full size sheet included in this addendum for revisions.
 - 1. Changed note 45 to note 54

28. Sheet A-103

A. Refer to revised full size sheet included in this addendum for revisions.

29. Sheet A-310

- A. Refer to revised full size sheet included in this addendum for revisions.
 - 1. Added dimensions to aluminum panel joints.

30. Sheet A-311

- A. Refer to revised full size sheet included in this addendum for revisions.
 - 1. Added dimensions to aluminum panel joints.

31. Sheet A-312

- A. Refer to revised full size sheet included in this addendum for revisions.
 - 1. Added dimensions to aluminum panel joints.

32. Sheet A-410

- A. Refer to revised full size sheet included in this addendum for revisions.
 - 1. Removed duplicate detail and adjusted detail numbers



33. Sheet A-411

- A. Refer to revised full size sheet included in this addendum for revisions.
 - 1. Corrected section tags.

34. Sheet A-413

- A. Refer to revised full size sheet included in this addendum for revisions.
 - 1. Corrected section tags.

35. Sheet A-414

- A. Refer to revised full size sheet included in this addendum for revisions.
 - 1. Corrected section tags.
 - 2. Updated aluminum panel dimensions.

36. Sheet A-502

- A. Refer to new full size sheet included in this addendum.
 - 1. Sheet includes site sign plan elevation, and sections.

37. Sheet A-601

A. Refer to revised full size sheet included in this addendum for revisions.

38. Sheet A-700

- A. Refer to revised full size sheet included in this addendum for revisions.
 - 1. Indicated volleyball sleeve location and divider curtain.

39. Sheet A-703

- A. Refer to revised full size sheet included in this addendum for revisions.
 - 1. Added tack wall elevation.

40. Sheet A-720

- A. Refer to revised full size sheet included in this addendum for revisions.
 - 1. Revised hand towel indication in gang toilet room to be electric hand dryer.

41. Sheet A-730

A. Refer to revised full size sheet included in this addendum for revisions.

42. Sheet A-820

A. Refer to revised full size sheet included in this addendum for revisions.

43. Sheet A-908

A. Refer to revised full size sheet included in this addendum for revisions.

44. Sheet PD208

A. Delete sheet in its entirety.

45. Sheet PD210

A. Refer to revised full size sheet included in this addendum for revisions.



46. Sheet E-002

- A. Refer to revised full size sheet included in the Addendum, which includes aT a minimum.
 - 1. Noting to modify Existing Panel "RDPB".

47. Sheet ES101

A. Refer to revised full size sheet included in this addendum for existing sign lights removed.

48. Sheet ES102

A. Refer to revised full size sheet included in this addendum for Power circuit wiring added for the new masonry signs.

49. Sheet ED204

A. Refer to revised full size sheet included in this addendum for revisions.

50. Sheet E-100

A. Refer to revised full size sheet included in this addendum for revisions.

51. Sheet E-103

- A. Refer to revised full size sheet included in this addendum for the following revisions:
 - 1. Modified plan notes and drawing.
 - 2. Added emergency light in Extended Learning C-125A.

52. Sheet E-101A and E-102A

- A. Refer to Two (2) revised full size sheets included in this addendum for the following revisions:
 - 1. Modified Sheet Title to clarify and note drawings as Alternate Lighting Plans.

53. Sheet E-103A

- A. Refer to revised full size sheets included in this addendum for the following revisions:
 - 1. Modified Sheet Title to clarify and note drawings as Alternate Lighting Plans.
 - 2. Deleted replacing lighting fixtures and controls in some of the rooms.

54. Sheet E-104A, E-105A, and E-108A through E-111A

- A. Refer to Six (6) revised full size sheets included in this addendum for the following revisions:
 - 1. Modified Sheet Title to clarify and note drawings as Alternate Lighting Plans.

55. Sheets E-200, E-202 and E-203


A. Refer to three (3) revised full size sheets included in this addendum for revisions.

56. Sheets E-501

A. Refer to revised full size sheets included in this addendum for revisions.

57. Sheets E-601 and E-602

A. Refer to two (2) revised full size sheets included in this addendum for revisions.

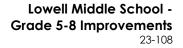



58. Sheet E-701

A. Refer to revised full size sheets included in this addendum for revisions.

1. modification of Existing Panel "RDPB" in lieu of replacing it.

59. Sheet E-702

- A. Refer to revised full size sheet included in this addendum for the following revisions:
 - 1. Modify the Existing Panel "RDPB" by adding two (2) 3P-200 Amp Fusible Switches. Provide 200 Amp fuses in one and label the other as a spare.

Pages 1 through 7, inclusive, Specification Section 07 42 63, revised Specification Section 27 51 23, and fifty two(52) Full-Size Drawings, constitute the total makeup of **Addendum Three**.



P. Brig 108 Tr Creek SC - Lowell MS 5-8 Improvements\Specs\Addendum 3\AD03 Lowell MS.docx



SECTION 07 42 63 METAL PANEL SIDING - FIELD ASSEMBLED

1 General

1.1 Section Includes

A. Field assembled preformed metal wall panels - deep ribs, related flashings, and accessory components.

1.2 Related Sections

- A. Section 05 12 00 Structural Steel: Structural steel frame.
- B. Section 05 50 00 Miscellaneous Metals: Steel girts and steel supports.
- C. Section 07 42 44 Composite Metal Panels.

1.3 References

- A. ASTM A153 Zinc Coating (Hot-Dip) on Iron and Steel Hardware.
- B. ASTM E72 Strength Tests of Panels for Building Construction.

1.4 Performance

- A. Preformed metal panel system to withstand code imposed design loads in accordance with ASTM E72.
 - 1. Maximum Allowable Deflection of Span: 1/180.
 - 2. Design Uniform Wind Load: In accordance with requirements of Indiana Building Code applicable codes.
- B. System to accommodate movement of components without buckling, failure of joint seals, undue stress on fasteners, or other detrimental effects, when subject to seasonal temperature ranges.
- C. System to accommodate tolerances of structure.
- D. Provide positive drainage to exterior for moisture entering or condensation occurring within panel system.

1.5 Submittals

- A. Submit shop drawings and product data under provisions of Division 1.
- B. Indicate materials, dimensions, panel layout, construction details, method of anchorage, method of installation, and closures.
- C. Submit manufacturer's available color samples for selection under provisions of Division 1.



D. Submit manufacturer's installation instructions under provisions of Division 1.

1.6 Delivery, Storage, And Handling

- A. Handle all materials carefully to avoid damage to surface coatings.
- B. Protect materials from traffic, dirt, and stains.
- C. Cover materials at job site until installed.

1.7 Warranty

A. Provide ten (10) year warranty on finish against failures due to noticeable checking, peeling, blistering, and chalking.

2 Products

- 2.1 Field Assembled Metal Panel Siding Acceptable Manufacturers
 - A. Centria, Pittsburgh, Pennsylvania.
 - B. MBCI, Shelbyville, Indiana.

2.2 Sheet Materials

A. Sheet Stock: Aluminum; 3003-H14, 0.050-inch gauge.

2.3 Materials

- A. Sealants and Gaskets: Manufacturer's standard type suitable for use with installation of metal panel system; non-staining; non-shrinking and non-sagging; ultra-violet and ozone resistant for exterior applications; color as selected.
- B. Fasteners: Manufacturer's standard exposed type to suit application; stainless steel fasteners with color-matching heads to finish of metal panels.
- C. Sub-Girts: 20 gage steel, zinc-coated to 1.25 ounces per square foot coating in accordance with ASTM A153; Only as required by manufacturer design currently provides support system sufficient to comply with manufacturers requireemnts.
- D. Touch-up Paint: As recommended by panel manufacturer.
- E. Bituminous Paint: As recommended by panel manufacturer.

2.4 Fabrication

- A. Exterior Wall Panels: Minimum 0.050-inch gage aluminum sheet stock; profile as indicated; 36 inches wide, 3" deep, rib spacing 3 at 12" O.C.; interlocking edges fitted with continuous gaskets or filled with sealant.
 - 1. Profile: Centria, MR3-36.
- B. Internal and External Corners: Same material, thickness, and finish as metal panels; profile to suit system; shop cut and factory mitered to required angles.



- C. Trim, Closure Pieces, Fascias, and Caps: Same material, thickness, and where exposed, of same finish as sheet stock; brake formed to required profiles.
- D. Fabricate panels in lengths to eliminate horizontal joints.
 - 1. Countersink end laps or butt with lap strips.
- E. Fabrication of component profiles on site not permitted.

2.5 Finish

- A. Exposed Surfaces: 1.0 mil thick, 70 percent Kynar 500 type finish, over minimum 0.2 mil baked-on modified epoxy primer; of **custom color** as provided by Architect.
- B. Reverse Side: Wash coat of 0.3 to 0.4 mil dry film thickness as standard with the manufacturer..

3 Execution

3.1 Inspection

A. Beginning of installation means acceptance of existing conditions.

3.2 Installation

- A. Install metal panel system on walls in accordance with manufacturer's instructions.
- B. Protect panel surfaces in contact with cementitious materials and dissimilar metals with bituminous paint.
 - 1. Allow to dry prior to installation.
- C. Remove site cuttings from finish surfaces.
- D. Permanently fasten panel system to structural supports; align, level, and plumb, within specified tolerances.
- E. Locate panel joints over supports.
 - 1. End lap panels minimum 2 inches, or as recommended by the manufacturer.
- F. Use concealed fasteners unless otherwise approved by the Architect.
- G. Seal and place gaskets to prevent weather penetration and to make installation air tight.
 - 1. Maintain neat appearance.
- H. Clean all surfaces immediately after erection.



3.3 Tolerances

- A. Maximum Offset From True Alignment Between Adjacent Members Butting or In Line: 1/16 inch.
- B. Maximum Variation from Plane or Location Indicated on Drawings: 1/8 inch.

END OF SECTION



SECTION 27 51 23 SCHOOL INTERCOMMUNICATIONS SYSTEMS

1 General

1.1 General

A. The provisions of Section 27 05 01 apply to the work in this Section and are part of these specifications.

1.2 Summary

- A. Section Includes:
 - 1. Extending Existing School Intercommunications Sound System into the new addition and renovatef areas of the building.

1.3 Related Sections:

- 1. Section 27 05 00 Communications Systems Electrical Requirements
- 2. Section 27 05 01 Basic Communication Systems Requirements.
- 3. Section 27 15 00 Voice, Data, and Video Cabling Infrastructure.
- 4. Section 27 41 16 Indoor Sound Reinforcement Systems.

1.4 Products Furnished But Not Installed Under This Section

- A. Intercommunications system enclosures, enclosure supports, backboxes, and cabinets.
- B. Furnish the items listed in Paragraph 1.2 B. to the Contractor responsible for Section 27 05 00 for installation by that Contractor.

1.5 Scope Of Work

- A. Provide all labor, materials and equipment required for the extension of the existing school intercommunications sound system throughout the new addition and renovated areas of the building as indicated in the Contract Documents. Modify or replace Existing School Intercommunications System Equipment as necessary to accommodate the new equipment and devices being added.
- B. All existing features and functions of the existing system are to be maintained throughout the building unless specifically indicated otherwise in the Contract Documents.



- C. Remove the existing school intercommunications sound system equipment, call-in switches, microphone inputs, cabling, etc. no longer required in the renovated areas of the building. Stub and cap all concealed existing system conduit that is not reused.
- D. It is the responsibility of this Contractor to ensure that all new equipment connected to the existing system is compatible and will operate properly with the existing system equipment, and that all existing system equipment is completely functional.
- E. Keep the existing school intercommunications sound system operational at all times during school operating hours. Make all system changes or shutdowns so as to provide minimum of interference with the operation of facility. Notify the Owner not less than 24 hours in advance of a shutdown/changeover and obtain approval from the Owner and Construction Manager.

1.6 System Description

- A. System providing separate, individual speaker station line circuits to to each loudspeaker or group of loudspeakers in a room, to each exterior loudspeaker, and to each group of loudspeakers in each corridors.
 - 1. Provide quantity of internal circuits for speaker station lines as required to serve the building as indicated in this Section and on the Drawings.
 - 2. Provide the quantity of volume controls as shown on the Drawings.

1.7 System Performance

A. Match Existing.

2 Products

2.1 Acceptable Manufacturers and Equipment

- A. MGeneral Equipment to match Existing.
- B. Gymnasium School Intercommunicaitons System Loundspeakers
 - 1. Atlas Sound
 - 2. Lowell

2.2 System Equipment

A. General - Match Existing.



- B. Bi-Directional Wall Mount Loudspeaker Assembly:
 - Loudspeaker and Transformer Assembly: Loudspeaker shall have an eight inch diameter cone, permanent magnet type loudspeaker having a minimum sensitivity of at least 95 dB SPL at 4 feet from 1 watt input power, a minimum program material power rating of at least 15 watts, a ceramic magnet with a minimum weight of 4.8 ounce, and frequency response uniform from 65 to 12,000 Hz. Quantity as indicated on Drawings; Atlas Sound Model C5A, Lowell Model 805, or approved equa that is compatible with existing systeml.
 - 2. Transformer: Loudspeaker transformer capable of delivering within plus or minus 1.5 dB of full rated power from 100 to 10,000 Hz with less than 1.5 dB insertion loss and less than 1.5 percent induced distortion, primary power taps rating of 1/4, 1/2, 1, 2, and 4 watts for 25 and 70 volt distribution lines, and the secondary rated for 8 ohms. Provide one unit per loudspeaker; Atlas Sound Model LT-72, Lowell Model TLM572, or approved equal that is compatible with existing system.
 - 3. Enclosure/Baffle: Designed to properly mount 8 inch diameter loudspeakers. Constructed of 20 gage aluminum with brushed (satin) aluminum finish. Provide one unit for each wall mounted bi-directional loudspeaker; Atlas Sound Model 512-8, Lowell Model MCLB-8, or approved equal that is compatible with existing system.

2.3 System Volume Controls, Loudspeakers, and Stations

A. Match Existing.

2.4 Sound System Cables

A. Match Existing.

3 Execution

3.1 Installation

- A. Refer to Sections 27 05 00 and 27 05 01 for additional installation and wiring requirements.
- B. Cabling:
 - 1. Provide a separate loudspeaker cable to each loudspeaker or group of loudspeakers in a room and each group of loudspeakers in each corridor.
 - a. Connect restroom speakers to the adjacent corridor speaker circuits.
 - 2. Provide the appropriate cabling from the volume controls to the speakers.



3.2 System Adjustments, Tests And Measurements

- A. General:
 - 1. Perform all equipment and system adjustments, tests, and measurements specified in the Contract Documents. Perform the specified adjustments, tests, and measurements to each system specified in this Section unless otherwise noted in the Contract Documents. Testing is the sole responsibility of this Contractor.

END OF SECTION


PROJECT: ADDITIONS, RENOVATIONS, AND RELATED WORK TO LOWELL MIDDLE SCHOOL GRADE 5-8 IMPROVEMENTS TRI-CREEK SCHOOL CORPORATION LOWELL, INDIANA



LOWELL



VICINITY MAP

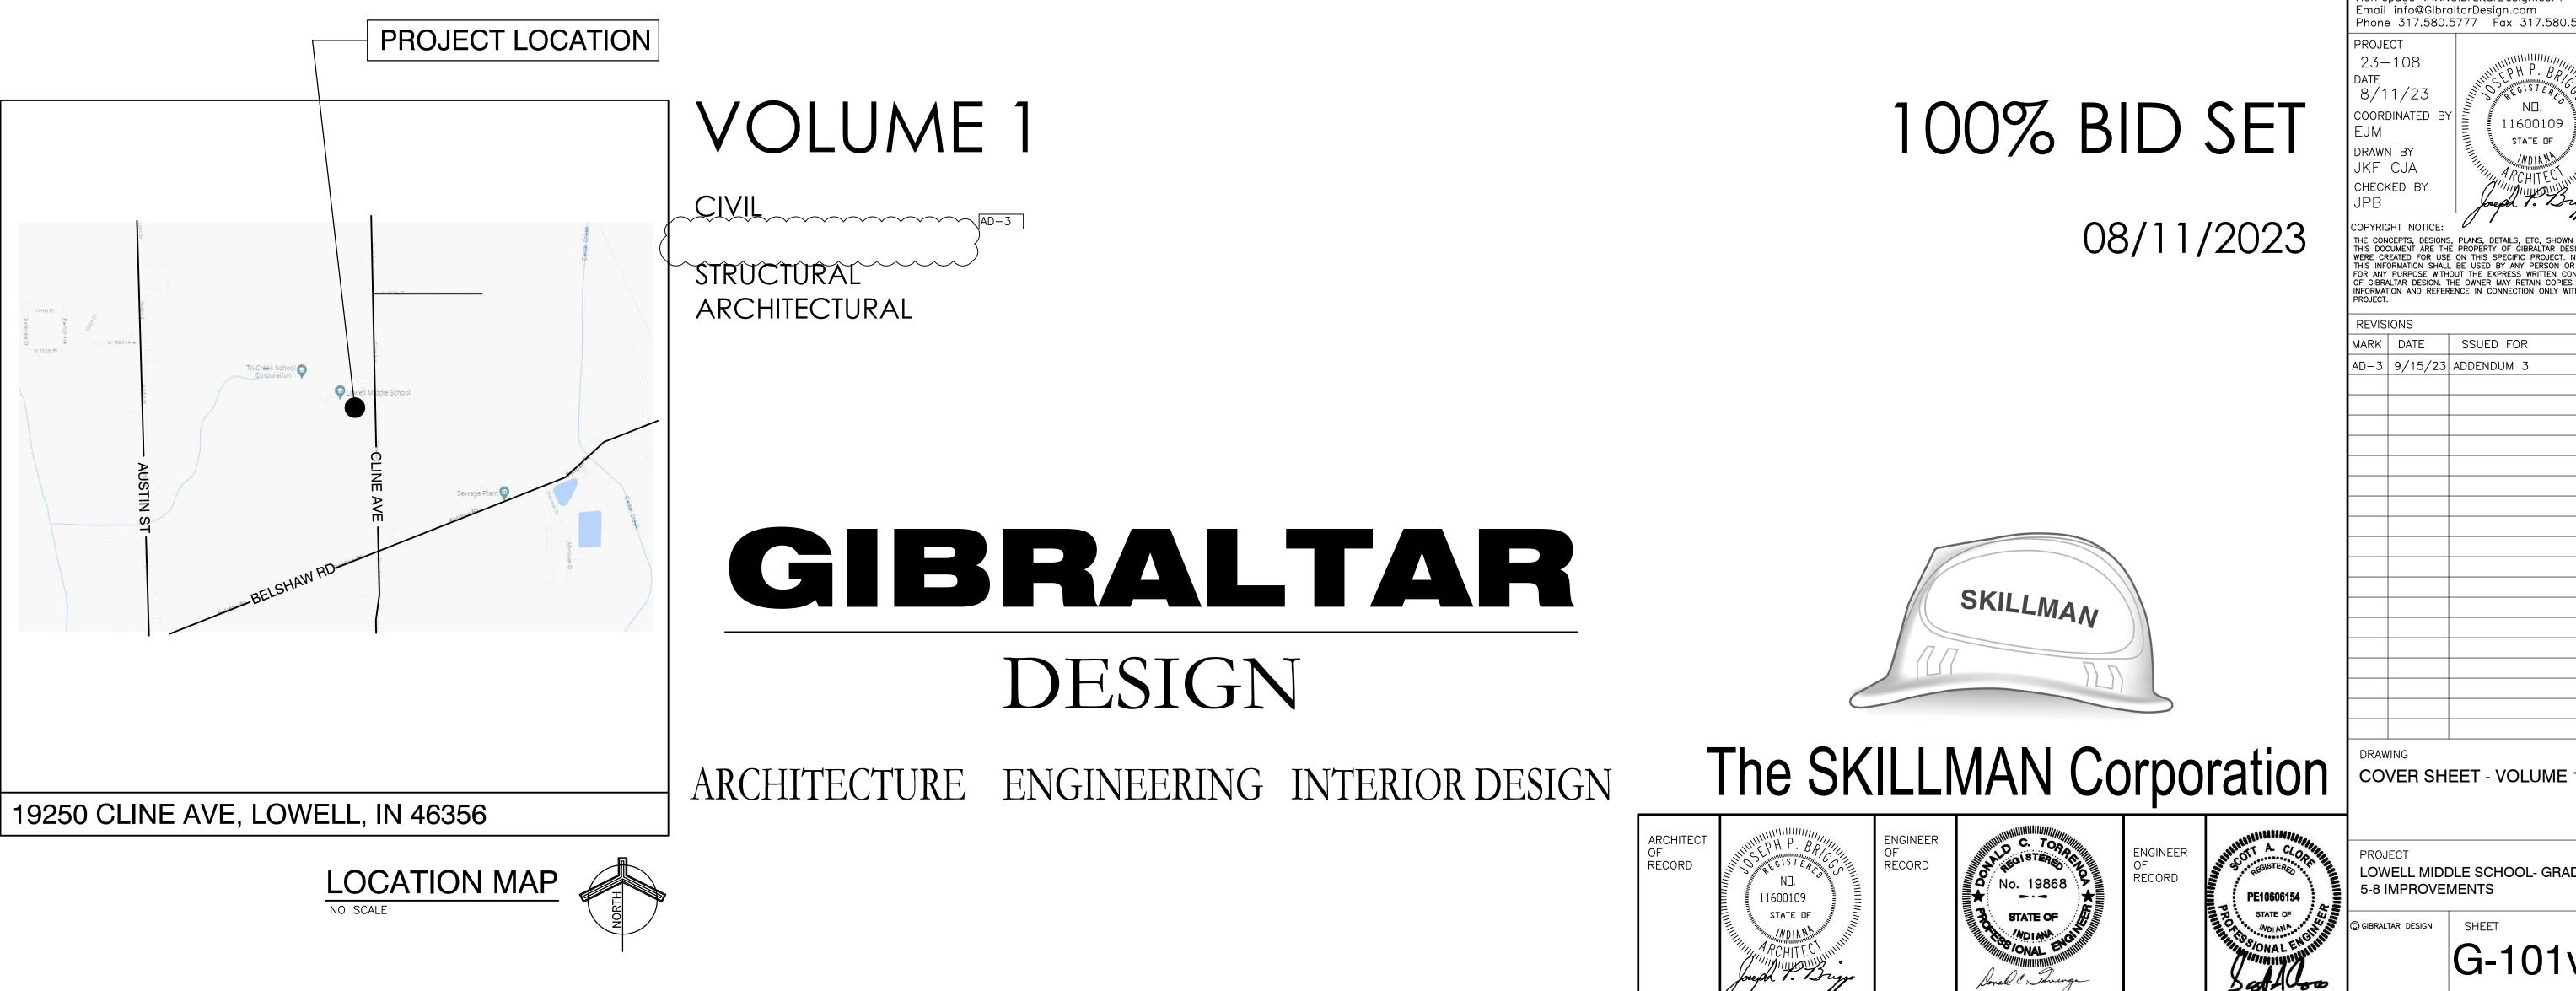

/, 9/12/2023 - 3:59 PM - LAST SAVED
108 TRI-CREEK SC - LOWELL MS 5-8
EMENTS\23-108 DRAWINGS\02 GENR\G-1


AD-3



PROJECT: ADDITIONS, RENOVATIONS, AND RELATED WORK TO LOWELL MIDDLE SCHOOL GRADE 5-8 IMPROVEMENTS TRI-CREEK SCHOOL CORPORATION LOWELL, INDIANA



LOWELL

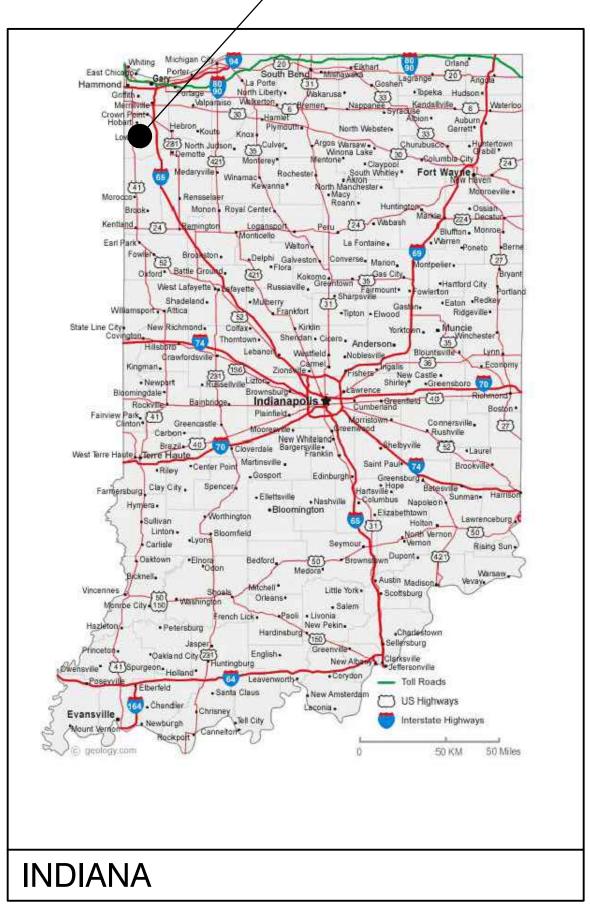



VICINITY MAP



VOLUME 2

MECHANICAL FIRE PROTECTION PLUMBING ELECTRICAL






100% BID SET


AD-3

08/11/2023

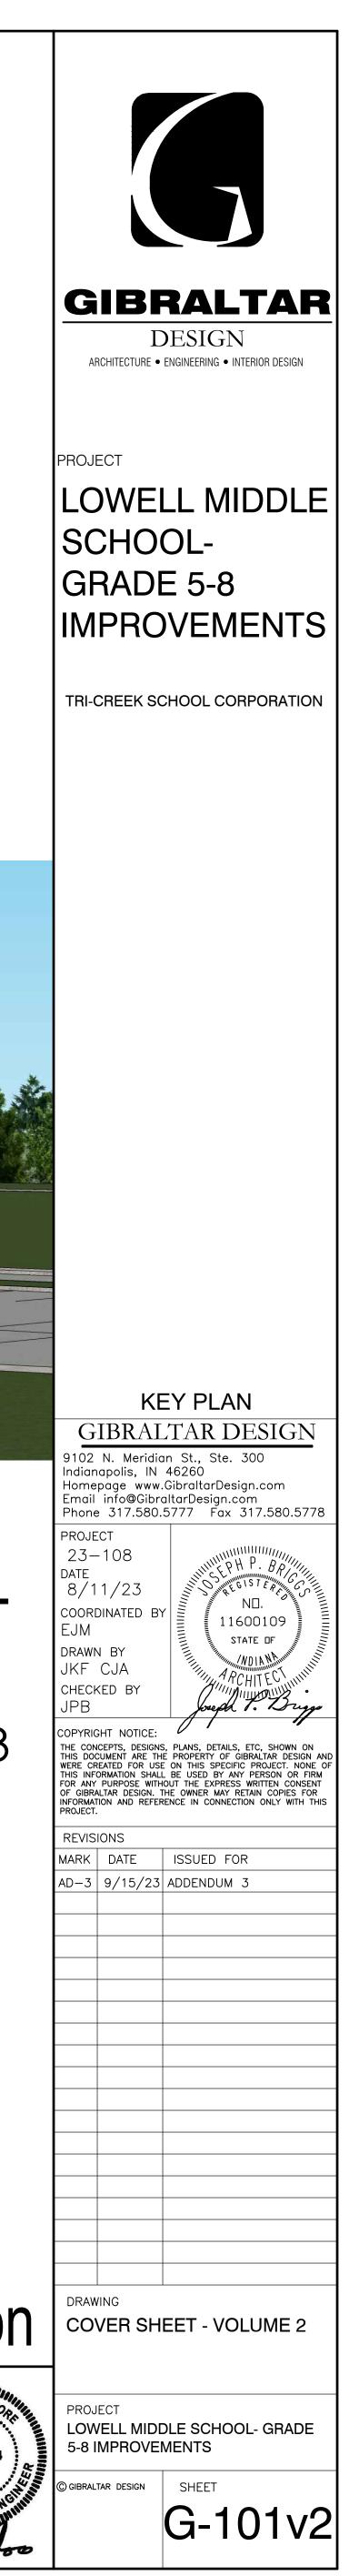


G	GENERAL G-101v1 COVER SHEET - VOLUME 1 G-102v1 SHEET INDEX - VOLUME 1 G-201 FIRST FLOOR LIFE SAFETY PLAN G-202 SECOND FLOOR LIFE SAFETY PLAN G-301 TYPICAL ACCESSIBLE MOUNTING HEIGHTS, ABBREVIATIONS, SYMBOLOGY, AND LEGEND CIVIL
	C-1.0 EXISTING TOPOGRAPHY & UTILITIES C-1.1 DEMOLITION PLAN C-2.0 SITE PLAN C-3.0 GRADING & UTILITIES PLAN C-4.0 DETAILS & SPECIFICATIONS C-4.1 DETAILS & SPECIFICATIONS C-5.0 STORM WATER POLLUTION PREVENTION PLAN (SWPPP) C-6.0 SWPPP DETAILS & SPECIFICATIONS
S	S-001 STRUCTURAL NOTES S-201 FOUNDATION PLAN S-202 ROOF FRAMING PLAN S-401 TYPICAL FOUNDATION DETAILS S-402 STRUCTURAL FOUNDATION SECTIONS S-403 TYPICAL MASONRY DETAILS S-411 TYPICAL FRAMING DETAILS S-412 STRUCTURAL FRAMING SECTIONS
A	AD101 UNIT "A" ARCHITECTURAL FIRST FLOOR DEMOLITION PLAN AD102 UNIT "B" ARCHITECTURAL FIRST FLOOR DEMOLITION PLAN AD103 UNIT "C" ARCHITECTURAL FIRST FLOOR DEMOLITION PLAN AD104 UNIT "D" ARCHITECTURAL FIRST FLOOR DEMOLITION PLAN AD105 UNIT "E" ARCHITECTURAL FIRST FLOOR DEMOLITION PLAN AD106 NOT USED AD107 NOT USED
	 AD108 UNIT "C" ARCHITECTURAL SECOND FLOOR DEMOLITION PLAN AD109 UNIT "D" ARCHITECTURAL SECOND FLOOR DEMOLITION PLAN AD110 UNIT "E" ARCHITECTURAL FIRST FLOOR PLAN – ALTERNATE BID A-101 UNIT "A" ARCHITECTURAL FIRST FLOOR PLAN A-102 UNIT "B" ARCHITECTURAL FIRST FLOOR PLAN A-103 UNIT "C" ARCHITECTURAL FIRST FLOOR PLAN A-104 UNIT "D" ARCHITECTURAL FIRST FLOOR PLAN A-105 UNIT "E" ARCHITECTURAL FIRST FLOOR PLAN A-106 NOT USED
	 A 100 NOT USED A-107 NOT USED A-108 UNIT "C" ARCHITECTURAL SECOND FLOOR PLAN A-109 UNIT "D" ARCHITECTURAL SECOND FLOOR PLAN A-110 UNIT "E" ARCHITECTURAL SECOND FLOOR PLAN A-111 UNIT "F" ARCHITECTURAL SECOND FLOOR PLAN - ALTERNATE BID A-201 OVERALL ARCHITECTURAL ROOF PLAN A-202 ENLARGED ROOF PLAN - ALTERNATE BID A-210 ROOF DETAILS A-211 ROOF DETAILS A-212 ROOF DETAILS
	 A-301 OVERALL EXTERIOR ELEVATIONS A-310 EXTERIOR ELEVATIONS A-311 EXTERIOR ELEVATIONS A-312 EXTERIOR ELEVATIONS A-410 WALL SECTIONS A-411 WALL SECTIONS A-412 WALL SECTIONS A-413 WALL SECTIONS A-414 WALL SECTIONS
	A=501 TYPICAL DETAILS A-502 SIGN PLAN, ELEVATIONS AND SECTIONS A-601 DOOR SCHEDULE, FRAME PROFILES, ELEVATIONS, AND METAL FRAME DETAILS A-610 WINDOW AND STOREFRONT ELEVATIONS AND DETAILS A-700 UNIT "F" FIRST FLOOR EQUIPMENT PLAN – ALTERNATE BID A-701 NOT USED A-702 UNIT "B" FIRST FLOOR EQUIPMENT PLAN A-703 UNIT "C" FIRST FLOOR EQUIPMENT PLAN
	 A-704 UNIT "D" FIRST FLOOR EQUIPMENT PLAN A-705 UNIT "E" FIRST FLOOR EQUIPMENT PLAN A-706 NOT USED A-708 NOT USED A-709 UNIT "D" SECOND FLOOR EQUIPMENT PLAN A-710 NOT USED A-720 ENLARGED RESTROOM PLANS A-730 CASEWORK SCHEDULE AND ELEVATIONS
	A-760 MILLWORK ENLARGED PLANS, ELEVATIONS AND DETAILS A-800 UNIT "F" FIRST FLOOR FINISH PLAN – ALTERNATE BID A-801 UNIT "A" FIRST FLOOR FINISH PLAN A-802 UNIT "B" FIRST FLOOR FINISH PLAN A-803 UNIT "C" FIRST FLOOR FINISH PLAN A-804 UNIT "D" FIRST FLOOR FINISH PLAN A-805 UNIT "E" FIRST FLOOR FINISH PLAN A-806 NOT USED A-807 NOT USED
	A=807 NOT USED A=808 UNIT "C" SECOND FLOOR FINISH PLAN A=809 UNIT "D" SECOND FLOOR FINISH PLAN A=810 UNIT "E" SECOND FLOOR FINISH PLAN A=820 FINISH LEGEND A=840 GYMNASIUM COURT MARKING PLAN A=860 INTERIOR ELEVATIONS A=861 INTERIOR ELEVATIONS
	 A-900 UNIT "F" ARCHITECTURAL FIRST FLOOR REFLECTED CEILING PLAN - ALTERNATE B A-901 UNIT "A" ARCHITECTURAL FIRST FLOOR REFLECTED CEILING PLAN A-902 UNIT "B" ARCHITECTURAL FIRST FLOOR REFLECTED CEILING PLAN A-903 UNIT "C" ARCHITECTURAL FIRST FLOOR REFLECTED CEILING PLAN A-904 UNIT "D" ARCHITECTURAL FIRST FLOOR REFLECTED CEILING PLAN A-905 UNIT "E" ARCHITECTURAL FIRST FLOOR REFLECTED CEILING PLAN A-906 NOT USED A-907 NOT USED A-908 UNIT "C" ARCHITECTURAL SECOND FLOOR REFLECTED CEILING PLAN A-909 UNIT "D" ARCHITECTURAL SECOND FLOOR REFLECTED CEILING PLAN
	A—910 UNIT "E" ARCHITECTURAL SECOND FLOOR REFLECTED CEILING PLAN


SHEE	TINDEX - VOLUME 2
	ERAL v2 COVER SHEET – VOLUME 2 2v2 SHEET INDEX – VOLUME 2
M-00 MD101 MD102 MD103 MD104 MD105 MD106 MD107 MD108 MD107 MD108 MD107 MD108 MD107 MD108 MD107 MD108 MD107 MD108 MD107 MD108 MD107 MD108 MD107 MD108 MD107 MD108 MD107 MD108 MD107 MD108 MD107 MD108 MD107 MD108 MD107 MD108 MD107 MD108 MD107 MD108 MD107 MD108 MD107 MD108 MD108 MD107 MD108 MD1	 NOT USED UNIT "C" FIRST FLOOR MECHANICAL DEMOLITION PLAN UNIT "D" FIRST FLOOR MECHANICAL DEMOLITION PLAN NOT USED NOT USED NOT USED UNIT "D" SECOND FLOOR MECHANICAL DEMOLITION PLAN NOT USED UNIT "F" FIRST FLOOR MECHANICAL DEMOLITION PLAN NOT USED UNIT "F" FIRST FLOOR MECHANICAL PLAN - ALTERNATE UNIT "A" FIRST FLOOR MECHANICAL PLAN NOT USED UNIT "C" FIRST FLOOR MECHANICAL PLAN UNIT "C" FIRST FLOOR MECHANICAL PLAN UNIT "C" FIRST FLOOR MECHANICAL PLAN UNIT "D" FIRST FLOOR MECHANICAL PLAN UNIT "D" SECOND FLOOR MECHANICAL PLAN UNIT "D" SECOND FLOOR MECHANICAL PLAN NOT USED NOT USED NOT USED NOT USED NOT USED PARTIAL MECHANICAL ROOF PLAN
FP001	PROTECTION GENERAL FIRE PROTECTION NOTES, LEGEND, DETAILS AND SCHEDULES FIRE PROTECTION FLOOR PLANS
P-00 PD101 PD102 PD103	NOT USED NOT USED UNIT "D" FOUNDATION PLUMBING DEMOLITION PLAN NOT USED NOT USED UNIT "B" FIRST FLOOR PLUMBING DEMOLITION PLAN UNIT "C" FIRST FLOOR PLUMBING DEMOLITION PLAN UNIT "D" FIRST FLOOR PLUMBING DEMOLITION PLAN NOT USED NOT USED NOT USED
P-202 P-203 P-203 P-203 P-203 P-203 P-203 P-203 P-203 P-203	UNIT "E" SECOND FLOOR PLUMBING DEMOLITION PLAN UNIT "F" FOUNDATION PLUMBING PLAN – ALTERNATE NOT USED NOT USED UNIT "D" FOUNDATION PLUMBING PLAN NOT USED UNIT "F" FIRST FLOOR PLUMBING PLAN – ALTERNATE UNIT "A" FIRST FLOOR PLUMBING PLAN UNIT "A" FIRST FLOOR PLUMBING PLAN UNIT "C" FIRST FLOOR PLUMBING PLAN UNIT "C" FIRST FLOOR PLUMBING PLAN UNIT "D" FIRST FLOOR PLUMBING PLAN NOT USED NOT USED NOT USED NOT USED
E E E E E E E E E E E E E E E E E E E	 FURCEAL SYMBOLS, SCHEDULES, DETAILS AND NOTES ELECTRICAL DEMOLITION SITE PLANS ELECTRICAL DEMOLITION SITE PLANS ELECTRICAL SITE PLANS UNT "A" ELECTRICAL FIRST FLOOR DEMOLITION LICHTING PLANS UNT "A" ELECTRICAL FIRST FLOOR DEMOLITION LICHTING PLANS UNT "C" ELECTRICAL SECOND FLOOR DEMOLITION POWER PLANS UNT "C" ELECTRICAL FIRST FLOOR DEMOLITION POWER PLANS UNT "C" ELECTRICAL SECOND FLOOR DEMOLITION POWER PLANS UNT "C" ELECTRICAL FIRST FLOOR LIGHTING PLAN - ALTERNATE UNT "C" ELECTRICAL SECOND FLOOR LIGHTING PLANS UNT "C" ELECTRICAL SECOND FLOOR LIGHTING PLANS UNT "C" ELECTRICAL FIRST FLOOR LIGHTING PLANS UNT "C" ELECTRICAL SECOND FLOOR LIGHTING PLANS UNT "C" ELECTRICAL SECOND FLOOR LIGHTING PLANS UNT "C" ELECTRICAL SECOND FLOOR LIGHTING PLANS UNT "C" ELECTRICAL FIRST FLOOR LIGHTING PLANS UNT "C" ELECTRICAL SECOND FLOOR LIGHTING PLANS UNT "C" ELECTRICAL SECOND FLOOR LIGHTING PLANS - ALTERNATE UNT "C" ELECTRICAL FIRST FLOOR LIGHTING PLANS - ALTERNATE UNT "C" ELECTRICAL FIRST FLOOR UNDER PLANS - ALTERNATE UNT "C" ELECTRICAL FIRST FLOOR UNDER PLANS - ALTERNATE UNT "C" ELECTRICAL FIRST FLOOR PUWER PLANS - ALTERNATE<

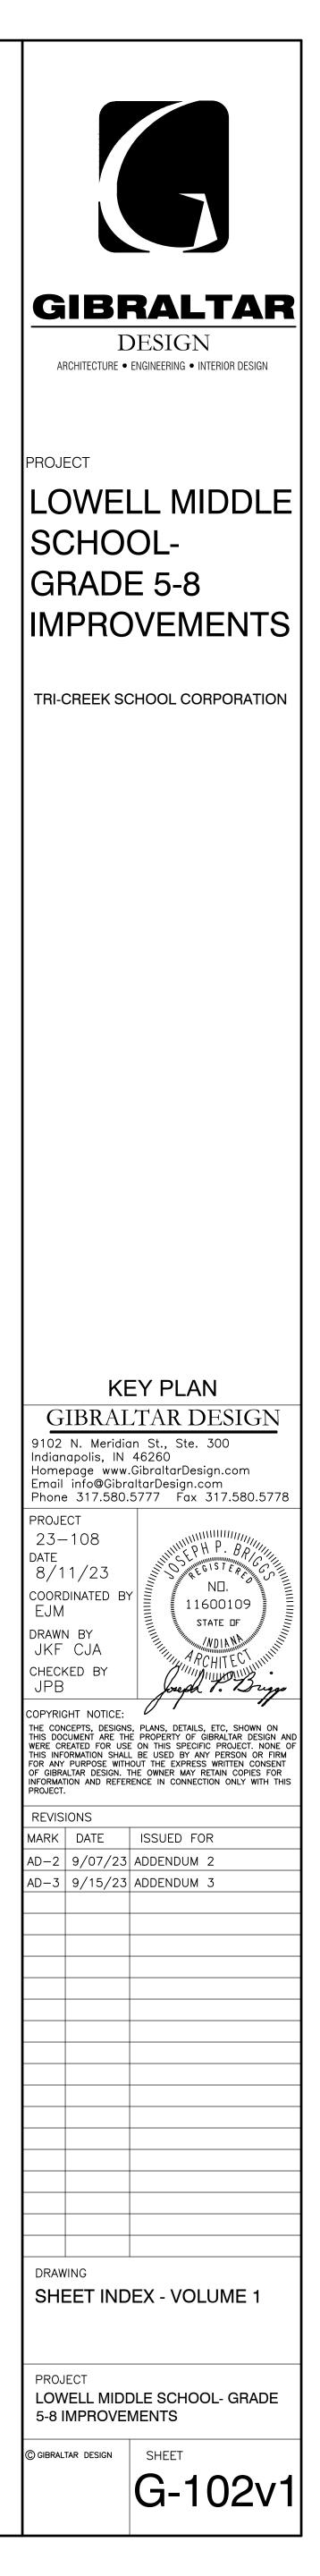


G	GENEF G-101v1	RAL 1 COVER SHEET - VOLUME 1
	G-201 G-202	SECOND FLOOR LIFE SAFETY PLAN TYPICAL ACCESSIBLE MOUNTING HEIGHTS, ABBREVIATIONS,
С	C-1.0 C-1.1 C-2.0 C-3.0 C-4.0 C-4.1 C-5.0	EXISTING TOPOGRAPHY & UTILITIES DEMOLITION PLAN SITE PLAN GRADING & UTILITIES PLAN DETAILS & SPECIFICATIONS DETAILS & SPECIFICATIONS STORM WATER POLLUTION PREVENTION PLAN (SWPPP)
~~~~	~~~~~~~~~~~~~~~~~~~~~~~~~~~~~~~~~~~~~~	SWPPP DETAILS & SPECIFICATIONS
S		CTURAL
•	S-001 S-201 S-202 S-401 S-402 S-403 S-411 S-412	FOUNDATION PLAN ROOF FRAMING PLAN TYPICAL FOUNDATION DETAILS STRUCTURAL FOUNDATION SECTIONS TYPICAL MASONRY DETAILS TYPICAL FRAMING DETAILS
A	AD101 AD102 AD103 AD104 AD105 AD106	TECTURAL UNIT "A" ARCHITECTURAL FIRST FLOOR DEMOLITION PLAN UNIT "B" ARCHITECTURAL FIRST FLOOR DEMOLITION PLAN UNIT "C" ARCHITECTURAL FIRST FLOOR DEMOLITION PLAN UNIT "D" ARCHITECTURAL FIRST FLOOR DEMOLITION PLAN UNIT "E" ARCHITECTURAL FIRST FLOOR DEMOLITION PLAN NOT USED
	AD107 AD108 AD109 AD110 A-100 A-101 A-102 A-103	NOT USED UNIT "C" ARCHITECTURAL SECOND FLOOR DEMOLITION PLAN UNIT "D" ARCHITECTURAL SECOND FLOOR DEMOLITION PLAN UNIT "E" ARCHITECTURAL FIRST FLOOR PLAN – ALTERNATE BID UNIT "A" ARCHITECTURAL FIRST FLOOR PLAN UNIT "B" ARCHITECTURAL FIRST FLOOR PLAN UNIT "B" ARCHITECTURAL FIRST FLOOR PLAN UNIT "C" ARCHITECTURAL FIRST FLOOR PLAN UNIT "D" ARCHITECTURAL FIRST FLOOR PLAN
	A-104 A-105 A-106 A-107 A-108 A-109 A-110 A-111	UNIT "E" ARCHITECTURAL FIRST FLOOR PLAN NOT USED NOT USED UNIT "C" ARCHITECTURAL SECOND FLOOR PLAN UNIT "D" ARCHITECTURAL SECOND FLOOR PLAN UNIT "E" ARCHITECTURAL SECOND FLOOR PLAN UNIT "F" ARCHITECTURAL SECOND FLOOR PLAN – ALTERNATE BID
		OVERALL ARCHITECTURAL ROOF PLAN ENLARGED ROOF PLAN – ALTERNATE BID ROOF DETAILS ROOF DETAILS ROOF DETAILS
	A-301 A-310 A-311 A-312	OVERALL EXTERIOR ELEVATIONS EXTERIOR ELEVATIONS EXTERIOR ELEVATIONS EXTERIOR ELEVATIONS WALL SECTIONS
	A-411 A-412 A-413 A-414	WALL SECTIONS WALL SECTIONS WALL SECTIONS WALL SECTIONS
(	A=501 A=502 A=601 A=610	TYPICAL DETAILS SIGN PLAN, ELEVATIONS AND SECTIONS AD-3 DOOR SCHEDULE, FRAME PROFILES, ELEVATIONS, AND METAL FRAME DETAILS WINDOW AND STOREFRONT ELEVATIONS AND DETAILS
		UNIT "C" FIRST FLOOR EQUIPMENT PLAN UNIT "D" FIRST FLOOR EQUIPMENT PLAN UNIT "E" FIRST FLOOR EQUIPMENT PLAN NOT USED NOT USED NOT USED UNIT "D" SECOND FLOOR EQUIPMENT PLAN
	A-710 A-720 A-730	NOT USED ENLARGED RESTROOM PLANS CASEWORK SCHEDULE AND ELEVATIONS
	A-802 A-803 A-804 A-805	MILLWORK ENLARGED PLANS, ELEVATIONS AND DETAILS UNIT "F" FIRST FLOOR FINISH PLAN – ALTERNATE BID UNIT "A" FIRST FLOOR FINISH PLAN UNIT "B" FIRST FLOOR FINISH PLAN UNIT "C" FIRST FLOOR FINISH PLAN UNIT "D" FIRST FLOOR FINISH PLAN
	A-806 A-807 A-808 A-809 A-810 A-820 A-840	NOT USED NOT USED UNIT "C". SECOND FLOOR FINISH PLAN UNIT "E" SECOND FLOOR FINISH PLAN FINISH LEGEND GYMNASIUM COURT MARKING PLAN
	A-860 A-861 A-900 A-901 A-902 A-903 A-904	INTERIOR ELEVATIONS INTERIOR ELEVATIONS UNIT "F" ARCHITECTURAL FIRST FLOOR REFLECTED CEILING PLAN – ALTERNATE UNIT "A" ARCHITECTURAL FIRST FLOOR REFLECTED CEILING PLAN UNIT "B" ARCHITECTURAL FIRST FLOOR REFLECTED CEILING PLAN UNIT "C" ARCHITECTURAL FIRST FLOOR REFLECTED CEILING PLAN UNIT "D" ARCHITECTURAL FIRST FLOOR REFLECTED CEILING PLAN
	A-904 A-905 A-906 A-907 A-908 A-909 A-910	UNIT "E" ARCHITECTURAL FIRST FLOOR REFLECTED CEILING PLAN NOT USED NOT USED UNIT "C" ARCHITECTURAL SECOND FLOOR REFLECTED CEILING PLAN

SHEET INDEX - VOLUME 2
G GENERAL G-101v2 COVER SHEET - VOLUME 2 G-102v2 SHEET INDEX - VOLUME 2 MECHANICAL
<ul> <li>M-001 GENERAL MECHANICAL NOTES AND LEGEND</li> <li>MD101 UNIT "A" FIRST FLOOR MECHANICAL DEMOLITION PLAN MD102 NOT USED</li> <li>MD103 UNIT "C" FIRST FLOOR MECHANICAL DEMOLITION PLAN MD104 UNIT "D" FIRST FLOOR MECHANICAL DEMOLITION PLAN MD105 NOT USED</li> <li>MD106 NOT USED</li> <li>MD107 NOT USED</li> <li>MD109 UNIT "D" SECOND FLOOR MECHANICAL DEMOLITION PLAN MD109 UNIT "D" SECOND FLOOR MECHANICAL DEMOLITION PLAN MD100 UNIT "F" FIRST FLOOR MECHANICAL PLAN – ALTERNATE</li> <li>M-100 UNIT "F" FIRST FLOOR MECHANICAL PLAN – ALTERNATE</li> <li>M-101 UNIT "A" FIRST FLOOR MECHANICAL PLAN M-102 NOT USED</li> <li>M-103 UNIT "C" FIRST FLOOR MECHANICAL PLAN M-104 UNIT "C" FIRST FLOOR MECHANICAL PLAN M-105 NOT USED</li> <li>M-104 UNIT "C" FIRST FLOOR MECHANICAL PLAN M-105 NOT USED</li> <li>M-105 NOT USED</li> <li>M-106 NOT USED</li> <li>M-107 NOT USED</li> <li>M-108 NOT USED</li> <li>M-108 NOT USED</li> <li>M-109 UNIT "D" SECOND FLOOR MECHANICAL PLAN</li> <li>M-101 NOT USED</li> <li>MR101 PARTIAL MECHANICAL ROOF PLAN</li> <li>MR101 PARTIAL MECHANICAL ROOF PLAN</li> <li>M-501 MECHANICAL DETAILS</li> <li>M-601 MECHANICAL EQUIPMENT SCHEDULES</li> </ul>
FPO01 GENERAL FIRE PROTECTION NOTES, LEGEND, DETAILS AND SCHEDULES FP101 FIRE PROTECTION FLOOR PLANS
PLUMBING         P-001       GENERAL PLUMBING NOTES, LEGEND AND SCHEDULES         PD101       NOT USED         PD102       NOT USED         PD103       NOT USED         PD104       UNIT "D" FOUNDATION PLUMBING DEMOLITION PLAN         PD105       NOT USED         PD201       NOT USED         PD202       UNIT "B" FIRST FLOOR PLUMBING DEMOLITION PLAN         PD203       UNIT "C" FIRST FLOOR PLUMBING DEMOLITION PLAN         PD204       UNIT "D" FIRST FLOOR PLUMBING DEMOLITION PLAN         PD204       UNIT "D" FIRST FLOOR PLUMBING DEMOLITION PLAN
PD205 NOT USED PD206 NOT USED PD207 NOT USED PD208 NOT USED PD209 NOT USED
P-100 UNIT "F" FOUNDATION PLUMBING PLAN - ALTERNATE P-101 NOT USED P-102 NOT USED P-103 NOT USED P-104 UNIT "D" FOUNDATION PLUMBING PLAN P-105 NOT USED P-106 NOT USED
<ul> <li>P-200 UNIT "F" FIRST FLOOR PLUMBING PLAN - ALTERNATE</li> <li>P-201 UNIT "A" FIRST FLOOR PLUMBING PLAN</li> <li>P-202 UNIT "B" FIRST FLOOR PLUMBING PLAN</li> <li>P-203 UNIT "C" FIRST FLOOR PLUMBING PLAN</li> <li>P-204 UNIT "D" FIRST FLOOR PLUMBING PLAN</li> <li>P-205 NOT USED</li> <li>P-206 NOT USED</li> <li>P-208 NOT USED</li> <li>P-209 NOT USED</li> <li>P-209 NOT USED</li> <li>P-210 UNIT "E" SECOND FLOOR PLUMBING PLAN</li> <li>P-501 PLUMBING DETAILS</li> </ul>
ELECTRICAL E-001 ELECTRICAL SYMBOLS, SCHEDULES, DETAILS AND NOTES E-002 OVERALL ELECTRICAL FLOOR PLANS

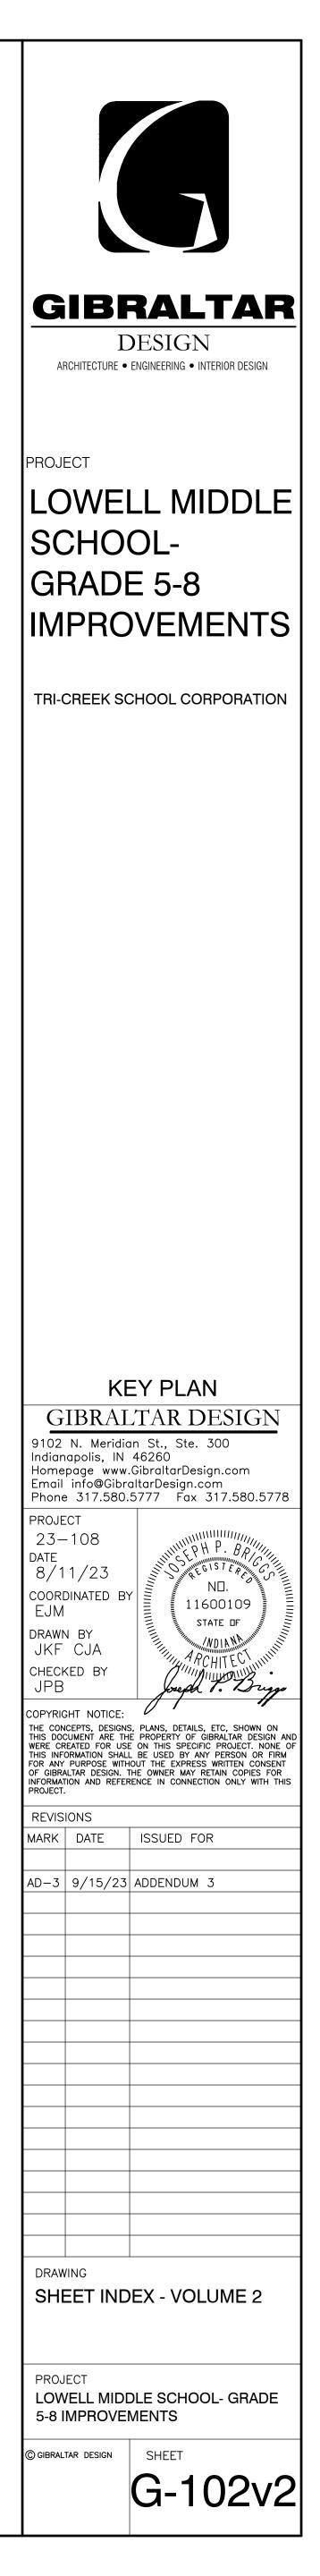

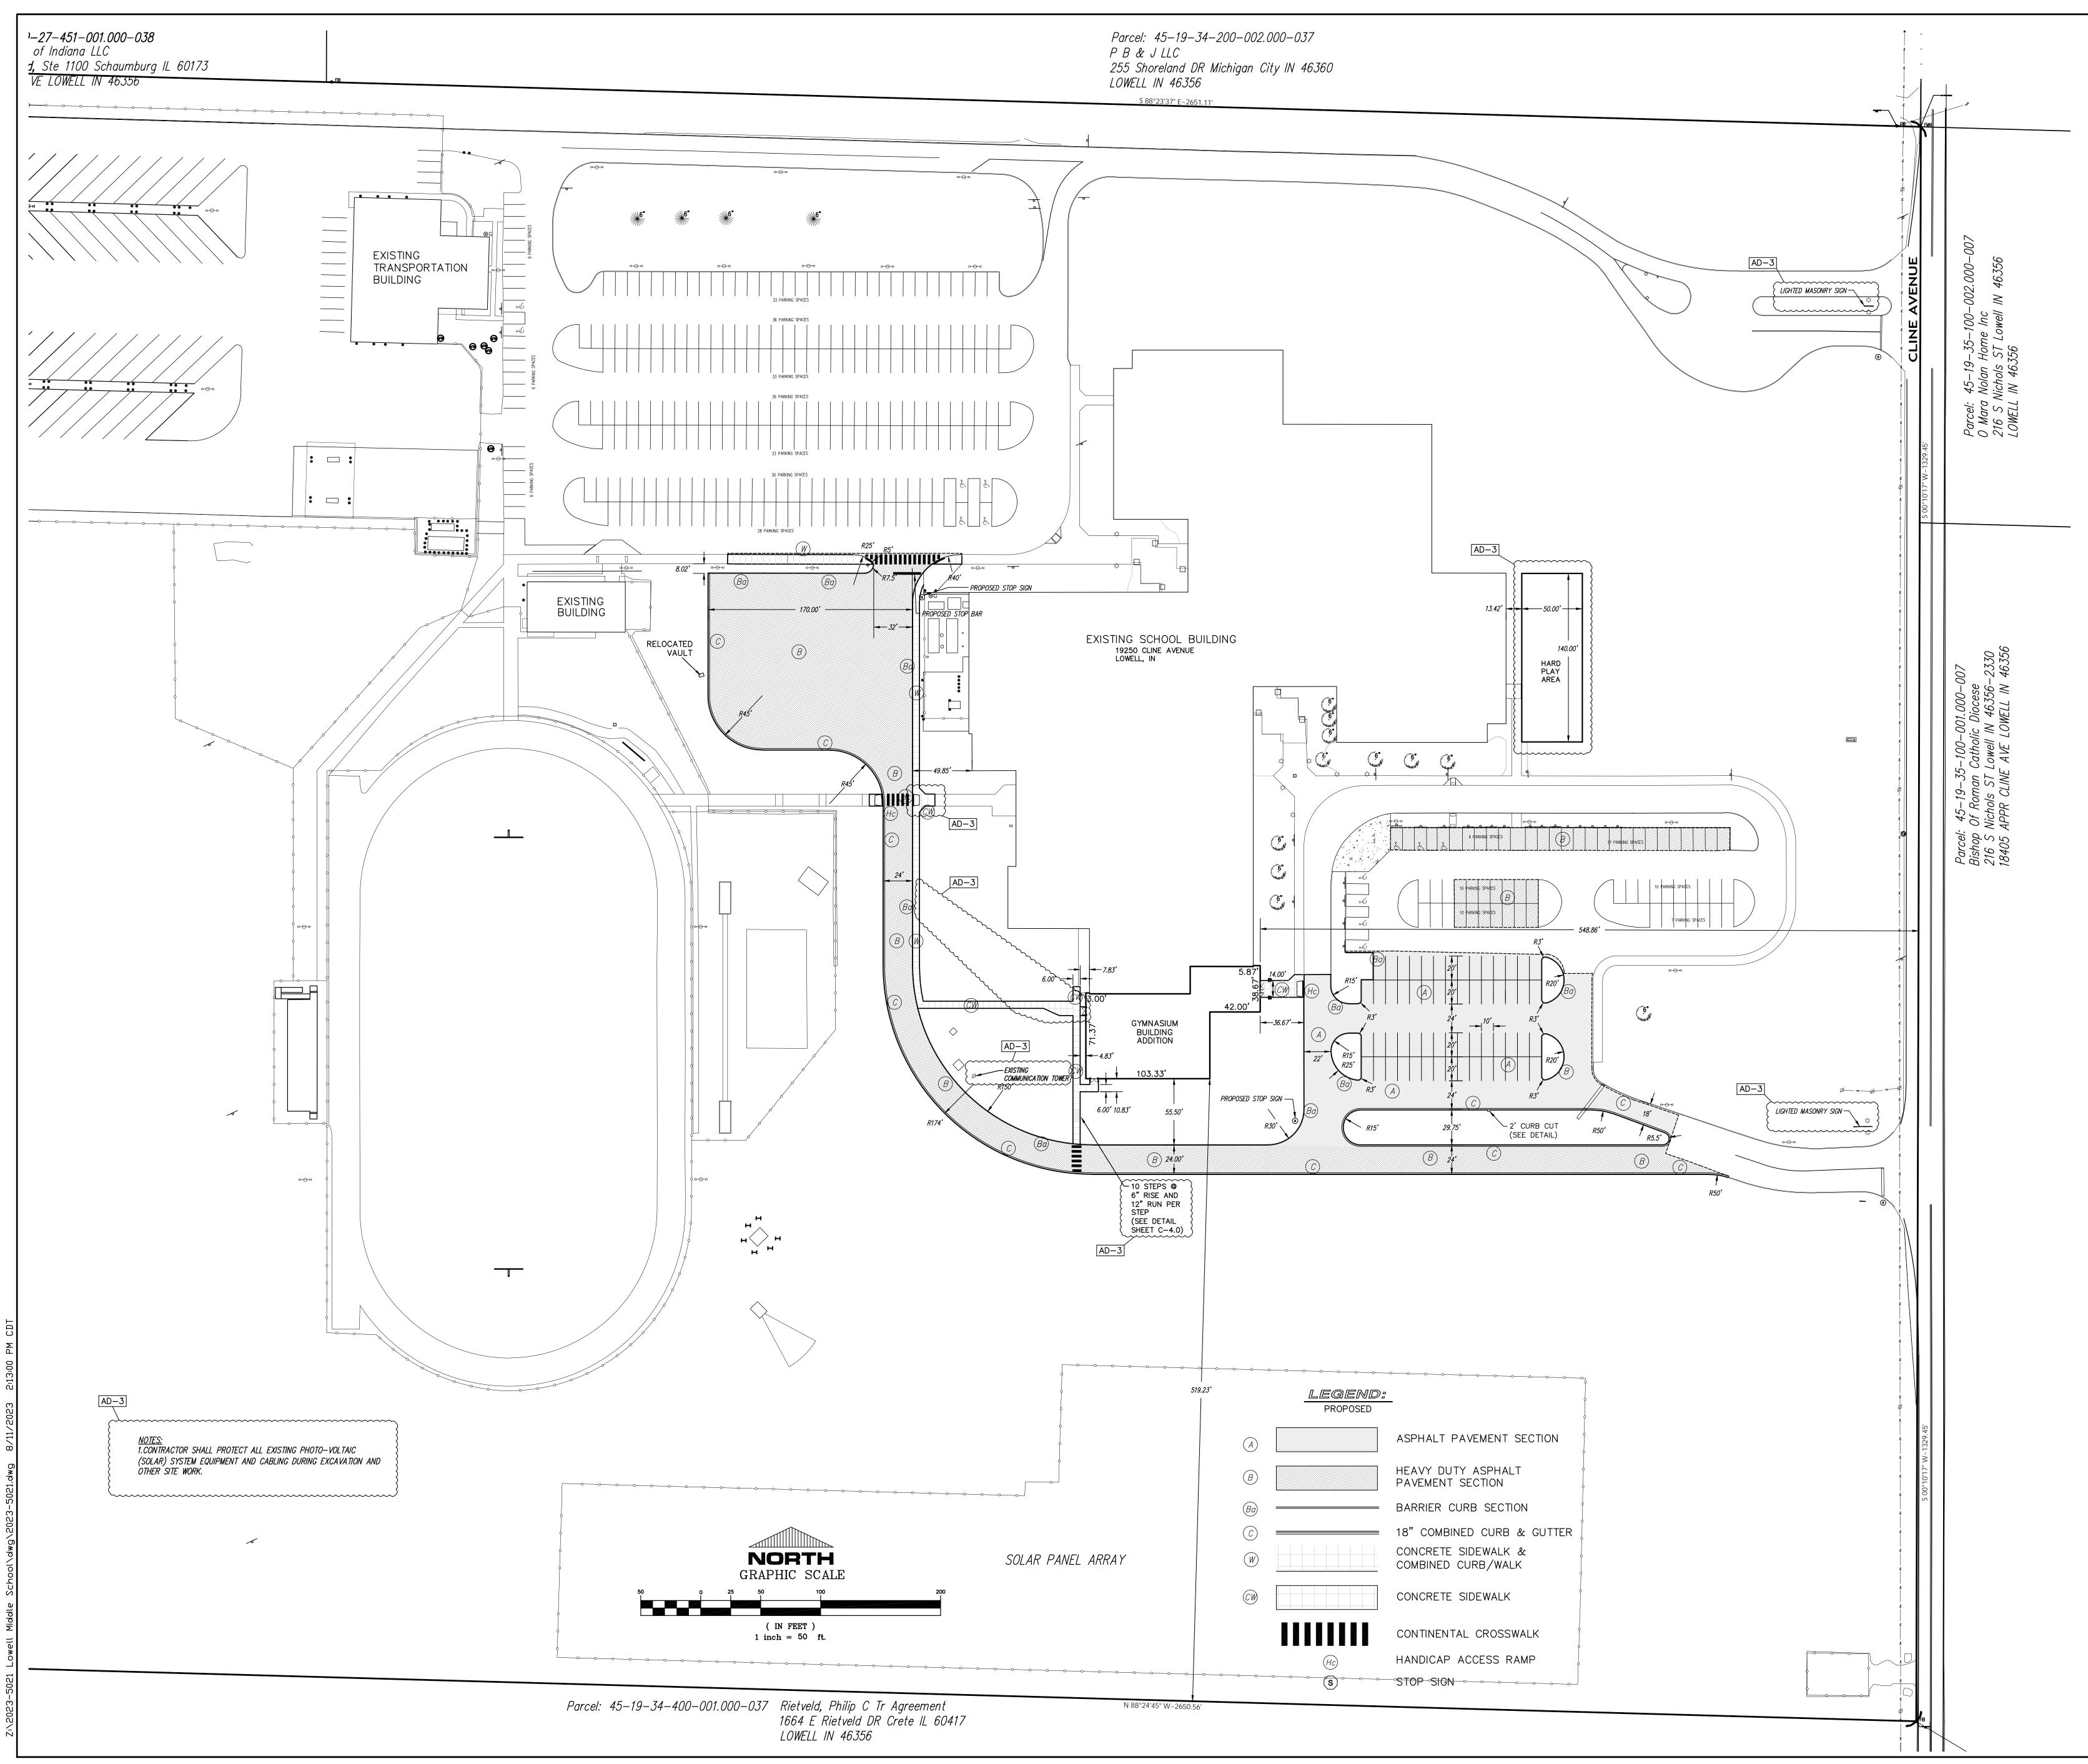


	<b>BALTAR</b> <b>ESIGN</b> ENGINEERING • INTERIOR DESIGN
SCHO GRADE	L MIDDLE OL- E 5-8 VEMENTS
TRI-CREEK SC	HOOL CORPORATION
907 RIDGE ROAD MUNSTER, IN 46321 T: (219) 836-8918 F: (219) 836-1138	EERING, INC. Is & LAND SURVEYORS
Email info@Gibro	46260 GibraltarDesign.com IltarDesign.com
Phone 317.580.5 PROJECT 23-108 DATE COORDINATED BY DCT/AM	No. 19868
DRAWN BY EM CHECKED BY	Jonal C. Tourga
WERE CREATED FOR USE THIS INFORMATION SHALL FOR ANY PURPOSE WITHO OF GIBRALTAR DESIGN. TI	, PLANS, DETAILS, ETC, SHOWN ON E PROPERTY OF GIBRALTAR DESIGN AND ON THIS SPECIFIC PROJECT. NONE OF BE USED BY ANY PERSON OR FIRM DUT THE EXPRESS WRITTEN CONSENT HE OWNER MAY RETAIN COPIES FOR ENCE IN CONNECTION ONLY WITH THIS
REVISIONS DATE AD-3 9/15/23	ISSUED FOR
DRAWING SITE PLAN	
PROJECT LOWELL MIDE 5-8 IMPROVEM	DLE SCHOOL- GRADE
	SHEET
	C-2.0

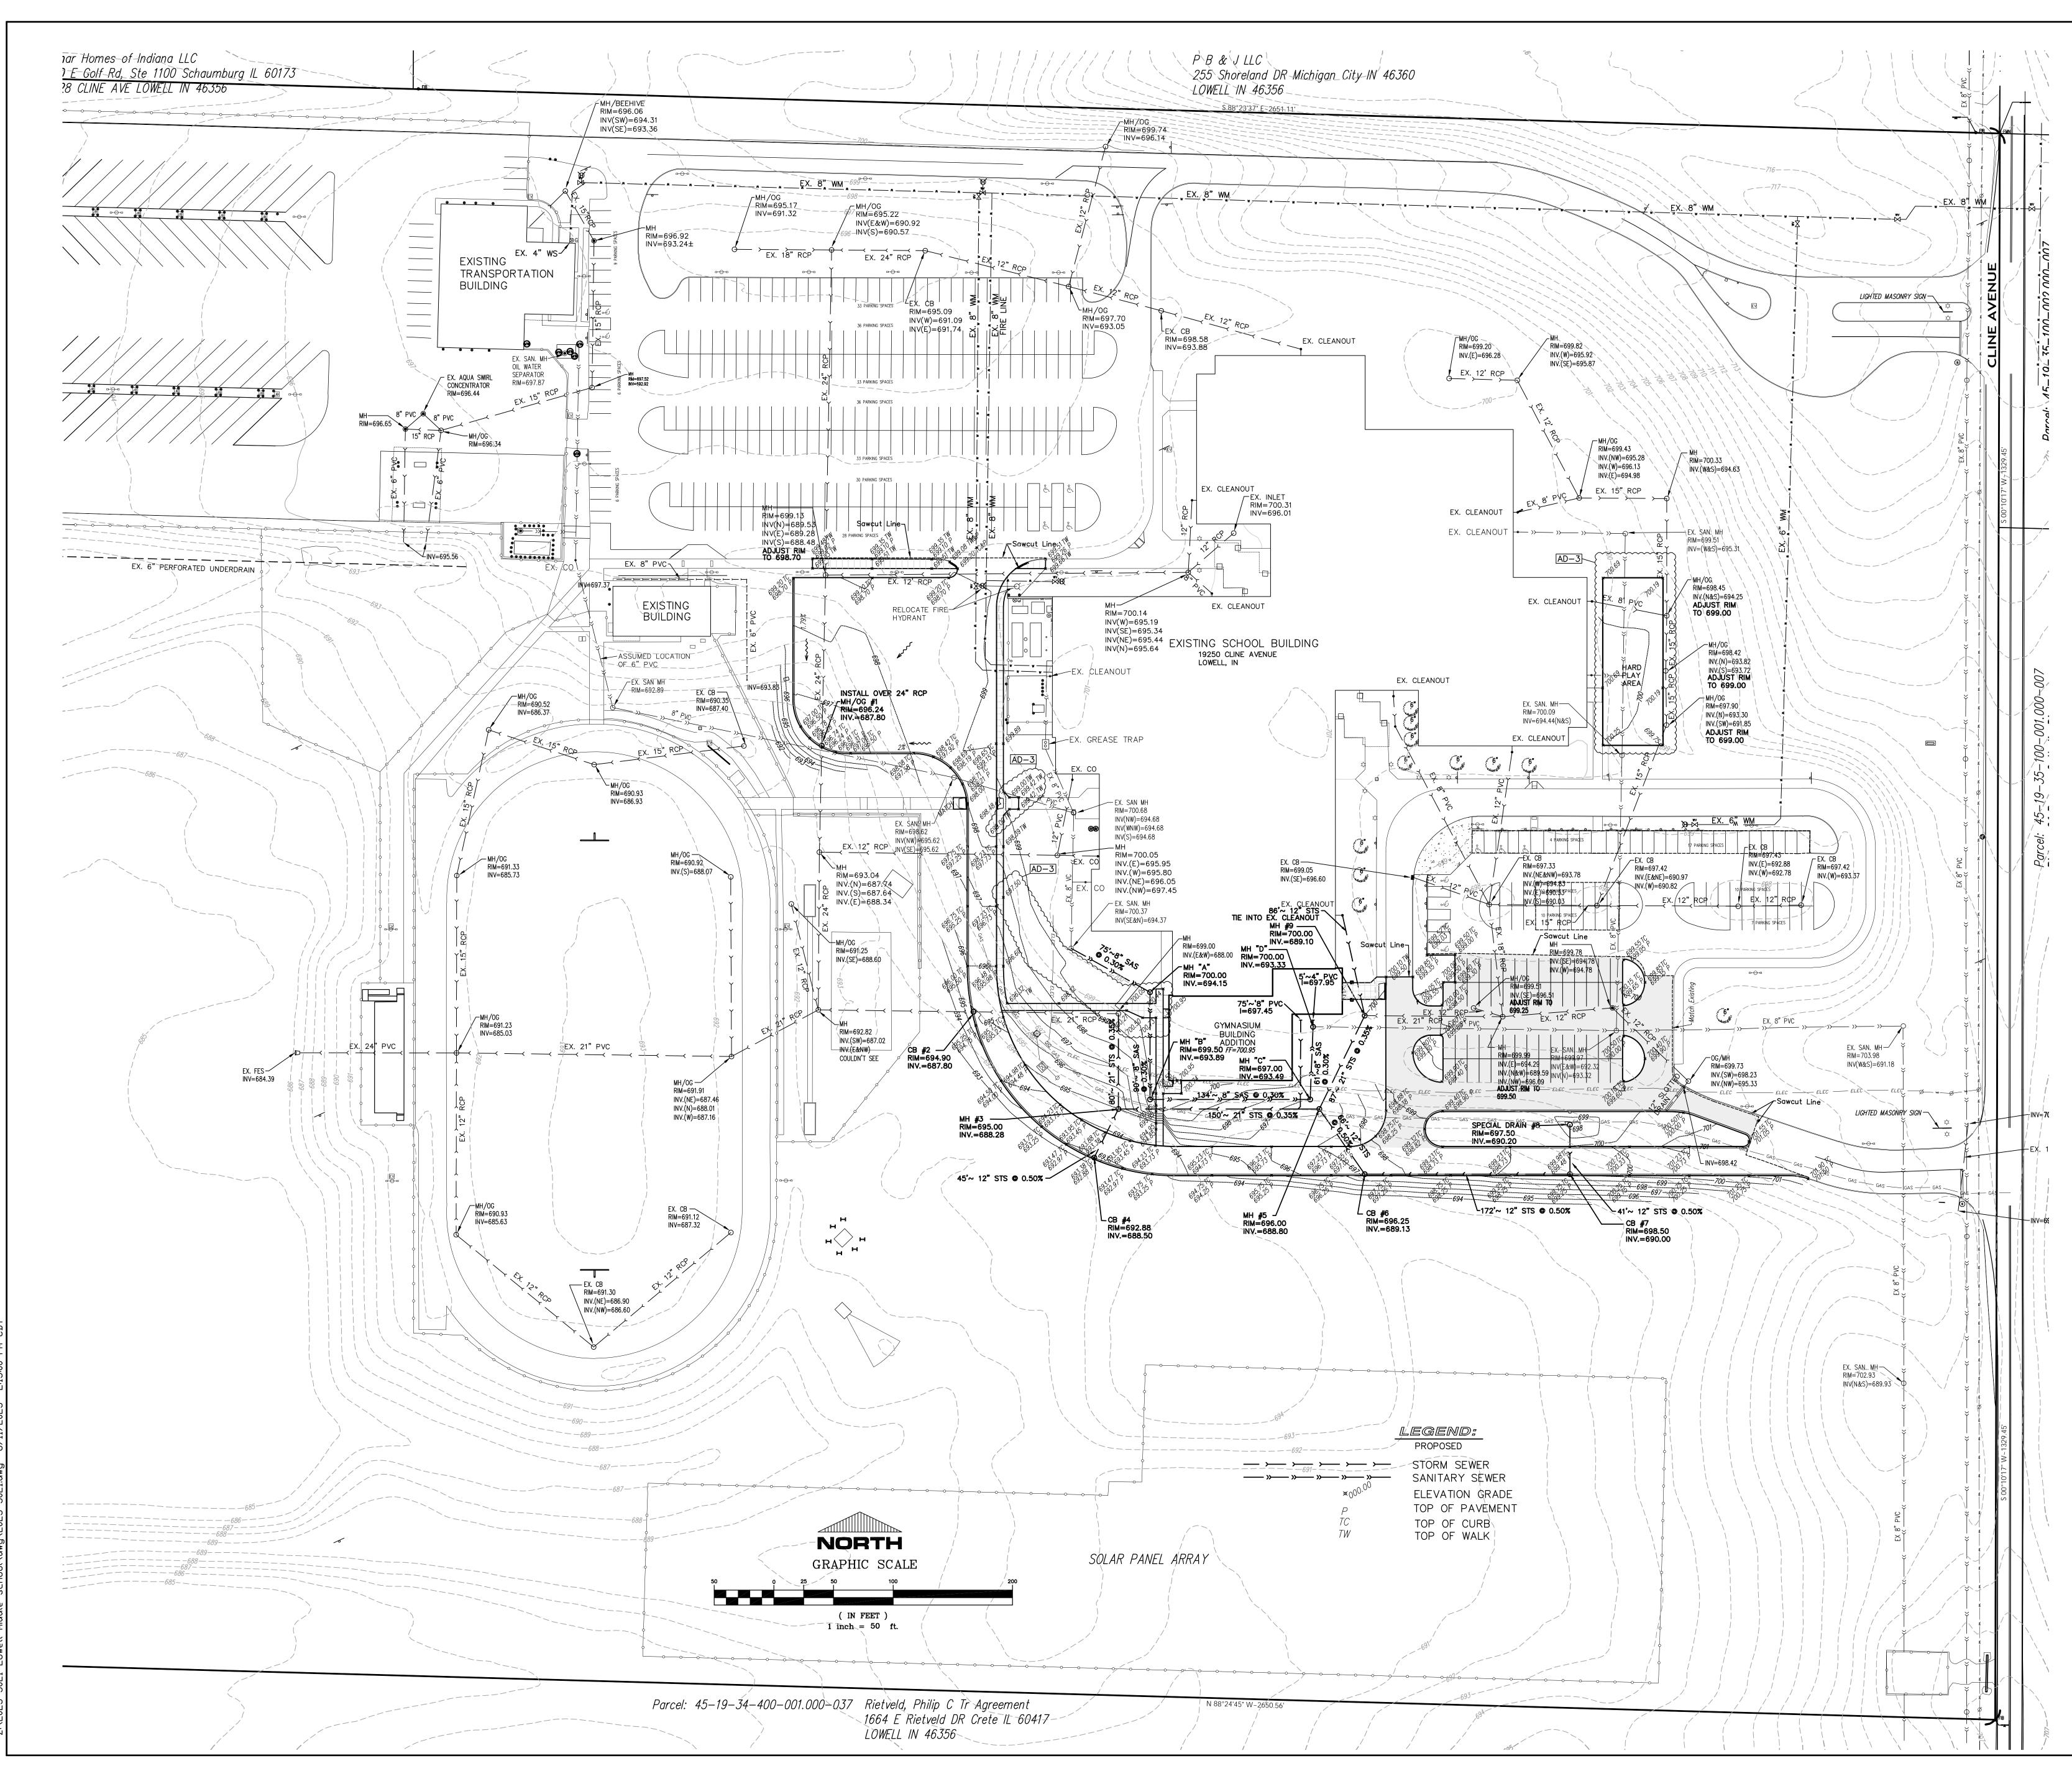


-5021 | cwell Middle School/dwo/2023-5021 dwo 8/11/2023 2413400 DV


GIBF	ALTAR
	ESIGN
SCHO	L MIDDLE
GRADE	
IMPRO	VEMENTS
TRI-CREEK SC	HOOL CORPORATION
TORRENGA ENGINE	
CONSULTING ENGINEERS 907 RIDGE ROAD MUNSTER, IN 46321 T: (219) 836-8918 F: (219) 836-1138	
GIBRAL 9102 N. Meridian	
Indianapolis, IN 4 Homepage www.0 Email info@Gibra	46260 GibraltarDesign.com
PROJECT 23–108 DATE	D C. TOA
date coordinated by DCT/AM	MO. 19868 ★ ★ STATE OF
drawn by EM	Jonal C. Tourga
CHECKED BY DCT/AM COPYRIGHT NOTICE:	Donal C. Idvierga
THE CONCEPTS, DESIGNS, THIS DOCUMENT ARE THE WERE CREATED FOR USE THIS INFORMATION SHALL FOR ANY PURPOSE WITHO OF GIBRALTAR DESIGN. TH	PLANS, DETAILS, ETC, SHOWN ON PROPERTY OF GIBRALTAR DESIGN AND ON THIS SPECIFIC PROJECT. NONE OF BE USED BY ANY PERSON OR FIRM OUT THE EXPRESS WRITTEN CONSENT 4E OWNER MAY RETAIN COPIES FOR ENCE IN CONNECTION ONLY WITH THIS
REVISIONS DATE AD-3 9/15/23	ISSUED FOR ADDENDUM #3
	<i>n</i>
DRAWING GRADING &	UTILITIES PLAN
PROJECT LOWELL MIDD 5-8 IMPROVEM	LE SCHOOL- GRADE
	SHEET
	C-3.0

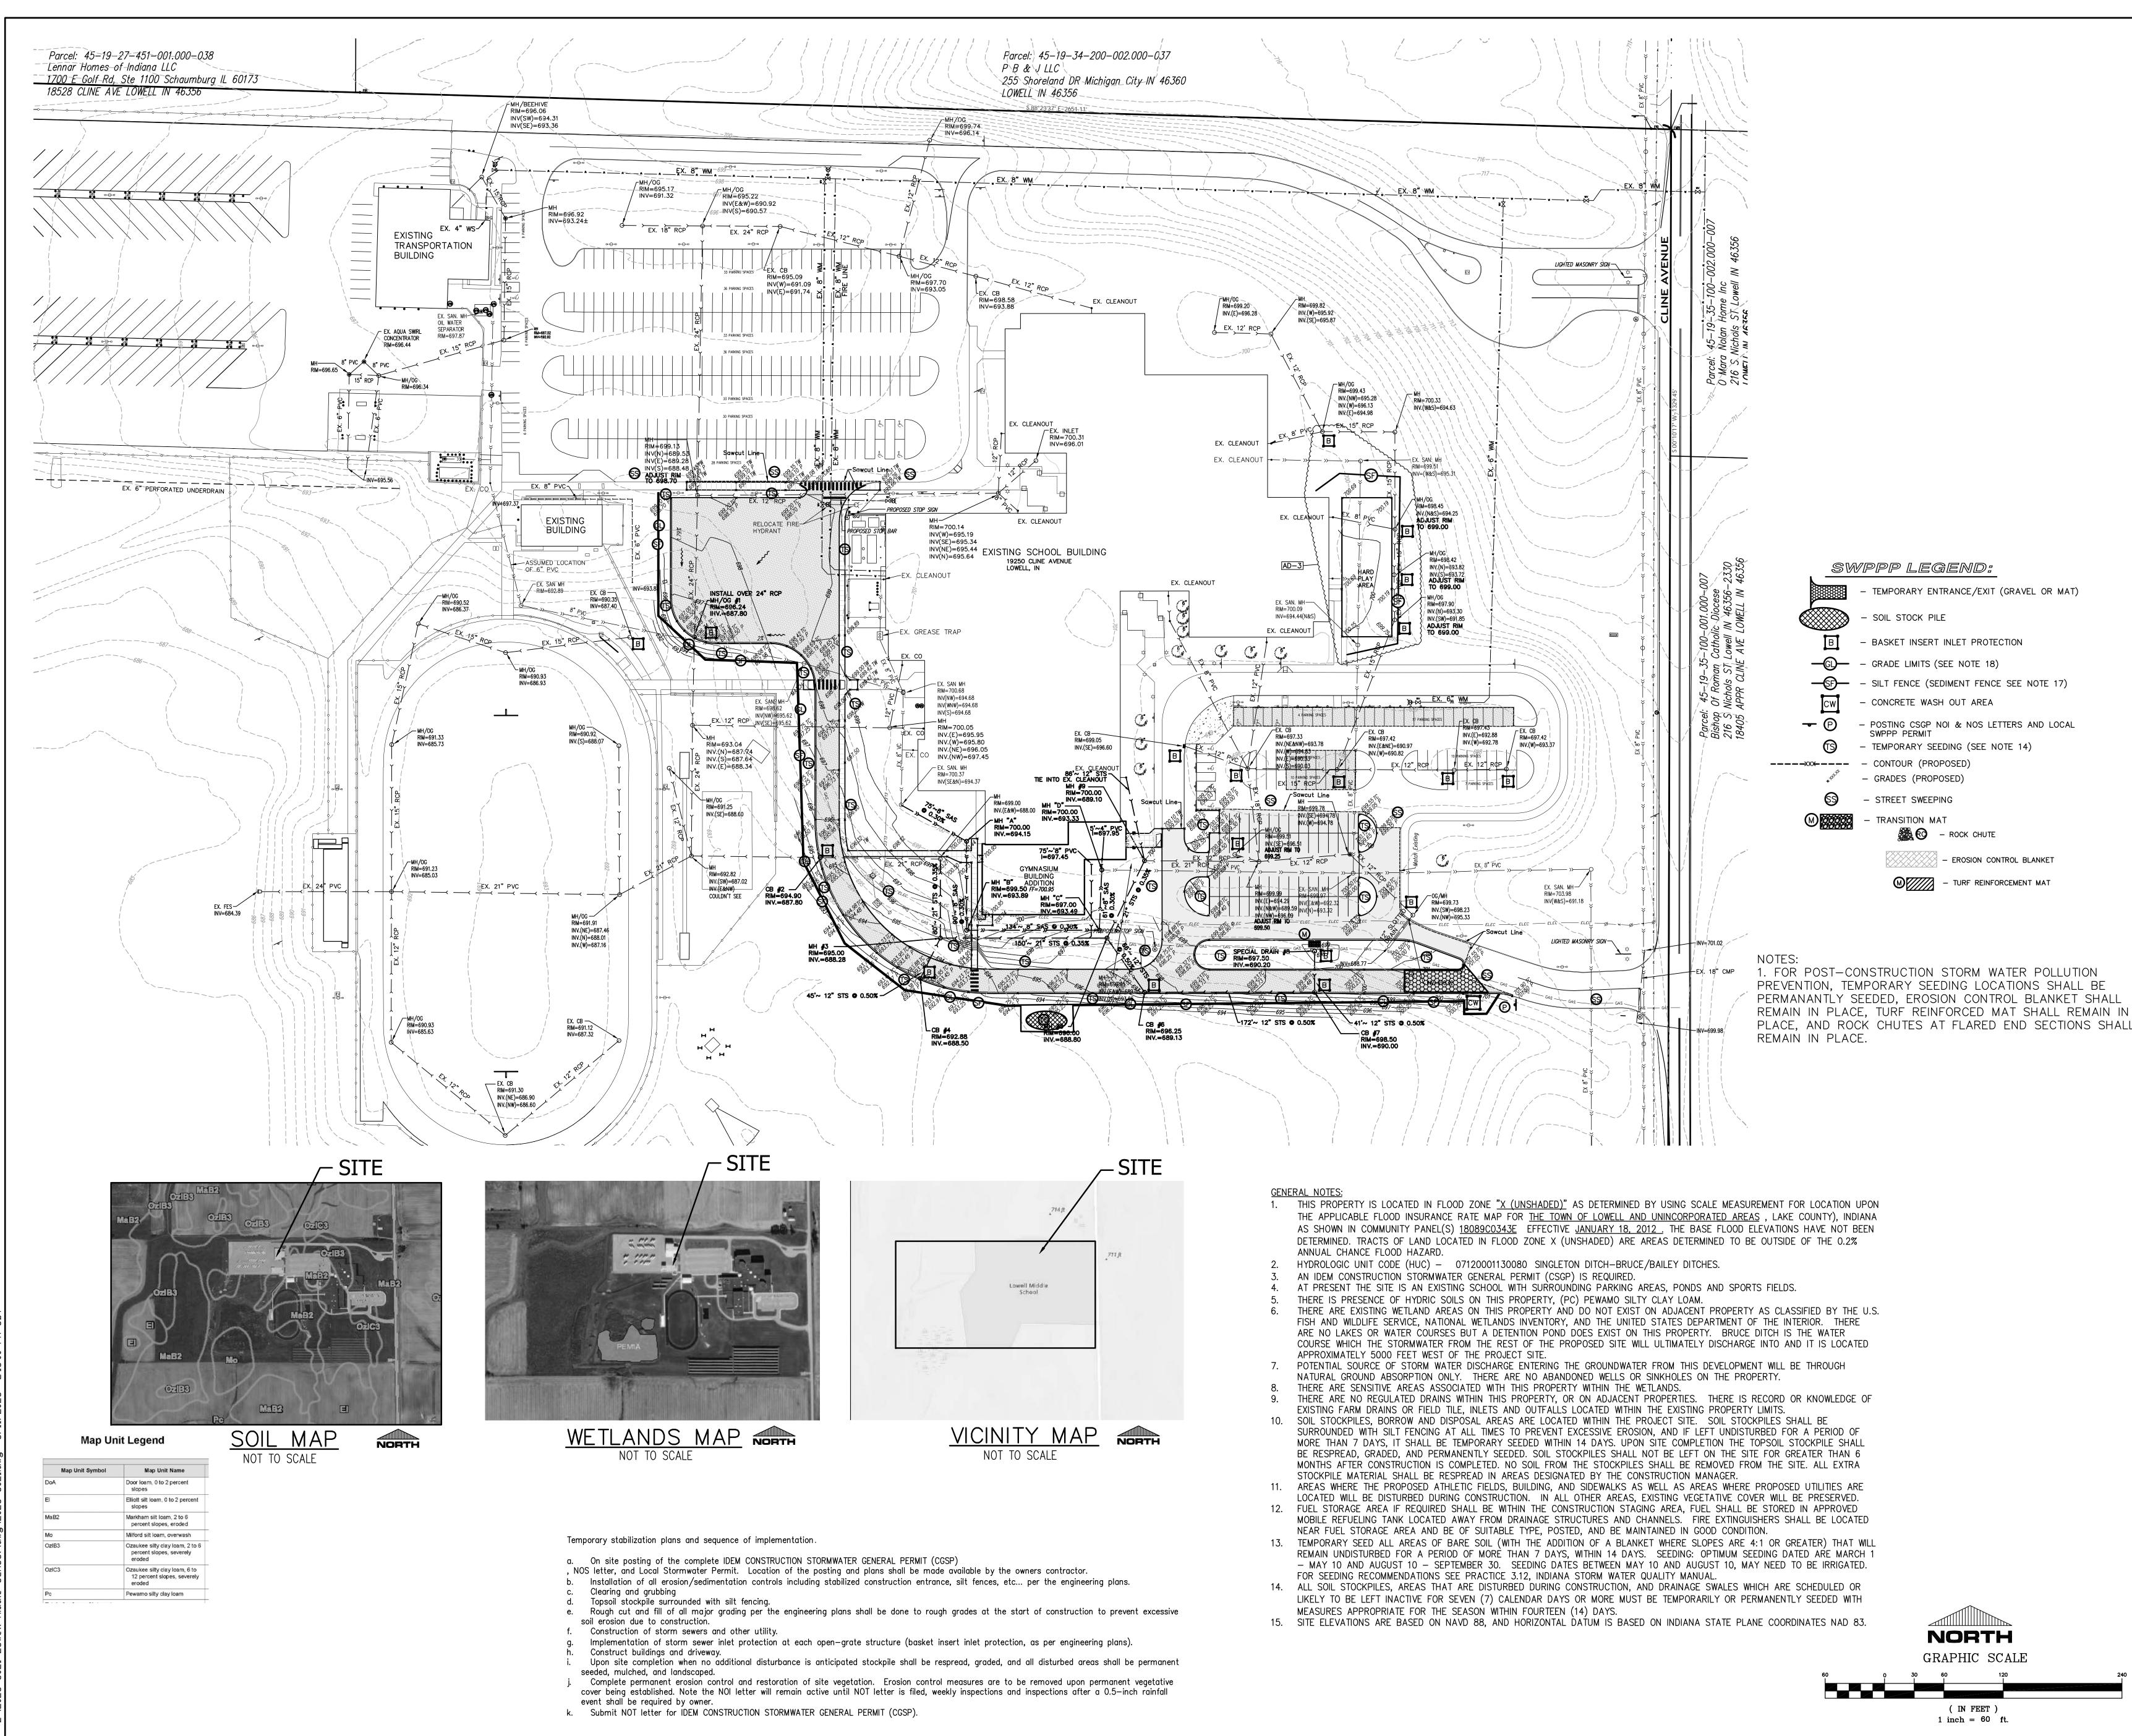



GIBRALTAR DESIGN ARCHITECTURE • ENGINEERING • INTERIOR DESIGN PROJECT: LOWELL MIDDLE SCHOOL-GRADE 5-8 IMPROVEMENTS TRI-CREEK SCHOOL CORPORATION TORRENGA ENGINEERING, INC. CONSULTING ENGINEERS & LAND SURVEYORS 907 RIDGE ROAD MUNSTER, IN 46321 T: (219) 836-8918 F: (219) 836-1138 Ļ⋿ GIBRALTAR DESIGN 9102 N. Meridian St., Ste. 300 ndianapolis, IN 46260 Homepage www.GibraltarDesign.com mail info@GibraltarDesign.com Phone 317.580.5777 Fax 317.580.5778 PROJECT 23-108 DATE No. 19868 --coordinated e DCT/AM STATE OF DRAWN BY ЕM Donal C. Toweng CHECKED BY DCT/AM OPYRIGHT NOTICE: THE CONCEPTS, DESIGNS, PLANS, DETAILS, ETC, SHOWN ON THIS DOCUMENT ARE THE PROPERTY OF GIBRALTAR DESIGN RE CREATED FOR USE ON THIS SPECIFIC PROJECT HIS INFORMATION SHALL BE USED BY ANY PERSON OR FIRM OR ANY PURPOSE WITHOUT THE EXPRESS WRITTEN CONSENT OF GIBRALTAR DESIGN. THE OWNER MAY RETAIN COPIES FOR ORMATION AND REFERENCE IN CONNECTION ONLY WITH T REVISIONS DATE ISSUED FOR AD-3 9/15/23 ADDENDUM #3 DRAWING STORM WATER POLLUTION PREVENTION PLAN (SWPPP) PROJECT LOWELL MIDDLE SCHOOL- GRADE 5-8 IMPROVEMENTS SHEET C-5.0

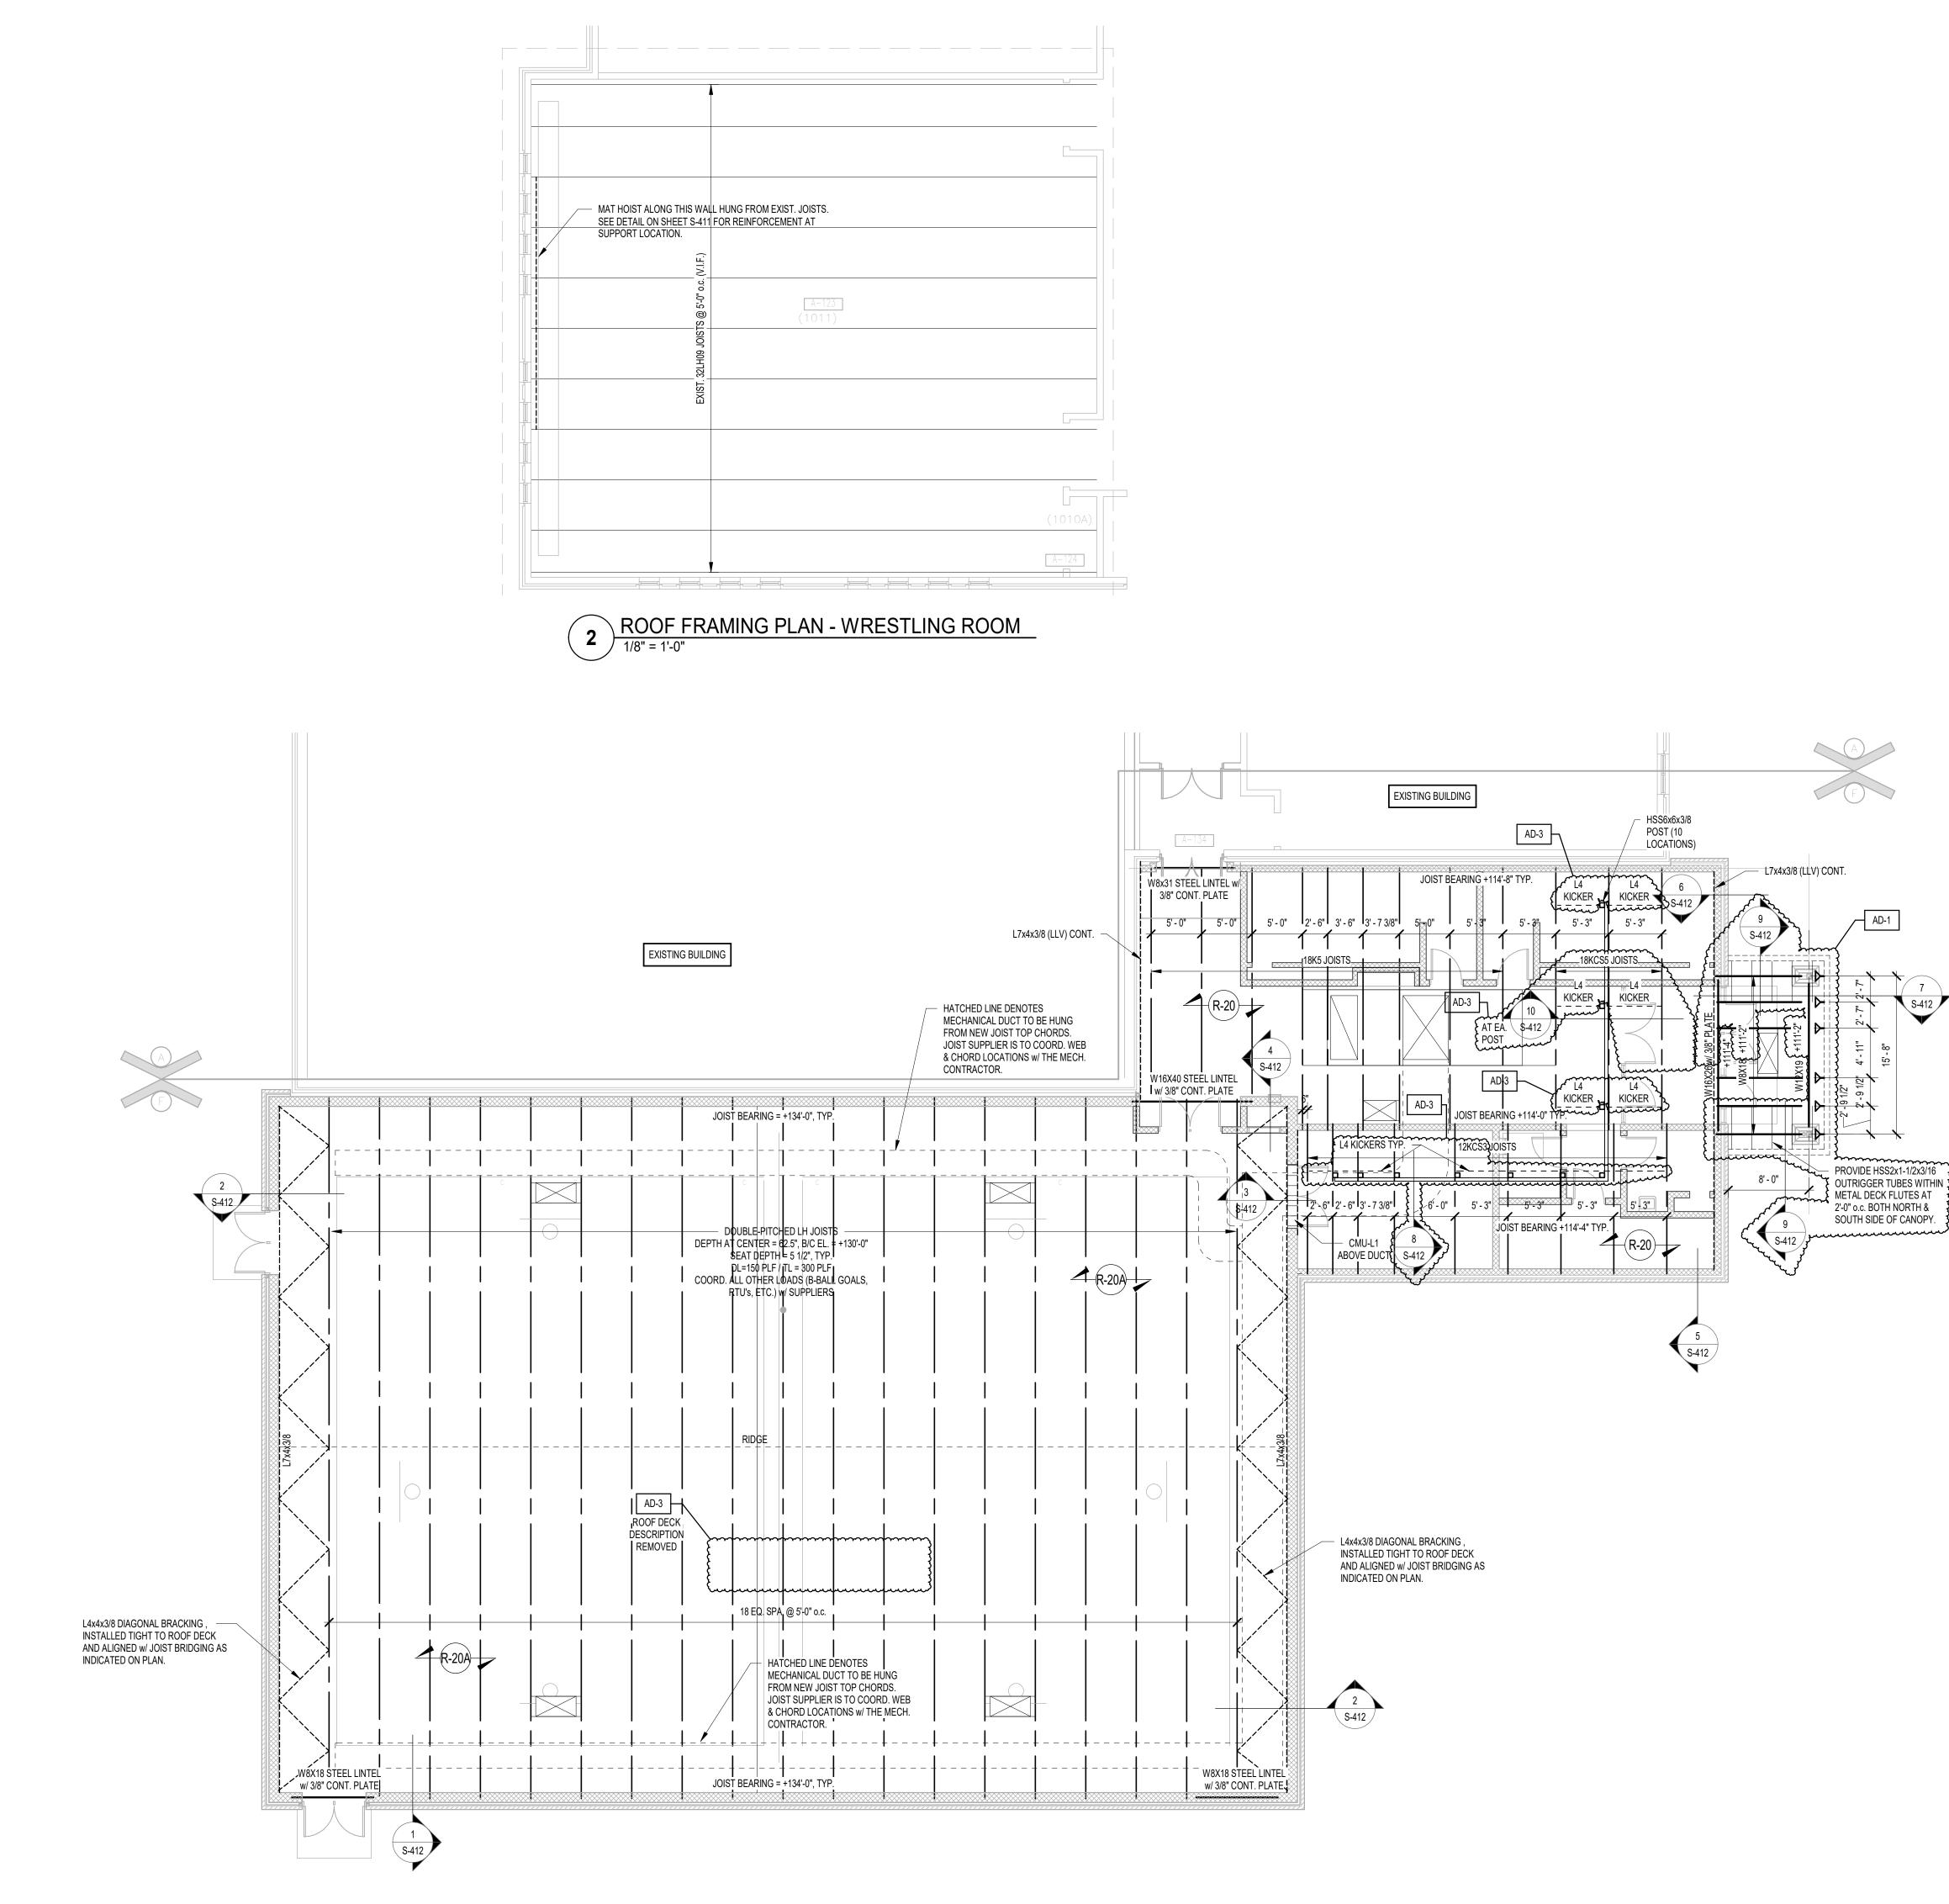


**1** ROOF FRAMING PLAN - NEW GYMNASIUM

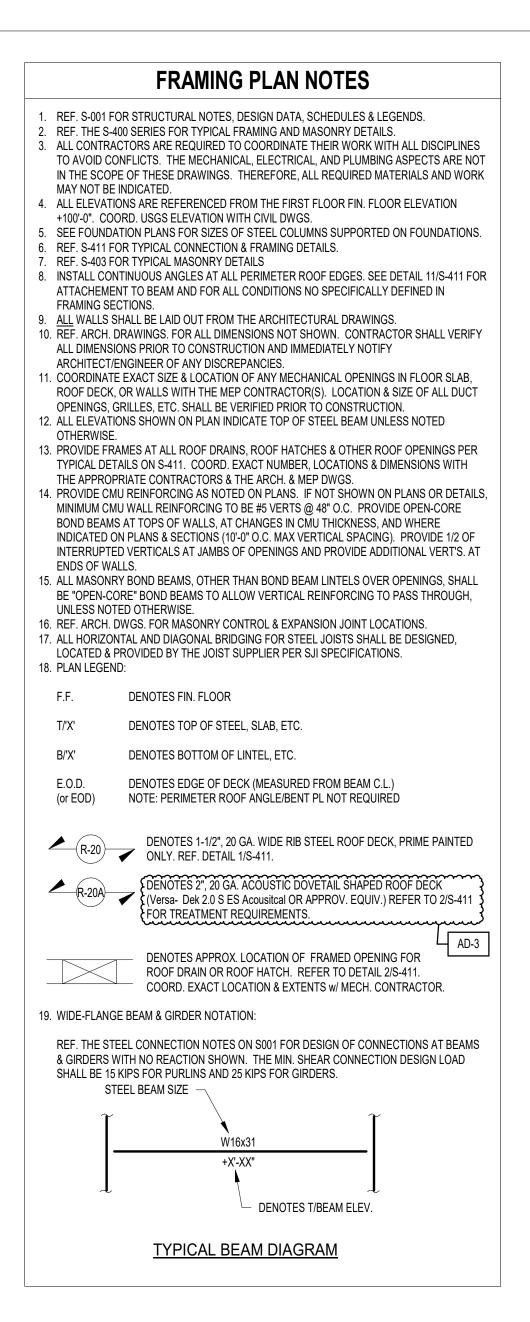

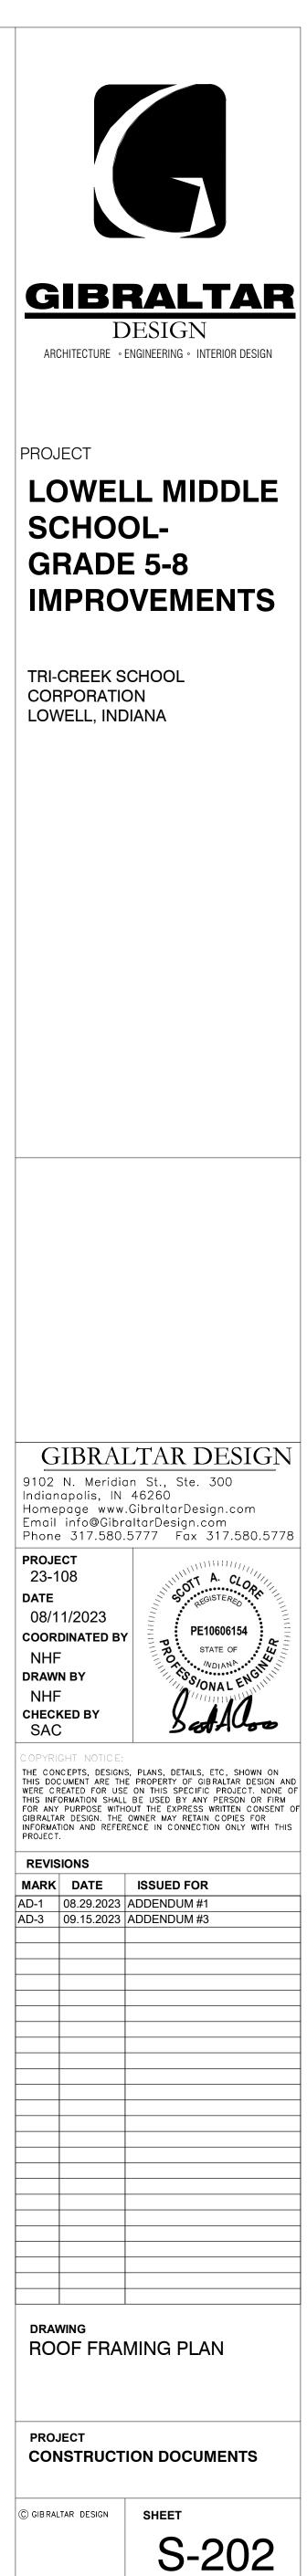

 


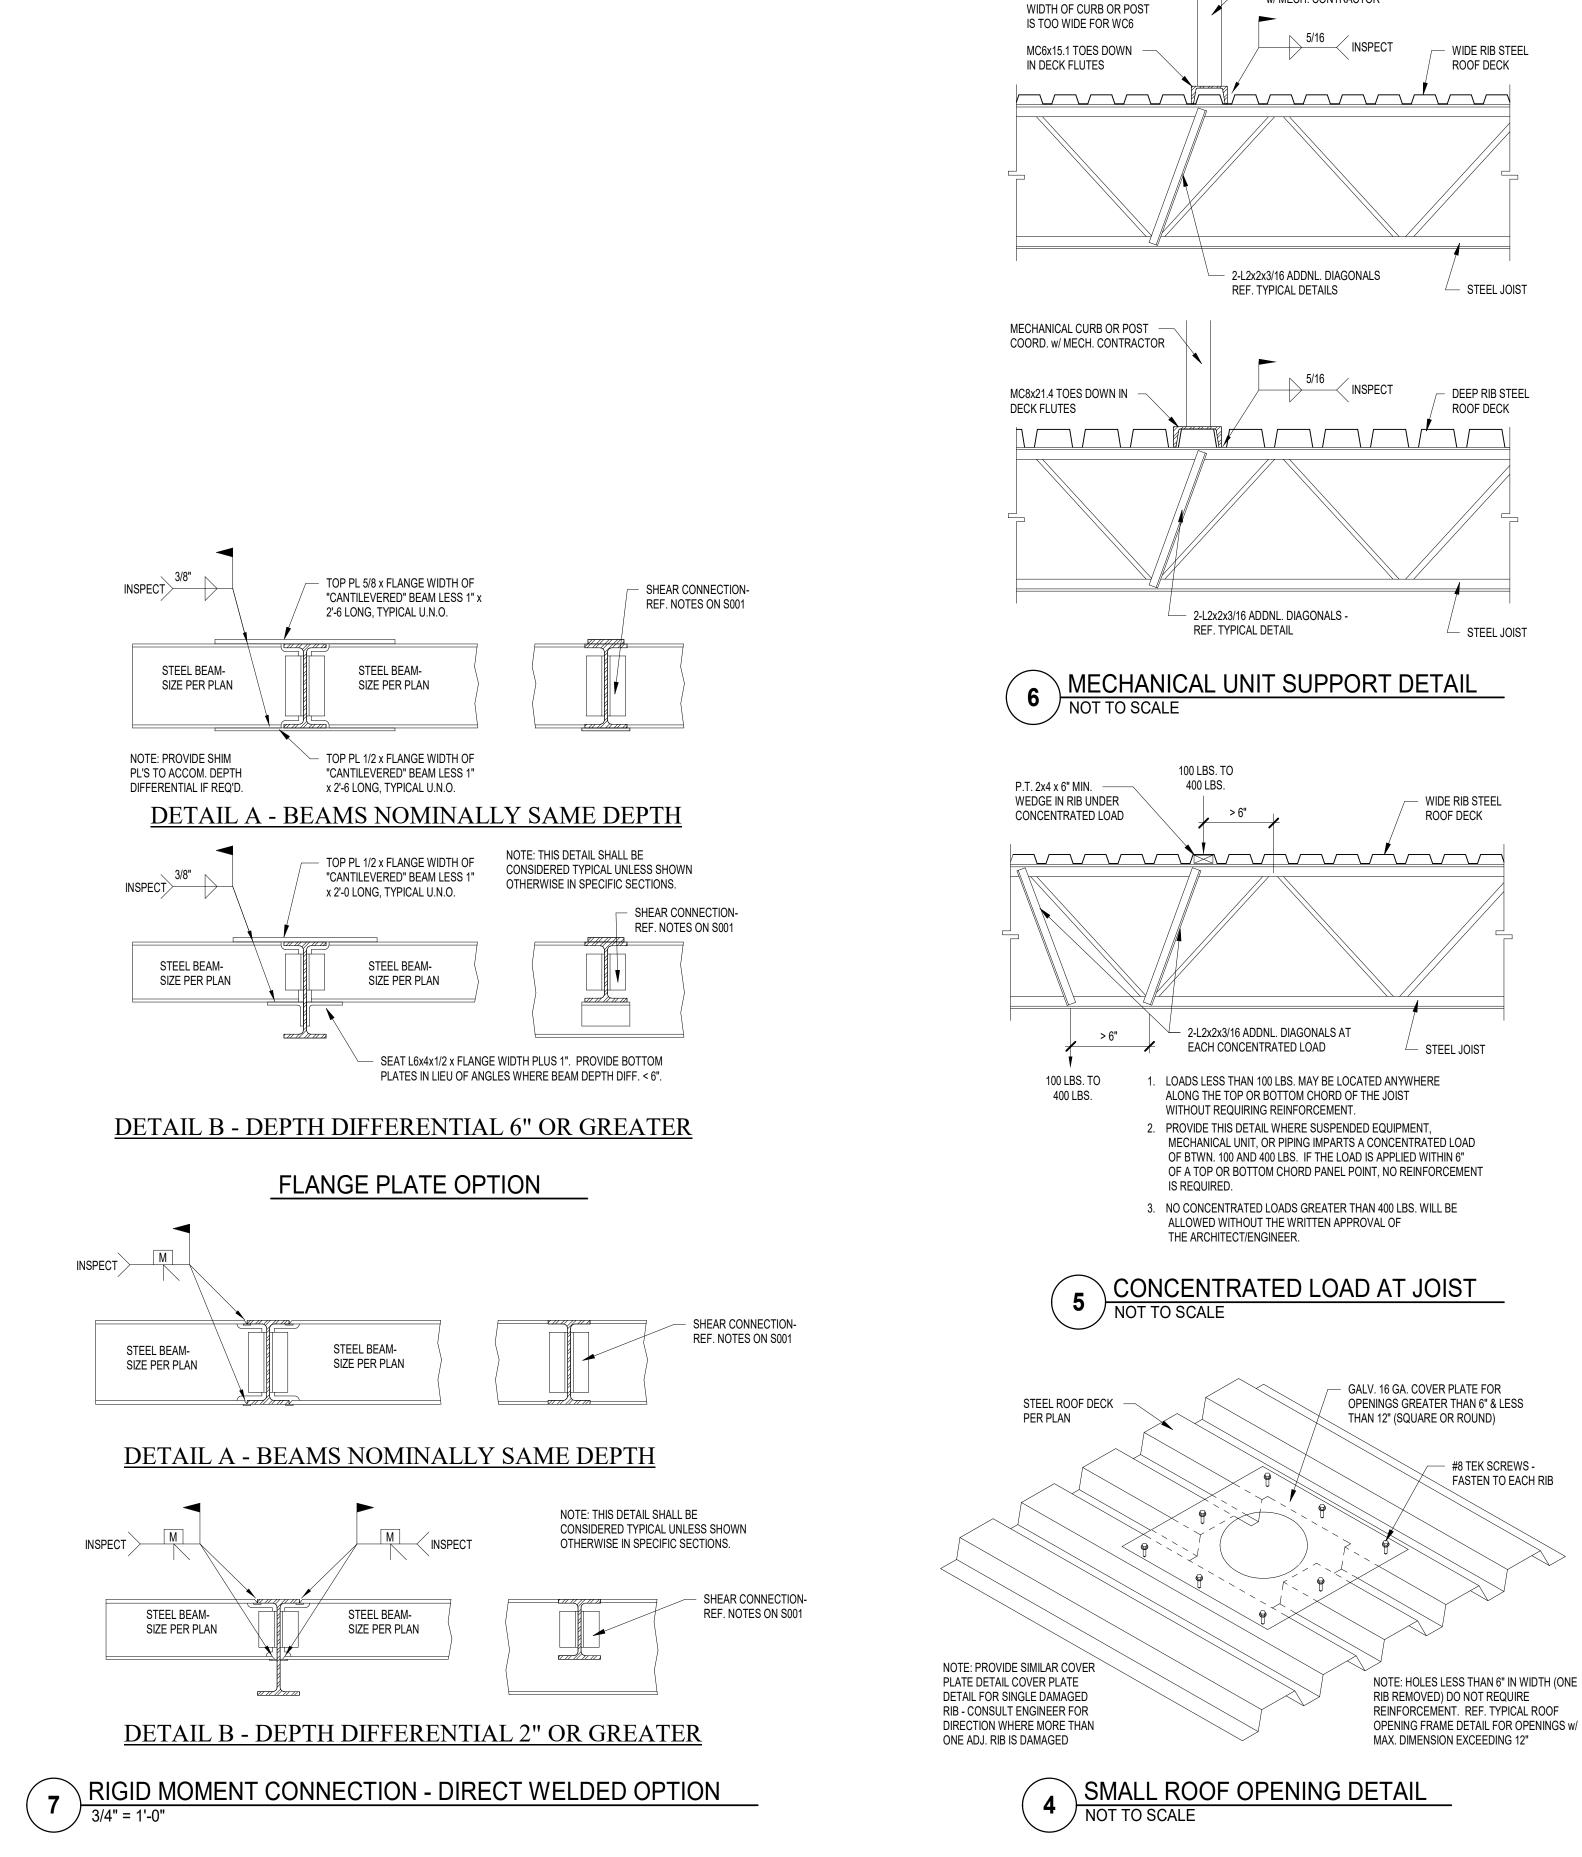



MECHANICAL CURB OR POST COORD.


w/ MECH. CONTRACTOR

NOTE: USE C12x20.7 WHEN

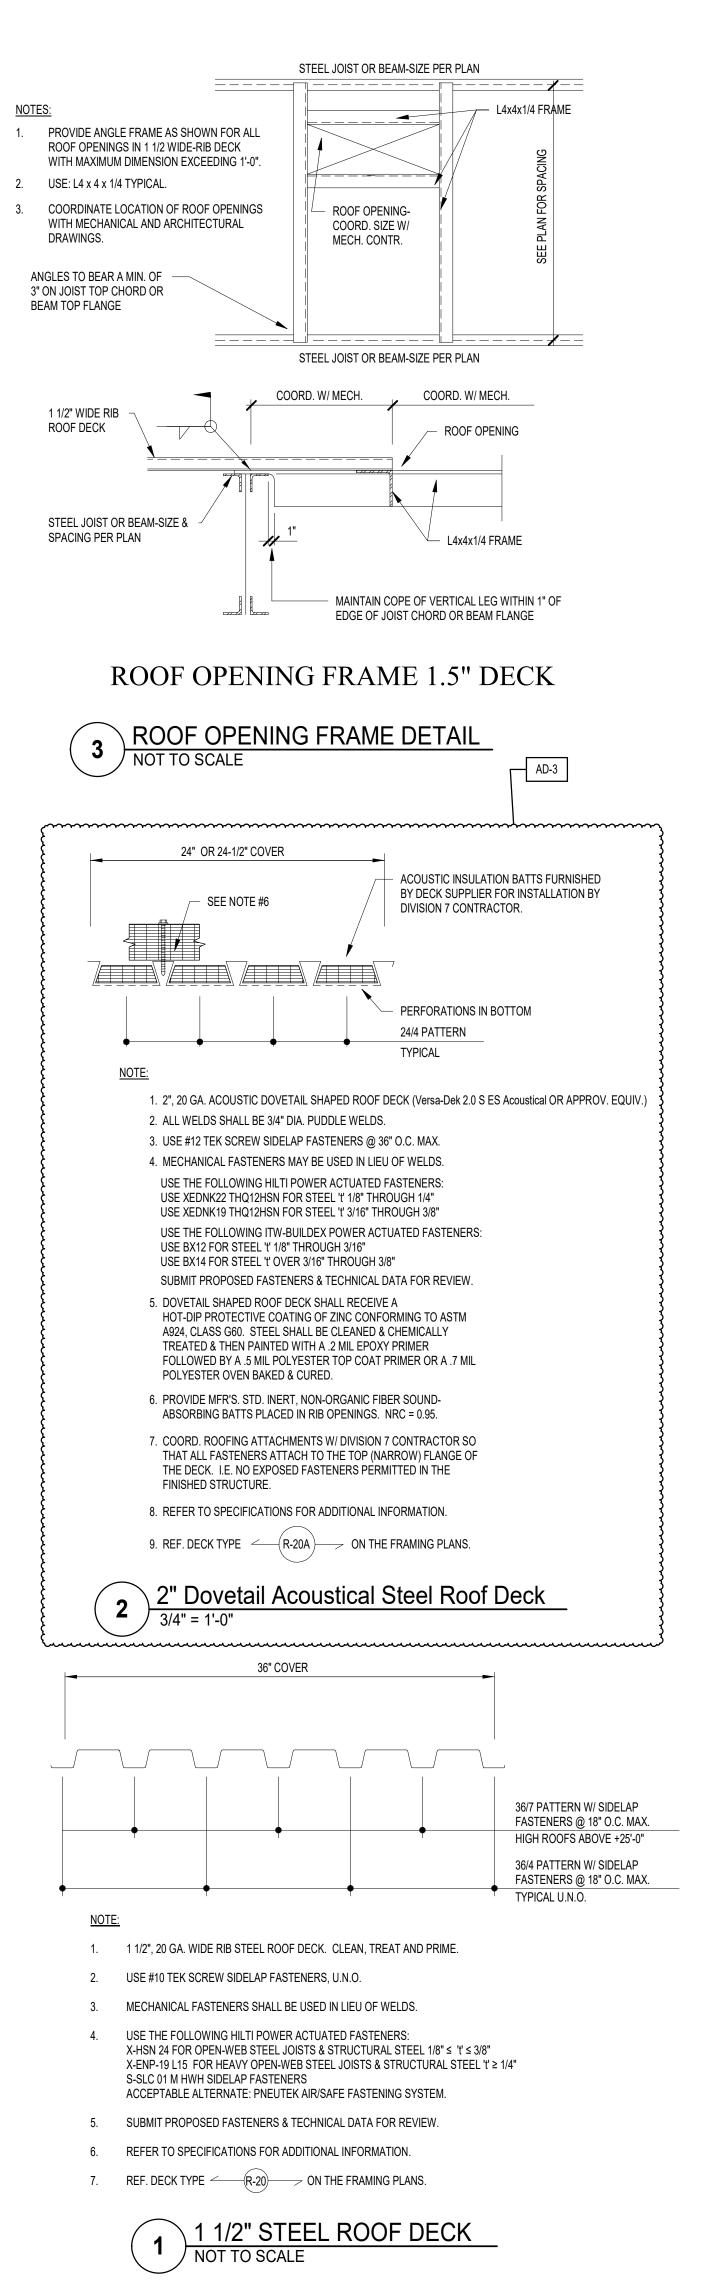

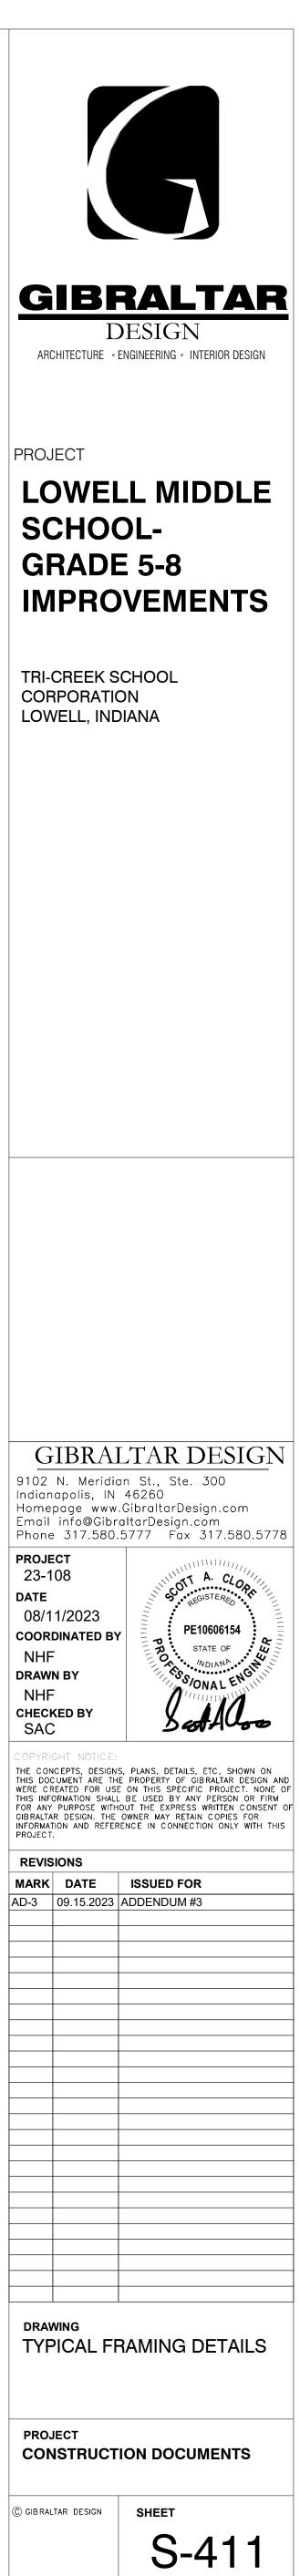

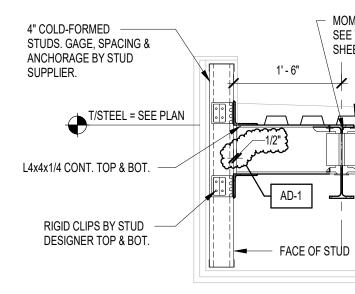


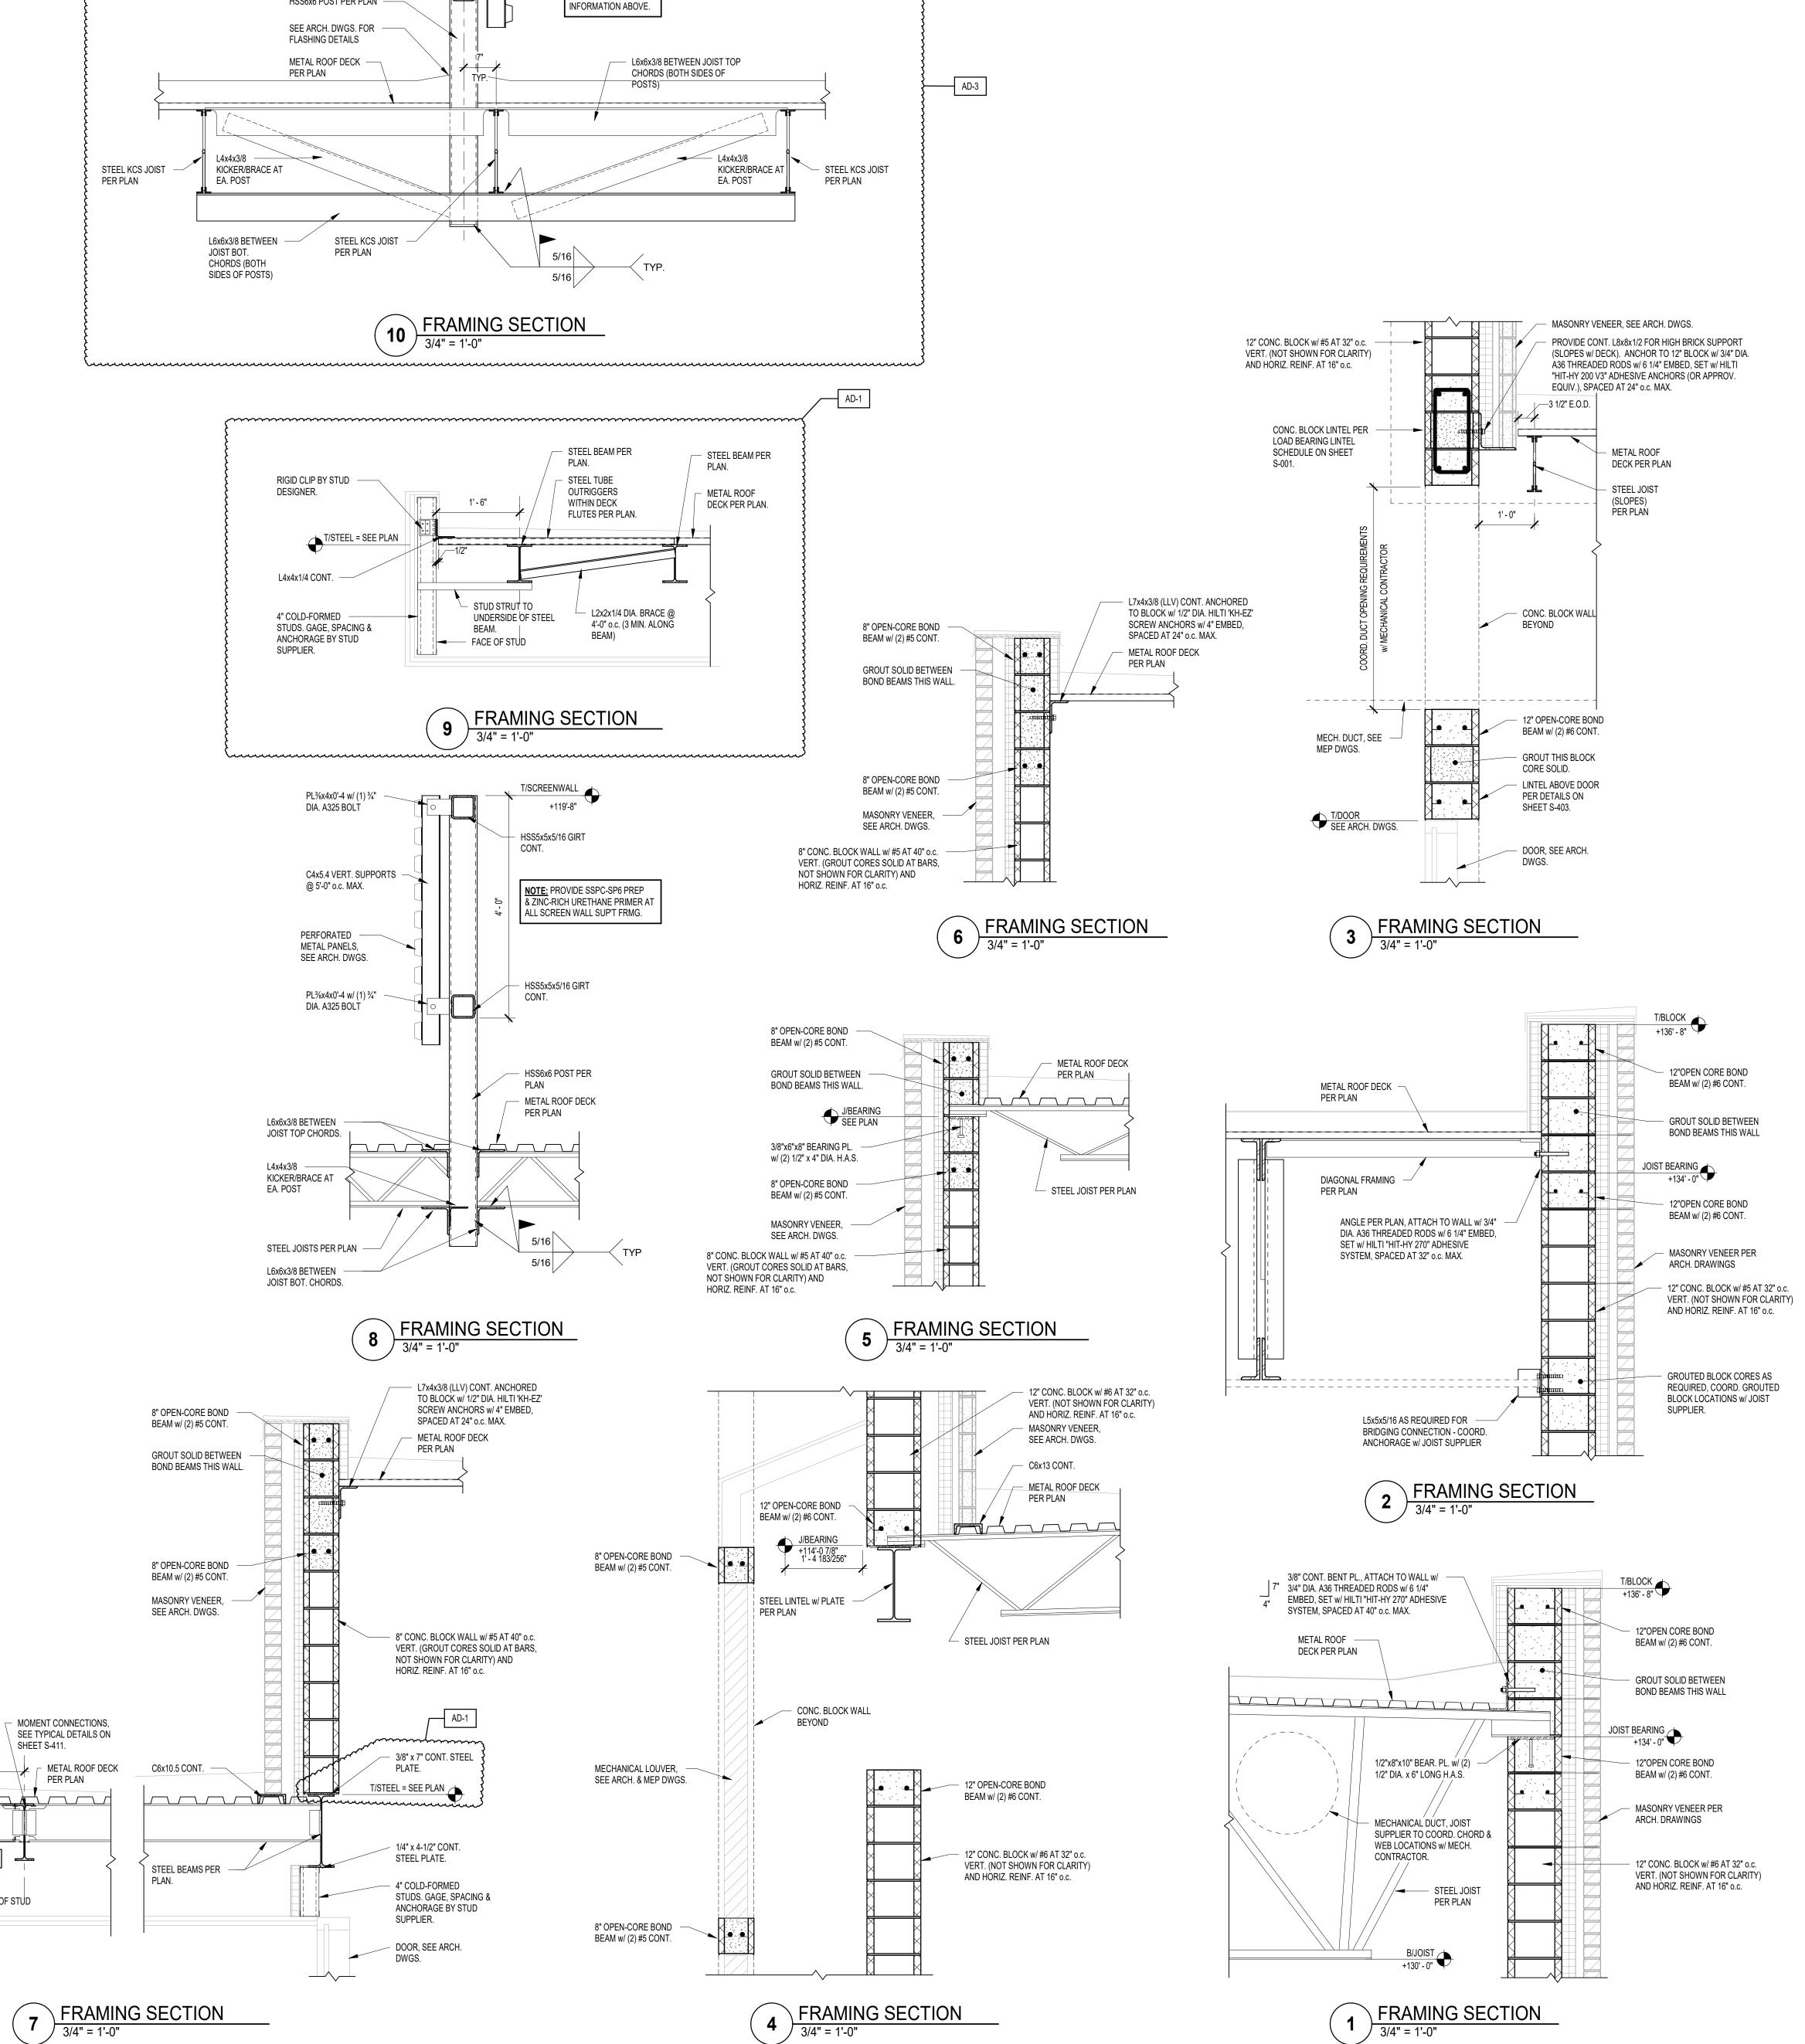


NOTE: REFERENCE SECTION 8/S-412 FOR

BALANCE OF

HSS6x6 POST PER PLAN -

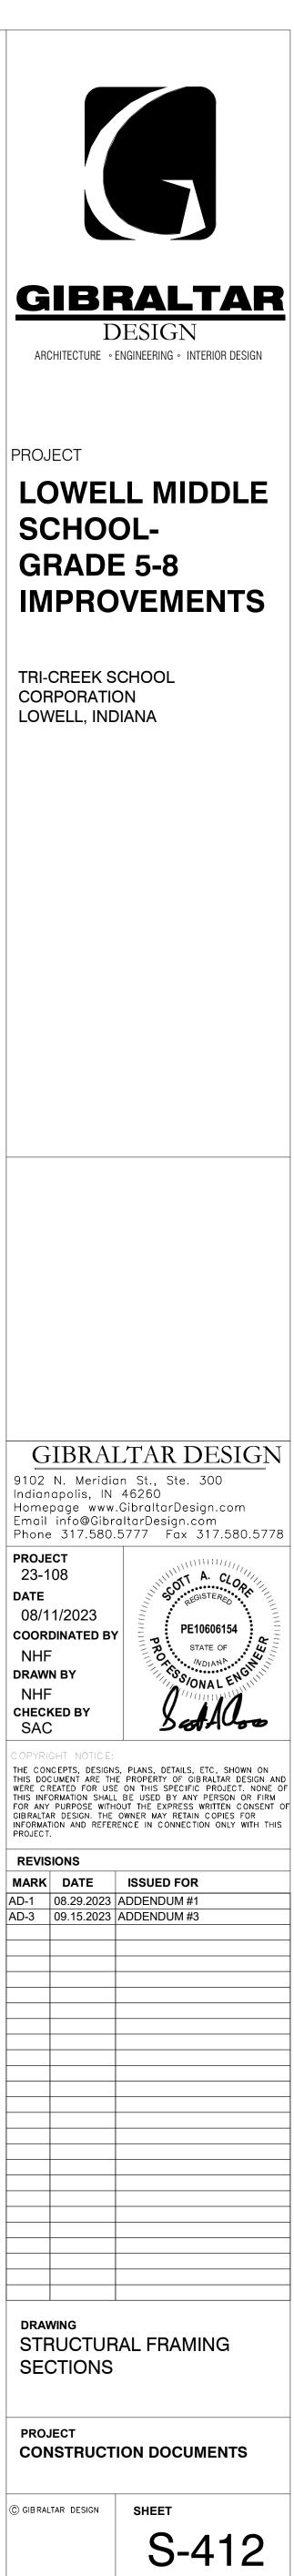

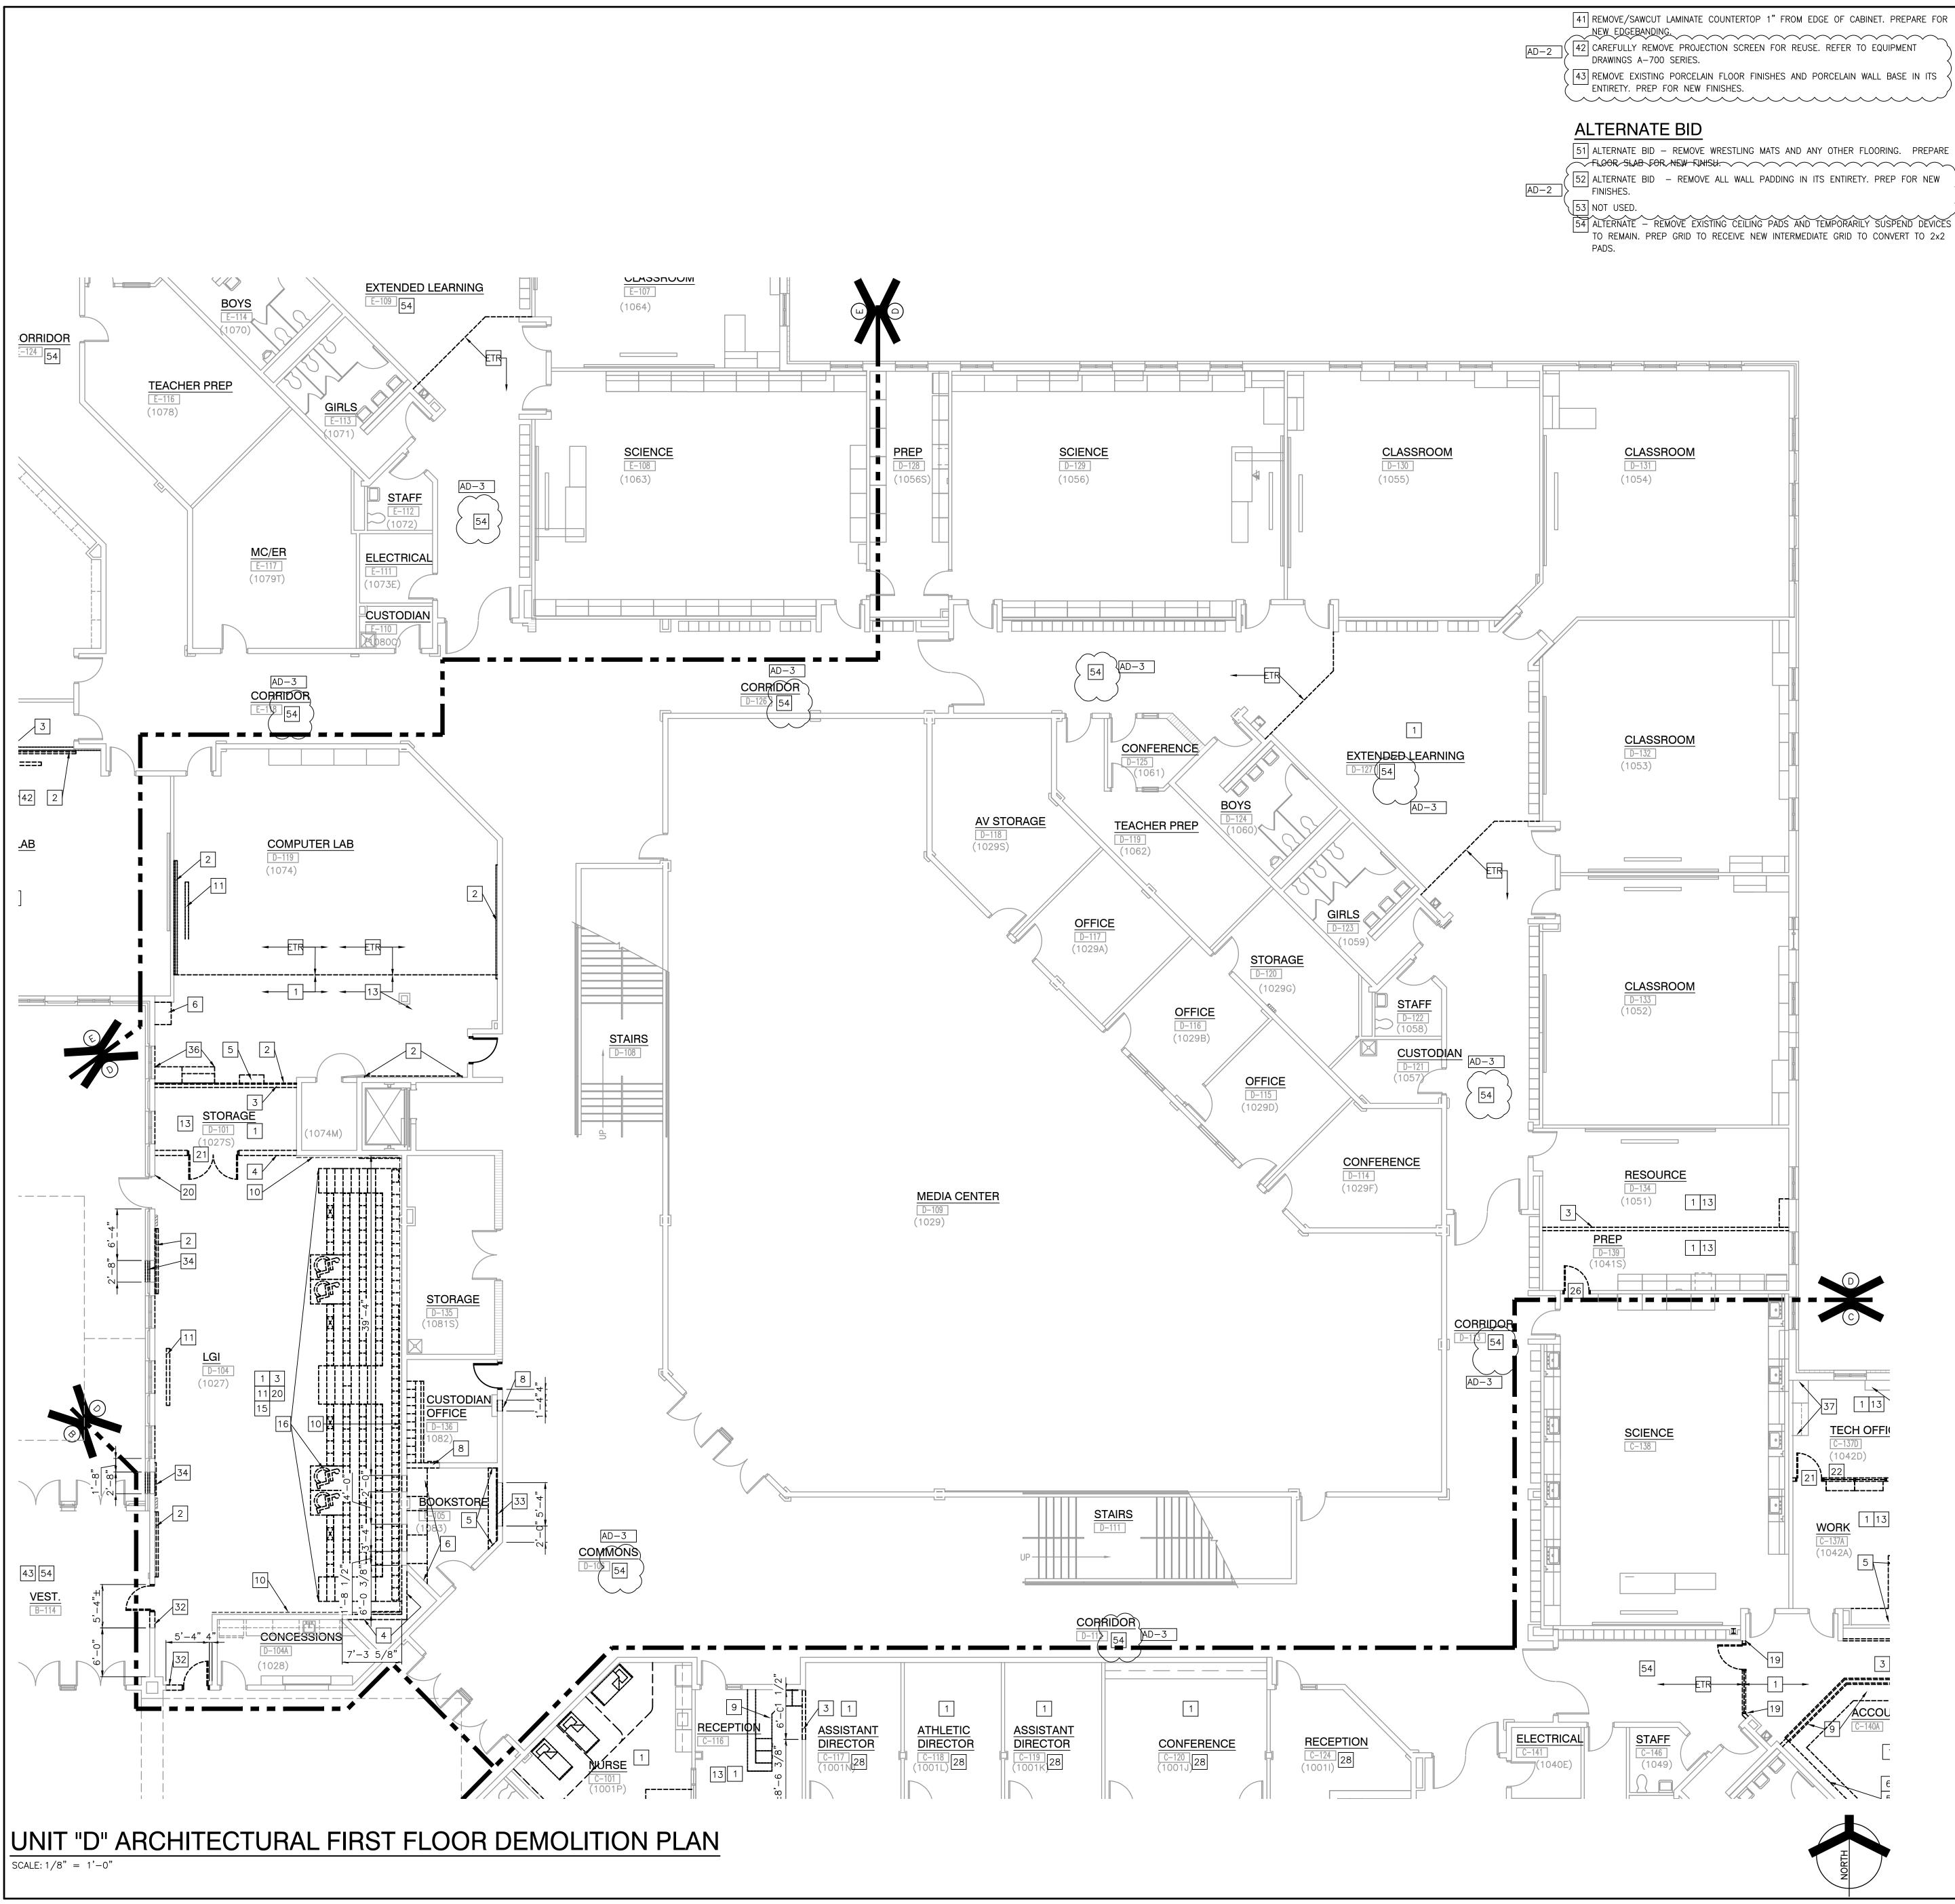



### GENERAL DEMOLITION NOTES:

- A. FOR GENERAL PROJECT NOTES, MATERIAL INDICATIONS LEGEND, SYMBOL LEGEND, ABBREVIATIONS, ETC., REFER TO G SERIES SHEETS. UNLESS NOTED OTHERWISE ON THIS SHEET, THE GENERAL CONTRACTOR IS
- RESPONSIBLE FOR ALL DEMO AND REMOVAL WORK INDICATED ON THIS SHEET. CONTRACTORS ENCOUNTERING EXISTING MATERIAL WHICH IS SUSPECTED OF CONTAINING ASBESTOS SHALL STOP WORK IMMEDIATELY AND NOTIFY THE OWNER AND THE OWNERS REPRESENTATIVE.
- BOLD DASHED LINES INDICATE EXISTING ITEMS TO BE REMOVED UNLESS OTHERWISE NOTED. THE CONTRACTOR IS RESPONSIBLE FOR FIELD VERIFYING THE EXTENT OF DEMOLITION WORK PRIOR TO BIDDING AND FOR COORDINATING THE EXTENT OF DEMOLITION WITH THE INSTALLATION OF NEW SYSTEMS.
- EACH CONTRACTOR SHALL BE RESPONSIBLE FOR ALL DEMOLITION APPLICABLE TO THEIR SCOPE OF WORK AND AS REQUIRED FOR INSTALLATION OF NEW WORK WHETHER OR NOT IT IS SPECIFICALLY INDICATED OR NOTED IN THESE DOCUMENTS. REMOVE ALL ITEMS AND FINISHES MADE OBSOLETE BY NEW CONSTRUCTION. VERIFY
- ITEMS DEEMED OBSOLETE WITH ARCHITECT PRIOR TO REMOVAL. REFER TO NEW CONSTRUCTION DRAWINGS FOR DEMOLITION REQUIRED NOT SHOWN ON DEMOLITION EACH CONTRACTOR SHALL BE RESPONSIBLE FOR OFF SITE REMOVAL OF ALL
- DEMOLITION MATERIALS AND/OR ITEMS UNLESS NOTED OTHERWISE OR DIRECTED BY THE OWNER.
- H. PRIOR TO STARTING DEMOLITION, CONSTRUCT DUST CONTROL BARRIERS AS REQUIRED TO PREVENT THE SPREAD OF DUST INTO SURROUNDING AREAS (WHERE APPLICABLE). WHERE BUILDING EGRESS IS REQUIRED TO PASS THROUGH DEMOLITION, CONSTRUCTION, AND NEW CONSTRUCTION AREAS, PROVIDE APPROVED BARRIERS, ETC
- TO ENSURE SAFETY OF THE PUBLIC. J. RELOCATED ITEMS SHALL BE CLEANED AND PLACED IN STORAGE, PER OWNERS' DIRECTION, UNTIL ITEMS ARE READY TO BE INSTALLED. IF ITEMS ARE DAMAGED
- DURING DEMOLITION OR RELOCATION, THEY SHALL BE REPAIRED OR REPLACED WITH NEW ITEMS AS APPROVED. K. DEMOLITION SHALL BE PERFORMED WITHOUT DAMAGE TO EXISTING CONSTRUCTION T REMAIN. WHERE SUCH DAMAGE OCCURS, PATCH, REPAIR, OR RESTORE WALLS, FLOORS, CEILING, ETC. NEATLY TO MATCH EXISTING ADJACENT SURFACE. PROVIDE SHORING, BRACING, OR SUPPORT TO PREVENT MOVEMENT OR SETTLEMENT OF EXISTING
- STRUCTURES. L. EACH CONTRACTOR IS RESPONSIBLE FOR CUTTING, PATCHING, AND DISCONNECTION OF ITEMS APPLICABLE TO THEIR SCOPE OF WORK. WHERE EXISTING SERVICES ARE ABANDONED, CAP AT LEAST 1" BEHIND NEW FINISHES AND/OR EXISTING SURFACE AND
- PATCH TO RECEIVE NEW FINISHES OR MATCH EXISTING FINISH. M. ON WALLS THAT ARE TO RECEIVE NEW FINISHES, REMOVE AND REINSTALL EXISTING
- EQUIPMENT TO REMAIN FOR INSTALLATION OF NEW FINISHES. N. WHERE WALLS OR BULKHEADS ARE REMOVED, PATCH FLOORS, CEILINGS, AND ADJACENT WALLS AS REQUIRED TO MATCH EXISTING OR RECEIVE NEW FINISHES WHERE APPLICABLE. WHERE EXISTING DUCTWORK, PIPING, OR EQUIPMENT IS REMOVED, PATCH OPENINGS AND/OR SURFACES TO MATCH ADJACENT SURFACES OR RECEIVE NEW FINISHES WHERE APPLICABLE. REFER TO ALL DEMOLITION DRAWINGS FOR EXTENT OF ITEMS TO REMOVED.
- O. OVER CUT NEW OPENINGS IN EXISTING WALL FOR NEW CONSTRUCTION. PATCH AND REPAIR WALLS TO MATCH EXISTING. WHERE APPLICABLE, TOOTH NEW MASONRY INTO EXISTING MASONRY.
- P. ALL EQUIPMENT AND FURNITURE WHICH ARE CONSIDERED LOOSE FURNISHING SHALL BE REMOVED BY THE OWNER PRIOR TO DEMOLITION.
- Q. MASONRY WALLS TO BE REMOVED SHALL BE REMOVED TO A POINT 2" MINIMUM BELOW THE EXISTING FLOOR SLAB UNLESS SETTING ON A SLAB OR SPECIFICALLY NOTED OTHERWISE. PATCH WITH NEW CONCRETE TO BE FLUSH WITH THE EXISTING FLOOR SLAB.
- R. EACH CONTRACTOR SHALL BE RESPONSIBLE FOR GENERAL REVIEW OF DEMOLITION NOTES AND GENERAL DEMOLITION NOTES AS THEY APPLY TO THEIR SCOPE OF WORK. S. THE OWNER RESERVES THE RIGHT TO CLAIM ANY MATERIALS THAT ARE BEING
- DEMOLISHED PRIOR TO THE CONTRACTOR DISPOSING OF THEM OFF SITE. T. REFER TO THE STRUCTURAL, MECHANICAL, PLUMBING, ELECTRICAL AND TECHNOLOGY
- DOCUMENTS FOR COMPLETE SCOPE OF DEMOLITION WORK. U. "FLOORING" DENOTES FLOOR COVERING MATERIALS INCLUDING BACKING, ADHESIVES AND BASES DOWN TO BUT EXCLUSIVE OF FLOOR SLABS AND STRUCTURAL MATERIALS
- UNLESS NOTED OTHERWISE. V. DEMOLITION IS TO FOLLOW ESTABLISHED CONSTRUCTION SEQUENCE. REFER TO SPECIFICATIONS AND DRAWINGS FOR REQUIREMENTS AND SPECIAL CONDITIONS.
- W. WHERE APPLICABLE SALVAGE EXISTING MASONRY (FACE BRICK, GLAZED CMU, FACING TILE) AS REQUIRED FOR PATCHING AND INFILL IN RENOVATED AREAS WHERE INDICATED DISCARD UNUSED PORTION OFF SITE.
- X. REFER TO STRUCTURAL SHEETS FOR NEW LINTELS IN OPENINGS CREATED IN EXISTING MASONRY WALLS **DEMOLITION PLAN NOTES:**


# (ALL PLAN NOTES MAY NOT BE INDICATED ON THIS SHEET.)


- 1 REMOVE EXISTING FLOOR FINISHES AND WALL BASE IN ITS ENTIRETY. PREP FOR NEW
- FINISHES. 2 REMOVE MARKERBOARD/ TACKBOARD/ CHALKBOARD IN ITS ENTIRETY, PREP WALL
- FOR NEW FINISHES.
- 3 REMOVE METAL STUD WALL. PATCH AND REPAIR ADJACENT FLOOR AND WALL TO ACCEPT NEW FINISHES.
- 4 REMOVE MASONRY WALL. PATCH AND REPAIR ADJACENT FLOOR AND WALL TO
- ACCEPT NEW FINISHES. 5 REMOVE BASE CABINETS AND COUNTERTOP SYSTEM COMPLETE. PATCH AND REPAIR
- WALL AND FLOOR TO RECEIVE NEW FINISHES. 6 REMOVE WALL CABINET SYSTEM COMPLETE. PATCH AND REPAIR WALL AND FLOOR TO
- RECEIVE NEW FINISHES. 7 REMOVE SHELVING SYSTEM IN ITS ENTIRETY. PATCH AND REPAIR WALL AND FLOOR
- TO RECEIVE NEW FINISHES. 8 REMOVE PORTION OF WALL FOR NEW CONSTRUCTION
- 9 REMOVE EXISTING MILLWORK SYSTEM IN ITS ENTIRETY. PATCH AND REPAIR WALL AND FLOOR TO RECEIVE NEW FINISHES.
- 10 REMOVE EXISTING TECTUM WALL FINISH FROM EXISTING CMU WALLS.
- 11 REMOVE MOUNTED PROJECTOR/ SPEAKER ASSEMBLY IN ITS ENTIRETY. 12 REMOVE TECHNOLOGY ASSEMBLIES. REFER TO TECHNOLOGY AND MEP DRAWINGS F
- ADDITIONAL INFORMATION.
- 13 REMOVE ACOUSTICAL CEILING SYSTEM AND DEVICES THEREIN.
- 14 REMOVE EXISTING GYPSUM CEILING SYSTEM / BULKHEADS IN ITS ENTIRETY. 15 REMOVE EXISTING VCT FLOOR FINISH AND TRANSITIONS. PREP FOR NEW FINISHES.
- 16 REMOVE TELESCOPING BLEACHER SYSTEM COMPLETE.
- 17 REMOVE AND SALVAGE EXISTING KILN AND HOOD IN ITS ENTIRETY. INSTALL INSULATED PANEL BEHIND EXTERIOR WALL LOUVER WATER TIGHT.
- 18 REMOVE SHELVING AND COUNTER TOP SYSTEM IN ITS ENTIRETY. PATCH AND F WALL AND FLOOR TO RECEIVE NEW FINISHES.
- 19 REMOVE METAL DOOR AND GLAZING ASSEMBLY, AND PERIMETER STUD WALL CONSTRUCTION UP TO MASONRY WALL. PATCH WALL AND FLOOR TO RECEIVE NEW FINISHES.
- 20 REMOVE TV ASSEMBLY COMPLETE. PATCH AND REPAIR WALL TO RECEIVE NEW FINISHES.
- 21 REMOVE EXISTING DOOR, FRAME AND HARDWARE SYSTEM IN ITS ENTIRETY.
- 22 REMOVE EXISTING HOLLOW METAL FRAME AND GLAZING COMPLETE.
- 23 REMOVE GYPSUM BOARD BULKHEAD COMPLETE
- 24 REMOVE EXISTING SPEAKER ASSEMBLY IN ITS ENTIRETY.
- 25 REMOVE EXISTING BASE CABINETS, WALL CABINETS AND PLUMBING FIXTURES COMPLETE. CUT AND CAP LINE BELOW WALL OR FLOOR SURFACE. UNLESS OTHERWISE NOTED ON PLUMBING DRAWINGS, PATCH AND REPAIR FLOOR AND/ OR WALL TO ACCEPT NEW FINISHES.
- 26 REMOVE EXISTING DOOR, FRAME AND HARDWARE SYSTEM COMPLETE. PREP WALL TO
- RECEIVE CONSTRUCTION.
- 27 EXISTING MASONRY VENEER WALL TO REMAIN. CAREFULLY PATCH AND REPAIR DAMAGE TO RETURN TO LIKE NEW CONDITION. 28 REMOVE CEILING PADS. CLEAN GRID.
- 29 MODIFY EXISTING SINK AND DRAIN ASSEMBLY TO PROVIDE PLASTER TRAPS. REFER TO PLUMBING DRAWINGS FOR ADDITIONAL INFO.
- 30 EXISTING LAY-IN CEILING GRID AND SUSPENSION SYSTEM TO REMAIN. MODIFY TO ACCOMMODATE NEW MEP, FP, AND TECH AT AND ABOVE CEILING. REINSTALL ASSEMBLIES TO RETURN TO LIKE NEW CONDITION. SALVAGE CEILING PADS FOR REINSTALL.
- 31 REMOVE EXISTING BUILDING LETTERING FROM MASONRY VENEER. PATCH WITH EPOXY - FILLER TO MATCH SURROUNDING MASONRY.
- 32 CAREFULLY REMOVE DOOR AND PORTION OF MASONRY WALL FOR NEW CONSTRUCTION. *SALVAGE ALL DECORATIVE MASONRY AND (TILE BASE*.
- AD-2 33 REMOVE OVERHEAD COILING DOOR COMPLETE.
- 34 REMOVE EXTERIOR WALL SYSTEM FOR NEW ALUMINUM WINDOW SYSTEM. WHERE SMALLER WINDOW EXISTS, REMOVE WINDOW, SALVAGE MARBLE SILL. 35 REMOVE EXISTING STOOP. REFER TO CIVIL SHEETS FOR SITE DEMO.
- 36 REMOVE AND SALVAGE CASEWORK IN ITS ENTIRETY. PATCH AND REPAIR WALL AND
- FLOOR TO ACCEPT NEW FINISHES. REFER TO EQUIPMENT PLANS.
- 37 EXISTING CASEWORK TO REMAIN.
- 38 REMOVE TALL CABINET SYSTEM COMPLETE. PATCH AND REPAIR WALL AND FLOOR TO RECEIVE NEW FINISHES.
- 39 EXISTING REFRIGERATOR TO BE REMOVED BY OWNER.
- 40 REMOVE CEILING TILE. GRID TO REMAIN. REWORK FOR NEW EXHAUST HOOD.

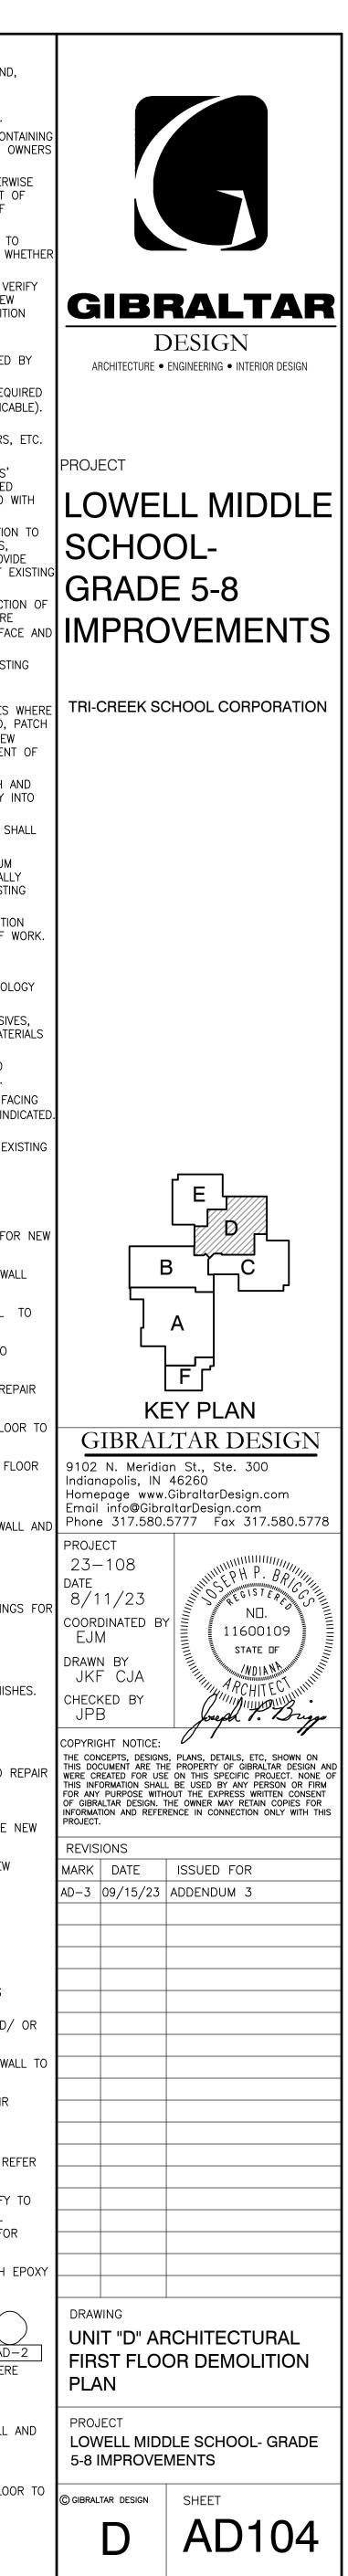

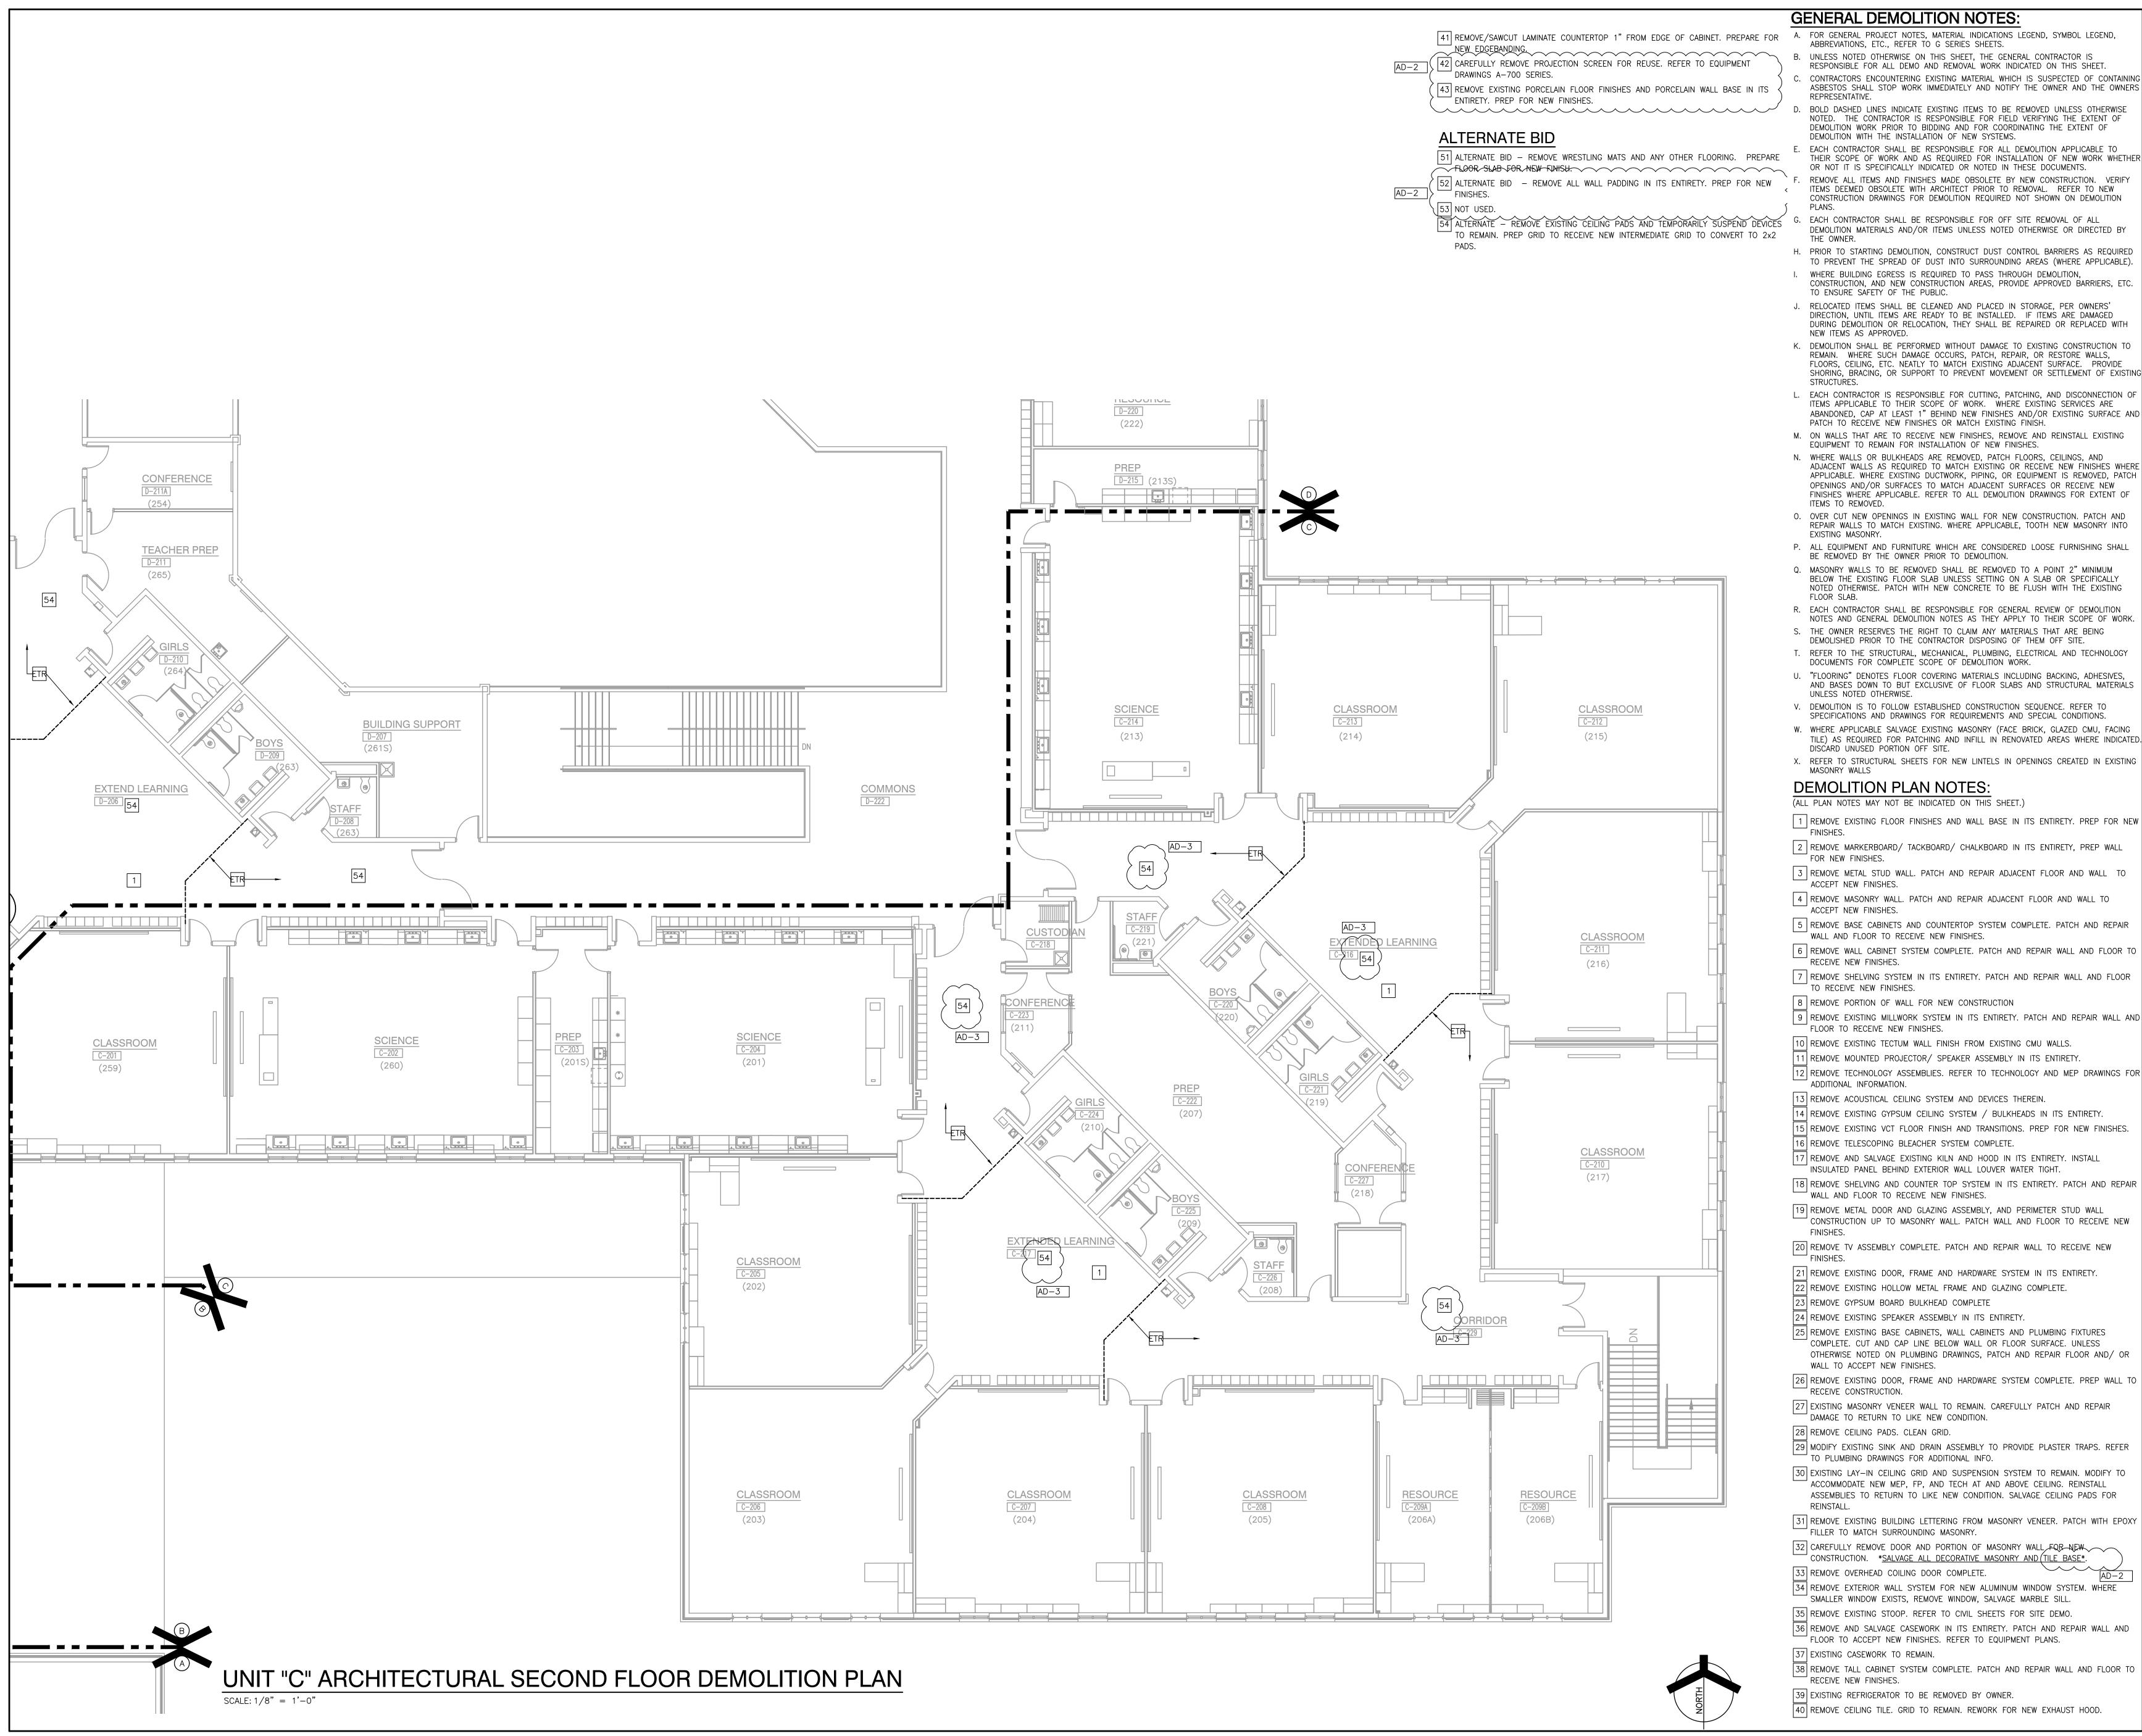

40 REMOVE CEILING TILE. GRID TO REMAIN. REWORK FOR NEW EXHAUST HOOD.

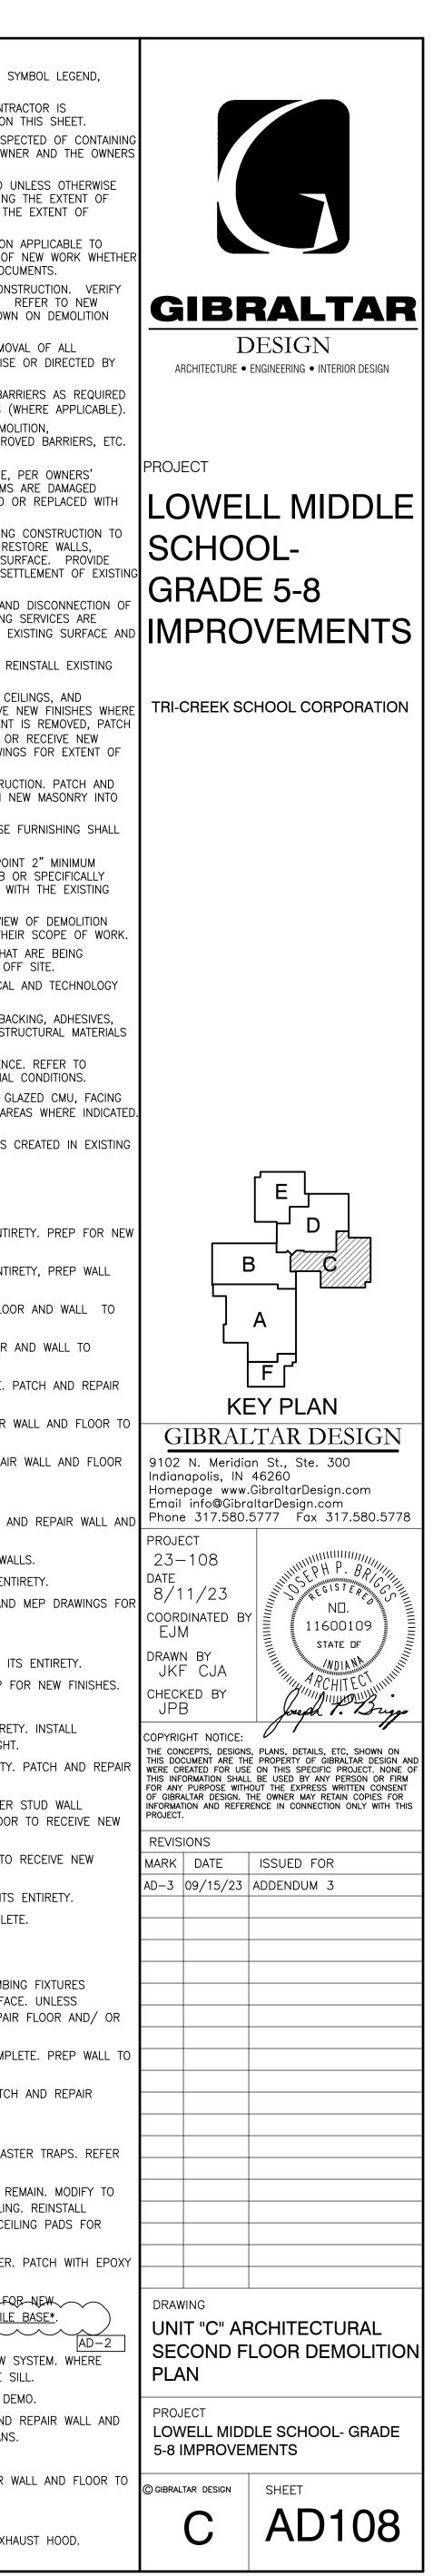

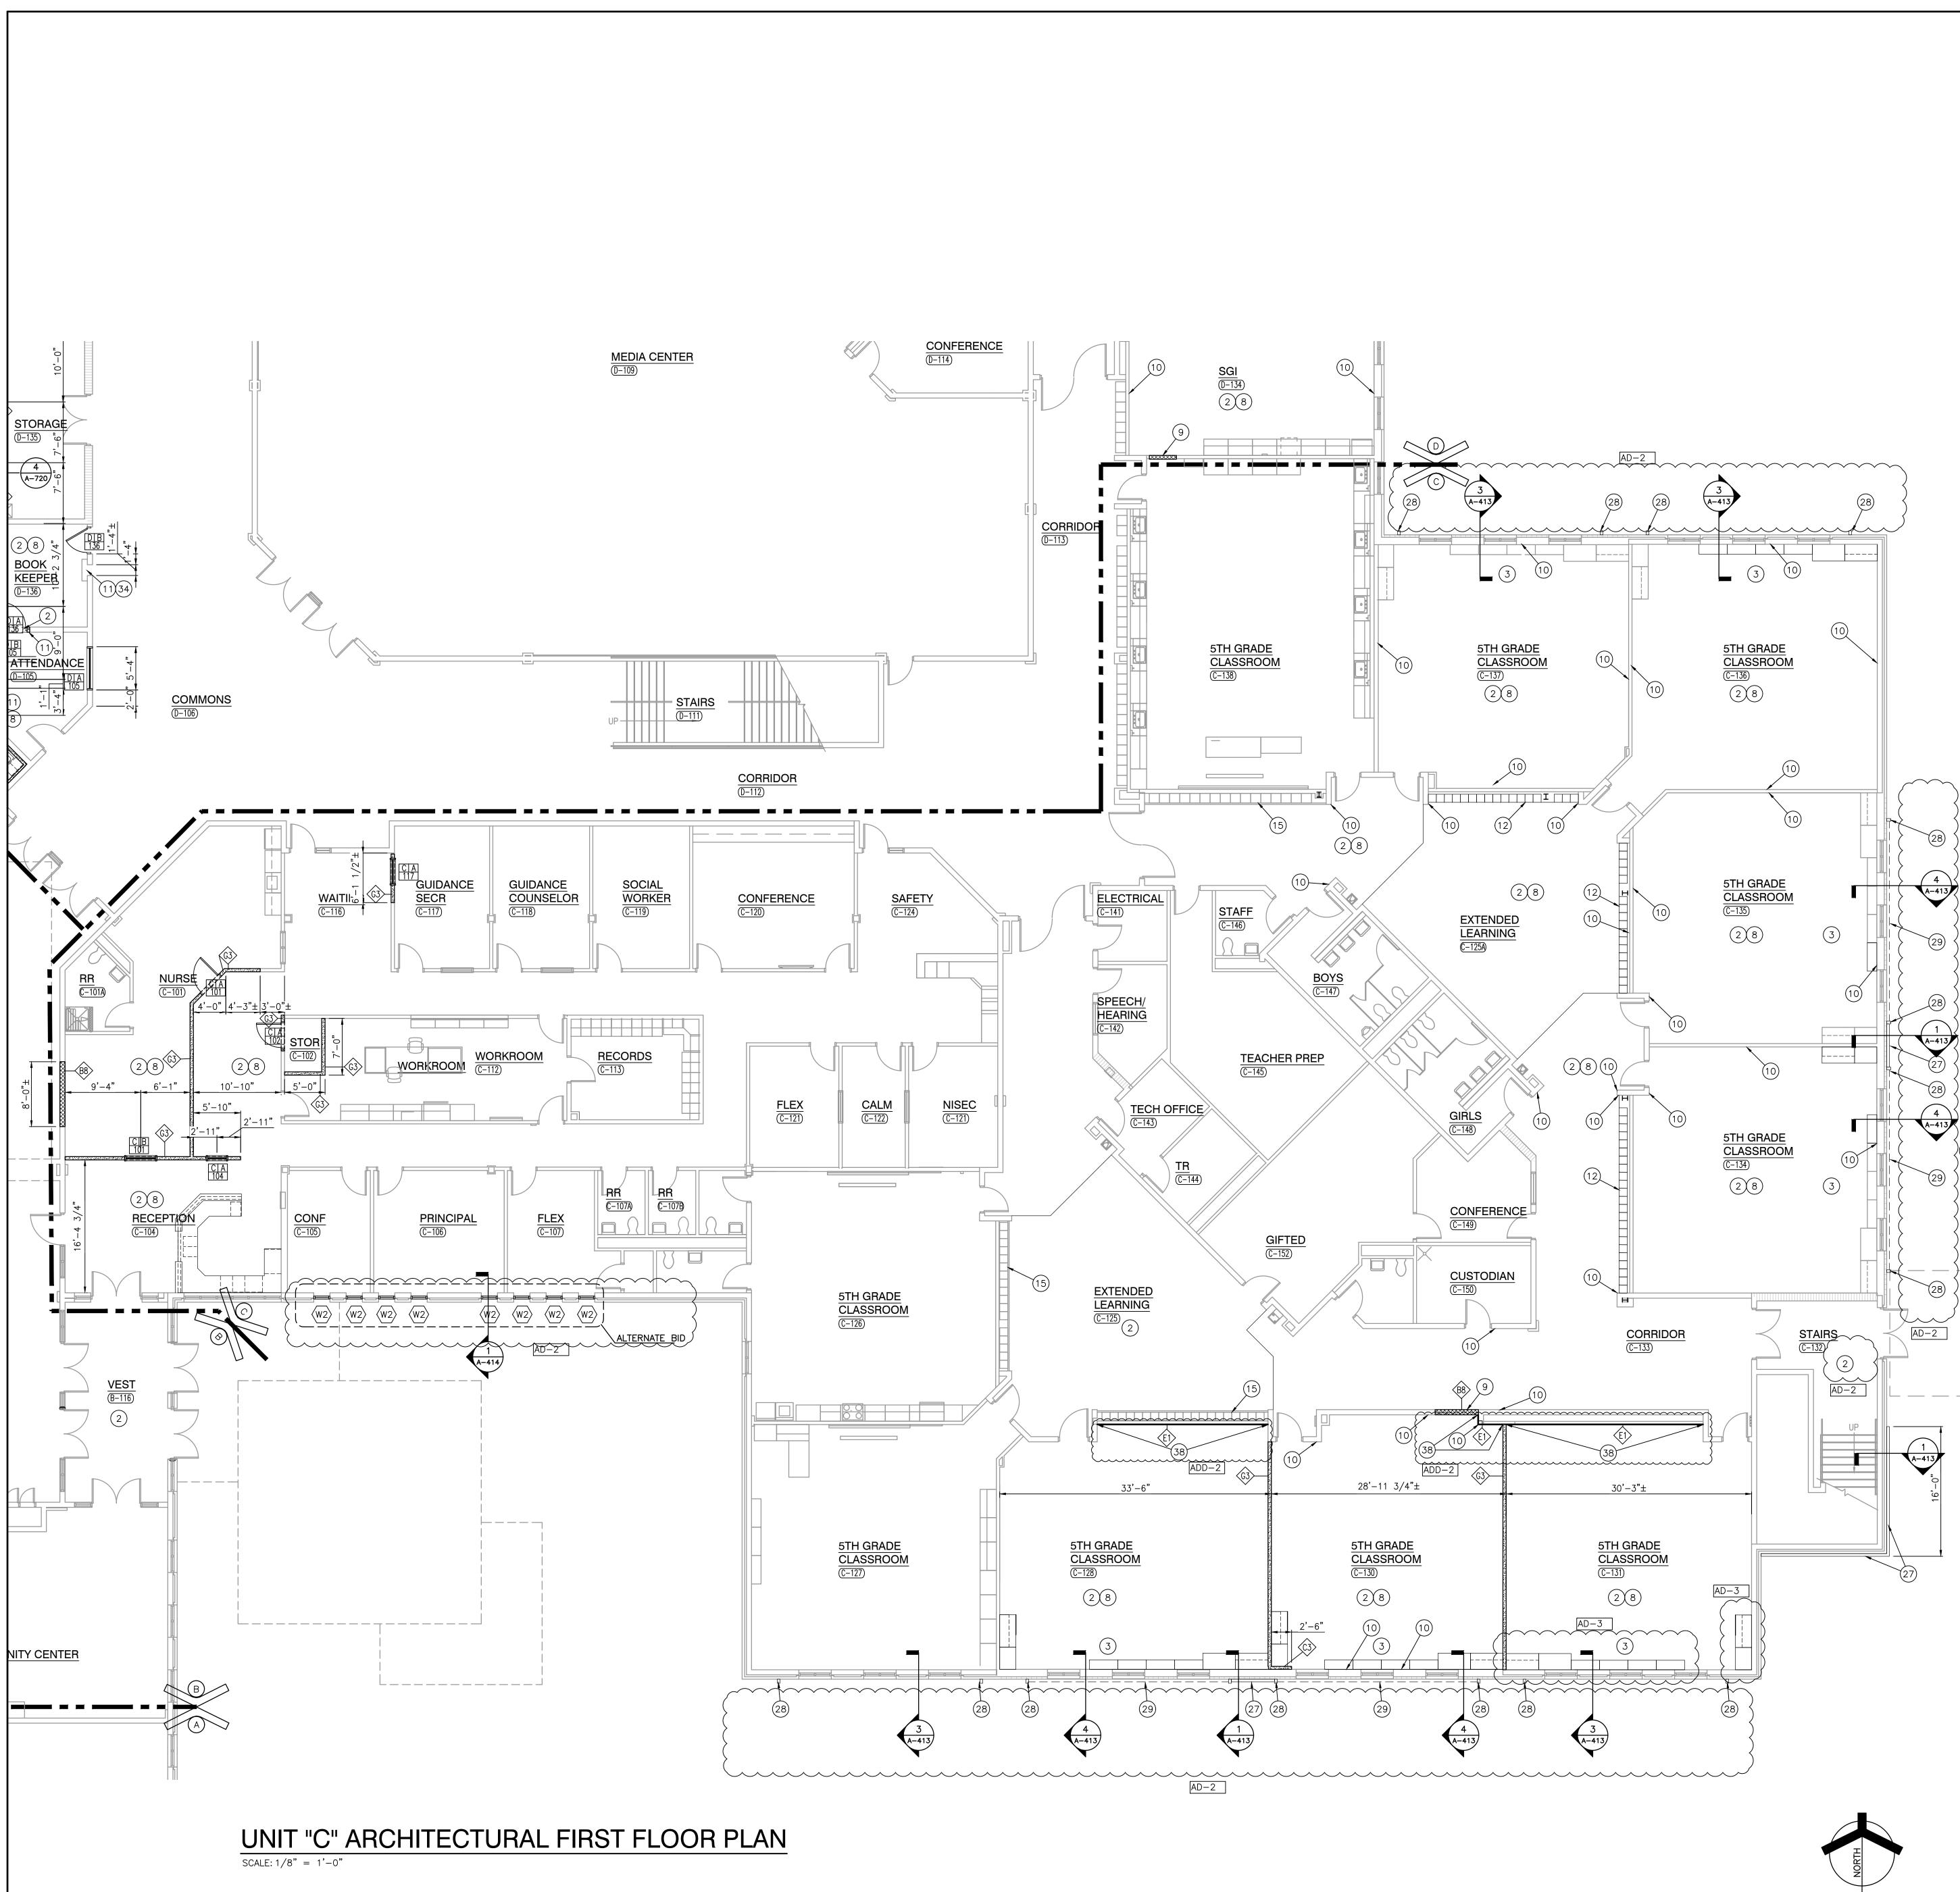

## **GENERAL PLAN NOTES:**

- A. FOR GENERAL PROJECT NOTES, MATERIAL INDICATIONS LEGEND, SYMBOL LEGEND, ABBREVIATIONS, ETC., REFER TO GI SERIES SHEETS. B. PLAN DIMENSIONS TO MASONRY WALLS ARE TO FACE OF ROUGH MASONRY.
- PLAN DIMENSIONS TO STUD WALLS ARE TO FACE OF FINISHED GYPSUM BOARD OR PLASTER. PLAN DIMENSIONS TO STUD WALLS WITH CERAMIC TILE FINISH ARE TO THE FACE OF TILE BACKER BOARD.
- C. ALL CMU WALLS THAT DO NOT LAY OUT IN FULL OR HALF LENGTHS SHOULD BE BALANCED SO AS NOT TO HAVE ANY PIECES LESS THAN 4" IN SIZE EXPOSED TO VIEW. D. MASONRY WALLS BEARING ON A THICKENED SLAB AT SLAB DEPRESSIONS
- REQUIRE CUT MASONRY UNITS SO THAT COURSING BEGINS AT THE FLOOR LINE.
- E. THE BASE FIRST FLOOR ELEVATION INDICATED FOR THE PROJECT IS 100'-0". REFER TO SITE PLAN FOR CORRELATION TO USGS DATUM.
- F. HINGE SIDE OF DOOR JAMB AT CMU WALLS SHALL BE LOCATED 8" MINIMUM GIBRALTAR FROM ADJACENT WALL AND HINGE SIDE OF DOOR JAMB AT GYPSUM BOARD WALLS SHALL BE LOCATED 4" MINIMUM FROM ADJACENT WALL UNLESS NOTED OTHERWISE.
- G. PROVIDE WOOD BLOCKING (OR METAL STRAPPING WHERE APPLICABLE) WITHIN METAL STUD WALLS FOR WALL MOUNTED ITEMS.
- H. REFER TO LIFE SAFETY PLANS REGARDING FIRE RATED WALL LOCATIONS AND OTHER CODE INFORMATION.
- I. INTERIOR CMU WALLS ARE TO BE RUNNING BOND UNLESS NOTED
- OTHERWISE. J. WHERE NEW CMU WALLS INTERSECT EXISTING CMU WALLS AT A CORNER OR ARE ALIGNED WITH EXISTING CMU WALLS, TOOTH NEW CMU INTO EXISTING
- CMU UNLESS NOTED OTHERWISE. K. REFER TO FINISH PLANS FOR LOCATION AND EXTENT OF FINISHED FLOOR AND WALL MATERIAL.
- L. ALL EXPOSED CONCRETE MASONRY UNITS (CMU) CORNERS ARE TO BE BULLNOSED, EXCEPT AT MASONRY BULKHEADS AND EXTERIOR WINDOW
- JAMBS. M. REFER TO DEMOLITION SHEETS FOR ADDITIONAL PATCHING AND REPAIR WORK.

# PLAN LEGEND:

 $\bigcirc$  INDICATES STOREFRONT, CURTAIN WALL, OR WINDOW SYSTEM. REFER TO A-600 SERIES SHEETS FOR ELEVATIONS AND DETAILS. A-600 SERIES SHEETS FOR ELEVATIONS AND DETAILS. INDICATES WALL TYPES REFER TO A-501 FOR WALL THICKNESS, HEIGHT, AND COMPOSITION.


### PLAN NOTES:


- (ALL PLAN NOTES MAY NOT BE INDICATED ON THIS SHEET.)
- (1) CONCRETE STOOP/VOID SLAB. (2) PATCH FLOOR, SKIM COAT FOR NEW FINISHES.
- (3) CASEWORK / MILLWORK / AND OR COUNTERTOP (TYPICAL), REFER TO EQUIPMENT PLANS.
- (4) CARD READER, REFER TO ELECTRICAL/TECHNOLOGY SHEETS.
- (5) PUSH PAD FOR ADA OPERATOR, REFER TO ELECTRICAL SHEETS..
- (6) EXPANSION JOINT COVER.
- 7) FLOOR DRAIN, REFER TO PLUMBING SHEETS.
- (8) PATCH WALLS. PREPARE WALLS AND FRAMES FOR NEW FINISHES. (9) WHERE DOOR FRAME HAS BEEN REMOVED, INFILL WALL TO MATCH
- EXISTING ADJACENT WALL SURFACES, TOOTH IN CMU (TYPICAL). (10) WHERE CONNECTING WALL HAS BEEN REMOVED, PATCH WALL TO MATCH
- EXISTING ADJACENT WALL SURFACES (TYPICAL) (11) TOOTH IN CMU INTO NEW OPENING TO MATCH ADJACENT MASONRY
- SURFACES. (12) NEW LOCKERS. REFER TO EQUIPMENT PLANS.
- 13) NEW CONCRETE SIDEWALK SLAB.
- (14) DASHED LINE INDICATES TYPICAL BULKHEAD, REFER TO SECTIONS AND REFLECTED CEILING PLANS. (ALL BULKHEADS ARE NOT INDICATED ON THIS PLAN)
- (15) EXISTING LOCKERS TO REMAIN. PROTECT DURING CONSTRUCTION.
- (16) SCOREBOARD. REFER TO ELECTRICAL. 17) DISPLAY BOARD/TV MONITOR, REFER TO EQUIPMENT PLANS.
- (18) SEMI-RECESSED FIRE EXTINGUISHER CABINET. REFER TO SHEET A-501.
- 19) SURFACE MOUNTED FIRE EXTINGUISHER
- 20) MECHANICAL LOUVER. REFER TO MECHANICAL SHEETS AND SHEET A-501. (21) GYM DIVIDER CURTAIN.
- (22) MAT LIFTER SUPPORTED ON EXISTING JOISTS. REFER TO STRUCTURAL DRAWINGS FOR JOIST REINFORCEMENT. REFER TO ELECTRICAL CENTER ON ROOM
- (23) MOTOR OPERATED BLEACHERS. REFER TO EQUIPMENT PLAN AND ELECTRICAL.
- (24) 6'-0"H ATHLETIC WALL PROTECTION PADDING. REFER TO SHEET A-501.
- 25) CASEWORK RELOCATED FROM E-120 SHEET AD-105.
- 26) 2" EXPANSION JOINT MATERIAL AND ALUMINUM PLATE. COMPOSITE ALUMINUM WALL PANELS ON EXISTING MASONRY WALL. REFER
- TO WALL SECTIONS 28 DECORATIVE ALUMINUM RAIL. REFER TO SECTION SHEET AND 6/A-412.)
- 9) COMPOSITE ALUMINUM WALL PANEL ABOVE.
- 0 CASEWORK RELOCATED FROM D-119 SHEET AD-105. 31) CASEWORK RELOCATED FROM D-204 SHEET AD-109.
- (32) MOP SINK. REFER TO PLUMBING.
- (33) SOUND SYSTEM. REFER TO ELECTRICAL.
- (34) MODIFY MASONRY WALL FOR THROUGH WALL DROP BOX. (35) METAL LADDER TO ROOF HATCH
- (36) PROVIDE NEW EDGE BANDING WHERE LAMINATE TOP WAS CUT. MATCH
- EXISTING FINISH. (37) DASHED LINES INDICATE BOND BEAM LINTEL ABOVE AT 8'-8" PAINT.


(38) LAMINATE 5/8" GYPSUM BOARD TO EXISTING WALL. AD-2


PLAN NOTES Owner Furnished and Installec (ALL PLAN NOTES MAY NOT BE INDICATED ON THIS SHEET.) (40) VENDING MACHINES

(41) REFRIGERATOR

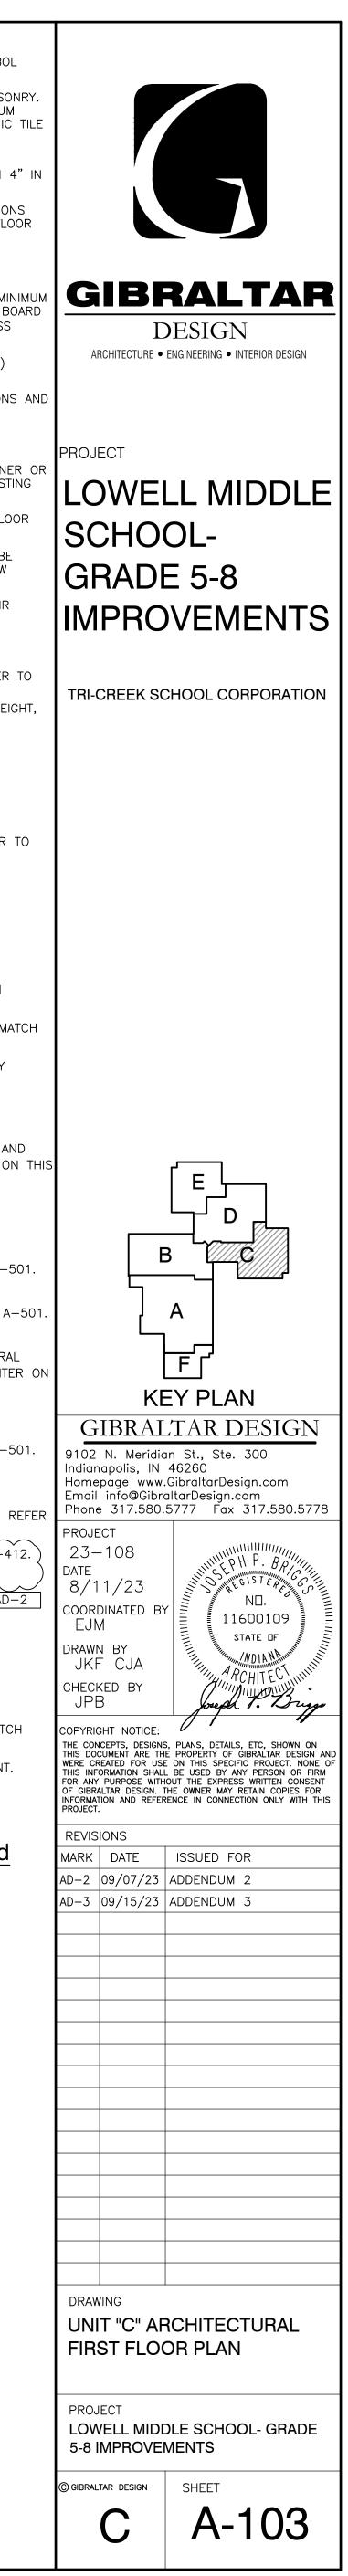


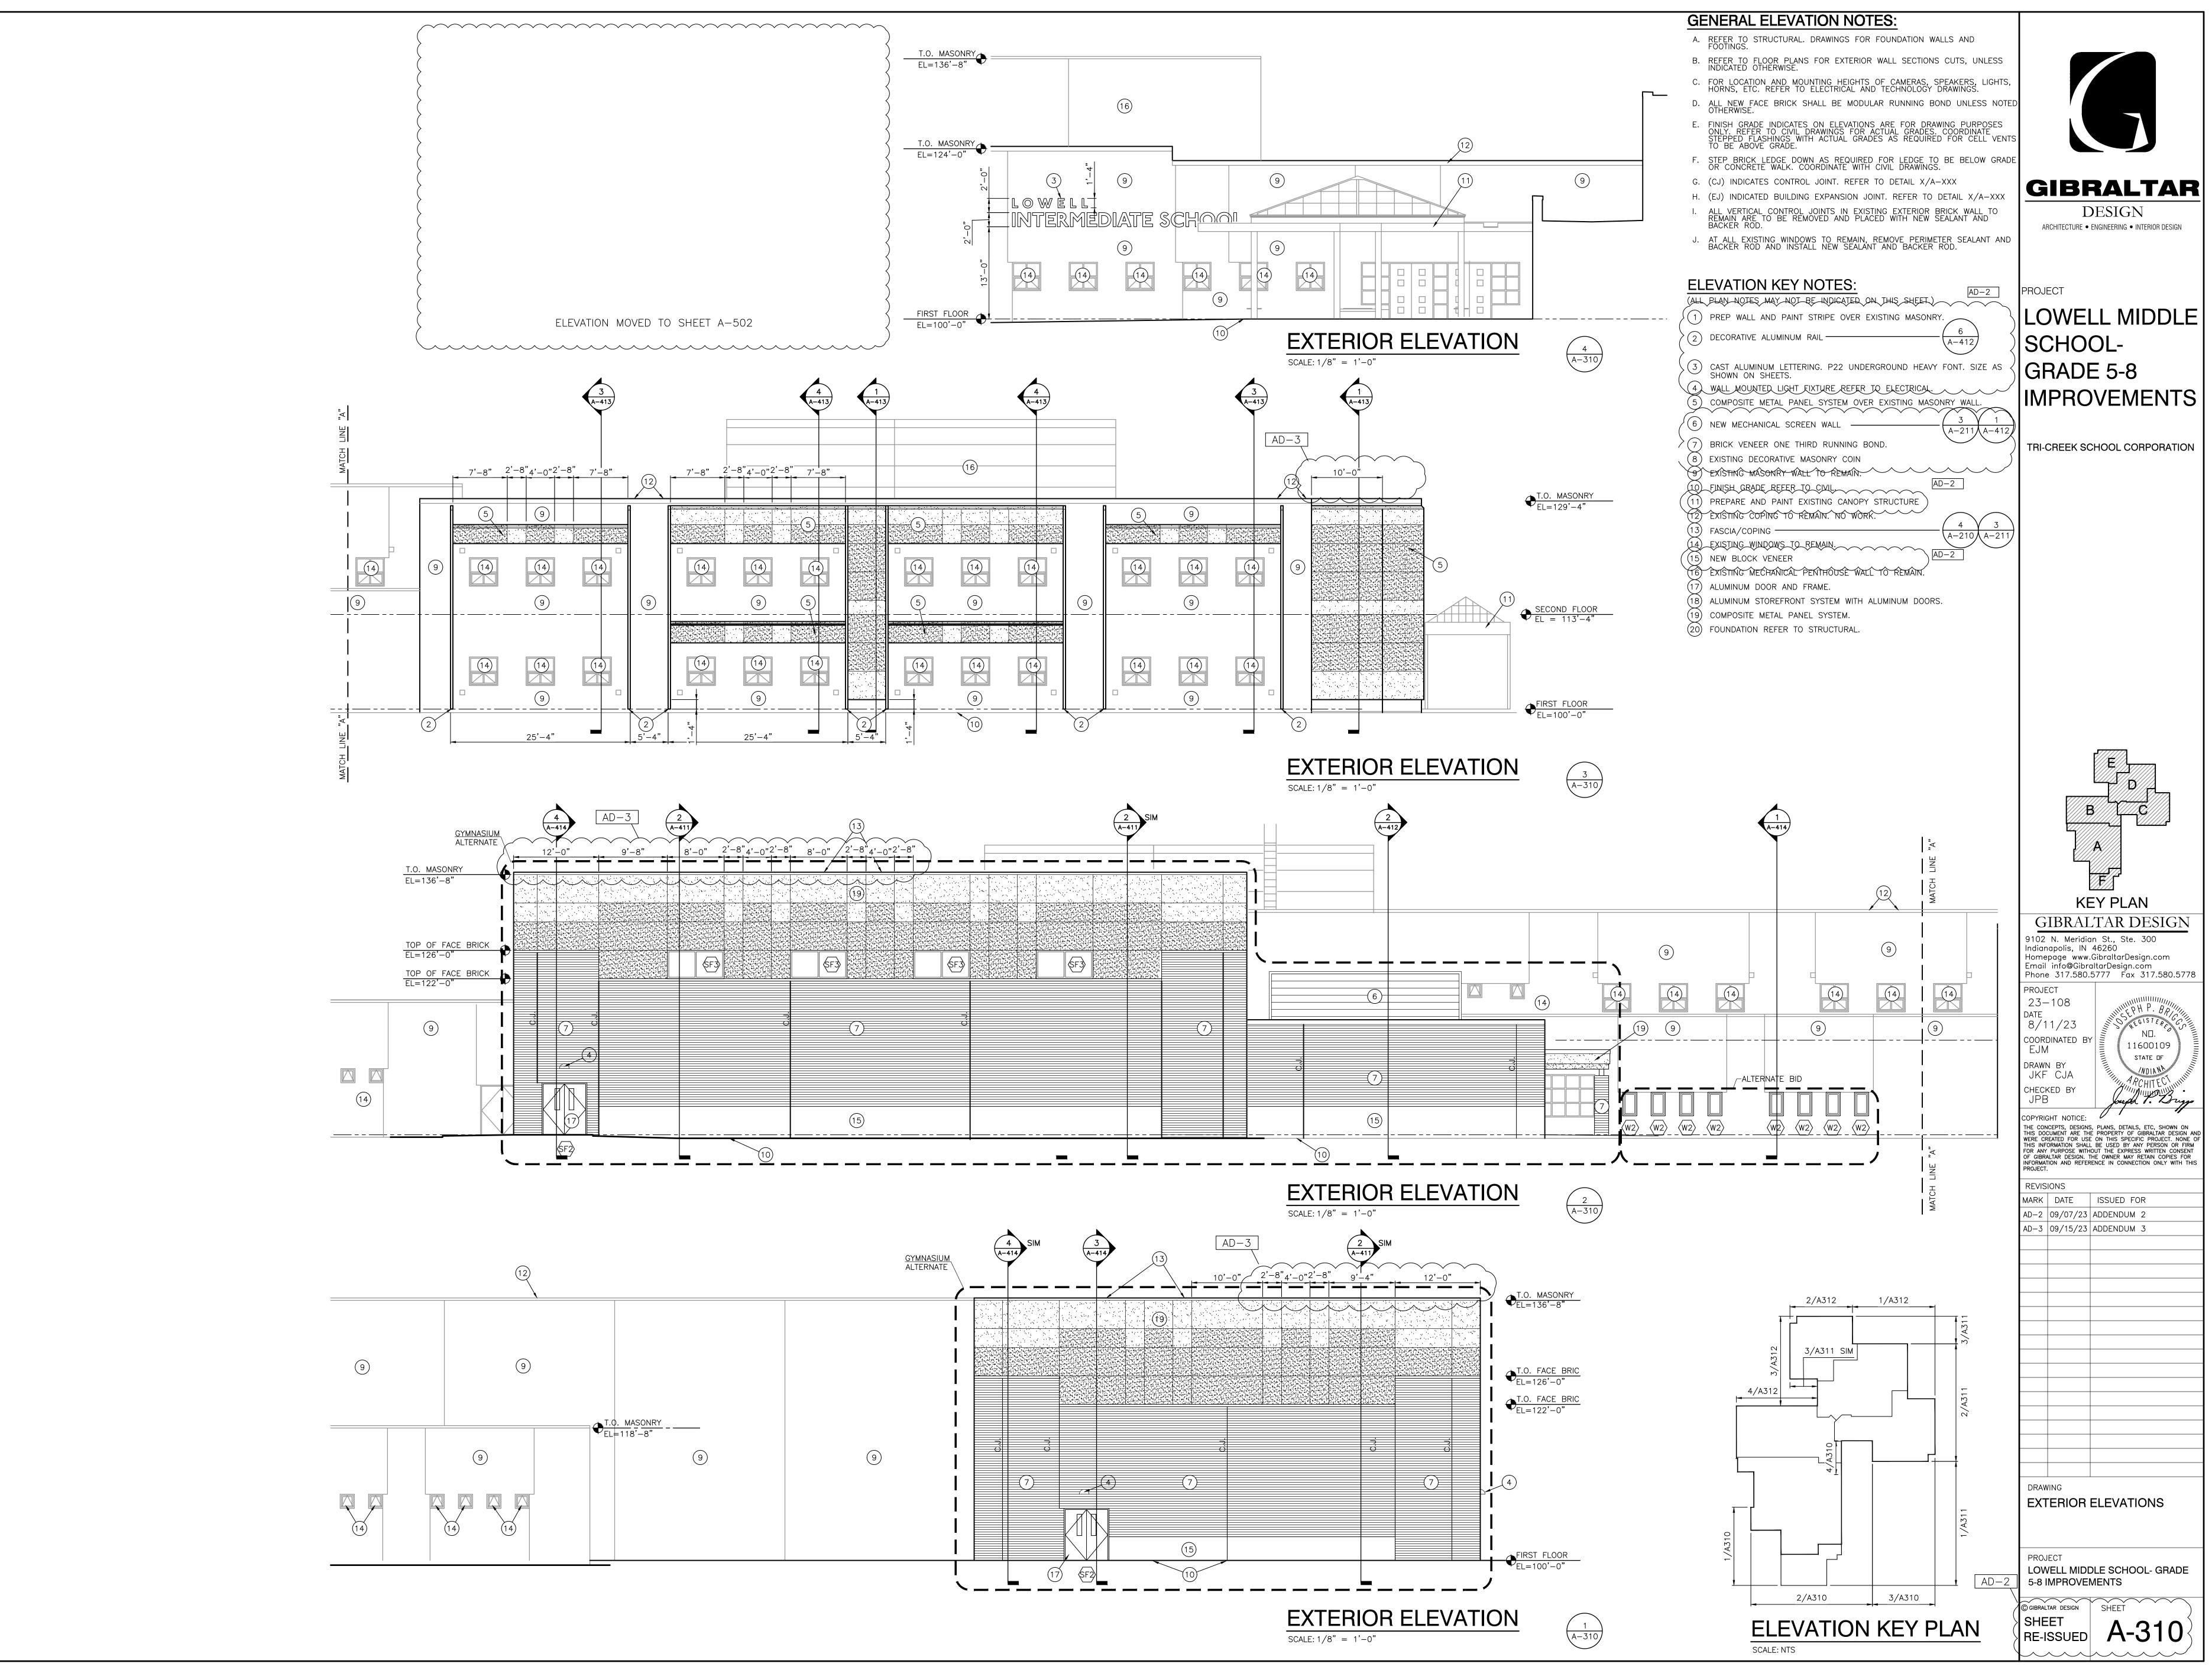

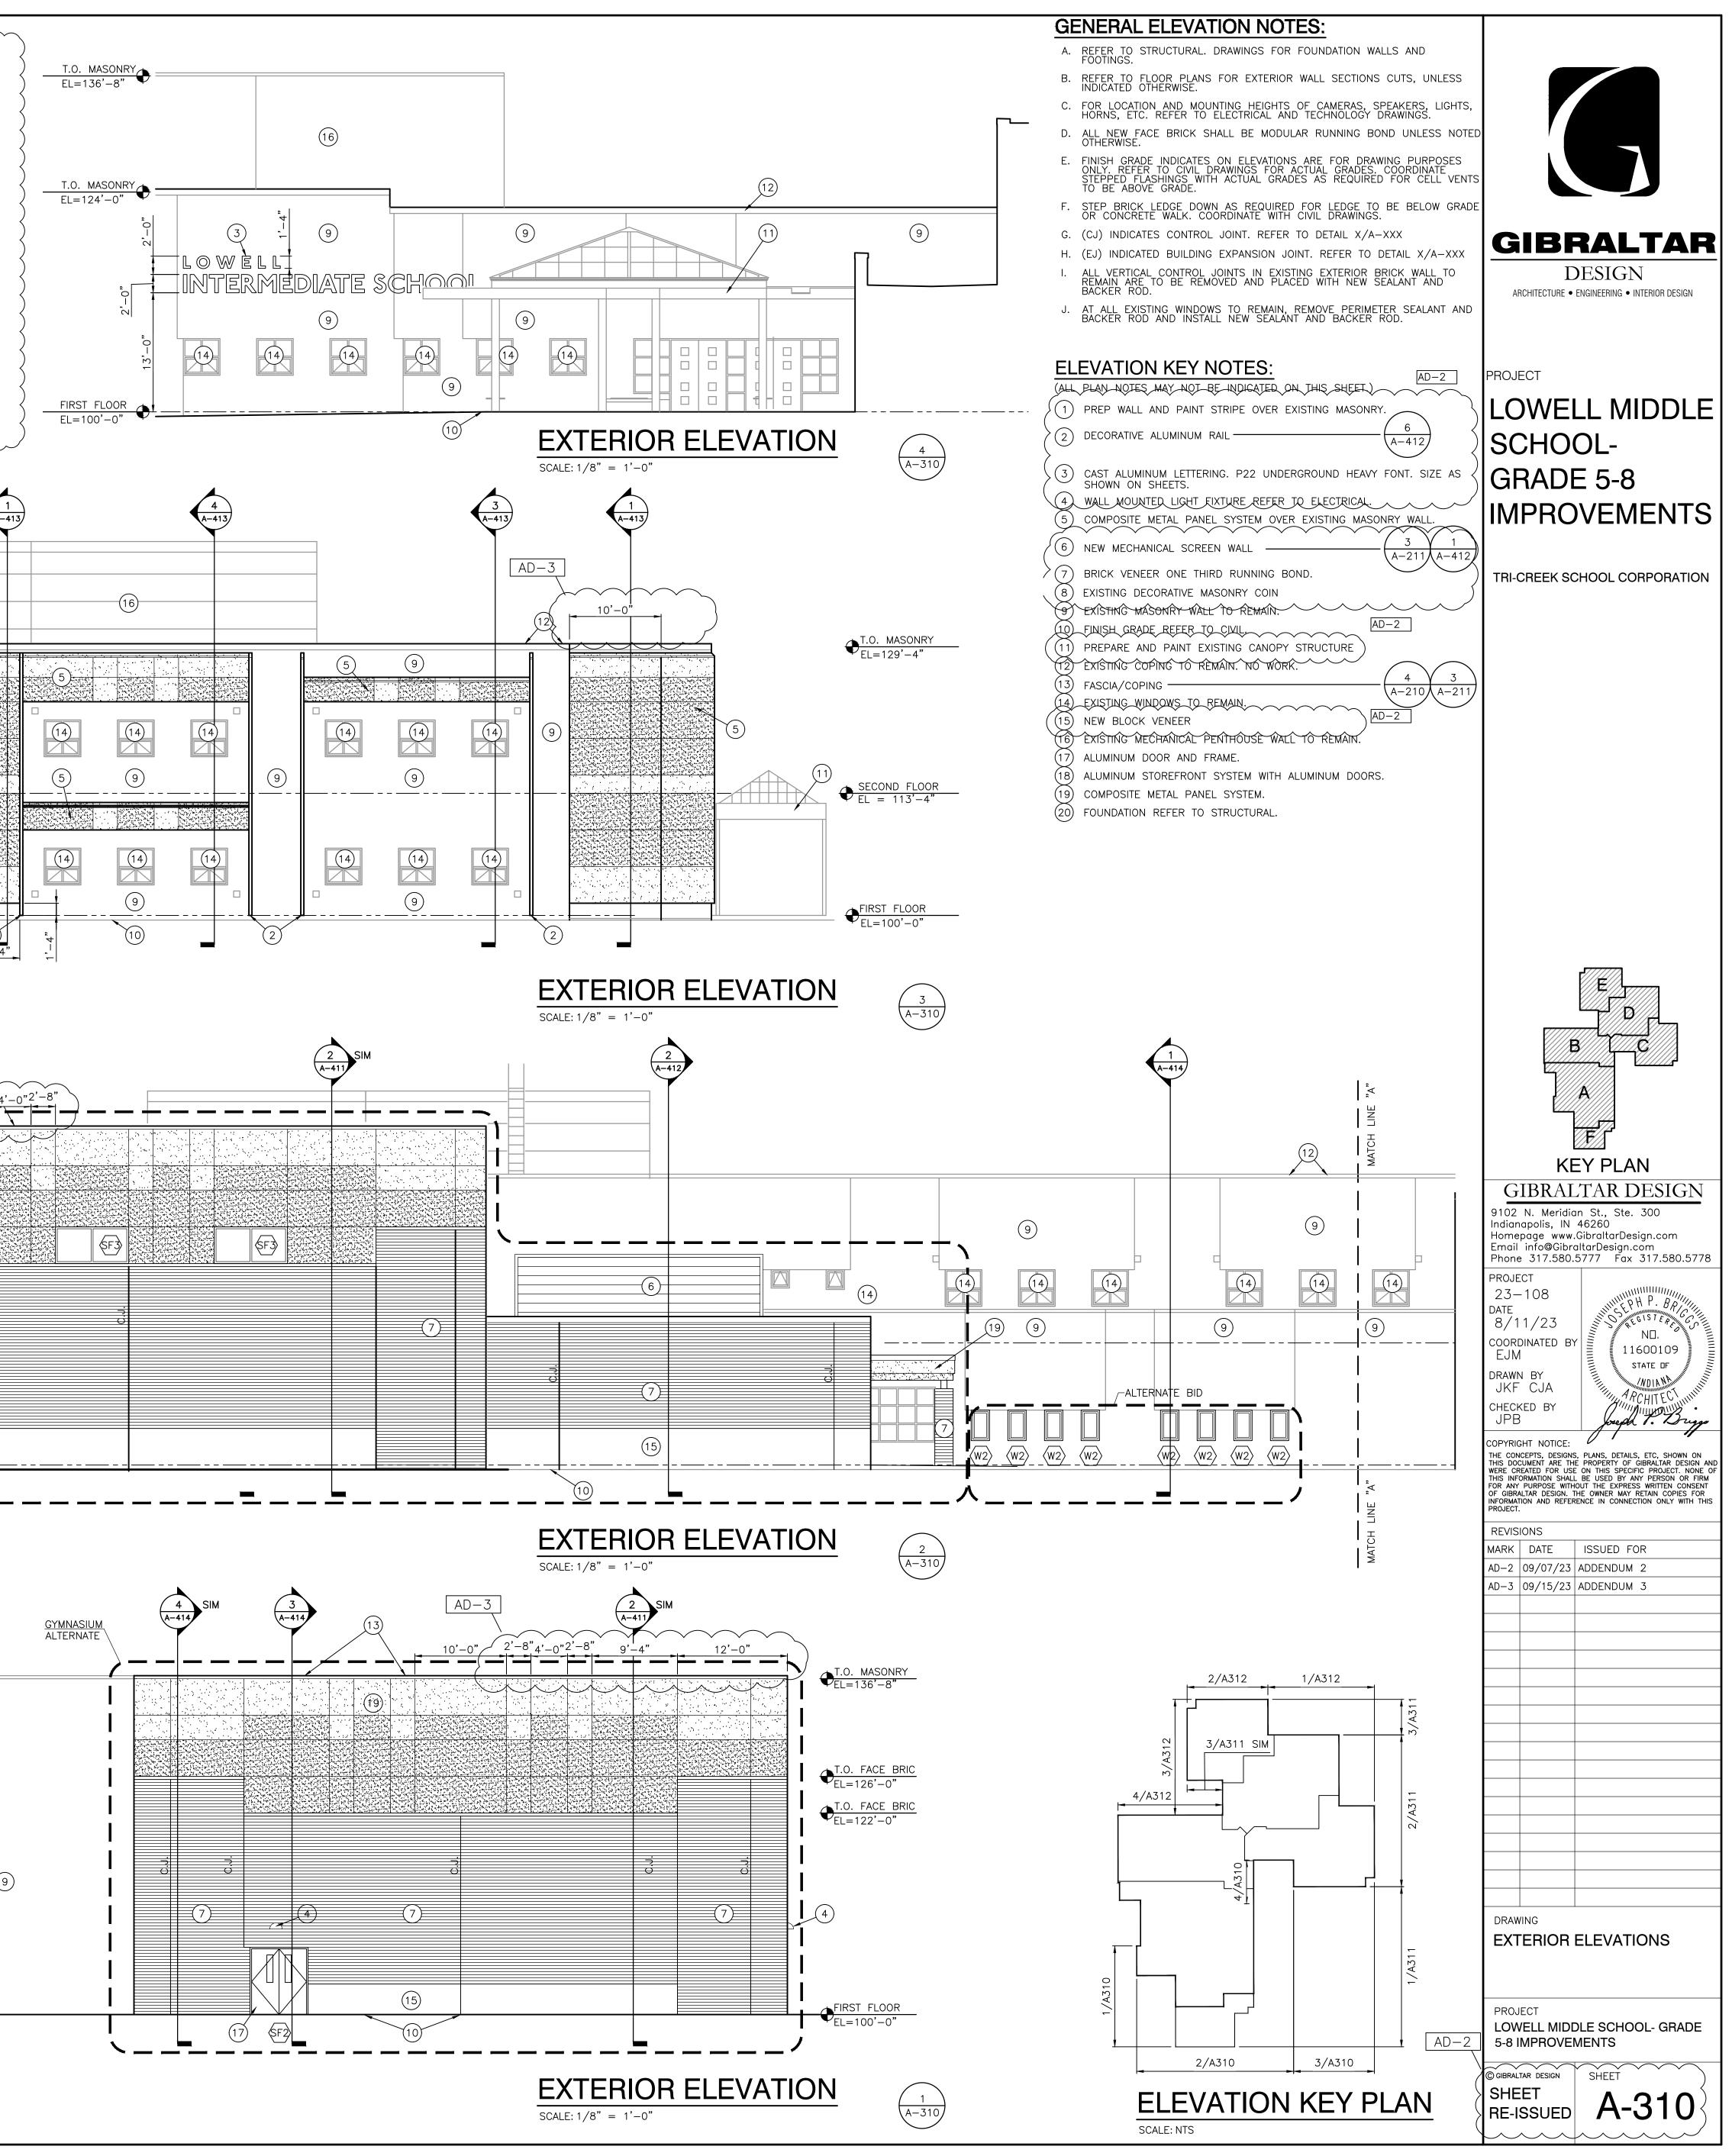

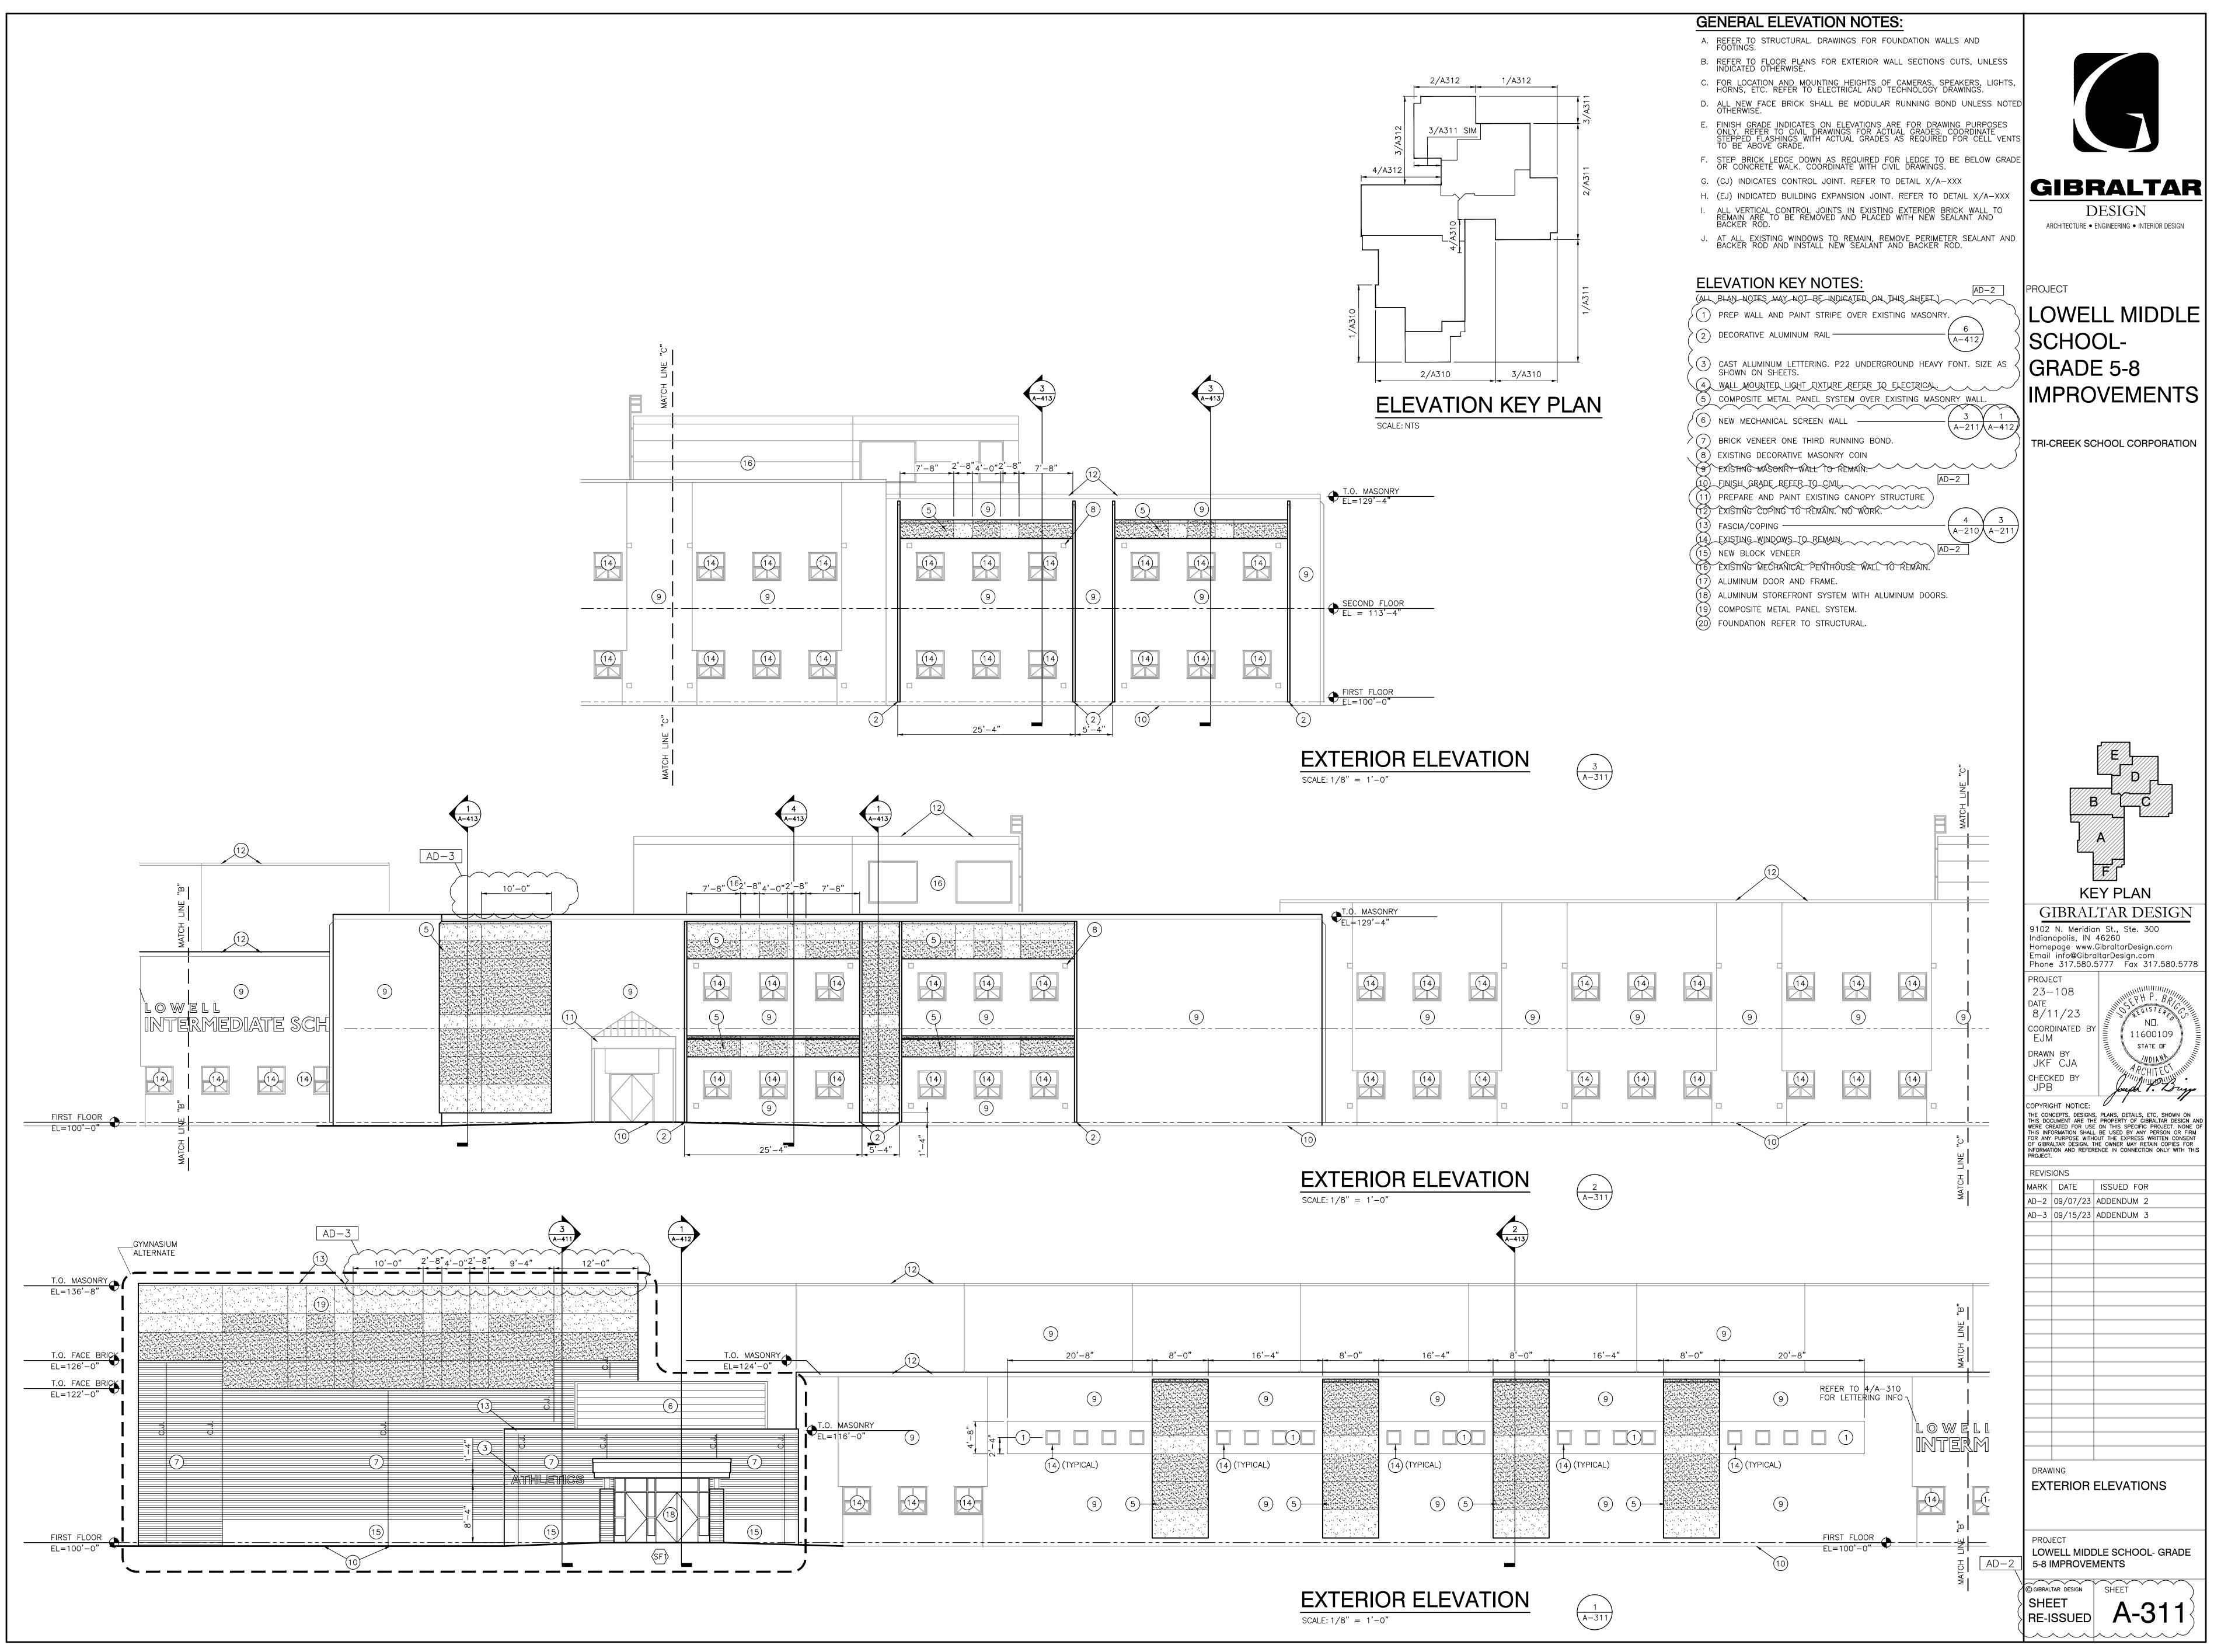



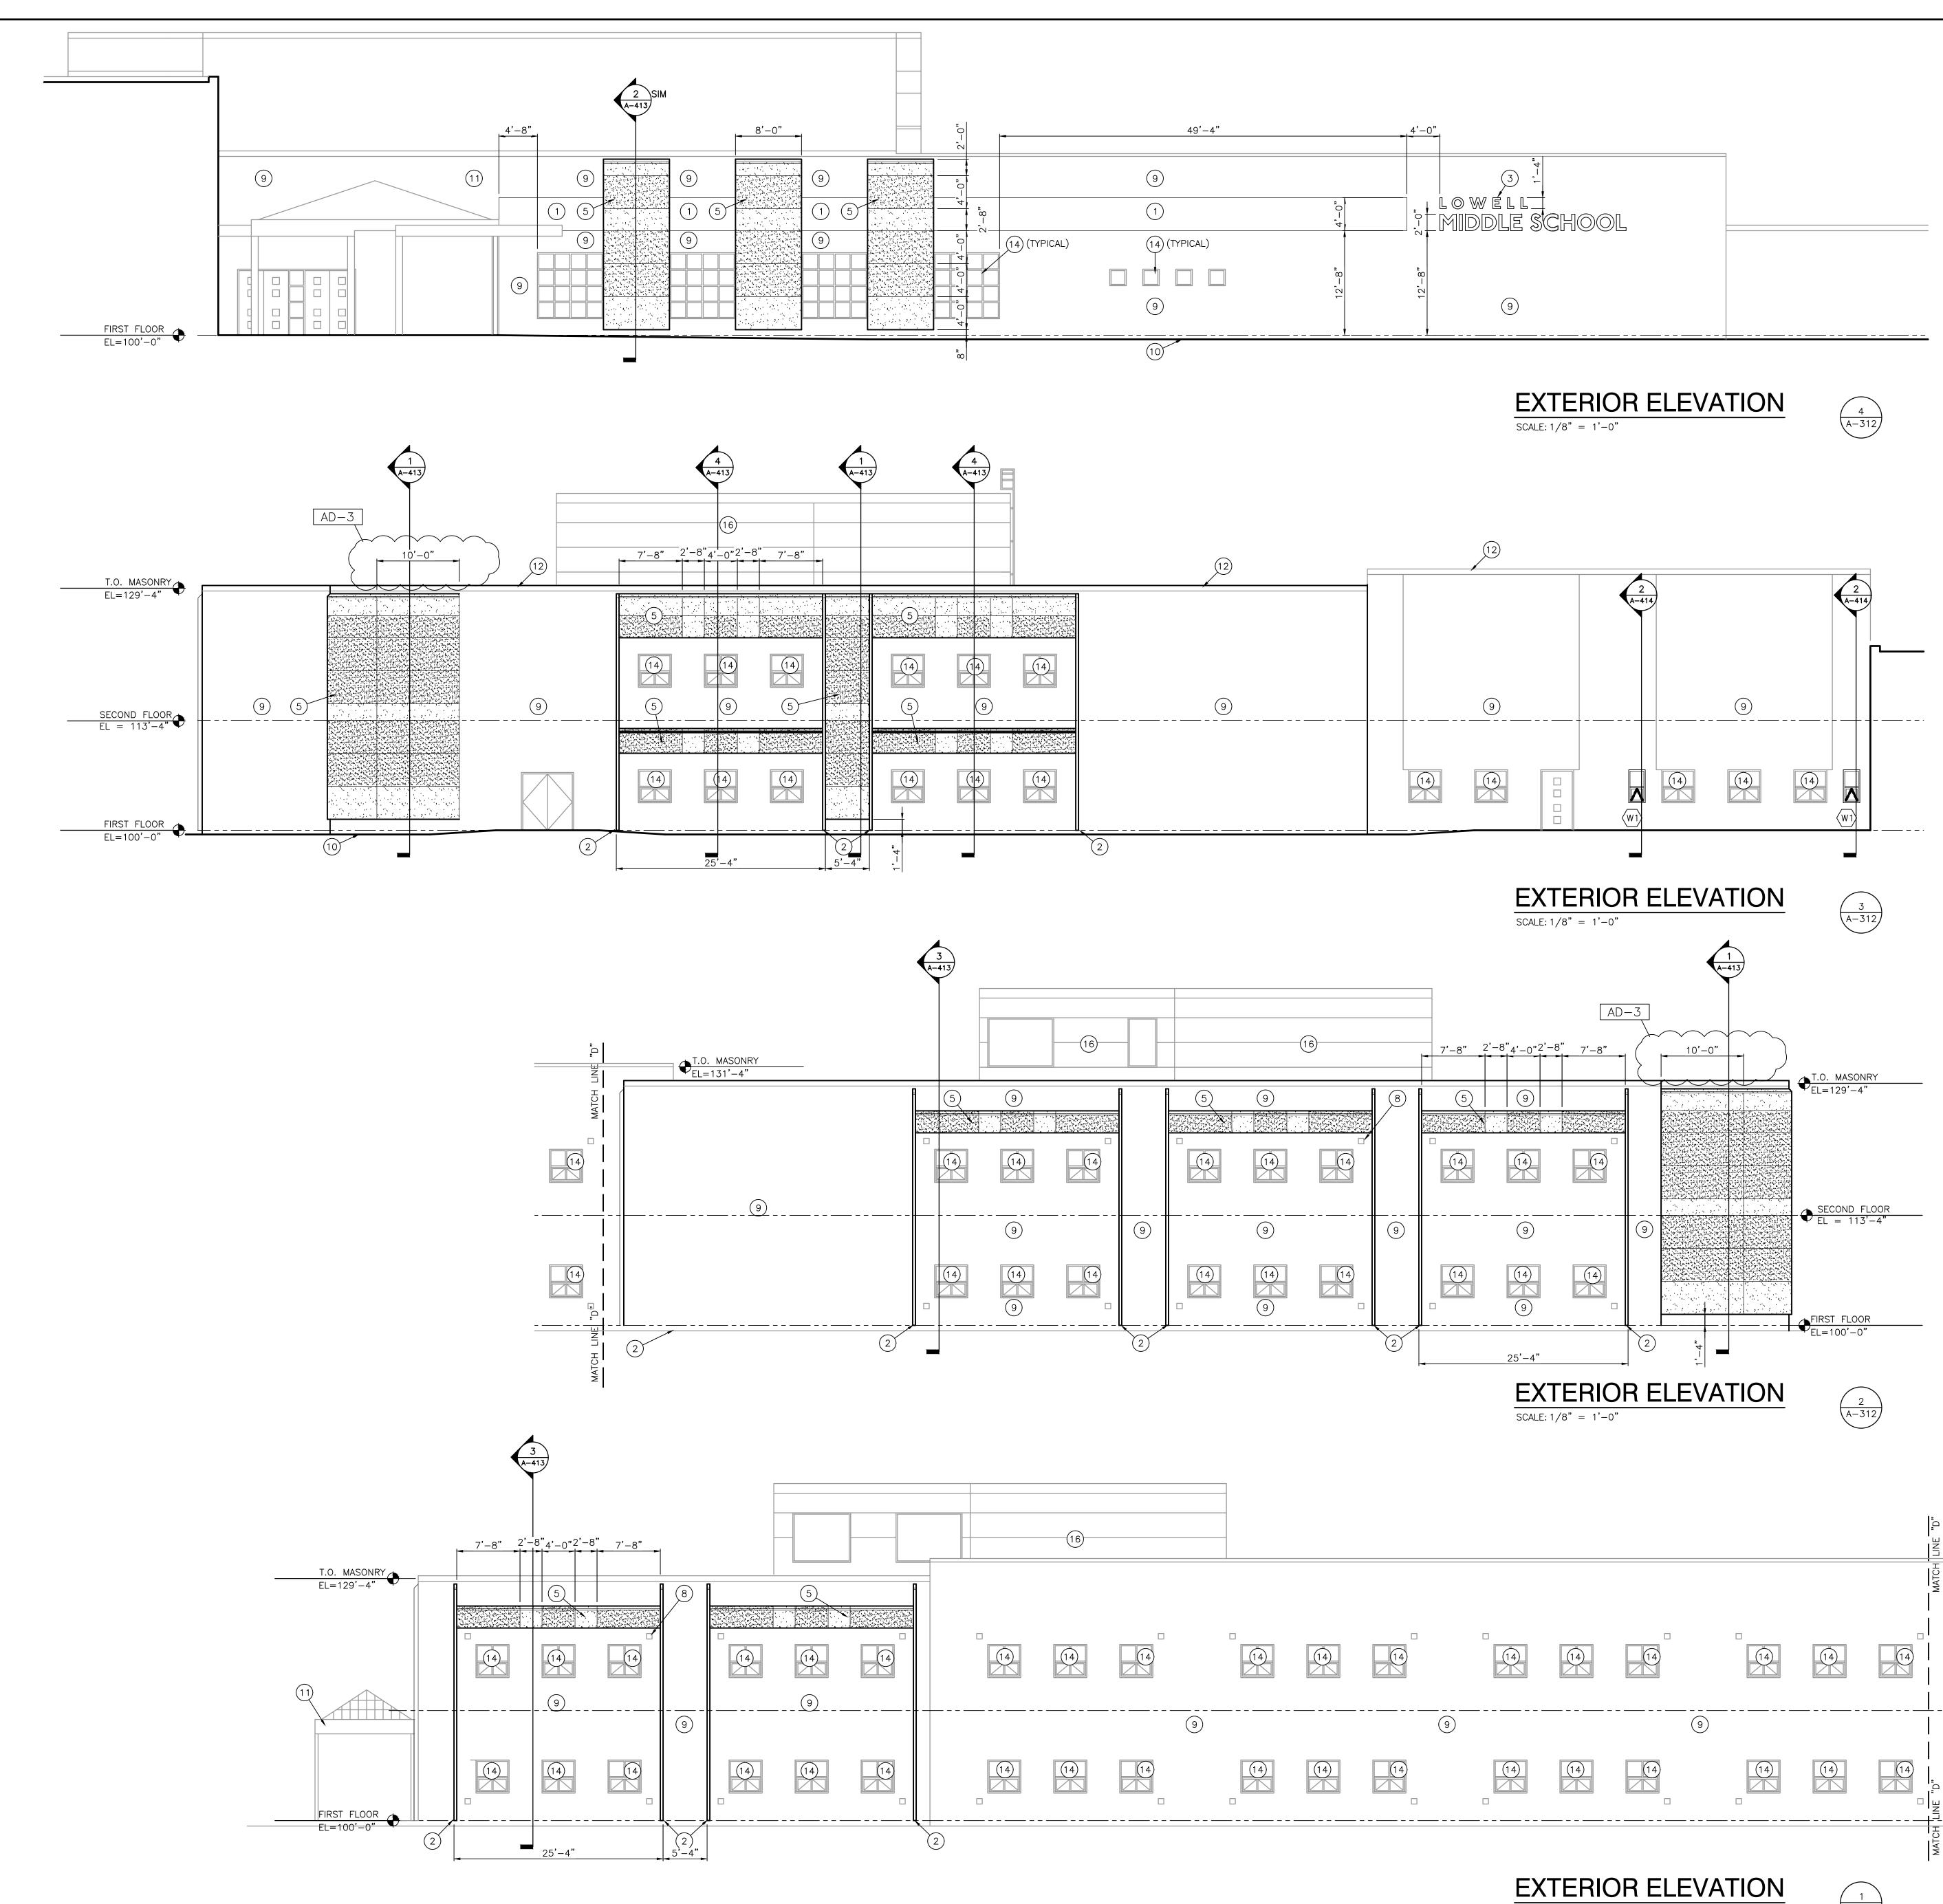

## **GENERAL ELEVATION NOTES:**

- A. REFER TO STRUCTURAL. DRAWINGS FOR FOUNDATION WALLS AND FOOTINGS.
- B. REFER TO FLOOR PLANS FOR EXTERIOR WALL SECTIONS CUTS, UNLESS INDICATED OTHERWISE.
- C. FOR LOCATION AND MOUNTING HEIGHTS OF CAMERAS, SPEAKERS, LIGHTS, HORNS, ETC. REFER TO ELECTRICAL AND TECHNOLOGY DRAWINGS.
- D. ALL NEW FACE BRICK SHALL BE MODULAR RUNNING BOND UNLESS NOTED OTHERWISE.
- E. FINISH GRADE INDICATES ON ELEVATIONS ARE FOR DRAWING PURPOSES ONLY. REFER TO CIVIL DRAWINGS FOR ACTUAL GRADES. COORDINATE STEPPED FLASHINGS WITH ACTUAL GRADES AS REQUIRED FOR CELL VENTS TO BE ABOVE GRADE.
- F. STEP BRICK LEDGE DOWN AS REQUIRED FOR LEDGE TO BE BELOW GRADE OR CONCRETE WALK. COORDINATE WITH CIVIL DRAWINGS.
- G. (CJ) INDICATES CONTROL JOINT. REFER TO DETAIL X/A-XXX
- H. (EJ) INDICATED BUILDING EXPANSION JOINT. REFER TO DETAIL X/A-XXX ALL VERTICAL CONTROL JOINTS IN EXISTING EXTERIOR BRICK WALL TO REMAIN ARE TO BE REMOVED AND PLACED WITH NEW SEALANT AND BACKER ROD.
- J. AT ALL EXISTING WINDOWS TO REMAIN, REMOVE PERIMETER SEALANT AND BACKER ROD AND INSTALL NEW SEALANT AND BACKER ROD.


#### **ELEVATION KEY NOTES:**


ALL	PLAN NOTES MAY NOT BE INDICATED ON THIS SHEET.)	$\sim$
	PREP WALL AND PAINT STRIPE OVER EXISTING MASONRY.	$\frown$
2	DECORATIVE ALUMINUM RAIL	6 -412
$\sim$ $(3)$	CAST ALUMINUM LETTERING. P22 UNDERGROUND HEAVY FOI SHOWN ON SHEETS.	NT. S
(4)	WALL MOUNTED LIGHT FIXTURE REFER TO ELECTRICAL.	$\overline{}$
5	COMPOSITE METAL PANEL SYSTEM OVER EXISTING MASONRY	WAL
6	NEW MECHANICAL SCREEN WALL	<u> </u>
(7)	BRICK VENEER ONE THIRD RUNNING BOND.	
(8)	EXISTING DECORATIVE MASONRY COIN	
$\langle \mathfrak{P} \rangle$	EXISTING MASONRY WALL TO REMAIN.	
	FINISH GRADE REFER TO CIVIL, AD-2	
(11)	PREPARE AND PAINT EXISTING CANOPY STRUCTURE	
(12)	ÈXIŜTING ĈOPING TO REMAIN. NO WORK.	$\frown$
(13)		<u>4</u> -210
(14)	_EXISTING_WINDOWS_TO_REMAIN.	
(15)	NEW BLOCK VENEER	
(16)	EXISTING MECHANICAL PENTHOUSE WALL TO REMAIN.	


- (17) ALUMINUM DOOR AND FRAME.
- (18) ALUMINUM STOREFRONT SYSTEM WITH ALUMINUM DOORS.
- (19) COMPOSITE METAL PANEL SYSTEM.(20) FOUNDATION REFER TO STRUCTURAL.

2/A312 1/A312 3/A311 SIM 4/A312 **⊢** <u>′</u> _____ 2) 2/A310 3/A310 ELEVATION KEY PLAN  $\begin{pmatrix} 1 \\ A-312 \end{pmatrix}$ SCALE: 1/8" = 1'-0"

SCALE: NTS

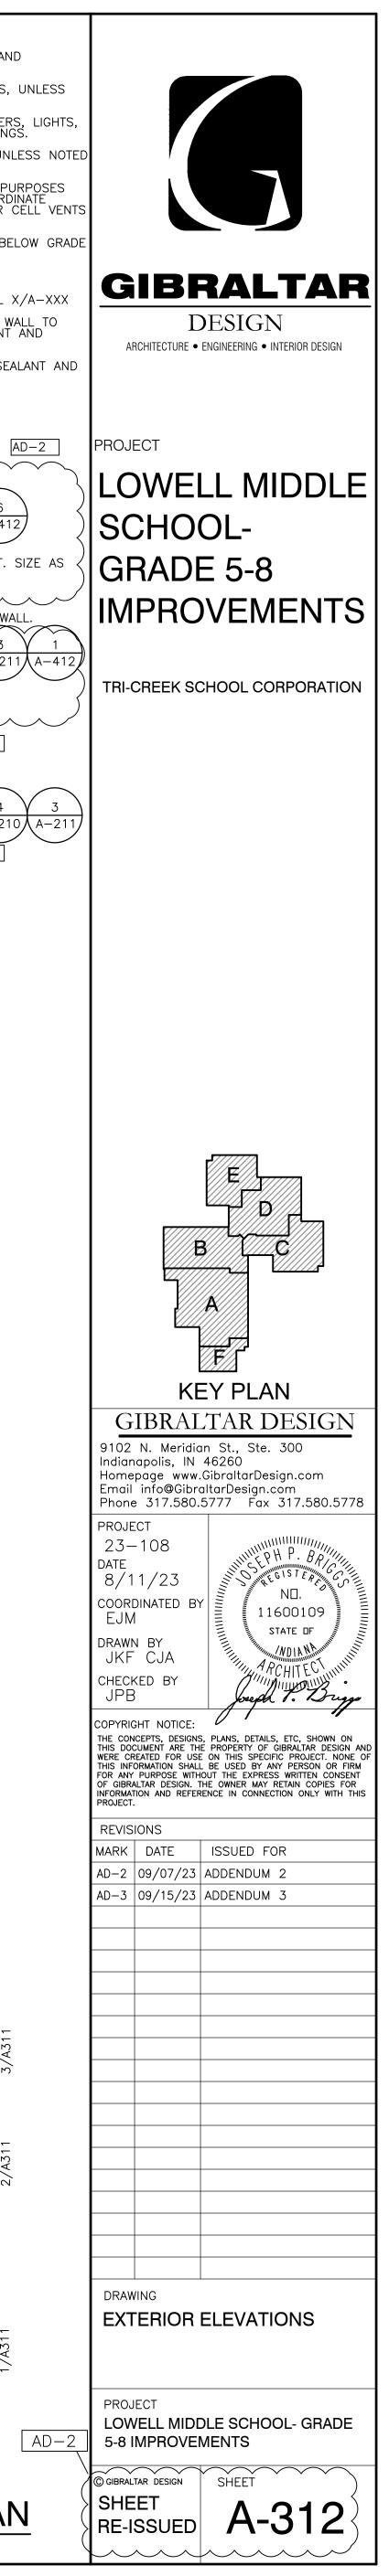


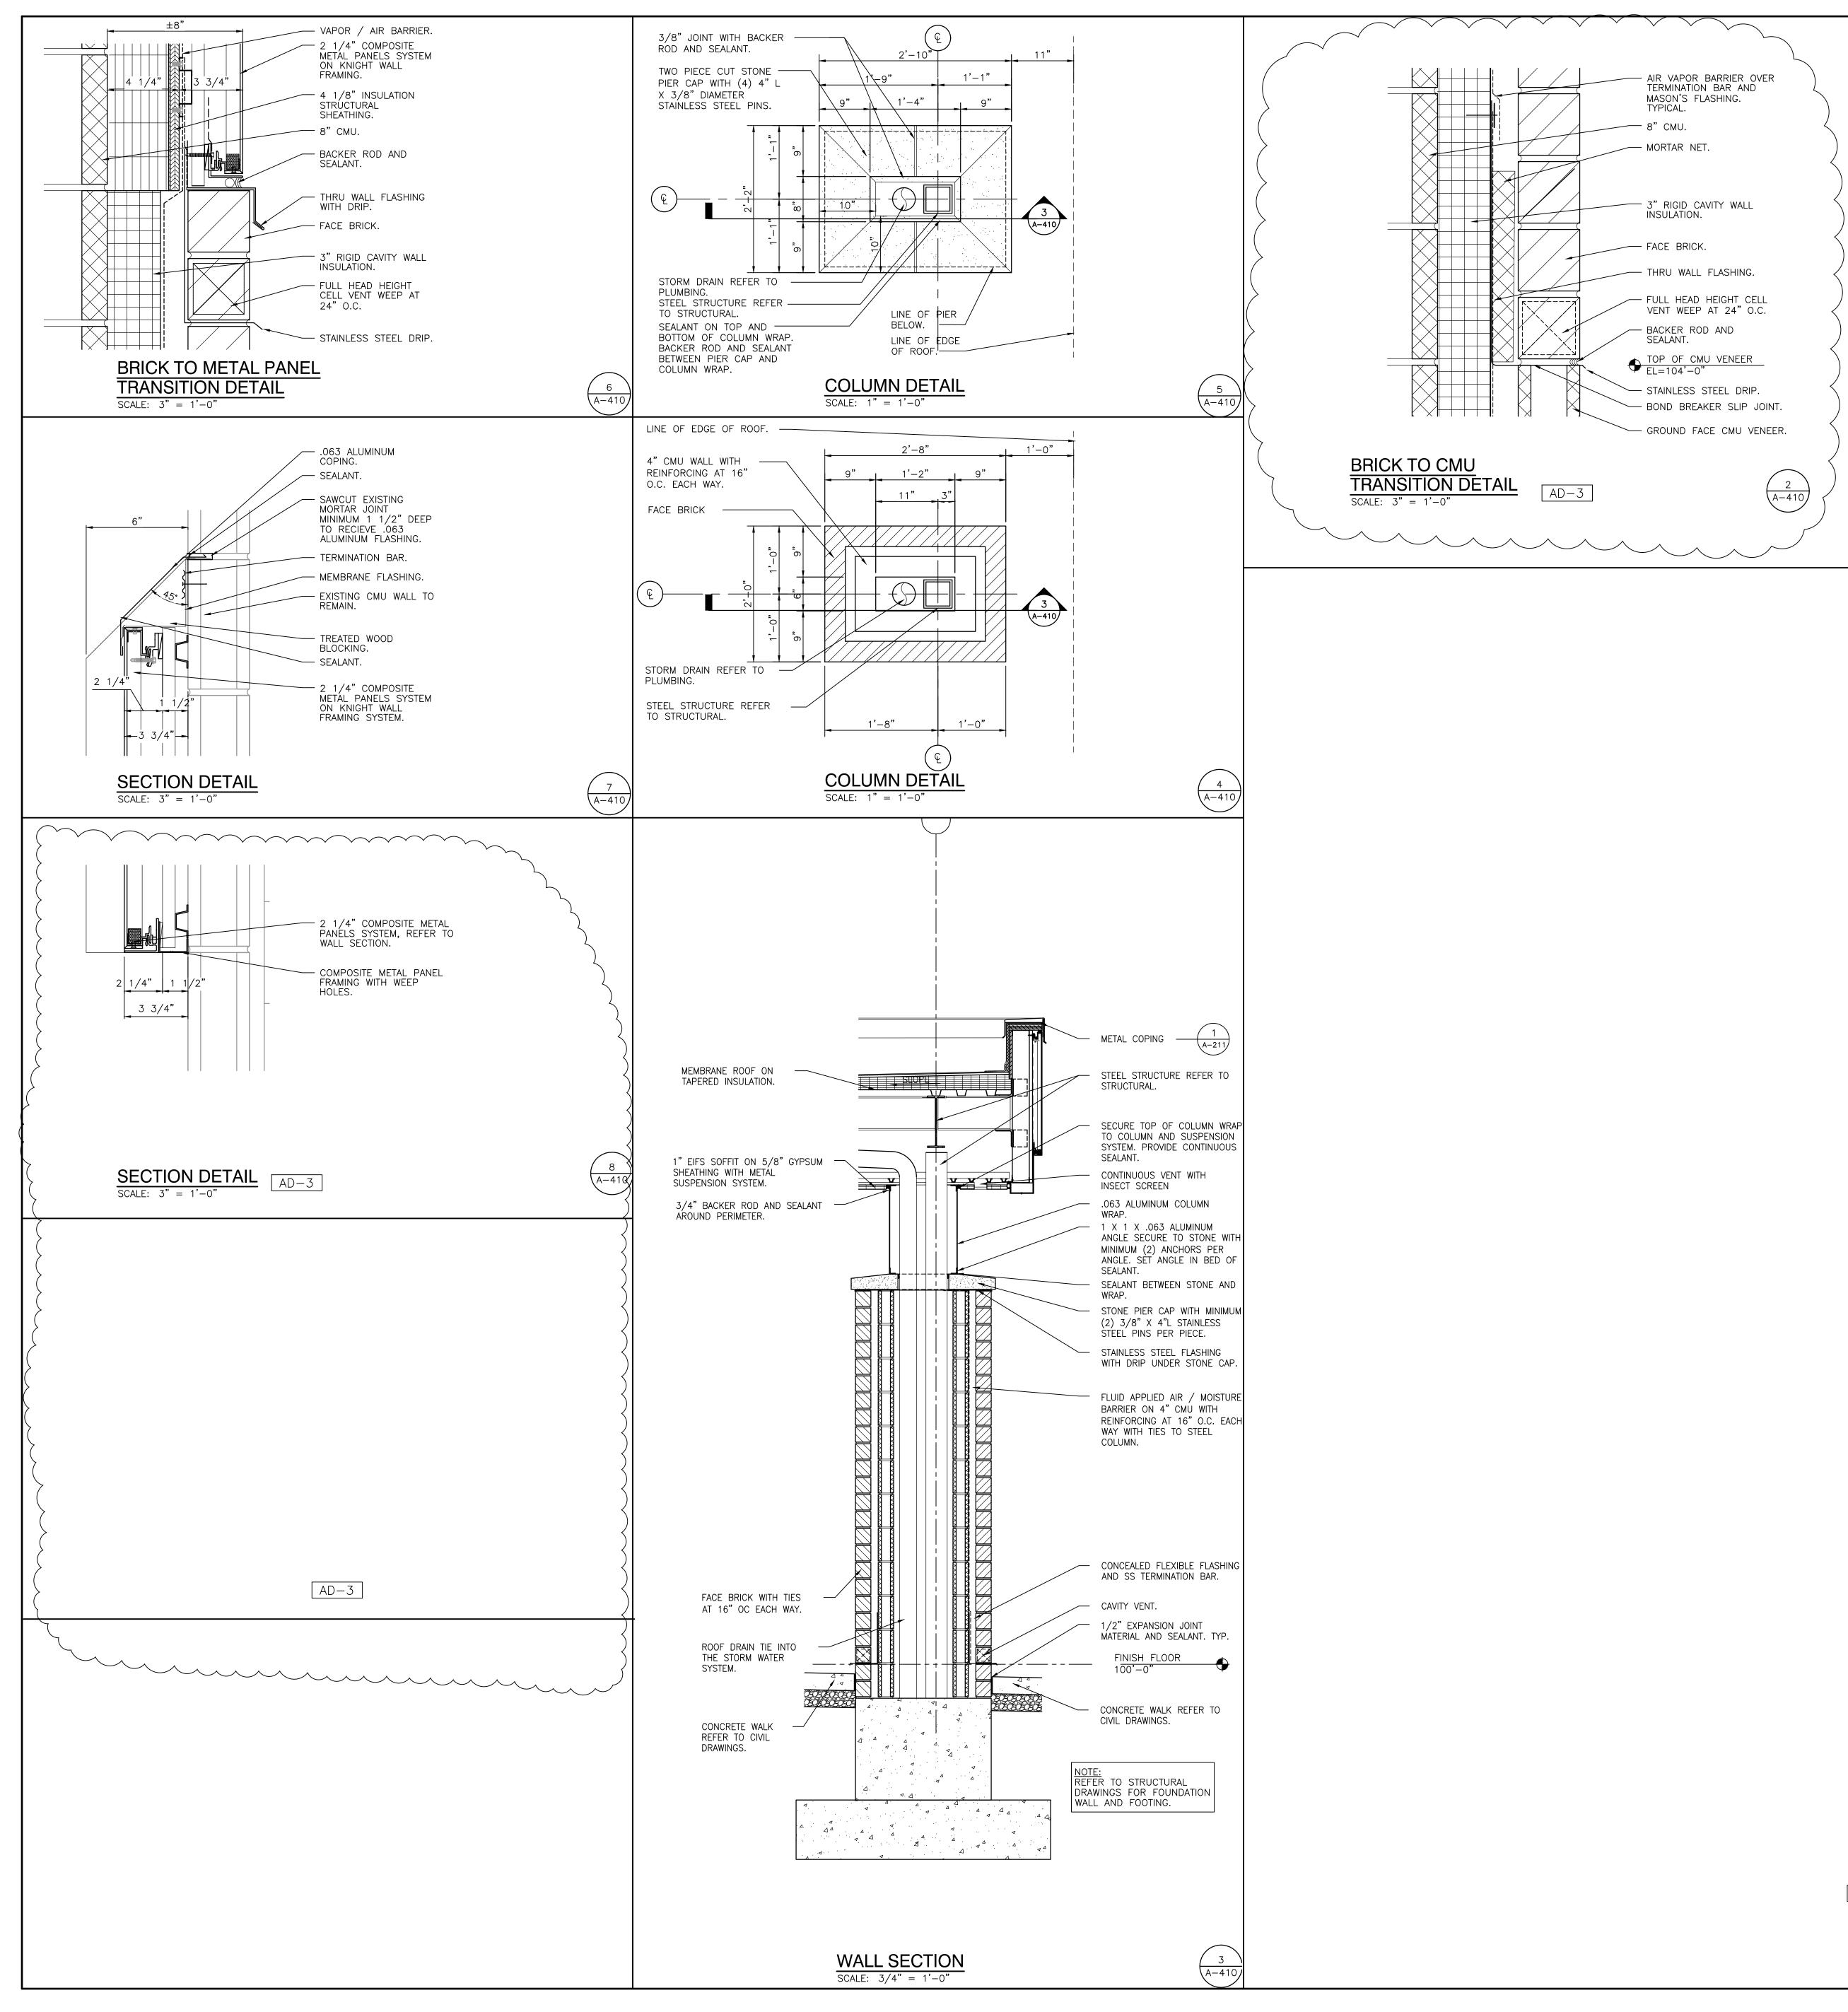


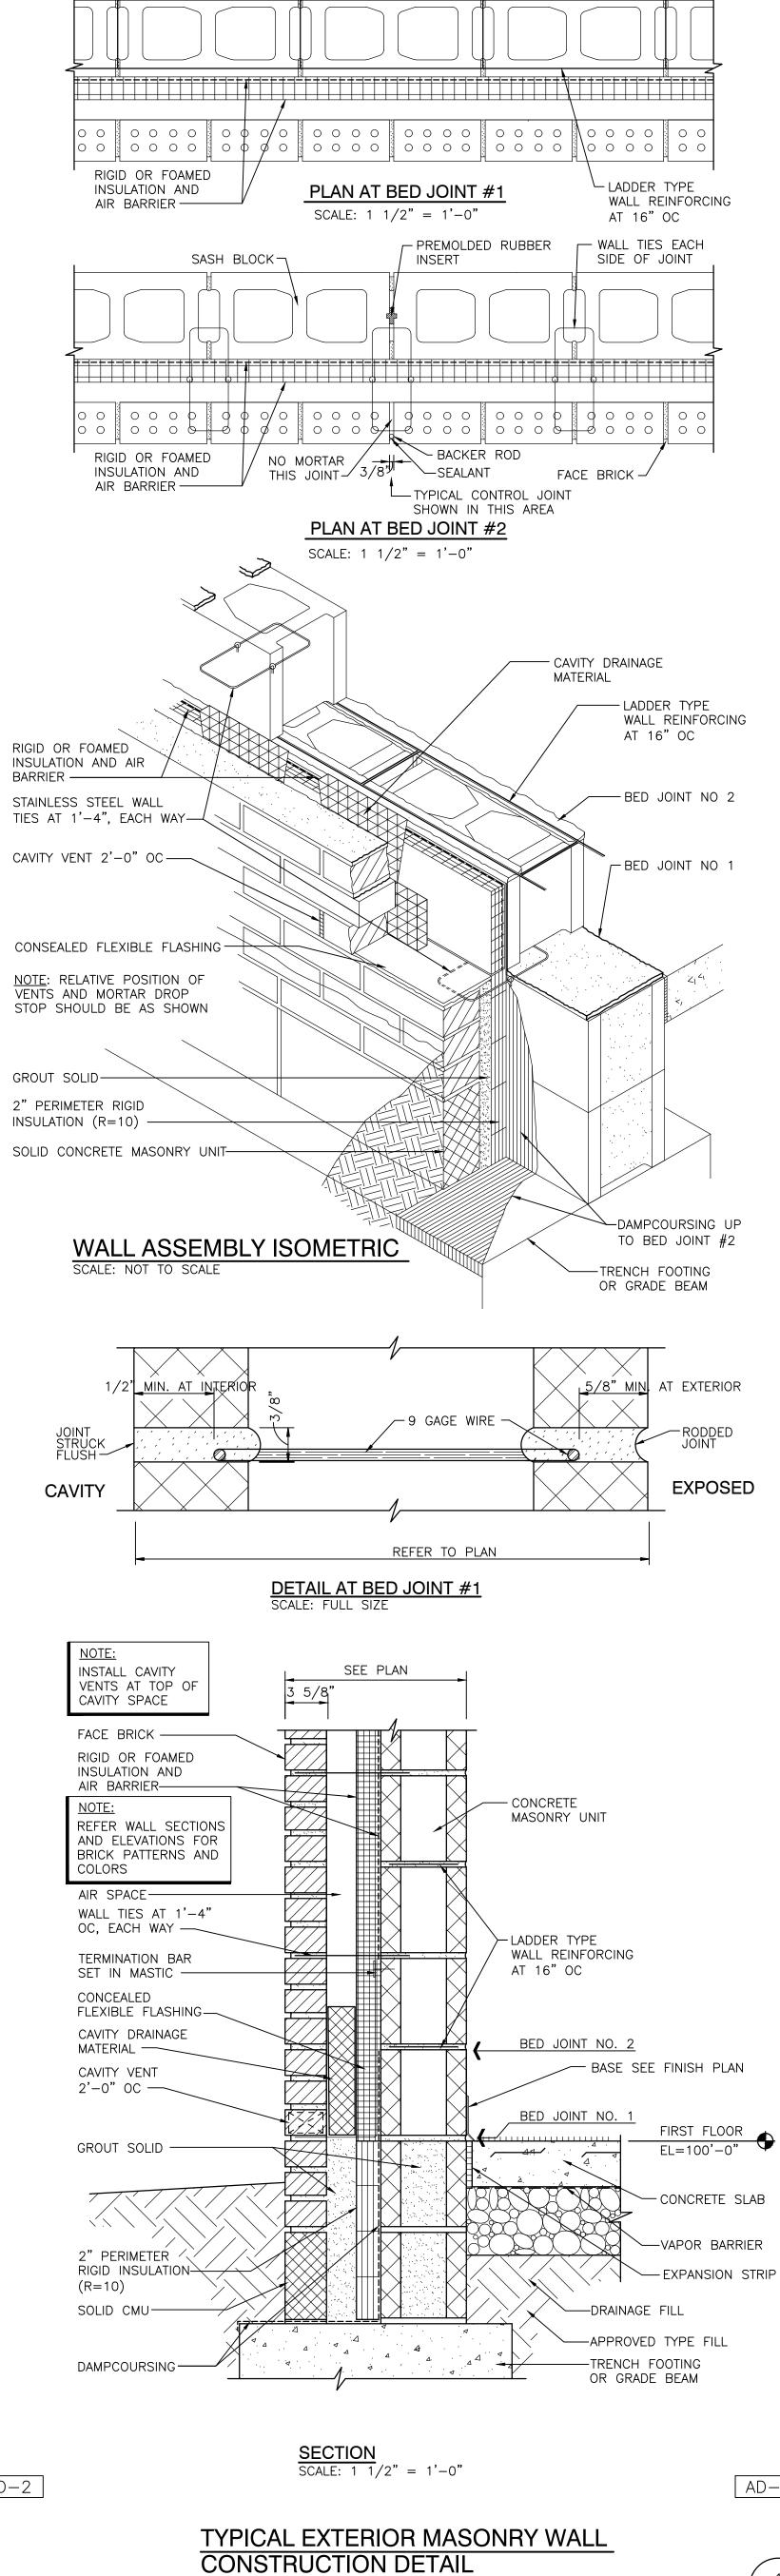


AD-2

SCALE: AS INDICATED

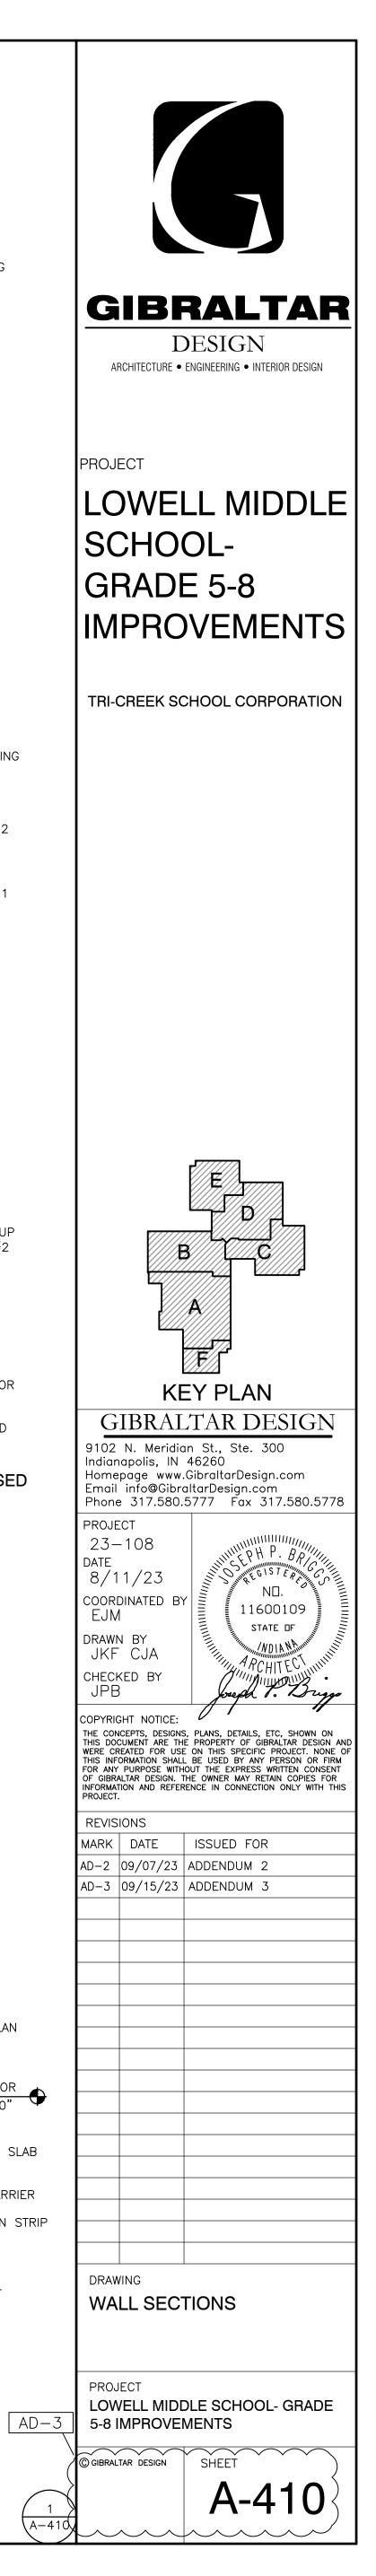

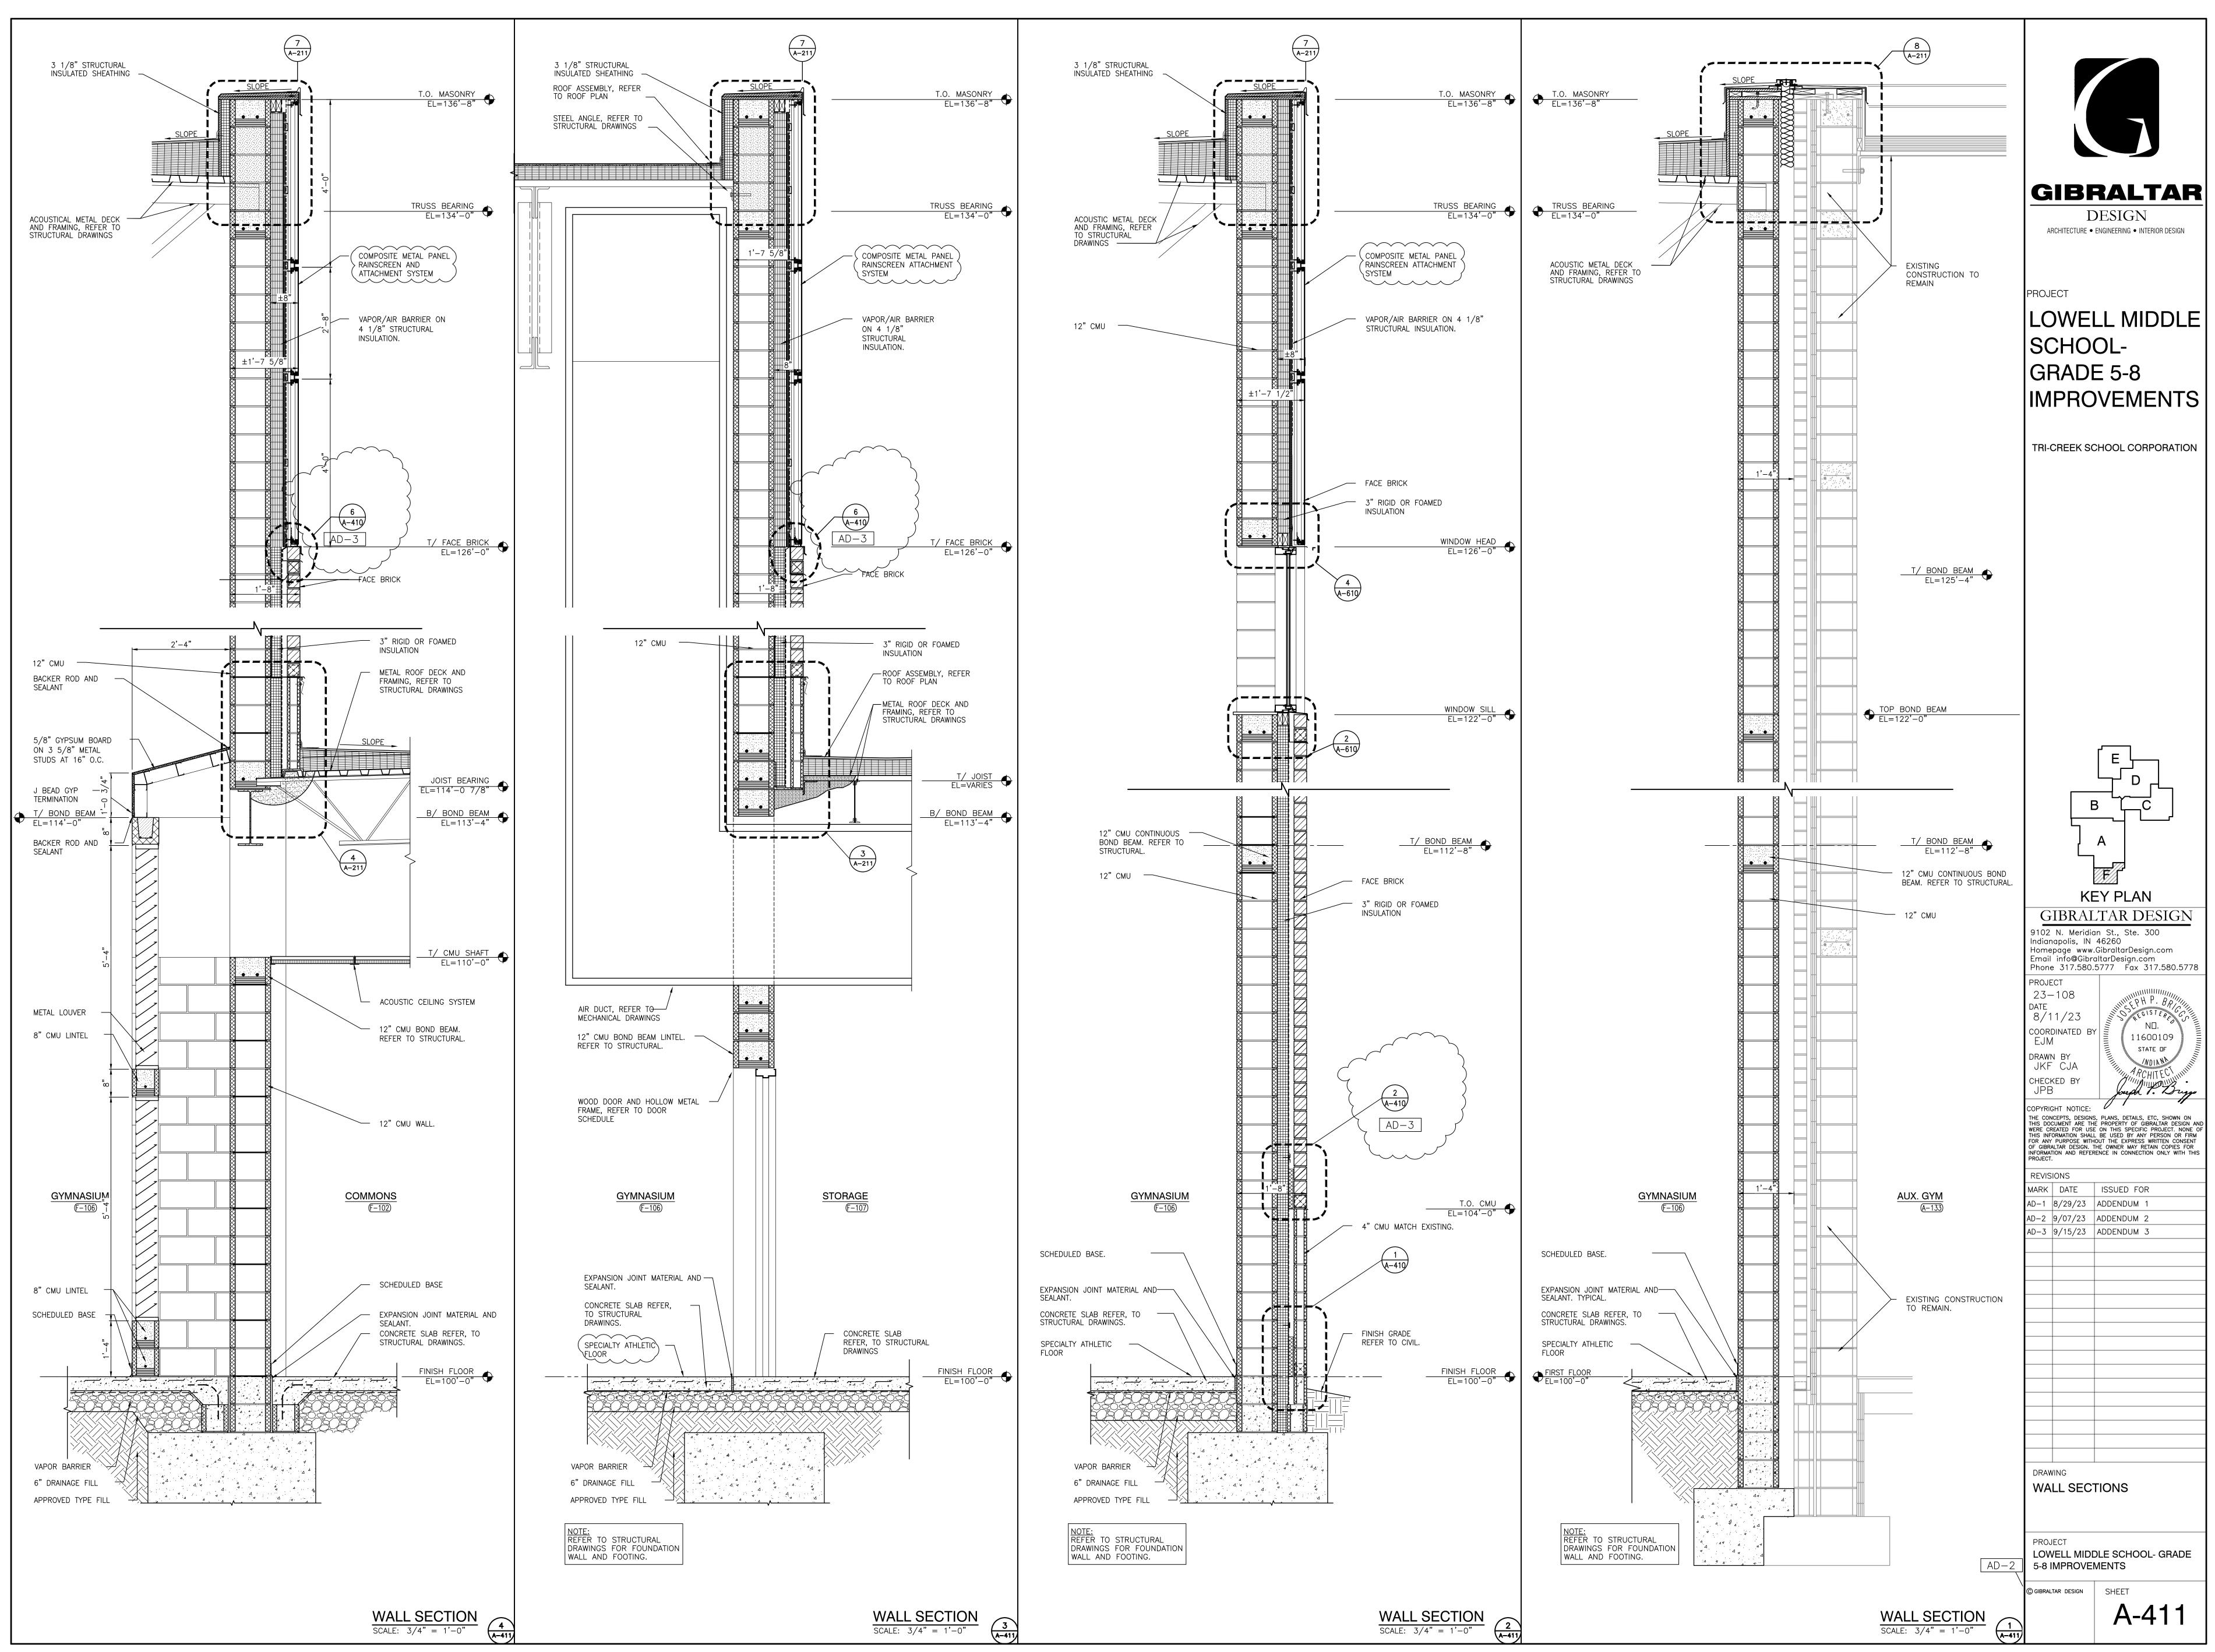





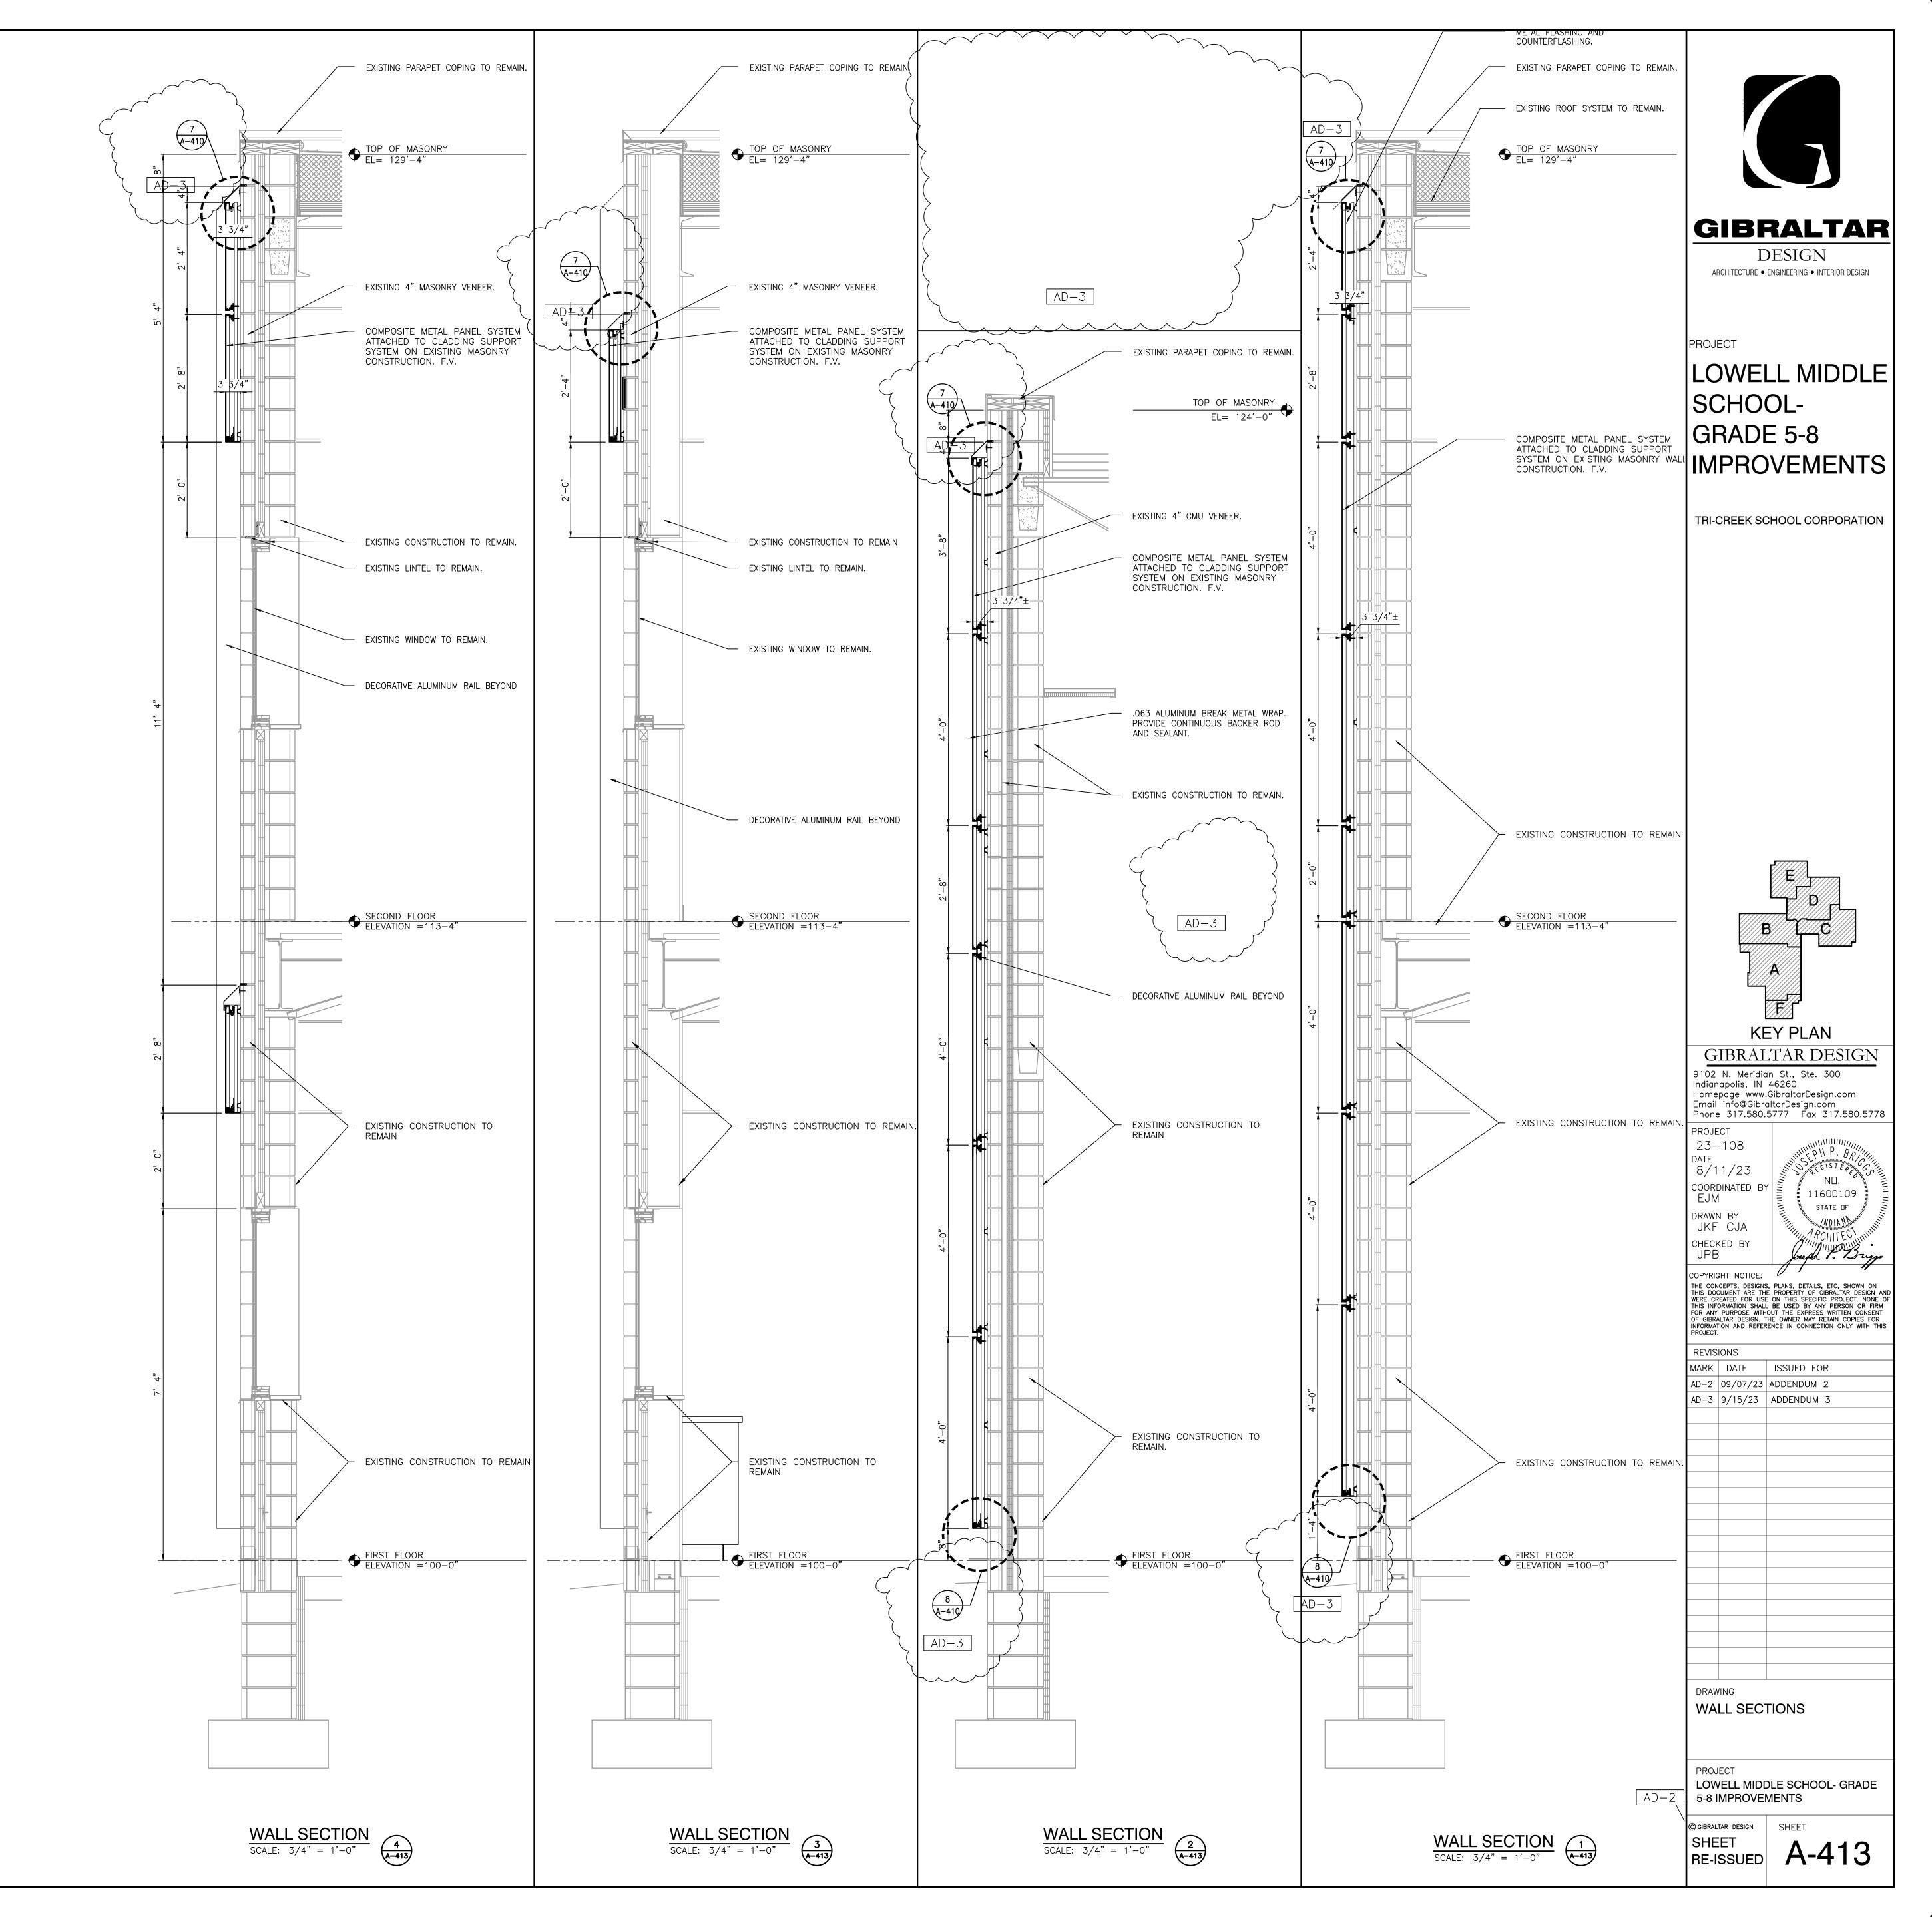



1y, 9/14/2023 – 6:05 PM – LAST SAVED B 108 TRI-CREEK SC – LOWELL MS 5–8 EMENTS\23–108 DRAWINGS\05 ARCH\A-414.1 ursdo \23-PROVI

亡 どう

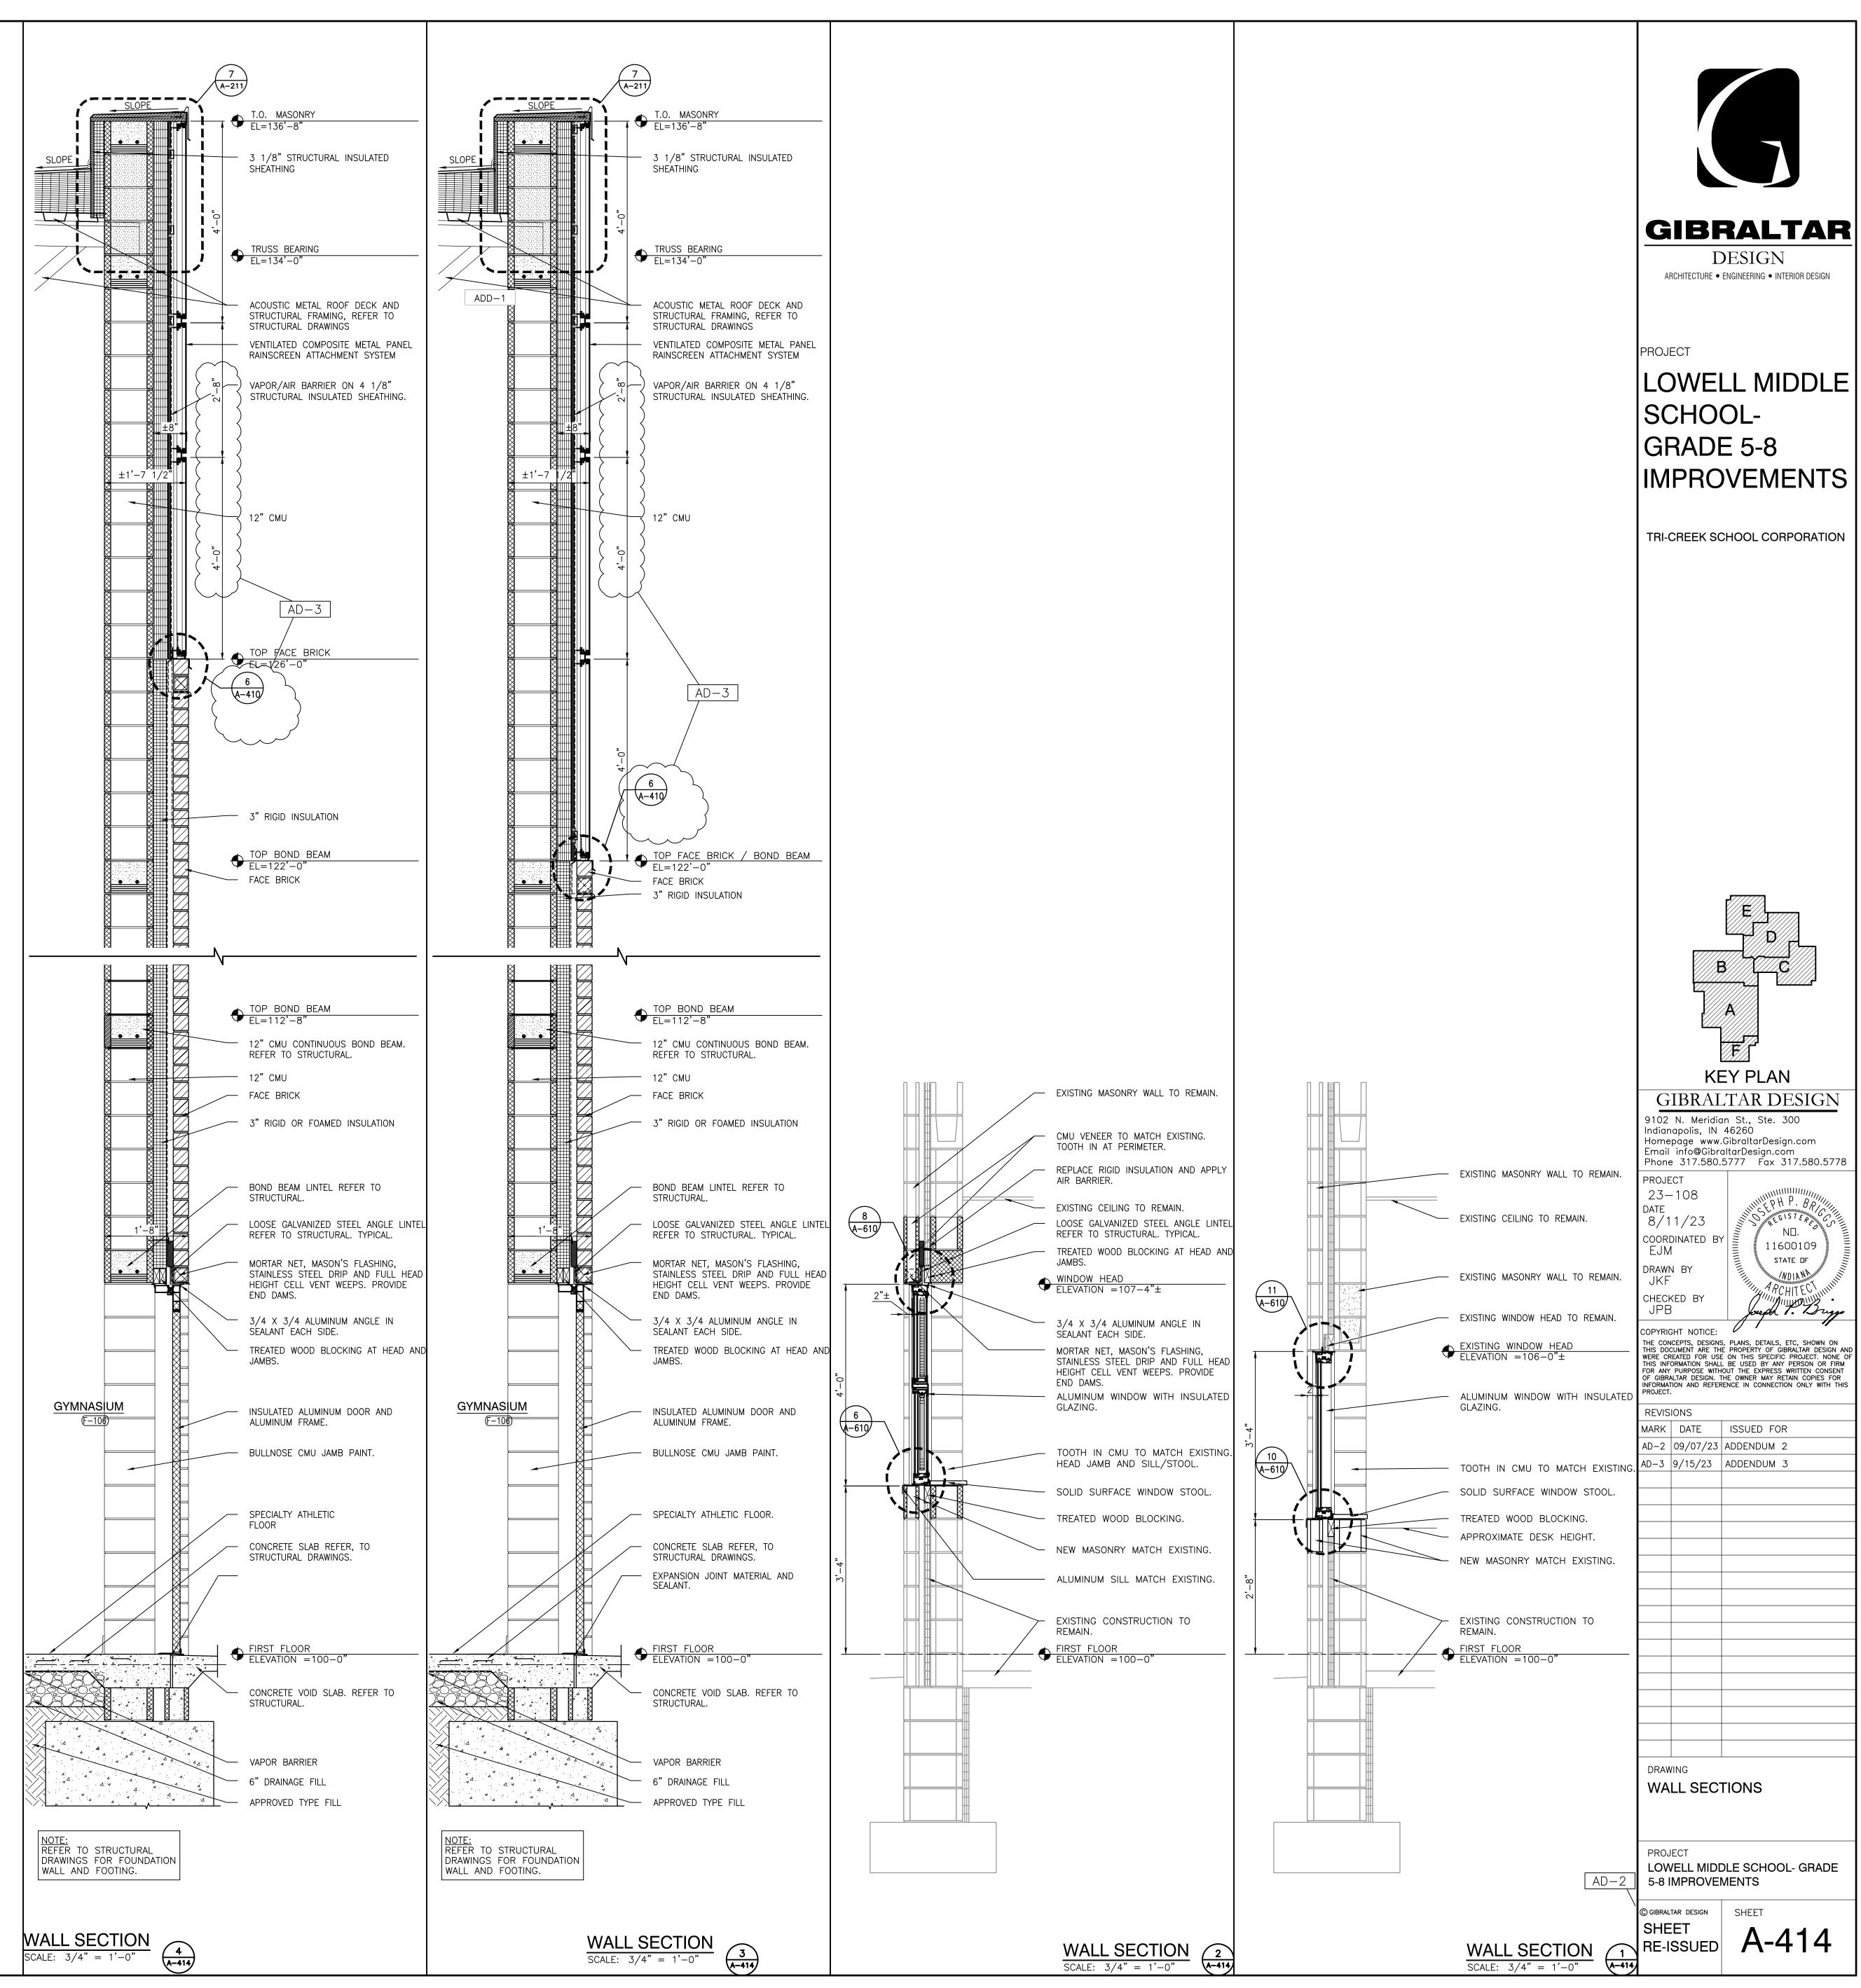

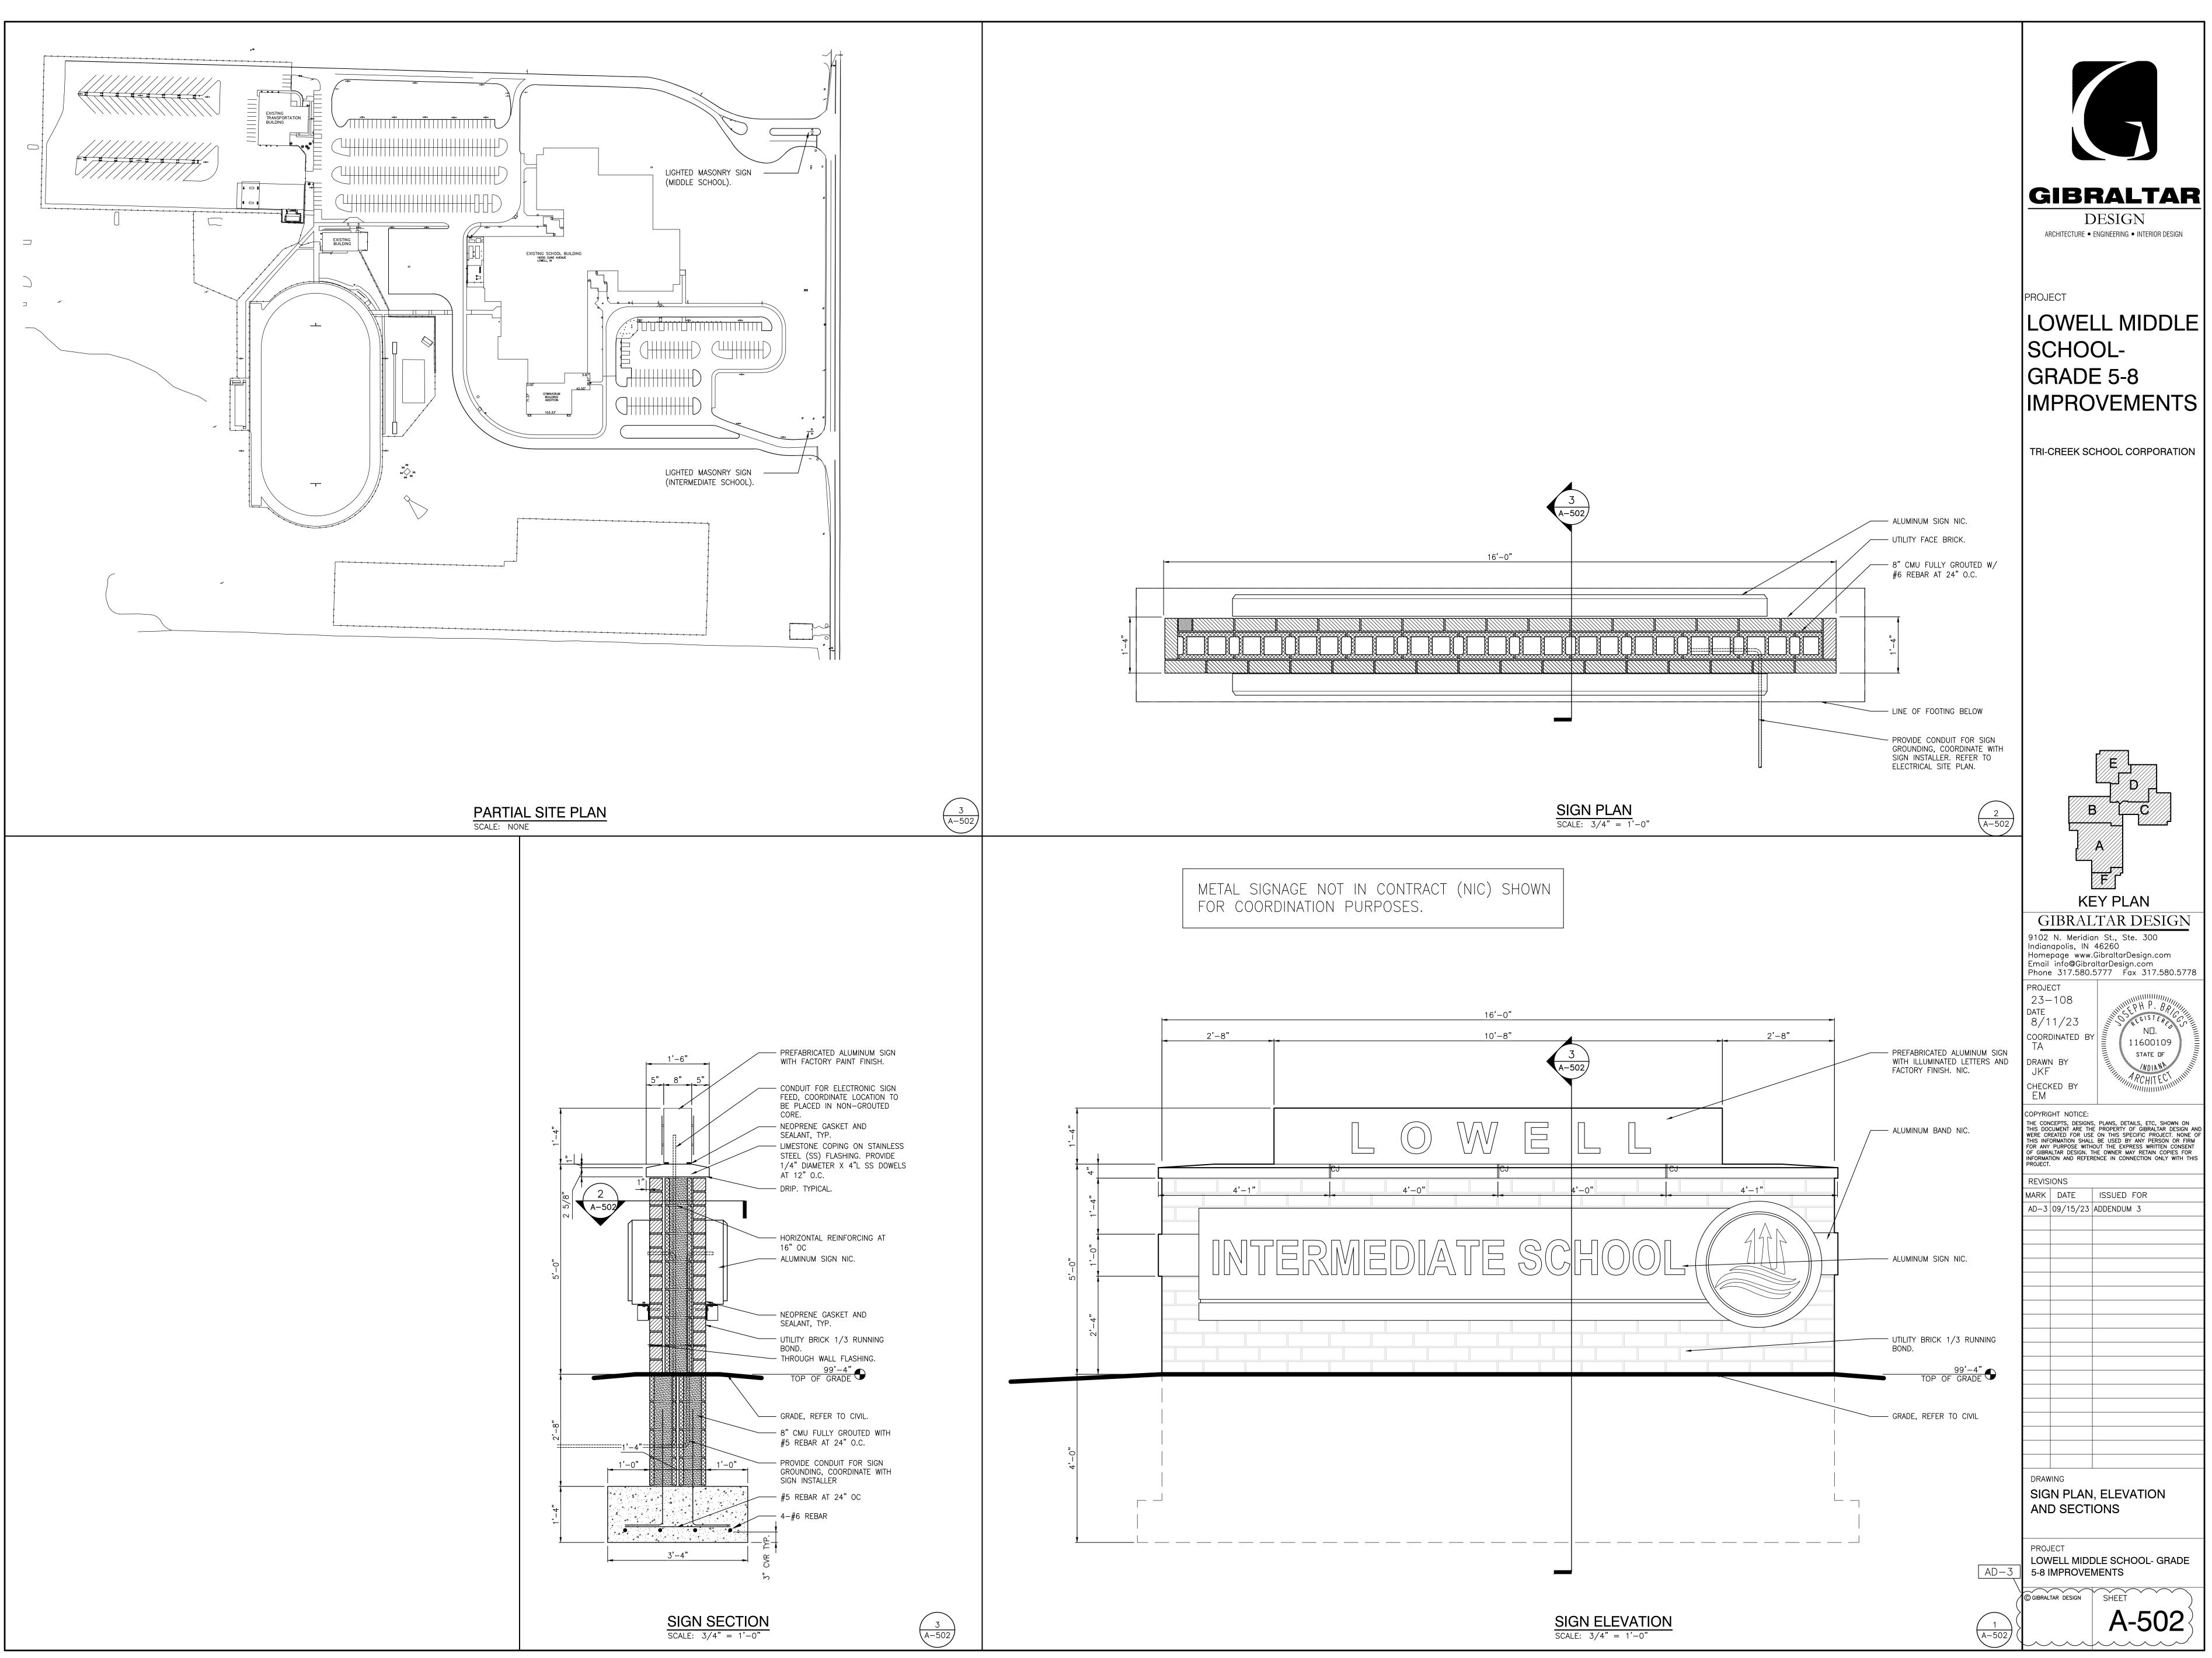


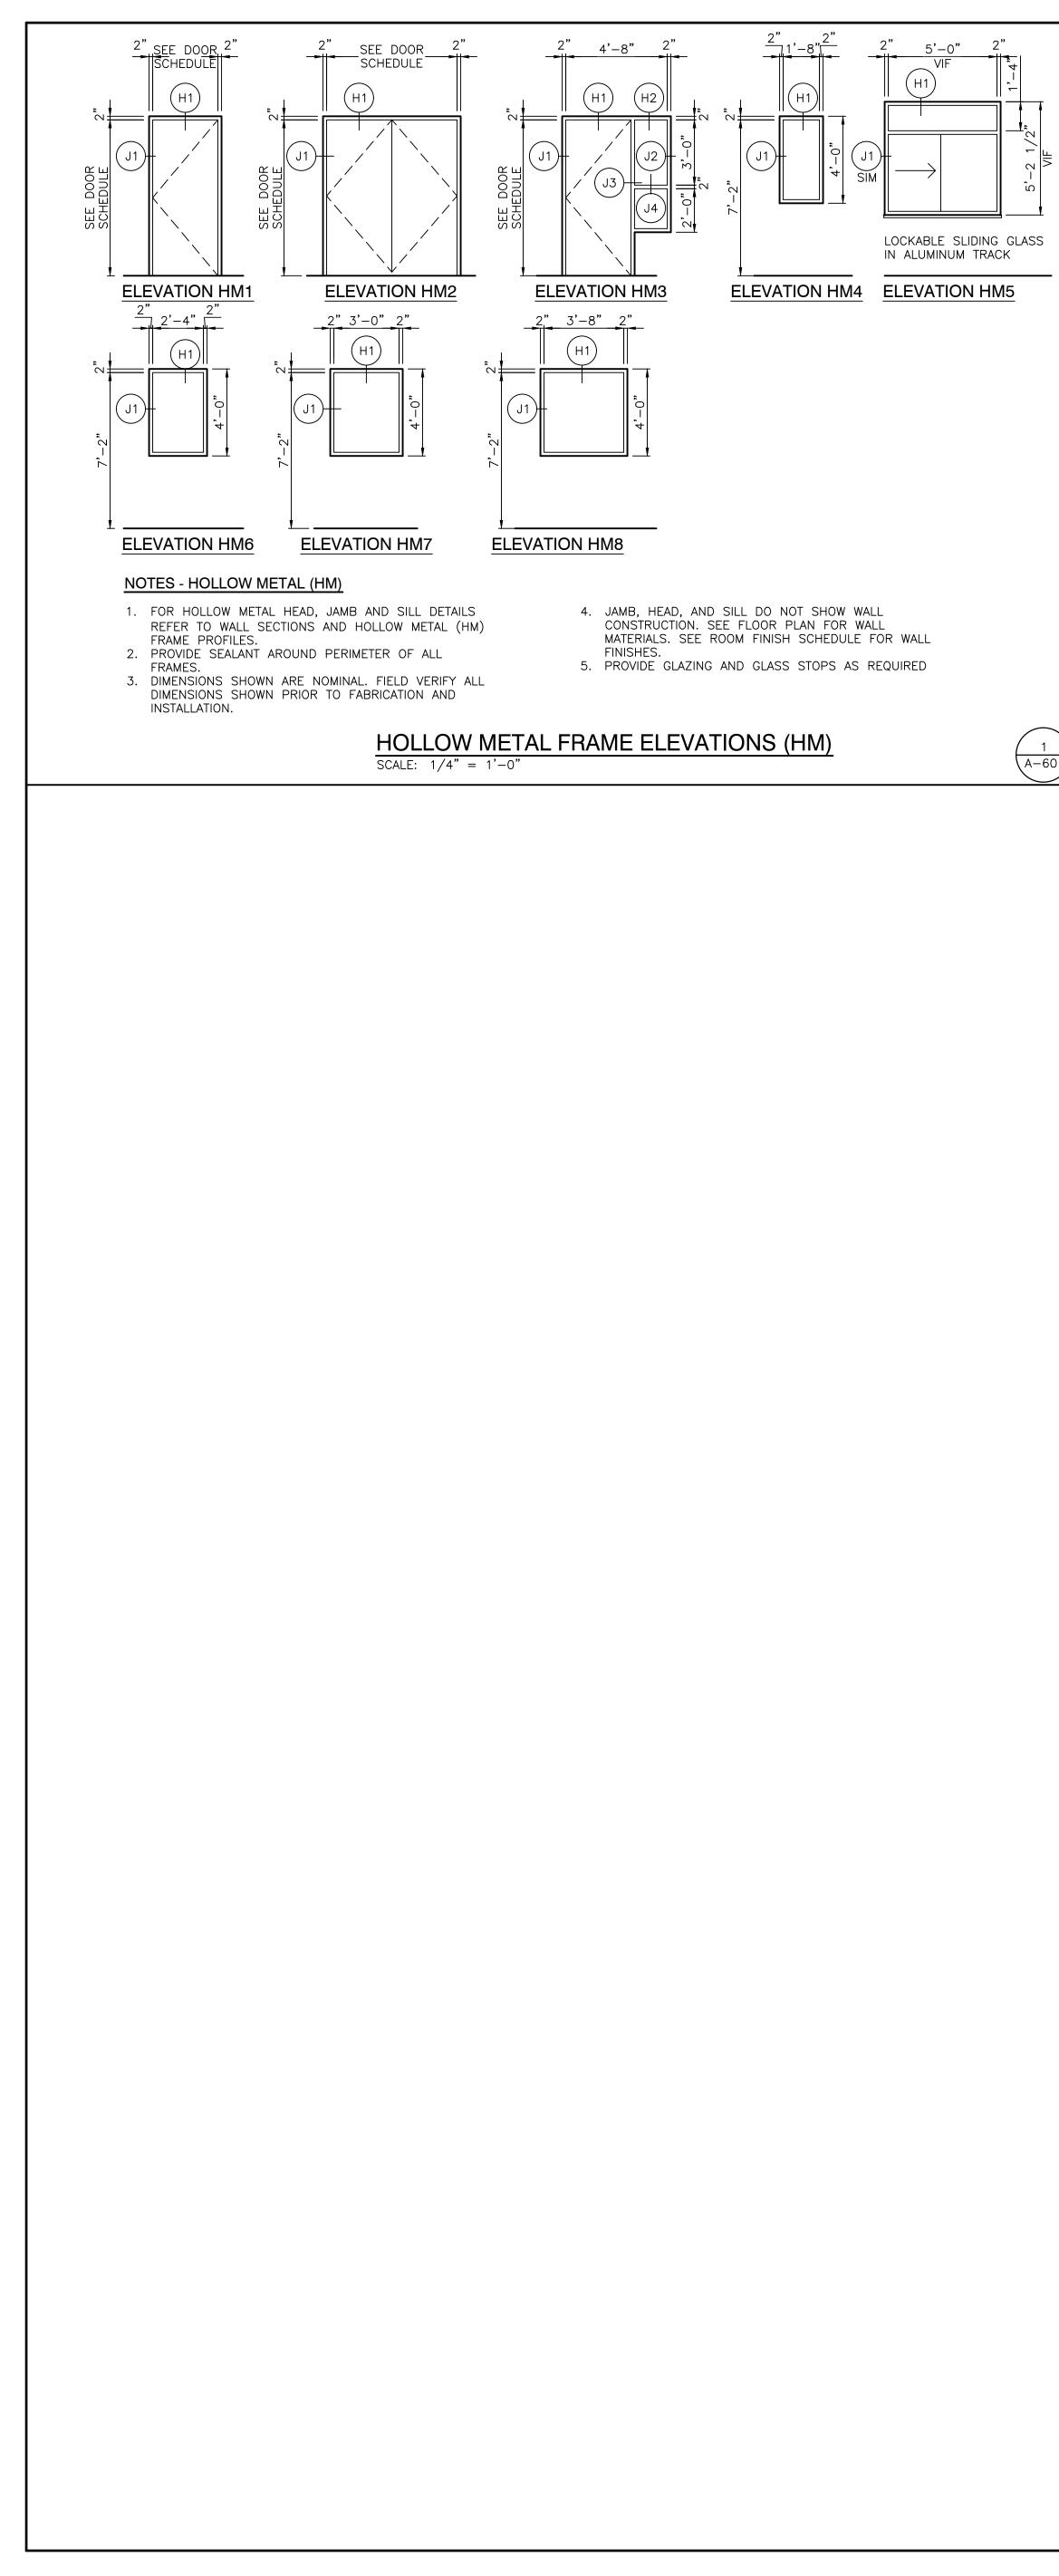


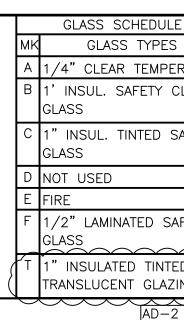


# DOOR AND FRAME SCHEDULE


			[	DOOR				GLASS				FRAME				HARDWARE		
	NO	DESCRIPTION	TYPE	DOOR SIZE (WxH) (INCHES)	MATERIAL	LOU	DOOR	SIDE LGT	TRA	MAT'L	WIDTH	HEAD	JAMB	SILL	ELEV	LABEL	EXIT DEVICE	CLOS
	A-134A	DOUBLE	10	PR 36 x 86	EXT'G					EXT'G	5 3/4"				EXT'G	_		YE
	C-101A	SINGLE	1	36 x 86	WOOD					НМ	5 3/4"	REFER	то	ELEV	HM1			
	C-101B	BORROWED LIGHT	-	_				А		НМ	5 3/4"	REFER	то	ELEV	НМ8			
	C-102A	SINGLE	1	36 x 86	WOOD					НМ	5 3/4"	REFER	то	ELEV	HM1	45		YE
	C-104A	BORROWED LIGHT	-	_				А		НМ	5 3/4"	REFER	то	ELEV	НМ6			
	C-117A	BORROWED LIGHT	-	_				А		НМ	5 3/4"	REFER	то	ELEV	НМ7			
	D-105A	BORROWED LIGHT	-	_				А		НМ	5 3/4"	REFER	то	ELEV	НМ5			
	D-105B	BORROWED LIGHT	-	_				F		НМ	5 3/4"	REFER	то	ELEV	HM4			
	D-136A	SINGLE	1	36 x 86	WOOD					НМ	5 3/4"	REFER	то	ELEV	HM1			YE
	D-136B	SINGLE	5	36 x 86	WOOD					EXT'G	5 3/4"				EXT'G			YE
1 A-601	D-151A	SINGLE	1	36 x 86	WOOD		F	F	F	НМ	5 3/4"	REFER	то	ELEV	НМЗ		YES	YE
A-601	D-151B	SINGLE	1	36 x 86	WOOD		F	F	F	НМ	5 3/4"	REFER	то	ELEV	НМЗ			YE
	D-153A	SINGLE	1	36 x 86	WOOD					НМ	8 3/8"	REFER	то	ELEV	HM1			YE
	D-154A	SINGLE	1	36 x 86	WOOD					НМ	8 3/8"	REFER	то	ELEV	HM1			YE
	D-154B	BORROWED LIGHT	-	_				А		НМ	8 3/8"	REFER	то	ELEV	HM4			
	D-155A	SINGLE	1	36 x 86	WOOD					НМ	8 3/8"	REFER	то	ELEV	HM1			YE
	D-155B	BORROWED LIGHT	_	_				А		НМ	8 3/8"	REFER	то	ELEV	HM4			
	D-156A	SINGLE	4	36 x 86	WOOD			F		НМ	8 3/8"	REFER	то	ELEV	HM1			YE
	D-156B	BORROWED LIGHT	-	_				F		НМ	8 3/8"	REFER	то	ELEV	НМ8			
	D-157A	SINGLE	2	36 x 86	WOOD			A		EXT'G	5 3/4"				EXT'G			
	D-158A	SINGLE	1	36 x 86	WOOD					НМ	8 3/8"	REFER	то	ELEV	HM1			YE
	D-158B	BORROWED LIGHT	-	_				А		НМ	8 3/8"	REFER	то	ELEV	HM4			
	D-159A	SINGLE	1	36 x 86	WD					НМ	8 3/8"	REFER	то	ELEV	HM1			
	D-160A	SINGLE	1	36 x 86	WD					НМ	8 3/8"	REFER	то	ELEV	HM1			
	D-161A	SINGLE	1	36 x 86	WOOD					НМ	8 3/8"	REFER	то	ELEV	HM1			YE
	D-161B	BORROWED LIGHT	-	_				А		НМ	8 3/8"	REFER	то	ELEV	HM4			
	D-161C	BORROWED LIGHT	-	_				A		НМ	8 3/8"	REFER	то	ELEV	НМ7			
	D-162A	SINGLE	1	36 x 86	WOOD					НМ	8 3/8"	REFER	то	ELEV	HM1			YE
	D-162B	BORROWED LIGHT	-	_				F		НМ	8 3/8"	REFER	то	ELEV	НМ7			

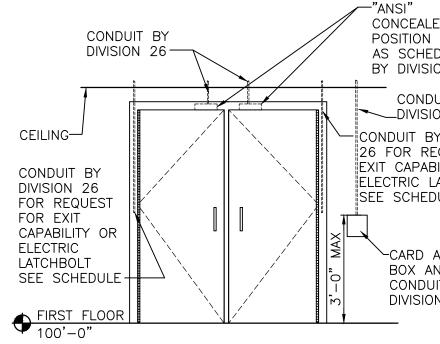


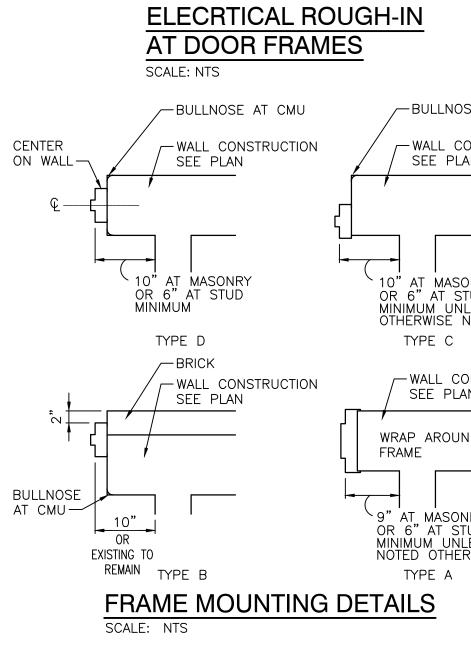

HEDUL				- "			/ERIFY HEI CENTER LII	NE 1	ΓΟ ΜΑΤ	СН	DEVICE								N	ii	ER SCHEI LOUVER S
TEMPE				8"~ 1		- 1	5" 서 기 효	8 ≮ Г	" イ	8" ≮≁ ☐ ∞	Ť	^{EQ 1} ۲ ۲	0" _{EQ}	ו בי		۱		- –			
NTED S	SAFETY			ſ						- 0	*			10.12.10.				Ì			
						ł	100			] [ <u>`</u>	×			I .							
TED SA	\FETY													101, 101, 10,		י   					
D TINTE	ED)					]	+0, +0, +0,									   1 (					
T GLAZ			I	2 	D-3	•				) F	RA		5 <b>E S</b>	CH	EDI		) (EXIS				
					DOOR					GLASS					RAME					HARD	WARE
LOSER	NOTES	NO		TYPE	DOOR SIZE ( (INCHES)	• •	MATERIAL	LOU	DOOR	SIDE LGT	TRA	MAT'L		WIDTH	HEAD	JAMB	SILL	ELEV	LABEL	EXIT DEVICE	CLOSER
YES		D-164A	CASED OPENING	-	42 x 86	5						НМ		3/8"	REFER	ТО	ELEV	HM1			
		E-120A	SINGLE	10			EXT'G		-3			EXT'G		3/8"				EXT'G		YES	YES
		E-120B	SINGLE				EXT'G					EXT'G	5	3/8"				EXT'G		YES	YES
YES		F-101A F-101B	DOUBLE SINGLE	5	<pre>PR 36 x 36 x 86</pre>	$\longrightarrow$	FLUSH AL FLUSH AL	}	B	В  В	B	AL AL		6" 6"	REFER REFER		ELEV ELEV	SF1 SF1		YES	YES
		F-101B		5	PR 36 x	$\longrightarrow$	FLUSH AL	5	F	F	F	AL	4	1/2"	REFER		ELEV			YES	YES
		F-102B	SINGLE	5	36 x 86	<del>~ (</del>	FLUSH AL	)	F	F	F	AL		1/2"	REFER		ELEV	SF1			YES
		F-103A	SINGLE	1	) 36 x 86	5	WOOD					НМ	5	3/4"	REFER	ТО	ELEV	HM1			YES
YES		F-104A	SINGLE	1	36 x 86	5	WOOD					НМ	5	3/4"	REFER	то	ELEV	HM1		AD-3	YES
YES	12	F-105A	SINGLE	1	36 x 86	3	WOOD					НМ	5	3/4"	REFER	ТО	ELEV	НМ1	$\sim$		YES
YES	2,8	F-106A	DOUBLE (	2	PR 36 x	86	WOOD	<u> </u>	E	$\left\langle \right\rangle$		НМ	5	3/4"	REFER	ТО	ELEV	нм2		ES	YES
YES	2,8	F-106B		5	PR 36 x	86 {	FLUSH AL	$\left\langle \right\rangle$	С	}		AL		6"	REFER	ТО	ELEV	SF2		YES	YES
YES		F-106C		5	} PR 36 x	86	FLUSH AL	3	С	}		AL		6"	REFER	ТО	ELEV	SF2	AD-3	YES	YES
YES		F-107A	DOUBLE	1	PR 36 x	86	WOOD	$\langle \rangle$	AD-2			НМ	5	3/4"	REFER	ТО	ELEV	HM2	45		YES
		F-108A	SINGLE	1	36 x 86	5	WOOD	A	-3			НМ	5	3/4"	REFER	ТО	ELEV	HM1	45	~~	YES
YES		F-109A	SINGLE	1	36 x 86		WOOD					НМ		3/4"	REFER		ELEV	HM1			YES
					D-3 DOOR	D	OOR		i	) F			ES		EDU FRAME	JLE			LABEL	HARD	WARE
YES		NO	DESCRIPTION	TYPE			MATERIAL	LOU				MAT'L	V	WIDTH	HEAD	JAMB	SILL	ELEV		EXIT DEVICE	CLOSER
		D-204A	SINGLE	10	36 x 86	6	EXT'G					EXT"G	5	3/4"				EXT'G		YES	YES
YES	11,12	D-204B	SINGLE	10	36 x 86	5	EXT'G					EXT'G	5	3/4"				EXT'G		YES	YES
TES		GENER	AL DOOR NO	TES																	
		B. SEA	IB, HEAD, AND SI AL ALL JAMBS AN	D HEA	ADS WHERE FRAM	MES ME	ET EXPOSE	DM	ASONRY	′ AND/	OR GYI	PSUM B	BOARD.								
		AT D. PRC	OVIDE A SCRIBE N BOTH SIDES OF OVIDE GLAZING AN	ALUMI ND GL	NUM FRAMES. SI ASS STOPS AS F	ET SCR REQUIRE	IBE MOLDS ED.	IN 3	SEALAN ⁻	Τ.	JONL	RAWING	5. 501	KIBE MULL	O TO BE	3/4	X 3/4	METAL	AI EXIE	RIUR UF	METAL FRA
YES		F. SHI	_D VERIFY ALL DI M SPACE IS NOT R DOOR POSITION	SHOV	WN ON DOOR FR	RAME EL	EVATIONS	FOR	ALUMIN	UM ST		DNT. T	AKE TI	HESE DIME	NSIONS	INTO A	CCOUN	T AND /	ADJUST D	IMENSIONS	S ACCORDI
		I. FOF	R ELECTRICAL ROU R HOLLOW METAL R ALUMINUM STOF	FRAM	IE ELEVATIONS (H	HM) AN	D PROFILES	S RE	FER TO												
		K. GLA L. REF	ASS NOTED IN SIE TER TO FLOOR PL ERE FRAMES INDI	DELIGH _ANS	T COLUMN FOR	STORE	FRONT WITH WAND EXIS	I NO STING	DOOR GADA F	APPLII PUSH F	ES TO PADS FO	ALL OPI OR POW	VER AS	SSISTED OF	PERATOR	RS.				-D	
YES		DOOR	SCHEDULE NO	OTES	S (REMARKS)	<u>:</u>															
		2. DOC 3. PRC	OR TO BE CONT	ROLL	ED BY CARD R ED OPERATOR	READER	/FOB. REI	FER	TO EL						IN.						
		5. KEY	VIDE ALUMINUM ED REMOVABLE VIDE HOLD OPE	MULI	LION.	N FULL	. BED OF	MAS	STIC.												
		7. PRE 8. PRC	PARE DOOR AN VIDE DOOR REL VIDE TOP AND	ID FR _EASE	AME FOR DOOF ON AI PHONE	E LOCA	TED AT R	ECEF	PTION LEAF.	DESK.											
		10. PRC 11. PRC	VIDE WALL MOU VIDE STORE FU V DOOR IN EXIS	JNTED INCTIC	) ELECTROMAGN ON IN EXISTING	NETIC [	DOOR HOL	DER	(S) BY										ALLED B'	( HARDW.	ARE INST.
	I		DOOK IN EXIC	STINO																	
																		~5/	8"		
ED DO		12 GA	GE CLIP ANGLE	BY											SEE	EDULE	2"		SEE S	SCHEDUL GLASS TN	
I SWITC EDULED ION 8		FASTEN	FRAME MANUFA NED SECURELY TURAL FRAMING	TO	ER											GLASS	;		2 "	CHEDULE	
DUIT BY		ROOF	CONSTRUCTION RUNNER CHANN														_		VARIES	SCHEE	
BY DIVI	SION T FOR	SECUR "Z" ME	ELY ANCHORED EMBER AT EACH	TO I END											GLAZ STOF	ING C	5		2,	SEE	
BILITY LATCHE DULE		WITH S	SHEET METAL S	CREW	s			1								JIRED			GLAZING AS REQU		
			DOOR FRAME -																		
ACCES AND JIT BY	S	WIDTH	GE "Z" MEMBER OF FRAME, TAC D TO FRAME, T	CK							$\left \right $										
ON 26			GE ROUGH BUC					$\sim$													
		MANUF	IEL BY DOOR F ACTURER AT EA DED FROM FLOO	NCH J	JAMB		/									SEE SCHED				1	/2"
			TURAL FRAMING CONSTRUCTION		/E						<b>X</b>		ľ	2"		FOR G		Γ	LAZING		<u> </u>
	5 A-601	то сн	GE "Z" MEMBER	AME,	TWO					<b>,</b>						ла 11 г. – С.			AS REQU		2,
SE AT	$\smile$		AMB, LOCATED A MIDPOINT OF FR		)P			/								VARIES					5/8
ONSTRU	JCTION	THICKN	SS THAN WALL					/						瓦		2" 2"		<u>2"</u>		<b></b>	SEE SCH FOR GLA
AN 		DOOR	USED WITH 5 FRAME UNLESS WISE NOTED —					_			$\ge$		∟ ⊿⊺			ING ST REQUIR				<u>, JAM</u>	B.12
							~	K					0/ (		<u> </u>			<u> </u>		., 0,	
ONRY																					
ONRY TUD LESS NOTED		DOOR	FRAME ANCHOR	),											_ <b>_</b>	1/2"	SE	E			
		ANCHC TO FLO	ORED SECURELY OOR AND WELD AME-USED AT							×				EE SCHEI		۲ ۳	SC FC	HEDUL R GLAS		SEE SCI	HEDULE
ONSTRU AN	JCTION	MASON	IRY WALLS ONL' FRAME ANCHOR											or door		(	GLA	ZING S REQUII		2"	
ND		WELD AND R	TO DOOR FRAM OUGH BUCK	Ē									+1	<b>_</b>		5/8"		⋰∟ॷ⋃Ⅱ	··		
			IEL, AND ANCHO ELY TO FLOOR			/	/						2'	<u> </u>							
NRY FUD												F		D H1/		IB 'I.	1		ç	SILL S	1/ 51
TUD LESS RWISE		<b>т</b> \/	'PICAL HE	= ^ г	ם א א א א		ഺ൛൜൛	<u>۸</u>	いて			_					_	┍╸╴	-		
			LE: NTS	_~L							3-601			<b>_OW  </b> 3" = 1'-		4L (	HΜ)	FKA	NME F	ϓUF	LES (
	A-601																				

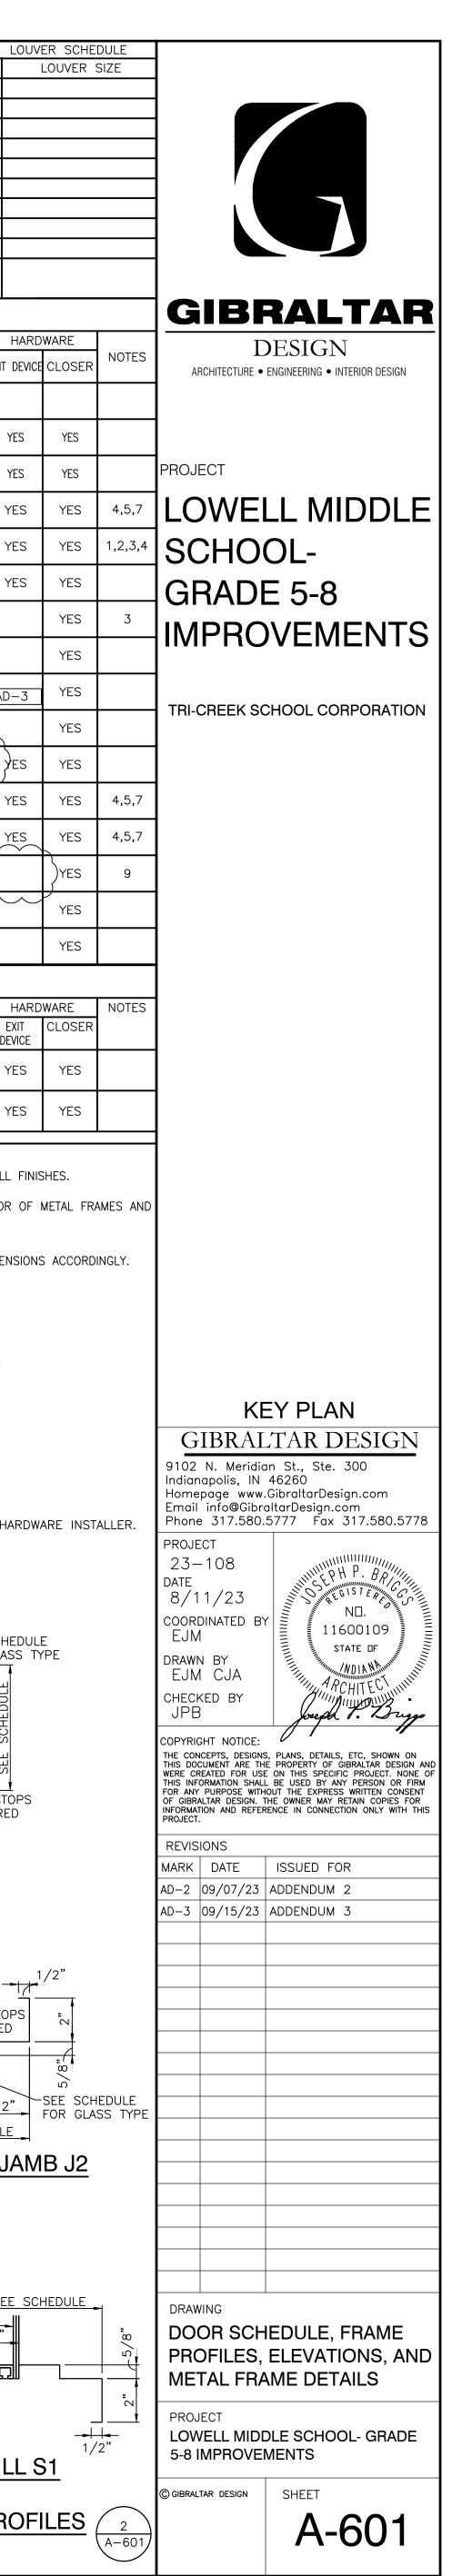

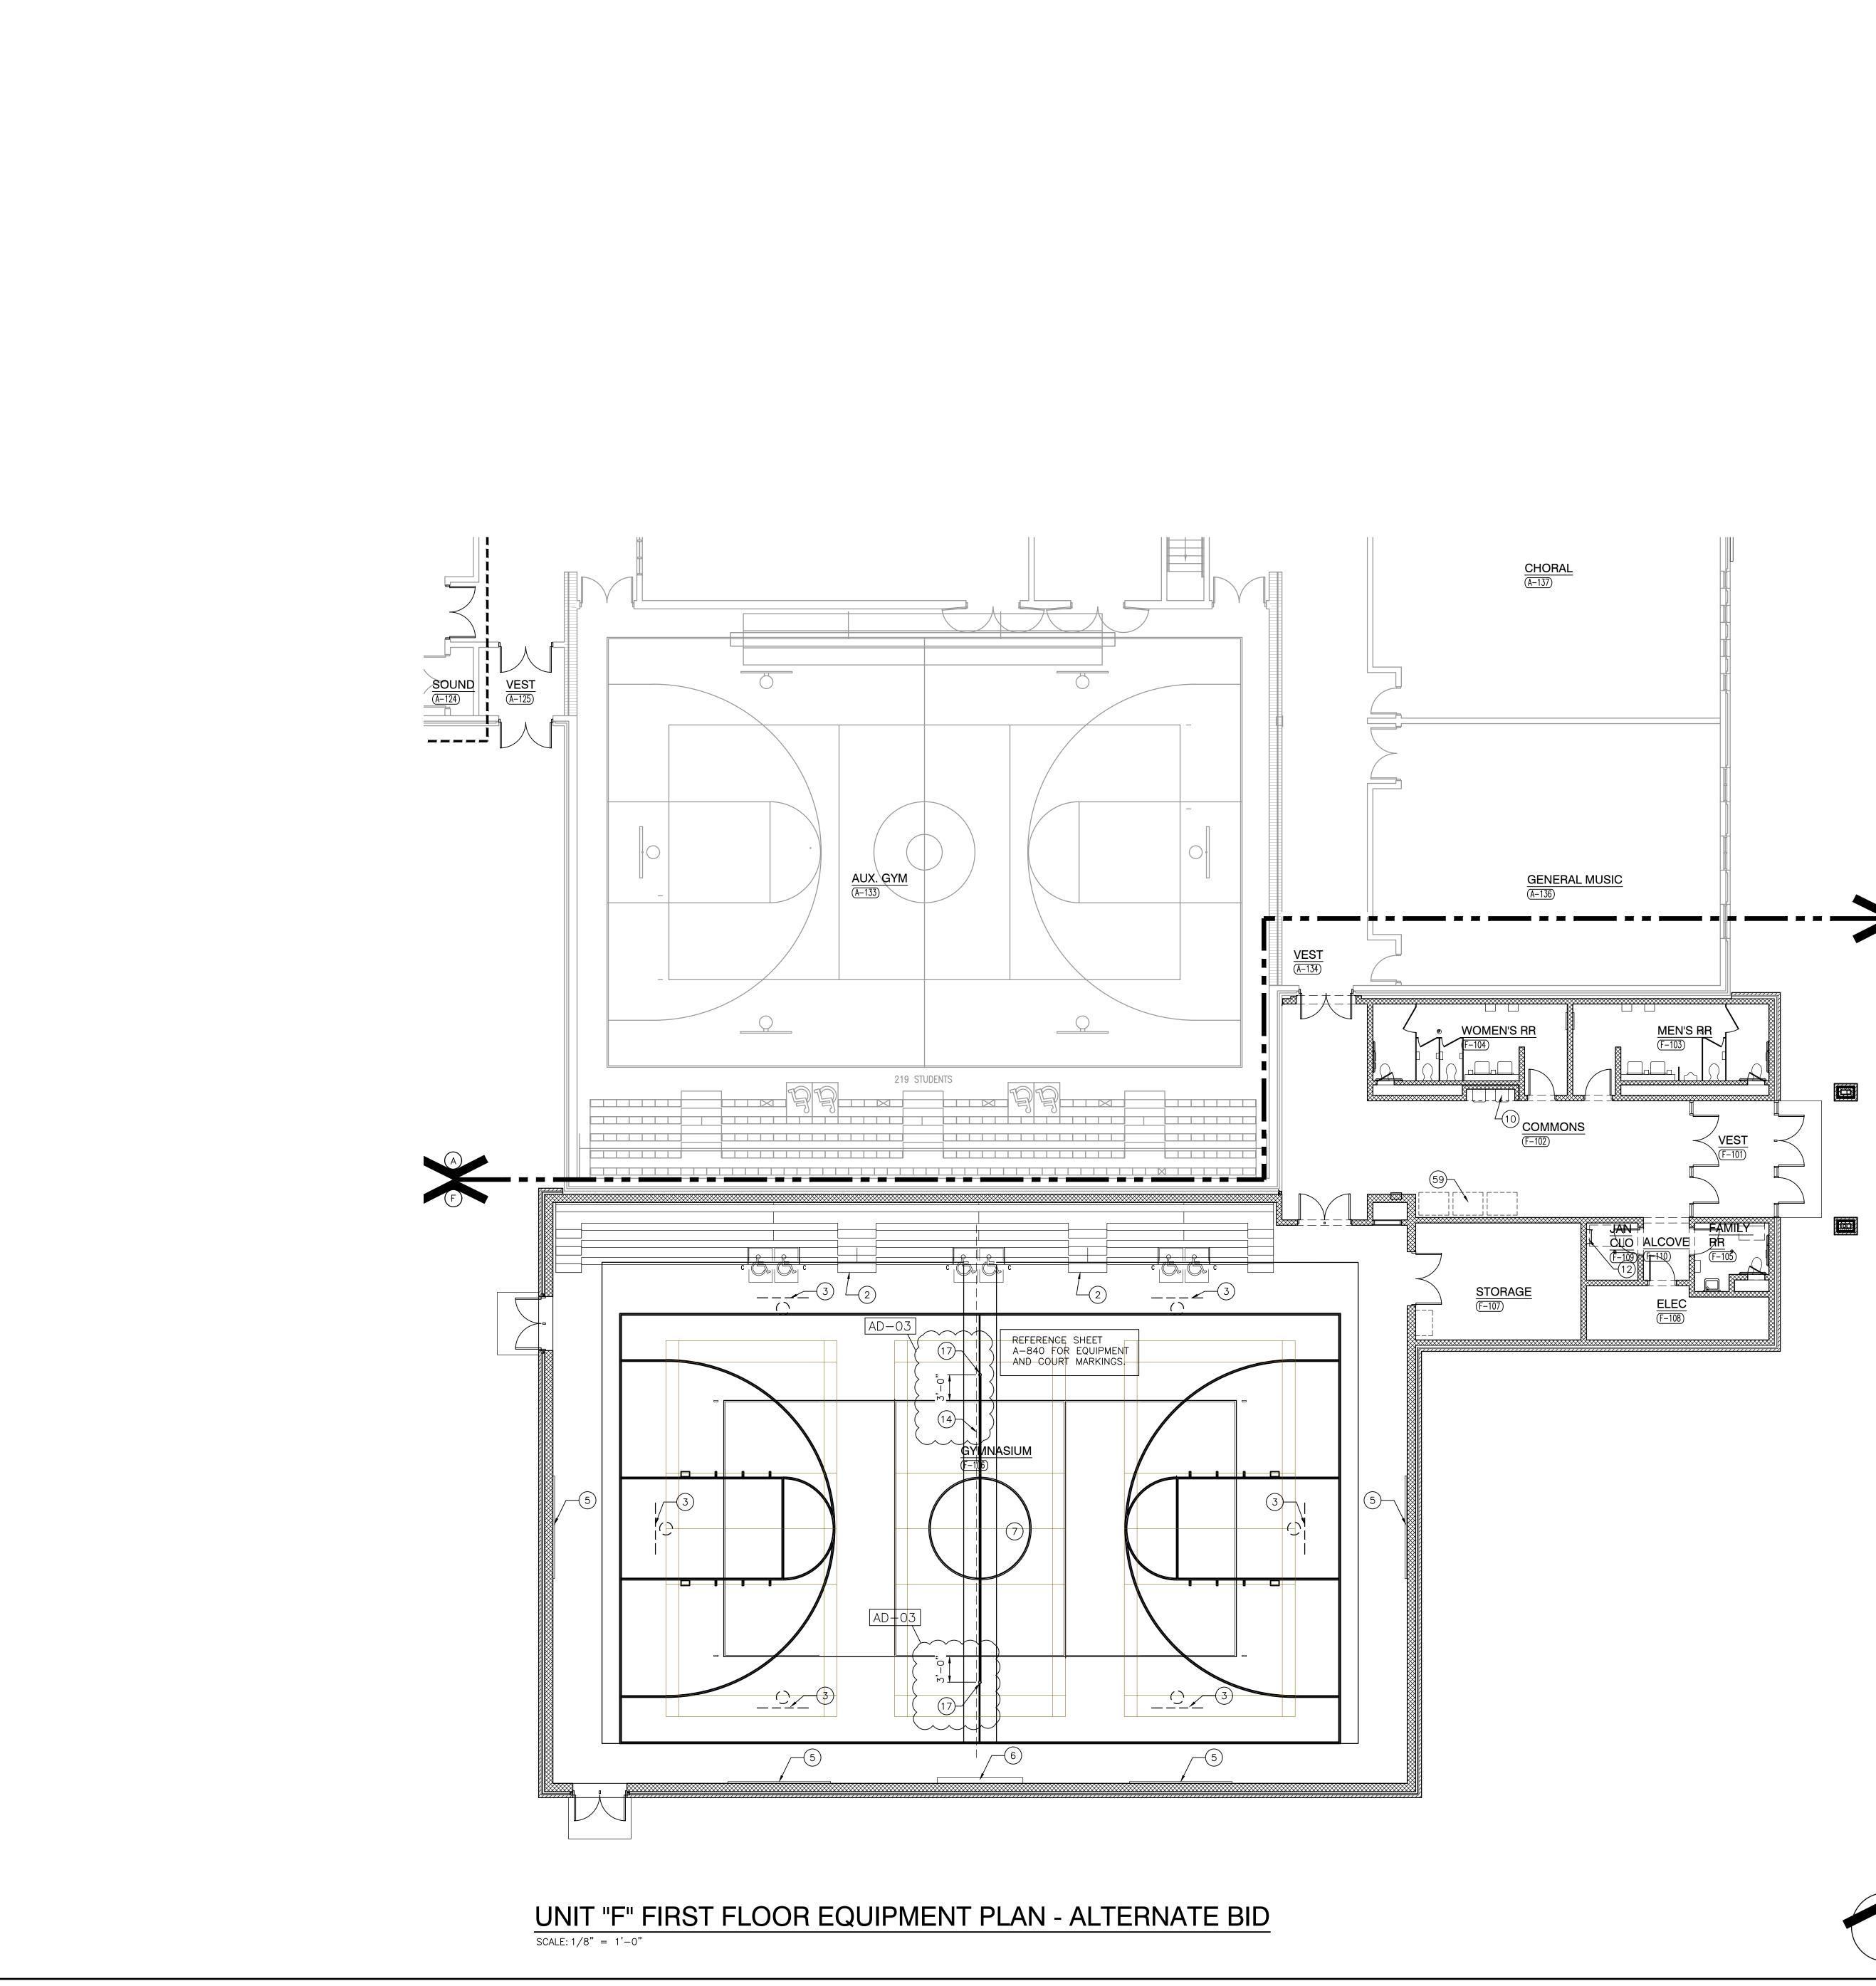

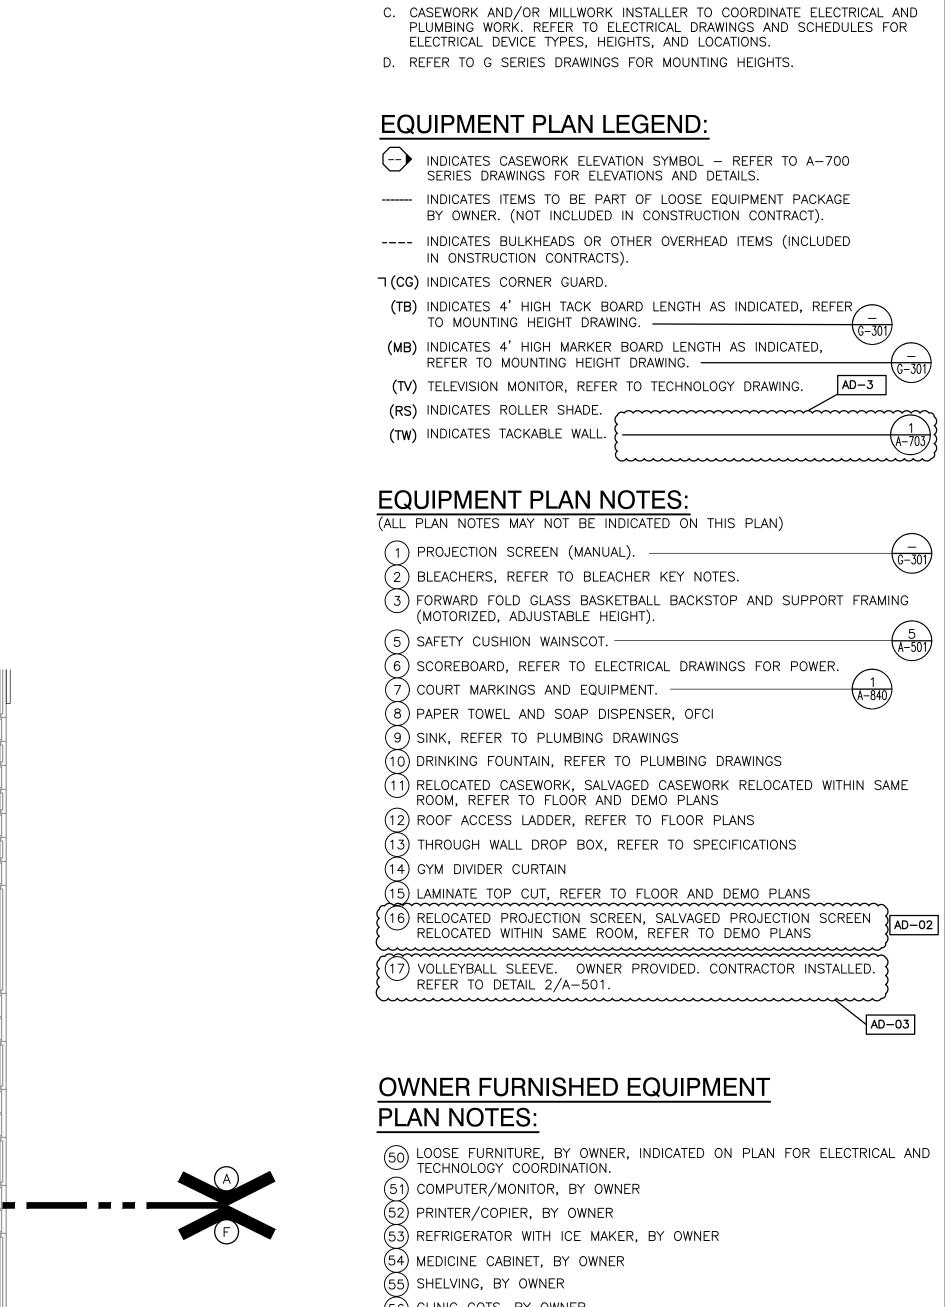

INFORMATION.

B. FIELD VERIFY ALL DIMENSIONS.

GENERAL EQUIPMENT PLAN NOTES:


A. REFER TO SPECIFICATIONS AND FINISH LEGEND FOR ADDITIONAL


- (56) CLINIC COTS, BY OWNER
- (57) CLINIC PRIVACY CURTAIN, BY OWNER
- (58) KILN, BY OWNER, REFER TO MECHANICAL DRAWINGS FOR EXAUST (59) VENDING MACHINE, BY OWNER

# **BLEACHER KEY NOTES:**

(B1) BLEACHERS (1 LOCATION) 188 NET SEATS (18" WIDE) WITH 6 RECOVERABLE / RETRACTABLE SEATS FOR 6 ADA COMPLIANT WHEELCHAIR SEATING LOCATIONS.



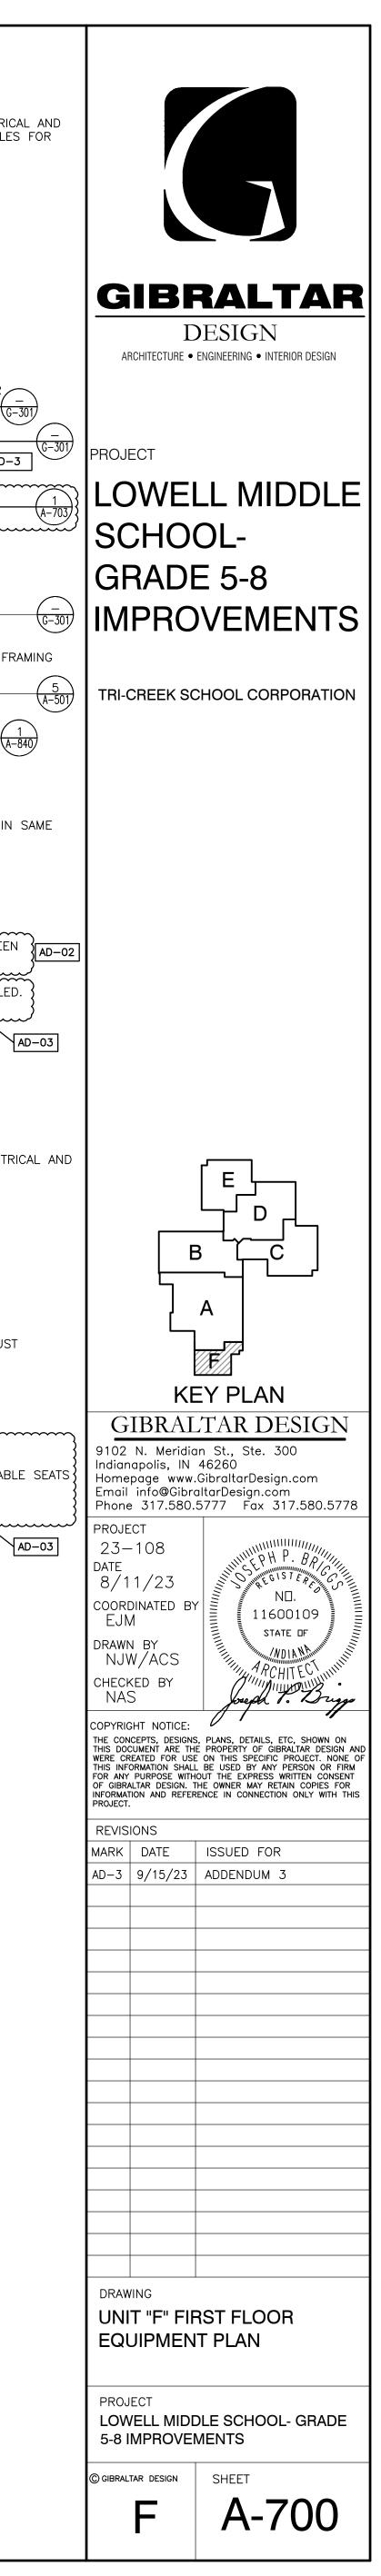

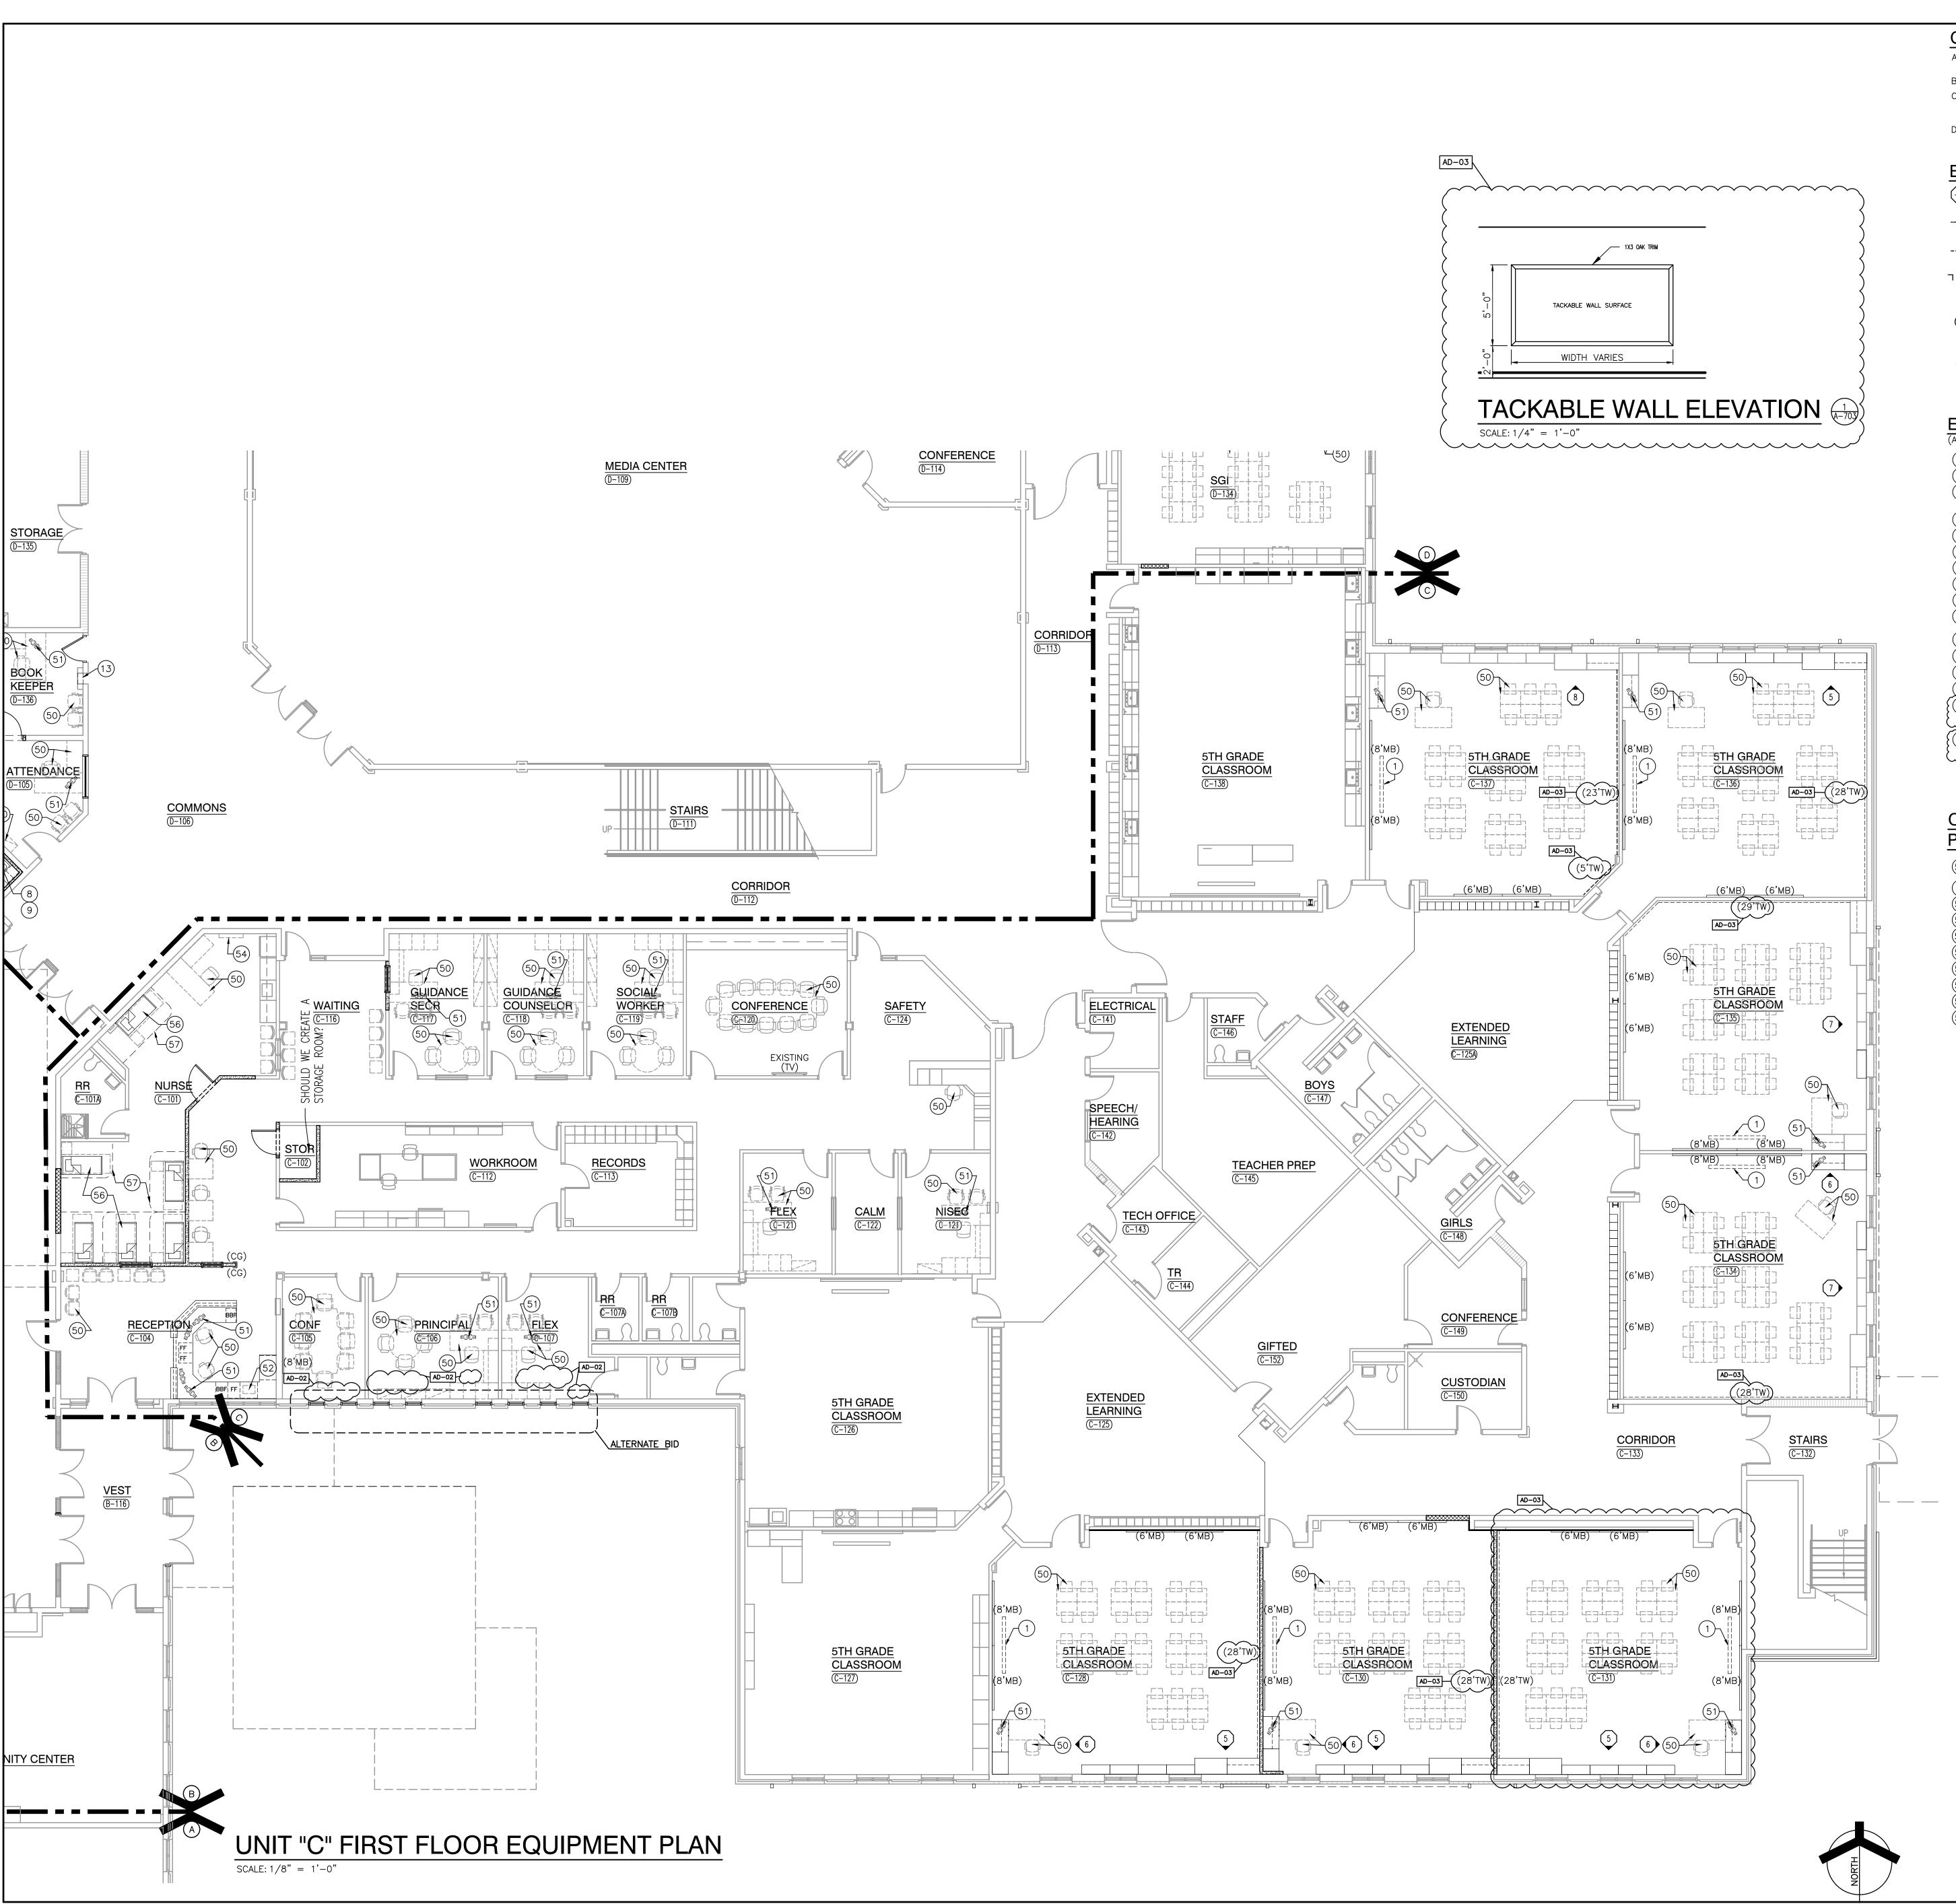

# GENERAL EQUIPMENT PLAN NOTES:

- A. REFER TO SPECIFICATIONS AND FINISH LEGEND FOR ADDITIONAL INFORMATION.
- B. FIELD VERIFY ALL DIMENSIONS.
- C. CASEWORK AND/OR MILLWORK INSTALLER TO COORDINATE ELECTRICAL AND PLUMBING WORK. REFER TO ELECTRICAL DRAWINGS AND SCHEDULES FOR
- ELECTRICAL DEVICE TYPES, HEIGHTS, AND LOCATIONS. D. REFER TO G SERIES DRAWINGS FOR MOUNTING HEIGHTS.

# EQUIPMENT PLAN LEGEND:


- (--) INDICATES CASEWORK ELEVATION SYMBOL REFER TO A-700 SERIES DRAWINGS FOR ELEVATIONS AND DETAILS. ----- INDICATES ITEMS TO BE PART OF LOOSE EQUIPMENT PACKAGE BY OWNER. (NOT INCLUDED IN CONSTRUCTION CONTRACT). ---- INDICATES BULKHEADS OR OTHER OVERHEAD ITEMS (INCLUDED IN ONSTRUCTION CONTRACTS). ☐ (CG) INDICATES CORNER GUARD. (TB) INDICATES 4' HIGH TACK BOARD LENGTH AS INDICATED, REFER TO MOUNTING HEIGHT DRAWING. <u>(</u>G-301) (MB) INDICATES 4' HIGH MARKER BOARD LENGTH AS INDICATED, REFER TO MOUNTING HEIGHT DRAWING. ----
- (TV) TELEVISION MONITOR, REFER TO TECHNOLOGY DRAWING. AD-3 (RS) INDICATES ROLLER SHADE. (TW) INDICATES TACKABLE WALL.

# **EQUIPMENT PLAN NOTES:**


- (ALL PLAN NOTES MAY NOT BE INDICATED ON THIS PLAN)
- (1) PROJECTION SCREEN (MANUAL). (2) BLEACHERS, REFER TO BLEACHER KEY NOTES.
- (3) FORWARD FOLD GLASS BASKETBALL BACKSTOP AND SUPPORT FRAMING
- (MOTORIZED, ADJUSTABLE HEIGHT).
- (5) SAFETY CUSHION WAINSCOT. -
- (6) SCOREBOARD, REFER TO ELECTRICAL DRAWINGS FOR POWER.
- (7) COURT MARKINGS AND EQUIPMENT. -
- (8) PAPER TOWEL AND SOAP DISPENSER, OFCI
- (9) SINK, REFER TO PLUMBING DRAWINGS
- (10) DRINKING FOUNTAIN, REFER TO PLUMBING DRAWINGS
- (11) RELOCATED CASEWORK, SALVAGED CASEWORK RELOCATED WITHIN SAME
- ROOM, REFER TO FLOOR AND DEMO PLANS (12) ROOF ACCESS LADDER, REFER TO FLOOR PLANS
- (13) THROUGH WALL DROP BOX, REFER TO SPECIFICATIONS
- (14) GYM DIVIDER CURTAIN
- 15) LAMINATE TOP CUT. REFER TO FLOOR AND DEMO PLANS
- (16) RELOCATED PROJECTION SCREEN, SALVAGED PROJECTION SCREEN
- RELOCATED WITHIN SAME ROOM, REFER TO DEMO PLANS
- 7) VOLLEYBALL SLEEVE. OWNER PROVIDED. CONTRACTOR INSTALLED. REFER TO DETAIL 2/A-501.


### OWNER FURNISHED EQUIPMENT PLAN NOTES:

- 50 LOOSE FURNITURE, BY OWNER, INDICATED ON PLAN FOR ELECTRICAL AND TECHNOLOGY COORDINATION.
- (51) COMPUTER/MONITOR, BY OWNER
- 52) PRINTER/COPIER, BY OWNER
- (53) REFRIGERATOR WITH ICE MAKER, BY OWNER
- (54) MEDICINE CABINET, BY OWNER
- (55) SHELVING, BY OWNER
- (56) CLINIC COTS, BY OWNER
- (57) CLINIC PRIVACY CURTAIN, BY OWNER
- (58) KILN, BY OWNER, REFER TO MECHANICAL DRAWINGS FOR EXAUST
- (59) VENDING MACHINE, BY OWNER

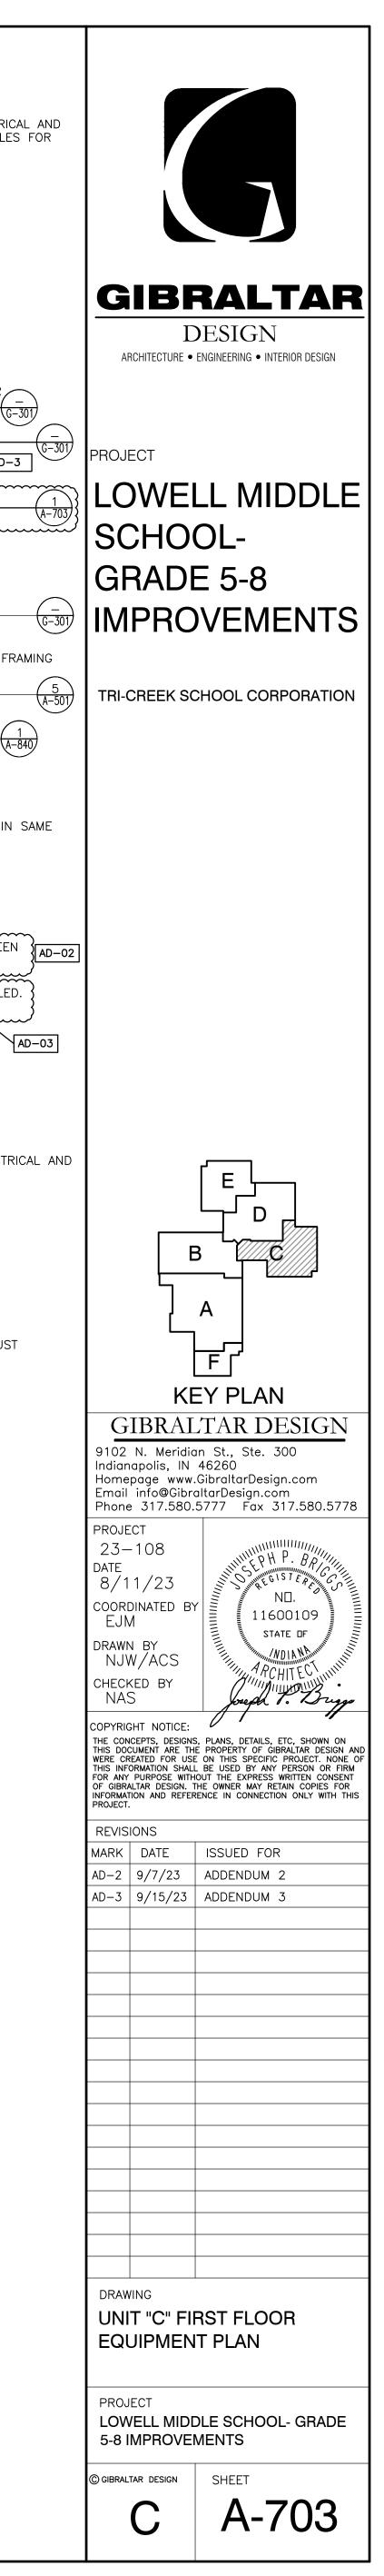

hursday, 9/14/2023 - 11:54 AM - LAST SAVED BY:ASCOTT :\23-108 TRI-CREEK SC - LOWELL MS 5-8 APROVEMENTS\23-108 DRAWINGS\05 ARCH\A-720.DWG

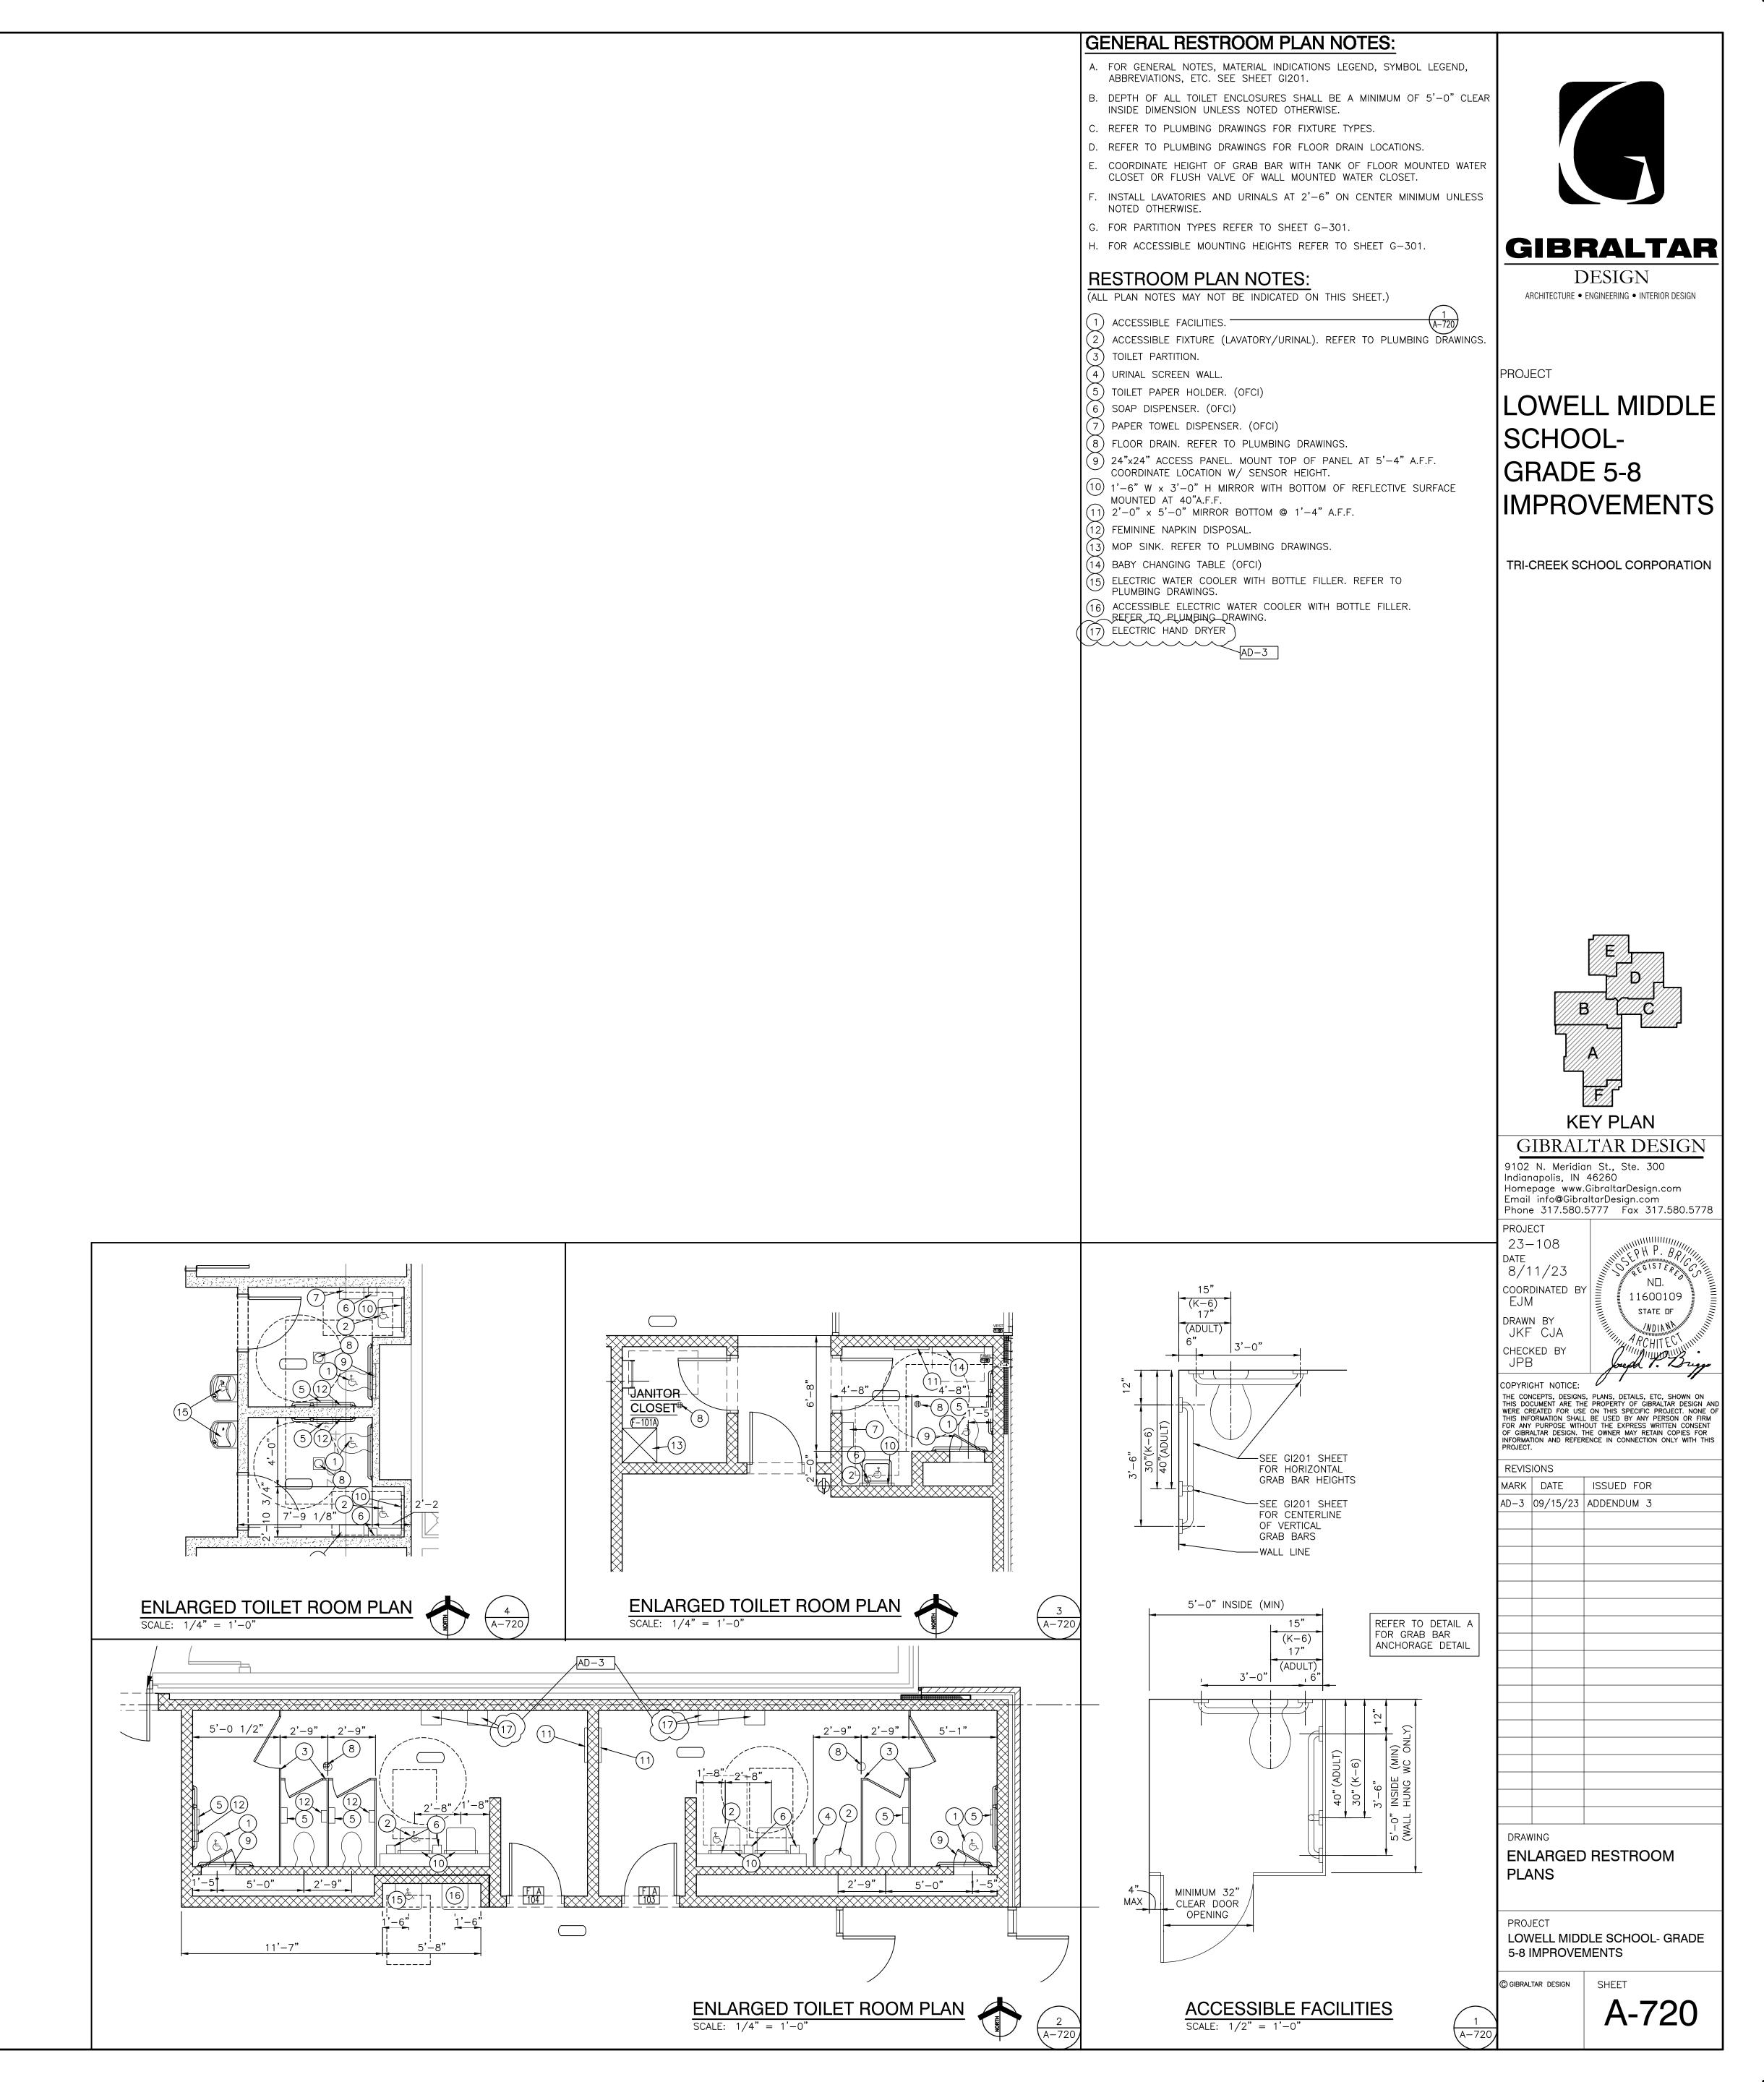


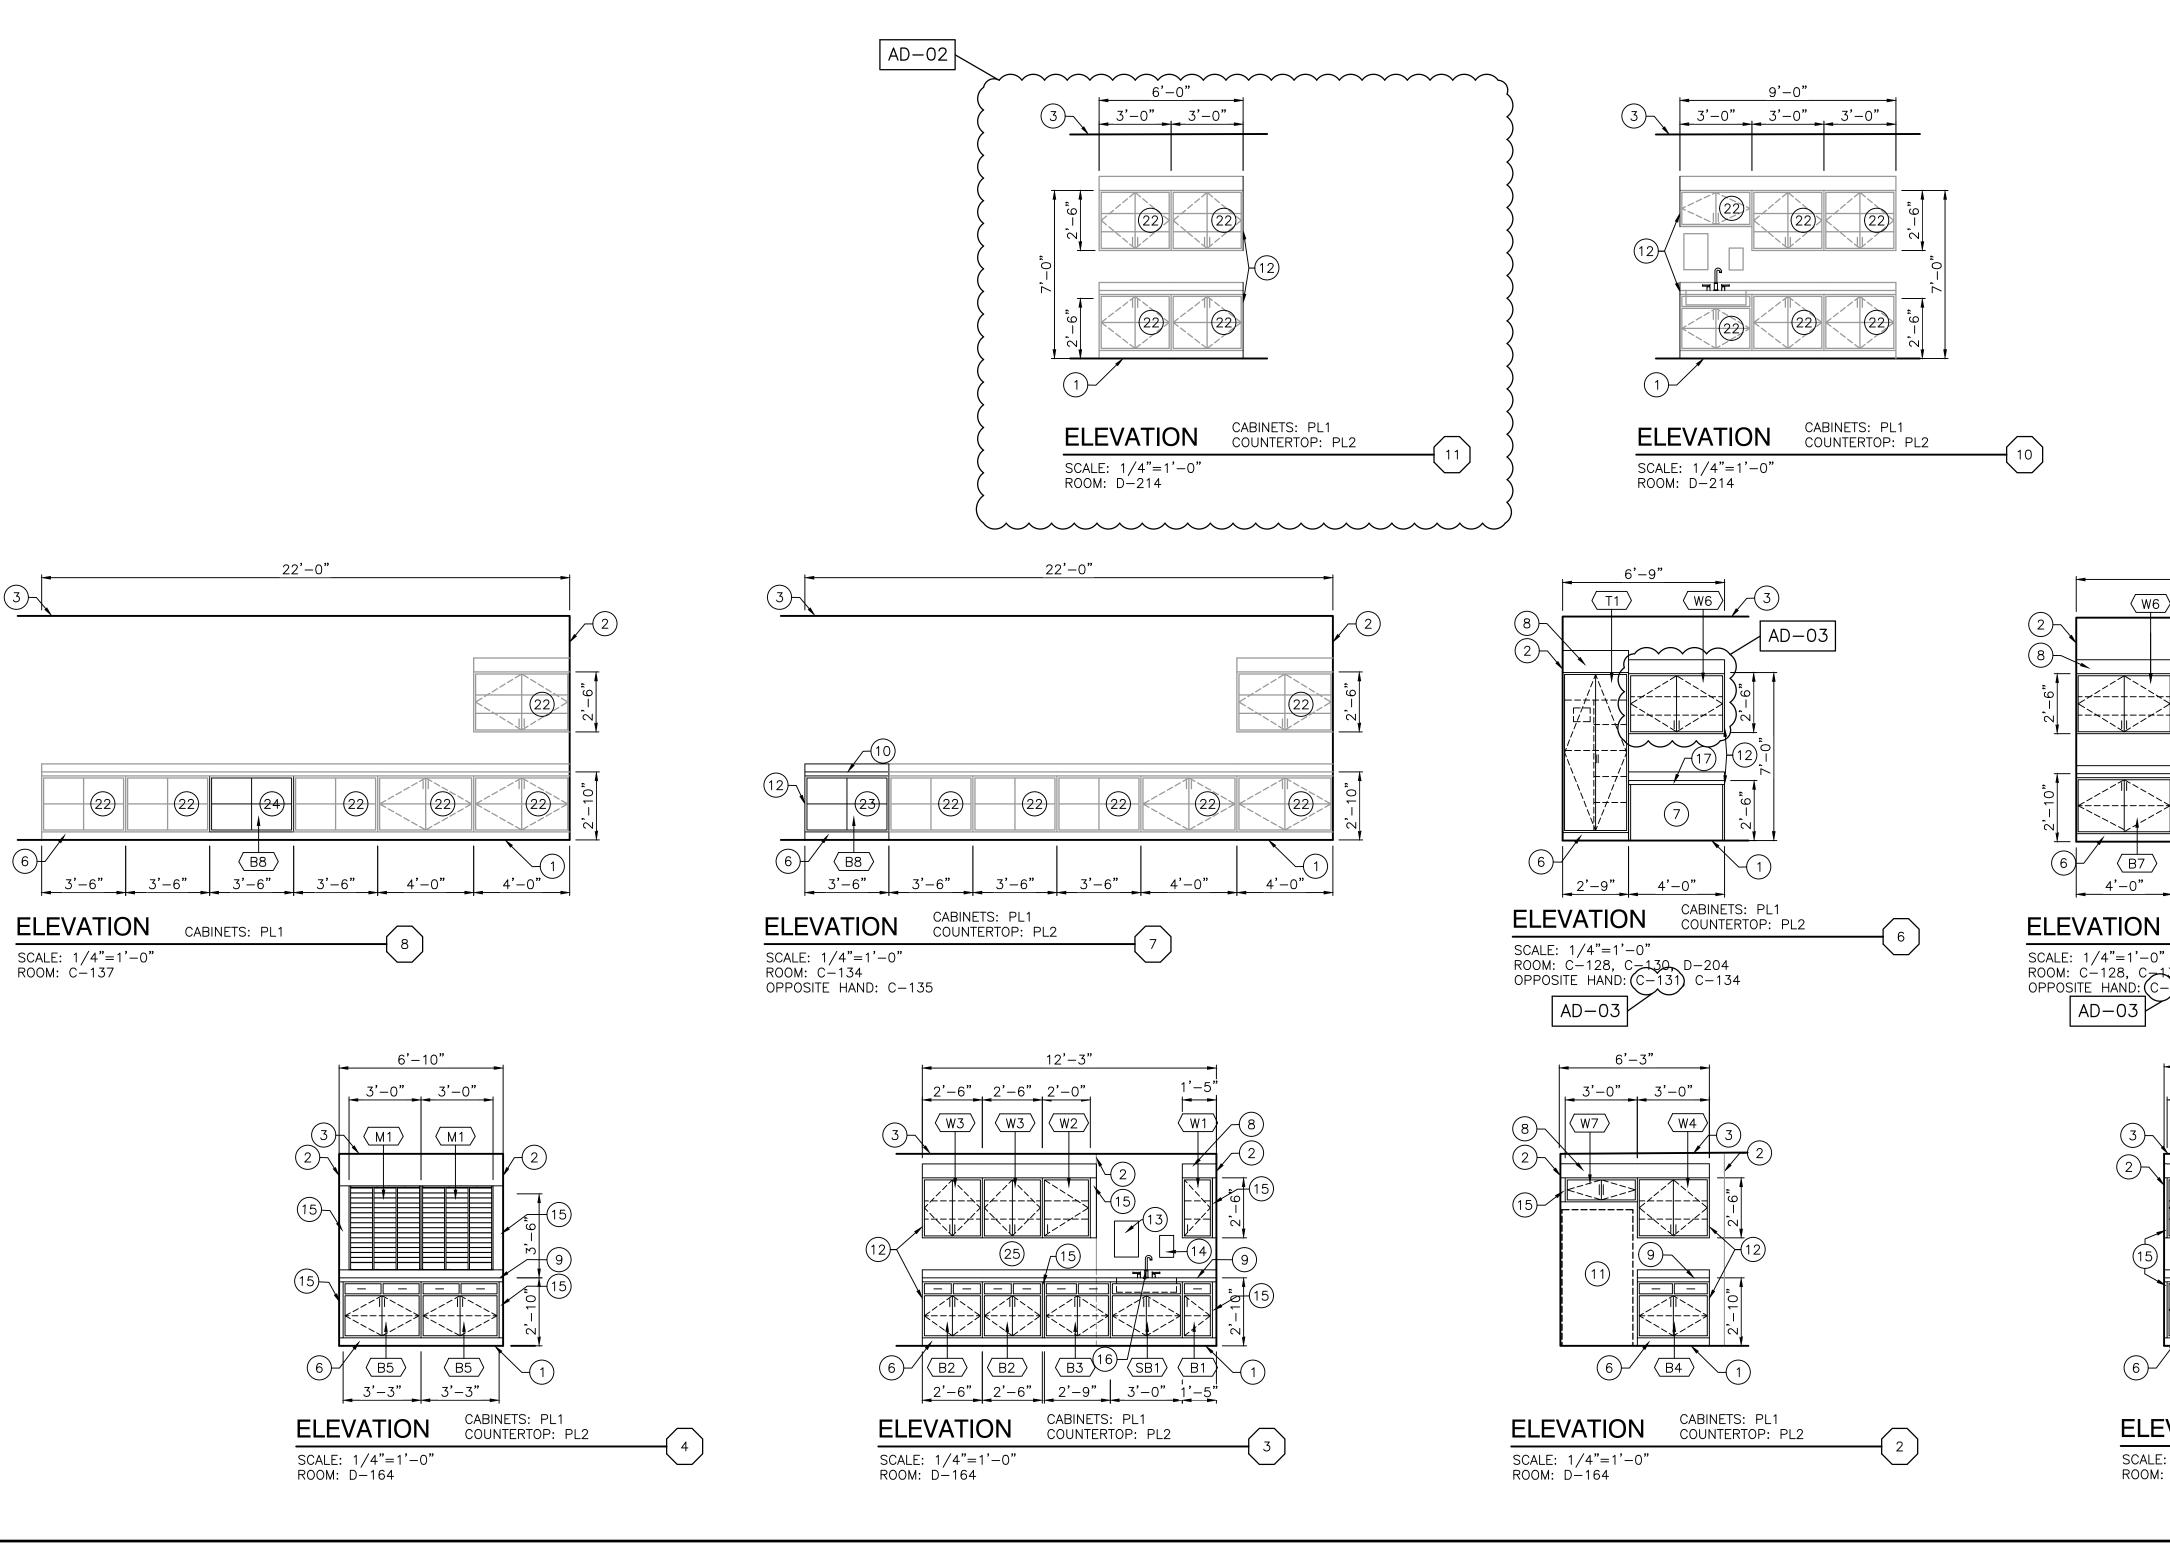

'ЕD 73С 19/14/2023 - 11:11 AM - LAST SA 108 TRI-CREEK SC - LOWELL MS 5-8 EMENTS\23-108 DRAWINGS\05 ARCH\A- (3)

(6)

			_	LAMINATE CASEWORK SCHEDULE
	MARK B1	<b>NUMBER</b> 10421		24"D X 34"H ONE DOOR, RIGHT HINGED
	B2 B3 B4	10432 10432 10432	30" 33" 36"	24"D X 34"H TWO DOORS, TWO DRAWERS 24"D X 34"H TWO DOORS, TWO DRAWERS 24"D X 34"H TWO DOORS, TWO DRAWERS
	B5 B6	10432 10129	39" 42"	24"D X 34"H TWO DOORS, TWO DRAWERS 24"D X 34"H TWO DOORS
	B7 B8 SB1	10129 10138 10479	42"	24"D X 34"H TWO DOORS 15"D X 34"H OPEN UNIT, TWO ADJUST. SHELVES, VERTICAL DIV 24"D X 32"H FALSE FRONT, DOORS, REMOVABLE BACK
	W1 W2	16120 16120	15" 24"	14"D X 30"H ONE DOOR, RIGHT HINGED 14"D X 30"H ONE DOOR, RIGHT HINGED
	W3 W4 W5	16129 16129 16129	30" 36" 42"	14"D X 30"H TWO DOORS, ADJUSTABLE SHELVES. 14"D X 30"H TWO DOORS, ADJUSTABLE SHELVES. 14"D X 30"H TWO DOORS, ADJUSTABLE SHELVES.
AD-03	W6 W7 W8	16129 16129 	48" 	14"D X 30"H TWO DOORS, ADJUSTABLE SHELVES 14"D X 12"H TWO DOORS, ABOVE REFRIGERATOR. NOT USED
	M1	15251		14"D X 42"H MAIL CUBICLE, 3/4" MAIL DIVIDERS, 33 COMPART
	T1	26602	33"	24"D X 84"H WARDROBE, TWO DOORS, LOCKABLE
		REFER TO E	QUIPM	NOTES (APPLIES TO PLASTIC LAMINATE CASEWORK) ENT PLANS FOR CASEWORK LOCATIONS AND FINISH LEGEND IN DRAWINGS FOR FINISH INFORMATION. REFER TO SPECIFICATIONS FO
	В.	INDUSTRIES,	ULING INC (	MATION. PURPOSES ONLY, MODEL NUMBERS ARE TAKEN FROM STEVENS UNLESS NOTED OTHERWISE) AND ARE FOR CABINET REQUIREMENT TCATIONS FOR CABINET CONSTRUCTION METHODS.
		ALL COUNTE BACKSPLASE	ERTOPS	AND CASEWORK DIMENSIONS WITH CASEWORK MANUFACTURER. TO BE PLASTIC LAMINATE WITH 4" HIGH PLASTIC LAMINATE OR ENDSPASH AT ALL LOCATIONS WHERE COUNTERTOP MEETS E (UNLESS NOTED OTHERWISE).
	F.	PROVIDE 3M PROVIDE A	IM PVC 4" HIG	E EDGE ON ALL PLASTIC LAMINATED COUNTERTOPS AND BACKSPLA TH TOE SPACE ON ALL BASE AND FULL HEIGHT CABINETS.
	н.	OPEN INTER ALL EXPOSE PROVIDE CC	IORS C ED CAS	EWORK SURFACES TO BE PLASTIC LAMINATE FINISHED, INCLUDING DF CABINETRY (UNLESS NOTED OTHERWISE). EWORK ENDS SHALL BE FINISHED TO MATCH CASEWORK FRONTS. DUS PLASTIC LAMINATE SLOPED TOPS ON ALL WALL AND FULL HE
		CABINETS (U FILLER PANI TO MAKE C. CASEWORK	JNLESS ELS, TF ASEWOF MANUF/	S OTHERWISE NOTED). RIM, AND MOLDING PROVIDED SHALL BE CONTINUOUS AS NECESSA RK CONTINUOUS TO ADJACENT PARTITION, CEILING, AND/OR BULK ACTURER / INSTALLER SHALL PROVIDE ALL FILLERS AND SCRIBES
	L.	PROVIDE LO ALL ADJOINI	CKS O NG CA	COMPLETE AND FINISHED CASEWORK INSTALLATION. N ALL CABINET DRAWERS AND DOORS, KEYED ALIKE BY ROOM. BINETS SHALL BE ALIGNED. REQUIRES SHIMMING, PROVIDE ONLY APPROVED METAL SHIMS.
	N.	CABINETS L	OCATED	D IN FRONT OF A PIPE CHASE SHALL HAVE REMOVABLE BACKS. ALANT AT ALL JUNCTIONS OF CASEWORK / COUNTERTOPS WITH R CASEWORK.
		SURFACES / INSTALLER.	AND SI	VINYL COVE BASE AT ALL TOE SPACE AREAS AND AT EXPOSED IDES OF CABINETS ADJACENT TO TOE SPACES. BY FLOORING ICAL DRAWINGS AND SCHEDULES FOR DEVICE TYPES, HEIGHTS AN
6'-9"	R.	REFER TO F	PLUMBI	NG DRAWINGS AND SCHEDULES FOR FIXTURE TYPES AND LOCATIO NG DRAWINGS FOR PLUMBING CONNECTIONS. LLING AND PATCHING OF CASEWORK AND COUNTERTOPS AS REQUI
		FOR INSTALI	ATION	OF PIPING OR CONDUIT SHALL BE BY CASEWORK MANUFACTUREF
				${\sf S}$ (applies to plastic laminate casework)
	$ \begin{array}{c} 1\\ 2\\ 3 \end{array} $			FLOOR (16) SINK, REFER TO PLUMBING DRAWIN (17) TEACHER'S STATION (18) NOT USED AD-03
	4 5 6	NOT USED		(19) NOT USED
ELEVATION CABINETS: PL1 COUNTERTOP: PL2	7 8 9	) KNEE SPAC ) SLOPED TO ) 25"D COUN	E P (COI ITERTOF	(22) EXISTING CASEWORK TO REMAIN, VI EXISTING CONDITIONS, REFER TO D PLANS P WITH 4" (23) NEW BASE UNIT AND COUNTERTOP,
SCALE: 1/4"=1'-0" ROOM: E-120	10	NOTED OTH 16"D COUN	ERWISE ITERTOF H AND	P WITH 4" (24) NEW BASE UNIT TO MATCH EXISTIN SIDESPLASH UNLESS UNITS, INSTALL UNDER EXISTING
22'-0"	(11) (12) (13)	) REFRIGERAT ) FINISHED B	OR, BY ACK/EN	CONDITIONS.
	14	) SOAP DISPI	ENSER IEL FIN	(OFCI) IISHED TO MATCH
(9) (10)				
$\begin{array}{c ccccccccccccccccccccccccccccccccccc$				
ATION CABINETS: PL1 COUNTERTOP: PL2				
/4"=1'-0" -128, C-130, E-121 <u>E HAND:</u> (C-131), C-136 D-03				
10'-9"				
$\begin{array}{c ccccccccccccccccccccccccccccccccccc$				
ELEVATION CABINETS: PL1 COUNTERTOP: PL2				
SCALE: 1/4"=1'-0" ROOM: D-157				

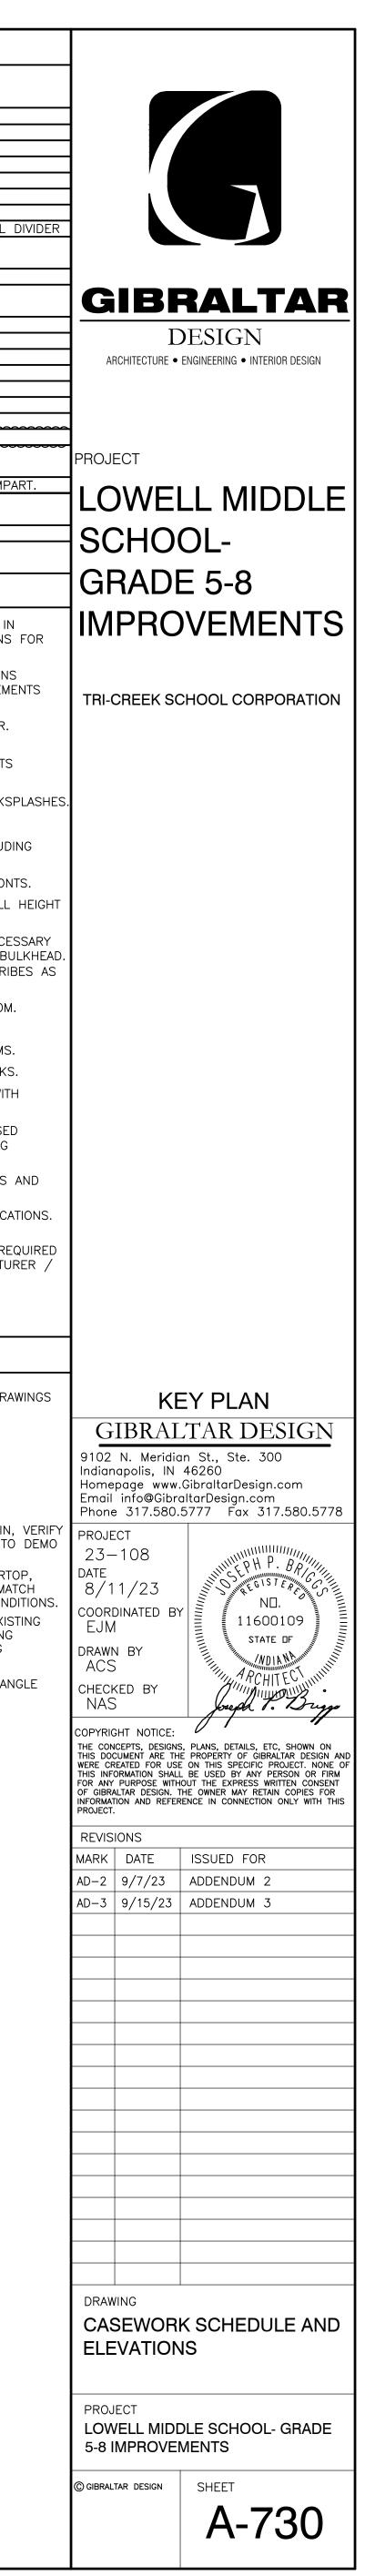


Friday, 9/15/2023 – 9:07 AM – LAST SAVED BY:ASCOTT Y:\23–108 TRI-CREEK SC – LOWELL MS 5–8 IMPROVEMENTS\23–108 DRAWINGS\05 ARCH\A-820.DWG


SURFACE	MARK	DESCRIPTION	MANUFACTURER	PATTERN/FINISH	NUMBER/COLOR	SIZE	COMMENTS
<b>CEILING MATERIA</b>	LS						Ъ
	ACT1	ACOUSTICAL CEILING	ARMSTRONG	FINE FISSURED	1728 WHITE	24" X 24"	ANGLED TEGULAR
	P5	PAINT	SHERWIN WILLIAMS		SW 7007 CEILING BRIGHT WHITE		
WALL BASE							
	B1	VINYL BASE	TARKETT		BURNT UMBER 63	4" COVE	
	B2	VINYL BASE	TARKETT		BURNT UMBER 63	6" MILLWORK REVEAL	
	В3	VINYL BASE	TARKETT		BURNT UMBER 63	6" COVE	
	TB1	PORCELAIN TILE BASE	AMERICAN OLEAN	UNGLAZED MOSAICS	WILLOW SPECKLE 0A94	5" BUILT UP COVE	
FLOOR MATERIAL	<u>Ş</u>	<b>i</b>	<b>i</b>				
	C1	CARPET TILE	TARKETT	GABARDINE 11511	BEDSTONE 77204	18" X 36"	VERTICAL ASHLAR
	C2	CARPET TILE	TARKETT	APPLAUSE III 02803	FIREWORKS 28515	24" X 24"	MONOLITHIC
	C3	WALK OFF CARPET TILE	TARKETT	ABRASIVE ACTION II 02578	WINTER GREY 19103	24" X 24"	MONOLITHIC
	VCT1	VINYL COMPOSITION TILE	TARKETT	VCT II	573 DESERT STORM	12" X 12"	
	SC	SEALED CONCRETE					
	SE1	ROLLED RUBBER FLOOR		ADVANCE	192 DARK MAPLE		
1	SF2	ROLLED_RUBBER_FLOOR_	MONDO	ARMOR		6 <u>MM</u>	
						0" V 0"	
	FT1	FLOOR TILE	AMERICAN OLEAN	UNGLAZED MOSAICS	WILLOW SPECKLE 0A94	2" X 2"	
	I	I	1	1			
WALL MATERIALS	3						
	P1	PAINT	SHERWIN WILLAIMS		CUSTOM COLOR		SEE NOTE 1
	P1 P2	PAINT	SHERWIN WILLAMS		SW 7029 AGREEABLE GRAY		
	P3	PAINT	SHERWIN WILLAIMS		CUSTOM COLOR RED		SEE NOTE 2
	P4	PAINT	SHERWIN WILLIAMS		SW 6258 TRICORN BLACK		
	P5	SEE CEILING MATERIALS					
	W1	WALLCOATING	SHERWIN WILLIAMS		SW 7029 AGREEABLE GRAY		
					_		
	WC1	WALL COVERING	MOMENTUM	ON STAGE	DUSK DUET AZ53584 SG		
	WC2	WALL COVERING	MOMENTUM				PRICE AS WC1
	WT1		AMERICAN OLEAN		STABLE 0055	3" X 6"	
	WT2	CERAMIC WALL TILE	AMERICAN OLEAN	COLOR STORY WALL COLOR STORY WALL	STABLE 0055 STORY GREY 0040	3" X 6"	
	WTZ WT3	CERAMIC WALL TILE	AMERICAN OLEAN	COLOR STORY WALL	PASSION 0019	2" X 8"	
	W15	CERAMIC WALL HEL	AMERICAN OLLAN	COLOR STORT WALL			
	AR-AWP1	ACOUSTICAL PANEL		IECIUM	CUSTOM COLOR RED		SEE NOTE 2
	AR-AWP2	ACOUSTICAL PANEL		TECTUM	SW 6258 TRICORN BLACK		
	AR-AWP3	ACOUSTICAL PANEL		TECTUM	SW 7504 KEYSTONE GRAY		
CASEWORK AND I	MILLWORK						
	PL1	PLASTIC LAMINATE	WILSONART	MATTE 60	TUNGSTEN EV 4814		
	PL2	PLASTIC LAMINATE	WILSONART	MATTE 60	BURNISSHED CHESTNUT 4796		
	PL3	PLASTIC LAMINATE	NEVAMAR	TEXTURED	WHITE ESSENSE ES7001		
	PL4	PLASTIC LAMINATE	WILSONART	FINE VELVET TEXTURE 38	RIVER CHERRY 7937		
	PL5	PLASTIC LAMINATE	WILSONART	FINE VELVET TEXTURE 38	OILED SOAPSTONE 4882		
	SS1	SOLID SURFACE	CORIAN		NEUTRAL AGGREGATE		
	<del>.</del>						
MISCELLANEOUS			1	1			I
	RS1	NOT USED WINDOW ROLLER SHADE					
	RS2	CORNER GUARD	МЕСНО	BLACKOUT			
	CG TRIM1	METAL TRIM	SCHLUTER	 RONDEC	SATIN ANODIZED ALUMINUM		
L		WOOD DOOR STAIN	JUILUTER	RONDEC RED OAK CLEAR STAIN	SATIN ANODIZED ALUMINUM		
	B	BLEACHERS	HUSSEY SEATING		TITANIUM 7540C		
			LIGGGEI GLAHNO				1
	TP			ORANGE PFFI TFXTURF	SANDSTONF		
	TP	TOILET PARTITIONS	HINY HIDERS	ORANGE PEEL TEXTURE	SANDSTONE		

ETR = EXISTING TO REMAIN

NOTE 1: CUSTOM COLOR TO MATCH EXISTING NOTE 2: CUSTOM COLOR TO MATCH EXISTING RED



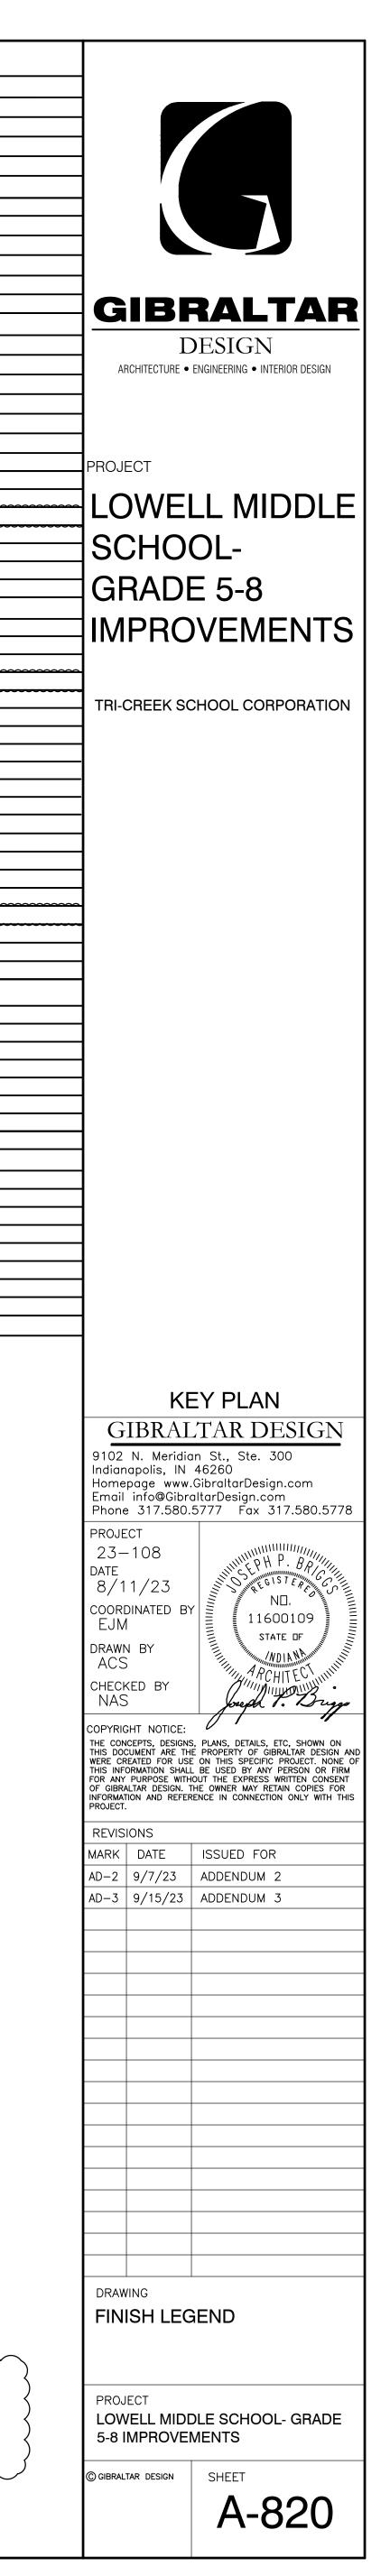

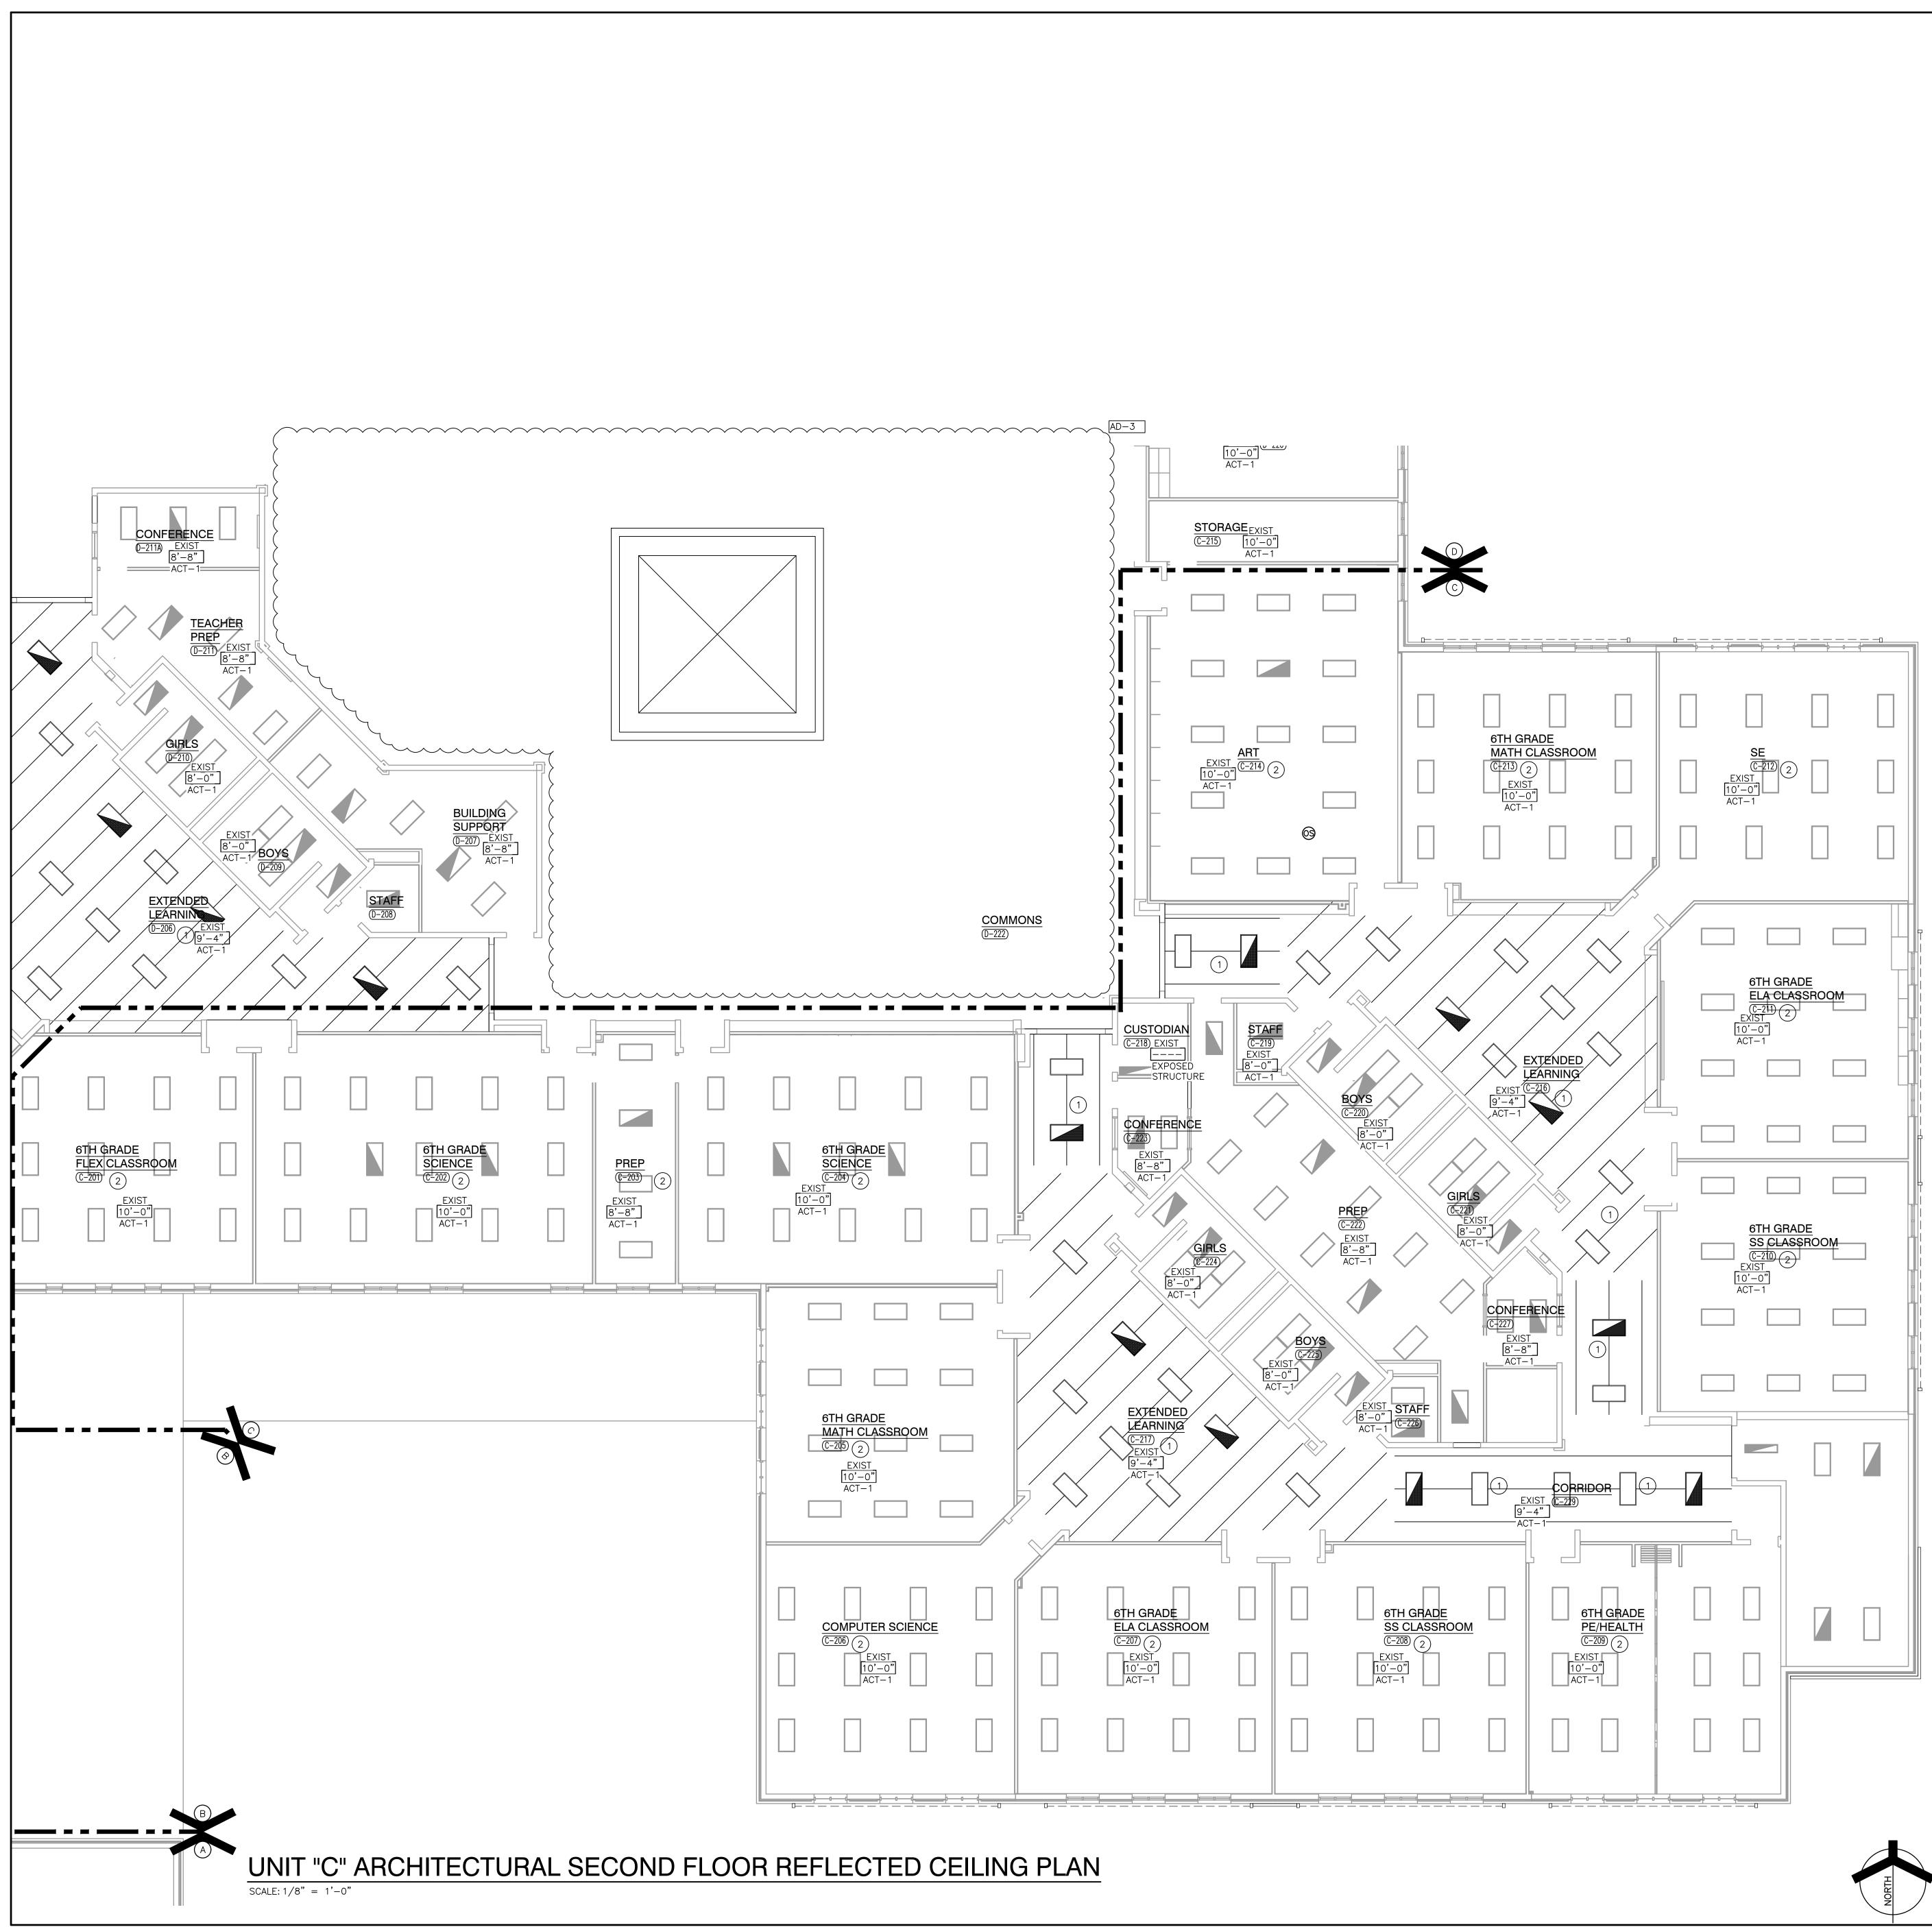

# GENERAL REFLECTED CEILING PLAN NOTES:

- A. FOR GENERAL PROJECT NOTES, MATERIAL INDICATIONS LEGEND, SYMBOL LEGEND, ABBREVIATIONS, ETC., REFER TO GI SERIES SHEETS.
- B. THE ARCHITECTURAL REFLECTED CEILING PLAN GOVERN THE LAYOUT OF ALL CEILING ELEMENTS AND PENETRATIONS.
- C. BULKHEAD FRAMING SHALL BE ATTACHED TO STRUCTURAL SUPPORTS AND
- NOT THE ROOF DECK.
- D. REFER TO FLOOR PLANS FOR WALL TYPES
- E. REFER TO ELECTRICAL DRAWINGS FOR ADDITIONAL CEILING MOUNTED ELECTRICAL ITEMS.
- F. REFER TO TECHNOLOGY DRAWINGS FOR ADDITIONAL CEILING MOUNTED TECHNOLOGY ITEMS.
- G. REFER TO MECHANICAL DRAWINGS FOR LOCATION OF CEILING DIFFUSERS, RETURN AIR GRILLS, AND CEILING CABINET HEATERS.

# REFLECTED CEILING PLAN LEGEND:

	GYPSUM BOARD BULKHEAD/CEILING	0 ⊗i	LED LIGHT EXIT LIGHT 1×4 LIGHT FIXTURE
+ + - + + +	EIFS SOFFIT		2×4 LIGHT FIXTURE PENDANT LIGHT FIXTURE
	ACT 1 2'-0" x 2'-0" ACST. BD. CEILING NOTE INSTALL AT 8'-8" A UNLESS NOTED OTHERWISE ACT 1 2'-0" x 4'-0" ACST. BD. CEILING SEE ROOM FINISH SCHEDULE	• FF -0	PENDANT LIGHT FIXTURE LINEAR LIGHT FIXTURE WALL SCONCE LIGHT FIX SUPPLY AIR DIFFUSER LINEAR SUPPLY AIR DIFF
	ACT 2 2'-0" X 4'-0" VINYL FACED ACST. BD. CEILING SEE ROOM FINISH SCHEDULE	⊞ ⊙S	RETURN, EXHAUST, AND TRANSFER AIR GRILLE CEILING SPEAKER OCCUPANCY SENSOR


### **REFLECTED CEILING PLAN NOTES:** (ALL PLAN NOTES MAY NOT BE INDICATED ON THIS SHEET.)


- 1 ALTERNATE ADD NEW 24" GRID AS REQUIRED TO CONVERT TO EXISTING 2x4 GRID TO A 2x2 GRID. ADD NEW CEILING PADS AND DEVICES. REFER TO MEP SHEETS.
- (2) ALTERNATE REFER TO ELECTRICAL SHEETS FOR NEW DEVICES.


(3) GYPSUM BOARD BULKHEAD. REFER TO ------

- (4) OPEN TO STRUCTURE ABOVE NO CEILING REQUIRED.
- (5) GYM EQUIPMENT (TYPICAL). REFER TO EQUIPMENT DRAWINGS.
- $\bigcirc$  3" WIDE LINEAR SOFFIT VENT. LENGTH AS INDICATED.
- (7) EIFS 'V' GROOVE REVEAL/JOINT.
- 8 CMU LINTEL AT 8'-8" AFF
- 9 WALL-MOUNTED SCOREBOARD. REFER TO 700 SERIES SHEETS AND ELECTRICAL DRAWINGS.
- (10) REWORK CEILING GRID FOR NEW EXHAUST HOOD.
- (11) 6" ALUMINUM EXPANSION JOINT COVER
- 12 ADD NEW 24" GRID AS REQUIRED TO CONVERT TO EXISTING 2x4 GRID TO A 2x2 GRID. ADD NEW CEILING PADS AND DEVICES. REFER TO MEP SHEETS.
- (13) PAINT EXPOSED STRUCTURE AND ROOF DECK.
- ((14) APPROXIMATE LOCATION OF SUPPLY AIR DUCT COORDINATE WITH Ś STRUCTURAL AND REFER TO MECHANICAL.

_____

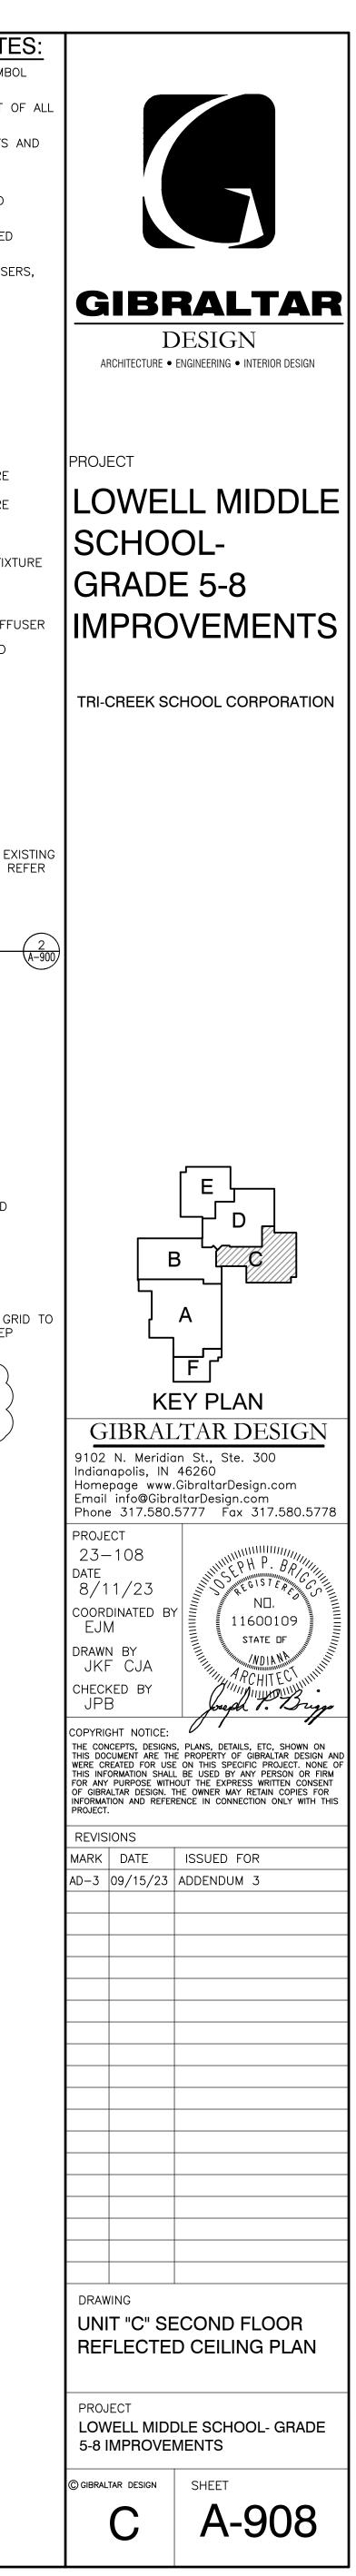

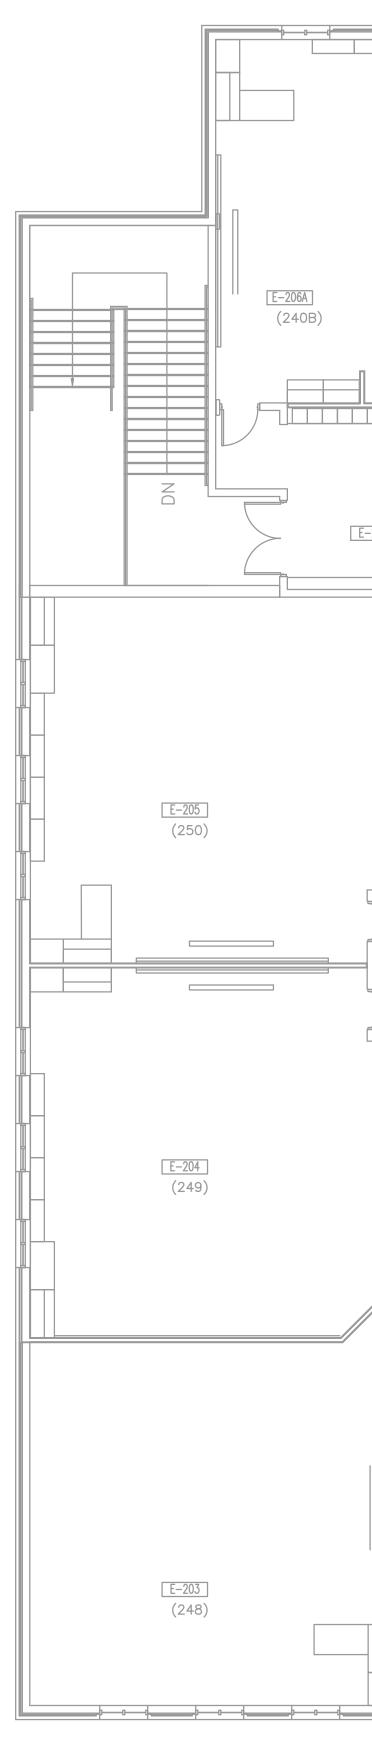


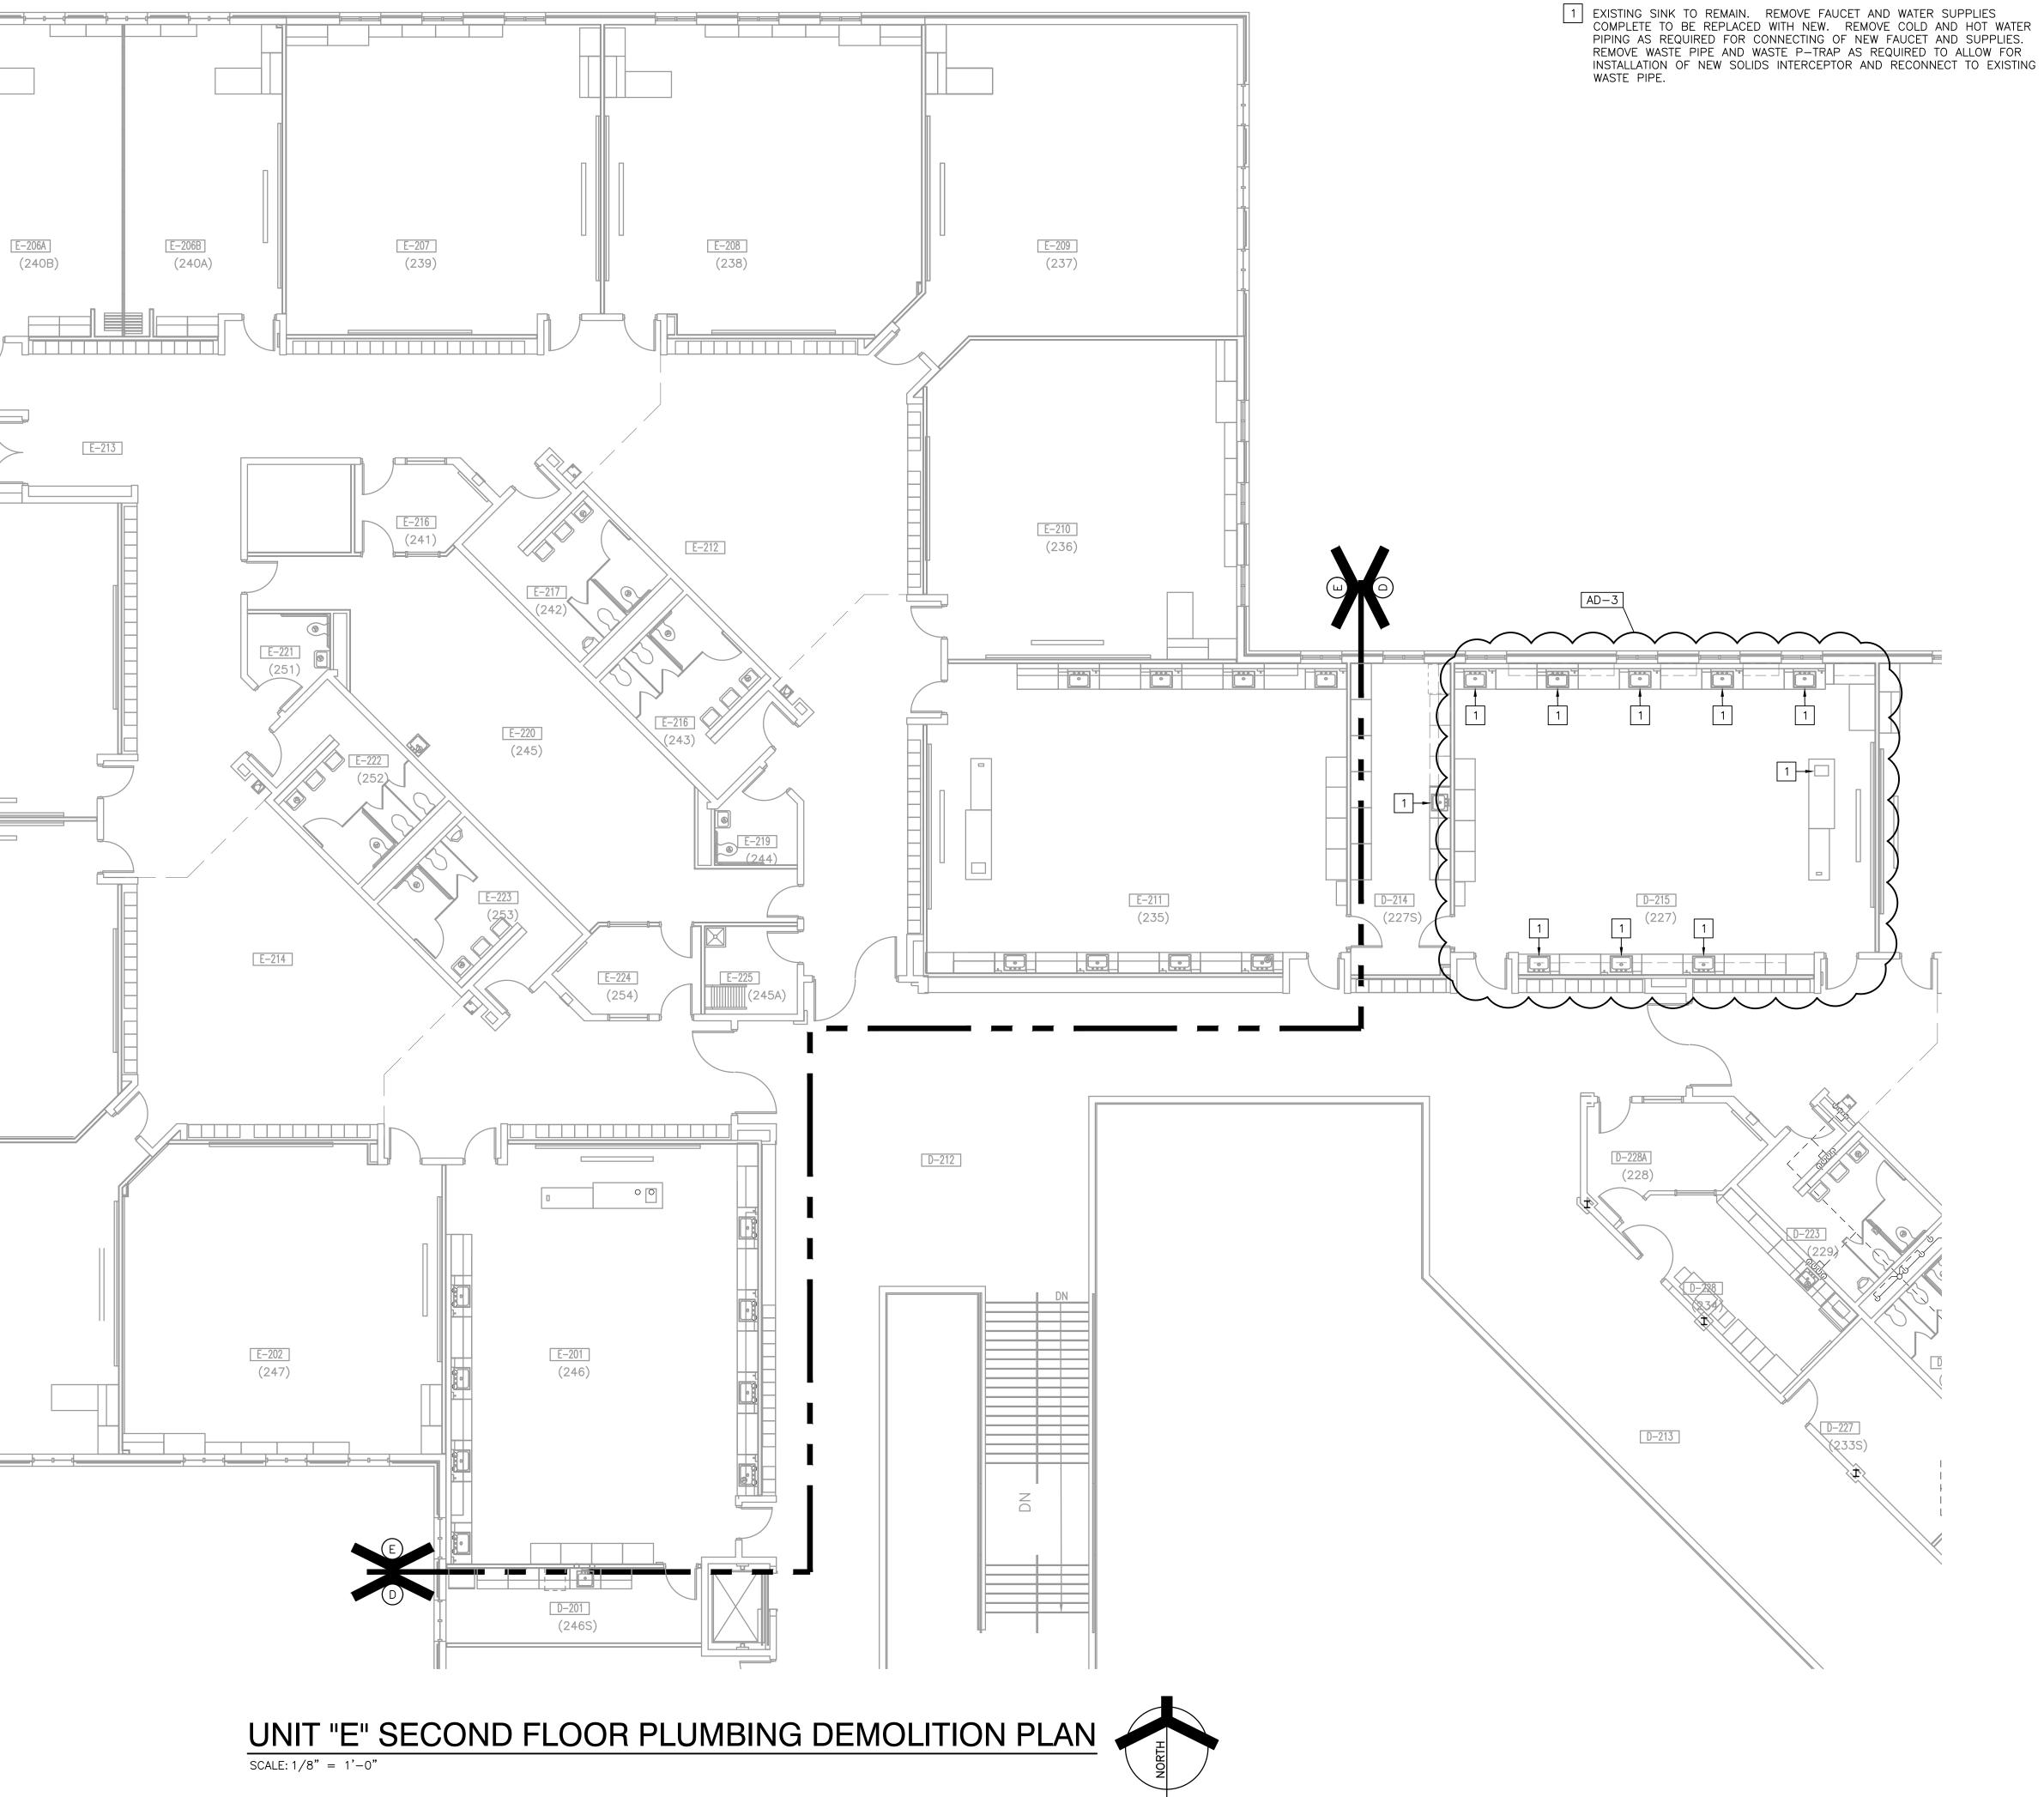



# **DEMOLITION GENERAL NOTES:**

- SEE SHEET P-001 FOR ADDITIONAL GENERAL PLUMBING NOTES, LEGEND AND SCHEDULES.
- 2. SEE SHEET P-501 FOR PLUMBING DETAILS.
- 3. ALL EQUIPMENT NOTED TO BE REMOVED SHALL BE DEFINED AS COMPLETE REMOVAL OF PIPE CONNECTIONS, TEMPERATURE CONTROLS, ELECTRICAL CONNECTIONS, DUCTWORK CONNECTIONS, EQUIPMENT CONCRETE PADS, ETC. UNLESS NOTED OTHERWISE.
- 4. PIPING INDICATED TO BE REMOVED SHALL INCLUDE ALL INSULATION, HANGERS, RODS, AND BOLTS ASSOCIATED WITH THE REMOVED PIPING.
- 5. REMOVE ALL DEBRIS FROM DEMOLITION WORK AREAS ON A DAILY BASIS.
- 6. PATCH ALL WALLS AND ROOF OPENINGS CREATED BY DEMOLITION OF PIPING, FIXTURES AND EQUIPMENT UNLESS NOTED OTHERWISE ON ARCHITECTURAL SHEETS.
- 7. COORDINATE ANY SALVAGE ITEMS THE OWNER WISHES TO RETAIN. TURN OVER ITEMS TO OWNERS STOCK AS DIRECTED.
- 8. CONTRACTOR SHALL DISPOSE OF ANY REMOVED MATERIALS, PIPING AND EQUIPMENT IN A SAFE AND LEGAL MANNER.
- 9. LOCATE ALL SHUT-OFF VALVES ON WATER PIPING SYSTEMS AND ENSURE VALVES WILL HOLD WITHOUT LEAKAGE PRIOR TO DEMOLITION OF EQUIPMENT OR PIPING. REPLACE DEFECTIVE SHUT-OFF VALVES WITH NEW SAME SIZE VALVES..

# **DEMOLITION PLAN NOTES:**

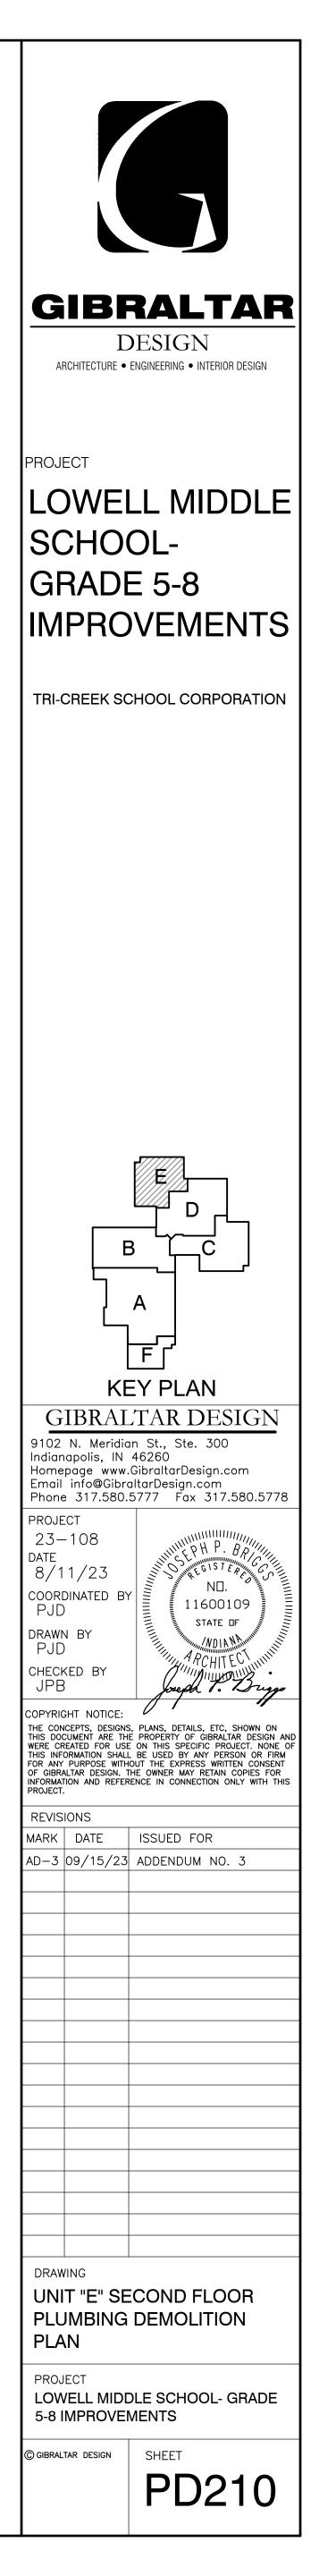

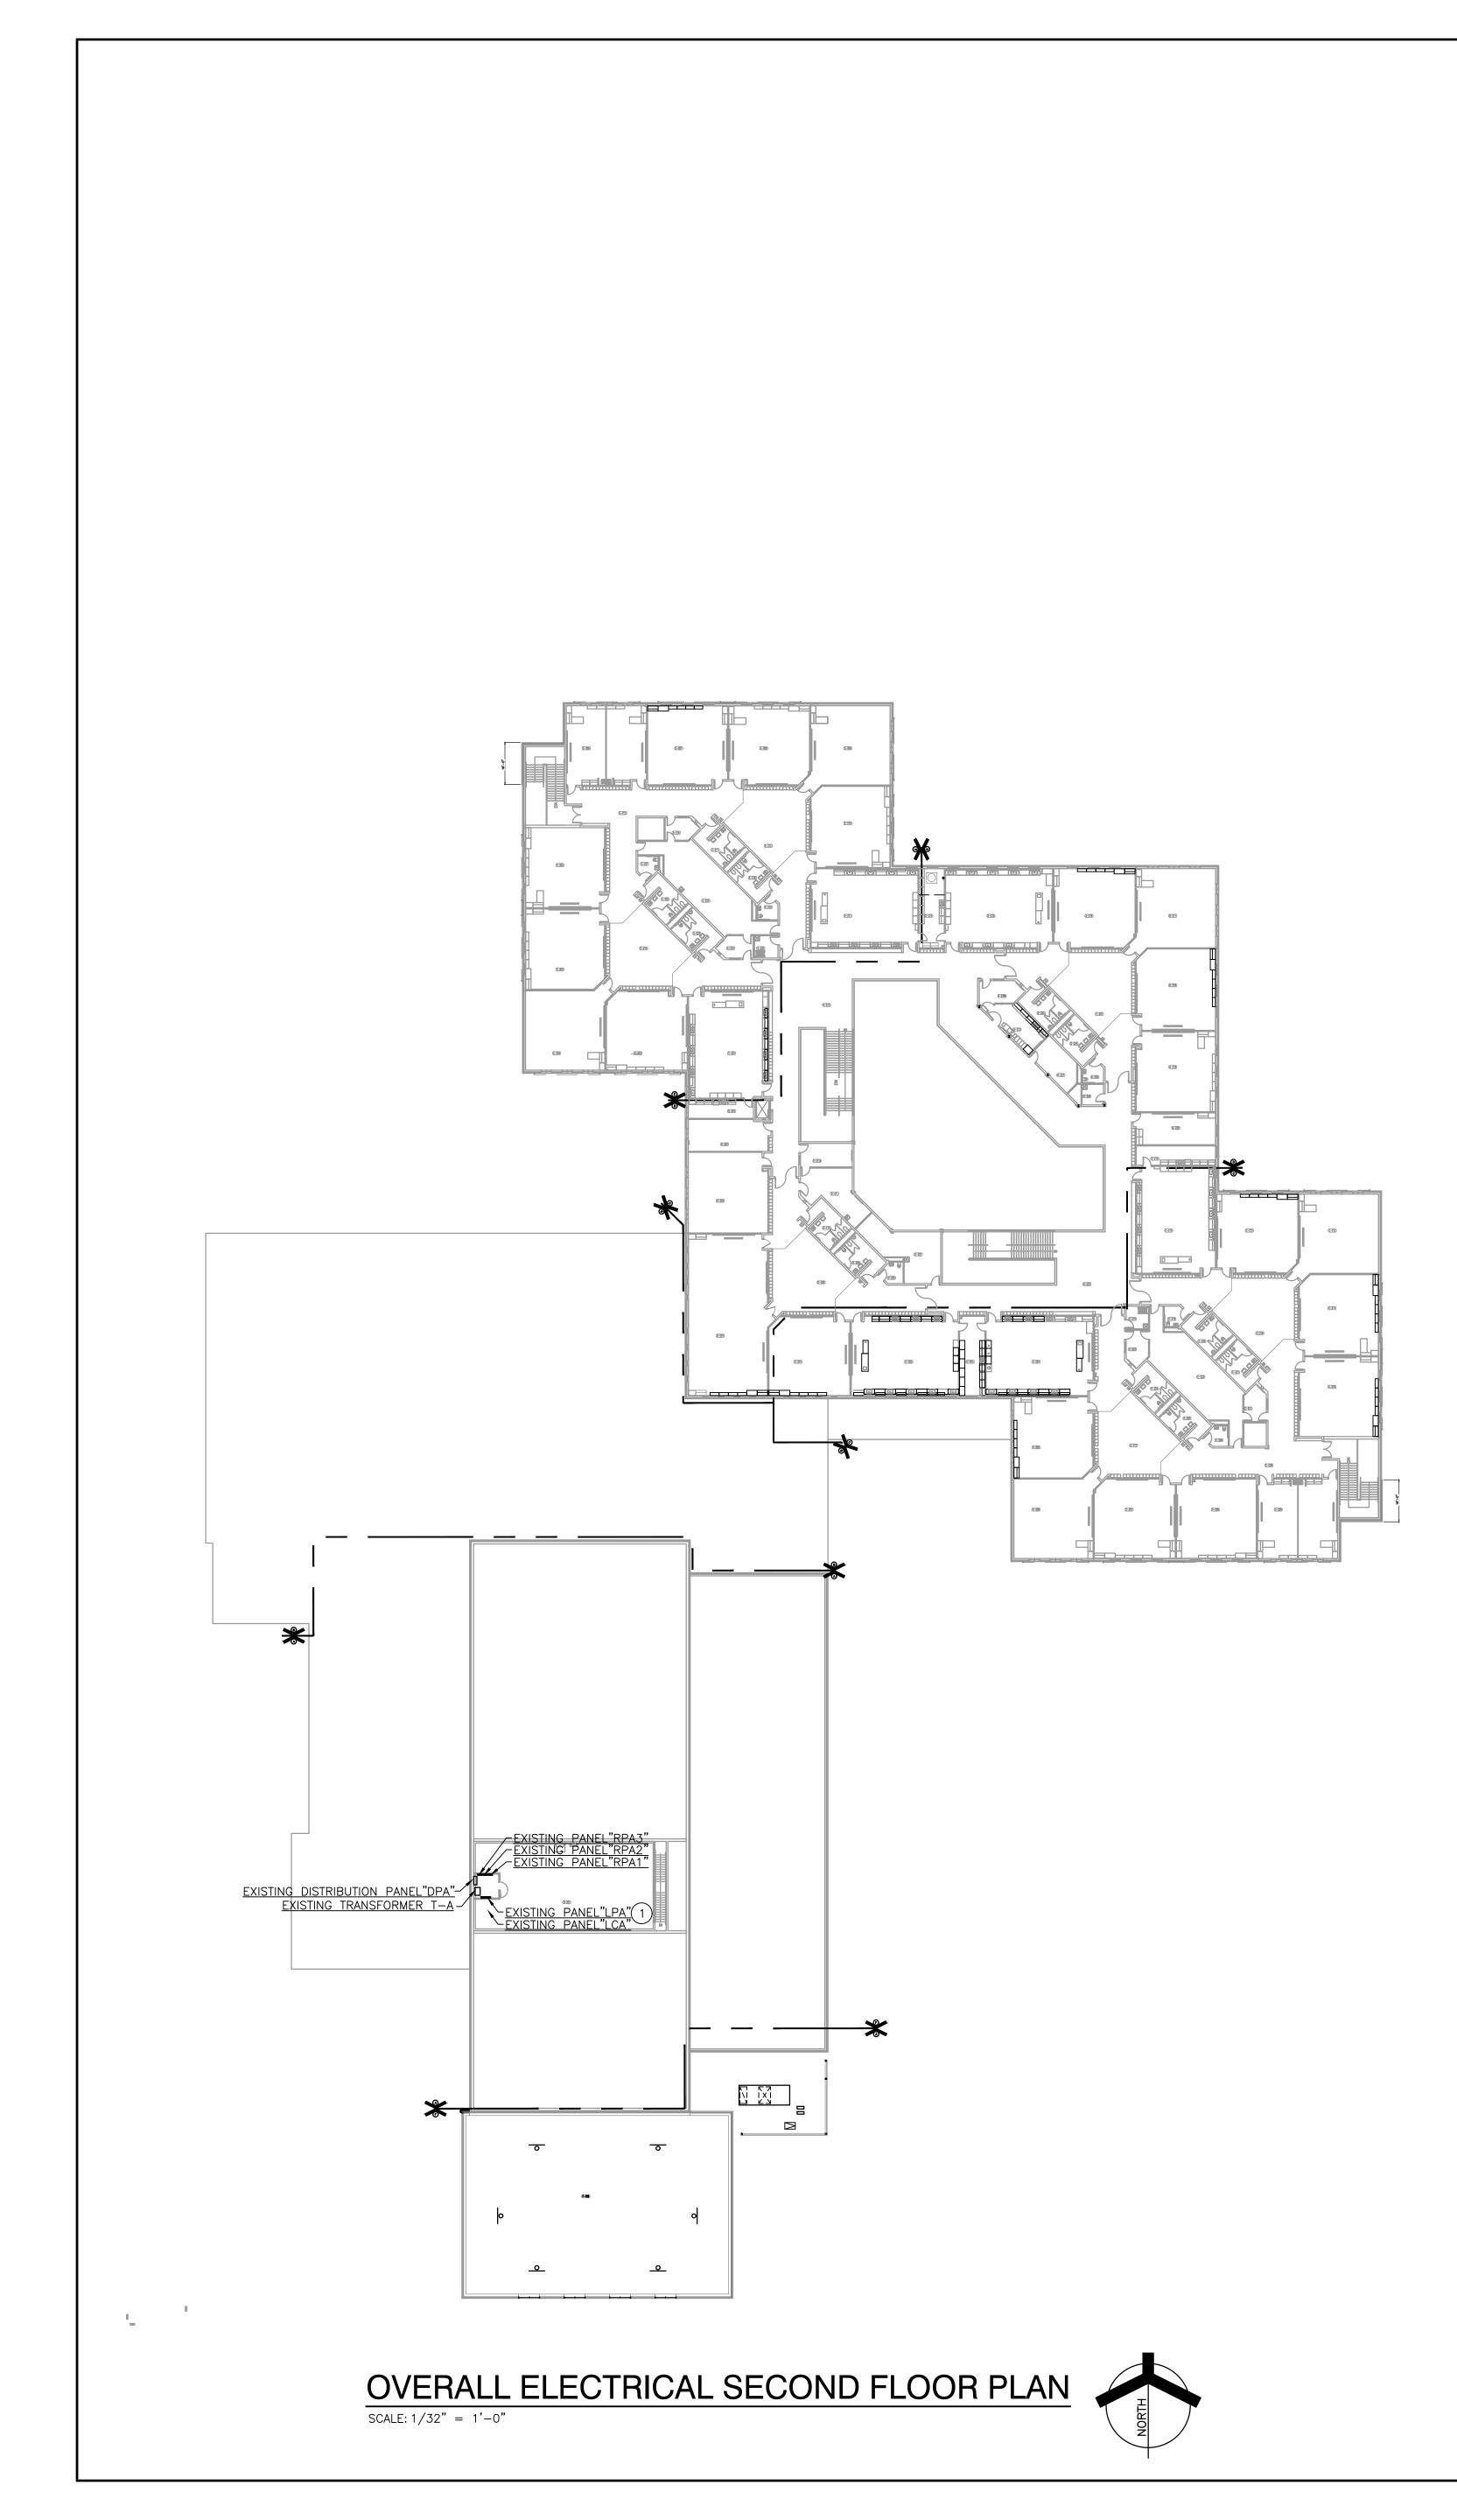

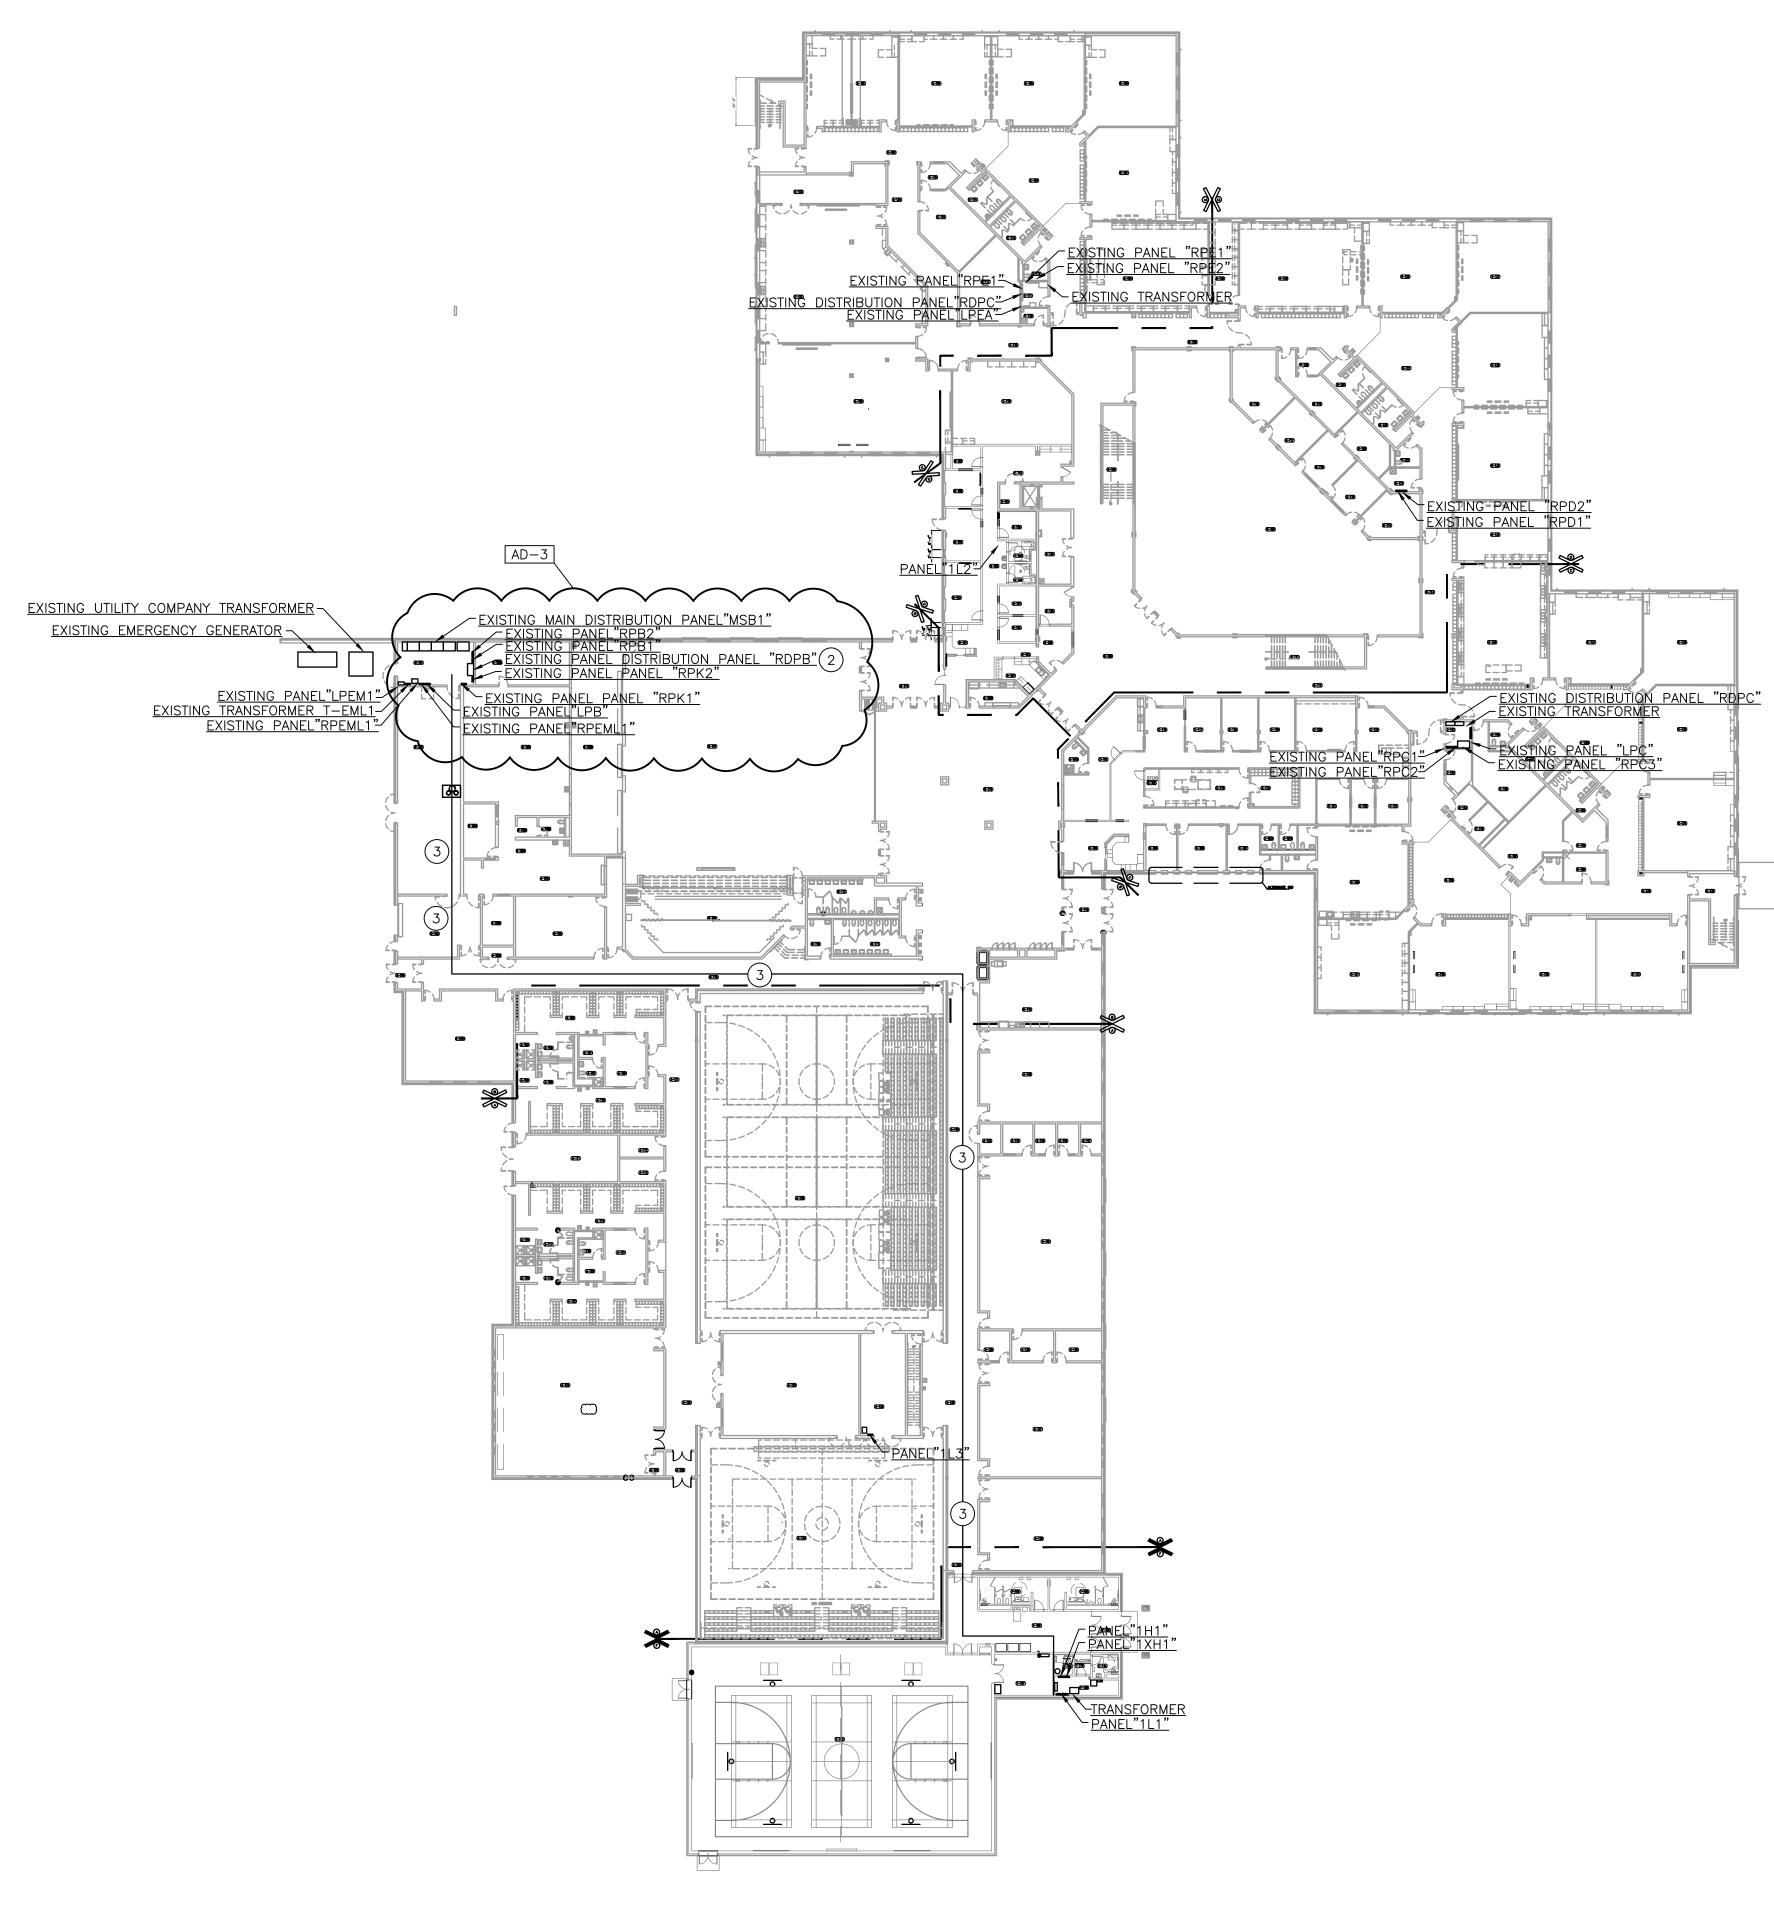

 FOR ADDITIONAL GENERAL ELECTRICAL NOTES, SEE GENERAL ELECTRICAL PROJECT NOTES ON SHEET E-001.

- 2. SEE E-600 SHEETS FOR ELECTRICAL DETAILS AND SCHEDULES.
- 3. SEE E-700 SHEETS FOR ELECTRICAL DISTRIBUTION DIAGRAMS.

# ELECTRICAL PLAN NOTES:

 (THESE NOTES APPLY TO THIS SHEET ONLY)

 1
 MODIFY EXISTING PANEL "LPCA" AS SHOWN ON THE PANEL SCHEDULE ON E-600 SERIES SHEETS.


 AD-3
 2


 MODIFY EXISTING PANEL "RDPB" AS SHOWN ON THE POWER DISTRIBUTION DIAGRAMS.


 3
 REMOVE AND REINSTALL EXISTING CEILINGS AS NECESSARY TO COMPLETE THE ELECTRICAL WORK. ALTERNATE BID.


OVERALL ELECTRICAL FIRST FLOOR PLAN

SCALE: 1/32" = 1'-0"

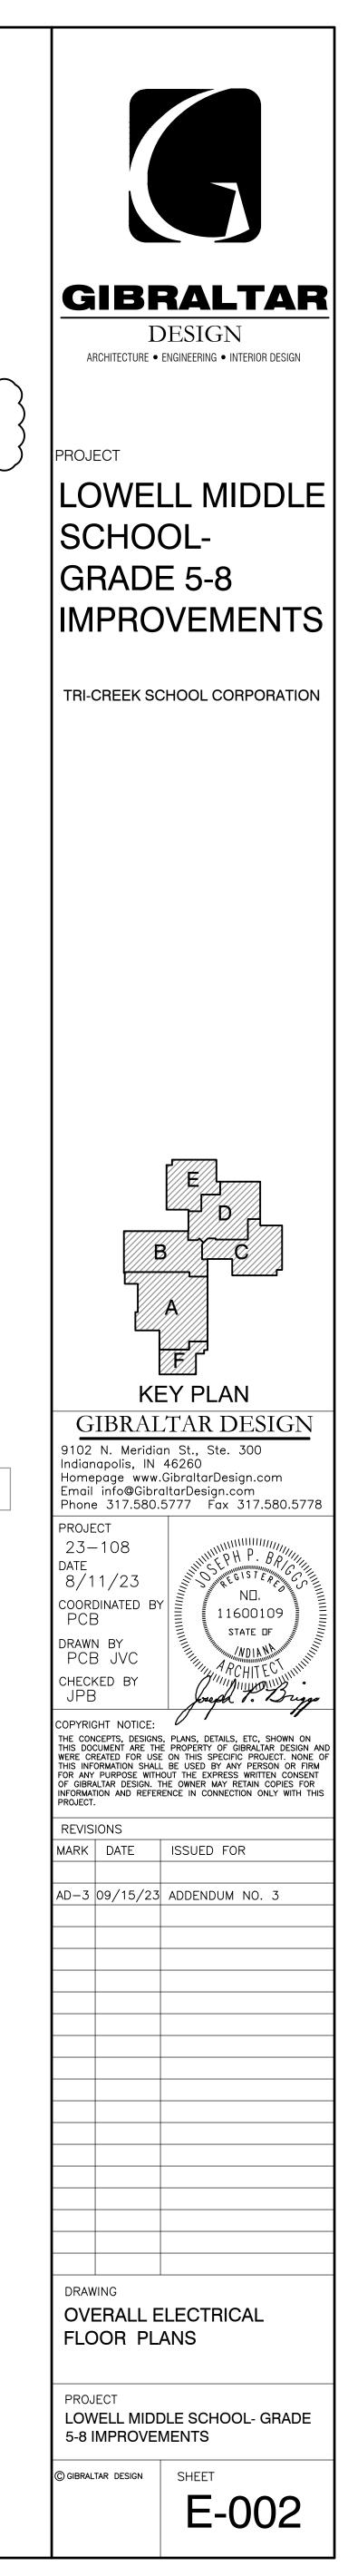

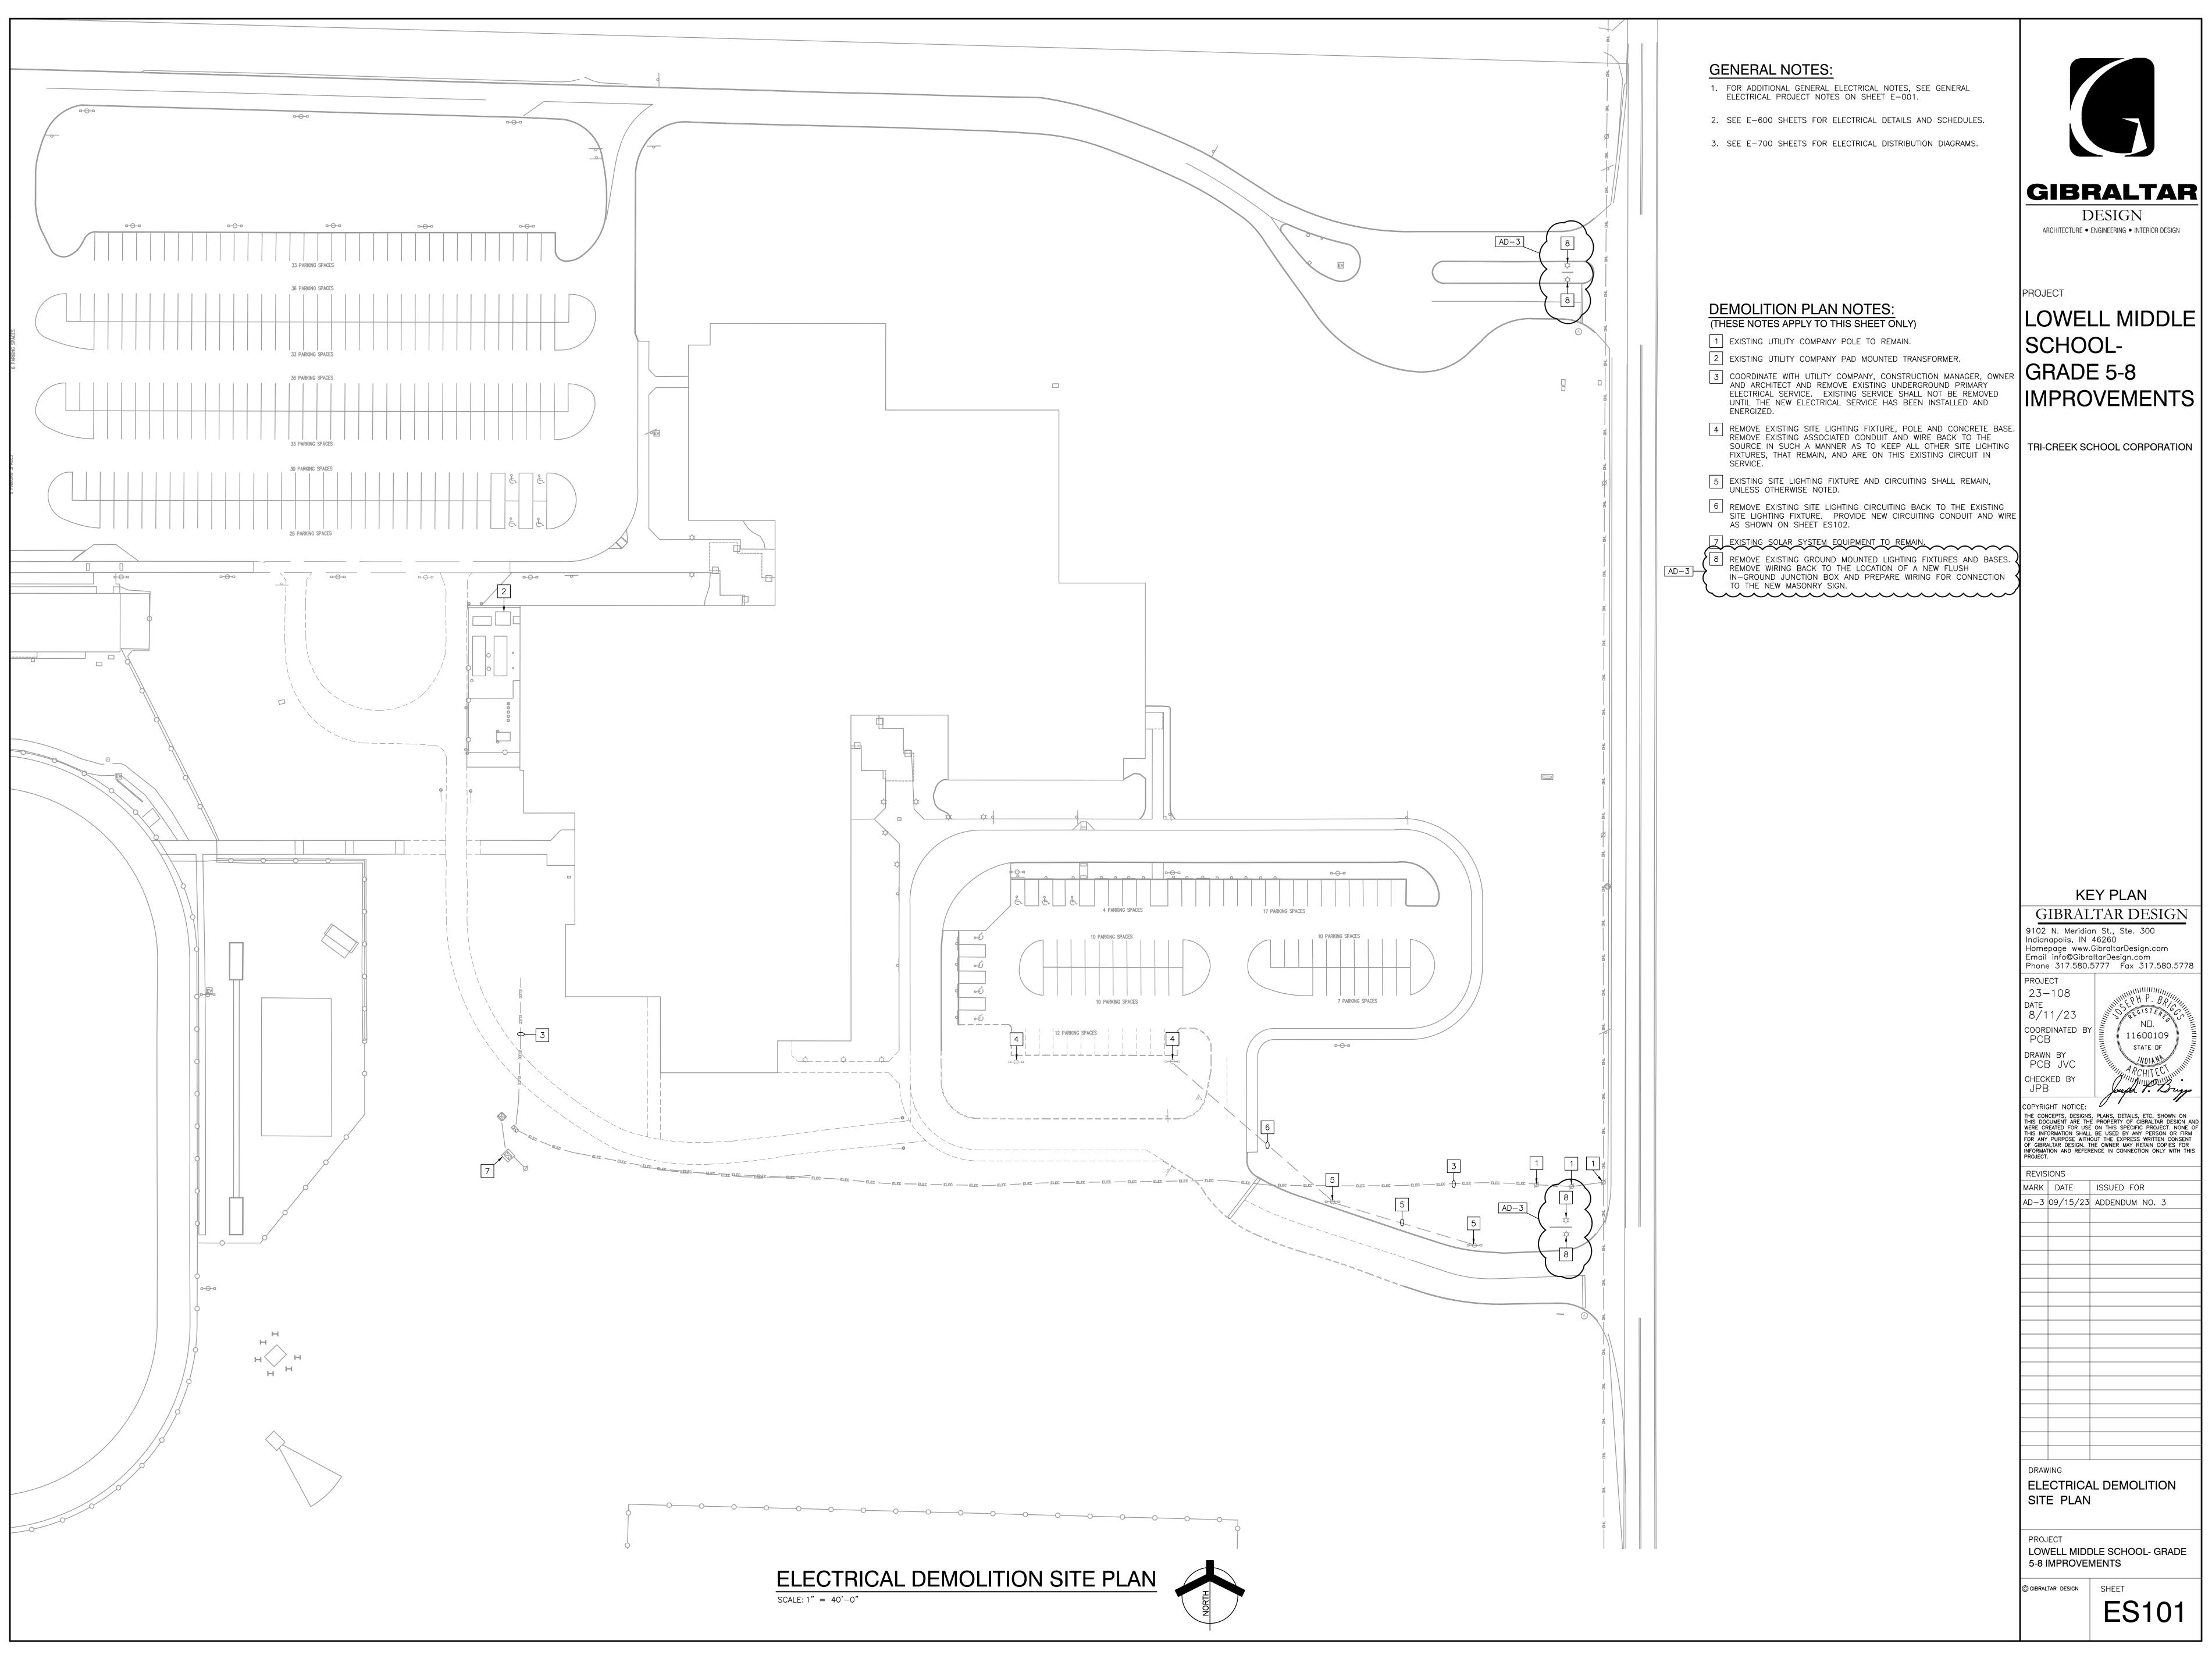

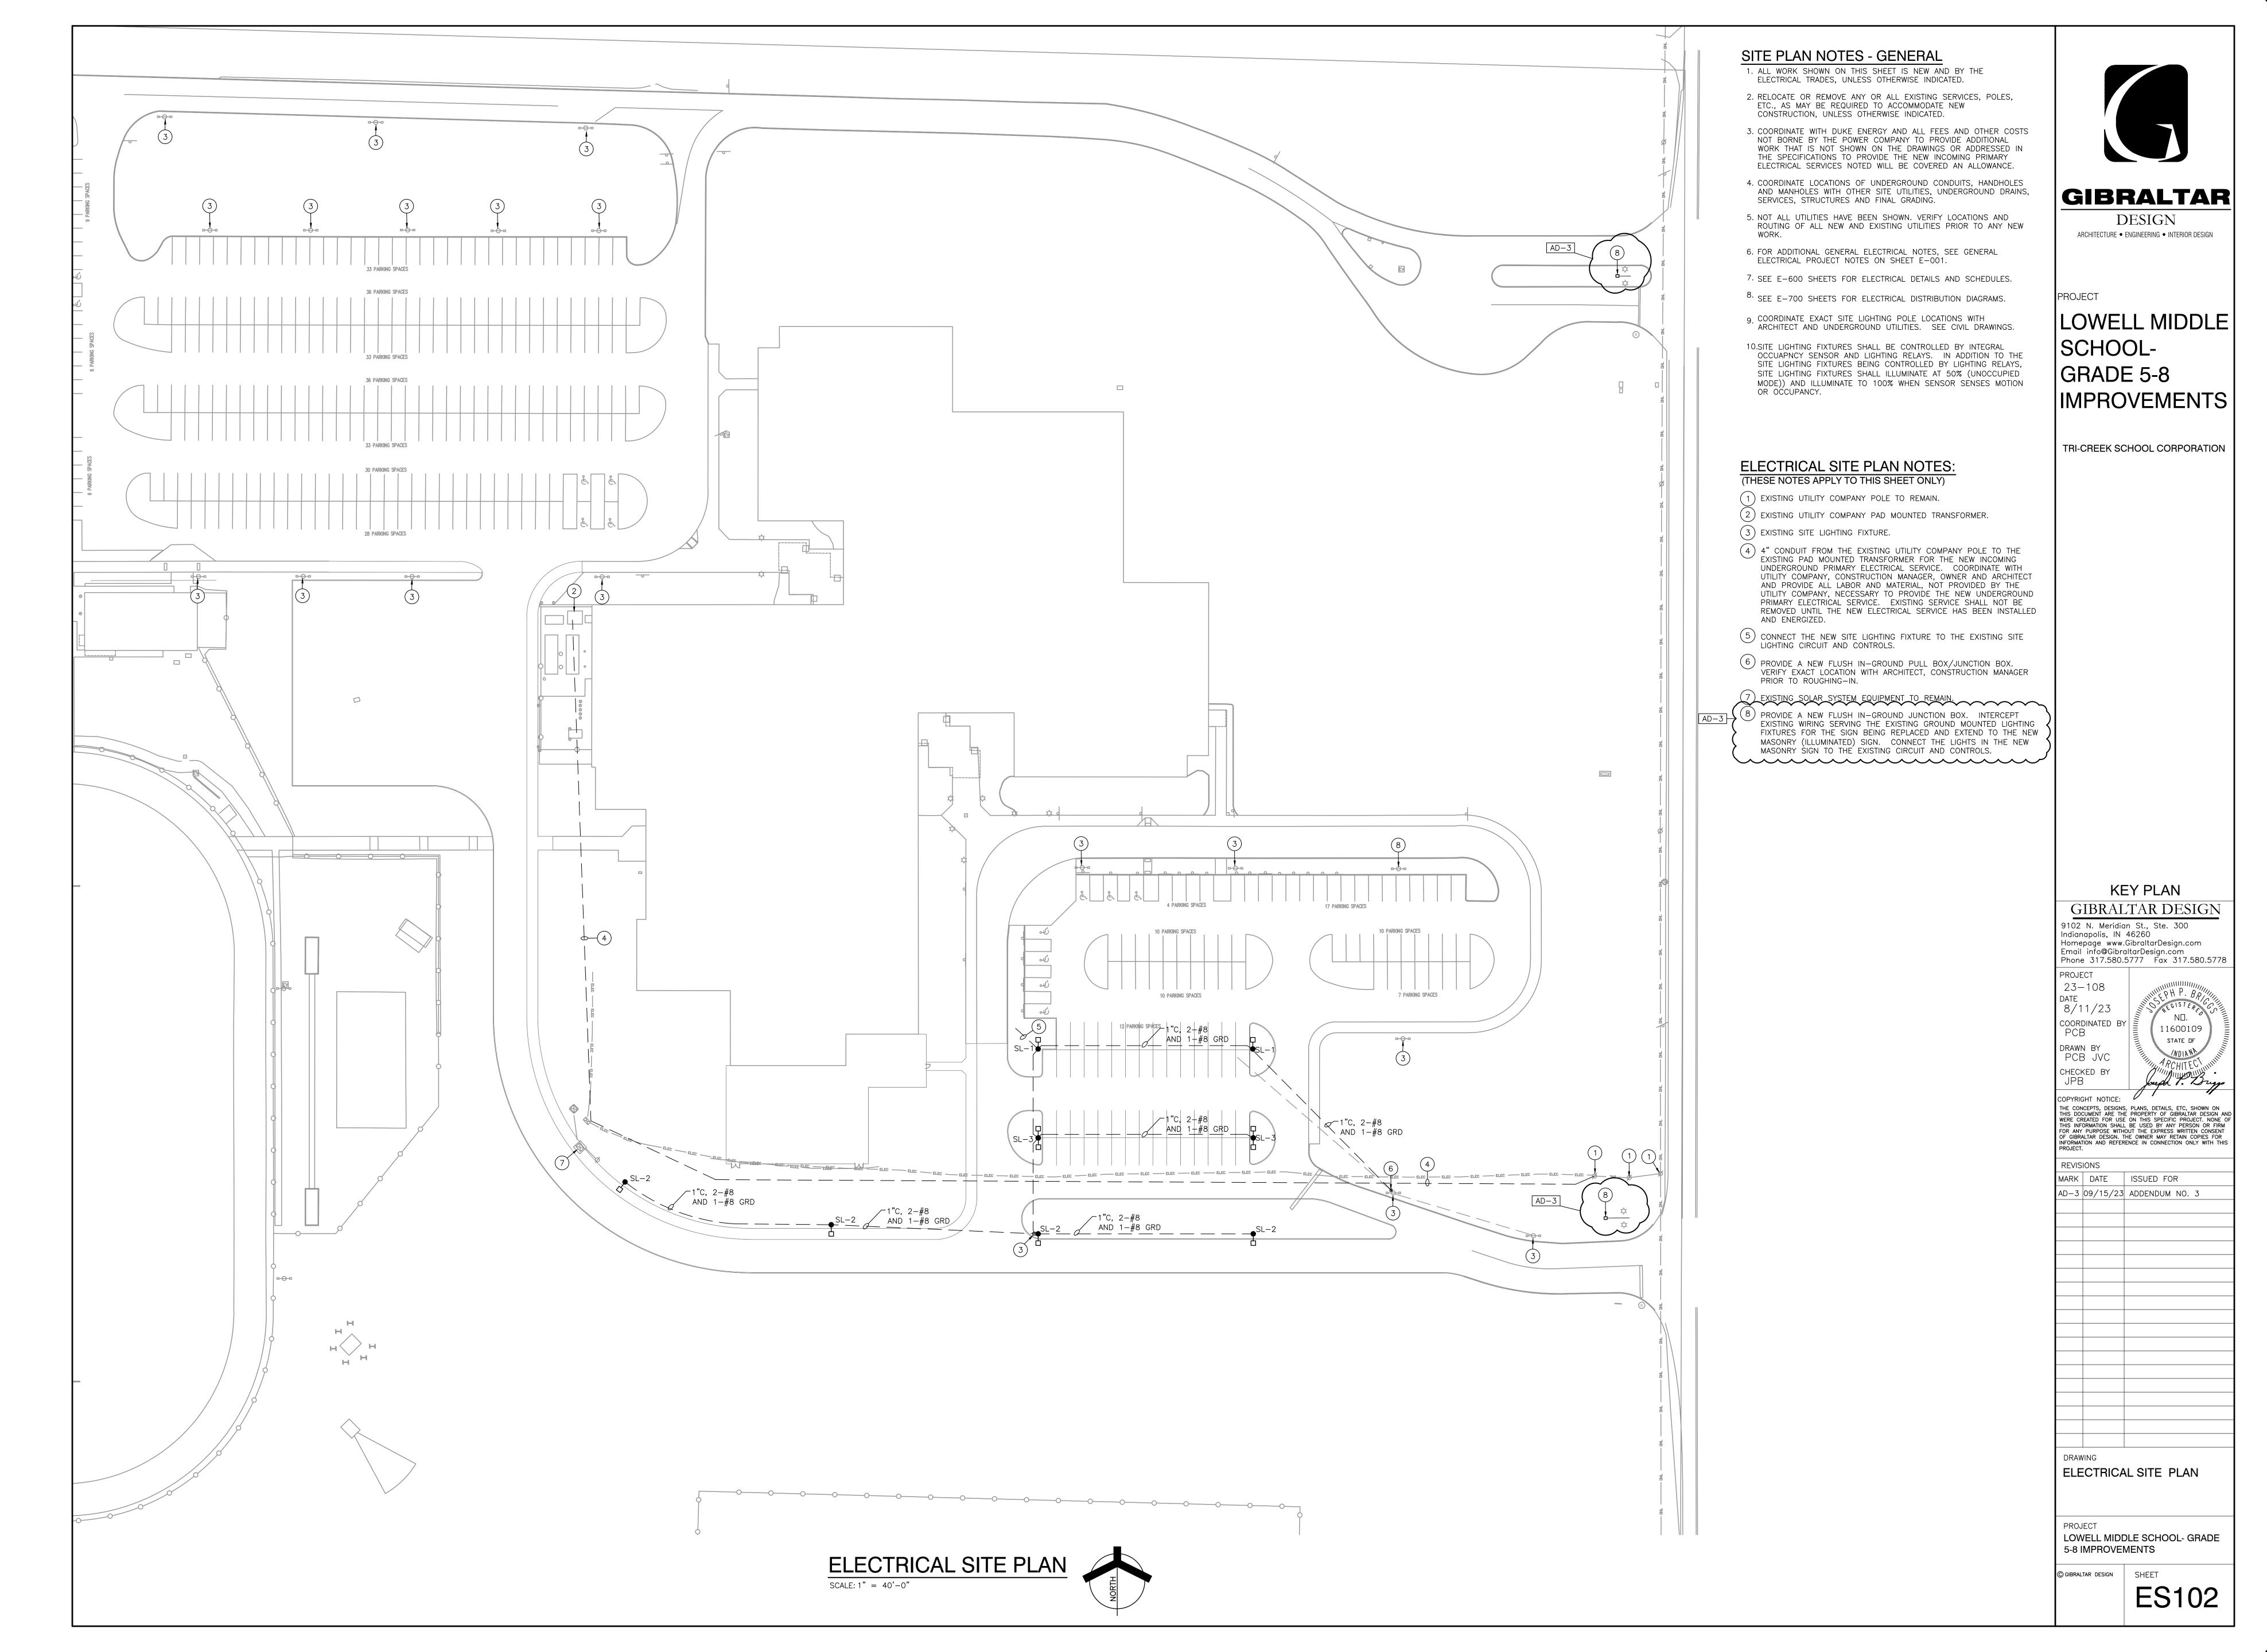

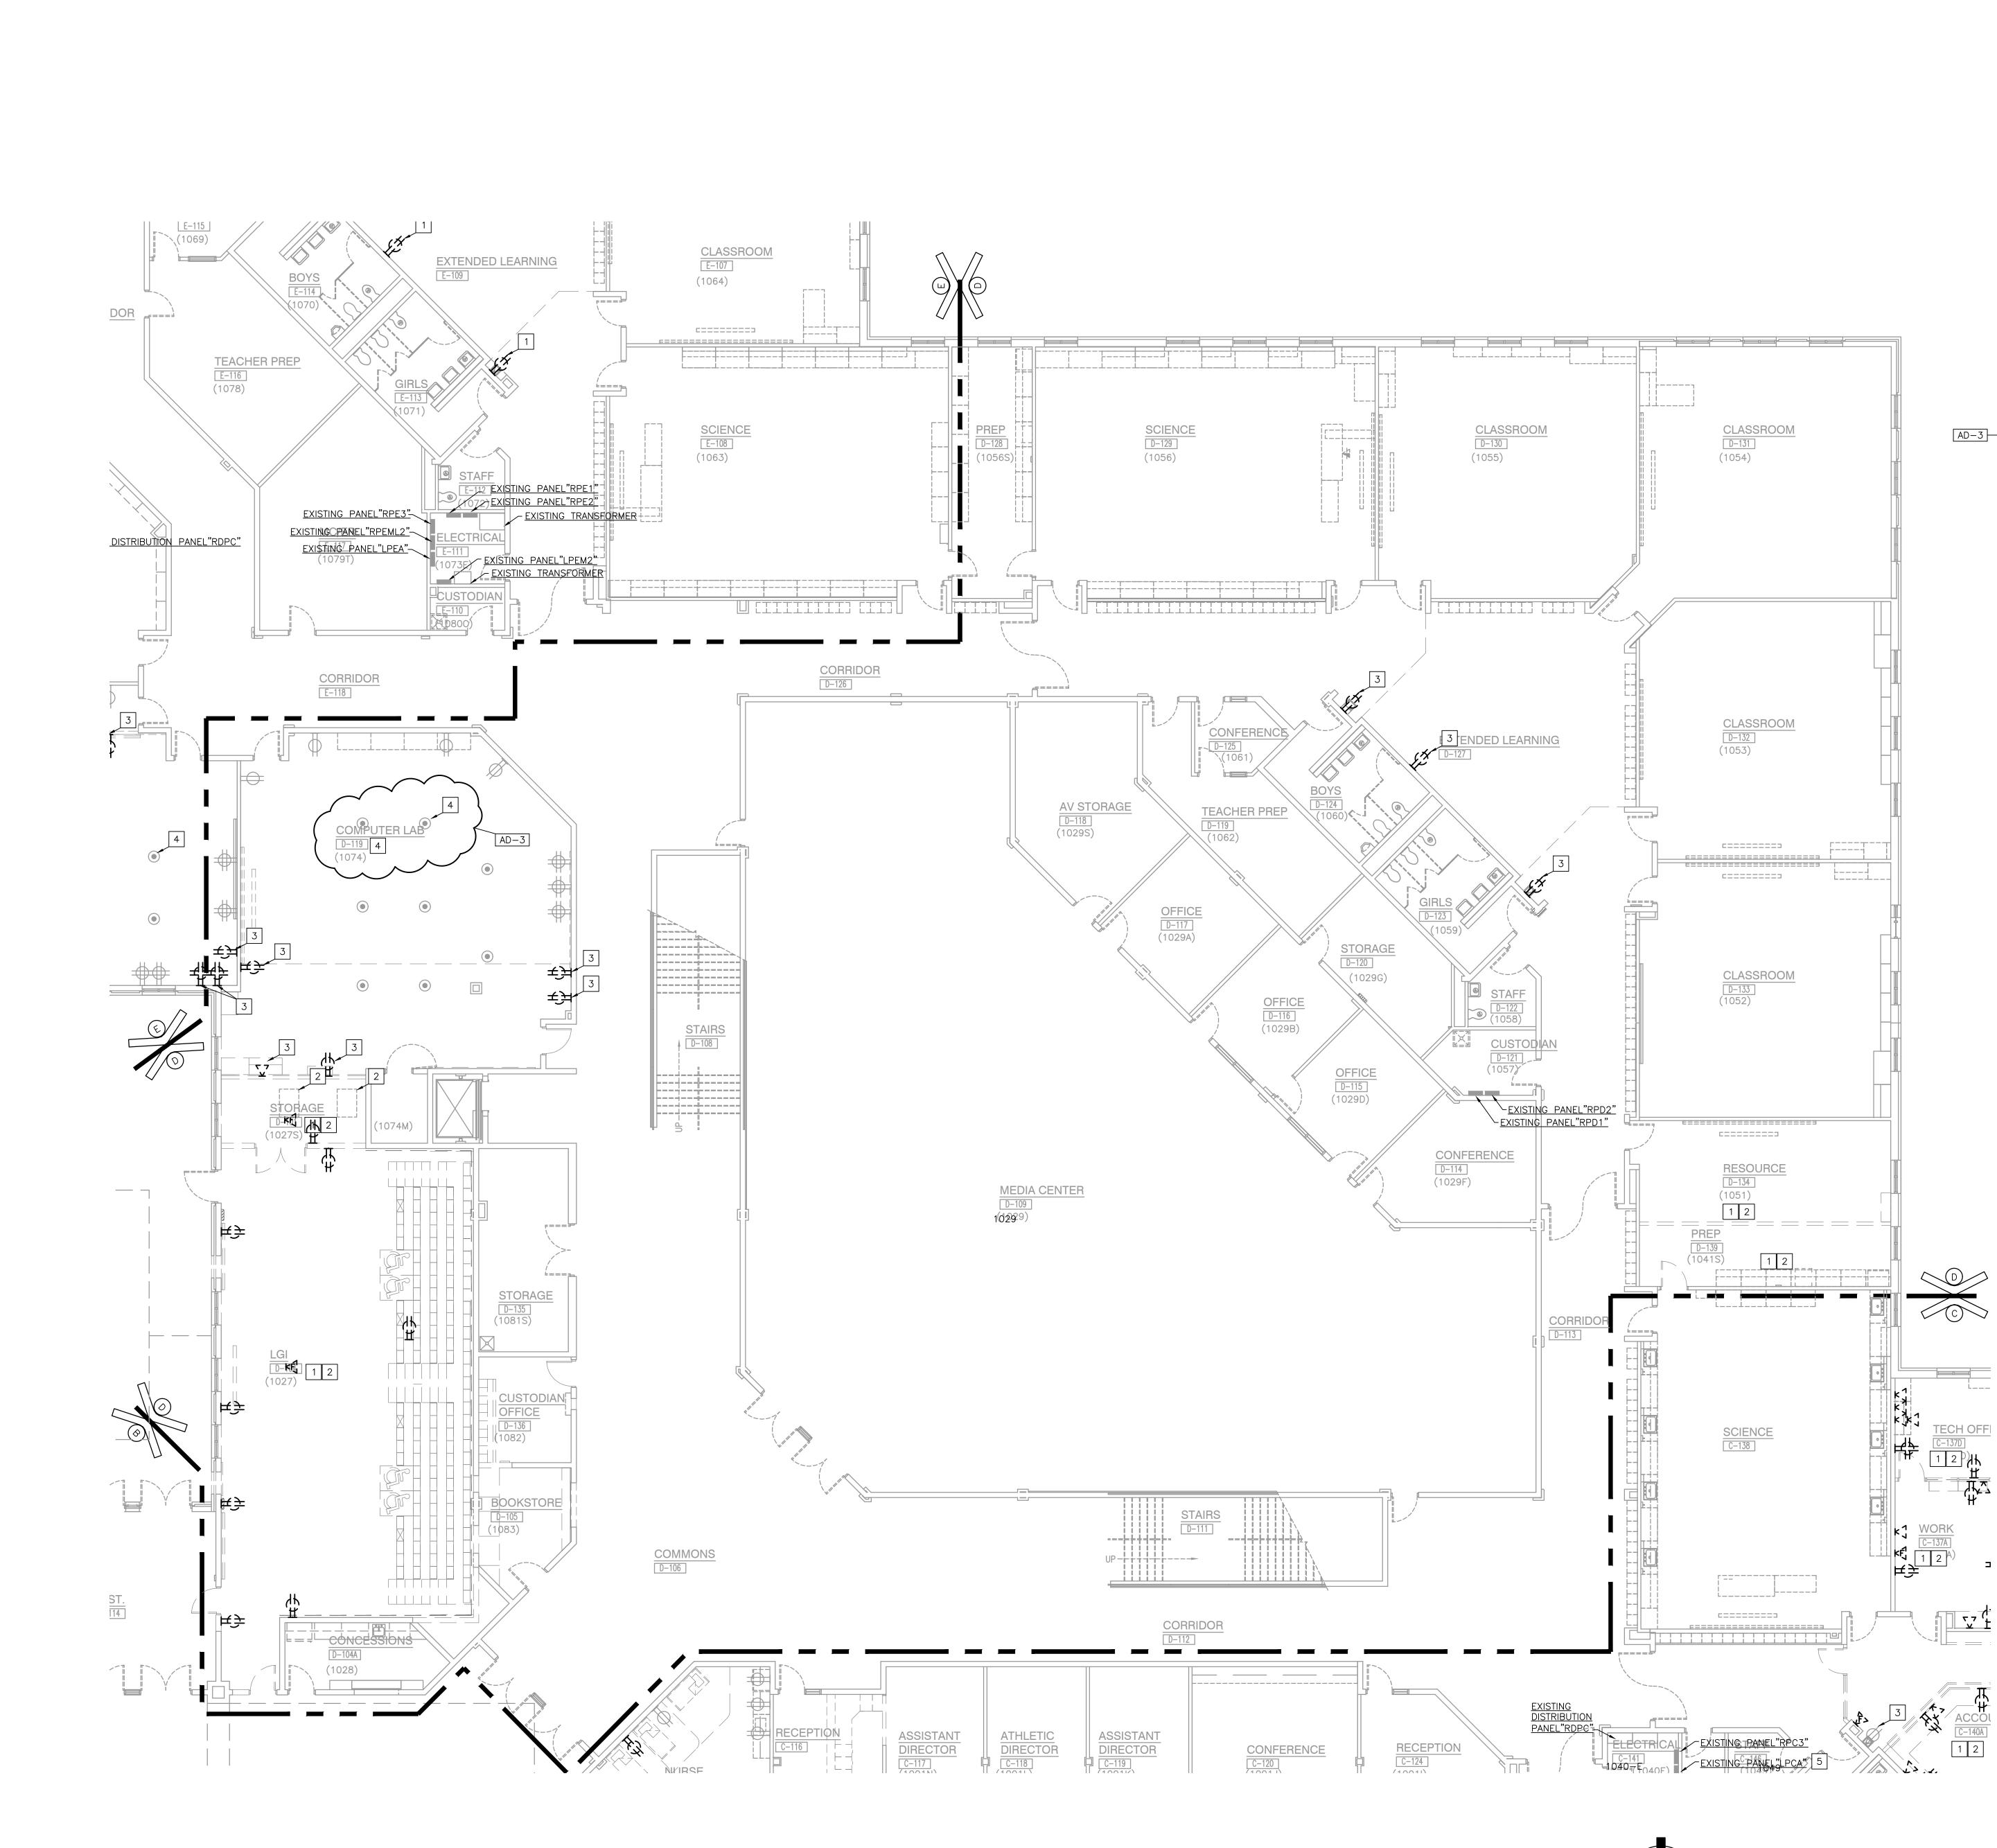

# UNIT "D" ELECTRICAL FIRST FLOOR DEMOLITION POWER PLAN

SCALE: 1/8" = 1'-0"




1. FOR ADDITIONAL GENERAL ELECTRICAL DEMOLITION NOTES SEE GENERAL ELECTRICAL PROJECT NOTES ON SHEET E-001.


2. DISCONNECT EXISTING EQUIPMENT WITH ELECTRICAL CONNECTIONS BEING DEMOLISHED AS SHOWN ON THE ARCHITECTURAL, MECHANICAL AND PLUMBING DRAWINGS. THESE ITEMS INCLUDE AIR HANDLING UNITS, CABINET HEATERS, FAN POWERED BOXES, EXHAUST FANS, PUMPS, WATER HEATERS, DISPLAY CASES, ETC.


### **DEMOLITION PLAN NOTES:** (THESE NOTES APPLY TO THIS SHEET ONLY)


1 REMOVE EXISTING WIRING DEVICES, INCLUDING FIRE ALARM DEVICES AND TECHNOLOGY DEVICES IN THIS ROOM AND REMOVE ASSOCIATED WIRING BACK TO THE SOURCE IN SUCH A MANNER AS TO KEEP ALL OTHER WIRING DEVICES ON THIS CIRCUIT/WIRING, THAT ARE TO REMAIN, IN SERVICE, UNLESS OTHERWISE NOTED. 2 DISCONNECT MECHANICAL EQUIPMENT IN THIS ROOM THAT IS TO BE REMOVED AND REMOVE ASSOCIATED WIRING BACK TO THE SOURCE IN

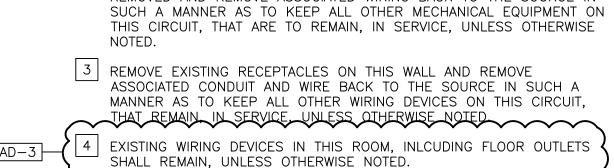



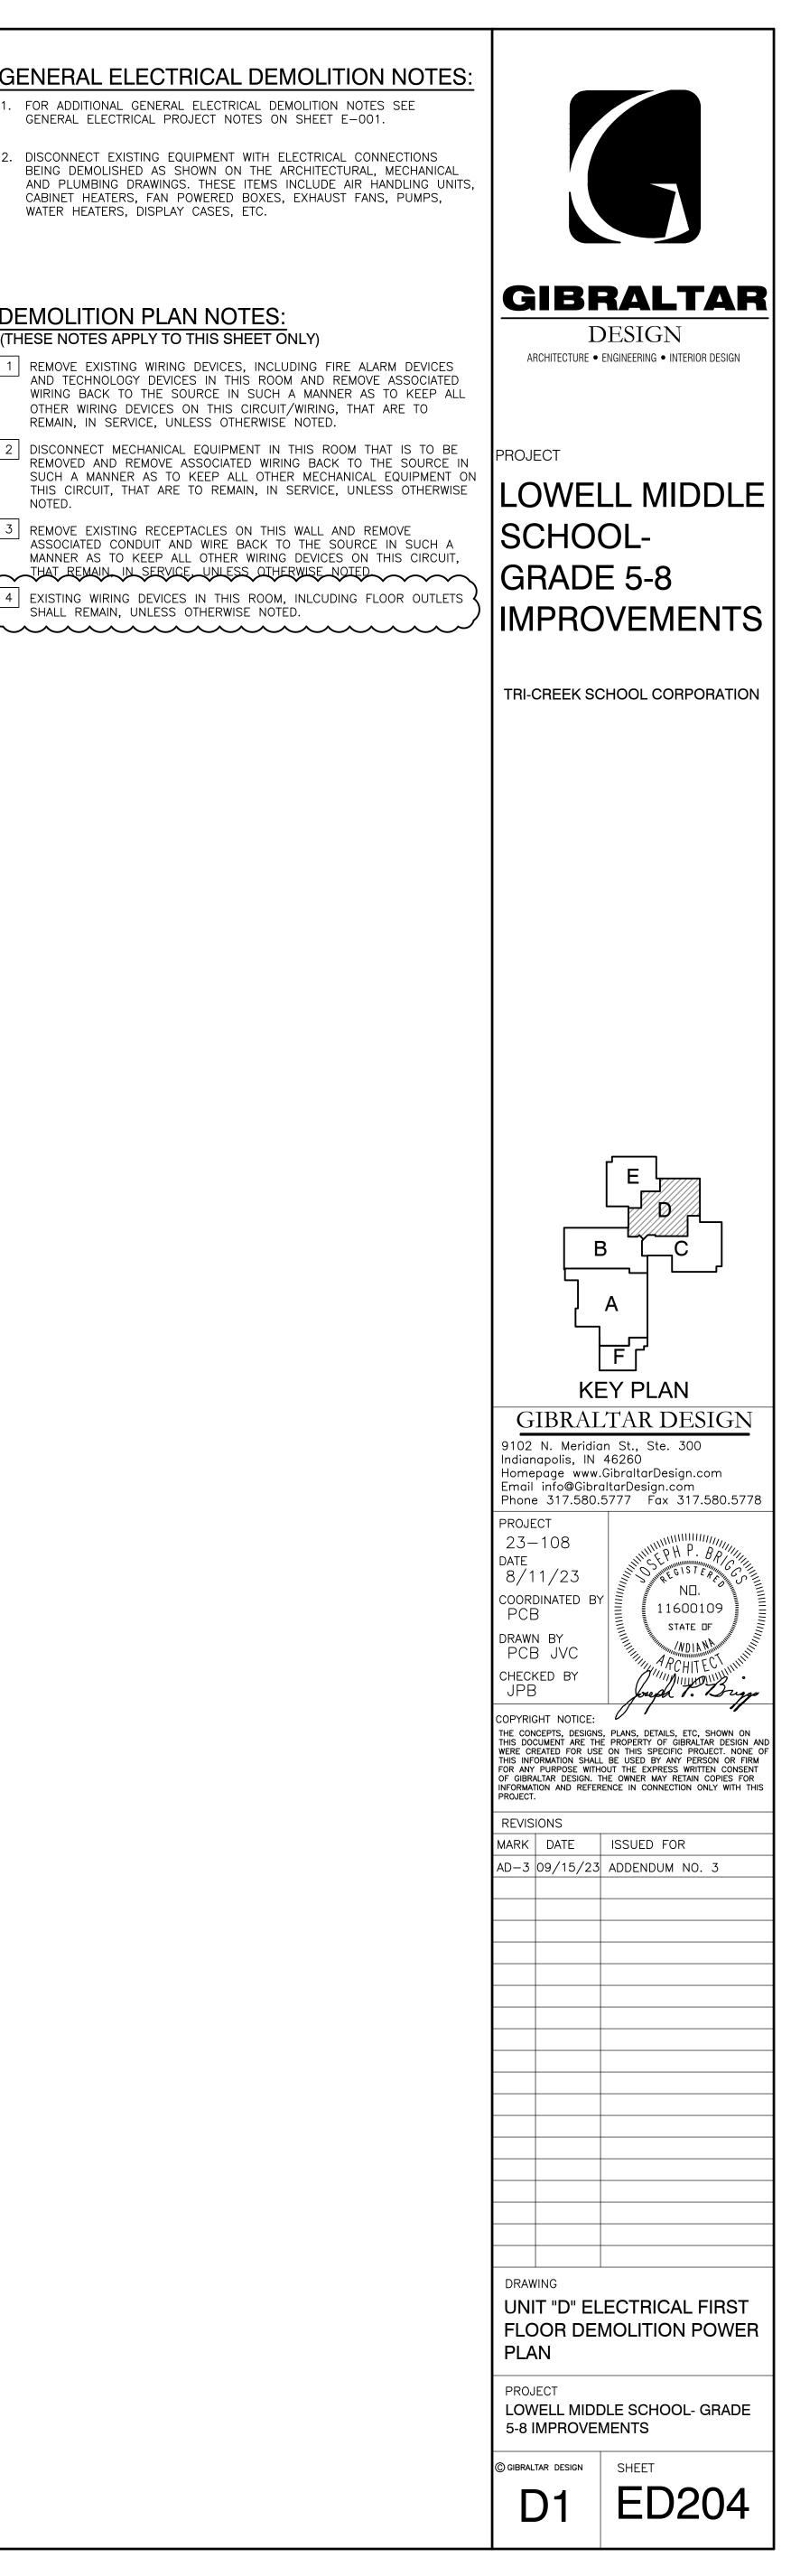

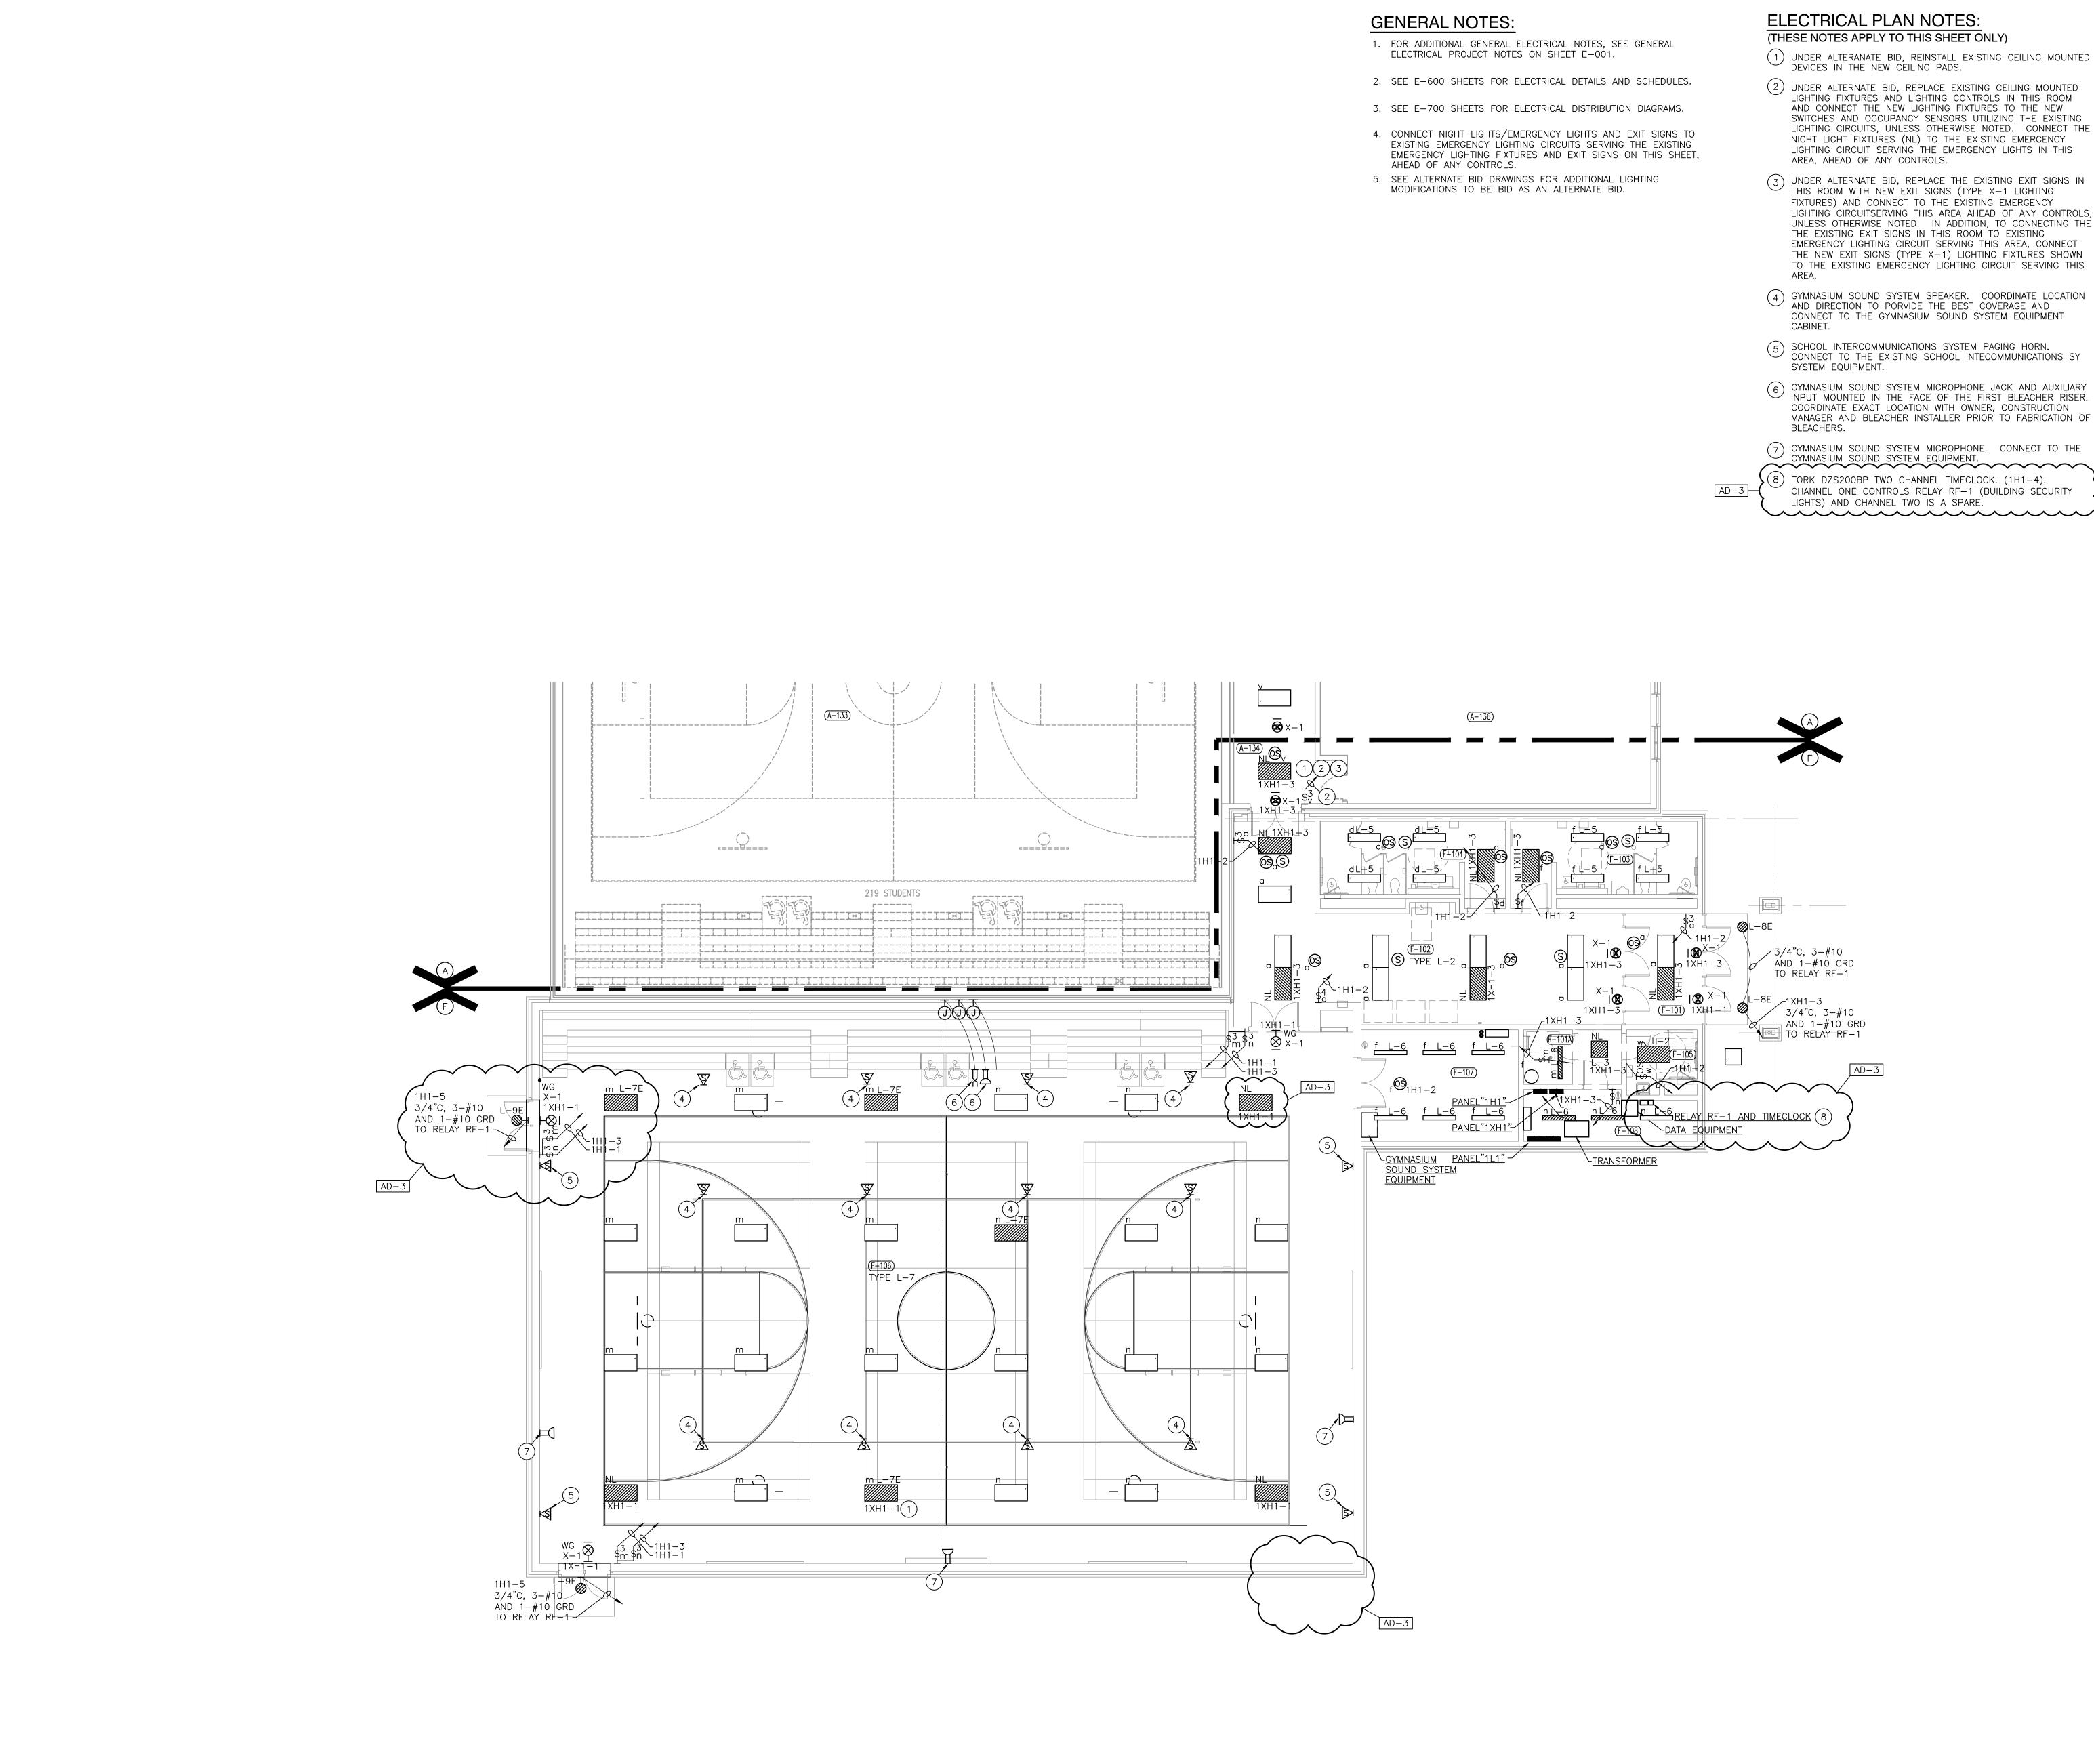

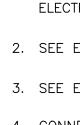



# UNIT "F" ELECTRICAL FIRST FLOOR LIGHTING PLAN - ALTERNATE SCALE: 1/8" = 1'-0"

# ELECTRICAL PLAN NOTES:

(THESE NOTES APPLY TO THIS SHEET ONLY)

(1) UNDER ALTERANATE BID, REINSTALL EXISTING CEILING MOUNTED DEVICES IN THE NEW CEILING PADS. (2) UNDER ALTERNATE BID, REPLACE EXISTING CEILING MOUNTED

ROOM

 $-10^{-1}$ 

F-104


F-106


-107


F-108


NO

- LIGHTING FIXTURES AND LIGHTING CONTROLS IN THIS ROOM AND CONNECT THE NEW LIGHTING FIXTURES TO THE NEW SWITCHES AND OCCUPANCY SENSORS UTILIZING THE EXISTING LIGHTING CIRCUITS, UNLESS OTHERWISE NOTED. CONNECT THE NIGHT LIGHT FIXTURES (NL) TO THE EXISTING EMERGENCY LIGHTING CIRCUIT SERVING THE EMERGENCY LIGHTS IN THIS AREA, AHEAD OF ANY CONTROLS.
- 3 UNDER ALTERNATE BID, REPLACE THE EXISTING EXIT SIGNS IN THIS ROOM WITH NEW EXIT SIGNS (TYPE X-1 LIGHTING FIXTURES) AND CONNECT TO THE EXISTING EMERGENCY LIGHTING CIRCUITSERVING THIS AREA AHEAD OF ANY CONTROLS. UNLESS OTHERWISE NOTED. IN ADDITION, TO CONNECTING THE THE EXISTING EXIT SIGNS IN THIS ROOM TO EXISTING EMERGENCY LIGHTING CIRCUIT SERVING THIS AREA, CONNECT THE NEW EXIT SIGNS (TYPE X-1) LIGHTING FIXTURES SHOWN TO THE EXISTING EMERGENCY LIGHTING CIRCUIT SERVING THIS
- (4) GYMNASIUM SOUND SYSTEM SPEAKER. COORDINATE LOCATION AND DIRECTION TO PORVIDE THE BEST COVERAGE AND CONNECT TO THE GYMNASIUM SOUND SYSTEM EQUIPMENT
- 5 SCHOOL INTERCOMMUNICATIONS SYSTEM PAGING HORN. CONNECT TO THE EXISTING SCHOOL INTECOMMUNICATION CONNECT TO THE EXISTING SCHOOL INTECOMMUNICATIONS SY SYSTEM EQUIPMENT.
- 6 GYMNASIUM SOUND SYSTEM MICROPHONE JACK AND AUXILIARY INPUT MOUNTED IN THE FACE OF THE FIRST BLEACHER RISER. COORDINATE EXACT LOCATION WITH OWNER, CONSTRUCTION MANAGER AND BLEACHER INSTALLER PRIOR TO FABRICATION OF
- (7) GYMNASIUM SOUND SYSTEM MICROPHONE. CONNECT TO THE GYMNASIUM SOUND SYSTEM EQUIPMENT.
- (8) TORK DZS200BP TWO CHANNEL TIMECLOCK. (1H1-4). CHANNEL ONE CONTROLS RELAY RF-1 (BUILDING SECURITY LIGHTS) AND CHANNEL TWO IS A SPARE.

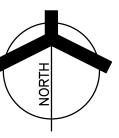

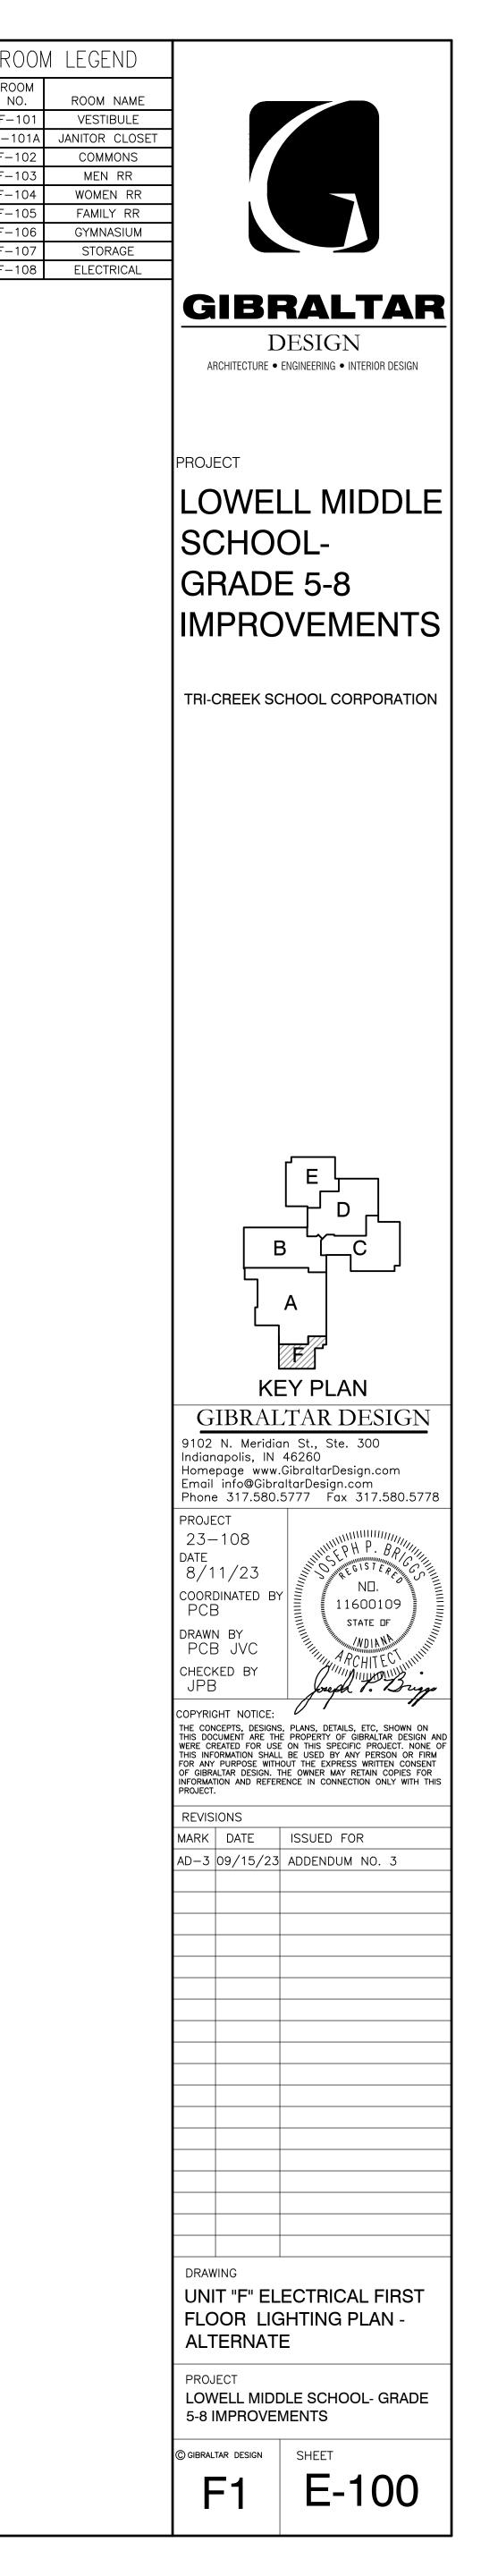

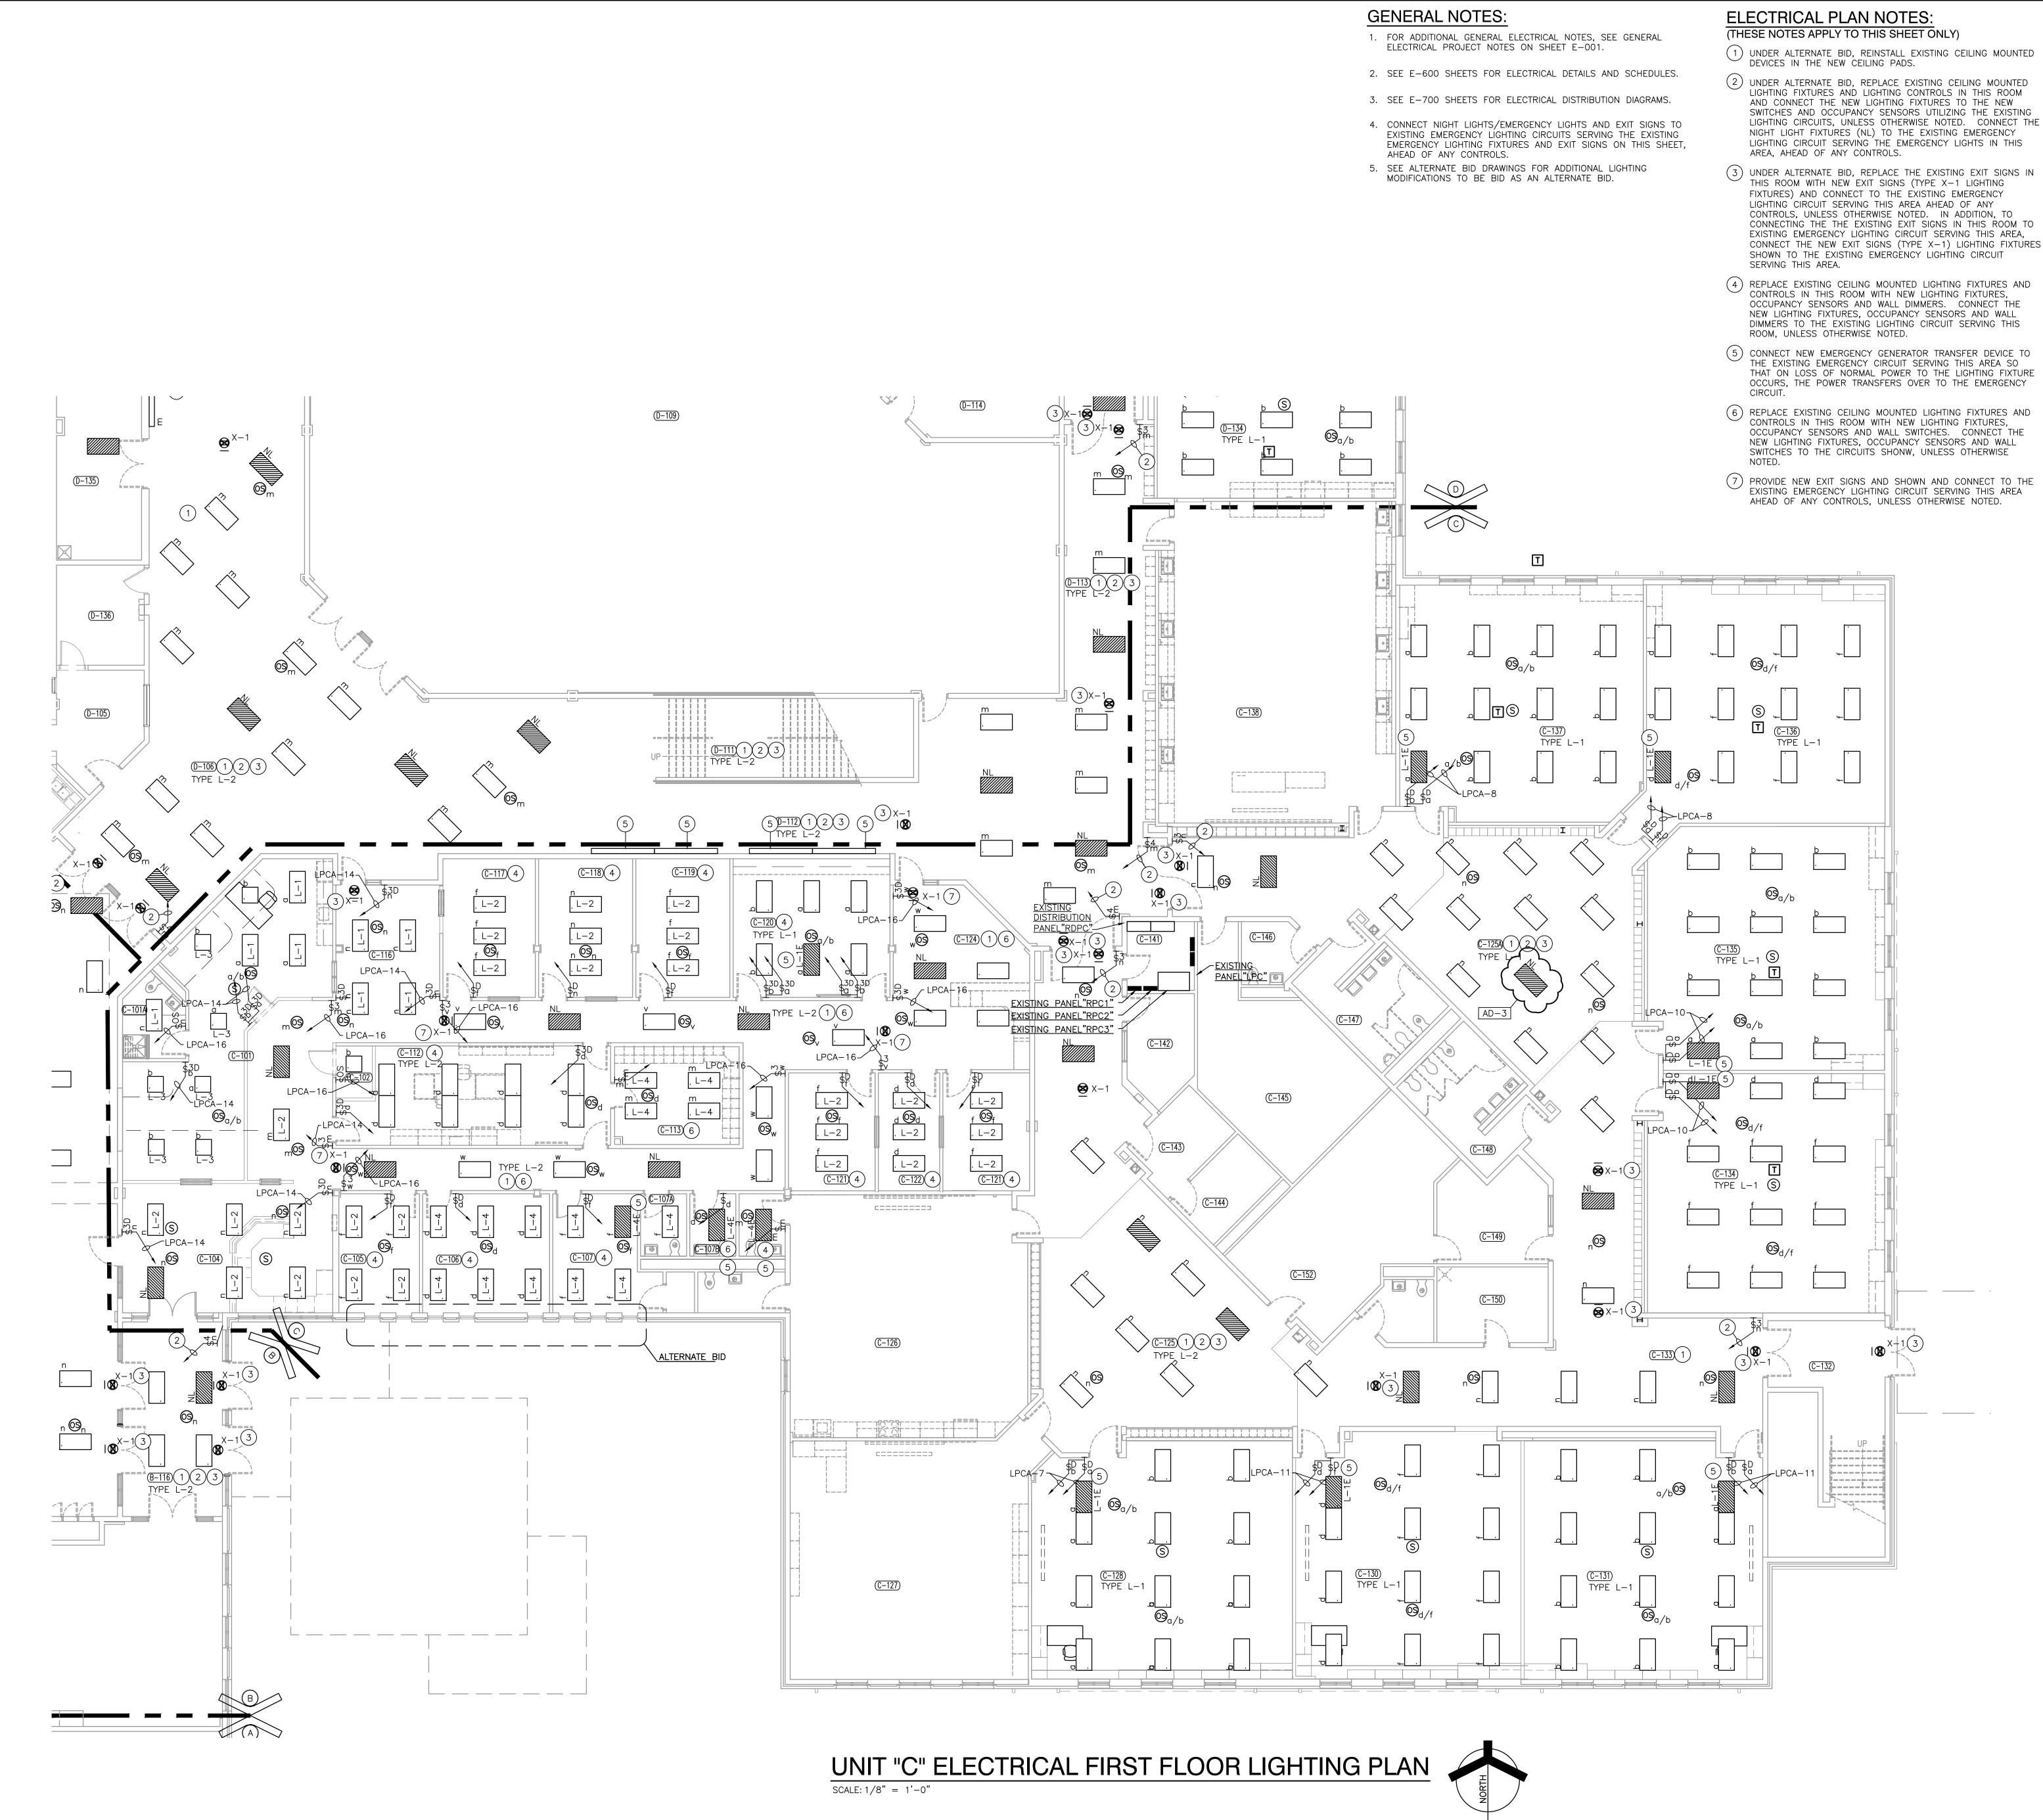


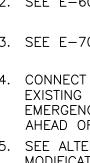



- LIGHTING FIXTURES AND LIGHTING CONTROLS IN THIS ROOM AND CONNECT THE NEW LIGHTING FIXTURES TO THE NEW SWITCHES AND OCCUPANCY SENSORS UTILIZING THE EXISTING LIGHTING CIRCUITS, UNLESS OTHERWISE NOTED. CONNECT THE NIGHT LIGHT FIXTURES (NL) TO THE EXISTING EMERGENCY LIGHTING CIRCUIT SERVING THE EMERGENCY LIGHTS IN THIS
- THIS ROOM WITH NEW EXIT SIGNS (TYPE X-1 LIGHTING FIXTURES) AND CONNECT TO THE EXISTING EMERGENCY LIGHTING CIRCUIT SERVING THIS AREA AHEAD OF ANY CONTROLS, UNLESS OTHERWISE NOTED. IN ADDITION, TO CONNECTING THE THE EXISTING EXIT SIGNS IN THIS ROOM TO EXISTING EMERGENCY LIGHTING CIRCUIT SERVING THIS AREA, CONNECT THE NEW EXIT SIGNS (TYPE X-1) LIGHTING FIXTURES SHOWN TO THE EXISTING EMERGÈNCY LIGHTING CIRCUIT SERVING THIS AREA.
- CONTROLS IN THIS ROOM WITH NEW LIGHTING FIXTURES, OCCUPANCY SENSORS AND WALL DIMMERS. CONNECT THE NEW LIGHTING FIXTURES, OCCUPANCY SENSORS AND WALL DIMMERS TO THE EXISTING LIGHTING CIRCUIT SERVING THIS ROOM, UNLESS OTHERWISE NOTED.
- THE EXISTING EMERGENCY CIRCUIT SERVING THIS AREA SO THAT ON LOSS OF NORMAL POWER TO THE LIGHTING FIXTURE OCCURS, THE POWER TRANSFERS OVER TO THE EMERGENCY
- OCCUPANCY SENSORS AND WALL SWITCHES. CONNECT THE NEW LIGHTING FIXTURES, OCCUPANCY SENSORS AND WALL SWITCHES TO THE CIRCUITS SHONW, UNLESS OTHERWISE
- EXISTING EMERGENCY LIGHTING CIRCUIT SERVING THIS AREA AHEAD OF ANY CONTROLS, UNLESS OTHERWISE NOTED.




-	
	M LEGEN
ROOM NO.	ROOM N
C-101	NURS
C-101A	RESTRC
C-101B	
C-102	STORA
C-103	
C-104	RECEPT
C-105	CONFERE
C-106 C-107	PRINCIF FLEX
C-107 C-107A	RESTRC
C-107A	RESTRO
C-108	
C-109	
C-110	
C-111	
C-112	WORKRO
C-113	RECOR
C-114	
C-115	
C-116	WAITIN
C-117	GUIDANCE SE
C-118	GUIDANCE CO
C-119 C-120	SOCIAL WO
C-120	FLEX
C-121 C-121	NISE
C-122	CALM
C-123	
C-124	SAFET
C-125	EXTENDED L
C-125A	EXTENDED L
C-126	5TH GRADE
C-127	5TH GRADE
C-128	5TH GRADE
C-129	
C-130	5TH GRADE
C-131 C-132	5TH GRADE STAIR
C = 132 C = 133	
C-134	5TH GRADE
C-135	5TH GRADE
C-136	5TH GRADE
C-137	5TH GRADE
C-138	5TH GRADE
C-139	
C-140	
C-141	ELECTRI
C-142	SPEECH/H
C - 143	TECH OF
C-144 C-145	TR
C-145 C-146	TEACHER STAFF TO
C-140 C-147	BOYS
C-148	GIRLS
C-149	CONFERE
C-150	CUSTOD
C-151	STAFF TO
C-152	GIFTE

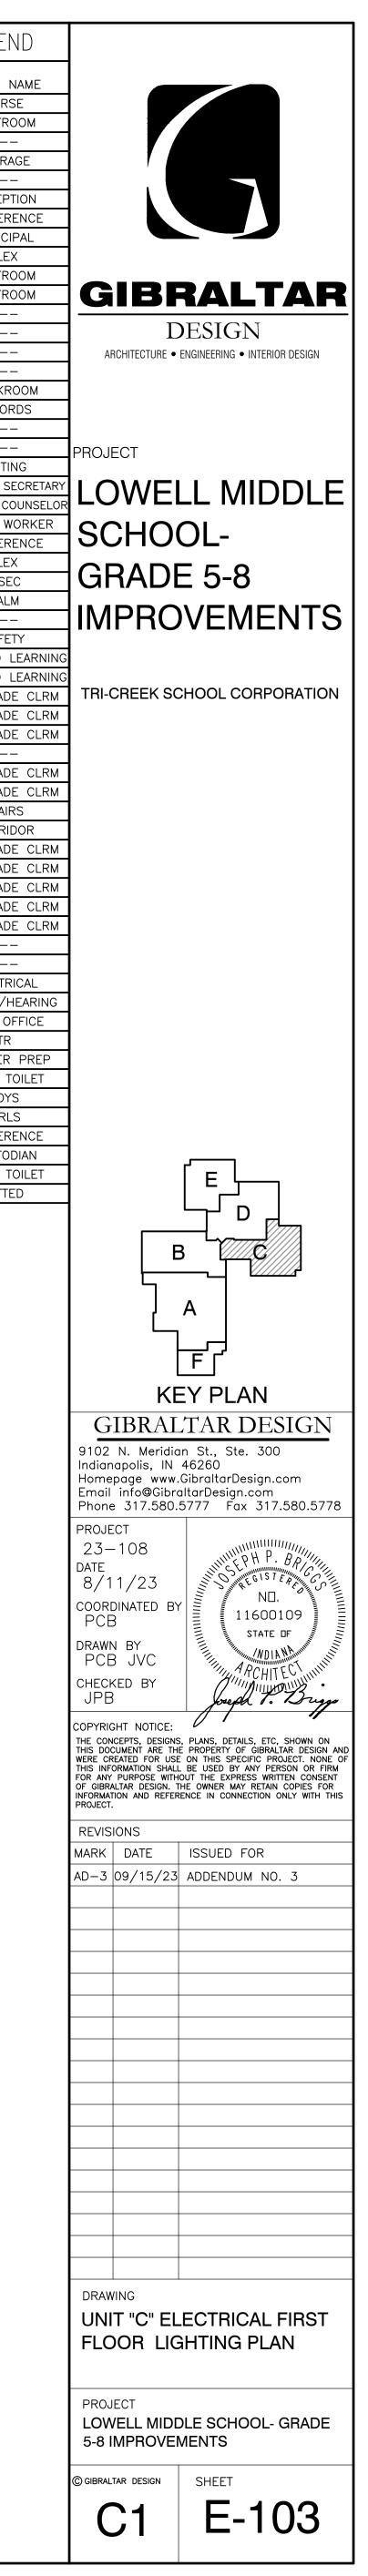


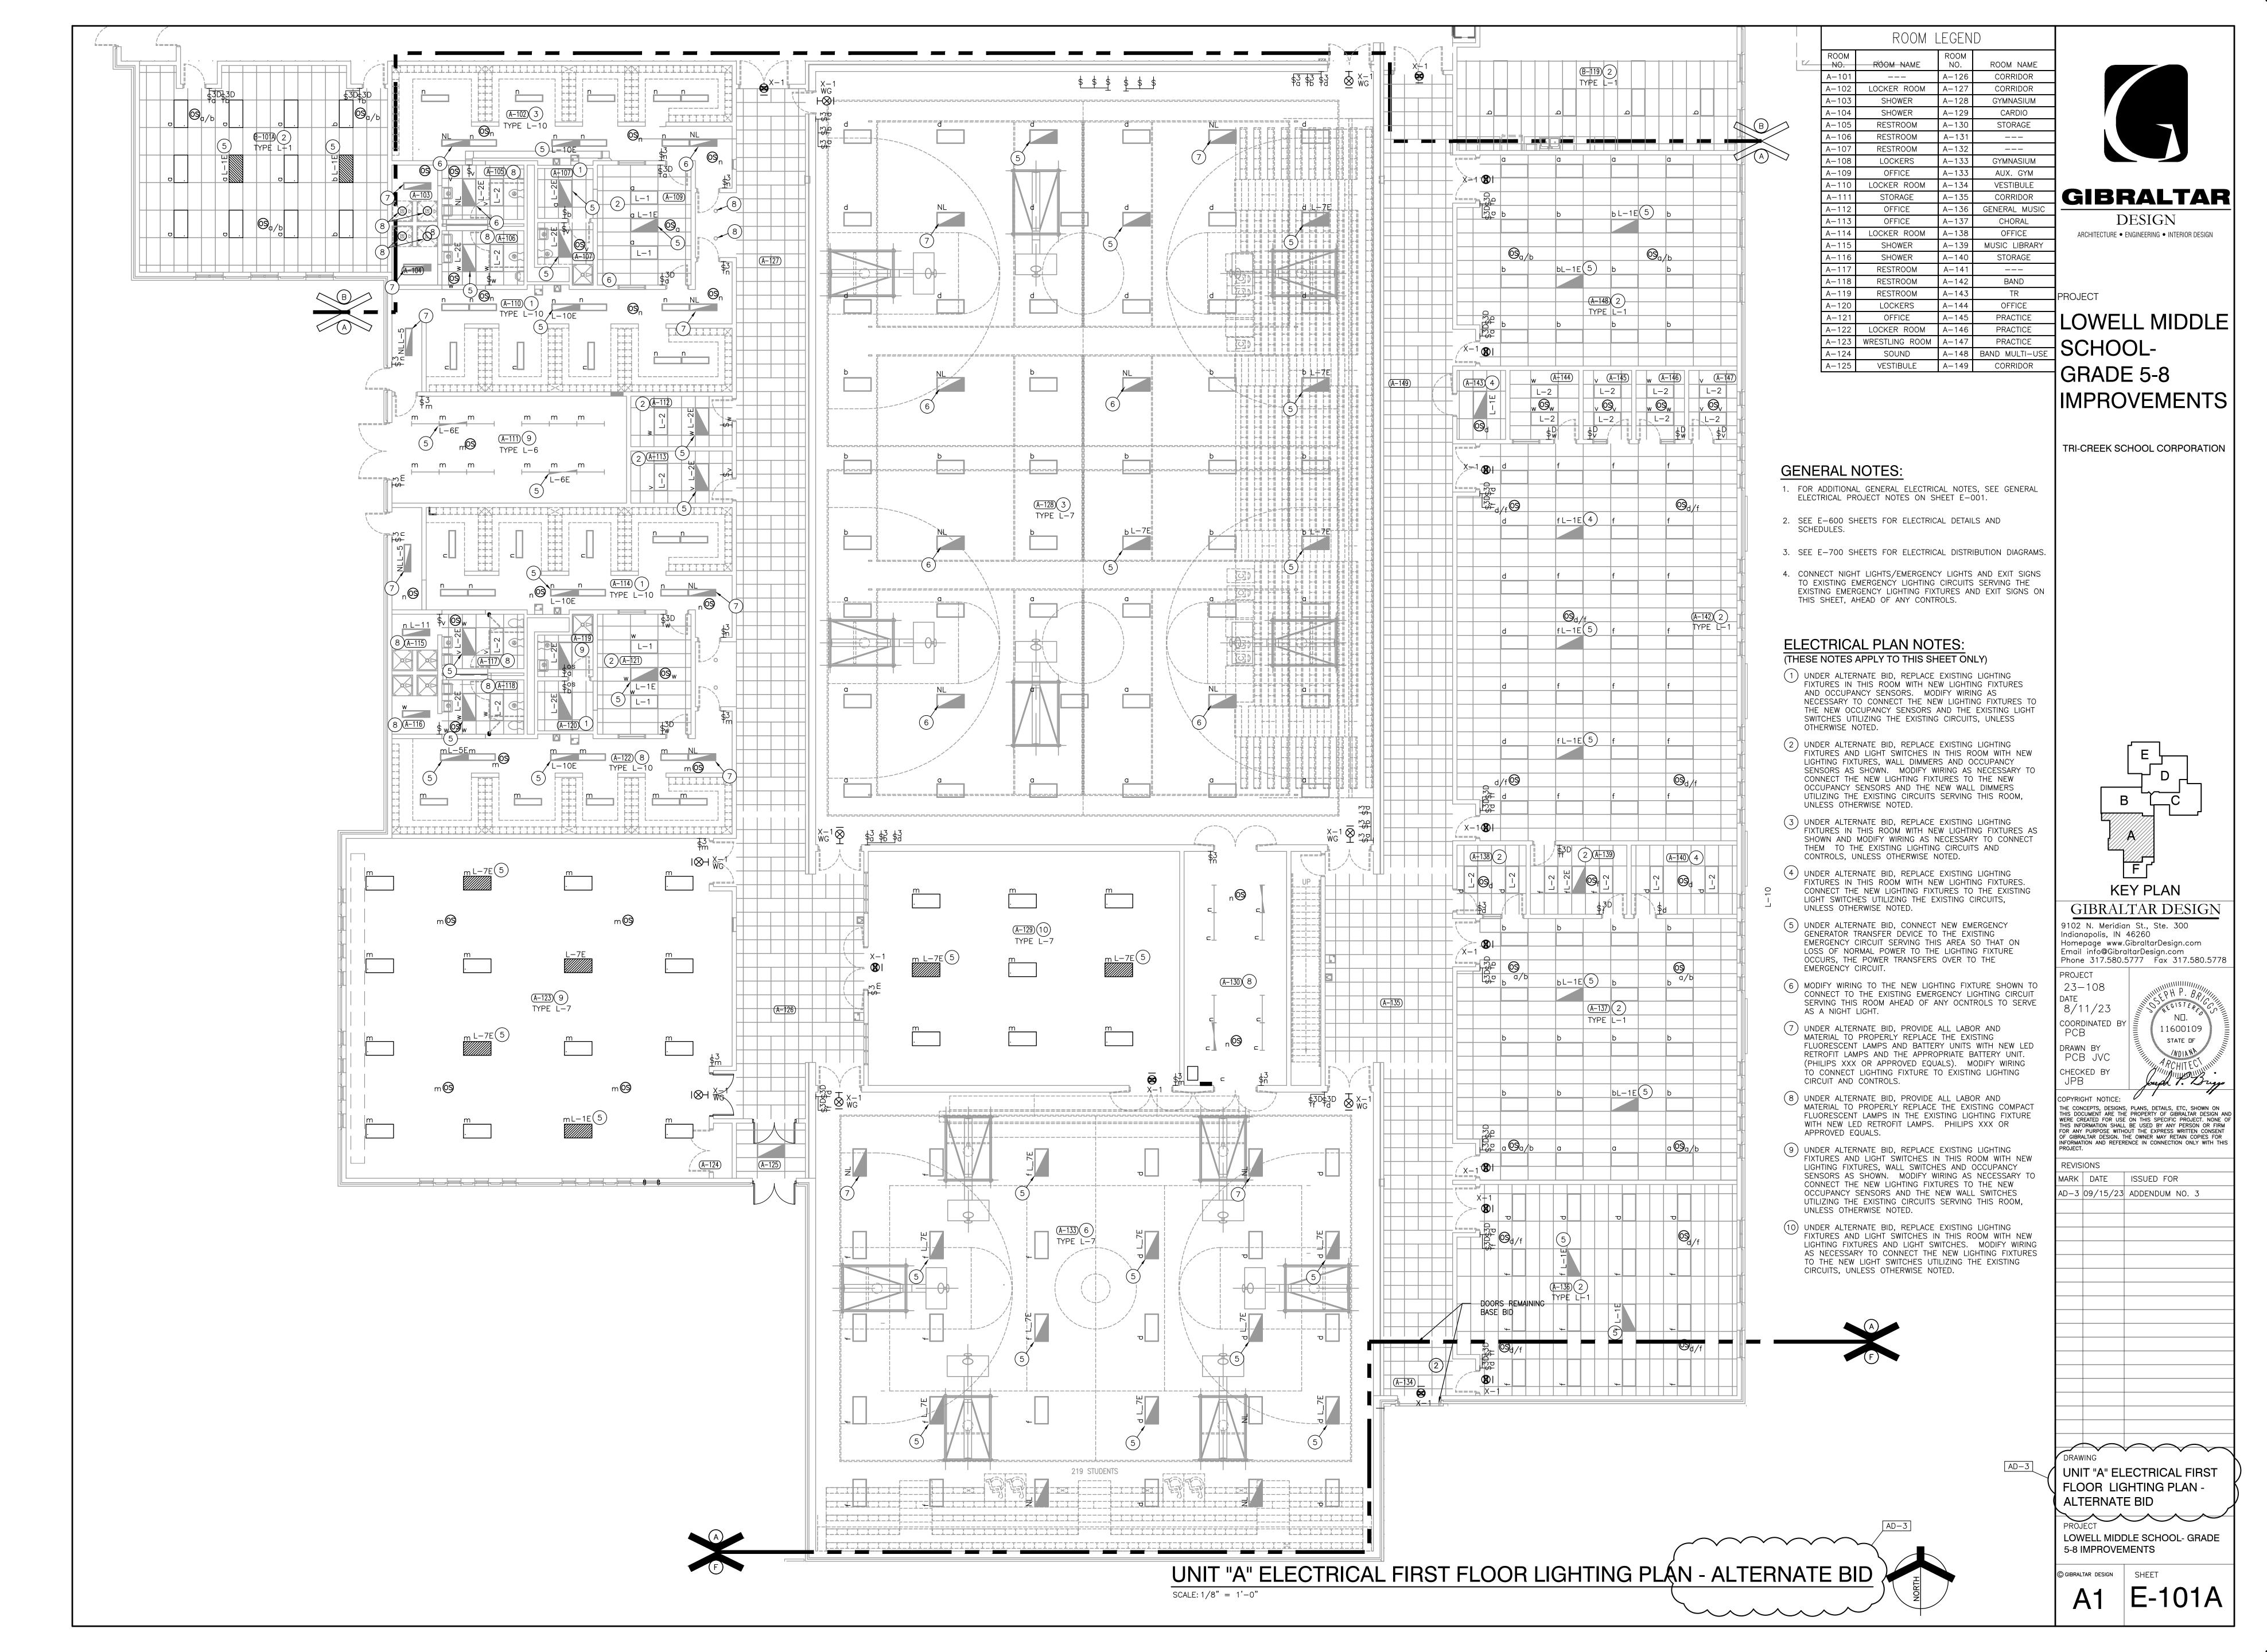


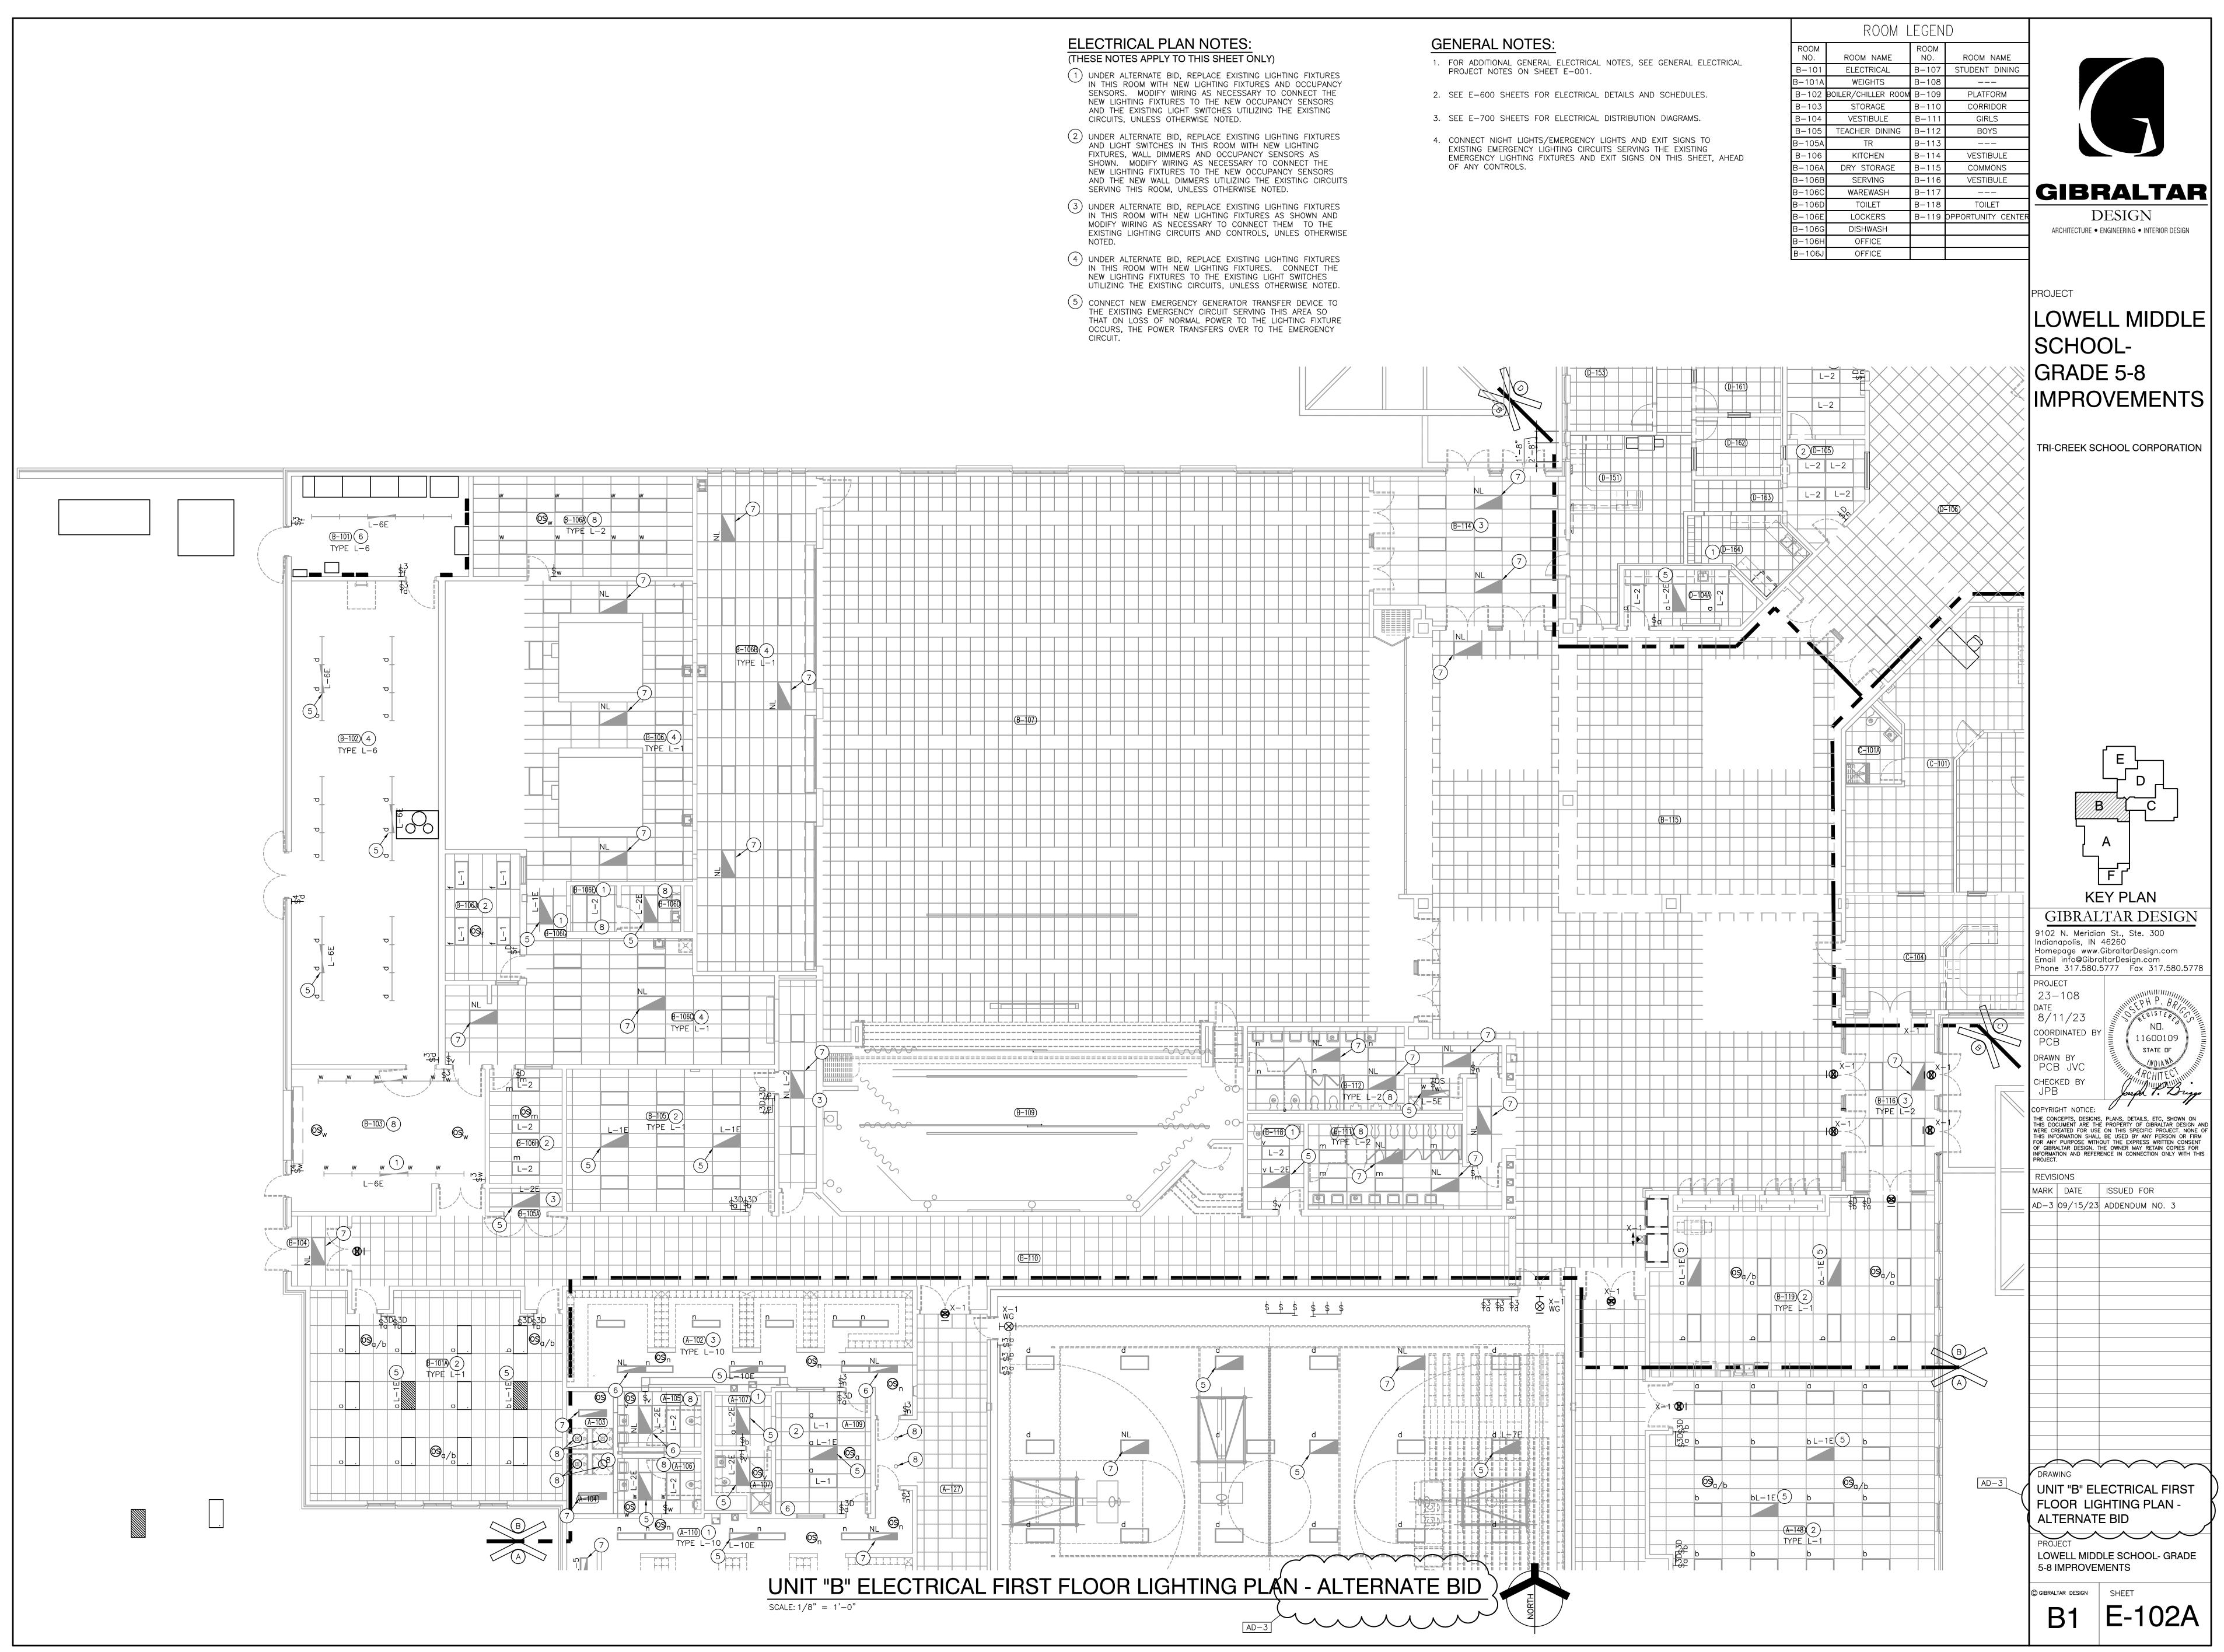

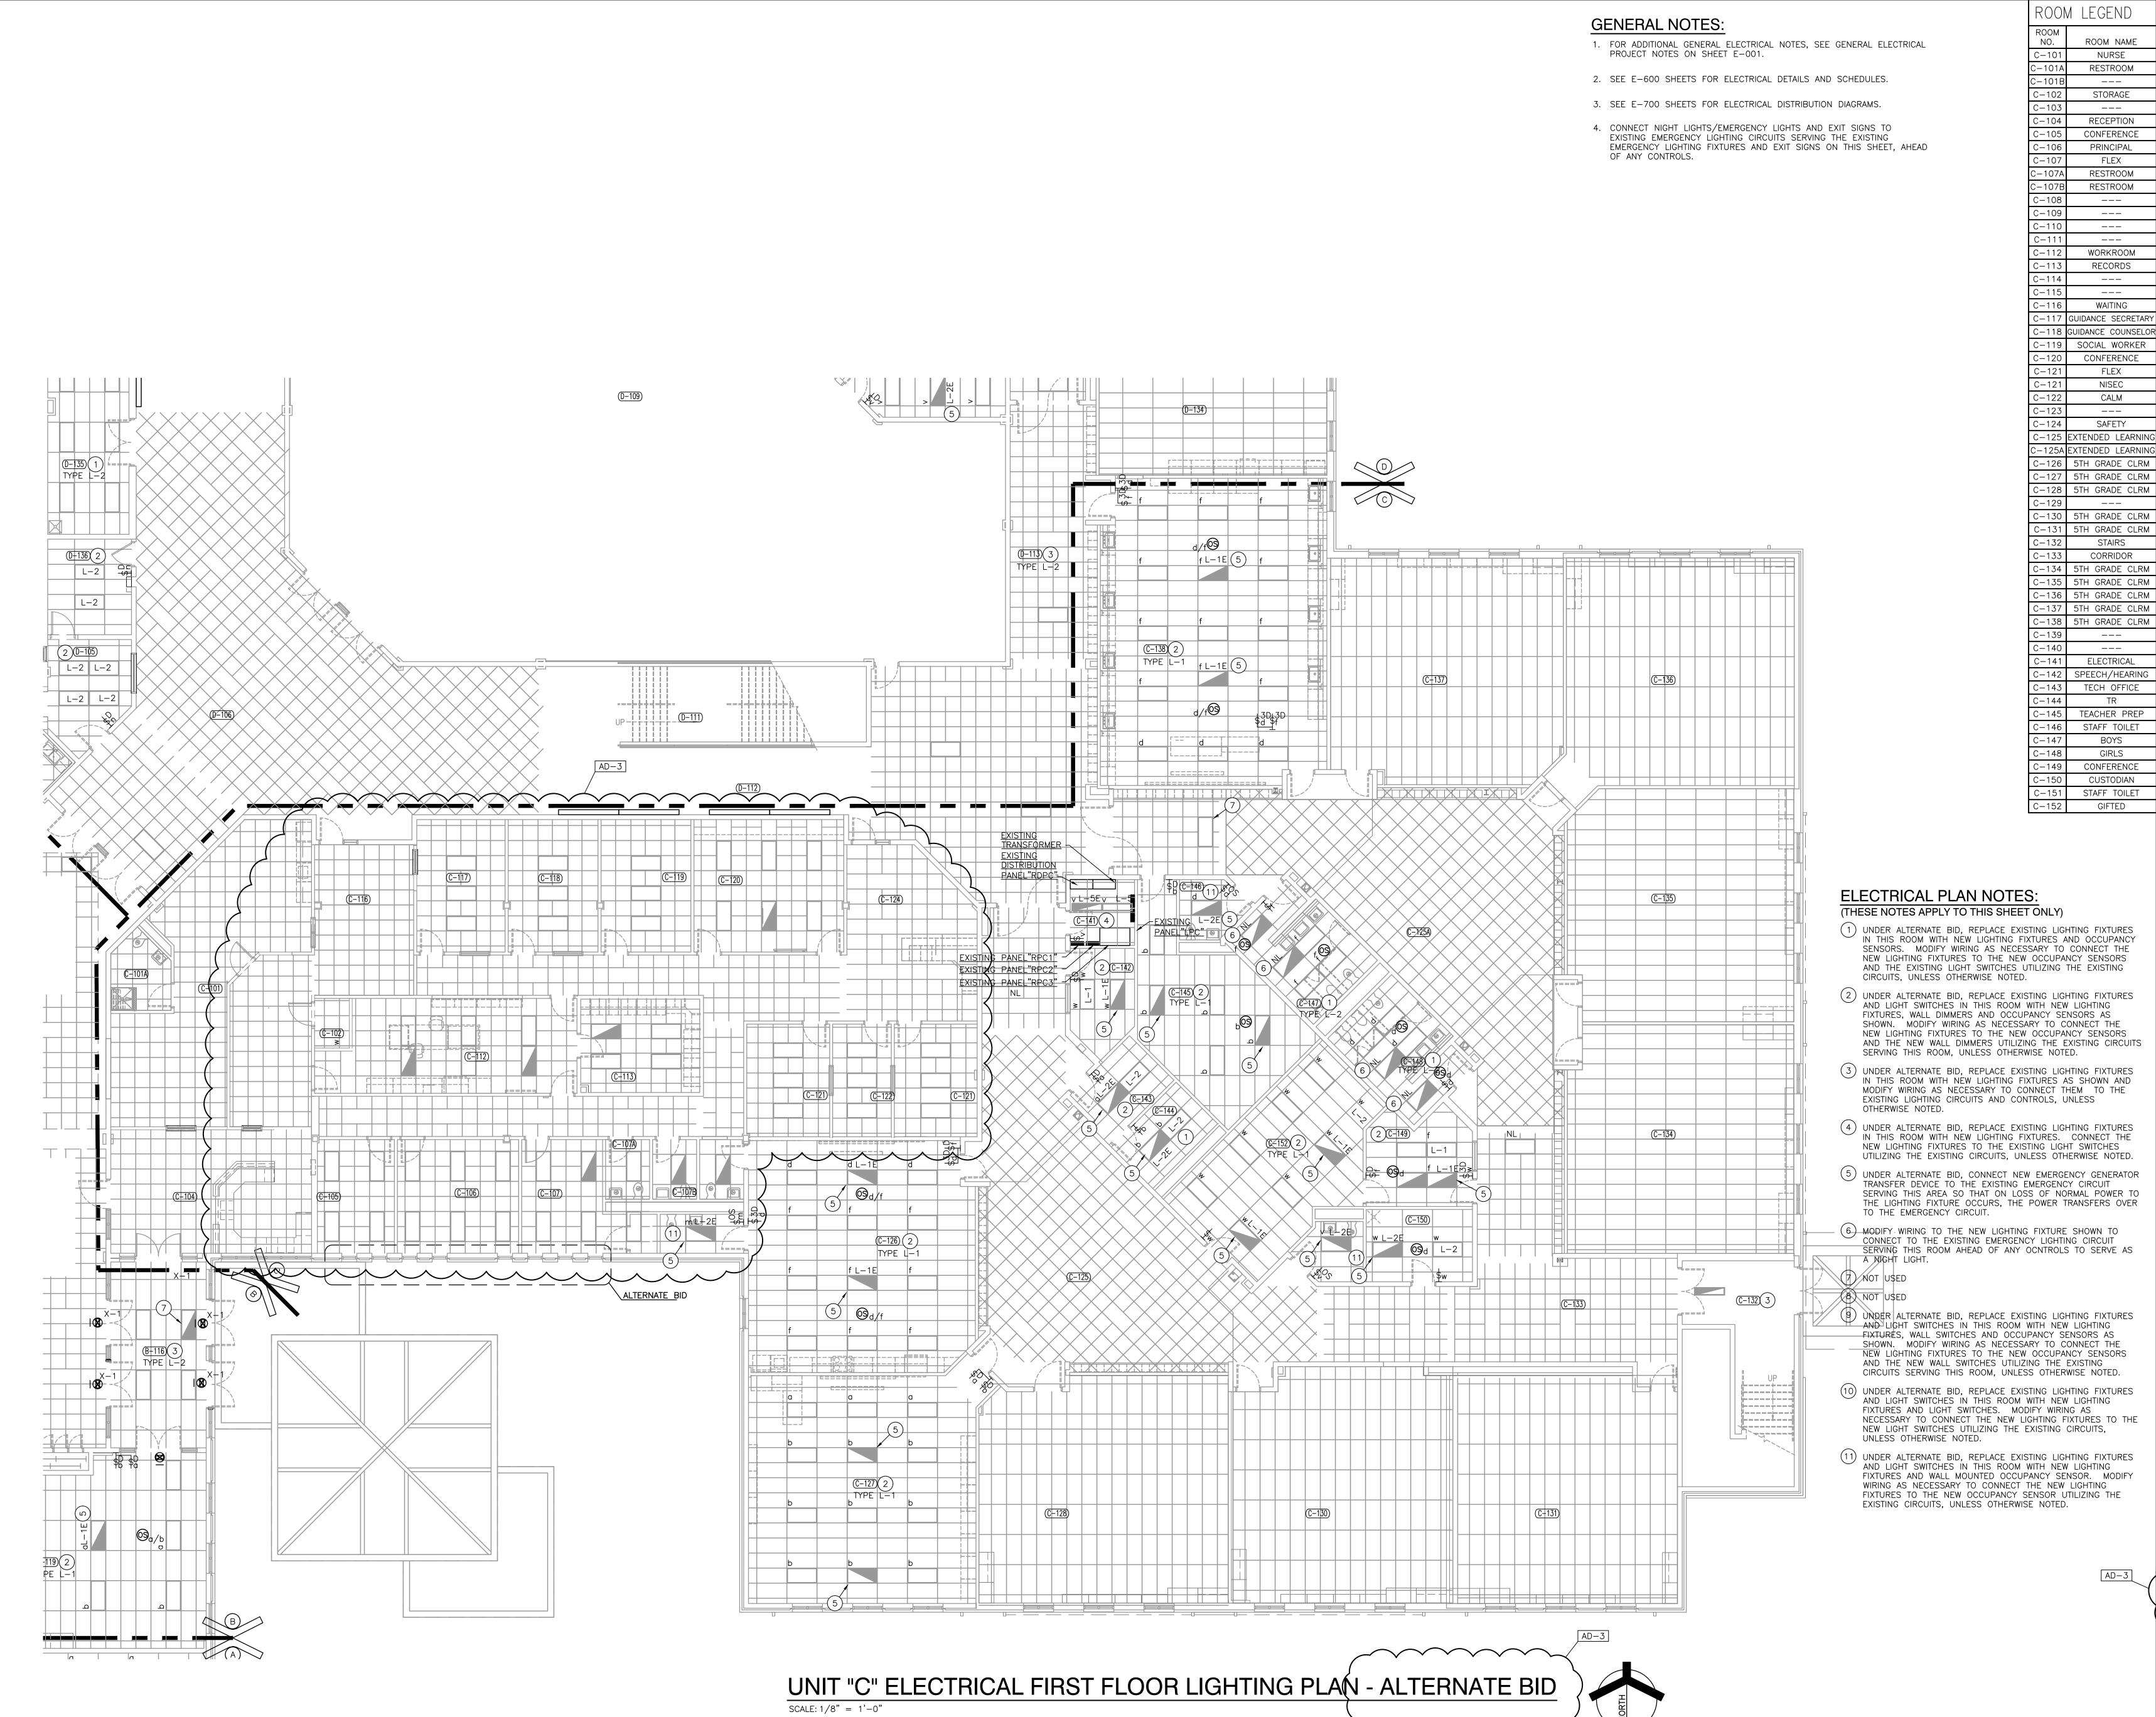

 $\sim$ 

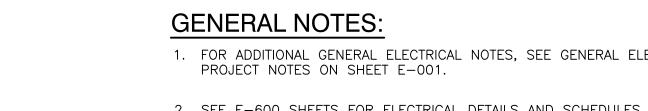

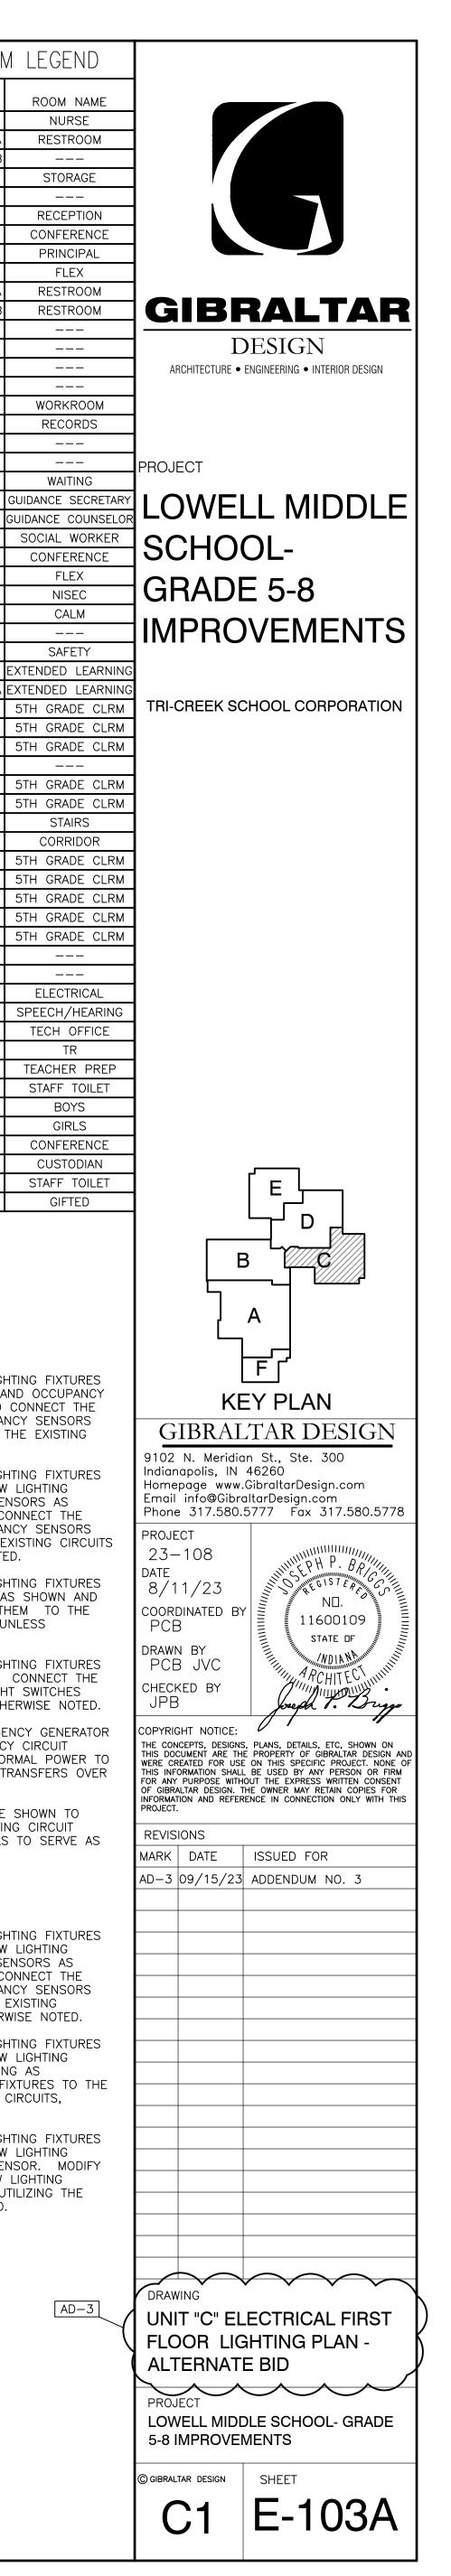





	ROOM L	EGEN	D
ROOM NO.	ROOM NAME	ROOM NO.	ROOM N
D-101	MACHINE ROOM	D-133	5TH GRADE F
D-102		D-134	SG
D-103		D-135	STORA
D-104		D-136	BOOK KI
D-104A	CONCESSIONS	D-137	
D-105	ATTENDANCE	D-138	
D-106	COMMONS	D-139	
D-107		D-140	
D-108	STAIRS	D-141	
D-109	MEDIA CENTER	D-142	
D-110		D-143	
D-111	STAIRS	D-144	
D-112	CORRIDOR	D-145	
D-113	CORRIDOR	D-146	
D-114	CONFERENCE	D-147	
D-115	OFFICE	D-148	
D-116	OFFICE	D-149	
D-117	OFFICE	D-150	
D-118	AV STORAGE	D-151	RECEP
D-119	TEACHER PREP	D-152	HAL
D-120	STORAGE	D-153	CONFER
D-121	CUSTODIAN	D-154	PRINCI
D-122	STAFF TOILET	D-155	STUDENT S
D-123	GIRLS	D-156	DE-ESCALATI
D-124	BOYS	D-157	FILE
D-125	CONFERENCE	D-158	ATHLETIC D
D-126	CORRIDOR	D-159	RESTR
D-127	EXTENDED LEARNING	D-160	RESTR
D-128	STORAGE	D-161	DEA
D-129	7TH GRADE SCIENCE LAE	D-162	ISS
D-130	7TH GRADE FLEX CLRM	D-163	MAII
D-131	7TH GRADE PE/HEALTH	D-164	WORKR
D-132	SE		

# FOR ADDITIONAL GENERAL ELECTRICAL NOTES, SEE GENERAL ELECTRICAL PROJECT NOTES ON SHEET E-001.

- 2. SEE E-600 SHEETS FOR ELECTRICAL DETAILS AND SCHEDULES.
- 3. SEE E-700 SHEETS FOR ELECTRICAL DISTRIBUTION DIAGRAMS.
- 4. CONNECT NIGHT LIGHTS/EMERGENCY LIGHTS AND EXIT SIGNS TO EXISTING EMERGENCY LIGHTING CIRCUITS SERVING THE EXISTING EMERGENCY LIGHTING FIXTURES AND EXIT SIGNS ON THIS SHEET, AHEAD OF ANY CONTROLS.

- 1 UNDER ALTERNATE BID, REPLACE EXISTING LIGHTING FIXTURES IN THIS ROOM WITH NEW LIGHTING FIXTURES AND OCCUPANCY SENSORS. MODIFY WIRING AS NECESSARY TO CONNECT THE NEW LIGHTING FIXTURES TO THE NEW OCCUPANCY SENSORS AND THE EXISTING LIGHT SWITCHES UTILIZING THE EXISTING CIRCUITS, UNLESS OTHERWISE NOTED.
- 2 UNDER ALTERNATE BID, REPLACE EXISTING LIGHTING FIXTURES AND LIGHT SWITCHES IN THIS ROOM WITH NEW LIGHTING FIXTURES, WALL DIMMERS AND OCCUPANCY SENSORS AS SHOWN. MODIFY WIRING AS NECESSARY TO CONNECT THE NEW LIGHTING FIXTURES TO THE NEW OCCUPANCY SENSORS AND THE NEW WALL DIMMERS UTILIZING THE EXISTING CIRCUITS SERVING THIS ROOM, UNLESS OTHERWISE NOTED.
- 3 UNDER ALTERNATE BID, REPLACE EXISTING LIGHTING FIXTURES IN THIS ROOM WITH NEW LIGHTING FIXTURES AS SHOWN AND MODIFY WIRING AS NECESSARY TO CONNECT THEM TO THE EXISTING LIGHTING CIRCUITS AND CONTROLS, UNLES OTHERWISE NOTED.
- 4 UNDER ALTERNATE BID, REPLACE EXISTING LIGHTING FIXTURES IN THIS ROOM WITH NEW LIGHTING FIXTURES. CONNECT THE NEW LIGHTING FIXTURES TO THE EXISTING LIGHT SWITCHES UTILIZING THE EXISTING CIRCUITS, UNLESS OTHERWISE NOTED.
- 5 CONNECT NEW EMERGENCY GENERATOR TRANSFER DEVICE TO THE EXISTING EMERGENCY CIRCUIT SERVING THIS AREA SO THAT ON LOSS OF NORMAL POWER TO THE LIGHTING FIXTURE OCCURS, THE POWER TRANSFERS OVER TO THE EMERGENCY CIRCUIT.

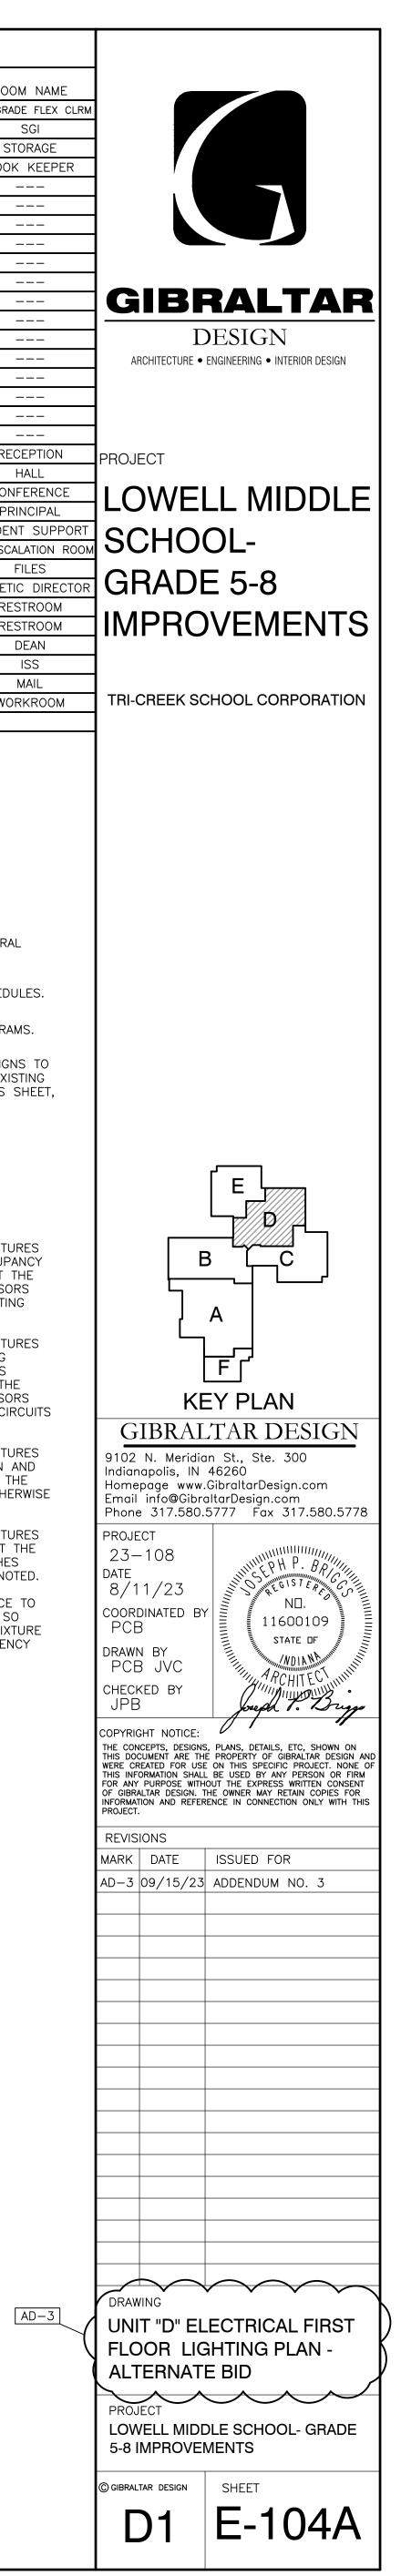


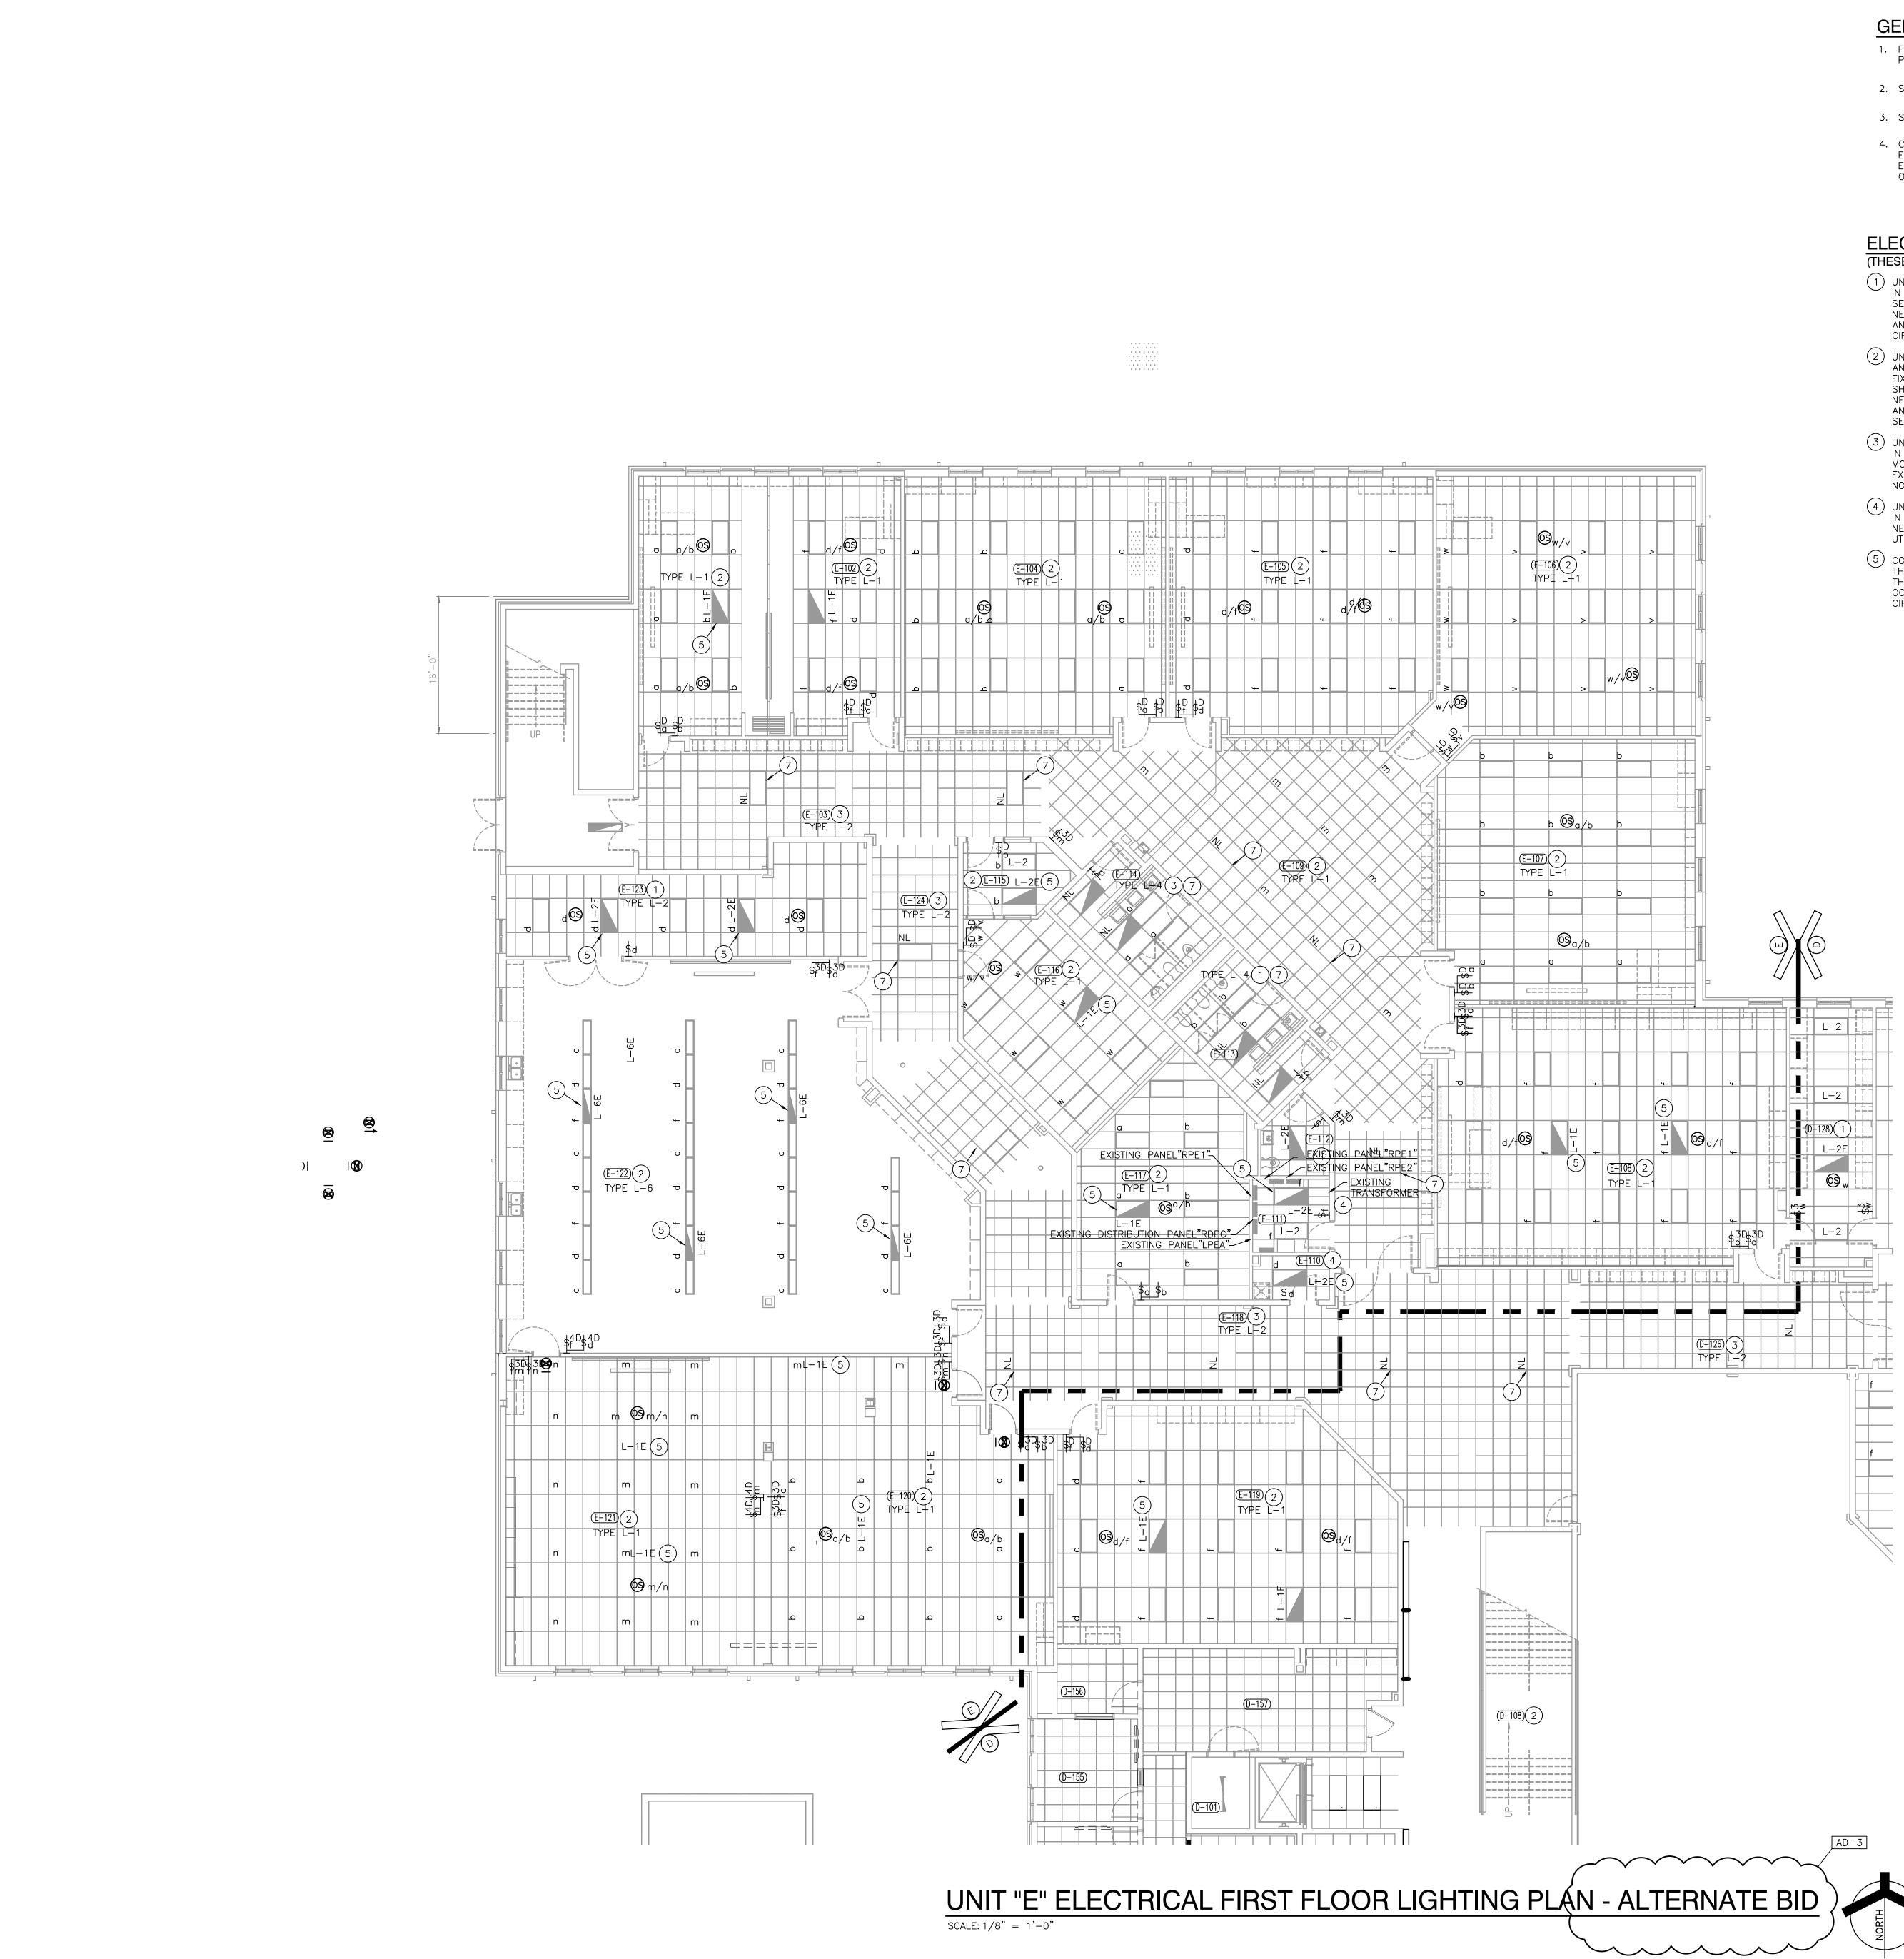


- 1. FOR ADDITIONAL GENERAL ELECTRICAL NOTES, SEE GENERAL ELECTRICAL PROJECT NOTES ON SHEET E-001.
- 2. SEE E-600 SHEETS FOR ELECTRICAL DETAILS AND SCHEDULES.
- 3. SEE E-700 SHEETS FOR ELECTRICAL DISTRIBUTION DIAGRAMS.
- 4. CONNECT NIGHT LIGHTS/EMERGENCY LIGHTS AND EXIT SIGNS TO EXISTING EMERGENCY LIGHTING CIRCUITS SERVING THE EXISTING EMERGENCY LIGHTING FIXTURES AND EXIT SIGNS ON THIS SHEET, AHEAD OF ANY CONTROLS.

- 1 UNDER ALTERNATE BID, REPLACE EXISTING LIGHTING FIXTURES IN THIS ROOM WITH NEW LIGHTING FIXTURES AND OCCUPANCY SENSORS. MODIFY WIRING AS NECESSARY TO CONNECT THE NEW LIGHTING FIXTURES TO THE NEW OCCUPANCY SENSORS AND THE EXISTING LIGHT SWITCHES UTILIZING THE EXISTING CIRCUITS, UNLESS OTHERWISE NOTED.
- 2 UNDER ALTERNATE BID, REPLACE EXISTING LIGHTING FIXTURES AND LIGHT SWITCHES IN THIS ROOM WITH NEW LIGHTING FIXTURES, WALL DIMMERS AND OCCUPANCY SENSORS AS SHOWN. MODIFY WIRING AS NECESSARY TO CONNECT THE NEW LIGHTING FIXTURES TO THE NEW OCCUPANCY SENSORS AND THE NEW WALL DIMMERS UTILIZING THE EXISTING CIRCUITS SERVING THIS ROOM, UNLESS OTHERWISE NOTED.
- (3) UNDER ALTERNATE BID, REPLACE EXISTING LIGHTING FIXTURES IN THIS ROOM WITH NEW LIGHTING FIXTURES AS SHOWN AND MODIFY WIRING AS NECESSARY TO CONNECT THEM TO THE EXISTING LIGHTING CIRCUITS AND CONTROLS, UNLES OTHERWISE NOTED.
- 4 UNDER ALTERNATE BID, REPLACE EXISTING LIGHTING FIXTURES IN THIS ROOM WITH NEW LIGHTING FIXTURES. CONNECT THE NEW LIGHTING FIXTURES TO THE EXISTING LIGHT SWITCHES UTILIZING THE EXISTING CIRCUITS, UNLESS OTHERWISE NOTED.
- (5) CONNECT NEW EMERGENCY GENERATOR TRANSFER DEVICE TO THE EXISTING EMERGENCY CIRCUIT SERVING THIS AREA SO THAT ON LOSS OF NORMAL POWER TO THE LIGHTING FIXTURE OCCURS, THE POWER TRANSFERS OVER TO THE EMERGENCY CIRCUIT.

M LEGE
ROOM
7TH GRADE
CORRI
SE
7TH GRADE
7TH GRADE
7TH GRADE
7TH GRADE S
EXTENDED
CUSTO
ELECTF
STAFF 1
GIRI
BOY
CONFER
TEACHER
MC/
CORRI
COMPUTE
COMPUTE
COMPUTER AF
PLT
STOR
CORRI

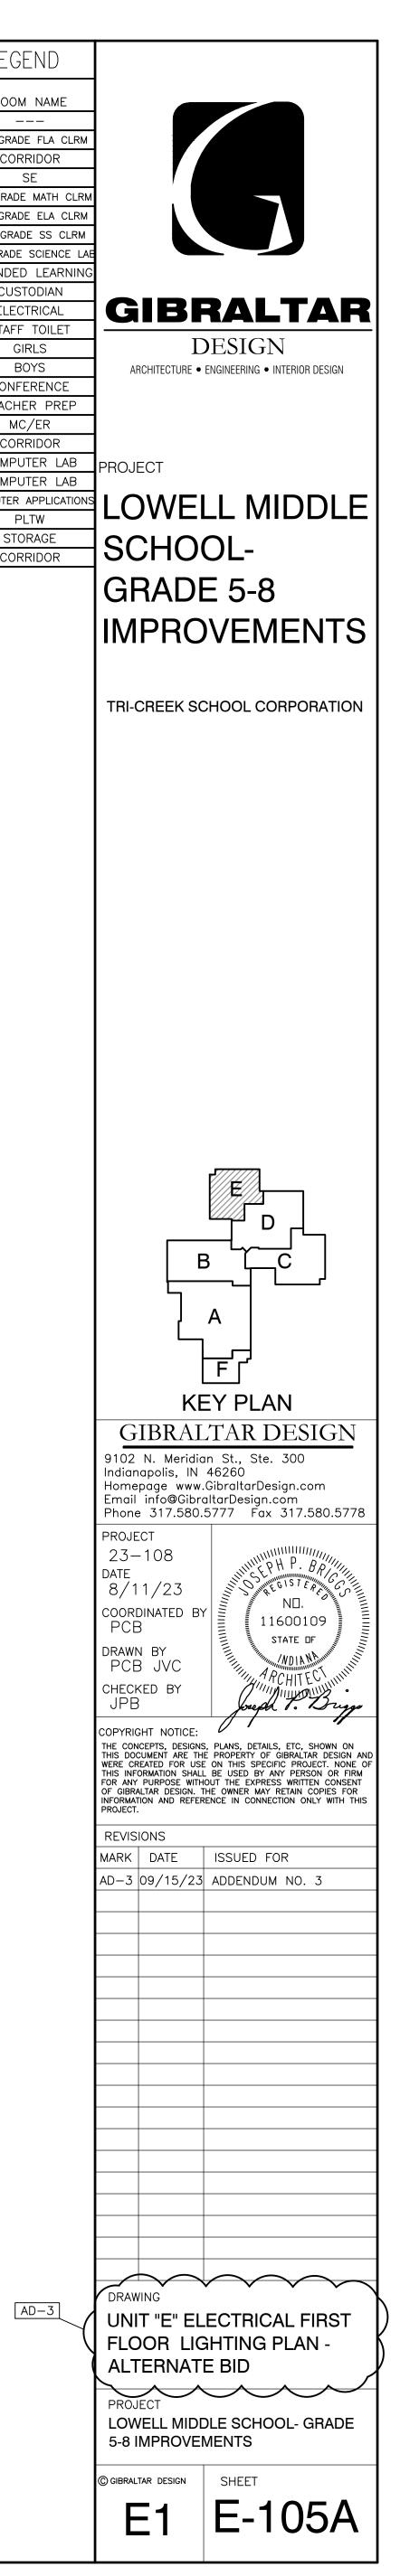

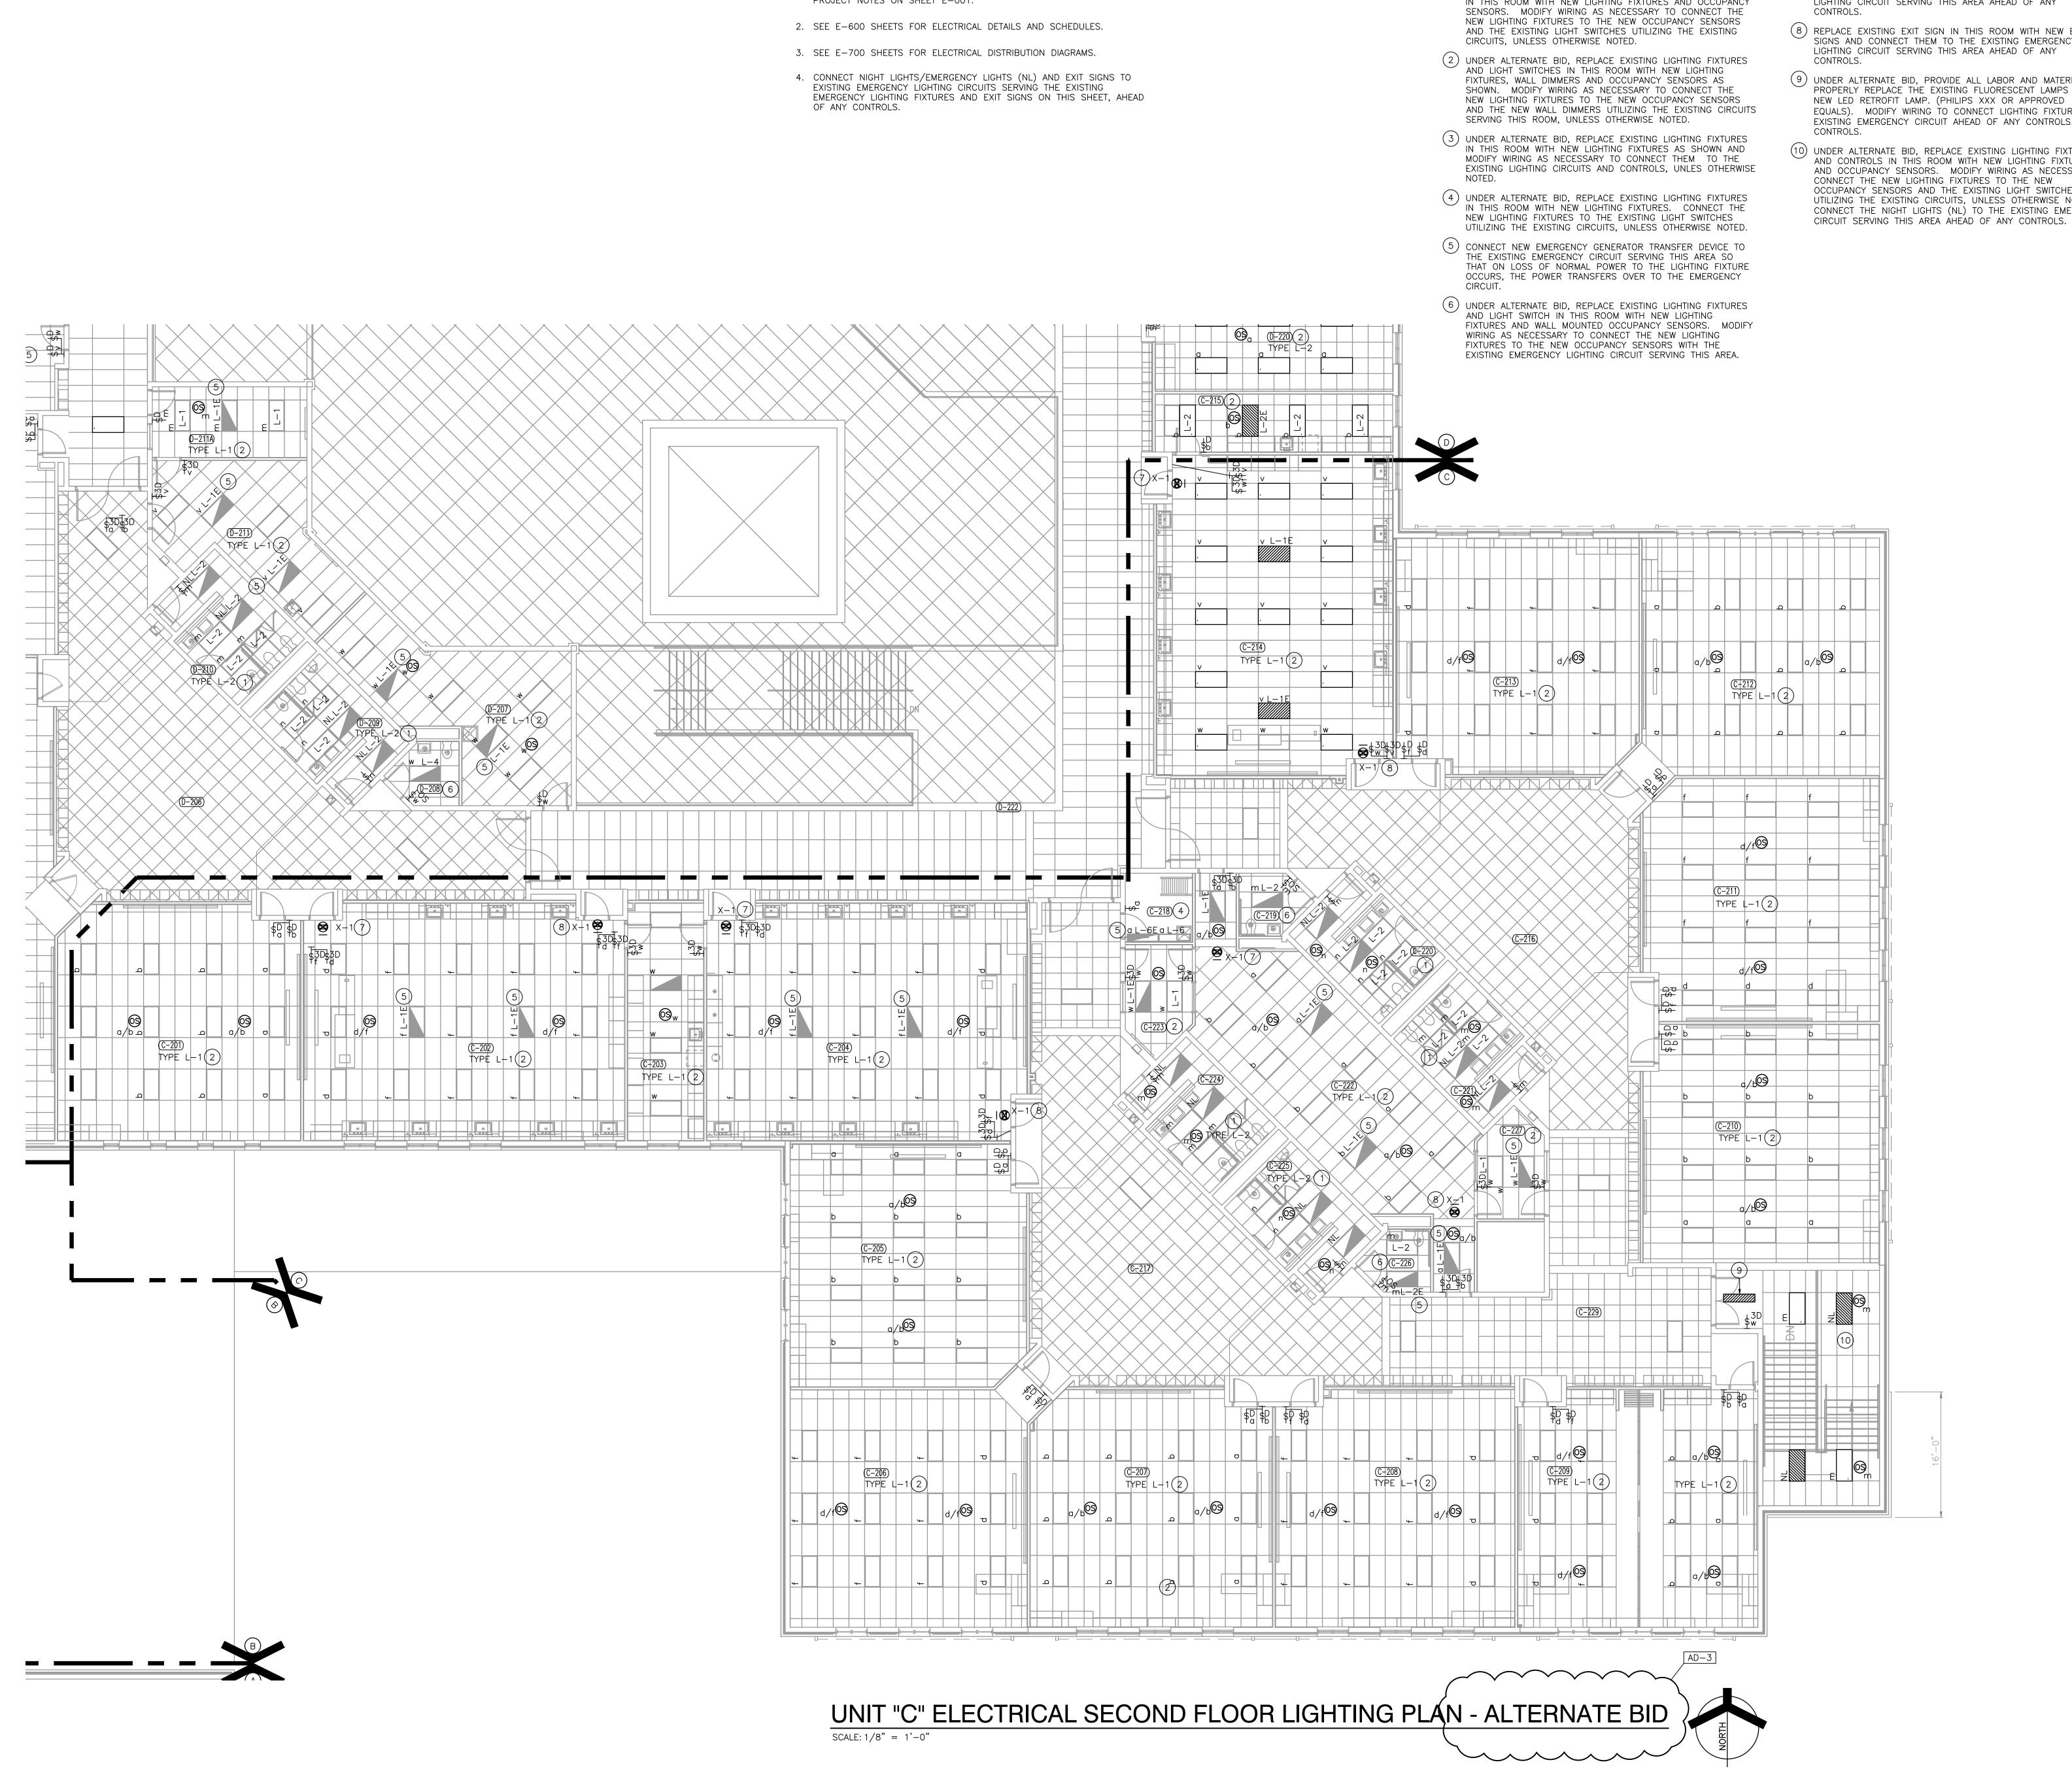


1. FOR ADDITIONAL GENERAL ELECTRICAL NOTES, SEE GENERAL ELECTRICAL PROJECT NOTES ON SHEET E-001.


### **ELECTRICAL PLAN NOTES:** (THESE NOTES APPLY TO THIS SHEET ONLY)


- (1) UNDER ALTERNATE BID, REPLACE EXISTING LIGHTING FIXTURES IN THIS ROOM WITH NEW LIGHTING FIXTURES AND OCCUPANCY

- (7) CONNECT NEW EXIT SIGN TO THE EXISTING EMERGENCY LIGHTING CIRCUIT SERVING THIS AREA AHEAD OF ANY
- (8) REPLACE EXISTING EXIT SIGN IN THIS ROOM WITH NEW EXIT SIGNS AND CONNECT THEM TO THE EXISTING EMERGENCY LIGHTING CIRCUIT SERVING THIS AREA AHEAD OF ANY
- (9) under alternate bid, provide all labor and material to PROPERLY REPLACE THE EXISTING FLUORESCENT LAMPS WITH NEW LED RETROFIT LAMP. (PHILIPS XXX OR APPROVED EQUALS). MODIFY WIRING TO CONNECT LIGHTING FIXTURE TO EXISTING EMERGENCY CIRCUIT AHEAD OF ANY CONTROLS.
- (10) UNDER ALTERNATE BID, REPLACE EXISTING LIGHTING FIXTURES AND CONTROLS IN THIS ROOM WITH NEW LIGHTING FIXTURES AND OCCUPANCY SENSORS. MODIFY WIRING AS NECESSARY TO CONNECT THE NEW LIGHTING FIXTURES TO THE NEW OCCUPANCY SENSORS AND THE EXISTING LIGHT SWITCHES UTILIZING THE EXISTING CIRCUITS, UNLESS OTHERWISE NOTED. CONNECT THE NIGHT LIGHTS (NL) TO THE EXISTING EMERGENCY

ROOI	M LEGEI
ROOM NO.	ROOM
C-201	6TH GRADE
	6TH GRADE
C-202 C-203	PRE
C-203	6TH GRADE
C-205 C-206	6TH GRADE N
C-207	6TH GRADE
C-208	6TH GRADE
C-209	6TH GRADE
C-210 C-211	6TH GRADE
	6TH GRADE
C-212	SE
C-213 C-214	6TH GRADE M
C-215 C-216	STOR
	EXTENDED
C-217	EXTENDED
C-218	CUSTO STAFF 1
C-219	
C-220	BOY
C-221	GIRL
C-222	
C-223	CONFER
C-224 C-225	GIRL
	BOY
C-226	STAFF 1
C = 227	CONFER
C-228	
U-229	CORRI

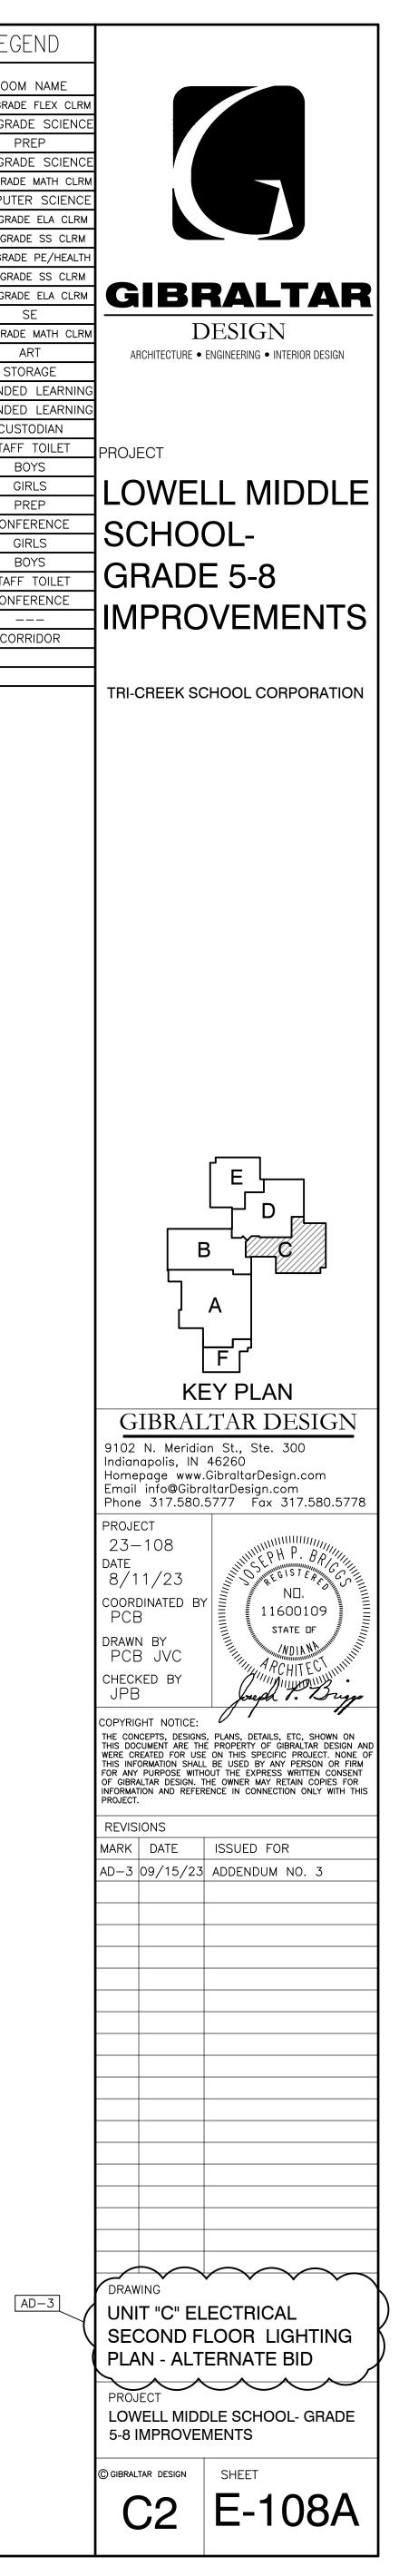

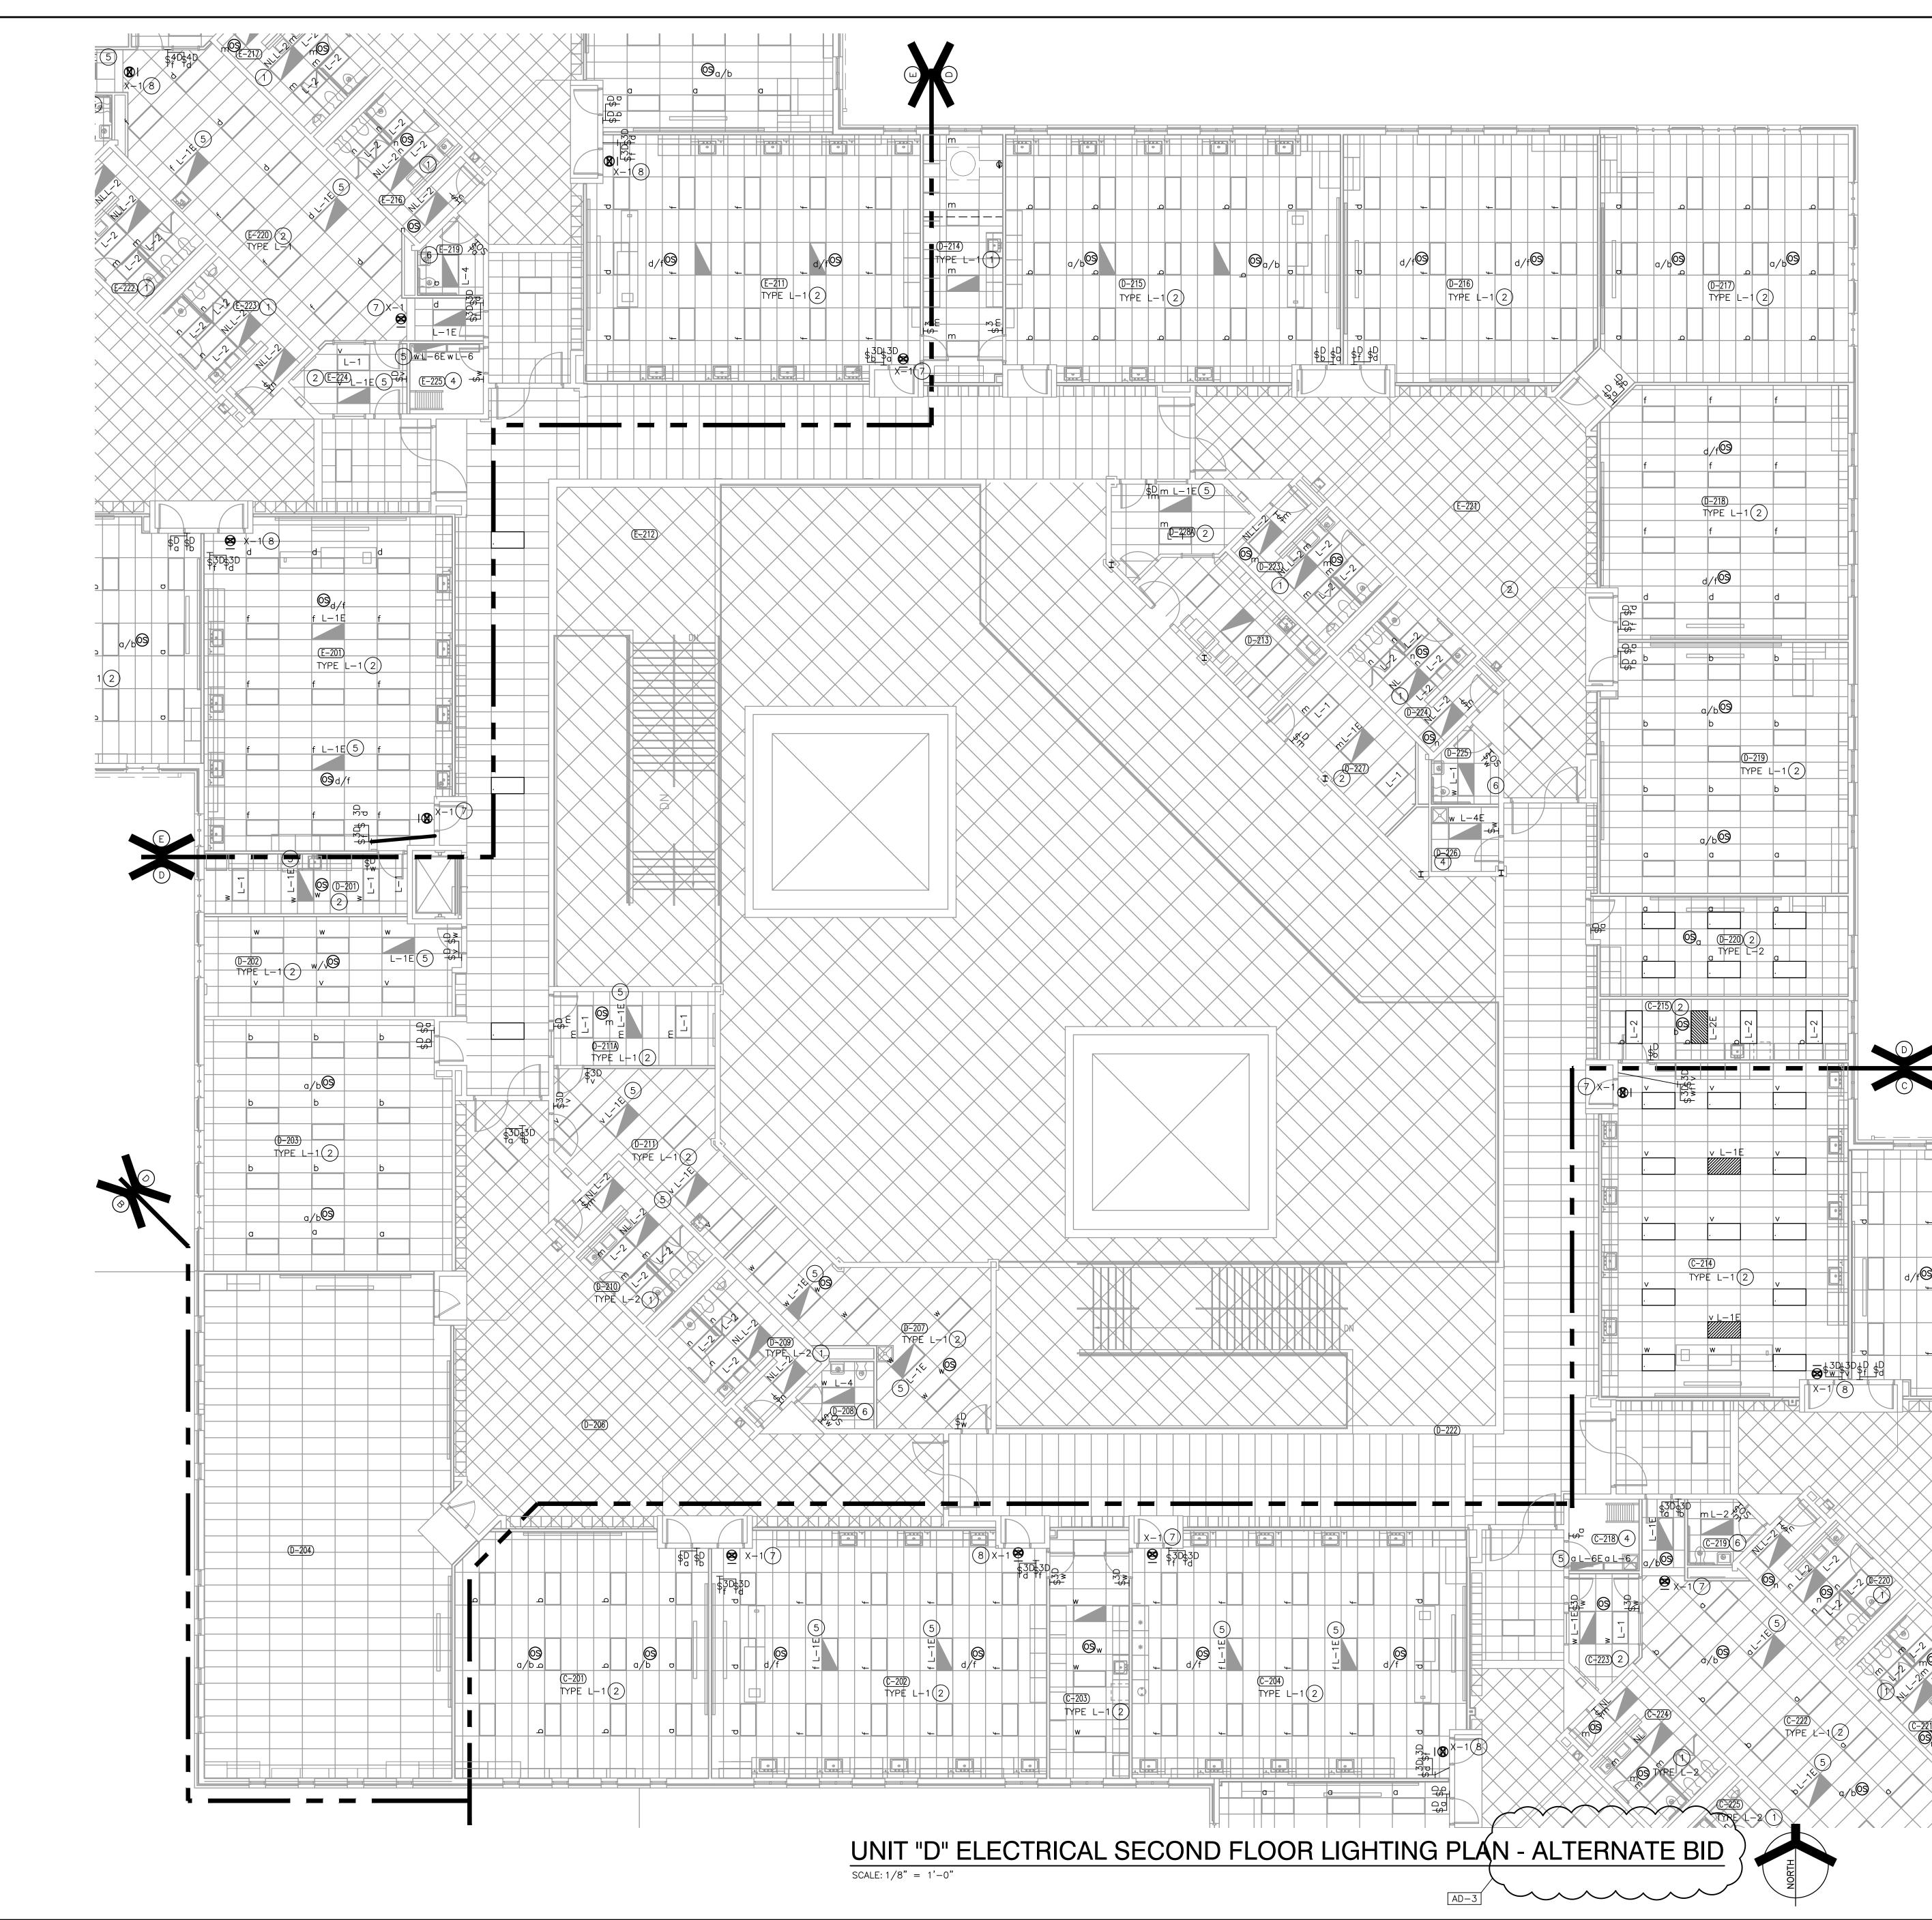


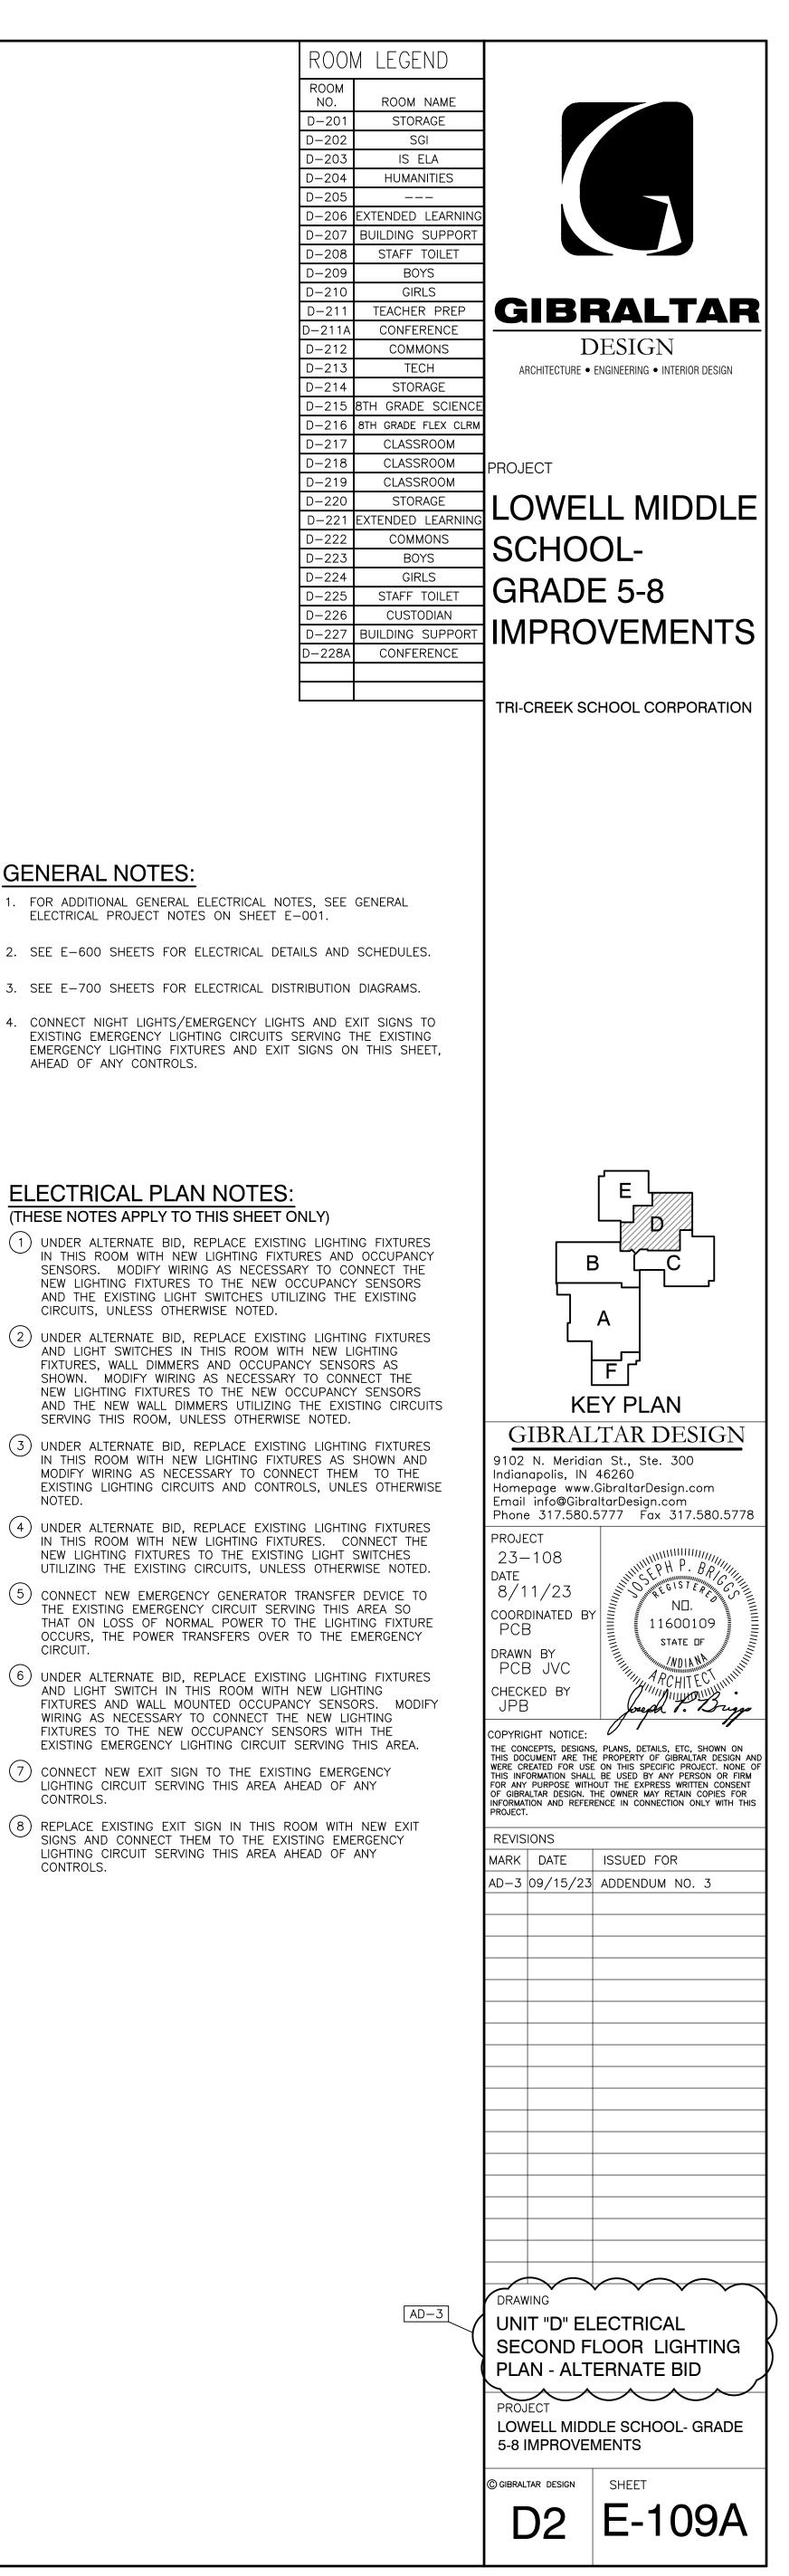

FOR ADDITIONAL GENERAL ELECTRICAL NOTES, SEE GENERAL ELECTRICAL PROJECT NOTES ON SHEET E-001.

- 3. SEE E-700 SHEETS FOR ELECTRICAL DISTRIBUTION DIAGRAMS.
- 4. CONNECT NIGHT LIGHTS/EMERGENCY LIGHTS AND EXIT SIGNS TO EXISTING EMERGENCY LIGHTING CIRCUITS SERVING THE EXISTING EMERGENCY LIGHTING FIXTURES AND EXIT SIGNS ON THIS SHEET, AHEAD OF ANY CONTROLS.


- 1 UNDER ALTERNATE BID, REPLACE EXISTING LIGHTING FIXTURES IN THIS ROOM WITH NEW LIGHTING FIXTURES AND OCCUPANCY SENSORS. MODIFY WIRING AS NECESSARY TO CONNECT THE NEW LIGHTING FIXTURES TO THE NEW OCCUPANCY SENSORS AND THE EXISTING LIGHT SWITCHES UTILIZING THE EXISTING CIRCUITS, UNLESS OTHERWISE NOTED.
- 2 UNDER ALTERNATE BID, REPLACE EXISTING LIGHTING FIXTURES AND LIGHT SWITCHES IN THIS ROOM WITH NEW LIGHTING FIXTURES, WALL DIMMERS AND OCCUPANCY SENSORS AS SHOWN. MODIFY WIRING AS NECESSARY TO CONNECT THE NEW LIGHTING FIXTURES TO THE NEW OCCUPANCY SENSORS AND THE NEW WALL DIMMERS UTILIZING THE EXISTING CIRCUITS SERVING THIS ROOM, UNLESS OTHERWISE NOTED.
- (3) UNDER ALTERNATE BID, REPLACE EXISTING LIGHTING FIXTURES IN THIS ROOM WITH NEW LIGHTING FIXTURES AS SHOWN AND MODIFY WIRING AS NECESSARY TO CONNECT THEM TO THE EXISTING LIGHTING CIRCUITS AND CONTROLS, UNLES OTHERWISE NOTED.
- (4) UNDER ALTERNATE BID, REPLACE EXISTING LIGHTING FIXTURES IN THIS ROOM WITH NEW LIGHTING FIXTURES. CONNECT THE NEW LIGHTING FIXTURES TO THE EXISTING LIGHT SWITCHES UTILIZING THE EXISTING CIRCUITS, UNLESS OTHERWISE NOTED.
- 5) CONNECT NEW EMERGENCY GENERATOR TRANSFER DEVICE TO THE EXISTING EMERGENCY CIRCUIT SERVING THIS AREA SO THAT ON LOSS OF NORMAL POWER TO THE LIGHTING FIXTURE OCCURS, THE POWER TRANSFERS OVER TO THE EMERGENCY CIRCUIT.
- 6 UNDER ALTERNATE BID, REPLACE EXISTING LIGHTING FIXTURES AND LIGHT SWITCH IN THIS ROOM WITH NEW LIGHTING FIXTURES AND WALL MOUNTED OCCUPANCY SENSORS. MODIFY WIRING AS NECESSARY TO CONNECT THE NEW LIGHTING FIXTURES TO THE NEW OCCUPANCY SENSORS WITH THE EXISTING EMERGENCY LIGHTING CIRCUIT SERVING THIS AREA.
- 7) CONNECT NEW EXIT SIGN TO THE EXISTING EMERGENCY LIGHTING CIRCUIT SERVING THIS AREA AHEAD OF ANY CONTROLS.
- (8) REPLACE EXISTING EXIT SIGN IN THIS ROOM WITH NEW EXIT SIGNS AND CONNECT THEM TO THE EXISTING EMERGENCY LIGHTING CIRCUIT SERVING THIS AREA AHEAD OF ANY CONTROLS.

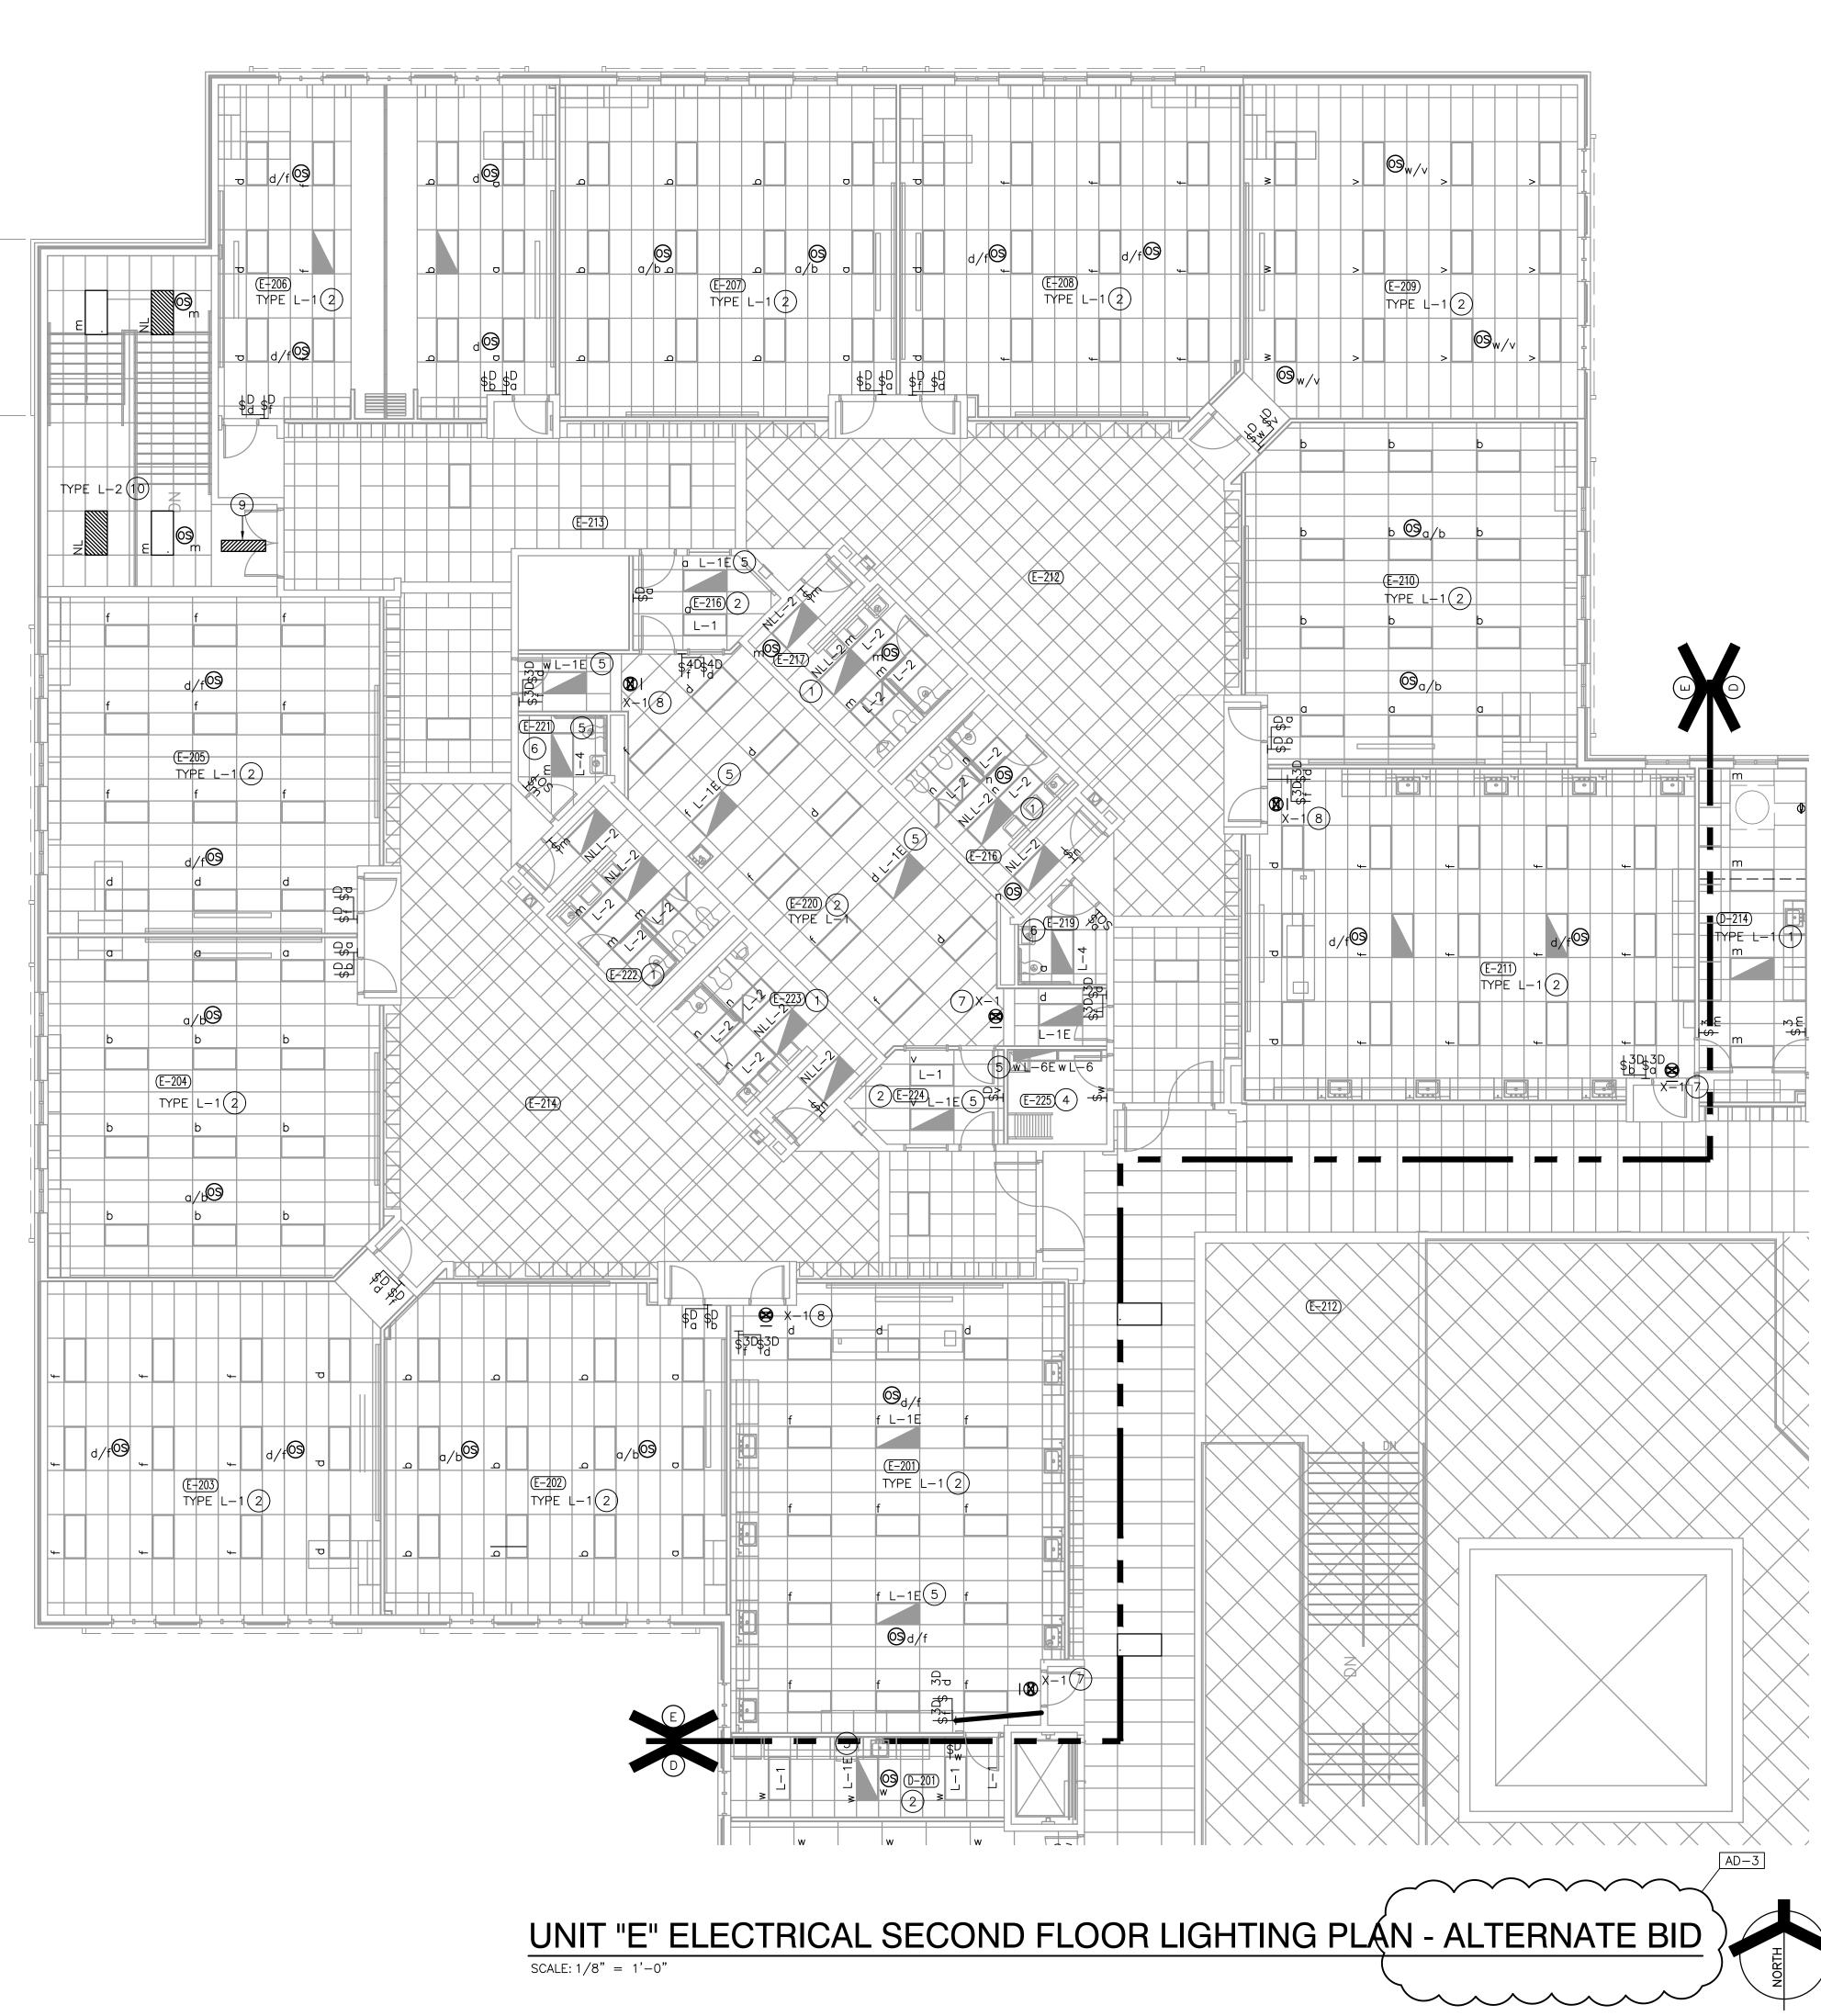


PROJECT NOTES ON SHEET E-001.

- 1. FOR ADDITIONAL GENERAL ELECTRICAL NOTES, SEE GENERAL ELECTRICAL
- 2. SEE E-600 SHEETS FOR ELECTRICAL DETAILS AND SCHEDULES.
- 3. SEE E-700 SHEETS FOR ELECTRICAL DISTRIBUTION DIAGRAMS. 4. CONNECT NIGHT LIGHTS/EMERGENCY LIGHTS AND EXIT SIGNS TO
- EXISTING EMERGENCY LIGHTING CIRCUITS SERVING THE EXISTING EMERGENCY LIGHTING FIXTURES AND EXIT SIGNS ON THIS SHEET, AHEAD OF ANY CONTROLS.


- (1) UNDER ALTERNATE BID, REPLACE EXISTING LIGHTING FIXTURES IN THIS ROOM WITH NEW LIGHTING FIXTURES AND OCCUPANCY SENSORS. MODIFY WIRING AS NECESSARY TO CONNECT THE NEW LIGHTING FIXTURES TO THE NEW OCCUPANCY SENSORS AND THE EXISTING LIGHT SWITCHES UTILIZING THE EXISTING CIRCUITS, UNLESS OTHERWISE NOTED.
- (2) UNDER ALTERNATE BID, REPLACE EXISTING LIGHTING FIXTURES AND LIGHT SWITCHES IN THIS ROOM WITH NEW LIGHTING FIXTURES, WALL DIMMERS AND OCCUPANCY SENSORS AS SHOWN. MODIFY WIRING AS NECESSARY TO CONNECT THE NEW LIGHTING FIXTURES TO THE NEW OCCUPANCY SENSORS AND THE NEW WALL DIMMERS UTILIZING THE EXISTING CIRCUITS SERVING THIS ROOM, UNLESS OTHERWISE NOTED.
- (3) UNDER ALTERNATE BID, REPLACE EXISTING LIGHTING FIXTURES IN THIS ROOM WITH NEW LIGHTING FIXTURES AS SHOWN AND MODIFY WIRING AS NECESSARY TO CONNECT THEM TO THE EXISTING LIGHTING CIRCUITS AND CONTROLS, UNLES OTHERWISE NOTED.
- (4) UNDER ALTERNATE BID, REPLACE EXISTING LIGHTING FIXTURES IN THIS ROOM WITH NEW LIGHTING FIXTURES. CONNECT THE NEW LIGHTING FIXTURES TO THE EXISTING LIGHT SWITCHES UTILIZING THE EXISTING CIRCUITS, UNLESS OTHERWISE NOTED.
- (5) CONNECT NEW EMERGENCY GENERATOR TRANSFER DEVICE TO THE EXISTING EMERGENCY CIRCUIT SERVING THIS AREA SO THAT ON LOSS OF NORMAL POWER TO THE LIGHTING FIXTURE OCCURS, THE POWER TRANSFERS OVER TO THE EMERGENCY CIRCUIT.
- (6) UNDER ALTERNATE BID, REPLACE EXISTING LIGHTING FIXTURES AND LIGHT SWITCH IN THIS ROOM WITH NEW LIGHTING FIXTURES AND WALL MOUNTED OCCUPANCY SENSORS. MODIFY WIRING AS NECESSARY TO CONNECT THE NEW LIGHTING FIXTURES TO THE NEW OCCUPANCY SENSORS WITH THE EXISTING EMERGENCY LIGHTING CIRCUIT SERVING THIS AREA.
- (7) CONNECT NEW EXIT SIGN TO THE EXISTING EMERGENCY LIGHTING CIRCUIT SERVING THIS AREA AHEAD OF ANY CONTROLS.
- (8) REPLACE EXISTING EXIT SIGN IN THIS ROOM WITH NEW EXIT SIGNS AND CONNECT THEM TO THE EXISTING EMERGENCY LIGHTING CIRCUIT SERVING THIS AREA AHEAD OF ANY CONTROLS.
- 9 UNDER ALTERNATE BID, PROVIDE ALL LABOR AND MATERIAL TO PROPERLY REPLACE THE EXISTING FLUORESCENT LAMPS WITH NEW LED RETROFIT LAMP. (PHILIPS XXX OR APPROVED EQUALS). MODIFY WIRING TO CONNECT LIGHTING FIXTURE TO EXISTING EMERGENCY CIRCUIT AHEAD OF ANY CONTROLS. CONTROLS.
- (10) UNDER ALTERNATE BID, REPLACE EXISTING LIGHTING FIXTURES AND CONTROLS IN THIS ROOM WITH NEW LIGHTING FIXTURES AND OCCUPANCY SENSORS. MODIFY WIRING AS NECESSARY TO CONNECT THE NEW LIGHTING FIXTURES TO THE NEW OCCUPANCY SENSORS AND THE EXISTING LIGHT SWITCHES UTILIZING THE EXISTING CIRCUITS, UNLESS OTHERWISE NOTED. CONNECT THE NIGHT LIGHTS (NL) TO THE EXISTING EMERGENCY CIRCUIT SERVING THIS AREA AHEAD OF ANY CONTROLS.

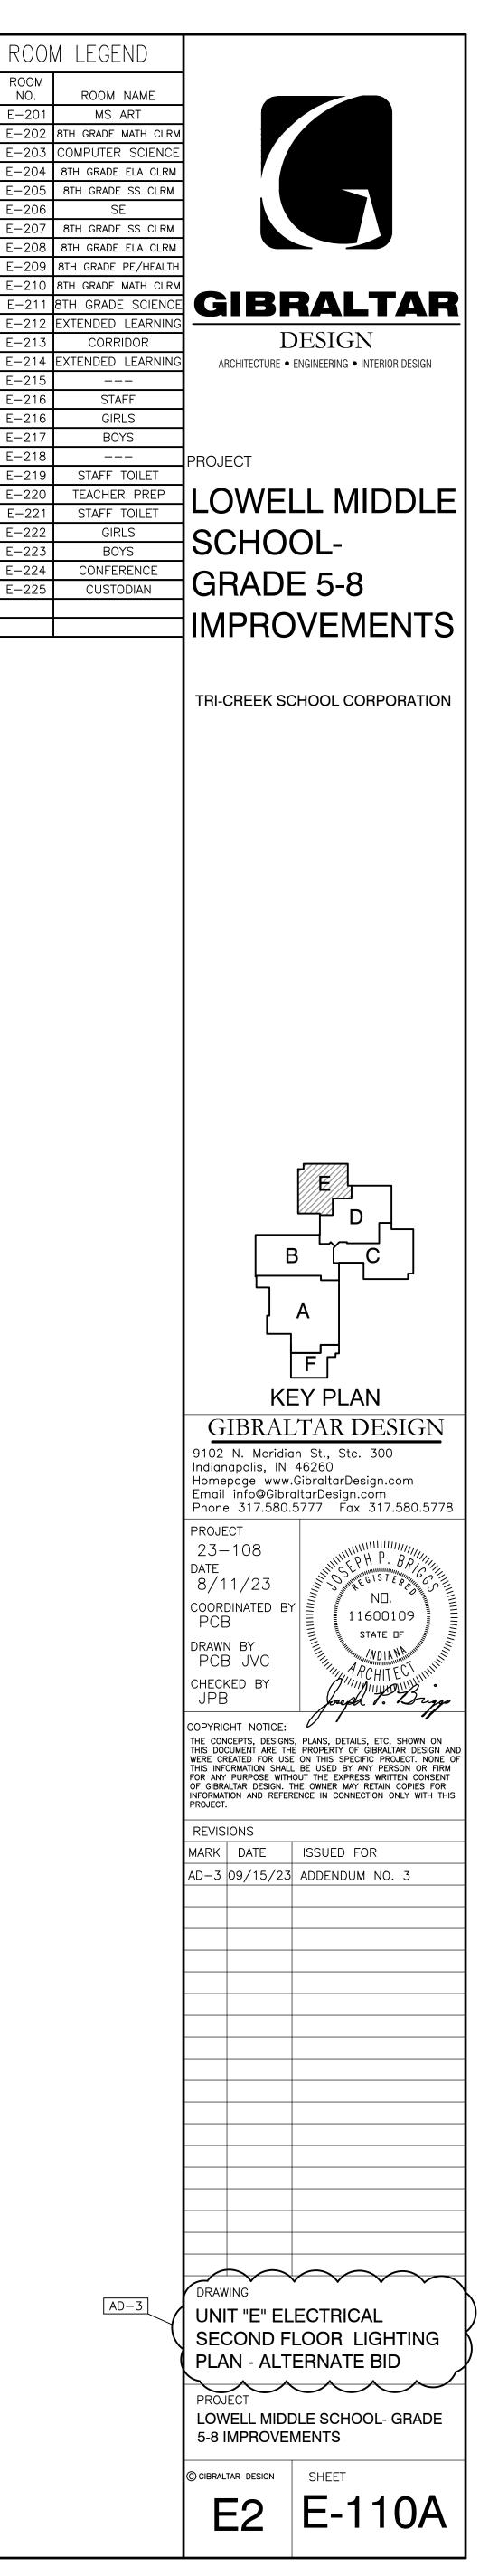

1y, 9/14/2023 – 7:08 PM – LAST SAVED BY 108 TRI-CREEK SC – LOWELL MS 5–8 EMENTS\23–108 DRAWINGS\09 ELEC\E-111A.

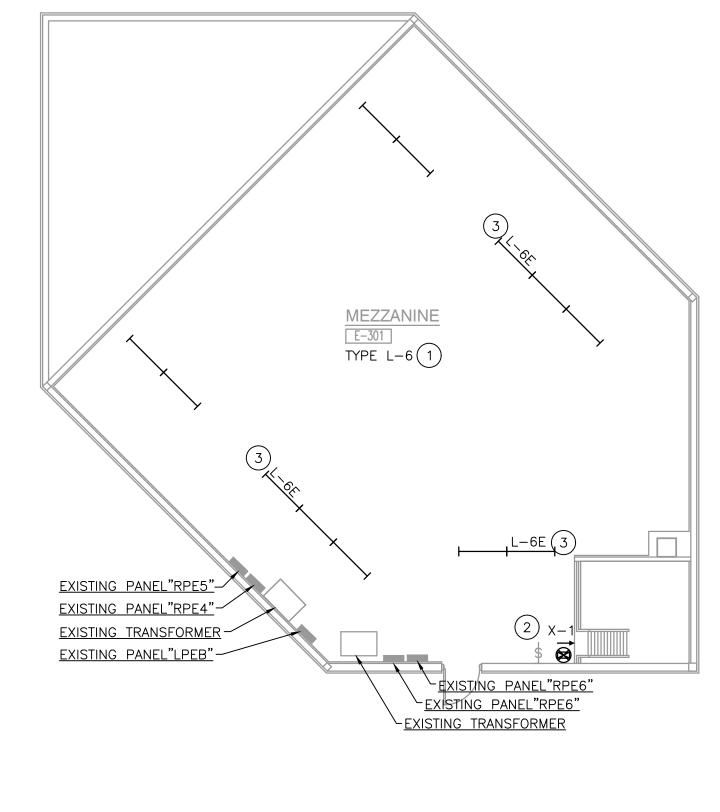



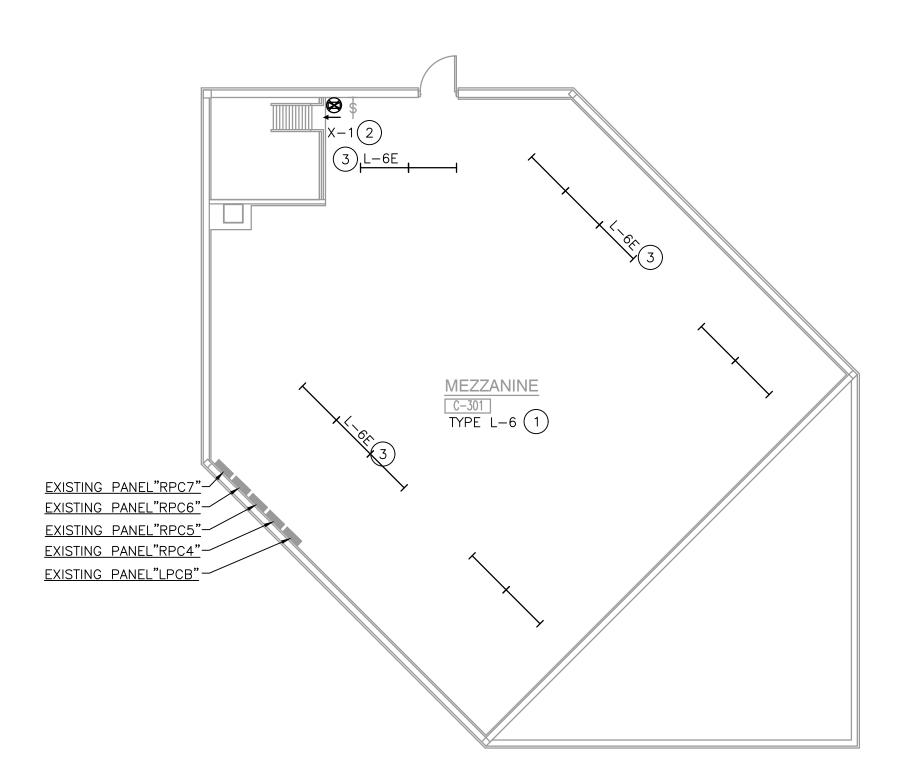





# **GENERAL NOTES:**


- FOR ADDITIONAL GENERAL ELECTRICAL NOTES, SEE GENERAL ELECTRICAL PROJECT NOTES ON SHEET E-001.
- 2. SEE E-600 SHEETS FOR ELECTRICAL DETAILS AND SCHEDULES.
- 3. SEE E-700 SHEETS FOR ELECTRICAL DISTRIBUTION DIAGRAMS.
- 4. CONNECT NIGHT LIGHTS/EMERGENCY LIGHTS AND EXIT SIGNS TO EXISTING EMERGENCY LIGHTING CIRCUITS SERVING THE EXISTING EMERGENCY LIGHTING FIXTURES AND EXIT SIGNS ON THIS SHEET, AHEAD OF ANY CONTROLS.


# **ELECTRICAL PLAN NOTES:**

- (THESE NOTES APPLY TO THIS SHEET ONLY) 1 UNDER ALTERNATE BID, REPLACE EXISTING LIGHTING FIXTURES IN THIS ROOM WITH NEW LIGHTING FIXTURES. CONNECT THE NEW LIGHTING FIXTURES TO THE EXISTING LIGHT SWITCHES UTILIZING THE EXISTING CIRCUITS.
- 2 CONNECT THE EXIT SIGNS IN THIS ROOM TO EXISTING EMERGENCY LIGHTING CIRCUITS SERVING THE EXISTING EMERGENCY LIGHTING FIXTURES AND EXIT SIGNS IN THIS UNIT AHEAD OF ANY CONTROLS.
- (3) connect the emergency generator transfer device on this LIGHTING FIXTURE TO THE EXISTING EMERGENCY LIGHTING CIRCUITS SERVING THE EXISTING EMERGENCY LIGHTING FIXTURES IN THIS UNIT SO THAT WHEN THE LIGHTING FIXTURE SENSES LOSS OF NORMAL POWER, IT TRANSFERS TO THE EMERGENCY CIRCUIT.

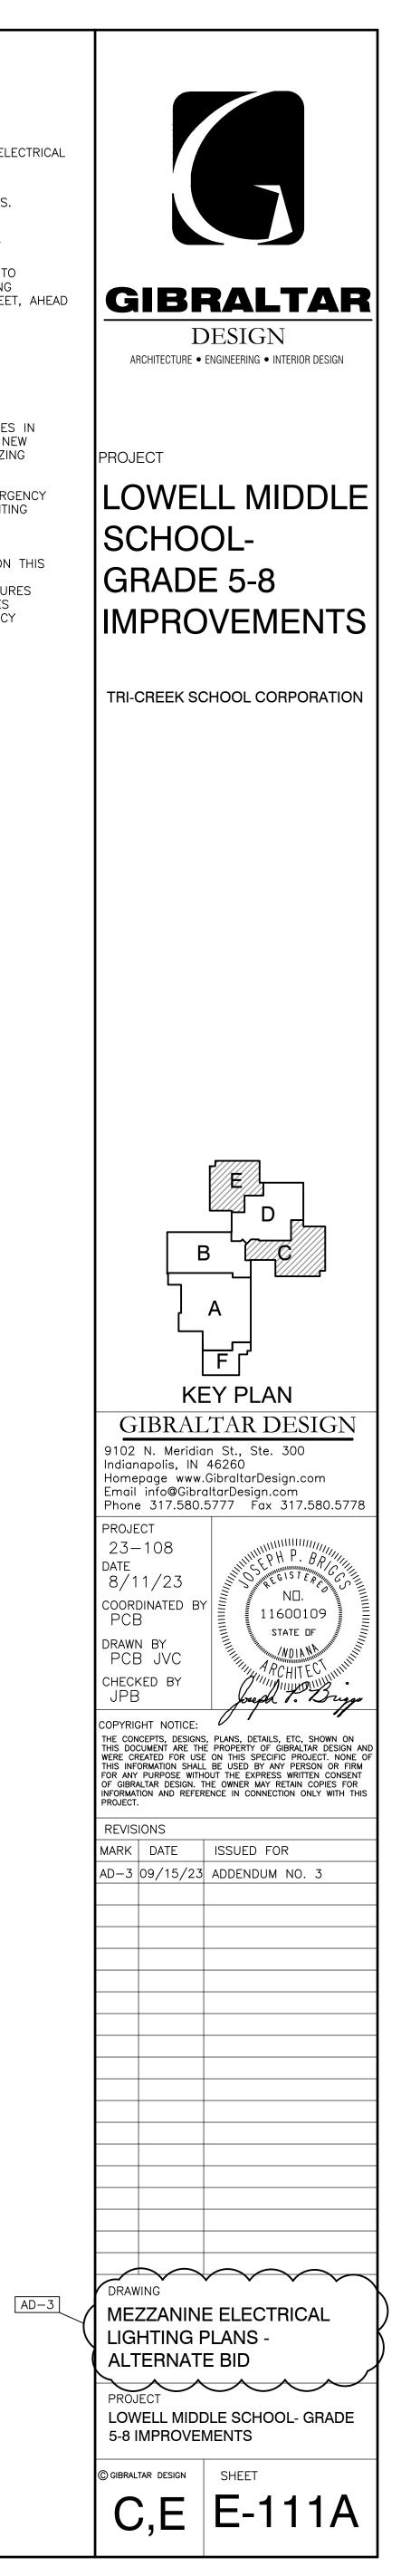

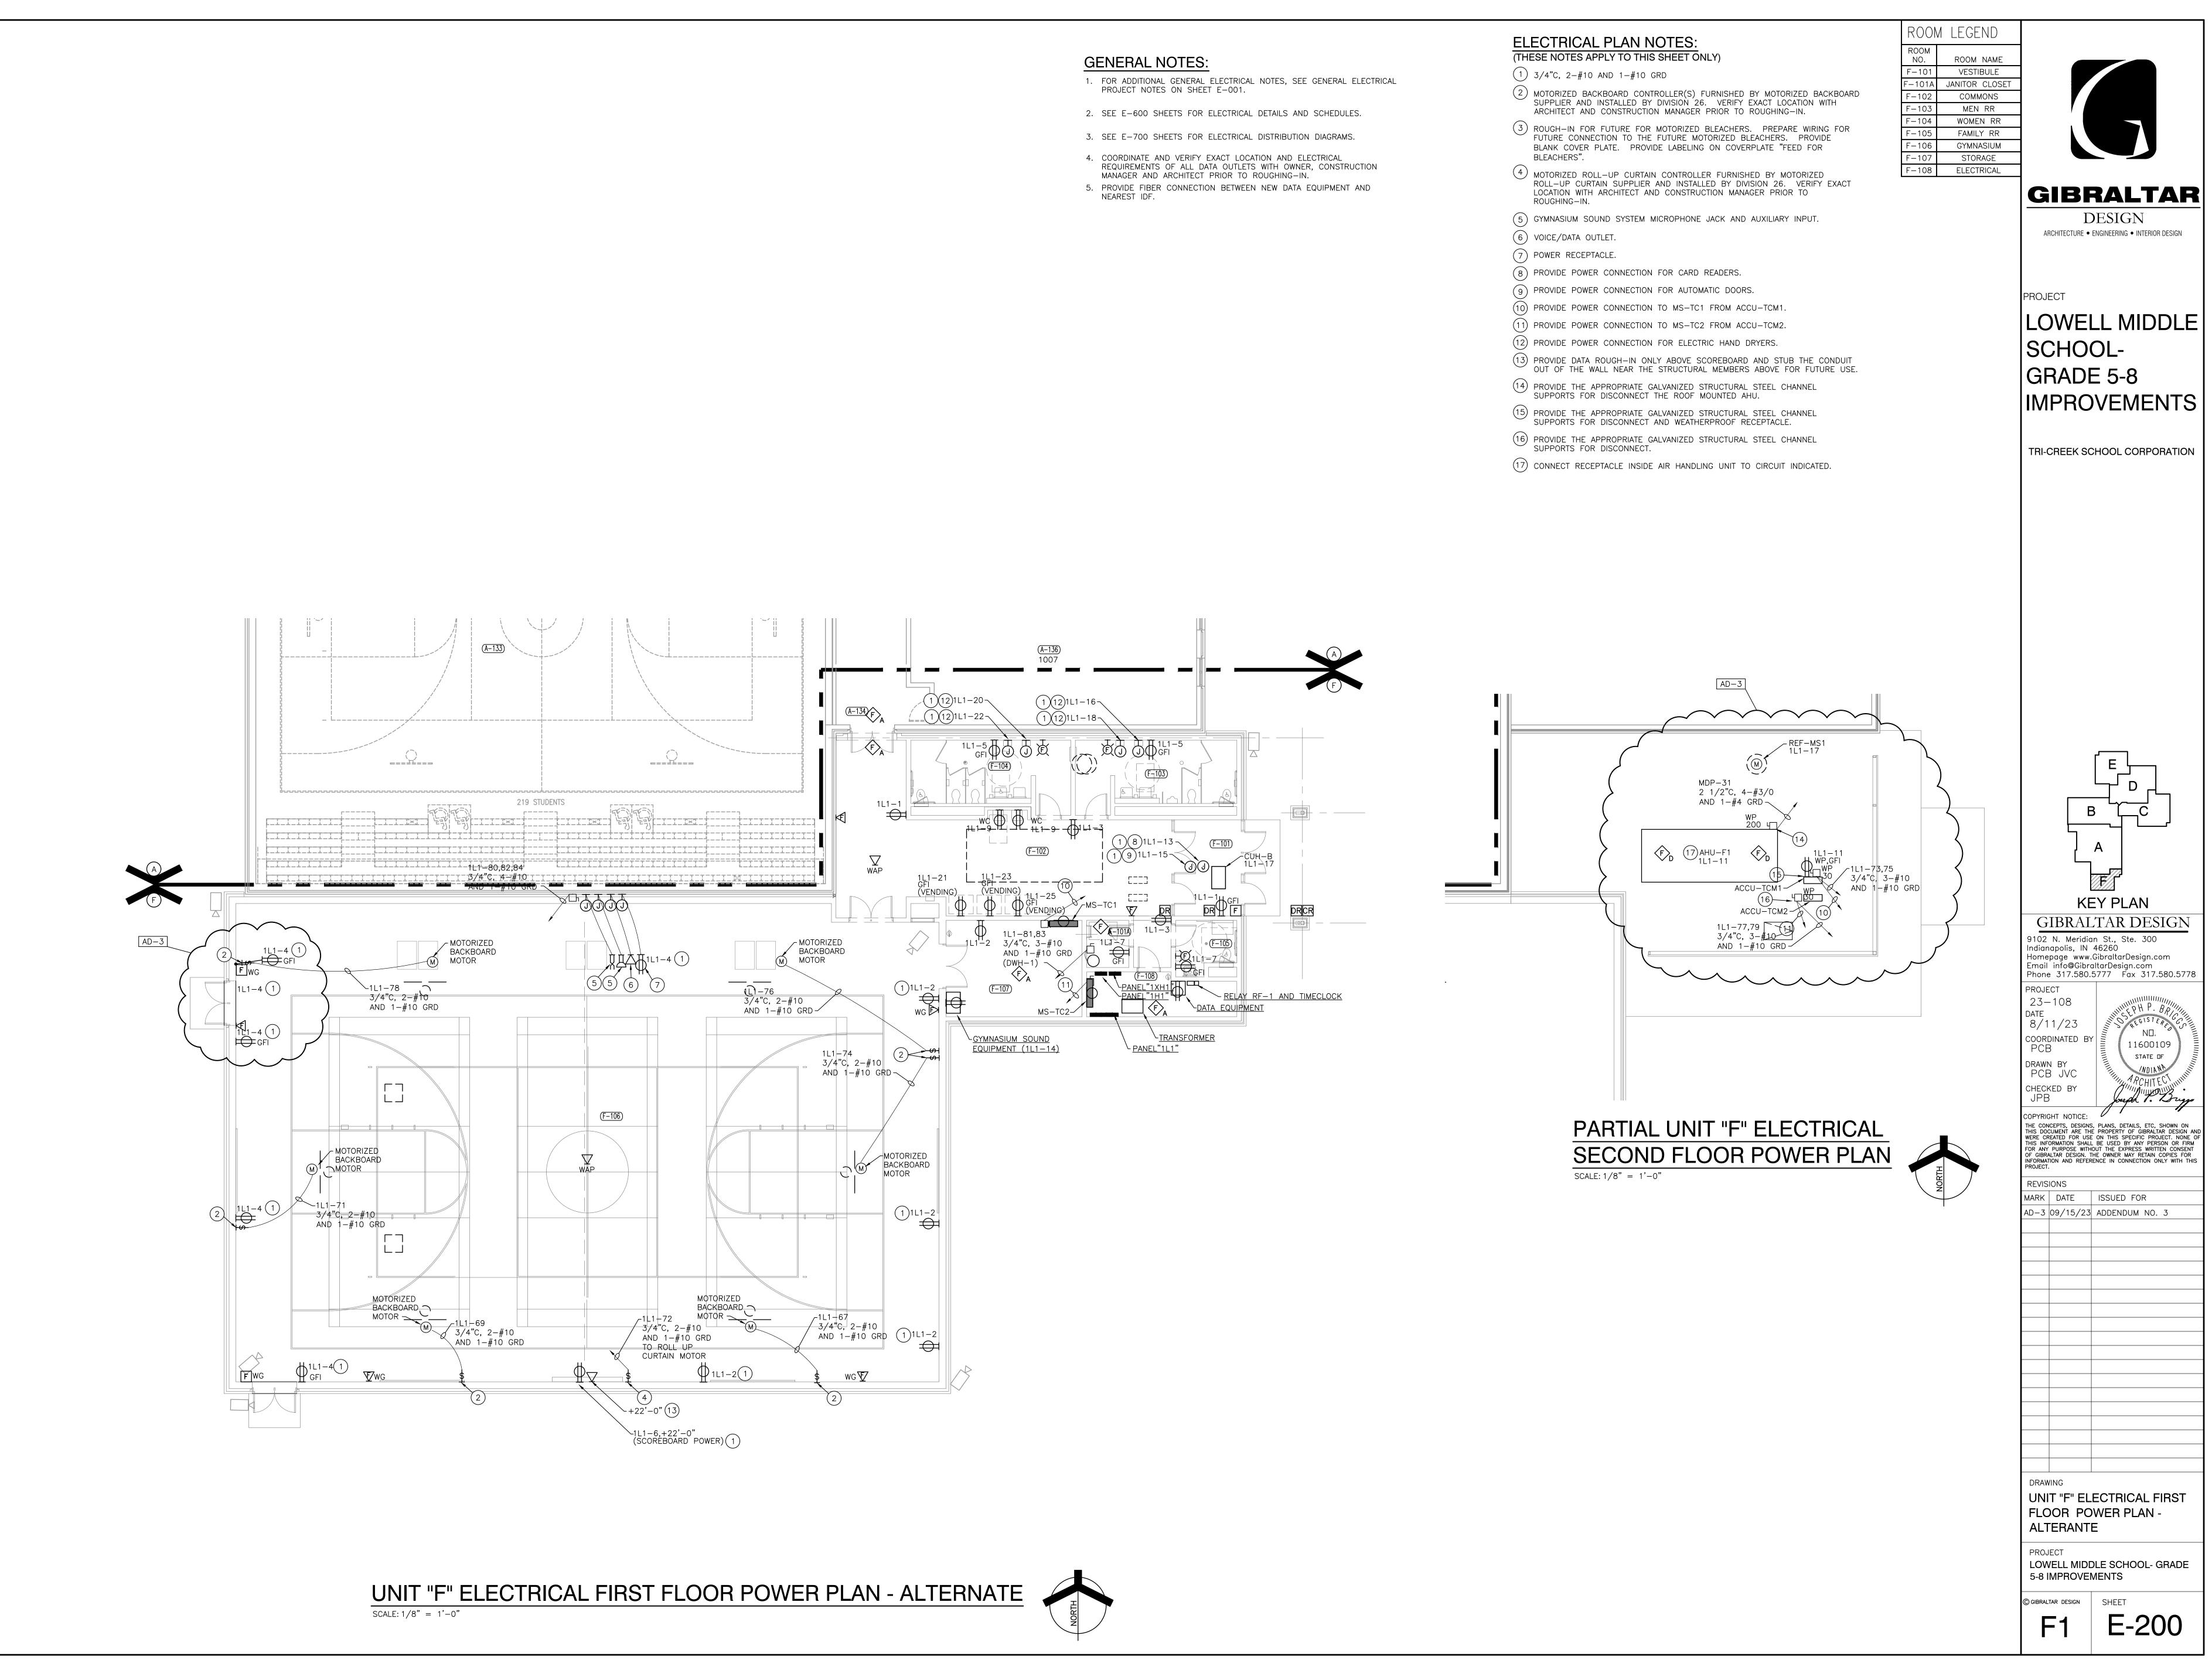


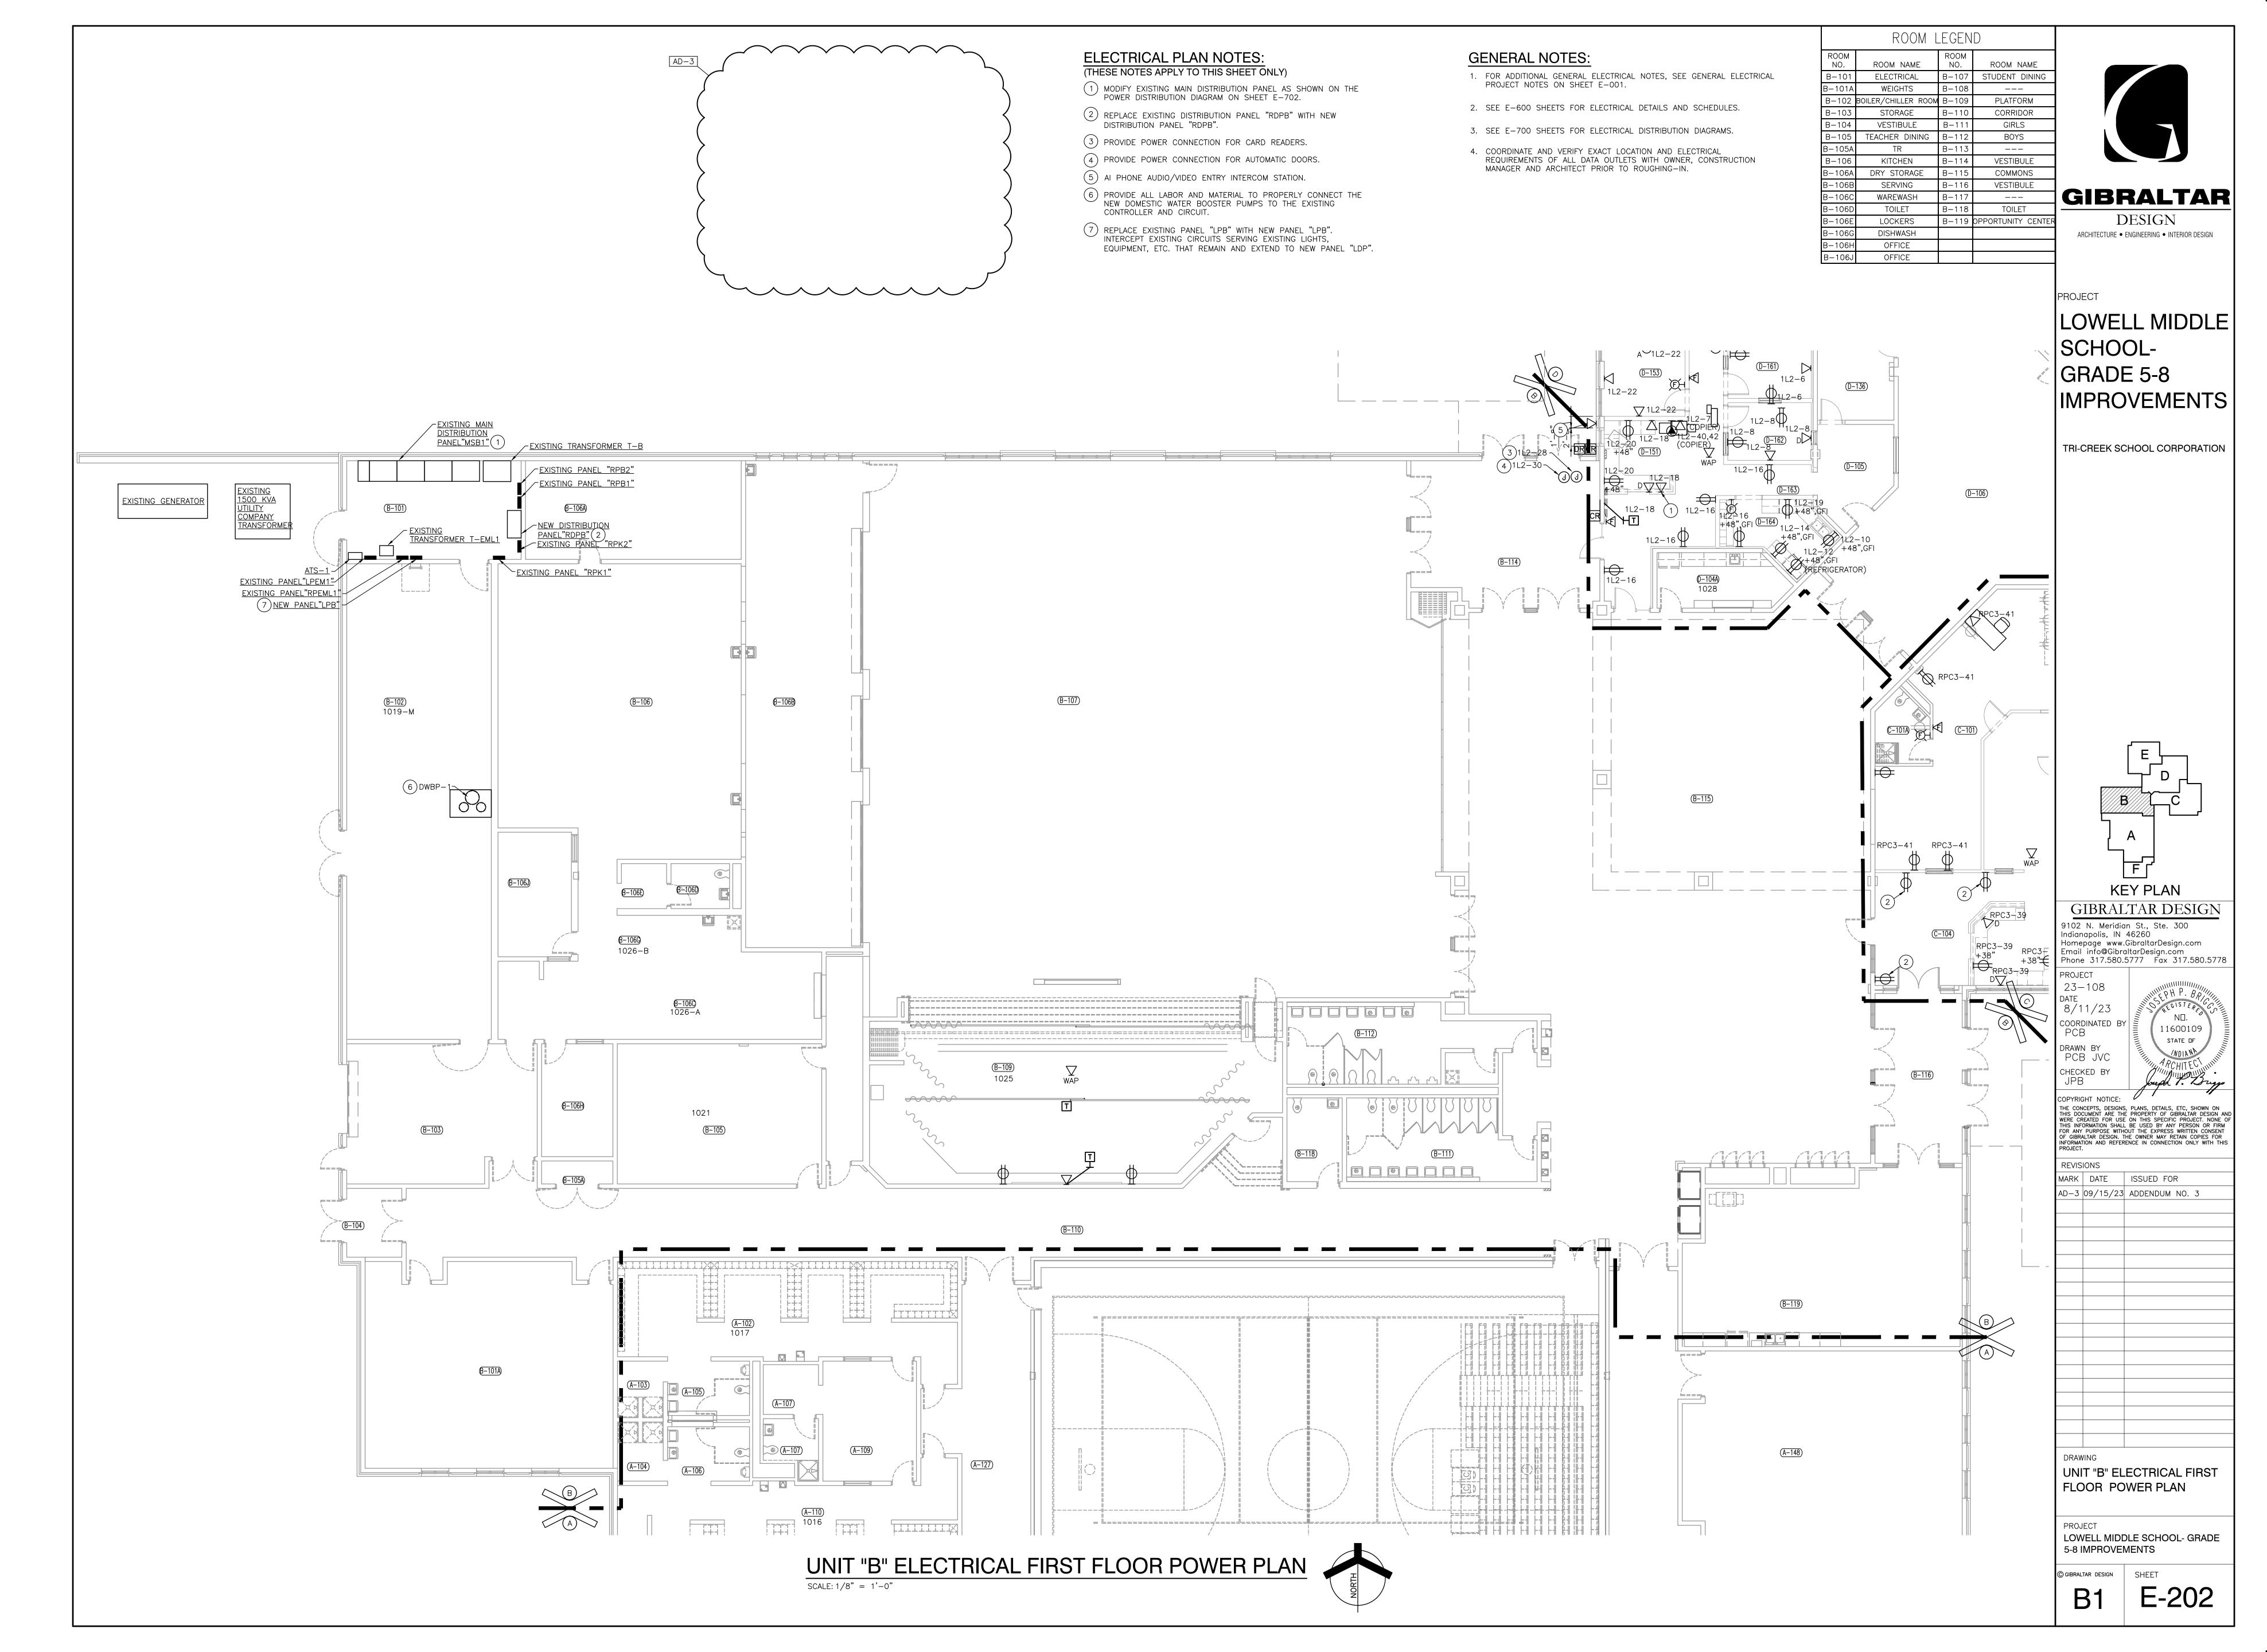


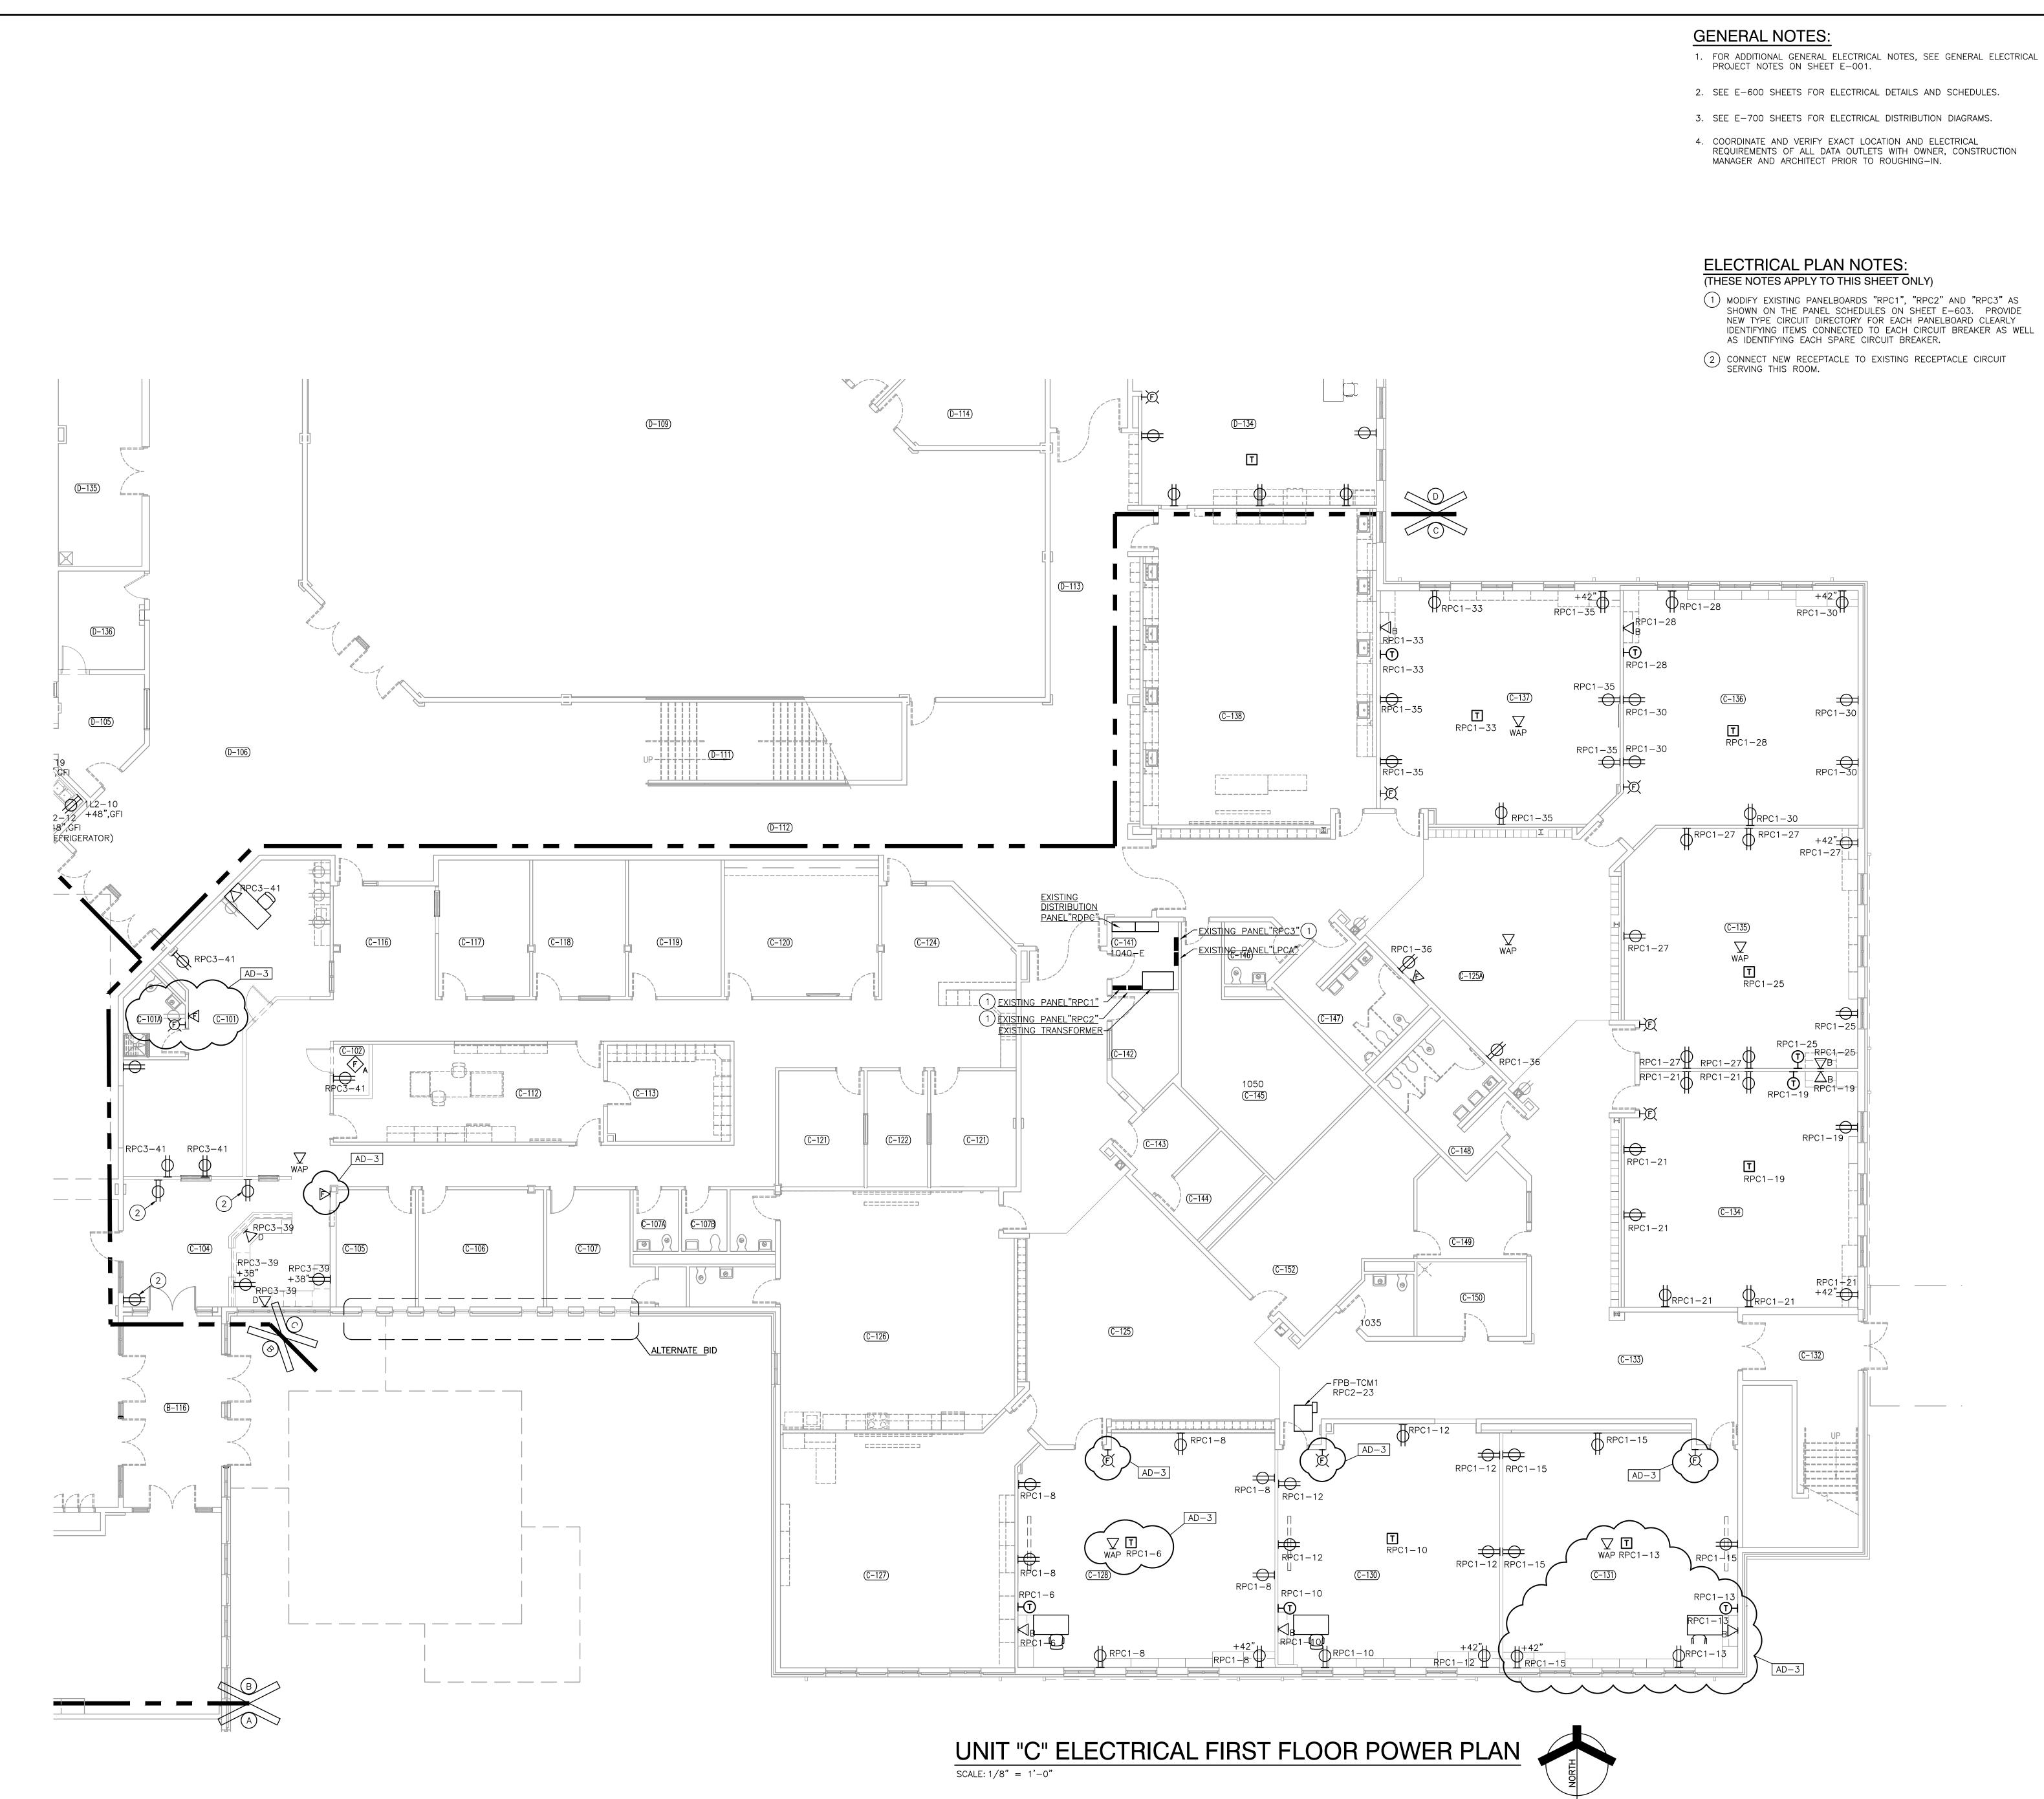

- REQUIREMENTS OF ALL DATA OUTLETS WITH OWNER, CONSTRUCTION MANAGER AND ARCHITECT PRIOR TO ROUGHING-IN.


- (1) MODIFY EXISTING PANELBOARDS "RPC1", "RPC2" AND "RPC3" AS SHOWN ON THE PANEL SCHEDULES ON SHEET E-603. PROVIDE NEW TYPE CIRCUIT DIRECTORY FOR EACH PANELBOARD CLEARLY IDENTIFYING ITEMS CONNECTED TO EACH CIRCUIT BREAKER AS WELL AS IDENTIFYING EACH SPARE CIRCUIT BREAKER.

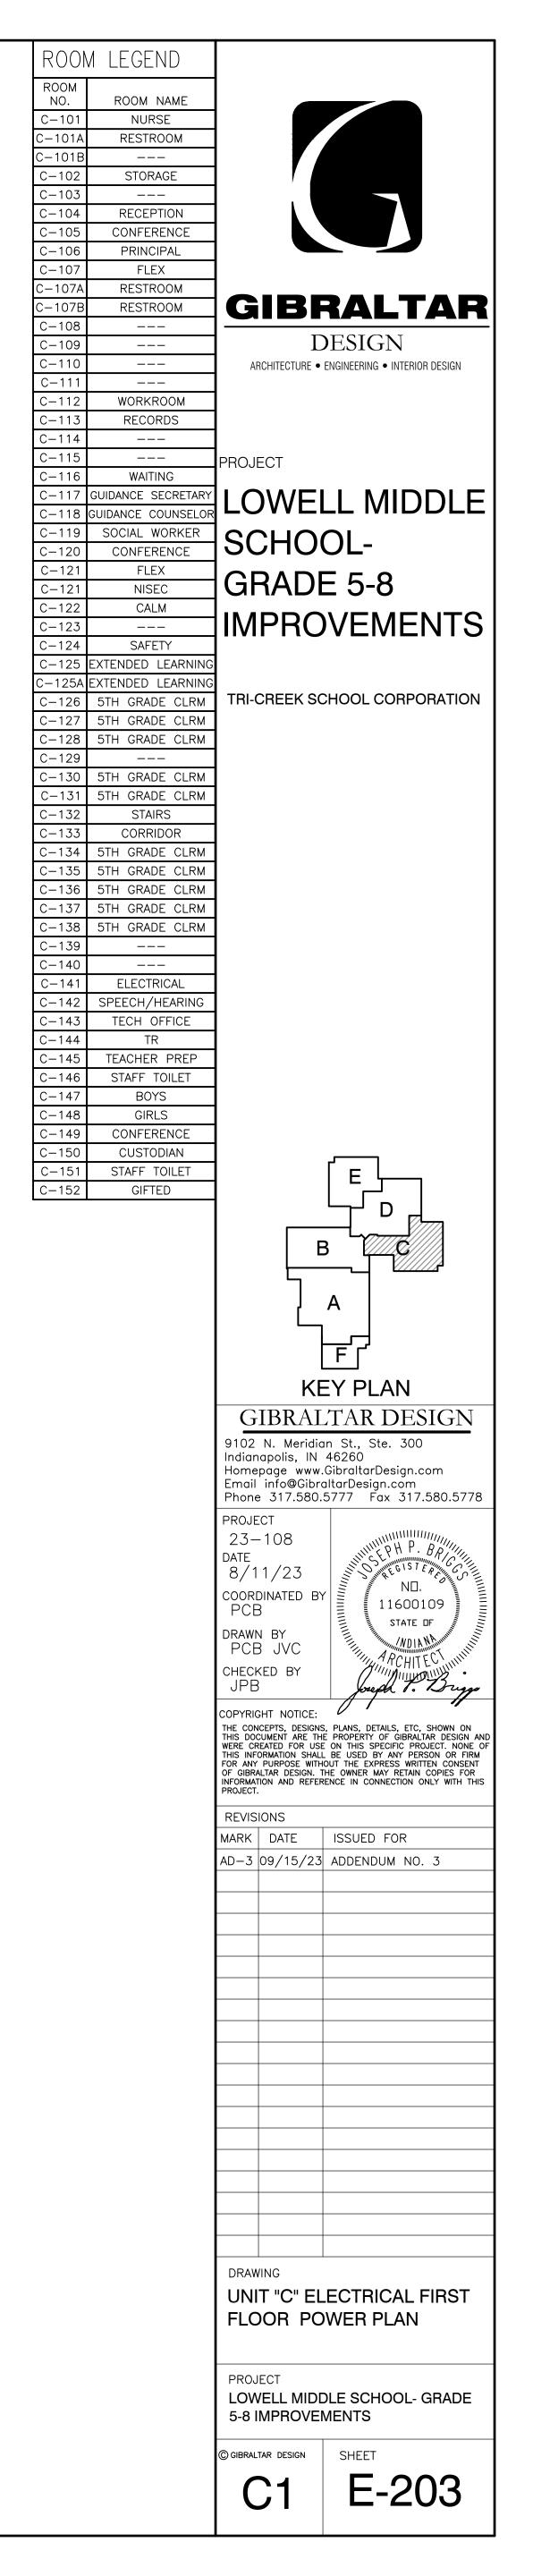

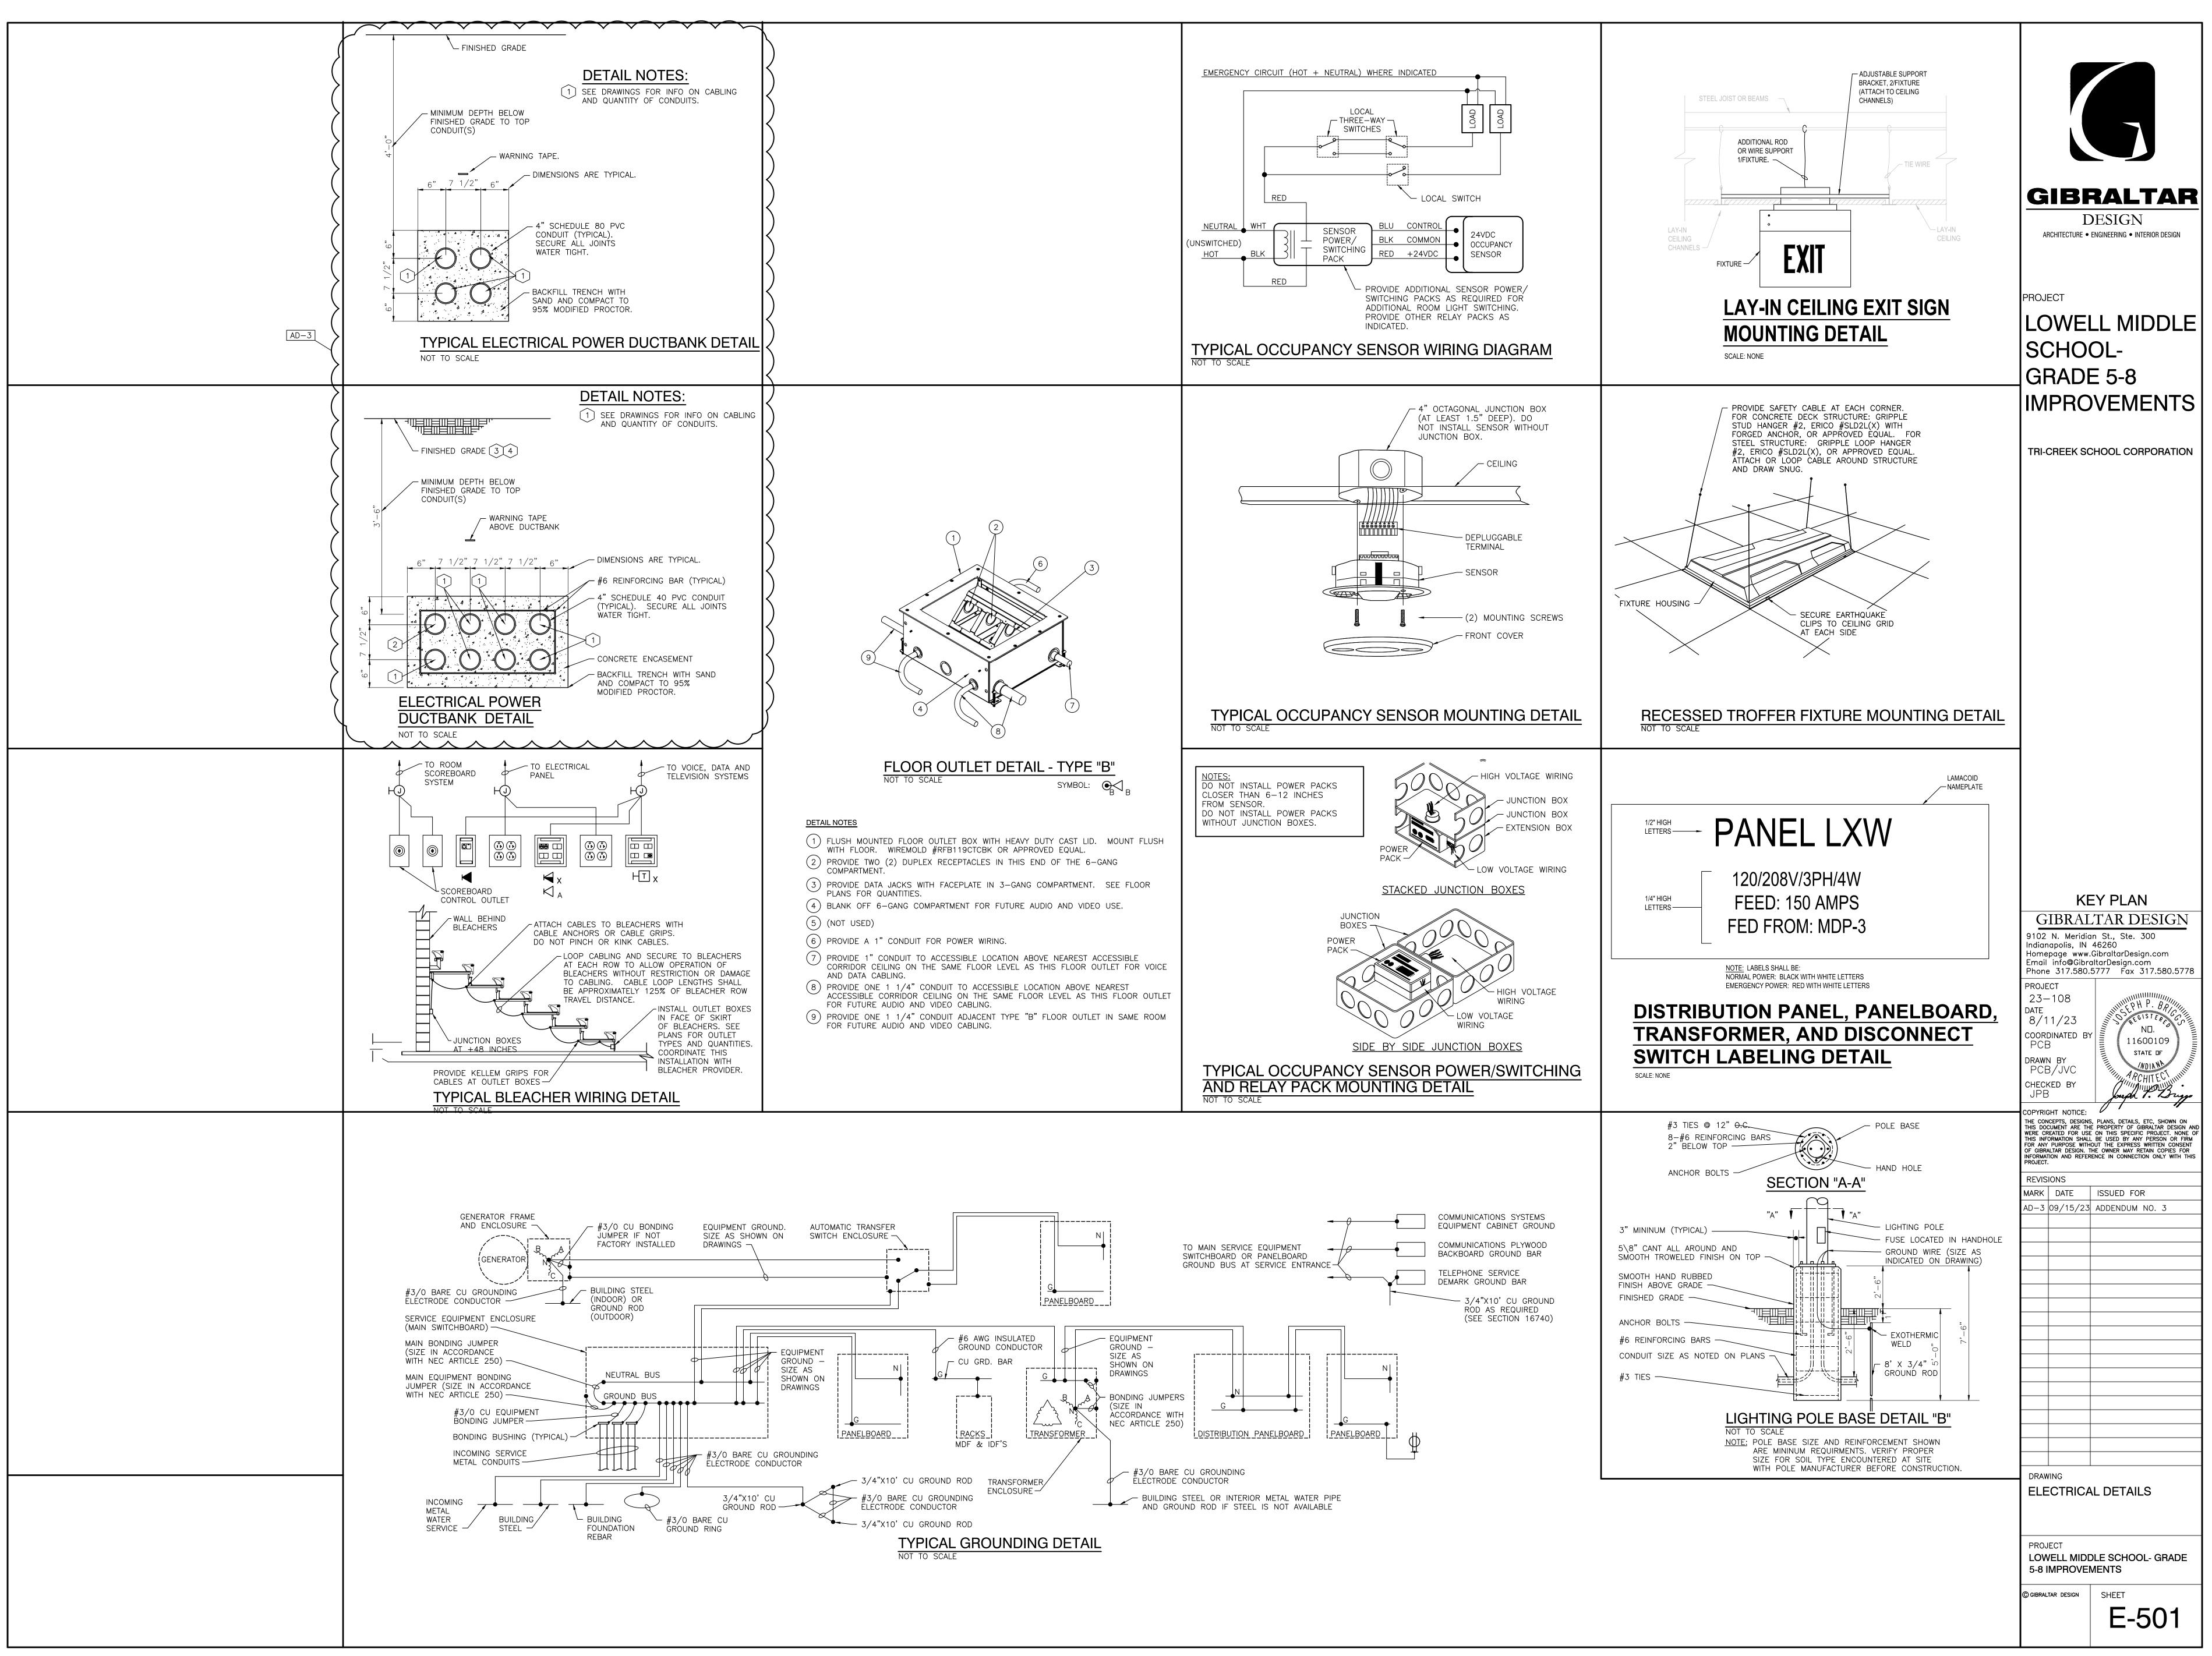


		LIGHTIN	IG REI	AY S	CHED	ULE			
MARK & TYPE	ITEM	CONTROLLED CIRCUIT(S)		COIL VOLT			SELECTOR SWITCH	CONTROL	SEE NOTES
RF-1 SQUARE D #8903 SERIES W/ NEMA 3R ENCLOS.	BUILDING SECURITY LIGHTS	1H1-5	1H1-4	277	F-107	N.O.	HOA	TIMECLOCK	1,2,4,5,6

NOTES: 1. FURNISH NEMA 1 ENCLOSURE WITH HINGED COVER UNLESS OTHERWISE NOTED. 2. ELECTRICALLY HELD. 3. MECHANICALLY HELD. 4. PROVIDE SELECTOR SWITCH IN RELAY ENCLOSURES WITH LOOP AND BRIDLE STRAPS FROM MAIN DEPARTMENT TO HINGED COVER FOR SELECTOR SWITCHES. 5. FURNISH FUSE PROTECTION FOR COIL CIRCUIT. 6. ALL RELAYS AND SELECTOR SWITCHES SHALL BE PREWIRED BY MANUFACTURER.

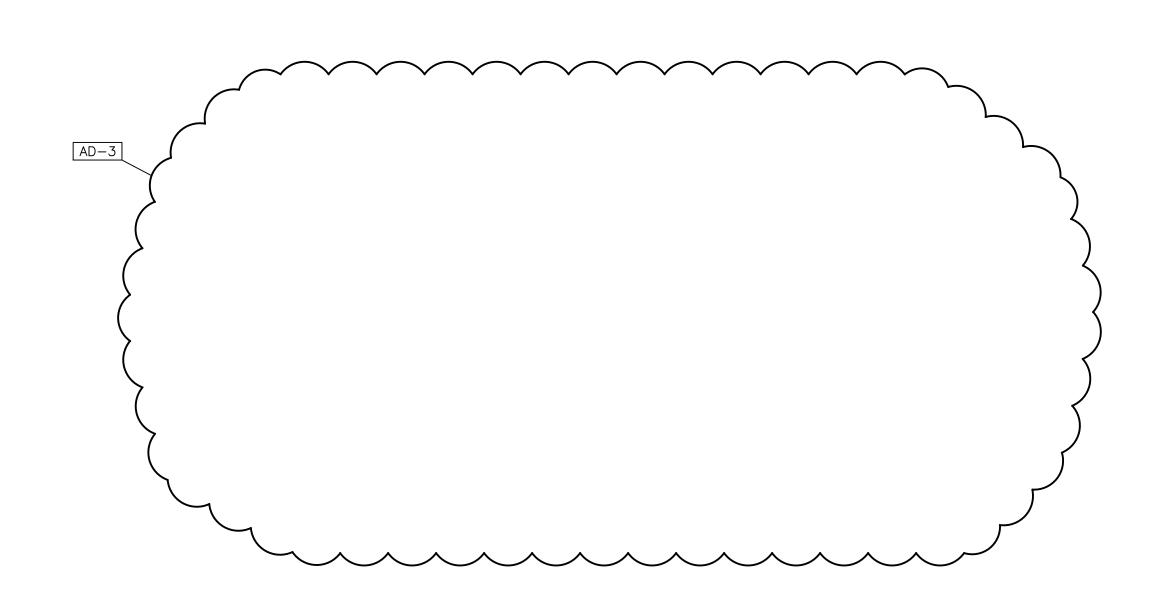

•

			וחחוו							RE SCHEDULE
	ТҮРЕ	MANUFACTURERS	VOLTAGE	SOURCE	LUMENS	DEGREE K.	WATTAGE	DIMMING	MOUNTING	DESCRIPTION
	L-1	METALUX SB24CZ-LD5-50S-UNV-L840-CD1-EQ-CLIP- PAF DAYBRITE 2RGX-60L-840-RS-UNV-DIM LITHONIA 2BLT4BA-60L-ADP-EZ1-LP840-EQCLIP-PAF COLUMBIA RLA24-40-VL-G-ED1-U	MVOLT	LED	6000 (6221/6000 /6051/ 7630)	4000	52.2/60/ 46/77	0-10V 1% DIMMING		2X4 RECESSED GRID MOUNTED DIRECT/INDIRECT LED TYPE LIGHTING FIXTURE WITH EARTHQUAKE CLIPS AND MULTI-VOLT LED DIMMING DRIVER. FIXTURE SHALL BE PROVIDED WITH BOTTOM ACCESS.
	L-1E	METALUX SB24CZ-LD5-60S-UNV-L840-CD1-EQ-CLIP- PAF-GTD DAYBRITE 2FGXG-60L-840-4-RS-UNV-DIM-GTD/E LITHONIA 2BLTBA4-60L-ADP-EZ1-LP840-EQCLIP-PAF-	MVOLT	LED	6000 (6221/6000 /6051/ 7630)	4000	52.2/60/ 46/77	0-10V 1% DIMMING		2X4 RECESSED GRID MOUNTED DIRECT/INDIRECT LED TYPE LIGHTING FIXTURE WITH EARTHQUAKE CLIPS, MULTI-I-VOLT LED DIMMING DRIVER AND INTEGRAL LEVITON ECD00-200 EMERGENCY GENERATOR TRANSFER DEVICE. CONNECT TO NORMAL POWER AND EMERGENCY POWER VIA THE TRANSFER DEVICE. FIXTURE
	1.2	GTD COLUMBIA RLA24-40-VL-G-ED1-U-GTD METALUX SB24CZ-LD5-50S-UNV-L840-CD1-EQ-CLIP-	MVOLT	LED	4800	4000	40.7/41/	0-10V 1%		SHALL BE PROVIDED WITH BOTTOM ACCESS. 2X4 RECESSED GRID MOUNTED DIRECT/INDIRECT LED TYPE LIGHTING FIXTURE
	L-2	METALUX SB24C2-LD5-50S-UNV-L840-CD1-EQ-CLIP- PAF DAYBRITE 2FGXG-50L-840-4-RS-UNV-DIM LITHONIA 2BLT4BA-48L-ADP-EZ1-LP840-EQCLIP-PAF COLUMBIA RLA24-40-ML-G-ED1-U	MVOLI	LED	4800 (5190/ 5000/ 4839/5200)		40.7/41/ 38/52	DIMMING		WITH EARTHQUAKE CLIPS AND MULTI-VOLT LED DIMMING DRIVER. FIXTURE SHALL BE PROVIDED WITH BOTTOM ACCESS.
	L-2E	METALUX SB24CZ-LD5-50S-UNV-L840-CD1-EQ-CLIP- PAF-GTD DAYBRITE 2FGXG-50L-840-4-RS-UNV-DIM-GTD/E LITHONIA 2BLT4BA-48L-ADP-EZ1-LP840-EQCLIP-PAF- GTD	MVOLT	LED	4800 (5190/ 5000/ 4839/5200)	4000	40.7/41/ 38/52	0-10V 1% DIMMING		2X4 RECESSED GRID MOUNTED DIRECT/INDIRECT LED TYPE LIGHTING FIXTURE WITH EARTHQUAKE CLIPS, ACRYLIC LENS (0.125 MINIMUM THICKNESS), MULTI- VOLT LED DIMMING DRIVER AND INTEGRAL LEVITON ECD00-200 EMERGENCY GENERATOR TRANSFER DEVICE. CONNECT TO NORMAL POWER AND EMERGENCY POWER VIA THE TRANSFER DEVICE. FIXTURE SHALL BE PROVIDED
	L-3	COLUMBIA RLA24-40-ML-G-ED1-U-GTD METALUX 22CZ-LD5-44S-UNV-L840-CD1-DF-22W-U- PAF DAYBRITE 2FGXG-40L-840-2-RS-UNV-DIM LITHONIA 2BLTBA2-40L-ADP-EZ1-LP840-DGA22-PAF	MVOLT	LED	4000 (4091/4000 /4102/ 4750)	4000	36.4/34/ 31/42	0-10V 1% DIMMING	GRID	WITH BOTTOM ACCESS. 2X2 RECESSED MOUNTED FLANGED DIRECT/INDIRECT LED TYPE LIGHTING FIXTURE WITH MULTI-VOLT LED DIMMING DRIVER. FIXTURE SHALL BE PROVIDED WITH BOTTOM ACCESS.
	L-4	COLUMBIA RLA22-40-VL-G-ED1-U METALUX 24CZ-LD5-40S-UNV-L840-CD1-EQ-CLIP-PAF DAYBRITE 2FGXG-40L-840-RS-UNV-DIM LITHONIA 2BLTBA4-40L-ADP-EZ1-LP840-EQCLIP-PAF COLUMBIA RLA24-40-LW-G-ED1-U	MVOLT	LED	4000 (4124/ 4000/4023/ 4340)	4000	29/31/ 31/42	0-10V 1% DIMMING		2X4 RECESSED GRID MOUNTED DIRECT/INDIRECT LED TYPE LIGHTING FIXTURE WITH EARTHQUAKE CLIPS AND MULTI-VOLT LED DIMMING DRIVER. FIXTURE SHALL BE PROVIDED WITH BOTTOM ACCESS.
	L-4E	METALUX SB24CZ-LD5-40S-UNV-L840-CD1-EQ-CLIP- PAF-GTD DAYBRITE 2FGXG-40L-840-RS-UNV-DIM-GTD/E LITHONIA 2BLTBA4-40L-ADP-EZ1-LP840-EQCLIP-PAF- GTD	MVOLT	LED	4000 (4124/ 4000/4023/ 4340)	4000	29/31/ 31/42	0-10V 1% DIMMING		2X4 RECESSED GRID MOUNTED DIRECT/INDIRECT LED TYPE LIGHTING FIXTURE WITH EARTHQUAKE CLIPS, ACRYLIC LENS (0.125 MINIMUM THICKNESS), MULTI- VOLT LED DIMMING DRIVER AND INTEGRAL LEVITON ECD00-200 EMERGENCY GENERATOR TRANSFER DEVICE. CONNECT TO NORMAL POWER AND EMERGENCY POWER VIA THE TRANSFER DEVICE. FIXTURE SHALL BE PROVIDED
	L-5	COLUMBIA RLA24-40-LW-G-ED1-U-GTD METALUX SB14CZ-LD5-39S-UNV-L840-CD1-PAF- EQCLIP-U DAYBRITE 1FGXG-40L-840-RS-UNV-DIM LITHONIA BLTBA4-40L-ADP-EZ1-ADP-EZ1-LP840- LATC-PAF COLUMBIA RLA24-40-ML-G-ED1-U	MVOLT	LED	4000 (4119/4000 /4062/ 4160)	4000	35.7/34/ 34/39	0-10V 1% DIMMING	GRID	WITH BOTTOM ACCESS. 1X4 RECESSED GRID MOUNTED DIRECT/INDIRECT LED TYPE LIGHTING FIXTURE WITH EARTHQUAKE CLIPS AND MULTI-VOLT LED DIMMING DRIVER. FIXTURE SHALL BE PROVIDED WITH BOTTOM ACCESS.
	L-5E	COLUMBIA RLA24-40-MIL-G-ED1-0 METALUX SB14CZ-LD5-39S-UNV-L840-CD1-PAF- EQCLIP-U-GTR2 DAYBRITE 1FGXG-40L-840-RS-UNV-DIM-GTD/E LITHONIA BLTBA4-40L-ADP-EZ1-ADP-EZ1-LP840- LATC-PAF-GTD COLUMBIA RLA24-40-ML-G-ED1-U-GTD	120/277	LED	4000 (4119/4000 /4062/ 4160)	4000	35.7/34/ 34/39	0-10V 1% DIMMING		1X4 RECESSED GRID MOUNTED DIRECT/INDIRECT LED TYPE LIGHTING FIXTURE WITH EARTHQUAKE CLIPS, MULTI-VOLT LED DIMMING DRIVER AND INTEGRAL LEVITON ECD00-200 EMERGENCY GENERATOR TRANSFER DEVICE. CONNECT TO NORMAL POWER AND EMERGENCY POWER VIA THE TRANSFER DEVICE. FIXTURE SHALL BE PROVIDED WITH BOTTOM ACCESS.
	L-6	METALUX 4SNLED-LD5-33SL-LW-UNV-L840-CD1-U DAYBRITE FSS440L840-UNV-DIM-DACHXX LITHONIA ZL1N-L48-SMR-3000LM-FST-MVOLT-40K- 80CRI-WH	120/277	LED	3000 (3504/4000 /3723/ 5720)	4000	28/31/31/ 41.7	NONE		4' PENDANT MOUNTED INDUSTRIAL LIGHTING FIXTURE WITH LENSED AND WIDE DISTRIBUTION
	L-6E	COLUMBIA MPS4-40HL-C-W-EDU-CSHC METALUX 4SNLED-LD5-33SL-LW-UNV-L840-CD1-U- GTD DAYBRITE FSS440L840-UNV-DIM-DACHXX-GTD/E LITHONIA ZL1N-L48-SMR-3000LM-FST-MVOLT-40K- 80CRI-WH-GTD	120/277	LED	3000 (3504/4000 /3723/ 5720)		28/31/31/ 41.7	NONE		4' PENDANT MOUNTED INDUSTRIAL LIGHTING FIXTURE WITH LENSED, WIDE DISTRIBUTION AND INTEGRAL LEVITON ECD00-200 EMERGENCY GENERATOR TRANSFER DEVICE. CONNECT TO NORMAL POWER AND EMERGENCY POWER VIA THE TRANSFER DEVICE.
	L-7	COLUMBIA MPS4-40HL-C-W-EDU-CSHC-GTD LITHONIA IBE-L48-18000LM-ATC-MD-MVOLT-GZ10- 40K-80CRI-WGIBE METALUX LHB-18-UNV-L840-CD-LHB-WG23 COLUMBIA PELA-840-L24-B-EDU-PM-WG DAYBRITE FBY24L840-UNV-LFA-FBY-WG	120/277	LED	18000 (18052/ 18500/ 22420/ 22055)	4000	136/132/ 161/176	NONE		4' PENDANT MOUNTED INDUSTRIAL HIGH BAY LIGHTING FIXTURE WITH LENS (WIDE DISTRIBUTION) AND WIRE GUARD.
	L-7E	LITHONIA IBE-L48-18000LM-ATC-MD-MVOLT-GZ10- 40K-80CRI-WGIBE-GTD METALUX LHB-18-UNV-L840-CD-LHB-WG23-GTD COLUMBIA PELA-840-L24-B-EDU-PM-WG-GTD DAYBRITE FBY24L840-UNV-LFA-FBY-WG-GTD	120/277	LED	18000 (18052/ 18500/ 22420/ 22055)	4000	136/132/ 161/176	NONE		4' PENDANT MOUNTED INDUSTRIAL HIGH BAY LIGHTING FIXTURE WITH LENS (WIDE DISTRIBUTION), WIRE GUARD AND INTEGRAL LEVITON ECD00-200 EMERGENCY GENERATOR TRANSFER DEVICE. CONNECT TO NORMAL POWER AND EMERGENCY POWER VIA THE TRANSFER DEVICE.
	L-8E	HALO PD6-30-D010-PDM6A-840-61V-C-EM LITHONIA LDN6-40/30-L06AR-LSS-MVOLT-EZ10- ELRSD LIGHTOLIER 6RNEM6-Z6RDL30940WOCDDZ-10U PRESCOLITE LTR-H-ML-30L-DM1-LTR-6RD-T-ML-40K8- MD-SSEMST-B24	MVOLT	LED	3000 (2963/ 3033.9/ 3182/2993)		36.4/34.69/ 31.2/ 41.50	0-10V		6" ROUND RECESSED MOUNTED DOWNLIGHT WITH CLEAR ALZAK REFLECTOR, MULTI-VOLT LED DRIVER AND INTEGRAL COLD WEATHER EMERGENCY BATTERY UNIT WITH SELF DIAGNOSTIC FEATURE. UL LISTED FOR DAMP LOCATIONS.
	L-9	LITHONIA WSQ LED-P4-40K-SR3-MVOLT-CBA MCGRAW EDISON ISS-SA1E-740-U-T3-CBA GARDCO 106L-32L-700-NW-G1-3-UNV-STD-FIN HUBBELL QSP2-24L-70-4K7-3-XXX-XXX	120/277	LED	6500 (6547/7129 /7242/ 7939)		61/58.2/70 /87	NONE		WALL MOUNTED OUTDOOR WEATHERPROOF QUARTER SPHERE CUTOFF TYPE LIGHTING FIXTURE WITH LED LAMPS, LED DRIVER. UL LISTED FOR WET LOCATIONS. COLOR TO BE SELECTED BY THE ARCHITECT.
	L-9E	LITHONIA WSQ LED-P4-40K-SR3-MVOLT-E20WC-CBA MCGRAW EDISON ISS-SA1E-740-U-T3-CBP-CBA GARDCO 106L-32L-700-NW-G1-3-UNV-STD-FIN-EBPC HUBBELL QSP2-24L-70-4K7-3-XXX-XXX-EH	120/277	LED	6500 (6547/7129 /7242/ 7939)		61/58.2/70 /87	NONE		WALL MOUNTED OUTDOOR WEATHERPROOF QUARTER SPHERE CUTOFF TYPE LIGHTING FIXTURE WITH LED LAMPS, LED DRIVER AND COLD WEATHER EMERGENCY BATTERY PACK. UL LISTED FOR WET LOCATIONS. COLOR TO BE SELECTED BY THE ARCHITECT.
	L-10									
	X1	SURE-LITES CX61R EMERGI-LITE BAPXN-1R LITHONIA LES-1R DUAL LITE SESR-BN	120/277	LED			1	NONE		SURFACE MOUNTED DIE CAST ALUMINUM EXIT SIGN WITH SINGLE BRUSHED ALUMINUM STENCIL FACE WITH RED LETTERS (ARROWS AS INDICATED ON DRAWINGS).
	X2	SURE-LITES CX61R EMERGI-LITE BAPXN-2R LITHONIA LES2R DUAL LITE SEDR-BN	120/277	LED			1	NONE		SURFACE MOUNTED DIE CAST ALUMINUM EXIT SIGN WITH DOUBLE BRUSHED ALUMINUM STENCIL FACE WITH RED LETTERS (ARROWS AS INDICATED ON DRAWINGS), NI-CAD BATTERY AND SELF DIAGNOSTIC FEATURE.
AD-3	<u>S-1</u>	MC GRAW-EDISON GLEON-AF-04-LED-E1-D-SL4-CBA LITHONIA DSX1-LED-P3-50K-T3M-MVOLT-SPA-CBA GARDCO P26-64L-800-NW-G2-AR-4-UNV-HIS-STD-FIN HUBBELL VP-1-60L-160-4K7-4F-UNV-AX-CBA-BC- RTSB30-80A-A-B3-XXX	480	LED	19935/ 21737/ 21145/ 21000	4000	225/135/ 153/157.8	NONE		POLE ARM MOUNTED LED SITE LIGHTING FIXTURE WITH TYPE IV LIGHT DISTRIBUTION MOUNTED ON A 30'-0" ROUND TAPERED STEEL POLE. COLOR AND FINISH TO BE SELCTED BY THE ARCHITECT.
	S-2	MC GRAW-EDISON GLEON-AF-04-LED-E1-D-SL4-CBA LITHONIA DSX1-LED-P3-50K-T3M-MVOLT-SPA-CBA GARDCO P26-64L-800-NW-G2-AR-4-UNV-HIS-STD-FIN HUBBELL VP-1-60L-160-4K7-4F-UNV-AX-CBA-BC- RTSB30-80A-A-B3-XXX	480	LED	19935/ 21737/ 21145/ 21000	4000	225/135/ 153/157.8	NONE	MOUNTED	POLE ARM MOUNTED LED SITE LIGHTING FIXTURE WITH TYPE III LIGHT DISTRIBUTION MOUNTED ON A 30'-0" ROUND TAPERED STEEL POLE. COLOR AND FINISH TO BE SELCTED BY THE ARCHITECT.
$\left\langle \right\rangle$	S-3	MC GRAW-EDISON GLEON-AF-04-LED-E1-D-SL4-CBA LITHONIA DSX1-LED-P3-50K-T3M-MVOLT-SPA-CBA GARDCO P26-64L-800-NW-G2-AR-4-UNV-HIS-STD-FIN HUBBELL VP-1-60L-160-4K7-4F-UNV-AX-CBA-BC- RTSB30-80A-A-B3-XXX	480	LED	19935/ 21737/ 21145/ 21000	4000	225/135/ 153/157.8	NONE	MOUNTED	TWO (2) POLE ARM MOUNTED LED SITE LIGHTING FIXTURE WITH TYPE III LIGHT DISTRIBUTION MOUNTED (180 DEGREES) ON A 30'-0" ROUND TAPERED STEEL POLE. COLOR AND FINISH TO BE SELECTED BY THE ARCHITECT.

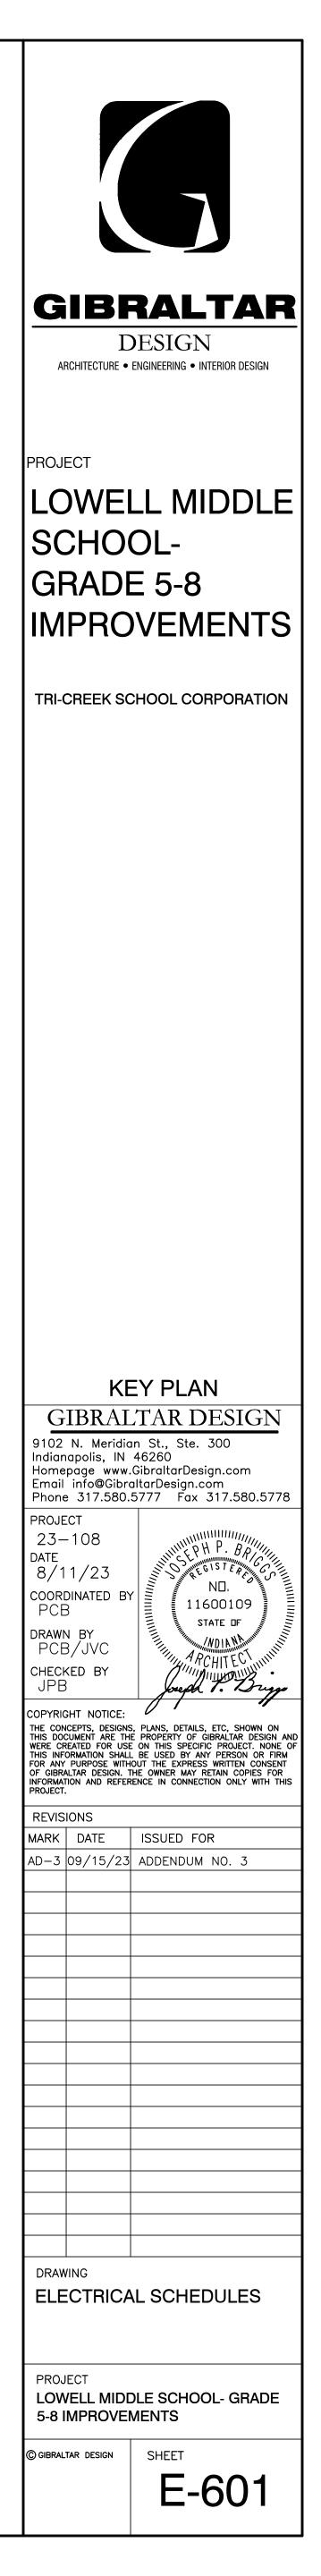

MARK & TYPE				<b>REM</b>	RKS											
'1H1"					HCIRCI	JITS SH	ALL BE	CIRCUI	T BREA	KERS.						
TYPE: SQ D NF OR AF	PRO	ED EC	UAL	CIRCUI	T BREA	KERS S	HALL H	AVE MI	NIMUM	18,000 A	MP INT	ERRUPT	ING C/	APACI	TY - T	YPE EDB.
277/480V, 3 PH, 4W																
225 AMP MAIN LUGS																
NEMA 1																
SURFACE MOUNTED																
DESCRIPTION		POLE		LTS	REC	EQUIP	A	B	С	HEAT	A/C	FUTR	POLE	TRIP	CIR	DESCRIPTION
106 LIGHTS	1	1	20	2.00			2.00									
															-	F-102,103,104,105,
	_			2.00			2.00						1	20	2	106,107 LIGHTS
106 LIGHTS	3	1	20	2.00				2.00								
																RELAY RF-1
				0.00				0.00						20		CONTROL AND
				2.00				2.00					1	20	4	TIMECLOCK
	_		20	1 00					1 00							
IGHTS (RELAY RF-1)	5	1	20	1.00					1.00				4	20	6	SDADE
SPARE	7	4	20										1	20	6	SPARE
	7	1	20										1	20	8	SPARE
SPARE	9	1	20										I	20	0	
	3	1	20										1	20	10	SPARE
PARE	11	1	20										1	20	10	
		1	20										1	20	12	SPARE
SPARE	13	1	20										1	20	14	
		'							<b> </b>				1	20	14	SPARE
PARE	15	1	20													- / 11 3-
		1											1	20	16	SPARE
PARE	17	1	20													- / 11 5-
													1	20	18	SPARE
SPARE	19	1	20													
		'						<b></b>	<b> </b>				1	20	20	SPARE
SPARE	21	1	20													
													1	20	22	SPARE
SPARE	23	1	20													
													1	20	24	SPARE
SPARE	25	1	20													Canada Canada Canada
													1	20	26	SPARE
SPARE	27	1	20						1							
									l –				1	20	28	SPARE
PARE	29	1	20						www.unneutitionilililili							
													1	20	30	SPARE
SPARE	31	1	20													
													1	20	32	SPARE
SPARE	33	1	20													
													1	20	34	SPARE
PARE	35	1	20													
													1	20	36	SPARE
PARE	37	1	20													
																45 KVA
																TRANSFORMER
					2.94	8.52	11.46						3	80	38	(PANEL "1L1")
SPARE	39	1	20													
					2.94	9.62		12.56					$\sim$	$\square$	40	
SPARE	41	1	20													
					2.22	11.13			13.35				1	1	42	
			111101	9.00	8.10	29.27	15.46	16.56	14.35			- T				

		L	OW	1		LE S	CHO	OL P	ANEL	BOA	RD S	CHE	DUL	E		
MARK & TYPE				REMA												
'1L1" - SECTION 1							ALL BE									
TYPE: SQ D NQ OR A 120/208V, 3 PH, 4W	PPRO	VED EC	QUAL	UAL CIRCUIT BREAKERS SHALL HAVE MINIMUM 22,000 AMP INTERRUPTING CAPACITY - TY TWO SECTION PANEL - BOTH SECTIONS SAME HEIGHT - SECTION 1 OF 2.												YPE QOB-VH.
150 AMP MAIN BREAM	ER			100 3	LUTION	FANLL	- DO III	SLOR	JNS SA		JIII - 3L		1012.			
NEMA 1																
SURFACE MOUNTED																
DESCRIPTION		POLE		LTS		EQUIP		B	C	HEAT	A/C	FUTR	POLE	TRIP	CIR	DESCRIPTION
F-101,102 RECPS	1	1	20		0.36		0.36		<b>.</b>	_					_	
F-102 RECPS	3	1	20		0.72		0.72	0.36	<b>_</b>				1	20	2	F-106 RECPS
F-102 NECFS	3		20	8	0.30			0.30					1	20	4	F-106 RECPS
F-103,104 RECPS	5	1	20	8	0.36				0.36							
																F-106 RECP
		L				1.50			1.50				1	20	6	(SCOREBOARD)
F-101A,105 RECP	7	1	20	8	0.36		0.36								_	CDADE
F-102 RECPS (WC)	9	1	20	0	0.36			0.36	<b>.</b>				1	20	8	SPARE
	3		20		0.50			0.00					1	20	10	SPARE
ROOF RECPS	11	1	20	2	0.36				0.36							
													1	20	12	SPARE
CARD READERS	13	1	20			0.50	0.50								ļ	
						1 50	1 50						4	20		F-107 RECP (SOUND
AUTOMATIC DOOR						1.50	1.50		<b>_</b>	-			1	20	14	SYSTEM EQUIP.)
OPERATORS	15	1	20			0.50		0.50								
	10					0.00		0.00		-						F-103 ELECTRIC HAN
						1.50		1.50					1	20	16	DRYER
REF-MS1 (1/10 HP)																
CUH-B	17	1	20			0.17			0.17							
						1.50			1.50				1	20	18	F-103 ELECTRIC HAN
SPARE	19	1	20	8		1.50			1.50				1	20	10	
			20													F-104 ELECTRIC HAN
						1.50	1.50						1	20	20	DRYER
F-102 RECP																
(VENDING)	21	1	20	8	1.50			1.50								
						1.50		1.50					1	20	22	F-104 ELECTRIC HAN DRYER
F-102 RECP				0		1.50		1.50					1	20	22	DITLI
(VENDING)	23	1	20		1.50				1.50							
													1	20	24	SPARE
F-102 RECP																
(VENDING)	25	1	20	3	1.50		1.50		ļ	-						00405
SPARE	27	1	20						<b>.</b>				1	20	26	SPARE
	-1	<u> </u>	20										1	20	28	SPARE
SPARE	29	1	20													
													1	20	30	SPARE
SPARE	31	1	20													00405
SPARE	33	1	20						<b>.</b>				1	20	32	SPARE
OF ARE	33		20										1	20	34	SPARE
SPARE	35	1	20	2									'	20		51700
													1	20	36	SPARE
SPARE	37	1	20								_					
													1	20	38	SPARE
SPARE	39	1	20										4	20	40	CDADE
SPARE	41	1	20	8									1	20	40	SPARE
		, ·									L		1	20	42	SPARE
TOTAL CONN	ECTED		(kVA)		8.10	29.27	11.46	12.56	13.35							
		LOAD			8.10	29.27	1			1						

MARK & TYPE				REM	ARKS											
"1L2"				BRANC	CH CIRC	UITS SH	ALL BE	CIRCUI	<b>FBREA</b>	KERS.						
TYPE: SQ D NQ OR AF	PRO	VED E	QUAL	CIRCUI	T BREA	KERS S	HALL H	AVE MI	NIMUM :	22,000 A	MP INT	ERRUP	TING C/	PACI	TY - T	YPE QOB-VH.
120/208V, 3 PH, 4W																
225 AMP MAIN LUGS																
	CID	POLE		LTS	REC	EQUIP	A	В	С	HEAT	A/C	FUTD	POLE	TRIP		DESCRIPTION
DESCRIPTION D-5 RECPS	1	1	20	LIS	1.08	EQUIP	1.08	Þ	U U	HEAT	A/C	FUIR	POLE	IRIP		DESCRIPTION
D-5 RECFS	1	1	20	8	0.54		0.54						1	20	2	D-159,160 RECPS
D-158 RECPS	3	1	20	8	1.08		0.04	1.08					'	20	-	B 100,100 REDIO
	-				0.36			0.36					1	20	4	D-152 RECPS (WC)
				~												
D-152, 157, 156, RECPS	5	1	20		0.72				0.72							
					1.08				1.08				1	20	6	D-161 RECPS
D-157 RECPS																
(COPIER)	7	1	20		1.08		1.08									
. 457	_				1.08		1.08	4.00					1	20	8	D-162 RECPS
D-157 RECPS	9	1	20	8	1.08			1.08					4	20	10	
D-157 RECPS	11	1	20	8	0.36			0.36	1.08				1	20	10	D-164 RECP
D-137 NEOF 3	11	1	20	8	1.00				1.00							D-164 RECP
					1.08				1.08				1	20	12	(REFRIGERATOR)
D-155 RECPS	13	1	20	8	1.08		1.08									(
19 III WA WA THE BALLE HAR P. SIDA													1	20	14	D-164 RECP
D-154 RECPS	15	1	20	0	0.54			0.54		[						
													1	20	16	D-151,164 RECPS
D-154 RECPS	17	1	20		0.90				0.90							
					1.08				1.08				1	20	18	D-151 RECPS
D-164 RECP	19	1	20		0.18		0.18								L	
	~ 1				0.54		0.54						1	20	20	D-151 RECPS
SPARE	21	1	20	8	1.00			1.00					4		22	
SPARE	23	1	20	<u> </u>	1.08			1.08					1	20	22	D-153 RECPS
SFARE	23	I	20	8	0.54				0.54				1	20	24	D-153 RECPS
SPARE	25	1	20	8	0.54				0.54				1	20	27	D-100 KEGI 0
	20		20	8		1.00	1.00			<b> </b>			1	20	26	VAV-1,2,3,4,5
SPARE	27	1	20	8												
				8		1.00		1.00					1	20	28	CARD READERS
SPARE	29	1	20													
						1.00			1.00				1	20	30	AUTOMATIC DOORS
SPARE	31	1	20													
													1	20	32	SPARE
SPARE	33	1	20	8												0.04.05
SPARE	35	1	20							ļ			1	20	34	SPARE
SPARE	30	I	20	8				ļ					1	20	36	SPARE
SPARE	37	1	20	<u>.</u>									1	20	30	SFARE
	51	1											1	20	38	SPARE
SPARE	39	1	20													
		· ·														D-11 208V RECP
						1.00		1.00					2	20	40	(COPIER)
SPARE	41	1	20													
						1.00			1.00				$\sum$	$\leq$	42	
TOTAL CONNE	CTEL	LOAD	(kVA)	)	16.56	5.00	6.58	6.50	8.48							
TOTAL DEI					13.28	5.00	i			1		1	1			

LOWELL MIDDLE SCHOOL PANELBOARD SCHEDULE

			.Ow	ELL I	VIDL	DLE S	CHO	OL P	ANE	LBOA	RD S	SCHE	DUL	E		
MARK & TYPE				REMA	RKS											
"1L3"				BRANC	H CIRC	UITS SH	ALL BE	CIRCUI	T BREA	KERS.						
TYPE: SQ D NQ OR A	PPRO	VED EC	QUAL	CIRCUI	<b>BREA</b>	KERS S	HALL H	AVE MI		22,000 A	MP INT	ERRUP	TING C	APACI	TY - T	YPE QOB-VH.
120/208V, 3 PH, 4W																
100 AMP MAIN BREAK	ER															
NEMA 1																
SURFACE MOUNTED																
DESCRIPTION	CIR	POLE	TRIP	LTS		EQUIP	Α	B	C	HEAT	A/C	FUTR	POLE	TRIP	CIR	DESCRIPTION
A-129 RECP	1	1	20		1.50		1.50									
					1.50		1.50						1	20	2	A-129 RECP
A-129 RECP	3	1	20		1.50			1.50								
					1.50			1.50					1	20	4	A-129 RECP
A-129 RECP	5	1	20		1.50				1.50							
					1.50				1.50				1	20	6	A-129 RECP
A-129 RECP	7	1	20		1.50		1.50									
					1.50		1.50						1	20	8	A-129 RECP
A-129 RECP	9	1	20		1.50			1.50								
					1.50			1.50					1	20	10	A-129 RECP
A-129 RECP	11	1	20		1.50				1.50							
					1.50				1.50				1	20	12	A-129 RECP
A-129 RECP	13	1	20		1.50		1.50									
					1.50		1.50						1	20	14	A-129 RECP
A-129 RECP	15	1	20		1.50			1.50								
					1.50			1.50					1	20	16	A-129 RECP
A-129 RECP	17	1	20		1.50				1.50							
					1.50				1.50				1	20	18	A-129 RECP
SPARE	19	1	20													
					1.50		1.50						1	20	20	A-129 RECP
SPARE	21	1	20													
					1.50			1.50					1	20	22	A-129 RECP
SPARE	23	1	20													
					0.72				0.72				1	20	24	A-129 RECPS
SPARE	25	1	20													
													1	20	26	SPARE
SPARE	27	1	20													
													1	20	28	SPARE
SPARE	29	1	20													L
													1	20	30	SPARE
TOTAL CONNE	CTED	LOAD	(kVA)		30.72		10.50	10.50	9.72							
TOTAL DE	MANE	LOAD	(kVA)		20.36											

•

MARK & TYPE				REM/	RKS											
"1L1" - SECTION 2						UITS SH	ALL BE	CIRCUI	T BREA	KERS.						
TYPE: SQ D NQ OR AP	PRO	VED E	QUAL	CIRCUI	T BREA	KERS SI	HALL H	AVE MI		22,000 A	MP INT	ERRUP	TING C	APACI	TY - T	YPE QOB-VH.
120/208V, 3 PH, 4W				TWO S	ECTION	PANEL	- BOTH	SECTIO	NS SA	ME HEIG	HT - SI	ECTION	2 OF 2			
225 AMP MAIN LUGS																
NEMA 1																
SURFACE MOUNTED								_								
DESCRIPTION		POLE		LTS	REC	EQUIP	A	B	C	HEAT	A/C	FUIR	POLE			DESCRIPTION
SPARE	43	1	20	8									1	20	11	SPARE
SPARE	45	1	20										1	20	44	SPARE
OFAIL	45	1	20										1	20	46	SPARE
SPARE	47	1	20													
													1	20	48	SPARE
SPARE	49	1	20				000000000000000000000000000000000000000									
													1	20	50	SPARE
SPARE	51	1	20													
													1	20	52	SPARE
SPARE	53	1	20										4		E4	
SPARE	55	1	20										1	20	54	SPARE
SPARE	55	1	20										1	20	56	SPARE
SPARE	57	1	20										'	20		
													1	20	58	SPARE
SPARE	59	1	20													
													1	20	60	SPARE
SPARE	61	1	20													
													1	20	62	SPARE
SPARE	63	1	20													
00405													1	20	64	SPARE
SPARE	65	1	20										1	20	66	SPARE
MOTORIZED													1	20	00	SPARE
BACKBOARD (3/4 HP)	67	1	30			1.59	1.59									
						1.00	1.00						1	20	68	SPARE
MOTORIZED																
BACKBOARD (3/4 HP)	69	1	30			1.59		1.59								
													1	20	70	SPARE
MOTORIZED																
BACKBOARD (3/4 HP)	71	1	30			1.59			1.59						ļ	
						4.04			4.04					20		
ACCU-TCM1	73	2	30			1.84 1.15	1.15		1.84				1	30	12	CURTAIN (1 HE
	13	2	50			1.15	1.15									MOTORIZED
													1	30	74	BACKBOARD
	75	$\sim$		1		1.15		1.15								
																1
																MOTORIZED
													1	30	76	BACKBOARD
ACCU-TCM2	77	2	30			1.15			1.15							
													4	20	70	MOTORIZED
	79		$\sim$			1.15	1.15						1	30	18	BACKBOARD
	15					1.15	1.15									MOTORIZED
						1.13	1.13						3	30	80	BLEACHERS
HOT WATER HEATER			p													
DWH-1 (4.5 KW)	81	2	30			2.25		2.25								
						1.13		1.13							82	
	83		$\sum$			2.25			2.25							
						1.13			1.13					$\sum$	84	

		L	OW	ELL I		LE S	СНО	OL P	ANEL	BOA	RD S	CHE	DUL	E			
MARK & TYPE				<b>REM</b> A	RKS												
"1XH1"				BRANC	CH CIRC	UITS SH	ALL BE	CIRCUI	T BREA	KERS.							
TYPE: SQ D NF OR AF	PROV	ED EQ	UAL	CIRCUI	T BREA	KERS S	HALL H	AVE MI	NIMUM	18,000 A	MP INT	ERRUPT	ING CA	PACI	TY - T	YPE EDB.	
277/480V, 3 PH, 4W																	
100 AMP MAIN LUGS					AD-3												
NEMA 1			-			/		<u> </u>									
	-	IPOLE		LTS					0		A.(C)	CUTD				DECODIDITION	
DESCRIPTION	CIR	POLE	TRIP	LIS	REC	EQUIP	) <u>A</u>	B	C	HEAT	A/C	FUTR	POLE	IRIP	CIR	DESCRIPTION	
F-101,102,103,104, 105,106,107,108							)										
LIGHTS	1	1	20	2.00			2.00										
LIGITIO	1	1	20	2.00			)2.00						1	20	2	SPARE	
	$\sim$		20			$\sim$									-		
													1	20	4	SPARE	
SPARE	5	1	20														
													1	20	6	SPARE	
SPARE	7	1	20														
							000000000000000000000000000000000000000						1	20	8	SPARE	
SPARE	9	1	20										·				
00405													1	20	10	SPARE	
SPARE	11	1	20	3									1	20	10	SPARE	
SPACE	13	1	20										1	20	12	SPARE	
OFACE	13	1	20										1		14	SPACE	
SPACE	15	1	20										1		17		
													1		16	SPACE	
SPACE	17	1	20	1													
													1		18	SPACE	
TOTAL CONN	ECTE		(kVA)	2.00			2.00										
TOTAL DE			(kVA)	2.00													
							2.00										

MARK & TYPE				REM/	RKS											
"LP-EM1"				EXISTIN	G EAT	ON PAN	ELBOAR	RD								
TYPE: EXISTING EAT	ON			PROVI	DE A 3F	-60 AM		IT BRE	AKER (C	RCUIT	15,17,19	) IN TH	REE (3)	) EXIS	TING	1P-SPACES .
277/480V, 3 PH, 4W						17 AND			•				•			
200 AMP MAIN LUGS																
NEMA 1				FED FF	ROM AT	S-1										
SURFACE MOUNTED				ELECT	RICAL F	ROOM B	-101									
DESCRIPTION	CIR	POLE	TRIP	LTS	REC	EQUIP	A	B	С	HEAT	A/C	FUTR	POLE	TRIP	CIR	DESCRIPTION
PANEL "LP-EM2"	1	3	100													
													3	60	2	
	3		$\backslash$													
														$\geq$	4	
	5	$\square$														
															6	
XFMR T-BE (PANEL "RP-EML1")	7	3	30													
													1	20	8	UNIT B EMERGENC
	9	$\sim$	$\sim$													
																UNIT B EMERGENO
													1	20	10	AND EXIT LIGHTS
	11															
																UNIT A EMERGENO
													1	20	12	AND EXIT LIGHTS
OUTDOOR LIGHTING	13	1	20													
																UNIT A EMERGENC
													1	20	14	LIGHTS
PANEL "1XH1"	15	3	30												40	
	47	<											1	20	16	
	17		$\sim$										1	20	10	SPACE
	19												1	20	10	SPACE
	13												1	20	20	SPACE
				1									1	20	20	OF AUL
				1												
				1												
				1												
															+	
		000000000000000000000000000000000000000		1		1										
TOTAL CONN	CTED		(kVA)	ĺ												

