

ADDENDUM NO. 01

February 14, 2024

**ZCS-ZCHS Stadium Locker Building & Concrete Repairs, ZMS Tennis Courts
and Eagle Elementary Building Demolition & Playground Renovation
1000 Mulberry St.
Zionsville, IN, 46077**

TO: ALL BIDDERS OF RECORD

This Addendum forms a part of and modifies the Bidding Requirements, Contract Forms, Contract Conditions, the Specifications, and the Drawings dated January 22, 2024, by Fanning Howey (Architect). Acknowledge receipt of the Addendum in the space provided on the Bid Form. Failure to do so may subject the Bidder to disqualification.

This Addendum consists of Pages ADD 1-1 through ADD 1 - 3 and attached Addendum No. 1 from Fanning Howey dated February 14, 2024 for **Zionsville High School 223139.00** consisting of 5 pages, specification section 10 14 23.16 – Interior Panel Signage, and 29 Drawings. **Eagle Elementary 223135.00** consisting of 1 page and 2 Drawings, and **Zionsville Middle School 223144.00** consisting of 1 page and 2 Drawings.

1. 00 20 00 – Information Available to Bidders

- B. ZCHS Site Logistics Plan is included as part of this Addendum.
- C. ZMS Site Logistics Plan is included as part of this Addendum.
- D. Eagle Elementary Site Logistics Plan included as part of this Addendum.
- E. Pre-Award Meetings are scheduled as noted below:
 - Bid Category #01 – 2/27/24 @ 9:00am
 - Bid Category #02 – 2/27/24 @ 10:00am
 - Bid Category #03 – 2/27/24 @ 12:00pm
 - Bid Category #04 – 2/27/24 @ 1:00pm
 - Bid Category #05 – 2/27/24 @ 2:30pm

2. 00 31 00 – Bid Form

- A. Replace existing specification section in entirety with specification section included as part of this Addendum.

3. 01 12 00 – Multiple Contract Summary

A. Bid Category No. 1 – General Trades at ZCHS

Remove the following Specification Sections from Scope of Work:

- 01 51 10 – Temporary Electricity, Lighting and Warning Systems
- 01 51 30 – Temporary Heating, Ventilation and Cooling
- 01 51 50 – Temporary Water

Add the following Clarifications:

- 19. Contractor is responsible for the stone access drive(s) and laydown areas as noted in Site Logistics Plan.
- 20. Contractor is required to remove and haul off all stone access and laydown areas in existing landscaping. Fill with topsoil and seed at the conclusion of the project.
- 21. Contractor to review Site Utility, Site Demolition and Site Layout Plan to ensure concrete sidewalk demolition and putback corresponds with the underground utility work. Specifically, the 42 LF of 12” HDPE pipe that runs between existing structure EX F12 and New Structure furthest west. It appears additional concrete demo and replacement is required to accommodate this work. The intent would be to replace existing walk to nearest control joint.
- 22. Equipment operation outside of temporary construction fencing is prohibited during pickup, drop off and bus hours. Estimated times are Monday – Friday, 8:00 – 9:00am and 3:15-4:15pm.
- 23. Deliveries are prohibited during pickup, drop off and bus hours. Estimated times are Monday – Friday, 8:00 – 9:00am and 3:15-4:15pm.

B. Bid Category No. 2 – Plumbing & HVAC at ZCHS (223139.00)

Add the following Clarifications:

- 9. Equipment operation outside of temporary construction fencing is prohibited during pickup, drop off and bus hours. Estimated times are Monday – Friday, 8:00 – 9:00am and 3:15 – 4:15pm.
- 10. Deliveries are prohibited during pickup, drop off and bus hours. Estimated times are Monday – Friday, 8:00 – 9:00am and 3:15 – 4:15pm.

C. Bid Category No. 3 – Electrical & Technology at ZCHS (223139.00)

Add the following Clarifications:

- 8. Equipment operation outside of temporary construction fencing is prohibited during pickup, drop off and bus hours. Estimated times are Monday – Friday, 8:00 – 9:00am and 3:15 – 4:15pm.
- 9. Deliveries are prohibited during pickup, drop off and bus hours. Estimated times are Monday – Friday, 8:00 – 9:00am and 3: 3:15 – 4:15pm.

D. Bid Category No. 4 – General Trades at ZMS (223144.00)

Add the following Clarifications:

5. Contractor is required to remove and haul off all stone access and laydown areas in existing landscaping. Fill with topsoil and seed at the conclusion of the project.
6. Equipment operation outside of temporary construction fencing is prohibited during pickup, drop off and bus hours. Estimated times are Monday – Friday, 8:30 – 9:30am and 3:15 – 4:15pm.
7. Deliveries are prohibited during pickup, drop off and bus hours. Estimated times are Monday – Friday, 8:30 – 9:30am and 3:15 – 4:15pm.

E. Bid Category No. 5 – General Trades at Eagle Elementary (223135.00)

Add the following Clarifications:

7. Contractor is required to remove and haul off all stone access and laydown areas in existing landscaping. Fill with topsoil and seed at the conclusion of the project.
8. Equipment operation outside of temporary construction fencing is prohibited during pickup, drop off and bus hours. Estimated times are Monday – Friday, 7:30 – 8:30am and 2:00 – 3:00pm.
9. Deliveries are prohibited during pickup, drop off and bus hours. Estimated times are Monday – Friday, 7:30 – 8:30am and 2:00 – 3:00pm.


4. 01 23 00 – Alternates

- A. Replace existing specification section in entirety with specification section included as part of this Addendum.


5. 01 32 00 – Schedules and Reports

- A. Guideline Schedule is included as part of this Addendum for reference by all Contractors.

END OF ADDENDUM

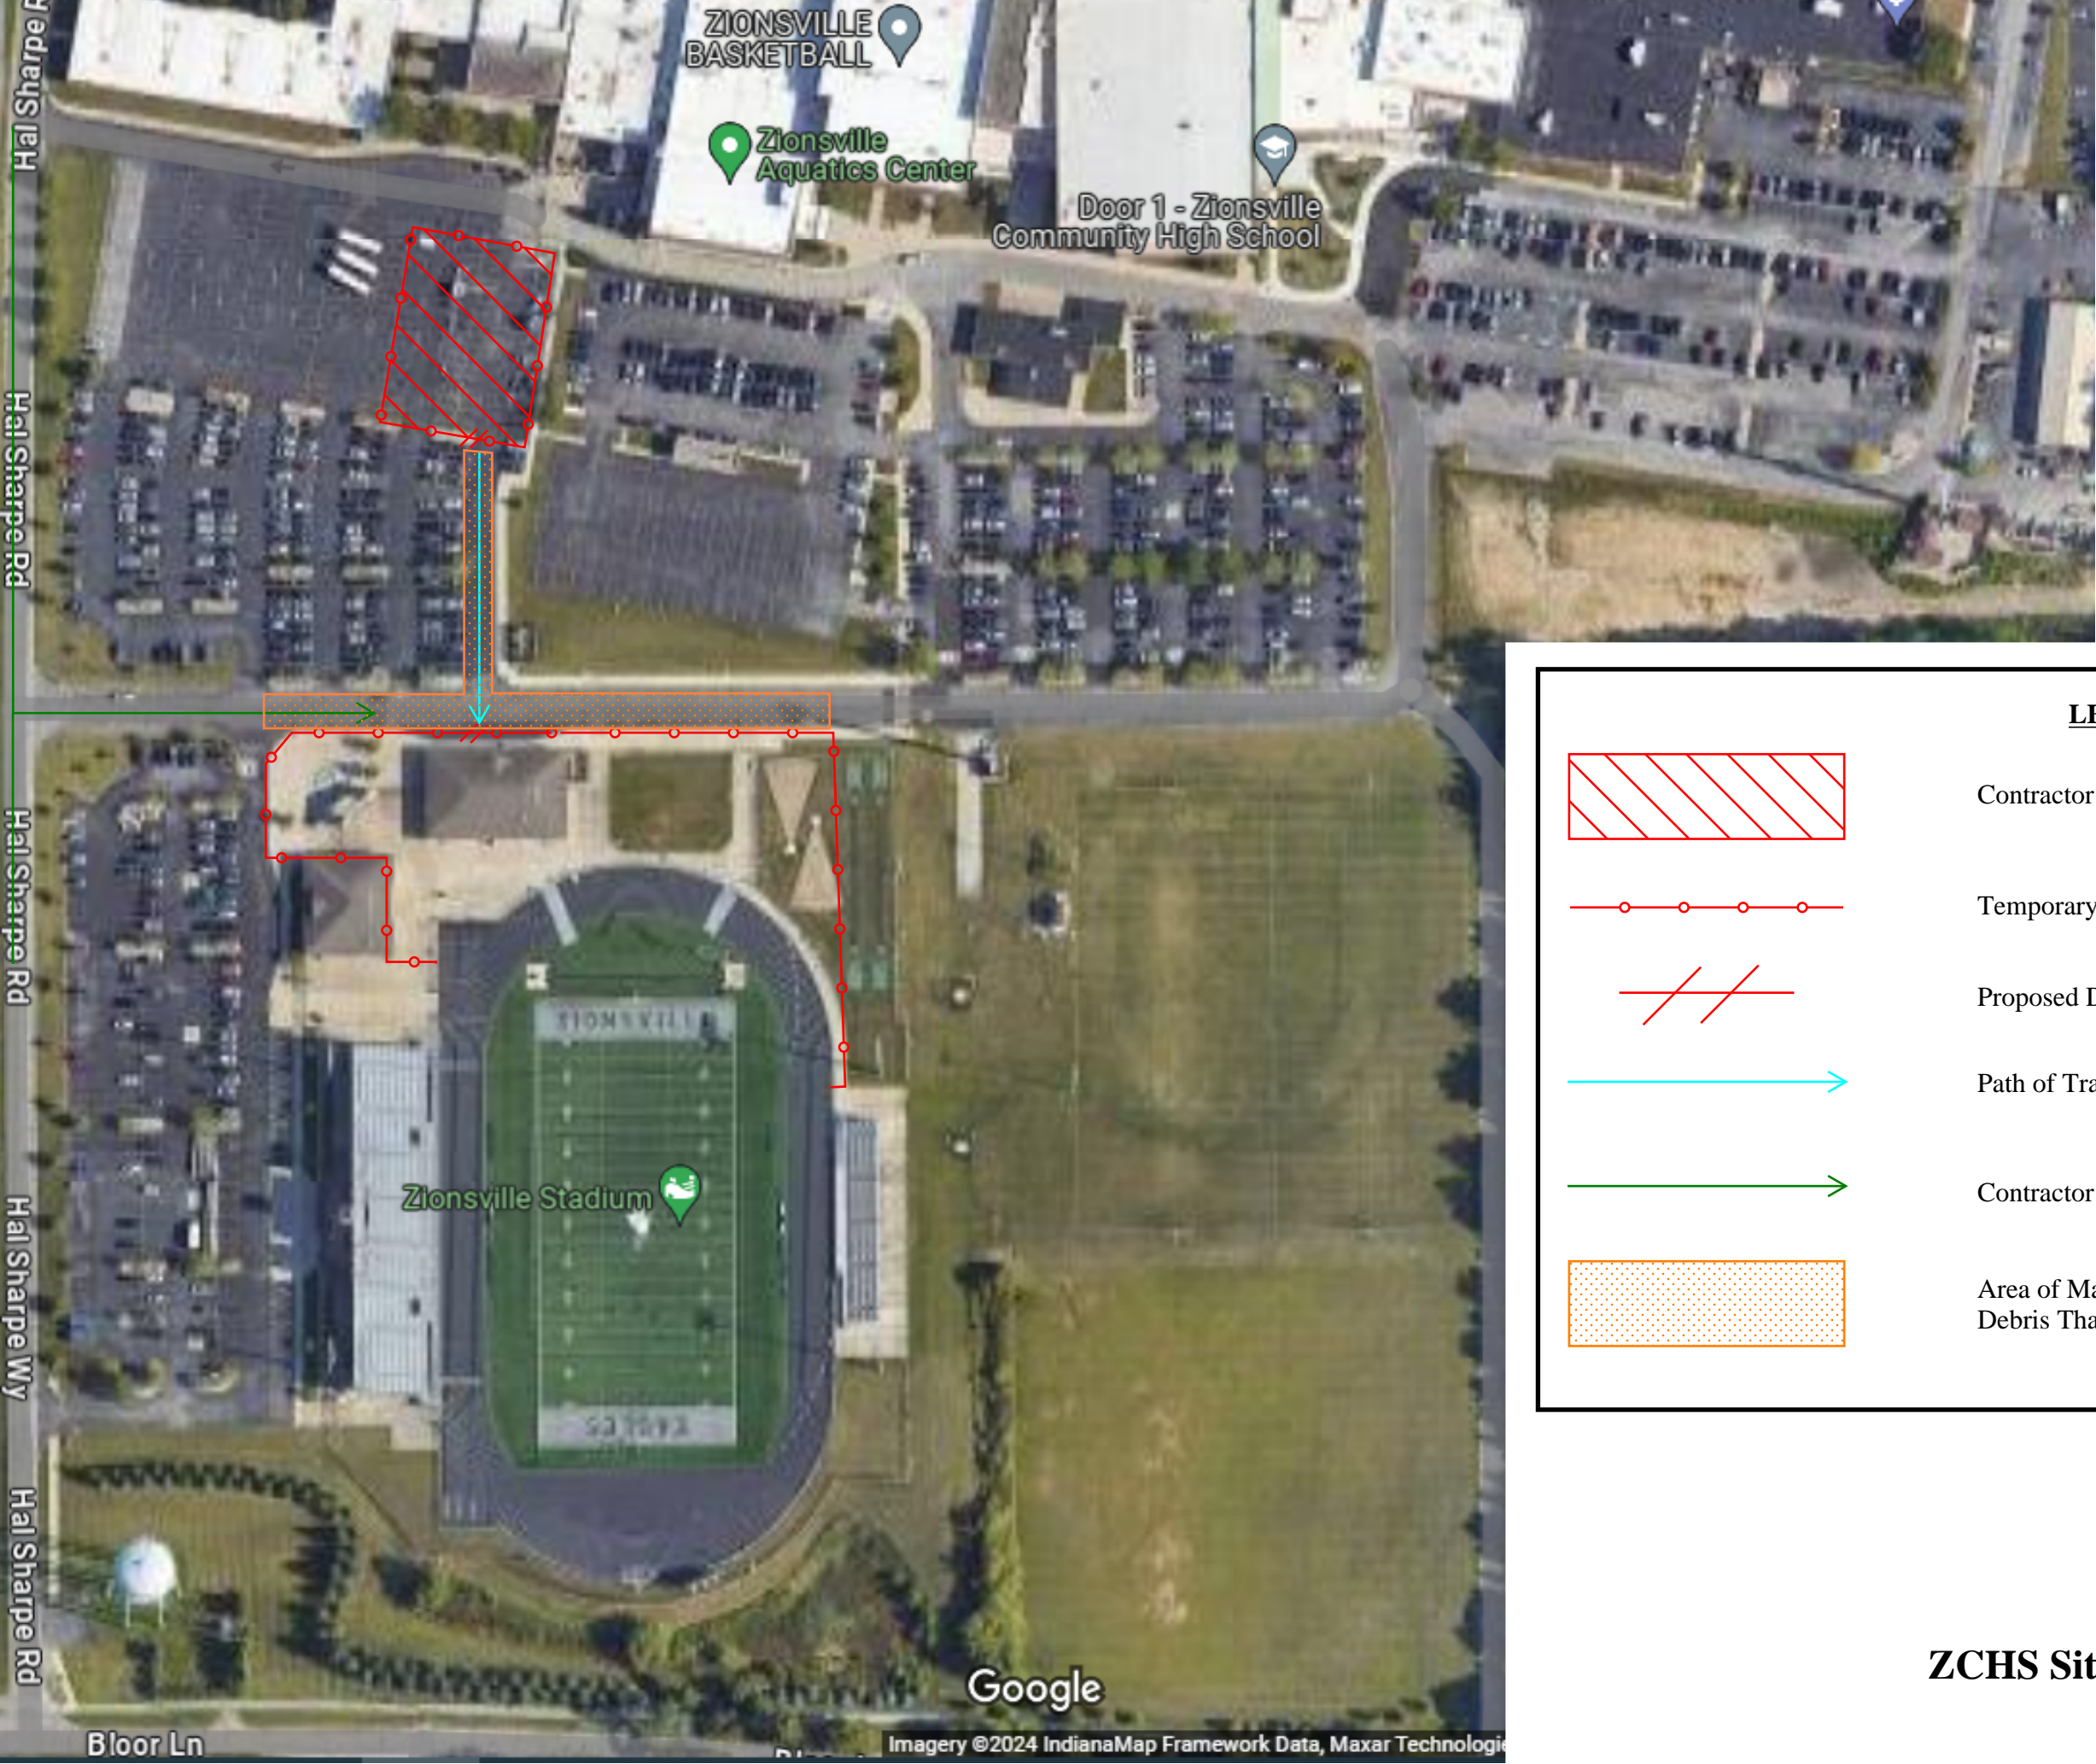


LEGEND:

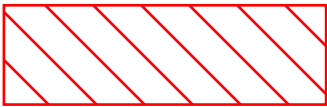

Contractor laydown and parking area.



Temporary Construction Fencing

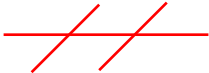


Proposed Double Gate for Access



Path of Travel To / From Laydown & Construction




Contractor Access to Project Site

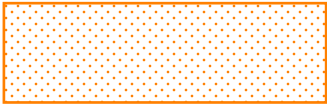

Area of Mandatory Street Sweeping / Cleaning to Avoid Debris That May Damage Vehicles

ZCHS Site Logistics Plan

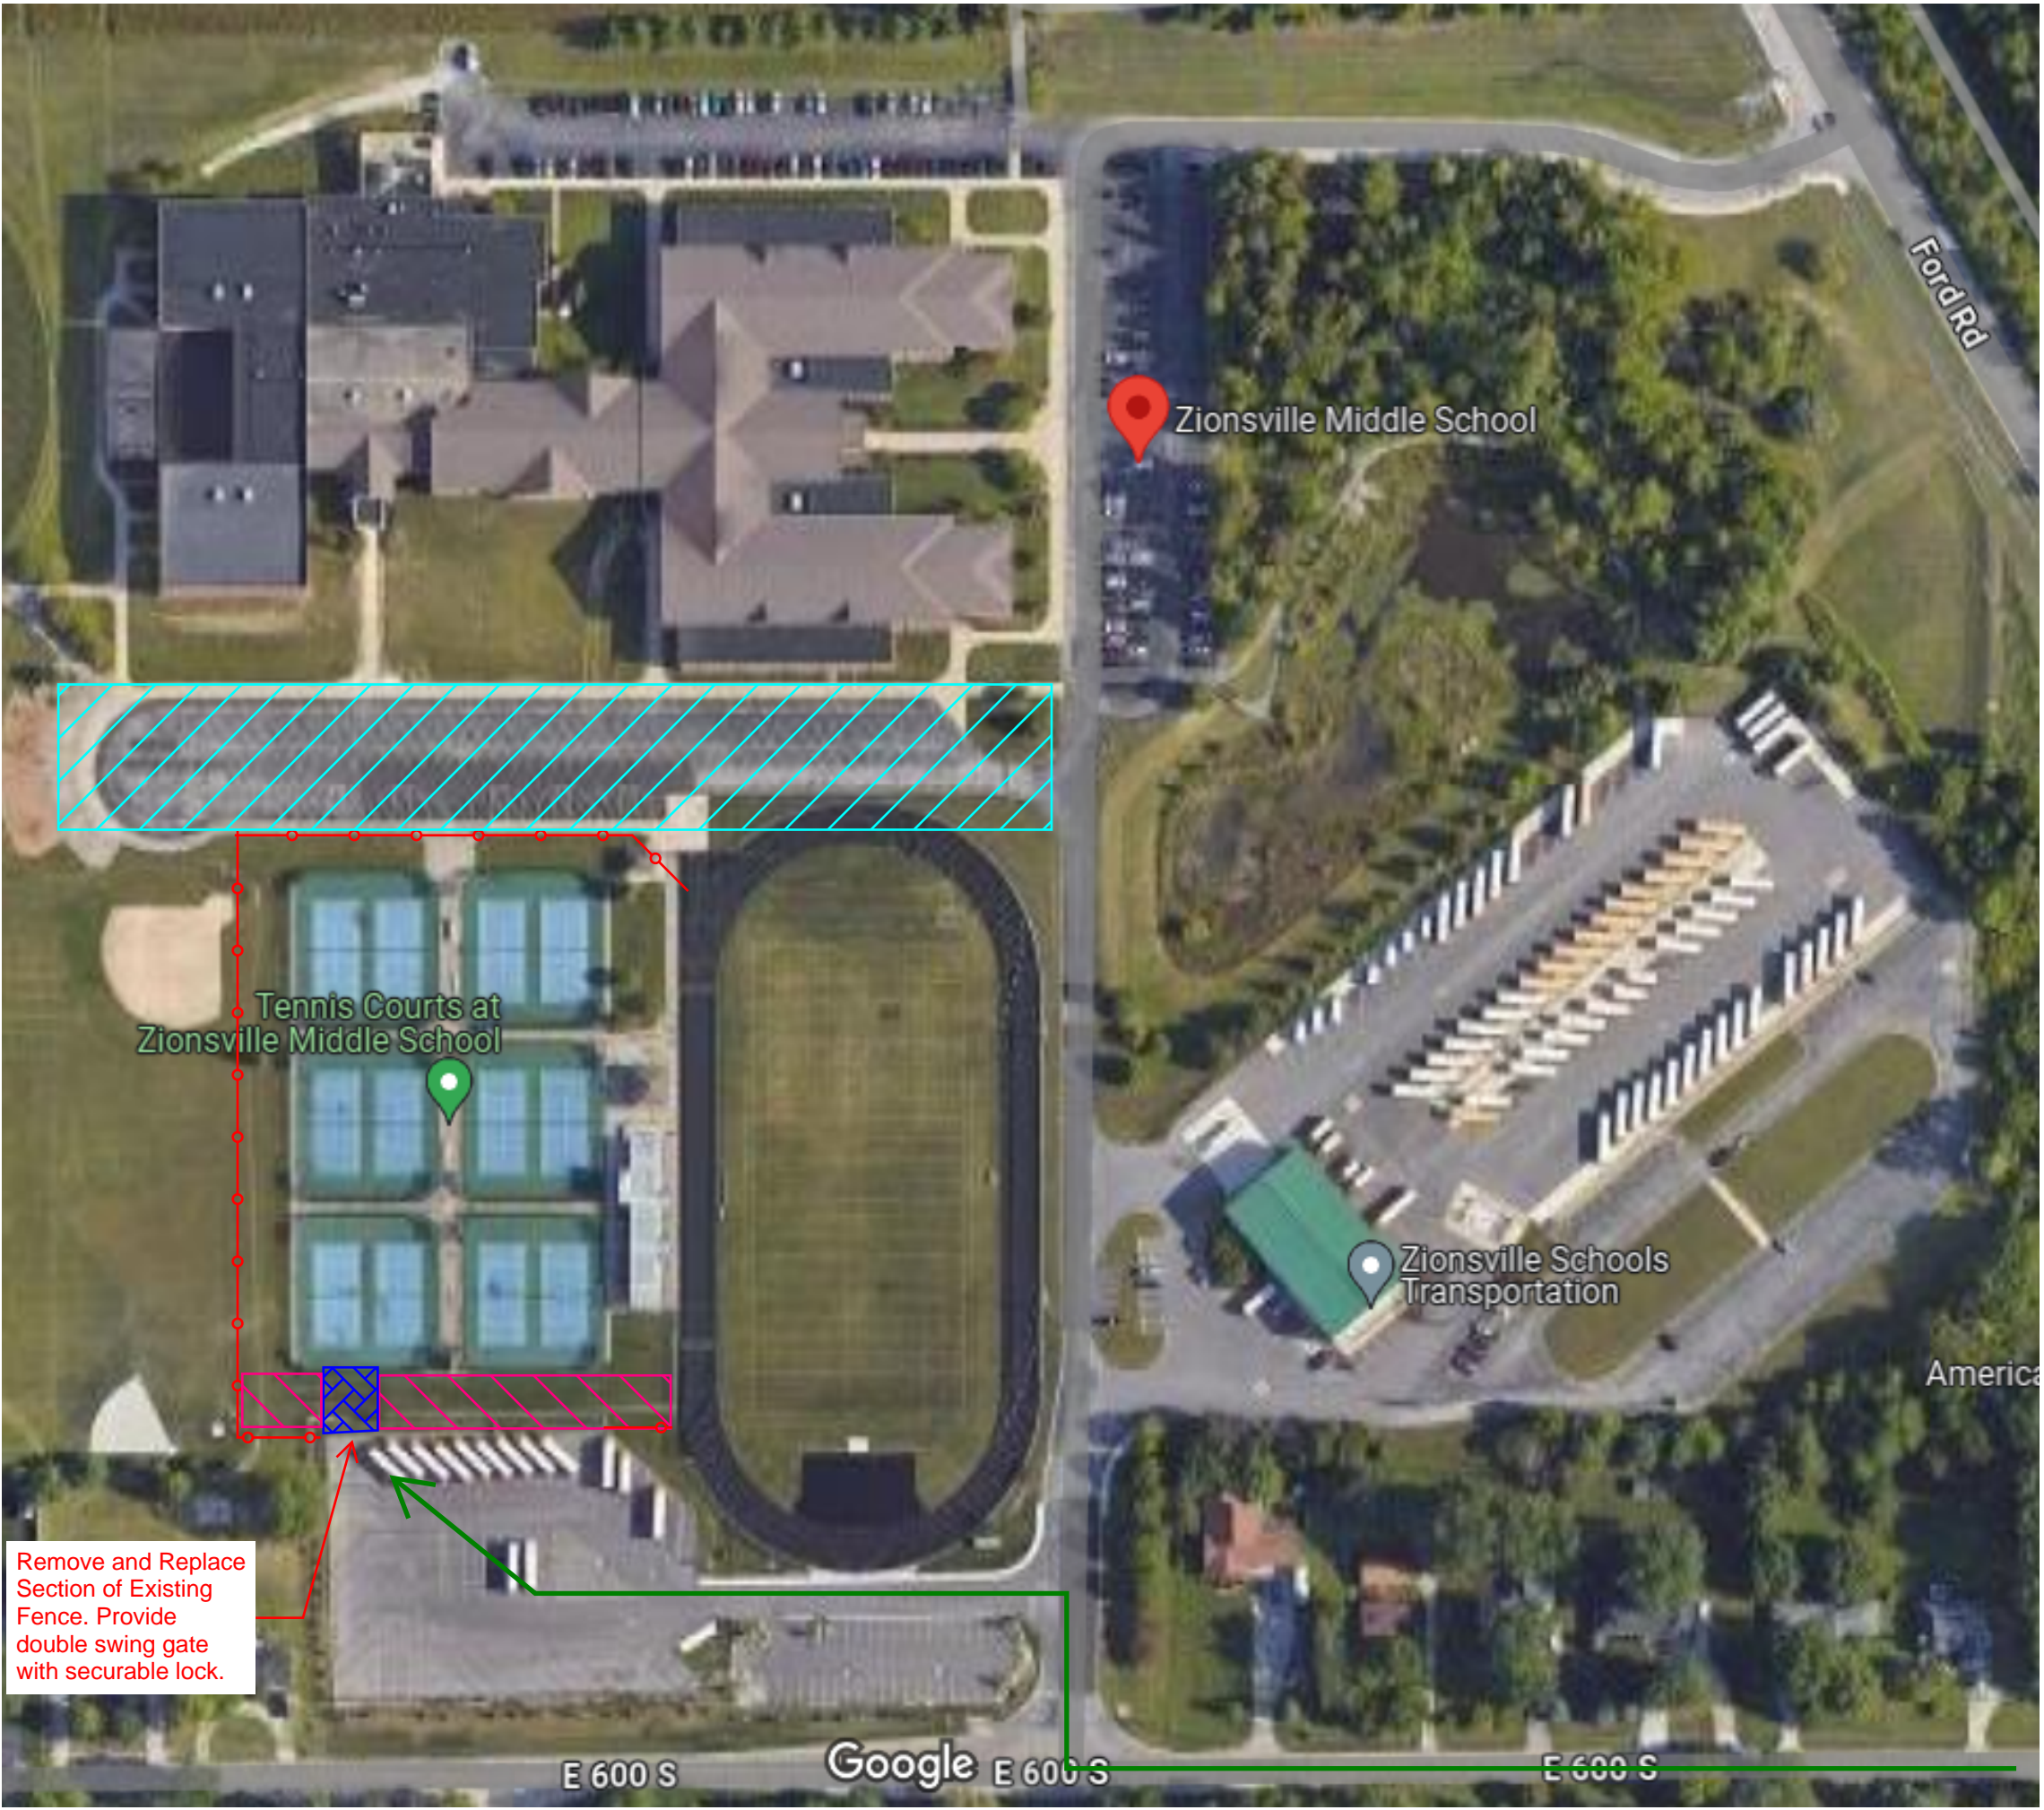

Remove and Replace
Section of Existing
Fence. Provide
double swing gate
with securable lock.

Temporary Construction Fencing


Temporary Stone Access Drive. 12" thick,
composed of 8" #8 stone and 4" #53 stone.
Intended for equipment and delivery access.

Temporary Contractor Parking and Laydown.
8" thick composed of #53 stone.

Prohibited Contractor / Equipment Delivery.
Not parking, staging or delivery in this area
at any time.

Access Route for Contractors and Delivery


ZCHS Site Logistics Plan

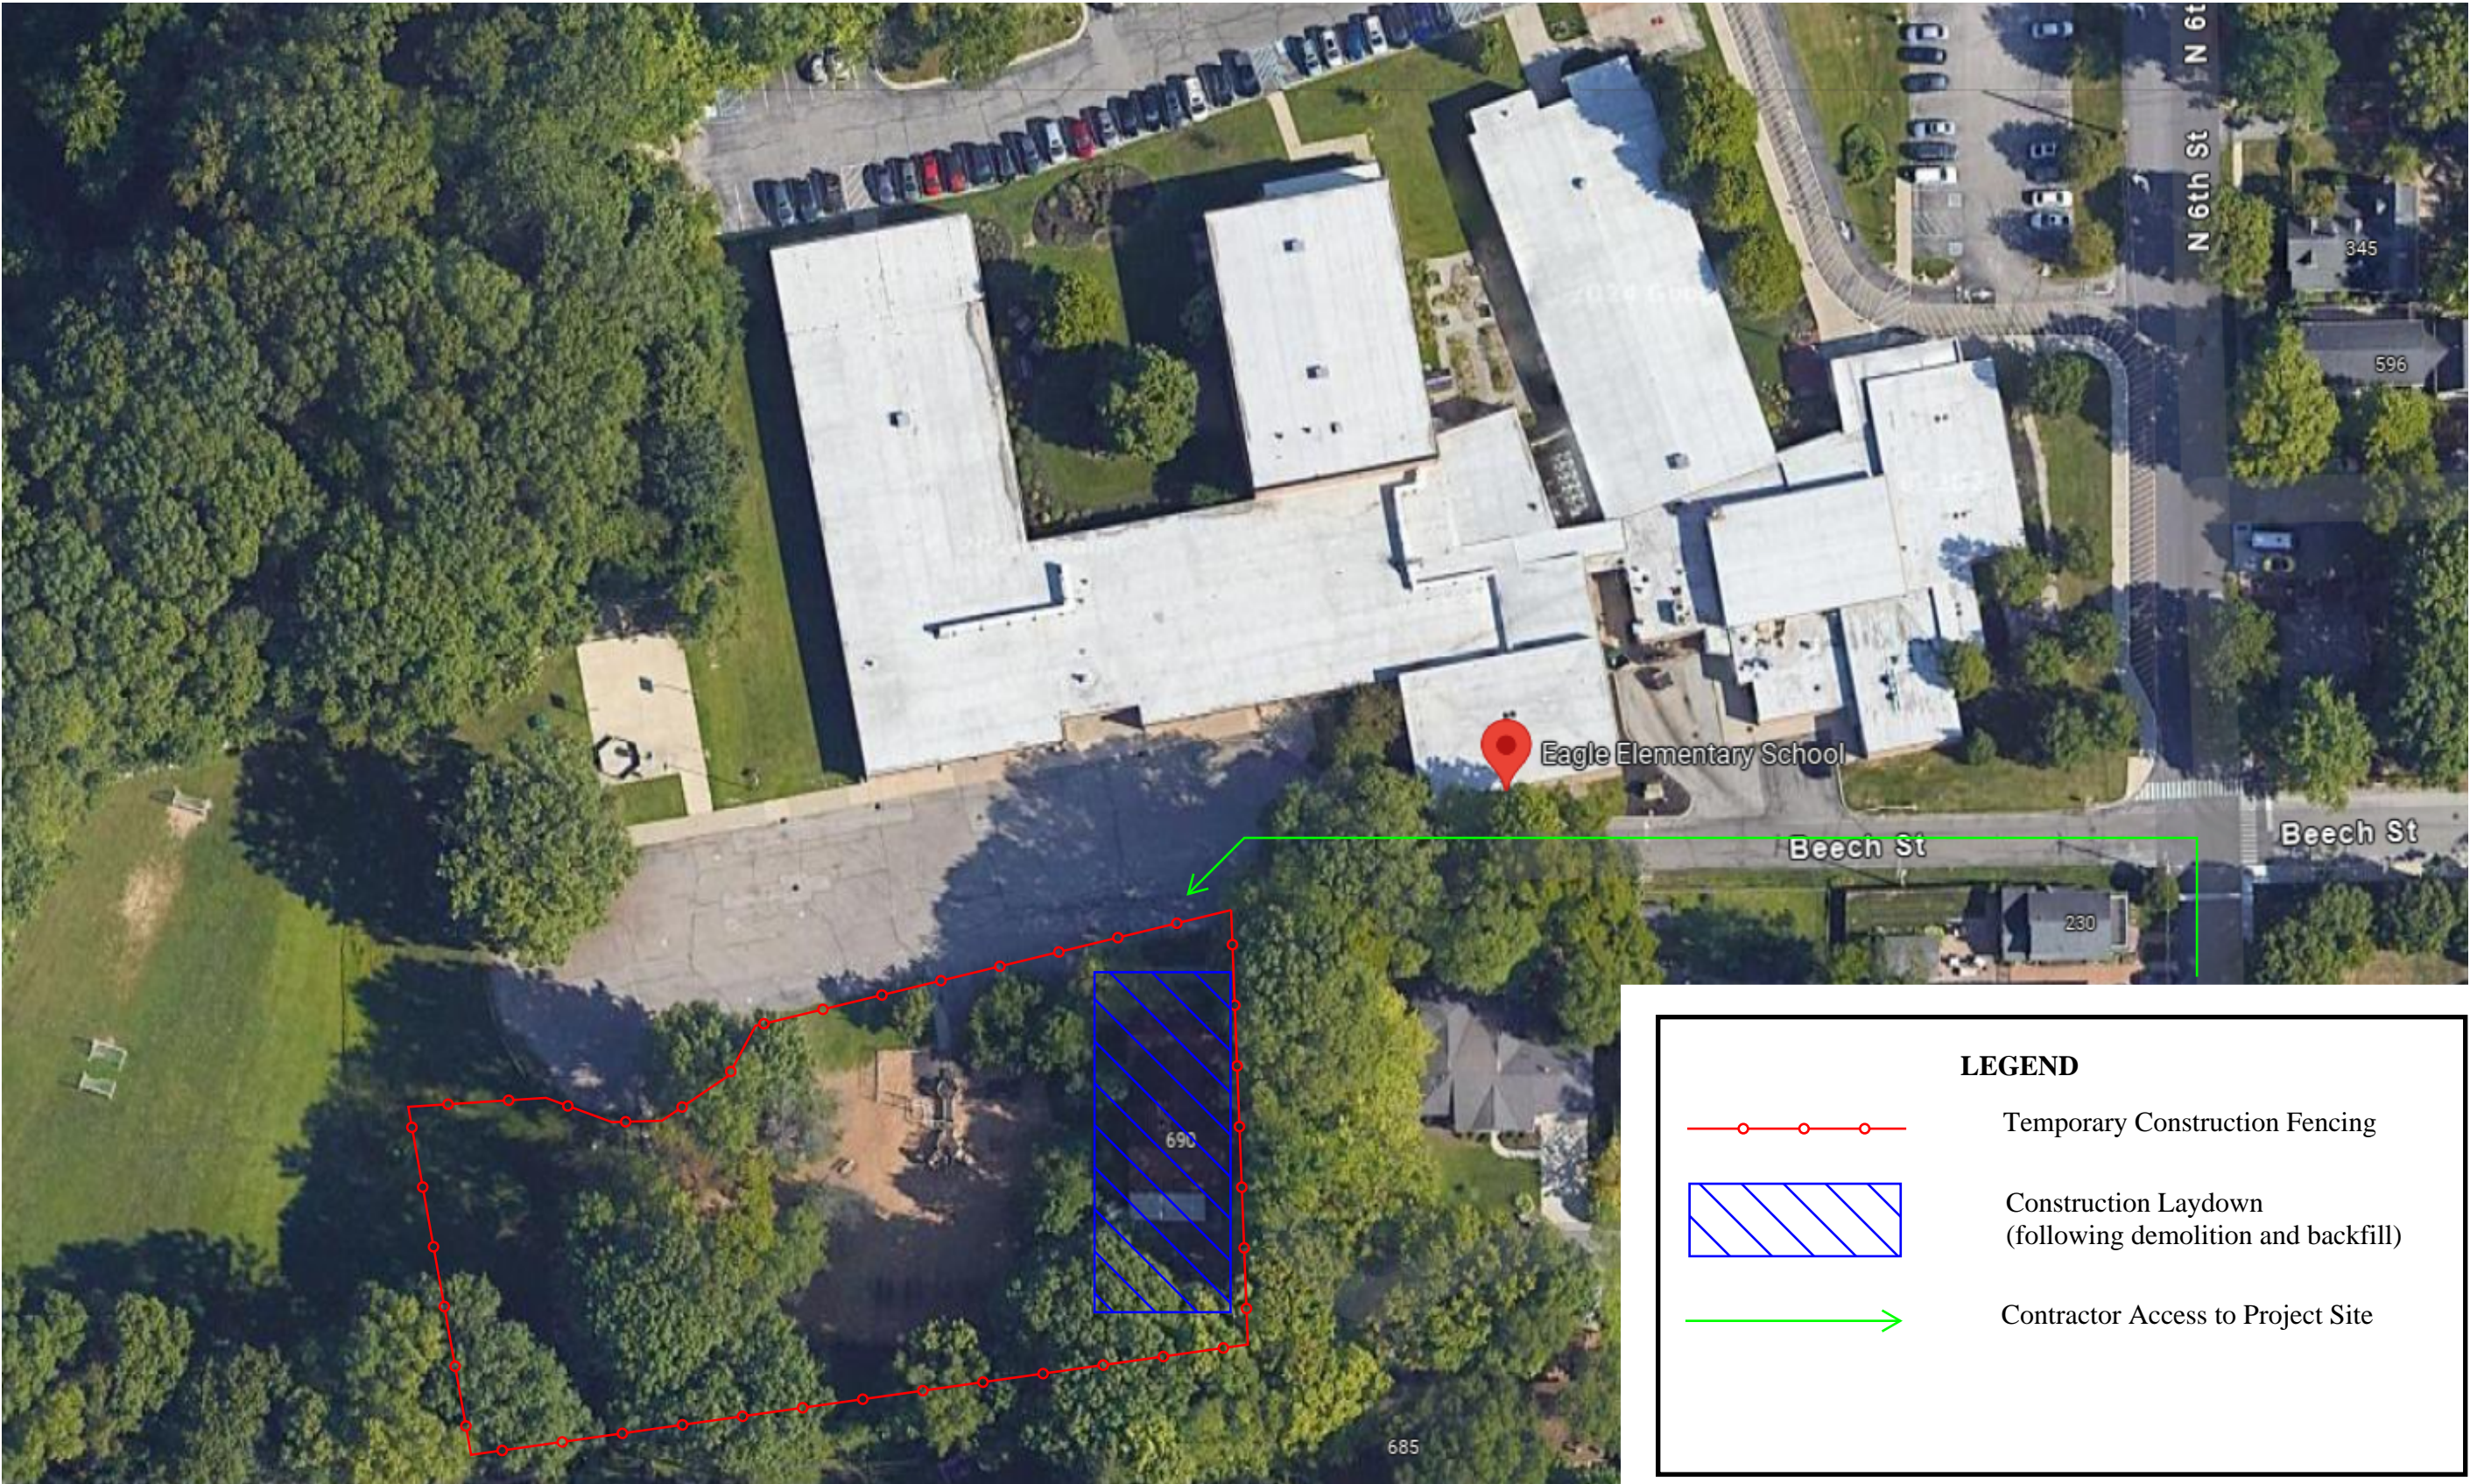








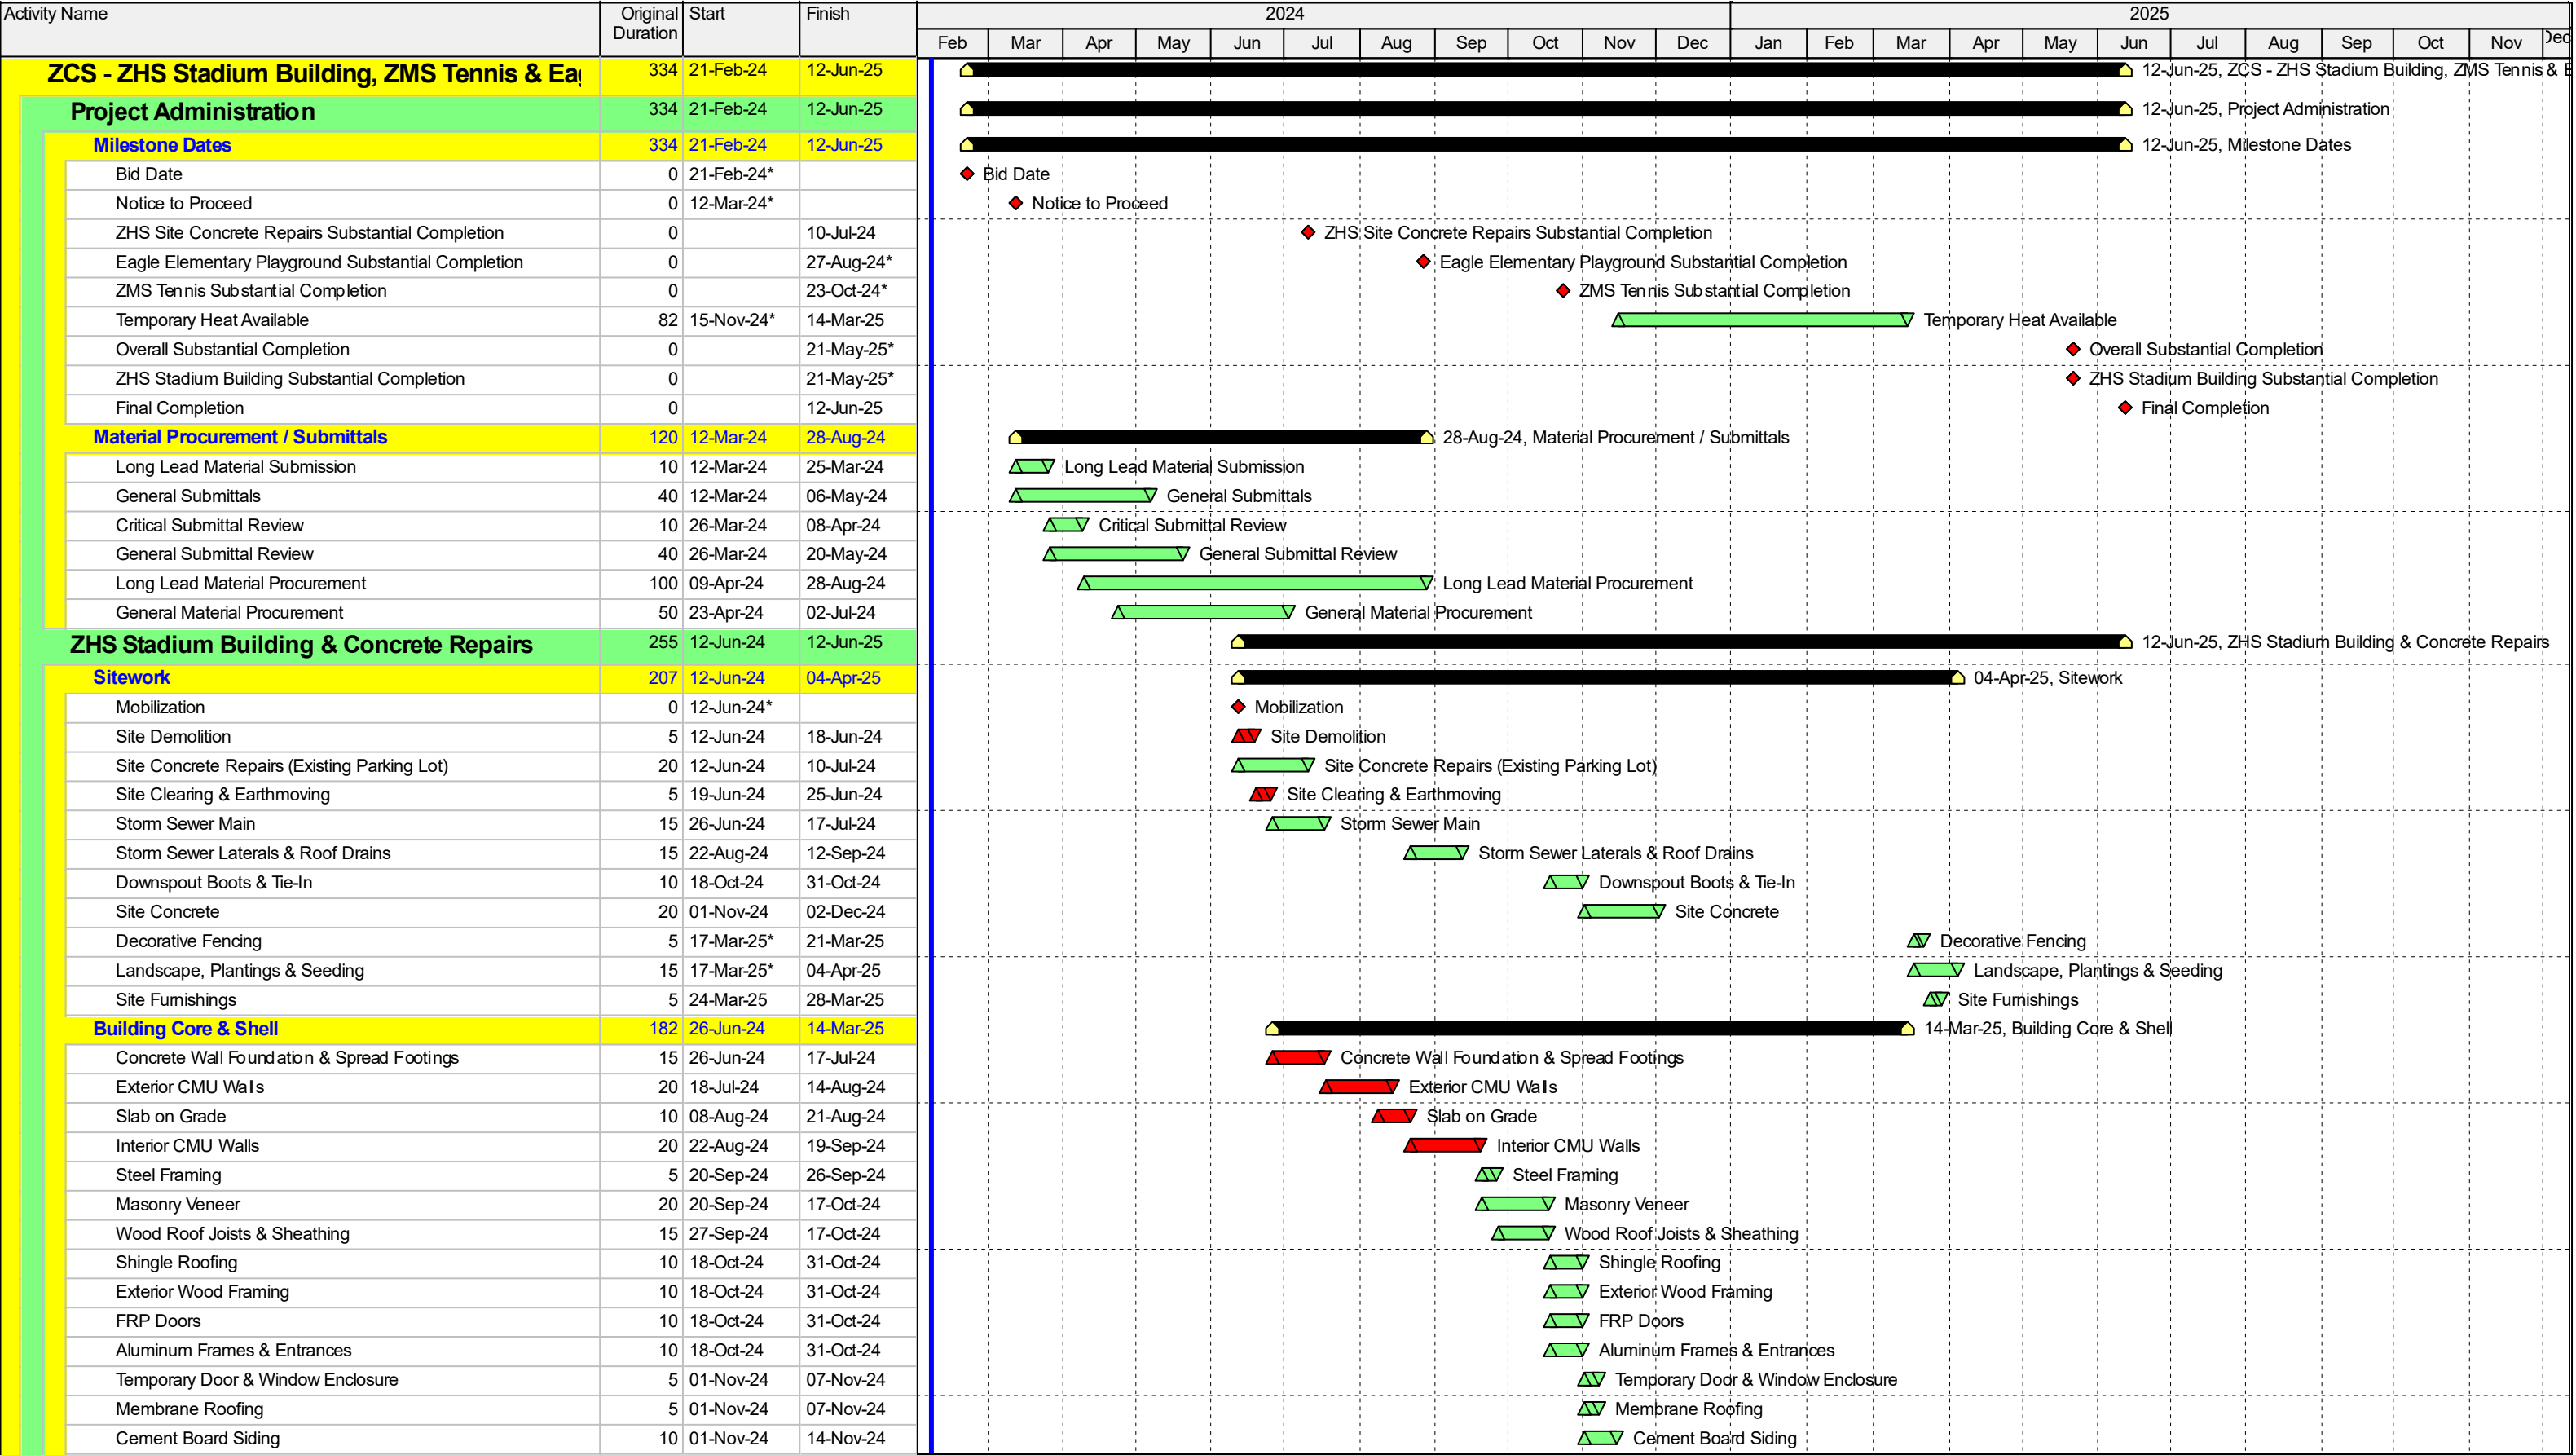

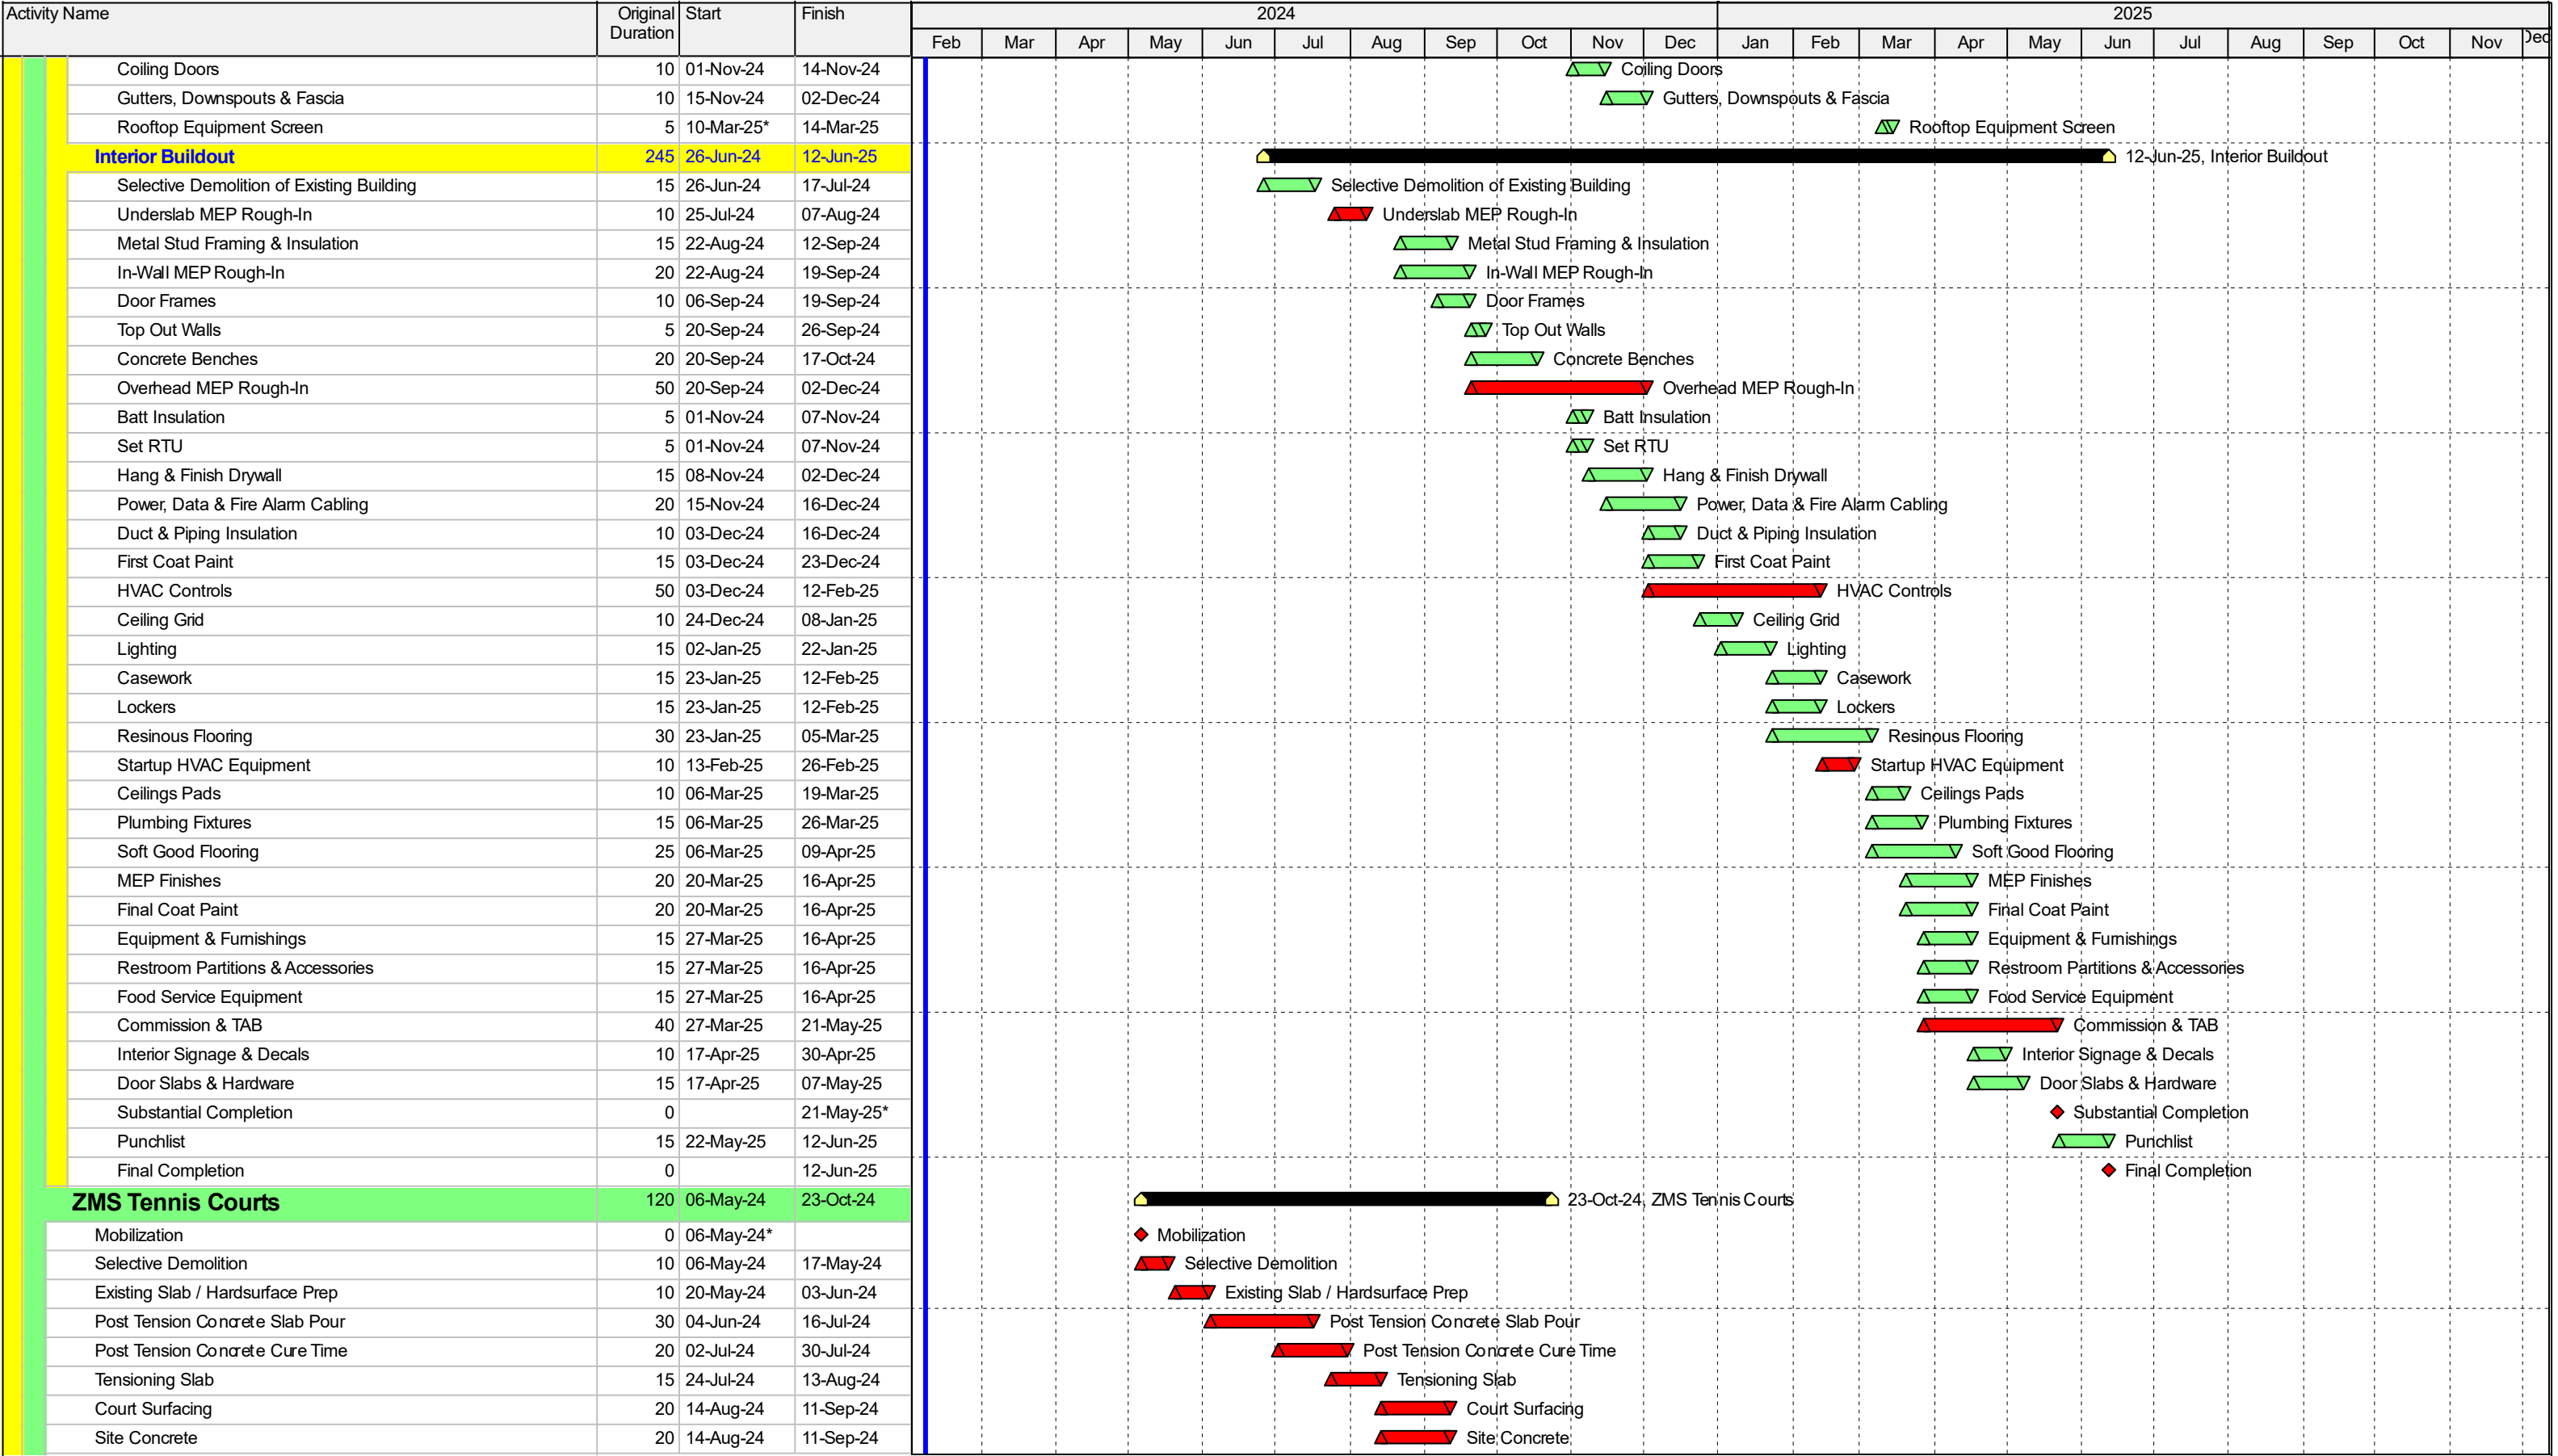




 







LEGEND

	Temporary Construction Fencing
	Construction Laydown (following demolition and backfill)
	Contractor Access to Project Site

  EAGLE ELEMENTARY SITE LOGISTICS PLAN





Activity Name		Original Duration	Start	Finish	2024												2025											
					Feb	Mar	Apr	May	Jun	Jul	Aug	Sep	Oct	Nov	Dec	Jan	Feb	Mar	Apr	May	Jun	Jul	Aug	Sep	Oct	Nov	Dec	
	Landscaping	10	12-Sep-24	25-Sep-24										Landscaping														
	Site Furnishings	15	12-Sep-24	02-Oct-24										Site Furnishings														
	Substantial Completion	0		02-Oct-24*										Substantial Completion														
	Punchlist	15	03-Oct-24	23-Oct-24										Punchlist														
	Final Completion	0		23-Oct-24										Final Completion														
	Eagle Playground	95	06-May-24	18-Sep-24					18-Sep-24, Eagle Playground																			
	Mobilization	0	06-May-24*						Mobilization																			
	House / Structure Demolition	10	06-May-24	17-May-24					House / Structure Demolition																			
	House / Structure Infill	5	20-May-24	24-May-24					House / Structure Infill																			
	Site / Playground Demolition	15	20-May-24	10-Jun-24					Site / Playground Demolition																			
	Site Clearing & Earthwork	10	11-Jun-24	24-Jun-24					Site Clearing & Earthwork																			
	Retaining Walls	15	25-Jun-24	16-Jul-24					Retaining Walls																			
	Playground Underdrains & Stone	5	10-Jul-24	16-Jul-24					Playground Underdrains & Stone																			
	Playground Equipment	10	17-Jul-24	30-Jul-24					Playground Equipment																			
	Site Concrete	20	17-Jul-24	13-Aug-24					Site Concrete																			
	Poured in Place Surface	15	31-Jul-24	20-Aug-24					Poured in Place Surface																			
	Landscaping	5	21-Aug-24	27-Aug-24					Landscaping																			
	Site Furnishings	5	21-Aug-24	27-Aug-24					Site Furnishings																			
	Substantial Completion	0		27-Aug-24*					Substantial Completion																			
	Punchlist	15	28-Aug-24	18-Sep-24					Punchlist																			
Final Completion	0		18-Sep-24					Final Completion																				

CONTRACTOR'S BID FOR PUBLIC WORKS FORM NO. 96

Format (Revised 2013)
(Amended for ZCS)

**ZCHS Stadium Locker Building & Concrete Repairs,
ZMS Tennis Courts and Eagle Elementary Building
Demolition & Playground Renovation**
Zionsville Community Schools
(Boone, County)

PART I

(To be completed for all bids. Please type or print)

Date (month, day, year): _____

BIDDER (Firm) _____

Address _____ P.O. Box _____

City/State/Zip ____

Telephone Number: _____ Email Address: _____

Person to contact regarding this Bid _____

Pursuant to notices given, the undersigned offers to furnish labor and/or materials necessary to complete the public works project of:

Insert Category No. (s) and Name(s)

Of public works project, ***ZCHS Stadium Locker Building & Concrete Repairs, ZMS Tennis Courts and Eagle Elementary Building Demolition & Playground Renovation***, in accordance with Plans and Specifications prepared by ***Fanning Howey Associates, 350 E New York St. Ste. #300, Indianapolis, IN 46204,*** as follows:

BASE BID

For the sum of _____
(Sum in words)

_____ DOLLARS (\$_____)
(Sum in figures)

Receipt of Addenda No. (s) _____

Bidder agrees that this Bid shall remain in force for a period of sixty (60) consecutive calendar days from the due date, and Bids may be accepted or rejected during this period. Bids not accepted within said sixty (60) consecutive calendar days shall be deemed rejected.

Attended pre-bid conference YES _____ NO _____

Has visited the jobsite YES _____ NO _____

The Bidder has reviewed the Guideline Schedule in Section 01 32 00 and the intent
Of the schedule can be met. YES NO

Bidder has included their Written Drug Testing Plan that covers all employees of the bidder who will perform work on the public work project and meets or exceeds the requirements set in IC 4-13-18-5 or IC 4-13-18-6.

The Skillman Corporation's diversity initiative is to create a program to encourage, assist and measure the active participation of Minority- Owned, Women-Owned, Veteran – Owned and Disabled Individual-Owned Businesses. The Program is to ensure that MWVDBEs are provided full and equal opportunity to participate in all Skillman Corporation's Projects.

Bidder has included:

DBE:	YES _____%	NO _____
MBE:	YES _____%	NO _____
WBE:	YES _____%	NO _____
VBE:	YES _____%	NO _____

The undersigned further agrees to furnish a bond or certified check with this Bid for an amount specified in the Notice to Bidders. If Alternate Bids apply, submit a proposal for each in accordance with the Plans and Specifications.

If additional units of material included in the contract are needed, the cost of units must be the same as that shown in the original contract if accepted by the governmental unit. If the bid is to be awarded on a unit bases, the itemization of the units shall be shown on a separate attachment.

The contractor and his subcontractors, if any, shall not discriminate against or intimidate any employee, or applicant for employment, to be employed in the performance of this contract, with respect to any matter directly or indirectly related to employment because of race, religion, color, sex, national origin or ancestry. Breach of this covenant may be regarded as a material breach of the contract.

CERTIFICATION OF USE OF UNITED STATES STEEL PRODUCTS
(if applicable)

I, the undersigned bidder, or agent as a contractor on a public works project, understand my statutory obligation to use steel products made in the United States (I.C. 5-16-8-2). I hereby certify that I and all subcontractors employed by me for this project will use U.S. steel on this project if awarded. I understand that violations hereunder may result in forfeiture of contractual payments.

ALTERNATE BIDS

A blank entry or an entry of "No Bid", "N/A", or similar entry on any Alternate will cause the bid to be rejected as non-responsive only if that Alternate is selected. If no change in the bid amount is required, indicate "No Change".

****MARK "ADD" OR "DEDUCT" FOR EACH ALTERNATE****

Alternate Bid No. 1 – Eagle Elementary School Park Shelter

Change the Base Bid the sum of _____
(sum in words)

_____ DOLLARS (\$_____) ADD
(sum in figures) DEDUCT

Alternate Bid No. 2 – Fire Alarm by Siemens

Change the Base Bid the sum of _____
(sum in words)

_____ DOLLARS (\$_____) ADD
(sum in figures) DEDUCT

Alternate Bid No. 3 – Fire Alarm by Notifier

Change the Base Bid the sum of _____
(sum in words)

_____ DOLLARS (\$_____) ADD
(sum in figures) DEDUCT

(Continue to next page)

Alternate Bid No. 4 – Fire Alarm by National Time and Signal Corporation

Change the Base Bid the sum of _____
(sum in words)

_____ DOLLARS (\$_____) ADD
(sum in figures) DEDUCT

PART II

(For projects of \$150,000 or more – IC 36-1-12-4)

These statements to be submitted under oath by each bidder with and as a part of his bid. (Attach additional pages for each section as needed.)

SECTION I EXPERIENCE QUESTIONNAIRE

1. What public works projects has your organization completed for the period of one (1) year prior to the date of the current bid?

Contract Amount	Class of Work	Completion Date	Name and Address of Owner

2. What public works projects are now in process of construction by your organization?

Contract Amount	Class of Work	Completion Date	Name and Address of Owner

3. Have you ever failed to complete any work awarded to you?_____ If so, where and why?

4. List references from private firms for which you have performed work.

SECTION II PLAN AND EQUIPMENT QUESTIONNAIRE

1. Explain your plan or layout for performing proposed Work. (Examples could include a narrative of when you could begin, complete the project, number of workers, etc. and any other information which you believe would enable the governmental unit to consider your bid.)

2. Please list the names and addresses of all subcontractors (i.e. persons or firms outside your own firm who have performed part of the work) that you have used on public works projects during the past five (5) years along with a brief description of the work done by each subcontractor.

3. If you intend to sublet any portion of the work, state the name and addresses of each subcontractor, equipment to be used by the subcontractor, and whether you will required a bond. However, if you are unable to currently provide a listing, please understand a listing must be provided prior to contract approval. Until the completion of the proposed project, you are under a continuing obligation to immediately notify the governmental unit in the event that you subsequently determine that you will use a subcontractor on the proposed project.

4. What equipment do you have available to use for the proposed Project? Any equipment used by subcontractors may also be required to be listed by the governmental unit.

5. Have you into contracts or received offers for all materials which substantiate the prices used in preparing your proposal? If not, please explain the rationale used which corroborate the process listed.

SECTION III CONTRACTOR'S FINANCIAL STATEMENT

Attachment of Bidder's financial statement is mandatory. Any Bid submitted without said financial statement as required by statute shall thereby be rendered invalid. The financial statement provided hereunder to the governing body awarding the Contract must be specific enough in detail so that said governing body can make a proper determination of the Bidder's capability for completing the Project if awarded.

SECTION IV CONTRACTOR NON-COLLUSION AFFIDAVIT

The undersigned Bidder or agent, being duly sworn on oath, says that he has not, nor has any other member, representative, or agent of the firm, company, corporation or partnership represented by him, entered into any combination, collusion or agreement with any person relative to the price to be bid by anyone at such letting nor to prevent any person from bidding nor to induce anyone to refrain from bidding, and that this Bid is made without reference to any other bid and without any agreement, understanding or combination with any other person in reference to such bidding.

He further says that no person or persons, firms, or corporations has, have, or will receive directly or indirectly, any rebate, fee, gift, commission, or thing of value on account of such contract.

SECTION V OATH AND AFFIRMATION

I HEREBY AFFIRM UNDER THE PENALTIES OF PERJURY THAT THE FACTS AND INFORMATION CONTAINED IN THE FOREGOING BID FOR PUBLIC WORKS ARE TRUE AND CORRECT

Dated at _____ this _____ day of _____, 20

(Name of Organization)

By

(Title of Person Signing)

ACKNOWLEDGEMENT

STATE OF _____)
) SS:
COUNTY OF _____)

Before me, a Notary Public, personally appeared the above-named

Swore that the statements contained in the foregoing document are true and correct.

Subscribed and sworn to before me this _____ day of _____,

(Title)

Notary Public

My Commission Expires: _____

County of Residence: _____

END OF SECTION 00 31 00

SECTION 01 23 00 - ALTERNATES

PART 1 - GENERAL

1.01 RELATED DOCUMENTS

- A. Drawings and general provisions of the Contract, including amended General Conditions and other Division 1 Specification Sections, apply to work of this Section.

1.02 PURPOSE

- A. The Bids for the Alternates described herein are required in order for the Owner to obtain information necessary for the proper consideration of the Project in its entirety.

1.03 ALTERNATES

- A. Definitions: Alternates are defined as alternate products, materials, equipment, installations, or systems for the Work, which may, at Owner's option and under terms established by Instructions to Bidders, be selected and recorded in the Owner-Contractor Agreement to either supplement or displace corresponding basic requirements of Contract Documents. Alternates may or may not substantially change scope and general character of the Work; and must not be confused with "allowances", "unit prices", "change orders", "substitutions", and other similar provisions.

1.04 SCHEDULE OF ALTERNATES

- A. ALTERNATE NO. 1: EAGLE ELEMENTARY SCHOOL PARK SHELTER
Base Bid: No new park shelter. Concrete slab/sidewalk area at the Park Shelter/Pavilion shall be part of base bid.
Alternate: Provide complete Park Shelter/Pavilion Structure with storage room as described within the Drawings and Specifications. This includes complete engineered and finished structure, foundations, and accessories. Electrical devices, receptacles, conduit, wiring and lighting within Park Shelter/Pavilion as indicated on the Electrical drawings shall also be included in the Alternate.
- B. ALTERNATE NO. 2: FIRE ALARM BY SIEMENS
Base Bid: Provide material, labor and equipment for installation of complete noncoded addressable system.
Alternate: Complete Fire Alarm system per Specification Section 28 31 11 utilizing Siemens parts, equipment and programming.
- C. ALTERNATE NO. 3: FIRE ALARM BY NOTIFIER
Base Bid: Provide material, labor and equipment for installation of complete noncoded addressable system.

Alternate: Complete Fire Alarm system per Specification Section 28 31 11 utilizing Notifier parts, equipment and programming.

D. ALTERNATE NO. 4: FIRE ALARM BY NATIONAL TIME AND SIGNAL CORPORATION

Base Bid: Provide material, labor and equipment for installation of complete noncoded addressable system.

Alternate: Complete Fire Alarm system per Specification Section 28 31 11 utilizing National Time and Signal Corporation parts, equipment and programming.

PART 2 - PRODUCTS, PART 3 - EXECUTION (Not Used)

END OF SECTION 01 23 00

ADDENDUM NO. 1

Zionsville Community High School Stadium Locker Building Addition and Renovation

Zionsville Community Schools
Zionsville, Indiana

Project No. 223139.00

Index of Contents

Addendum No. 1, 15 items, 5 pages

Revised Project Manual Section: 10 14 23.16 – Interior Panel Signage

Revised Drawing Sheets: G1.0, A0.01, AD0.01 A1.00, A1.01, A1.02, A5.01, A6S.01, A7S.01, A8S.01, PD1A, PP1A, MD.01, M2.01, M3.01, M4.01, M5.01, M5.02, M5.03, M5.04, M6.01, E1.02, E2.01, E5.01, E5.02, E6.01, E6.02, E7.01, and E8.01

Date: February 14, 2024

I hereby certify that this Addendum was prepared by me or under my direct supervision and that I am a duly registered Architect/Engineer under the Laws of the State of Indiana.

FANNING/HOWEY ASSOCIATES, INC.
ARCHITECTS/ENGINEERS/CONSULTANTS



Paul A. Miller, License No. AR10800161
Expiration Date: 12/31/2025

TO: ALL BIDDERS OF RECORD

ADDENDUM NO. 1 to Drawings and Project Manual, dated January 22, 2024, for Zionsville Community Schools, 900 Mulberry Street, Zionsville, Indiana; as prepared by Fanning/Howey Associates, Inc., Indianapolis, Indiana. This Addendum shall hereby be and become a part of the Contract Documents the same as if originally bound thereto.

The following clarifications, amendments, additions, revisions, changes, and modifications change the original Contract Documents only in the amount and to the extent hereinafter specified in this Addendum.

Each bidder shall acknowledge receipt of this Addendum in his proposal or bid.

NOTE: Bidders are responsible for becoming familiar with every item of this Addendum. (This includes miscellaneous items at the very end of this Addendum.)

RE: ALL BIDDERS

ITEM NO. 1. PROJECT MANUAL, TABLE OF CONTENTS

- A. Book 2, Page 00 01 10-2, DIVISION 10: Add Section 10 14 23.16 – Interior Panel Signage.

ITEM NO. 2. NEW PROJECT MANUAL SECTION(S)

- A. New Project Manual Section 10 14 23.16 – Interior Panel Signage is included with and hereby made a part of this Addendum.

ITEM NO. 3. PROJECT MANUAL, SECTION 08 71 00 – DOOR HARDWARE SETS

- A. Article 3.7, Door Hardware Sets: Revise Hardware Set No. 4.0 as follows:

Set: 4.0

Doors: A109A, A110A, B109A

2	Continuous Hinge	CFM_SLF-HD1 (Size as Required)		PE 087100
1	Self Latching Flush Bolt Set	2845 / 2945 (type as required)	US32D	RO 087100
1	Storeroom/Closet Lock	LC 8204 LNP	US26D	SA 087100
1	SFIC Mortise Cylinder Housing	Size and Cam as required	US32D	SA 087100
1	SFIC Core	SFIC Cylinder Core to be supplied under allowance		BE
2	Surface Closer	TB 351 CPS (HW SPG STP Arm)	EN	SA 087100
2	Blade Stop Spacer Kit	581-1 or 2 (as required)	EN	SA 087100
2	Kick Plate	K1050 8" high X 2" LDW CSK BEV	US32D	RO 087100
1	Rain Guard	346C		PE 087100
1	Perimeter Gaskets	Perimeter Gaskets by Door/Frame Manufacturer		OT

2	Sweep	3452AV	PE 087100
1	Threshold	2005AV ES14L	PE 087100
1	Door Position Switch	By Security Supplier	OT

Notes: * Provide Z Astragal from Door Manufacturer.

* Threshold to extend from Masonry to Masonry. Cope as Required.

* Weatherstrip supplied with aluminum frame & door.

* Coordinate all wiring & conduit with the electrical contractor.

* Door contacts monitor the position of the doors and reports status to the security system.

B. Article 3.7, Hardware Set No.12.0: Add Door No. A106A, A106B, B110A and B112A, to the list of doors.

C. Article 3.7, Hardware Set No.17.0: Delete Door No. A106A and A106B, from the list of doors.

D. Article 3.7, Hardware Set No. 23.0: Delete Door No. B110A and B112A, from the list of doors. Add Door No. B125B and B125C, to the list of doors. Revise Hardware Set No. 23.0 as follows:

Set: 23.0

Doors: B125B, B125C

1	Door Position Switch	By Security Supplier	OT
---	----------------------	----------------------	----

Notes: * Coordinate all wiring & conduit with the electrical contractor.

* Door contacts monitor the position of the doors and reports status to the security system.

E. Article 3.7, Hardware Set No.24.0: Delete Door No. B125B and B125C, from the list of doors.

ITEM NO. 4. PROJECT MANUAL, SECTION 09 21 16 – GYPSUM BOARD ASSEMBLIES

A. Add 2.1, A., 4., as follows:

- "4. Abuse-Resistant/Mold-Resistant Gypsum Boards
 - 1. Sheetrock Mold Tough AR; United States Gypsum Company
 - 2. Hi-Abuse XP Wallboard; National Gypsum Co.
 - 3. Extreme Abuse-Resistant with M2Tech; CertainTeed Gypsum, Inc.
 - 4. M-Bloc Impact Resistant; American Gypsum
 - 5. Den Armour Plus (Impact-Resistant); Georgia Pacific"

B. Add 2.6, D., as follows:

- "D. Abuse-Resistant/Mold-Resistant Gypsum Boards (Level 1) (ARGB): Boards shall be 5/8 inch thick, complying with Type X or C fire resistance in accordance with ASTM C1396, and C1629, and for NFPA Class 1 Flame Spread, Smoke Development and Fuel Contribution under ASTM E84.
 - 1. Surface Abrasion: ASTM C 1629, meets or exceeds Level 2 requirements.
 - 2. Indentation: ASTM C 1629, meets or exceeds Level 1 requirements.
 - 3. Soft-Body Impact: ASTM C 1629, meets or exceeds Level 1 requirements."

Addendum No. 1

Zionsville Community High School Stadium Locker Building Addition and Renovation
Zionsville Community Schools

ITEM NO. 5. PROJECT MANUAL, SECTION 10 51 13 – METAL LOCKERS

A. Replace 2.4, D., 1., a., as follows:

“a. Provide unperforated sides at lockers with solid doors, corner units, end of run against walls and where finished or box end panel is provided.”

B. Replace 2.4, P., 2., as follows:

“2. Boxed End Panels: Fabricated from 0.0528-inch thick, cold-rolled steel sheet.”

C. Replace 2.5, H., as follows:

“H. Boxed End Panels: Fabricated from 0.0528-inch thick steel sheet. Fabricated with 1-inch wide edge dimension, and designed for concealing fasteners and holes at exposed ends of nonrecessed metal lockers; finished to match lockers.”

D. Replace 3.2, C., 6., as follows:

“6. Attach boxed end panels with concealed fasteners only at perimeter to conceal exposed ends of nonrecessed metal lockers.”

ITEM NO. 6. PROJECT MANUAL, SECTION 12 32 16 – MANUFACTURED PLASTIC-LAMINATE FACED (EDUCATIONAL) CASEWORK

A. Add 2.10, C., 5., as follows:

“5. Substrate: 1 – 1-1/8 inch exterior glue particleboard.”

ITEM NO. 7. PROJECT MANUAL, SECTION 12 48 26.01 – ENTRANCE CARPET TILE

A. Delete 2.2, A., 1., in its entirety.

ITEM NO. 8. PROJECT MANUAL, SECTION 23 33 00 – AIR DUCT ACCESSORIES

A. Add 1.1, A., 10., as follows:

“10. Smoke Dampers.”

B. Add Article 2.11 as follows:

“2.11 SMOKE DAMPERS

A. Manufacturers: Subject to compliance, provide products by one of the following:

1. Air Balance Inc.; a division of Mestek, Inc.
2. Cesco Products; a division of Mestek, Inc.
3. Greenheck Fan Corporation.
4. Nailor Industries Inc.
5. PHL, Inc.
6. Ruskin Company.

B. General Requirements: Label according to UL 555S by an NRTL.

- C. Frame: Multiple-blade type; fabricated with roll-formed, 0.034-inch galvanized steel; with mitered and interlocking corners.
- D. Blades: Roll-formed, horizontal, interlocking, 0.034-inch, galvanized steel. In place of interlocking blades, use full-length, 0.034-inch, galvanized steel connectors.
- E. Leakage: Class II.
- F. Rated pressure and velocity to exceed design airflow conditions.
- G. Mounting Sleeve: Factory-installed, 0.052-inch, galvanized sheet steel; length to suit wall or floor application.
- H. Damper Motors: Two-position action.
- I. Comply with NEMA designation, temperature rating, service factor, enclosure type, and efficiency requirements for motors specified in Division 23 Section "Common Motor Requirements for HVAC Equipment."
 - 1. Motor Sizes: Minimum size as indicated. If not indicated, large enough so driven load will not require motor to operate in service factor range above 1.0.
 - 2. Controllers, Electrical Devices, and Wiring: Comply with requirements for electrical devices and connections specified in Division 26 Sections.
 - 3. Permanent-Split-Capacitor or Shaded-Pole Motors: with oil-immersed and sealed gear trains.
 - 4. Spring-Return Motors: Equip with an integral spiral-spring mechanism where indicated. Enclose entire spring mechanism in a removable housing designed for service or adjustments. Size for running torque rating of 150 in. x lbf and breakaway torque rating of 150 in. lbf.
 - 5. Outdoor Motors and Motors in Outdoor-Air Intakes: Equip with O-ring gaskets designed to make motors weatherproof. Equip motors with internal heaters to permit normal operation to minus 40oF.
 - 6. Nonspring-Return Motors: For dampers larger than 25 sq. ft., size motor for running torque rating of 150 in. x lbf and breakaway torque rating of 300 in. x lbf.
 - 7. Electrical Connection: 115 V, single phase, 60 Hz."

ITEM NO. 9. PROJECT MANUAL, SECTION 23 37 13 – DIFFUSERS, REGISTERS, AND GRILLES

- A. Article 2.3, G: Change "TMSA" to "OMNI" within paragraph.

ITEM NO. 10. PROJECT MANUAL, SECTION 28 31 11 – ADDRESSABLE FIRE-ALARM SYSTEM

- A. Change section 2.1, A., to read as:

- "A. Manufacturers: Subject to compliance with requirements, provide products by one of the following:
 - 1. Siemens Industry Inc, Building Technologies Division.
 - 2. NOTIFIER; part of the Honeywell's Fire Systems Group.
 - 3. National Time & Signal Corporation"

- B. Change sections 2.10, A., B., and C., to read as follows:

- "A. Digital alarm communicator transmitter shall be acceptable to the remote central station and shall comply with UL 632 and be listed and labeled by an NRTL, and comply with NFPA 72, 2016 edition.

- B. Dual-Path Communicator: Primary transmission channel for Internet Protocol (IP) communication connection and Secondary transmission channel for wireless cellular communication, and shall comply with UL 864 and be listed and labeled by an NRTL, and comply with NFPA 72, 2016 edition. Wireless communications protocol shall be compatible with the Owner's wireless service provider communications protocol. A separate, roof mounted antenna for wireless cellular communication shall be provided as required if signal reception from internal antenna on communicator is not sufficient.
- C. Functional Performance: Communicator units shall receive an alarm, supervisory, or trouble signal from fire-alarm control panel and automatically dial a preset number via for a remote central station via dedicated Internet Protocol (IP) communication. A secondary transmission channel via wireless cellular communicator shall also be employed. When contact is made with central station, signals shall be transmitted. If service on either channel is interrupted for longer than 45 seconds, transmitter shall initiate a local trouble signal and transmit the signal indicating loss of channel to the remote alarm receiving station over the remaining channel within 4 minutes. Transmitter shall automatically report communication service restoration to the central station. Local functions and display at the digital alarm communicator transmitter shall include the following:
1. Verification that both transmission channels are available.
 2. Programming device.
 3. LED display.
 4. Manual test report function and manual transmission clear indication.
 5. Communications failure with the central station or fire-alarm control panel."

ITEM NO. 11. REVISED DRAWING SHEETS

- A. Drawing Sheets: G1.0, A0.01, AD0.01 A1.00, A1.01, A1.02, A5.01, A6S.01, A7S.01, A8S.01, PD1A, PP1A, MD.01, M2.01, M3.01, M4.01, M5.01, M5.02, M5.03, M5.04, M6.01, E1.02, E2.01, E5.01, E5.02, E6.01, E6.02, E7.01, and E8.01 have been revised, dated 02/14/24, and are included with and hereby made a part of this Addendum. These Drawings supersede the original documents.

ITEM NO. 12. DRAWING SHEET NO. A1.01

- A. Revise all "W4A" wall tags to read "W4", typical.

ITEM NO. 13. DRAWING SHEET NO. A6.01

- A. Detail 5-A6.01: Remove "centered on wall" from Glazed Aluminum Storefront System note. Refer to dimension, as shown.

ITEM NO. 14. DRAWING SHEET NO. A7.01

- A. Equipment Notes: Revise Keynote 11 to read as follows:
- "11. EXISTING PROJECTOR AND PROJECTION SCREEN TO BE REINSTALLED BY OWNER IN EXISTING LOCATIONS."

ITEM NO. 15. DRAWING SHEET NO. A7.02

- A. Signage General Notes: Revise bullet point 4 to read as follows:
- ALL EXTERIOR SIGNS TO BE ETCHED ZINC MATERIAL, UNLESS NOTED OTHERWISE. INTERIOR SIGNS TO BE ACRYLIC, UNLESS NOTED OTHERWISE.

END OF ADDENDUM

SECTION 10 14 23.16 – INTERIOR PANEL SIGNAGE

PART 1 - GENERAL

1.1 SUMMARY

- A. This Section includes the following:
 - 1. Panel signs, including room-identification signs that are directly attached to building.
 - a. Acrylic
 - 2. Field-applied, vinyl-character signs
 - 3. Directories
 - a. Evacuation plan holders
- B. Related Sections include the following:
 - 1. Division 22 Section "Identification of Plumbing Piping and Equipment" for labels, tags, and nameplates for plumbing systems and equipment.
 - 2. Division 23 Section "Identification of HVAC Piping and Equipment" for labels, tags, and nameplates for HVAC systems and equipment.
 - 3. Division 26 Section "Identification for Electrical Systems" for labels, tags, and nameplates for electrical equipment.
 - 4. Division 26 Section "Interior Lighting" for illuminated Exit signs.

1.2 DEFINITIONS

- A. Accessibility Standard: U.S. Department of Justice's "2010 ADA Standards for Accessible Design."

1.3 COORDINATION

- A. Coordinate placement of anchorage devices with templates for installing signs.

1.4 ACTION SUBMITTALS

- A. Product Data: For each type of product indicated.
- B. Shop Drawings: Show fabrication and installation details for signs.
 - 1. Show sign mounting heights, locations of supplementary supports to be provided by others, and accessories.
 - 2. Provide message list, typestyles, graphic elements, including tactile characters and Braille, and layout for each sign.
- C. Samples for Initial Selection: Manufacturer's color charts consisting of actual units or sections of units showing the full range of colors available for the following:

1.5 CLOSEOUT SUBMITTALS:

- A. General: Closeout Submittals are to be submitted with O and M Manuals only. Do not submit with other ACTION and INFORMATIONAL Submittals:
 - 1. Maintenance Data: For signs to include in maintenance manuals.
 - 2. Warranty: Special warranty specified in this Section.

1.6 QUALITY ASSURANCE

- A. Regulatory Requirements: Signage shall be provided to conform to the USDOJ's "2010 ADA Standards for Accessible Design", ICC/ANSI A117.1, and State and Local Regulations. These requirements supersede Technical Specifications in this Section.

1.7 FIELD CONDITIONS

- A. Field Measurements: Verify locations of anchorage devices embedded in permanent construction by field measurements before fabrication and indicate measurements on Shop Drawings.

1.8 WARRANTY

- A. Special Warranty: Manufacturer's standard form in which manufacturer agrees to repair or replace components of signs that fail in materials or workmanship within specified warranty period.
 - 1. Failures include, but are not limited to, the following:
 - a. Deterioration of finishes beyond normal weathering.
 - b. Deterioration of embedded graphic image, colors, and sign lamination.
 - 2. Warranty Period: Five years from date of Substantial Completion.

PART 2 - PRODUCTS

2.1 MANUFACTURER

- A. Manufacturers: Subject to compliance with requirements, provide signage by one of the manufacturers specified.
 - 1. Panel Signs
 - a. Acrylic
 - 1) ASI Sign Systems, Inc.
 - 2) Advance Corporation
 - 3) 2/90 Sign Systems
 - 4) ACS Sign Systems
 - 5) Forty-Nine Degrees
 - 6) Interior Graphic Systems
 - 7) ACE Sign Systems
 - 8) ASE, Inc.
 - 9) Best Sign Systems
 - 10) Contemporary Plastics Inc.
 - 11) Essential Architectural Signs, Inc.
 - 12) Jarob
 - 13) Roban Signs
 - 14) Sign Solutions
 - 15) Appenx Architectural Signage
 - 16) Ellet Sign Company
 - 17) Sign PDQ
 - 18) REM Graphics and Signs LLC; Raster Braille Signage
 - 19) Identity Group Interior Sign Solution
 - 20) ISF Signs (Indianapolis)
 - 21) Landmark Sign
- B. Products of other manufacturers will be considered for acceptance provided they equal or exceed the material requirements and functional qualities of the specified product. The "Substitution Request Form" Sample sign, and complete technical data for evaluation must accompany requests for A/E's approval. All materials for evaluation must be received by the Project Manager and Specification Department at least 10 days prior to bid due date. Additional approved manufacturers will be issued by Addendum.

2.2 PERFORMANCE REQUIREMENTS

- A. Accessibility Standard: Comply with applicable provisions in the USDOJ's "2010 ADA Standards for Accessible Design," ICC A117.1, and requirements of authorities with jurisdiction for signs.

2.3 MATERIALS

- A. Acrylic Sheet: ASTM D 4802, Category A-1 (cell-cast sheet), Type UVF (UV filtering).
- B. Vinyl Film: UV-resistant vinyl film of nominal thickness indicated, with pressure-sensitive, permanent adhesive on back; die cut to form characters or images as indicated and suitable for exterior applications.
- C. Paints and Coatings for Sheet Materials: Inks, dyes, and paints that are recommended by manufacturer for optimum adherence to surface and are UV and water resistant for colors and exposure indicated.

2.4 PANEL SIGNS (INTERIOR SIGNAGE)

- A. Signage, General:
 - 1. Graphic Process: Comply with ADA Accessibility Guidelines and ICC/ANSI A117.1. All letters, numbers, and/or symbols shall contrast with background either light characters on a dark background or dark characters on a light background. Characters and background shall have matte finish.
 - a. Graphic Content and Style: Provide sign copy that complies with requirements indicated for size, style, spacing, content, mounting height and location, material, finishes, and color of signage.
 - 2. Characters: Letters and numbers shall have width to height ratio between 3:5 and 1:1 and a stroke width to height ratio between 1:5 and 1:10. Letters and numbers shall be raised 1/32-inch, uppercase, sans serif or simple sans serif type and shall be accompanied with Grade 2 Braille. Raised characters shall be 5/8-inch high minimum and 2 inches high maximum. Equivalent written description must be placed directly below pictogram. Pictogram can be any size within a minimum field of 6 inches in height. Produce precisely formed characters with square cut edges free from burrs and cut marks.
- B. Material:
 - 1. Acrylic Panel, fabricated in accordance with one of the following methods:
 - a. Acrylic signs
 - 1) Acrylic sheet shall be CNC cut to specifications with square or radius corners, and/or custom shapes, 0.080 inch minimum.
 - 2) 1/32 inch modified acrylic plate shall be adhered to the acrylic plate with a high bond chemical adhesive and the text and/or symbols shall be CNC cut to specifications.
 - a) Option: One layer of 1/4 inch acrylic with .062 inch backer when needed.
 - 3) Corresponding text and/or symbols shall be CNC cut from 1/16 inch modified acrylic embedded 1/32 inch and bond with chemical adhesive to the acrylic plate.
 - 4) Domed grade 2 Braille shall be embedded in the surface.
 - 5) Comply with requirements indicated for material, color, finish, design, shape, size, and details of construction.
 - b. Double panel (window) sign with changeable insert(s).
 - 1) Tactile appliqué: Opaque, single ply, modified acrylic sheet not less than 0.032 inch in thickness.
 - 2) Braille: Braille dots shall consist of 0.0625 optically clear UV stable acrylic spheres.
 - 3) Face laminate: Clear, non-glare, cast acrylic sheet not less than 0.080 inch in thickness.
 - 4) Backing sheet: Expanded PVC sign board or acrylic sheet not less than 0.125 inch in thickness.
 - 5) Changeable insert: Provide one of the following:
 - a) Paper inserts by Owner.

- C. Unframed Panel Signs: Fabricate signs with edges mechanically and smoothly finished to comply with the following requirements:
 - 1. Edge Condition: Eased, unless otherwise noted.
 - 2. Corner Condition: Rounded to a 3/8 inch radius, unless otherwise noted.
 - 3. Backer Sheet: Include a solid backer, 1/8 inch thick of acrylic sheet for all signs occurring on glass sidelights. Color shall match sign background color.

2.5 FIELD-APPLIED, VINYL-CHARACTER SIGNS

- A. Field-Applied, Vinyl-Character Sign: Prespaced characters die cut from 3 to 3.5 mil thick, weather-resistant vinyl film with release liner on the back and carrier film on the front for on-site alignment and application.
 - 1. Manufacturers: Subject to compliance with requirements provide one of the following:
 - a. Allen Markings
 - b. APCO Graphics, Inc.
 - c. Mohawk Sign Systems
 - d. Seton Identification Products
 - 2. Size: As indicated on Drawings.
 - 3. Substrate: As indicated on Drawings.
 - 4. Text and Font: As indicated on Drawings.

2.6 DIRECTORIES

- A. Evacuation Plan Holders: Provide one of the following in compliance with the authorities with jurisdiction:
 - 1. Acrylic Wall Mounted Sign Holder: Holds 8-1/2 inch by 11 inch signs. Acrylic frame has a "foldover" design allowing insert of signs from the top for easy changing. The wall mounted frame shall have precut holes for hanging.
 - a. Manufacture: Subject to compliance with requirements provide one of the following:
 - 1) Acrylic Wall mounted Sign Holder: Azar Displays
 - 2) Acrylic Sign Holder; Displays2Go
 - 3) Wallmount Sign Holder; Allen Display

2.7 ACCESSORIES

- A. Fasteners and Anchors: Manufacturer's standard as required for secure anchorage of signage, noncorrosive and compatible with each material joined, complying with the following:
 - 1. Use concealed fasteners and anchors, unless indicated to be exposed.
 - 2. Sign Mounting Fasteners
 - a. Concealed Studs: Concealed (blind), threaded studs welded or brazed to back of sign material or screwed into back of sign assembly, unless otherwise indicated.
 - 3. Inserts: Furnish inserts to be set by other trades into concrete or masonry work.
- B. Two-Face Tape: Use double-sided vinyl tape or silicone adhesive fabricated from materials that are not corrosive to sign material and mounting surface.
- C. Adhesive: As recommended by sign manufacturer.

2.8 FABRICATION

- A. General: Provide manufacturer's standard signs of configurations indicated.
 - 1. Welded Connections: Comply with AWS standards for recommended practices in shop welding. Provide welds behind finished surfaces without distortion or discoloration of exposed side. Clean exposed welded surfaces of welding flux and dress exposed and contact surfaces.
 - 2. Mill joints to tight, hairline fit. Form joints exposed to weather to exclude water penetration.

3. Preassemble signs in the shop to greatest extent possible. Disassemble signs only as necessary for shipping and handling limitations. Clearly mark units for reassembly and installation, in location not exposed to view after final assembly.
4. Conceal fasteners if possible; otherwise, locate fasteners where they will be inconspicuous.
5. Internally brace signs for stability and for securing fasteners.
6. Provide rebates, lugs, and brackets necessary to assemble components and to attach to existing work. Drill and tap for required fasteners. Use concealed fasteners where possible; use exposed fasteners that match sign finish.

- B. Subsurface-Applied Graphics: Apply graphics to back face of clear faced-sheet material to produce precisely formed image. Image shall be free of rough edges.
- C. Shop and Subsurface-Applied Vinyl: Align vinyl film in final position and apply to surface. Firmly press film from the middle outward to obtain good bond without blisters or fish mouths.

2.9 FINISHES, GENERAL

- A. Comply with NAAMM's "Metal Finishes Manual for Architectural and Metal Products" for recommendations for applying and designating finishes.
- B. Protect mechanical finishes on exposed surfaces from damage by applying a strippable, temporary protective covering before shipping.
- C. Appearance of Finished Work: Variations in appearance of abutting or adjacent pieces are acceptable if they are within one-half of the range of approved Samples. Noticeable variations in the same piece are not acceptable. Variations in appearance of other components are acceptable if they are within the range of approved Samples and are assembled or installed to minimize contrast.

2.10 ACRYLIC SHEET FINISHES

- A. Colored Coatings for Acrylic Sheet: For copy and background colors, provide colored coatings, including inks, dyes, and paints, that are recommended by acrylic manufacturers for optimum adherence to acrylic surface and that are UV and water resistant for five years for application intended.

PART 3 - EXECUTION

3.1 EXAMINATION

- A. Examine substrates, areas, and conditions, with Installer present, for compliance with requirements for installation tolerances and other conditions affecting performance of work.
- B. Verify that sign-support surfaces are within tolerances to accommodate signs without gaps or irregularities between backs of signs and support surfaces, unless otherwise indicated.
- C. Verify that anchor inserts are correctly sized and located to accommodate signs.
- D. Proceed with installation only after unsatisfactory conditions have been corrected.

3.2 INSTALLATION

- A. General: Install signs and accessories, using mounting methods of types described and complying with manufacturer's written instructions.
 1. Install signs level, plumb, and at heights indicated, with sign surfaces free of distortion and other defects in appearance.

2. Install signs on walls adjacent to latch side of door where applicable. Where not indicated or possible, such as double doors, install signs on nearest adjacent walls. Locate to allow approach within 3 inches of sign without encountering protruding objects or standing within swing of door.
 3. Before installation, verify that sign surfaces are clean and free of materials or debris that would impair installation.
 4. Install signs so they do not protrude or obstruct according to the accessibility standard.
- B. Accessibility Signs: Installation height and location shall comply with applicable provisions in the U.S. Architectural and Transportation Barriers Compliance Board's ADA-ABA Accessibility Guidelines for Buildings and Facilities and ICC A117.1 for signs.
1. Height above finish floor or ground: Tactile characters on signs shall be located 48 inches minimum above the "finish" floor or ground surface, measured from the base line of the lowest tactile character and 60 inches maximum above the finish floor or ground surface, measured from the baseline of the height tactile character.
 - a. Exception: Tactile characters for elevator car controls shall not be required to comply.
 2. Location: Where a tactile sign is provided at a door, the sign shall be located alongside the door latch side. Where a tactile sign is provided at double doors with one active leaf, the sign shall be located on the inactive leaf. Where a tactile sign is provided at double doors with two active leaves, the sign shall be located to the right of the right hand door. Where there is no wall space at the latch side of a single door or at the right side of double doors, signs shall be located on the nearest adjacent wall. Signs containing tactile characters shall be located so that a clear floor space of 18 inches minimum by 18 inches minimum, centered on tactile characters, is provided beyond the arc of any door swing between the closed position and 45 degree open position.
 - a. Exception: Signs with tactile characters shall be permitted on the push side of doors with closures and without hold-open devices.
- C. Wall-Mounted Panel Signs: Comply with sign manufacturer's written instructions except where more stringent requirements apply.
1. Silicone-Adhesive Mounting: Attach signs to irregular, porous, or vinyl-covered surfaces. Use double-sided tape when recommended by sign manufacturer to hold sign in place until adhesive has fully cured. Apply tape strips symmetrically to back of sign and of suitable quantity to support weight of sign without slippage. Keep strips away from edges to prevent visibility at sign edges. Place sign in position, and push to engage tape adhesive.
 2. Adhesive: Clean bond-breaking materials from substrate surface and remove loose debris. Apply linear beads or spots of adhesive symmetrically to back of sign and of suitable quantity to support weight of sign after cure without slippage. Keep adhesive away from edges to prevent adhesive extrusion as sign is applied and to prevent visibility of cured adhesive at sign edges. Place sign in position, and push to engage adhesive. Temporarily support sign in position until adhesive fully sets.
 3. Shim Plate Mounting: Provide 1/8 inch thick, concealed aluminum shim plates with predrilled and countersunk holes, at locations indicated, and where other mounting methods are not practicable. Attach plate with fasteners and anchors suitable for secure attachment to substrate. Attach panel signs to plate using method specified above.
 4. Signs Mounted on Glass: Provide matching opaque plate on opposite side of glass to conceal mounting materials.
- D. Field-Applied, Vinyl-Character Signs: Clean and dry substrate. Align sign characters in final position before removing release liner. Remove release liner in stages, and apply and firmly press characters into final position. Press from the middle outward to obtain good bond without blisters or fish mouths. Remove carrier film without disturbing applied vinyl film.

3.3 ADJUSTING AND CLEANING

- A. Remove and replace damaged or deformed signs and signs that do not comply with specified requirements. Replace signs with damaged or deteriorated finishes or components that cannot be successfully repaired by finish touchup or similar minor repair procedures.
- B. Remove temporary protective coverings and strippable films as signs are installed.
- C. On completion of installation, clean exposed surfaces of signs according to manufacturer's written instructions, and touch up minor nicks and abrasions in finish. Maintain signs in a clean condition during construction and protect from damage until acceptance by Owner.

END OF SECTION 10 14 00

PRE-BID REQUEST FOR INTERPRETATION/CLARIFICATION LOG

223139.00	1	2/12/24	Substitution Request for Thermoplastic Membrane Roofing; proposed substitution – Mule-Hide Products, .060 PVC roof system, including all components and accessories.	07 54 00	Substitution Not Approved
-----------	---	---------	--	----------	---------------------------


Drawing Path: P:\2023\1001_4750 CAD\Civil\Drawings\4 - 2023-075 Site Plan.dwg
Plotted By: dachur Time of Plot: 2/13/24 - 5:17pm Last Edited: 2/13/24 - 5:15pm



Know what's below.
Call before you dig.
Call 811 or 1-800-368-5844 before you begin any Digging Project.
Call 48 hours or 2 working days before you dig.
It's Fast, It's Easy and It's the Law in the state of Indiana!

CAUTION !!

THE LOCATIONS OF ALL EXISTING UNDERGROUND UTILITIES SHOWN ON THE PLAN ARE BASED UPON ABOVE GROUND EVIDENCE (INCLUDING, BUT NOT LIMITED TO, MANHOLES, INLETS, VALVES, AND MARKS MADE UPON THE GROUND BY OTHERS) AND ARE SPECULATIVE IN NATURE. THERE MAY ALSO BE OTHER EXISTING UNDERGROUND UTILITIES FOR WHICH THERE IS NO ABOVE GROUND EVIDENCE OR FOR WHICH NO ABOVE GROUND EVIDENCE WAS OBSERVED. THE EXACT LOCATIONS OF EXISTING UNDERGROUND UTILITIES SHALL BE VERIFIED BY CONTRACTOR PRIOR TO ANY AND ALL CONSTRUCTION.

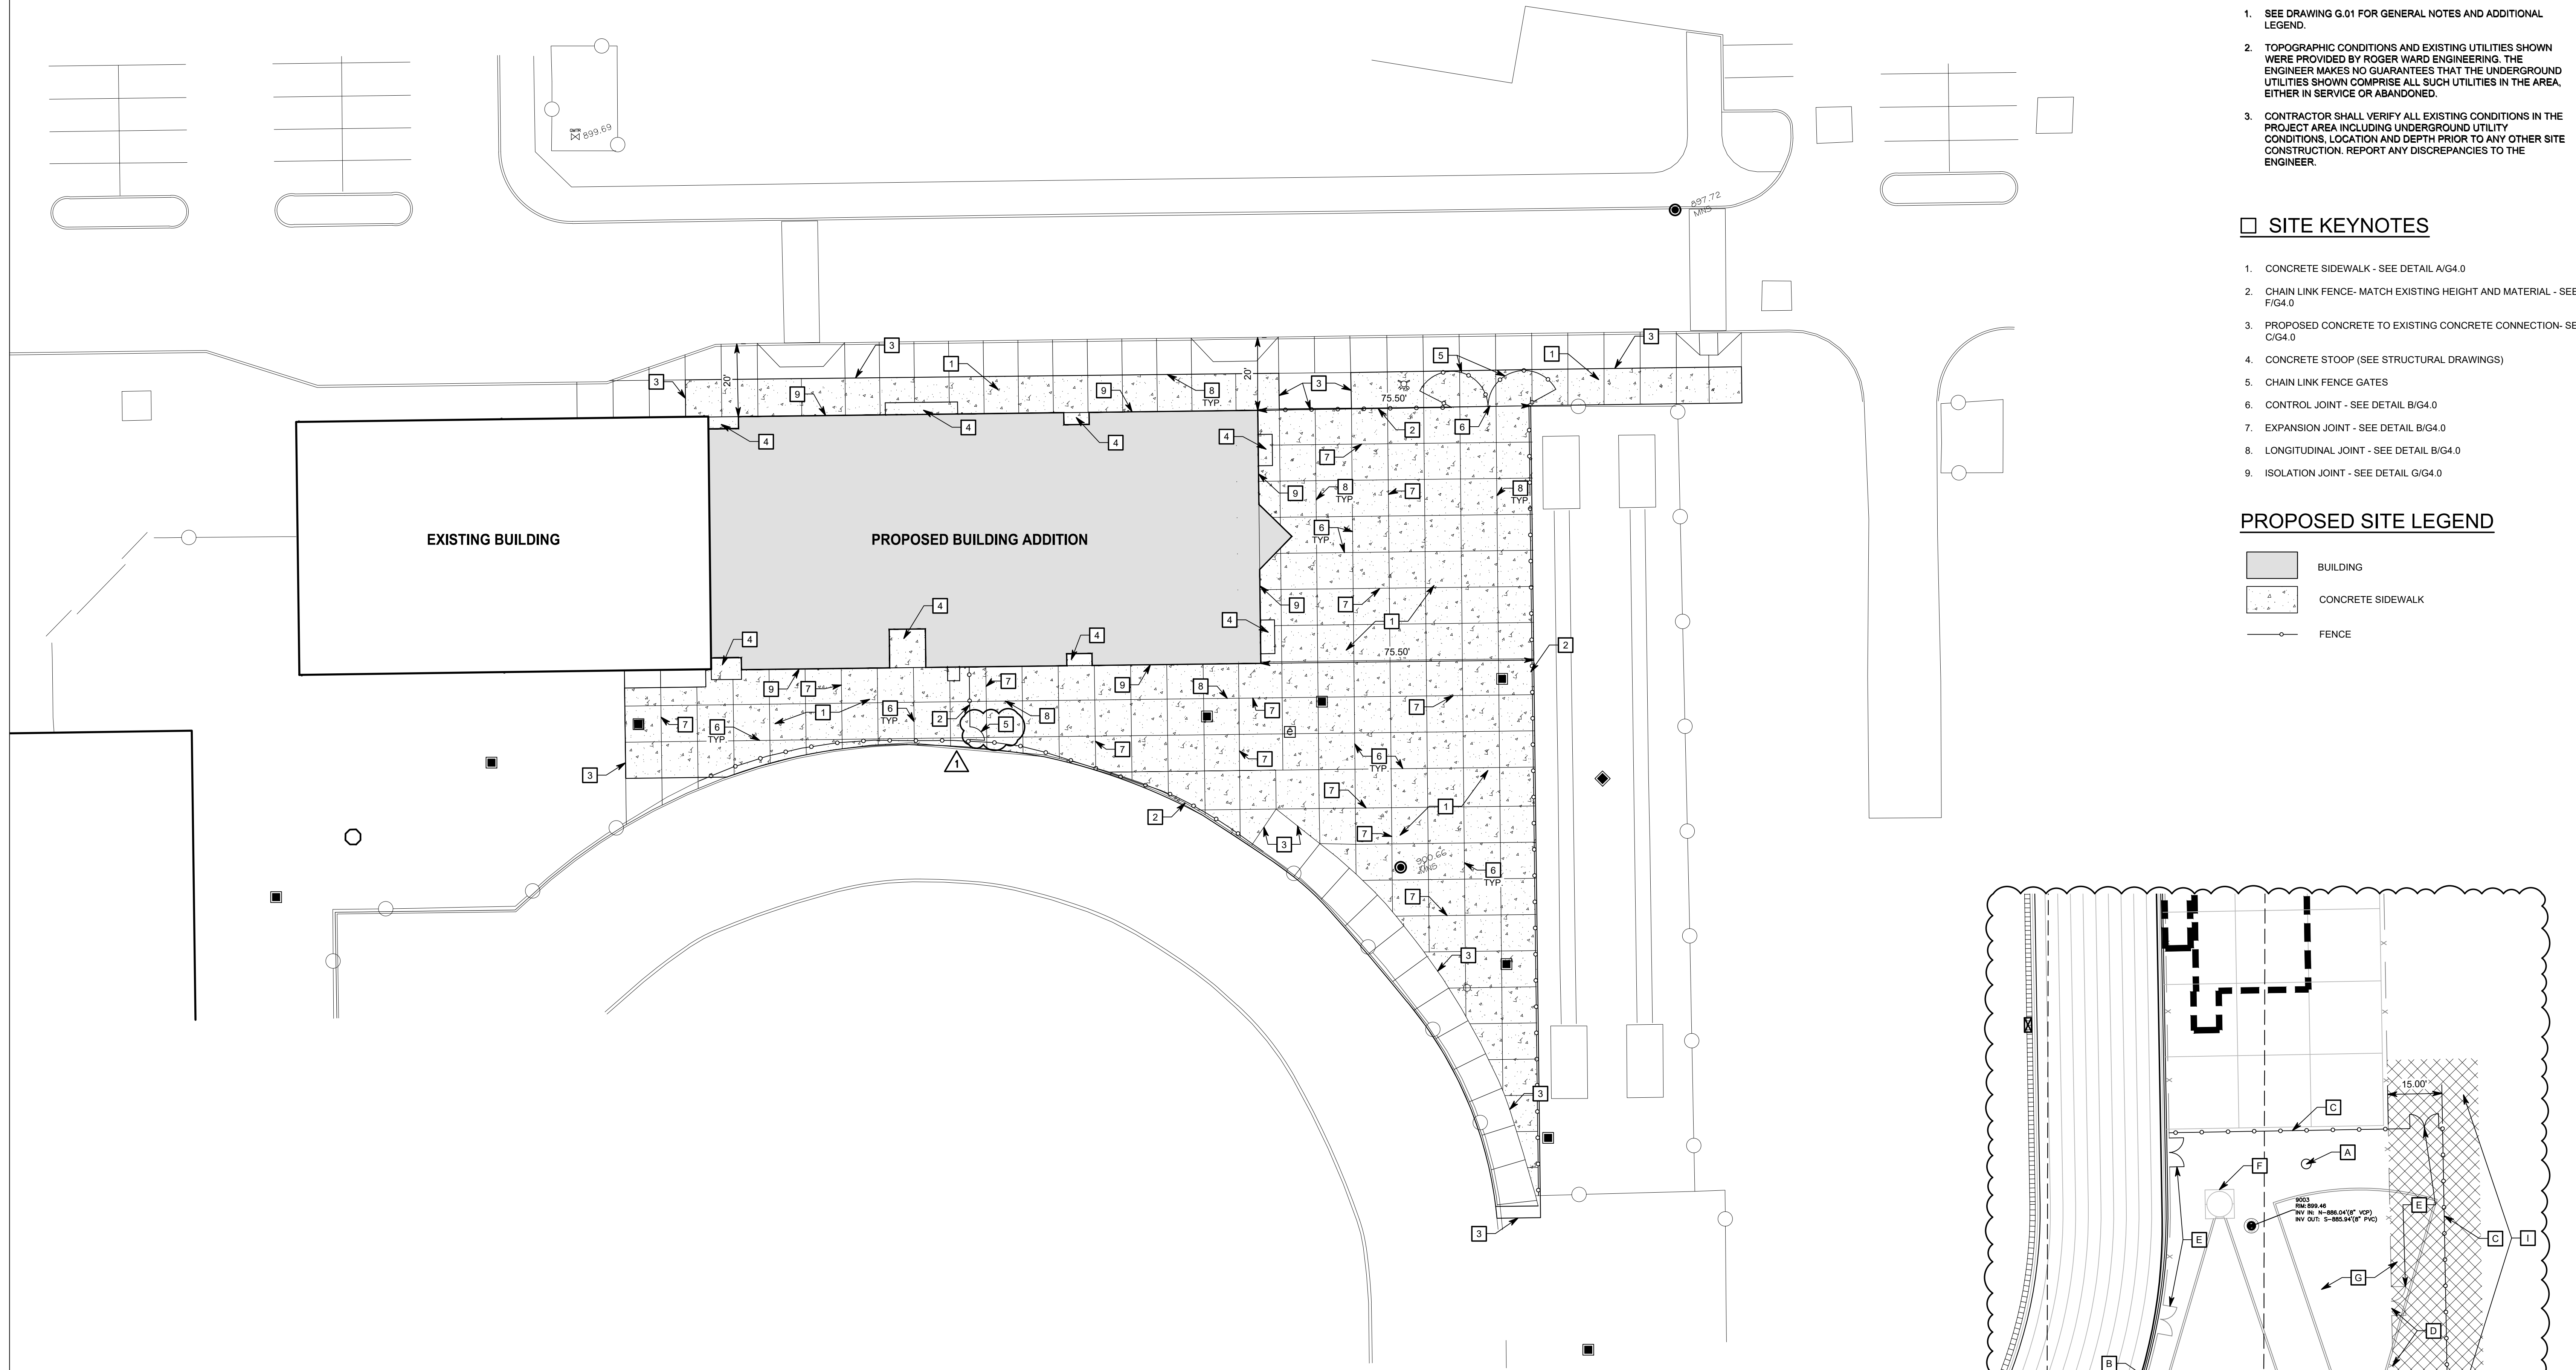

GENERAL NOTES

- SEE DRAWING G.01 FOR GENERAL NOTES AND ADDITIONAL LEGEND.
- TOPOGRAPHIC CONDITIONS AND EXISTING UTILITIES SHOWN WERE PROVIDED BY ROGER WARD ENGINEERING. THE ENGINEER MAKES NO GUARANTEES THAT THE UNDERGROUND UTILITIES SHOWN COMPRISE ALL SUCH UTILITIES IN THE AREA, EITHER IN SERVICE OR ABANDONED.
- CONTRACTOR SHALL VERIFY ALL EXISTING CONDITIONS IN THE PROJECT AREA INCLUDING UNDERGROUND UTILITY CONDITIONS, LOCATION AND DEPTH PRIOR TO ANY OTHER SITE CONSTRUCTION. REPORT ANY DISCREPANCIES TO THE ENGINEER.

SITE KEYNOTES

- CONCRETE SIDEWALK - SEE DETAIL A/G4.0
- CHAIN LINK FENCE- MATCH EXISTING HEIGHT AND MATERIAL - SEE DETAIL F/G4.0
- PROPOSED CONCRETE TO EXISTING CONCRETE CONNECTION- SEE DETAIL C/G4.0
- CONCRETE STOOP (SEE STRUCTURAL DRAWINGS)
- CHAIN LINK FENCE GATES
- CONTROL JOINT - SEE DETAIL B/G4.0
- EXPANSION JOINT - SEE DETAIL B/G4.0
- LONGITUDINAL JOINT - SEE DETAIL B/G4.0
- ISOLATION JOINT - SEE DETAIL G/G4.0

PROPOSED SITE LEGEND

- BUILDING
- CONCRETE SIDEWALK
- FENCE

SHOT PUT RELOCATION KEYNOTES

- EXISTING FIELD LIGHTING TO REMAIN (PROTECT DURING CONSTRUCTION)
- EXISTING CHAIN LINK FENCE TO REMAIN (PROTECT DURING CONSTRUCTION)
- CHAIN LINK FENCE- MATCH EXISTING HEIGHT AND MATERIAL - SEE DETAIL F/G4.0
- REMOVE EXISTING CHAIN LINK FENCE/GATES (SALVAGE FOR POTENTIAL RE-USE)
- RELOCATE EXISTING CHAIN LINK FENCE GATES
- SHOT PUT THROWING CIRCLE AND TOE BOARD (LAY OUT PER IHSAA REGULATIONS)
- SHOT PUT SAND PIT (LAY OUT PER IHSAA REGULATIONS)
- RELOCATE EXISTING AREA LIGHT
- RE-GRADE/FILL AREA BETWEEN EXISTING AND NEW FENCES (HATCHED AREA) TO PROVIDE A CONSISTENT SLOPE FOR ENTIRE SHOT PUT AREA. PROVIDE SMOOTH TRANSITION TO EXISTING GRADE OUTSIDE NEW FENCE.

SHOT PUT RELOCATION PLAN

SCALE: 1" = 20'

COPYRIGHT 2023 BY FANNING-HOWEY ASSOCIATES, INC.

ZIONSVILLE COMMUNITY HIGH SCHOOL FOOTBALL LOCKER BUILDING ADDITION AND RENOVATION

1000 MULBERRY STREET
ZIONSVILLE, INDIANA 46077

ZIONSVILLE COMMUNITY SCHOOLS



ARCHITECT


FANNING
HOWEY

(317) 848-0966 WWW.FHAI.COM
350 EAST NEW YORK ST, STE 300
INDIANAPOLIS, IN 46204

CIVIL ENGINEER



100% CD's

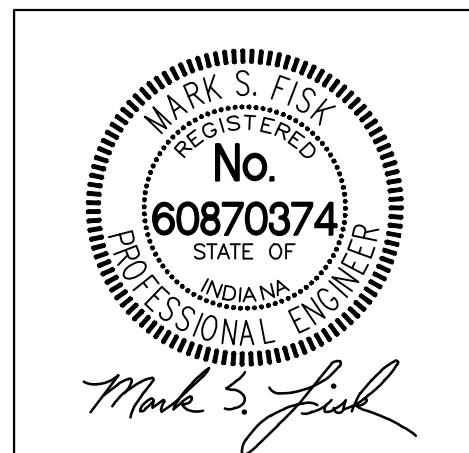

PROJECT MANAGER:

DRAWN BY:

PROJECT NUMBER:

PROJECT ISSUE DATE:

REV. NO.	DESCRIPTION	DATE
0	100% CD'S	01/22/2024
1	ADDENDUM #1	02/14/2024

SITE LAYOUT PLAN

G1.0

ZIONSVILLE COMMUNITY HIGH SCHOOL STADIUM LOCKER BUILDING ADDITION AND RENOVATION

900 MULBERRY ST.
ZIONSVILLE IN, 46077

ZIONSVILLE COMMUNITY SCHOOLS



ARCHITECT

FANNING HOWEY

317.848.0966 WWW.FHAI.COM
350 E NEW YORK ST, SUITE #300, INDIANAPOLIS, IN 46204


PROJECT LOCATION

A B

EXISTING CONCESSIONS BUILDING

KEY PLAN

CONSTRUCTION DOCUMENTS

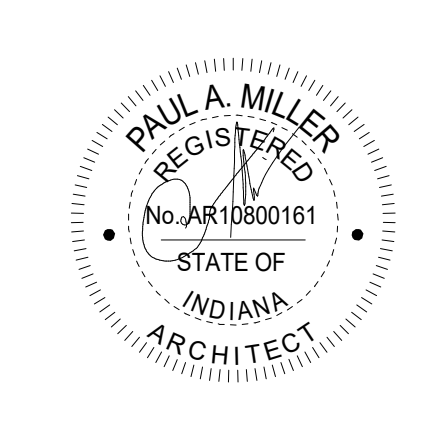

DRAWN BY: JAM

PROJECT NUMBER: 223139.00

PROJECT ISSUE DATE: 01/22/2024

REV. NO.	DESCRIPTION	DATE
1	ADDENDUM #1	02/14/2024

FIRST FLOOR CODE PLAN

A0.01

BUILDING CODE INFORMATION

- BUILDING DESCRIPTION:** MAJOR RENOVATION AND ADDITION TO EXISTING 2008 LOCKER ROOM BUILDING OCC TYPE B / CONSTRUCT TYPE V-B
- APPLICABLE CODE:** 2012 INTERNATIONAL BUILDING CODE - INDIANA BUILDING CODE, 2014 EDITION (675 IAC 13-2.6)
2012 INTERNATIONAL FIRE CODE - INDIANA FIRE CODE, 2014 EDITION (675 IAC 22-2)
2012 INTERNATIONAL MECHANICAL CODE - INDIANA MECHANICAL CODE, 2014 EDITION (675 IAC 18-1.6)
2012 INTERNATIONAL PLUMBING CODE - INDIANA PLUMBING CODE, 2012 EDITION (675 IAC 16-1.4)
2012 INTERNATIONAL ELECTRICAL CODE - INDIANA ELECTRICAL CODE, 2009 EDITION (NFPA 70-2008) (675 IAC 17-1.8)
INDIANA ENERGY CONSERVATION CODE- 2010 (ASHRAE 90.1, 2007 AMENDED) (672 IAC 19-4)
2010 ADA STANDARDS FOR ACCESSIBLE DESIGN

- BUILDING AREA AND HEIGHT**
 - OCCUPANCY/USE GROUP:** NON-SEPARATED OCCUPANCIES 508.3 BUSINESS, GROUP B EDUCATIONAL, GROUP E (302.1)
 - AREA LIMITATION (MOST RESTRICTIVE):** TABLE 503
ALLOWABLE AREA (GROUP E) 9,500 SF
ACTUAL AREA (GROUP E) 9,198 SF
ALLOWABLE AREA (GROUP B) 9,000 SF
ACTUAL AREA (GROUP B) 8,203 SF
TOTAL ACTUAL SF 17,401 SF
 - HEIGHT LIMITATION (MOST RESTRICTIVE):** 1 STORY, 40'-0" (TABLE 503)
1. HEIGHT MODIFICATIONS: 2 STORY, 60'-0" (504.2)
2. ACTUAL HEIGHT: 1 STORY, 23'-6"

- MIXED USE AND OCCUPANCY SECTION 508.3:** OCCUPANCY CLASSIFICATION INDIVIDUALLY CLASSIFIED IN ACCORDANCE WITH 302.1 ALLOWABLE BUILDING AREA AND HEIGHT MOST RESTRICTIVE FOR EACH OCCUPANCY IN ACCORDANCE WITH 503.1
- INCIDENTAL USE AREAS SECTION 509:** CLASSIFIED ACCORDING TO OCCUPANCY WHERE LOCATED NOT MORE THAN 10% OF BUILDING AREA WHERE LOCATED
- ACCESSORY USE AREAS INDIANA BUILDING CODE SECTION 508.3.1:** ACCESSORY OCCUPANCIES ARE THOSE OCCUPANCIES SUBSIDIARY TO THE MAIN OCCUPANCY OF THE BUILDING OR PORTION THEREOF. AGGREGATE ACCESSORY OCCUPANCIES SHALL NOT OCCUPY MORE THAN 10% OF THE AREA OF THE STORY IN TABLE 503 WITHOUT HEIGHT AND AREA INCREASES IN ACCORDANCE WITH SECTIONS 504 AND 506 FOR SUCH ACCESSORY OCCUPANCIES (2012 INTERNATIONAL BUILDING CODE)

- TYPE OF CONSTRUCTION INDIANA BUILDING CODE CHAPTER 6 (SEE TABLE)**
TYPE V-B
FIRE SEPARATION DISTANCES INDIANA BUILDING CODE TABLE 602:
REFER TO THE SITE PLAN DRAWINGS FOR LOCATION OF BUILDING(S) ON SITE. DISTANCES TO CLOSEST INTERIOR LOT LINES, TO THE CENTER OF A STREET, ALLEY OR PUBLIC WAY, OR TO AN IMAGINARY LINE BETWEEN TWO BUILDINGS ON THE SAME LOT.

- FIRE RESISTANCE RATED CONSTRUCTION INDIANA BUILDING CODE CHAPTER 7:** REFER TO THE CODE PLANS FOR MAXIMUM AREAS OF EXTERIOR OPENINGS BASED ON THE FIRE SEPARATION DISTANCES.

- PENETRATIONS THROUGH FIRE-RESISTANCE-RATED ASSEMBLIES:** SHALL BE PROVIDED WITH FIRESTOPPING PER PROJECT MANUAL.
- CEILING AND FLOOR OPENINGS THROUGH NON-FIRE-RESISTANCE-RATED ASSEMBLIES:** SHALL BE PROVIDED WITH FIRELOCKING PER PROJECT MANUAL.

- INTERIOR FINISHES TO COMPLY WITH INDIANA BUILDING CODE CHAPTER 8**
- FIRE PROTECTION SYSTEMS INDIANA BUILDING CODE CHAPTER 9:**
THE ENTIRE BUILDING SHALL BE PROVIDED WITH AN AUTOMATIC SPRINKLER SYSTEM COMPLYING WITH 903.3.1.1 REFER TO FIRE PROTECTION DRAWINGS.

- MEANS OF EGRESS INDIANA BUILDING CODE CHAPTER 10:**
THE MEANS OF EGRESS REQUIREMENTS SHALL BE DETERMINED BY THE ACTUAL OR COMPUTED NUMBER OF OCCUPANTS WHICHEVER IS THE LARGEST NUMBER. REFER TO THE CODE PLANS FOR ROOM OCCUPANT LOADS. AREAS OR ROOMS WITH 50 OR MORE OCCUPANTS SHALL BE PROVIDED WITH TWO OR MORE MEANS OF EGRESS. 500 OR MORE OCCUPANTS SHALL BE PROVIDED WITH THREE OR MORE MEANS OF EGRESS, AND 1000 OR MORE OCCUPANTS SHALL BE PROVIDED WITH FOUR OR MORE MEANS OF EGRESS.

- STRUCTURAL DESIGN LOADS:** REFER TO STRUCTURAL DRAWINGS FOR CODE REQUIREMENTS

BUILDING DESIGNED FOR:
382 STUDENTS AND 18 STAFF

XXX	ROOM NUMBER
E	OCCUPANCY CLASSIFICATION - REFER TO KEY
45	CALCULATED MAXIMUM OCCUPANT LOAD

CODE PLAN LEGEND

EXTERIOR WALLS TO HAVE UNPROTECTED OR PROTECTED OPENINGS LIMITED IN AREA BY TABLE 705.8

INTERIOR WALLS
+SP +SP +SP INCIDENTAL OCCUPANCY PARTITION WITH CONSTRUCTION CAPABLE OF RESISTING PASSAGE OF SMOKE AND HAS SELF-CLOSING AND/OR AUTOMATIC CLOSING DOORS WITH SMOKE DETECTORS, 508.4.2

MISCELLANEOUS

○ FIRE EXTINGUISHER

A.E.D.

8,203 SF - GROUP B OCCUPANCY

9,198 SF - GROUP E OCCUPANCY

NOTE:
AUTOMATIC SPRINKLER SYSTEM THROUGHOUT EXISTING BUILDING IS TO BE EXTENDED THROUGHOUT NEW ADDITION.
PER 718.4.3 (EXCEPTION) ATTIC DRAFT STOPPING IS NOT REQUIRED.

FIRST FLOOR - CODE PLAN

SCALE: 1/16" = 1'-0"

ROOM LEGEND - UNIT A			ROOM LEGEND - UNIT B		
ROOM NO.	ROOM NAME	AREA (SF)	ROOM NO.	ROOM NAME	AREA (SF)
A101	TOILET	64 SF	B101	VESTIBULE	82 SF
A102	TEAM ROOM	1212 SF	B102	CORRIDOR	424 SF
A103	SMALL TEAM ROOM / HOSPITALITY	252 SF	B103	VESTIBULE	65 SF
A104	SMALL TEAM ROOM	245 SF	B104	IDF	20 SF
A105	ENTRY	180 SF	B105	SHOWERS / TOILETS	234 SF
A106	TEAM ROOM	1194 SF	B106	TRAINING ROOM	370 SF
A107	COACH	226 SF	B107	LOCKER ROOM	1353 SF
A108	COACH RESTROOM	116 SF	B108	STORAGE	646 SF
A109	STORAGE	209 SF	B109	MECHANICAL	194 SF
A110	MECHANICAL	212 SF	B110	LOCKER ROOM	613 SF
A111	FIRE PROTECTION	66 SF	B111	SHOWERS / TOILETS	272 SF
A112	CUSTODIAL / STORAGE	118 SF	B112	LOCKER ROOM	628 SF
A113	STORAGE	234 SF	B113	SHOWERS / TOILETS	281 SF
A114	COACH	229 SF	B114	OFFICIALS RESTROOM	82 SF
A115	COACH RESTROOM	118 SF	B115	OFFICIALS LOCKER	104 SF
A116	ENTRY	179 SF	B116	VESTIBULE	73 SF
A117	COACH	256 SF	B117	CORRIDOR	374 SF
A118	COACH RESTROOM	67 SF	B118	VESTIBULE	73 SF
A119	TEAM ROOM	1206 SF	B119	WOMEN'S RESTROOM	574 SF
A120	CORRIDOR	130 SF	B120	CUSTODIAL	45 SF
A121	SMALL TEAM ROOM	229 SF	B121	COACHES OFFICE	676 SF
A122	SMALL TEAM ROOM	273 SF	B122	STORAGE	128 SF
A123	CUSTODIAL	48 SF	B123	COACHES RR	136 SF
			B124	FAMILY RESTROOM	73 SF
			B125	CONCESSIONS	507 SF
			B126	STORAGE	145 SF
			B127	MEN'S RESTROOM	396 SF

OCCUPANCY CLASSIFICATION - KEY

Class Abbreviation	Classification	Area Per Occupant	Occupancy Gross or Net
AC	AC - Accessory Storage Areas, Mechanical Equipment Rooms	300 SF	Gross
B	B - Business Areas	150 SF	Gross
E	E - Educational	20 SF	Net
I	I - Incidental Use - Furnace Room Over 400,000 Btu	300 SF	Gross

PLUMBING FIXTURE COUNTS

USER GROUP	NUMBER OF USERS	USER PER GENDER	WATER CLOSETS		LAVATORIES		DRINKING FNTS.		SERVICE SINKS	
			REQUIRED	PROVIDED	REQUIRED	PROVIDED	REQUIRED	PROVIDED	REQUIRED	PROVIDED
EDUCATIONAL (E)	[317]	[211] M.	1/50 = 5	4 W.C.	1/50 = 5	[7]	1/1000 = 3	3	1	1
		[106] F.	1/50 = 3	4 W.C.	1/50 = 3	[3]				
OFFICE (B)	[24]	[12] M.	1/25 = 1	4 W.C.	1/40 = 1	[4]	1/1000 = 1	1	1	1
		[12] F.	1/25 = 1	3 W.C.	1/40 = 1	[3]				
*ASSEMBLY (A5) BLEACHERS	996	[498] M.	1/75 = 7	4 W.C.	1/150 = 4	[6]	1/1000 = 1	1**	1	1
		[498] F.	1/40 = 13	13 W.C.	1/150 = 4	[6]				


BUILDING DESIGNED FOR 374 STUDENTS AND 18 STAFF

FAMILY TOILET ROOM/UNISEX ASSEMBLY AREAS - 1 REQUIRED, 1 PROVIDED

* RESTROOMS FOR ADJACENT 996-SEAT CAPACITY VISITORS SPECTATOR OUTDOOR BLEACHERS

** DRINKING FOUNTAINS PROVIDED AT EXISTING ADJACENT CONCESSIONS BUILDING

C:\Users\kshah\Documents\2024_ARCH_23139.00_Initial\gpn\WP01.rvt
2/13/2024 8:25:54 AM

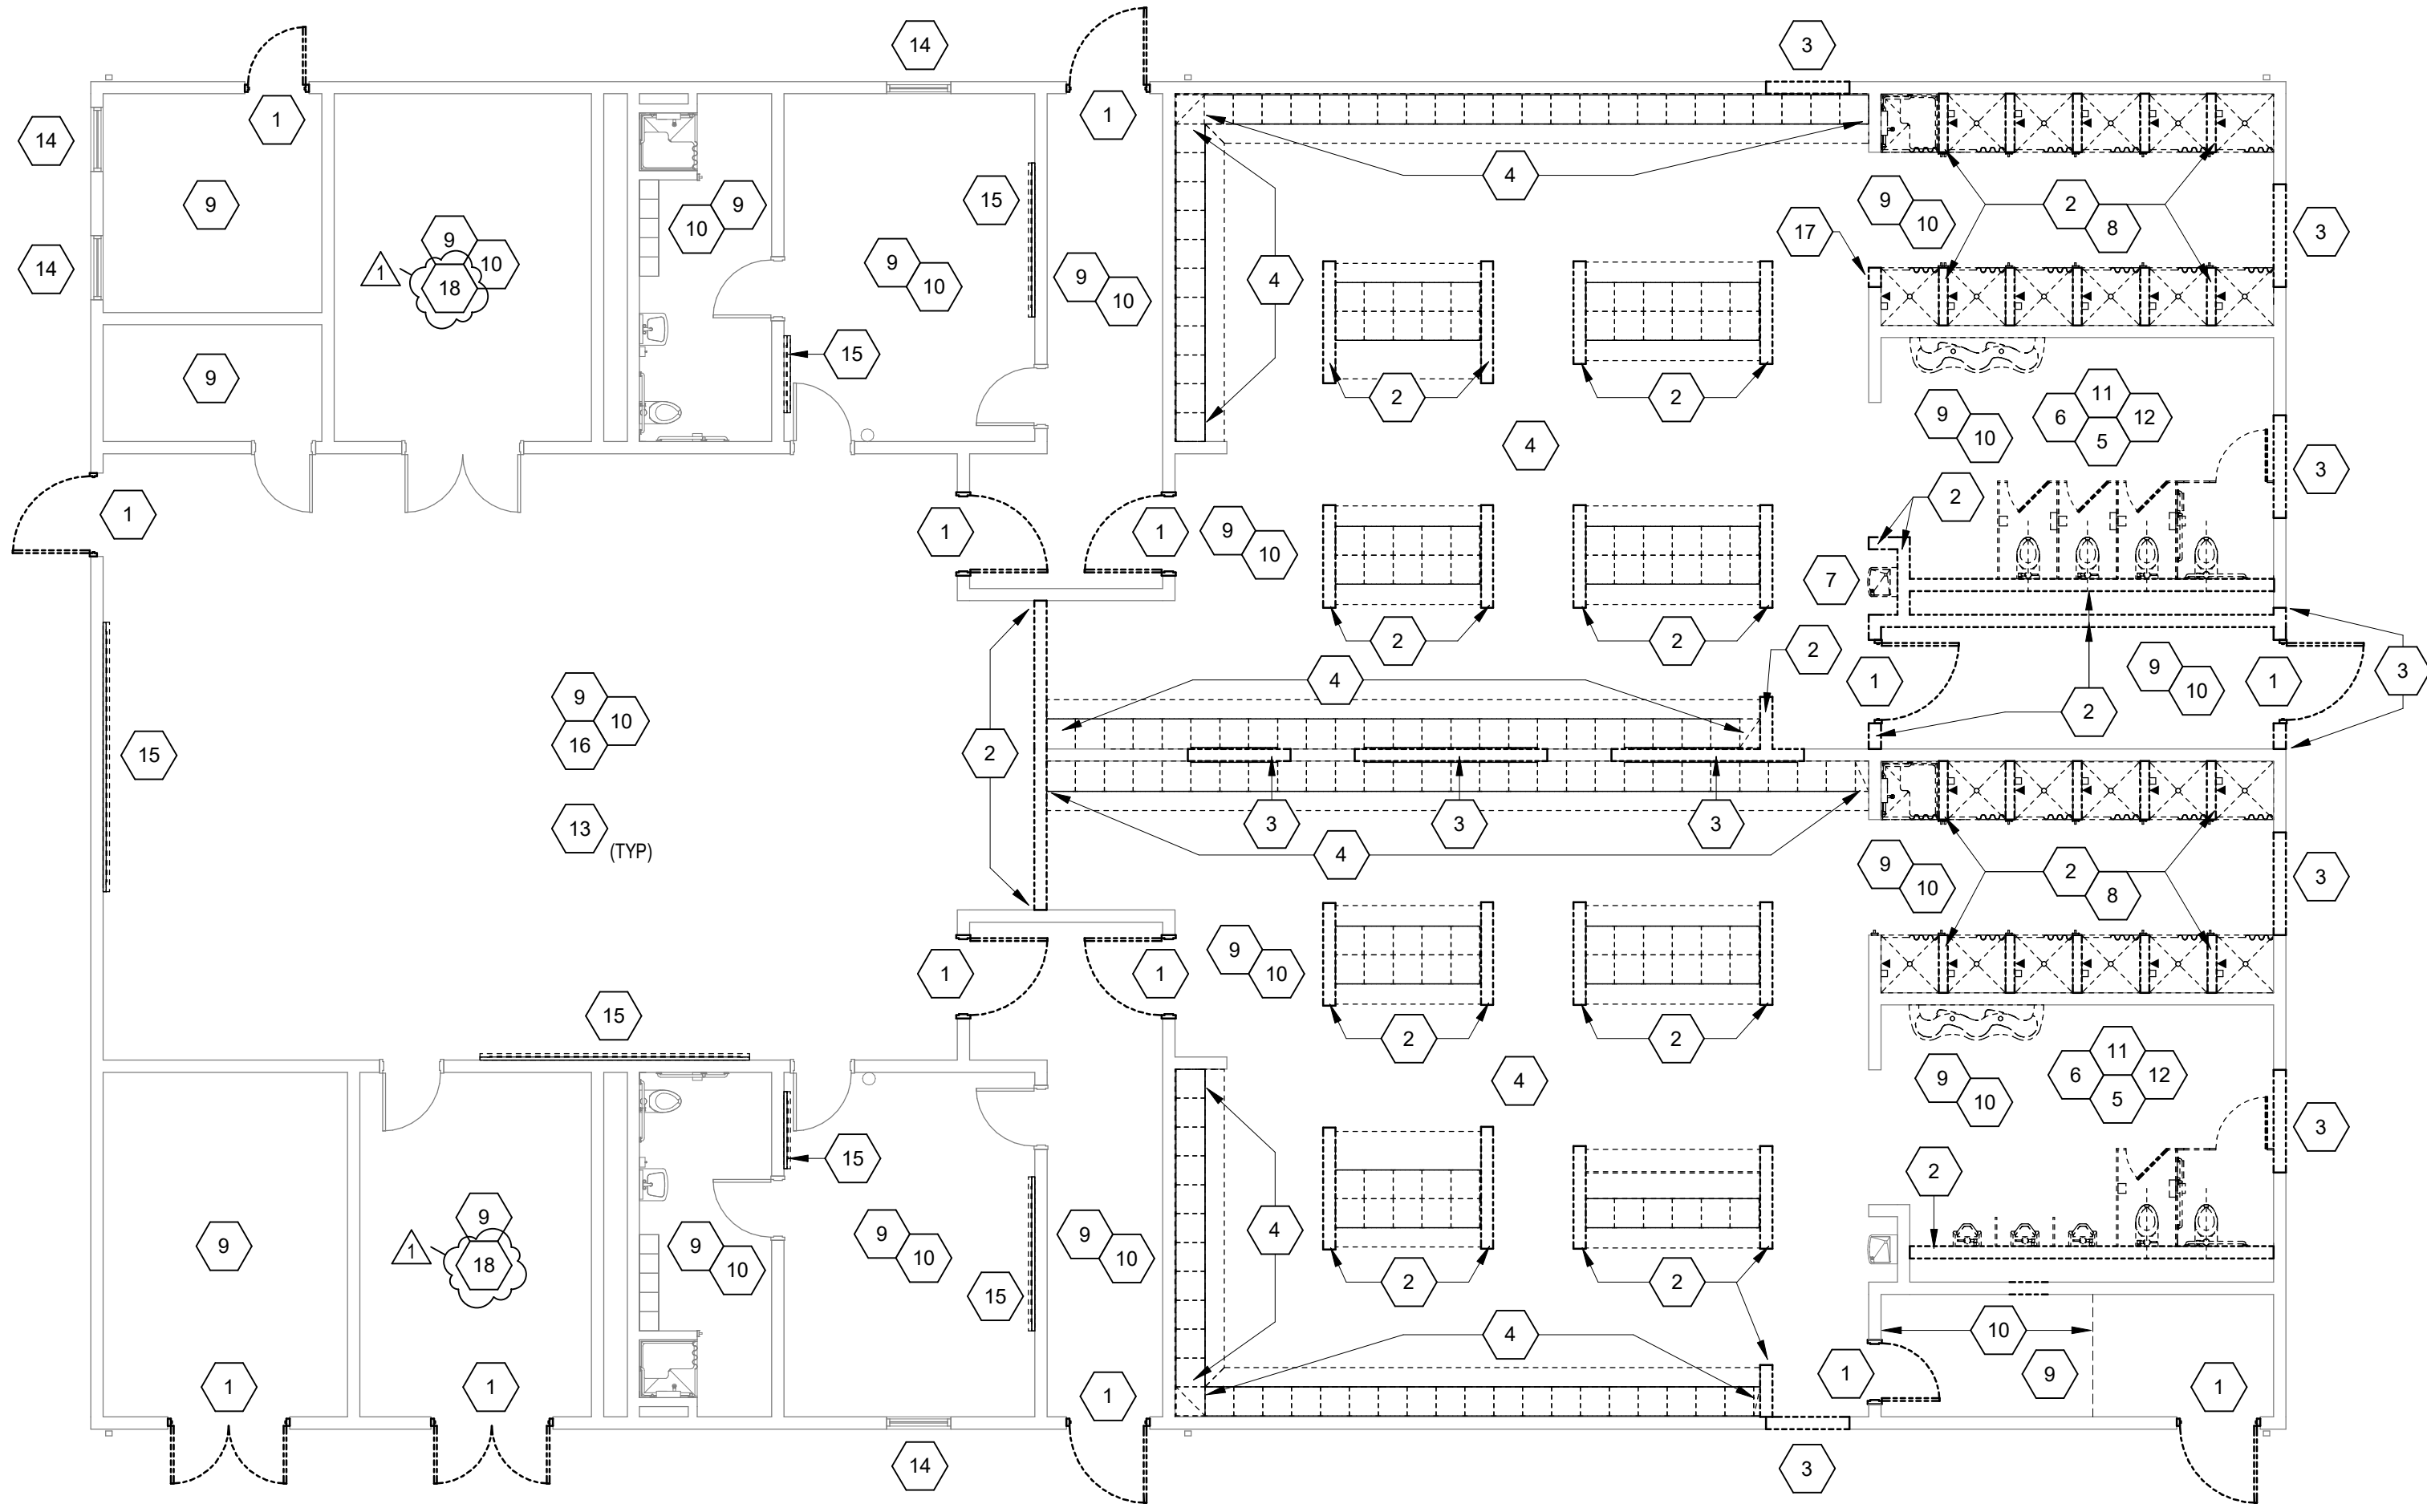

FIRST FLOOR DEMOLITION PLAN

SCALE: 1/8" = 1'-0"

ARCHITECTURAL DEMOLITION GENERAL NOTES

- DEMOLITION IS TO FOLLOW ESTABLISHED CONSTRUCTION SEQUENCE. CONTRACTOR IS TO VERIFY THEIR WORK IN THE FIELD WITH THE DEMOLITION DRAWINGS, NEW CONSTRUCTION DRAWINGS, AND THE EXISTING IN-FIELD CONDITIONS. REPORT DISCREPANCIES TO THE ARCHITECT.
- "FLOORING" DENOTES FLOOR COVERING MATERIALS, INCLUDING BACKINGS, ADHESIVES, BASES, DOWN TO BUT EXCLUSIVE OF FLOOR SLABS AND STRUCTURAL MATERIALS, UNLESS NOTED OTHERWISE.
- "CEILING" DENOTES CEILING MATERIALS INCLUDING SUSPENSION SYSTEMS ADHESIVE RESIDUES, MOLDINGS, UP TO BUT EXCLUSIVE OF STRUCTURAL MATERIALS.
- WALLS TO BE REMOVED SHALL BE REMOVED TO A POINT 2" (MIN.) BELOW THE EXISTING FLOOR SLAB (UNLESS SETTING ON SLAB). PATCH WITH NEW CONCRETE TO BE FLUSH WITH THE EXISTING FLOOR SLAB.
- WHEN OPENINGS ARE CUT INTO AN EXISTING WALL, THE OPENING SHALL BE A MINIMUM OF 1'-4" LONGER THAN THE FINISHED OPENING REQUIRED TO ALLOW FOR 8" (MIN.) OR NEW CMU TOOTHED-IN AT EDGES.
- AFTER THE DEMOLITION OF MATERIALS, THE RESULTING EXPOSED SURFACE SHALL BE SMOOTH AND FLUSH WITH EXISTING CONDITIONS.
- MECHANICAL AND ELECTRICAL ITEMS THAT ARE CAPPED AND ABANDONED SHALL BE LOCATED BEHIND FINAL FINISH SYSTEMS.
- COORDINATE THIS WORK WITH DEMOLITION WORK ON SITE. STRUCTURAL, PLUMBING, MECHANICAL, AND ELECTRICAL.
- PROVIDE INTERIOR AND EXTERIOR SHORING, BRACING, OR SUPPORT TO PREVENT MOVEMENT OR SETTLEMENT OF EXISTING STRUCTURES.
- CONTRACTOR TO FIELD VERIFY PORTIONS OR SECTIONS OF EXISTING WALLS TO BE FILLED IN AND SALVAGE NECESSARY MATERIAL.
- MATERIALS OF DEMOLITION SHALL BE DISPOSED OF OFF-SITE UNLESS OTHERWISE DIRECTED BY OWNER.
- OWNER TO REMOVE EXISTING FURNITURE AND MISCELLANEOUS ITEMS NOT SHOWN AND NOT TO BE DEMOLISHED. CONTRACTOR TO NOTIFY OWNER IN ADVANCE WHEN ITEMS NEED TO BE REMOVED. CONTRACTOR IS RESPONSIBLE FOR OTHER ITEMS TO BE REMOVED.
- ITEMS TO BE PATCHED. REMOVE ALL LOOSE OR DAMAGED MATERIAL. REFINISH TO LIKE NEW CONDITION, OR IF CONDITION WARRANTS REPLACE IN ENTIRETY.
- THE OWNER SHALL RESERVE RIGHT TO CLAIM ANY MATERIALS THAT ARE BEING DEMOLISHED PRIOR TO THE CONTRACTOR DISPOSING OF THEM OFF-SITE.
- "TURNED OVER TO THE OWNER" DENOTES: 1) TAG AND IDENTIFY ITEMS; 2) STORE IN AN ORDERLY FASHION IN A LOCATION DESIGNATED BY THE OWNER.
- ITEMS MADE OBSOLETE TO ACCOMMODATE NEW CONSTRUCTION OR RENOVATION SHALL BE REMOVED.
- ITEMS TO BE REMOVED SHALL BE REMOVED IN THEIR ENTIRETY.
- AFTER REMOVAL OF ITEMS, THE EXISTING WALL SURFACES (IF EXPOSED) SHALL BE REPAIRED/PATCHED AS REQUIRED TO RECEIVE NEW FINISHES.

DEMOLITION PLAN NOTES

(ALL NOTES MAY NOT BE INDICATED ON THIS SHEET)

- REMOVE EXISTING DOOR(S) AND FRAME ALONG WITH ALL RELATED ACCESSORIES
- REMOVE EXISTING MASONRY WALL CONSTRUCTION, ALONG WITH ALL RELATED ACCESSORIES. RELOCATE EXISTING MEPT ITEMS AS REQUIRED TO ACCOMMODATE NEW CONSTRUCTION. COORDINATE WITH MEPT SERIES DRAWINGS. PATCH AND REPAIR EXISTING GWB CEILING AT MASONRY WALL DEMO. INFILL WITH NEW GWB / BATT INSULATION ABOVE AS REQUIRED TO CONCEAL ATTIC SPACE
- PROVIDE OPENING IN EXISTING MASONRY WALL CONSTRUCTION AS REQUIRED TO ACCOMMODATE NEW CONSTRUCTION. REFER TO FLOOR PLANS FOR EXTENTS.
- REMOVE EXISTING LOCKERS, CMU BASE AND WOOD BENCH, ALONG WITH ALL RELATED ACCESSORIES
- REMOVE TOILET PARTITION(S) AND SUPPORT FRAMING IN ITS ENTIRETY
- REMOVE EXISTING PLUMBING FIXTURE(S), ALONG WITH ALL RELATED ACCESSORIES. REFER TO PLUMBING DRAWINGS FOR ADDITIONAL DEMOLITION, PATCH AND REPAIR ADJACENT WALL AND FLOOR SURFACE AND PREPARE TO ACCEPT NEW FINISHES
- REMOVE EXISTING DRINKING FOUNTAIN AND ALL RELATED ACCESSORIES IN THEIR ENTIRETY
- REMOVE EXISTING SHOWER HEAD AND CONTROL, GRAB BARS, SOAP TRAY, SHOWER SEAT, SHOWER ROD AND CURTAIN IN THEIR ENTIRETY
- EXISTING FINISH CEILING TO REMAIN
- REMOVE EXISTING WALL BASE AND TRANSITIONS (WHERE APPLICABLE). REMOVE EXISTING EPOXY FLOOR COATING TOPCOAT, SEALERS AND WAX. CLEAN SURFACE AND MECHANICALLY ABRASE COATING TO REMOVE ANY TEXTURE AND PROVIDE REQUIRED SURFACE PROFILE IN PREPARATION FOR NEW FLOOR FINISH
- REMOVE EXISTING MIRROR, MOUNTING HARDWARE AND ALL ADHESIVE FROM SUBSTRATE
- REMOVE EXISTING SOAP DISPENSERS, GRAB BARS, ROLL HOLDERS AND ALL RELATED RESTROOM ACCESSORIES
- REMOVE EXISTING WALL-MOUNTED ACOUSTICAL PANELS, MOUNTING ACCESSORIES AND ADHESIVES. PATCH AND REPAIR ADJACENT WALL, TO REMAIN. PREPARE SURFACE TO ACCEPT NEW FINISHES
- EXISTING WINDOW SYSTEM TO REMAIN
- REMOVE EXISTING DISPLAYBOARD, MOUNTING ACCESSORIES AND ADHESIVES. PATCH AND REPAIR ADJACENT WALL. PREPARE SURFACE TO ACCEPT NEW FINISHES
- REMOVE AND SALVAGE EXISTING WALL-MOUNTED PROJECTION SCREEN AND CEILING-MOUNTED PROJECTOR, ALONG WITH ALL RELATED ACCESSORIES. TURN OVER TO OWNER
- REMOVE PORTION OF EXISTING MASONRY WALL CONSTRUCTION AS REQUIRED TO ACCOMMODATE NEW FRAME / MASONRY TOOTH. REFER TO FLOOR PLANS FOR EXTENTS
- REMOVE EXISTING METAL SHELVING UNITS AS REQUIRED TO INSTALL NEW FINISHES. SALVAGE AND REINSTALL UNITS TO THEIR ORIGINAL LOCATION UPON INSTALLATION OF NEW FINISHES

VERIFICATION NOTE

CONTRACTOR SHALL VERIFY ALL DIMENSIONS AND CLEARANCES AND ALL EXISTING FIELD CONDITIONS BEFORE STARTING CONSTRUCTION. COMMENCEMENT OF WORK CONSTITUTES ACCEPTANCE OF CONDITIONS. SHOULD DIFFERENT CONDITIONS BE ENCOUNTERED, CONTACT THE ARCHITECT BEFORE PROCEEDING WITH WORK.

COPYRIGHT 2024 BY FANNINGHOWEY ASSOCIATES, INC.

ZIONSVILLE COMMUNITY HIGH SCHOOL STADIUM LOCKER BUILDING ADDITION AND RENOVATION

900 MULBERRY ST.
ZIONSVILLE IN, 46077

ZIONSVILLE COMMUNITY SCHOOLS



Zionsville
Community Schools

ARCHITECT


FANNING HOWEY

317.848.0966


WWW.FHAI.COM

330 E NEW YORK ST, SUITE #300, INDIANAPOLIS, IN 46204

PROJECT
LOCATION

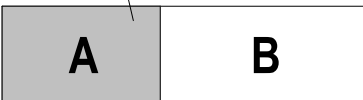


EXISTING
CONCESSIONS
BUILDING

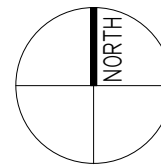

KEY PLAN

CONSTRUCTION DOCUMENTS

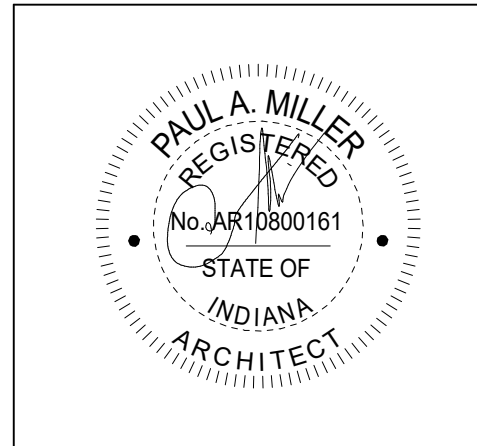

DRAWN BY: BC / KT

PROJECT NUMBER: 23139.00

PROJECT ISSUE DATE: 01.22.2024

REV. NO.	DESCRIPTION	DATE
1	ADDENDUM #1	02.14.2024


DEMOLITION PLAN

AD0.01


GYPSUM WALLBOARD SCHEDULE

LOCATION	TYPE	MOSTURE-AND-MOLD-RESISTANT GYPSUM BOARD (WGB)	IMPACT RESISTANT AND MOSTURE-AND-MOLD-RESISTANT GYPSUM BOARD (IRGB) TO 4'-7" AFF	IMPACT RESISTANT AND MOSTURE-AND-MOLD-RESISTANT GYPSUM BOARD (IRGB) TO 4'-7" AFF
TEAM ROOMS				●
STAFF OFFICES			●	
STAFF AND SINGLE STALL RESTROOMS (EXCEPT WET WALLS)			●	
VESTIBULES, CORRIDORS AND ENTRIES				●
MECHANICAL, FIRE PROTECTION, CUSTODIAL AND STORAGE ROOMS				●
BULKHEADS AND CEILINGS		●		

NOTES:
1. WET WALLS: WALLS WITH PLUMBING FIXTURES MOUNTED ON THEM AND WALLS IN SHOWER OR SIMILAR AREAS THAT WILL BE INTERMITTENTLY WET.

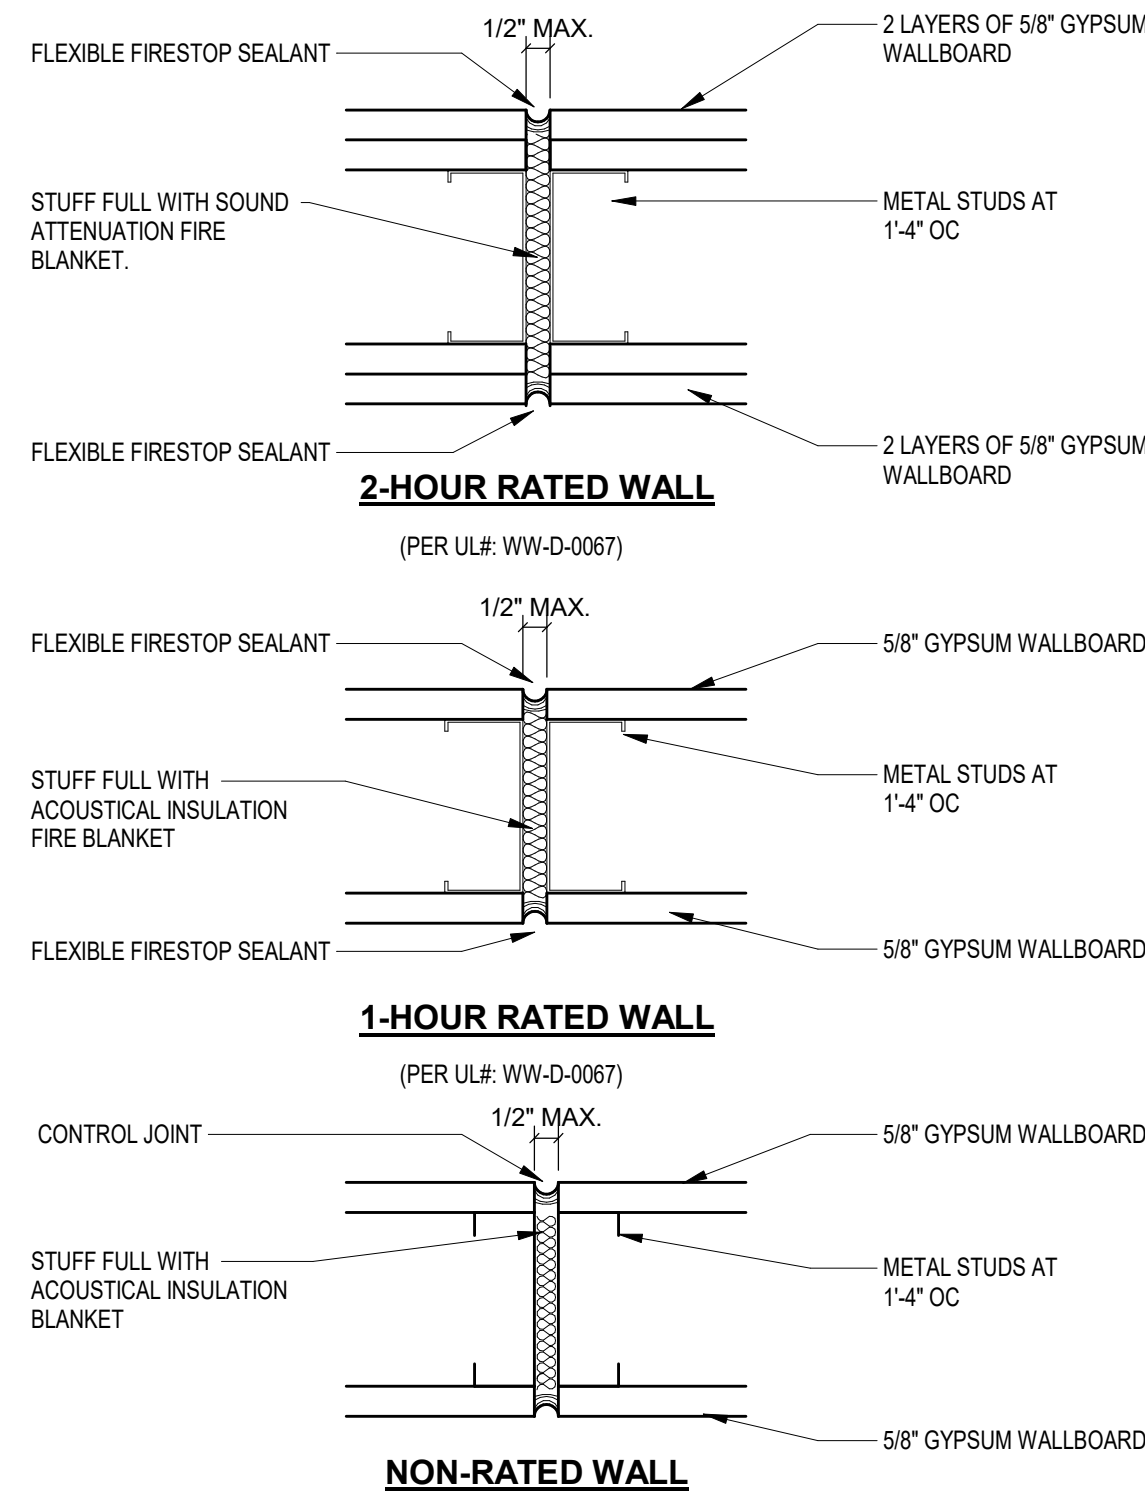

WALL TYPE SCHEDULE

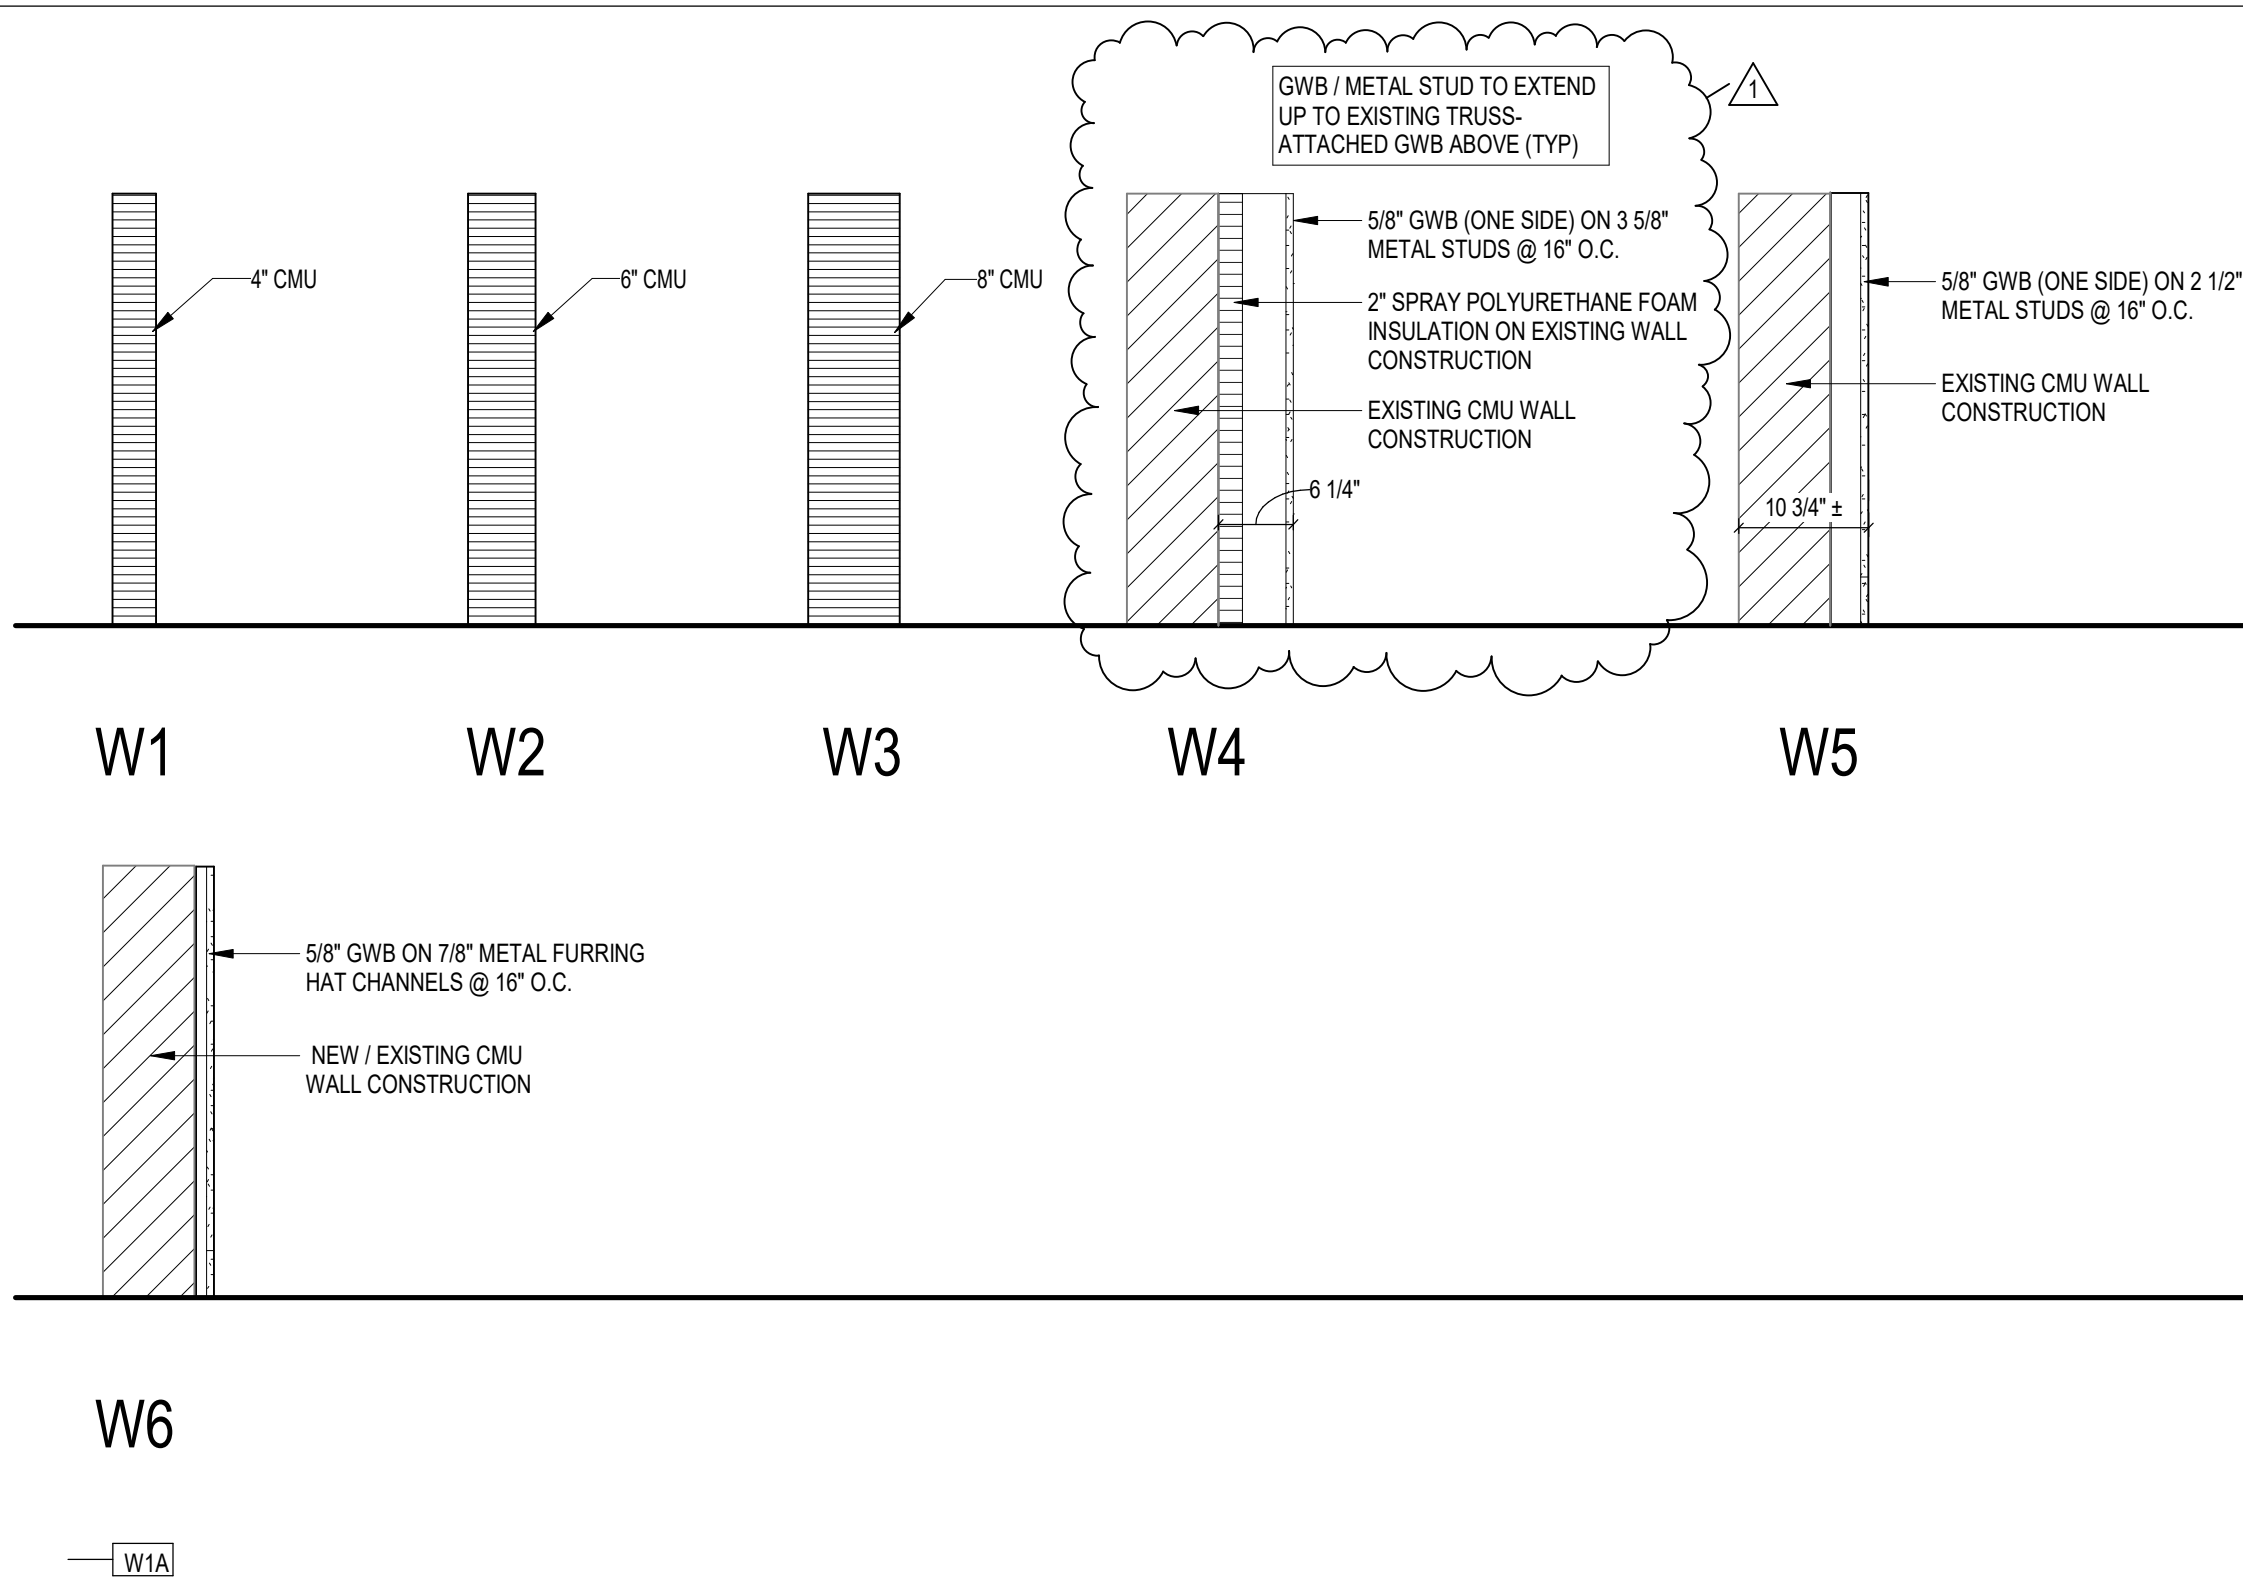


WALL TYPE GENERAL NOTES

- WALL TYPE AS SHOWN "1" REFERS TO WALL CONSTRUCTION BELOW CEILING, "A" REFERS TO WALL CONSTRUCTION ABOVE CEILING.
- REFER TO INTERIOR FINISH PLANS AND LIST OF FINISHES FOR WALL FINISHES.
- REFER TO STRUCTURAL DRAWINGS FOR HORIZONTAL AND VERTICAL REINFORCING AT MASONRY WALLS.
- PROVIDE DEEP LEG TRACK AT ALL STEEL STUDS THAT EXTEND TO DECK/STRUCTURE ABOVE (UNO).
- PACK VOIDS AT NON-RATED WALLS W/ MINERAL WOOL.
- PROVIDE SOUND ATTENUATION BLANKETS AT WALLS THAT REQUIRE ACOUSTICAL INSULATION OR SOUND RATED CONSTRUCTION.
- REFER TO SPECIFICATIONS FOR LOCATIONS WHERE ABUSE RESISTANT GYPSUM BOARD, MOISTURE RESISTANT GYPSUM BOARD, WATER RESISTANT BACKER BOARD, AND CEMENTITIOUS BACKER BOARD ARE REQUIRED.



WALL CONSTRUCTION ABOVE CEILING

AN (*) AFTER THE WALL TYPE NUMBER INDICATES WALL TO BE GROUTED SOLID FOR SOUND DEADENING PURPOSES. REFER TO STRUCTURAL DRAWINGS FOR OTHER GROUTING AND REINFORCING REQUIREMENTS.

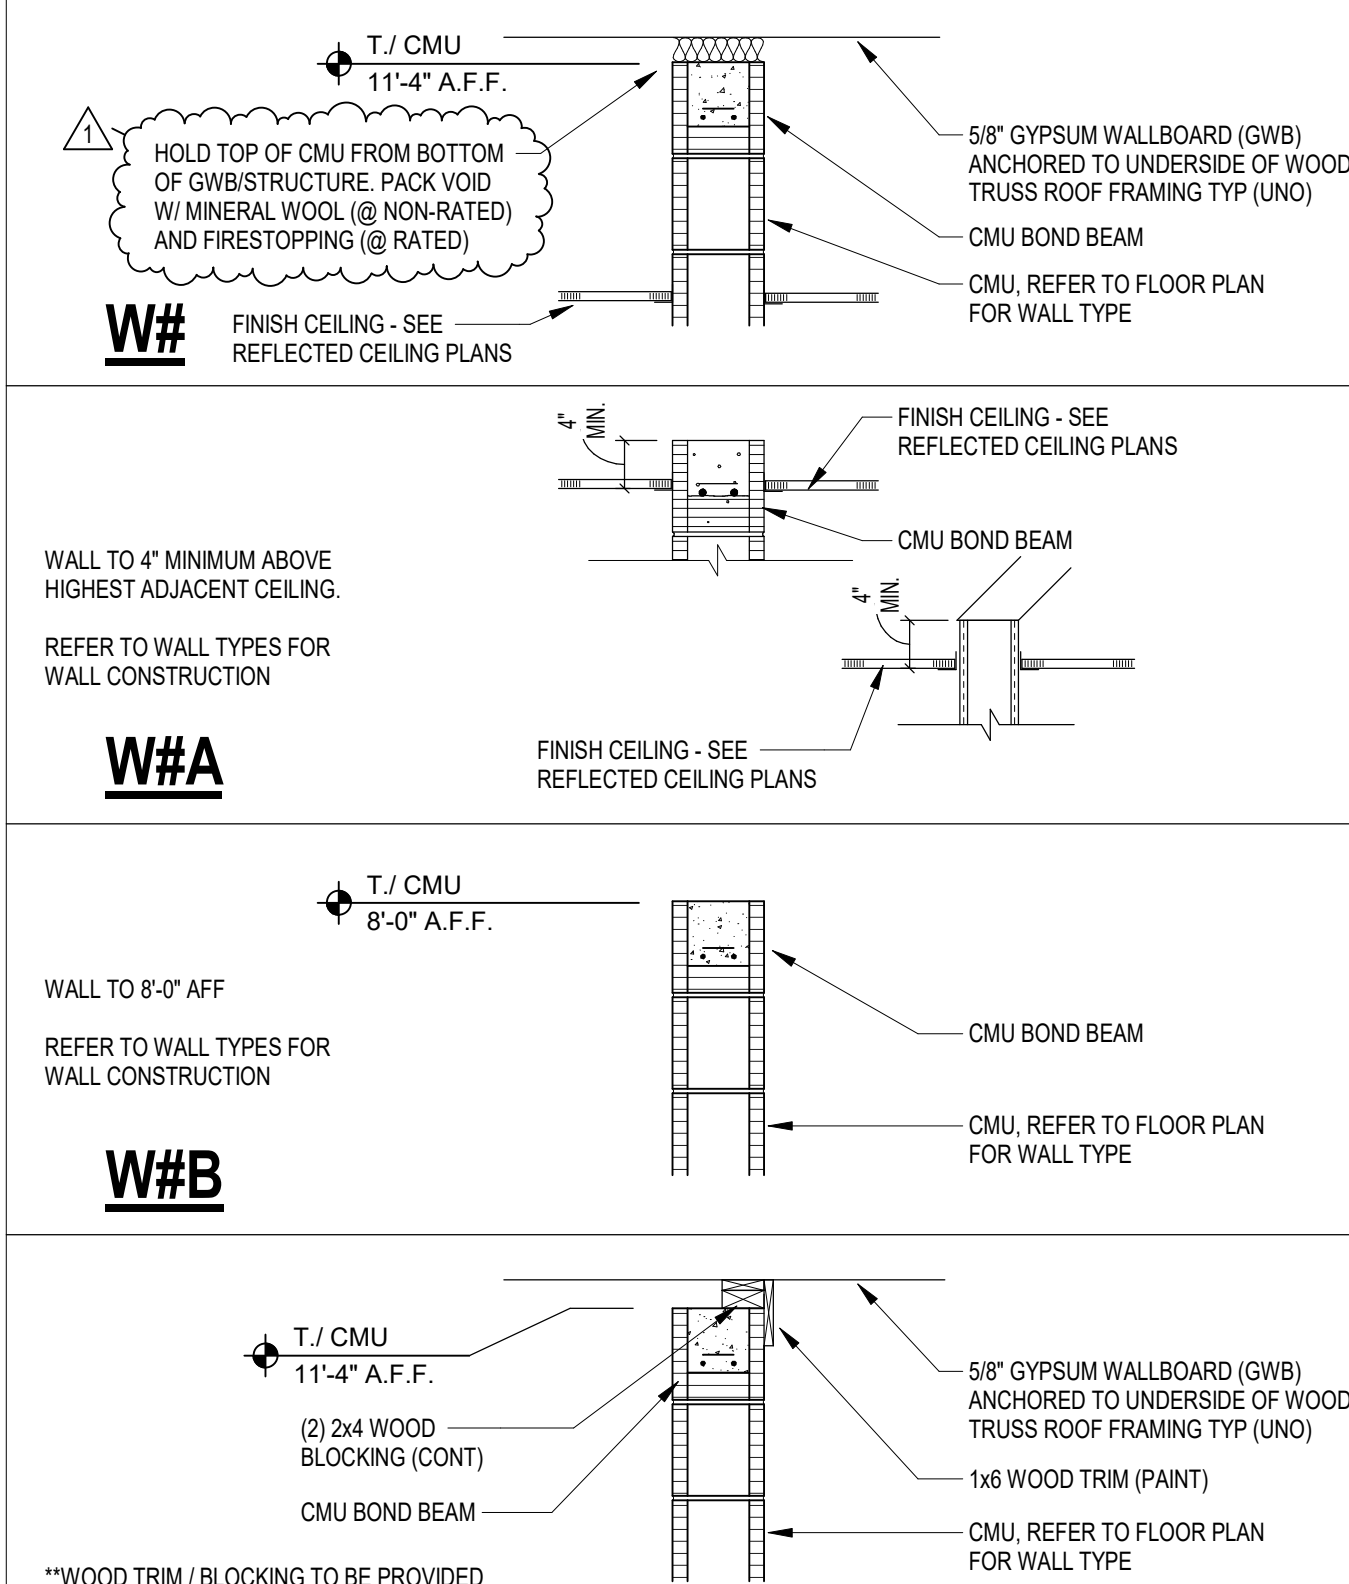

5 TYPICAL STUD WALL CONTROL JOINTS

SCALE: 3" = 1'-0"

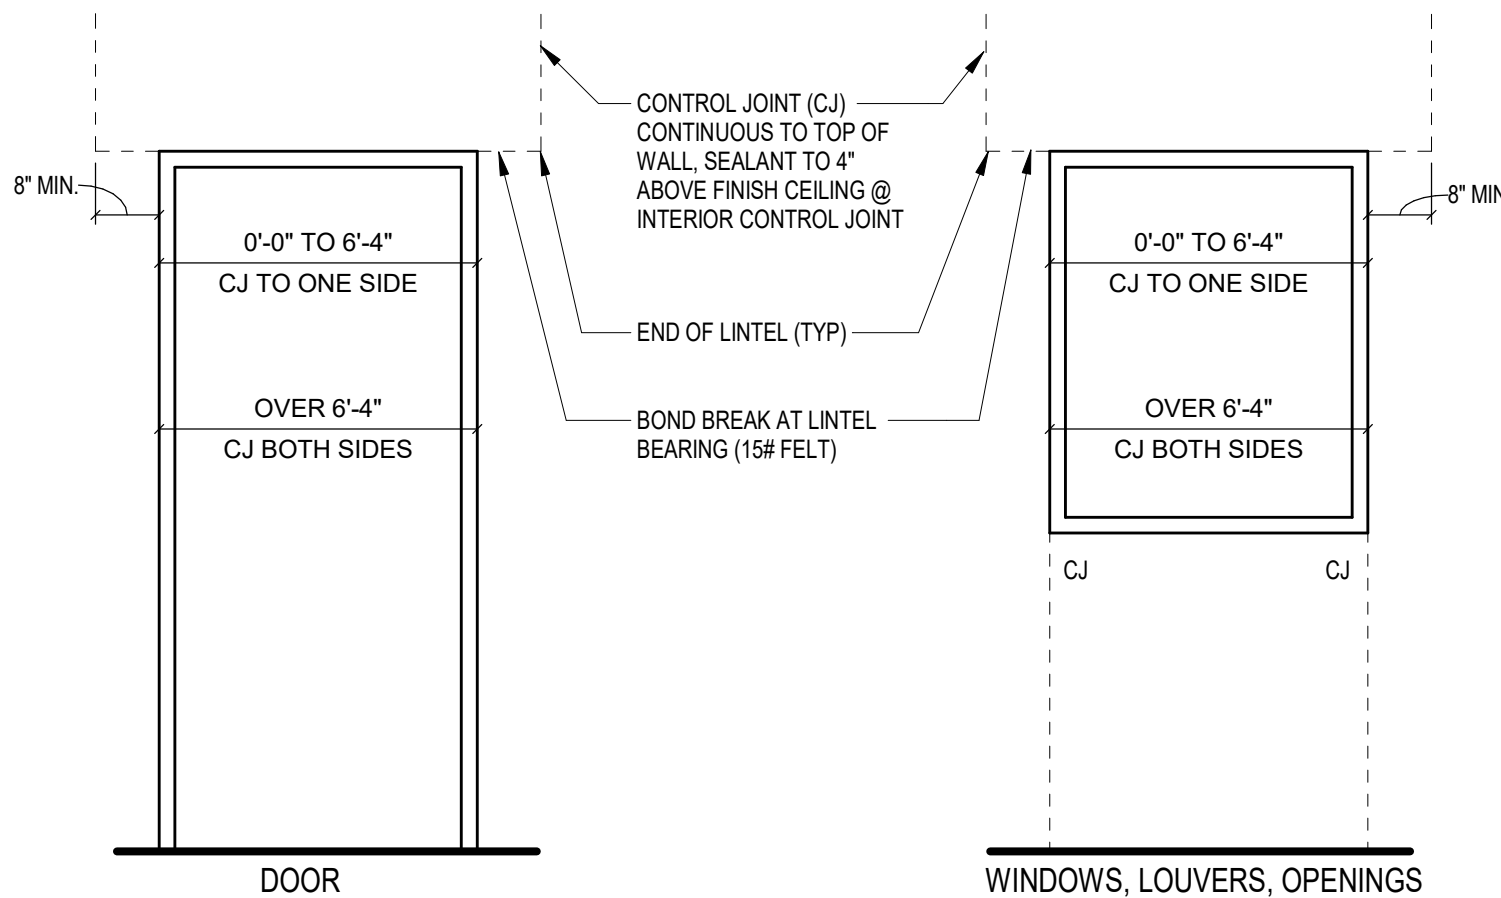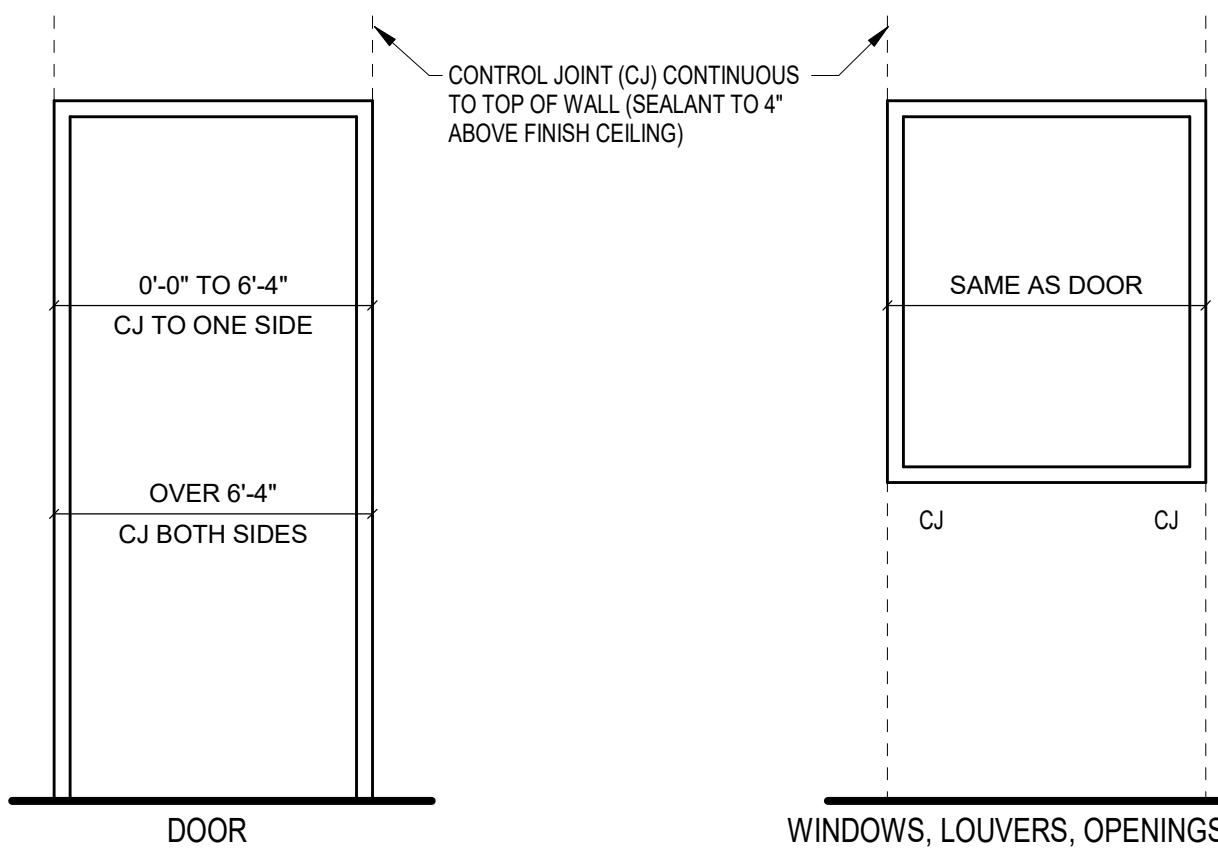


TYPICAL PLACEMENT OF CONTROL JOINTS (CJ) IN CMU WALLS AT OPENINGS

SCALE: 1 1/2" = 1'-0"


1 TYPICAL CONTROL JOINT

SCALE: 1 1/2" = 1'-0"

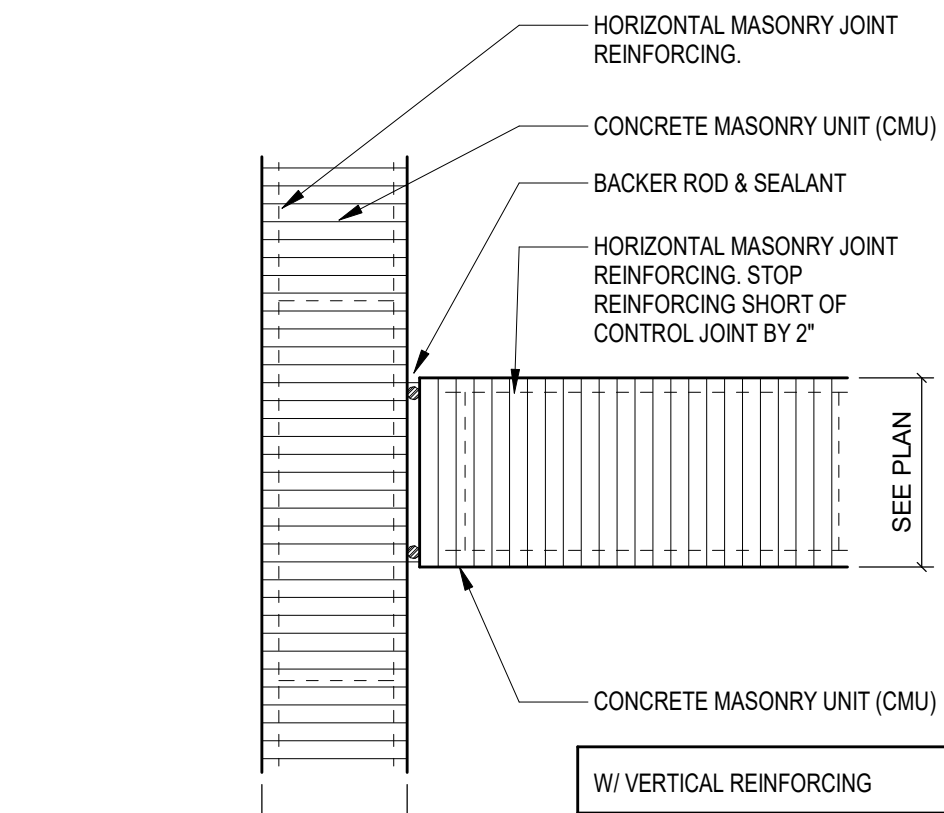

8 GYPSUM WALLBOARD WALL

SCALE: 1 1/2" = 1'-0"

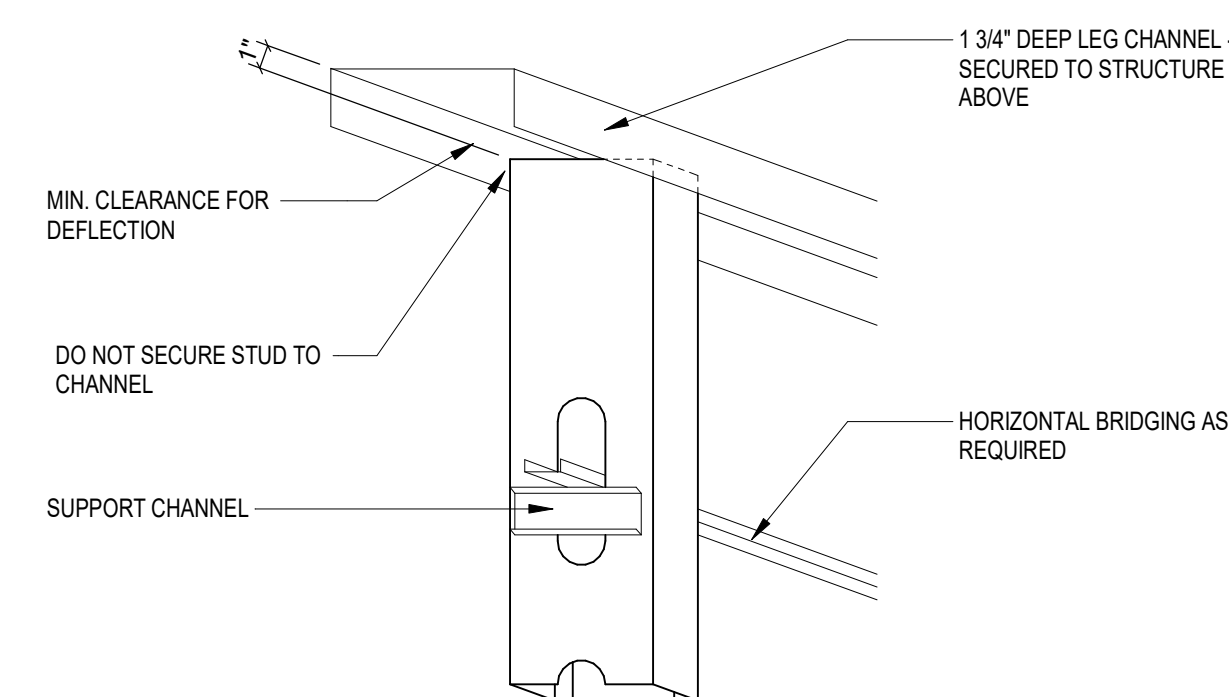


9 METAL STUD / DEEP LEG TRACK

SCALE: 1 1/2" = 1'-0"

6 TYPICAL PLACEMENT OF CONTROL JOINTS IN GYPSUM WALLBOARD AT OPENINGS

SCALE: 1 1/2" = 1'-0"

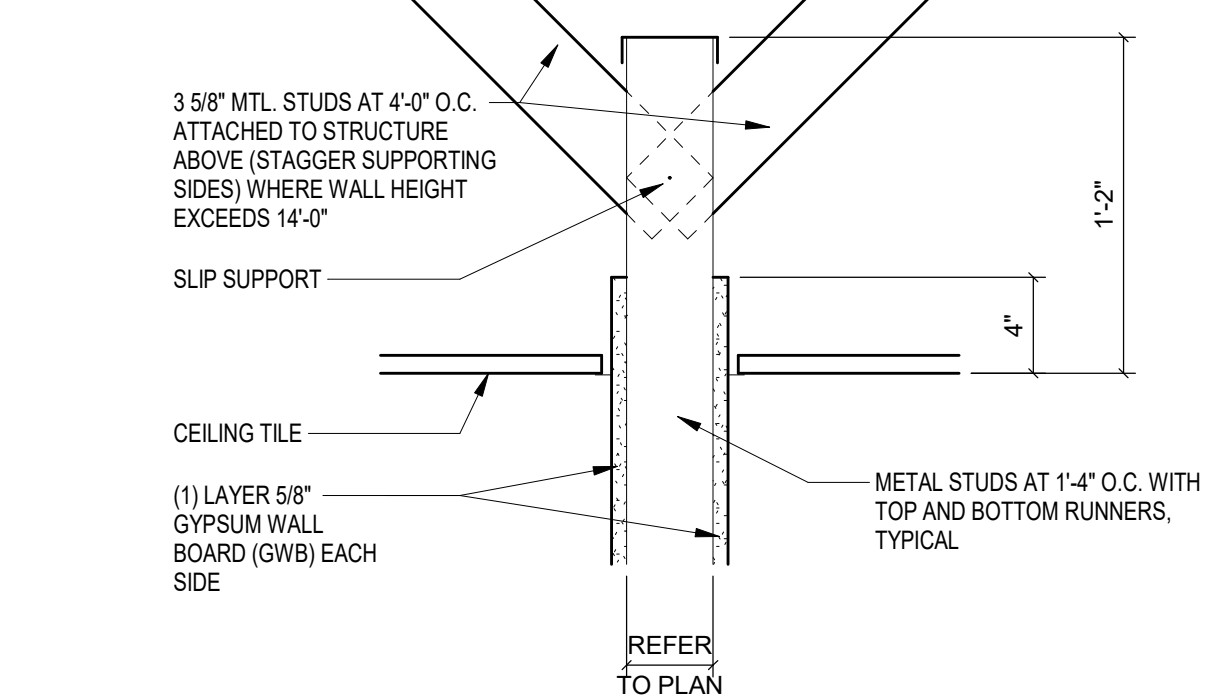


7 BRACING - GWB / METAL STUD WALL

SCALE: 1 1/2" = 1'-0"


4 SECTION - LOW WALL (CMU)

SCALE: 1 1/2" = 1'-0"

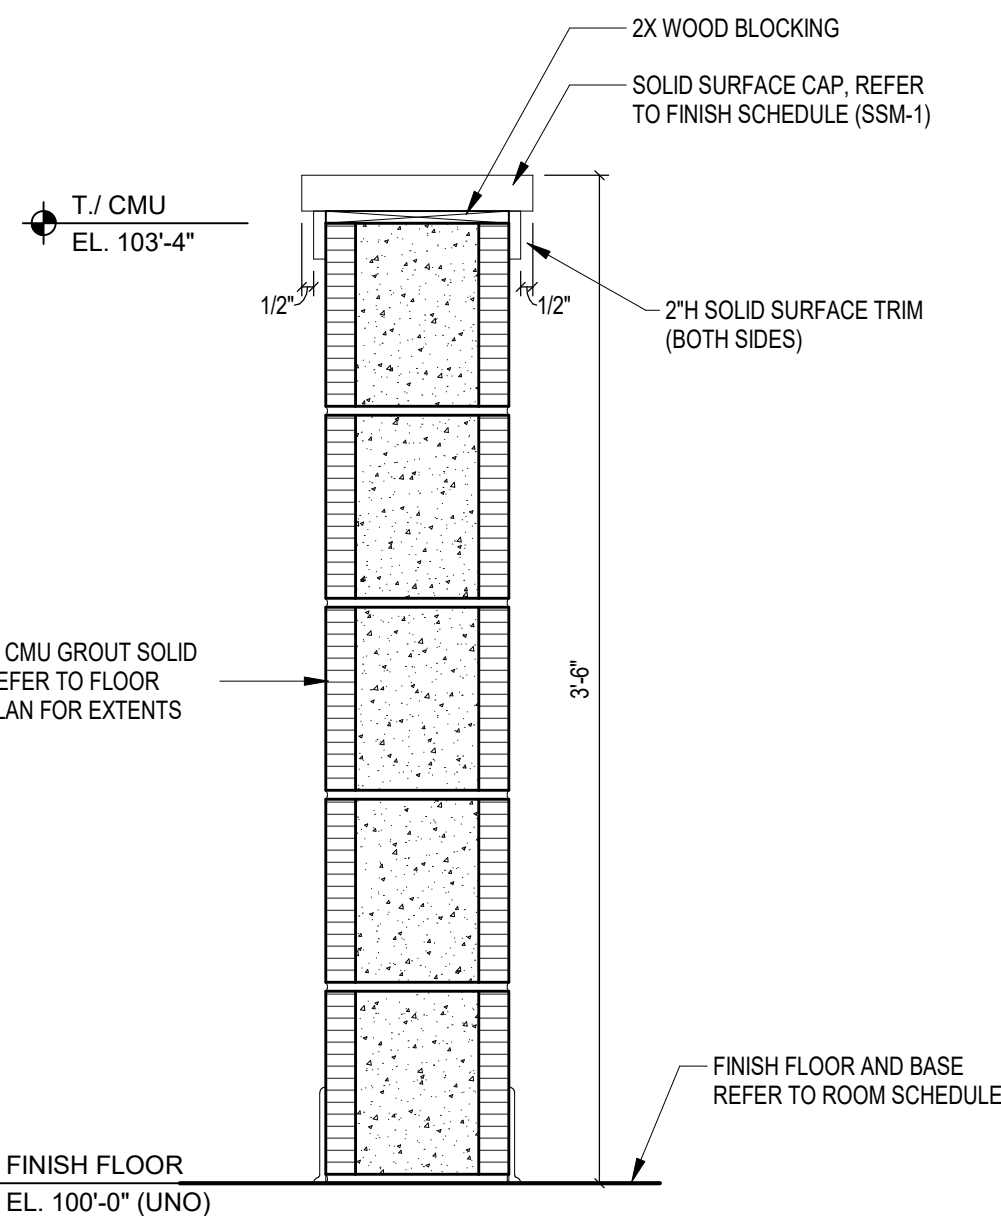

TYPICAL CONTROL JOINT @ FLOOR JOINT

SCALE: 1 1/2" = 1'-0"

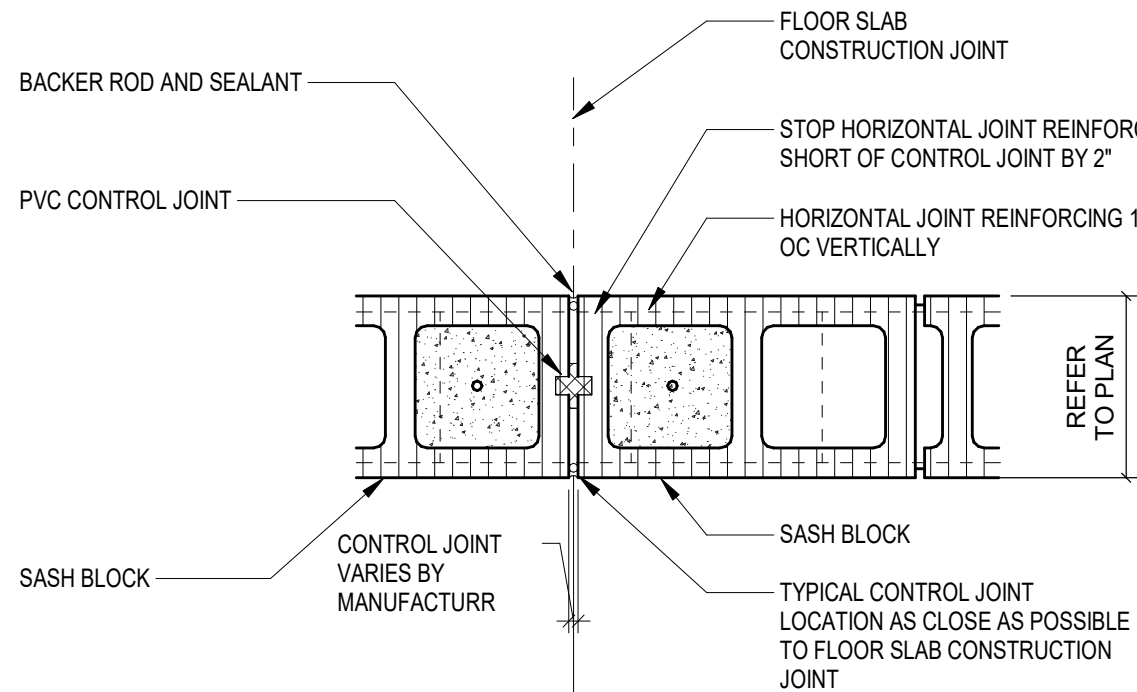

COPYRIGHT 2024 BY FANNINGHOWEY ASSOCIATES, INC.

ZIONSVILLE COMMUNITY HIGH SCHOOL STADIUM LOCKER BUILDING ADDITION AND RENOVATION

900 MULBERRY ST.
ZIONSVILLE IN, 46077

ZIONSVILLE COMMUNITY SCHOOLS



ARCHITECT


FANNING HOWEY

317.848.0966

WWW.FHAI.COM

350 E NEW YORK ST, SUITE #300, INDIANAPOLIS, IN 46204

CONSTRUCTION DOCUMENTS

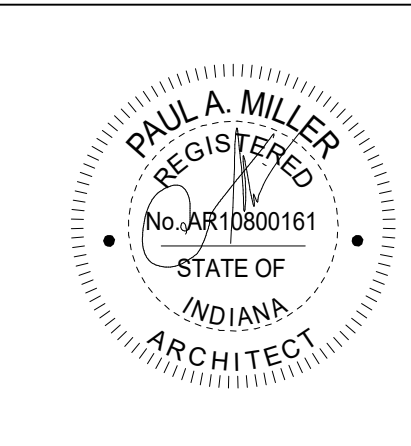

DRAWN BY: KT

PROJECT NUMBER: 223139.00

PROJECT ISSUE DATE: 01.22.2024

REV. NO.	DESCRIPTION	DATE
1	ADDENDUM #1	02.14.2024

WALL TYPES AND DETAILS

A1.00

ZIONSVILLE COMMUNITY HIGH SCHOOL STADIUM LOCKER BUILDING ADDITION AND RENOVATION

900 MULBERRY ST.
ZIONSVILLE IN, 46077

ZIONSVILLE COMMUNITY SCHOOLS



ZIONSVILLE
Community Schools

ARCHITECT

FANNING HOWEY

317.848.0966

WWW.FHAI.COM

350 E NEW YORK ST, SUITE #300, INDIANAPOLIS, IN 46204


PROJECT LOCATION

A B

EXISTING CONCESSIONS BUILDING

KEY PLAN

CONSTRUCTION DOCUMENTS

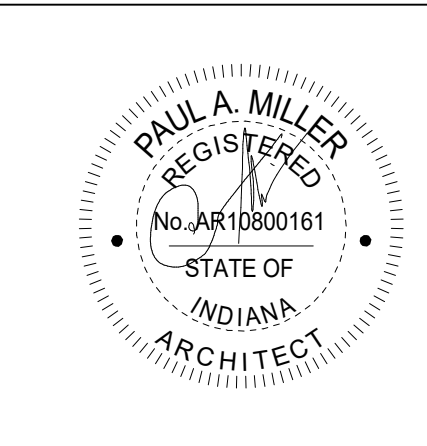

DRAWN BY: BCKT

PROJECT NUMBER: 23139.00

PROJECT ISSUE DATE: 01.22.2024

REV. NO.	DESCRIPTION	DATE
1	ADDENDUM #1	02.14.2024

FIRST FLOOR ARCHITECTURAL PLANS

A1.01

ROOM LEGEND - UNIT B		
ROOM NO.	ROOM NAME	AREA (SF)
B101	VESTIBULE	82 SF
B102	CORRIDOR	424 SF
B103	VESTIBULE	65 SF
B104	IDF	29 SF
B105	SHOWERS / TOILETS	234 SF
B106	TRAINING ROOM	377 SF
B107	LOCKER ROOM	1,353 SF
B108	STORAGE	646 SF
B109	MECHANICAL	194 SF
B110	LOCKER ROOM	613 SF
B111	SHOWERS / TOILETS	377 SF
B112	LOCKER ROOM	638 SF
B113	SHOWERS / TOILETS	281 SF
B114	OFFICIALS RESTROOM	82 SF
B115	OFFICIALS LOCKER	104 SF
B116	VESTIBULE	73 SF
B117	CORRIDOR	374 SF
B118	VESTIBULE	73 SF
B119	WOMEN'S RESTROOM	574 SF
B120	CUSTODIAL	45 SF
B121	COACHES OFFICE	676 SF
B122	STORAGE	129 SF
B123	COACHES RR	136 SF
B124	FAMILY RESTROOM	73 SF
B125	CONCESSIONS	507 SF
B126	STORAGE	145 SF
B127	MEN'S RESTROOM	396 SF

ROOM LEGEND - UNIT A		
ROOM NO.	ROOM NAME	AREA (SF)
A101	TOILET	64 SF
A102	TEAM ROOM	1212 SF
A103	SMALL TEAM ROOM / HOSPITALITY	252 SF
A104	SMALL TEAM ROOM	245 SF
A105	ENTRY	180 SF
A106	TEAM ROOM	1184 SF
A107	COACH	228 SF
A108	COACH RESTROOM	116 SF
A109	STORAGE	209 SF
A110	MECHANICAL	212 SF
A111	FIRE PROTECTION	66 SF
A112	CUSTODIAL / STORAGE	118 SF
A113	STORAGE	234 SF
A114	COACH	229 SF
A115	COACH RESTROOM	118 SF
A116	ENTRY	179 SF
A117	COACH	258 SF
A118	COACH RESTROOM	67 SF
A119	TEAM ROOM	1206 SF
A120	CORRIDOR	130 SF
A121	SMALL TEAM ROOM	228 SF
A122	SMALL TEAM ROOM	273 SF
A123	CUSTODIAL	48 SF

ARCHITECTURAL PLAN GENERAL NOTES

- ALL CMU WALLS THAT DO NOT LAY OUT IN FULL OR HALF LENGTHS SHOULD BE BALANCED SO AS NOT TO HAVE ANY PIECES LESS THAN 4" IN SIZE EXPOSED TO VIEW.
- WHERE DISSIMILAR FLOOR MATERIALS MEET, THEY SHALL DO SO UNDER THE CENTERLINE OF THE DOOR, UNLESS NOTED OTHERWISE.
- THERE SHALL BE PERIMETER INSULATION CONTINUOUS AROUND THE ENTIRE PERIMETER OF THE BUILDING EXTENDING 2'-0" MINIMUM BELOW GRADE.
- THE BASE FLOOR ELEVATION INDICATED FOR THE PROJECT IS 100'-0". REFER TO SITE PLAN FOR CORRELATION TO USGS DATUM.
- ALL INTERIOR MASONRY WALLS THAT HAVE A 2" JOINT (U.N.O.) AT THE DECK TO BE FILLED WITH FIRE STOPPING AT RATED WALLS PER PROJECT MANUAL, AND MINERAL WOOL AT THE NON-RATED WALLS, TO ALLOW FOR DEFLECTION.
- FOR TYPICAL COMMON JOINT DETAILS AND CONSTRUCTION MOVEMENT JOINT DETAILS REFER TO DETAILS ON SHEET XX.
- ALL DIMENSIONS ON FLOOR PLANS ARE TO FINISH FACE OF CMU, CONCRETE, BRICK OR FINISH FACE OF GWB AT METAL STUD WALLS, UNLESS NOTED OTHERWISE. EXCEPTION: EXTERIOR METAL STUD WALLS ARE TO FACE OF METAL STUDS.
- HINGE SIDE DOOR JAMB AT WALLS WILL TYPICALLY BE LOCATED 4" MINIMUM FROM ADJACENT WALL UNLESS NOTED OTHERWISE.
- ALL EXPOSED CONCRETE MASONRY UNITS (CMU) CORNERS ARE TO BE BULLNOSE, EXCEPT AT BULKHEADS, WINDOW AND DOOR HEADS.
- SEE REFLECTED CEILING PLANS FOR BULKHEAD LOCATIONS AND DETAIL REFERENCES.
- REFER TO ROOM FINISH SCHEDULE OR PLAN AND EQUIPMENT PLANS FOR LOCATION AND EXTENT OF FINISH FLOOR MATERIALS.
- PROVIDE WOOD BLOCKING AS REQUIRED, WITHIN METAL STUD WALLS FOR WALL MOUNTED ITEMS.
- REFER TO MASTER/CODE PLANS FOR CODE INFORMATION AND FIRE RATED WALL LOCATIONS.
- PROVIDE SPRAY FOAM INSULATION AND THERMAL BARRIER CONTINUOUS AT INTERSECTION OF EXTERIOR WALLS AND DECK.

ARCHITECTURAL PLAN NOTES

(ALL NOTES MAY NOT BE INDICATED ON THIS SHEET)

— W### INDICATES WALL TYPE. REFER TO DRAWING A1.01 FOR WALL THICKNESS, HEIGHT AND COMPOSITION.


3 DASHED LINE INDICATES ROOF OVERHANGS, REFER TO ROOF PLAN.

26 LOW WALL REFER TO 4-A1.01.

27 EXISTING WINDOW TO REMAIN. REFER TO FRAME DETAILS 7 AND 8-A6.02.


33 DEFIBRILLATOR CABINET (AED). PROVIDE A SMOOTH FACE CMU AT LOCATION OF AED CABINET.

37 DASHED LINE INDICATES GWB BULKHEAD. REFER TO REFLECTED CEILING PLAN.

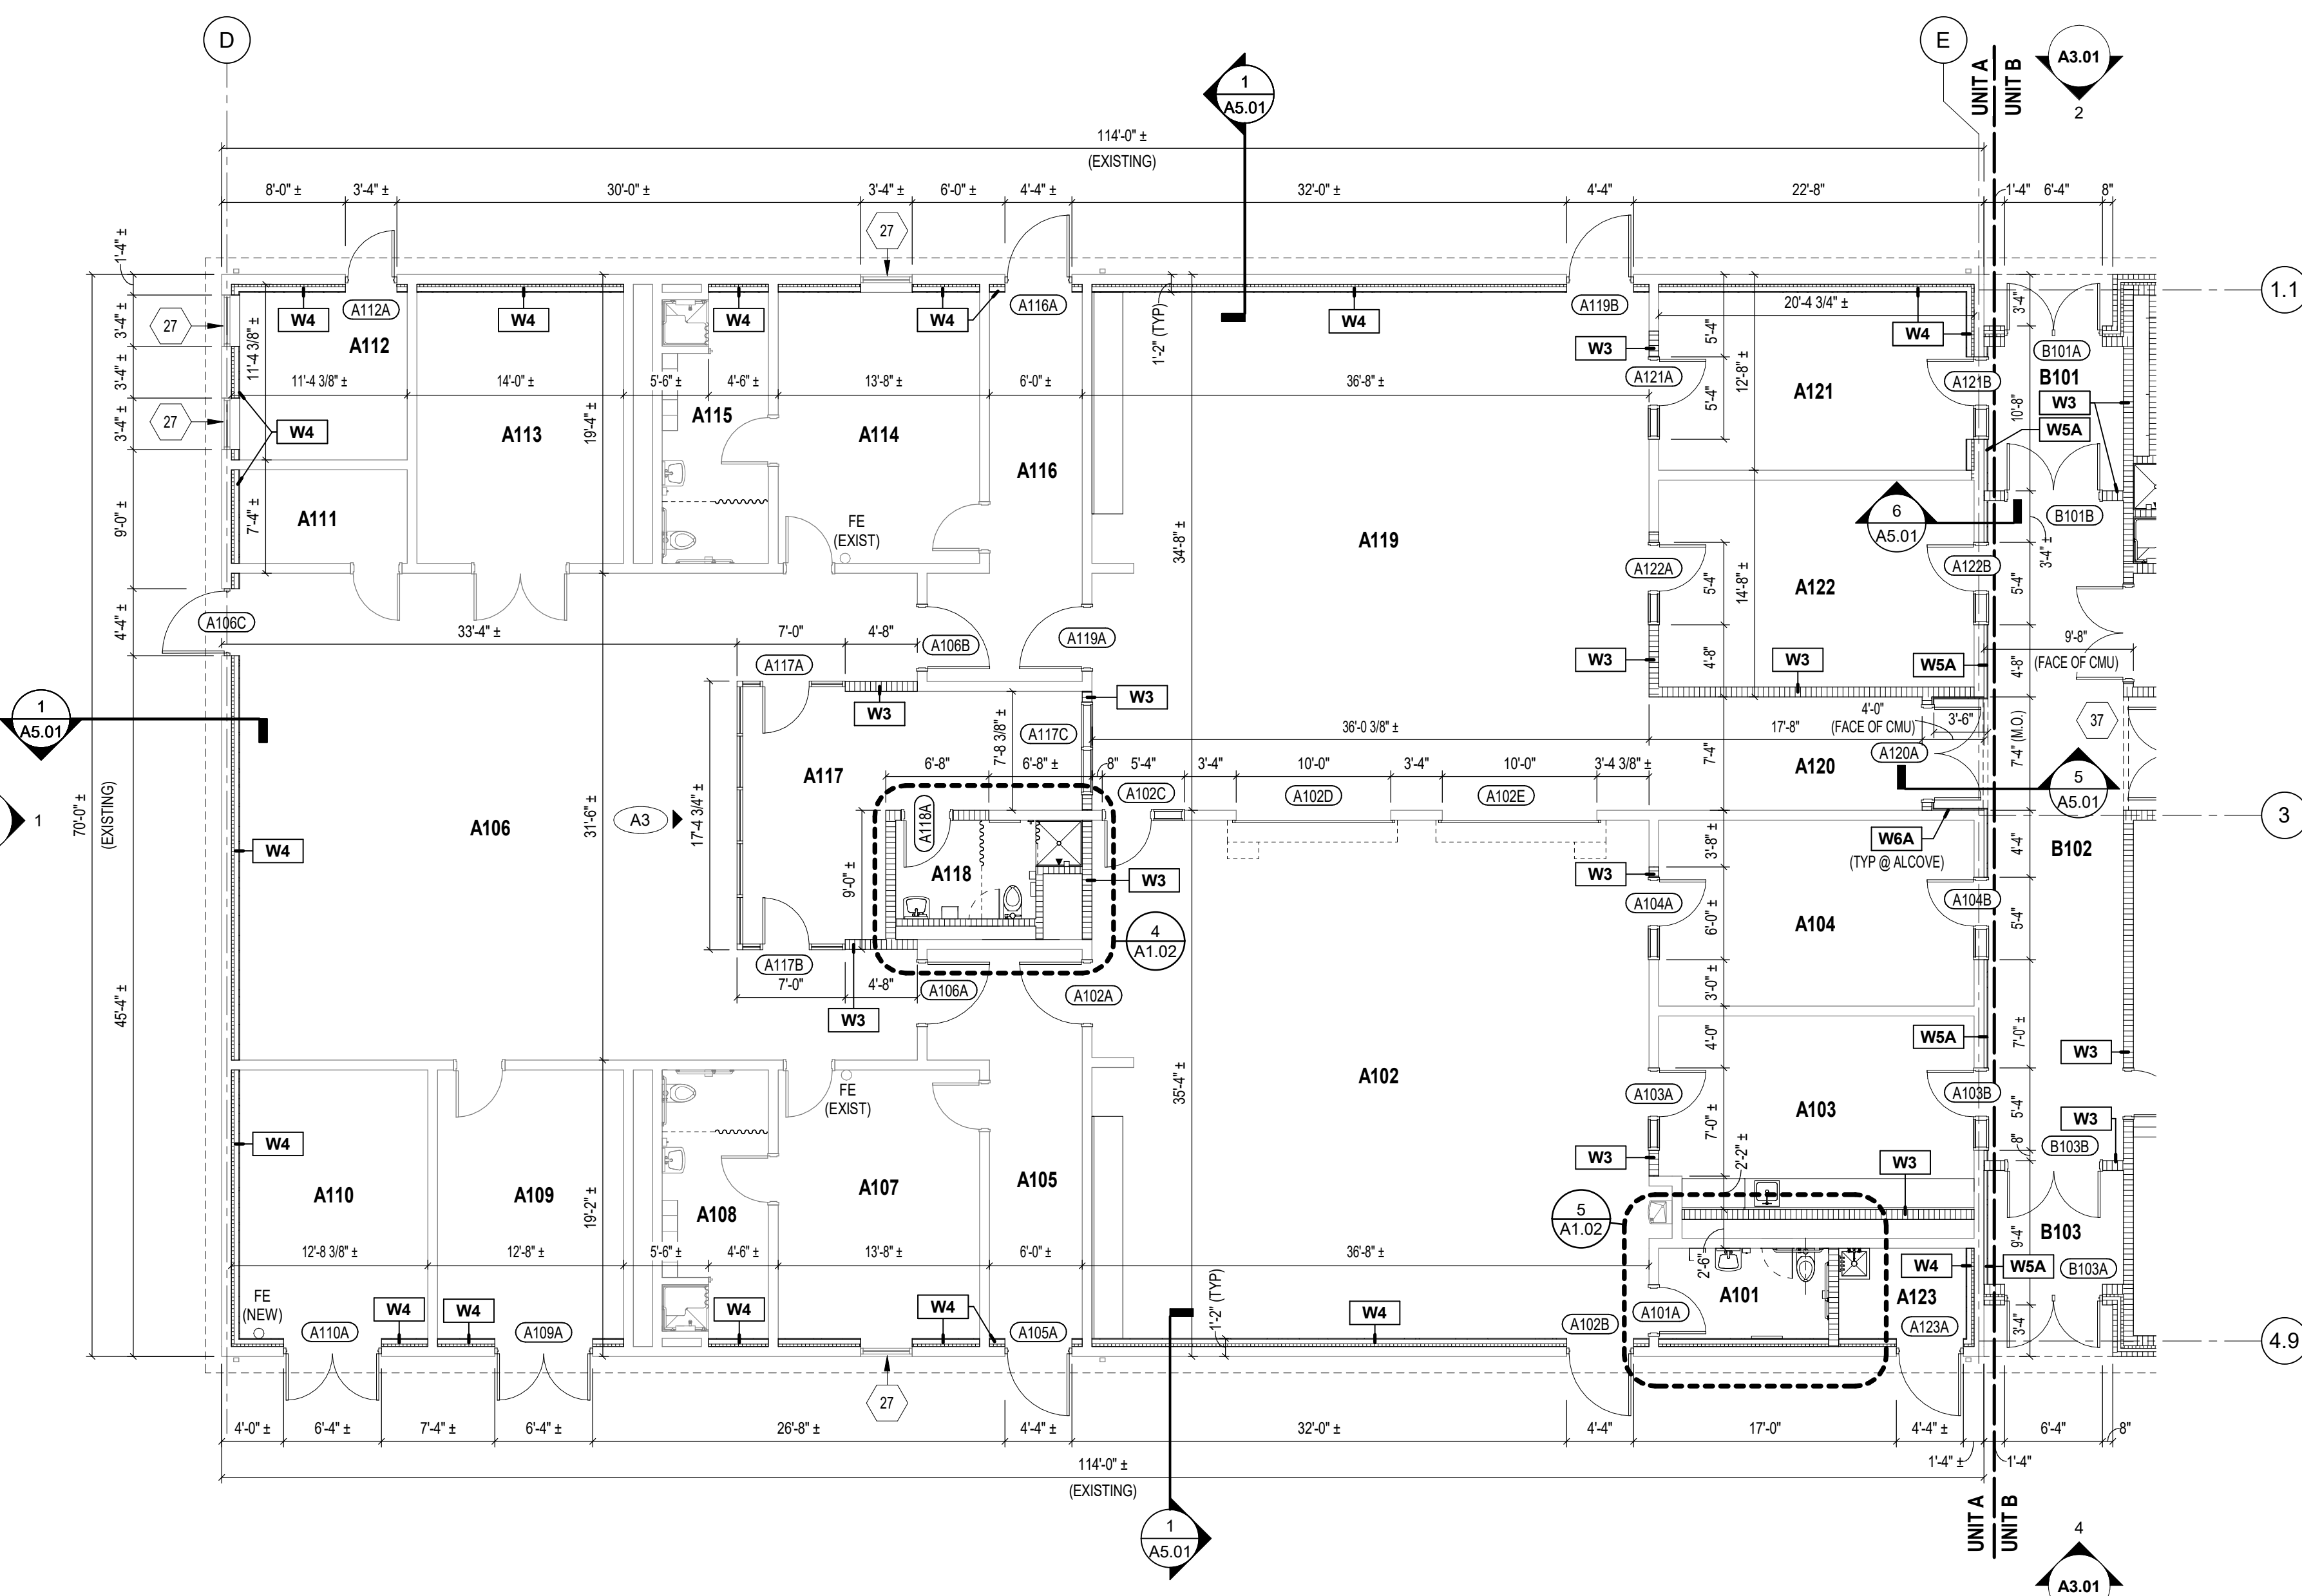

UNIT A - FIRST FLOOR ARCHITECTURAL PLAN

SCALE: 1/8" = 1'-0"

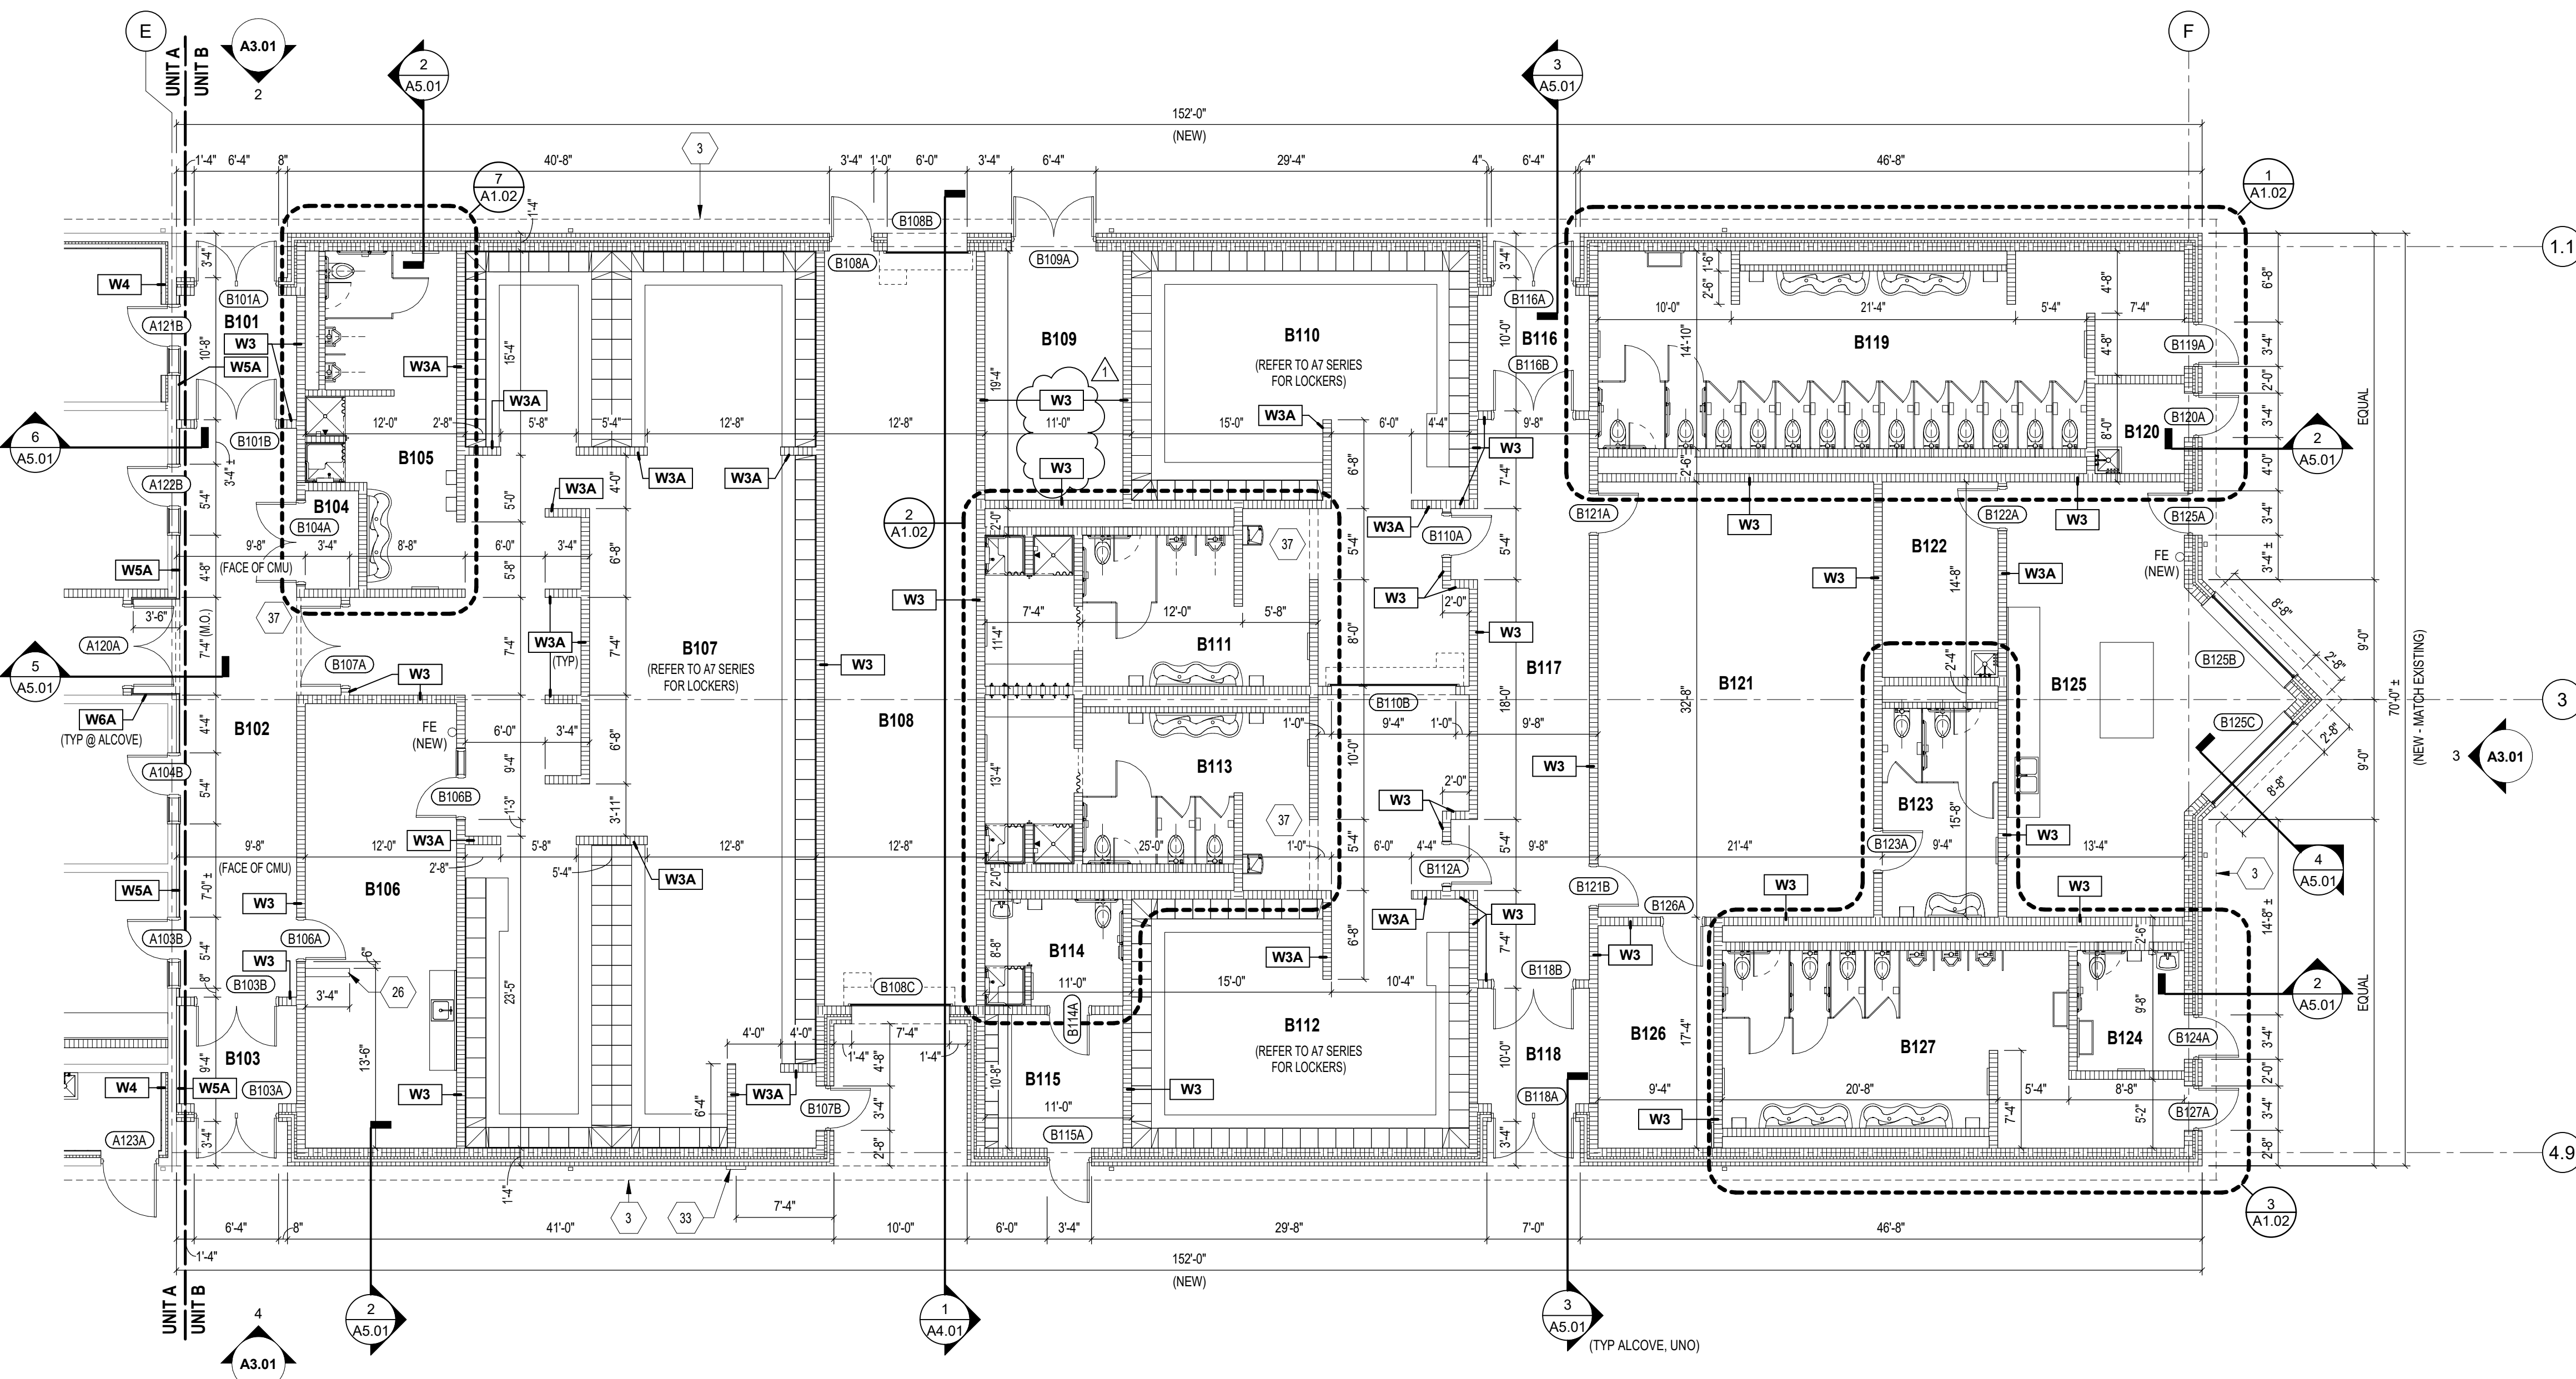

UNIT B - FIRST FLOOR ARCHITECTURAL PLAN








SCALE: 1/8" = 1'-0"

VERIFICATION NOTE

CONTRACTOR SHALL VERIFY ALL DIMENSIONS AND CLEARANCES AND ALL EXISTING FIELD CONDITIONS BEFORE STARTING CONSTRUCTION. COMMENCEMENT OF WORK CONSTITUTES ACCEPTANCE OF CONDITIONS.

SHOULD DIFFERENT CONDITIONS BE ENCOUNTERED, CONTACT THE ARCHITECT BEFORE PROCEEDING WITH WORK.

C:\Users\kshah\Documents\2021_ARCH\223139_00_Indianapolis\WP\01.dwg
2/12/2024 3:46:01 PM

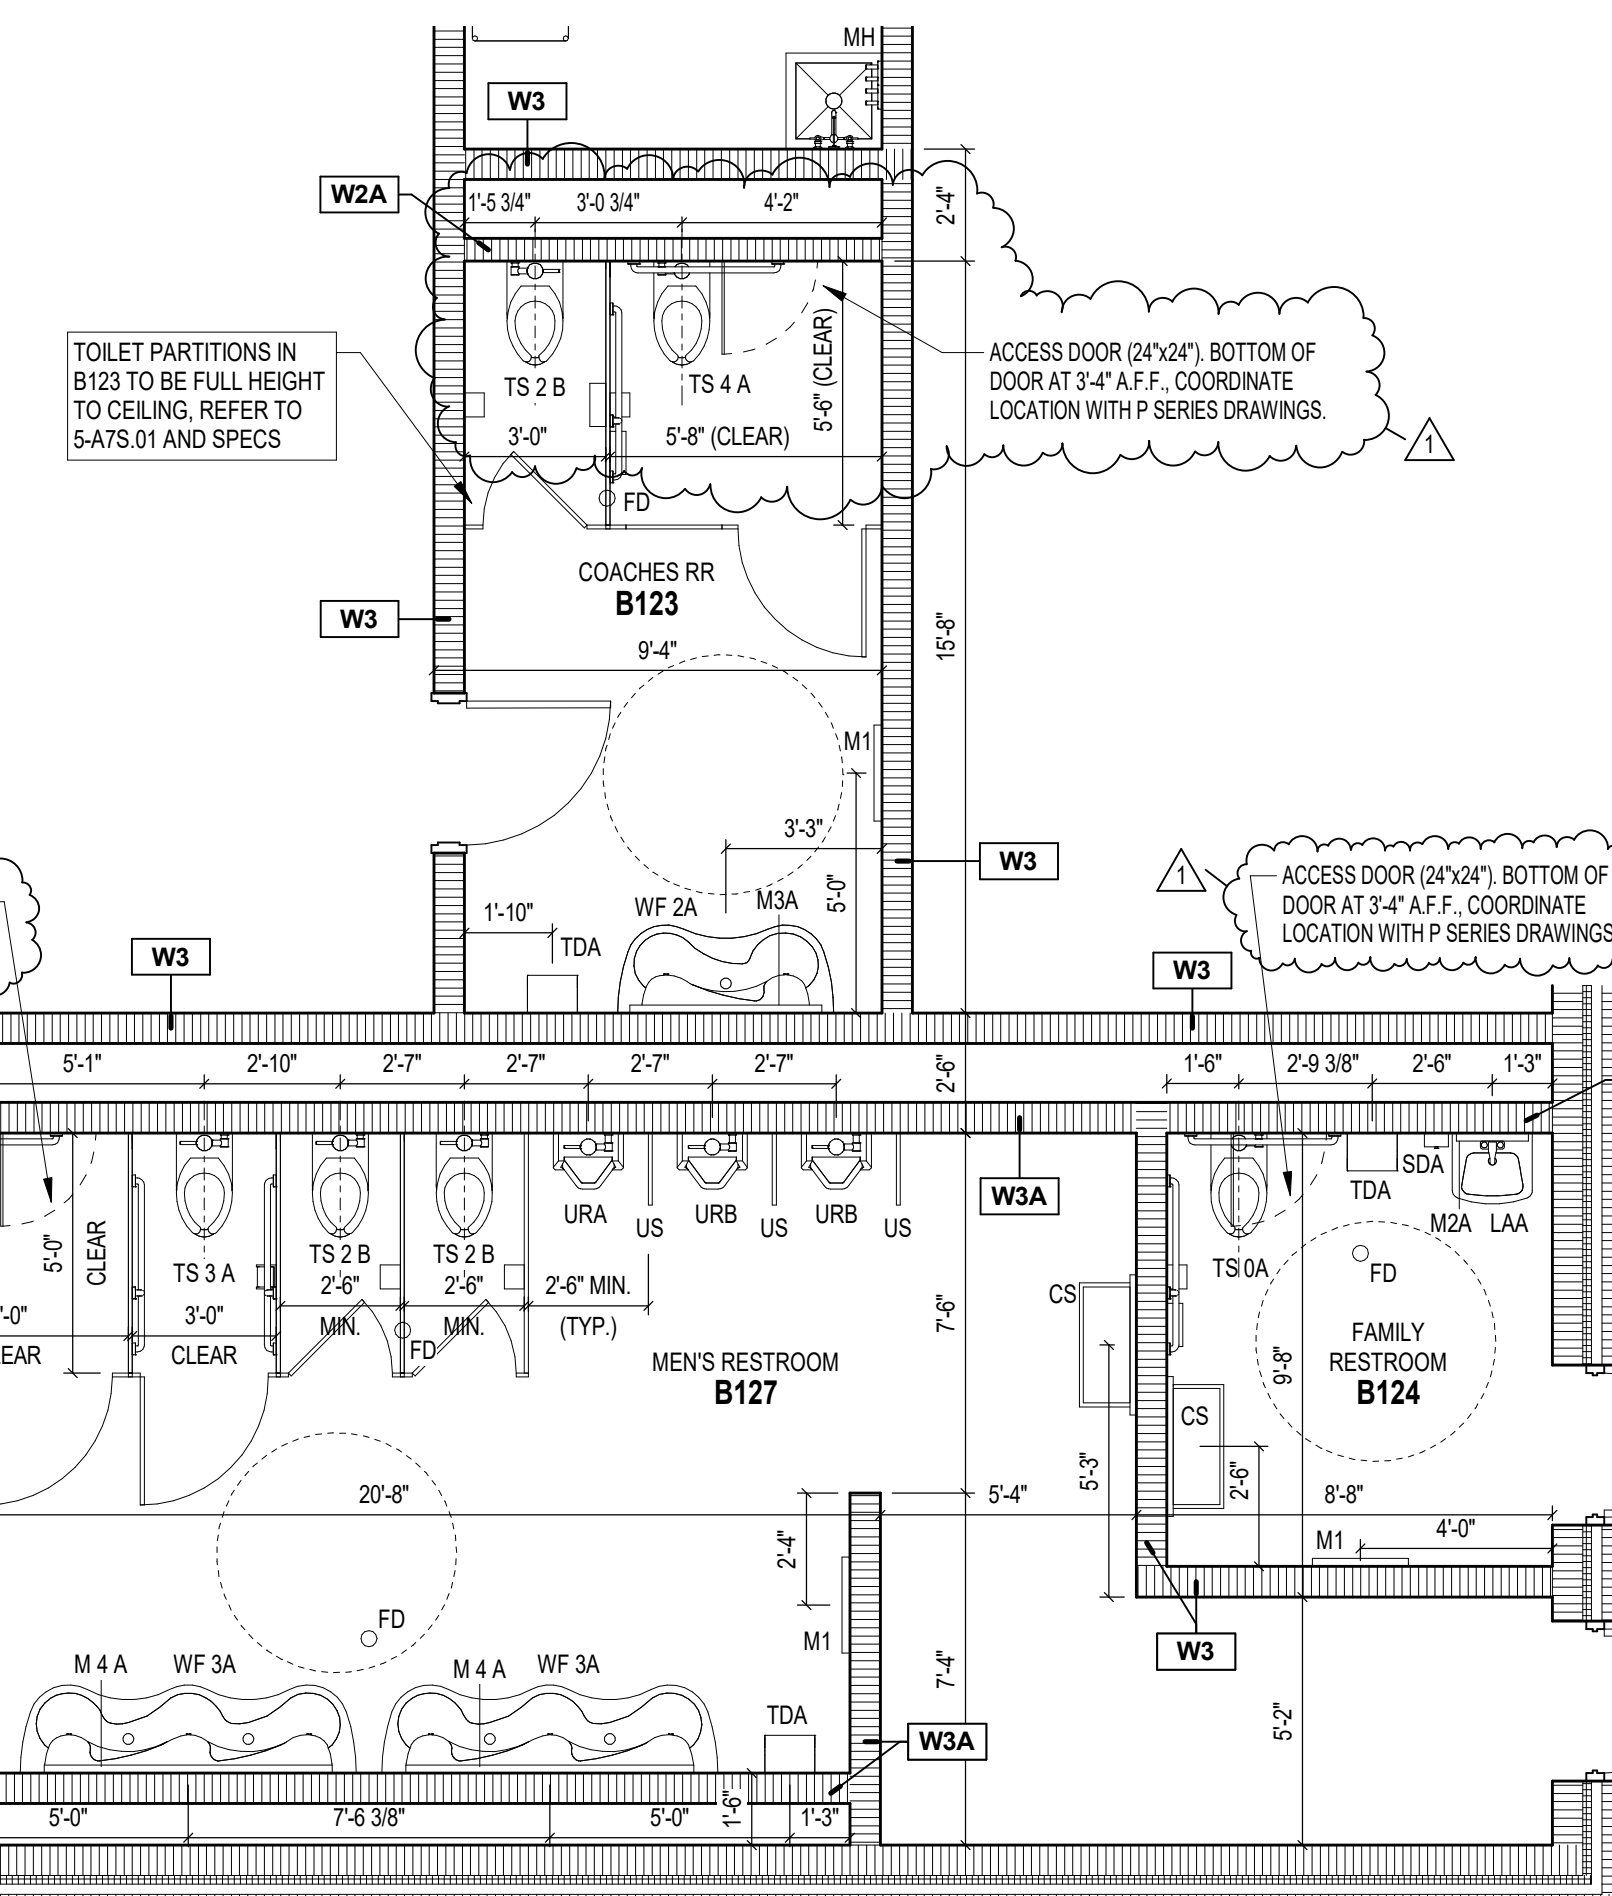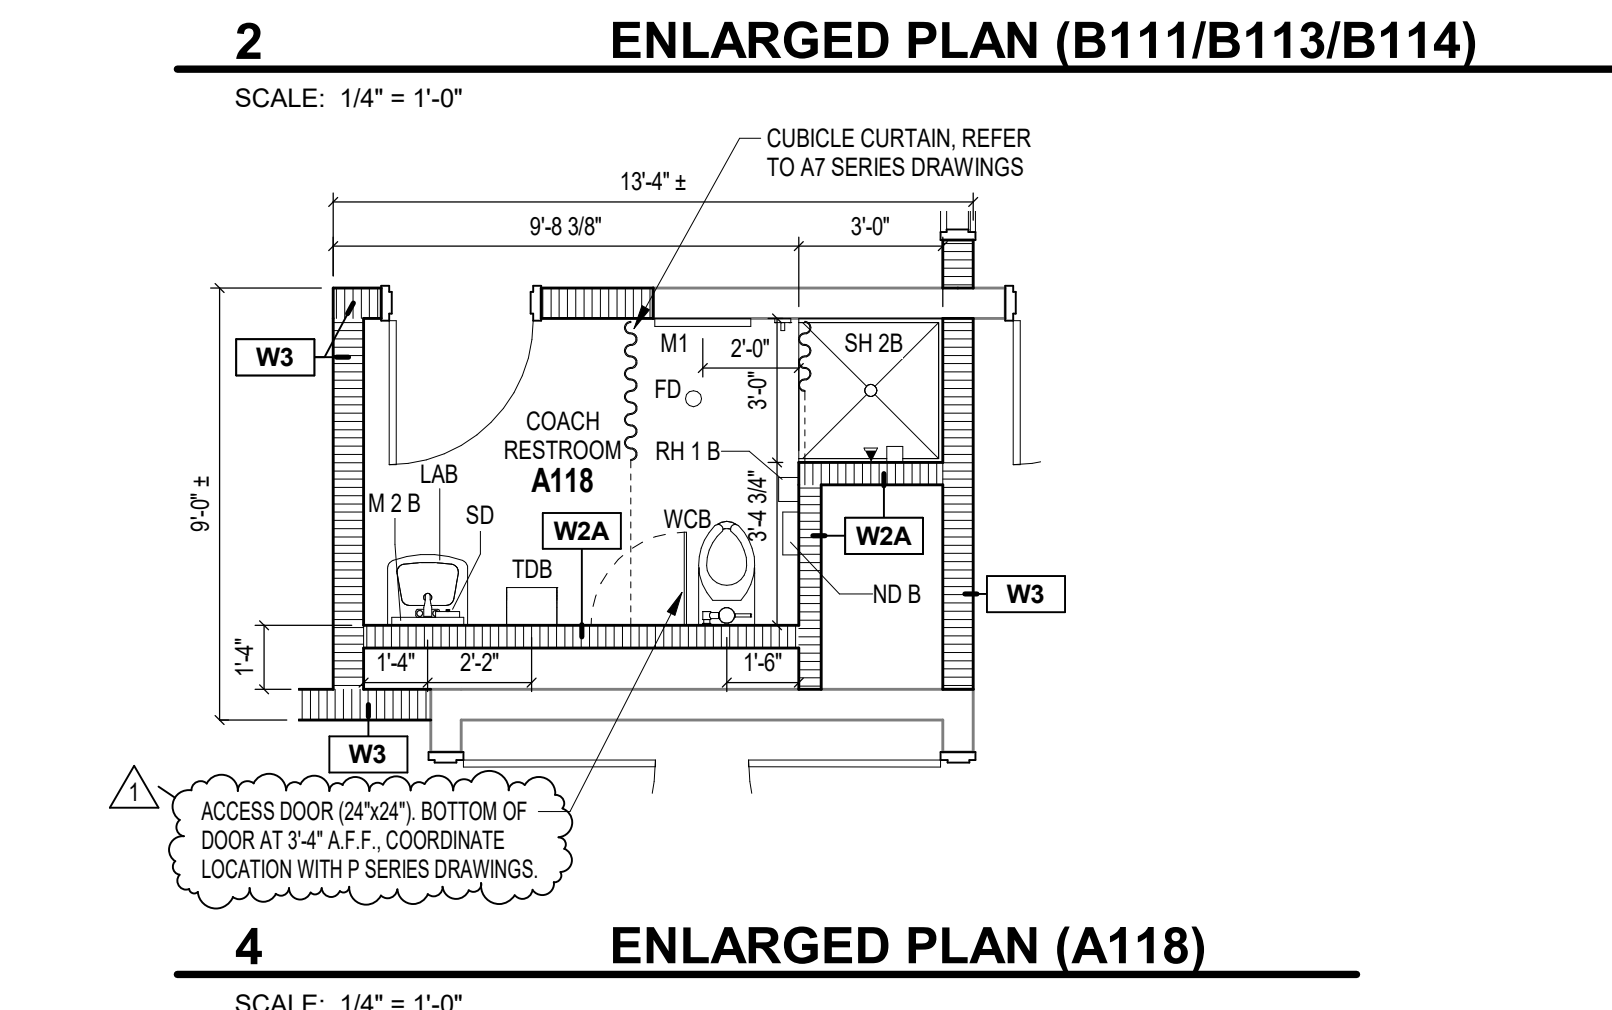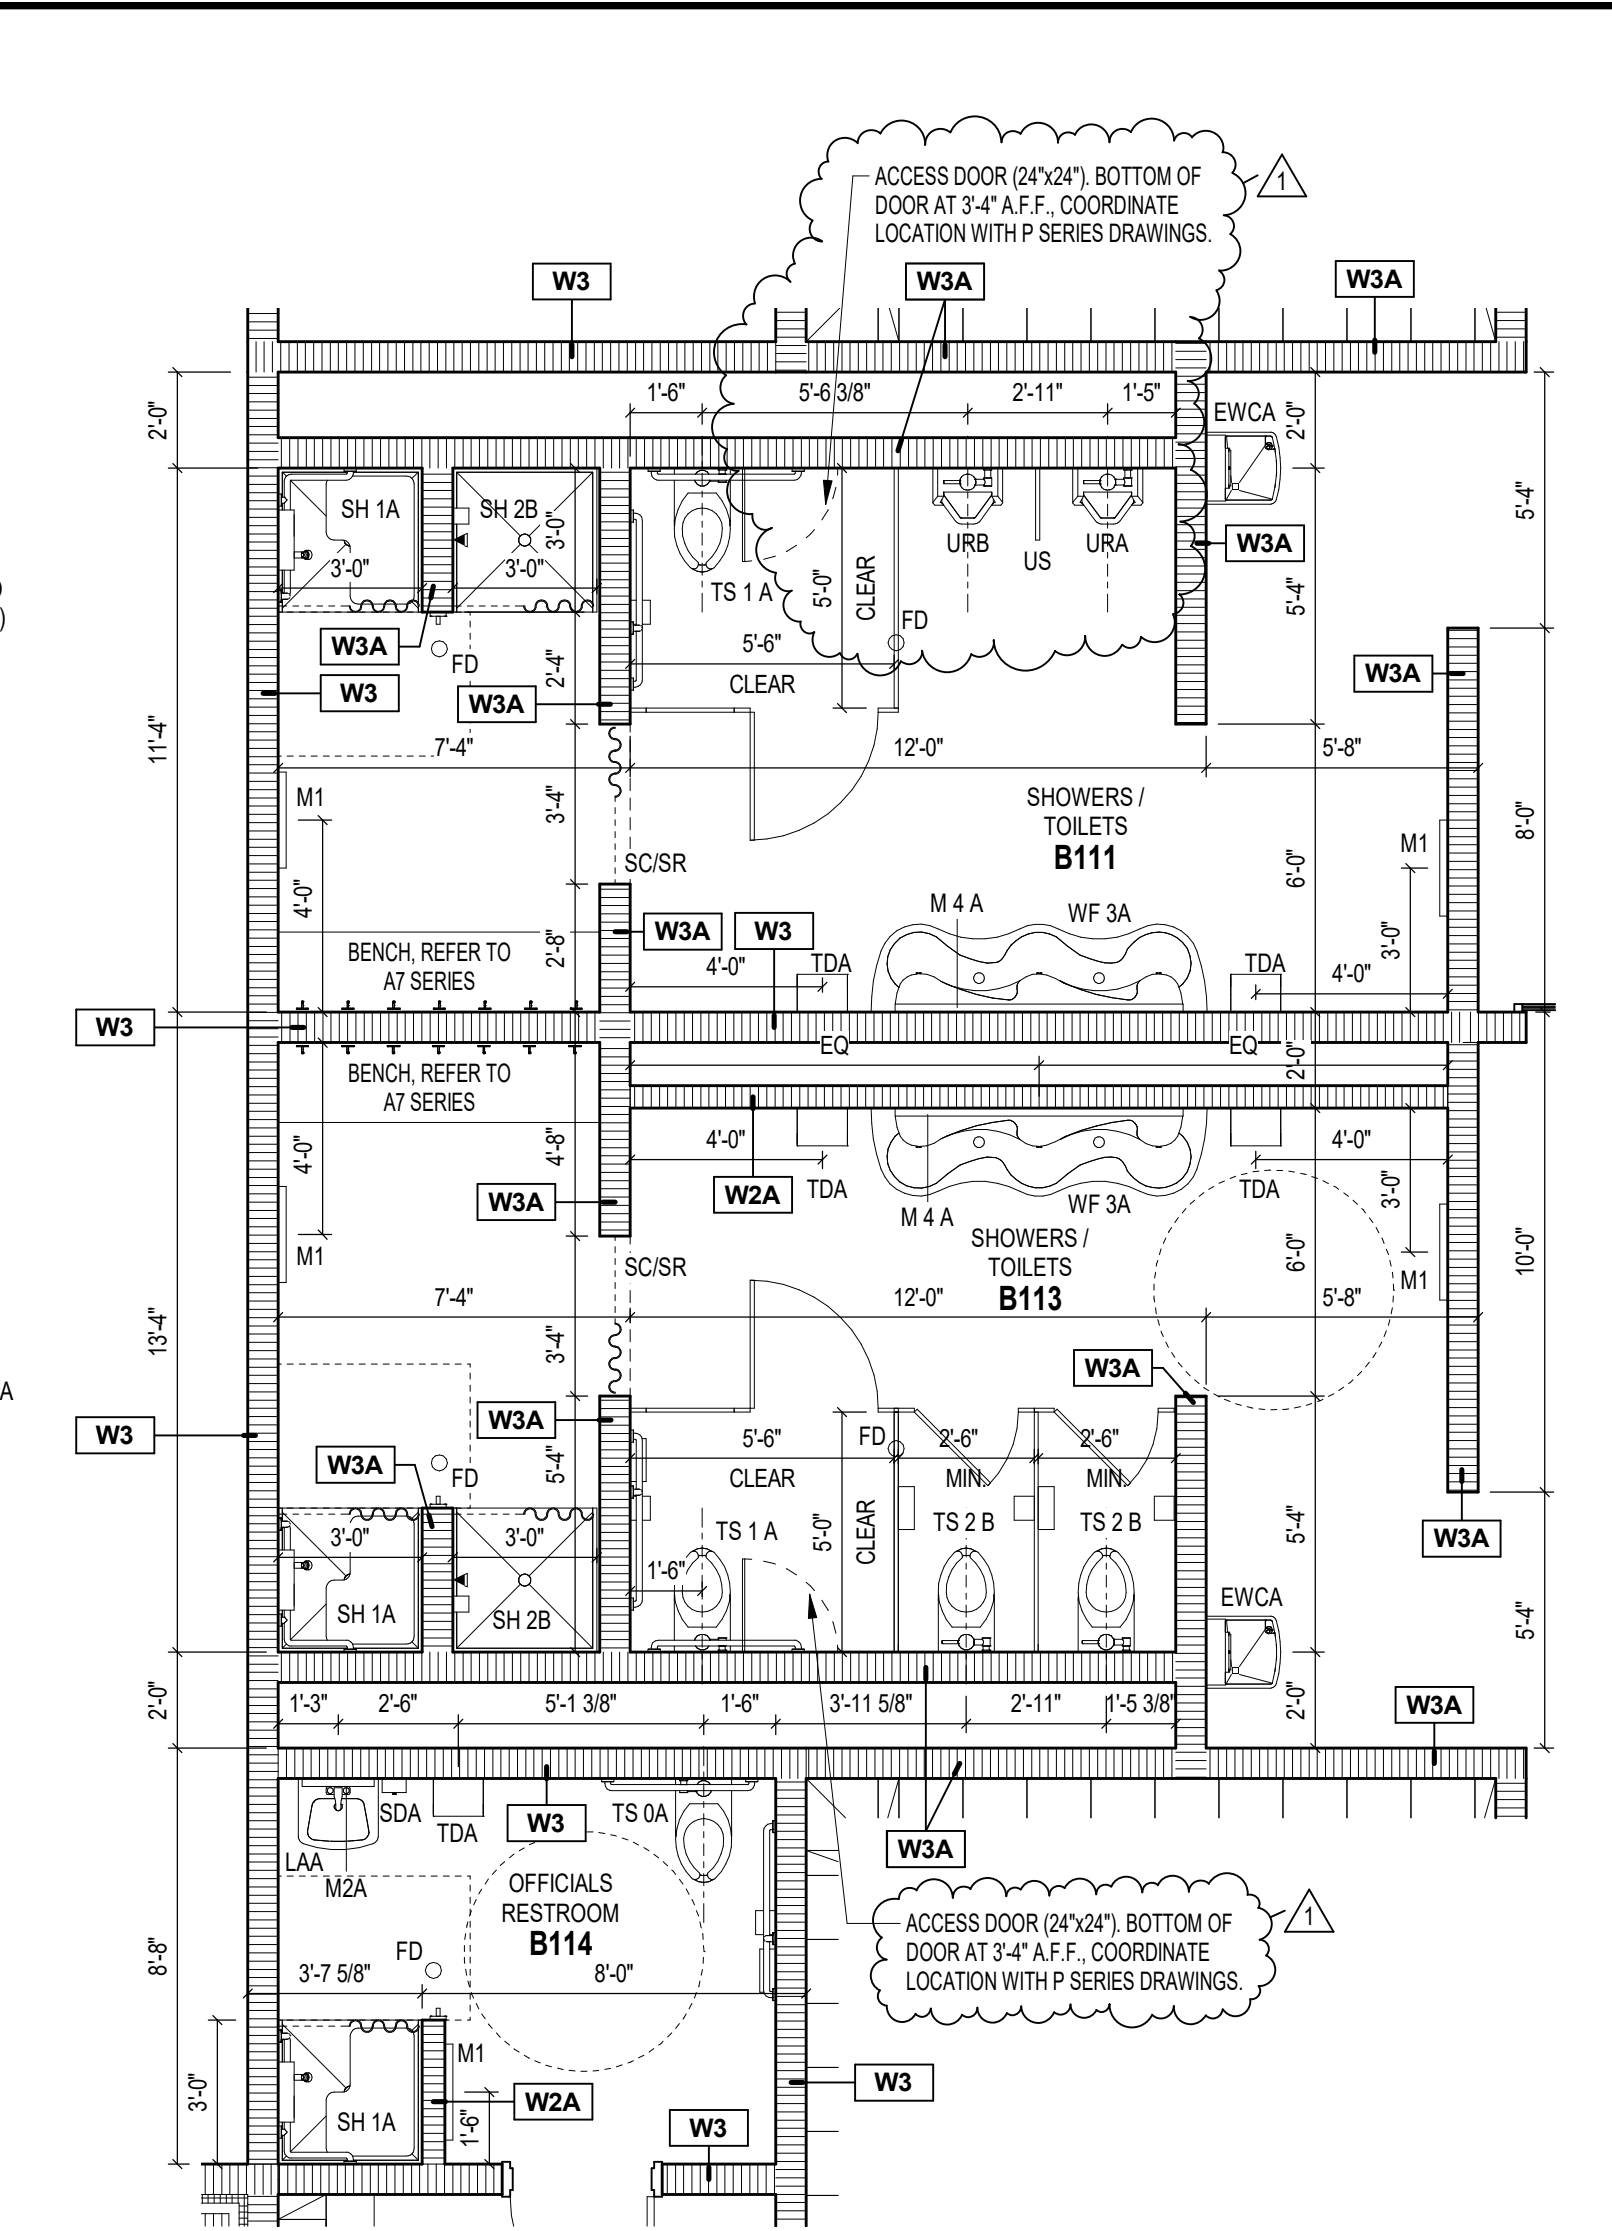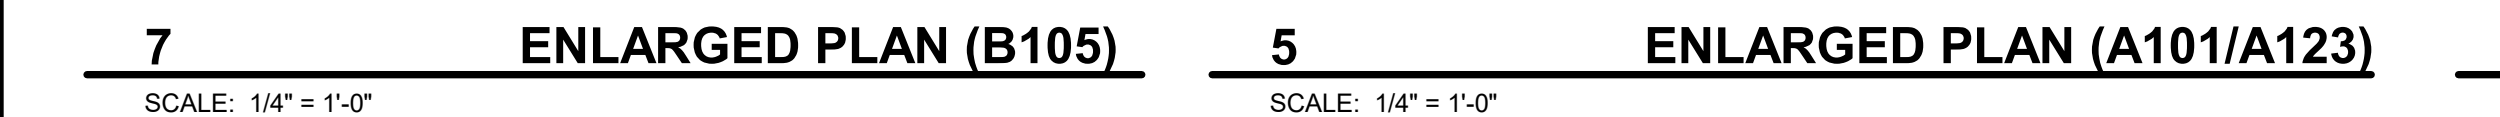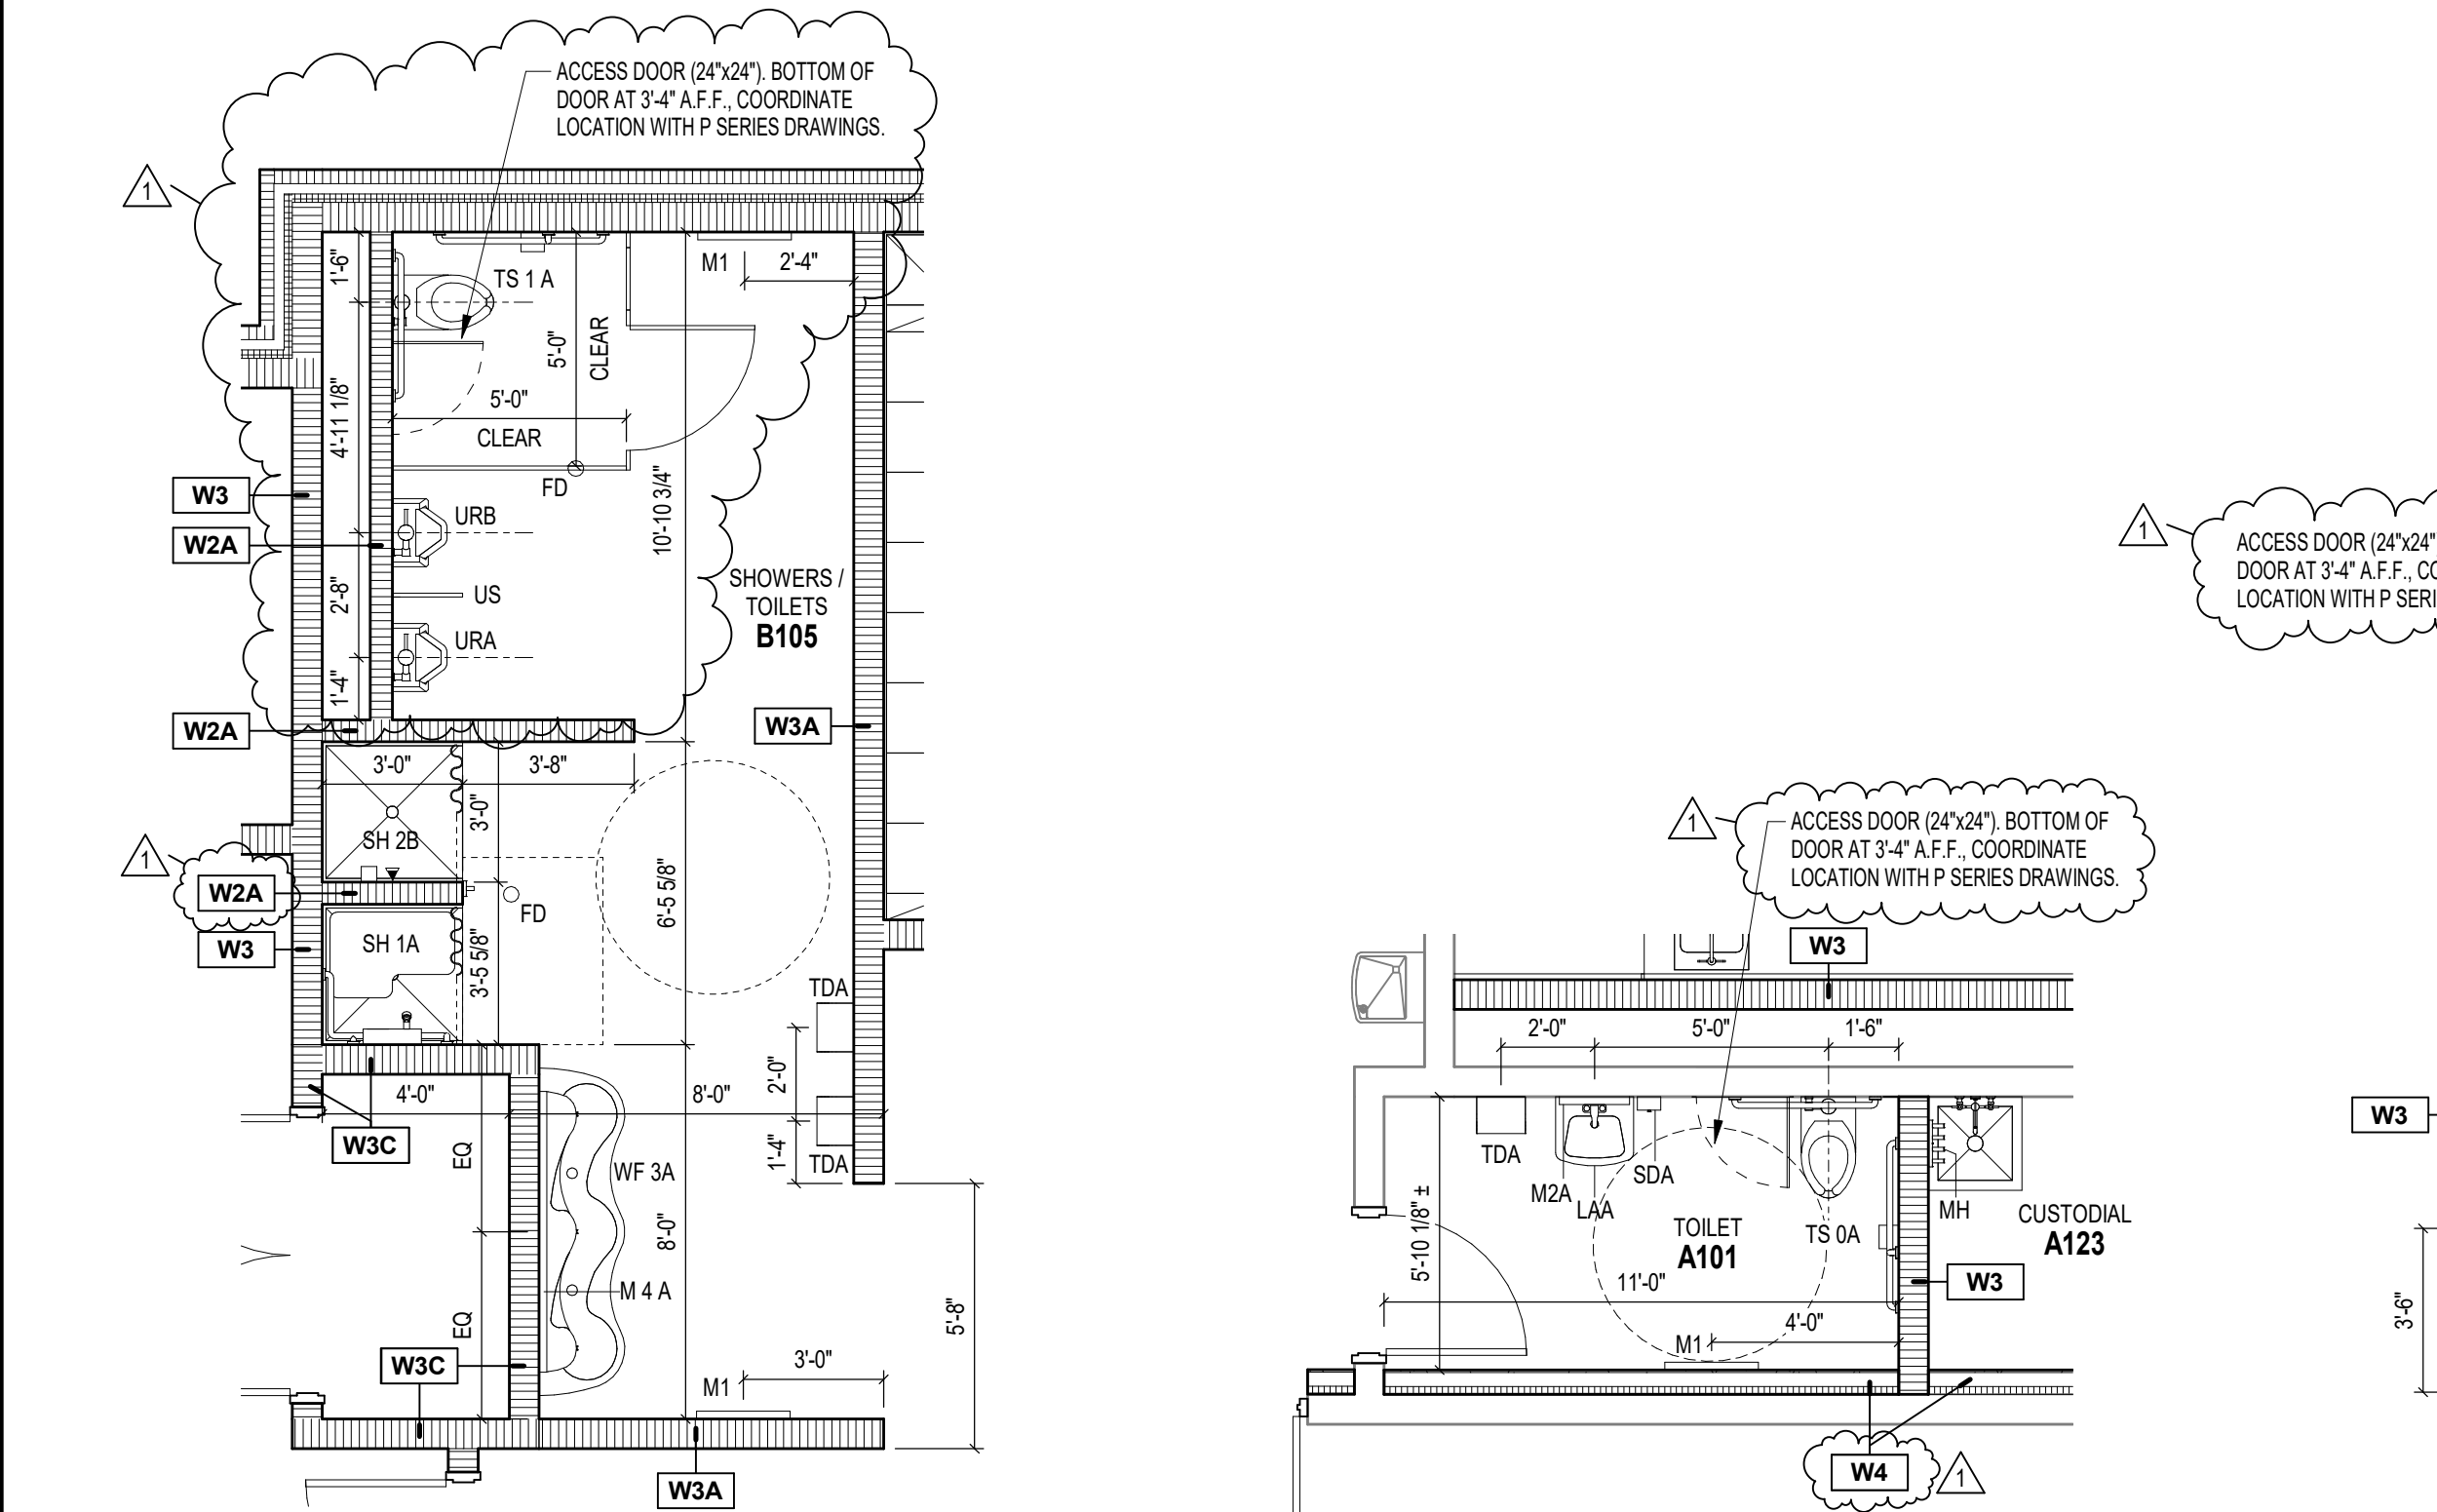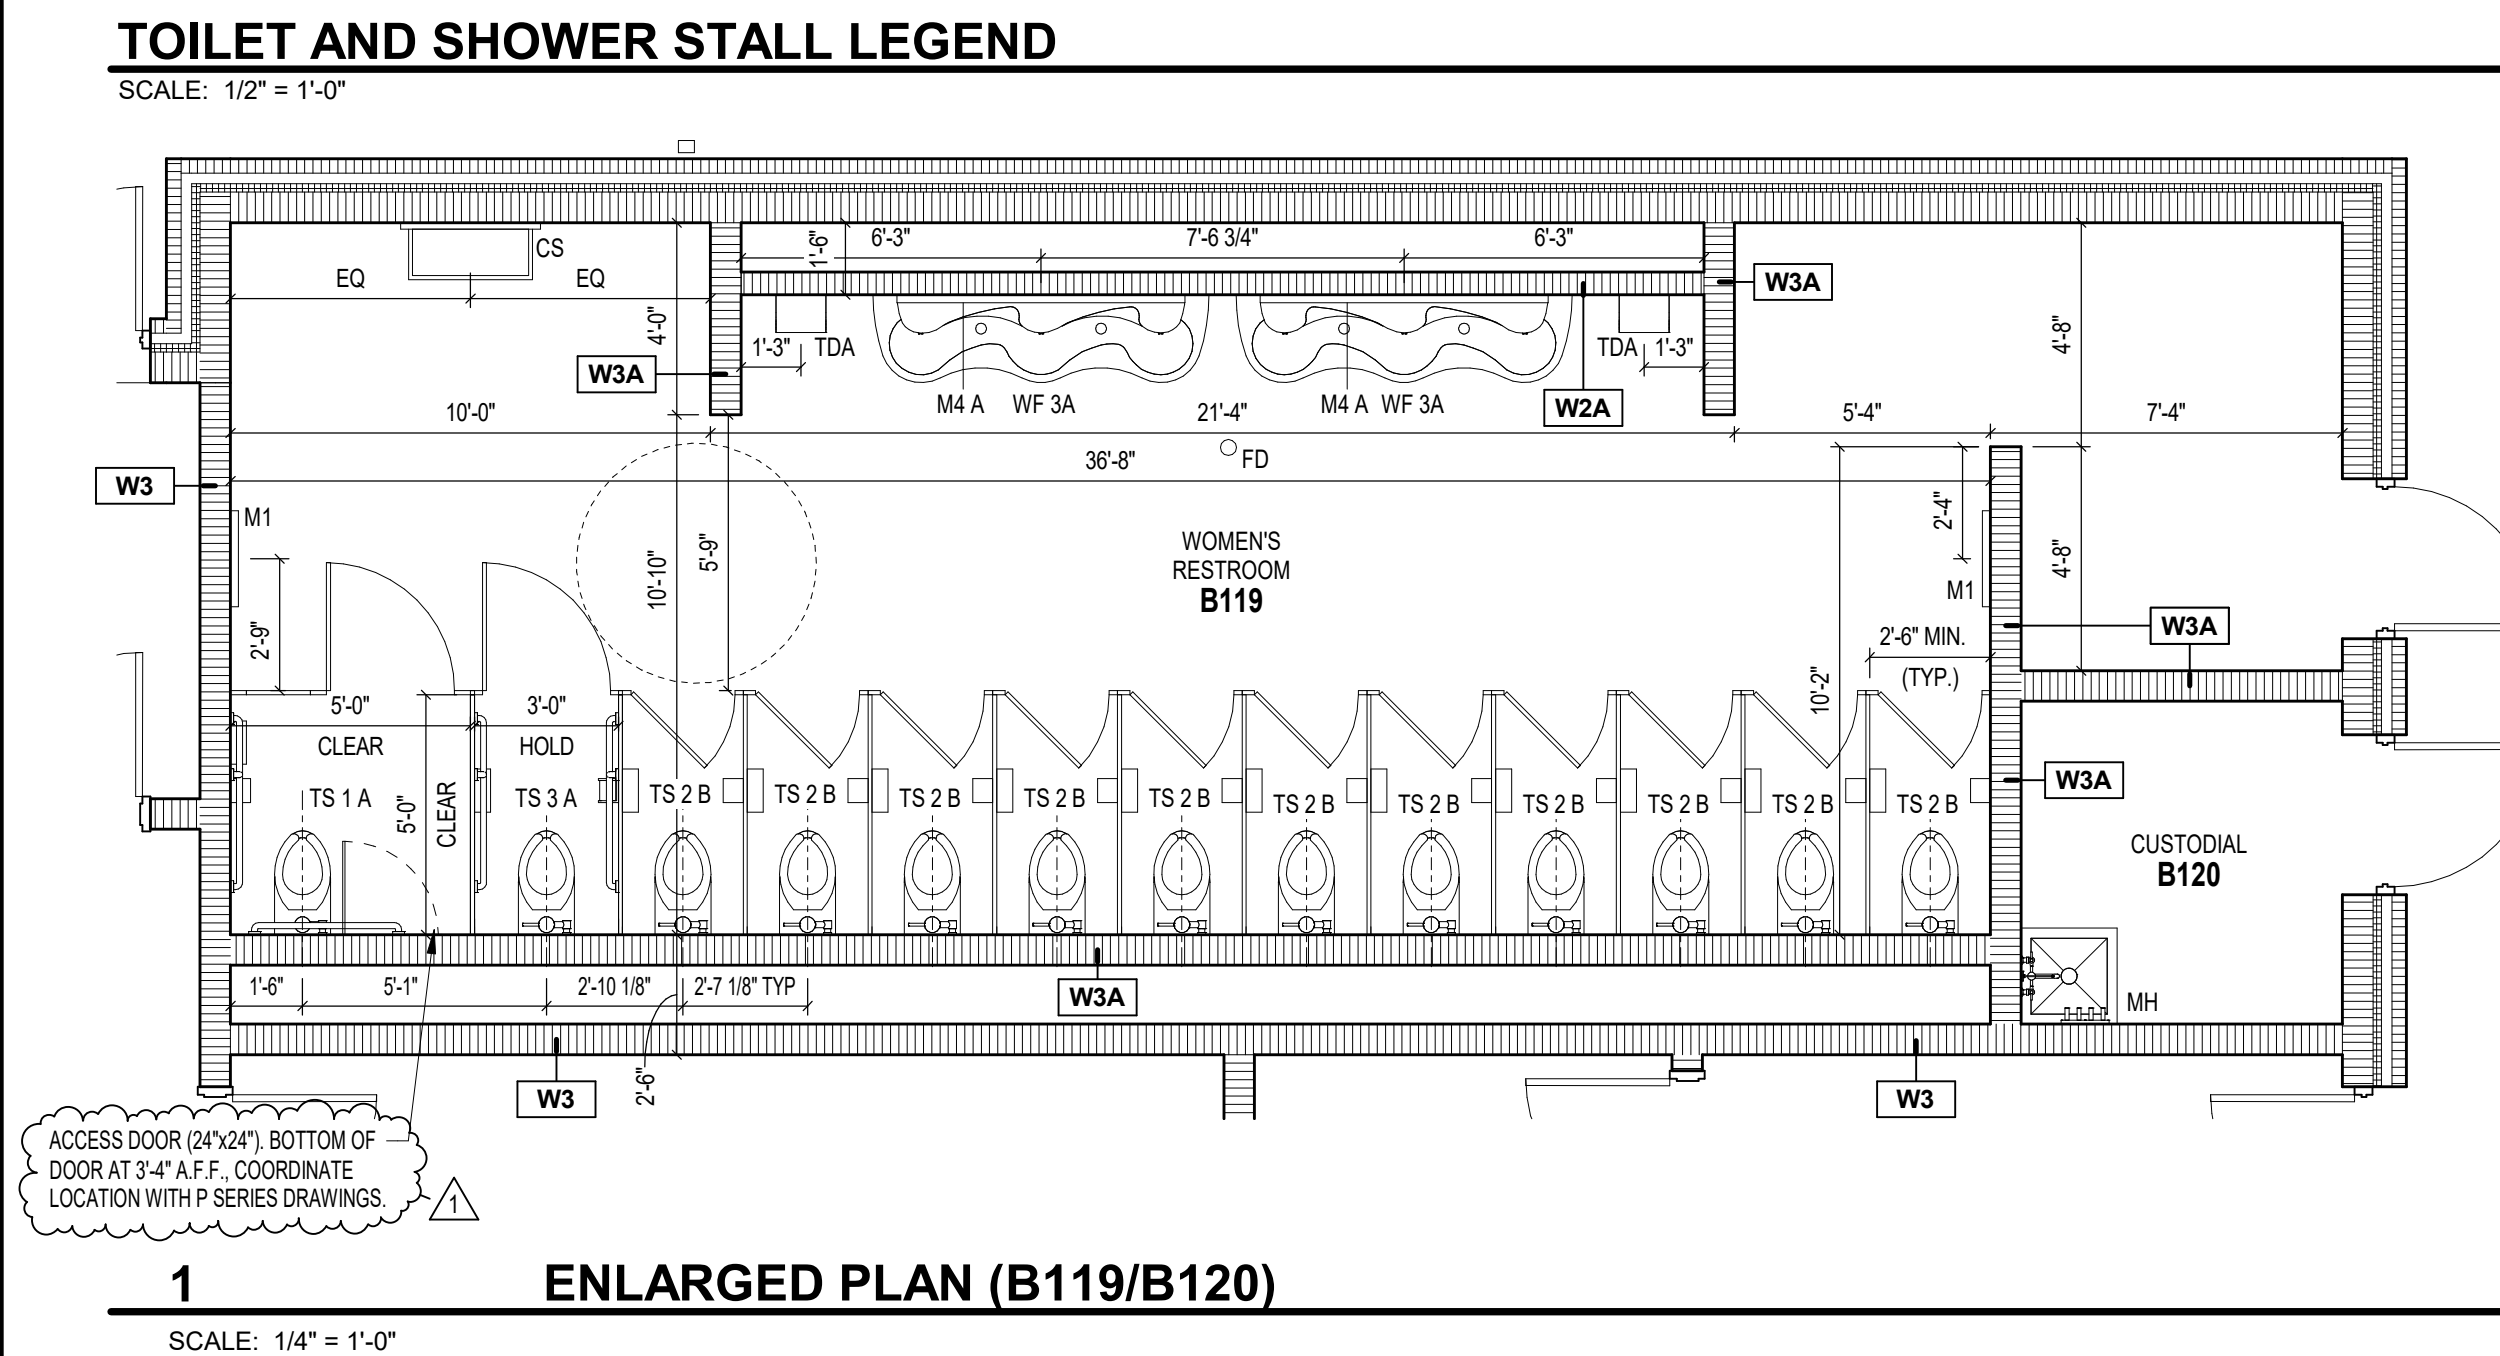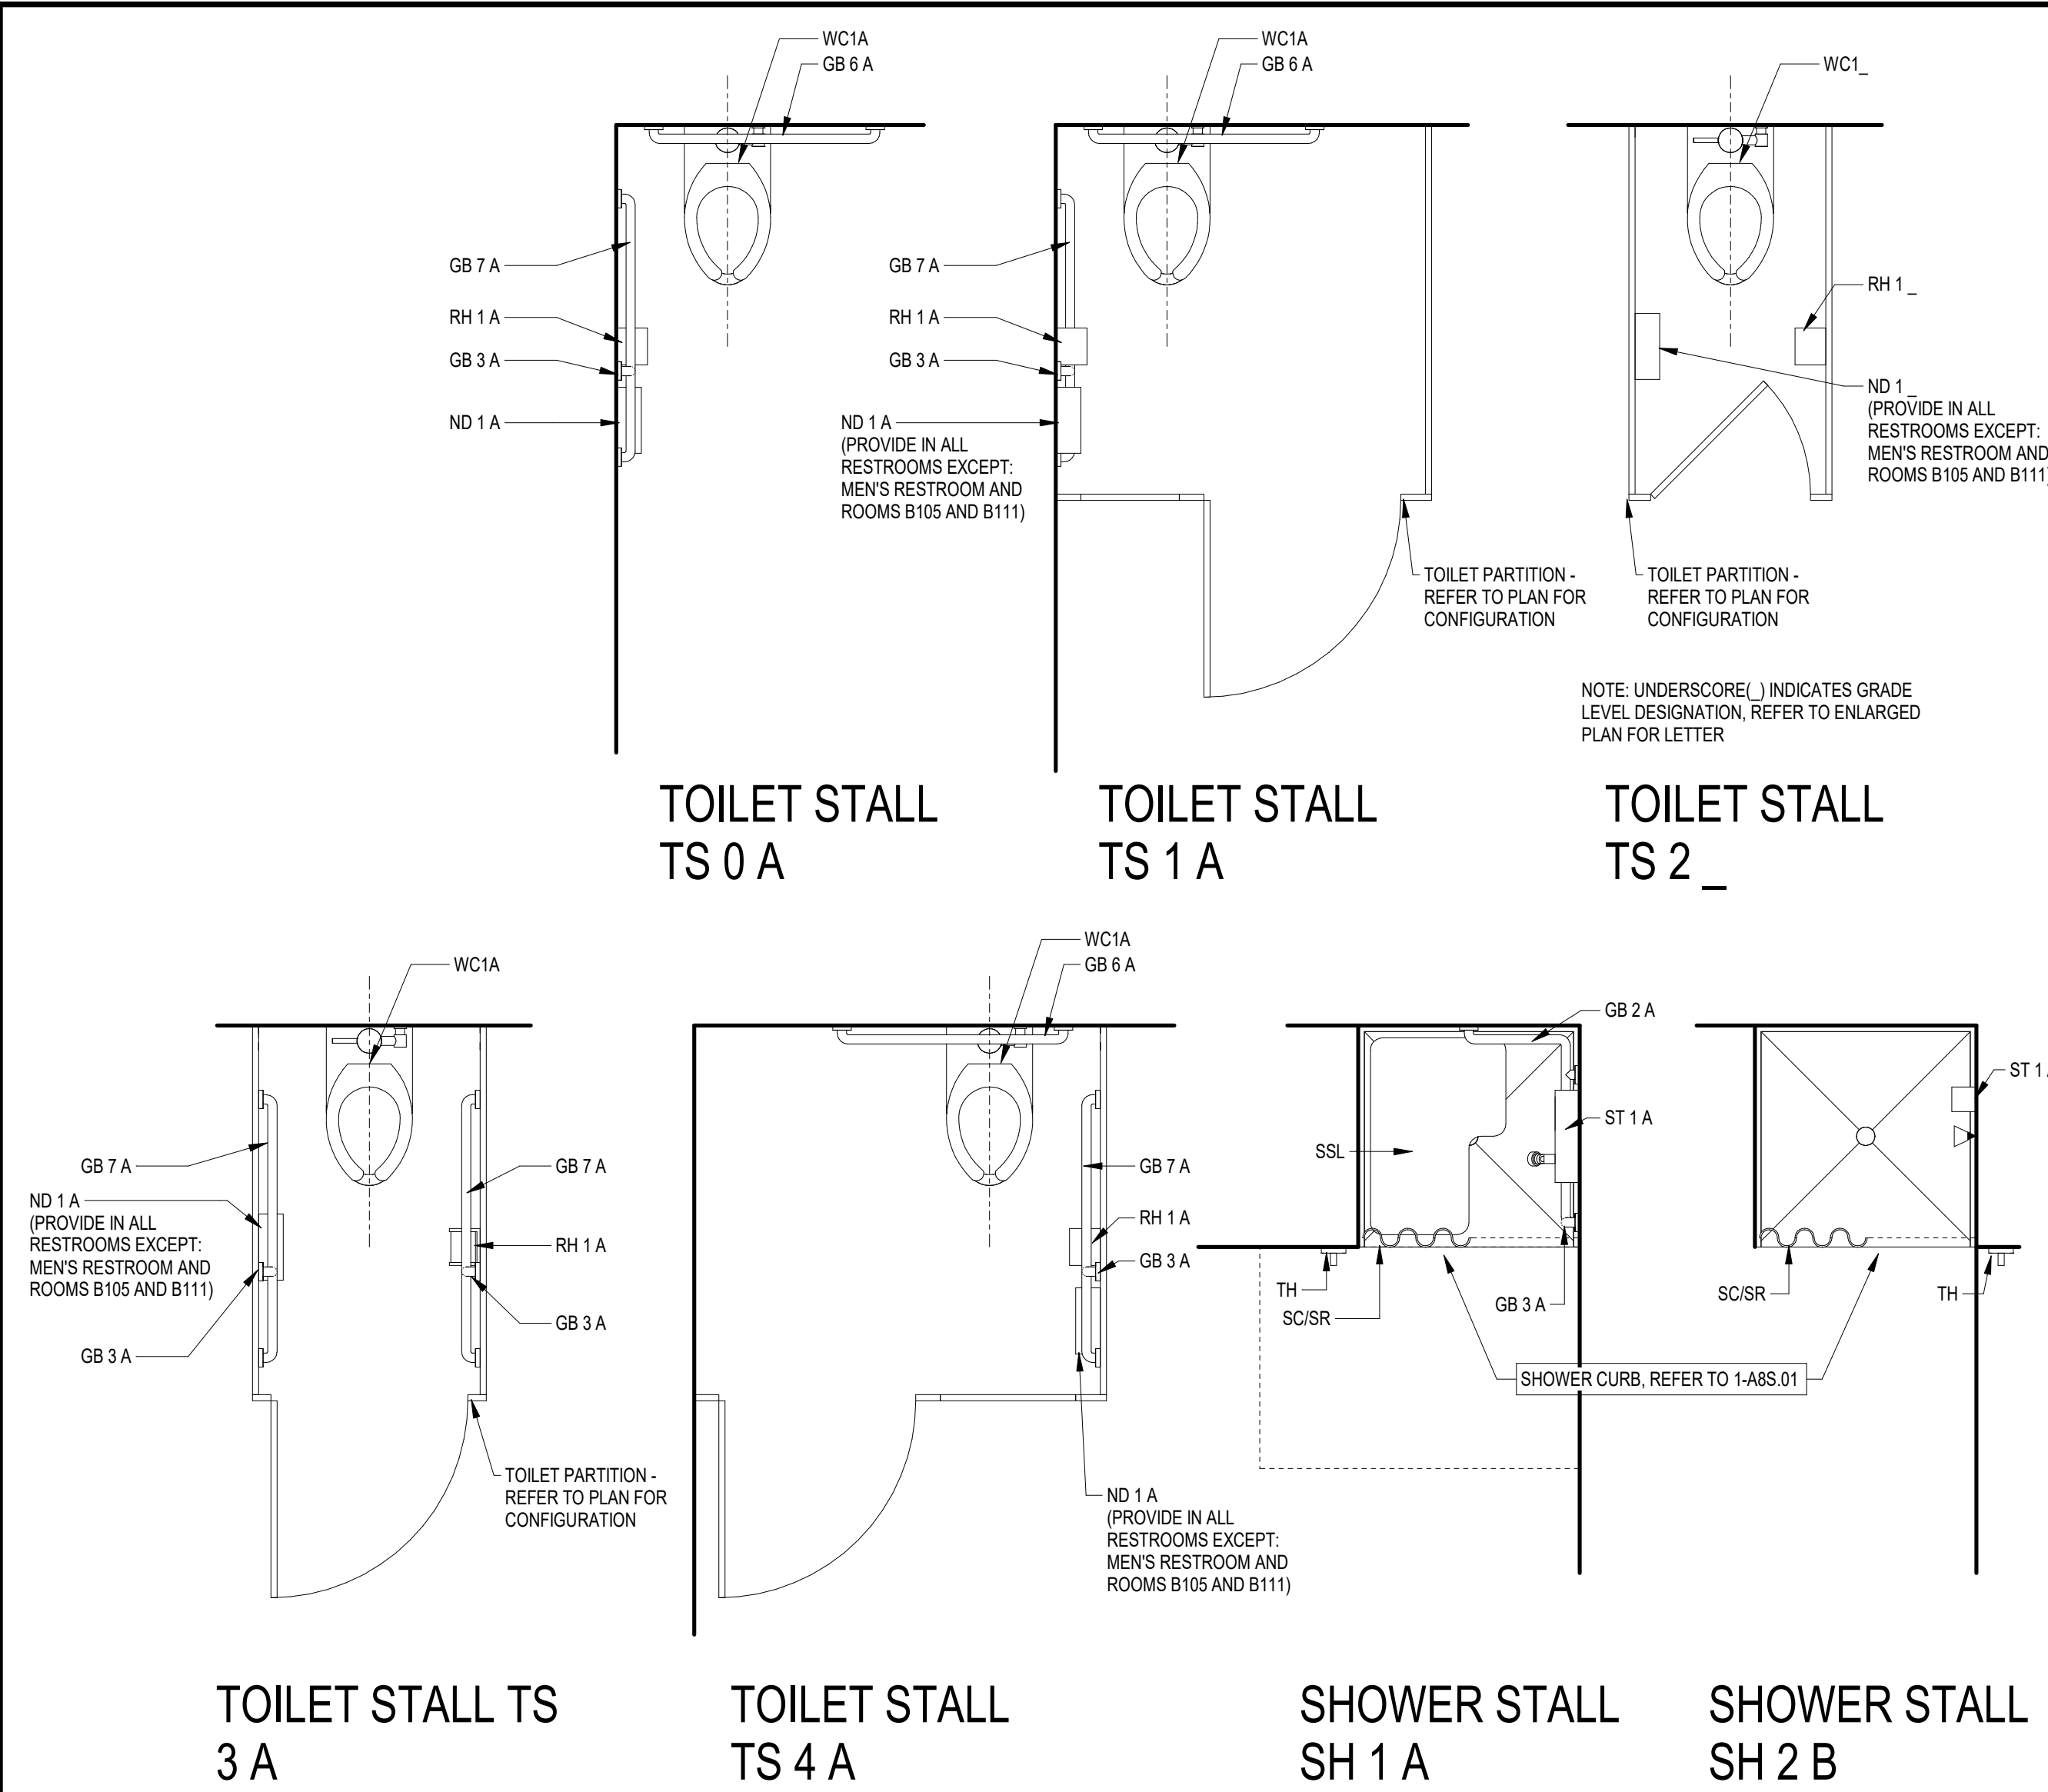

WATER CLOSETS AND ACCESSORIES

AMBULATORY ADULT ADA WATER CLOSETS

WCA - WATER CLOSET
GB A - GRAB BAR
RH A - TOILET ROLL HOLDER
ND A - SANITARY NAPKIN DISPOSAL

WHEELCHAIR ADULT ADA WATER CLOSETS

WCA - WATER CLOSET
GB A - GRAB BAR
RH A - TOILET ROLL HOLDER
ND A - SANITARY NAPKIN DISPOSAL

WC - WATER CLOSET
RH - TOILET ROLL HOLDER
ND - SANITARY NAPKIN DISPOSAL

STANDARD WATER CLOSETS
GRADES 7 AND ABOVE

WF - WASHFOUNTAIN

WF - (2 PERSON)
WF - (3 PERSON)

LV - LAVATORY, M - MIRROR, SD - SOAP DISPENSER

SHOWER

TRANSFER TYPE 36" x 36" SHOWER

TOILET ACCESSORIES ABBREVIATIONS

CH - COAT HOOK
CS - CHANGING STATION
EWC - ELECTRIC WATER COOLER
DF - DRINKING FOUNTAIN
FD - FLOOR DRAIN
FEC - FIRE EXTINGUISHER CABINET
FE - FIRE EXTINGUISHER
GB - GRAB BAR
HD - HAND DRYER
HRD - HAIR DRYER
LA - LAVATORY
M - MIRROR
MH - MOP HOLDER
ND - NAPKIN DISPOSAL
NV - NAPKIN VENDOR
RH - ROLL HOLDER (TOILET PAPER DISPENSER)
UR - URINAL
US - URINAL SCREEN
SC - SHOWER CURTAIN
SD - SOAP DISPENSER
ST - SOAP TRY
TD - TOWEL DISPENSER (PAPER)
TDD - TOWEL DISPENSER / TOWEL DISPOSAL (PAPER)
TH - TOWEL HOOK
WC - WATER CLOSET
WF - WASHFOUNTAIN
WR - WASTE RECEPTACLE

TOILET ACCESSORIES ABBREVIATIONS

CH - COAT HOOK
CS - CHANGING STATION
EWC - ELECTRIC WATER COOLER
DF - DRINKING FOUNTAIN
FD - FLOOR DRAIN
FEC - FIRE EXTINGUISHER CABINET
FE - FIRE EXTINGUISHER
GB - GRAB BAR
HD - HAND DRYER
HRD - HAIR DRYER
LA - LAVATORY
M - MIRROR
MH - MOP HOLDER
ND - NAPKIN DISPOSAL
NV - NAPKIN VENDOR
RH - ROLL HOLDER (TOILET PAPER DISPENSER)
UR - URINAL
US - URINAL SCREEN
SC - SHOWER CURTAIN
SD - SOAP DISPENSER
ST - SOAP TRY
TD - TOWEL DISPENSER (PAPER)
TDD - TOWEL DISPENSER / TOWEL DISPOSAL (PAPER)
TH - TOWEL HOOK
WC - WATER CLOSET
WF - WASHFOUNTAIN
WR - WASTE RECEPTACLE

MOUNTING HEIGHT NOTES:

1. MOUNTING HEIGHTS ARE BASED UPON THE FOLLOWING: TOILET, BATH AND LAUNDRY EQUIPMENT (ACCESSORIES), BOBICK WASHROOM EQUIPMENT, INC., LAVATORIES, URINALS AND WATER CLOSETS, AMERICAN STANDARD, INC. CONTRACTOR SHALL BE RESPONSIBLE FOR COORDINATING THE MOUNTING HEIGHTS OF TOILET ACCESSORIES SUPPLIED BY OTHER MANUFACTURERS.

2. MOUNTING HEIGHT DRAWING INDICATES A TWO PIECE GRAB BAR. GRAB BAR MAY BE A ONE PIECE OR A TWO PIECE GRAB BAR. REFER TO SPECIFICATIONS FOR SPECIFIC TYPE OF GRAB BAR TO BE USED.

3. UNDERSCORE (_) REFER TO ENLARGED PLANS FOR MISSING NUMBER IDENTIFYING THE SPECIFIC TYPE OF TOILET ACCESSORY

GRAB BAR SCHEDULE
(ALL SIZES MAY NOT BE USED ON THIS PROJECT)

GB1 - 36" x 54" TWO WALL
GB2 - 36"x36" TWO WALL
GB3 - 18" STRAIGHT
GB4 - 24" STRAIGHT
GB5 - 30" STRAIGHT
GB6 - 36" STRAIGHT
GB7 - 42" STRAIGHT
GB8 - 48" STRAIGHT

MIRROR SCHEDULE
(ALL SIZES MAY NOT BE USED ON THIS PROJECT)

M1 - 24" W x 60" H
M2 - 18" W x 30" H
M3 - 48" W x 30" H
M4 - 60" W x 30" H

SAMPLE TOILET ACCESSORY LABELING:

RH1A
RH
1
A
WCA

GRADE LEVEL LEGEND:

A - ADULT ACCESSIBLE (ADA) HEIGHTS (GRADES 7 AND ABOVE)
B - GRADES 9 AND ABOVE (ADULTS)
C - GRADES 7-6
D - GRADES 4-6
E - GRADES 1-3
F - PRESCHOOL-KINDERGARTEN
G - CHILDREN'S ACCESSIBLE (ADA) HEIGHTS (K-6)
H - CHILDREN'S ACCESSIBLE (ADA) HEIGHTS (PRESCHOOL)

CONSTRUCTION DOCUMENTS

DRAWN BY: KT / BC
PROJECT NUMBER: 223139.00
PROJECT ISSUE DATE: 01.22.2024

REV. NO. DESCRIPTION DATE

1 ADDENDUM #1 02.14.2024

ENLARGED TOILET ROOM PLANS

A1.02

ZIONSVILLE COMMUNITY HIGH SCHOOL STADIUM LOCKER BUILDING ADDITION AND RENOVATION

900 MULBERRY ST.
ZIONSVILLE IN, 46077

ZIONSVILLE COMMUNITY SCHOOLS

ZIONSVILLE Community Schools

ARCHITECT

FANNING HOWEY

317.848.0966
350 E NEW YORK ST, SUITE #300, INDIANAPOLIS, IN 46204
WWW.FHAI.COM

PAUL A. MILLER REGISTERED ARCHITECT

CONSTRUCTION DOCUMENTS







DRAWN BY: KT / BC
PROJECT NUMBER: 223139.00
PROJECT ISSUE DATE: 01.22.2024

REV. NO. DESCRIPTION DATE

1 ADDENDUM #1 02.14.2024

ENLARGED TOILET ROOM PLANS

A1.02

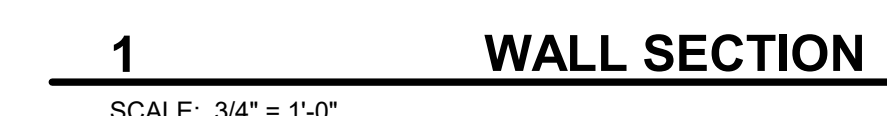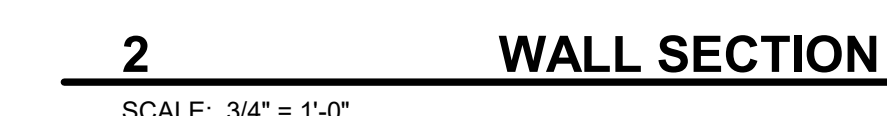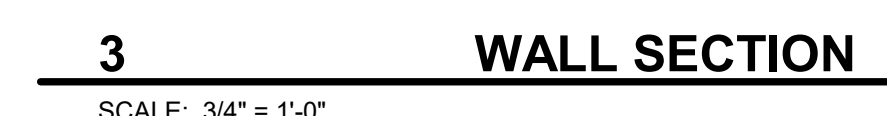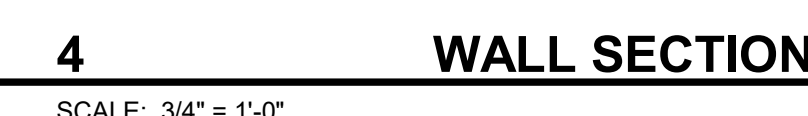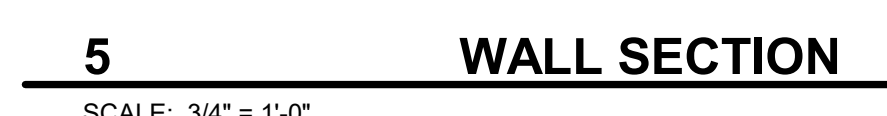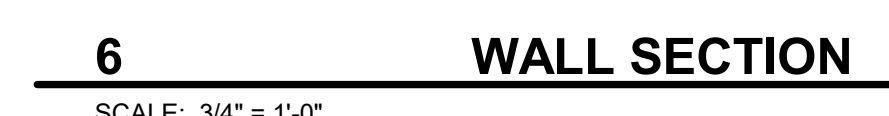


- 900 MULBERRY ST.
ZIONSVILLE IN, 46077



**FANNING
HOWEY**

317.848.0966 **WWW.FHALC.COM**

350 E NEW YORK ST, SUITE #300, INDIANAPOLIS, IN 46204

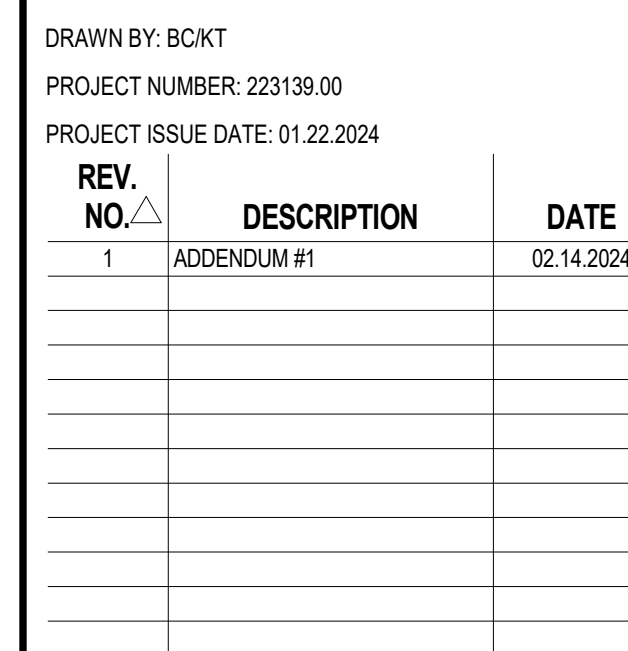

WALL SECTIONS

A5.01

DOOR AND FRAME SCHEDULE																
DOOR NUMBER	DOORS		FRAME MATERIAL	FRAME ELEVATION	FRAME			DETAILS			FIRE RATING IN MINS.	HARDWARE		STC RATING	REMARKS	DOOR NUMBER
	DOOR SIZE (WxH)	DOOR TYPE			JAMB DEPTH	HEAD	JAMB	SILL	SET NO.	KEYSIDE ROOM						
A101A	3'-0" x 7'-2"	F HM	HM	HM1	8 3/4"	3-A6.01	14-A6.01	-			21.0	A102		2.3		A101A
A102A	4'-0" x 7'-2"	FG2 HM	HM	HM1	8 3/4"	3-A6.01	14-A6.01	-			12.0	A105		2.3		A102A
A102B	4'-0" x 7'-2"	F FRP	AL	A1	4 1/2"	10-A6.01	2-A6.02	-	-		5.0	EXT		2.1, 2.2		A102B
A102C	3'-0" x 7'-2"	F HM	HM	HM3	8 3/4"	2-A6.01	13-A6.01	-			17.0	A102				A102C
A102D	10'-0" x 8'-0"	OHCD	STL	-	2"	6-A6.01	18-A6.01	-			24.0	A119		2.9		A102D
A102E	10'-0" x 8'-0"	OHCD	STL	-	2"	6-A6.01	18-A6.01	-			24.0	A119		2.9		A102E
A103A	3'-0" x 7'-2"	F HM	HM	HM3	8 3/4"	1-A6.01	12/13-A6.01	-			18.0	A102				A103A
A103B	3'-0" x 7'-2"	F HM	HM	HM3	11 7/8"	4-A6.01	15-A6.01	-			18.0	B102				A103B
A104A	3'-0" x 7'-2"	F HM	HM	HM3	8 3/4"	1-A6.01	12/13-A6.01	-			18.0	A102				A104A
A104B	3'-0" x 7'-2"	F HM	HM	HM3	11 7/8"	4-A6.01	15-A6.01	-			18.0	B102				A104B
A105A	4'-0" x 7'-2"	F FRP	AL	A1	4 1/2"	11-A6.01	2-A6.02	-	-		3.0	EXT	-	2.1, 2.2, 2.3, 2.4		A105A
A106A	4'-0" x 7'-2"	FG2 HM	HM	HM1	8 3/4"	3-A6.01	14-A6.01	-			12.0	A105		2.3		A106A
A106B	4'-0" x 7'-2"	FG2 HM	HM	HM1	8 3/4"	3-A6.01	14-A6.01	-			12.0	A116		2.3		A106B
A106C	4'-0" x 7'-2"	F FRP	AL	A1	4 1/2"	11-A6.01	2-A6.02	-	-		5.0	EXT		2.1, 2.2, 2.3		A106C
A109A	PR 3'-0" x 7'-2"	F FRP	AL	A2	4 1/2"	11-A6.01	2-A6.02	-			4.0	EXT		2.1, 2.2, 2.3, 2.7		A109A
A110A	PR 3'-0" x 7'-2"	F FRP	AL	A2	4 1/2"	11-A6.01	2-A6.02	-			4.0	EXT		2.1, 2.2, 2.3, 2.7		A110A
A112A	3'-0" x 7'-2"	F FRP	AL	A1	4 1/2"	11-A6.01	2-A6.02	-	-		7.0	EXT		2.1, 2.2, 2.3		A112A
A116A	4'-0" x 7'-2"	F FRP	AL	A1	4 1/2"	11-A6.01	2-A6.02	-	-		3.0	EXT	-	2.1, 2.2, 2.3, 2.4		A116A
A117A	3'-0" x 7'-2"	FGAL2	AL	A4	4 1/2"	5-A6.01	16/17-A6.01	-			10.0	A106				A117A
A117B	3'-0" x 7'-2"	FGAL2	AL	A5	4 1/2"	5-A6.01	16/17-A6.01	-			10.0	A106				A117B
A117C			HM	HM4	8 3/4"	1-A6.01	12-A6.01	4-A6.02			-	A117				A117C
A118A	3'-0" x 7'-2"	F HM	HM	HM1	8 3/4"	1-A6.01	12-A6.01	-			19.0	A117				A118A
A119A	4'-0" x 7'-2"	FG2 HM	HM	HM1	8 3/4"	3-A6.01	14-A6.01	-			12.0	A116		2.3		A119A
A119B	4'-0" x 7'-2"	F FRP	AL	A1	4 1/2"	10-A6.01	2-A6.02	-	-		5.0	EXT		2.1, 2.2		A119B
A120A	PR 3'-0" x 7'-2"	N HM	HM	HM2	10 1/4"	1-A6.01	12-A6.01	-			11.0	B102				A120A
A121A	3'-0" x 7'-2"	F HM	HM	HM3	8 3/4"	1/2-A6.01	12/13-A6.01	-			18.0	A119				A121A
A121B	3'-0" x 7'-2"	F HM	HM	HM3	11 7/8"	4-A6.01	15-A6.01	-			18.0	B101				A121B
A122A	3'-0" x 7'-2"	F HM	HM	HM3	8 3/4"	1-A6.01	12-A6.01	-			18.0	A119				A122A
A122B	3'-0" x 7'-2"	F HM	HM	HM3	11 7/8"	4-A6.01	15-A6.0									

2.1 Provide door undercut as required for door bottom sweep, by door supplier, with ADA compliant threshold as scheduled.

2.2 Threshold to run from masonry to masonry, notch around frame.

2.3 New door, frame, and hardware in existing wall opening. Field verify existing opening size prior to fabricating new door and frame.

2.4 Door with security access system and electronic door hardware. See Division 08 Section "Door Hardware" and electrical drawings. Division 08, Division 26, Division 28, and security access contractor to coordinate for location and installation of conduit/wiring required for electrified hardware items mounted to doors and frames, including, but not limited to, cutting/drilling any access holes required for pulling wires through frame head/jamb/s to the electrified hardware items.

2.5 Hardware removable mullion by Division 08 Section "Door Hardware".

2.6 Automatic Door Operator, see Division 08 Section "Door Hardware", Division 26 to provide keyed disconnect switch for automatic door operator.

2.7 Overlapping "Z" astragal by door supplier, factory prepared for hardware as specified. Astragal to be on key side of door.

2.8 See Division 08 Section "Coiling Counter Doors".

2.9 See Division 08 Section "Overhead Coiling Doors".

2.10 Doors shall have a 1" undercut. Coordinate with Division 08 "Door Hardware".



SCALE: 1/4" = 1'-0"

FIELD VERIFY DIMENSIONS SHOWN
PRIOR TO FABRICATION / INSTALLATION



SCALE: 1/4" = 1'-0"

**ZIONSVILLE
COMMUNITY HIGH
SCHOOL STADIUM
LOCKER BUILDING
ADDITION AND
RENOVATION**

900 MULBERRY ST.
ZIONSVILLE IN, 46077

**ZIONSVILLE COMMUNITY
SCHOOLS**



ZIONSVILLE
COMMUNITY SCHOOLS

ARCHITECT

**FANNING
HOWEY**

317.848.0966

WWW.FHAI.COM

350 E NEW YORK ST, SUITE #300, INDIANAPOLIS, IN 46204

DRAWN BY: KT / BA




PROJECT NUMBER: 223139.00

PROJECT ISSUE DATE: 01.22.202


[illegible]

**DOOR AND FRAME SCHEDULE,
DOOR TYPES & FRAME ELEVATIONS**


A6S.01

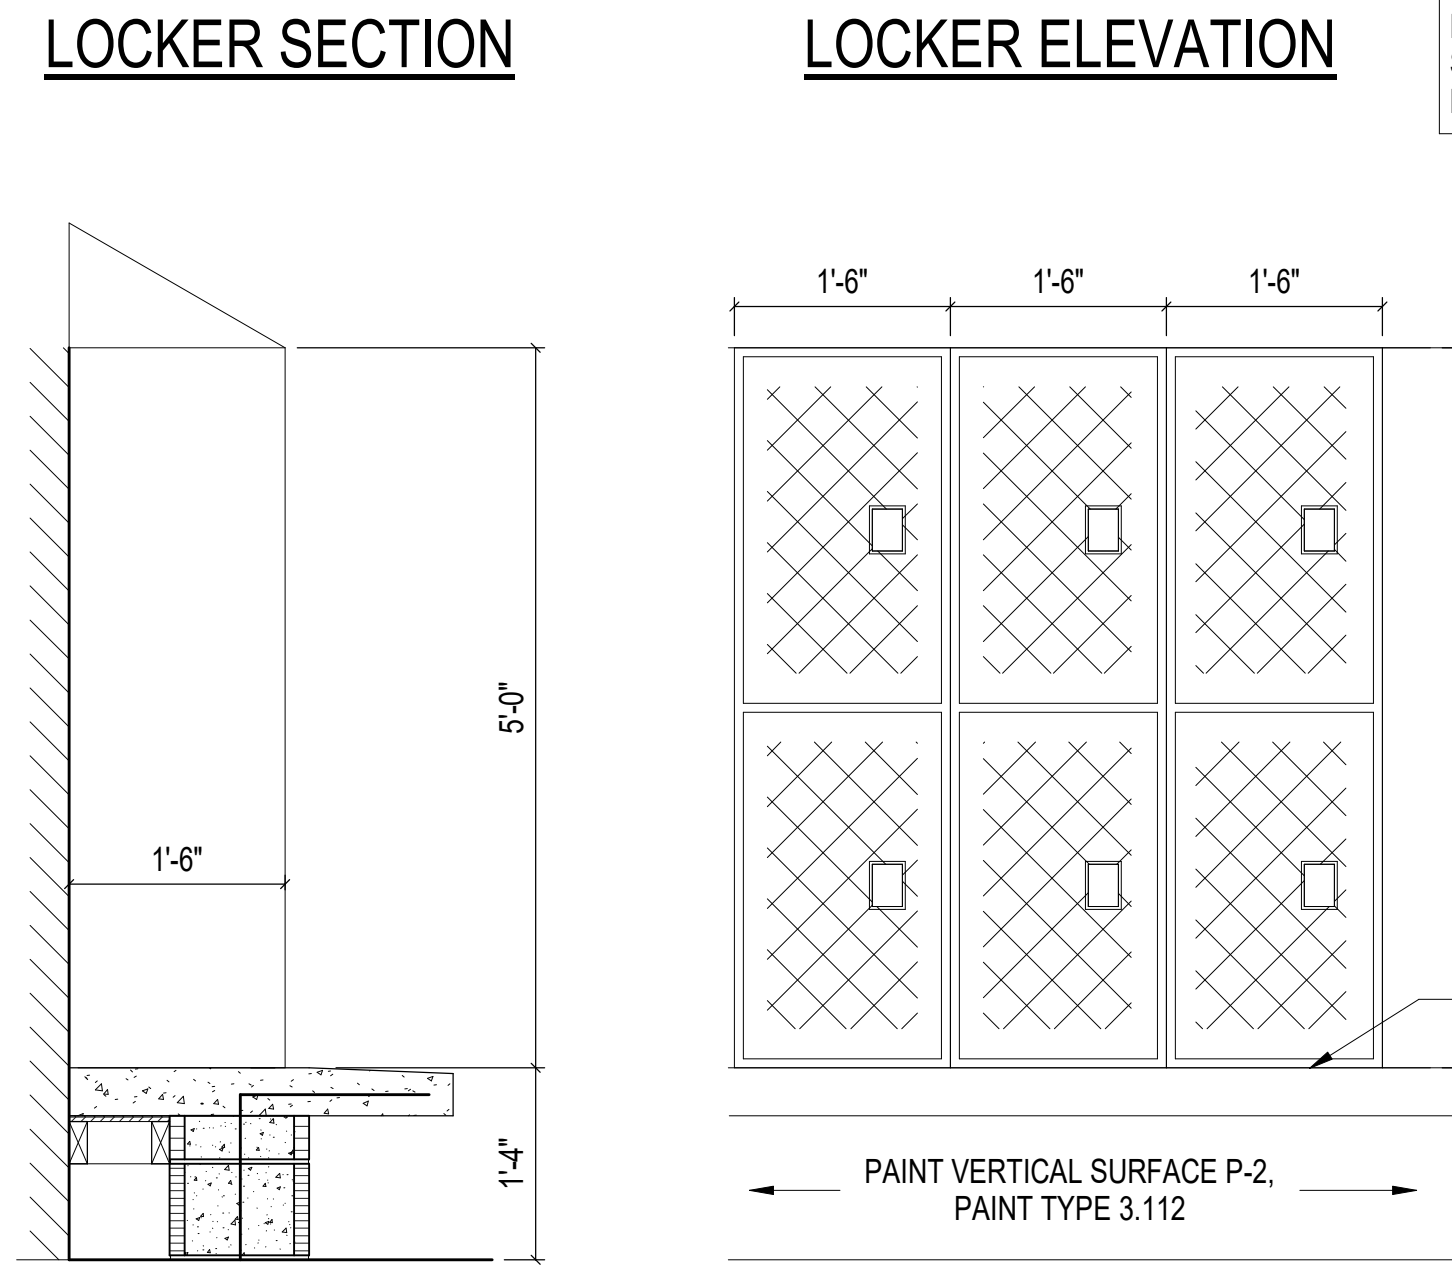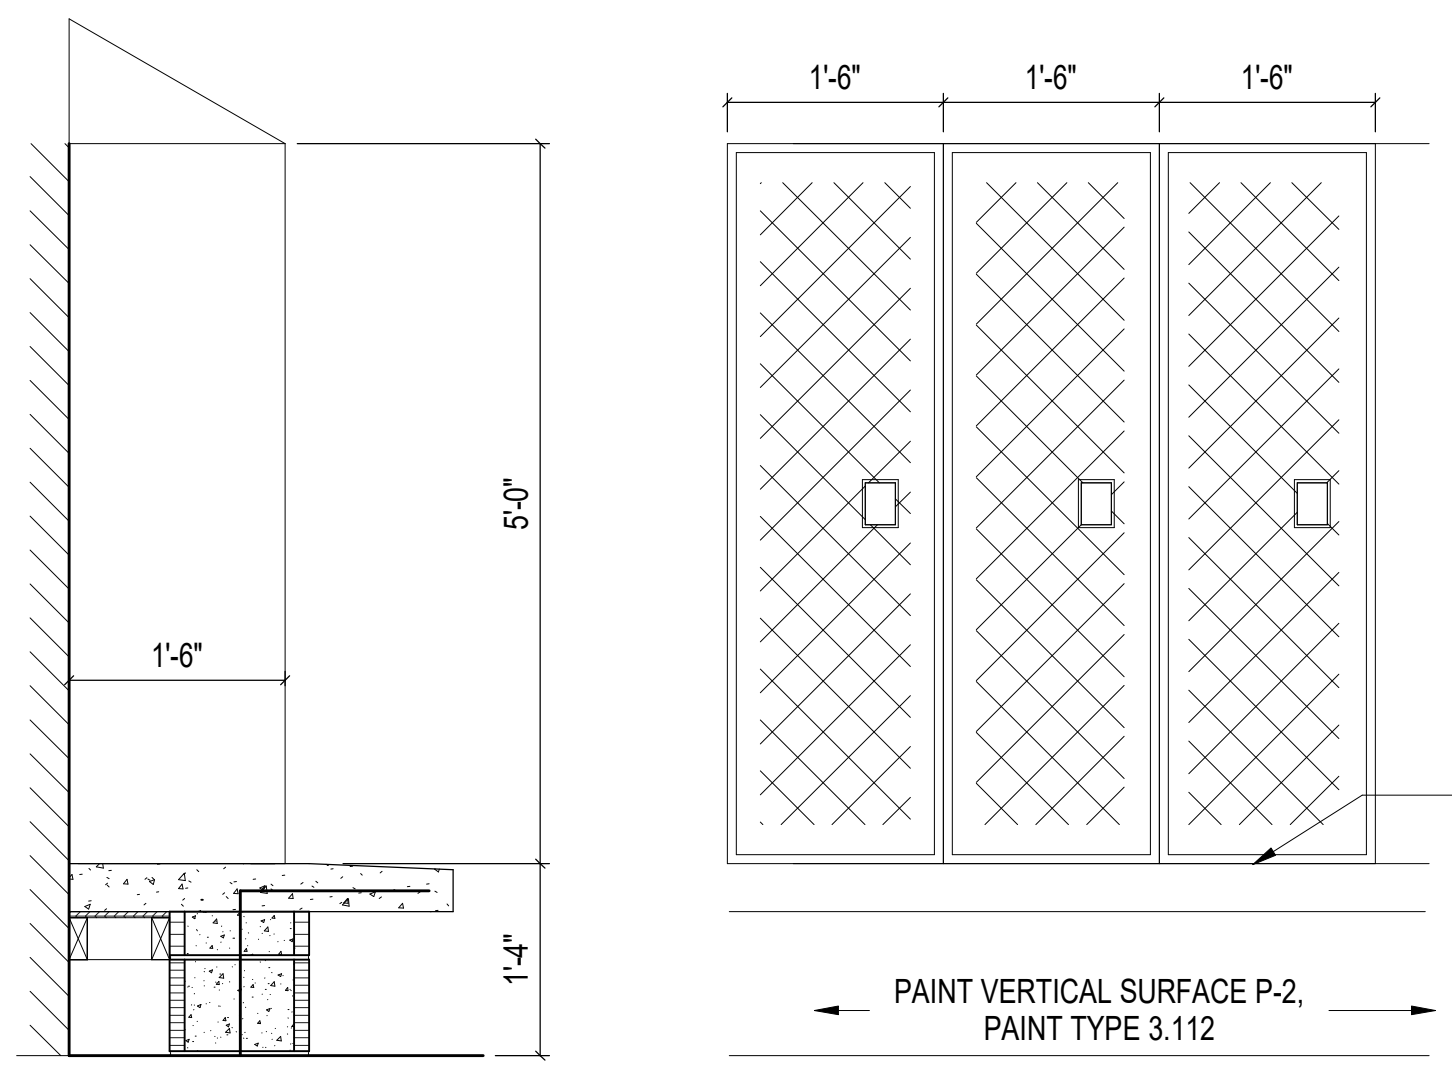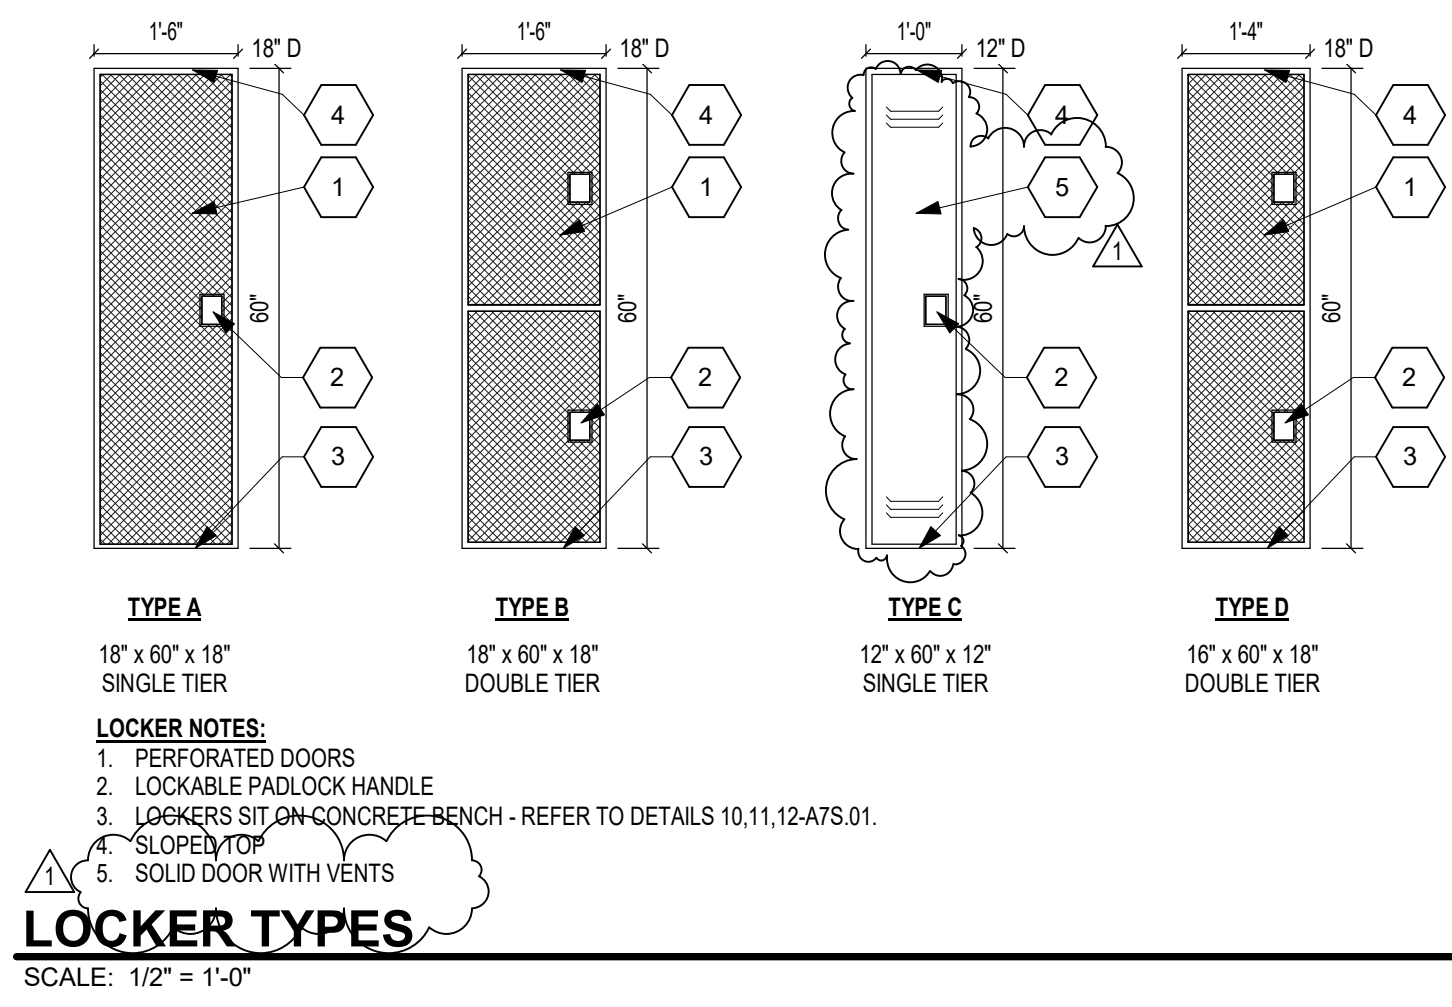


10 LOCKER SECTION AND ELEVATION

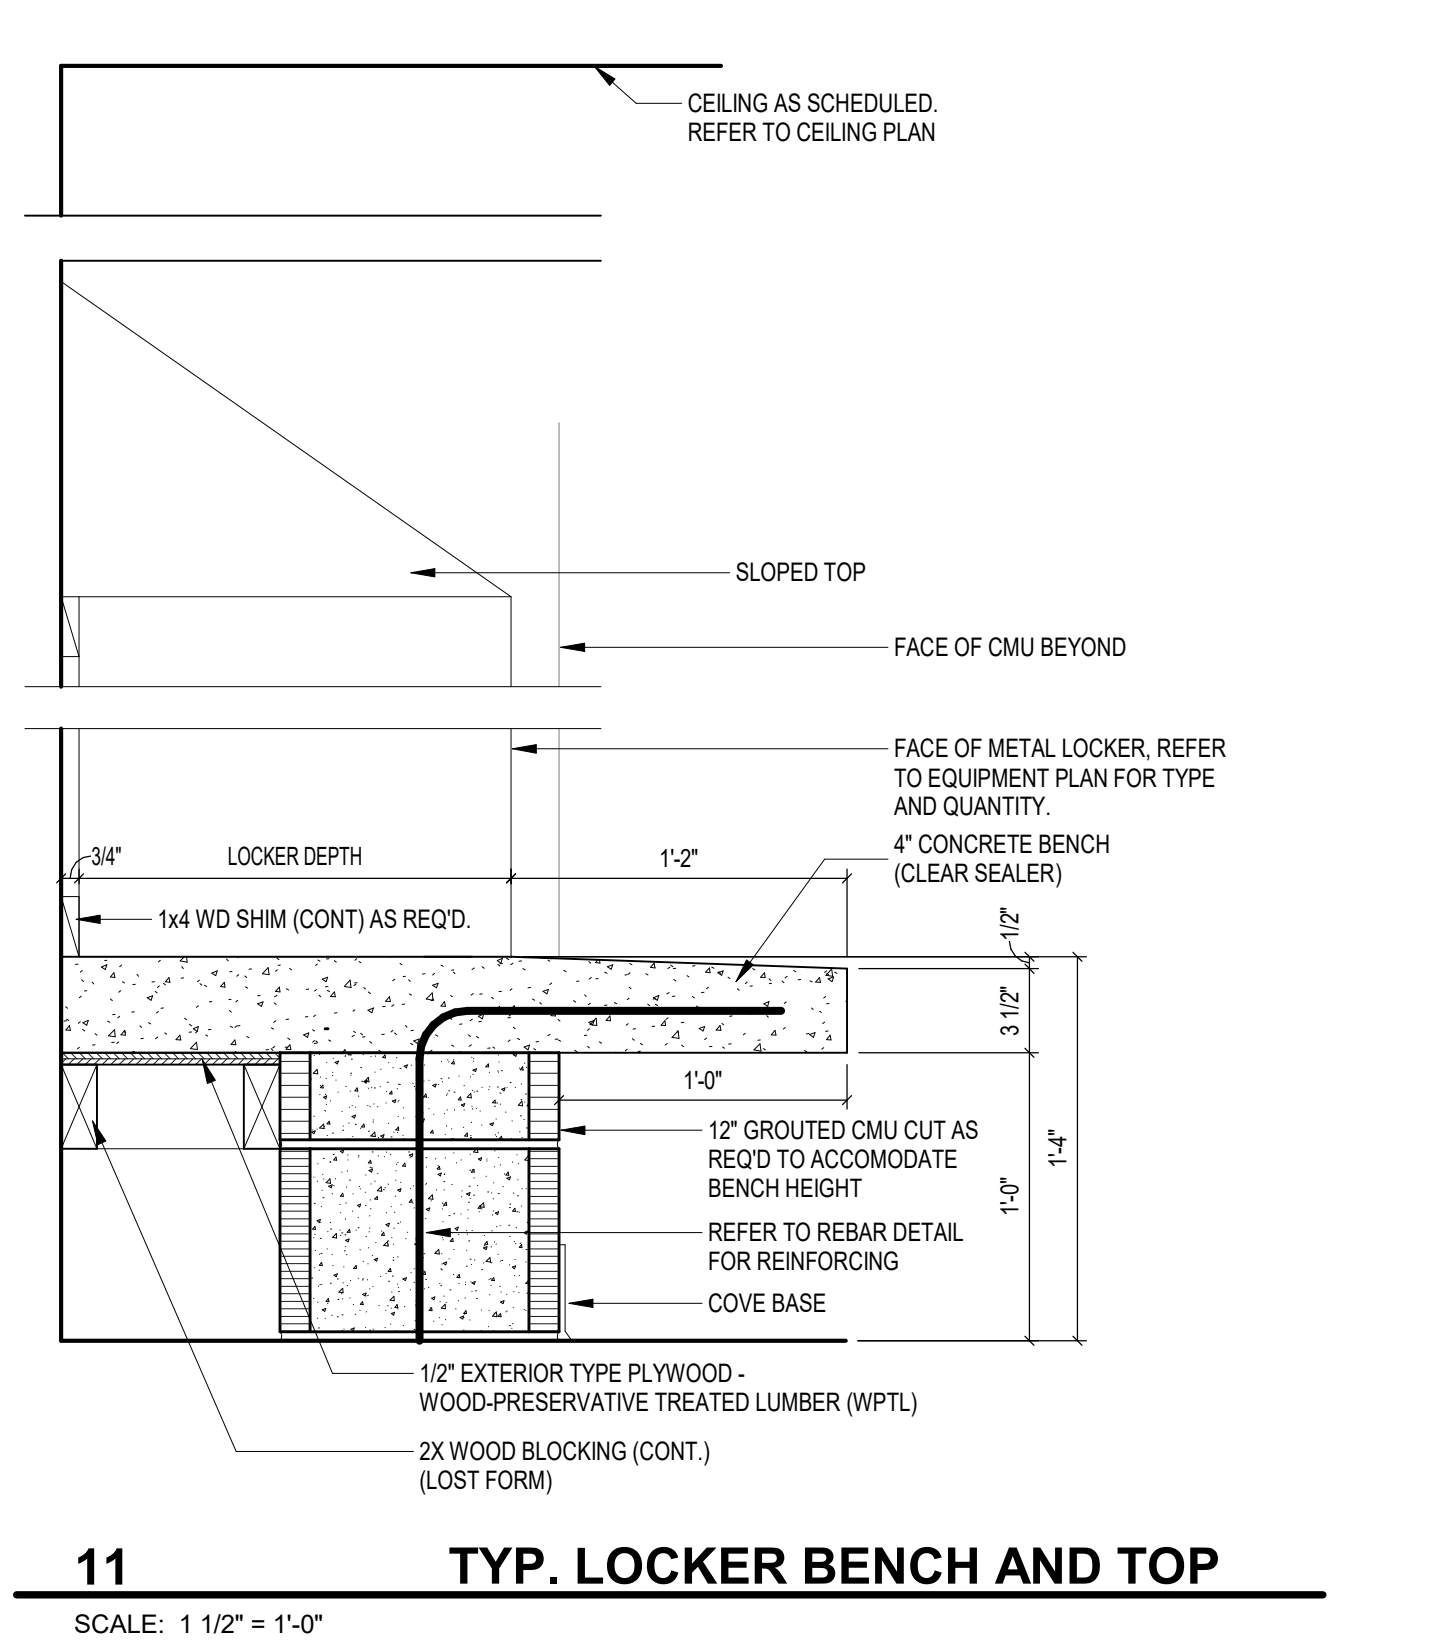


11 TYP. LOCKER BENCH AND TOP

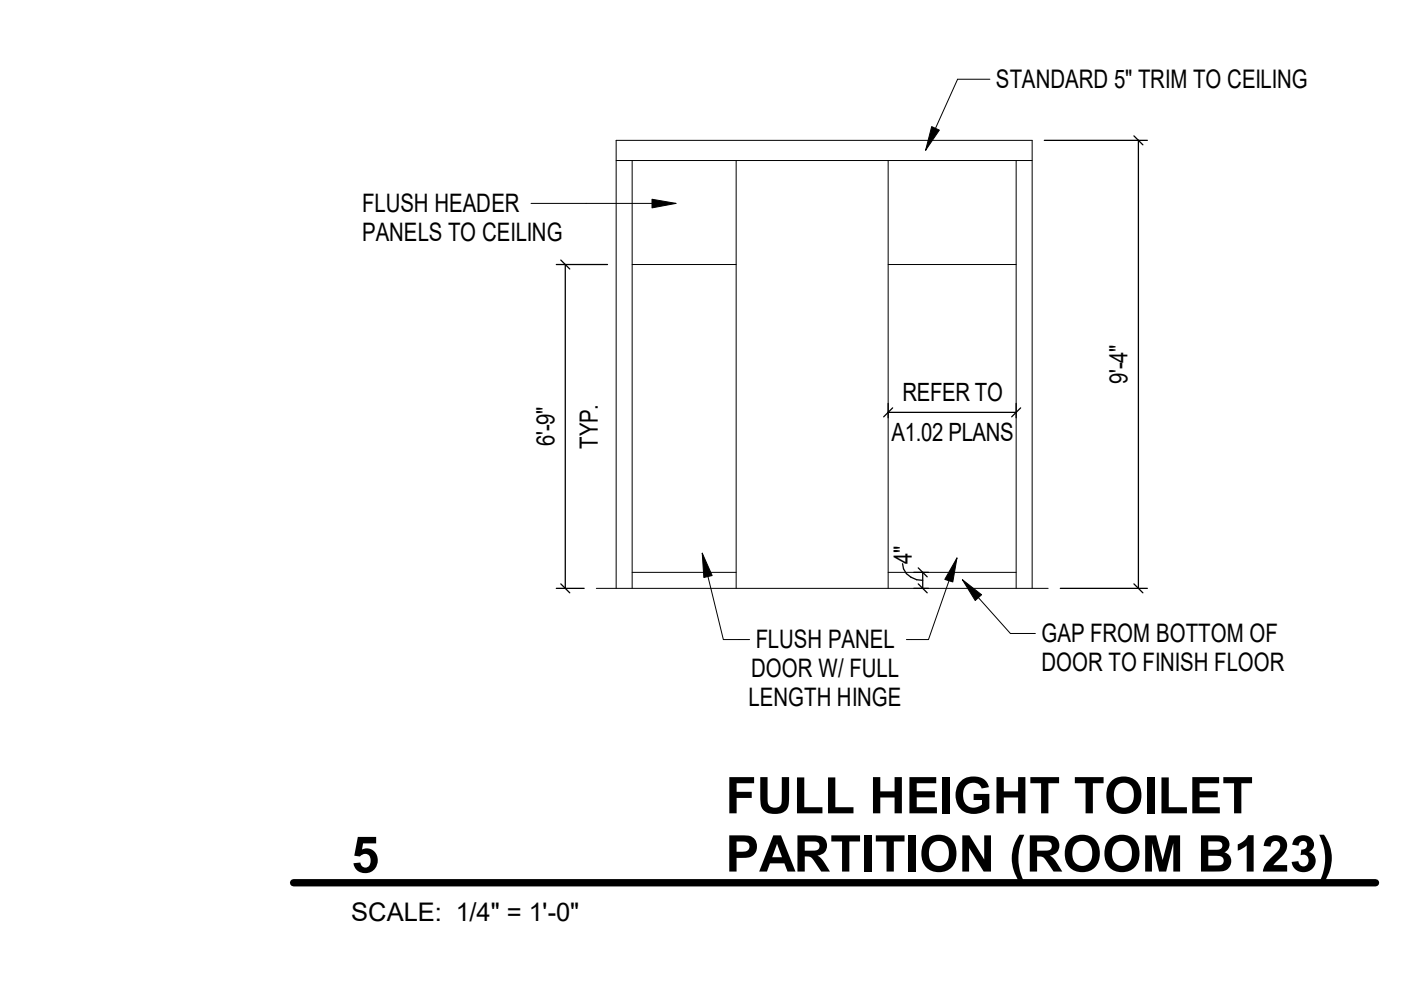


5 FULL HEIGHT TOILET PARTITION (ROOM B123)

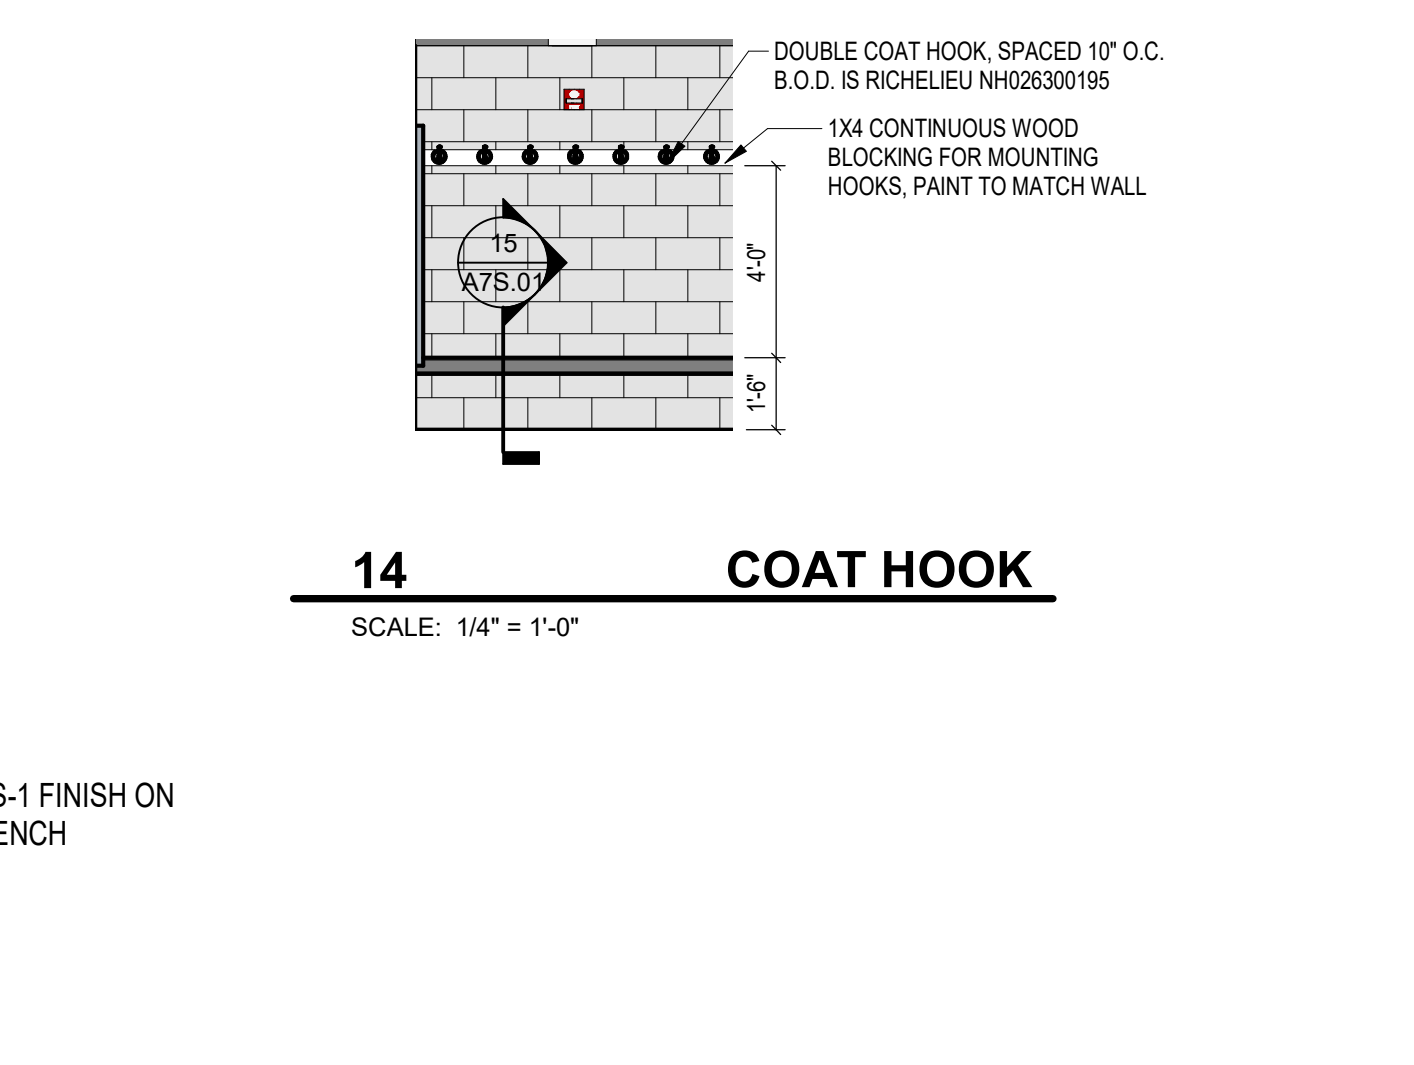

14 COAT HOOK

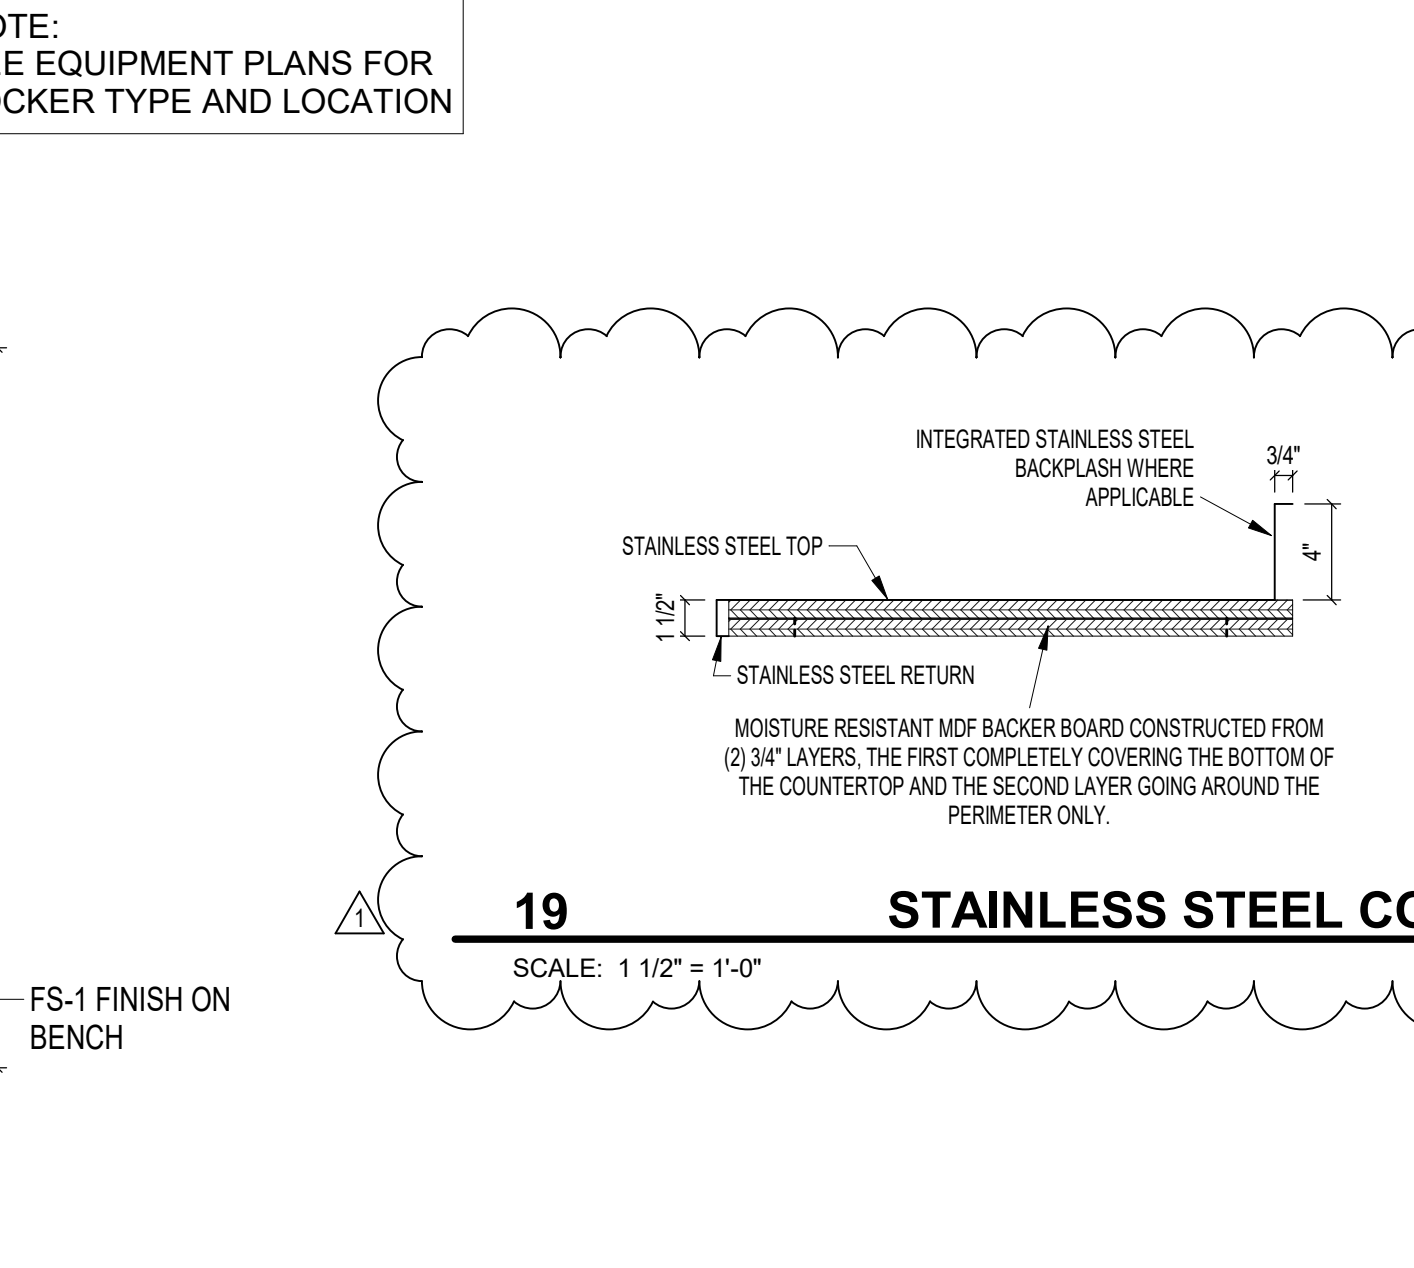

19 STAINLESS STEEL COUNTER

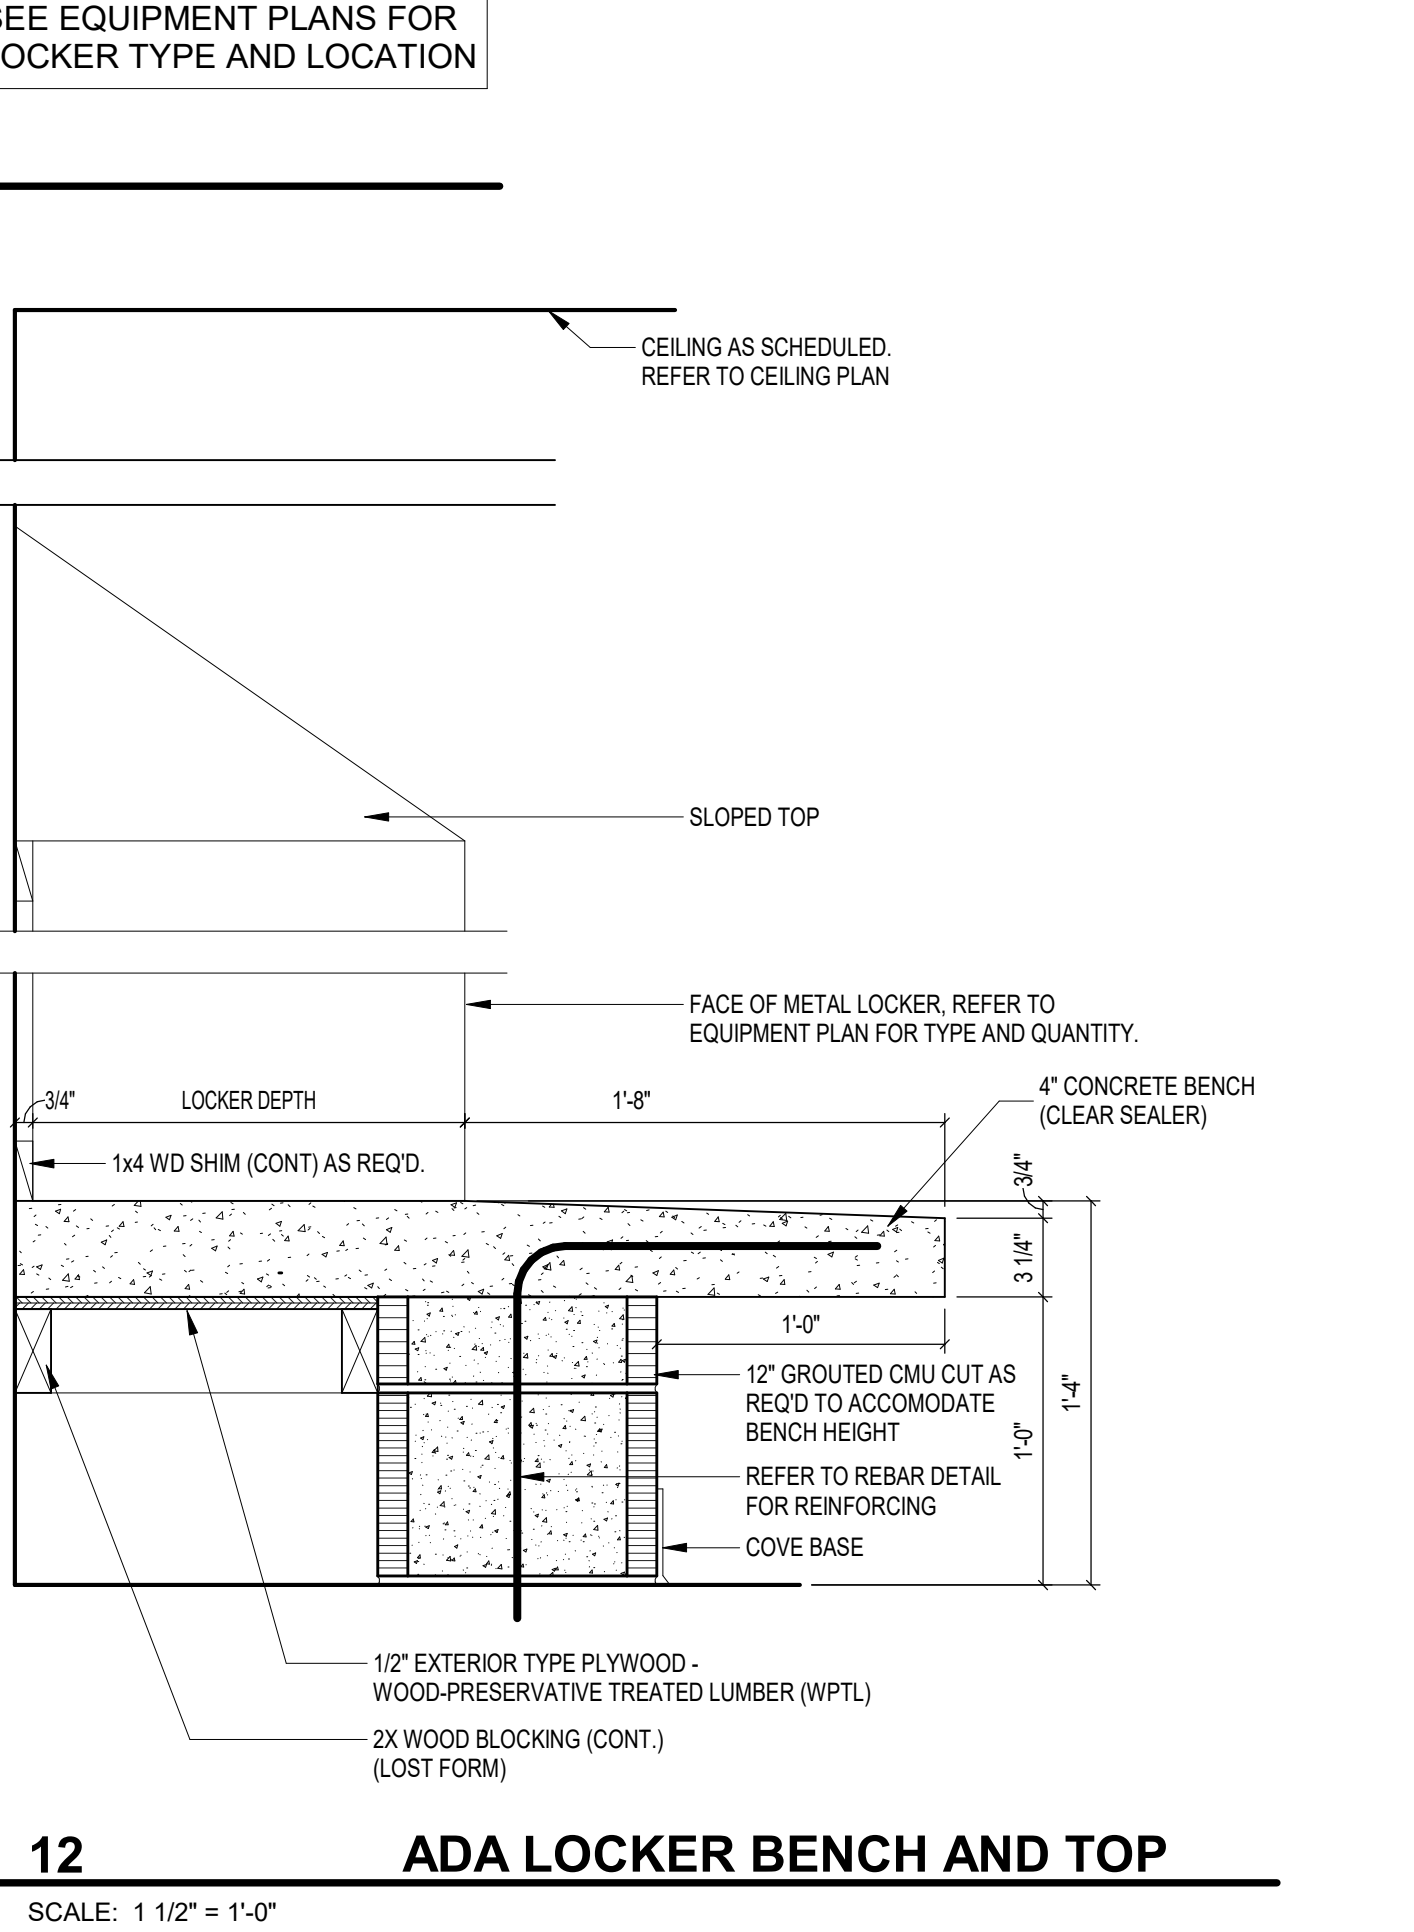


12 ADA LOCKER BENCH AND TOP


EDUCATIONAL CASEWORK SCHEDULE					
TYPE	NO.	SIZE	DESCRIPTION		
		W	D	H	
B	1	1'-6"	2'-0"	2'-10"	BASE UNIT WITH TWO ADJUSTABLE SHELVES AND ONE HINGED DOOR.
B	2	2'-6"	2'-0"	2'-10"	BASE UNIT WITH TWO ADJUSTABLE SHELVES AND TWO HINGED DOORS.
B	3	2'-6"	2'-0"	2'-10"	BASE UNIT WITH TWO ADJUSTABLE SHELVES AND TWO HINGED DOORS.
B	4	3'-0"	2'-0"	2'-10"	BASE UNIT WITH TWO ADJUSTABLE SHELVES AND TWO HINGED DOORS.
BO	5	2'-3"	1'-8"	2'-10"	OPEN BASE UNIT WITH ONE ADJUSTABLE SHELF.
BO	33	2'-9"	1'-1"	2'-10"	OPEN BASE UNIT WITH ONE ADJUSTABLE SHELF.
BS	6	3'-0"	2'-0"	2'-0"	ADULT ADA SINK BASE UNIT WITH A REMOVABLE ACCESS PANEL.
BS	7	3'-3"	2'-0"	2'-10"	ADA SINK BASE UNIT WITH TWO POCKET DOORS AND ONE BLANK DRAWER PANEL.
D	8	1'-6"	2'-0"	2'-10"	DRAWER UNIT WITH FOUR EQUAL DRAWERS, 4-1/2 INCHES DEEP INSIDE.
D	9	1'-9"	2'-0"	2'-10"	DRAWER UNIT WITH FOUR EQUAL DRAWERS, 4-1/2 INCHES DEEP INSIDE.
D	10	1'-9"	2'-0"	3'-0"	DRAWER UNIT WITH FOUR EQUAL DRAWERS, 5 INCHES DEEP INSIDE.
T	11	2'-6"	2'-0"	2'-0"	TALL UNIT WITH FIVE ADJUSTABLE SHELVES AND TWO HINGED DOORS.
TO	13	2'-0"	2'-0"	7'-0"	OPEN TALL UNIT WITH FIVE ADJUSTABLE SHELVES.
TO	14	2'-3"	2'-0"	7'-0"	OPEN TALL UNIT WITH FIVE ADJUSTABLE SHELVES.
TO	15	2'-6"	2'-0"	7'-0"	OPEN TALL UNIT WITH FIVE ADJUSTABLE SHELVES.
W	12	1'-2"	1'-2"	2'-6"	WALL UNIT WITH ONE ADJUSTABLE SHELF AND ONE HINGED DOOR.
W	13	1'-2"	1'-2"	2'-6"	WALL UNIT WITH ONE ADJUSTABLE SHELF AND ONE HINGED DOOR.
W	14	3'-0"	1'-2"	1'-3"	WALL UNIT WITH TWO HINGED DOORS.
W	15	2'-6"	1'-2"	2'-6"	WALL UNIT WITH ONE ADJUSTABLE SHELF AND TWO HINGED DOORS.
W	16	3'-0"	1'-2"	2'-6"	WALL UNIT WITH ONE ADJUSTABLE SHELF AND TWO HINGED DOORS.
WDH	17	3'-0"	2'-0"	7'-0"	TALL TEACHER WARDROBE UNIT WITH ONE FIXED SHELF, ROD, THREE ADJUSTABLE SHELVES, 10 INCH X 12 INCH MIRROR, PIN TRAY, THREE FILE DRAWERS, AND TWO HINGED DOORS. WITH GLASS INSERT AND ONE VENT IN DOOR, CABINET IS LOCKABLE.

FOOD SERVICE EQUIPMENT					
ITEM #	QTY	DESCRIPTION	MANUFACTURER	MODEL	PROVIDED BY
FS-1	2	BEVERAGE COOLERS	BY VENDOR	BY VENDOR	OWNER
FS-5	1	COFFEE BREWER	BY VENDOR	BY VENDOR	OWNER
FS-6	1	SLUSHY MACHINE	BY VENDOR	BY VENDOR	OWNER
FS-7	1	CAPPUCINO MACHINE	BY VENDOR	BY VENDOR	OWNER
FS-8	1	ICE CREAM MERCHANDISER	BY VENDOR	BY VENDOR	OWNER
FS-12	1	HOT DOG GRILL	STAR	30C	OWNER
FS-13	1	POPCORN POPPER	GOLD MEDAL PRODUCTS	2389	OWNER
FS-17	2	COUNTERTOP DISPLAY CASE	HATCO	FDWD-1X	OWNER
FS-18	2	NACHO CHEESE DISPLAY	GOLD MEDAL PRODUCTS	5300	OWNER
FS-19	2	HOT DOG BUN	APW WYOTT MODEL	BW-20	OWNER
FS-20	1	COUNTERTOP DISPLAY CASE	HATCO	FDWD-1X	OWNER
FS-32		WIRE SHELVING	METRO	2449NK3	OWNER


RESIDENTIAL APPLIANCE SCHEDULE					
ITEM NO.	ITEM DESCRIPTION		ELEC. FIELD CONNECTION	MECH. FIELD CONNECTION	PLUMB. FIELD CONNECTION
(A-1)	REFRIGERATOR WITHOUT ICE MAKER • 26.8 CU FT. • FRENCH DOOR • NO DISPENSER • ENERGY STAR QUALIFIED • 70 1/4" x 36 1/2" x 35 1 1/8" D • COLOR: FINGERPRINT-RESISTANT STAINLESS STEEL • BASIS OF DESIGN FRIGIDAIRE FRN2823AS		115V, 60Hz, 15AMPS		
(A-2)	ICE MACHINE • 340 LBS/DAY • 80 LB STORAGE • NUGGET ICE • 24"W x 39"H x 28 5/8"D • COLOR: STAINLESS STEEL • BASIS OF DESIGN ESSENTIAL ICE UN324		115 V/60Hz/ SIGNLE PHASE/ 15 AMP		X
(A-3)	UNDERCOUNTER REFRIGERATOR • 26.8 CU FT. • FRENCH DOOR • NO DISPENSER • ENERGY STAR QUALIFIED • 70 1/4" x 36 1/2" x 35 1 1/8" D • COLOR: FINGERPRINT-RESISTANT STAINLESS STEEL • BASIS OF DESIGN FRIGIDAIRE FRN2823AS		115V, 60Hz, 15AMPS		X

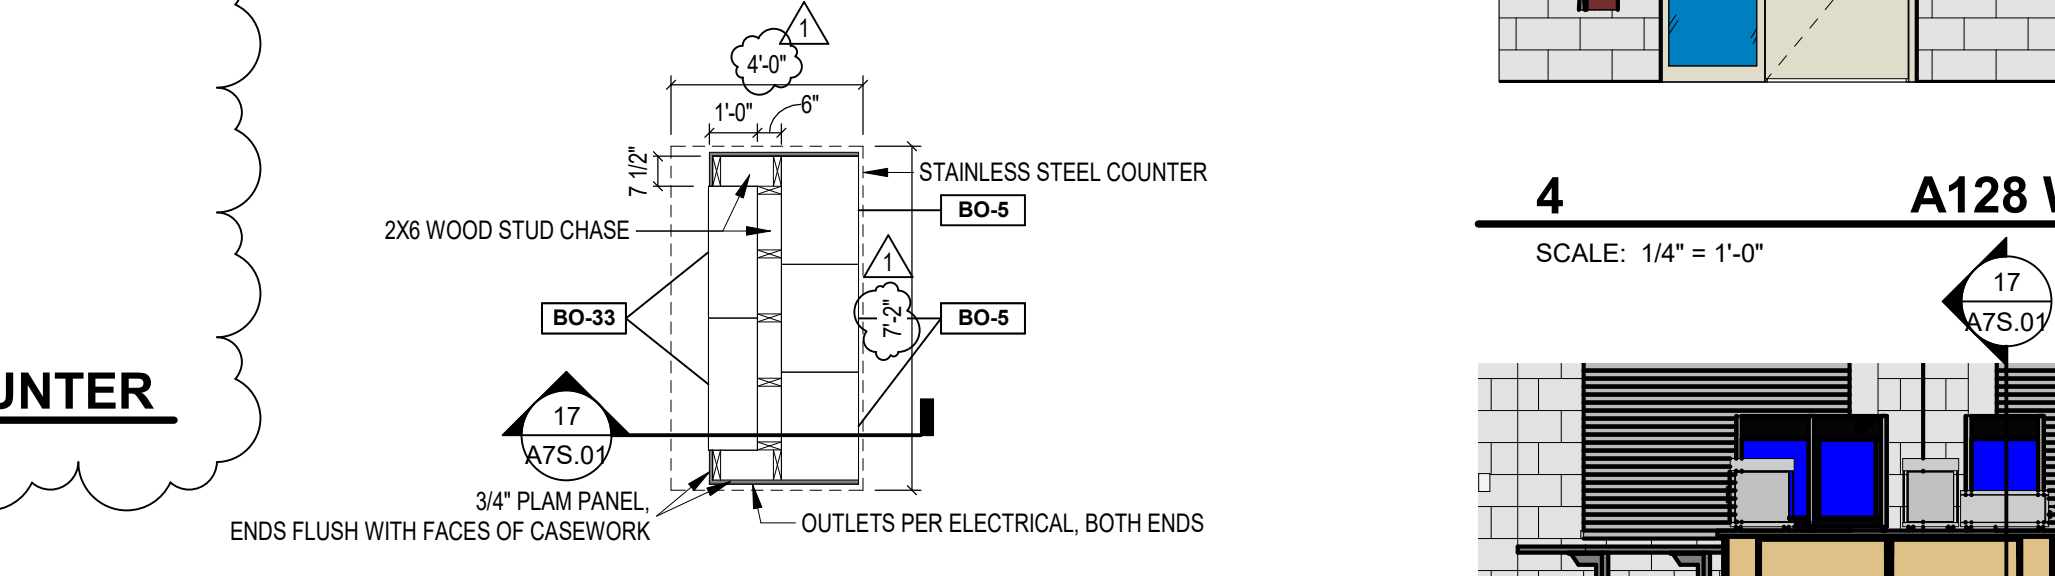


16 B125 ENLARGED ISLAND PLAN

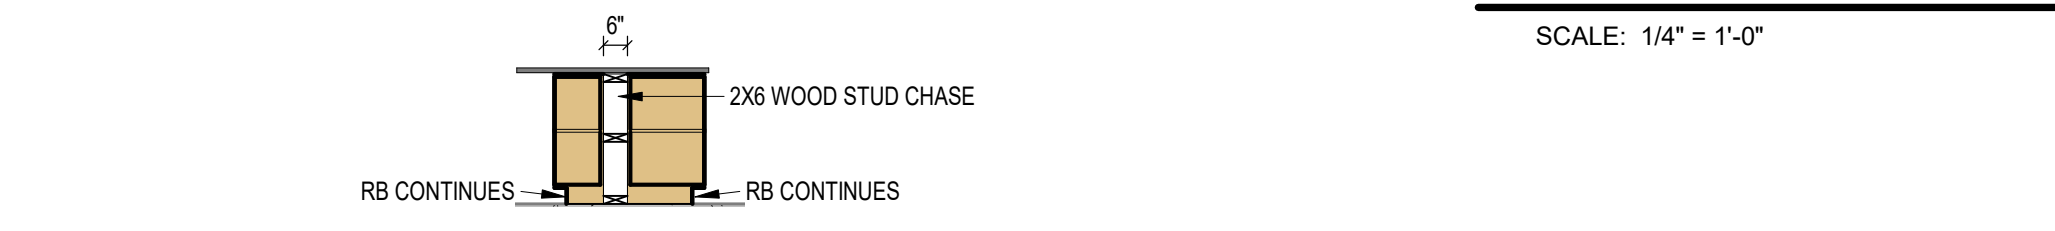


17 B125 ISLAND SECTION

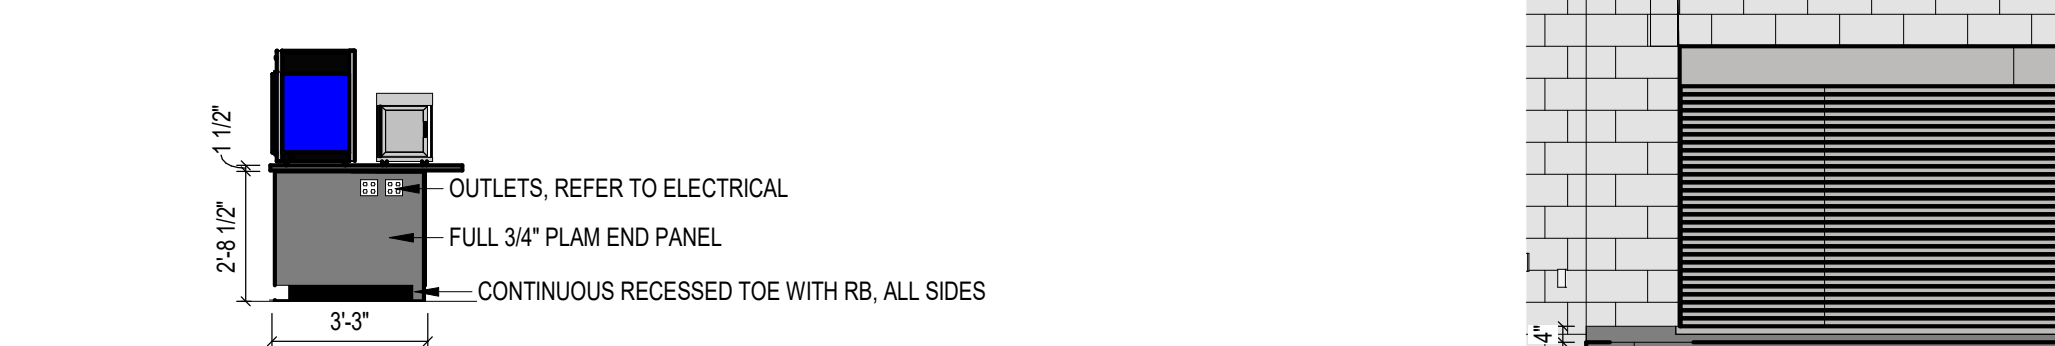


18 TYP ISLAND END

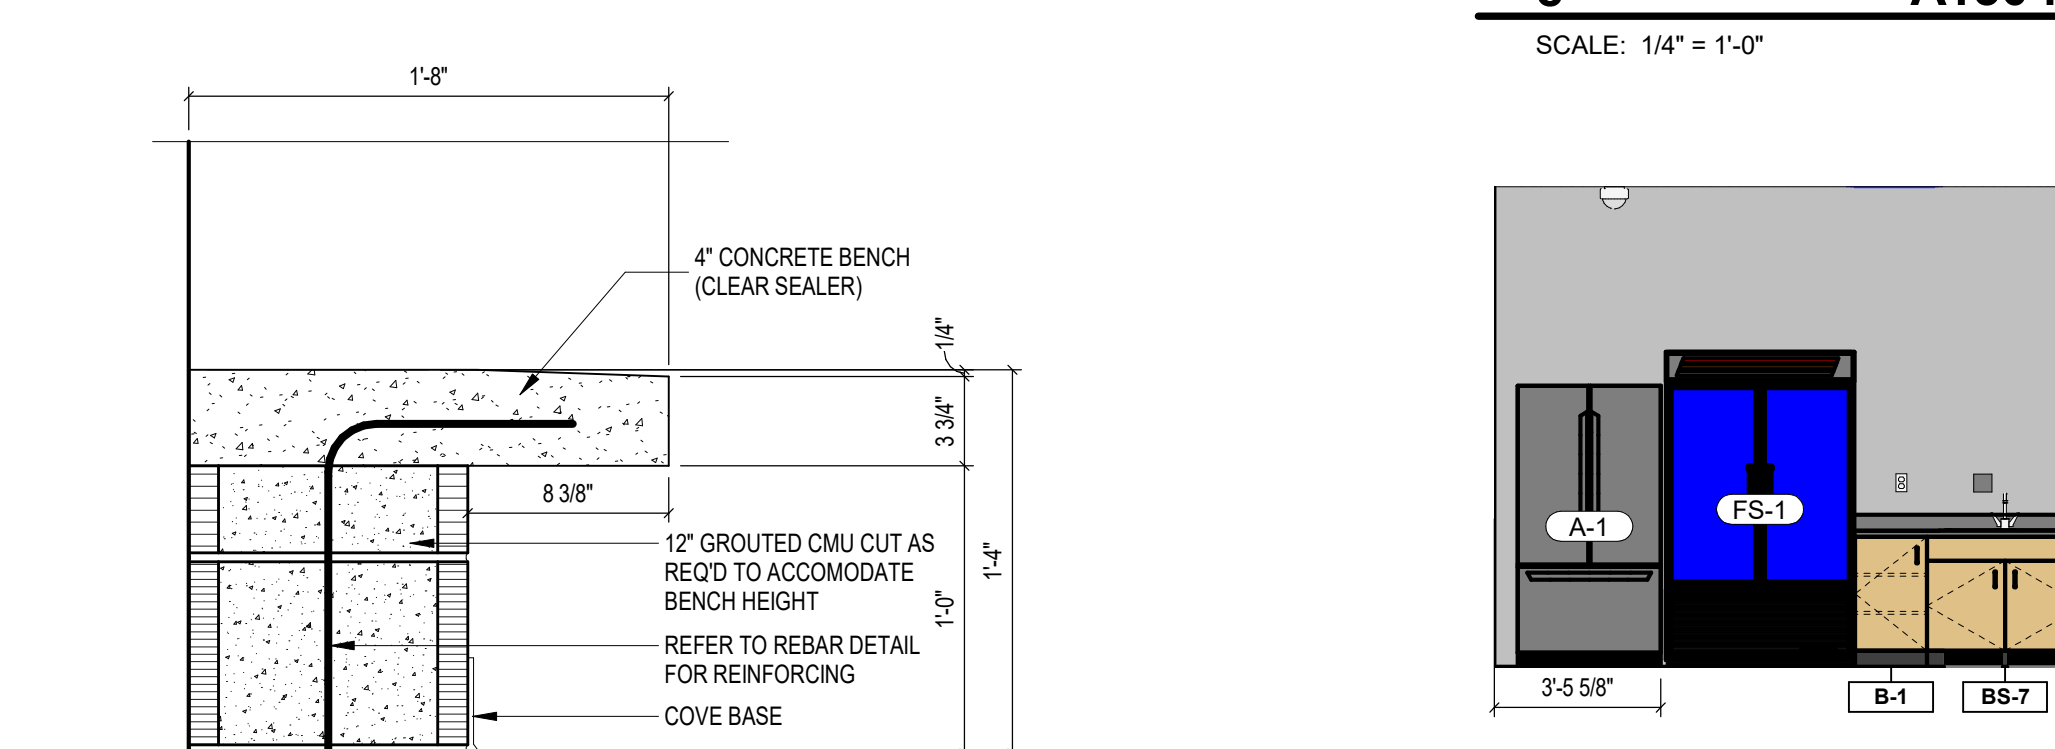


15 TYP. BENCH AND TOP

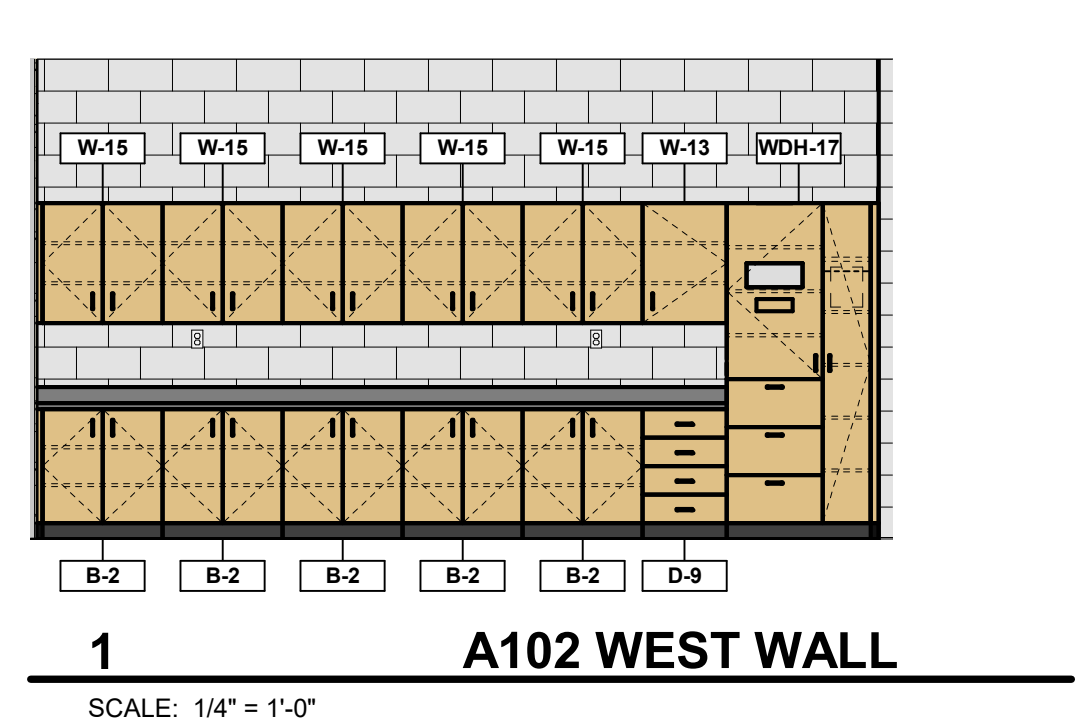


1 A102 WEST WALL

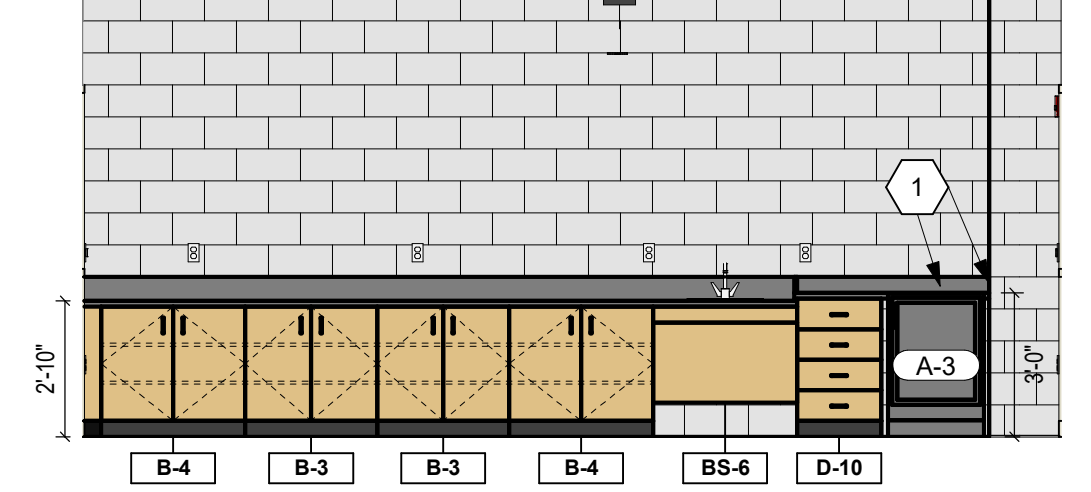


2 A103 SOUTH WALL

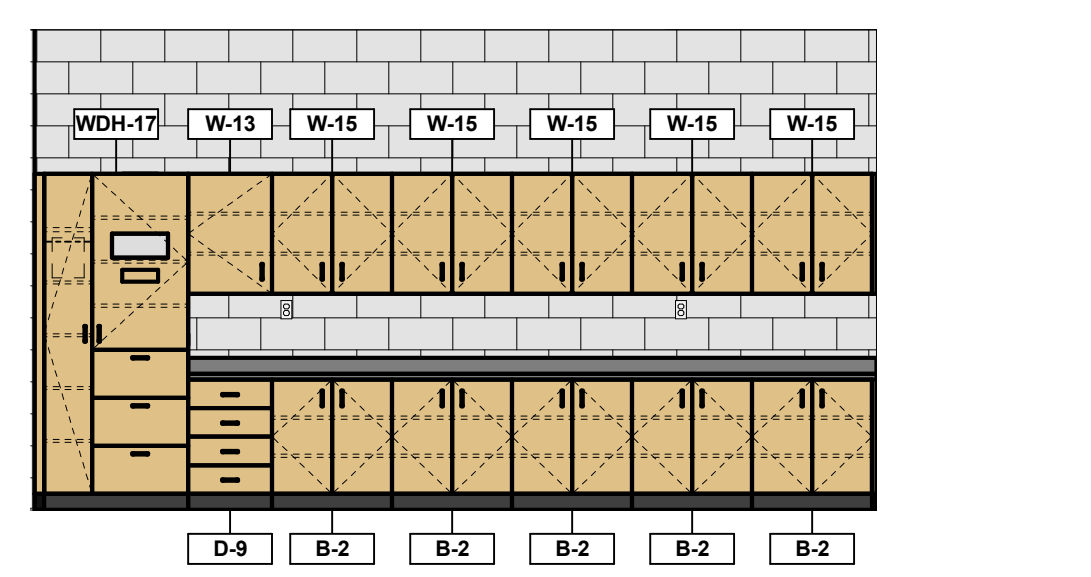


3 A119 WEST WALL

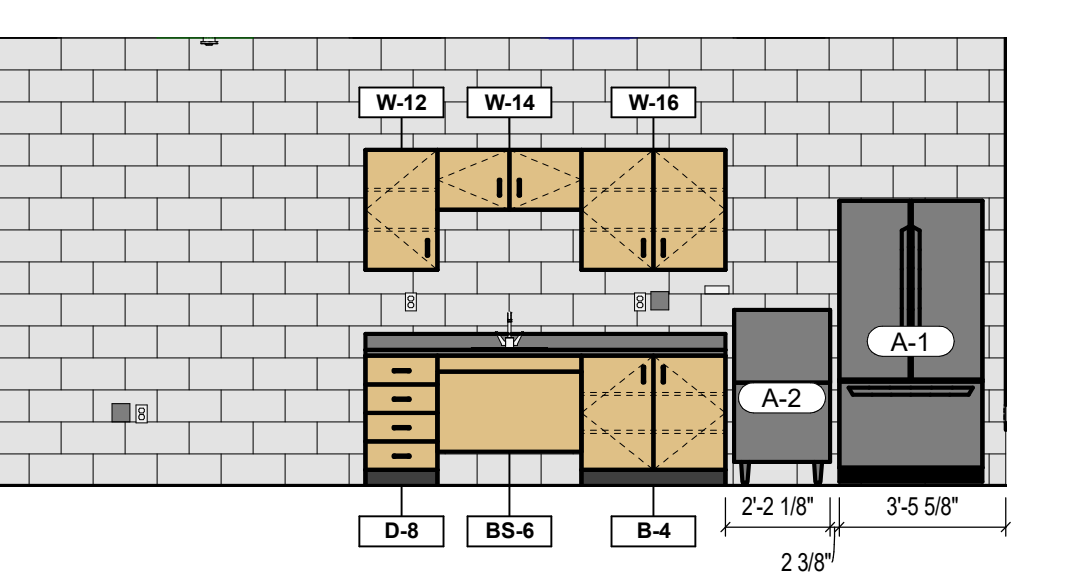

4 A128 WEST WALL

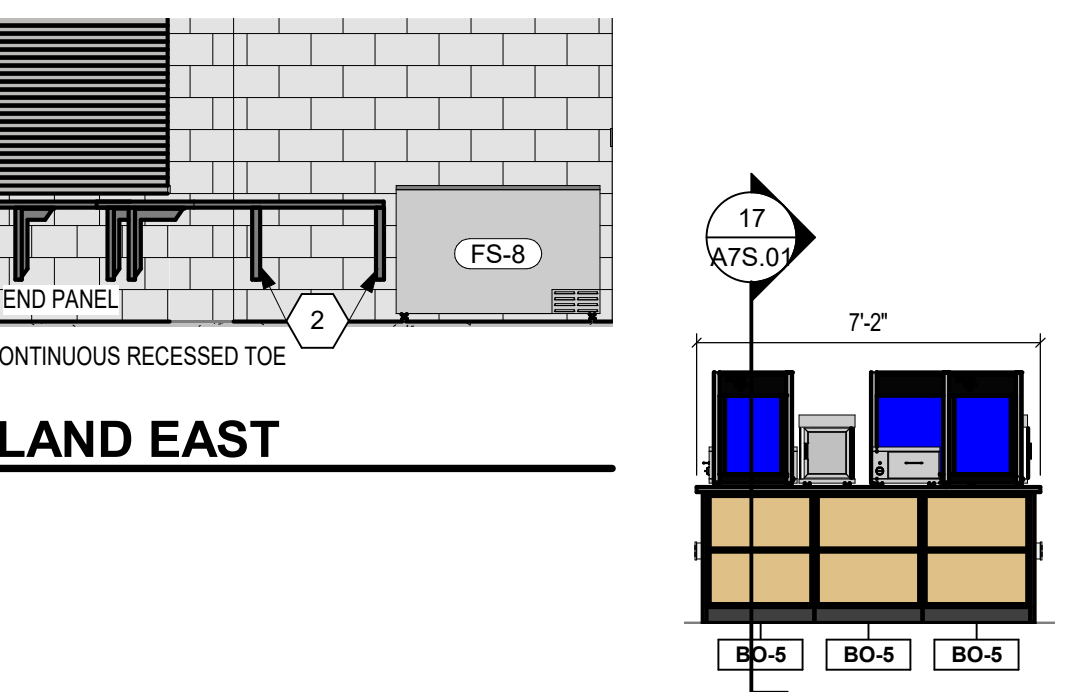


6 A150 ISLAND EAST

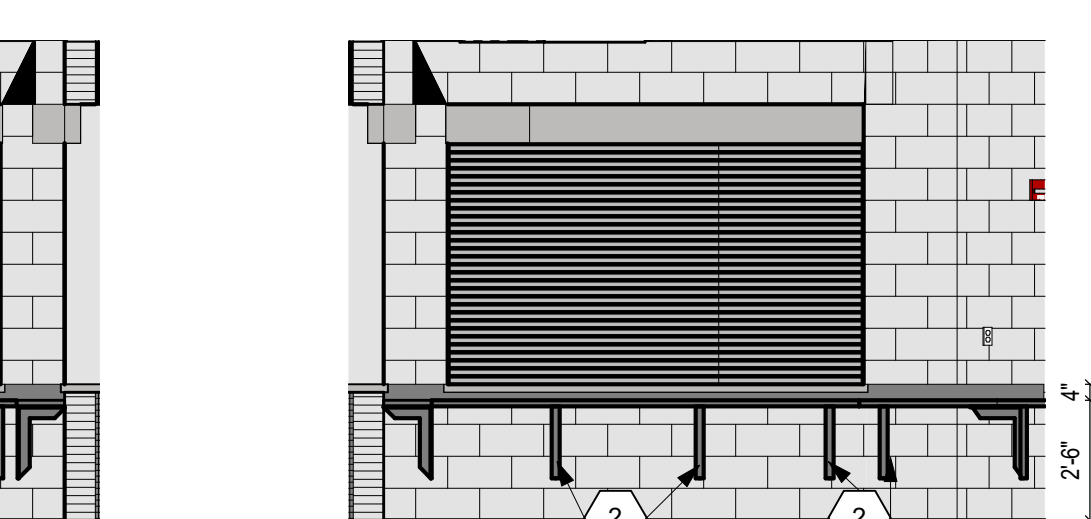

7 A150 ISLAND WEST



8 A150 NE WALL

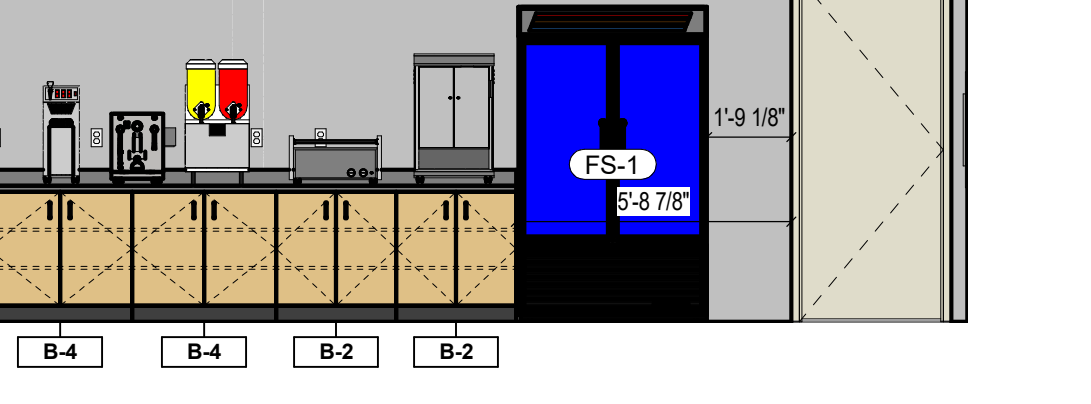

13 A150 SE WALL

INTERIOR ELEVATION NOTES
(ALL NOTES MAY NOT BE INDICATED ON THIS SHEET)
1. PROVIDE CLEAT AT BACK AND SIDE WALLS TO SUPPORT COUNTERTOP.
2. COUNTER SUPPORT BRACKETS SPACED NO FURTHER THAN 3'-0" ON CENTER. BASIS OF DESIGN RACKS SURFACE MOUNT ED COUNTER SUPPORT. SIZE CORRECTLY ACCORDING TO COUNTER DEPTH.

COPYRIGHT 2024 BY FANNINGHOWE ASSOCIATES, INC.
ZIONSVILLE COMMUNITY HIGH SCHOOL STADIUM LOCKER BUILDING ADDITION AND RENOVATION
900 MULBERRY ST.
ZIONSVILLE IN, 46077

ZIONSVILLE COMMUNITY SCHOOLS
ZIONSVILLE
Community Schools


ARCHITECT
FANNING HOWE
317.848.0966
WWW.FHAI.COM
350 E NEW YORK ST, SUITE #300, INDIANAPOLIS, IN 46204

PROJECT LOCATION
EXISTING CONCESSIONS BUILDING
KEY PLAN

CONSTRUCTION DOCUMENTS
PAUL A. MILLER
REGISTERED ARCHITECT
No. AR10800161
STATE OF INDIANA


DRAWN BY: MKH PROJECT NUMBER: 223139.00 PROJECT ISSUE DATE: 01.22.2024		
REV. NO.	DESCRIPTION	DATE
1	ADDENDUM #1	02.14.2024

VERIFICATION NOTE
CONTRACTOR SHALL VERIFY ALL DIMENSIONS AND CLEARANCES AND ALL EXISTING FIELD CONDITIONS BEFORE STARTING CONSTRUCTION. COMMENCEMENT OF WORK CONSTITUTES ACCEPTANCE OF CONDITIONS.
SHOULD DIFFERENT CONDITIONS BE ENCOUNTERED, CONTACT THE ARCHITECT BEFORE PROCEEDING WITH WORK.
EDUCATIONAL CASEWORK SCHEDULES
A7S.01

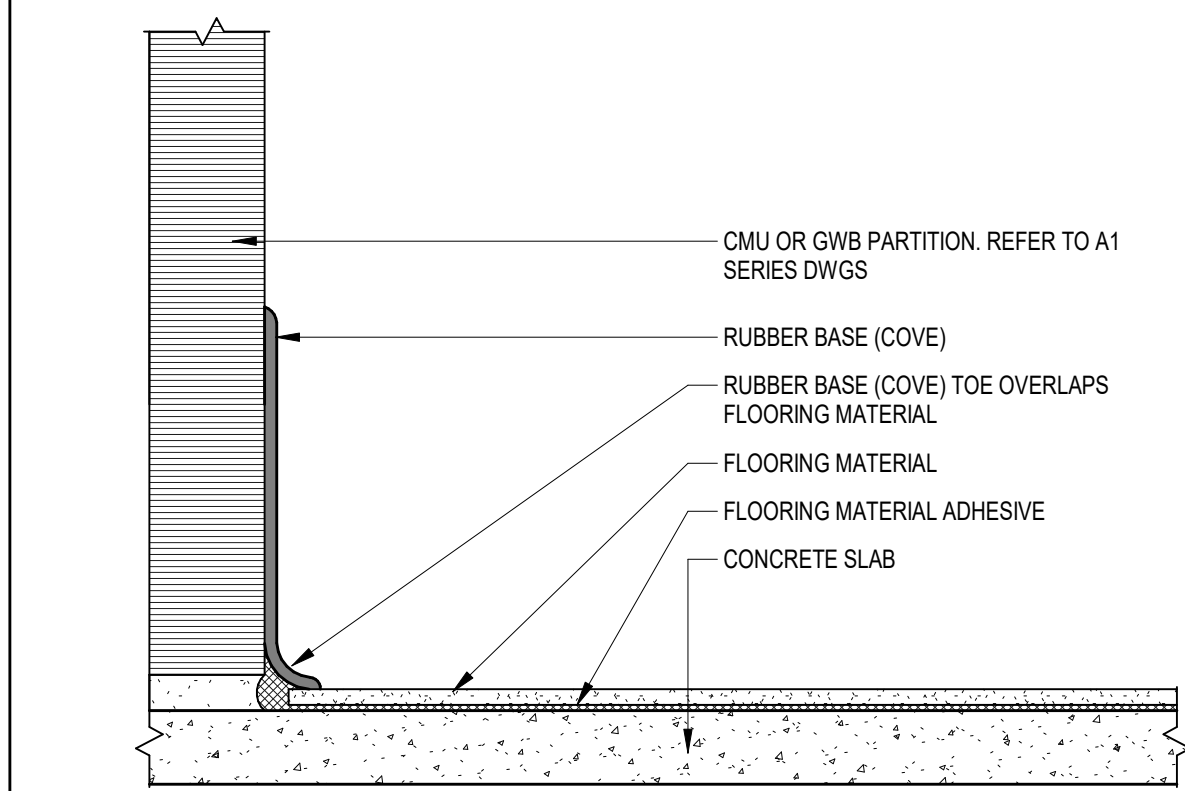


RB WALL BASE DETAIL

- SCALE: 6" = 1'-0"
- REFER TO PROJECT MANUAL FOR ADDITIONAL INFORMATION

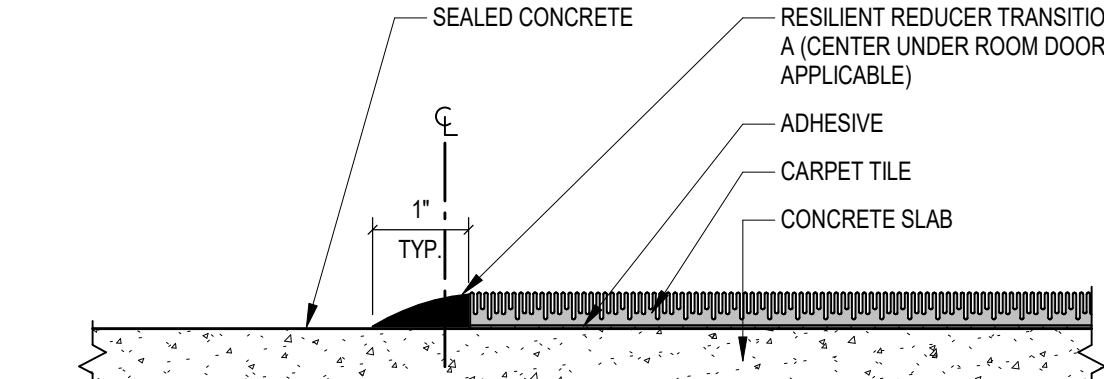


FLOOR TRANSITION DETAIL

- SCALE: NTS
- REFER TO PROJECT MANUAL FOR ADDITIONAL INFORMATION
- DETAIL SIMILAR FOR TERR TO CSC FLOORING TRANSITION.

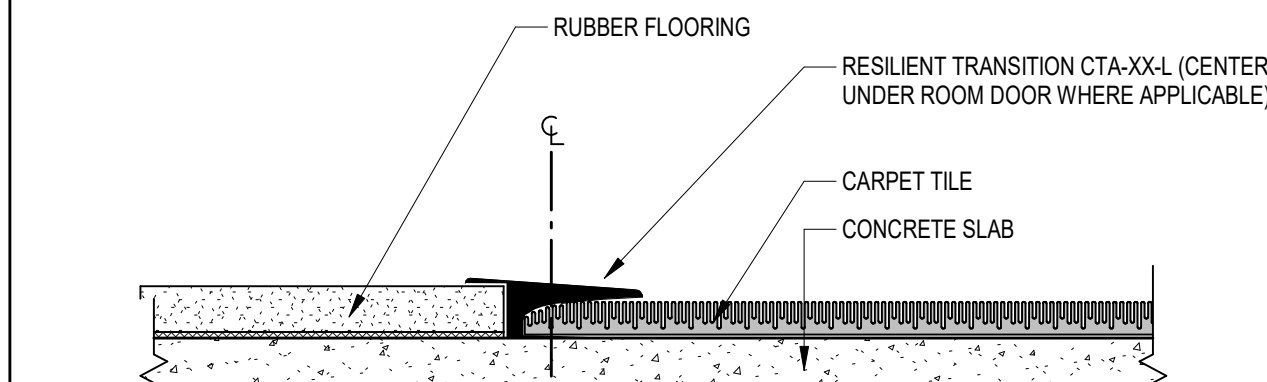


FLOOR TRANSITION DETAIL

- SCALE: NTS
- REFER TO PROJECT MANUAL FOR ADDITIONAL INFORMATION

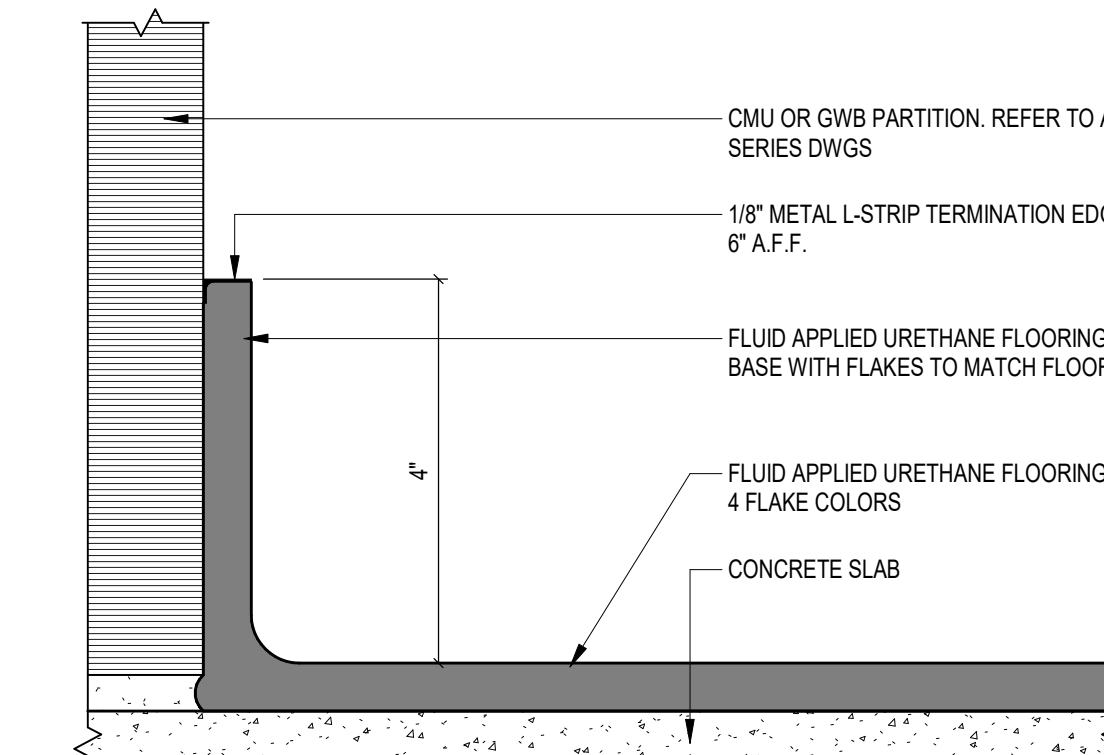


DRF WALL BASE DETAIL

- SCALE: 6" = 1'-0"
- REFER TO PROJECT MANUAL FOR ADDITIONAL INFORMATION

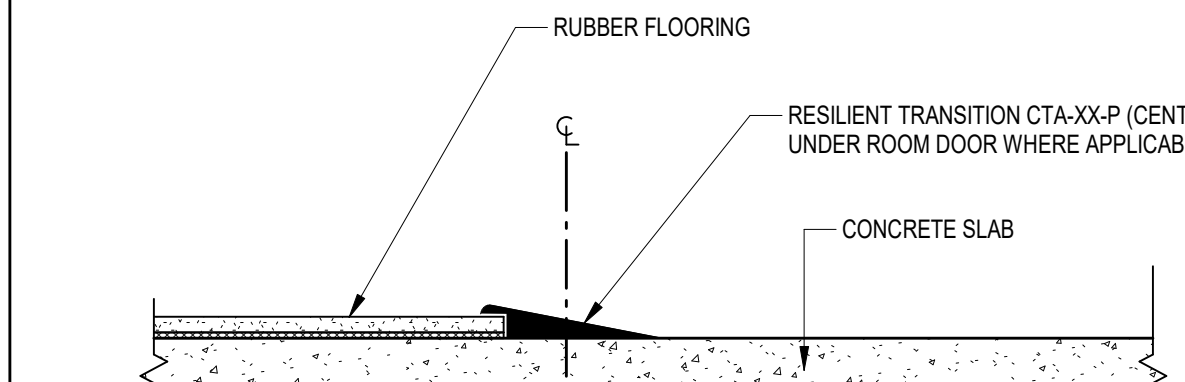

FLOOR TRANSITION DETAIL

- SCALE: NTS
- REFER TO PROJECT MANUAL FOR ADDITIONAL INFORMATION

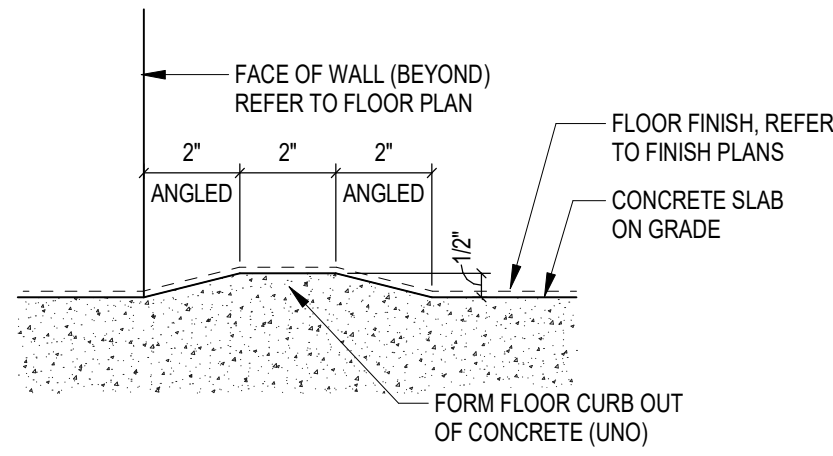

1

SHOWER CURB

SCALE: 3" = 1'-0"

LIST OF FINISHES

REFER TO AXX.500 ARCH. DWG. SHEETS

FLOOR MATERIALS

REFER TO AXX.500 ARCH. DWG. SHEETS

CARPET TILE

MATERIAL ABBREVIATION	MATERIAL/MANUFACTURER	COLOR SELECTION
CART-1	INTERFACE / WOVEN GRADIENCE / IWG100	108051 ONYX/ 50CMx50CM
CART-2	INTERFACE / WOVEN GRADIENCE / IWG100	107672 ONYX/PINE/ 50CMx50CM
CART-3	INTERFACE / WOVEN GRADIENCE / IWG200	108056 PINE/ 50CMx50CM
• ALL CARPET BACKING TO HAVE A MOISTURE RESISTANT BARRIER.		
• INSTALLATION METHOD TO BE HALF-DROP, UNLESS OTHERWISE NOTED.		
• PROVIDE INSTALLATION DRAWINGS FOR REVIEW.		

FLOOR SEALER

MATERIAL ABBREVIATION	MATERIAL/MANUFACTURER	COLOR SELECTION
FS	REFER TO SPECIFICATIONS	CLEAR

DECORATIVE RESINOUS FLOORING

MATERIAL ABBREVIATION	MATERIAL/MANUFACTURER	COLOR SELECTION
DRF-1	REFER TO SPECIFICATIONS	50% F3080 LANAI GRAY, 25% F1380 FOREST GREEN, 15% F8958 ALPACA WHITE, 10% F5920 CYBERSPACE

RUBBER FLOOR TILE

MATERIAL ABBREVIATION	MATERIAL/MANUFACTURER	COLOR SELECTION
RFT-1	MATTER SURFACES / DECAHALON DESIGN TILE	CLOVER

ENTRY CARPET TILE

MATERIAL ABBREVIATION	MATERIAL/MANUFACTURER	COLOR SELECTION
ECT-1	INTERFACE / STEP REPEAT SR 889	IRON 104938

BASE MATERIALS

RESILIENT BASE

4"H COVE BASE

MATERIAL ABBREVIATION	MATERIAL/MANUFACTURER	COLOR SELECTION
RB-1	JOHNSONITE ROPPE	GRAY 48 MATCH JOHNSONITE

DECORATIVE RESINOUS BASE

4"H BASE

MATERIAL ABBREVIATION	MATERIAL/MANUFACTURER	COLOR SELECTION
DRF-1	REFER TO SPECIFICATIONS	MATCH DRF-1 FLOORING

WALL FINISHES

PAINT

MATERIAL ABBREVIATION	MATERIAL/MANUFACTURER	COLOR SELECTION
P-1 (FIELD)	SHERWIN WILLIAMS	SW 7009 PEARLY WHITE
P-2 (SCHOOL COLOR)	SHERWIN WILLIAMS	KPL 1/857 MIDNIGHT CLOVER
P-3 (CEILING)	SHERWIN WILLIAMS	SW 7009 EXTRA WHITE
P-4 (DOOR FRAMES)	PPG	PPG0845 CITY SKYLINE

CEILING MATERIALS

ACOUSTICAL CEILING TILE

MATERIAL ABBREVIATION	MATERIAL/MANUFACTURER	COLOR SELECTION
ACT-1	REFER TO SPECIFICATIONS	WHITE / 24"x24"
ACT-2	REFER TO SPECIFICATIONS	WHITE / 24"x24"

INTERIOR FINISH SYSTEM

MATERIAL ABBREVIATION	MATERIAL/MANUFACTURER	COLOR SELECTION
IFS	REFER TO SPECIFICATIONS	ARCHITECT TO CHOOSE FROM MANUFACTURER STANDARD

MATERIAL & FINISH GENERAL NOTES

- REFER TO FINISH A8 SERIES FINISH PLANS FOR MATERIALS, PATTERNS, AND COLORS.
- ALL CARPET TO HAVE HALF-DROP INSTALL, UNLESS NOTED OTHERWISE.
- (RB) RUBBER BASE AT ALL FS, RTT AND CART LOCATIONS. ALL RB TO BE NOTED RB-1, UNLESS NOTED OTHERWISE.
- ALL ECT TO HAVE MONOLITHIC INSTALL, UNLESS NOTED OTHERWISE.

PAINT TYPE GENERAL NOTES

- PAINTING AND FINISHING OF EXTERIOR SURFACES AS DESIGNATED. DETAILS SHALL BE UNDER THE WORK SECTION 09 91 13 - EXTERIOR PAINTING.
- ALL GYPSUM BOARD CEILINGS AND SOFFITS SHALL BE PAINTED WITH PAINT TYPE #9.21 (FLAT) UNLESS OTHERWISE NOTED.
- IN ROOMS ~~A108, A116, A118, B106, B111, B113, B114, B120~~ PAINT WITH PAINT CODE #4.222 (EPOXY SEMI-GLOSS, WET AREAS). REFER TO SECTION 09600 - HIGH PERFORMANCE COATINGS.
- IN ROOMS ~~A101, A105, A108, A116, A118, A123, B101, B102, B103, B105, B106, B107, B108, B110, B111, B112, B113, B114, B115, B116, B117, B118, B119, B120, B122, B123, B124, B125, B127~~ PAINT WITH PAINT CODE #4.224 (EPOXY SEMI-GLOSS, NONWET AREAS). REFER TO SECTION 09600 - HIGH PERFORMANCE COATINGS.
- ALL GYPSUM BOARD PAINT WITH PAINT CODE #9.211 (EPOXY SEMI-GLOSS). REFER TO SECTION 09600 - HIGH PERFORMANCE COATINGS.
- ALL NON-INTEGRALLY COLORED CMU WALLS IN HIGH TRAFFIC AREAS PAINT WITH PAINT CODE WET ENVIRONMENTS #4.222 (EPOXY GLOSS). DRY ENVIRONMENTS REQUIRING ADDITIONAL ABRASION RESISTANCE (EX TOILET ROOMS) 4.224 (EPOXY SEMI-GLOSS). REFER TO SECTION 09600 - HIGH PERFORMANCE COATINGS.
- ALL CONCRETE SHALL BE PAINTED INTERIOR PAINT TYPE #3.113 (EPOXY). REFER TO SECTION 09600 - HIGH PERFORMANCE COATINGS.
- ALL STEEL ON HM DOORS/FRAMES SHALL BE PAINTED INTERIOR PAINT TYPE #5.222 (EPOXY). REFER TO SECTION 09600 - HIGH PERFORMANCE COATINGS.
- ALL GALVANIZED STEEL SHALL BE PAINTED INTERIOR PAINT TYPE #5.322 (EPOXY). REFER TO SECTION 09600 - HIGH PERFORMANCE COATINGS.
- ALL FERROUS METAL (EXCLUDING STRUCTURE) SHALL BE PAINTED INTERIOR PAINT TYPE #5.12.
- ALL GALVANIZED METAL (EXCLUDING STRUCTURE) SHALL BE PAINTED INTERIOR PAINT TYPE #5.32.
- ALL WOOD TRIM SHALL BE PAINTED INTERIOR PAINT TYPE #6.31.
- ALL EXPOSED MECHANICAL INSULATION / PIPING SHALL BE PAINTED INTERIOR PAINT TYPE #10.11.
- ALL WALLS ARE TO RECEIVE AN SEMI-GLOSS FINISH AND ALL CEILINGS/BULKHEADS ARE TO RECEIVE A FLAT FINISH.

PAINT COLOR GENERAL NOTES

- ALL INTERIOR WALLS SHALL BE PAINTED P-1, UNLESS OTHERWISE INDICATED ON FINISH PLANS OR INTERIOR ELEVATIONS.
- PAINT ALL PAINTED EXPOSED CEILINGS AND GYPSUM BOARD CEILINGS P-3 UNLESS OTHERWISE NOTED ON FINISH PLANS, CEILING PLANS, OR INTERIOR ELEVATIONS.
- PAINT ALL GWB SOFFITS P-1 UNLESS OTHERWISE NOTED ON FINISH PLANS OR INTERIOR ELEVATIONS.
- PAINT ALL INTERIOR HOLLOW METAL FRAMES AND DOOR FRAMES P-4.
- ALL EXTERIOR DOORS AND FRAMES SHALL BE PAINTED TO MATCH EXISTING.

EQUIPMENT MATERIALS

REFER TO A7 ARCH. DWG. SHEETS

HP PLASTIC LAMINATE

MATERIAL ABBREVIATION	MATERIAL/MANUFACTURER	COLOR SELECTION
PL-1 (COUNTERS)	WILSONART	PEARL SOAPSTONE 4886-38
PL-2 (CABINETS)	WILSONART	CLASSIC LINEN 4943-38

KICKPLATES

STAINLESS STEEL

LOCKERS

MATERIAL ABBREVIATION	MATERIAL/MANUFACTURER	COLOR SELECTION
	REFER TO SPECIFICATIONS	STANDARD, TO BE SELECTED

MARKERBOARDS

WHITE / PROJECTABLE

TOILET PARTITIONS/COMPARTMENTS

MATERIAL ABBREVIATION	MATERIAL/MANUFACTURER	COLOR SELECTION
TPP-1	REFER TO SPECIFICATIONS	TO BE SELECTED
TPP-2 (B123)	REFER TO SPECIFICATIONS	TO BE SELECTED, FULL HEIGHT

ROLLER WINDOW SHADES

MATERIAL ABBREVIATION	MATERIAL/MANUFACTURER	COLOR SELECTION
RWS	REFER TO SPECIFICATIONS	OPAQUE, TO BE SELECTED FROM MANUF. STANDARDS

SHOWER CURTAINS

WHITE

CUBICLE CURTAINS

MATERIAL ABBREVIATION	MATERIAL/MANUFACTURER	COLOR SELECTION
CC	ARCHITEX / RX1008	SOOTHE

TACKBOARDS

MATERIAL ABBREVIATION	MATERIAL/MANUFACTURER	COLOR SELECTION
TB	REFER TO SPECIFICATIONS	TO BE SELECTED

WASH FOUNTAIN SOLID SURFACE

MATERIAL ABBREVIATION	MATERIAL/MANUFACTURER	COLOR SELECTION
LAV	REFER TO SPECIFICATIONS	ARCHITECT TO SELECT FROM MANUFACTURER'S FULL RANGE OF STANDARD AND DESIGNER COLORS

SOLID SURFACE

MATERIAL ABBREVIATION	MATERIAL/MANUFACTURER	COLOR SELECTION
SSM-1 (WALL CAP)	CORIAN	ARTISTA BEIGE
SSM-2 (WINDOW SILLS)	CORIAN	ARTISTA BEIGE

EQUIPMENT MATERIAL & FINISH GEN. NOTES

- COLOR SELECTION OF ALL FINISHES FOR ARCHITECTURAL WOODWORK/CUSTOM CASEWORK ITEMS ARE NOTED ON CASEWORK ELEVATIONS.
- EDUCATION CASEWORK FINISHES ARE AS FOLLOWS:
 - HIGH PRESSURE PLASTIC LAMINATE COUNTERTOPS AND WORKSURFACES ARE TO BE PL-1, UNLESS OTHERWISE NOTED.
 - HIGH PRESSURE PLASTIC LAMINATE CABINETS/VERTICAL SURFACES ARE TO BE PL-2, UNLESS OTHERWISE NOTED.
 - INTERIOR MELAMINE TO BE WHITE.
 - 3MM AND 1MM PVC EDGES ON COUNTERTOPS AND WORKSURFACES ARE TO MATCH PL-1.
 - 3MM AND 1MM PVC EDGES ON CASEWORK ARE TO MATCH PL-2.
 - HANDLES TO BE BRUSHED CHROME.
 - HINGES TO BE BRUSH CHROME.
 - SUBMIT SAMPLES OF GROMMETS FOR APPROVAL.
 - SUBMIT SAMPLES OF TECHNOLOGY CABINET VENTS FOR APPROVAL.
- ALL DOORS TO RECEIVE NEW INTERIOR AND EXTERIOR (WHERE APPLICABLE) ROOM SIGNAGE, PER ALLOWANCE.

ZIONSVILLE
COMMUNITY HIGH
SCHOOL STADIUM
LOCKER BUILDING
ADDITION AND
RENOVATION

900 MULBERRY ST.
ZIONSVILLE IN, 46077

ZIONSVILLE COMMUNITY
SCHOOLS




ARCHITECT




317.848.0966
350 E NEW YORK ST, SUITE #300, INDIANAPOLIS, IN 46204

WWW.FHAI.COM

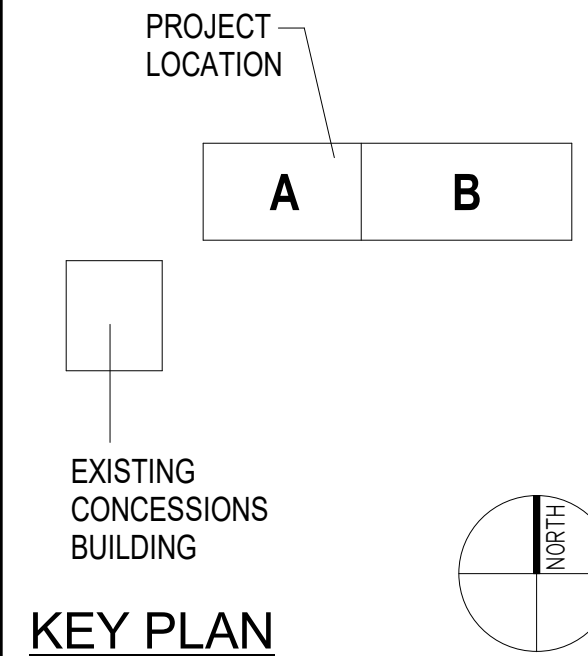

CONSTRUCTION DOCUMENTS

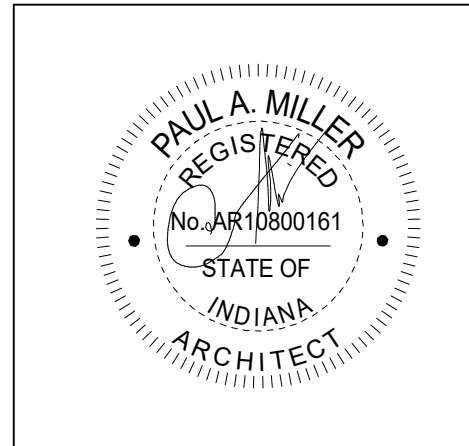

DRAWN BY: MKH
PROJECT NUMBER: 223139.00
PROJECT ISSUE DATE: 01.22.2024

REV. NO.	DESCRIPTION	DATE
1	ADDENDUM #1	02.14.2024

LIST OF FINISHES

A8S.01




**FANNING
HOWEY**




creative engineering solutions
mechanical • electrical • plumbing
201 S Rural St., Suite 210
Indianapolis, IN 46201 • 463-777-8182
www.creativeveng.net

EXISTING
CONCESSIONS
BUILDING


KEY PLAN

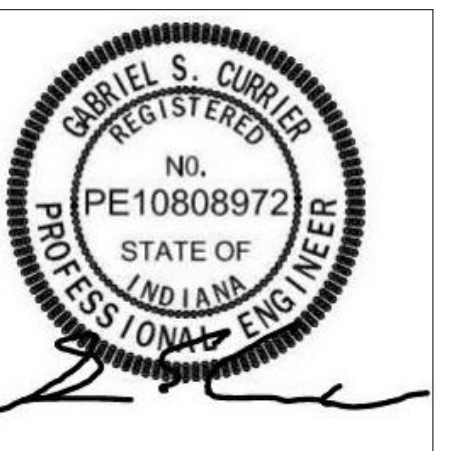

		.	
1	Addendum #1		02/14/2024
.9			

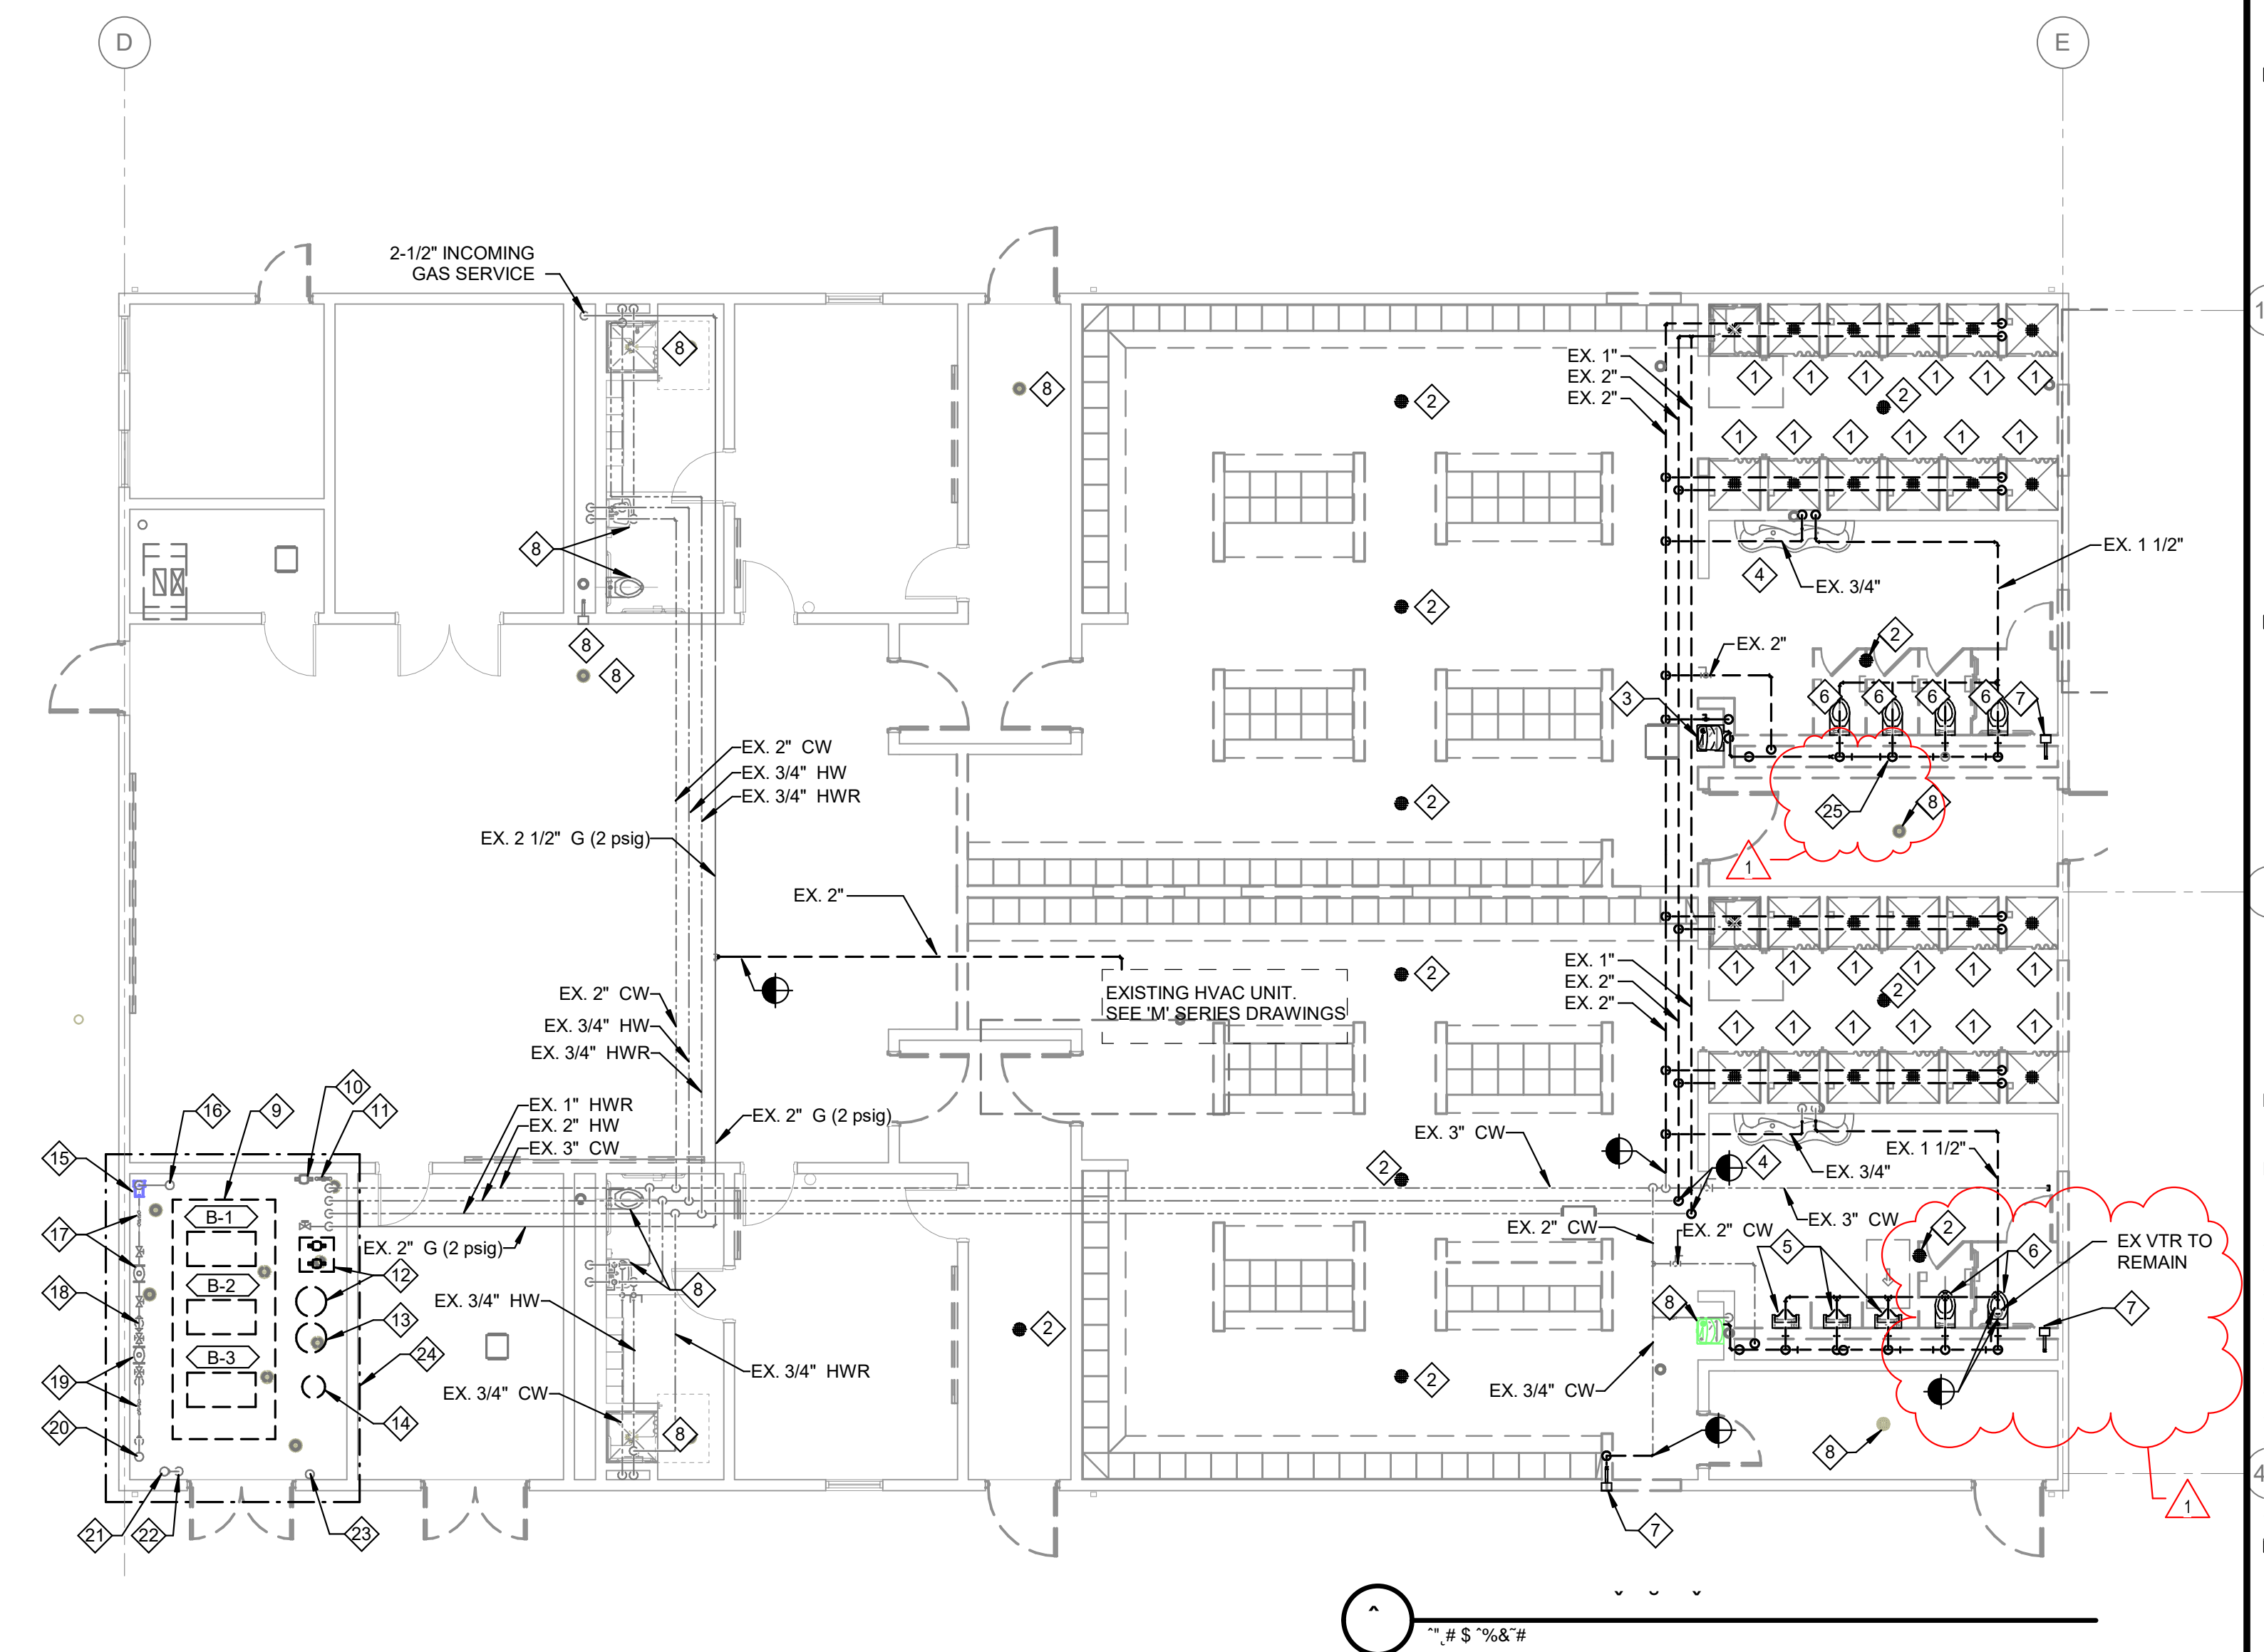

C:\Users\jporter\Documents\2023\024_ZHS_Bldg001_P_2022_Central_LockerCWF.Mxd
2/13/2024 11:42:48 AM

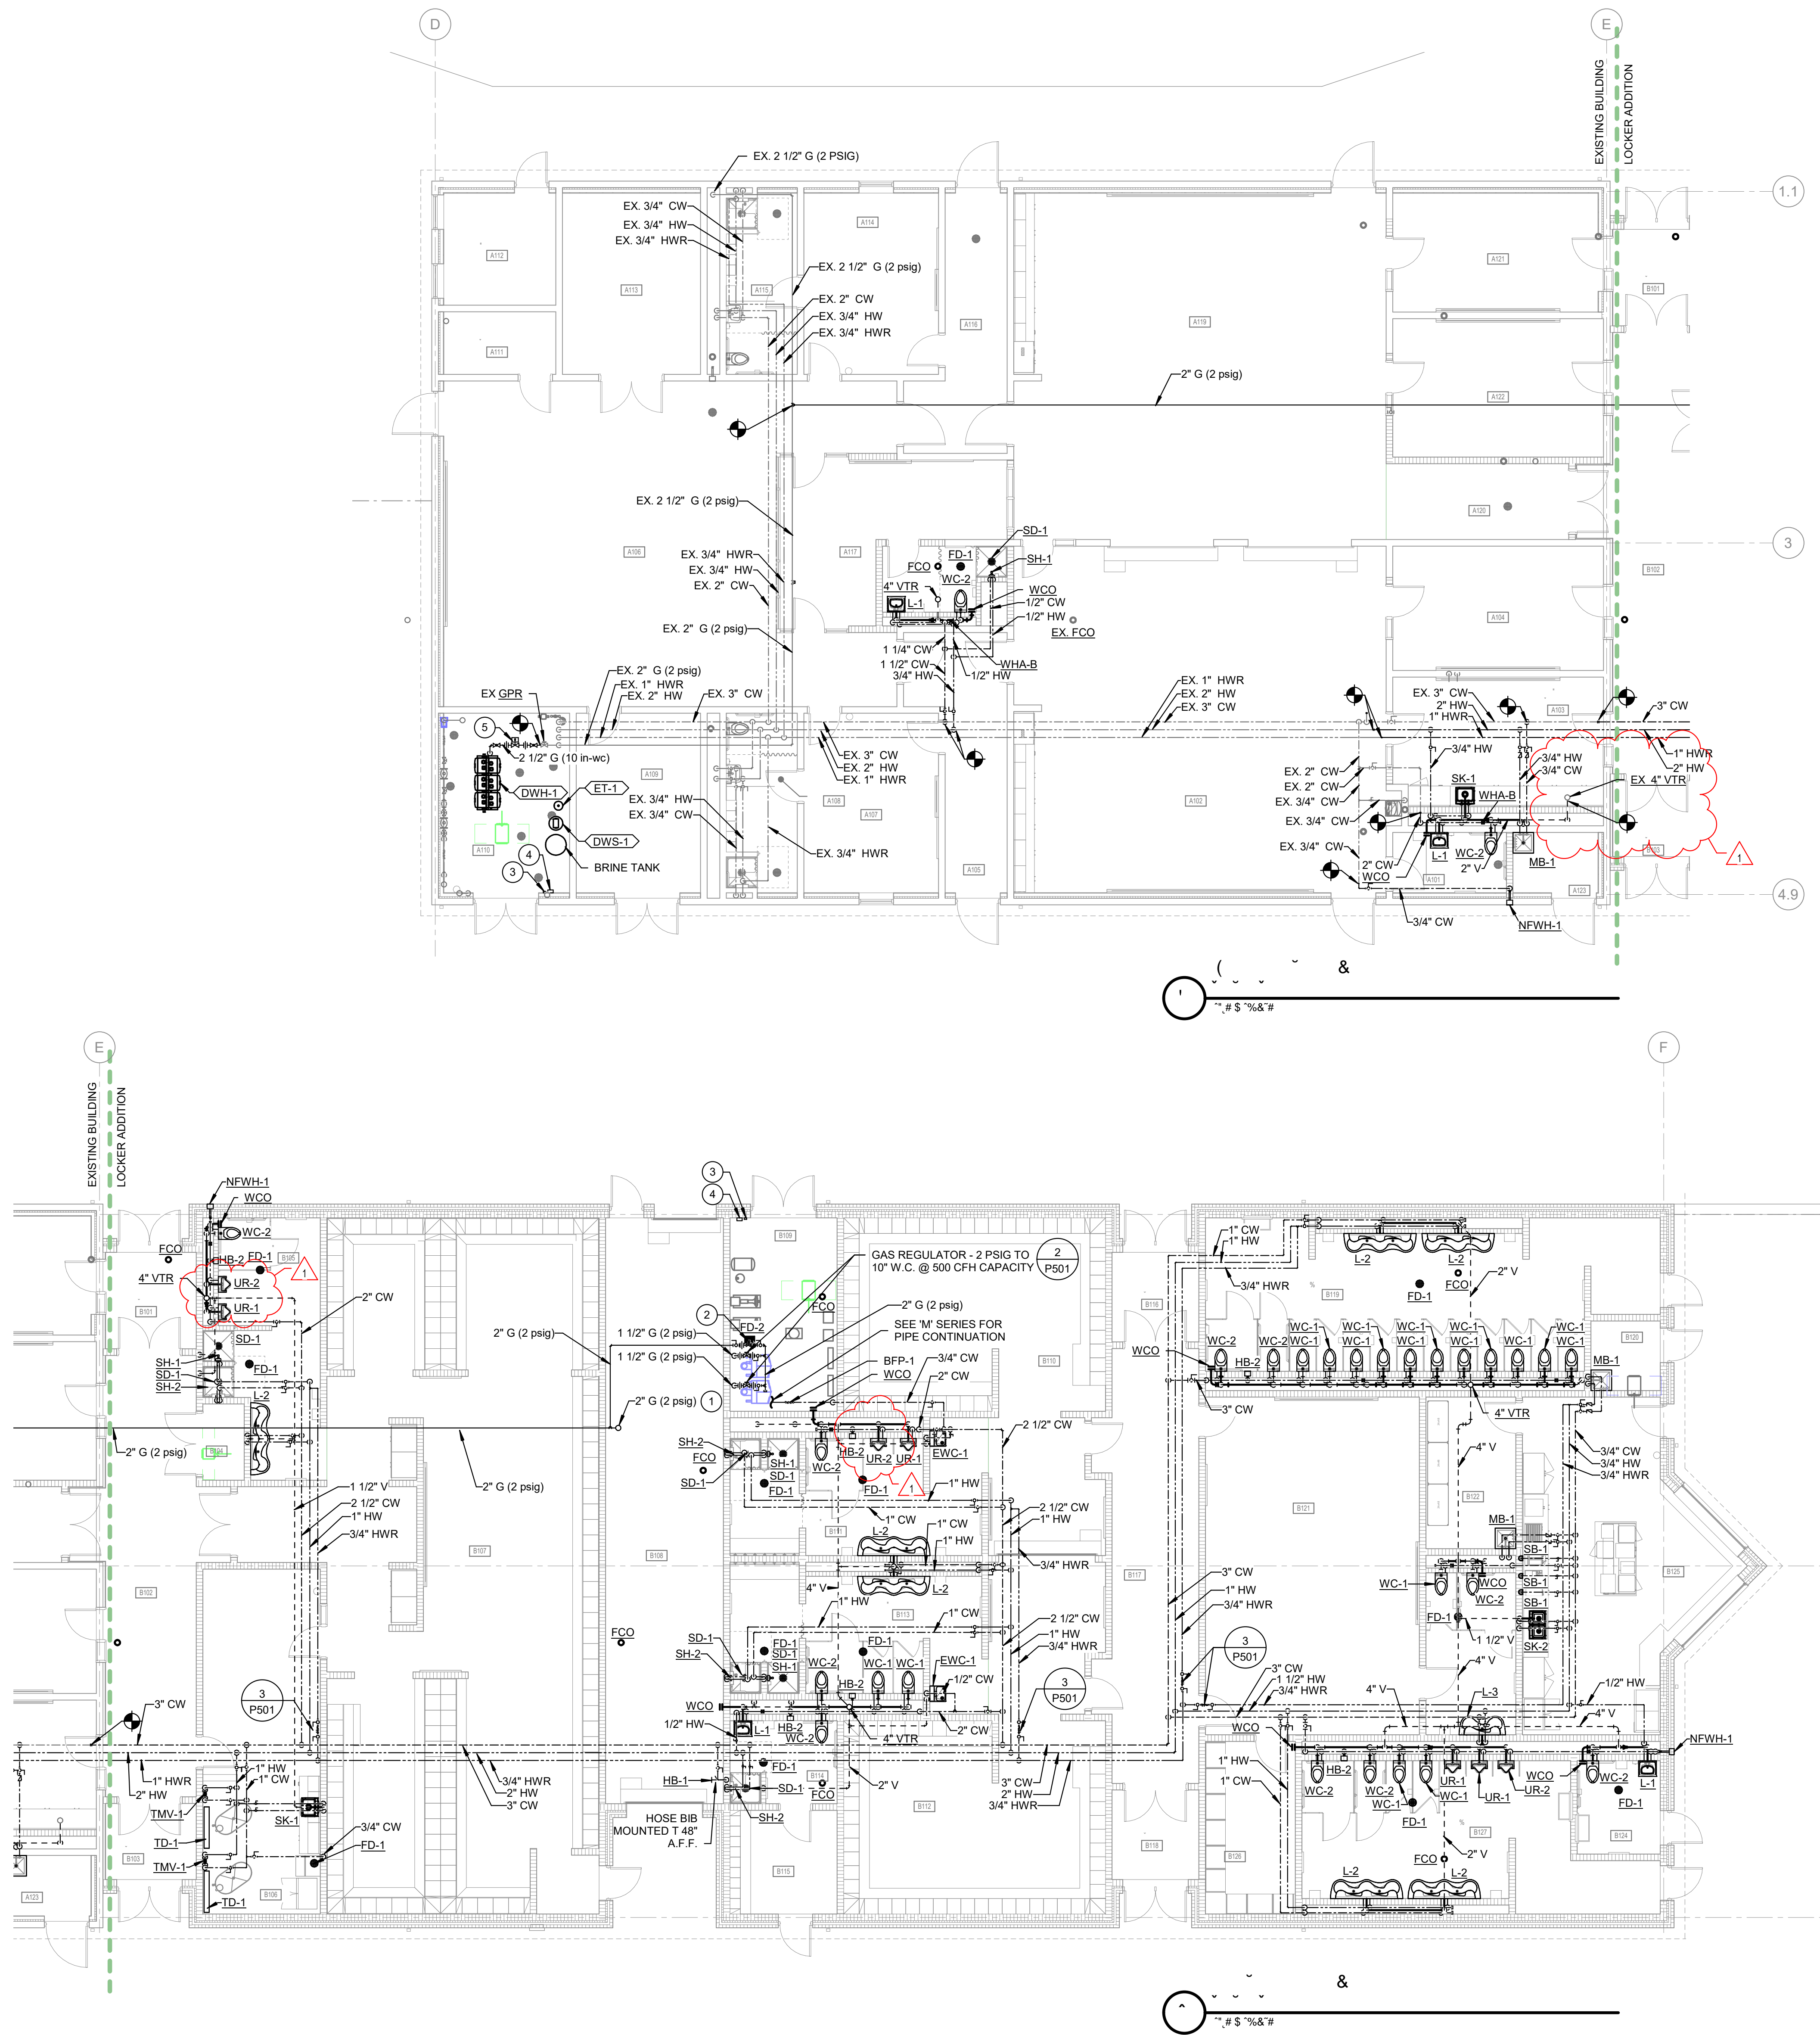

1. ROUTE A 2" PSI GAS LINE UP TO NEW ROOF TOP UNIT WITH SHUT OFF VALVE, UNION, GAS PRESSURE REGULATOR AND DIRT LEG. GAS PRESSURE REGULATOR TO BE CAPABLE OF RECEIVING 2 PSI SERVICE PRESSURE AND REGULATING DOWN TO 10" W.C. SUPPLYING 500,000 BTUH. LINE SIZE FROM REGULATOR TO RTU TO BE A 1" LINE
2. EMERGENCY GAS SHUT-OFF SOLENOID VALVE-2" (AGS; MERLIN 1064)
3. EMERGENCY GAS SHUT-OFF PANIC BUTTON (AGS; #AGS-EGOTW)
4. EMERGENCY GAS SHUT-OFF MASTER CONTROL PANEL (AGS; #AGSCH4C0)
5. EMERGENCY GAS SHUT-OFF SOLENOID VALVE-2" (AGS; MERLIN 1072)


COPYRIGHT 2023 BY FANNINGHOWEY ASSOCIATES, INC.

900 MULBERRY ST.
ZIONSVILLE IN, 46077



**FANNING
HOWEY**

350 E NEW YORK ST, SUITE #300, INDIANAPOLIS, IN 46204

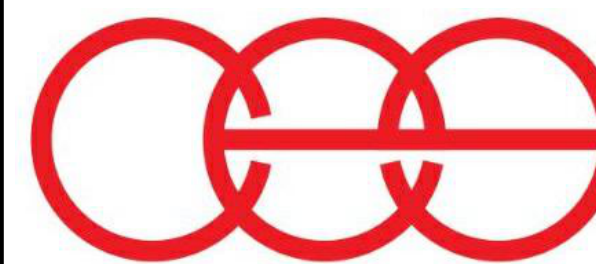


creative engineering solutions
mechanical • electrical • plumbing
201 S Rural St., Suite 210
Indianapolis, IN 46201 • 463-777-8182
www.creativeveng.net

PROJECT
LOCATION



EXISTING
CONCESSIONS
BUILDING

KEY PLAN

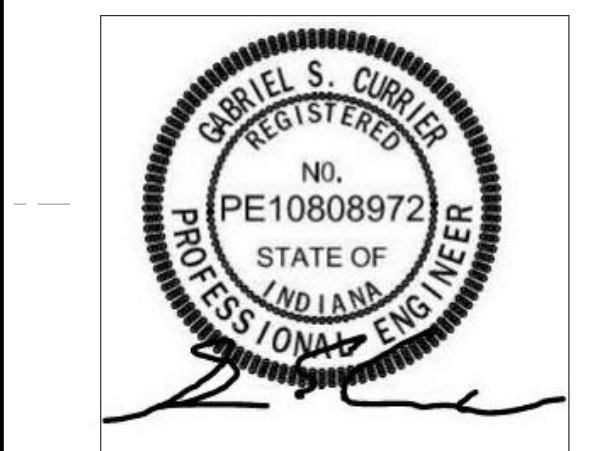

DRAWN BY: LP
PROJECT NUMBER: 223139.00
PROJECT ISSUE DATE: 01/22/2024

1 Addendum #1 02/14/2024

4.9

VVA

**ZIONSVILLE
COMMUNITY HIGH
SCHOOL STADIUM
LOCKER BUILDING
ADDITION AND
RENOVATION**

900 MULBERRY ST.
ZIONSVILLE IN, 46077

**ZIONSVILLE COMMUNITY
SCHOOLS**



ZIONSVILLE
—COMMUNITY SCHOOLS—

ARCHITECT


**FANNING
HOWEY**

317.848.0966

WWW.FHAI.COM

350 E NEW YORK ST, SUITE #300, INDIANAPOLIS, IN 46204

CONSULTANT

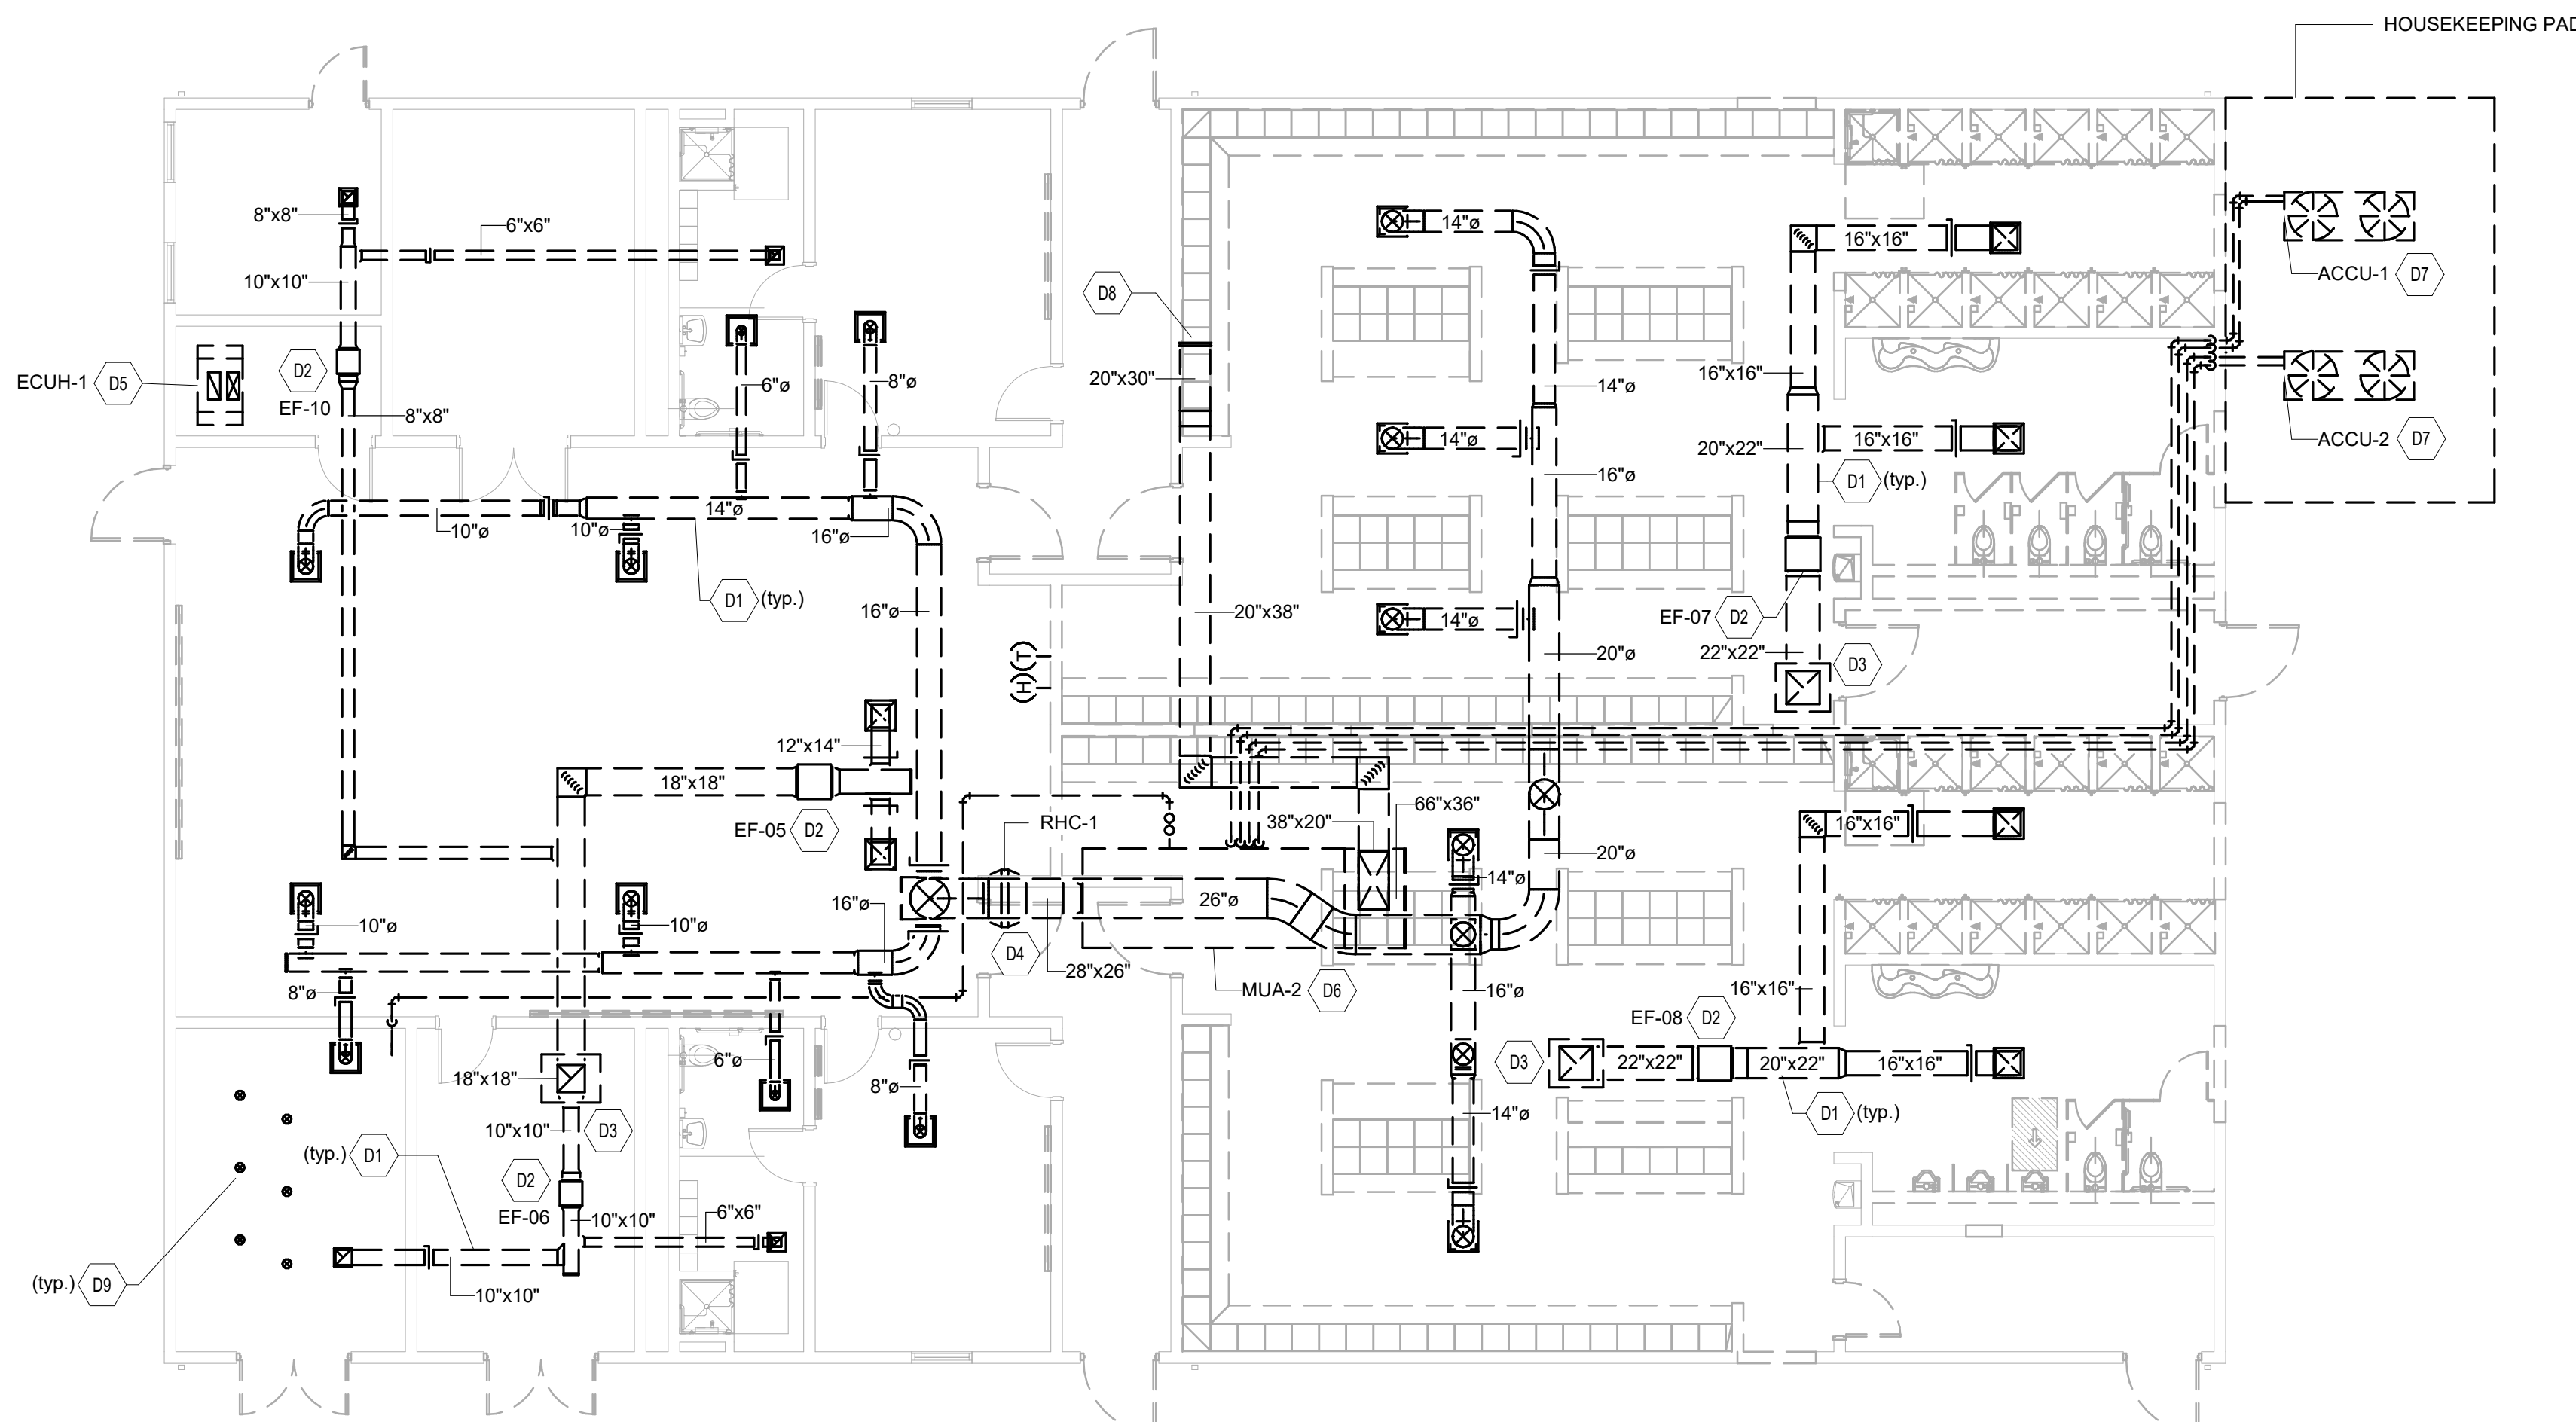

EXISTING LOCKER BUILDING - HVAC DEMOLITION PLAN

1

SCALE: 1/8" = 1'-0"

MECHANICAL DEMOLITION PLAN NOTES

(ALL NOTES MAY NOT BE INDICATED ON THIS SHEET)

NO.	DESCRIPTION
D1	EXISTING DUCTWORK AND ASSOCIATED AIR DEVICES TO BE REMOVED. PATCH OPENING IN EXISTING GYPSUM CEILING TO MATCH ADJACENT CONSTRUCTION. PROVIDE INSULATION ABOVE PATCHED AREA TO MATCH EXISTING ROOF WATERTIGHTNESS.
D2	EXHAUST FAN TO BE REMOVED COMPLETELY, INCLUDING ASSOCIATED DUCTWORK, AIR DEVICES, SUPPORTS, CONTROLS, ETC. DISPOSE OF ALL MATERIALS OFFSITE. COORDINATE ALL DISCONNECT REQUIREMENTS WITH ELECTRICAL CONTRACTOR PRIOR TO REMOVAL.
D3	ROOF VENTILATOR TO BE REMOVED COMPLETELY INCLUDING ASSOCIATED AIR DEVICES, SUPPORTS, ETC. DISPOSE OF ALL MATERIALS OFFSITE. PATCH EXISTING ROOF CEILING TO MATCH ADJACENT CONSTRUCTION, AND SEAL EXTERIOR PENETRATIONS WATER-TIGHT. MAINTAIN ANY EXISTING ROOF WARRANTY.
D4	REHEAT COIL TO BE REMOVED COMPLETELY INCLUDING ASSOCIATED DUCTWORK, AIR DEVICES, SUPPORTS, CONTROLS, ETC. DISPOSE OF ALL MATERIALS OFFSITE. COORDINATE ALL DISCONNECT REQUIREMENTS WITH ELECTRICAL CONTRACTOR PRIOR TO REMOVAL.
D5	CABINET UNIT HEATER TO BE REMOVED COMPLETELY INCLUDING SUPPORTS, CONTROLS, ETC. DISPOSE OF ALL MATERIALS OFFSITE. COORDINATE ALL DISCONNECT REQUIREMENTS WITH ELECTRICAL CONTRACTOR PRIOR TO REMOVAL. PATCH OPENING IN EXISTING GYPSUM CEILING TO MATCH INSULATION ABOVE PATCHED AREA TO MATCH INSULATION ABOVE EXISTING AREA.
D6	MAKEUP AIR UNIT TO BE REMOVED COMPLETELY INCLUDING ASSOCIATED DUCTWORK, AIR DEVICES, SUPPORTS, FLUE/COMBUSTION PIPING, DRAIN PIPING, ETC. DISPOSE OF ALL MATERIALS OFFSITE. COORDINATE ALL DISCONNECT REQUIREMENTS WITH ELECTRICAL CONTRACTOR PRIOR TO REMOVAL.
D7	AIR COOLED CONDENSING UNIT TO BE REMOVED COMPLETELY INCLUDING ASSOCIATED PIPING, DRAIN PIPING, CONTROLS, ETC. DISPOSE OF ALL MATERIALS OFFSITE. COORDINATE ALL DISCONNECT REQUIREMENTS WITH ELECTRICAL CONTRACTOR PRIOR TO REMOVAL.
D8	EXISTING ROOF FAN TO BE REMOVED COMPLETELY INCLUDING ASSOCIATED SUPPLY AND EXHAUST DUCTWORK, ETC. OF ALL MATERIALS OFFSITE.
D9	BOILER COMBUSTION AIR AND VENT PIPING TO BE REMOVED COMPLETELY INCLUDING ALL MATERIALS OFFSITE. PATCH OPENING IN EXISTING GYPSUM CEILING TO MATCH ADJACENT CONSTRUCTION. PROVIDE INSULATION ABOVE PATCHED AREA TO MATCH INSULATION ABOVE ADJACENT AREA TO MATCH EXISTING ROOF OPENING TO MATCH ADJACENT CONSTRUCTION, AND SEAL EXTERIOR PENETRATIONS WATER-TIGHT. MAINTAIN ANY EXISTING ROOF WARRANTY.

VERIFICATION NOTE

CONTRACTOR SHALL VERIFY ALL DIMENSIONS AND CLEARANCES AND ALL EXISTING FIELD CONDITIONS BEFORE STARTING CONSTRUCTION. COMMENCEMENT OF WORK CONSTITUTES ACCEPTANCE OF CONDITIONS.

SHOULD DIFFERENT CONDITIONS BE ENCOUNTERED, CONTACT THE ARCHITECT BEFORE PROCEEDING WITH WORK.


PROJECT LOCATION



EXISTING
CONCESSIONS
BUILDING

KEY PLAN

CONSTRUCTION DOCUMENTS

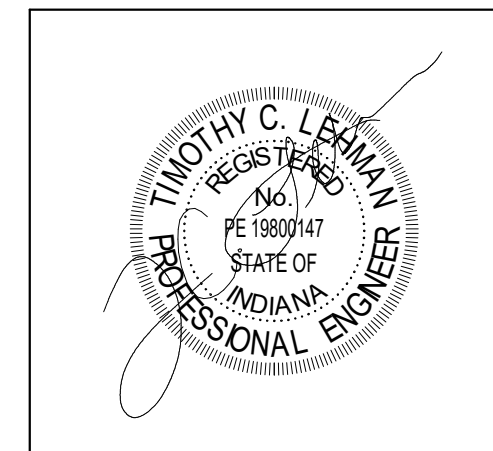

DRAWN BY: KPF

PROJECT NUMBER: 223139.00


PROJECT ISSUE DATE: 01.22.2022

[illegible]

**EXISTING LOCKER BUILDING - HVAC
DEMOLITION PLAN**


MD.01

C:\Users\kross\Documents\2021_MECH_23139_00_kross5007.rvt
2/13/2024 11:59:19 AM

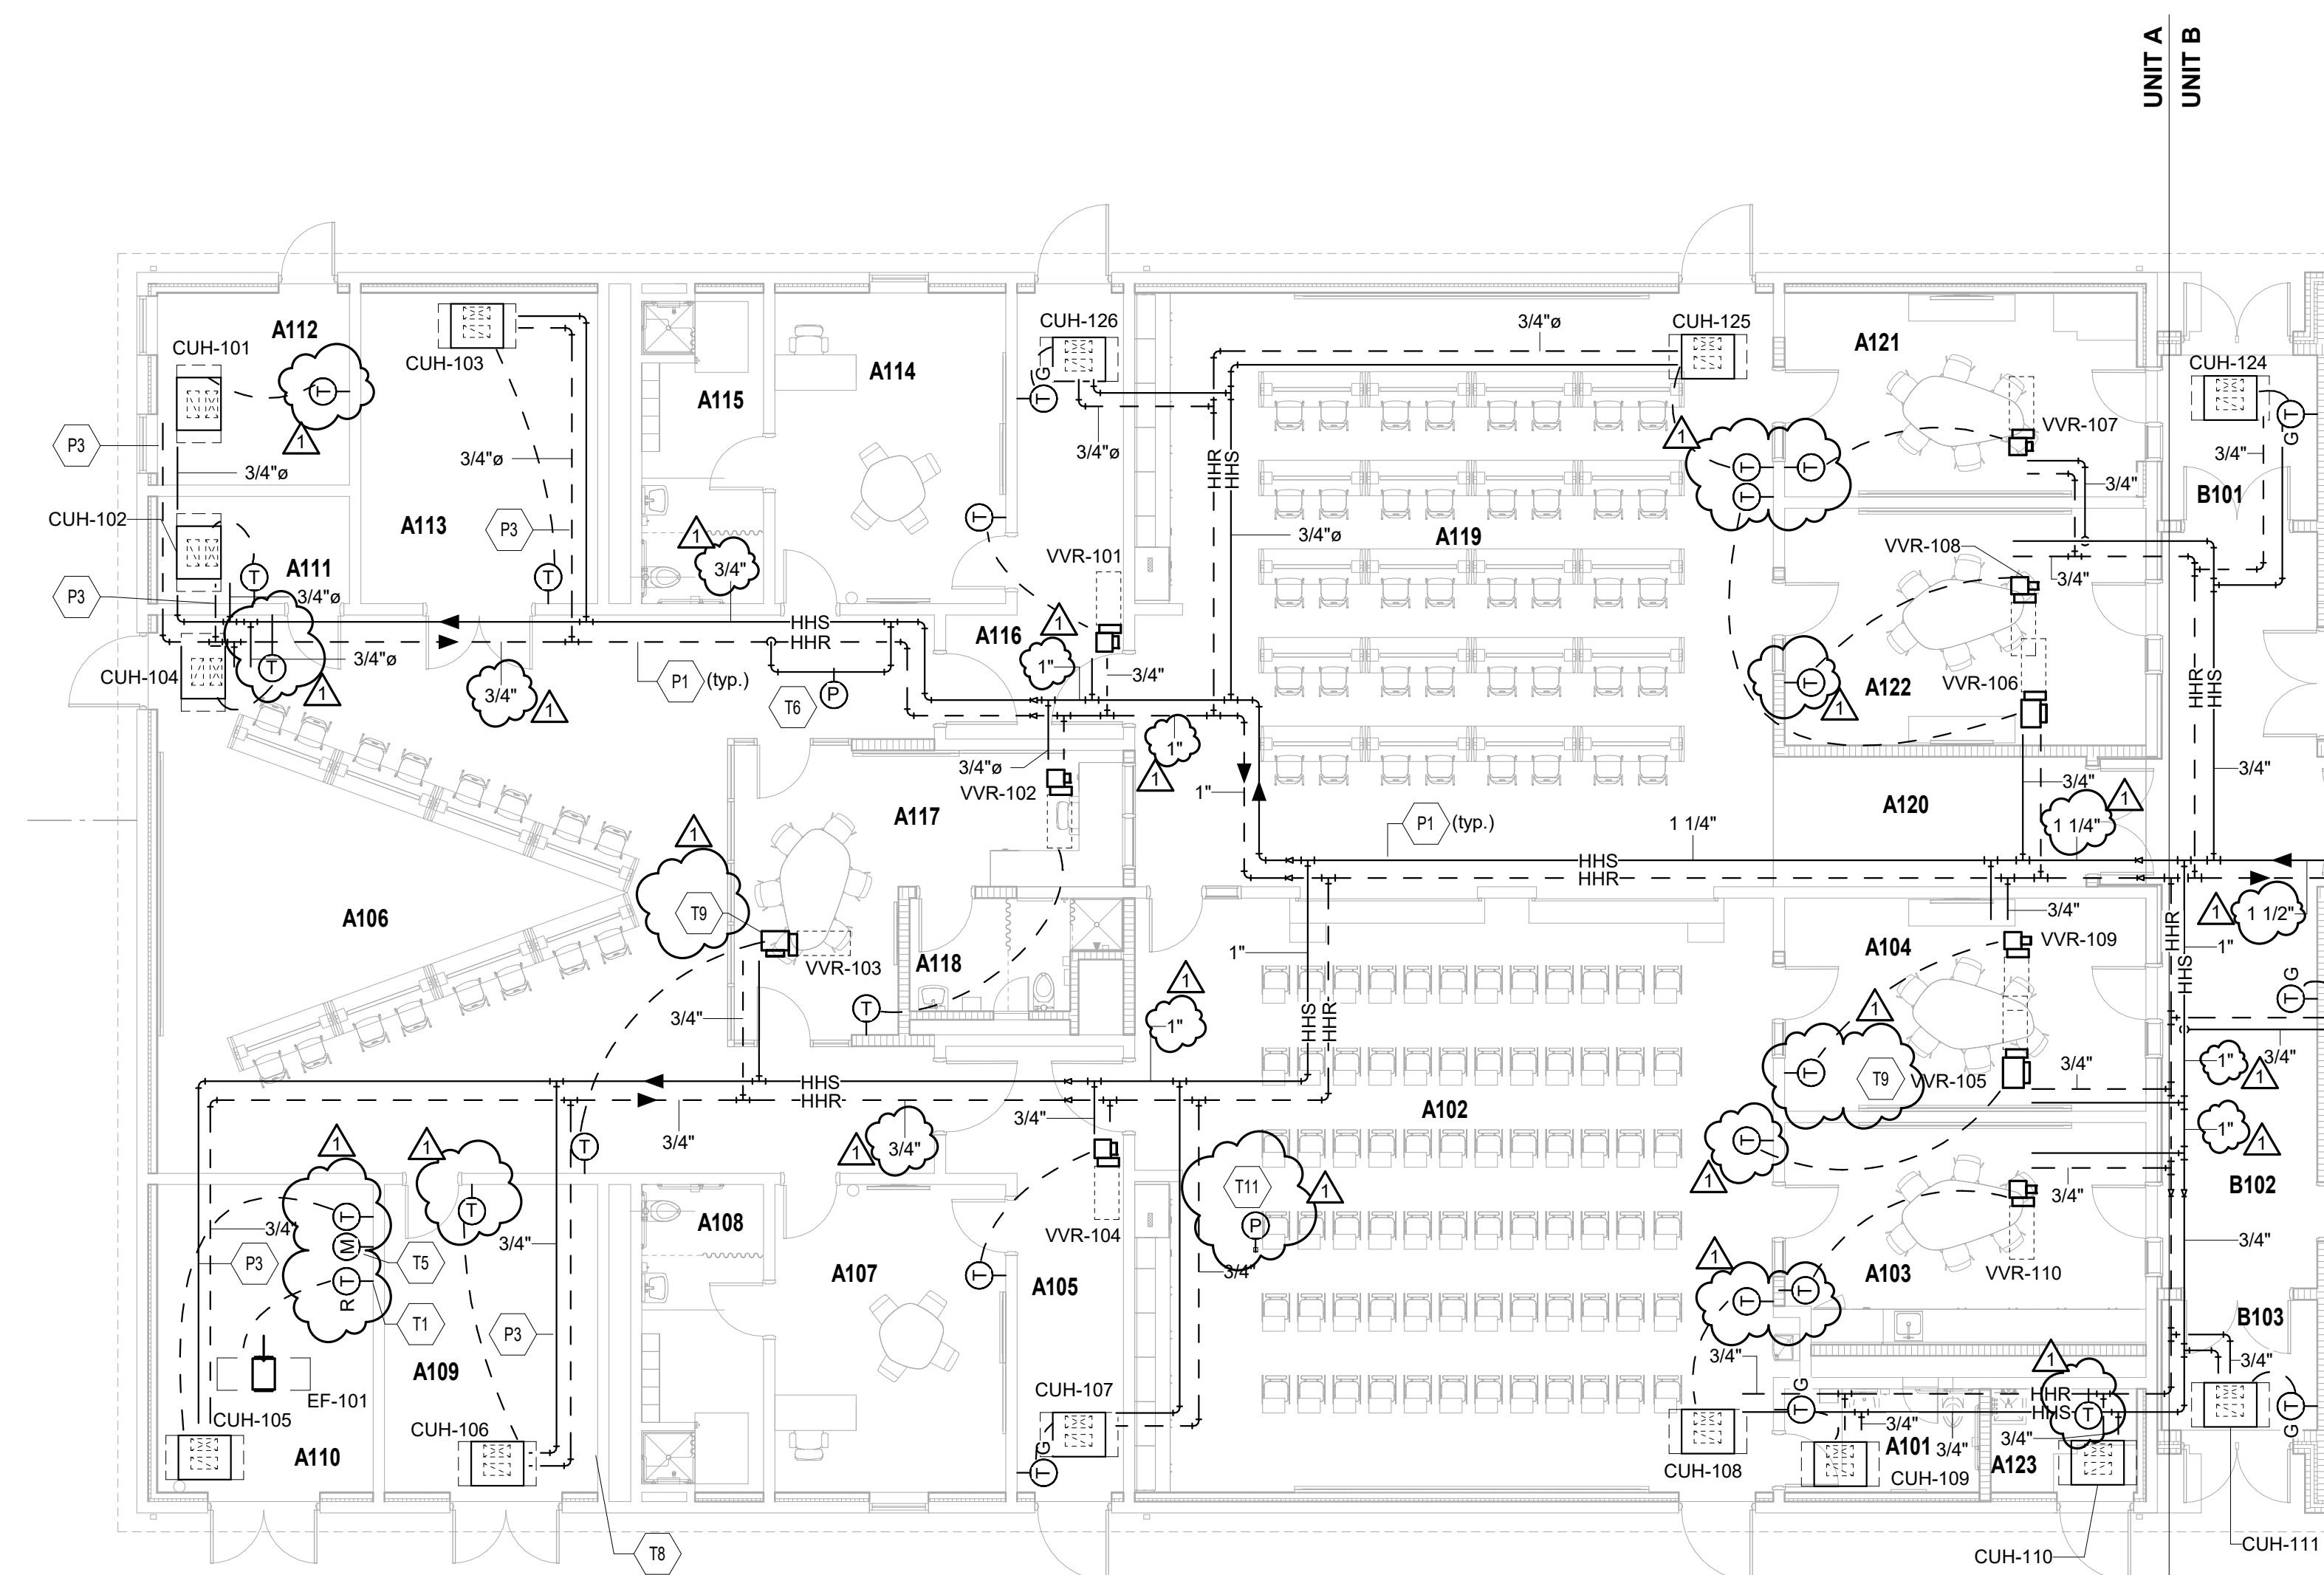

1
UNIT A - HVAC PIPING AND
TEMPERATURE CONTROL PLAN

SCALE: 1/8" = 1'-0"

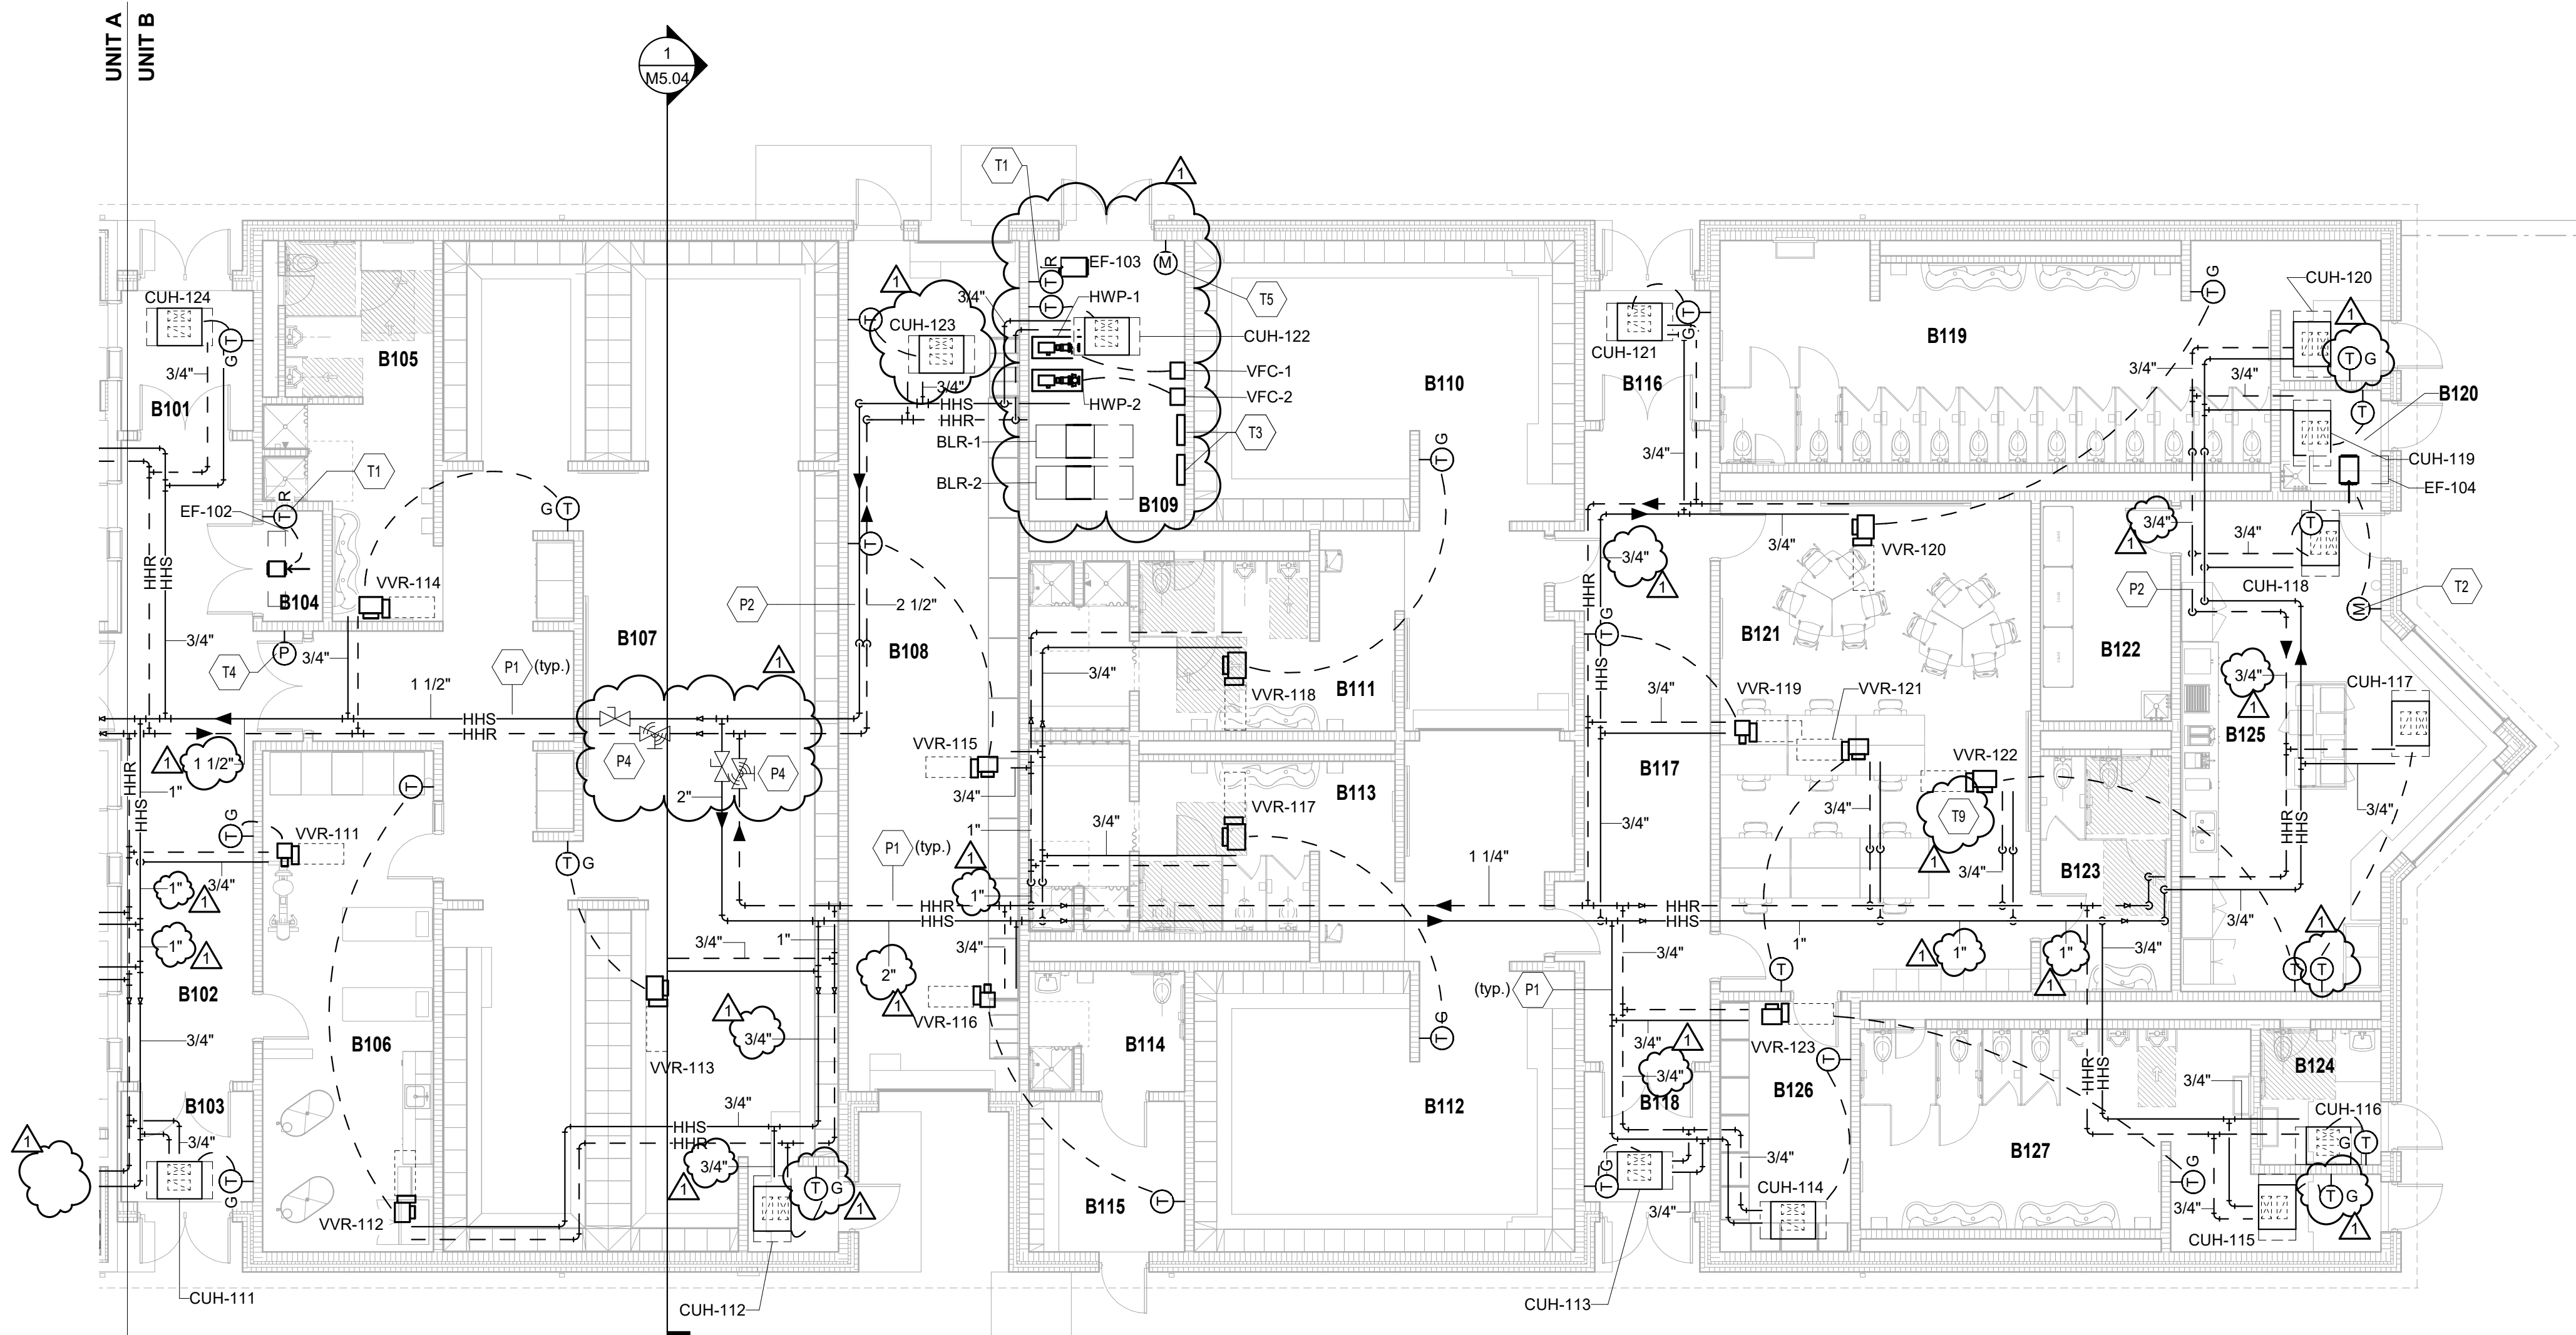

2
UNIT B - HVAC PIPING AND
TEMPERATURE CONTROL PLAN

SCALE: 1/8" = 1'-0"

ROOM LEGEND - FIRST FLOOR UNIT A		
ROOM NO.	ROOM NAME	AREA (SF)
A101	TOILET	64 SF
A102	TEAM ROOM	1212 SF
A103	SMALL TEAM ROOM / HOSPITALITY	252 SF
A104	SMALL TEAM ROOM	245 SF
A105	ENTRY	180 SF
A106	TEAM ROOM	1164 SF
A107	COACH	228 SF
A108	COACH RESTROOM	116 SF
A109	STORAGE	209 SF
A110	MECHANICAL	212 SF
A111	FIRE PROTECTION	68 SF
A112	CUSTODIAL / STORAGE	118 SF
A113	STORAGE	234 SF
A114	COACH	229 SF
A115	COACH RESTROOM	118 SF
A116	ENTRY	179 SF
A117	COACH	256 SF
A118	COACH RESTROOM	67 SF
A119	TEAM ROOM	1206 SF
A120	CORRIDOR	130 SF
A121	SMALL TEAM ROOM	229 SF
A122	SMALL TEAM ROOM	273 SF
A123	CUSTODIAL	48 SF
B101	VESTIBULE	82 SF
B102	CORRIDOR	424 SF
B103	VESTIBULE	65 SF
B104	IDF	29 SF
B105	SHOWERS / TOILETS	234 SF
B106	TRAINING ROOM	377 SF
B107	LOCKER ROOM	1353 SF
B108	STORAGE	648 SF
B109	MECHANICAL	194 SF
B110	LOCKER ROOM	613 SF
B111	SHOWERS / TOILETS	272 SF
B112	LOCKER ROOM	628 SF
B113	SHOWERS / TOILETS	281 SF
B114	OFFICIALS RESTROOM	82 SF
B115	OFFICIALS LOCKER	104 SF
B116	VESTIBULE	73 SF
B117	CORRIDOR	374 SF
B118	VESTIBULE	73 SF
B119	WOMEN'S RESTROOM	574 SF
B120	CUSTODIAL	45 SF
B121	COACHES OFFICE	676 SF
B122	STORAGE	128 SF
B123	COACHES RR	136 SF
B124	FAMILY RESTROOM	73 SF
B125	CONCESSIONS	507 SF
B126	STORAGE	145 SF
B127	MEN'S RESTROOM	386 SF

HVAC PIPING PLAN GENERAL NOTES

- ALL PIPING AND VALVES SHALL BE CONCEALED ABOVE THE CEILING AND WITHIN WALLS, UNLESS OTHERWISE NOTED.
- REFER TO THE SPECIFICATIONS FOR REQUIREMENTS RELATED TO EQUIPMENT QUALITY, CONSTRUCTION AND FINISH OF MATERIALS.
- ARRANGE PIPING, ETC. TO ALLOW FOR EASY ACCESS TO COILS, VALVES, DAMPERS AND CONTROLS. KEEP AREAS ADJACENT TO ACCESS PANELS FREE AND CLEAR OF ANY OBSTRUCTIONS.
- MECHANICAL CONTRACTOR IS RESPONSIBLE FOR HIS RESPECTIVE WORK FOR REPAIRING AND PATCHING TO MATCH EXISTING SURFACES, SIDEWALKS, STREETS, FLOORS, WALLS, ROOFS, CEILING AND PAVEMENT.
- HYDRONIC SUPPLY AND RETURN PIPING SHALL BE THE SAME SIZE UNLESS OTHERWISE NOTED.

TEMPERATURE CONTROL PLAN GENERAL NOTES

- ALL THERMOSTATS/SENSORS TO BE MOUNTED WITH BOTTOM AT 4" AFF UNLESS OTHERWISE NOTED. COORDINATE EXACT LOCATION WITH ALL TRADES.
- WHEN (2) OR MORE SENSORS ARE LOCATED IN THE SAME AREA, PROVIDE BETWEEN 2" AND 4" OF SPACING BETWEEN EACH DEVICE, NO MORE, NO LESS.
- REFER TO SECTIONS 230000 AND 230093 FOR TEMPERATURE CONTROL SPECIFICATIONS AND SEQUENCE OF OPERATIONS.
- TEMPERATURE CONTROL CONTRACTOR SHALL PROVIDE INTERCONNECTING WIRING BETWEEN VARIABLE FREQUENCY CONTROLLER AND EQUIPMENT.

HVAC PIPING AND TEMPERATURE CONTROL PLAN NOTES

(ALL NOTES MAY NOT BE INDICATED ON THIS SHEET)

NO. DESCRIPTION

P1 PIPING SHALL RUN IN THE INTERSTITIAL SPACE.

P2 PIPING SHALL BE ROUTED INTO ATTIC SPACE AT LOCATION SHOWN, AND ROUTED BACK INTO INTERSTITIAL SPACE WHEN SHOWN.

P3 EXPOSED PIPING/PIPING INSULATION TO BE PAINTED TO COLOR SELECTED BY ARCHITECT/OWNER.

P4 PROVIDE SHUT-OFF VALVE IN THE SUPPLY PIPING, AND BALANCING VALVE IN THE RETURN PIPING AT LOCATION SHOWN.

T1 REVERSE ACTING THERMOSTAT TO CONTROL EXHAUST FAN. TEMPERATURE SETPOINT TO BE 85°F.

T2 THERMOSTAT/SENSOR PROVIDED BY DIVISION 28 TO CONTROL EXHAUST FAN.

T3 APPROXIMATE LOCATION OF TEMPERATURE CONTROL PANEL. COORDINATE FINAL LOCATION WITH ALL TRADES. COORDINATE WITH TECHNOLOGY CONTRACTOR TO PROVIDE DATA DROPS FOR EACH PANEL.

T4 APPROXIMATE LOCATION OF PRESSURE SENSOR PROVIDED BY ROOFTOP UNIT MANUFACTURER.

T5 TEMPERATURE CONTROL CONTRACTOR SHALL PROVIDE CARBON MONOXIDE DETECTOR. REFER TO PROJECT MANUAL, COORDINATE EXACT LOCATION WITH ALL TRADES.

T6 APPROXIMATE LOCATION OF DIFFERENTIAL PRESSURE TRANSMITTER FOR HEATING WATER VARIABLE PUMP CONTROL. TRANSMITTER PROVIDED BY TEMPERATURE CONTROL CONTRACTOR AND INSTALLED BY HVAC CONTRACTOR.

T7 APPROXIMATE LOCATION OF CONTACTORS PROVIDED BY ELECTRICAL CONTRACTOR FOR EXTERIOR BUILDING LIGHTING. TEMPERATURE CONTROL CONTRACTOR SHALL WIRE LOW-VOLTAGE WIRING TO THE TEMPERATURE CONTROL SYSTEM. COORDINATE EXACT LOCATION AND QUANTITY WITH ELECTRICAL CONTRACTOR. REFER TO TEMPERATURE CONTROL SPECIFICATION.

T8 UNIT SHALL BE PROVIDED WITH 3-WAY VALVE.

T9 APPROXIMATE LOCATION OF DUCT DIFFERENTIAL PRESSURE SENSOR. PROVIDE 18"X18" ACCESS PANEL IN GYPSUM CAP LOCATED ABOVE LAY-IN CEILING.

COPYRIGHT 2024 BY FANNINGHOWEY ASSOCIATES, INC.

ZIONSVILLE COMMUNITY HIGH SCHOOL STADIUM LOCKER BUILDING ADDITION AND RENOVATION

900 MULBERRY ST.
ZIONSVILLE IN, 46077

ZIONSVILLE COMMUNITY SCHOOLS



ARCHITECT

**FANNING
HOWEY**

317.848.0966

WWW.FHAI.COM

350 E NEW YORK ST, SUITE #300, INDIANAPOLIS, IN 46204

CONSULTANT


PROJECT LOCATION



EXISTING CONCESSIONS BUILDING

KEY PLAN

CONSTRUCTION DOCUMENTS

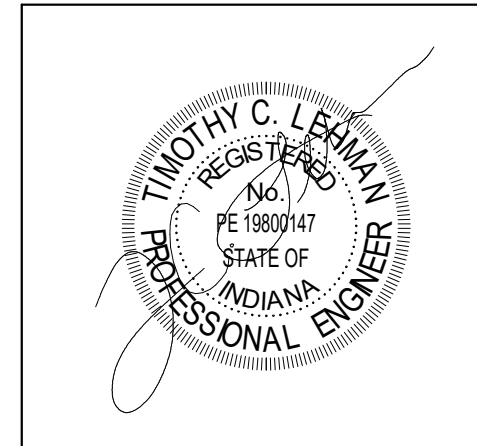

DRAWN BY: KPR

PROJECT NUMBER: 223139.00

PROJECT ISSUE DATE: 01/22/2024

REV. NO.	DESCRIPTION	DATE
1	ADDENDUM #1	2/14/2024


VERIFICATION NOTE

CONTRACTOR SHALL VERIFY ALL DIMENSIONS AND CLEARANCES AND ALL EXISTING FIELD CONDITIONS BEFORE STARTING CONSTRUCTION. COMMENCEMENT OF WORK CONSTITUTES ACCEPTANCE OF CONDITIONS.


SHOULD DIFFERENT CONDITIONS BE ENCOUNTERED, CONTACT THE ARCHITECT BEFORE PROCEEDING WITH WORK.

HVAC PIPING AND TEMPERATURE CONTROL PLAN

M3.01

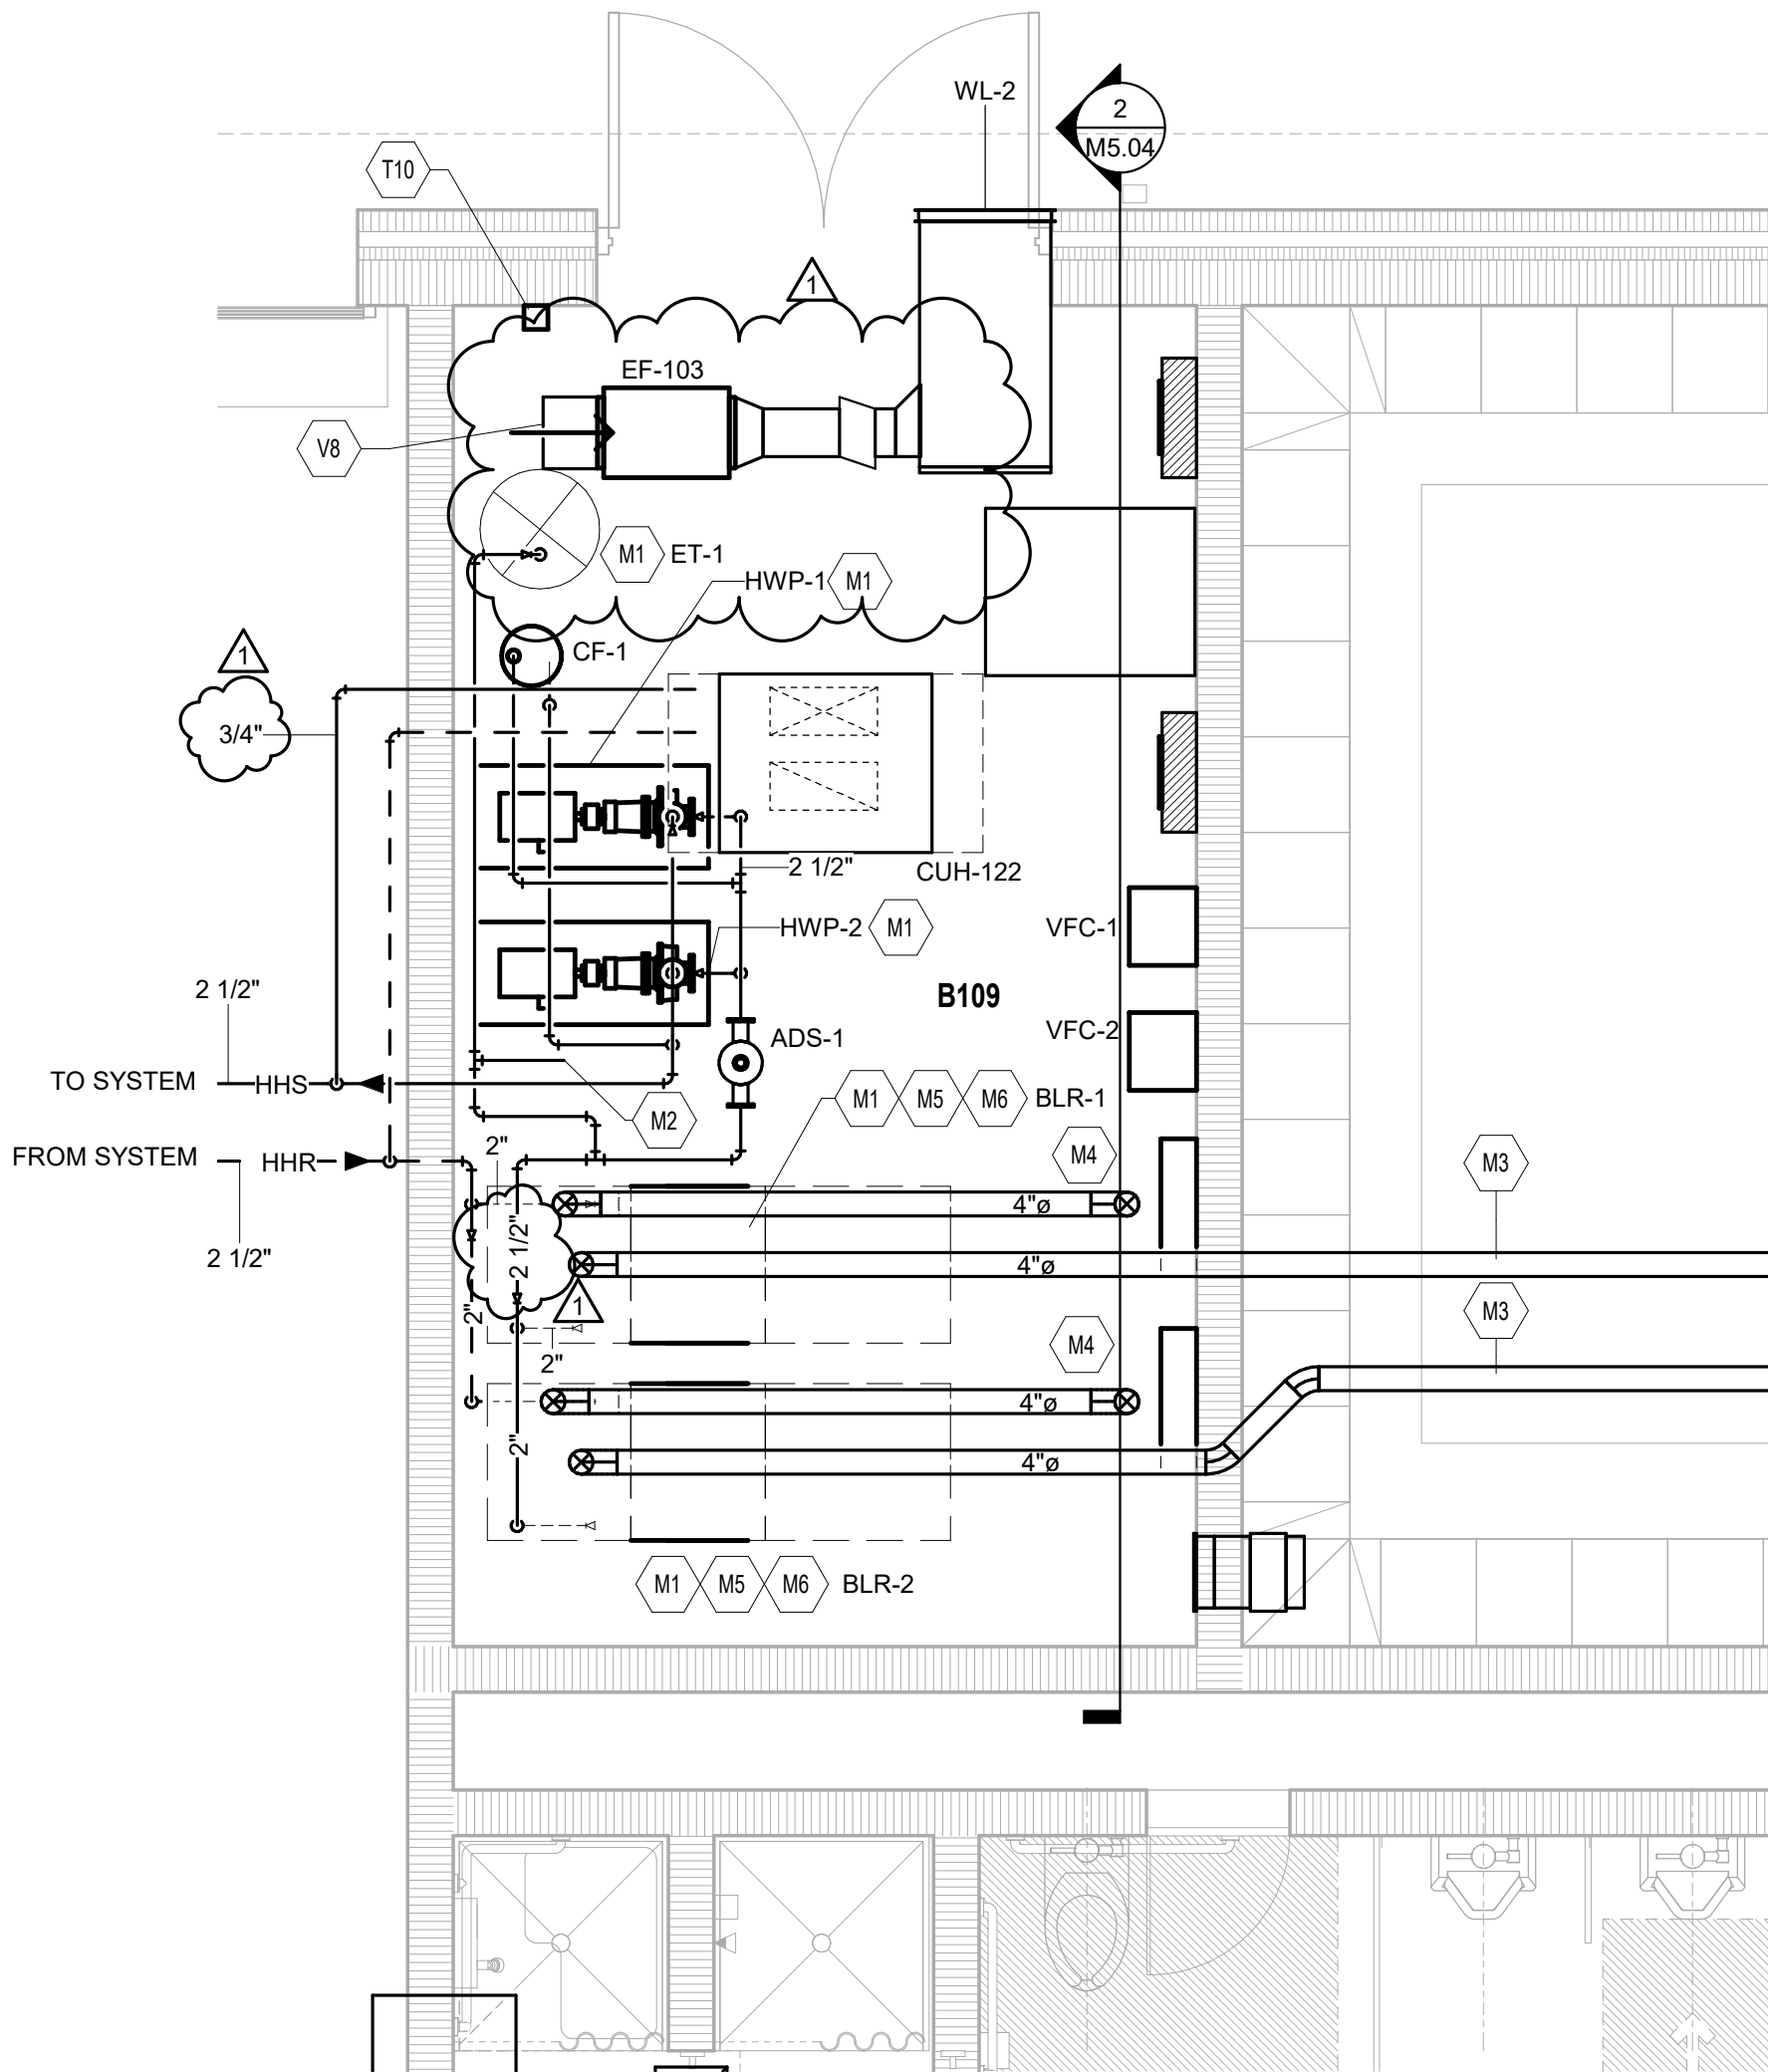

1 MECHANICAL ROOM PLAN
SCALE: 3/8" = 1'-0"

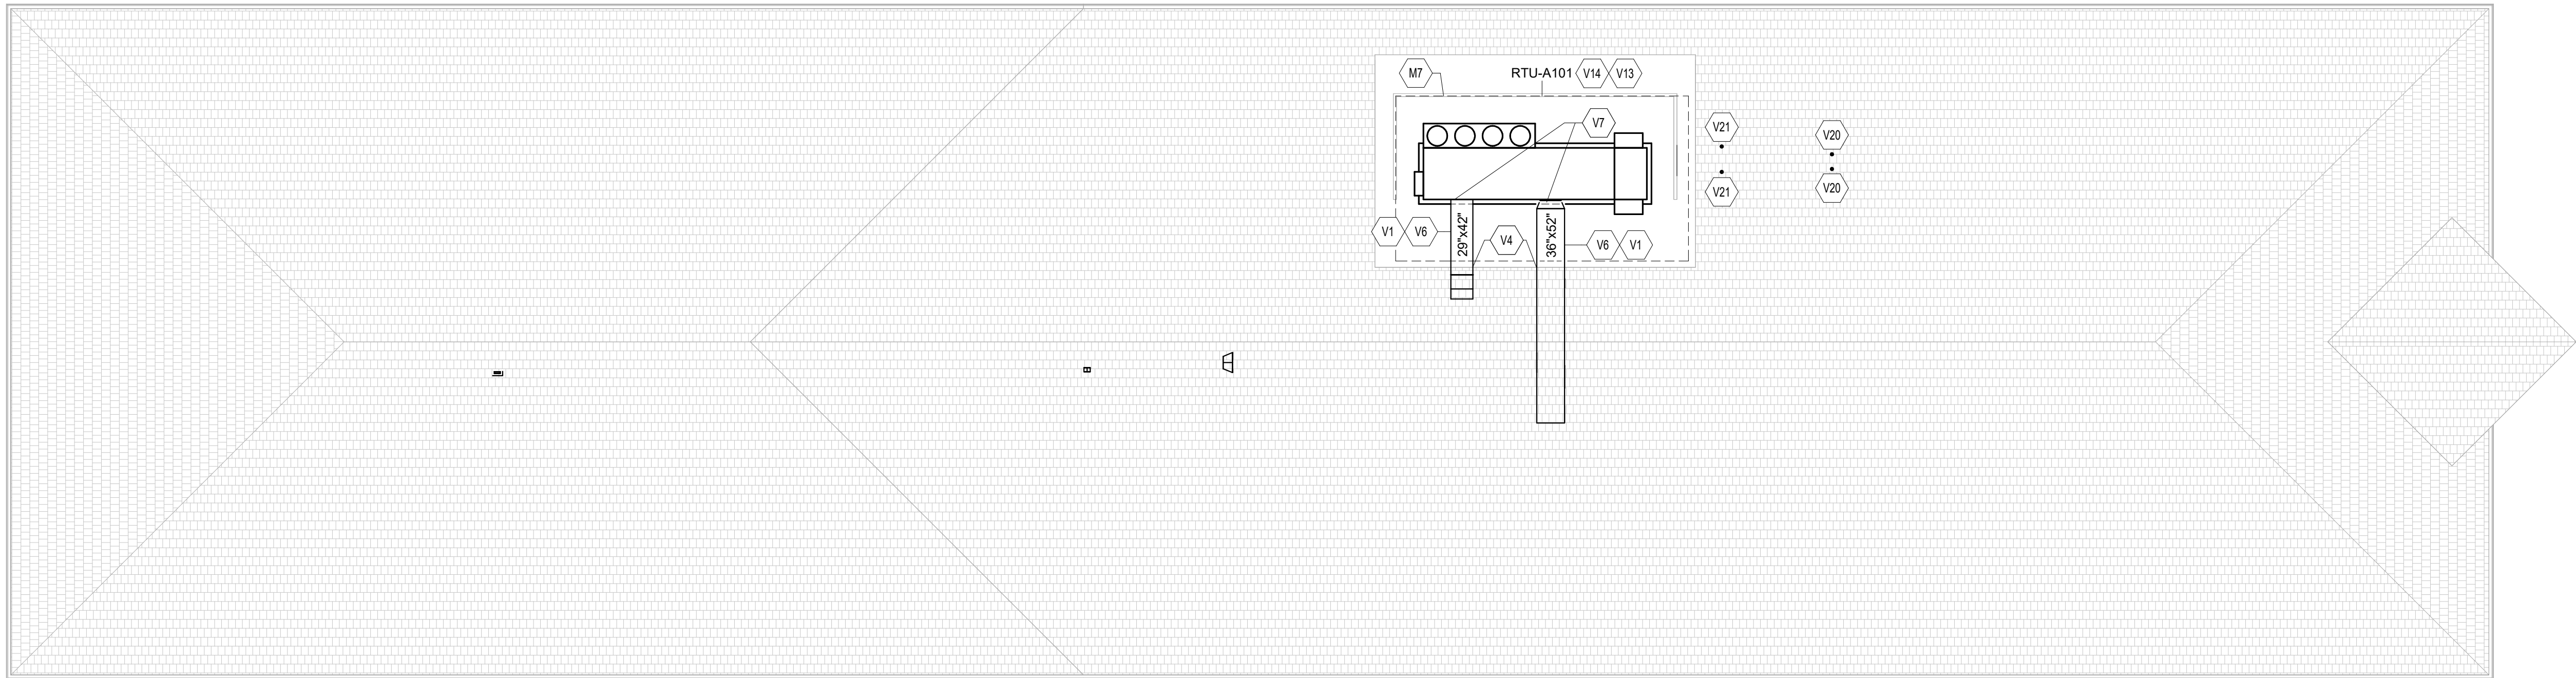

2 MECHANICAL ROOF PLAN
SCALE: 3/32" = 1'-0"

- MECHANICAL ROOM PLAN GENERAL NOTES
- A. ALL DUCTWORK, PIPING AND VALVES SHALL BE CONCEALED ABOVE THE CEILING AND WITHIN WALLS, UNLESS OTHERWISE NOTED.
- B. REFER TO THE SPECIFICATIONS FOR REQUIREMENTS RELATED TO EQUIPMENT QUALITY, CONSTRUCTION AND FINISH OF MATERIALS.
- C. ARRANGE DUCTWORK, PIPING, ETC. TO ALLOW FOR EASY ACCESS TO COILS, VALVES, DAMPERS AND CONTROLS. KEEP AREAS ADJACENT TO ACCESS PANELS FREE AND CLEAR OF ANY OBSTRUCTIONS.
- D. SEAL DUCT PENETRATIONS THROUGH THE FLOOR AND/OR WALLS IN ACCORDANCE WITH MECHANICAL CODE AND SMACNA REQUIREMENTS. SEAL DUCT PENETRATIONS THROUGH FIRE RATED FLOORS AND/OR WALLS WITH A MATERIAL HAVING SAME FIRE RATING AS THE WALL AND/OR FLOOR.
- E. MECHANICAL CONTRACTOR IS RESPONSIBLE FOR HIS RESPECTIVE WORK FOR REPAIRING AND PATCHING TO MATCH EXISTING SURFACES, SIDEWALKS, STREETS, FLOORS, WALLS, ROOFS, CEILING AND PAVEMENT.
- F. ALL RECTANGULAR SHEET METAL DUCT SIZES SHOWN ARE INSIDE FREE AREA DIMENSIONS. ALL ROUND DUCT SIZES SHOWN ARE INSIDE DIAMETERS.
- G. PROVIDE BALANCING DAMPER AT EACH DUCT BRANCH, SERVING DIFFUSER, GRILLE AND REGISTER.
- H. INSTALL WALL THERMOSTATS, TEMPERATURE SENSORS, HUMIDISTATS, ETC. 4' ABOVE THE FINISH FLOOR IN ACCORDANCE WITH ADA REQUIREMENTS.
- I. COORDINATE ALL REQUIRED WALL, ROOF AND FLOOR OPENINGS (BOTH DIMENSIONS AND LOCATIONS) WITH ALL OTHER TRADES.
- J. COORDINATE MECHANICAL SYSTEM INSTALLATION WITH STRUCTURE, FIRE PROTECTION AND LIGHTING LAYOUT.
- K. PROVIDE ALL NECESSARY TRANSITIONS TO EQUIPMENT FROM SIZES SHOWN ON PLAN.
- L. ALL RETURN/EXHAUST AIR DUCT ABOVE LOCKERS/SHOWER AREAS SHALL BE MADE OF ALUMINUM IN ACCORDANCE WITH SMACNA REQUIREMENTS.
- M. HYDRONIC SUPPLY AND RETURN PIPING SHALL BE THE SAME SIZE UNLESS OTHERWISE NOTED.

MECHANICAL ROOM PLAN NOTES
(ALL NOTES MAY NOT BE INDICATED ON THIS SHEET)

NO.	DESCRIPTION
M1	INSTALL EQUIPMENT ON 3-1/2" HIGH CONCRETE HOUSEKEEPING PAD. COORDINATE FINAL SIZE OF PAD ON SITE.
M2	CONNECTION POINT FOR MAKE-UP TO HEATING WATER SYSTEM. REFER TO DETAIL SHEET.
M3	FLUE PIPE SYSTEM FROM BOILER CONNECTION ROUTED UP ATTIC SPACE AND OUT THROUGH THE ROOF. FLUE PIPE SIZE AND INSTALLATION PER MANUFACTURER'S REQUIREMENTS. PROVIDE FIRE WRAPPING BETWEEN GYP CEILING AND EXTERIOR PENETRATION.
M4	SINGLE WALL STAINLESS STEEL INTAKE PIPE FROM THE BOILER CONNECTION TERMINATED THROUGH THE ROOF. INTAKE PIPE SIZE AND INSTALLATION PER MANUFACTURER'S REQUIREMENTS. PROVIDE FIRE WRAPPING BETWEEN GYP CEILING AND EXTERIOR PENETRATION.
M5	PRESSURE RELIEF VALVE. REFER TO BOILER MANUFACTURER FOR RECOMMENDED LOCATION. PIPE FULL SIZE TO FLOOR DRAIN. SUPPORT PIPING INDEPENDENTLY OF VALVE TO PREVENT STRESS AND ALLOW PROPER OPERATION.
M6	DRAIN PIPING WITH SHUT-OFF VALVE FROM BOILER TO FLOOR DRAIN. PIPE FULL SIZE TO FLOOR DRAIN.
M7	MANUFACTURER'S REQUIRED SERVICE CLEARANCE AROUND UNIT.
T10	APPROXIMATE LOCATION OF BOILER SHUT DOWN SWITCH PROVIDED AND INSTALLED BY TEMPERATURE CONTROL CONTRACTOR. COORDINATE WITH ELECTRICAL CONTRACTOR.
V1	EXTERIOR DUCTWORK TO BE INSULATED AND WRAPPED WITH JACKET PER SPECIFICATIONS.
V4	SEAL PENETRATIONS THROUGH THE EXTERIOR WALL WATER-TIGHT.
V6	IT IS THE RESPONSIBILITY OF THE CONTRACTOR TO HIRE AND DELEGATE THE DESIGN OF THE EXTERIOR DUCTWORK SUPPORTS TO AN ENGINEER. THIS SHALL BE DONE FOR ALL EXTERIOR DUCTWORK SYSTEMS. IT IS RECOMMENDED THAT SUPPORTS BE PLACED WITHIN 2' OF EACH ELBOW, 6" ON CENTER FOR STRAIGHT RUNS, AND FOR DUCTWORK EXTENDING VERTICALLY. HOWEVER, IT IS THE RESPONSIBILITY OF THE DELEGATED DESIGNER TO PROVIDE SUPPORTS AND FOUNDATION AS NECESSARY TO ENSURE THE DUCTWORK IS PROPERLY SUPPORTED AND ANCHORED. APPROXIMATE LOCATIONS ARE SHOWN, BUT ARE SUBJECT TO CHANGE BASED ON THE DESIGN COMPLETED BY THE ENGINEER Hired BY THE CONTRACTOR. COORDINATE FINAL LOCATIONS OF SUPPORTS WITH ALL OTHER TRADES.
V7	CONNECT DUCTWORK TO UNIT USING FLEXIBLE CONNECTORS.
V8	COVER OPENING WITH 1/2" WIRE MESH.
V19	ROUTE CONDENSATE DRAIN TO ADJACENT ROOF. SUPPORT PIPING AS NECESSARY. SEE CONDENSATE PIPING DETAIL ON SHEET M6.02. SIZE PER MANUFACTURER'S RECOMMENDATIONS.
V14	MOUNT UNIT ON 4" ROSE CURB PROVIDED BY UNIT MANUFACTURER.
V20	4" FLUE PIPE FOR BOILER UP THRU ROOF. SEE DETAIL SHEET.
V21	4" INTAKE PIPE FOR BOILER UP THRU ROOF. SEE DETAIL SHEET.

VERIFICATION NOTE

CONTRACTOR SHALL VERIFY ALL DIMENSIONS AND CLEARANCES AND ALL EXISTING FIELD CONDITIONS BEFORE STARTING CONSTRUCTION. COMMENCEMENT OF WORK CONSTITUTES ACCEPTANCE OF CONDITIONS.

SHOULD DIFFERENT CONDITIONS BE ENCOUNTERED, CONTACT THE ARCHITECT BEFORE PROCEEDING WITH WORK.

COPYRIGHT 2024 BY FANNINGHOWEY ASSOCIATES, INC.

ZIONSVILLE COMMUNITY HIGH SCHOOL STADIUM LOCKER BUILDING ADDITION AND RENOVATION

900 MULBERRY ST.
ZIONSVILLE IN, 46077





ARCHITECT

FANNING HOWEY

317.848.0966 WWW.FHAI.COM
350 E NEW YORK ST, SUITE #300, INDIANAPOLIS, IN 46204

CONSULTANT

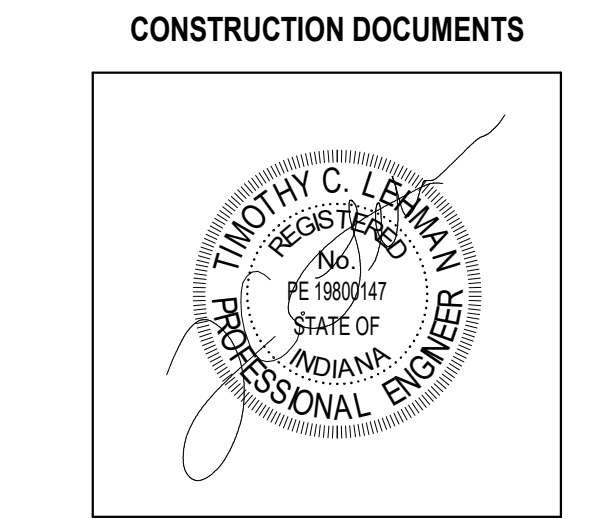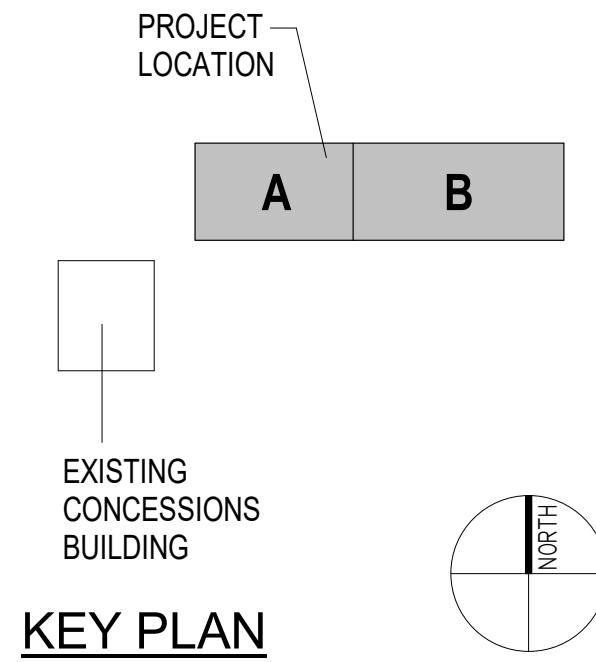

DRAWN BY: KPR

PROJECT NUMBER: 223139.00

PROJECT ISSUE DATE: 01.22.2024

REV. NO.	DESCRIPTION	DATE
1	ADDENDUM #1	2.14.2024

MECHANICAL ROOM AND ROOF PLAN

M4.01

		RTU/HEAT RECOVERY UNIT SCHEDULE																																																									
		FANS						EXHAUST/RELIEF						SUPPLY						EXHAUST								COOLING	DX COOLING COIL				COILS					GAS FIRED HEATING COIL										UNIT ELECTRIC							NOTES				
MARK	NOM. TON	CFM	O.A. CFM	EXT. S.P.	TOTAL S.P.	HP	TYPE	CFM	EXT. S.P.	TOTAL S.P.	HP	TYPE	CFM IN	CFM OUT	SUMMER		WINTER		CFM IN	CFM OUT	SUMMER		WINTER		HEAT WHEEL		EER/IEER		EAT	LAT	COOLING LOAD SENS.	TOTAL	APD	EAT	LAT	INPUT (MBH)	OUPUT (MBH)	APD	STAGES	VOLTAGE	FLA	MCA	MAX FUSE	SCCR	WEIGHT	MODEL NUMBER	BRAND												
															EAT	LAT	EAT	LAT			EAT	LAT	APD	H.P.																																			
RTU-A101	60	12,600	12,600	2.0	5.27	2x15	-	12,455	1.25	2.63	2x5	-	13,085	12,600	90.4	74.1	79.7	68.4	-1.0	-2.0	48.8	39.8	11,970	12,455	75.0	62.4	86.0	69.1	70.0	58.0	29.6	29.4	1.04	.25	10.0	79.7	68.3	50.6	50.2	331.5	617.2	0.52	48.8	79.4	500	405	0.46	10:1	460-3-60	169.3	176	200	65K	9,064	OAND720D4	TRANE	RTU-A101 NOTES		
NOTES: RTU-A101																																																											
1. FURNISH WITH MODULATING HOT GAS REHEAT AND HUMIDITY SENSOR FOR HUMIDITY CONTROL.												6. UNIT SHALL BE EQUIPPED WITH CLOGGED FILTER SWITCH.												12. UNIT MANUFACTURER TO PROVIDE SHORT CIRCUIT PROTECTION. SEE "SCCR" UNDER ELECTRICAL COLUMN IN SCHEDULE FOR RATING.												19. UNIT SHALL BE FURNISHED WITH MULTI-ZONE VAV CONTROL CAPABILITY. FURNISH WITH STATIC PRESSURE SENSOR.												SUMMER: INDOOR: 75° db/50% RH OUTDOOR: 90.4° db/74.1° wb											
2. FURNISH WITH DIGITAL SCROLL COMPRESSORS FOR MODULATING COOLING.												7. PROVIDE FACTORY MOUNTED CONVENIENCE OUTLET.												13. FURNISH UNIT WITH EXHAUST ISOLATION DAMPERS.												20. FURNISH WITH AIRFLOW MONITORING RING.												WINTER: INDOOR: 70.0° db OUTDOOR: -1.0° db											
3. FURNISH WITH BACNET CARD FOR INTEGRATION INTO BAS.												8. FURNISH WITH 2" MERV 8 PRE-FILTERS AND 4" MERV 13 FILTERS.												14. MAXIMUM FILTER FACE VELOCITY SHALL BE 500 FPM.												21. DISCHARGE TEMPERATURE SHALL BE SET TO 55°																							
4. VARIABLE FREQUENCY CONTROLLER (VFC) SHALL BE PROVIDED ON SUPPLY FAN AND EXHAUST FAN. VFC PROVIDED BY RTU MANUFACTURER.												9. TOTAL UNIT STATIC PRESSURE REFLECTS AVERAGE DIRTY FILTERS.												15. MAXIMUM COIL FACE VELOCITY SHALL BE 500 FPM.																																			
5. PROVIDE FACTORY MOUNTED 2 POSITION OUTDOOR AND RETURN AIR DAMPERS FOR BYPASS AROUND THE WHEEL DURING UNOCCUPIED MODE.												10. UNIT SHALL BE PLACED ON 14" ROOF CURB.												16. UNIT SHALL HAVE BYPASS DAMPERS AROUND WHEEL FOR FROST CONTROL.																																			
												11. UNIT TO BE SUPPLIED WITH FACTORY MOUNTED DISCONNECT SWITCH.												17. UNIT SHALL HAVE SINGLE POINT POWER CONNECTION.																																			
																								18. REFER TO SPECIFICATIONS.																																			

NOTES: RTU-A101

- FURNISH WITH MODULATING HOT GAS REHEAT AND HUMIDITY SENSOR FOR HUMIDITY CONTROL.
- FURNISH WITH DIGITAL SCROLL COMPRESSORS FOR MODULATING COOLING.
- FURNISH WITH BACKNET CARD FOR INTEGRATION INTO BAS.
- VARIABLE FREQUENCY CONTROLLER (VFC) SHALL BE PROVIDED ON SUPPLY FAN AND EXHAUST FAN. VFC PROVIDED BY RTU MANUFACTURER.
- PROVIDE FACTORY MOUNTED 2 POSITION OUTDOOR AND RETURN AIR DAMPERS FOR BYPASS AROUND THE WHEEL DURING UNOCCUPIED MODE.
- UNIT SHALL BE EQUIPPED WITH CLOGGED FILTER SWITCH.
- PROVIDE FACTORY MOUNTED CONVENIENCE OUTLET.
- FURNISH UNIT WITH EXHAUST PRE-FILTERS AND 4" MERV 13 FILTERS.
- TOTAL UNIT STATIC PRESSURE REFLECTS AVERAGE DIRTY FILTERS.
- UNIT SHALL BE PLACED ON 14" ROOF CURB.
- UNIT TO BE SUPPLIED WITH FACTORY MOUNTED DISCONNECT SWITCH.
- UNIT MANUFACTURER TO PROVIDE SHORT CIRCUIT PROTECTION. SEE "SCCR" UNDER ELECTRICAL COLUMN IN SCHEDULE FOR RATING.
- FURNISH UNIT WITH EXHAUST ISOLATION DAMPERS.
- MAXIMUM FILTER FACE VELOCITY SHALL BE 500 FPM.
- MAXIMUM COIL FACE VELOCITY SHALL BE 500 FPM.
- UNIT SHALL HAVE BYPASS DAMPERS AROUND WHEEL FOR FROST CONTROL.
- UNIT SHALL HAVE SINGLE POINT POWER CONNECTION.
- REFER TO SPECIFICATIONS.
- UNIT SHALL BE FURNISHED WITH MULTI-ZONE VAV CONTROL CAPABILITY. FURNISH WITH STATIC PRESSURE SENSOR.
- FURNISH WITH AIRFLOW MONITORING RING.
- DISCHARGE TEMPERATURE SHALL BE SET TO 55°

SUMMER:
INDOOR: 75° db/50% RH
OUTDOOR: 90.4° db/74.1° wb
WINTER:
INDOOR: 70.0° db
OUTDOOR: -1.0° db

HYDRONIC EXPANSION TANK SCHEDULE									
MARK	IDENTITY DATA	MANUFACTURER	MODEL	TYPE	VOLUME	TANK SIZE	WEIGHT	NOTES	
ET-1	MANUFACTURER	TACO	CA90-125	HEATING WATER	23.0 gal	DIA. 20"	LENGTH 29"	120	1.2

- NOTES:
- MOUNT ON 3-1/2" CONCRETE HOUSEKEEPING PAD.
 - REFER TO PROJECT MANUAL.
 - MANUFACTURED IN ACCORDANCE WITH ASME VIII

WALL LOUVER SCHEDULE									
MARK	SIZE WxH	FLOW	PRESSURE DROP	BOTTOM ELEVATION	TYPE	SYSTEM	MODEL	NOTES	

- NOTES:
- REFER TO PROJECT MANUAL SECTION 089119.
 - SEAL ALL AROUND WITH SILICONE.
 - REFER TO INSTALLATION DETAILS ON MECHANICAL AND ARCHITECTURAL DRAWINGS.
 - CUSTOM COLOR AS SELECTED BY ARCHITECT/ENGINEER. REFER TO SECTION 089119.
 - COORDINATE SIZE AND LOCATION WITH ALL TRADES.
 - N/A

EXHAUST FAN SCHEDULE																	
MARK	Manufacturer	Model	Description	Air Flow	External SP	Fan RPM	Inlet Sones	Drive Type	Motor Size	BHP	Voltage	Operating Frequency	Phase Number	Fan Control	Comments		

- NOTES:
- FURNISH WITH FACTORY MOUNTED AND WIRED DISCONNECT SWITCH.
 - FURNISH WITH VG MOTOR FOR FAN SPEED CONTROL. WITH DIAL ON FAN.
 - REFER TO SPECIFICATION SECTION 233423 FOR ADDITIONAL REQUIREMENTS.
 - ALL FAN MODELS SPECIFIED AS MANUFACTURED BY GREENHECK.
 - SUPPORT FROM STRUCTURE ABOVE WITH THREADED ROD AND VIBRATION ISOLATORS.
 - FURNISH WITH BACKDRAFT DAMPER.

KEY:
A AUTOMATIC OPERATION BY REVERSE ACTING THERMOSTAT.
D TIMER SWITCH BY DIVISION 26.

DIFFUSER, REGISTER AND GRILLE SCHEDULE									
MARK	TYPE	EXAMPLE MANUFACTURER MODEL NO.	NECK SIZE (IN)	DIFFUSER SIZE LxW (IN)	MAX CORE/NECK VEL.(FPM)	MAX CFM	MAX NC	FRAME/MOUNTING	REMARKS


- NOTES:
- COLOR BY ARCHITECT/ENGINEER.
 - 4-WAY BLOW DIFFUSERS UNLESS INDICATED OTHERWISE ON DRAWINGS.
 - BLADES SHALL BE 35° DEFLECTION.
 - PROVIDE ALUMINUM SURFACE MOUNT BORDER FOR DUCTED INSTALLATIONS.

CABINET UNIT HEATER SCHEDULE														
MARK	CFM	FAN SPEED (RPM)	HP	HEATING 140°F EWT				COIL ROWS	ELEC	MCA	MODEL	NOTES		

- NOTES:
- STANDARD COLOR AS SPECIFIED BY ARCHITECT.
 - INCLUDE FACTORY MOUNTED DISCONNECT.
 - UNIT SCHEDULED WITH BOTTOM SUPPLY AND BOTTOM RETURN.
 - UNIT SCHEDULED AS MANUFACTURED BY TRANE.
 - UNIT SHALL BE PROVIDED WITH CEILING TRIM KIT.
 - SUPPORT UNIT HEATER FROM STRUCTURE ABOVE WITH MINIMUM OF FOUR (4) 3/8" DIAMETER THREADED RODS AND VIBRATION ISOLATORS.
 - REFER TO SPECIFICATION SECTION 238239.
 - HORIZONTAL CEILING RECESSED UNIT.
 - UNIT SHALL BE CEILING MOUNTED.

VARIABLE AIR VOLUME TERMINAL UNIT SCHEDULE																	
MARK	MAX PRIMARY CFM	MIN PRIMARY CFM	INLET DIA.	WATER HEAT (140°F EWT)				COIL ROWS	MANUFACTURER	MODEL	NOTES						

- NOTES:
- UNIT MANUFACTURER SHALL PROVIDE REQUIRED HANGING BRACKETS TO PROPERLY SUPPORT UNIT.
 - HEATING COIL DESIGN BASED ON HIGH-EFFICIENCY HOT WATER COIL.
 - HEATING COIL LOADS CALCULATED WITH 140 DEG EWT AND 55 DEG EAT. MIN. 90 DEG LAT @ TOTAL PRIMARY AIR FLOW. APD TO BE BELOW 0.6 INCHES H2O.
 - REFER TO PROJECT MANUAL FOR ADDITIONAL REQUIREMENTS.
 - UNIT SELECTION MUST ALLOW FOR A MINIMUM OF 0.5" DOWNSIDE STATIC PRESSURE.
 - COILS SHALL BE SELECTED WITH 5" WPD MAXIMUM.
 - DIVISION 26 CONTRACTOR TO SUPPLY 120V/1 POWER TO EACH VAV TERMINAL FOR CONTROL. POWER. UNIT SHALL BE PROVIDED WITH FACTORY INSTALLED 120V/24V TRANSFORMER.
 - PROVIDE NUMBER OF COIL ROWS AS REQUIRED TO MEET MBH. COILS MAY REQUIRE 4-ROW.
 - CONTRACTOR TO CONFIRM LEFT HAND OR RIGHT HAND ORIENTATION PRIOR TO PURCHASE.
 - PROVIDE WITH FACTORY MOUNTED DISCONNECT.
 - MOUNT AT HEIGHT SUCH THAT THE MANUFACTURER'S CLEARANCES ARE MAINTAINED.

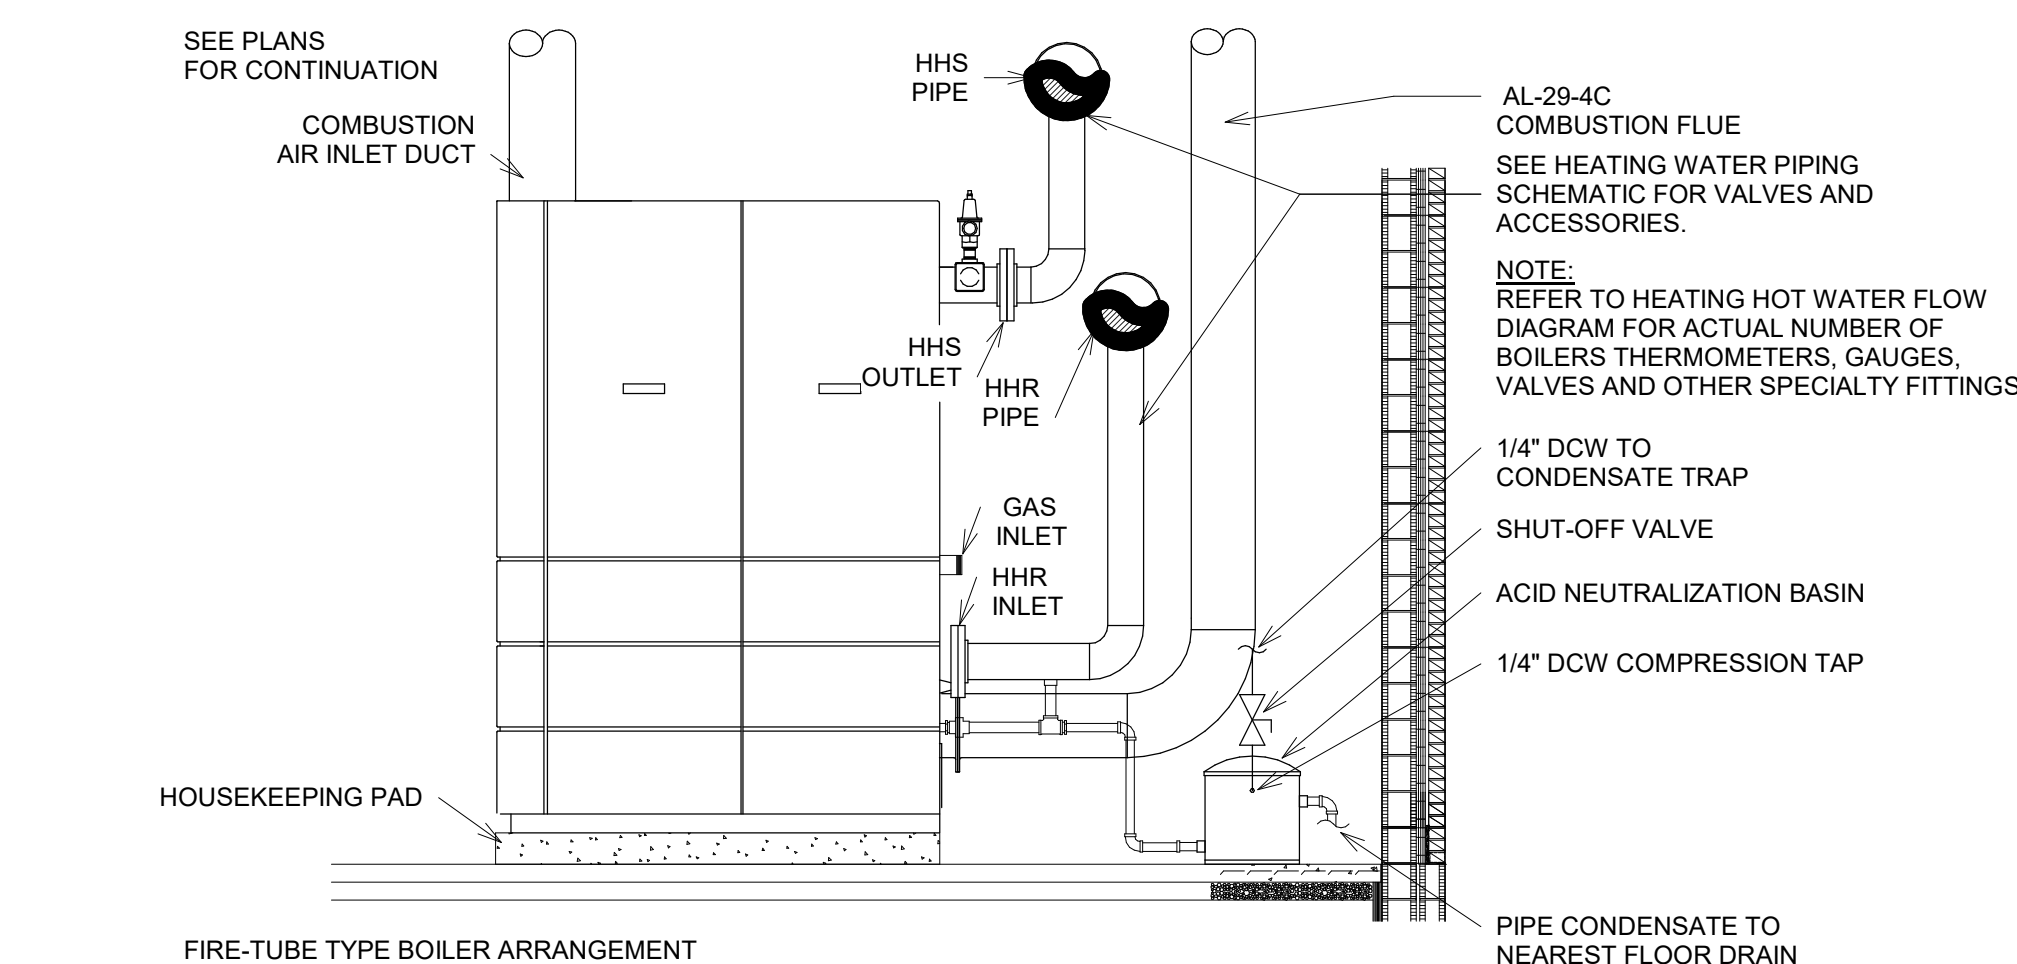

1 HEATING HOT WATER CONDENSING BOILER INSTALLATION DETAIL (ELEVATION)

N.T.S.

HEATING BOILER SCHEDULE												
IDENTITY DATA				HEATING WATER FLOW				HEATING CAPACITY		ELECTRICAL DATA		
MARK	MANUFACTURER	MODEL	WEIGHT (LBS)	TYPE	DESIGN (GPM)	EWT (°F)	LWT (°F)	ΔT (°F)	WPD (RH2 O)	INPUT	OUTPUT	EFF. η

- NOTES:
- INSTALL EQUIPMENT ON 3-1/2" HIGH CONCRETE HOUSEKEEPING PAD.
 - PROVIDE MODULATING BURNER WITH MINIMUM 7:1 TURNDOWN.
 - SINGLE POINT POWER CONNECTION.
 - REFER TO PROJECT MANUAL.
 - ELECTRICAL REQUIREMENTS VARY BY UNIT MANUFACTURER.

AIR/DIRT SEPARATOR SCHEDULE						
MARK	SYSTEM SERVED	SIZE	GPM	MAX. P.D. (FT)	MANUFACTURER	MODEL NO.

- NOTES:
- SUPPORT FROM STRUCTURE ABOVE.
 - REFER TO PROJECT MANUAL.

CHEMICAL SHOT FEEDER SCHEDULE		
MARK	VOLUME	NOTES


- NOTES:
- REFER TO PROJECT MANUAL.
 - INCLUDE LEG SUPPORT.
 - EQUIPMENT TO BE FLOOR MOUNTED.

HYDRONIC PUMP SCHEDULE									
IDENTITY DATA			PERFORMANCE DATA				ELECTRICAL DATA		
MARK	WEIGHT (LBS)	TYPE	FLOW RATE (GPM)	HEAD (RH20)	NPSH	HP	PUMP EFF. (%)	ELECTRICAL	NOTES

- NOTES:
- BASED ON TACO.
 - MOUNT ON 3 1/2" CONCRETE HOUSEKEEPING PAD.
 - SINGLE POINT POWER CONNECTION.
 - PUMP DISCONNECT AND WIRING BETWEEN PUMP AND VFD BY DIVISION 26
 - REFER TO PROJECT MANUAL.
 - PUMP CONTROLLED BY VARIABLE FREQUENCY CONTROLLER.


VARIABLE FREQUENCY CONTROLLER SCHEDULE						
MARK	EQUIPMENT SERVING	MARK SERVING	HP	ELECTRICAL SERVICE	NOTES	

- NOTES:
- DRIVE PROVIDED AND INSTALLED BY THE DIVISION 23 - HVAC CONTRACTOR.
 - DIVISION 26 - ELECTRICAL CONTRACTOR TO PROVIDE POWER WIRING TO VFC AND FROM VFC TO MOTOR(S).
 - TEMPERATURE CONTROL CONTRACTOR SHALL PROVIDE ALL TEMPERATURE CONTROL WIRING.
 - REFER TO SPECIFICATION SECTION 233923.
 - PROVIDE WITH A FACTORY MOUNTED DISCONNECT.

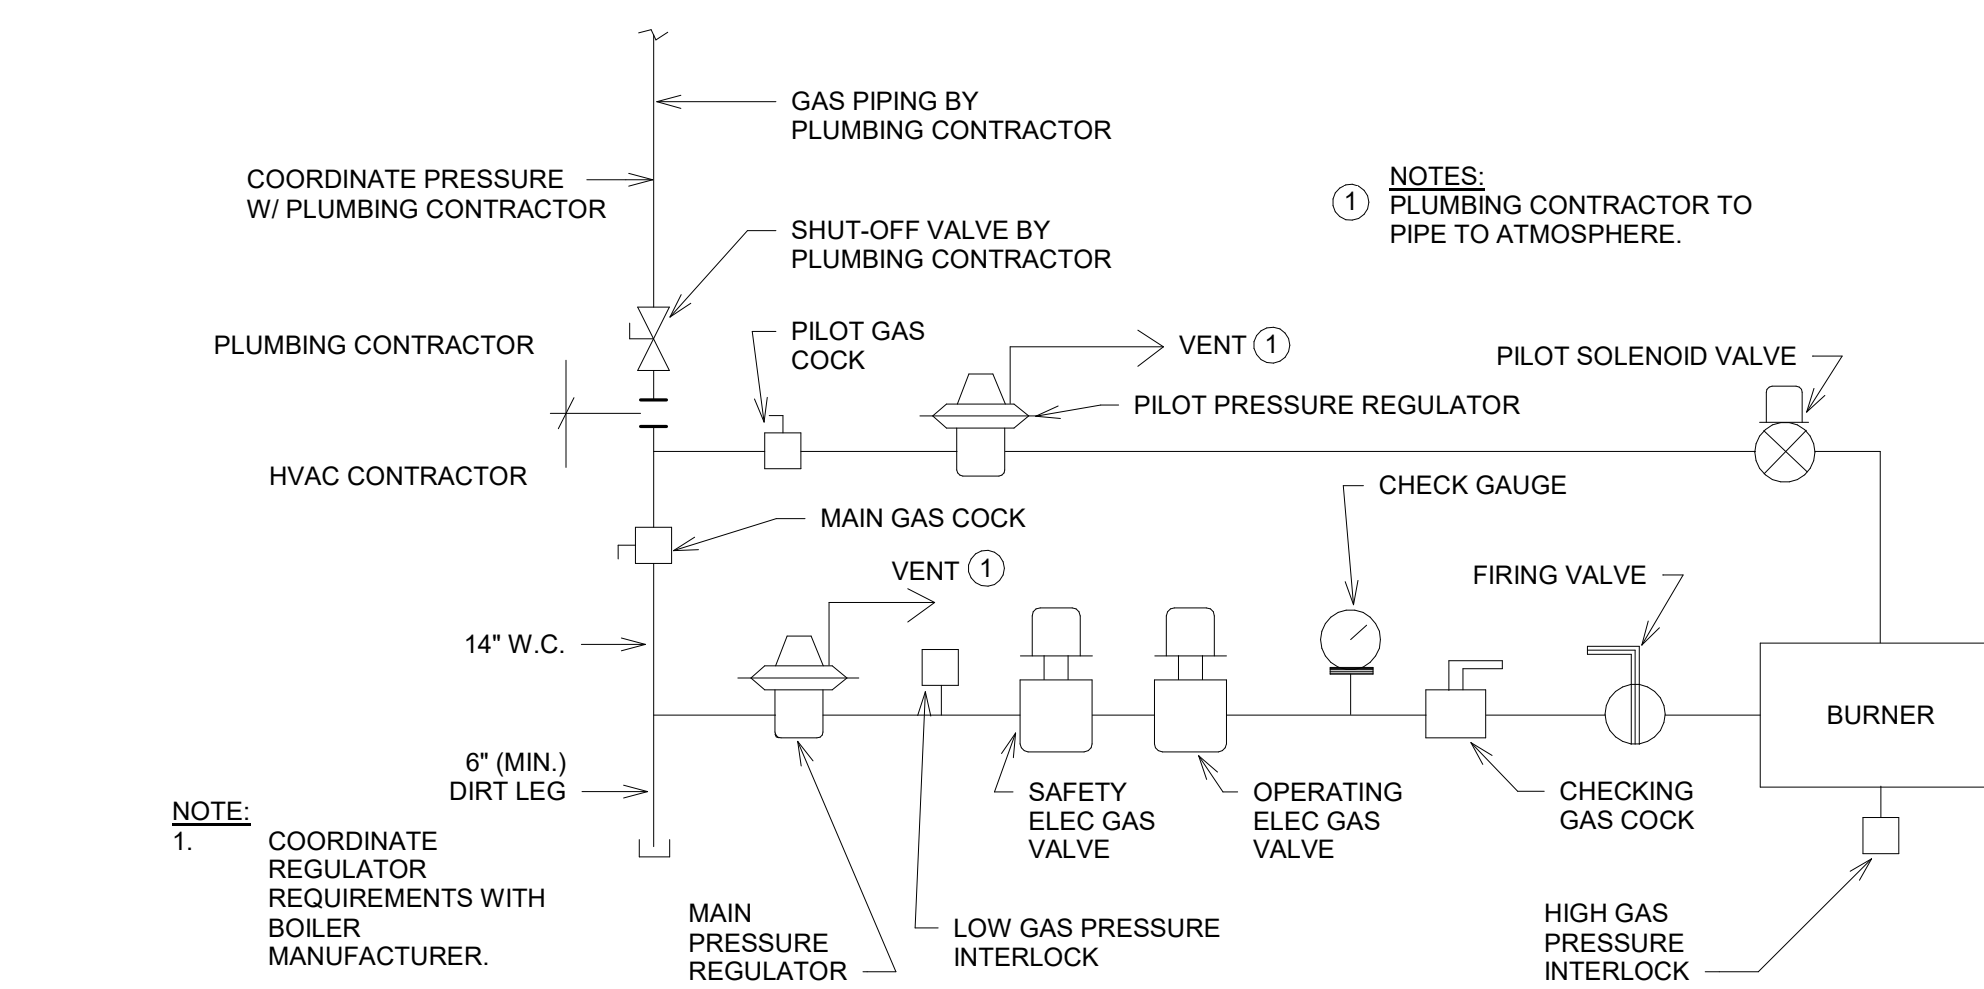


2 BOILER GAS TRAIN PIPING DIAGRAM

N.T.S.

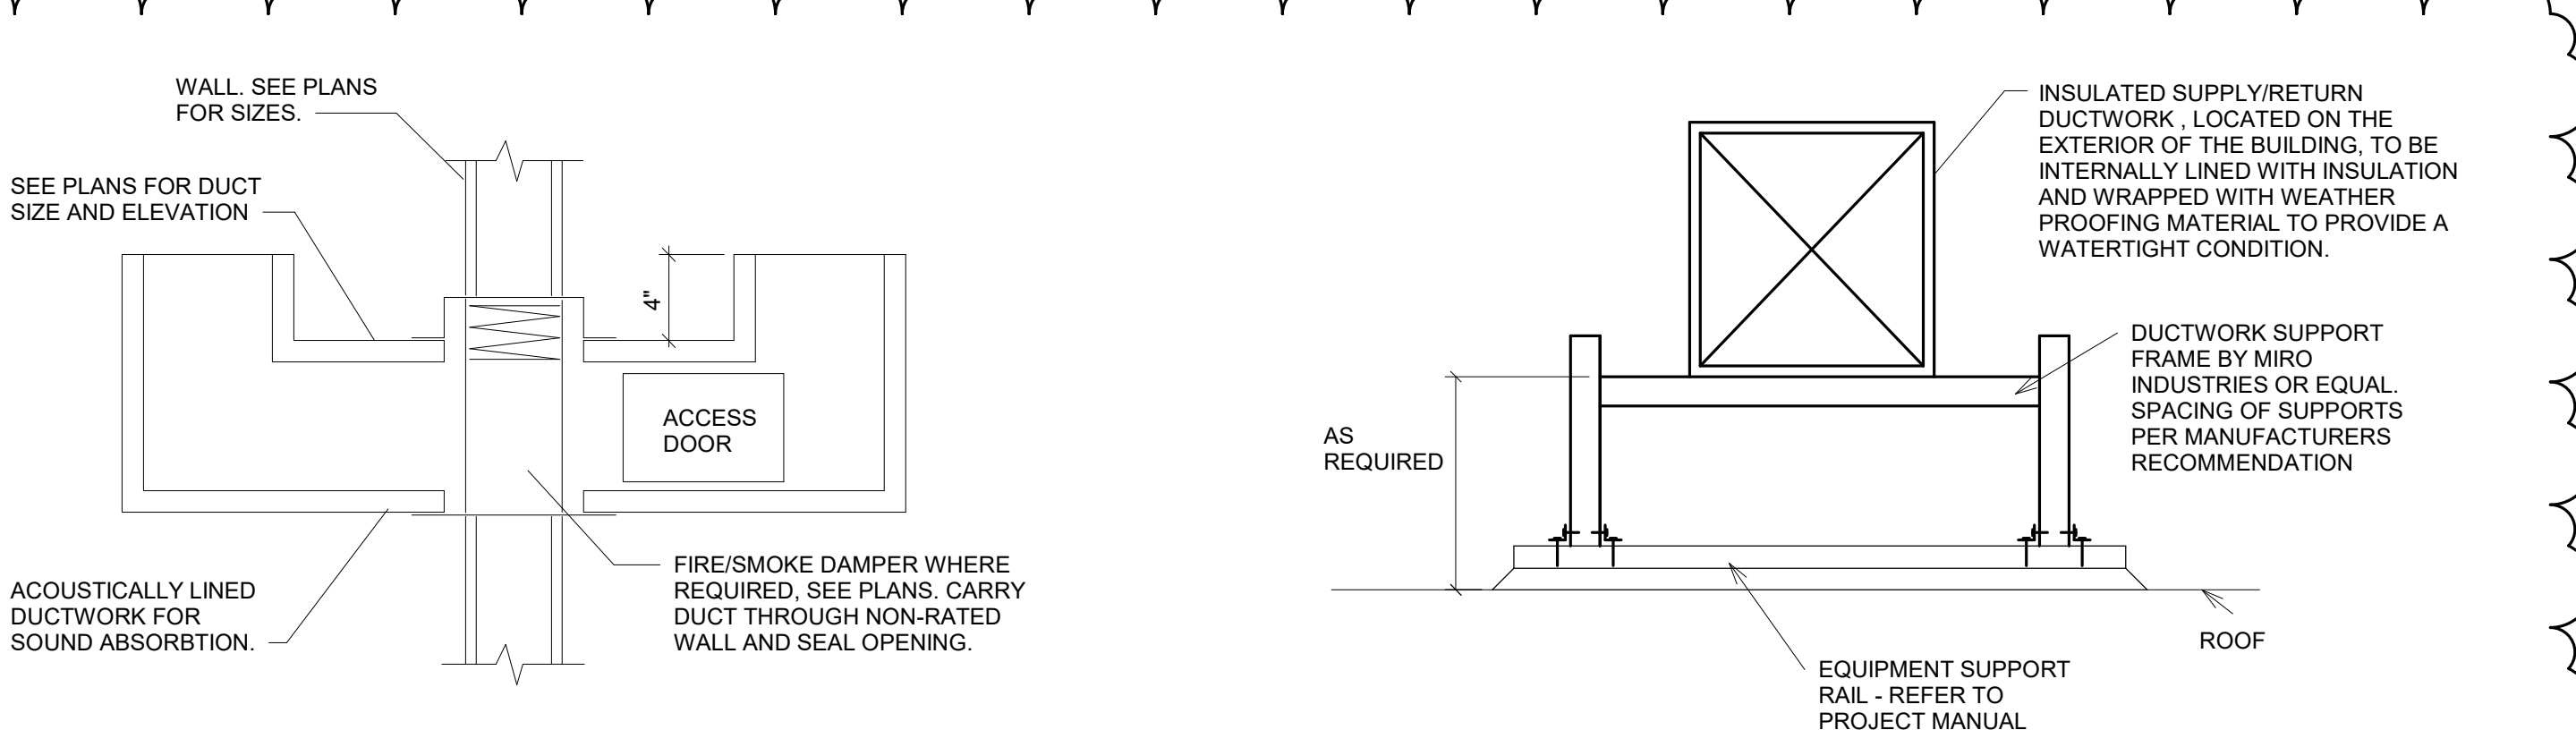

3 RETURN AIR SOUND TRAP DETAIL (F/S DAMPER)

N.T.S.

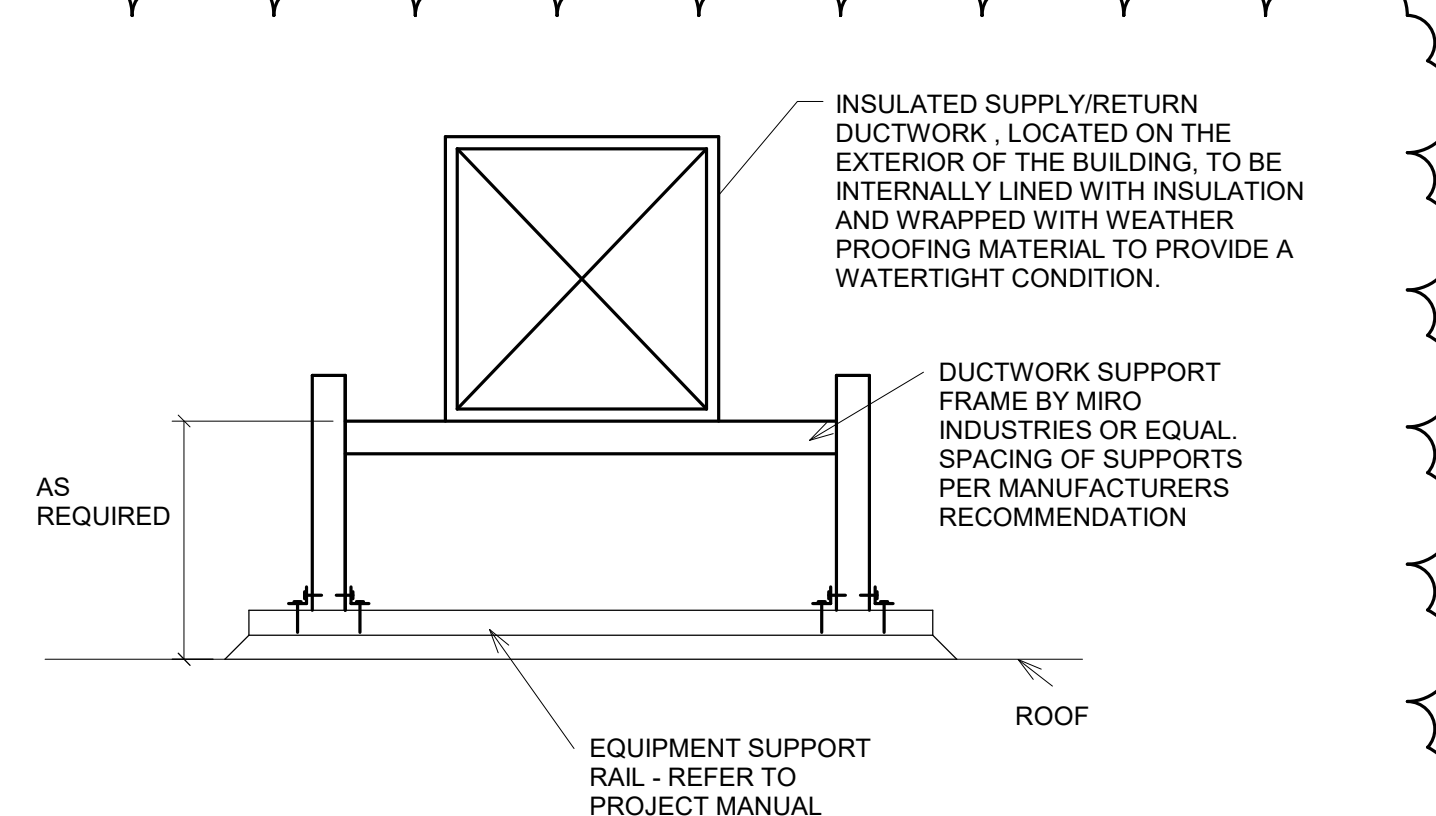

4 OUTDOOR PIPING SUPPORT DETAIL

N.T.S.

ZIONSVILLE COMMUNITY HIGH SCHOOL STADIUM LOCKER BUILDING ADDITION AND RENOVATION

900 MULBERRY ST.
ZIONSVILLE IN, 46077

ZIONSVILLE COMMUNITY SCHOOLS



Zionsville
Community Schools

ARCHITECT

FANNING HOWEY

317.848.0966
350 E NEW YORK ST, SUITE #300, INDIANAPOLIS, IN 46204

CONSULTANT

CONSTRUCTION DOCUMENTS



DRAWN BY: KPR

PROJECT NUMBER: 223139.00

PROJECT ISSUE DATE: 01/22/2024

REV. NO.	DESCRIPTION	DATE
----------	-------------	------

1	ADDENDUM #1	2.14.2024
---	-------------	-----------

MECHANICAL SCHEDULES AND DETAILS

M5.01

ZIONSVILLE COMMUNITY HIGH SCHOOL STADIUM LOCKER BUILDING ADDITION AND RENOVATION

900 MULBERRY ST.
ZIONSVILLE IN, 46077

ZIONSVILLE COMMUNITY SCHOOLS



ZIONSVILLE
Community Schools

ARCHITECT

FANNING HOWEY

317.848.0966

WWW.FHAI.COM

350 E NEW YORK ST, SUITE #300, INDIANAPOLIS, IN 46204

CONSULTANT

CONSTRUCTION DOCUMENTS



DRAWN BY: KPR


PROJECT NUMBER: 23139.00

PROJECT ISSUE DATE: 01.22.2024


REV. NO.	DESCRIPTION	DATE
1	ADDENDUM #1	2.14.2024

MECHANICAL DETAILS


M5.02

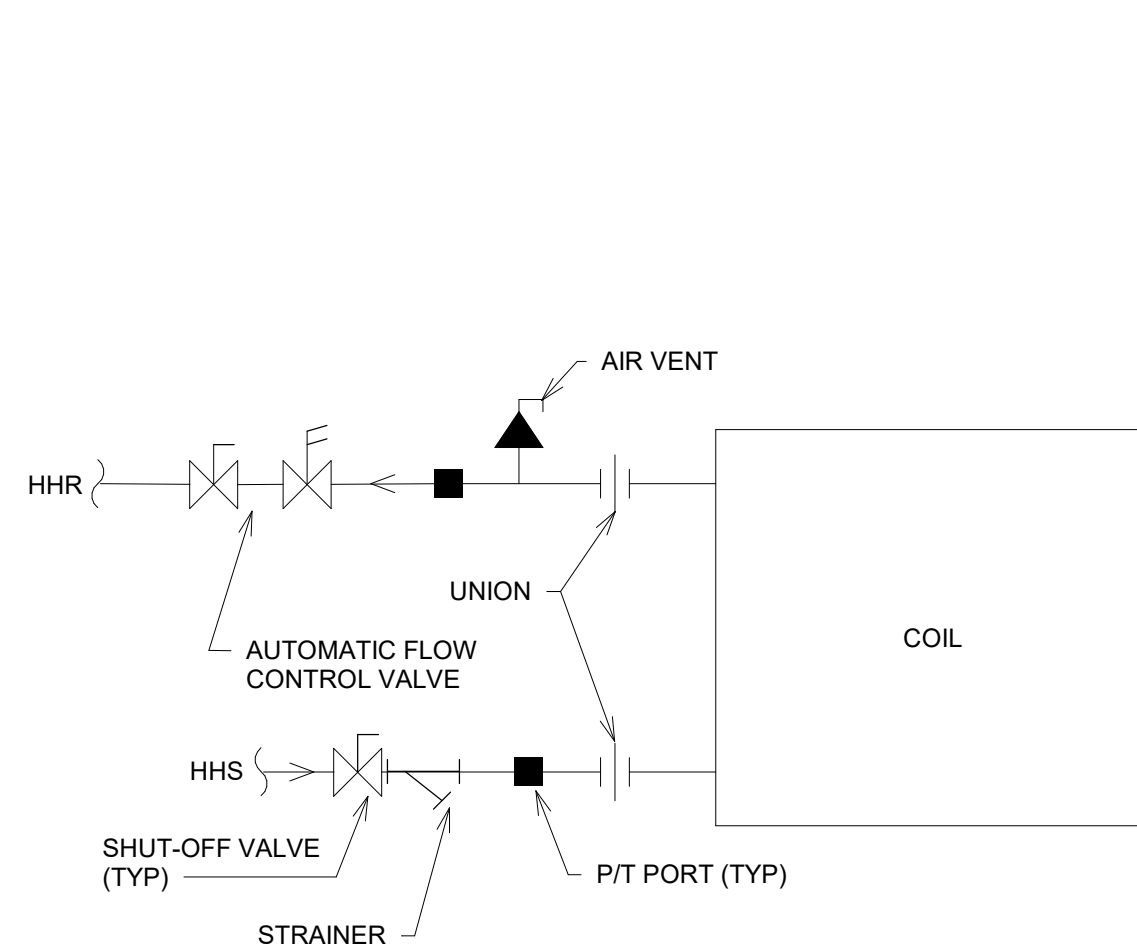


1
N.T.S.
CABINET HEATER COIL PIPING DIAGRAM

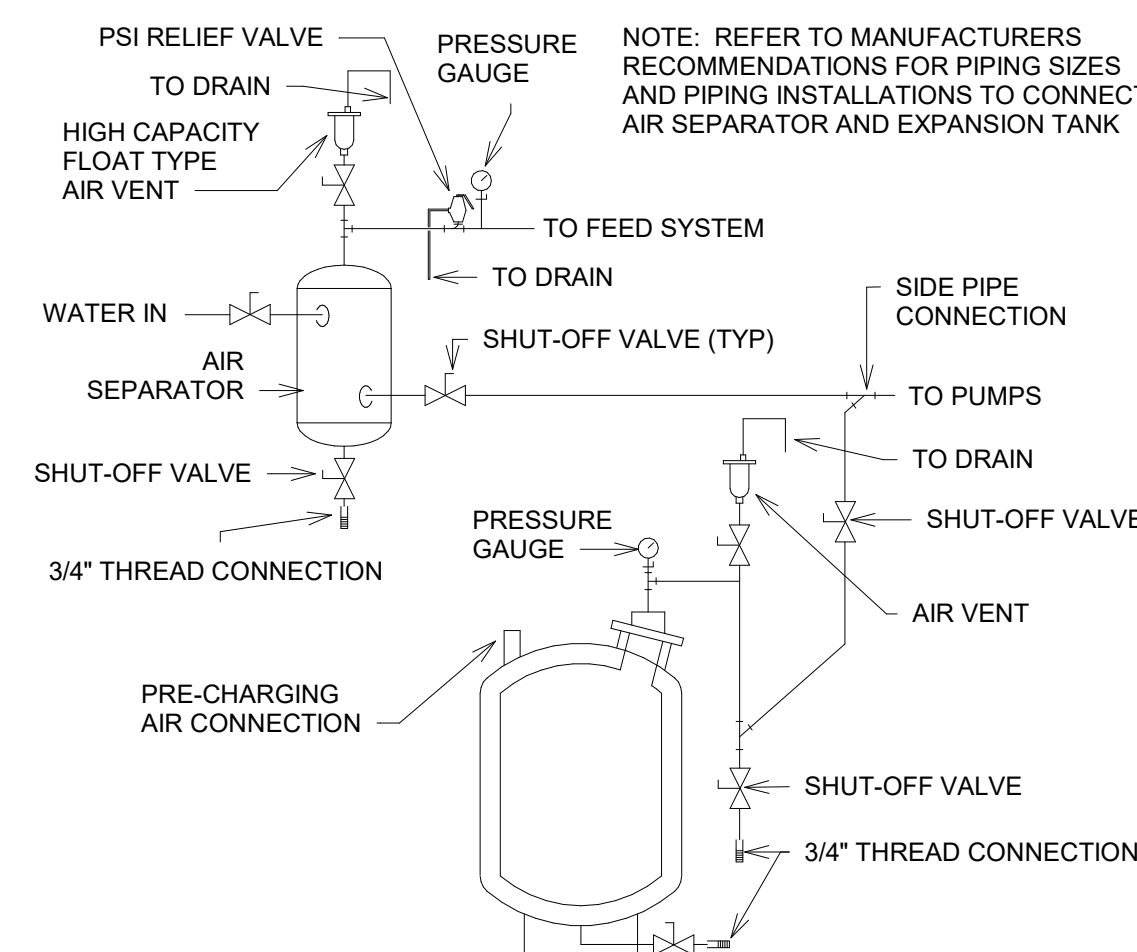


2
N.T.S.
AIR SEPARATOR/EXPANSION TANK PIPING DIAGRAM

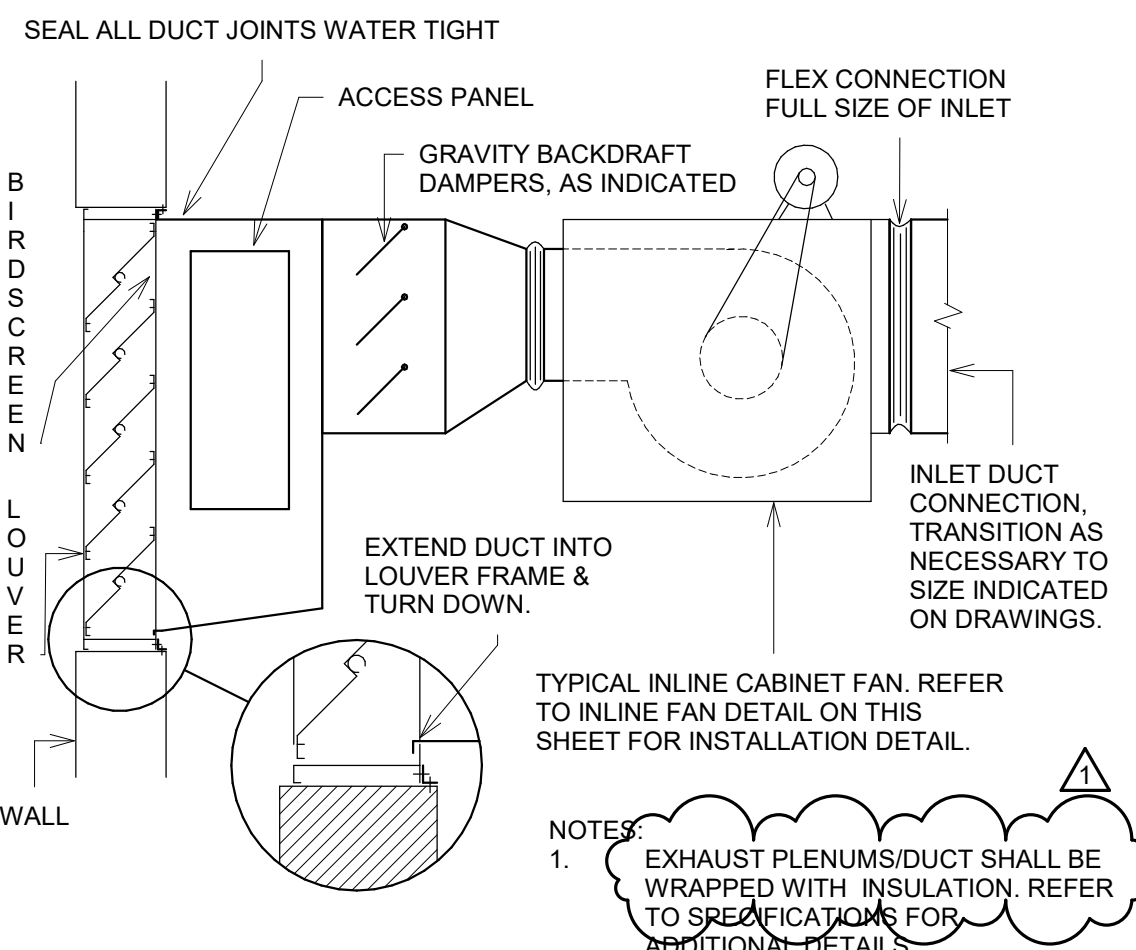


3
N.T.S.
EXHAUST LOUVER DETAIL

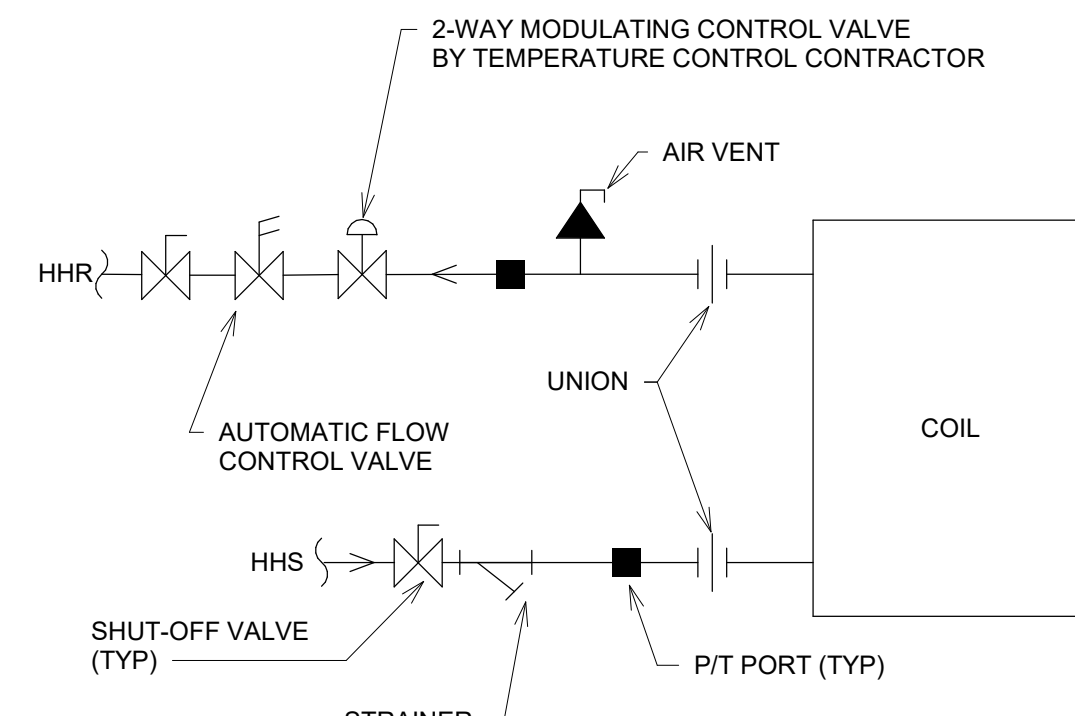


4
N.T.S.
VAV/VVR COIL PIPING DIAGRAM (TWO-WAY VALVE)

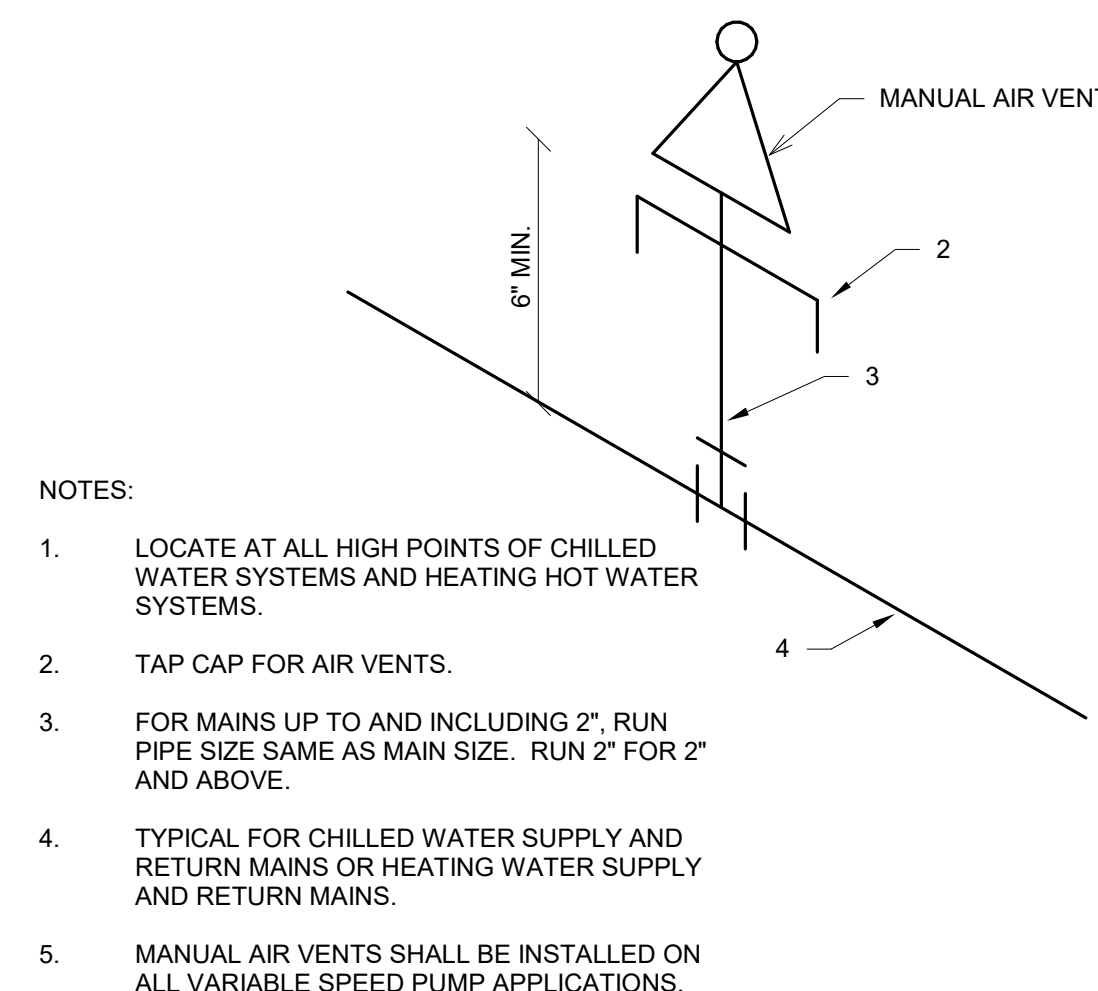


5
N.T.S.
MANUAL AIR VENT

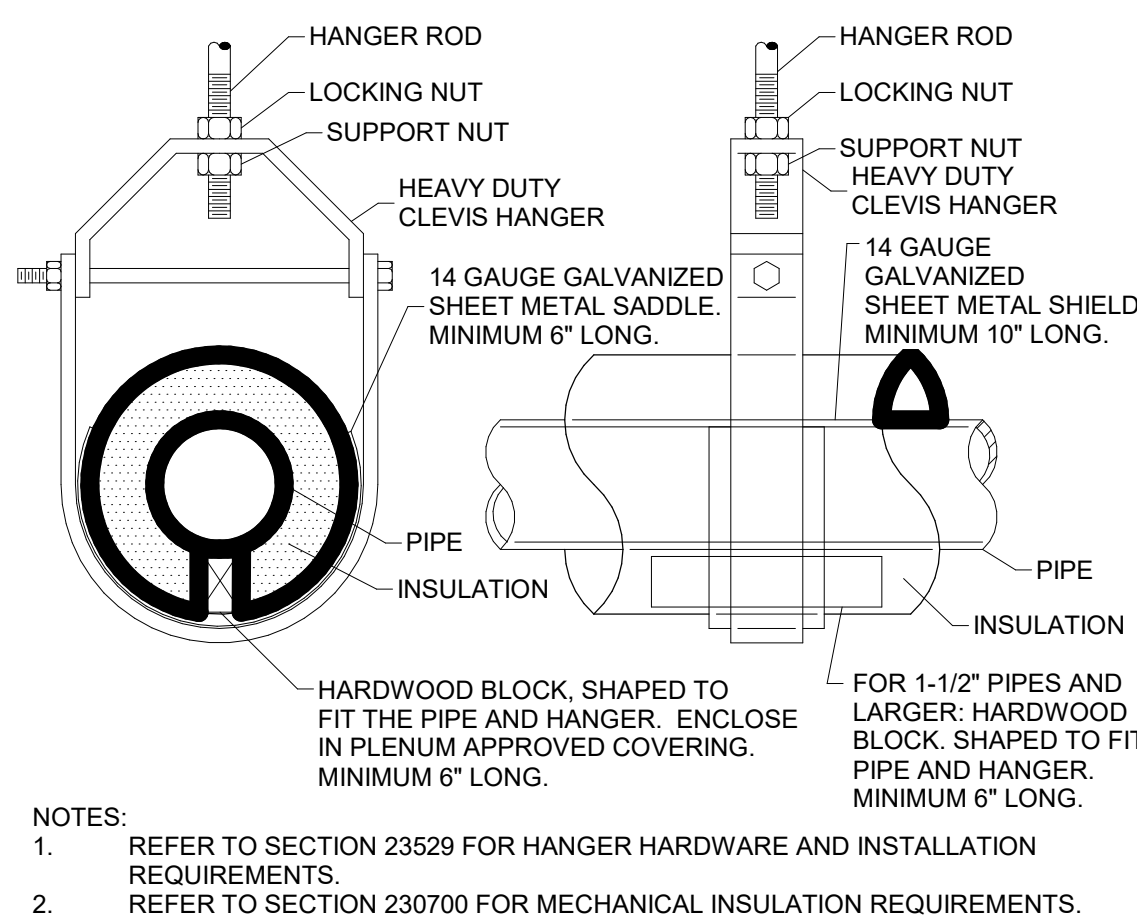


6
N.T.S.
PIPE HANGERS (6\"/>

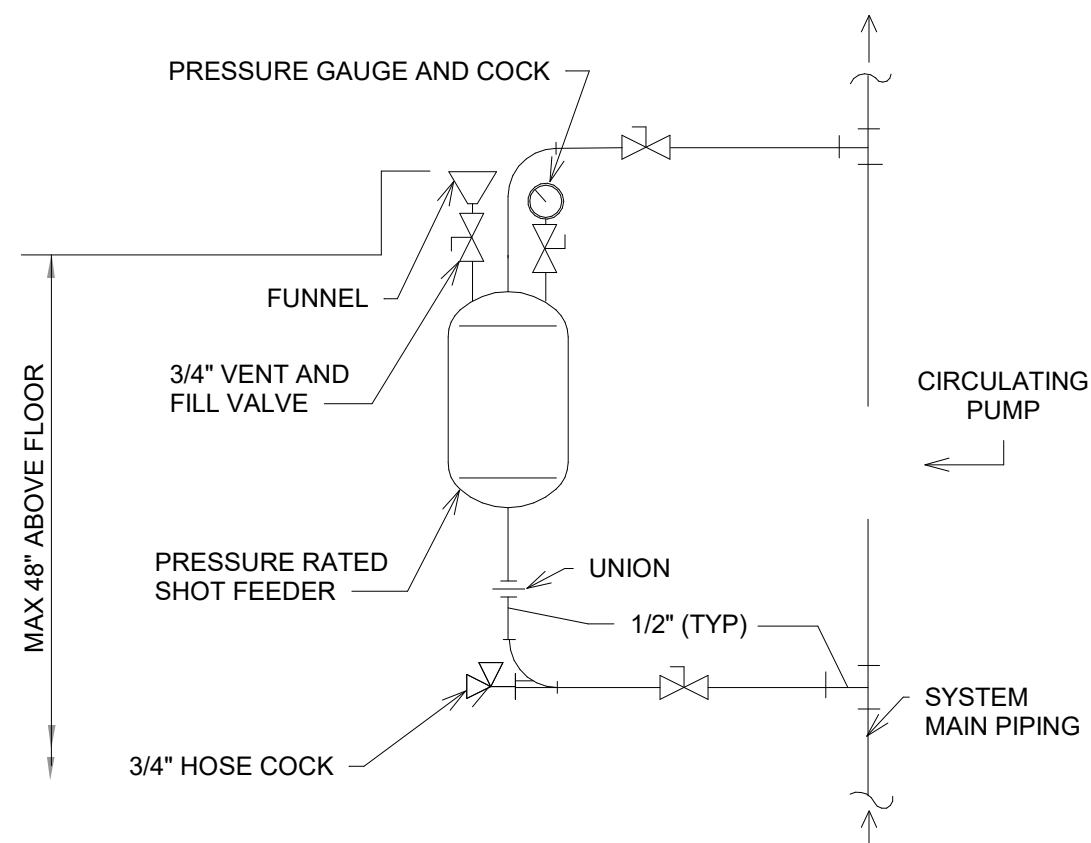


7
N.T.S.
CHEMICAL SHOT FEEDER

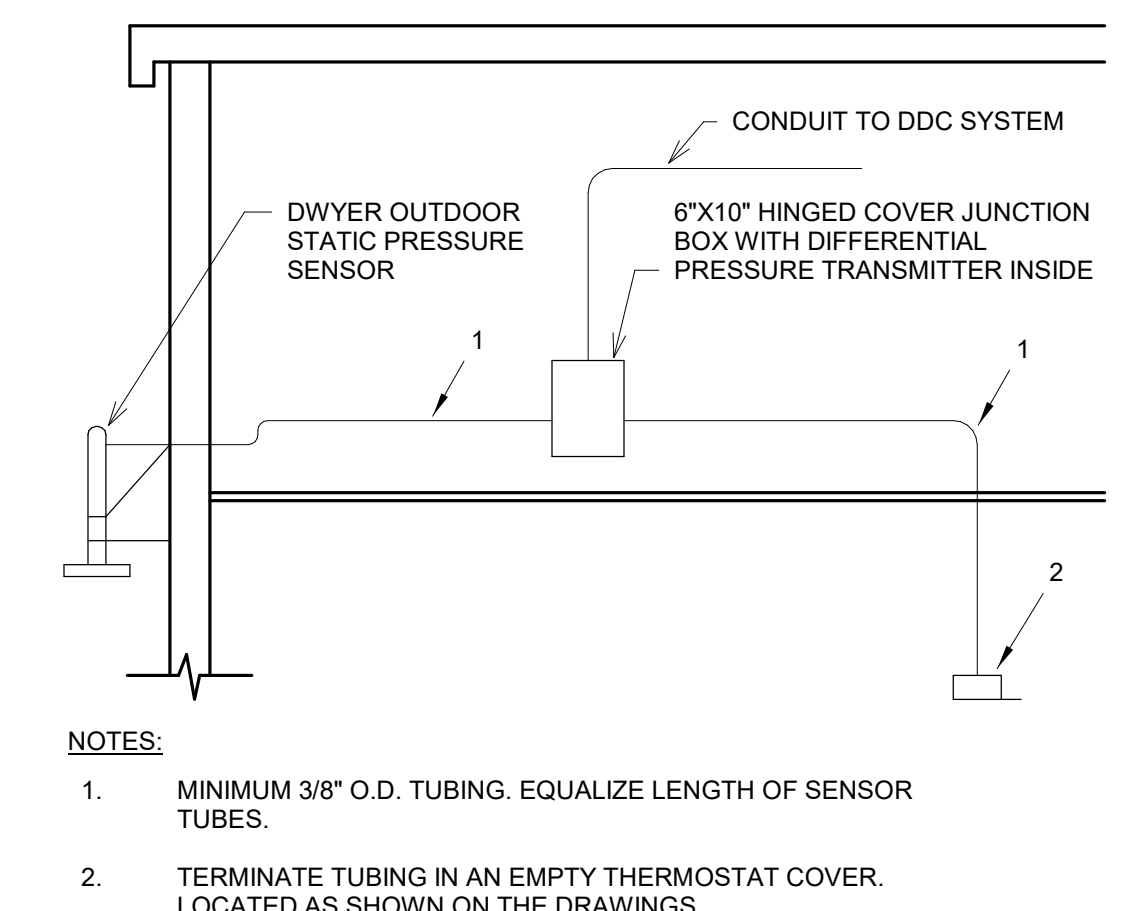


8
N.T.S.
BUILDING STATIC PRESSURE SENSOR DETAIL

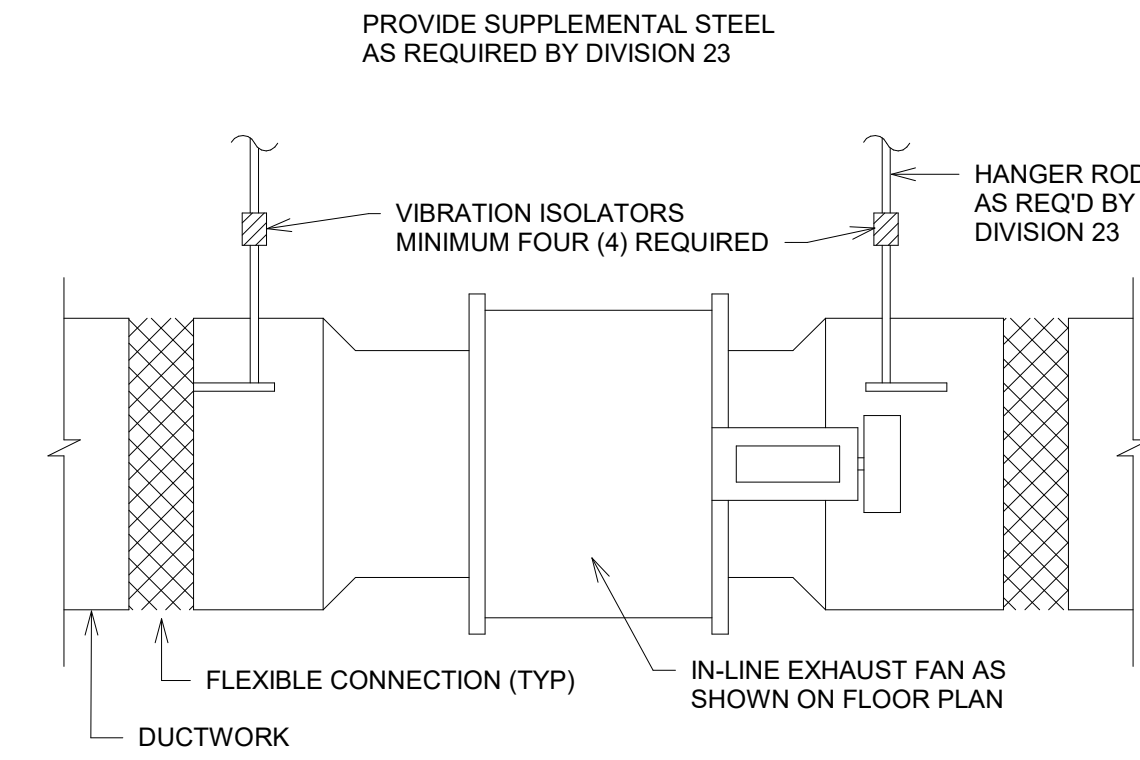


9
N.T.S.
IN-LINE EXHAUST FAN MOUNTING DETAIL

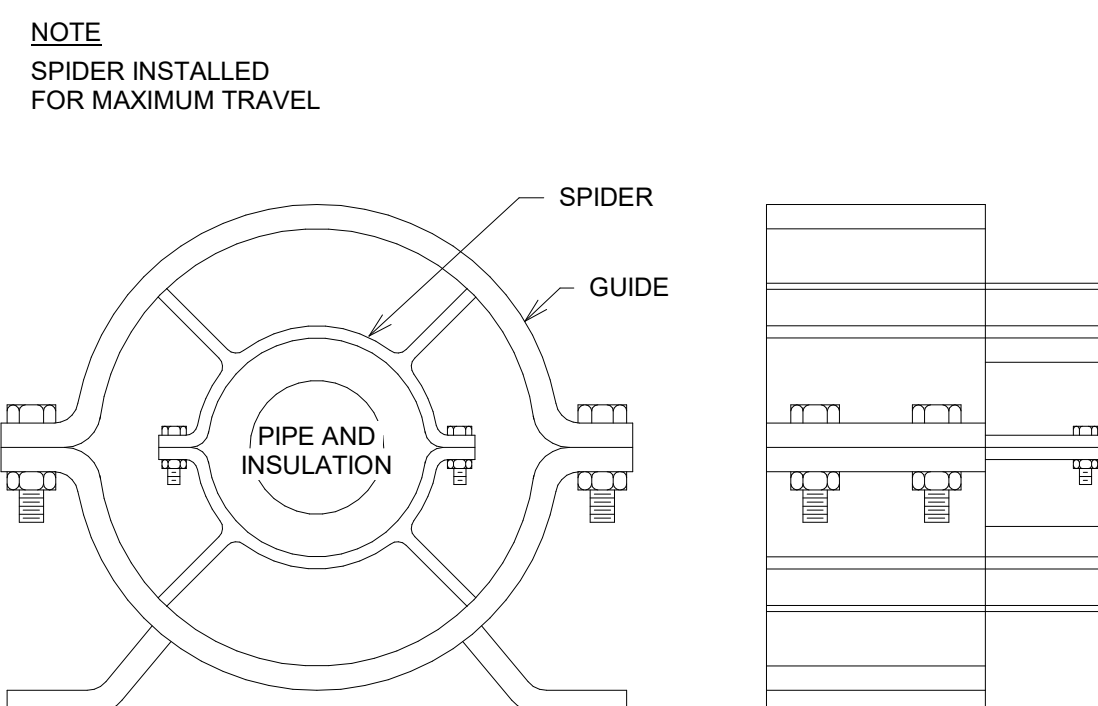


10
N.T.S.
PIPE ALIGNMENT GUIDE DETAIL

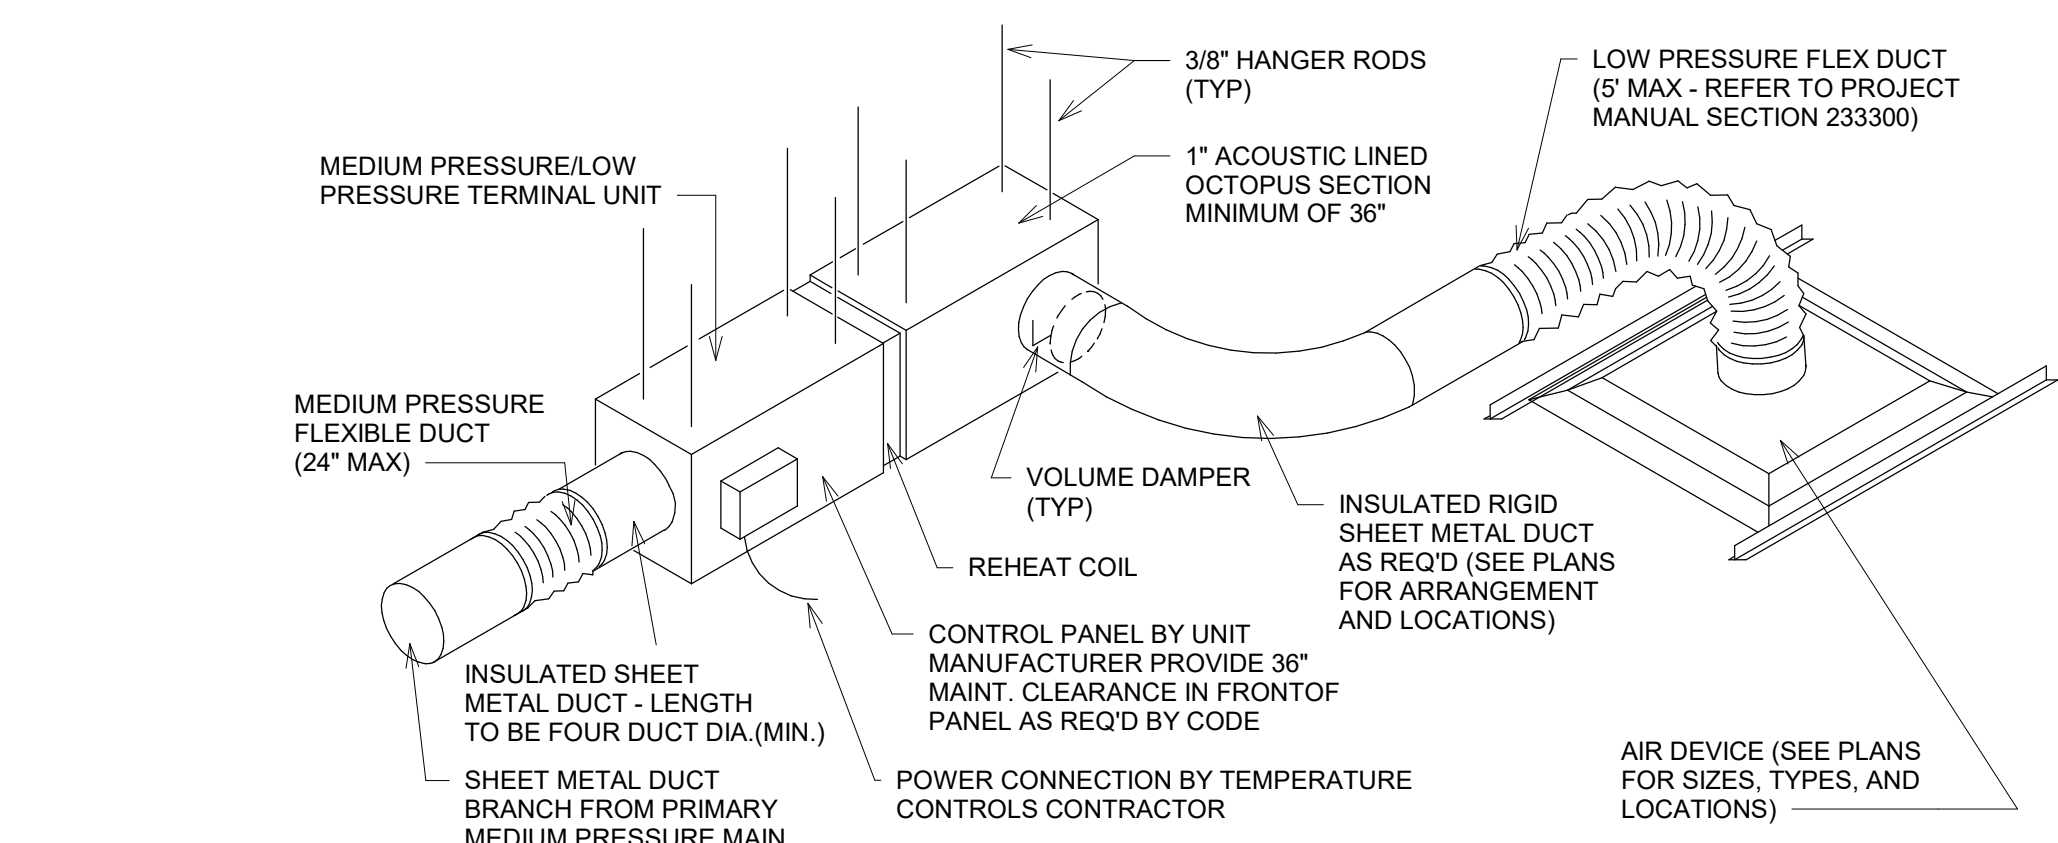


11
N.T.S.
TERMINAL REHEAT UNIT INSTALLATION DETAIL

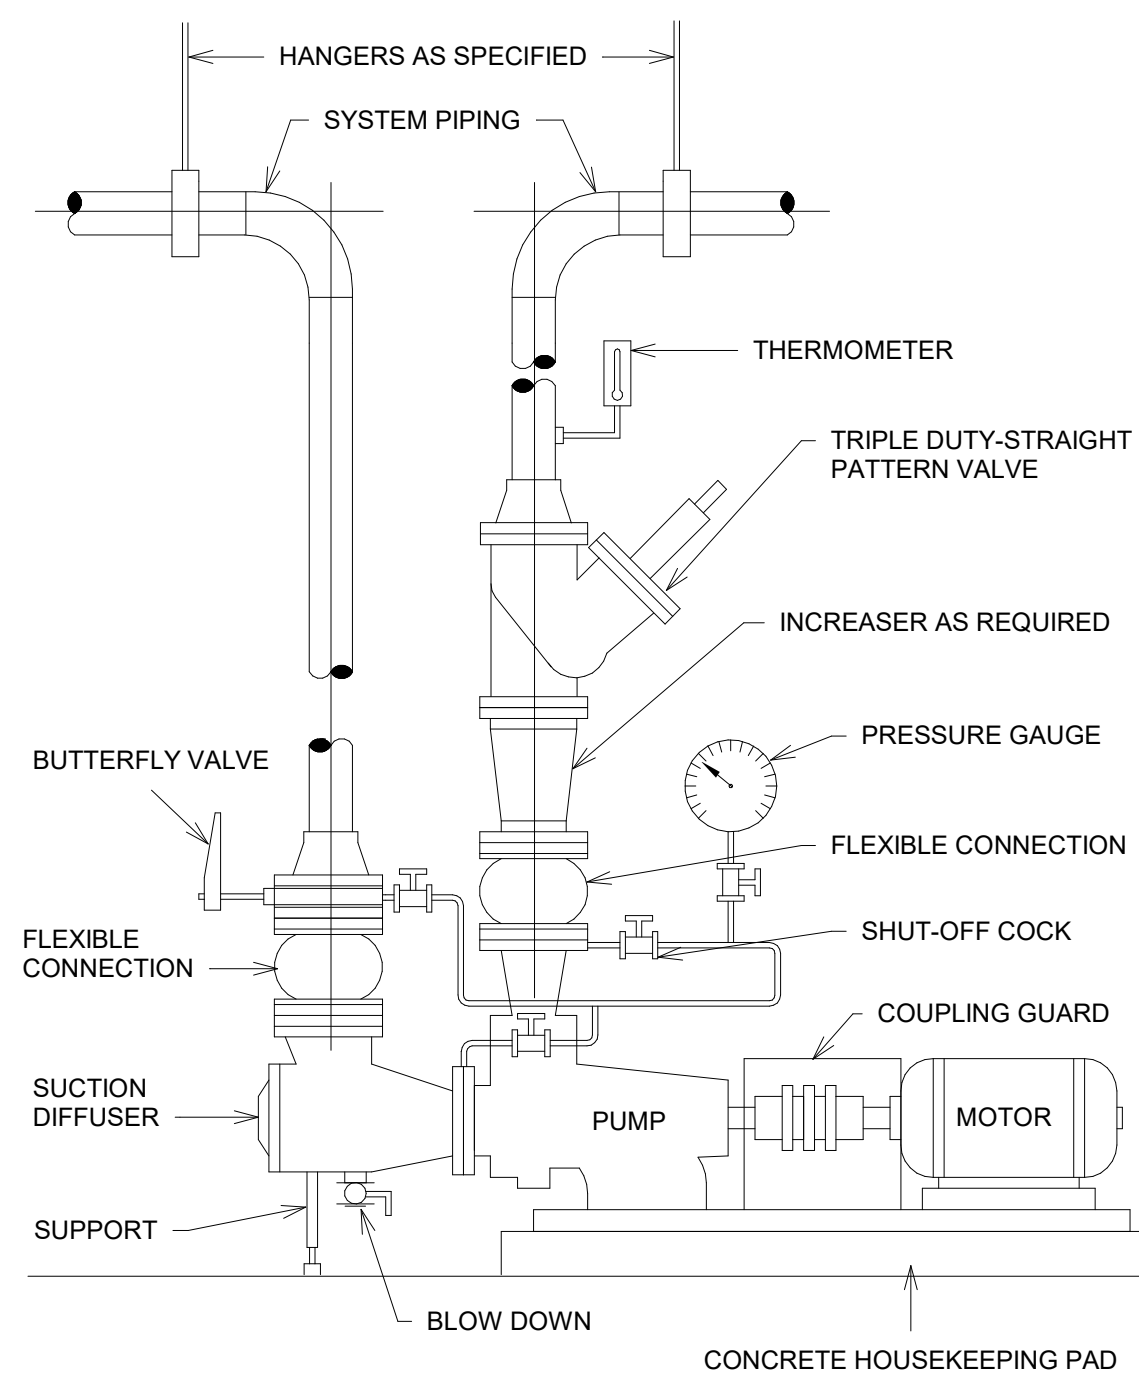


13
N.T.S.
BASE MOUNTED WATER PUMP PIPING DETAIL

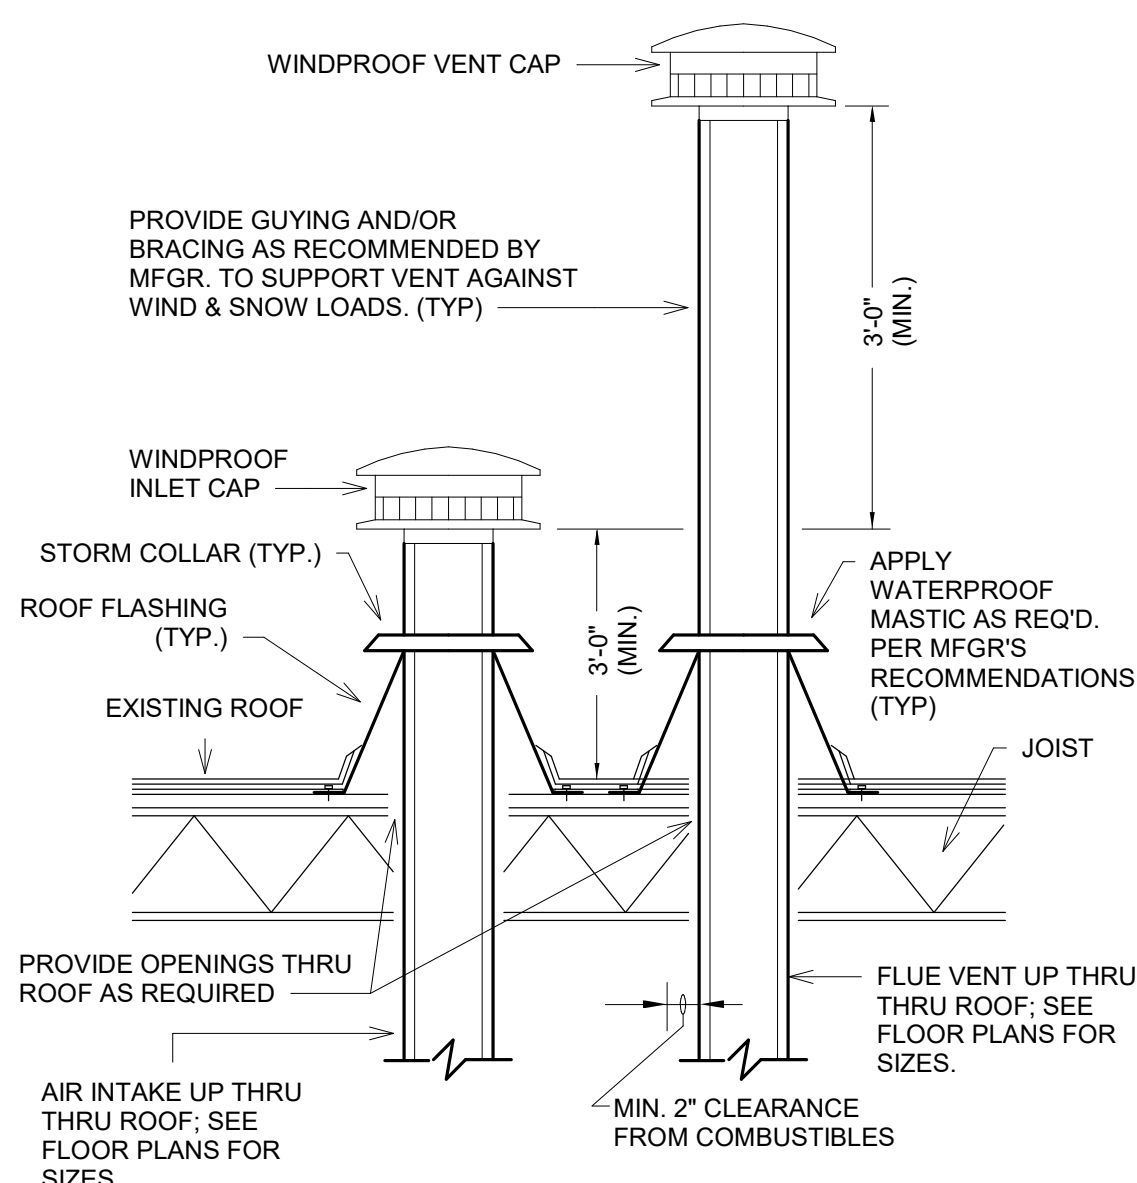

14
N.T.S.
BOILER FLUE INSTALLATION

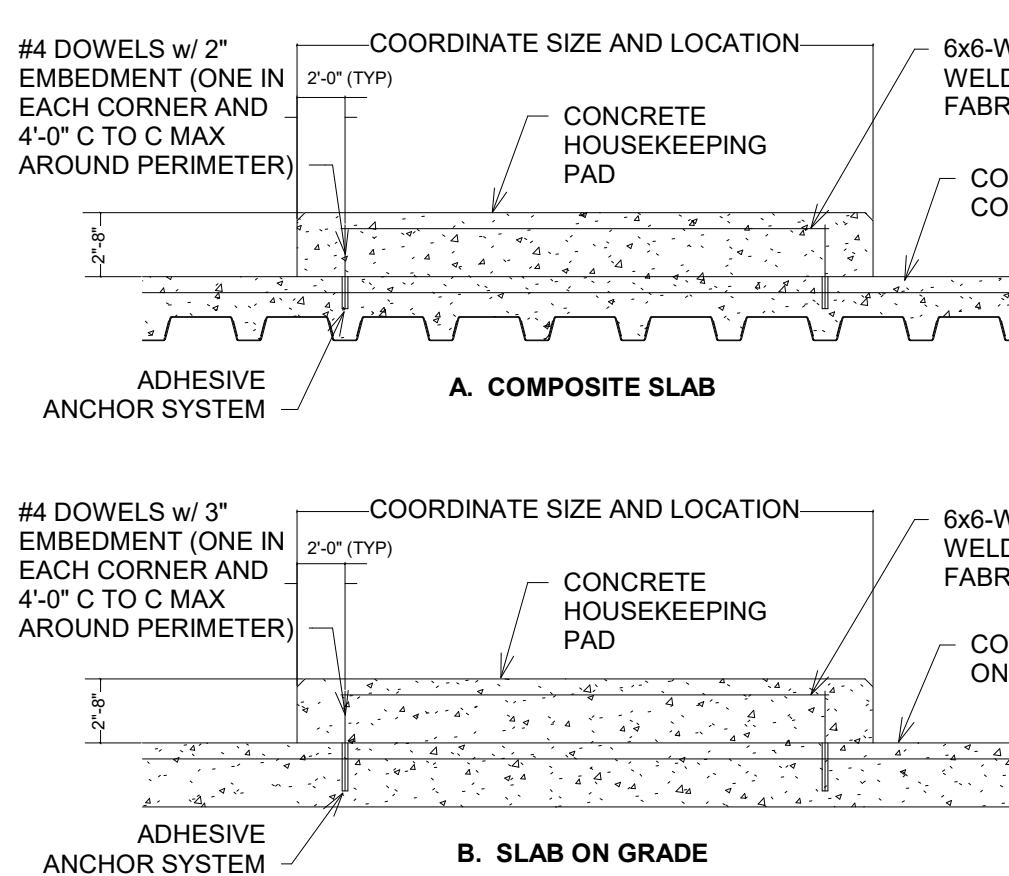

15
N.T.S.
HOUSEKEEPING PADS

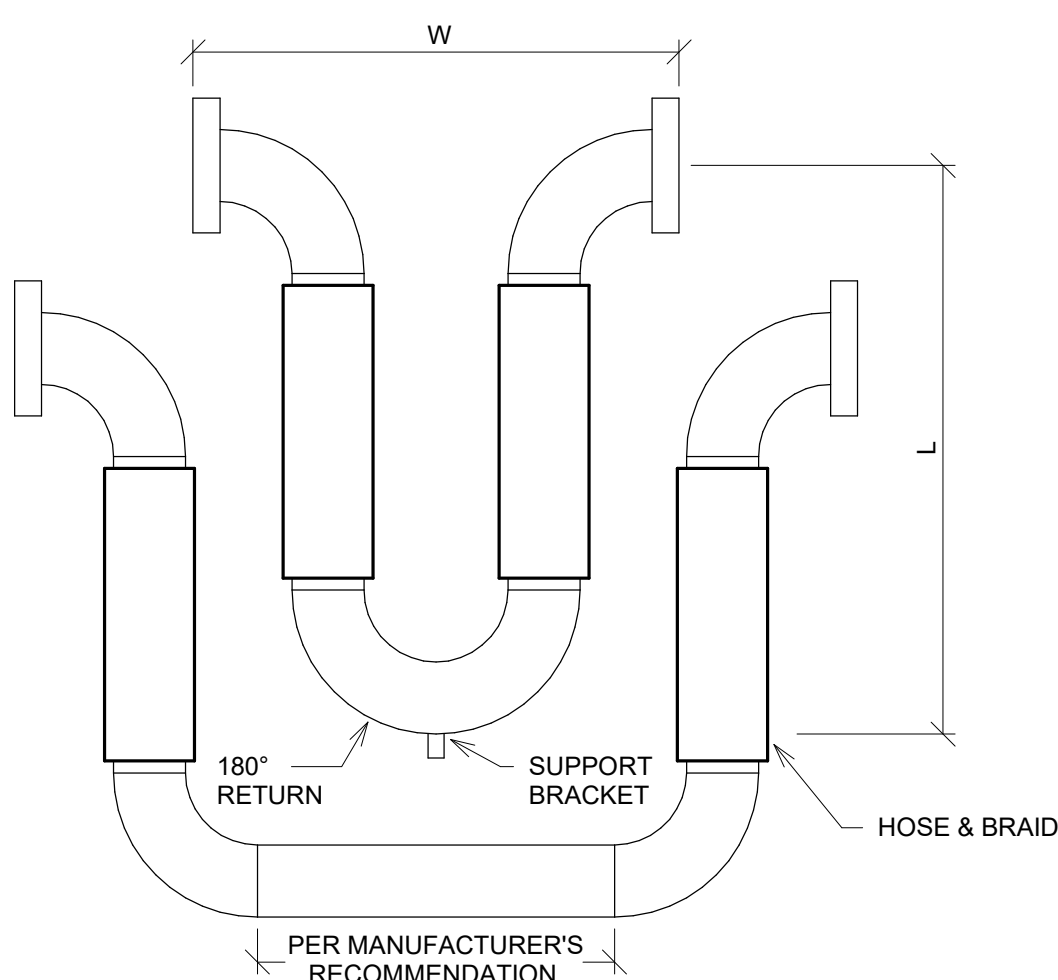


12
N.T.S.
HOSE AND BRAID FLEXIBLE LOOP DETAIL


NOTE:

1. FLEXIBLE LOOPS 2" AND LARGER MAY BE INSTALLED IN ANY OTHER ORIENTATION OTHER THAN HANGING DOWN. MUST HAVE THE 180° RETURN SUPPORTED. (SEE MANUFACTURERS INSTALLATION INSTRUCTIONS.)


SIZE	MOVEMENT	W	L	PSI @ 200'	SPRING FORCE LBS.	WEIGHT LBS.
1/2"	+/- 4"	8"	15"	706	45	2.5
3/4"	+/- 4"	9-1/2"	19"	577	47	2.5
1"	+/- 4"	10-1/4"	21"	470	53	3.0
1-1/4"	+/- 4"	11-1/4"	22"	361	66	4.0
1-1/2"	+/- 4"	11-3/4"	24"	329	70	4.5
2"	+/- 4"	20"	25"	500.0	78	18
2-1/2"	+/- 4"	21-1/2"	28"	387.0	83	29
3"	+/- 4"	24"	30"	288.0	90	43
4"	+/- 4"	30"	35"	232.0	120	60
5"	+/- 4"	36"	40"	191.0	196	99
6"	+/- 4"	42"	46"	165.0	202	150
8"	+/- 4"	56"	58"	212.0	260	286
10"	+/- 4"	68"	67"	175.0	283	461

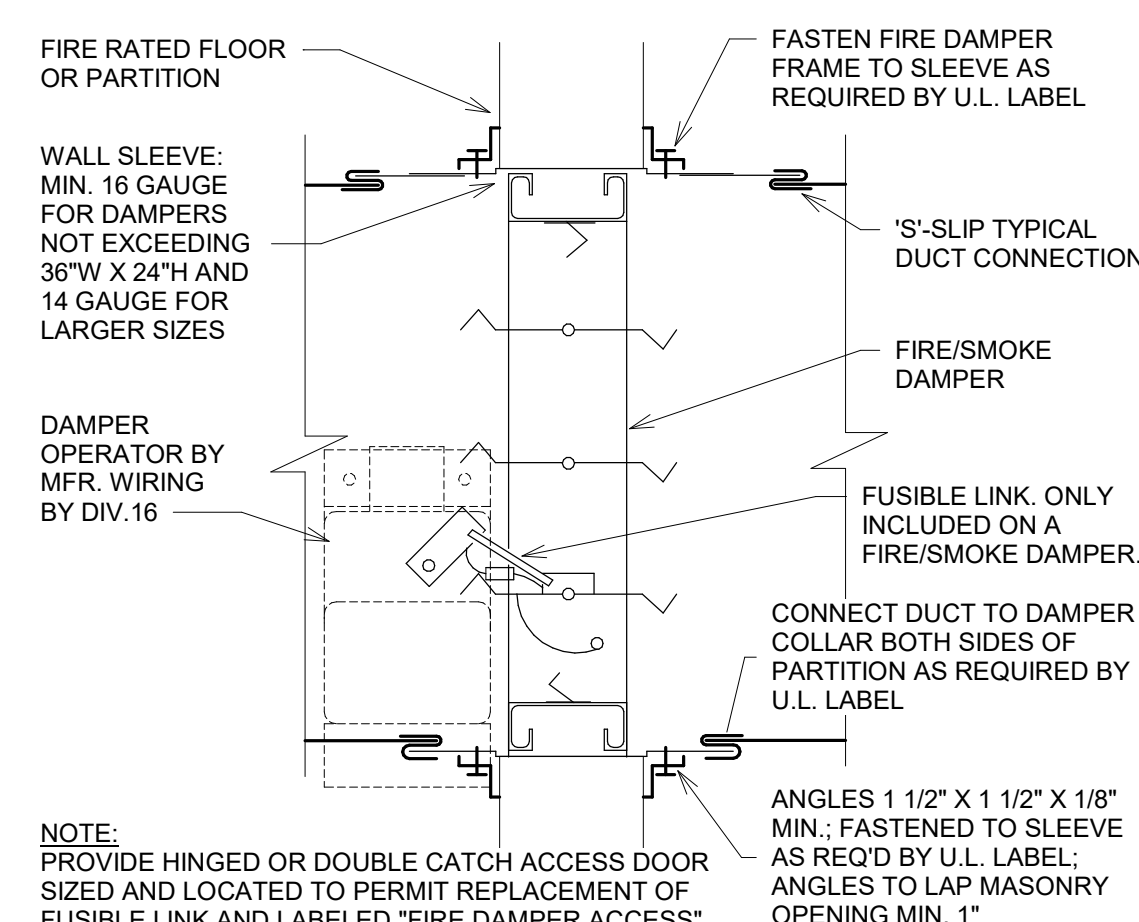

16
N.T.S.
SMOKE OR FIRE/SMOKE DAMPER DETAIL

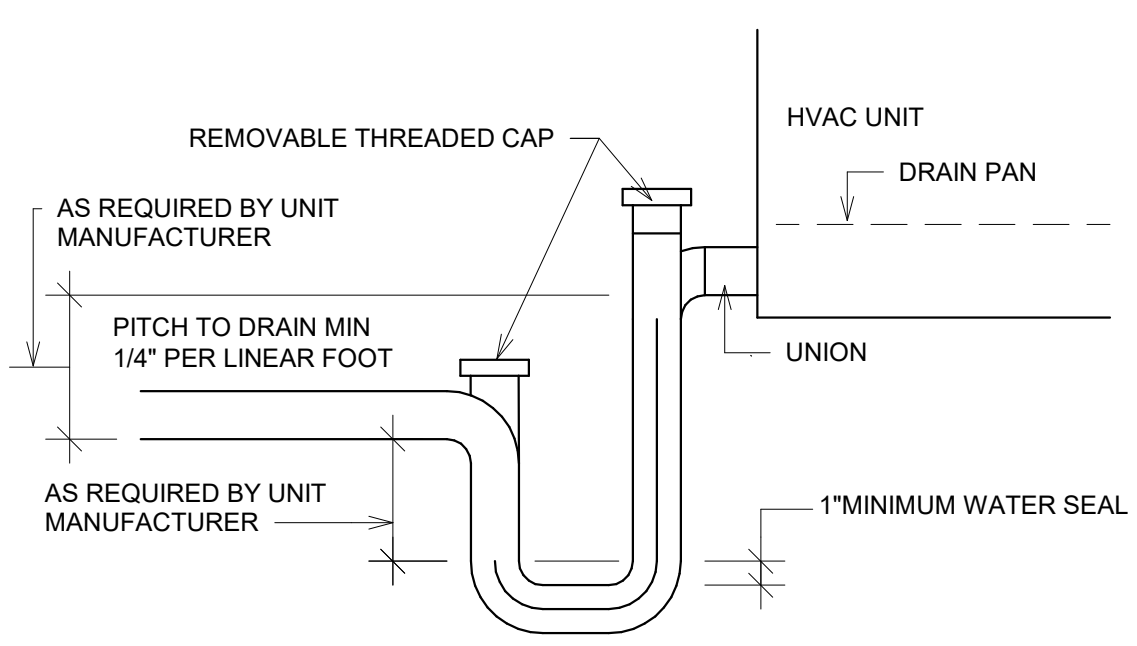

17
N.T.S.
CONDENSATE TRAP PIPING DIAGRAM

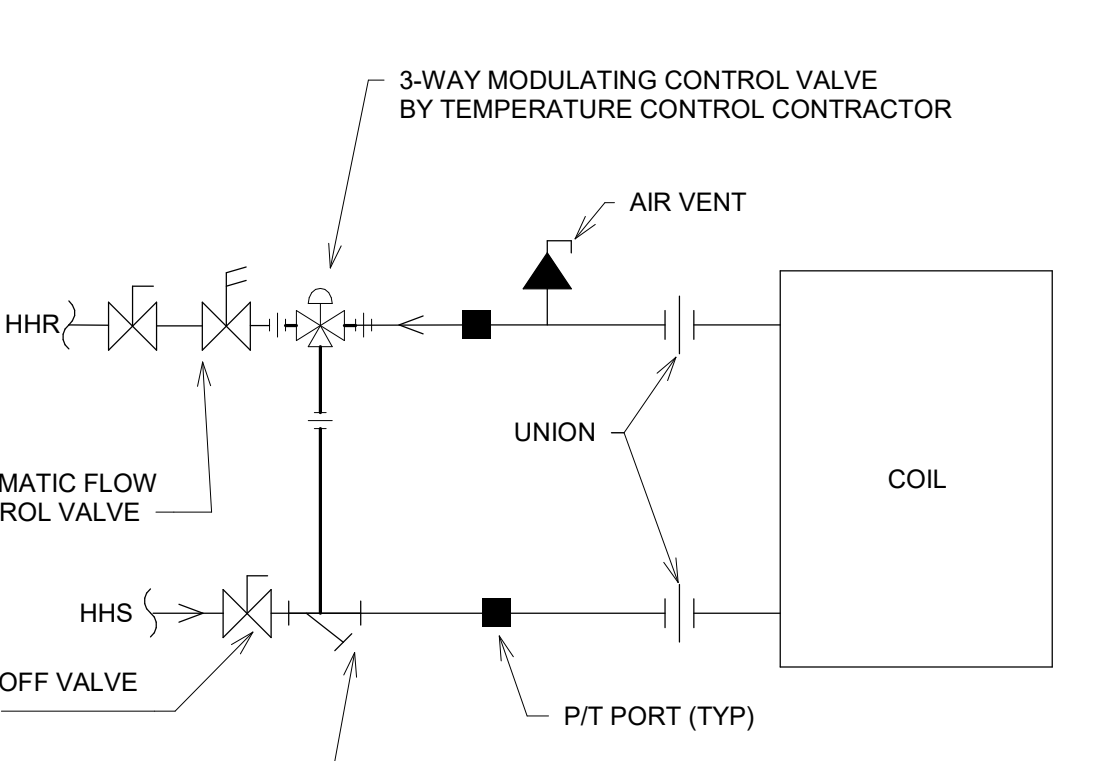

18
N.T.S.
VAV/VVR COIL PIPING DIAGRAM (THREE-WAY VALVE)

ZIONSVILLE
COMMUNITY HIGH
SCHOOL STADIUM
LOCKER BUILDING
ADDITION AND
RENOVATION

900 MULBERRY ST.
ZIONSVILLE IN, 46077

ZIONSVILLE COMMUNITY
SCHOOLS




ARCHITECT

FANNING
HOWEY

317.848.0966 WWW.FHAI.COM
350 E NEW YORK ST, SUITE #300, INDIANAPOLIS, IN 46204

CONSULTANT

CONSTRUCTION DOCUMENTS

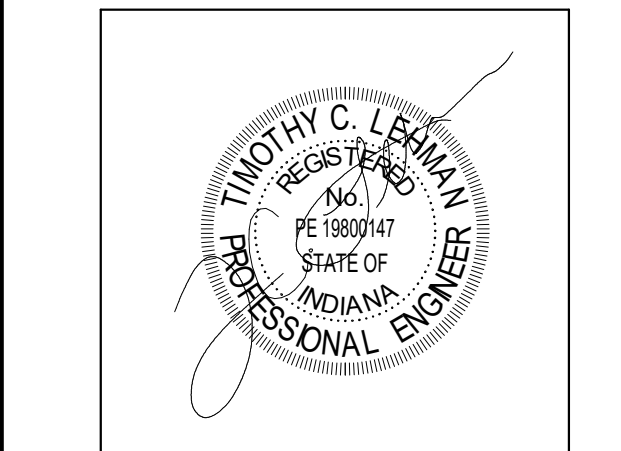


DRAWN BY: KPR
PROJECT NUMBER: 223139.00
PROJECT ISSUE DATE: 01.22.2024

REV. NO.	DESCRIPTION	DATE
1	ADDENDUM #1	2.14.2024

HEATING WATER SCHEMATIC

M5.03


DIFFERENTIAL PRESSURE TRANSMITTER PROVIDED BY
TEMPERATURE CONTROL CONTRACTOR AND INSTALLED BY
DIVISION 23-MVAC CONTRACTOR. REFER TO PIPING
PLANS FOR EXACT LOCATIONS AND QUANTITIES.

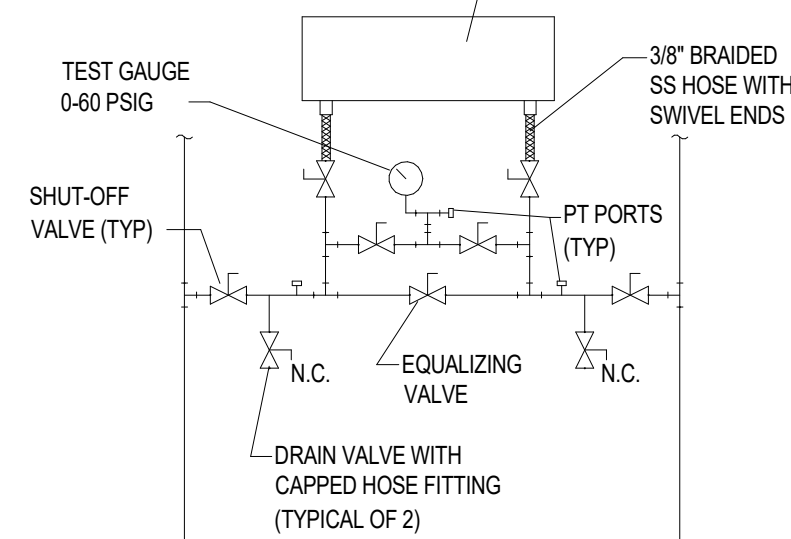

- DPT COMMISSIONING NOTES:
1. OPEN THE EQUALIZING VALVE.
 2. OPEN THE ISOLATION VALVES.
 3. SLOWLY CRACK JOINT OF BRAIDED HOSE TO BLEED AIR.
 4. TIGHTEN BRAIDED HOSE FITTING ONCE AIR IS BLED.
 5. CLOSE THE EQUALIZING VALVE TO READ DIFFERENTIAL PRESSURE.

REFER TO SPECIFIC DETAILS FOR COIL
HOOKUPS ON TERMINAL UNITS.

SCHEMATICS TO BE USED IN
CONJUNCTION WITH SPECIFICATIONS AND
CONSTRUCTION DOCUMENTS. SUBMITTALS TO
BE APPROVED BEFORE START OF INSTALLATION.

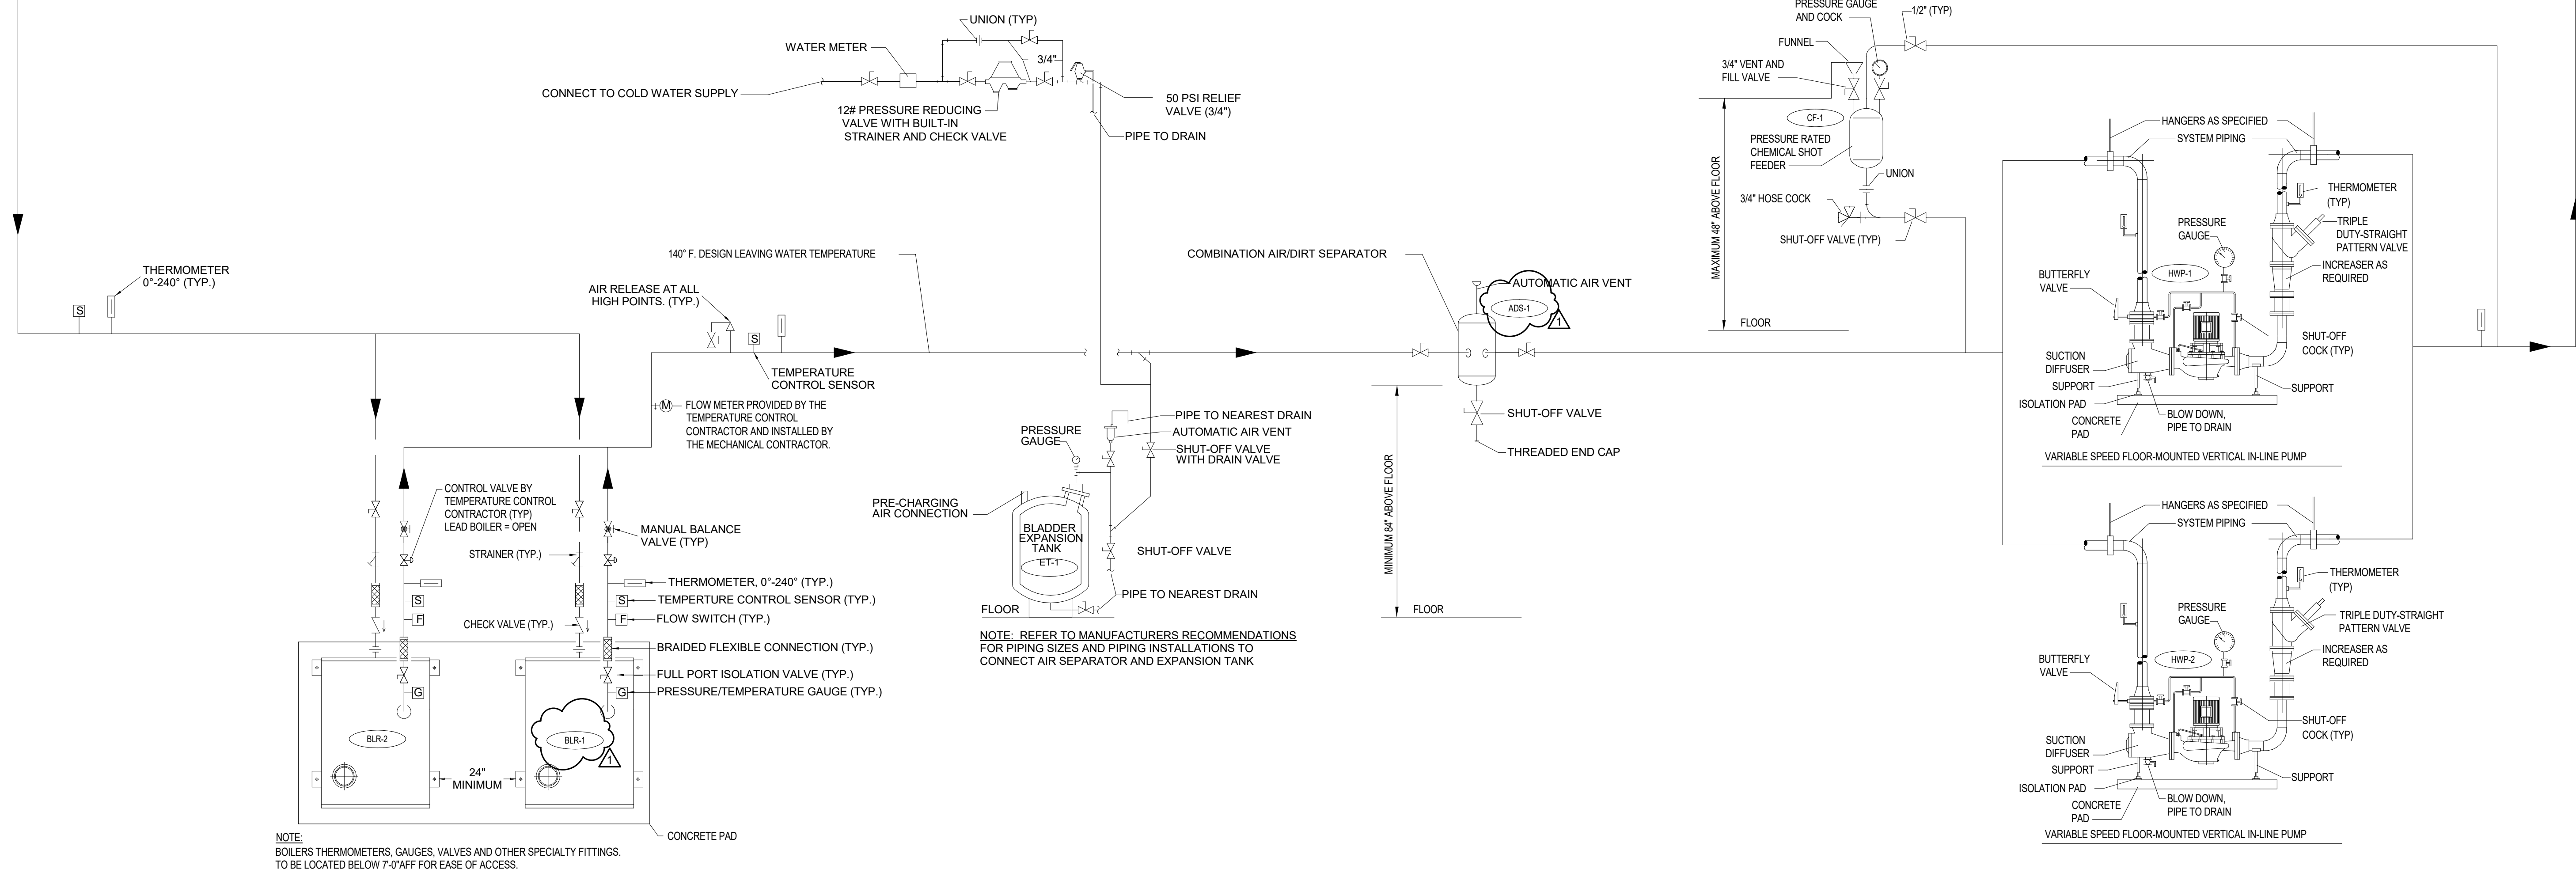

VARIABLE-PRIMARY HEATING WATER PIPING SCHEMATIC

NO SCALE

NOTE:
BOILERS THERMOMETERS, GAUGES, VALVES AND OTHER SPECIALTY FITTINGS
TO BE LOCATED BELOW 7'-0\"/>

ZIONSVILLE
COMMUNITY HIGH
SCHOOL STADIUM
LOCKER BUILDING
ADDITION AND
RENOVATION

900 MULBERRY ST.
ZIONSVILLE IN, 46077

ZIONSVILLE COMMUNITY
SCHOOLS




ARCHITECT

FANNING
HOWEY

317.848.0966 WWW.FHAI.COM
350 E NEW YORK ST, SUITE #300, INDIANAPOLIS, IN 46204

CONSULTANT

CONSTRUCTION DOCUMENTS

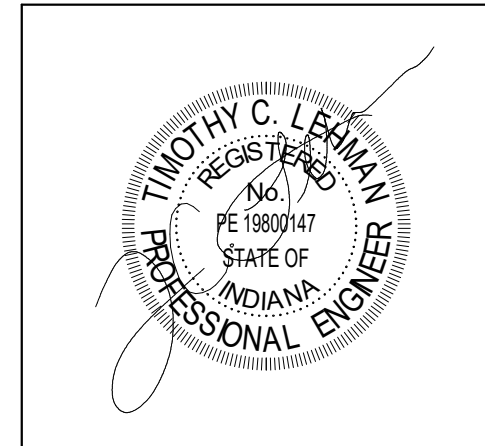

DRAWN BY: KPR


PROJECT NUMBER: 223139.00

PROJECT ISSUE DATE: 01.22.2024

REV. NO.	DESCRIPTION	DATE
1	ADDENDUM #1	2.14.2024


MECHANICAL SECTIONS

M5.04

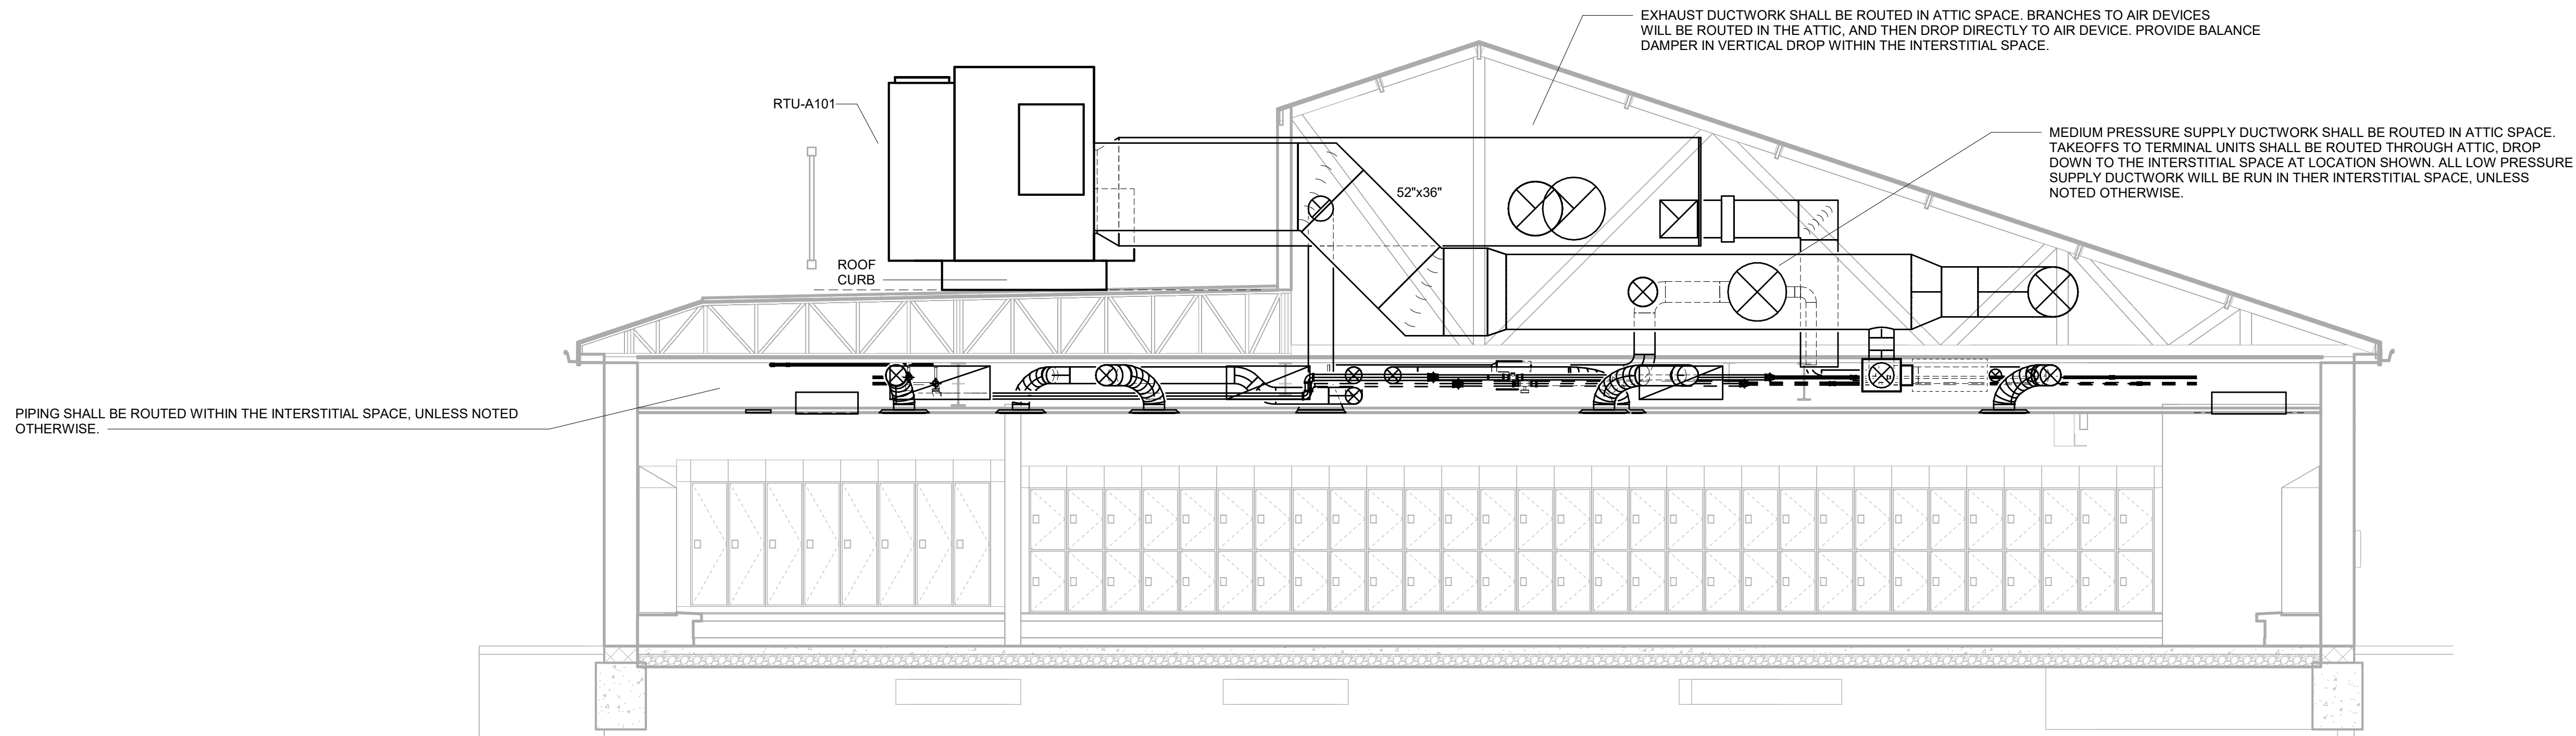

Section 1 - RTU-A101


SCALE: 1/4" = 1'-0"

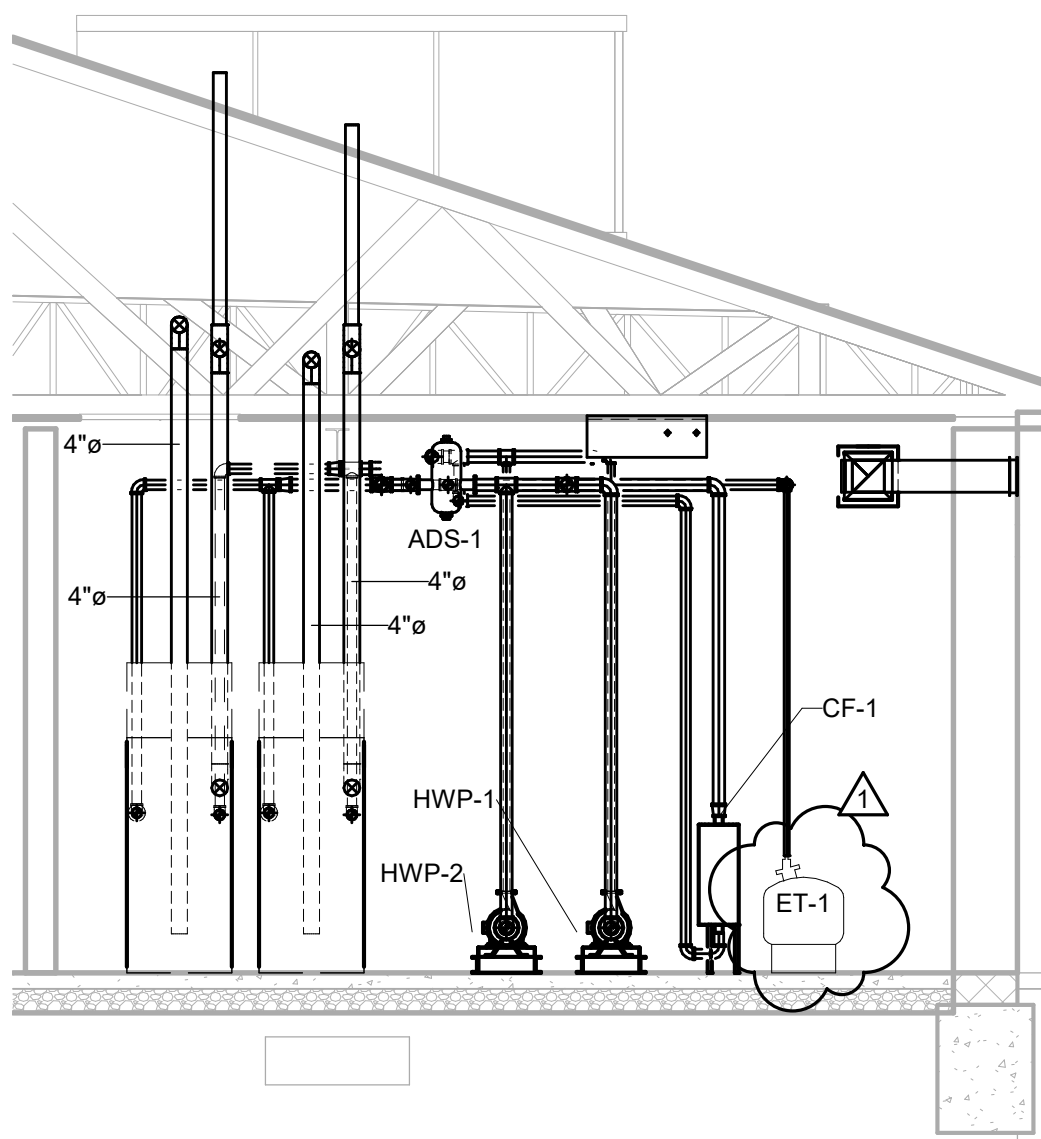





Section 2 - HEATING WATER PIPING

SCALE: 1/4" = 1'-0"

C:\Users\kross\Documents\2021_MECH_223139_00_kross5067.rvt
2/13/2024 11:56:44 AM

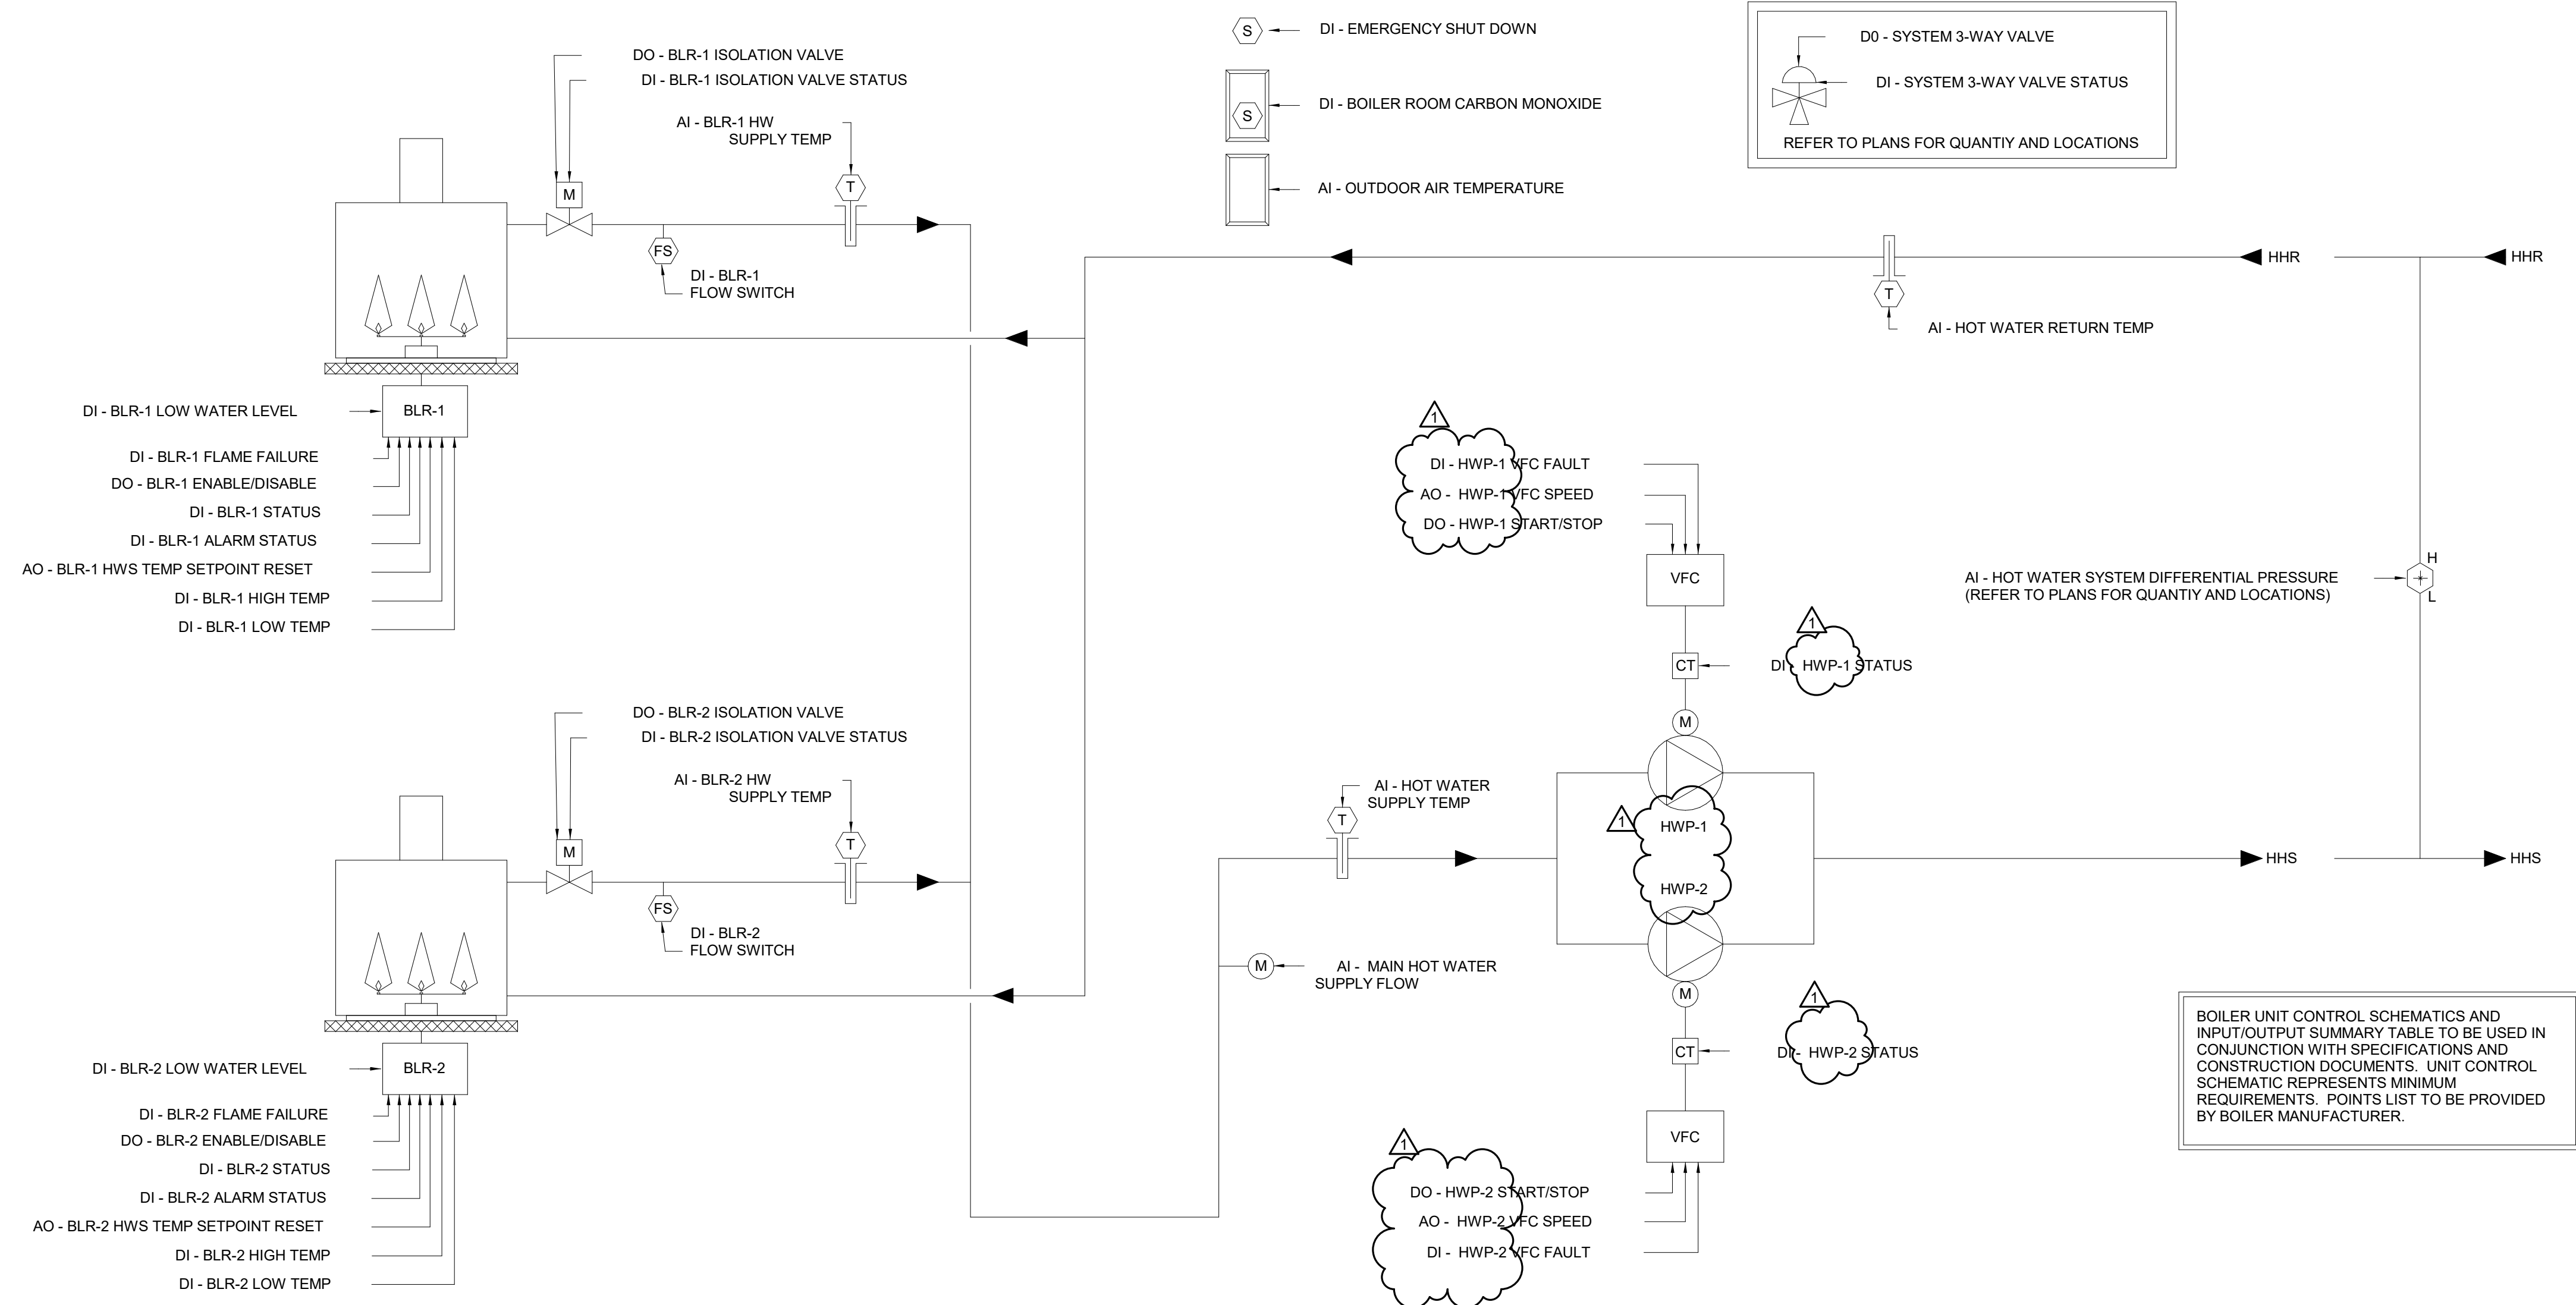

1 HEATING WATER CONTROL SCHEMATIC
SCALE NTS

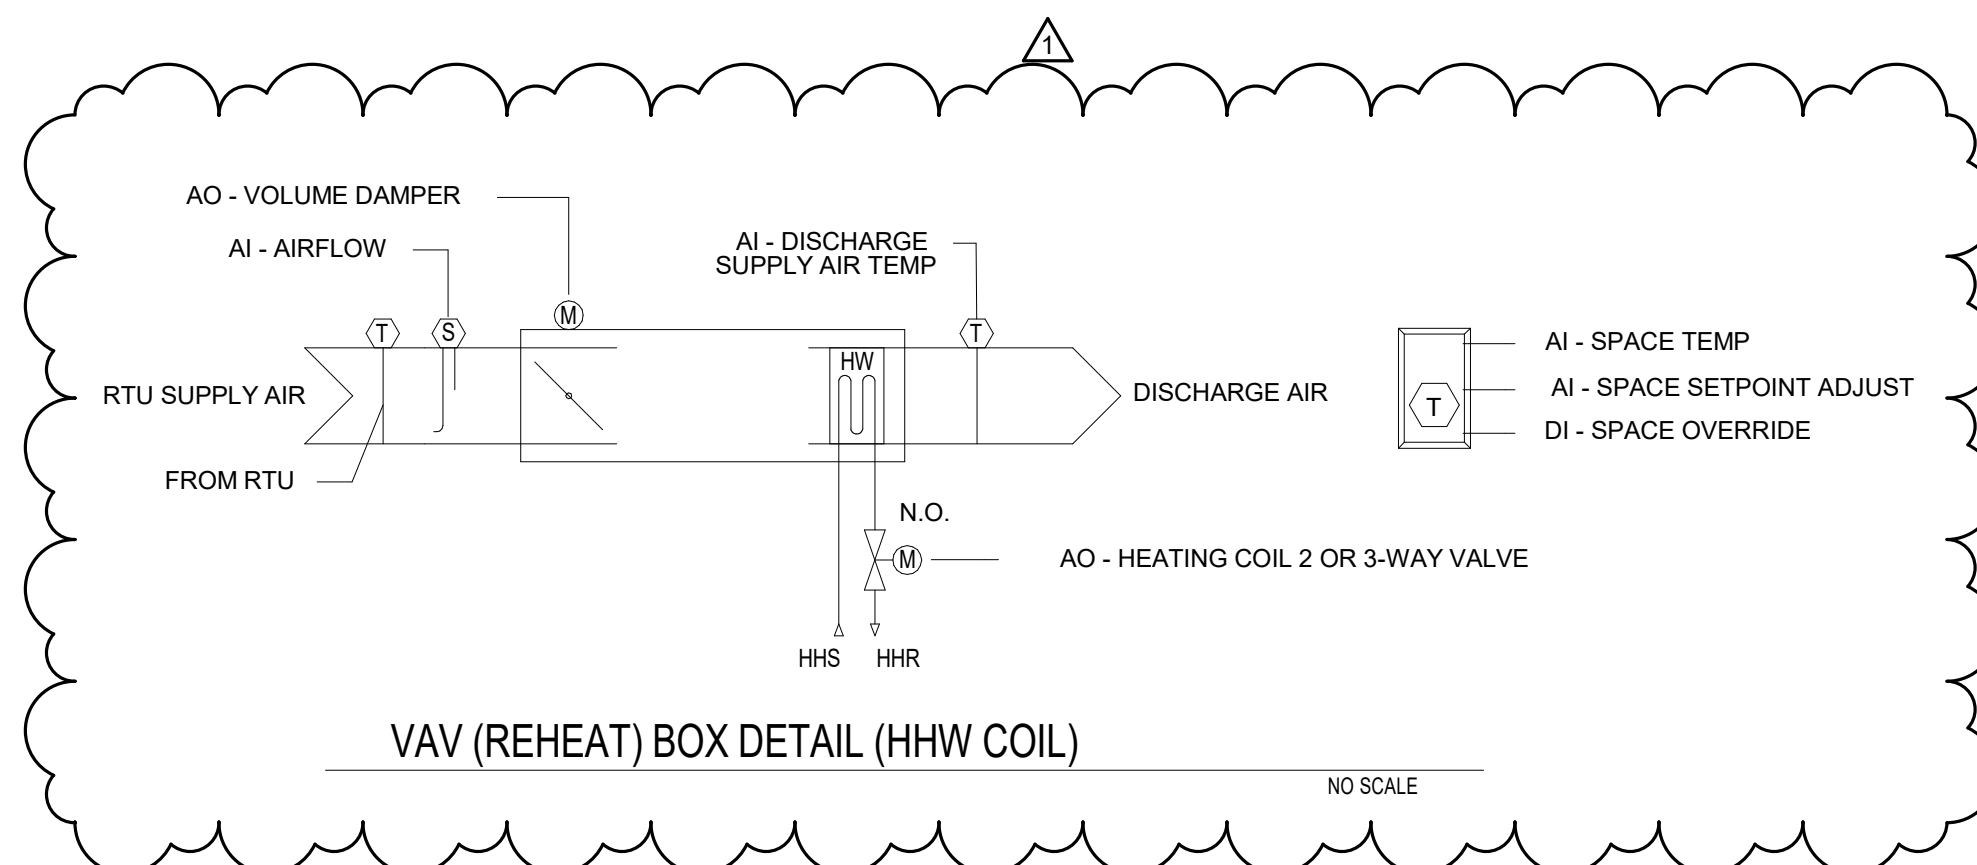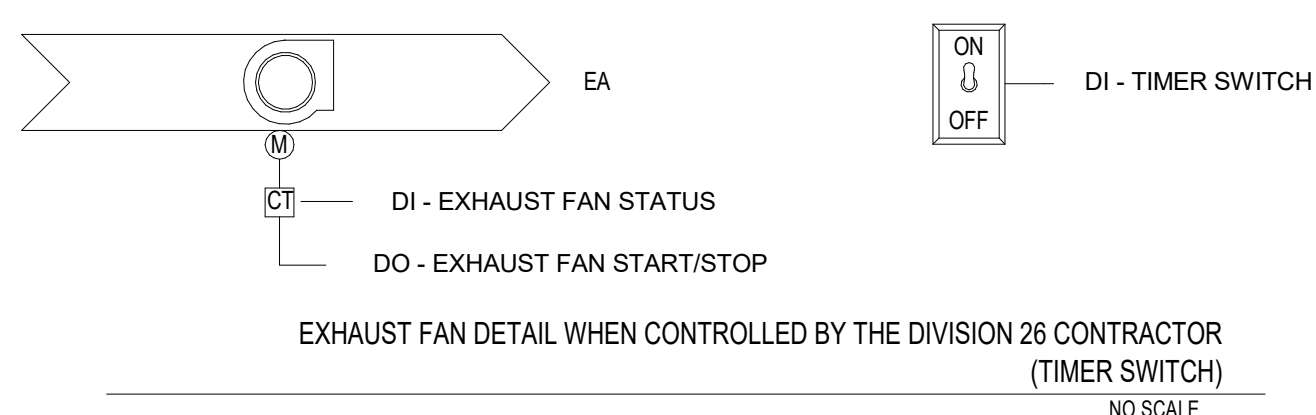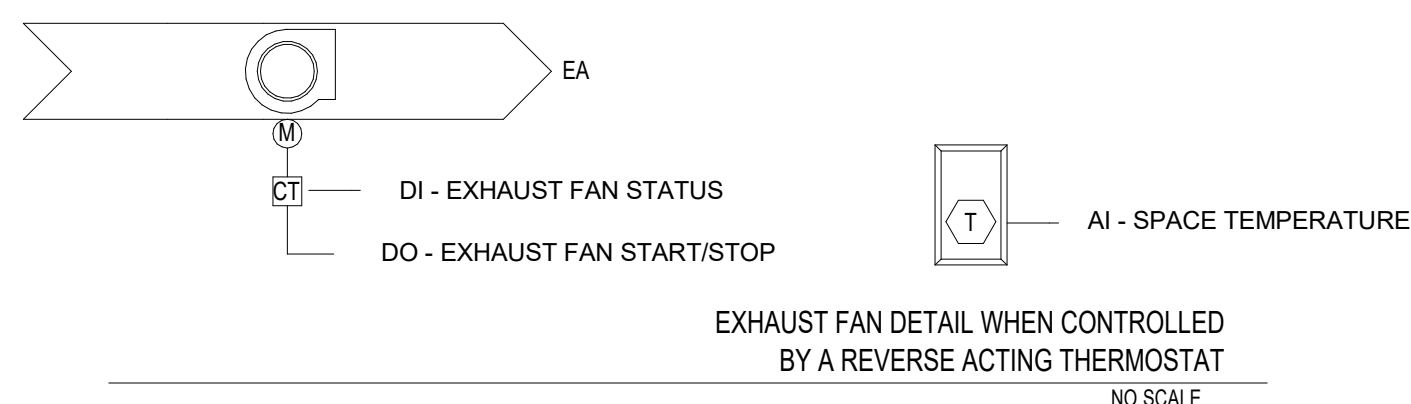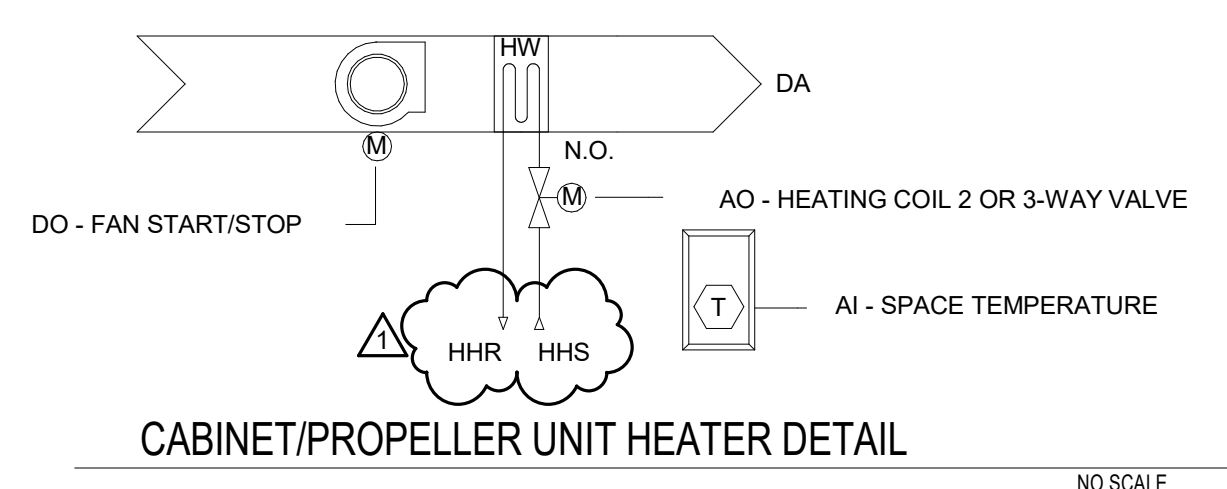

CONTROL SCHEMATICS AND INPUT/OUTPUT SUMMARY TABLE TO BE USED IN CONJUNCTION WITH SPECIFICATIONS AND CONSTRUCTION DOCUMENTS. UNIT CONTROL SCHEMATIC REPRESENTS MINIMUM REQUIREMENTS. POINTS LIST TO BE PROVIDED BY BOILER MANUFACTURER.

2-WAY AND 3-WAY CONTROL VALVES TO BE AS INDICATED ON PIPING PLANS AND COIL DETAILS.

TEMPERATURE SENSOR OR MULTI-FUNCTION SENSOR TO BE AS INDICATED ON TEMPERATURE CONTROL PLANS.

INPUT/OUTPUT SUMMARY TABLE							
PROJECT		HEATING WATER PLANT					
ZIONSVILLE HIGH SCHOOL LOCKER BUILDING ZIONSVILLE, INDIANA		AI	AO	DI	DO	TREND	ALARM
POINT DESCRIPTION							GRAPHIC
HOT WATER SUPPLY TEMP		X				X	X
HOT WATER RETURN TEMP		X				X	X
HOT WATER SYSTEM DIFFERENTIAL PRESSURE		X				X	X
BLR-1 HW SUPPLY TEMP		X				X	X
BLR-2 HW SUPPLY TEMP		X				X	X
BLR-1 HIGH TEMP		X				X	X
BLR-2 HIGH TEMP		X				X	X
BLR-1 LOW TEMP		X				X	X
BLR-2 LOW TEMP		X				X	X
MAIN HOT WATER SUPPLY FLOW		X				X	X
HWP-1 VFC SPEED		X				X	X
HWP-2 VFC SPEED		X				X	X
BLR-1 HW TEMP SETPOINT RESET		X				X	X
BLR-2 HW TEMP SETPOINT RESET		X				X	X
BLR-1 STATUS		X				X	X
BLR-2 STATUS		X				X	X
HWP-1 STATUS		X				X	X
HWP-2 STATUS		X				X	X
BLR-1 FLOW SWITCH		X				X	X
BLR-2 FLOW SWITCH		X				X	X
BLR-1 ALARM STATUS		X				X	X
BLR-2 ALARM STATUS		X				X	X
HWP-1 VFC FAULT		X				X	X
HWP-2 VFC FAULT		X				X	X
EMERGENCY SHUT-DOWN		X				X	X
BLR-1 ENABLE/DISABLE		X				X	X
BLR-2 ENABLE/DISABLE		X				X	X
HWP-1 START/STOP		X				X	X
HWP-2 START/STOP		X				X	X
BLR-1 ISOLATION VALVE		X				X	X
BLR-2 ISOLATION VALVE		X				X	X
BLR-1 FLAME FAILURE		X				X	X
BLR-2 FLAME FAILURE		X				X	X
BLR-1 LOW WATER LEVEL		X				X	X
BLR-2 LOW WATER LEVEL		X				X	X
BOILER ROOM CARBON MONOXIDE		X				X	X
OUTSIDE AIR TEMPERATURE		X				X	X
BLR-1 ISOLATION VALVE STATUS		X				X	X
BLR-2 ISOLATION VALVE STATUS		X				X	X

INPUT/OUTPUT SUMMARY TABLE							
POINT DESCRIPTION		AI	AO	DI	DO	TREND	ALARM
VVR TERMINAL BOX W/ HHW COIL		X				X	X
SPACE TEMPERATURE		X				X	X
DISCHARGE SUPPLY AIR TEMP		X				X	X
AIRFLOW		X				X	X
HEATING COIL 2-WAY/3-WAY VALVE		X				X	X
RTU SUPPLY AIR TEMP		X				X	X
SPACE SETPOINT ADJUSTMENT		X				X	X
CABINET/PROPELLER UNIT HEATERS							
FAN START/STOP				X			X
SPACE TEMPERATURE		X				X	X
HEATING COIL 2-WAY/3-WAY VALVE		X				X	X
GLOBAL POINTS							
OUTSIDE AIR TEMPERATURE		X				X	X
OUTSIDE AIR HUMIDITY		X				X	X
OUTSIDE AIR BAROMETRIC PRESSURE		X				X	X
OUTSIDE AIR CARBON DIOXIDE		X				X	X
TECHNOLOGY ROOMS TEMPERATURE		X				X	X
CARBON MONOXIDE SENSOR(S)						X	

EXHAUST FANS CONTROLLED BY REVERSE ACTING THERMOSTAT				
FAN STATUS		X		X
FAN START/STOP		X		X
SPACE TEMPERATURE	X		X	X
EXHAUST FAN CONTROLLED BY DIVISION 26 CONTRACTOR (TIMER SWITCH)				
FAN STATUS		X		X
FAN START/STOP		X		X
CONTROL BY DIVISION 26		X		X

COPYRIGHT 2024 BY FANNINGHOWEY ASSOCIATES, INC.

ZIONSVILLE COMMUNITY HIGH SCHOOL STADIUM LOCKER BUILDING ADDITION AND RENOVATION

900 MULBERRY ST.
ZIONSVILLE IN, 46077

ZIONSVILLE COMMUNITY SCHOOLS



ARCHITECT

FANNING HOWEY


317.848.0966

WWW.FHAI.COM

350 E NEW YORK ST, SUITE #300, INDIANAPOLIS, IN 46204

CONSULTANT

CONSTRUCTION DOCUMENTS

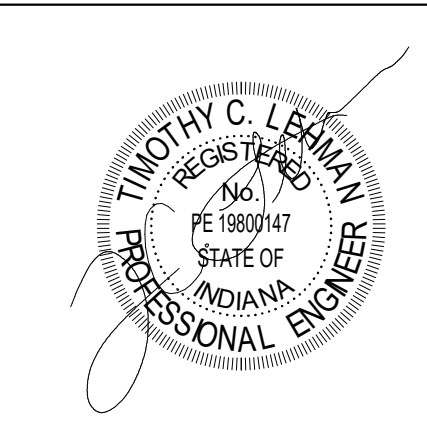

DRAWN BY: KPR

PROJECT NUMBER: 223139_00






PROJECT ISSUE DATE: 01/22/2024

REV.	NO.	DESCRIPTION	DATE
1	ADDENDUM #1		2.14.2024

TEMPERATURE CONTROL DIAGRAMS

M6.01

A	GROUNDING ELECTRODE CONDUCTOR, BARE, TINNED, STRANDED, COPPER-CONDUCTOR, (30 INCHES BELOW GRADE, MIN.) [24 INCHES FROM FOUNDATION, MIN.] FOR ELECTRICAL SERVICE OF 800 AMP OR LESS USE #20 AWG. FOR ELECTRICAL SERVICE GREATER THAN 800 AMP USE #40 AWG.
B	GROUNDING ELECTRODE CONDUCTOR, 2/0 AWG BARE, TINNED, STRANDED, COPPER-CONDUCTOR.
C	IRREVERSIBLE, COPPER, COMPRESSION CONNECTOR. (CABLE TO CABLE)
D	IRREVERSIBLE, COPPER, COMPRESSION CONNECTOR. (CABLE TO TRAY) BOND EACH SECTION, TRANSITION, RISER, TEE, ETC.
E	MAIN BONDING JUMPER PROVIDED BY MANUFACTURER AS PART OF LISTED AND LABELED SERVICE EQUIPMENT. IF NOT PROVIDED BY MANUFACTURER, PROVIDE #40 BARE, TINNED, STRANDED, COPPER-CONDUCTOR.
F	GROUNDING ELECTRODE CONDUCTOR: #40 AWG STRANDED, BARE, COPPER IN PVC CONDUIT.
G	GROUNDING CONDUCTOR (NEUTRAL): (REFER TO ONE-LINE DIAGRAM FOR CONDUCTOR SIZE).
H	PROVIDE UL 467 LISTED COMPRESSION CONNECTORS, TWO-HOLE LUGS.
I	SYSTEM BONDING JUMPER CONDUCTOR. SYSTEM BONDING JUMPER CONDUCTOR TO BE RUN IN EACH CONDUIT CONTAINING PHASE CONDUCTORS BETWEEN TRANSFORMER AND MAIN SECONDARY DISCONNECT. (REFER TO ONE-LINE DIAGRAM FOR CONDUCTOR SIZE)
JJ	10 FOOT BY 3/4" COPPER WELD GROUND ROD. TOP OF ROD SHALL BE 12" MINIMUM BELOW FINISHED GRADE.
J	8 FOOT BY 5/8" COPPER WELD GROUND ROD. TOP OF ROD SHALL BE 12" MINIMUM BELOW FINISHED GRADE.
K	PROVIDE EXOTHERMIC WELD FOR ALL CABLE TO ROD, CABLE TO CABLE OR CABLE TO STEEL CONNECTIONS.
L	EQUIPMENT BONDING JUMPER STRANDED, BARE, COPPER, <110A USE #6, <410A USE #2, <810A USE #20, <2100A USE #40) SCREW OF BUSBAR MAY BE USED WHEN PROVIDED AS PART OF LISTED SERVICE EQUIPMENT.
M	EQUIPMENT GROUNDING CONDUCTOR (REFER TO ONE LINE DIAGRAM FOR CONDUCTOR SIZE).
N	TELECOMMUNICATIONS BONDING BACKBONE: #40 AWG STRANDED BARE COPPER.
O	BONDING CONDUCTOR: 6 AWG STRANDED BARE COPPER.
P	1" PVC SLEEVE FOR ALL GROUNDING CONDUCTORS THROUGH FLOOR SLABS. NEVER ROUTE GROUNDING CONDUCTORS IN A METAL CONDUIT.
Q	PROVIDE UL 467 LISTED, ELECTRO-TIN-PLATED COPPER BUSBAR, 4" x 20" x 1/4" WITH (2) 2-INCH INSULATED STANDOFF SUPPORTS. PROVIDE ENGRAVED NAMEPLATE, SCREWED TO WALL, 6" ABOVE GROUNDING BUS BAR WHICH READS "IF THESE CONNECTORS OR CABLES ARE LOOSE OR MUST BE REMOVED, PLEASE CALL THE BUILDING TELECOMMUNICATIONS MANAGER".
R	PROVIDE UL 467 LISTED, ELECTRO-TIN-PLATED COPPER BUSBAR, 2" x 12" x 1/4" WITH (2) 2-INCH INSULATED STANDOFF SUPPORTS. PROVIDE ENGRAVED NAMEPLATE SCREW TO WALL, 6" ABOVE GROUNDING BUS BAR WHICH READS, "IF THESE CONNECTORS OR CABLES ARE LOOSE OR MUST BE REMOVED, PLEASE CALL THE BUILDING TELECOMMUNICATIONS MANAGER".
S	PROVIDE UL 467 LISTED, ELECTRO-TIN-PLATED COPPER BUSBAR, 4" x 20" x 1/4" WITH (2) 2-INCH INSULATED STANDOFF SUPPORTS. PROVIDE ENGRAVED NAMEPLATE, SCREWED TO WALL, 6" ABOVE GROUNDING BUS BAR WHICH READS "WARNING: SHOCK HAZARD EXISTS IF GROUNDING ELECTRODE CONDUCTOR OR BONDING JUMPER CONNECTION IN THIS EQUIPMENT IS REMOVED WHILE ALTERNATE SOURCE (GENERATOR) IS ENERGIZED".
T	CONTINUOUS, UNSPLICED BONDING CONDUCTOR FOR TELECOMMUNICATIONS: 2/0 AWG BARE, TINNED, STRANDED, COPPER-CONDUCTOR IN CABLE TRAYS.
U	BRAIDED ALUMINUM CABLE FOR LIGHTING DOWNRUNNER. SUPPORT SPACING PER NFPA 760.
V	CONNECT GROUND CABLE TO EXISTING SERVICE GROUNDING ELECTRODE AT UTILITY TRANSFORMER OR MAIN SWITCHBOARD GROUND BAR.
W	CONNECT TO EXISTING BUILDING GROUND LOOP IF FOUND, DISTURBED, OR DAMAGED, PROVIDE K AT ALL SPLICES AND NEW CABLE CONNECTIONS.
X	WELD A MINIMUM 6" x 3" x 1/4" STEEL PLATE TO UNDERSIDE OF BOTTOM FLANGE OF ROOF JOIST. THE STEEL PLATE SHALL BE WELDED TO THE BOTTOM FLANGE USING A NORMAL WELDING PROCEDURE WITH WELDS PARALLEL TO THE BOTTOM FLANGE ALONG THE EDGE. THEN BOND THE GROUNDING CONDUCTOR TO THE STEEL PLATE AT LEAST 1' AWAY FROM FLANGE, USING AN EXOTHERMIC WELD.
Y	PROVIDE WRAP AROUND PLASTIC LABEL ON EACH CONDUCTOR AT GROUND BAR. IDENTIFY WHAT THE CABLE IS CONNECTED TO.

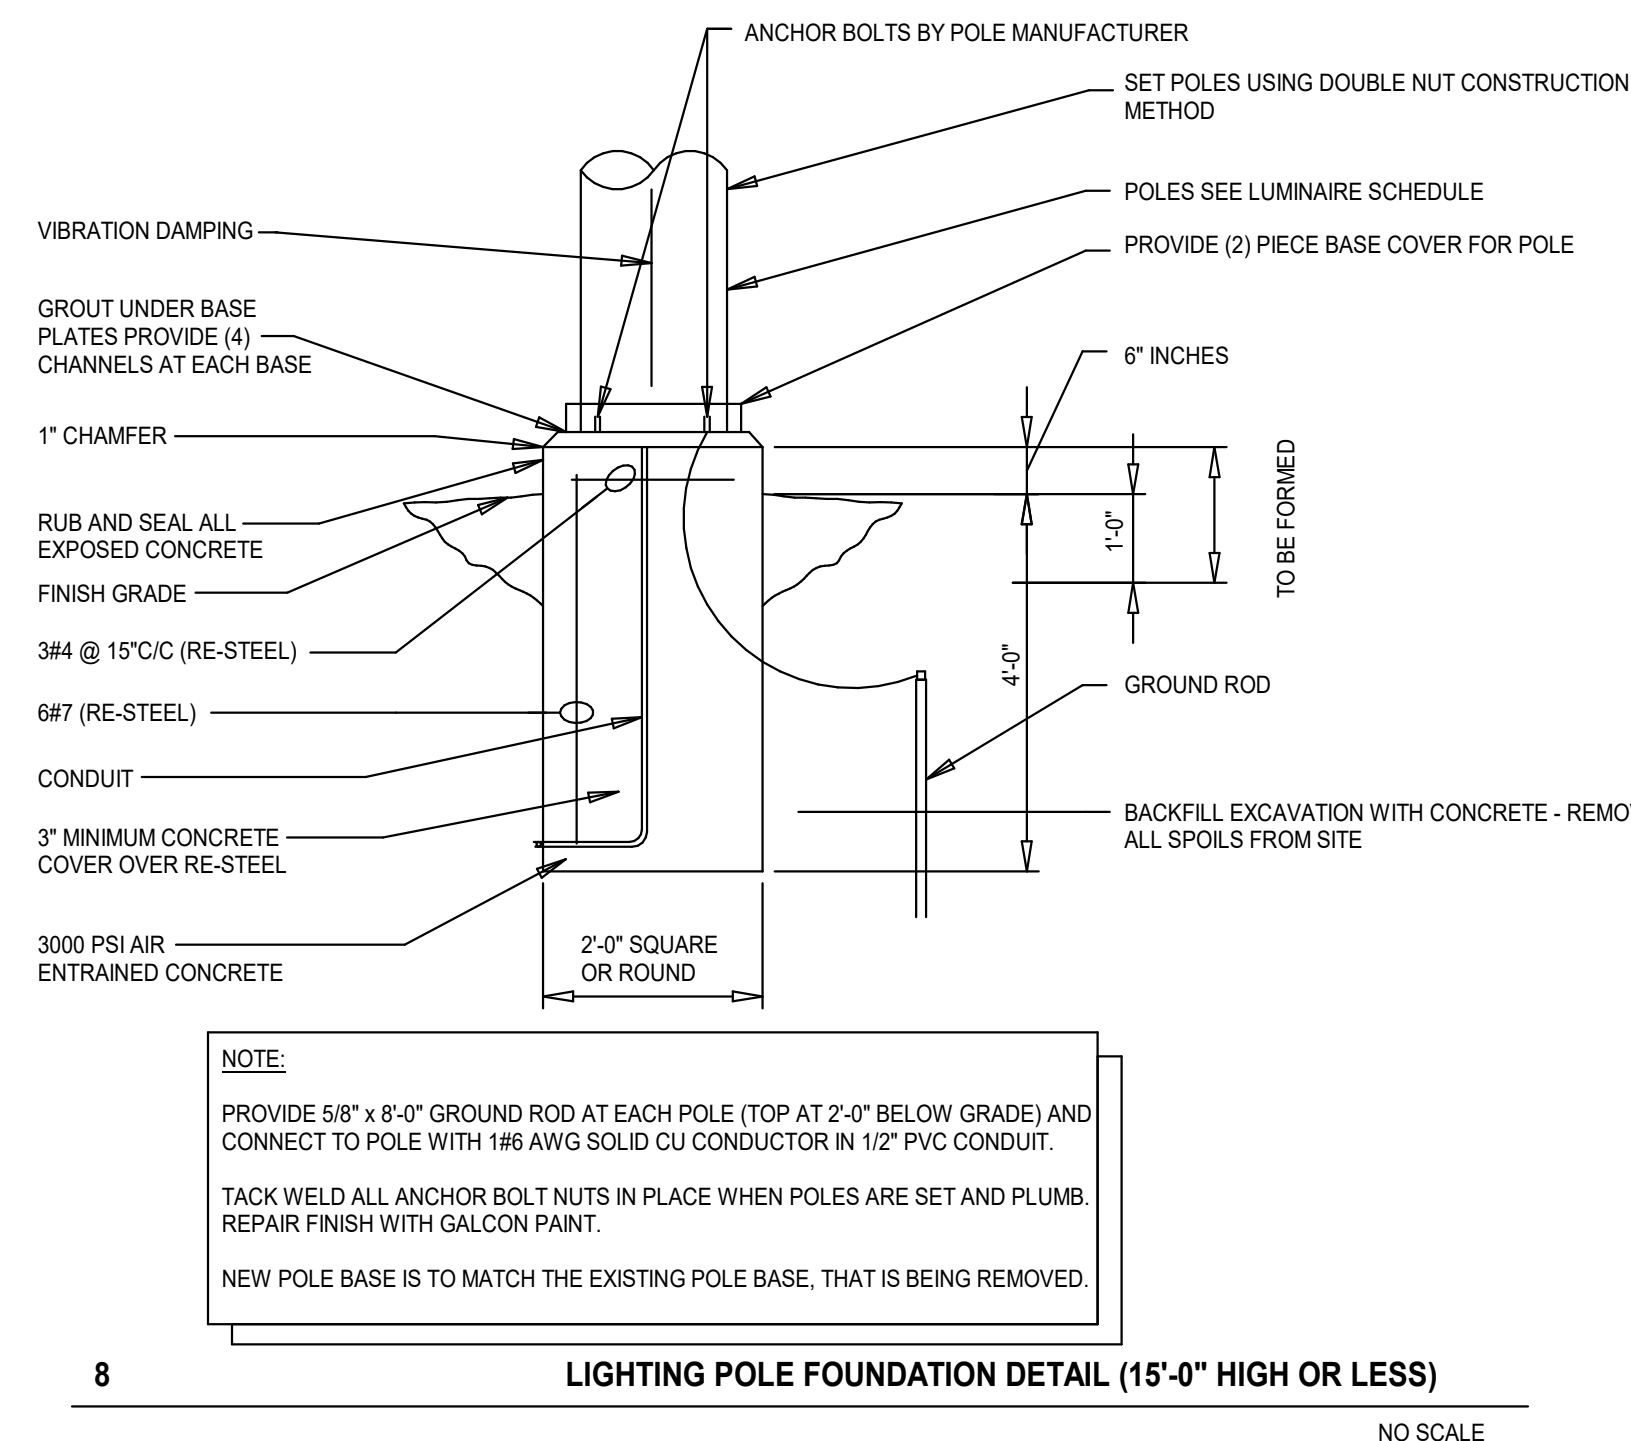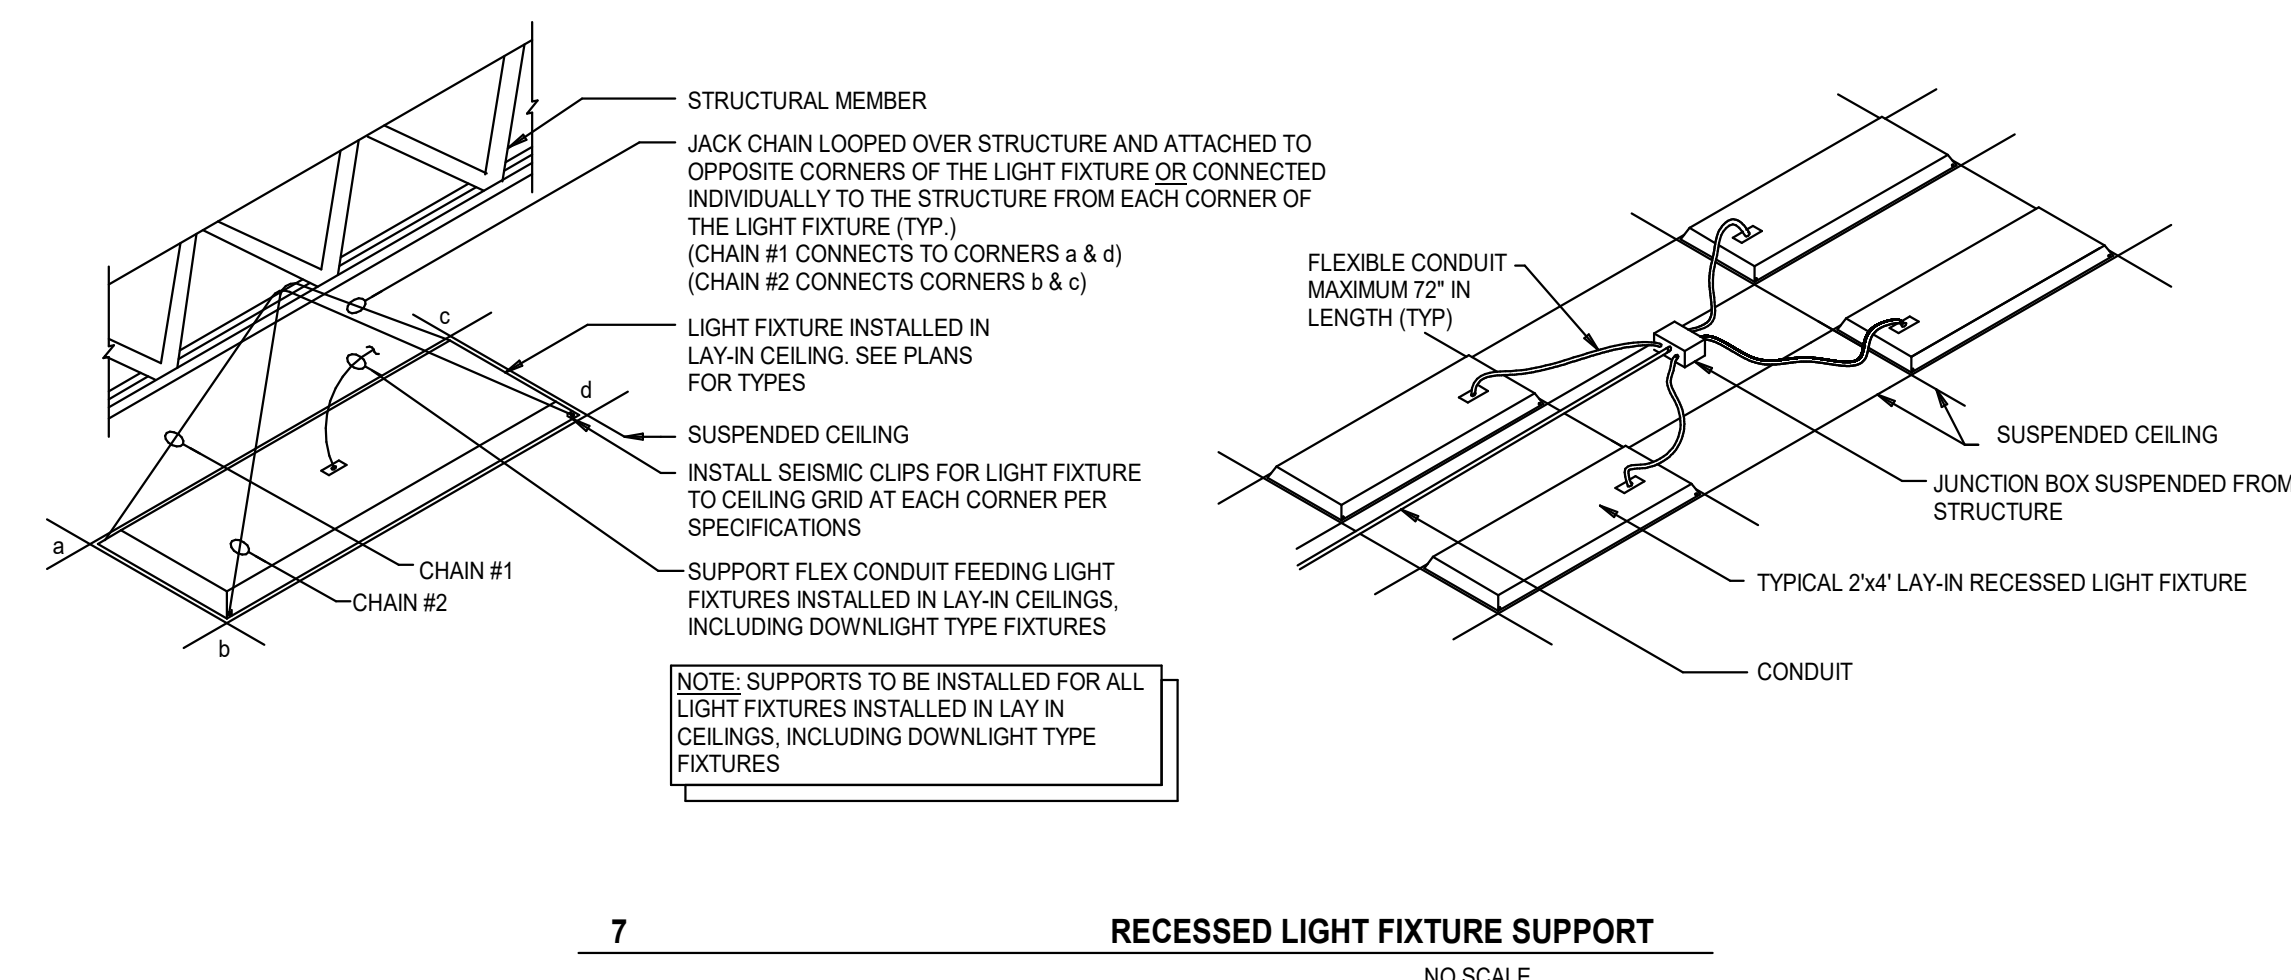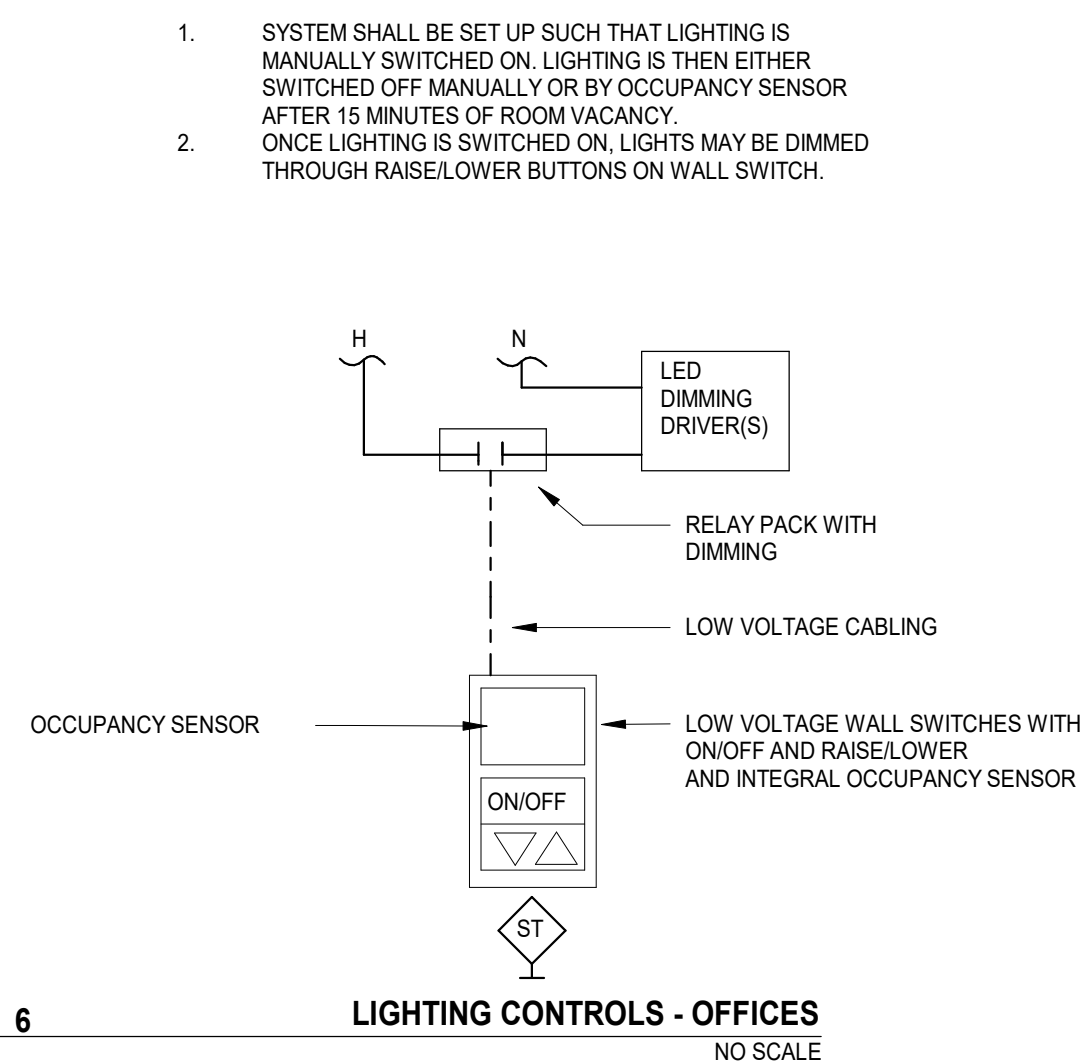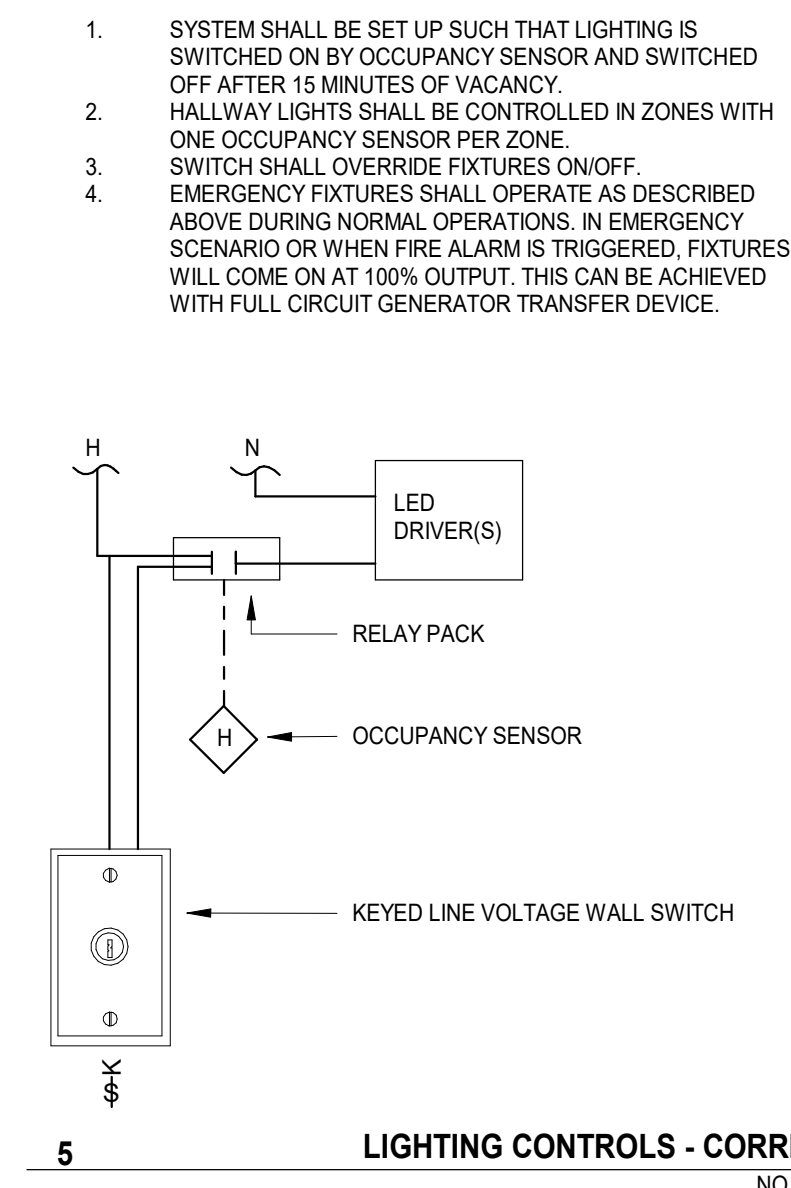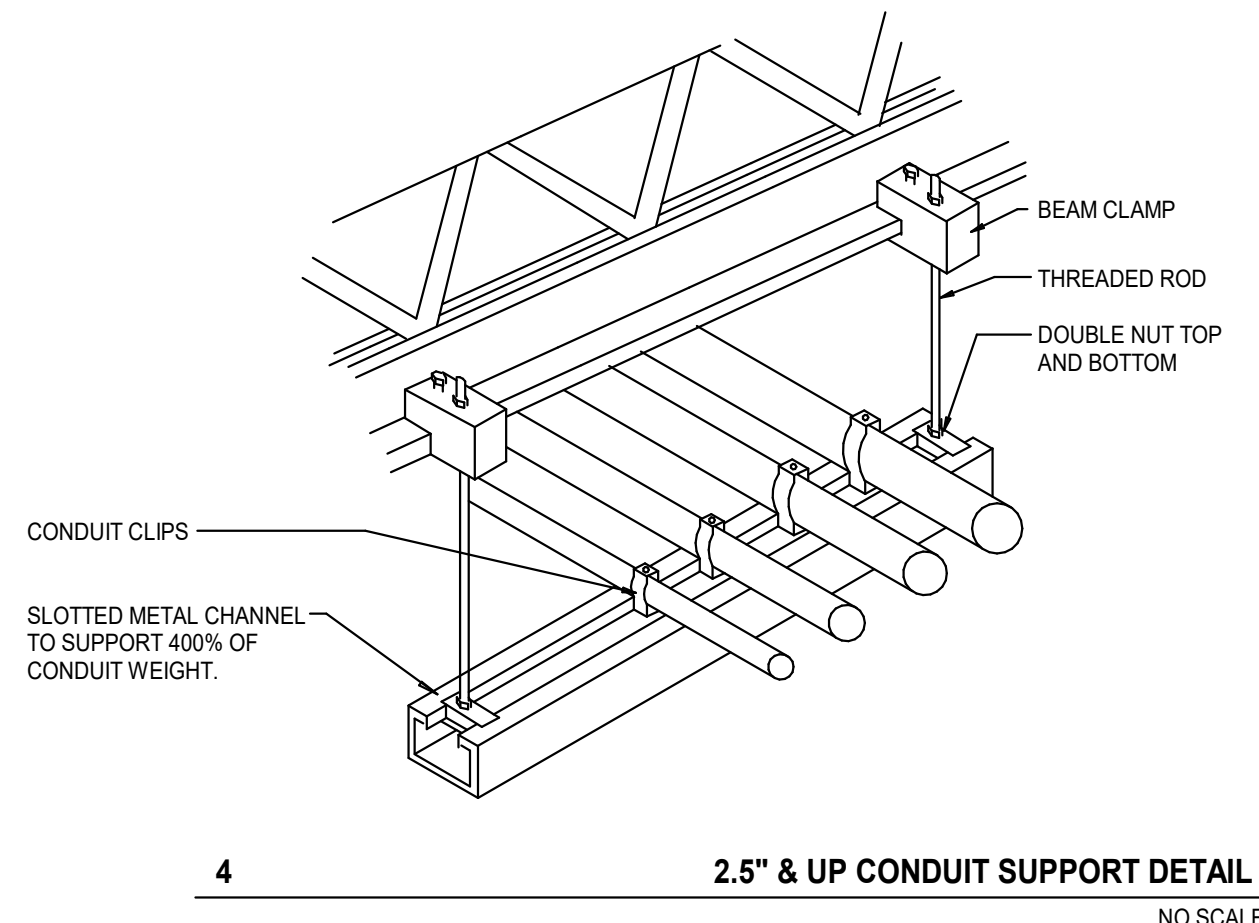

ZIONSVILLE
COMMUNITY HIGH
SCHOOL STADIUM
LOCKER BUILDING
ADDITION AND
RENOVATION

900 MULBERRY ST.
ZIONSVILLE IN, 46077

ZIONSVILLE COMMUNITY
SCHOOLS




ARCHITECT



317.848.0966 WWW.FHAI.COM
350 E NEW YORK ST, SUITE #300, INDIANAPOLIS, IN 46204

CONSULTANT

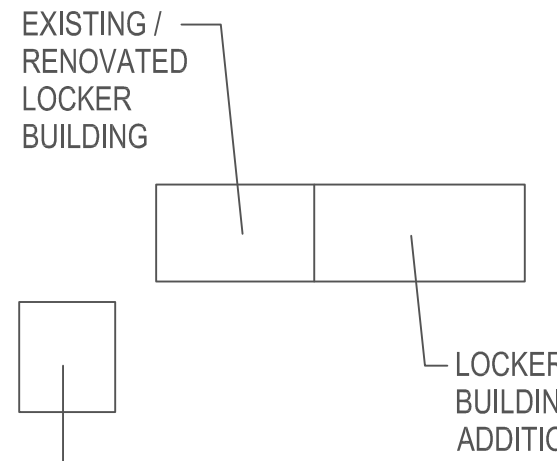

KEY PLAN

CONSTRUCTION DOCUMENTS



DRAWN BY: RDR
PROJECT NUMBER: 223139.00
PROJECT ISSUE DATE: 01-22-2024


REV.	DESCRIPTION	DATE
1	ADDENDUM #1	02.14.2024

ELECTRICAL SITE PLAN

E2.01

PLAN NOTES:

- S1 EXISTING LIGHT POLE AND FIXTURE TO BE RELOCATED. EXISTING CONCRETE BASE IS TO BE REMOVED.
- S2 NEW LOCATION OF EXISTING LIGHTPOLE AND FIXTURE ON A NEW CONCRETE BASE. EXTEND EXISTING CIRCUITY AND NEW CONDUIT TO NEW LOCATION.
- S3 REMOVE EXISTING SITE ELECTRICAL HANDHOLE.
- S4 NEW 3-INCH CONDUIT IS TO INTERCEPT EXISTING 3-INCH CONDUIT AND IS TO BE RUN TO THE LOCATION OF NEW PANELBOARD "H5" THEN STUBBED UP ABOVE THE FLOOR.

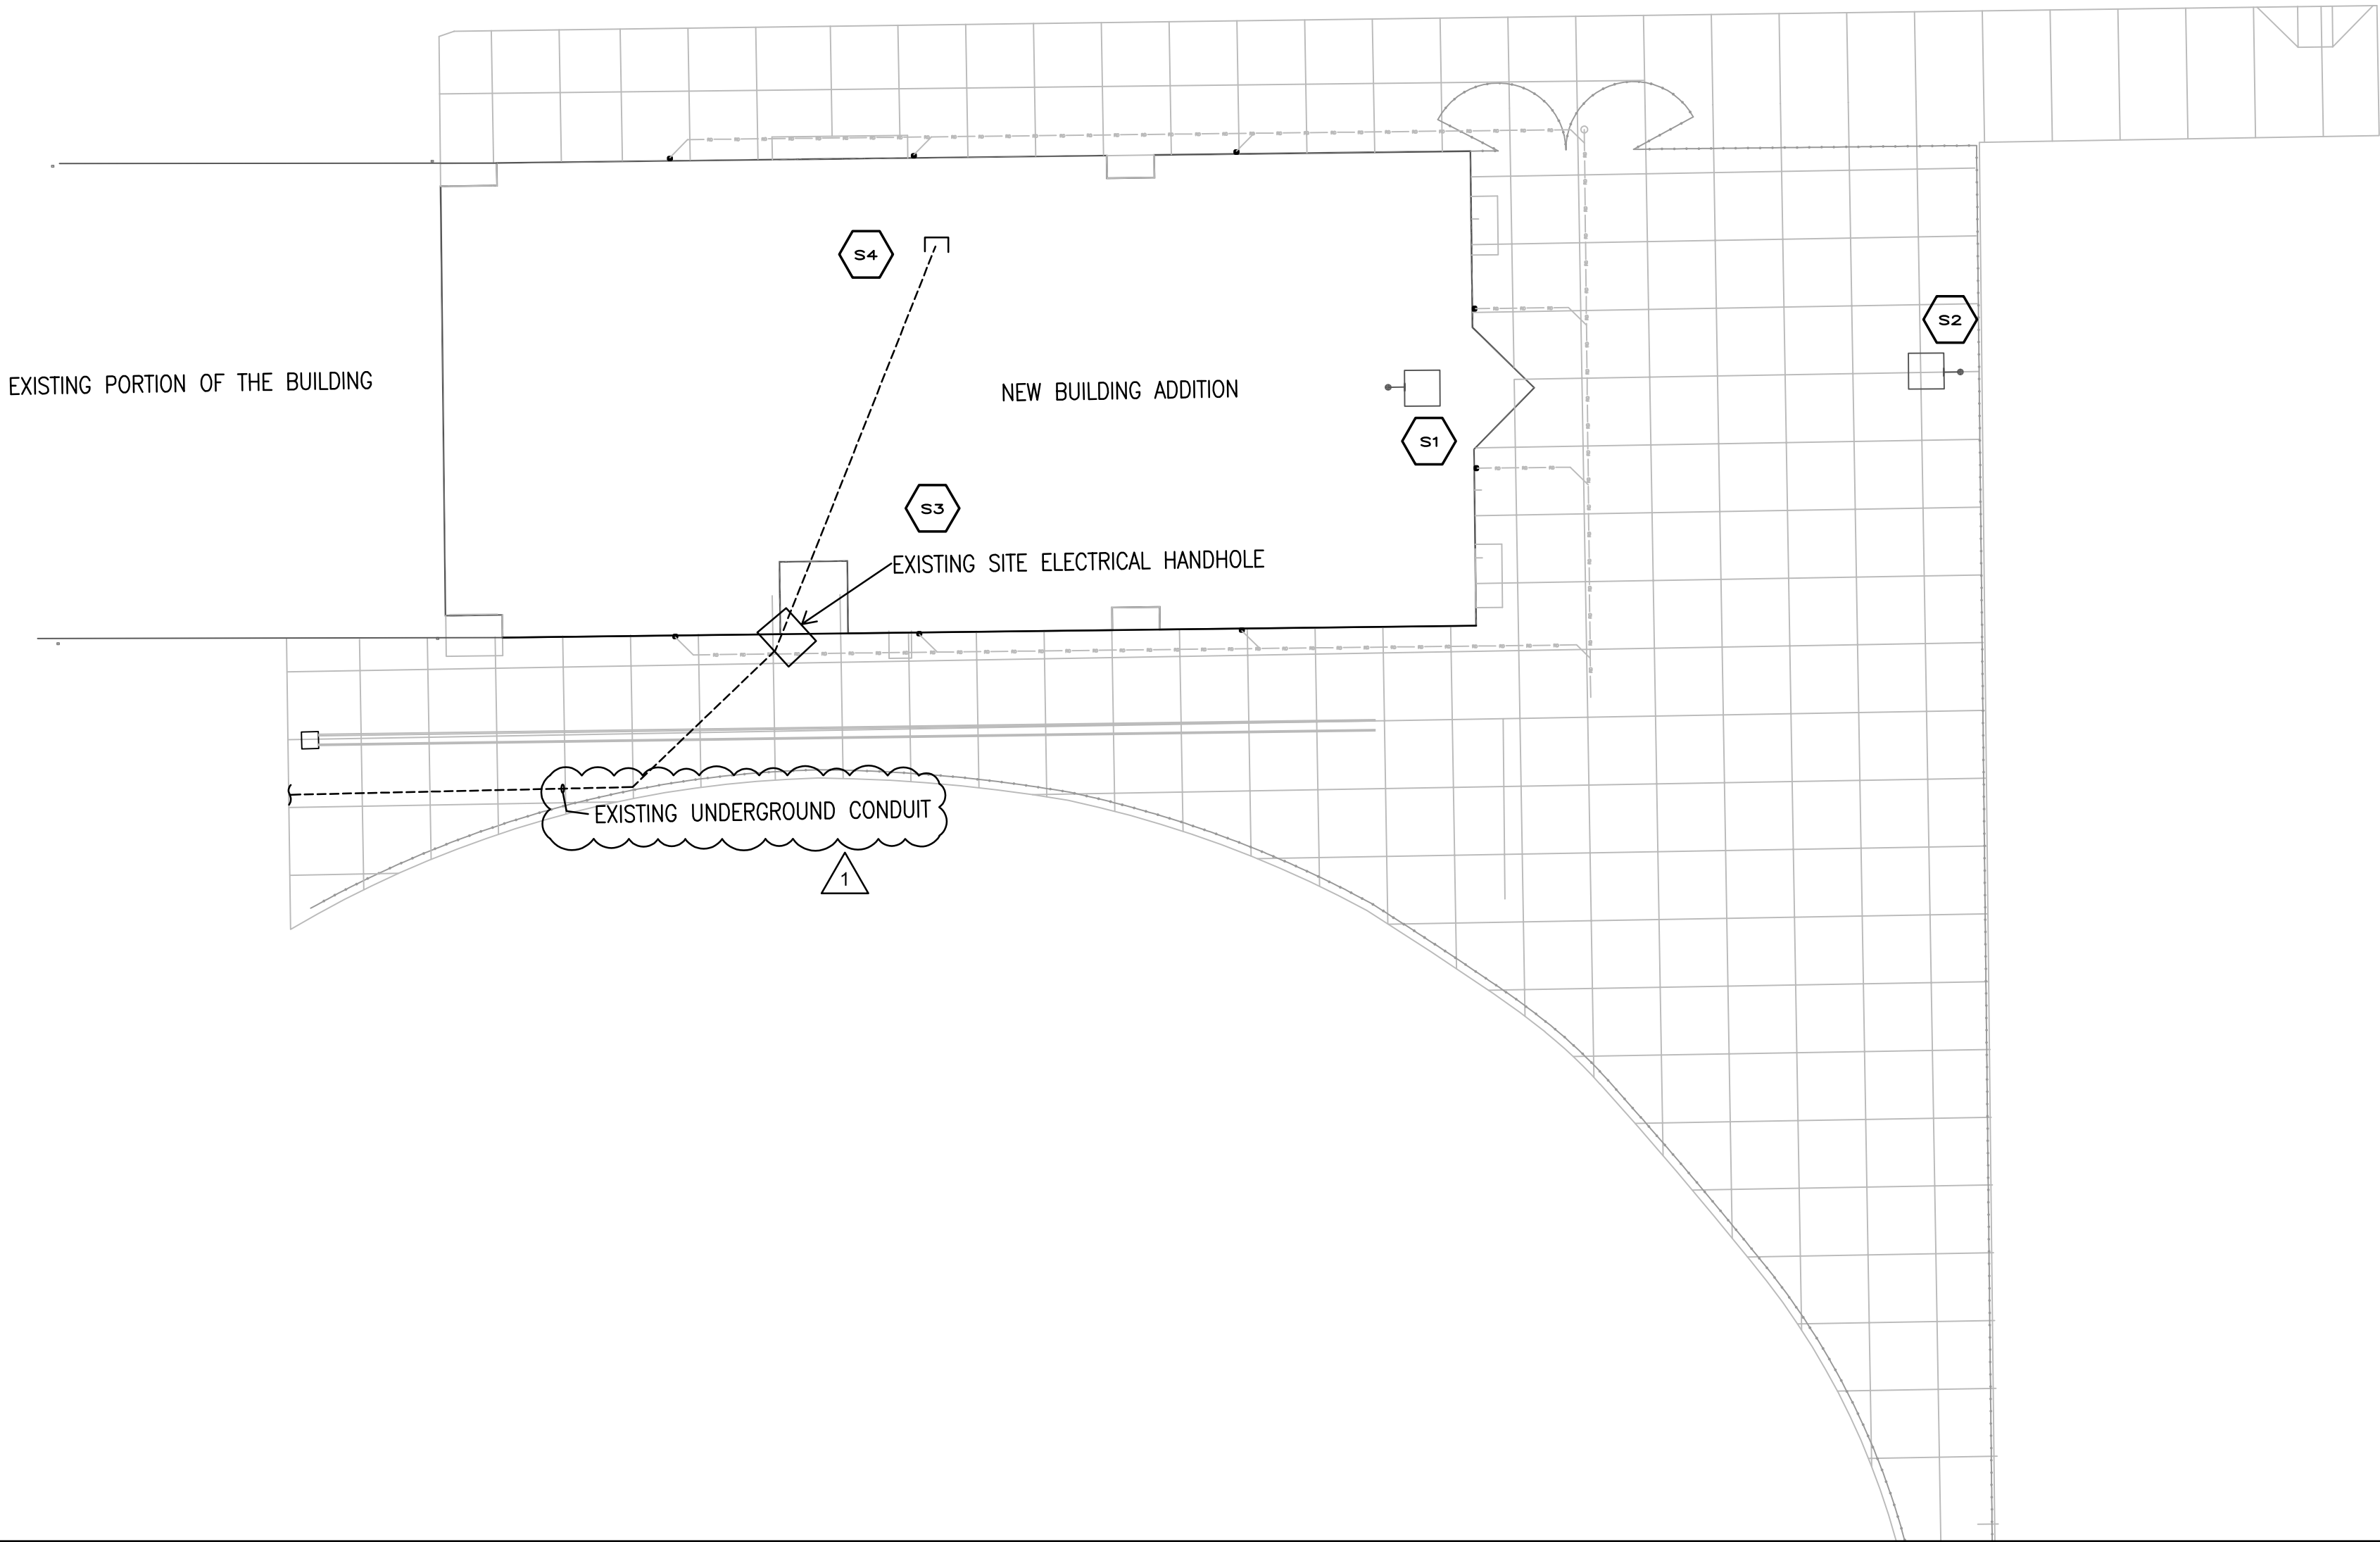

ELECTRICAL SITE PLAN

1" = 20'-0"

**ZIONSVILLE
COMMUNITY HIGH
SCHOOL STADIUM
LOCKER BUILDING
ADDITION AND
RENOVATION**

900 MULBERRY ST.
ZIONSVILLE IN, 46077

**ZIONSVILLE COMMUNITY
SCHOOLS**



ARCHITECT



**FANNING
HOWEY**

317.848.0966 WWW.FHAI.COM
350 E NEW YORK ST, SUITE #300, INDIANAPOLIS, IN 46204

CONSULTANT

ROOM LEGEND - FIRST FLOOR UNIT A		
ROOM NO.	ROOM NAME	AREA (SF)
A101	TOILET	64 SF
A102	TEAM ROOM	1212 SF
A103	SMALL TEAM ROOM / HOSPITALITY	242 SF
A104	SMALL TEAM ROOM	262 SF
A105	ENTRY	180 SF
A106	TEAM ROOM	1184 SF
A107	COACH	226 SF
A108	COACH RESTROOM	116 SF
A109	STORAGE	210 SF
A110	MECHANICAL	212 SF
A111	FIRE PROTECTION	66 SF
A112	CUSTODIAL / STORAGE	118 SF
A113	STORAGE	234 SF
A114	COACH	229 SF
A115	COACH RESTROOM	116 SF
A116	ENTRY	179 SF
A117	COACH	266 SF
A118	COACH RESTROOM	67 SF
A119	TEAM ROOM	1206 SF
A120	CORRIDOR	130 SF
A121	SMALL TEAM ROOM	220 SF
A122	SMALL TEAM ROOM	273 SF
A123	CUSTODIAL	48 SF


GENERAL NOTES - POWER

- PROVIDE REINFORCED TYPE PANELBOARD DIRECTORIES FOR EACH PANELBOARD ABOVE AND MODIFIED DURING CONSTRUCTION. FIELD VERIFY EXISTING CONDUIT INFORMATION WITH OWNERS. PROVIDE CONDUIT INFORMATION TO MAINTENANCE. MAINTENANCE IS ACCURATE. UNPUSHED SPARE BREAKERS SHALL BE IN THE OFF POSITION. VOLTAGE PROTECTION RECEPTACLE TO BE MOUNTED ABOVE WALL MOUNTED CONDUIT. RECEPTACLE TO BE 18" ABOVE WALL.
- CONTRACTOR SHALL VERIFY ALL DIMENSIONS AND CLEARANCES AND ALL EXISTING FIELD CONDITIONS BEFORE STARTING CONSTRUCTION. COMMENCEMENT OF WORK SHALL BE DEPENDANT ON RECEIPT OF ALL NECESSARY PERMITS. CONTRACTOR SHALL BE ENCOURAGED, CONTACT THE ARCHITECT BEFORE PROCEEDING WITH WORK. LABEL EACH RECEPTACLE WITH THE PANEL NAME AND CIRCUIT NUMBER ON THE FACE OF THE PANEL. LABEL EACH PLATE WITH THE PANEL NAME AND CIRCUIT NUMBER.
- PROVIDE "GFCI PROTECTED" LABEL ON COVER PLATE FOR ANY "GFCI PROTECTED" DEVICES.
- CONTRACTOR SHALL INCREASE CIRCUIT CONDUCTOR SIZE TO COMPENSATE FOR VOLTAGE DROP DUE TO EXCESSIVE CIRCUIT LENGTHS. IN NO CASE SHALL VOLTAGE DROP EXCEED 3% TO THE LOADS.
- REFER TO MECHANICAL PLANS FOR LOCATION OF MECHANICAL EQUIPMENT. LOCATE DISCONNECT SWITCHES PER NEC.
- REFER TO ELECTRICAL SCHEMATIC MECHANICAL DRAWINGS FOR ADDITIONAL CONDUIT, WIRING AND CONDUIT CONNECTIONS.
- ALL DEVICES, EQUIPMENT FIXTURES, AND THE LINE, SHALL BE BONDED WITH A PROTECTED EQUIPMENT BONDING SYSTEM. PROVIDE MECHANICAL AND ELECTRICAL BONDS OF METALLIC RACEWAY SYSTEM.


KEYNOTES

P1	WIRE TO A SPARE 20 AMP, 1-POLE CIRCUIT BREAKER IN THE DESIGNATED PANELBOARD.
P2	VERIFY LOCATION OF CEILING MOUNTED DUPE RECEPTACLE WITH THE VIDEO PROJECTOR LOCATION. WIRE TO EXISTING CEILING MOUNTED RECEPTACLE CIRCUIT.
P3	CEILING MOUNTED RECEPTACLE TO EXISTING CEILING MOUNTED RECEPTACLE CIRCUIT.
P4	WIRE NEW RECEPTACLE TO THE EXISTING CIRCUIT AT THIS LOCATION.
P5	EXISTING GAME CLOCK RECEPTACLE, MOUNTED UP HIGH.
P6	SECURITY GUARD BOMB MOUNTED ABOVE CEILING FOR THE DOOR SECURITY DEVICES AND POWER. WIRE TO NEAREST 20 AMP, 1-POL CIRCUIT IN THIS ROOM.
P7	NEW CEILING MOUNTED DUPE RECEPTACLE FOR THE VIDEO PROJECTOR. COORDINATE EXACT LOCATION IN THE FIELD WITH THE VIDEO PROJECTOR LOCATION.
P8	PROVIDE A DOUBLE EXCEPT RECEPTACLE ADJACENT TO TECHNOLOGY DATA BOX AT 65 INCHES AFF. BEHIND THE DESK WAY TO THE RIGHT. REFER TO THE "AS-BUILT" DRAWING FOR "A" SERIES DRAWINGS FOR CABINET CUT OUT LOCATION PRIOR TO ROUGH-IN.
P9	WIRE NEW RECEPTACLE TO EXISTING RECEPTACLE CIRCUIT IN THIS ROOM.
P10	COORDINATE THE LOCATION OF THE VIDEO PROJECTOR WITH THE VIDEO REFERENCED LOCATION AND REQUIREMENTS WITH THE INSTALLER PRIOR TO ROUGH-IN.

EXISTING /
RENOVATED
LOCKER
BUILDING

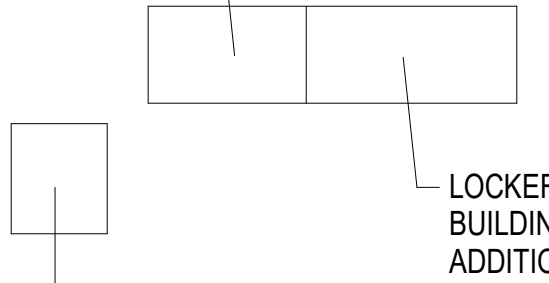


EXISTING
CONCESSIONS
BUILDING

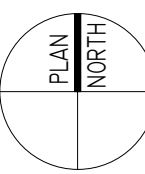

KEY PLAN

CONSTRUCTION DOCUMENTS

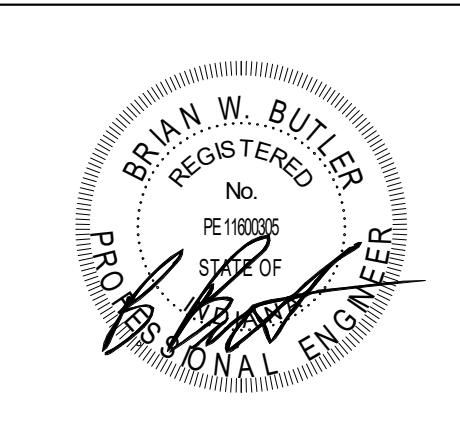

DRAWN BY: RDR


PROJECT NUMBER: 223139.00

PROJECT ISSUE DATE: 01.22.2024

[illegible]

UNIT A - FIRST FLOOR POWER PLAN

E5.01

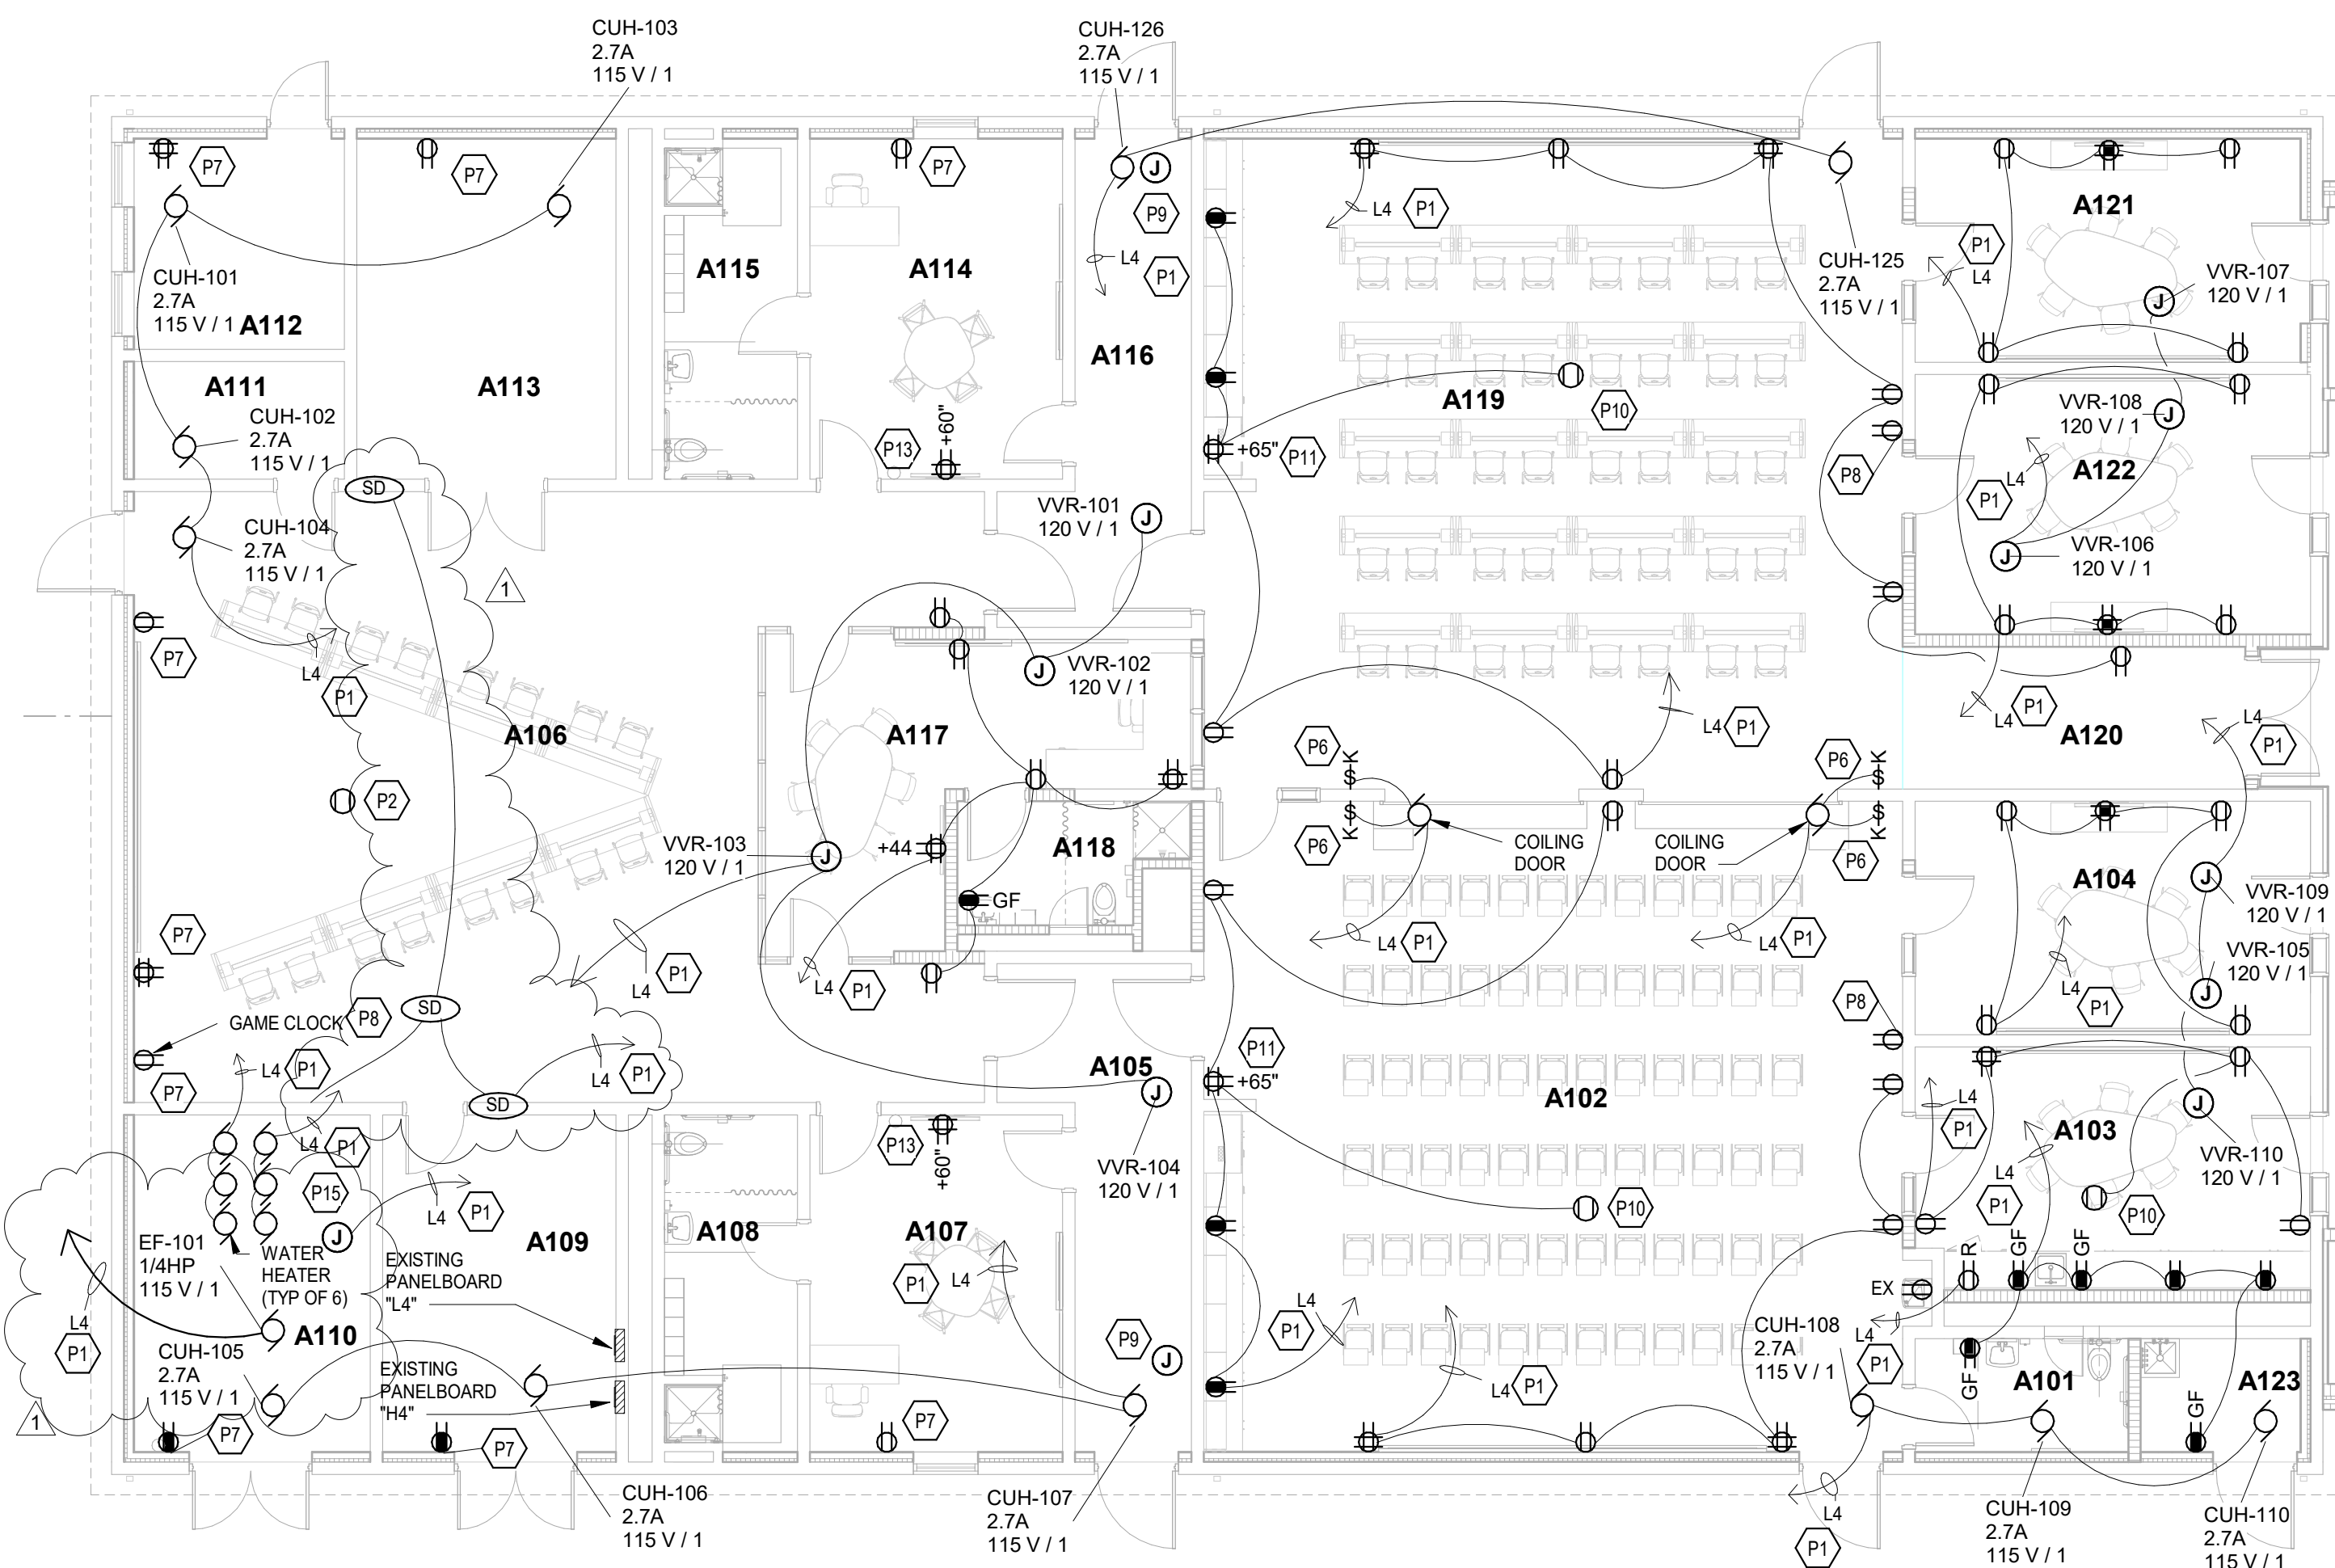

UNIT A - FIRST FLOOR POWER PLAN



GENERAL NOTES - POWER

- | KEYNOTES | |
|----------|--|
| P3 | TECHNOLOGY RACK (IDF) RECEPTACLE. COORDINATE MOUNTING LOCATION AND INSTALLATION REQUIREMENTS WITH THE TECHNOLOGY CONTRACTOR PRIOR TO ROUGH-IN. WIRE WITH #10 CONDUCTORS. |
| P4 | TECHNOLOGY RACK (IDF) BACKBOARD RECEPTABLES. REFER TO DETAIL "2E1-103" FOR MOUNTING LOCATIONS AND REQUIREMENTS. WIRE WITH #10 CONDUCTORS. |
| P5 | WIRE RECEPTACLE BEHIND THE WASHT PROVIDED TO THE GFI FEED THROUGH TERMINALS OF THE ADJACENT GFI RECEPTACLE TO PROTECT THE DOWN STREAM RECEPTABLES. |
| P6 | COILING DOWN CONTROL SWITCH PROVIDED BY THE COILING DOWN MANUFACTURER. |
| P9 | SECURITY JUNCTION BOX MOUNTED ABOVE CEILING FOR THE DOOR SECURITY DEVICES AND POWER. WIRE TO THE NEAREST DUPLEX RECEPTACLE CIRCUIT IN THIS ROOM. |
| P10 | VIDEO CEILING MOUNTED DUPLEX RECEPTACLE. COORDINATE WITH VIDEO CONTRACTOR. COORDINATE EXACT MOUNT LOCATION IN THE FIELD WITH THE VIDEO PROJECTOR LOCATION. |
| P12 | MOUNT NEW GAME CLOCK RECEPTACLE AT THE SAME HEIGHT AS THE EXISTING GAME CLOCK RECEPTABLES WITH #12. |
| P14 | AUTOMATIC DOWN OPERATOR MOTOR, PUSH BUTTONS AND KEYPAD SWITCH BY THE UNIT MANUFACTURER. CONSULT BACKBOXES AND POWER WIRING ARE PROVIDED BY THE DIVISION 26 INSTALLER PRIOR TO THE MANUFACTURERS REQUIREMENTS. LOCATIONS SHOWN ON THIS DRAWING. SHEET ARE FOR REFERENCE ONLY. VERIFY EXACT MOUNTING LOCATIONS WITH OPERATOR CONTRACTOR PRIOR TO ROUGH-IN. |
| P15 | AUTOMATIC GAS SHUT-OFF SYSTEM BY THE DIVISION 22 CONTRACTOR. VERIFY EXACT LOCATION AND REQUIREMENTS PRIOR TO ROUGH-IN. |
| P16 | RECEPTACLE IS TO BE MOUNTED TO WALL ADJACENT TO THE ROOFTOP PUT-IN UNIT. |



E5.02

C:\Users\jlemon\Documents\2021_ELEC_223139_00_anheman\FNSN.rvt
2/13/2024 11:19:31 AM

ZIONSVILLE
COMMUNITY HIGH
SCHOOL STADIUM
LOCKER BUILDING
ADDITION AND
RENOVATION

900 MULBERRY ST.
ZIONSVILLE IN, 46077

ZIONSVILLE COMMUNITY
SCHOOLS




ARCHITECT




317.848.0966 WWW.FHAI.COM
350 E NEW YORK ST, SUITE #300, INDIANAPOLIS, IN 46204

CONSULTANT

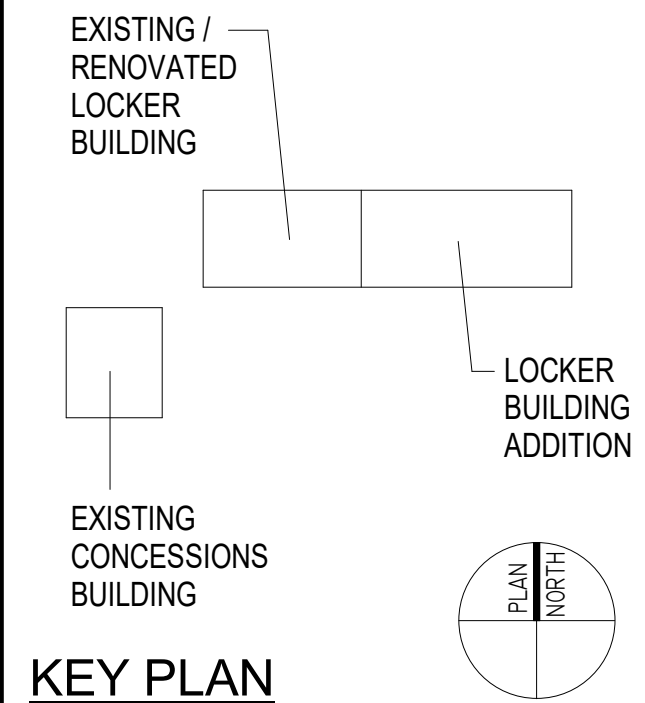

KEY PLAN

CONSTRUCTION DOCUMENTS

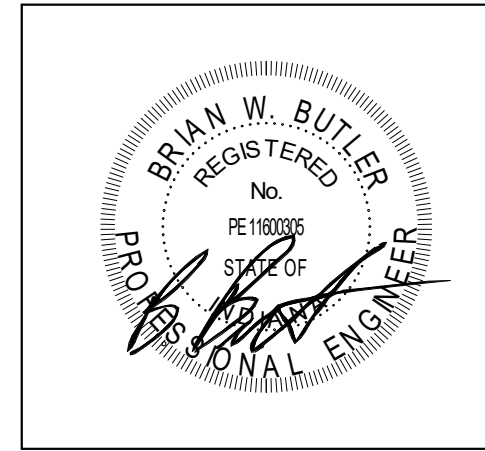

DRAWN BY: ROR

PROJECT NUMBER: 223139.00

PROJECT ISSUE DATE: 01/22/2024

REV. NO.	DESCRIPTION	DATE
1	ADDENDUM #1	02/14/2024

UNIT A - FIRST FLOOR FIRE ALARM
PLAN

E6.01


ROOM LEGEND - FIRST FLOOR UNIT A		
ROOM NO.	ROOM NAME	AREA (SF)
A101	TOILET	64 SF
A102	TEAM ROOM	1212 SF
A103	SMALL TEAM ROOM / HOSPITALITY	252 SF
A104	SMALL TEAM ROOM	245 SF
A105	ENTRY	180 SF
A106	TEAM ROOM	1184 SF
A107	COACH	226 SF
A108	COACH RESTROOM	116 SF
A109	STORAGE	209 SF
A110	MECHANICAL	212 SF
A111	FIRE PROTECTION	66 SF
A112	CUSTODIAL / STORAGE	118 SF
A113	STORAGE	234 SF
A114	COACH	229 SF
A115	COACH RESTROOM	118 SF
A116	ENTRY	179 SF
A117	COACH	256 SF
A118	COACH RESTROOM	67 SF
A119	TEAM ROOM	1206 SF
A120	CORRIDOR	130 SF
A121	SMALL TEAM ROOM	229 SF
A122	SMALL TEAM ROOM	273 SF
A123	CUSTODIAL	48 SF

GENERAL NOTES - FIRE ALARM

- QUANTITY AND LOCATION OF TAMPER AND FLOW SWITCHES IS FOR BIDDING PURPOSES ONLY. VERIFY EXACT QUANTITY AND LOCATIONS WITH SPRINKLER CONTRACTOR PRIOR TO FIRE ALARM SHOP DRAWING SUBMITTAL.
- FIRE ALARM LAYOUT IS SHOWN FOR COVERAGE AREA ONLY. CONTRACTOR SHALL PROVIDE DEVICES AS REQUIRED FOR COMPLETE COVERAGE.
- PROVIDE A 20 AMP, 120V CIRCUIT AS REQUIRED FOR NEW NAC PANEL THAT IS ADDED.
- REUSE EXISTING FIRE ALARM BACK BOXES AND CONDUIT WHERE POSSIBLE FOR NEW FIRE ALARM DEVICES.


KEYNOTES

F1	WIRE ALL EXISTING FLOW SWITCHES AND SUPERVISORY VALVES TO THE NEW FIRE ALARM SYSTEM.
F2	WIRE EXISTING POST INDICATOR VALVE TAMPER SWITCH TO THE NEW FIRE ALARM SYSTEM.
F5	PROVIDE A CO2 (CARBON DIOXIDE) DETECTOR IN THIS ROOM AND INTEGRATE WITH THE FIRE ALARM SYSTEM.

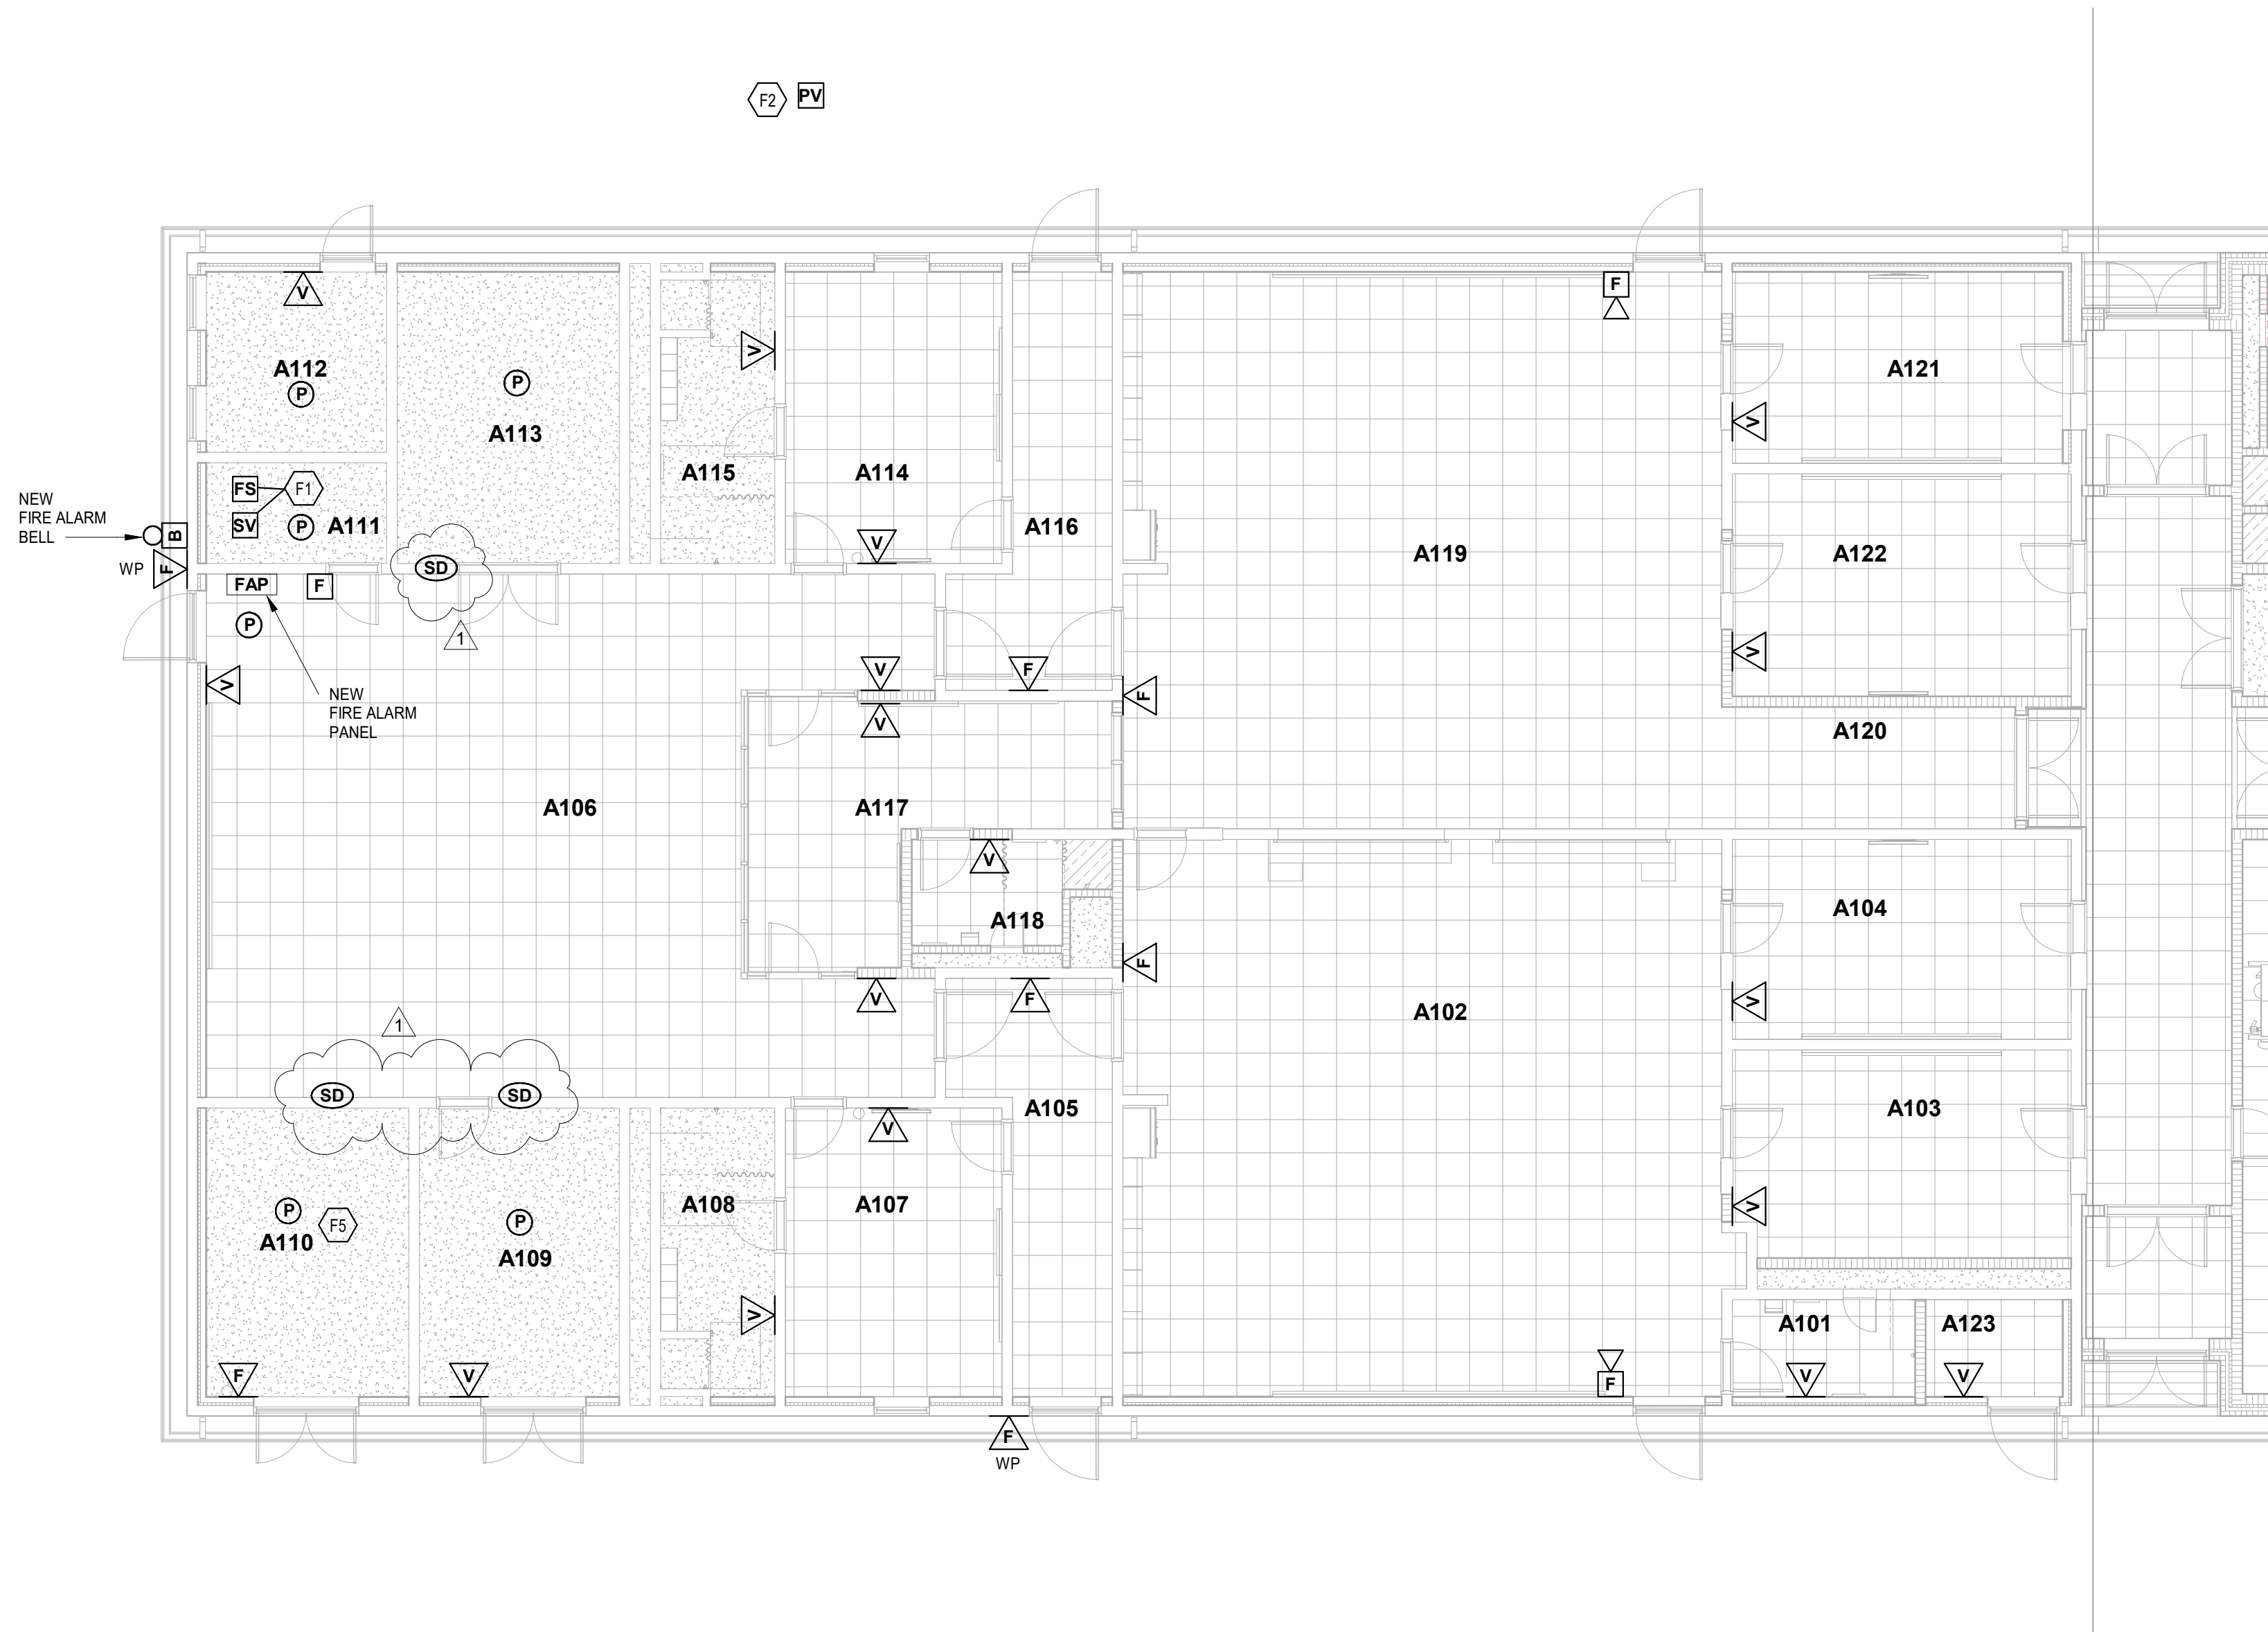

UNIT A - FIRST FLOOR FIRE ALARM PLAN
SCALE: 1/8" = 1'-0"

C:\Users\jlemon\Documents\2021_ELEC_223139_00_ahlemann\FNSN-v4
2/13/2024 11:19:25 AM

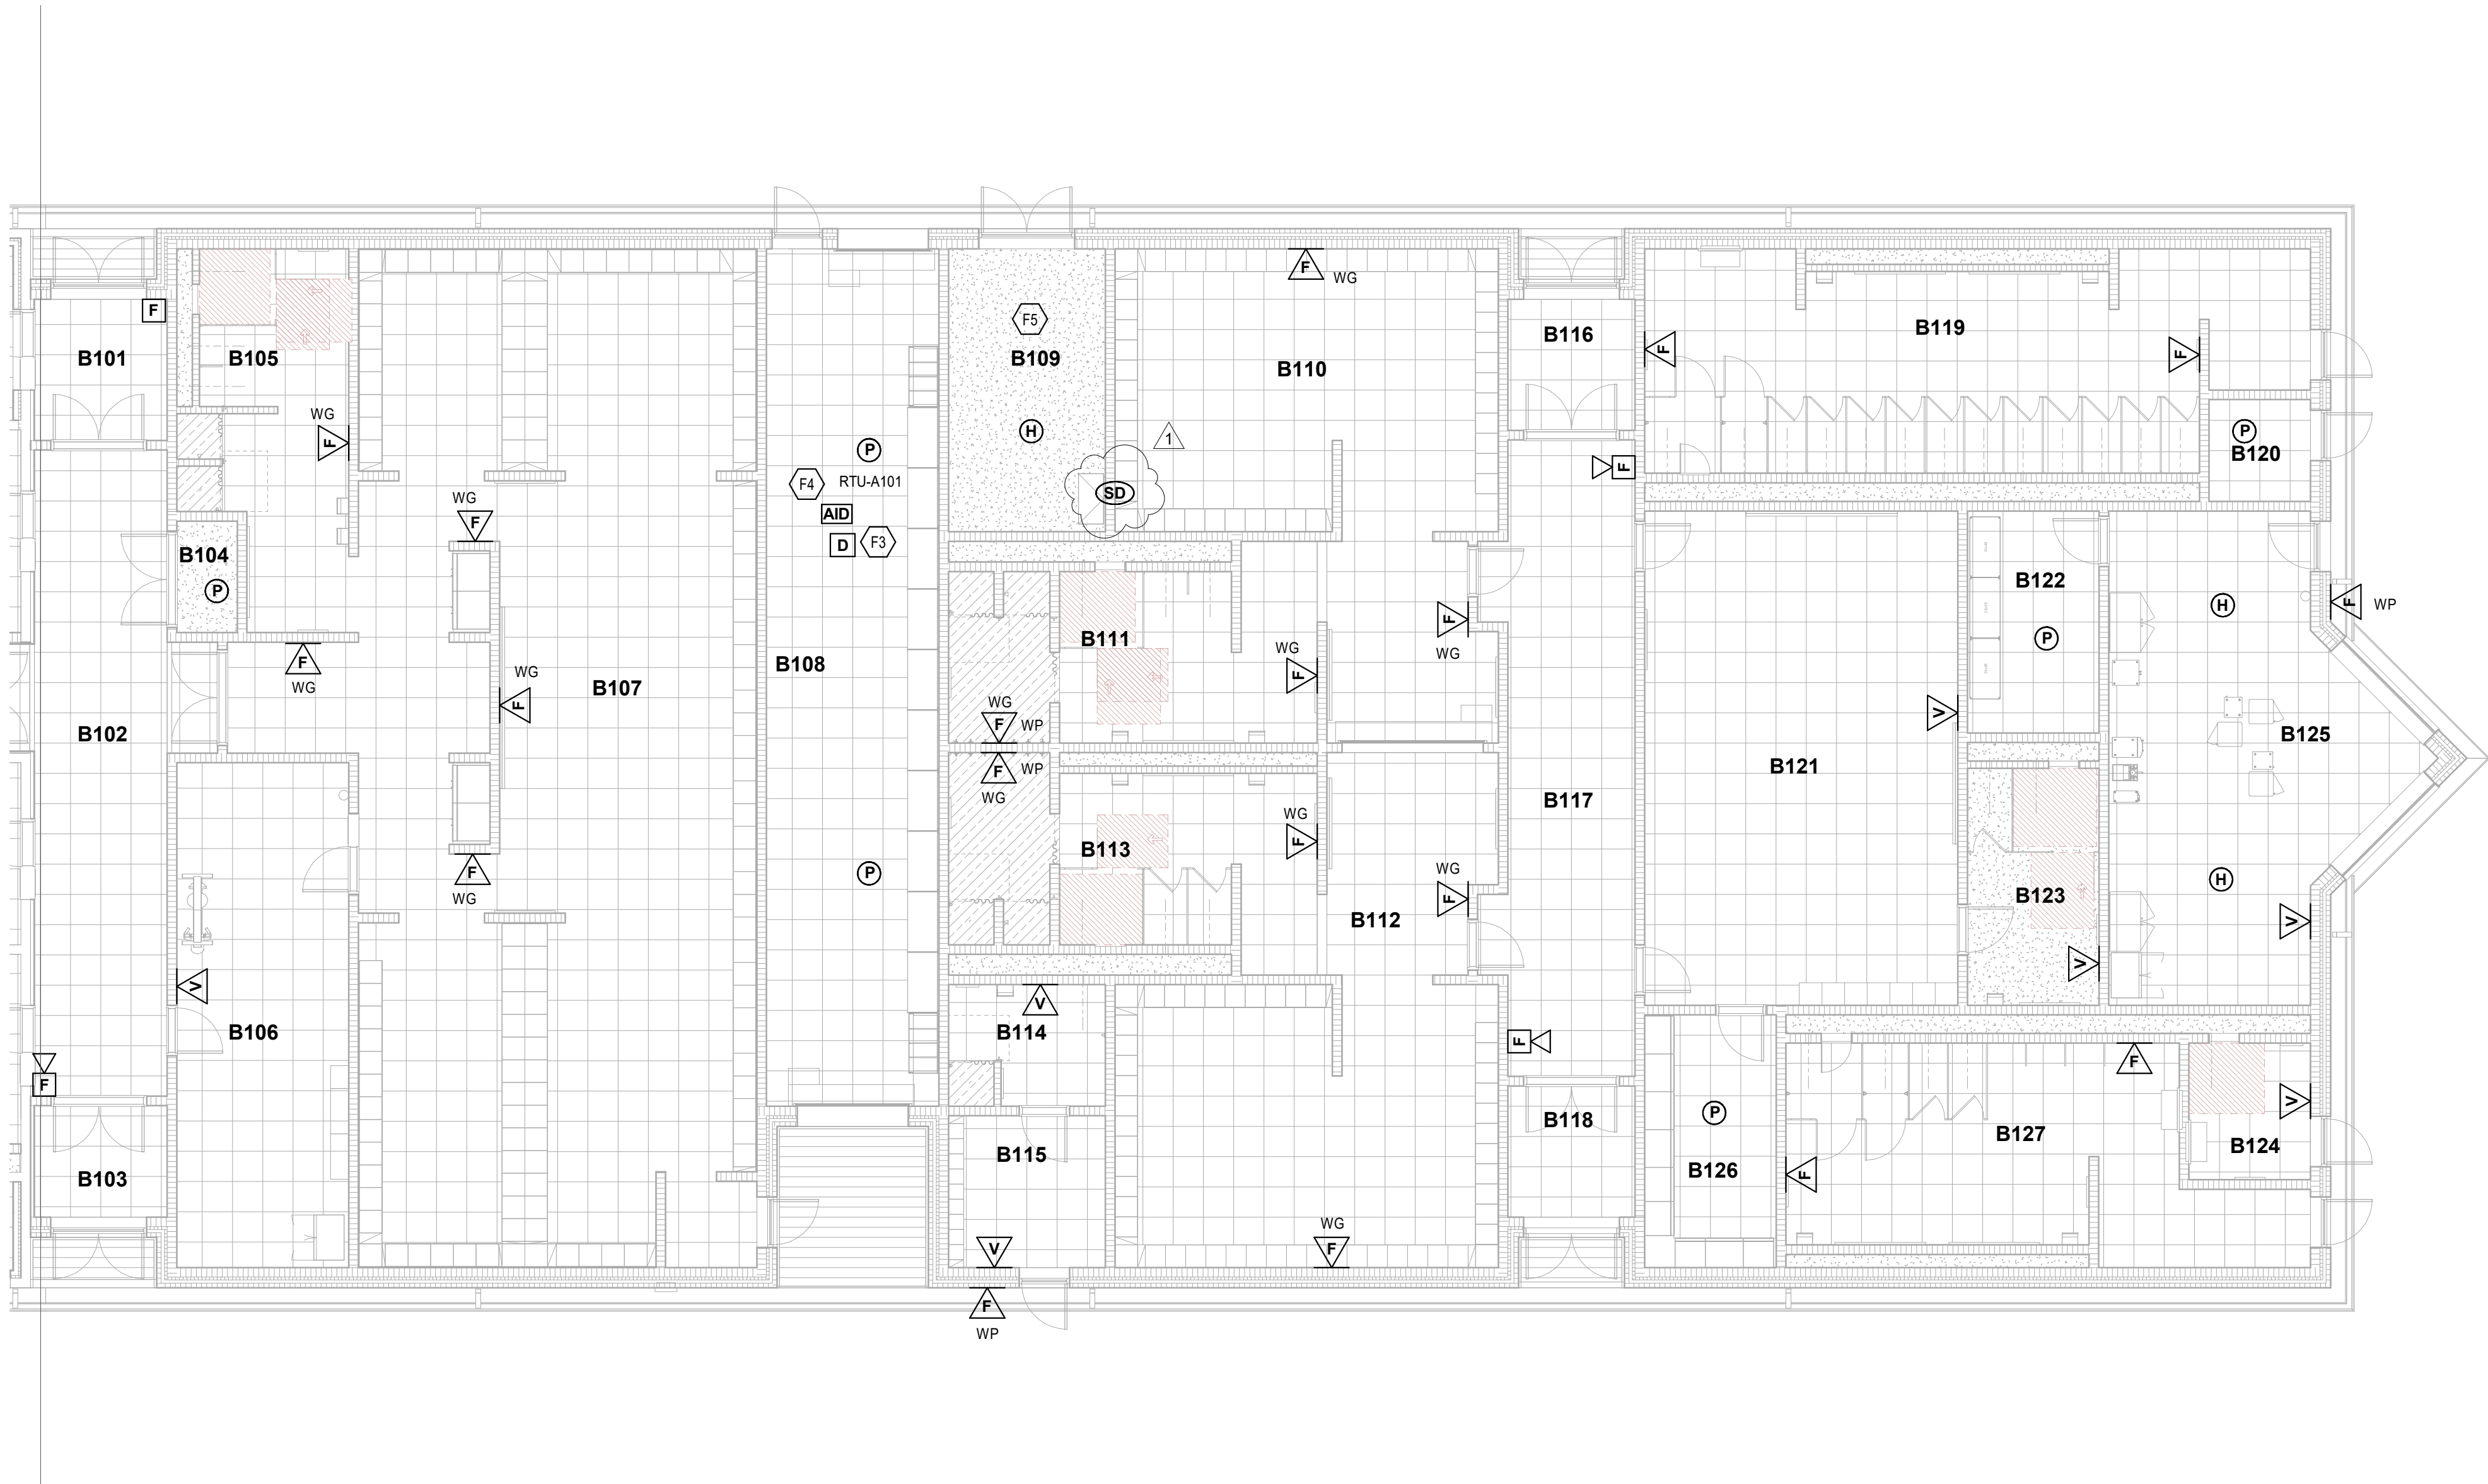

UNIT B - FIRST FLOOR FIRE ALARM PLAN
SCALE: 1/8" = 1'-0"

ROOM LEGEND - FIRST FLOOR UNIT B		
ROOM NO.	ROOM NAME	AREA (SF)
B101	VESTIBULE	82 SF
B102	CORRIDOR	424 SF
B103	VESTIBULE	65 SF
B104	IDF	29 SF
B105	SHOWERS / TOILETS	234 SF
B106	TRAINING ROOM	377 SF
B107	LOCKER ROOM	1353 SF
B108	STORAGE	646 SF
B109	MECHANICAL	194 SF
B110	LOCKER ROOM	613 SF
B111	SHOWERS / TOILETS	272 SF
B112	LOCKER ROOM	628 SF
B113	SHOWERS / TOILETS	281 SF
B114	OFFICIALS RESTROOM	82 SF
B115	OFFICIALS LOCKER	104 SF
B116	VESTIBULE	73 SF
B117	CORRIDOR	374 SF
B118	VESTIBULE	73 SF
B119	WOMEN'S RESTROOM	574 SF
B120	CUSTODIAL	45 SF
B121	COACHES OFFICE	676 SF
B122	STORAGE	128 SF
B123	COACHES RR	136 SF
B124	FAMILY RESTROOM	73 SF
B125	CONCESSIONS	607 SF
B126	STORAGE	145 SF
B127	MEN'S RESTROOM	396 SF

GENERAL NOTES - FIRE ALARM

1. QUANTITY AND LOCATION OF TAMPER AND FLOW SWITCHES IS FOR BIDDING PURPOSES ONLY. VERIFY EXACT QUANTITY AND LOCATIONS WITH SPRINKLER CONTRACTOR PRIOR TO FIRE ALARM SHOP DRAWING SUBMITTAL.
2. FIRE ALARM LAYOUT IS SHOWN FOR COVERAGE AREA ONLY. CONTRACTOR SHALL PROVIDE DEVICES AS REQUIRED FOR COMPLETE COVERAGE.
3. PROVIDE A 20 AMP, 120V CIRCUIT AS REQUIRED FOR NEW NAC PANEL THAT IS ADDED.
4. REUSE EXISTING FIRE ALARM BACK BOXES AND CONDUIT WHERE POSSIBLE FOR NEW FIRE ALARM DEVICES.

KEYNOTES	
F3	PROVIDE A DUCT MOUNTED SMOKE DETECTOR ON EACH OF THE SUPPLY AND RETURN AIR DUCTS FOR THIS MECHANICAL UNIT AT THIS LOCATION. VERIFY EXACT QUANTITIES IN THE FIELD.
F4	PROVIDE A DUCT MOUNTED RELAY.
F5	PROVIDE A CO2 (CARBON DIOXIDE) DETECTOR IN THIS ROOM AND INTEGRATE WITH THE FIRE ALARM SYSTEM.

COPYRIGHT 2024 BY FANNINGHOWEY ASSOCIATES, INC.

ZIONSVILLE
COMMUNITY HIGH
SCHOOL STADIUM
LOCKER BUILDING
ADDITION AND
RENOVATION

900 MULBERRY ST.
ZIONSVILLE IN, 46077

ZIONSVILLE COMMUNITY
SCHOOLS




ARCHITECT

**FANNING
HOWEY**


317.848.0966 WWW.FHAI.COM
350 E NEW YORK ST, SUITE #300, INDIANAPOLIS, IN 46204

CONSULTANT

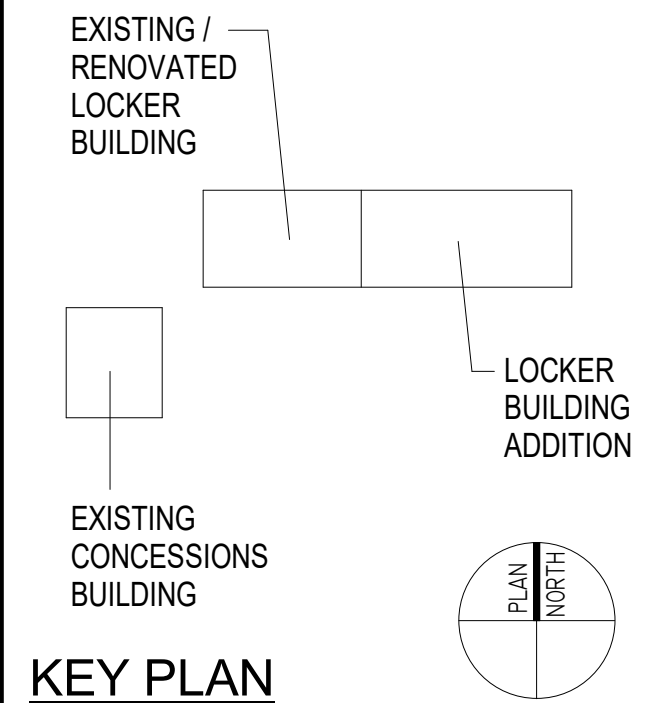

KEY PLAN

CONSTRUCTION DOCUMENTS

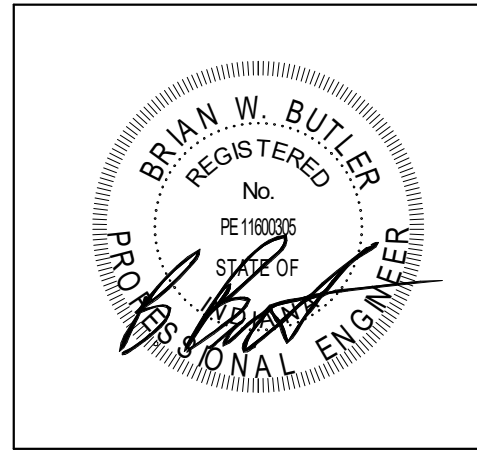

DRAWN BY: ROR

PROJECT NUMBER: 223139.00

PROJECT ISSUE DATE: 01/22/2024

REV. NO.	DESCRIPTION	DATE
1	ADDENDUM #1	02/14/2024

UNIT B - FIRST FLOOR FIRE ALARM
PLAN

E6.02

ZIONSVILLE
COMMUNITY HIGH
SCHOOL STADIUM
LOCKER BUILDING
ADDITION AND
RENOVATION

900 MULBERRY ST.
ZIONSVILLE IN, 46077

ZIONSVILLE COMMUNITY
SCHOOLS




ARCHITECT



317.848.0966 WWW.FHAI.COM
350 E NEW YORK ST, SUITE #300, INDIANAPOLIS, IN 46204

CONSULTANT

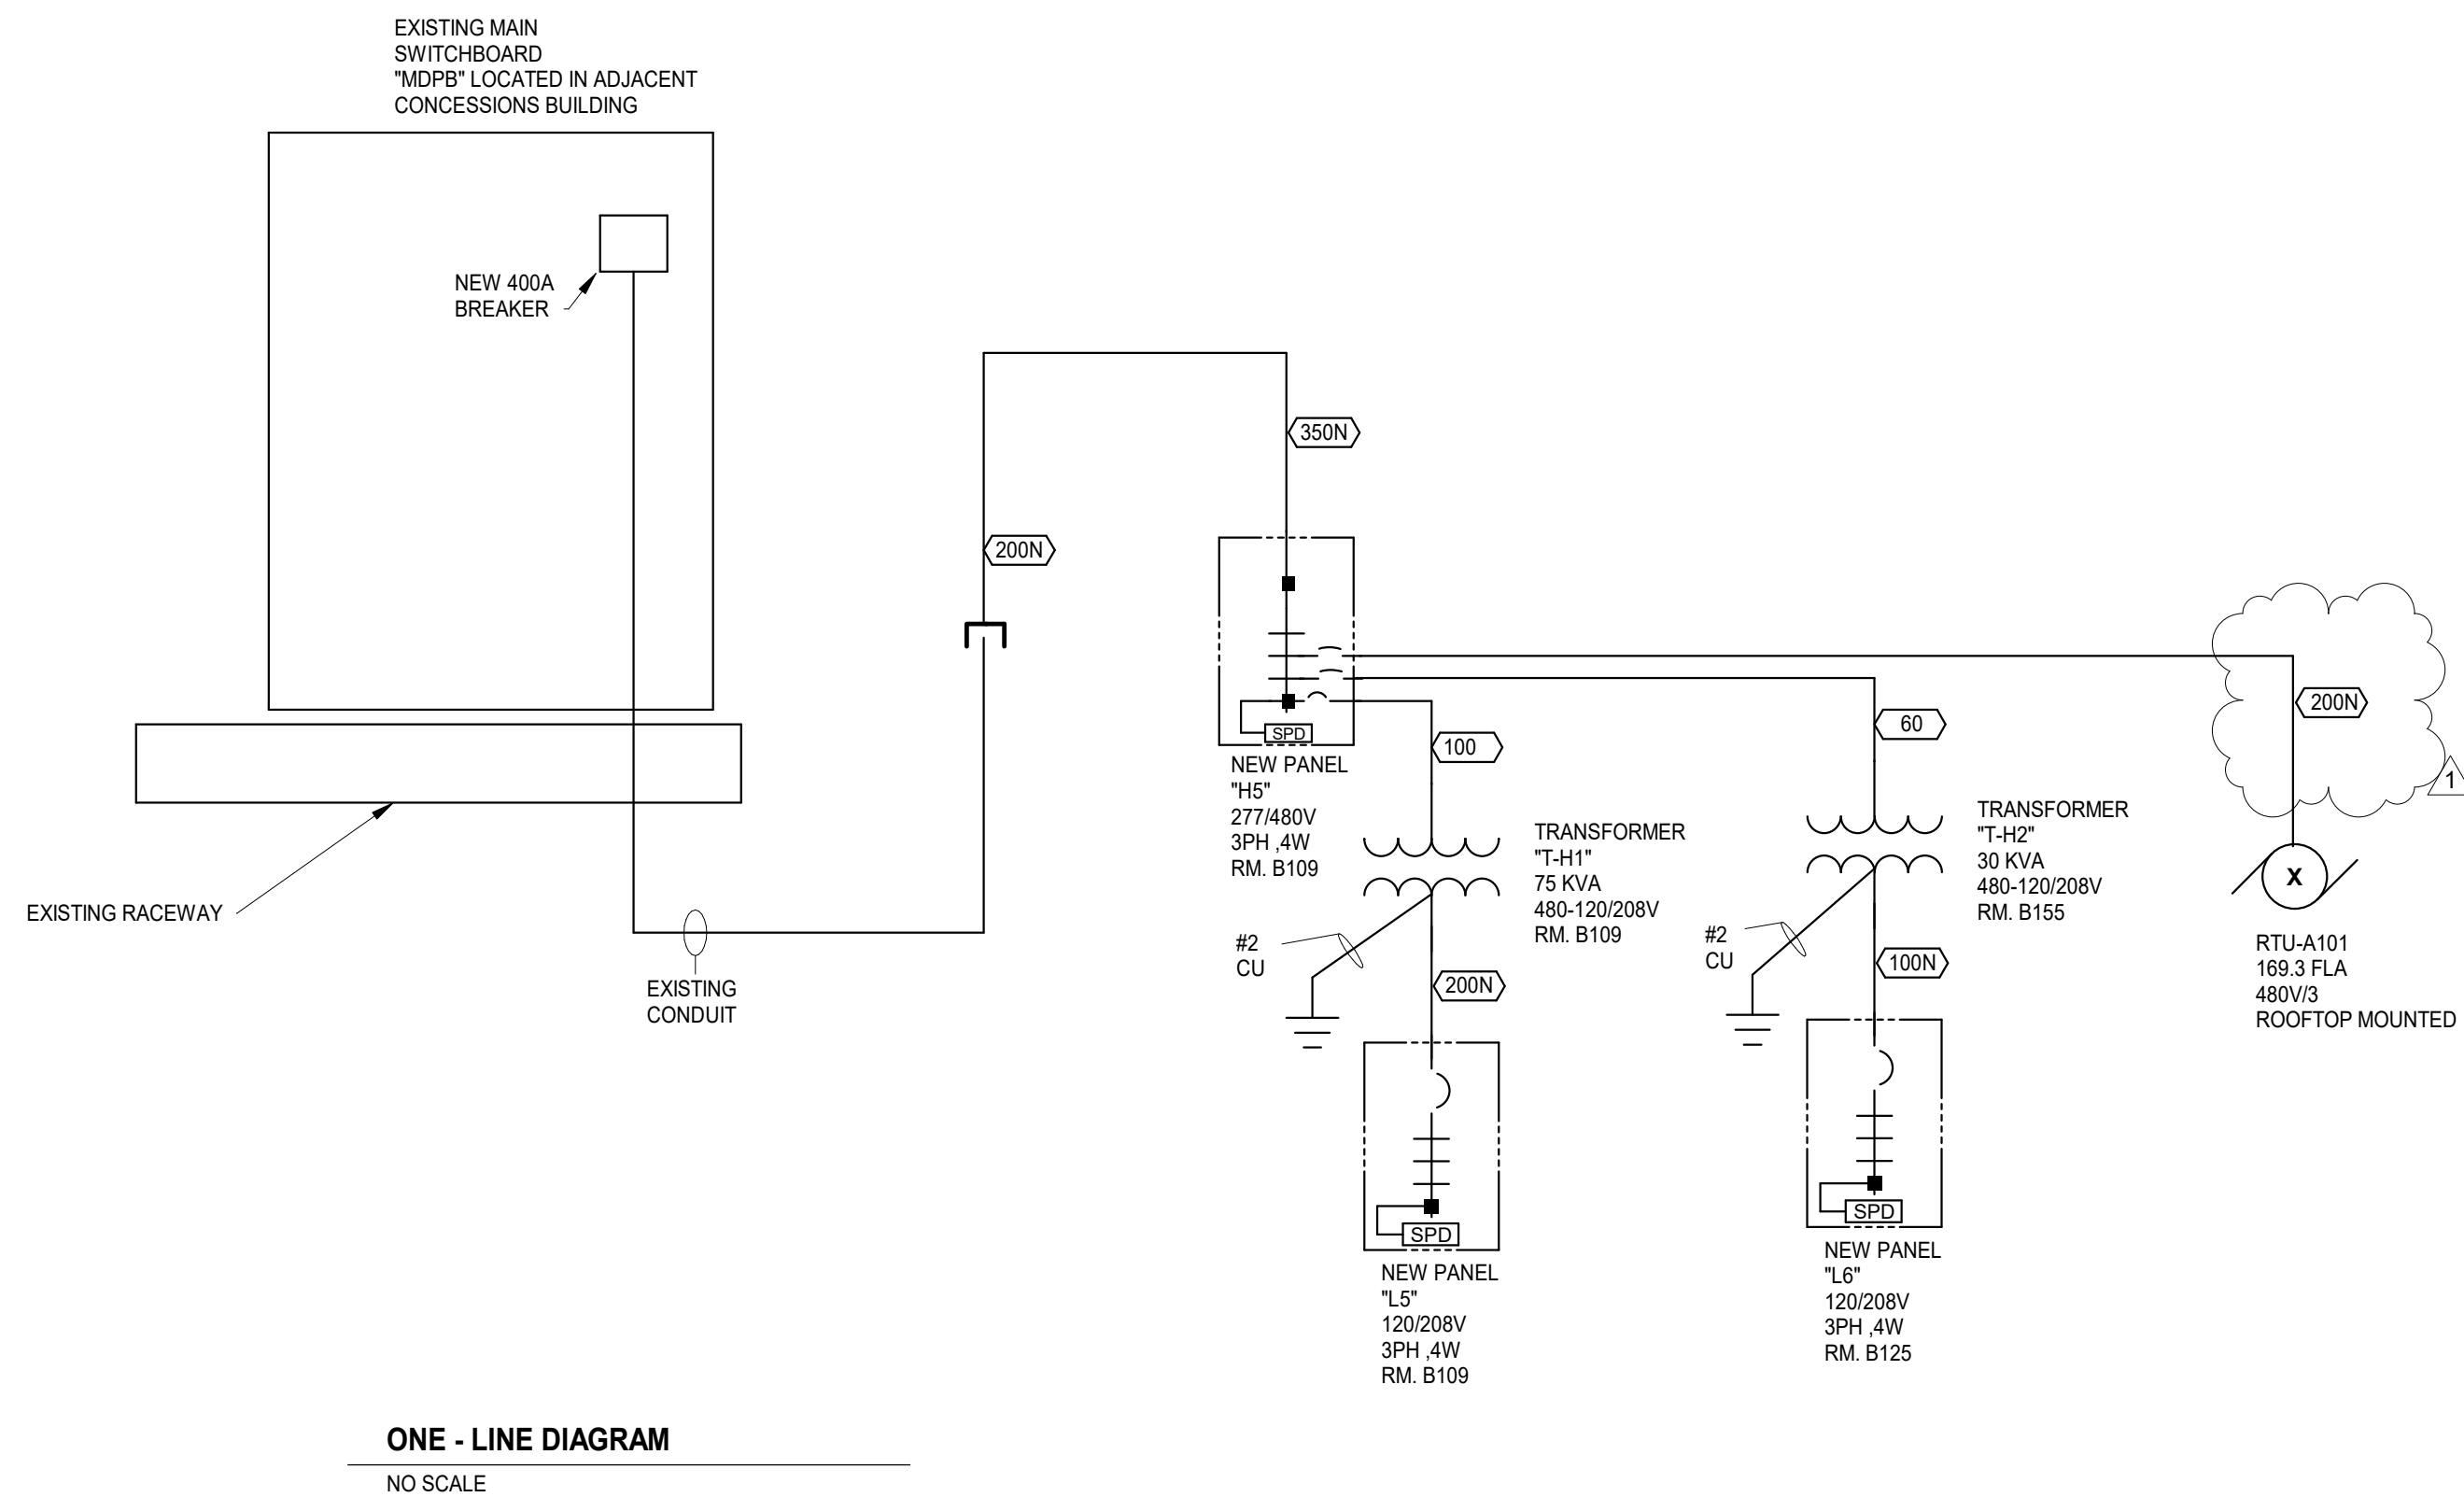


COPPER FEEDER SCHEDULE					
SOURCE 2014 NEC T310.15(B)(16), COPPER TSC, (THHW, THW, THWN, 90°C)					
X	NO.	CONDUCTOR SIZE			CONDUIT
FEEDER	OF	PHASE	NEUTRAL	GROUND	SIZE
LEGEND	SETS	QTY	(1)	(1)	KcIns
15	1	3 # 14			3/4
19N	1	3 # 14	#14	#14	3/4
20	1	3 # 12			3/4
20N	1	3 # 12	#12	#12	3/4
30	1	3 # 10			3/4
30N	1	3 # 10	#10	#10	3/4
40	1	3 # 8			3/4
40N	1	3 # 8	#8	#10	3/4
60	1	3 # 6			1
60N	1	3 # 6	#6	#10	1
80	1	3 # 4			1 1/4
80N	1	3 # 4	#4	#6	1 1/4
100	1	3 # 3			1 1/2
100N	1	3 # 3	#3	#6	1 1/2
125	1	3 # 1			2
125N	1	3 # 1	#1	#6	2
150	1	3 # 1/0			2
150N	1	3 # 1/0	#1/0	#6	2
175	1	3 # 2/0			2
175N	1	3 # 2/0	#2/0	#6	2
200	1	3 # 3/0			2
200N	1	3 # 3/0	#3/0	#6	2
225	1	3 # 4/0			2 1/2
225N	1	3 # 4/0	#4/0	#4	2 1/2
250	1	3 # 250			2 1/2
250N	1	3 # 250	#250	#4	2 1/2
300	1	3 # 350			3
300N	1	3 # 350	#350	#3	3
350	1	3 # 500			4
350N	1	3 # 500	#500	#3	4
400	1	3 # 600			4
400N	1	3 # 600	#600	#3	4
500	2	3 # 250			2 1/2
500N	2	3 # 250	#250	#2	2 1/2
600	2	3 # 350			3
600N	2	3 # 350	#350	#1	3
800	2	3 # 600			4
800N	2	3 # 600	#600	#1/0	4
1000	3	3 # 400			3
1000N	3	3 # 400	#400	#2/0	3
1200	3	3 # 600			4
1200N	3	3 # 600	#600	#3/0	4
1600	4	3 # 600			4
1600N	4	3 # 600	#600	#4/0	4
2000	5	3 # 600			4
2000N	5	3 # 600	#600	#250	4
2500	6	3 # 600			4
2500N	6	3 # 600	#600	#350	4
3000	7	3 # 600			4
3000N	7	3 # 600	#600	#400	4
3300	8	3 # 600			4
3300N	8	3 # 600	#600	#400	4
3700	9	3 # 600			4
3700N	9	3 # 600	#600	#400	4

ONE LINE DIAGRAM SYMBOLS

	MAIN LUG ONLY CIRCUIT BREAKER PANELBOARD, REFER TO E8 SERIES DRAWINGS FOR PANELBOARD SCHEDULES		DIGITAL ELECTRONIC POWER METER		COMBINATION MAGNETIC MOTOR STARTER WITH FUSED SWITCH		FUSED SWITCH IN SWITCHBOARD, 3P UNO		FUSED POTENTIAL TRANSFORMER
	MAIN BREAKER IN CIRCUIT BREAKER PANELBOARD, REFER TO E8 SERIES DRAWINGS FOR PANELBOARD SCHEDULES		KIRK KEY INTERLOCK		COMBINATION MAGNETIC MOTOR STARTER WITH CIRCUIT BREAKER		DISCONNECT SWITCH IN SWITCHBOARD, 3P UNO		CURRENT TRANSFORMERS, 3 UNO
	THROUGH FEED LUGS CIRCUIT BREAKER PANELBOARD, REFER TO E8 SERIES DRAWINGS FOR PANELBOARD SCHEDULES		UTILITY METER		COMBINATION MAGNETIC MOTOR STARTER WITH MOTOR CIRCUIT PROTECTOR		FUSED BOLTED PRESSURE SWITCH WITH GROUND FAULT AND SINGLE PHASE PROTECTION, 3P UNO		CAPACITOR
	MAIN DOUBLE LUG CIRCUIT BREAKER PANELBOARD, REFER TO E8 SERIES DRAWINGS FOR PANELBOARD SCHEDULES		TRANSFER SWITCH		DISCONNECT, 3P UNO		MOLDED CASE CIRCUIT BREAKER, 3P UNO		PLUG AND RECEPTACLE OR DRAWOUT DEVICE
	MAIN BREAKER IN CIRCUIT BREAKER PANELBOARD WITH SUB-FEED BREAKER, REFER TO E8 SERIES DRAWINGS FOR PANELBOARD SCHEDULES		SPD		CIRCUIT BREAKER IN SWITCHBOARD, 3P UNO		INSULATED CASED POWER CIRCUIT BREAKER WITH L.I.S.G. PROTECTION FEATURES, 3P UNO		POWER TRANSFORMER
	MAIN BREAKER IN CIRCUIT BREAKER PANELBOARD WITH INTEGRAL BUS CONNECTED SPD, REFER TO E8 SERIES DRAWINGS FOR PANELBOARD SCHEDULES		DRAWOUT CIRCUIT BREAKER, 3P UNO		SHUNT TRIP OPERATED CIRCUIT BREAKER		3 PHASE MOTOR. X INDICATES HORSEPOWER OR KILOWATTS		CONTROL PANEL, FURNISHED UNDER DIVISION 25
	MAIN BREAKER IN CIRCUIT BREAKER PANELBOARD WITH SPD MOUNTED ADJACENT WITH CLOSED NIPPLE, REFER TO E8 SERIES DRAWINGS FOR PANELBOARD SCHEDULES		GENERATOR						

CONSTRUCTION DOCUMENTS

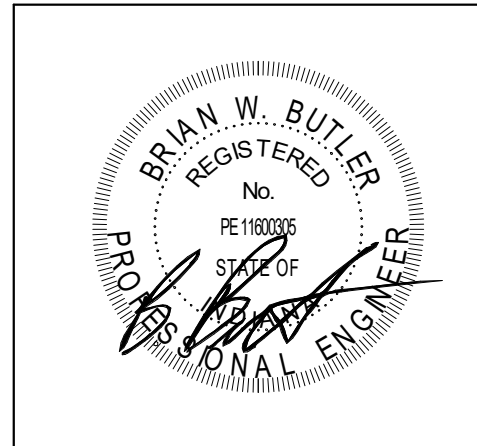

DRAWN BY: ROR		
PROJECT NUMBER: 223139.00		
PROJECT ISSUE DATE: 01.22.2024		
REV. NO.	DESCRIPTION	DATE
1	ADDENDUM #1	02.14.2024

ELECTRICAL ONE-LINE DIAGRAM

E7.01

ZIONSVILLE COMMUNITY HIGH SCHOOL STADIUM LOCKER BUILDING ADDITION AND RENOVATION

900 MULBERRY ST.
ZIONSVILLE IN, 46077

ZIONSVILLE COMMUNITY SCHOOLS



ZIONSVILLE
COMMUNITY SCHOOLS

ARCHITECT

FANNING HOWEY


317.848.0966

WWW.FHAI.COM

350 S NEW YORK ST, SUITE #300, INDIANAPOLIS, IN 46204

CONSULTANT

CONSTRUCTION DOCUMENTS

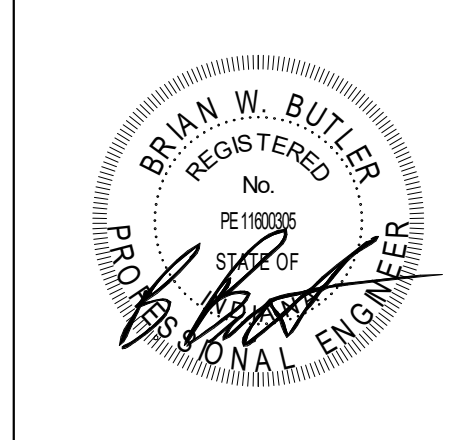

DRAWN BY: ROR

PROJECT NUMBER: 223139.00

PROJECT ISSUE DATE: 01/22/2024

REV. NO.	DESCRIPTION	DATE
1	ADDENDUM #1	02/14/2024

LUMINAIRE AND PANELBOARD SCHEDULES

E8.01

Branch Panel: H5

Location: ROOM B109

Supply From: EXISTING "M"DBP"

Mounting: Surface

Enclosure: Type 1

Notes: INTEGRAL SURGE PROTECTION

Volts: 480/277 Wye

Phases: 3

Wires: 4

A.I.C. Rating:

Mains Type: MLO

Mains Rating: 400 A

MCB Rating: 400 A

CKT	Circuit Description	Trip	Poles	A (VA)	B (VA)	C (VA)	Poles	Trip	Circuit Description	CKT
1	LIGHTING RM. B101-B107	20 A	1	1581	7147			3	100 A	2
3	LIGHTING RM. B108-B115	20 A	1		1363	5240		--		4
5	LIGHTING RM. B116-B127	20 A	1			1667	5042	--		6
7	HWP-1 SHP RM. B109	20 A	3	2105	4223			3	80 A	8
9	--	--	--	--	2105	3600		--		10
11	--	--	--	--	2105	3528		--		12
13	HWP-2 HP RM.B109	20 A	3	2105	46862			3	200 A	14
15	--	--	--	--	2105	46862		--		16
17	--	--	--	--	2105	46862		--		18
19	Spare	20 A	1	0	0			1	20 A	20
21	Spare	20 A	1		0	0		1	20 A	22
23	Spare	20 A	1			0	0	1	20 A	24
25	Spare	20 A	1	0	0			1	20 A	26
27	Spare	20 A	1		0	0		1	20 A	28
29	Spare	20 A	1			0	0	1	20 A	30
31	Spare	20 A	1	0	0			1	20 A	32
33	Spare	20 A	1		0	0		1	20 A	34
35	Spare	20 A	1			0	0	1	20 A	36
37	Spare	20 A	1	0	0			1	20 A	38
39	Spare	20 A	1		0	0		1	20 A	40
41	Spare	20 A	1			0	0	1	20 A	42
Total Load:				64024 VA	61276 VA	61310 VA				
Total Amps:				231 A	221 A	221 A				

Legend:

Load Classification	Connected Load	Demand Factor	Estimated Demand	Panel Totals
Lighting	4611 VA	100.00%	4611 VA	
Motor	160018 VA	121.96%	195165 VA	Total Conn. Load: 186609 VA
Other	0 VA	0.00%	0 VA	Total Est. Demand: 216054 VA
Receptacle - Convenience	360 VA	100.00%	360 VA	Total Conn.: 224 A
Receptacle	21260 VA	73.52%	15630 VA	Total Est. Demand: 260 A
Receptacle - Special	360 VA	80.00%	288 VA	

Notes:

Branch Panel: L5

Location: ROOM B109

Supply From: T-H1

Mounting: Surface

Enclosure: Type 1

Notes: INTEGRAL SURGE PROTECTION

Volts: 208/120 Wye

Phases: 3

Wires: 4

A.I.C. Rating:

Mains Type: MCB

Mains Rating: 200 A

MCB Rating: 200 A

CKT	Circuit Description	Trip	Poles	A	B	C	Poles	Trip	Circuit Description	CKT
1		20 A	1	900				1	20 A	2
3	IDF RACK RM. B104	20 A	1		180	900		1	20 A	4
5	IDF RACK RM. B104	20 A	1			360	180	1	20 A	6
7	RECEPTS RM. B102, B104	20 A	1	900	104			1	20 A	8
9	RECEPTS RM. B105, B107	20 A	1		1260	180		1	20 A	10
11	RECEPTS RM. B107, B108	20 A	1			1080	900	1	20 A	12
13	RECEPTS RM. B108, B109	20 A	1	900	720			1	20 A	14
15	RECEPTS RM. B106	20 A	1		1080	104		1	20 A	16
17	REFRIGERATOR RM. B106	20 A	1			1000	104	1	20 A	18
19	ICE MACHINE RM. B106	20 A	1	180	1440			1	20 A	20
21	WHIRLPOOL RM. B106	20 A	1		180	1080		1	20 A	22
23	WHIRLPOOL RM. B106	20 A	1			180	0	1	20 A	24
25	AUTOMATIC DOOR OPENER RM. B116	20 A	1	254	254			1	20 A	26
27	VVR-119, VVR120, VVR121, VVR122, VVR123	20 A	1		0	0		1	20 A	28
29	VVR-111, VVR112, VVR113, AND VVR114	20 A	1			0	1058	1	20 A	30
31	CUH-122, CUH-123, EF-103	20 A	1	1219	276			1	20 A	32
33	BOILER BLR-2 RM. B109	20 A	1		276	0		1	20 A	34
35	TEMP. CONTROL PANEL RM. B109	20 A	1			0	180	1	20 A	36
37	Spare	20 A	1	0	0			1	20 A	38
39	Spare	20 A	1		0	0		1	20 A	40
41	Spare	20 A	1			0	0	1	20 A	42
43	Spare	20 A	1	0	0			1	20 A	44
45	Spare	20 A	1		0	0		1	20 A	46
47	Spare	20 A	1			0	0	1	20 A	48
49	Spare	20 A	1	0	0			1	20 A	50
51	Spare	20 A	1			0	0	1	20 A	52
53	Spare	20 A	1				0	1	20 A	54
55	Spare	20 A	1	0	0			1	20 A	56
57	Spare	20 A	1		0	0		1	20 A	58
59	Spare	20 A	1			0	0	1	20 A	60
Total Load:				7147 VA	5240 VA	5042 VA				
Total Amps:				60 A	44 A	42 A				

Legend:

Load Classification	Connected Load	Demand Factor	Estimated Demand	Panel Totals
Motor	3649 VA	104.57%	3816 VA	
Other	0 VA	0.00%	0 VA	Total Conn. Load: 17429 VA
Receptacle - Convenience	360 VA	100.00%	360 VA	Total Est. Demand: 15994 VA
Receptacle	13060 VA	88.28%	11530 VA	Total Conn.: 48 A
Receptacle - Special	360 VA	80.00%	288 VA	Total Est. Demand: 44 A

Notes: NOTE 1: GFCI Circuit Breaker 5mA

PLAN TYPE	MANUFACTURER/CATALOG	MOUNTING	NO.	LAMPS		LUMENS	APPLIED VOLTAGE	DESCRIPTION	VA LOAD
				WATTS	TYPE				
LBW4	LUMINAIRE LIGHTING AEL SERIES	SURFACE WALL	1	20 W	LED	2030 lm	277 V	48-INCH VANDAL RESISTANT EXTERIOR WALL SCONCE, LISTED FOR WET LOCATION. COLOR TO BE BRONZE.	20 VA
LBW4X	LUMINAIRE LIGHTING AEL SERIES	SURFACE WALL	1	20 W	LED	2030 lm	277 V	48-INCH VANDAL RESISTANT EXTERIOR WALL SCONCE, LISTED FOR WET LOCATION. COLOR TO BE BRONZE. WITH EMERGENCY BATTERY UNIT	20 VA
LBW5	LUMINAIRE LIGHTING AEL SERIES	SURFACE WALL	1	30 W	LED	3317 lm	277 V	72-INCH VANDAL RESISTANT EXTERIOR WALL SCONCE, LISTED FOR WET LOCATION. COLOR TO BE BRONZE.	30 VA
LBW5X	LUMINAIRE LIGHTING AEL SERIES	SURFACE WALL	1	30 W	LED	3317 lm	277 V	72-INCH VANDAL RESISTANT EXTERIOR WALL SCONCE, LISTED FOR WET LOCATION. COLOR TO BE BRONZE. WITH EMERGENCY BATTERY UNIT	30 VA
LD61	PORTFOLIO LD6A SERIES GOTHAM EVO SERIES PRESCOLITE LFR-6RD-SH SERIES	RECESSED	1	22 W	LED	1500 lm	277 V	6-INCH ROUND APERTURE OPEN REFLECTOR LED DOWNLIGHT, MEDIUM DISTRIBUTION, CLEAR SPECULAR FINISH, SELF-FLANGED, 0-10VDC DIMMING, BAR HANGER ACCESSORY. FIXTURES IN SERVING AREA ARE TO BE EITHER 3000K OR 3500K AS NOTED. ALL OTHER INSTANCES TO BE 4000K.	19 VA
LDW61	PORTFOLIO LD6A SERIES GOTHAM EVO SHOWER SERIES PRESCOLITE LFR-6RD-SH SERIES	RECESSED	1	15 W	LED	1000 lm	277 V	6-INCH ROUND APERTURE LED SHOWER LIGHT WITH REGRESSED LENS REFLECTOR, WHITE REFLECTOR AND TRIM, SELF-FLANGED, IP65 WET LOCATION LISTED.	15 VA
LDW61GX	PORTFOLIO LD6A SERIES GOTHAM EVO SHOWER SERIES PRESCOLITE LFR-6RD-SH SERIES	RECESSED	1	15 W	LED	1000 lm	277 V	6-INCH ROUND APERTURE LED SHOWER LIGHT WITH REGRESSED LENS REFLECTOR, WHITE REFLECTOR AND TRIM, SELF-FLANGED, IP65 WET LOCATION LISTED, WITH EMERGENCY BATTERY UNIT.	15 VA
LDW61X	PORTFOLIO LD6A SERIES GOTHAM EVO SHOWER SERIES PRESCOLITE LFR-6RD-SH SERIES	RECESSED	1	15 W	LED	1000 lm	277 V	6-INCH ROUND APERTURE LED SHOWER LIGHT WITH REGRESSED LENS REFLECTOR, WHITE REFLECTOR AND TRIM, SELF-FLANGED, IP65 WET LOCATION LISTED, WITH EMERGENCY BATTERY UNIT.	15 VA
LF1	LITHONIA CPX SERIES EATON METALUX CGT SERIES COLUMBIA CBT SERIES	RECESSED	1	39 W	SOLID STATE LED	4000 lm	277 V	2 BY 4-FOOT BACK LIT FLAT PANEL WITH ALUMINUM FRAME, 10% DIMMING.	39 VA
LF1X	LITHONIA CPX SERIES EATON METALUX CGT SERIES COLUMBIA CBT SERIES	RECESSED	1	39 W	SOLID STATE LED	4000 lm	277 V	2 BY 4-FOOT BACK LIT FLAT PANEL WITH ALUMINUM FRAME, 10% DIMMING EMERGENCY BATTERY UNIT.	39 VA
LF2	LITHONIA CPX SERIES EATON METALUX CGT SERIES COLUMBIA CBT SERIES	RECESSED	1	47 W	SOLID STATE LED	4800 lm	277 V	2 BY 4-FOOT BACK LIT FLAT PANEL WITH ALUMINUM FRAME, 1% 0-10V DIMMING.	47 VA
LF2X	LITHONIA CPX SERIES EATON METALUX CGT SERIES COLUMBIA CBT SERIES	RECESSED	1	47 W	SOLID STATE LED	4800 lm	277 V	2 BY 4-FOOT BACK LIT FLAT PANEL WITH ALUMINUM FRAME, 1% 0-10V DIMMING EMERGENCY BATTERY UNIT.	47 VA
LF3X	LITHONIA CPX SERIES EATON METALUX CGT SERIES COLUMBIA CBT SERIES	RECESSED	1	53 W	SOLID STATE LED	6000 lm	277 V	2 BY 4-FOOT BACK LIT FLAT PANEL WITH ALUMINUM FRAME, 1% 0-10V DIMMING EMERGENCY BATTERY UNIT.	58 VA
LFS1	METALUX WNLED SERIES LITHONIA SBL SERIES COLUMBIA LAW SERIES	SURFACE	1	48 W	LED	4000 lm	277 V	4-FOOT LED WRAP AROUND FIXTURE, ACRYLIC PRISMATIC DIFFUSER, 0-10VDC DIMMING. IF SUSPENDED, INSTALL AT 8-FOOT AFF WITH CONDUIT STEMS (UNO).	27 VA
LFS1X	METALUX WNLED SERIES LITHONIA SBL SERIES COLUMBIA LAW SERIES	SURFACE	1	48 W	LED	4000 lm	277 V	4-FOOT LED WRAP AROUND FIXTURE, ACRYLIC PRISMATIC DIFFUSER, 0-10VDC DIMMING, WITH EMERGENCY BATTERY UNIT. IF SUSPENDED, INSTALL AT 8-FOOT AFF WITH CONDUIT STEMS (UNO).	27 VA
LTFW1	LITHONIA T SERIES EATON METALUX GR LED SERIES KURTZAN TL-R SERIES	RECESSED	1	45 W	LED	3900 lm	277 V	1 BY 4-FOOT LED TROFFER, INVERTED 0.187-INCH POLYCARBONATE LENS WITH UV ABSORBING OVERLAY, LISTED FOR WET LOCATIONS, IP65 RATED, NSF LISTED, FLANGE KIT.	45 VA
XC	SURE-LITES CX SERIES CHLORIDE 55 LINE SERIES LITHONIA SIGNATURE SERIES DUAL-LITE SEMPRA SERIES	SURFACE CEILING	1	3 W	RED LED	0 lm	277 V	TWO SIDED CAST ALUMINUM AC ONLY EXIT SIGN, SINGLE FACE, DIRECTIONAL ARROWS INDICATED. REFER TO PROJECT MANUAL FOR ADDITIONAL REQUIREMENTS.	3 VA
XVW	SURE-LITES UX SERIES CHLORIDE 60 LINE SERIES LITHONIA LV SERIES DUAL-LITE SEWL SERIES	SURFACE WALL	1	3 W	RED LED	0 lm	277 V	CAST ALUMINUM, VANDAL RESISTANT AC ONLY EXIT SIGN, SINGLE FACE, DIRECTIONAL ARROWS INDICATED. WHITE HOUSING, LISTED FOR WET LOCATIONS. REFER TO PROJECT MANUAL FOR ADDITIONAL REQUIREMENTS.	3 VA
XVW2	SURE-LITES UX SERIES CHLORIDE 60 LINE SERIES LITHONIA LV SERIES DUAL-LITE SEWL SERIES	SURFACE CEILING	1	3 W	RED LED	0 lm	277 V	CAST ALUMINUM, VANDAL RESISTANT AC ONLY EXIT SIGN, SINGLE FACE, DIRECTIONAL ARROWS INDICATED. WHITE HOUSING, LISTED FOR WET LOCATIONS. REFER TO PROJECT MANUAL FOR ADDITIONAL REQUIREMENTS.	3 VA
XW	SURE-LITES CX SERIES CHLORIDE 55 LINE SERIES LITHONIA SIGNATURE SERIES DUAL-LITE SEMPRA SERIES	SURFACE WALL	1	3 W	RED LED	0 lm	277 V	CAST ALUMINUM AC ONLY EXIT SIGN, SINGLE FACE, DIRECTIONAL ARROWS INDICATED. WHITE HOUSING, REFER TO PROJECT MANUAL FOR ADDITIONAL REQUIREMENTS.	3 VA

Branch Panel: L6

Location: RM. B125

Supply From: T-H2

Mounting: Recessed

Enclosure: Type 1

Notes: INTEGRAL SURGE PROTECTION

Volts: 208/120 Wye

Phases: 3

Wires: 4

A.I.C. Rating:

Mains Type: MCB

Mains Rating: 100 A

MCB Rating: 100 A

CKT	Circuit Description	Trip	Poles	A (VA)	B (VA)	C (VA)	Poles	Trip	Circuit Description	CKT	
1	RECEPTS RM. B125	20 A	1	720	180		1	20 A	COFFEE BREWER RM. B125	2	
3	RECEPTS RM. B122, B125	20 A	1		720	180	1	20 A	CAPPUCCINO MACHINE RM. B125	4	
5	REFRIGERATOR RM B125	20 A	1			1000	180	1	20 A	SLUSHY MACHINE RM. B125	6
7	ICE CREAM MERCHANDISER RM. B125	20 A	1	180	180			1	20 A	HOTDOG GRILL RM. B125	8
9	BEVERAGE COOLER RM. B125	20 A	1		180	180		1	20 A	POPCORN POPPER RM. B125	10
11	NACHO CHEESE DISPLAY RM. B125	20 A	1			180	180	1	20 A	BEVERAGE COOLER RM. B125	12
13	COUNTERTOP DISPLAY RM. B125	20 A	1	180	180			1	20 A	NACHO CHEESE DISPLAY RM. B125	14
15	COUNTERTOP DISPLAY RM. B125	20 A	1		180	180		1	20 A	COUNTERTOP DISPLAY RM. B125	16
17	HOTDOG BUN WARMER RM. B125	20 A	1			180	180	1	20 A	HOTDOG BUN WARMER RM. B125	18
19	RECEPTS RM. B124, B127	20 A	1	1080	180			1	20 A	RECEPTACLE RM. B125	20
21	RECEPTS RM. B119, B120	20 A	1		1080	828			1	CUH-119, CUH-120, CUH-121	22
23	CUH-117, CUH-118, EF-104	20 A	1				1219	1104	1	CUH-113, CUH 114, CUH 115, and CUH 116	24
25	Spare	20 A	1	0	0			1	20 A	Spare	26
27	Spare	20 A	1		0	0		1	20 A	Spare	28
29	Spare	20 A	1			0	0	1	20 A	Spare	30
Total Load:				2880 VA	3528 VA	4223 VA					
Total Amps:				24 A	30 A	36 A					

ADDENDUM NO. 1

Zionsville Middle School – Tennis Complex Renovation

Zionsville Community Schools
Zionsville, Indiana

Project No. 223144.00

Index of Contents

Addendum No. 1, 2 items, 1 page
Revised Drawing Sheets: G1.00 and G4.00

Date: February 14, 2024

TO: ALL BIDDERS OF RECORD

ADDENDUM NO. 1 to Drawings and Project Manual, dated January 22, 2024, for Zionsville Community Schools, 900 Mulberry Street, Zionsville, Indiana; as prepared by Fanning/Howey Associates, Inc., Indianapolis, Indiana. This Addendum shall hereby be and become a part of the Contract Documents the same as if originally bound thereto.

The following clarifications, amendments, additions, revisions, changes, and modifications change the original Contract Documents only in the amount and to the extent hereinafter specified in this Addendum.

Each bidder shall acknowledge receipt of this Addendum in his proposal or bid.

NOTE: Bidders are responsible for becoming familiar with every item of this Addendum. (This includes miscellaneous items at the very end of this Addendum.)

RE: ALL BIDDERS

ITEM NO. 1. ACCEPTABLE MANUFACTURERS

The following manufacturers are to be considered acceptable manufacturers (suppliers and fabricators) for the Sections of the Specifications listed. Listed manufacturers are required to bid on products equal in type and design, size, function, and quality to that originally specified. Final decision as to equality of products specified versus those proposed shall be made by the Architect.

Section 32 18 26 – Tennis Court Surfacing
- ICP Building Solutions Group, Andover, Maryland (Plexipave, DecoColor)

ITEM NO. 2. REVISED DRAWING SHEETS

- A. Drawing Sheets: G1.00 and G4.00 have been revised, dated 02/13/24, and are included with and hereby made a part of this Addendum. These Drawings supersede the original documents.

END OF ADDENDUM

PRE-BID REQUEST FOR INTERPRETATION/CLARIFICATION LOG

Project No.	RFI#	Date Received	Request for Interpretation Item	Dwg./Spec.	Response
223144.00	1	2/1/24	Substitution Request for Tennis Court Color Coating Surfacing System; proposed substitution - Plexipave, DecoColor, ICP Building Solutions Group	32 18 26	Substitution Approved
223144.00	2	2/9/24	<ol style="list-style-type: none"> 1. There are different Post diameters listed for the 10' Chain link fence on the Courts. Could you please advise which is correct? <ol style="list-style-type: none"> a. Detail 9/G4.00 – 4" Terminal Post, 4" Line Post b. Note 5 / G1.00 – 4" Terminal Post, 3" Line Post c. In the specs – 5" Terminal Post, 3" Line Post 2. There is a difference in Post embedment between drawings and specs. Could you please advise which is correct? <ol style="list-style-type: none"> a. Plans Detail 8/4.00 – 54" Embedment on all Posts b. Specs – 34" embedment for line post c. 60" embedment for Terminal/Gate Post 		Please follow the information listed within the Project Manual for both items pertaining to new fencing post diameters and embedment depths. Refer to Addendum No. 2.



ARCHITECT


FANNING HOWEY

1-800-848-0966 WWW.FHAI.COM
50 E NEW YORK ST # 300, INDIANAPOLIS, IN 46204



Neighborhood Map

Project Status

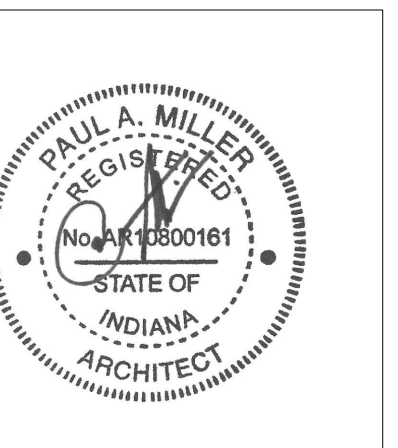

PROJECT MANAGER: JM
DRAWN BY: EB
PROJECT NUMBER: 223144.00
PROJECT ISSUE DATE: 01/22/2024

[illegible]






SITE LAYOUT PLAN

G1.00

PLAN NOTES

- STANDARD COURT LAYOUT AND SURFACING, PLAYING SURFACE (BLUE), FROM MANUFACTURER TENNIS COLOR. REFER TO PROJECT MANUAL 32 18 26 TENNIS COURT SURFACING. SEE DETAIL #12 SHOT GROUND FOR COURT LAYOUT TYP. SEE LAYOUT FOR COURT NUMBERING TO BE PLACED AT EACH COURT IN NUMERICAL ORDER, STARTING AT NORTHWEST COURT AND WORKING EAST - LEFT TO RIGHT - NORTH TO SOUTH.
- 2 TENNIS COURT SURFACING, PERIMETER COURT (GREEN), FROM MANUFACTURER STANDARD COLORS. REFER TO PROJECT MANUAL 32 18 26 TENNIS COURT SURFACING. PREPARE ALL NEW AND EXISTING PG SURFACES TO RECEIVE TENNIS COURT SURFACING, AND APPLY TENNIS COURT SURFACING. SEE DETAIL #12 SHOT GROUND.
- 3 COURT LINES (WHITE), 2" WIDE LAYOUT PER NPHS AND TENNIS REGULATIONS TYP. REFER TO DETAIL 1 ON G400, AND THE PROJECT MANUAL 32 18 26 TENNIS COURT SURFACING.
- SAWCUT JUNT TYP. ALONG NET LINE AND BETWEEN INDIVIDUAL COURTS. DEPTH OF CUT AS RECOMMENDED BY POST TENSION CORD. MANUFACTURER GUIDELINES: SEAL JUNT WITH PAINTABLE SEALANT MEETING THE REQUIREMENTS OF THE TENNIS COURT SURFACING MANUFACTURER GUIDELINES. SAWCUT AND SEALING OPERATION TO BE COMPLETED BEFORE COLOR SYSTEM INSTALLATION - REFER TO PROJECT MANUAL 03 38 16 UNBONDING POST TENSIONED CONC.
- 5 NEW 1/4" HIGH CHAIN LINK FENCING, 5" TERMINAL/GATE POSTS & 3" LINE POSTS, 1" 34" FABRIC, TOP MID AND BOTTOM RAIL, ALL MATERIALS TO BE BLACK VINYL. SEE DETAILS # 8-10 SHOT G400 AND DETAIL #2 SHOT G401.
- 6 NEW 4" WIDE AND 4" 7" TALL SINGLE MAIN GATES - SEE DETAILS #7-9, 13-14 HIT G400.
- 7 NEW 10" WIDE AND 4" 7" TALL DOUBLE WIDE MAIN GATES - SEE DETAILS #7-9 SHOT G400.
- 8 NEW TENNIS NET POSTS AND FOOTINGS AT EACH COURT TYP. (24) BLACK POWDER COATED NET POST - PROVIDE NEW NET POSTS AND ACCESSORIES - TENNIS BALL HOLDERS (12) - V-, SCORING HOLDERS (12) - V-, SEE DETAIL #12 SHOT G400 AND DETAIL #7 SHOT G401. REFER TO PROJECT MANUAL 11 68 33 ATHLETIC FIELD EQUIPMENT. ADJUST POST HEIGHTS TO MEET MANUFACTURER NET HEIGHT.
- 9 2X2" PAINTED ZIONSVILLE MIDDLE SCHOOL "Z" LOGO (9) - GRAY - BLACK AT 30% SHADOW 30% - CONTRASTOR Z TO COORDINATE GRAPHIC WITH OWNER (WHITE) OUTLINE, (GREEN) CENTER, SEE ENLARGED "Z" LOGO CENTERED BETWEEN COURTS.
- 10 TYP. EX. CONCRETE AND ASPHALT SURFACE PAVING WITHIN EX. TENNIS COMPLEX TO REMAIN - PREPARE SURFACES AS REQUIRED BY POST TENSION MANUAL. WRITTEN RECOMMENDATIONS PRIOR TO APPLYING NEW POST TENSIONED SLAB, PL UNIFORM TO AVERAGE, 6MIL ALONG WITH 10MIL - PROVIDE PER MANUF. WRITTEN RECOMMENDATIONS.
- 11 TYP. EX. EXISTING UNDERDRAIN SYSTEM AND URGULATED BASE COURSE WITHIN EX. TENNIS COURT CONCR. AND ASPHALT PAVING TO REMAIN. CONTRACTOR IS TO PROTECT THE CONTRACTOR IS TO PROTECT THE EXISTING DRAINAGE SYSTEM AND CLEAN OUTS DURING CONSTRUCTION. PRIOR TO FINALIZING BASE STONE PREPARATION, THE CONTRACTOR IS TO FLUSH THE UNDERDRAINS BY MEANS OF HYDRAULIC PRESSURE TO REMOVE OBSTRUCTIONS AND TO VERIFY POSITIVE DRAINAGE OF THE SYSTEM.
- 12 NEW TENNIS BACKBOARDS (6); INSTALL PER MANUF. WRITTEN RECOMMENDATIONS - SEE NEW TENNIS BACKBOARD DETAIL #11 ON SHEET G400.
- 13 NEW CENTER COURT NET TIE DOWN HARDWARE AND CONCRETE FOOTING (12). REFER TO DETAIL 44 SHIT G401.
- 14 NEW NETS (12). TOTAL NETS ARE TO BE INSTALLED PER MANUF. WRITTEN INSTRUCTIONS - SPORTS FIELD SPECIALTIES: BASES OF DESIGN.
- 15 TENNIS COURT LAYOUT; SEE DETAIL #12 G400.
- EX. CONCRETE PADS/WALKWAYS NOT IDENTIFIED FOR NEW WORK, TO REMAIN. REFER TO GD10.
- EX. DRAINAGE STRUCTURES, TO REMAIN - PROTECT DURING CONSTRUCTION. REFER TO GD10 AND SURVEY.
- 16 NEW RP RAP BED - TYP. C - CLEAN LINE LANE RAP TO BE INSTALLED PER MANUF. WRITTEN RECOMMENDATION - RP RAP PGs TO BE 1" LOWER THAN ADJACENT CONCR. PMNT PG ELEVATION - NO FINES AND OR GRAVEL WITHIN RP RAP MIX.
- 17 NEW POST TENSION CONCR. SURFACE WITH TENSIONING CABLES - CABLES ARE TO BE CONFIGURED INTO A SPECIFIED GRID LAYOUT AND STRESSED TO THE APPROPRIATE LEVELS - WHICH IS TO BE SPECIFIED BY MANUF. PRIOR TO THE START OF CONSTRUCTION. CONTRACTOR IS TO DETAIL AND PREP EX. CONCR. AND ASPHALT SURFACES AS NEEDED PRIOR TO INSTALLATION OF NEW PT SLAB. SEE DETAILS #1-9 SHOT G401 FOR FURTHER INFORMATION.
- 20 EX. FENCING TO REMAIN - PROTECT DURING CONSTRUCTION.
- 21 NEW F - REINFORCED CONCR. WALKS TO BE INSTALLED UPON EXISTING CONCR./ASPHALT PAVING AREAS, THE SITE PAVING IS SET WITHIN A 2" ROCK SETTING BED. INSTALL PER DETAILS #1-6 SHOT G400 AND DETAIL #5 SHIT G401 PER MANUF. WRITTEN RECOMMENDATIONS.
- 22 SITE WIDE - ALL EXISTING LIGHTING FIXTURES, POLES AND BASES ARE TO REMAIN MARKED OR OTHERWISE - CONTRACTOR IS TO PROTECT DURING CONSTRUCTION - SITE VERIFY EX. CONDITIONS PRIOR TO THE START OF CONSTRUCTION.
- EX. BACKSTOP TO REMAIN - PROTECT DURING CONSTRUCTION.
- 24 DISTURBED LAWN, RE-SEED. HYDROMULCH DISTURBED LAWNS AND RESTORE BACK TO ACCEPTABLE CONDITIONS PRIOR TO THE CONCLUSION OF CONSTRUCTION, REFER TO PROJECT MANUAL.
- NEW GRAVEL BED - ADD 3" DEPTH OF NEW SANDSTONE GRAVEL WITHIN NOTED SPACE - INSTALL STONE TO BE 1.5" LOWER THAN ADJACENT LAWN PG - PREVENT STONE FROM MIGRATING DOWN EX. DRAINAGE SWALES AND COLLECTING WITHIN EX. STORM MANHOLES.
- 26 EX. TICKET BOTH TO REMAIN - PROTECT DURING CONSTRUCTION.
- 27 EX. GRANDSTANDS AND SUPPORT BUILDING TO REMAIN - PROTECT DURING CONSTRUCTION.
- 28 ALL EX. BASKETBALL GOALS AND ASPHALT PAVING TO REMAIN - PROTECT DURING CONSTRUCTION TYP.
- 29 NEW TO EXISTING WALK - SEE DETAIL #5 SHIT G400.
- THICKENED EDGE PMNT @ EX. PMNT EDGE DETAIL #2 SHIT G400.
- 31 MONOLITHIC CONCR. WALK/CURBS AND GUTTER AT EX. LAWN AND GRAVEL BEDS. SEE DETAIL #1 SHIT G400.
- 32 HANDRAIL AT RAMP DETAIL, TO REMAIN #15 SHIT G400.

PLAN LEGEND

- | | |
|---|---|
|  | TENNIS COMPLEX; NEW POST TENSION CONC.
WITH TENNIS COURT SURFACING
SEE PLAN NOTES FOR FURTHER CLARIFICATION |
|  | TENNIS COURTS; NEW POST TENSION CONC.
WITH TENNIS COURT SURFACING
SEE PLAN NOTES FOR FURTHER CLARIFICATION |
|  | EX. GRAVEL BED; SEE PLAN NOTES |
|  | NEW 6" MONOLITHIC CONC. PAVING WITH CUTTER,
SEE PLAN NOTES FOR FURTHER CLARIFICATION |
|  | NEW RIP RAP BED ; SEE PLAN NOTES |

[illegible]

LOCATIONS GIVEN ARE APPROXIMATE
AND ARE TO BE SITE VERIFIED PRIOR
TO THE START OF CONSTRUCTION. ALL
CONCRETE AND ASPHALT PAVING NOT
NOTED FOR WORK IS TO REMAIN -
PROTECT DURING CONSTRUCTION TYPE

SITE LAYOUT PLAN

SCALE: 1" = 20'-0"



TENNIS COURT LAYOUT

LOOKING NORTH @ TENNIS COMPLEX - EAST/WEST INTERIOR FENCE SECTION

LOOKING SOUTH @ TENNIS COMPLEX - EAST/WEST INTERIOR FENCE SECTION

NEW TENNIS BACKBOARD

ADDENDUM NO. 1

Eagle Elementary School Playground and House Demolition

Zionsville Community Schools
Zionsville, Indiana

Project No. 223135.00

Index of Contents

Addendum No. 1, 3 items, 1 page
Revised Drawing Sheets: GD1.0 and G1.0

Date: February 14, 2024

FANNING/HOWEY ASSOCIATES, INC.
ARCHITECTS/ENGINEERS/CONSULTANTS

TO: ALL BIDDERS OF RECORD

ADDENDUM NO. 1 to Drawings and Project Manual, dated January 22, 2024, for Zionsville Community Schools, 900 Mulberry Street, Zionsville, Indiana; as prepared by Fanning/Howey Associates, Inc., Indianapolis, Indiana. This Addendum shall hereby be and become a part of the Contract Documents the same as if originally bound thereto.

The following clarifications, amendments, additions, revisions, changes, and modifications change the original Contract Documents only in the amount and to the extent hereinafter specified in this Addendum.

Each bidder shall acknowledge receipt of this Addendum in his proposal or bid.

NOTE: Bidders are responsible for becoming familiar with every item of this Addendum. (This includes miscellaneous items at the very end of this Addendum.)

RE: ALL BIDDERS

ITEM NO. 1. PROJECT MANUAL SECTION 11 68 00 – PLAYGROUND EQUIPMENT AND STRUCTURES

A. Replace 2.1, A., 3., as follows:

“3. Ultra Play/Playcore, for imitation log round steppers only.”

ITEM NO. 2. REVISED DRAWING SHEETS


A. Drawing Sheets: GD1.0 and G1.0 have been revised, dated 02/14/24, and are included with and hereby made a part of this Addendum. These Drawings supersede the original documents.

ITEM NO. 3. DRAWING SHEET NO. E2.01 - EAGLE ELEMENTARY ELECTRICAL SITE PLAN


A. GENERAL NOTES: Add the following note:

“R. UNDER THE ALTERNATE BID, PROVIDE PANELBOARD AND TIMECLOCK IN SHELTER STORAGE ROOM.”

END OF ADDENDUM


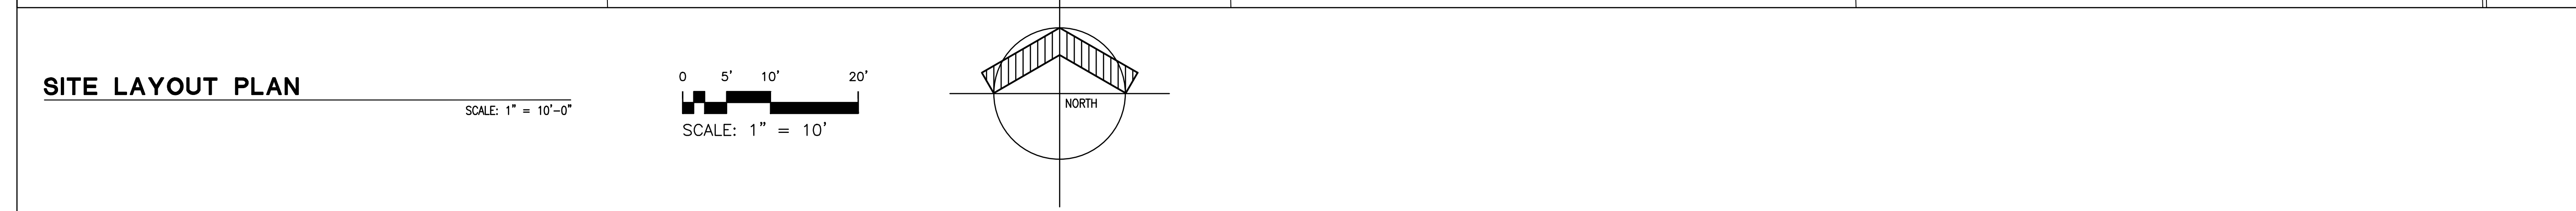


G1.0

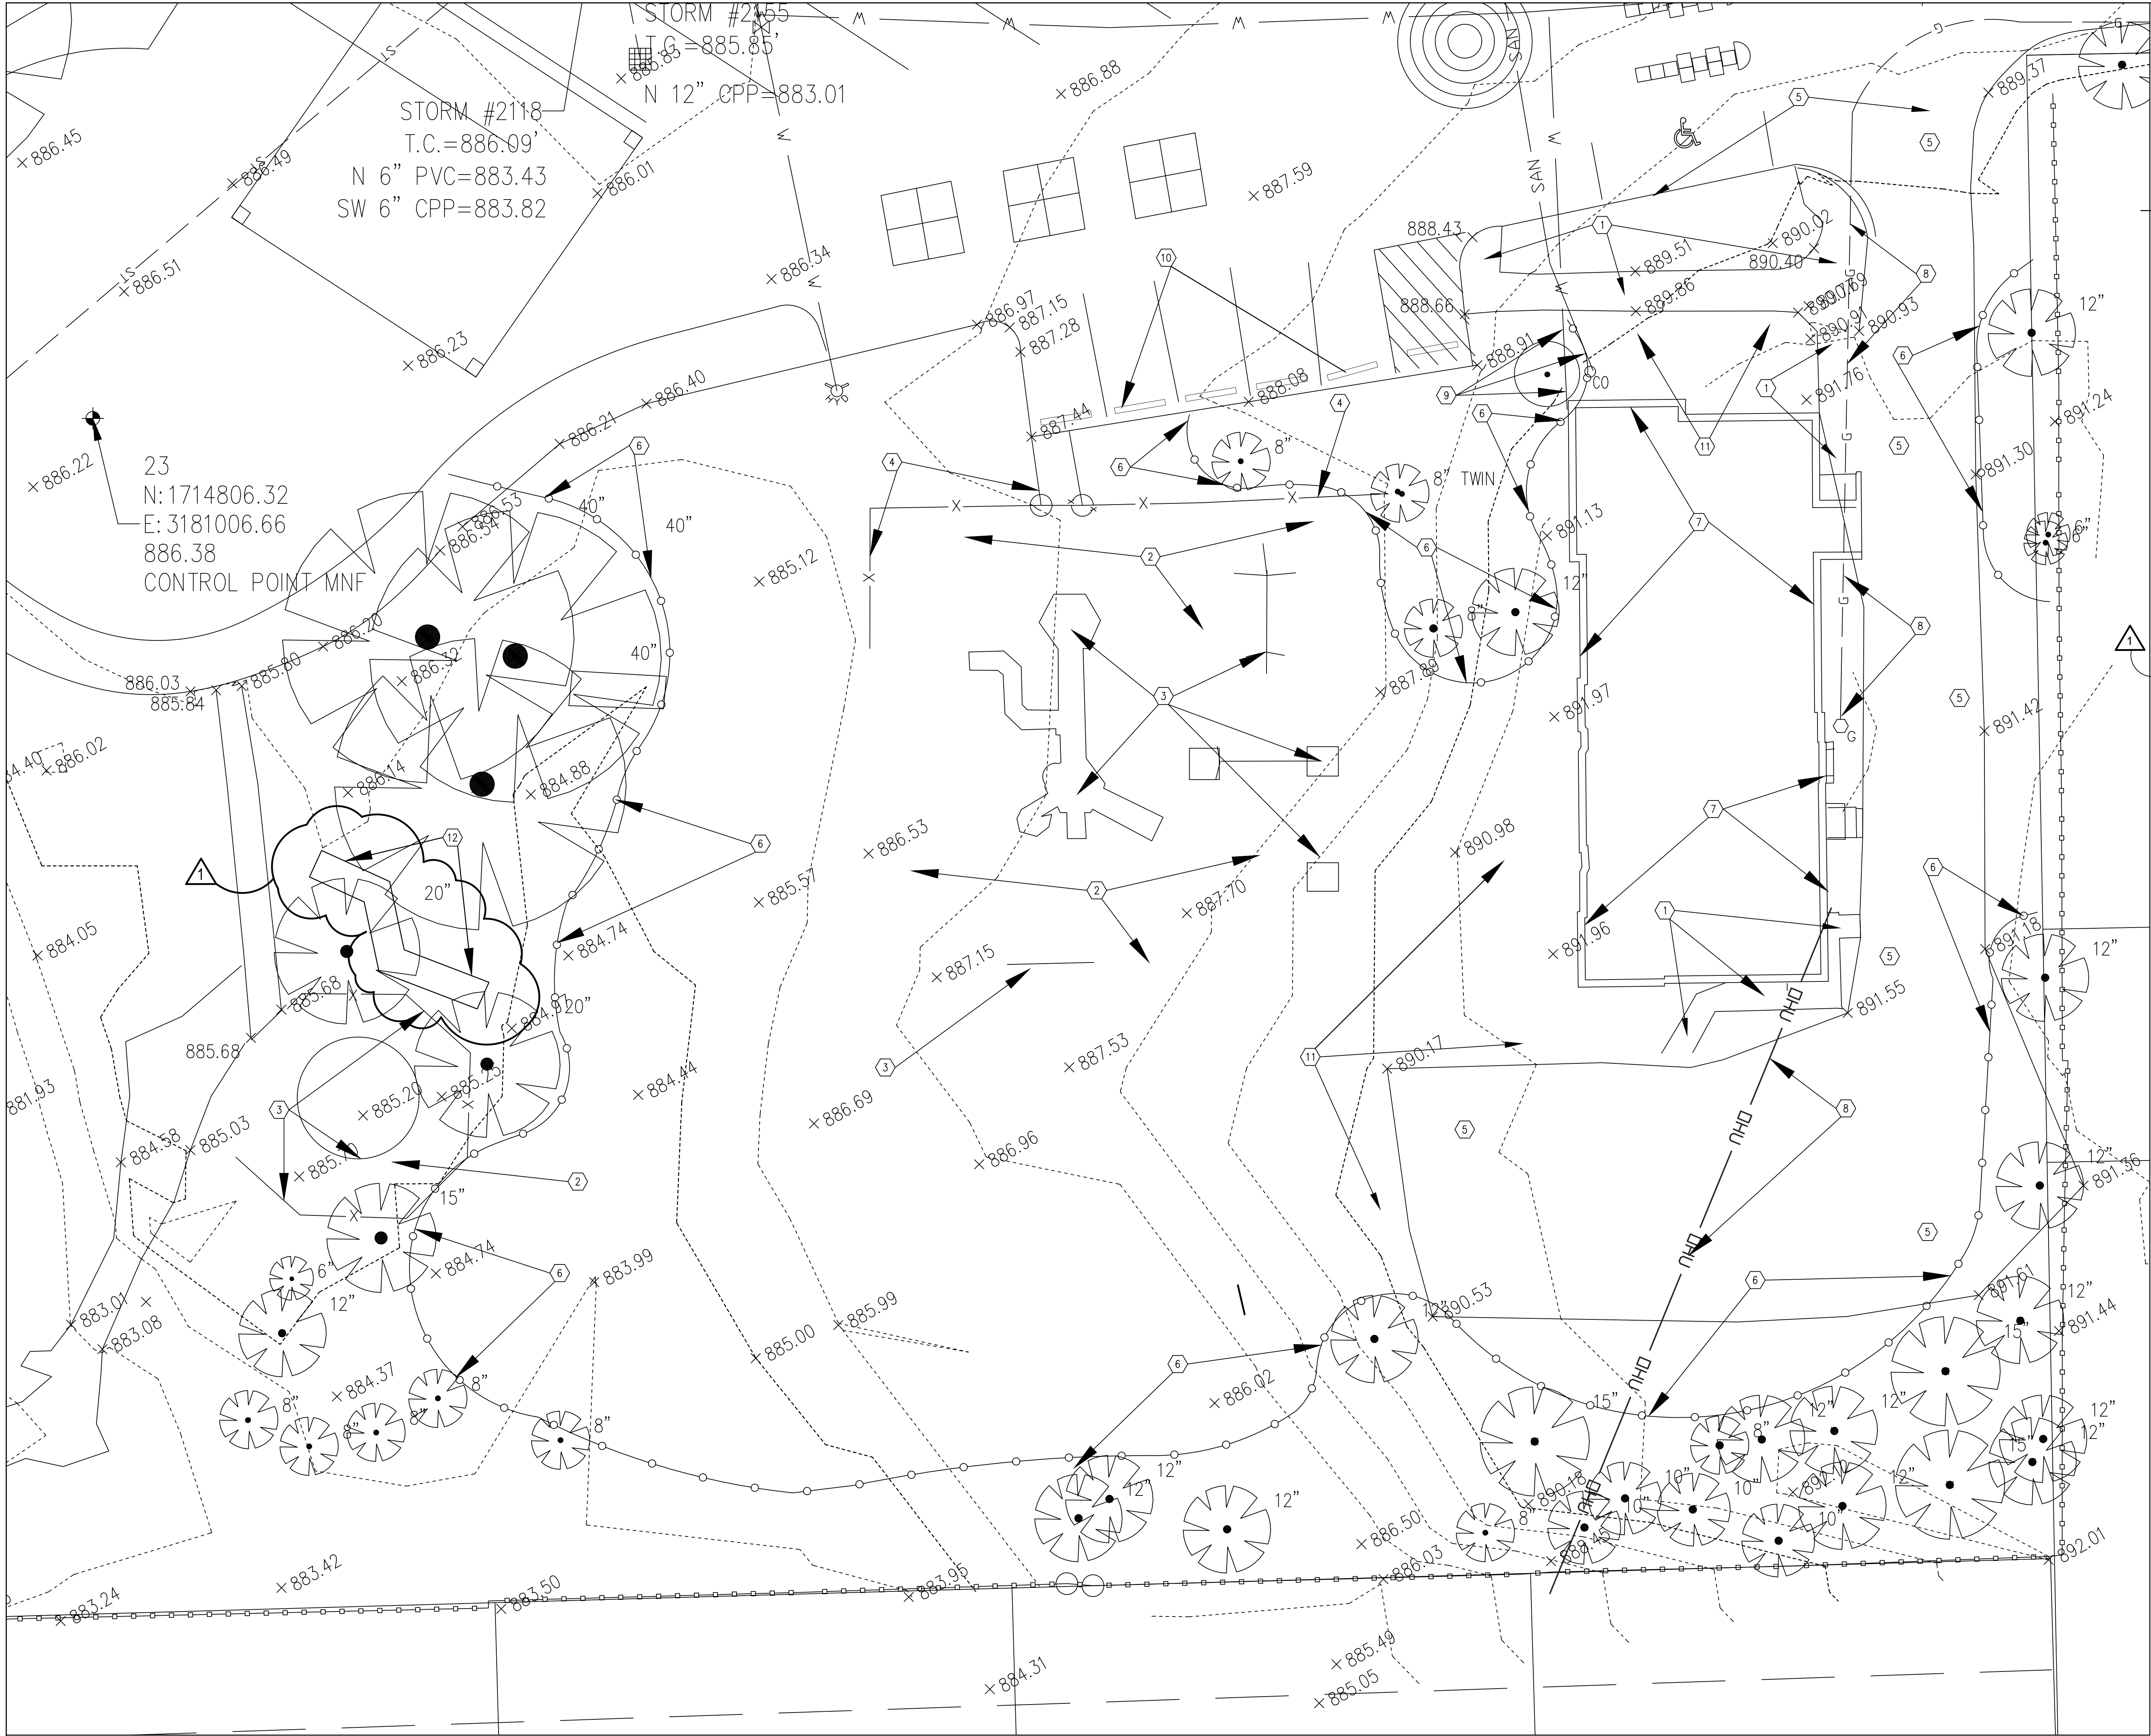

SITE DEMO PLAN

SCALE: 1" = 10'-0"

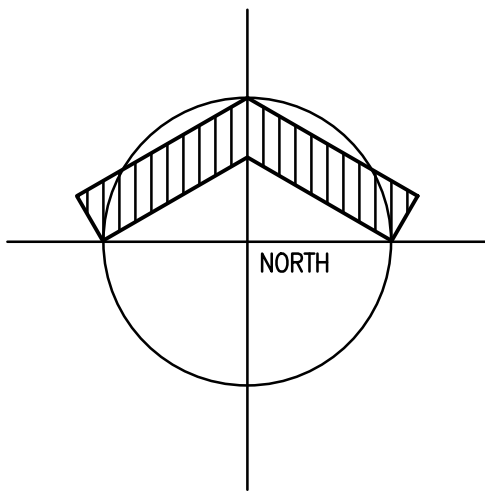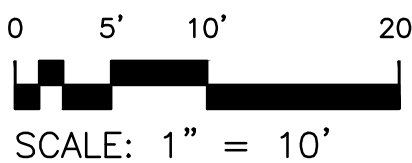

DEMOLITION PLAN NOTES

- 1 SAWCUT EXISTING CONCRETE PAVING AS NOTED IN CROSS HATCHED AREAS IN ITS ENTIRETY INCLUDING BASE AND DISPOSE OF OFF SITE AND DISPOSE OF OFF SITE AS APPROVED BY GOVERNING AGENCIES.
- 2 REMOVE EXISTING SOFT SURFACE MATERIAL AND ANY BASE AND DISPOSE OF OFF SITE.
- 3 REMOVE EXISTING PLAYGROUND EQUIPMENT IN ITS ENTIRETY INCLUDING FOUNDATIONS AND DISPOSE OF OFFSITE.
- 4 REMOVE EXISTING FENCING AND FOUNDATIONS AND REMOVE IN THEIR ENTIRETY AND DISPOSE OF OFFSITE.
- 5 SAWCUT AND REMOVE EXISTING ASPHALT PAVING AND AGGREGATE BASE AS NOTED IN SHADED AREAS AND DISPOSE OF OFF SITE IN A MANNER AND LOCATION AS APPROVED BY GOVERNING AGENCIES.
- 6 INSTALL ORANGE CONSTRUCTION FENCING AS TREE PROTECTION BARRIER IN LOCATIONS AS NOTED. KEEP ALL CONSTRUCTION TRAFFIC OFF OF AREA AND ONLY ALLOW ACTIVITY IN THE AREA WHEN NECESSARY TO COMPLETE WORK AT THE END OF ALL OTHER CONSTRUCTION. SEE DETAIL 14 C&D.
- 7 CONTRACTOR SHALL DEMOLISH EXISTING HOME AND REMOVE ALL DEBRIS INCLUDING FOUNDATION AND BASEMENT FLOOR SLAB AND DISPOSE OF OFF SITE IN A MANNER AND LOCATION AS APPROVED BY GOVERNING AGENCIES.
- 8 CONTRACTOR SHALL TERMINATE OR MAKE ARRANGEMENTS TO HAVE ALL UTILITIES TO EXISTING HOME AND ACROSS SITE WITHIN CONSTRUCTION AREA TERMINATED AND REMOVED IN THEIR ENTIRETY.
- 9 MAINTAIN AND PROTECT EXISTING WATER AND SEWER IF REQUIRED LINE FOR RECONNECTION TO NEW WATER HYDRANT.
- 10 REMOVE EXISTING CONCRETE BUMPER BLOCKS AND DISPOSE OF OFF SITE. PAINT OUT EXISTING PARKING STRIPING AS REQUIRED FOR NEW PLAYGROUND GAMES.
- 11 REMOVE ALL EXISTING SITE IMPROVEMENTS AS REQUIRED, WHETHER NOTED ON NOT TO ALLOW FOR NEW CONSTRUCTION.
- 12 PROTECT AND MAINTAIN EXISTING PLAY EQUIPMENT AS NOTED. REPLACE DAMAGED PARTS AND REPAIR EQUIPMENT TO A LIKE NEW CONDITION.

NOTE: CONTRACTORS SHALL CONDUCT A THOROUGH SITE INVESTIGATION AND VERIFY ALL EXISTING CONDITIONS IF NOTED ON PLANS OR NOT. REMOVE ALL MISC. EXISTING IMPROVEMENTS AS REQUIRED TO ALLOW FOR CONSTRUCTION OF NEW IMPROVEMENTS.

GENERAL DEMOLITION NOTES

1. THE SITE SHALL BE STRIPPED OF EXISTING IMPROVEMENTS AS NOTED. ALL THE REMOVED MATERIALS SHALL BE REMOVED FROM THE SITE BY THE GENERAL CONTRACTOR OR SUBCONTRACTOR.
2. REMOVAL OF THE EXISTING IMPROVEMENTS ARE AS NOTED ON THE PLANS OR AS REQUIRED BY THE PROJECT. THE MATERIALS REMOVED FROM THE SITE SHALL BE DISPOSED OF IN A PROPER AND LEGAL MANNER PER FEDERAL, STATE, AND OR LOCAL LAWS AND ORDINANCES.
3. EXISTING PAVEMENT, SIDEWALKS, CURBS, DRIVEWAYS, ELECTRICAL TRANSFORMER, DITCHES, DRAINAGE PIPES AND STRUCTURES, FENCES, LAWNS, TREES, BUSHES, MAILBOXES, SIGNS, POWER POLES, IRRIGATION LINES AND EQUIPMENT, ETC., TO REMAIN SHALL BE PROTECTED FROM DAMAGE BY THE CONTRACTOR. ANY DAMAGE DURING CONSTRUCTION SHALL BE RESTORED, RECONSTRUCTED OR REPLACED BY THE CONTRACTOR AT HIS EXPENSE. ALL DAMAGES SHALL BE RESTORED OR REPLACED TO AT LEAST THEIR ORIGINAL CONDITION OR AS REQUIRED OR DICTATED BY FEDERAL, STATE, COUNTY, CITY OR LOCAL REQUIREMENTS.
4. SAW CUT THE EDGES OF PAVED AREAS CLEAN, NEAT AND TRUE TO LINE SO NO UNWANTED CHIPPING OR BREAKING OF EXISTING PAVEMENT TO REMAIN WILL OCCUR. IN AREAS OF PAVERS TO BE REMOVED OR SAWCUT DO NOT SAWCUT PAVEMENT BUT REMOVE ENTIRE PAVEMENT TO END OR EDGE OF DISTURBED AREA.
5. IT IS THE RESPONSIBILITY OF THE CONTRACTOR TO INSPECT EACH DAY AND REMOVE ALL MUD, DIRT, GRAVEL AND LOOSE MATERIALS TRACKED, DUMPED, SPILLED OR WIND BLOWN FROM THIS SITE ONTO OTHER SITES, RIGHT OF WAYS, PUBLIC OR PRIVATE STREETS OR ROADS, DRIVEWAYS, YARDS OR SIDEWALKS. THE CONTRACTOR MUST CLEAN OR PICK UP DAILY IF NECESSARY. THE CONTRACTOR SHALL REDUCE THE AIRBORNE DUST DURING THE ENTIRE DEMOLITION SCHEDULE. WATER MAY BE USED AS A REDUCER.
6. THE CONTRACTOR SHALL MAINTAIN EROSION CONTROL DEVICES AS SPECIFIED OR AS REQUIRED BY CITY/ COUNTY DURING DEMOLITION.
7. IT IS THE CONTRACTOR'S RESPONSIBILITY TO NOTIFY ALL THE UTILITY COMPANIES AND DEPARTMENTS 72 HOURS BEFORE DEMOLITION IS TO START TO VERIFY ANY UTILITIES THAT MAY BE PRESENT ON SITE. ALL VERIFICATIONS, LOCATIONS, SIZE AND DEPTHS SHALL BE MADE BY THE APPROPRIATE UTILITY COMPANIES OR DEPARTMENTS. WHEN EXCAVATING AROUND OR OVER EXISTING UTILITIES, THE CONTRACTOR MUST NOTIFY THE UTILITY COMPANY SO A REPRESENTATIVE OF THE UTILITY MAY BE PRESENT DURING THE EXCAVATION TO INSTRUCT AND OBSERVE DURING THE EXCAVATION. CONTRACTOR TO CALL 811 OR 1-800-382-5544 BEFORE DIGGING.
8. IT IS THE RESPONSIBILITY OF THE CONTRACTOR OR CONTRACTORS TO OBTAIN ALL FEDERAL, STATE, COUNTY, CITY, AND LOCAL PERMITS FOR ANY AND ALL WORK REQUIRED UNLESS OTHERWISE NOTED. THIS SHALL INCLUDE ALL SUBMITTALS AS REQUIRED INCLUDING LAND DISTURBANCE, AND STORMWATER RUNOFF CONTROL. THE CONTRACTOR OR CONTRACTORS ARE RESPONSIBLE TO PAY FOR ALL REQUIRED PERMITS BY ANY OR ALL AGENCIES UNLESS OTHERWISE NOTED BY THE CONTRACT OR SPECIFICATIONS.
9. IT SHALL BE THE RESPONSIBILITY OF THE CONTRACTOR TO VERIFY WITH EACH UTILITY COMPANY AND OR AGENT WHO IS RESPONSIBLE TO REMOVE OR RELOCATE EACH EXISTING UTILITY. IT FURTHER SHALL BE THE RESPONSIBILITY OF THE CONTRACTOR TO BEAR THE COST FOR THE REMOVAL, TERMINATION OR RELOCATION OF UTILITIES IF THE RESPONSIBILITY IS NOT COVERED BY THE UTILITY COMPANY.
10. THE UTILITIES INDICATED ON THESE PLANS AND ON THE SURVEY MAY NOT BE A COMPLETE INVENTORY OF ALL THE EXISTING UTILITIES PRESENT ON AND AROUND THIS SITE. THE LOCATIONS AND SIZE OF THESE UTILITIES ARE APPROXIMATE. THIS INFORMATION WAS OBTAINED OR SUPPLIED FROM OTHERS AND USED BY THE ARCHITECT AND OR ENGINEER AND MAY NOT BE ACTUAL. THE ARCHITECT AND OR ENGINEER MAY NOT BE HELD LIABLE FOR ANY INCORRECT OR MISLEADING UTILITY INFORMATION INDICATED, IMPLIED OR NOT INDICATED ON THESE PLANS.
11. ALL CONTRACTORS MUST TAKE PARTICULAR CARE WHEN EXCAVATING IN AND AROUND EXISTING UTILITY LINES AND EQUIPMENT. ACTUAL FIELD LOCATIONS OF ALL THE EXISTING UTILITIES ARE THE CONTRACTORS RESPONSIBILITY AND MUST BE LOCATED EITHER BY THE REPRESENTATIVE OF THE UTILITY COMPANY OR BY A PRIVATE UNDERGROUND UTILITY LOCATING COMPANY PRIOR TO THE START OF DEMOLITION ACTIVITIES.
12. REMOVAL OF EXISTING CONCRETE OR OTHER PAVED AREAS INDICATED ON THE PLANS SHALL INCLUDE ALL AGGREGATE BASE MATERIALS IF REQUIRED. AREAS TO BE REMOVED SHALL BE SAW CUT CLEAN, NEAT AND TRUE TO LINE. REMOVE ALL NONORGANIC MATTER THAT WOULD INTERFERE WITH THE GROWTH OF TURF OR PLANT MATERIAL IN AREAS TO BE PLANTED.
13. THE CONTRACTOR SHALL NOTIFY THE OWNER PRIOR TO COMMENCEMENT OF DEMOLITION OPERATIONS. NO DEMOLITION, GRADING OR OTHER WORK SHALL COMMENCE UNTIL A COORDINATION MEETING HAS BEEN HELD BETWEEN THE CITY AND CONTRACTOR.

ZIONSVILLE
COMMUNITY
SCHOOLS
PLAYGROUND
IMPROVEMENTS

EAGLE ELEMENTARY SCHOOL
350 N. 6TH STREET
ZIONSVILLE, IN 46077

ZIONSVILLE COMMUNITY
SCHOOLS ZIONSVILLE,
INDIANA




ARCHITECT

FANNING
HOWEY

317-848-0966 WWW.FHAL.COM
350 E NEW YORK ST # 300, INDIANAPOLIS, IN 46204

Project Status

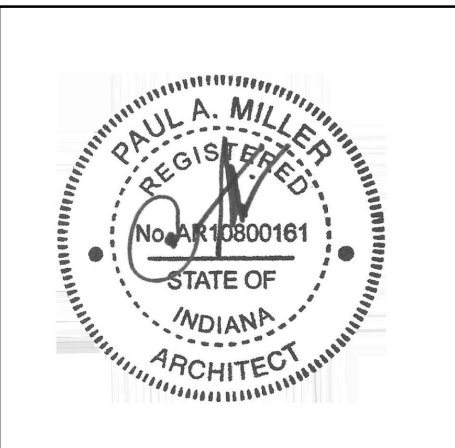

PROJECT MANAGER: JM
DRAWN BY: JB
PROJECT NUMBER: 223135.00
PROJECT ISSUE DATE: 1/22/2024

REV. NO.	DESCRIPTION	DATE
1	ADDENDUM #1	2-14-2024

EAGLE ELEMENTARY
SITE DEMO PLAN

GD1.0