ADDENDUM NO. 1

June 5, 2024

Connersville High School & Frazee Elem. Renovations 1100 Spartan Drive – High School 600 West Third Street – Frazee Elem. Connersville, IN 47331

TO: ALL BIDDERS OF RECORD

This Addendum forms a part of and modifies the Bidding Requirements, Contract Forms, Contract Conditions, the Specifications and the Drawings dated May 15, 2024, by Gibraltar Design. Acknowledge receipt of the Addendum in the space provided on the Bid Form. Failure to do so may subject the Bidder to disqualification.

This Addendum consists of Pages ADD 1-1 through ADD 1-2 and attached Gibraltar Design Addendum No. 1 dated June 5, 2024, consisting of 3 Pages, and, **Frazee Elementary** Revised Addendum Drawings M-101F, M-102F, M-103F, M-301F, M-501F, M-601F, M-602F, ED101F, EL101F, EP101F, E-501F, E-502F, E-503F, E-601F, E-602F. **Connersville HS** Revised Addendum Drawings PD201C, P-201C, P-501C, EP101C, EP111C, E-501C, and E-601C.

SPECIFICATION SECTION 01 12 00 MULTIPLE CONTRACT SUMMARY

1. Paragraph 3.03 Bid Categories

E. Bid Category No. 5 – Fire Protection, Plumbing & HVAC

Add the following clarification:

5. Include removal, storage and reinstallation of any existing devices/equipment/fixtures related to this Bid Categories scope that's required to complete replacement of adjacent renovation work.

F. Bid Category No. 6 – Electrical & Technology

Add the following clarification:

4. Include removal, storage and reinstallation of any existing devices/equipment/fixtures related to this Bid Categories scope that's required to complete replacement of adjacent renovation work. Include extension of roughins where wall thickness changes.



ADDENDUM ONE

Addendum One (AD.01) to the drawings and specifications prepared by Gibraltar Design for **Frazee Elementary School and Connersville High School Natatorium Renovations** for Fayette County School Corporation, Connersville, Indiana.

All Contractors bidding on this project shall read all of the items covered below and shall comply with all of the requirements as set forth, including any necessary refinements or additions generated by this Addendum and required by the intent of the original contract documents. All Contractors shall acknowledge on their bid form that they have received this Addendum and include the appropriate content of same within their bid proposal.

SPECIFICATIONS

1. Specification Section 08 91 00

Aluminum Wall Louvers

- A. Add Paragraph 2.1.G. to read:
 - "G. Pottorff, Fort Worth, Texas."
- B. Add Paragraph 2.5.G. to read:
 - "G. Model EFD-445 (P)."

DRAWINGS

FRAZEE ELEMENTARY SCHOOL

2. Sheet M-101F, M-102F, M-103F

A. Refer to three (3) revised full size drawing included in this addendum, for added pipe cover notes.

3. Sheet M-301F

- A. Refer to revised full size drawing included in this addendum, for the following revisions:
 - 1. Add demolition notes to sheet note box for hot water pumps, chemical treatment, and bypass filter.
 - 2. Hot water pumps and chemical treatment to be removed and notes.
 - 3. Add new hot water pumps, chemical treatment, and notes.

4. Sheet M-501F

A. Refer to revised full size drawing included in this addendum, for HWP-1 and HWP-2 added to pump schedule.

5. Sheet M-601F

A. Refer to revised full size drawing included in this addendum, for added piping support detail.

JUNE 5, 2024 AD.01-1



6. Sheet M-602F

A. Refer to revised full size drawing included in this addendum, for revised hot water system piping diagram.

7. Sheet ED101F

- A. Refer to revised full size drawing included in this addendum, for the following revision:
 - 1. Existing lighting controls to be demolished in Lighting Lower Level Plan.

8. Sheet EL101F

- A. Refer to revised full size drawing included in this addendum, for the following revisions:
 - 1. New lighting controls in Lighting Lower Level Plan Unit A.
 - 2. New lighting controls in Electrical Lighting Overall Plan.
 - 3. Add typical classroom zoning note in 4th Grade A-111.

9. Sheet EP101F

- A. Refer to revised full size drawing included in this addendum, for the following revisions:
 - 1. Add connection to new Alternate Scope #1 in Boiler A-114.
 - 2. Revise new panel AG1 in Boiler A-114.

10. Sheet E-501F

A. Refer to revised full size drawing included in this addendum, for Alternate HWPs added to Pump Equipment Connection Schedule.

11. Sheet E-502F

A. Refer to revised full size drawing included in this addendum, for revised panel schedules.

12. Sheet E-503F

A. Add new full size drawing included in this addendum, for new panels A1G and X-EM/LB.

13. Sheet E-601F

A. Refer to revised full size drawing included in this addendum, for revised lighting fixture schedule.

14. Sheet E-602F

A. Refer to revised full size drawing included in this addendum, for revised schematic one-line diagram.

CONNERSVILLE HS NATATORIUM

15. Sheet PD201C

- A. Refer to revised full size drawing included in this addendum, for the following revisions:
 - 1. Add location of existing domestic storage tank to remain.
 - 2. Add locations of domestic water circulation pumps to be demolished.

JUNE 5, 2024 AD.01-2



16. Sheet P-201C

- A. Refer to revised full size drawing included in this addendum, for the following revisions:
 - 1. Add location of existing domestic storage tank to remain.
 - 2. Add locations of new domestic water recirculation pumps CP-1 and CP-2.

17. Sheet P-501C

- A. Refer to revised full size drawing included in this addendum, for the following revisions:
 - 1. Revised Water Heater Diagram.
 - 2. Revised Water Softener Diagram.
 - 3. Revised Plumbing Equipment Schedule.

18. Sheet EP101C

A. Refer to revised full size drawing included in this addendum, for added circuit for water heater.

19. Sheet EP111C

- A. Refer to revised full size drawing included in this addendum, for the following revisions:
 - 1. Add and revise locations of plumbing equipment.
 - 2. Add Sheet Note 8.
 - 3. Revise note for hot water pumps on demolition plan.

20. Sheet E-501C

- A. Refer to revised full size drawing included in this addendum, for the following revisions:
 - 1. Revise color temperature for lights visible in pool area.
 - 2. Add and revise plumbing equipment on mechanical connection schedule.
 - 3. Add water heater to Panel CJ.

21. Sheet E-601C


- A. Refer to revised full size drawing included in this addendum, for the following revisions:
 - 1. Revise panel schedule templates.
 - 2. Revise chiller water pumps to 40 hp.
 - 3. Revise loads of circulation pumps.
 - 4. Add circuit for domestic booster pump.


Pages 1 through 3, inclusive, and Twenty-Two (22) Full-Size Drawings, constitutes the total makeup of **Addendum One**.



Joseph P. Briggs

JUNE 5, 2024 AD.01-3

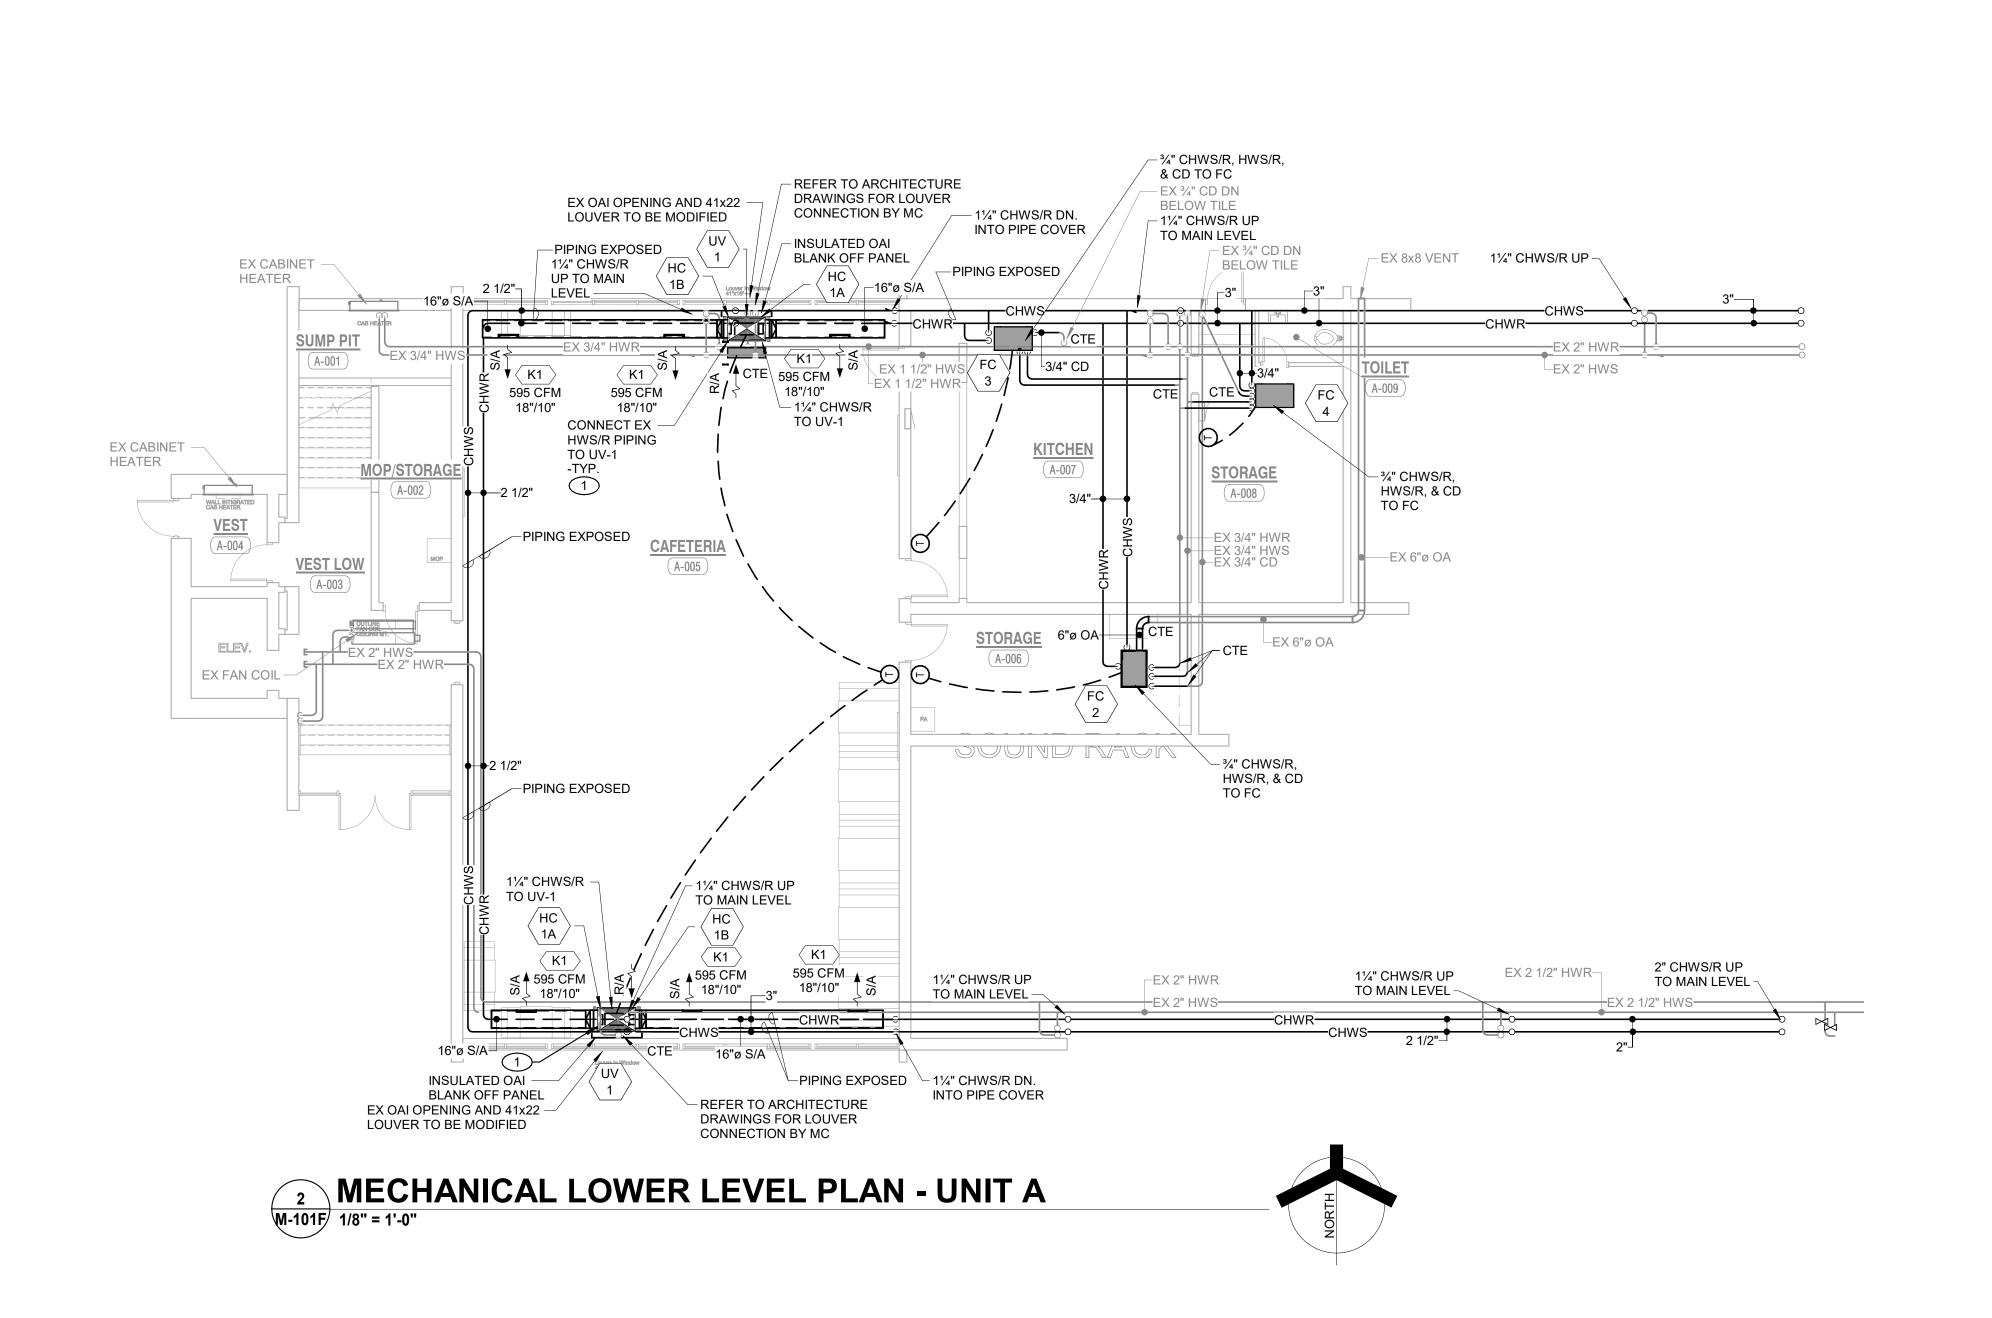

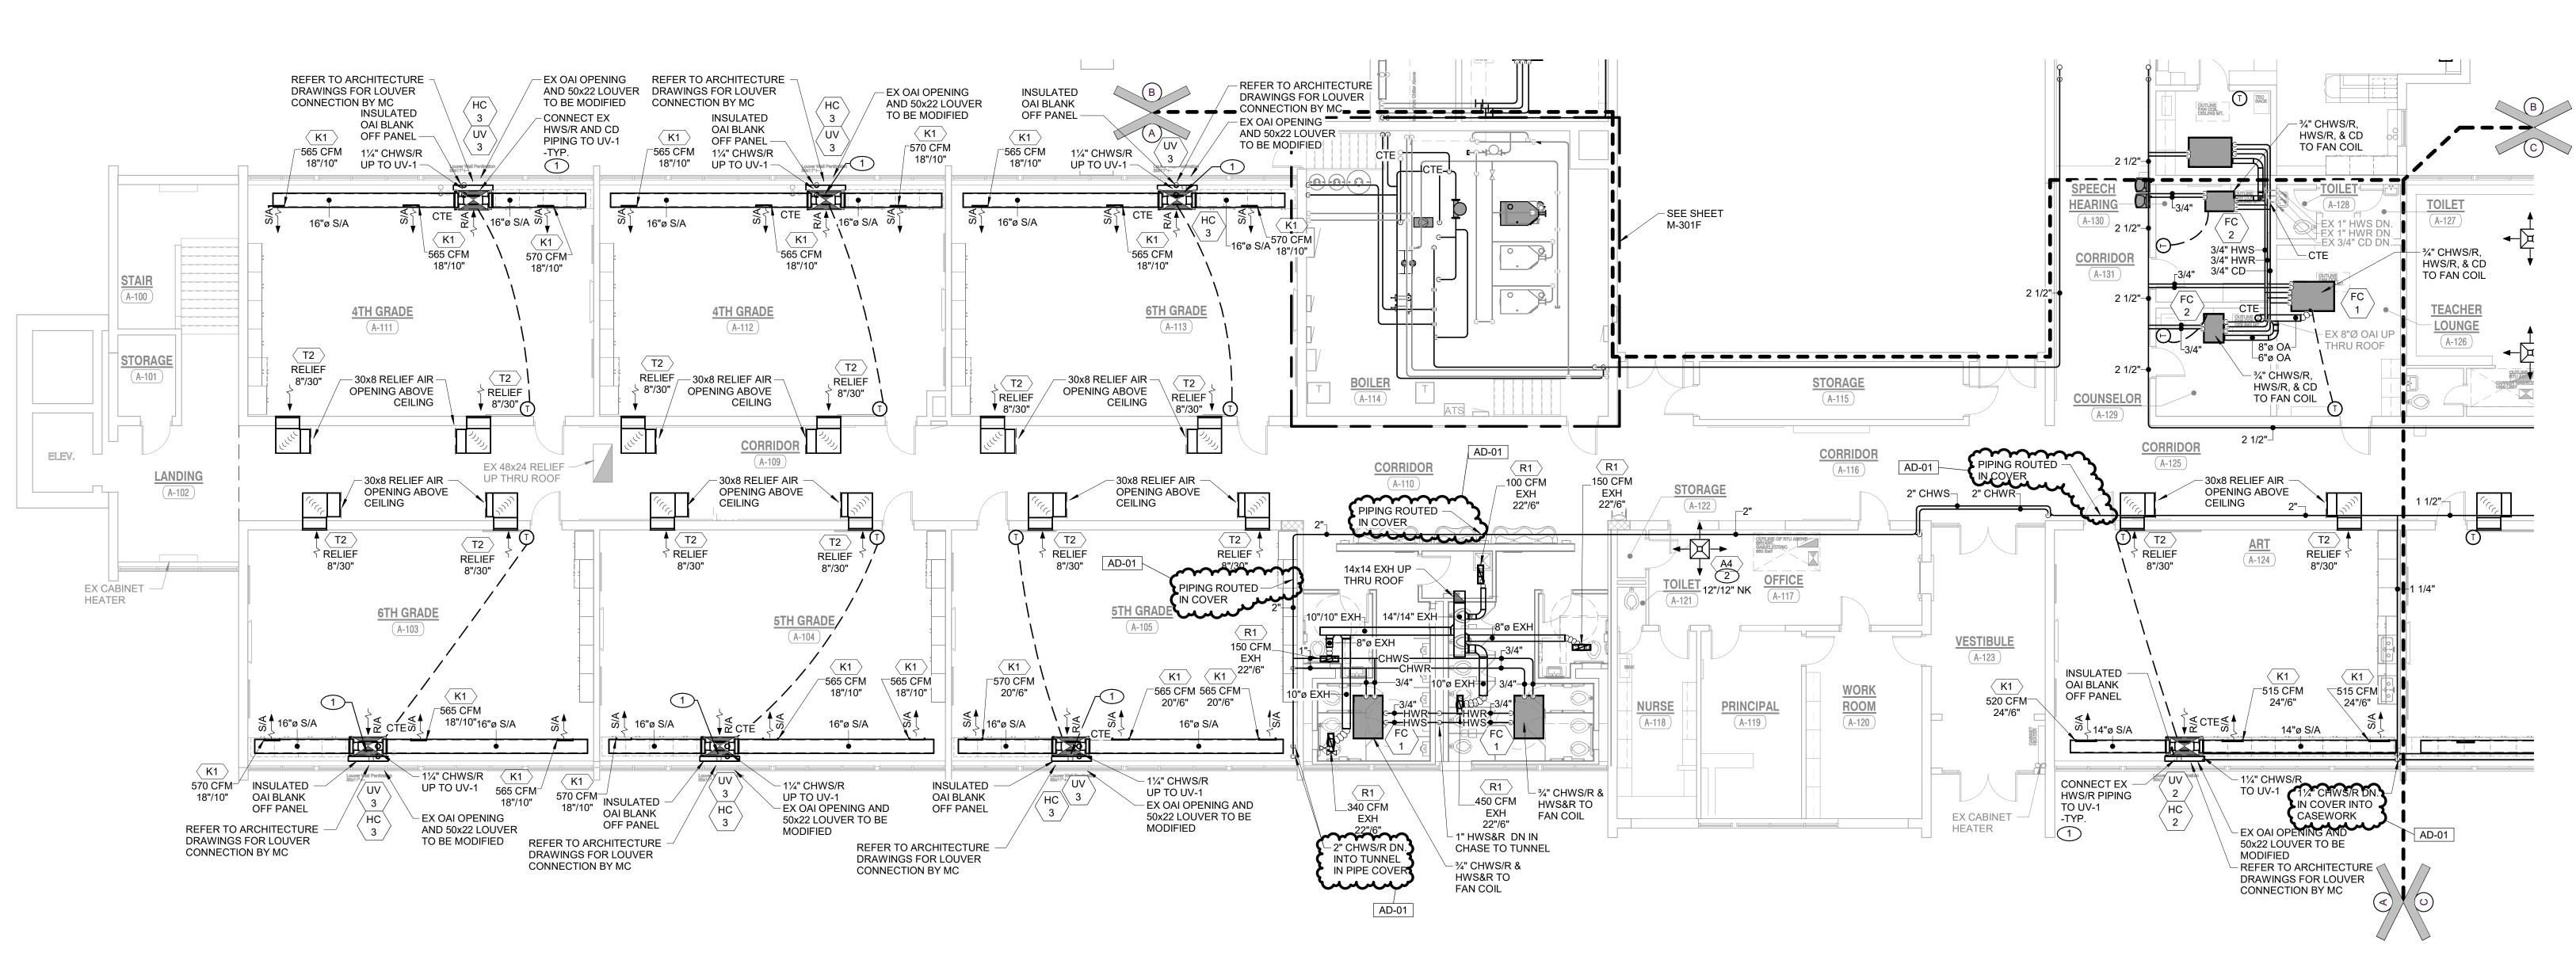

CONNECT NEW HOT WATER SUPPLY, HOT WATER RETURN, AND CONDENSATE PIPING TO EXISTING HOT WATER SUPPLY, HOT WATER RETURN, AND CONDENSATE PIPING AND TO NEW UNIT VENTILATOR. NEW PIPING SHALL MATCH EXISTING PIPE SIZE.

CONNECT EXISTING SUPPLY AIR DUCTWORK TO NEW SUPPLY AIR DIFFUSER COMPLETE AS REQUIRED. PROVIDE ADDITIONAL DUCTWORK, IF NECESSARY. BALANCE NEW SUPPLY AIR DIFFUSER TO EXISTING AIRFLOW CAPACITY.

SHEET NOTES

DESIGN

ARCHITECTURE • ENGINEERING • INTERIOR DESIGN

PROJECT:

MILLIES

ENGINEERING GROUP
(219) 924-8400


www.milliesengineeringgroup.

FRAZEE
ELEMENTARY
SCHOOL RENOVATIONS

FOR:
FAYETTE COUNTY SCHOOLS
CORPORATION

CONNERSVILLE, INDIANA

AND RELATED

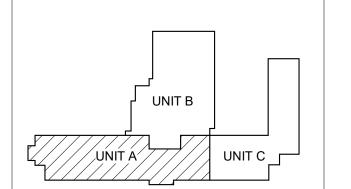

KEY PLAN

100% CONSTRUCTION DOCUMENTS

9102 N. Meridian St., Ste. 300 Indianapolis, IN 46260 Homepage: www.GibraltarDesign.com Email: info@GibraltarDesign.com Phone 317.580.5777 Fax 317.580.5778

PROJECT
23-152
DATE
05/15/24
COORDINATED BY
EH
DRAWN BY
CA
CHECKED BY

COPYRIGHT NOTICE:

THE CONCEPTS, DESIGNS, PLANS, DETAILS, ETC, SHOWN ON THIS DOCUMENT ARE THE PROPERTY OF GIBRALTAR DESIGN AND WERE CREATED FOR USE ON THIS SPECIFIC PROJECT. NONE OF THIS INFORMATION SHALL BE USED BY ANY PERSON OR FIRM FOR ANY PURPOSE WITHOUT THE EXPRESS WRITTEN CONSENT OF GIBRALTAR DESIGN. THE OWNER MAY RETAIN COPIES FOR INFORMATION AND REFERENCE IN CONNECTION ONLY WITH THIS PROJECT.

REVISIONS

MARK DATE ISSUED FOR

AD-01 06/05/24 ADDENDUM 1

UNIT "A" FIRST FLOOR AND LOWER LEVEL MECHANICAL PLANS

PROJECT
FRAZEE ELEMENTARY SCHOOL
RENOVATIONS AND RELATED

RENOVATIONS AND REWORK

© GIBRALTAR DESIGN
SHEET


M-101

MECHANICAL FIRST FLOOR PLAN - UNIT A

| 1/8" = 1'-0"



SHEET NOTES CONNECT NEW HOT WATER SUPPLY AND RETURN

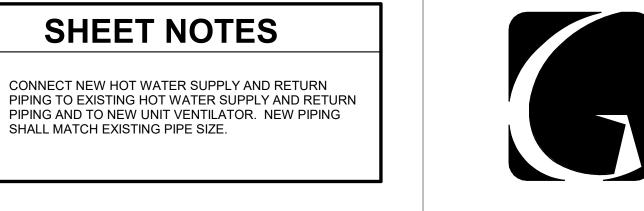




PROJECT:

GIBRALTAR

DESIGN

FRAZEE ELEMENTARY SCHOOL -RENOVATIONS AND RELATED WORK

FAYETTE COUNTY SCHOOLS CORPORATION CONNERSVILLE, INDIANA

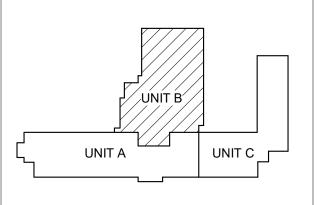

KEY PLAN

100% CONSTRUCTION **DOCUMENTS**

GIBRALTAR DESIGN 9102 N. Meridian St., Ste. 300 Indianapolis, IN 46260 Homepage: www.GibraltarDesign.com Email: info@GibraltarDesign.com Phone 317.580.5777 Fax 317.580.5778

DATE 05/15/24 COORDINATED BY DRAWN BY CA CHECKED BY


DJ COPYRIGHT NOTICE: THE CONCEPTS, DESIGNS, PLANS, DETAILS, ETC, SHOWN ON THIS DOCUMENT ARE THE PROPERTY OF GIBRALTAR DESIGN AND WERE CREATED FOR USE ON THIS SPECIFIC PROJECT. NONE OF THIS INFORMATION SHALL BE USED BY ANY PERSON OR FIRM FOR ANY PURPOSE WITHOUT THE EXPRESS WRITTEN CONSENT OF GIBRALTAR DESIGN. THE OWNER MAY RETAIN COPIES FOR INFORMATION AND REFERENCE IN CONNECTION ONLY WITH THIS PROJECT.

REVISIONS MARK DATE ISSUED FOR AD-01 06/05/24 ADDENDUM 1


DRAWING UNIT "B" MECHANICAL FIRST FLOOR PLAN

FRAZEE ELEMENTARY SCHOOL -

RENOVATIONS AND RELATED

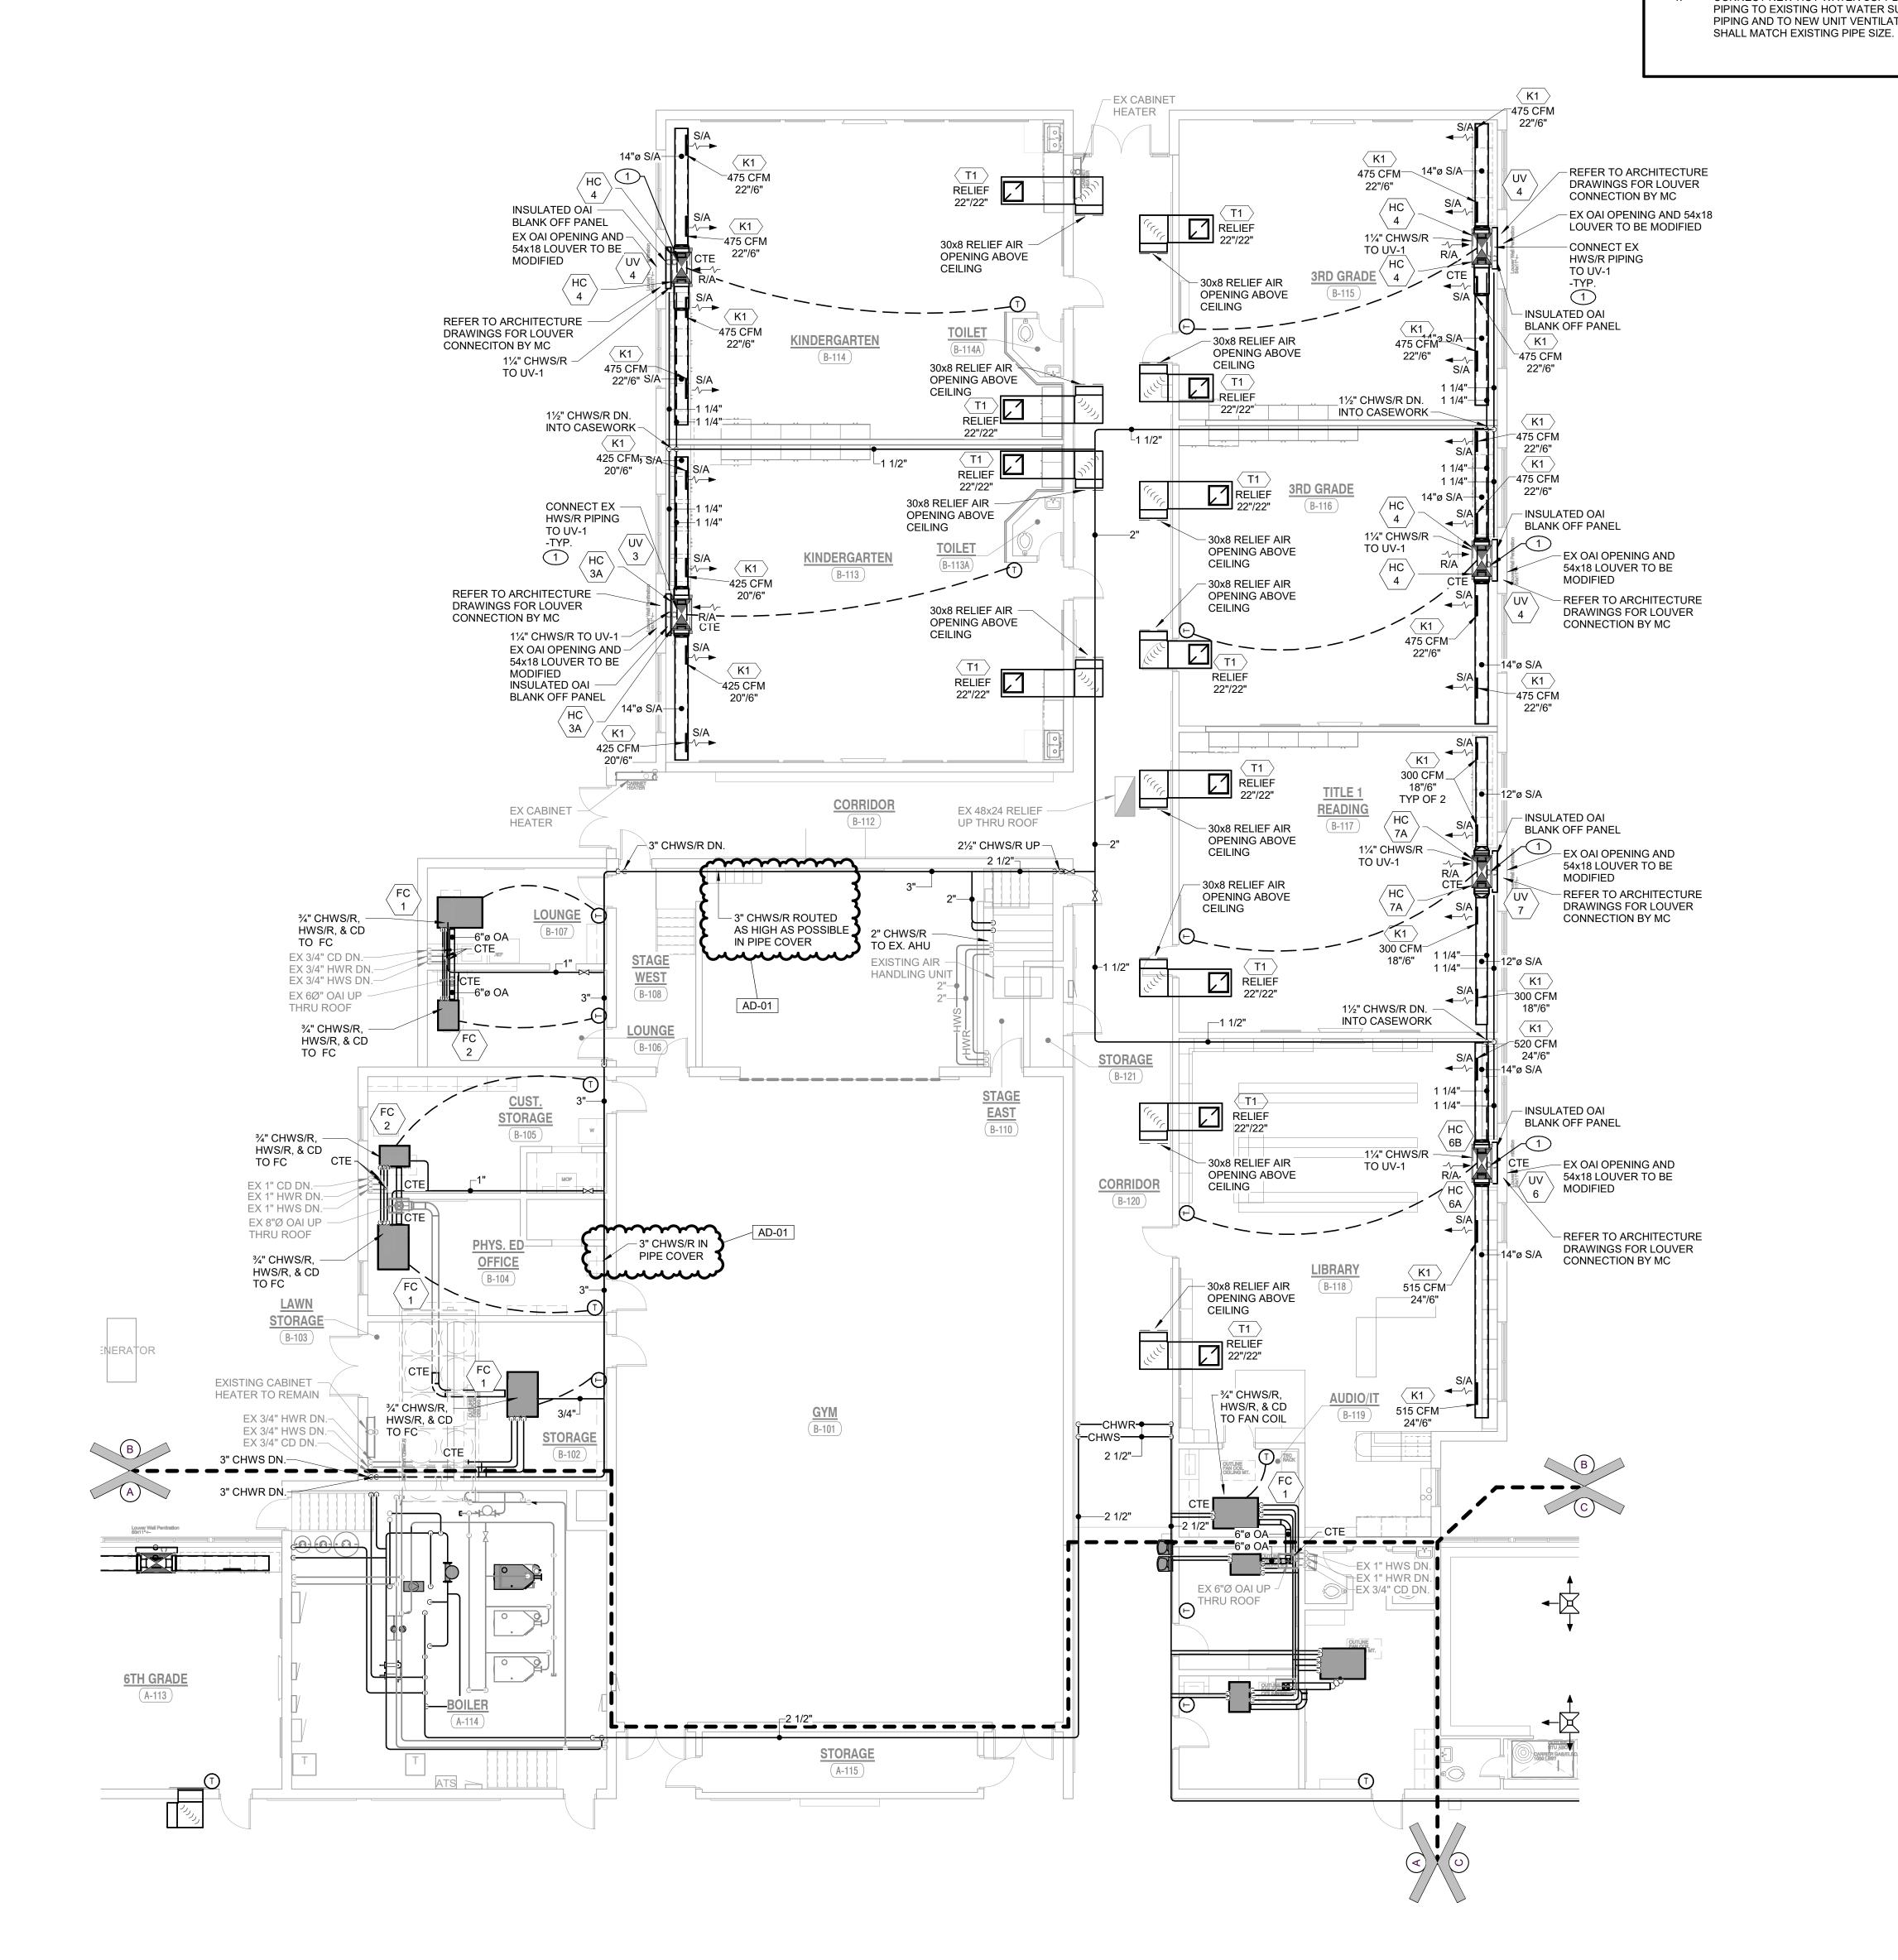



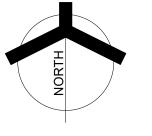

SHEET NOTES 1 CONNECT NEW HOT WATER SLIDRI Y AND E

- CONNECT NEW HOT WATER SUPPLY AND RETURN PIPING TO EXISTING HOT WATER SUPPLY AND RETURN PIPING AND TO NEW UNIT VENTILATOR. NEW PIPING SHALL MATCH EXISTING PIPE SIZE.
- CONNECT EXISTING SUPPLY AIR DUCTWORK TO NEW SUPPLY AIR DIFFUSER COMPLETE AS REQUIRED. PROVIDE ADDITIONAL DUCTWORK, IF NECESSARY. BALANCE NEW SUPPLY AIR DIFFUSER TO EXISTING AIRFLOW CAPACITY.
- 3. CONNECT EXISTING RETURN AIR DUCTWORK TO NEW RETURN AIR GRILLE COMPLETE AS REQUIRED. PROVIDE ADDITIONAL DUCTWORK, IF NECESSARY. BALANCE NEW RETURN AIR GRILLE TO EXISTING AIRFLOW CAPACITY.



MILLIES


ENGINEERING GROU
(219) 924-8400

(219) 924-840 www.milliesengineering

PROJECT:
FRAZEE

ELEMENTARY
SCHOOL RENOVATIONS
AND RELATED
WORK

FOR:
FAYETTE COUNTY SCHOOLS
CORPORATION
CONNERSVILLE, INDIANA

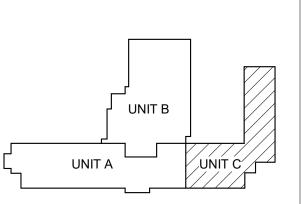

KEY PLAN



DOCUMENTS

GIBRALTAR DESIGN

9102 N. Meridian St., Ste. 300
Indianapolis, IN 46260
Homepage: www.GibraltarDesign.com

PROJECT
23-152
DATE
05/15/24
COORDINATED BY
EH
DRAWN BY
CA

CHECKED BY
DJ

COPYRIGHT NOTICE:

THE CONCEPTS, DESIGNS, PLANS, DETAILS, ETC, SHOWN ON THIS DOCUMENT ARE THE PROPERTY OF GIBRALTAR DESIGN AND WERE CREATED FOR USE ON THIS SPECIFIC PROJECT. NONE OF THIS INFORMATION SHALL BE USED BY ANY PERSON OR FIRM FOR ANY PURPOSE WITHOUT THE EXPRESS WRITTEN CONSENT OF GIBRALTAR DESIGN. THE OWNER MAY RETAIN COPIES FOR INFORMATION AND REFERENCE IN CONNECTION ONLY WITH THIS PROJECT.

CONNECTION ONLY WITH THIS PROJECT.

REVISIONS

MARK DATE ISSUED FOR


AD-01 06/05/24 ADDENDUM 1


DRAWING
UNIT "C" MECHANICAL
FIRST FLOOR PLAN


PROJECT
FRAZEE ELEMENTARY SCHOOL RENOVATIONS AND RELATED

© GIBRALTAR DESIGN

M-10

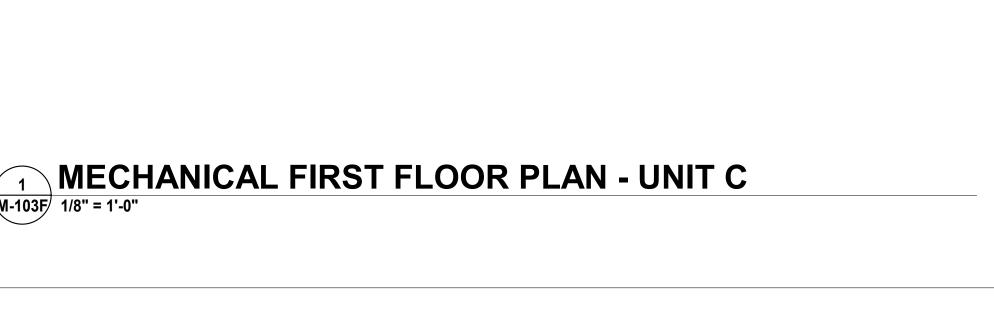

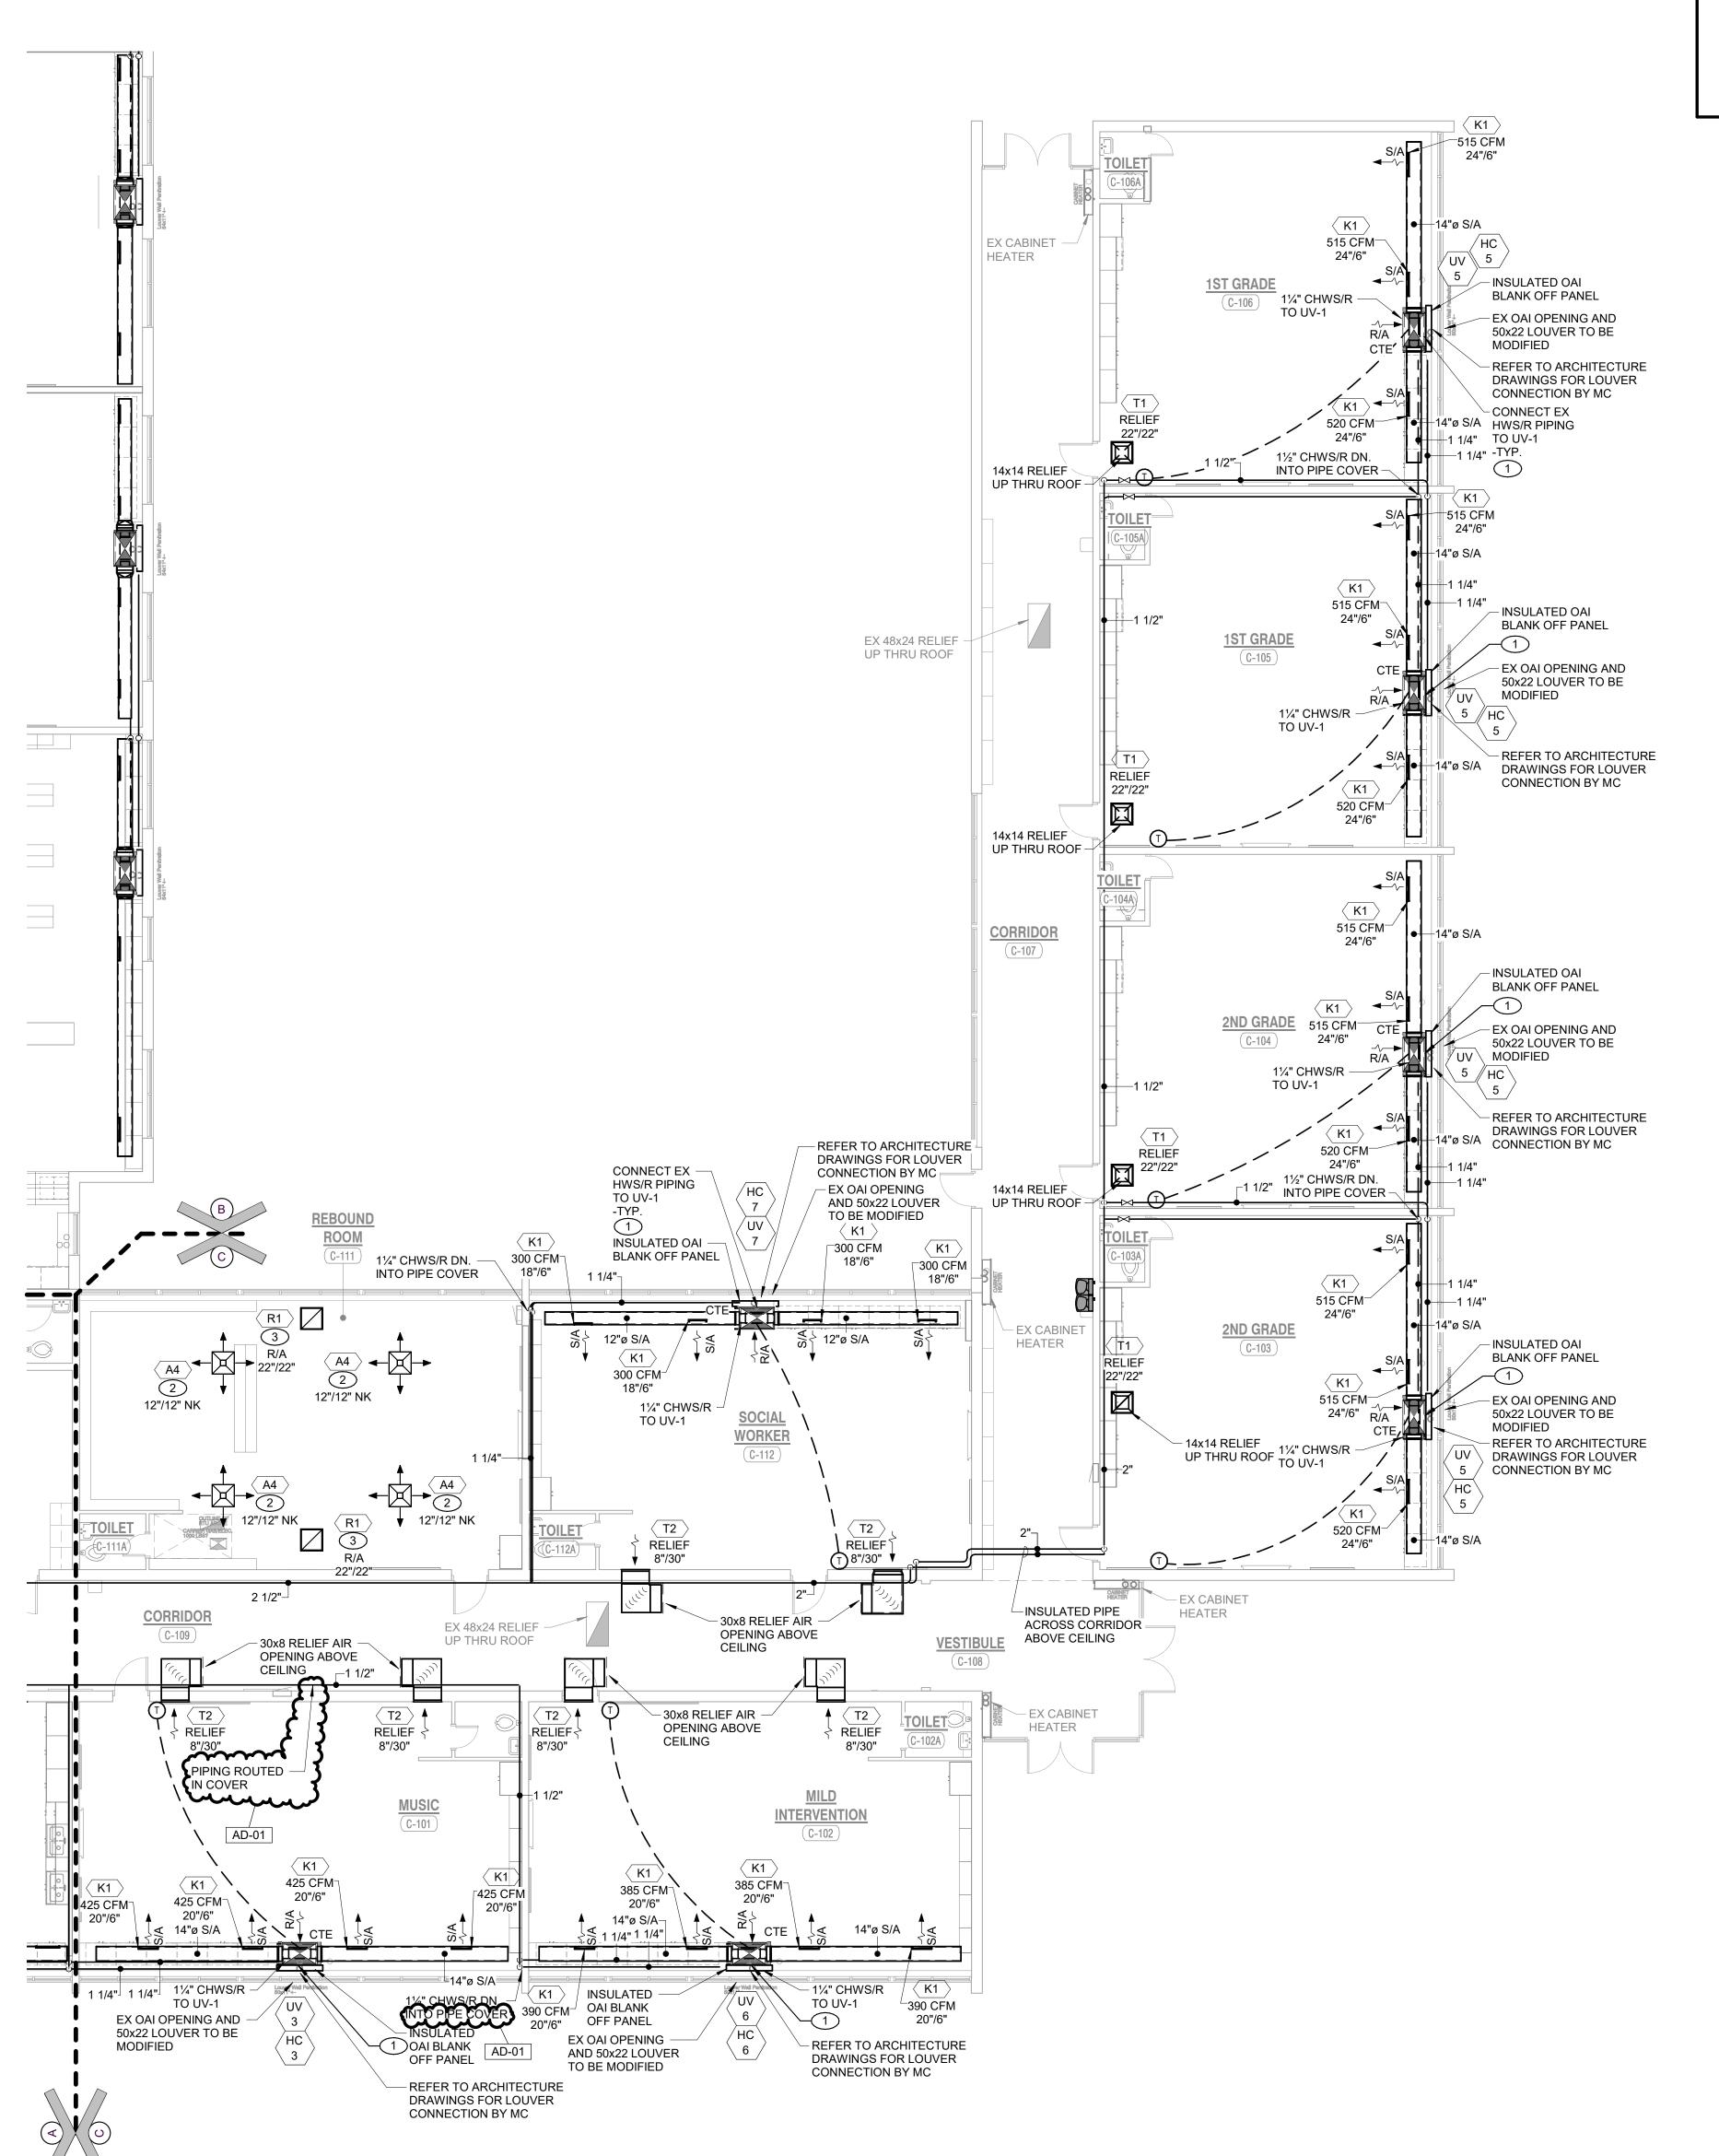

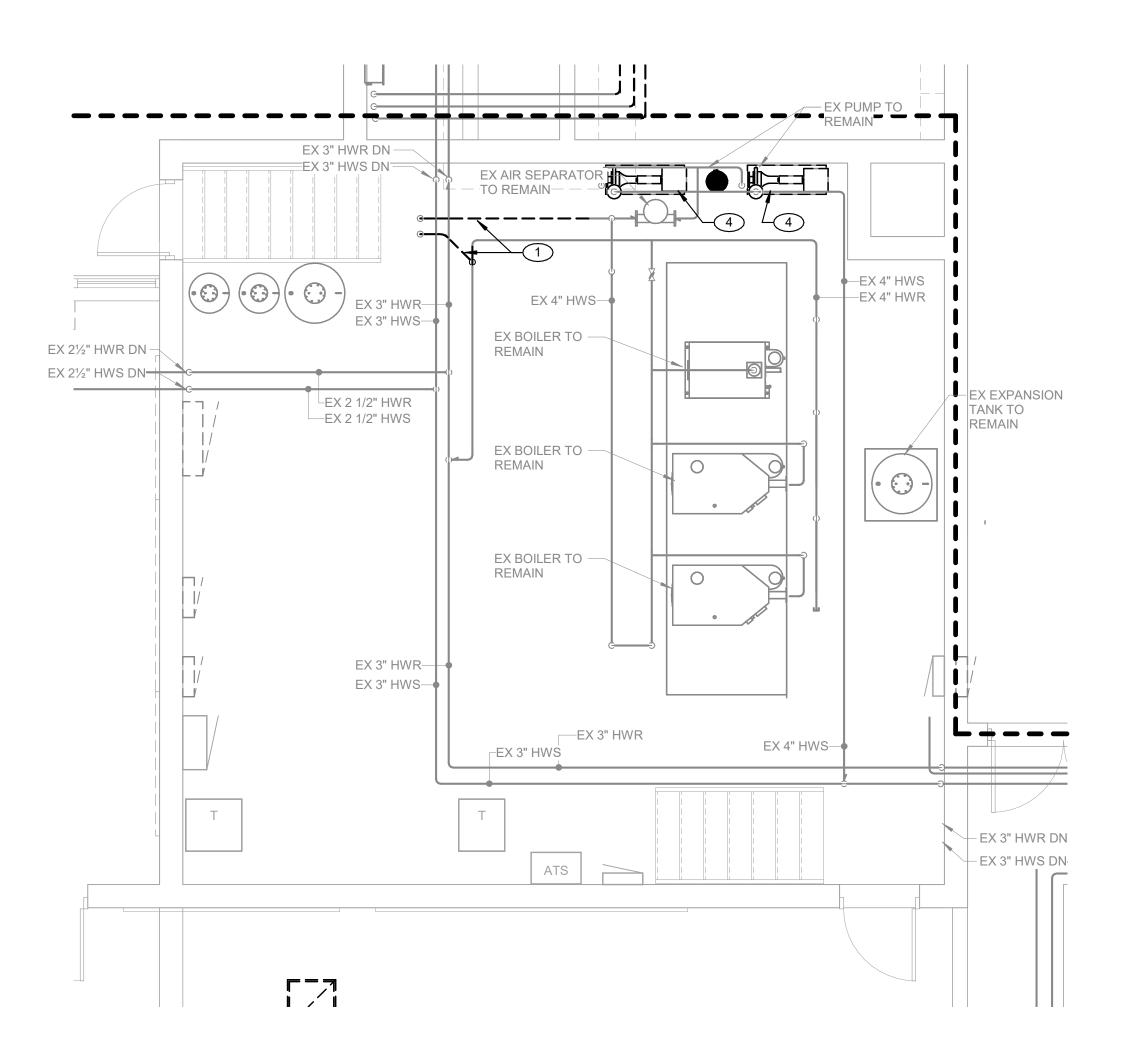

EX 3" HWR
EX 4" HWS

EX 21/2" HWR DN -

EX 21/2" HWS DN

ê /

EX 3" HWR DN -

EX 3" HWS DN=

EX 2 1/2" HWR

EX 2 1/2" HWS

minimum.

EX 4" HWS-

EX 4" HWS-

EX BOILER TO -

REMAIN

MECHANICAL DEMOLITION PLAN - BOILER ROOM ALTERNATE

M-301F 1/4" = 1'-0"

EX 4" HWR

EX 4" HWS

TANK TO REMAIN

EX 3" HWR DN

EX 3" HWS DN

SHEET NOTES

REMOVE EXISTING CHILLED WATER SUPPLY & RETURN PIPING AND ASSOCIATED VALVES COMPLETE AS REQUIRED.

- 2. REMOVE EXISTING BOILER AND ALL ASSOCIATED HOT WATER SUPPLY AND RETURN PIPING, GAS PIPING, FLUES, CONTROLS, ELECTRICAL POWER CONNECTIONS, ETC
- COMPLETE AS REQUIRED.

 CONNECT NEW HOT WATER SUPPLY, HOT WATER RETURN, AND GAS PIPING TO EXISTING HOT WATER

SUPPLY, HOT WATER RETURN, AND GAS PIPING AND TO

REMOVE EXISTING HOT WATER PUMPS AND ASSOCIATED

- NEW BOILER.

 CLEAN, LUBRICARE, AND CHECK EXISTING PUMP FOR PROPER OPERATION. TEST THE EXISTING PUMP FLOW CAPACITIES AND PUMP HEAD CAPABILITES BEFORE ANY
- SYSTEM MODIFICATIONS HAVE BEGUN AND SUBMIT FOR REVIEW.

 5. BALANCE EXISTING PUMP TO QUANTITY INDICATED ON PLANS.
- PIPING, VALVES, CONTROLS, ELECTRICAL CONNECTIONS, ETC. COMPLETE AS REQUIRED.
- REMOVE EXISTING CHEMICAL TREATMENT AND ASSOCIATED PIPING, ETC. COMPLETE AS REQUIRED.

 REMOVE EXISTING BYPASS FILTER AND ASSOCIATED PIPING, ETC. COMPLETE AS REQUIRED.

AD-01


GIBRALTAR DESIGN

PROJECT:

ARCHITECTURE • ENGINEERING • INTERIOR DESIGN

FRAZEE
ELEMENTARY
SCHOOL RENOVATIONS
AND RELATED
WORK

FOR:
FAYETTE COUNTY SCHOOLS
CORPORATION
CONNERSVILLE, INDIANA

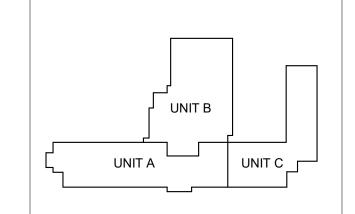

KEY PLAN

100% CONSTRUCTION

DOCUMENTS

GIBRALTAR DESIGN

9102 N. Meridian St., Ste. 300
Indianapolis, IN 46260
Homepage: www.GibraltarDesign.com
Email: info@GibraltarDesign.com
Phone 317.580.5777 Fax 317.580.5778

PROJECT
23-152
DATE
05/15/24
COORDINATED BY
EH
DRAWN BY
CA

EH
DRAWN BY
CA
CHECKED BY
DJ

COPYRIGHT NOTICE:
THE CONCEPTS, DESIGNS, PLANS, DETAILS, ETC, SHOWN ON THIS DOCUMENT ARE THE PROPERTY OF GIBRALTAR DESIGN AND WERE CREATED FOR USE ON THIS SPECIFIC PROJECT.
NONE OF THIS INFORMATION SHALL BE USED BY ANY PERSON OR FIRM FOR ANY PURPOSE WITHOUT THE EXPRESS WRITTEN CONSENT OF GIBRALTAR DESIGN. THE OWNER MAY RETAIN COPIES FOR INFORMATION AND REFERENCE IN CONNECTION ONLY WITH THIS PROJECT.

WRITTEN CONSENT OF GIBRALTAR DESIGN. THE RETAIN COPIES FOR INFORMATION AND REFERE CONNECTION ONLY WITH THIS PROJECT.

REVISIONS

MARK DATE ISSUED FOR

AD-01 06/05/24 ADDENDUM 1


DRAWING
MECHANICAL PLANS BOILER ROOM


PROJECT
FRAZEE ELEMENTARY SCHOOL RENOVATIONS AND RELATED

SHEET

M-301F

MECHANICAL DEMOLITION PLAN - BOILER ROOM
1/4" = 1'-0"

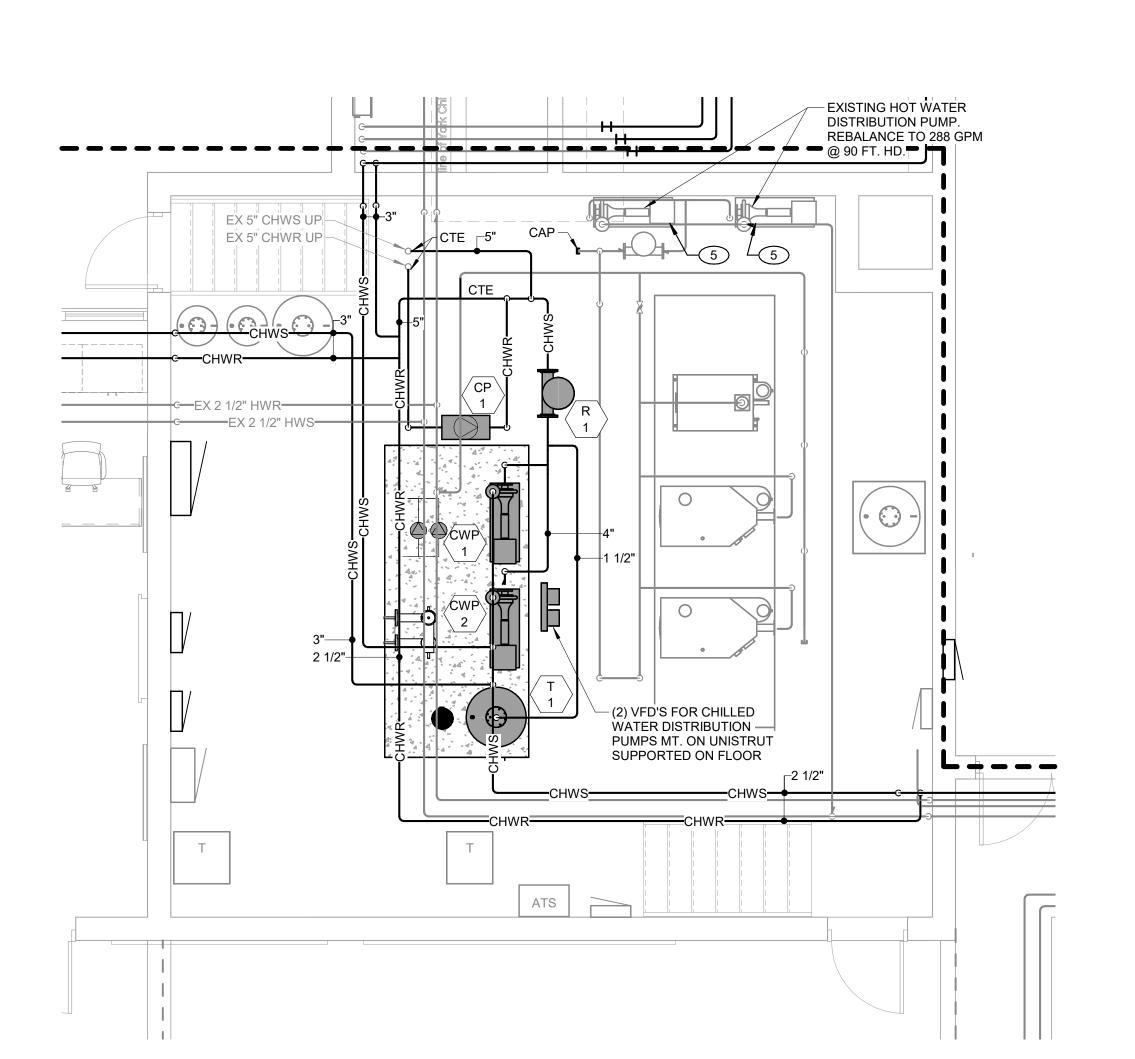

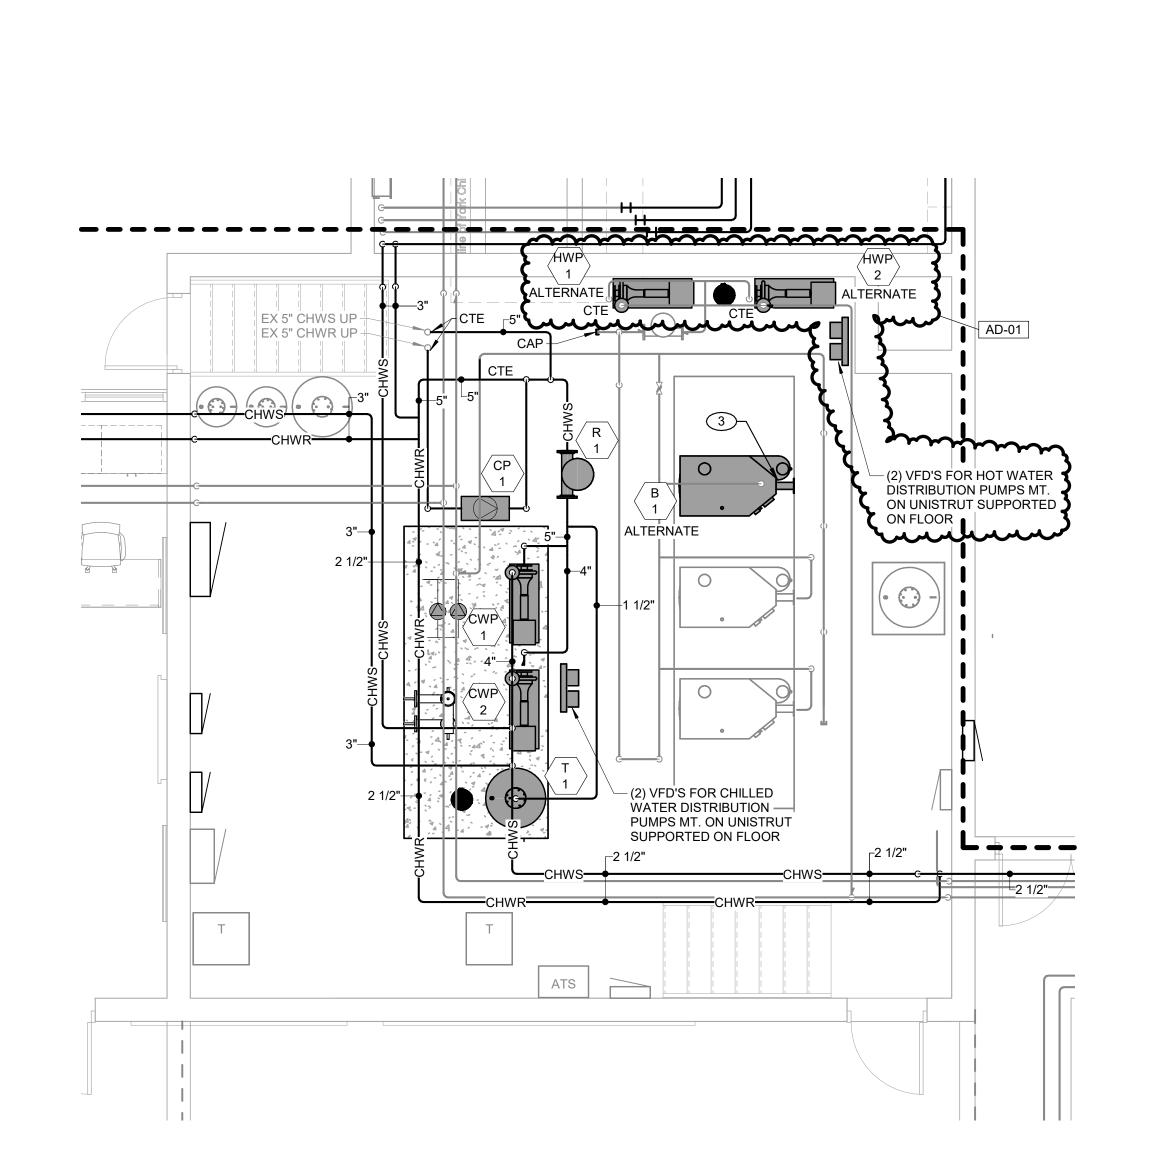

MECHANICAL PLAN - BOILER ROOM ALTERNATE

1/4" = 1'-0"

									ME	ECH	ANIC	AL	EQ	UIPM	1EN	T SC	HED	ULE															
					FAN MC	OTOR DA	TA			E	KHAUST FAN	NS		CHILLED	WATER C	COOLING EC	UIPMENT/C	OIL DATA		НС	T WATER	RHEATING	EQUIPMENT/0	OIL DATA				ELECT	RICAL DATA	\ \	UNITS CONTROLLE	EQUIPMENT	i
TAG	MANUFACTURER	MODEL NUMBER	DESCRIPTION	EFFICIENCY	-	MIN OAI	CFM												MAX	МВ	Н МВН			MAX	LOAD					STARTER	CONTROLLI CONTROLLI		
					CFM	HIGH	LOW TSF	P ESP B	HP HP	RPM CI	M ESP E	BHP H	IP RPM	MBH SH	C GPM	EDB EWB	LDB LWB	B EWT L	.WT WPD	CAT (IN) (OUT) GPM E	AT LAT EV	T LWT WPI	D HP MCA	FLA AMI	PS MOCP	VOLT P	HASE HZ.	MC. EC	C. BY		
UV-1	SYSTEMAIR	FRESHMAN - C	VERTICAL UNIT VENTILATOR - HOT WATER/CHILLED WATER - 4 PIPE	-	1800	755		0.1	- 1	-	- -	-	- -	91.21 57.1	5 15	84.4 70.9	55.7 55.4	45 5	7.12 12	- 115	.3 93.05	5 8	34 92.94 13	5 105.8 12	- 9.25		15	240	1 60	X -	TSTAT	-	NOTE 1
UV-2	SYSTEMAIR	FRESHMAN - C	VERTICAL UNIT VENTILATOR - HOT WATER/CHILLED WATER - 4 PIPE	-	1550	570		0.1	- 1	-		-		74.9 48.2	12.4	82.8 69.6	54.7 54.4	45 5	7.03 12	- 99.3	98.4	8	40 98.95 13	5 109.8 12	- 9.25		15	240	1 60	X -	TSTAT	-	NOTE 1
UV-3	SYSTEMAIR	FRESHMAN - C	VERTICAL UNIT VENTILATOR - HOT WATER/CHILLED WATER - 4 PIPE	-	1700	565		0.1	- 0.75	-		-		73.66 50.3	6 12.2	85.0 70.5	58.2 57.4	45 5	7.03 12	- 10	5 65.1	8	40 96.82 13	5 108.4 12	- 7.38		15	240	1 60	X -	TSTAT	-	NOTE 1
UV-4	SYSTEMAIR	FRESHMAN - C	VERTICAL UNIT VENTILATOR - HOT WATER/CHILLED WATER - 4 PIPE	-	1900	748	- -	0.1	- 1	-	- -	-		60.83 38.5	10.1	76.9 66.9	54.4 54.2	45	57 12	- 55.9	73.8	8 5	1.2 84.32 13	5 120.8 12	- 9.25		15	240	1 60	X -	TSTAT	-	NOTE 1
UV-5	SYSTEMAIR	FRESHMAN - C	VERTICAL UNIT VENTILATOR - HOT WATER/CHILLED WATER - 4 PIPE	-	1550	410		0.1	- 1	-	- -	-		70.51 50.2	22 11.7	82.3 68.9	58.4 57.5	45 5	7.01 12	- 98.3	85 66.4	8 5	1.9 99.38 13	5 110.1 12	- 9.25		15	240	1 60	X -	TSTAT	-	NOTE 1
UV-6	SYSTEMAIR	FRESHMAN - C	VERTICAL UNIT VENTILATOR - HOT WATER/CHILLED WATER - 4 PIPE	-	1550	325		0.1	- 1	-		-		52.81 36.7	3 8.8	78.3 67.0	56.9 56.2	45 5	6.96 12	- 53.8	55.8	8 5	4.9 86.58 13	5 121.4 12	- 9.25		15	240	1 60	X -	TSTAT	-	NOTE 1
UV-7	SYSTEMAIR	FRESHMAN - B	VERTICAL UNIT VENTILATOR - HOT WATER/CHILLED WATER - 4 PIPE	-	1200	110		0.1	- 1	-		-		32.61 32.6	51 5.4	76.5 57.8	51.7 57.3	45 5	7.03 12	- 40	9 32.8	8 6	4.2 95.34 13	5 124.6 12	- 9.25		15	240	1 60	X -	TSTAT	-	NOTE 1
FC-1	IEC	CBY-06	HORIZONTAL RECESSED FAN COIL UNIT - CHW/HW 4 PIPE	-	545	-		0.1	- 1/6	-		-		19.2 12.8	8 3.8	80.2 68.4	58.9 57.5	45	56.5 12		16.4	3.3 6	0.1 88.1 13	5 125 12		1.9 -	-	120	1 60	X -	TSTAT	-	NOTE 2
FC-2	IEC	CBY-03	HORIZONTAL RECESSED FAN COIL UNIT - CHW/HW 4 PIPE	-	255	-		0.1	- 1/7	-		-		8.7 6	2	77.4 65.7	55.6 54.3	45	53.7 12		7.3	2.9 7	0.8 97.5 13	5 129.9 12		1.5 -	-	120	1 60	Х -	TSTAT	-	NOTE 2
FC-3	IEC	CXB-12	HORIZONTAL CABINET FAN COIL UNIT - CHW/HW 4 PIPE	-	1115	-		0.1	- (2)1/6	-		-		37.4 24.	7 7.6	77.6 66.9	57.5 56.2	45	54.7 12		21.3	1 6	3.3 81 13	5 92.2 12		4.8 -	15	120	1 60	Х -	TSTAT	-	NOTE 2
FC-4	IEC	CXB-04	HORIZONTAL CABINET FAN COIL UNIT - CHW/HW 4 PIPE	-	320	-		0.1	- 1/6	-		-		10.3 6.6	2	77.1 67.1	58.5 57.0	45	55 12		13.4	1 6	5.1 104 13	5 107.9 12		2.1 -	-	120	1 60	Х -	TSTAT	-	NOTE 2
B-1	LOCHINVAR	FB-1001	CONDENSING HOT WATER BOILER - ALTERNATE	-	-	-		-		-		-			-			-		- 99	9 961	96	11	5 135 12	- 8		-	120	1 60	Х -	EX FMS	1838	NOTE 5
TEF-1	GREENHECK	GB-130	ROOF MOUNTED TOILET EXHAUST FAN	-	-	-		-		-	- 1190	0.3 1	1/4 1020		-			-			-	-			- 7.2		15	120	1 60	X -	WALL MTD. SWITCH	-	NOTE 3
HC-1A	TRANE	DSTB15016G0BA1 50BABA00B	HOT WATER HEATING COIL	-	-	-		-		-		_			-			-			13.7	1.37	55 75 13	5 115 12			-	-			INT'LCK W/ UV-1	-	NOTE 4
HC-1B	TRANE	DT0B15018G0BA1 50EABA0AB	HOT WATER HEATING COIL	-	-	-		-		-		-			-			-			26.64	2.67	55 75 13	5 115 12			-	-			INT'LCK W/ UV-2	-	NOTE 4
HC-2	TRANE	DW0B19022G0DA 095	HOT WATER HEATING COIL	-	-	-		-		-		-			-			-			33.94	3.4	55 75 13	5 115 12			-	-			INT'LCK W/ UV-3	-	NOTE 4
HC-3	TRANE	DW0B19024G0DA 090	HOT WATER HEATING COIL	-	-	-		-		-		-			-			-			36.44	3.65	55 75 13	5 115 12			-	-			INT'LCK W/ UV-4	-	NOTE 4
HC-3A	TRANE	DSTB15016G0BA1 50BABA0AB	HOT WATER HEATING COIL	-	-	-		-		-		-			-			-			19.1	1.91	55 75 13	5 115 12			-	-			INT'LCK W/ UV-5	-	NOTE 4
HC-4	TRANE	DSTB15016G0BA1 50EABA0AB	HOT WATER HEATING COIL	-	-	-		-		-		-			-			-			21.98	3 2.2	55 75 13	5 115 12			-	-			INT'LCK W/ UV-6	-	NOTE 4
HC-5	TRANE	DW0B19022G0DA 095	HOT WATER HEATING COIL	-	-	-		-		-		-			-			-			33.94	3.4	55 75 13	5 115 12			-	-			INT'LCK W/ UV-7	-	NOTE 4
HC-6	TRANE	DW0B19022G0DA 094	HOT WATER HEATING COIL	-	-	-		-		-		-			-			-			33.4	3.35	55 75 13	5 115 12			-	-			INT'LCK W/ UV-8	-	NOTE 4
HC-6A	TRANE	DSTB15016G0BA1 50EABA0AB	HOT WATER HEATING COIL	-	-	-	- -	-	- -	-	- -	-	- -	- -	-	- -		-	- -		23.02	2 2.31	55 75 13	5 115 12			-	-		- -	INT'LCK W/ UV-9	-	NOTE 4
HC-6B	TRANE	DSTB15016G0BAB A00B	HOT WATER HEATING COIL	-	-	-		-		-		_	- -		-			-	- -		12.44	1.25	55 75 13	5 115 12			-	-	- -		INT'LCK W/ UV-10	-	NOTE 4
HC-7	TRANE	DW0B15020G0DA 150	HOT WATER HEATING COIL	-	-	-		-		-		_	- -		-			-	- -		25.95	5 2.6	55 75 13	5 115 12			-	-	- -		INT'LCK W/ UV-11	-	NOTE 4
HC-7A	TRANE	DSTB15016G0BA1 50BABA00B	HOT WATER HEATING COIL	-	-	-		-	- -	-		_	- -		-			-			13.78	3 1.38	55 75 13	5 115 12			-	-	- -		INT'LCK W/ UV-12	_	NOTE 4
HC-8	TRANE	DW0B31030G0DA 080	HOT WATER HEATING COIL	-	-	-		-	- -	-		_			-	- -		-	- -		300.28	8 30.04	40 101.5 16	0 140 12			-	-			INT'LCK W/ UV-8	_	NOTE 4
											1																				1 2.0		

NOTE 1: PROVIDE WITH: INTEGRATED ENTHALPY ECONOMIZER WALL SLEEVE AND LOUVER DISCONNECT SWITCH 6" FALSEBACK FILLER PANEL FROM BACK OF UNIT TO WALL 13"W. UTILITY SIDE CABINET TERMINAL STRIPS FOR DDC READY FACE AND BYPASS DAMPER SEE SPECIFICATIONS FOR ADDITIONAL

REQUIREMENTS.

NOTE 2: PROVIDE WITH: VIBRATION ISOLATION HANGERS INTEGRAL S/A & R/A GRILLE DISCONNECT SWITCH CONDENSATE PUMP UNIT CONFIGURATION: BOTTOM SUPPLY AIR GRILLE BOTTOM RETURN AIR GRILLE BACK OUTSIDE AIR INTAKE DUCT COLLAR SEE SPECIFICATIONS FOR ADDITIONAL

REQUIREMENTS.

NOTE 3: PROVIDE WITH: DISCONNECT SWITCH MOTORIZED DAMPER BIRD SCREEN ROOF CURB SEE SPECIFICATIONS FOR ADDITIONAL REQUIREMENTS.

SEE SPECIFICATIONS FOR ADDITIONAL

NOTE 4:

REQUIREMENTS.

NOTE 5: PROVIDE WITH: NEUTRALIZATION BASIN
SEE SPECIFICATIONS FOR ADDITIONAL REQUIREMENTS.

COMBUSTION AIR INTAKE DAMPER

				PL	JM	P S	CH	IEC	DUL	E				
TAG									R DATA		STA	RTER	SUCTION/	
TAG	MANUFACTURER	MODEL NUMBER	DESCRIPTION	GPM	HEAD (FT.)	HP	RPM	VOLT	PHASE	HZ.	: MC.		DISCHARGE SIZE	REMARKS
CWP-1	BELL & GOSSETT	E-1510 2BD	BASE MOUNTED CHILLED WATER DISTRIBUTION PUMP	166	70	7 1/2	1561	480	3	60	Х	-	4"/4"	CHILLED WATER PRIMARY PUMPS W/ VFD OPERATING IN
CWP-2	BELL & GOSSETT	E-1510 2BD	BASE MOUNTED CHILLED WATER DISTRIBUTION PUMP	166	70	7 1/2	1561	480	3	60	Х	-	4"/4"	PARALLEL. 332 GPM @ 70 FT. HD. WITH DUAL POWER FEEDERS
CP-1	BELL & GOSSETT	E-80 4x4x7B	IN-LINE CHILLER PUMP	332	30	5	1750	480	3	60	×	~~	4"/4"	~~~~~~~~~~~~~~~~~~~~~~~~~~~~~~~~~~~~~~
HWP-1	BELL & GOSSETT	E-1510 2EB	BASE MOUNTED HOT WATER DISTRIBUTION PUMP - ALTERNATE	301	90	10	1750	480	3	60	Х	-	3"/2"	ALTERNATE
HWP-2	BELL & GOSSETT	E-1510 2EB	BASE MOUNTED HOT WATER DISTRIBUTION PUMP - ALTERNATE	301	90	10	1750	480	3	60	Х	-	3"/2"	ALTERNATE

				INTAKE/	RELIEF HO	OD SCHEDULE
TAG	MANUFACTURER	MODEL#	THROAT SIZE	DESCRIPTION	HOOD LOCATION	REMARKS
RH-1	ACME	#TIV	14x14	RELIEF AIR HOOD	ROOF	PROVIDE W/ BIRDSCREEN, BAROMETRIC RELIEF DAMPER. AND 18" HIGH ROOF CURB.

\bigcirc		GR	ILLE, REGI	STER,	& DIFFUS	ER SO	CHEDULE
TAG	MANUFACTURER	MODEL	DESCRIPTION	AIR PATTERN	MOUNTING	SIZE	TYPE OF CONTROL REMARKS
A4	NAILOR	6500-O	SUPPLY CEILING DIFFUSER	4-WAY	2' x 2' LAY-IN PANEL	SEE PLANS	OBD
K1	Price Industries	SDGE Series	Spiral Duct Grille Extruded Aluminum				
R1	NAILOR	6145H-O	RETURN/EXHAUST REGISTER	LOUVERED GRILLE	LAY-IN PANEL	SEE PLANS	OBD
T1	NAILOR	6145H	RETURN/EXHAUST REGISTER	LOUVERED GRILLE	LAY-IN PANEL	SEE PLANS	-
T2	NAILOR	6145H	RETURN/EXHAUST/T.A. GRILLE	LOUVERED GRILLE	SURFACE-MOUNTED	SEE PLANS	-

GIBRALTAR

DESIGN ARCHITECTURE • ENGINEERING • INTERIOR DESIGN

PROJECT:

FRAZEE ELEMENTARY SCHOOL -RENOVATIONS AND RELATED WORK

FAYETTE COUNTY SCHOOLS CORPORATION CONNERSVILLE, INDIANA

> 100% CONSTRUCTION **DOCUMENTS**

GIBRALTAR DESIGN 9102 N. Meridian St., Ste. 300 Homepage: www.GibraltarDesign.com Email: info@GibraltarDesign.com Phone 317.580.5777 Fax 317.580.5778

PROJECT 23-152 DATE 05/15/24 COORDINATED BY DRAWN BY CA CHECKED BY


DJ COPYRIGHT NOTICE: THE CONCEPTS, DESIGNS, PLANS, DETAILS, ETC, SHOWN ON THIS DOCUMENT ARE THE PROPERTY OF GIBRALTAR DESIGN AND WERE CREATED FOR USE ON THIS SPECIFIC PROJECT. NONE OF THIS INFORMATION SHALL BE USED BY ANY PERSON OR FIRM FOR ANY PURPOSE WITHOUT THE EXPRESS WRITTEN CONSENT OF GIBRALTAR DESIGN. THE OWNER MAY RETAIN COPIES FOR INFORMATION AND REFERENCE IN CONNECTION ONLY WITH THIS PROJECT.


REVISIONS MARK DATE ISSUED FOR AD-01 06/05/24 ADDENDUM 1


MECHANICAL SCHEDULES

PROJECT FRAZEE ELEMENTARY SCHOOL -RENOVATIONS AND RELATED

M-501F

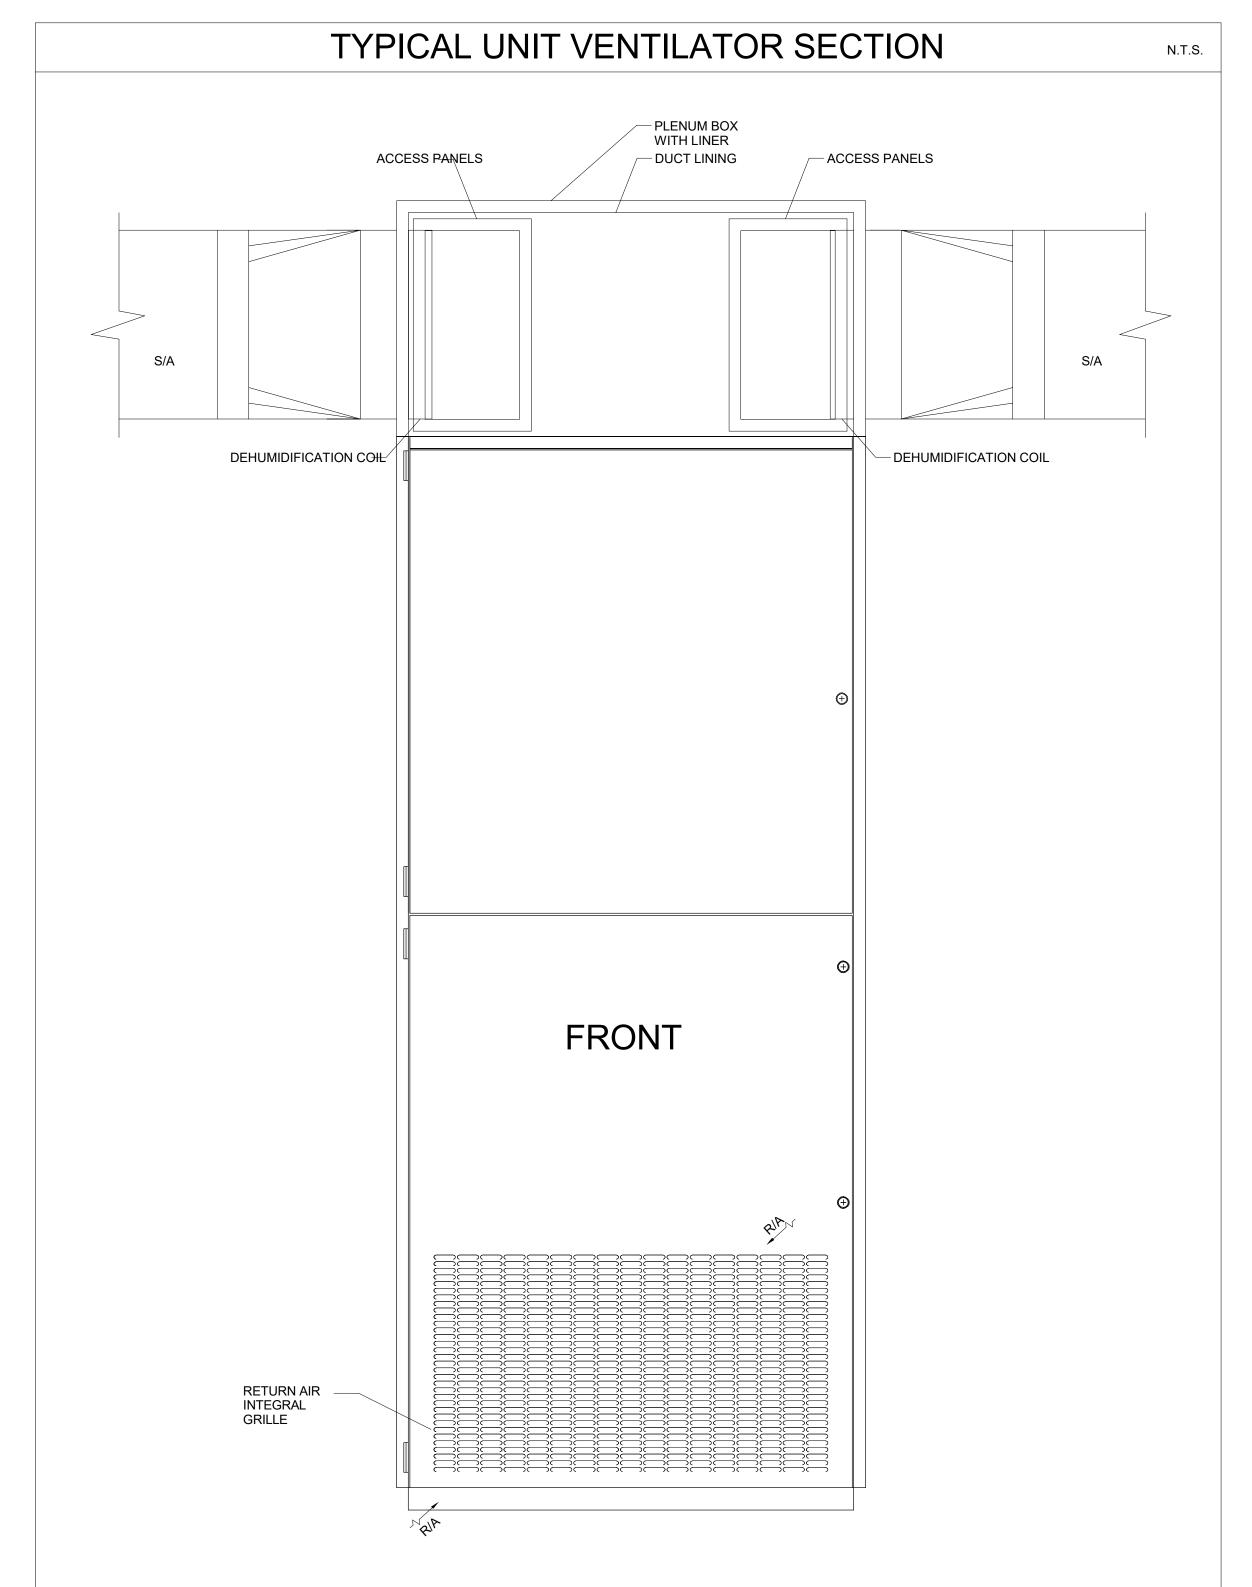


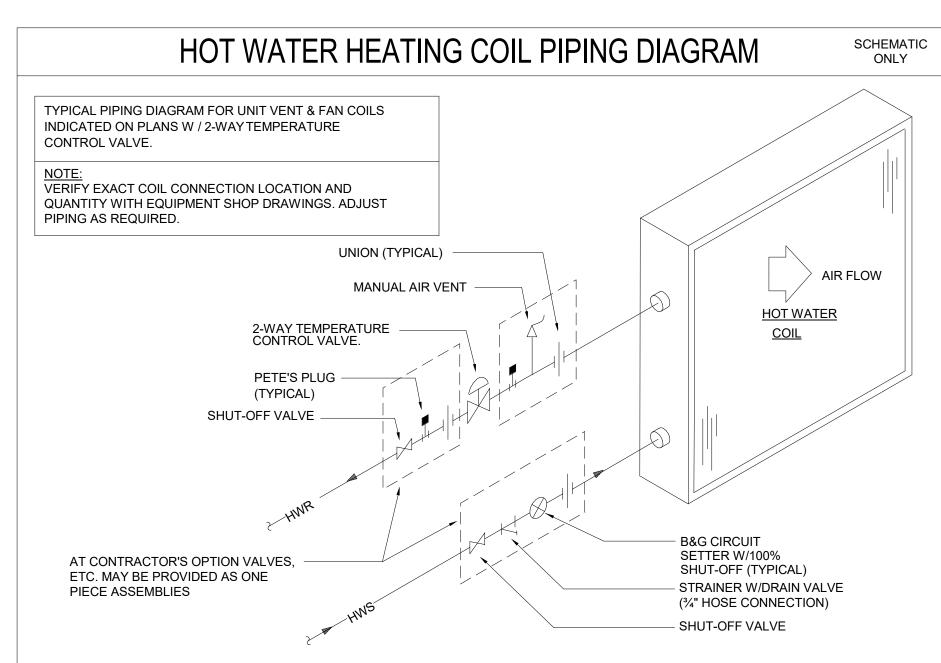

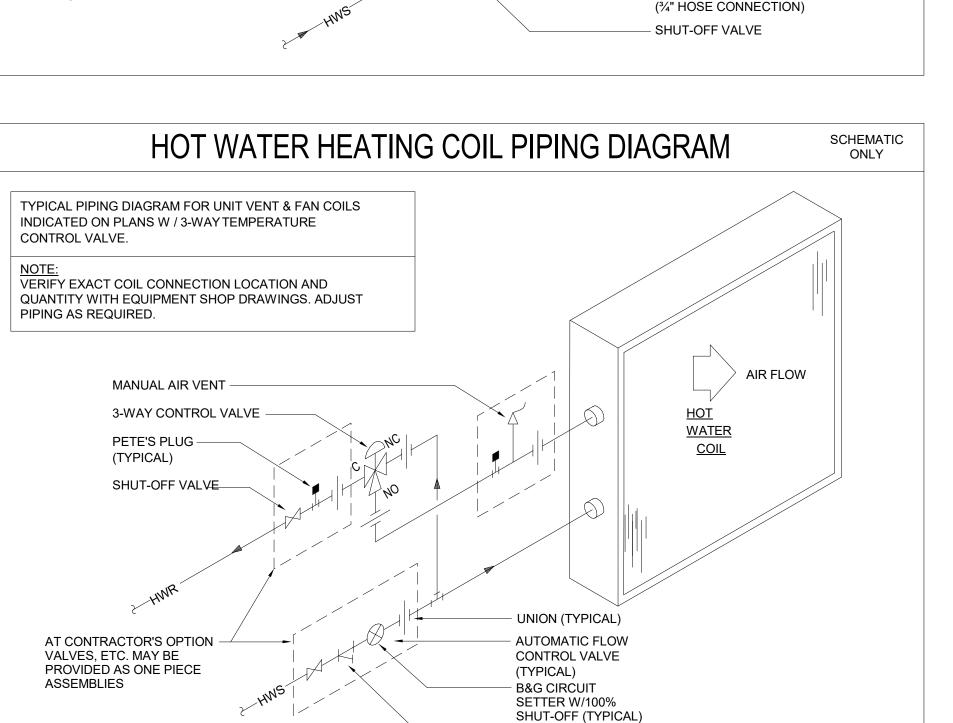



- STRAINER W/DRAIN VALVE

(¾" HOSE CONNECTION)

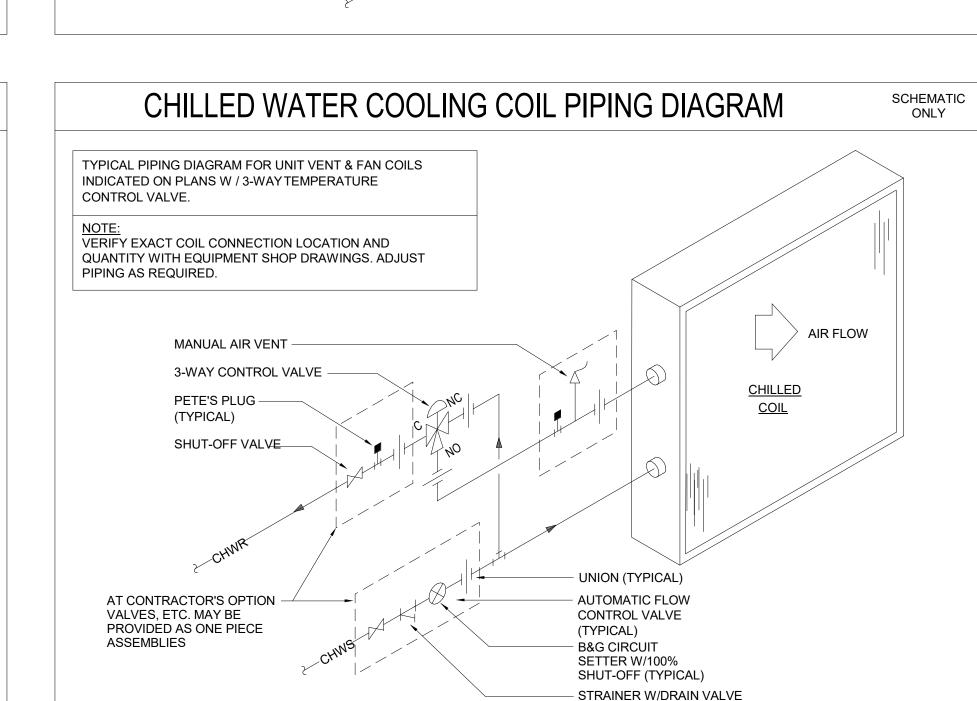

(3/4" HOSE CONNECTION)

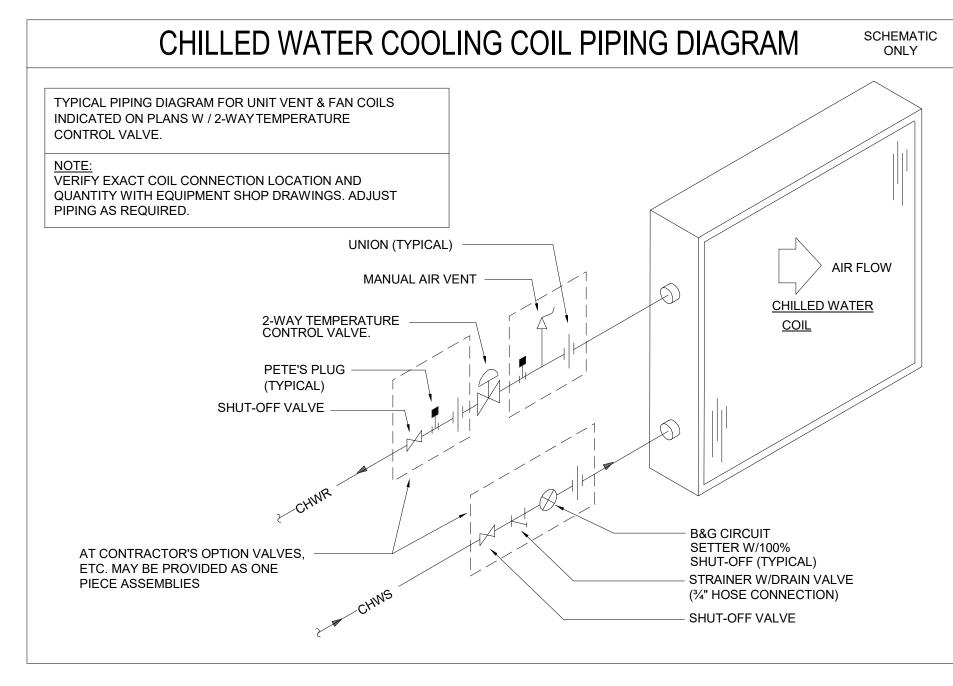

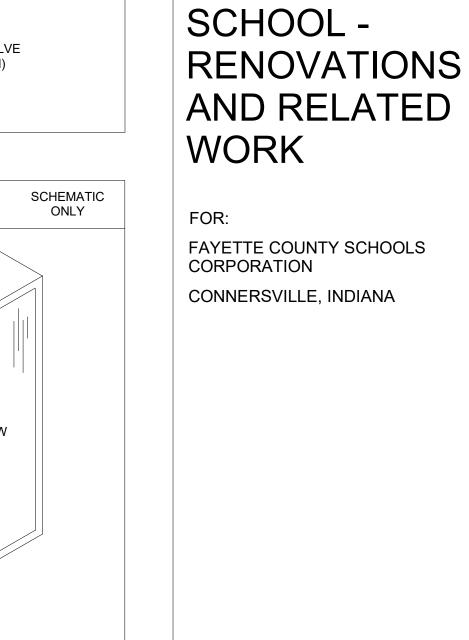

GIBRALTAR


DESIGN


ARCHITECTURE • ENGINEERING • INTERIOR DESIGN


ELEMENTARY


PROJECT:

FRAZEE

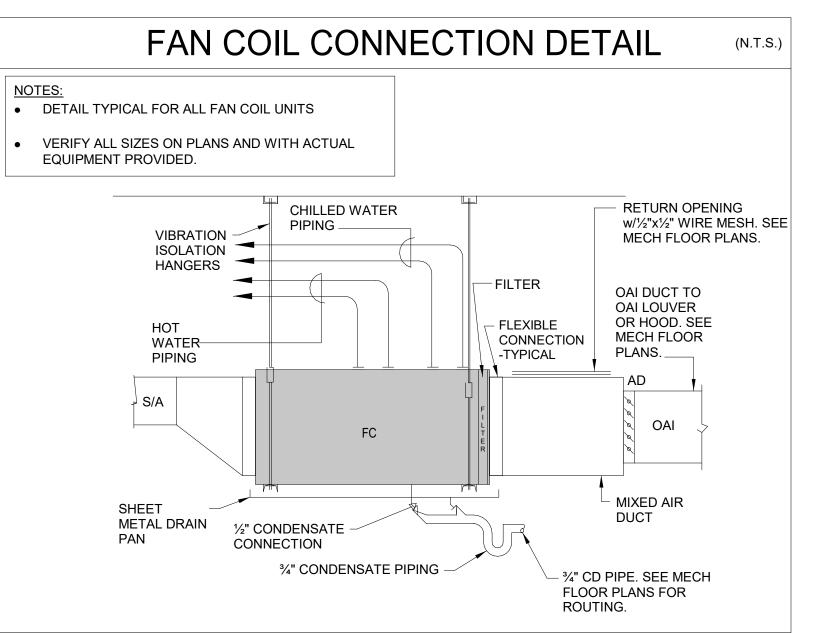


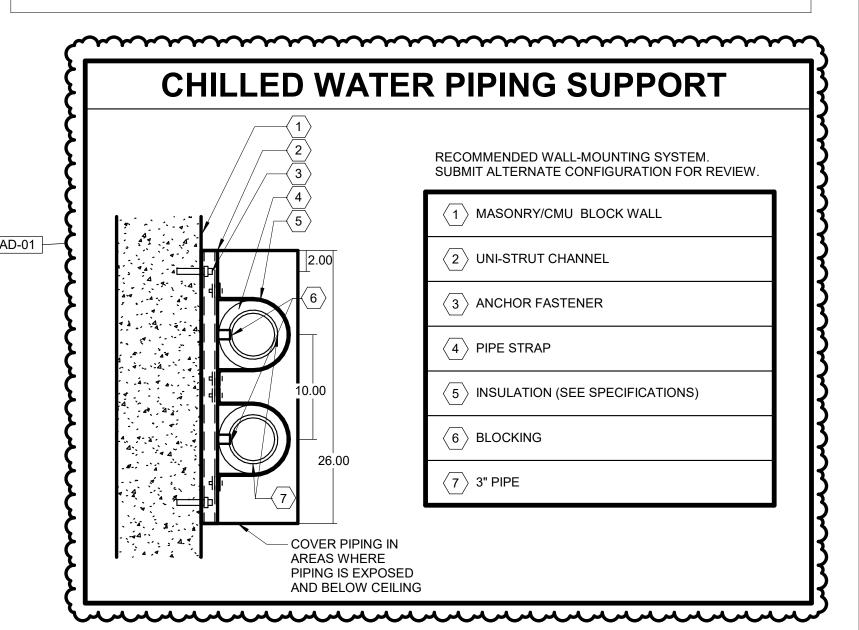


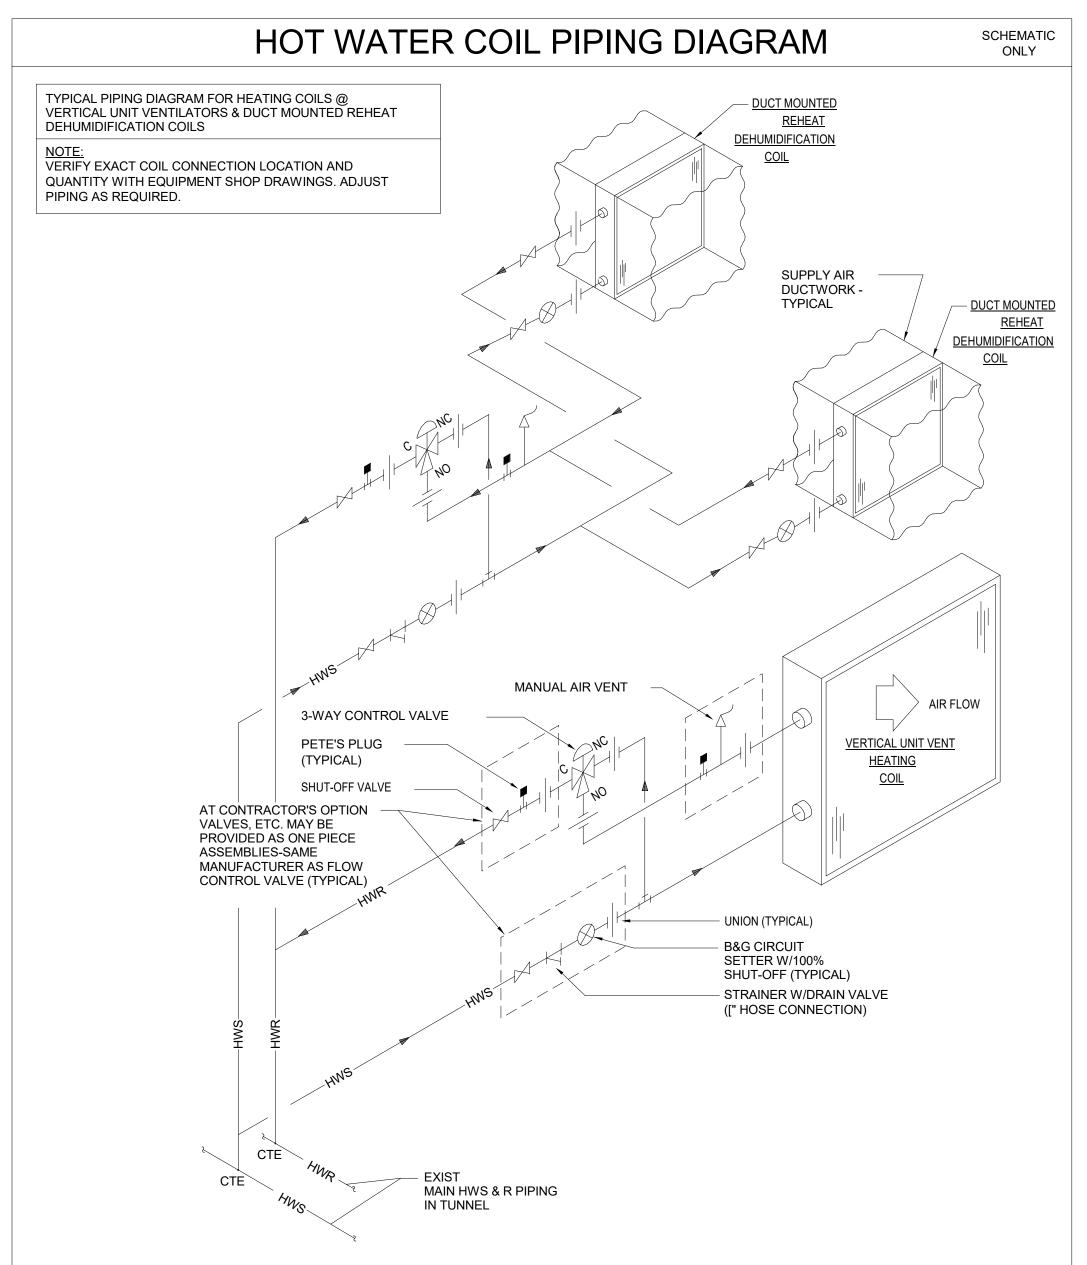

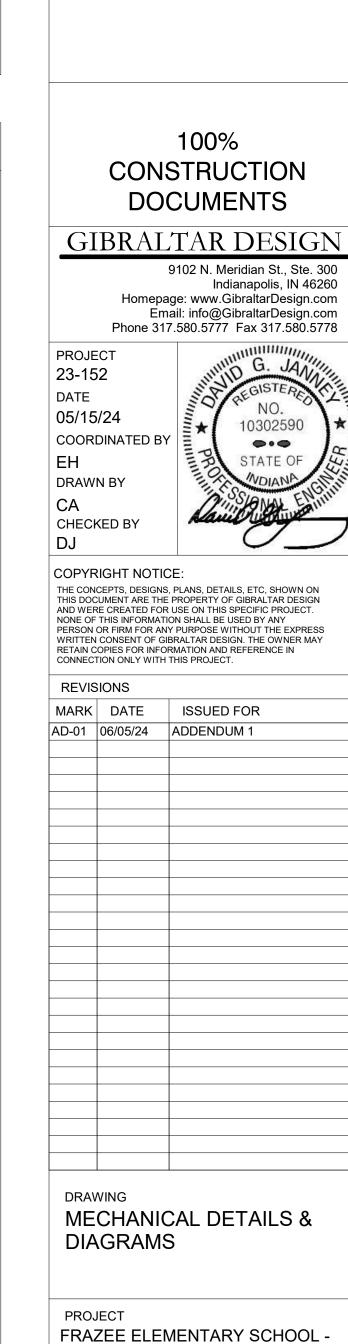

RENOVATIONS AND RELATED

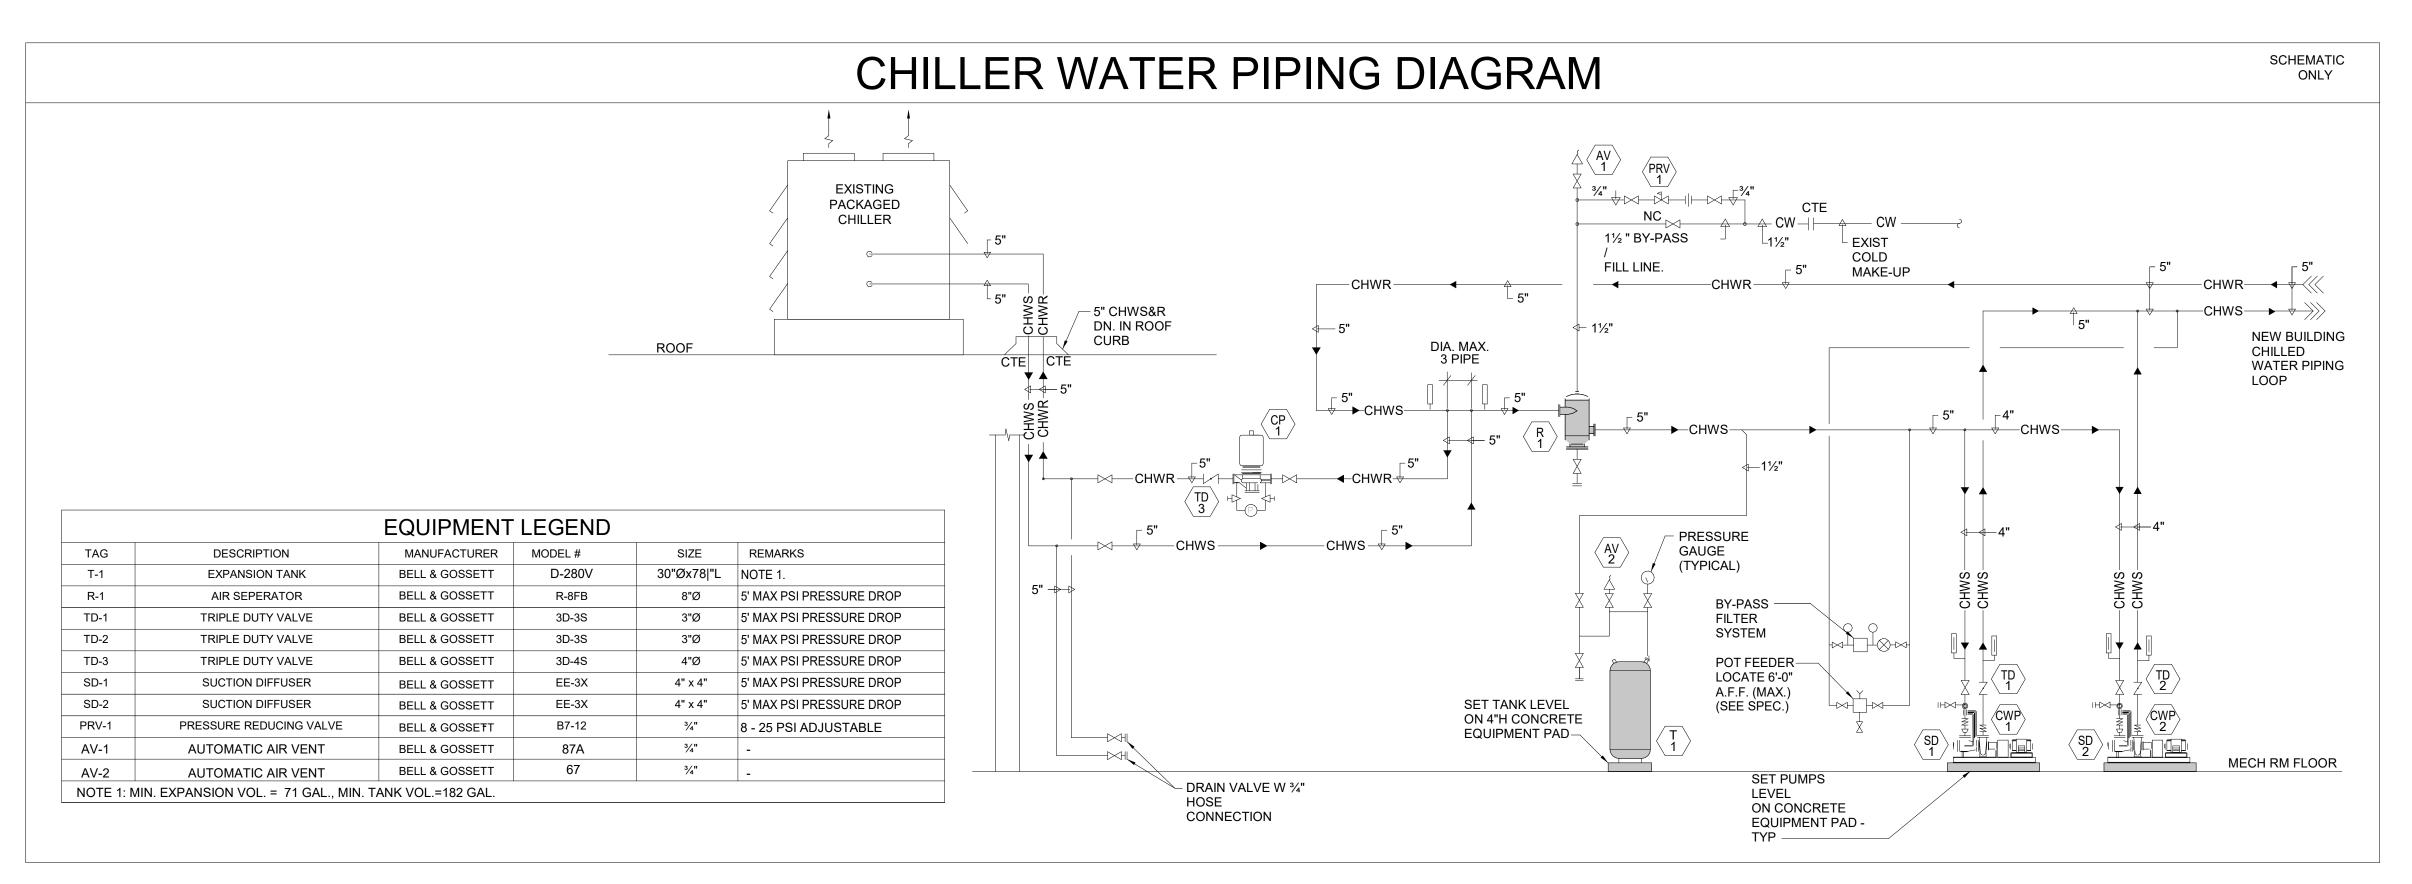

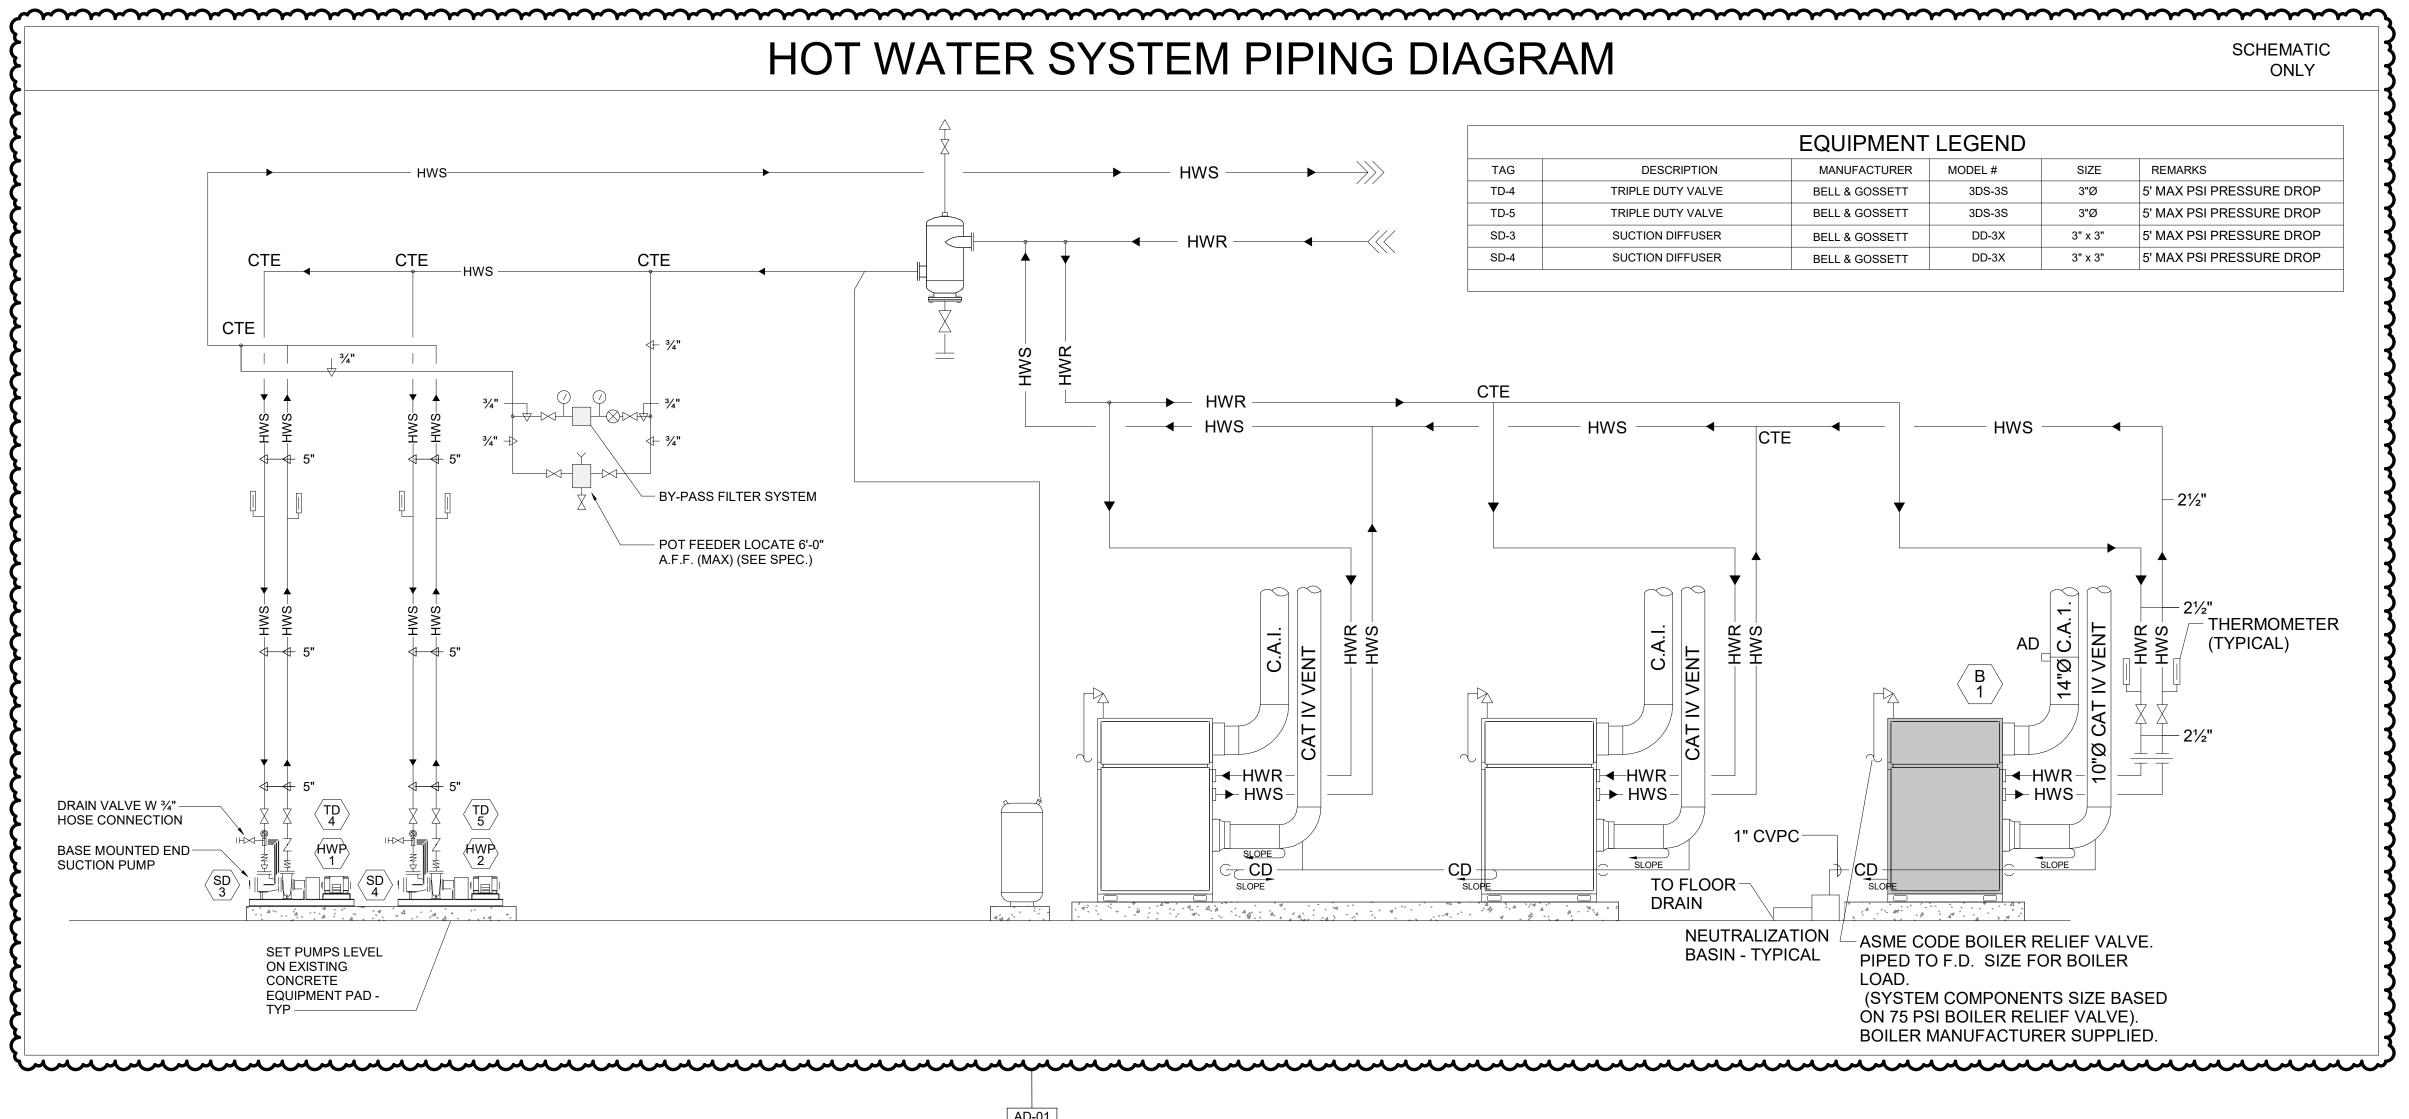



DESIGN

ARCHITECTURE • ENGINEERING • INTERIOR DESIGN

MILLIES

ENGINEERING GROUP
(219) 924-8400

www.milliesengineeringgroup.

PROJECT:

FRAZEE
ELEMENTARY
SCHOOL RENOVATIONS
AND RELATED
WORK

FOR:
FAYETTE COUNTY SCHOOLS
CORPORATION
CONNERSVILLE, INDIANA

100% CONSTRUCTION DOCUMENTS

9102 N. Meridian St., Ste. 300 Indianapolis, IN 46260 Homepage: www.GibraltarDesign.com Email: info@GibraltarDesign.com Phone 317.580.5777 Fax 317.580.5778

10302590

PROJECT
23-152
DATE
05/15/24
COORDINATED BY
EH
DRAWN BY
CA
CHECKED BY

COPYRIGHT NOTICE:

THE CONCEPTS, DESIGNS, PLANS, DETAILS, ETC, SHOWN ON THIS DOCUMENT ARE THE PROPERTY OF GIBRALTAR DESIGN AND WERE CREATED FOR USE ON THIS SPECIFIC PROJECT. NONE OF THIS INFORMATION SHALL BE USED BY ANY PERSON OR FIRM FOR ANY PURPOSE WITHOUT THE EXPRESS WRITTEN CONSENT OF GIBRALTAR DESIGN. THE OWNER MAY RETAIN COPIES FOR INFORMATION AND REFERENCE IN CONNECTION ONLY WITH THIS PROJECT.

REVISIONS

MARK DATE ISSUED FOR


AD-01 06/05/24 ADDENDUM 1

DRAWING
MECHANICAL DETAILS &
DIAGRAMS

PROJECT
FRAZEE ELEMENTARY SCHOOL RENOVATIONS AND RELATED

ORK BIBRALTAR BIGN

1-602F

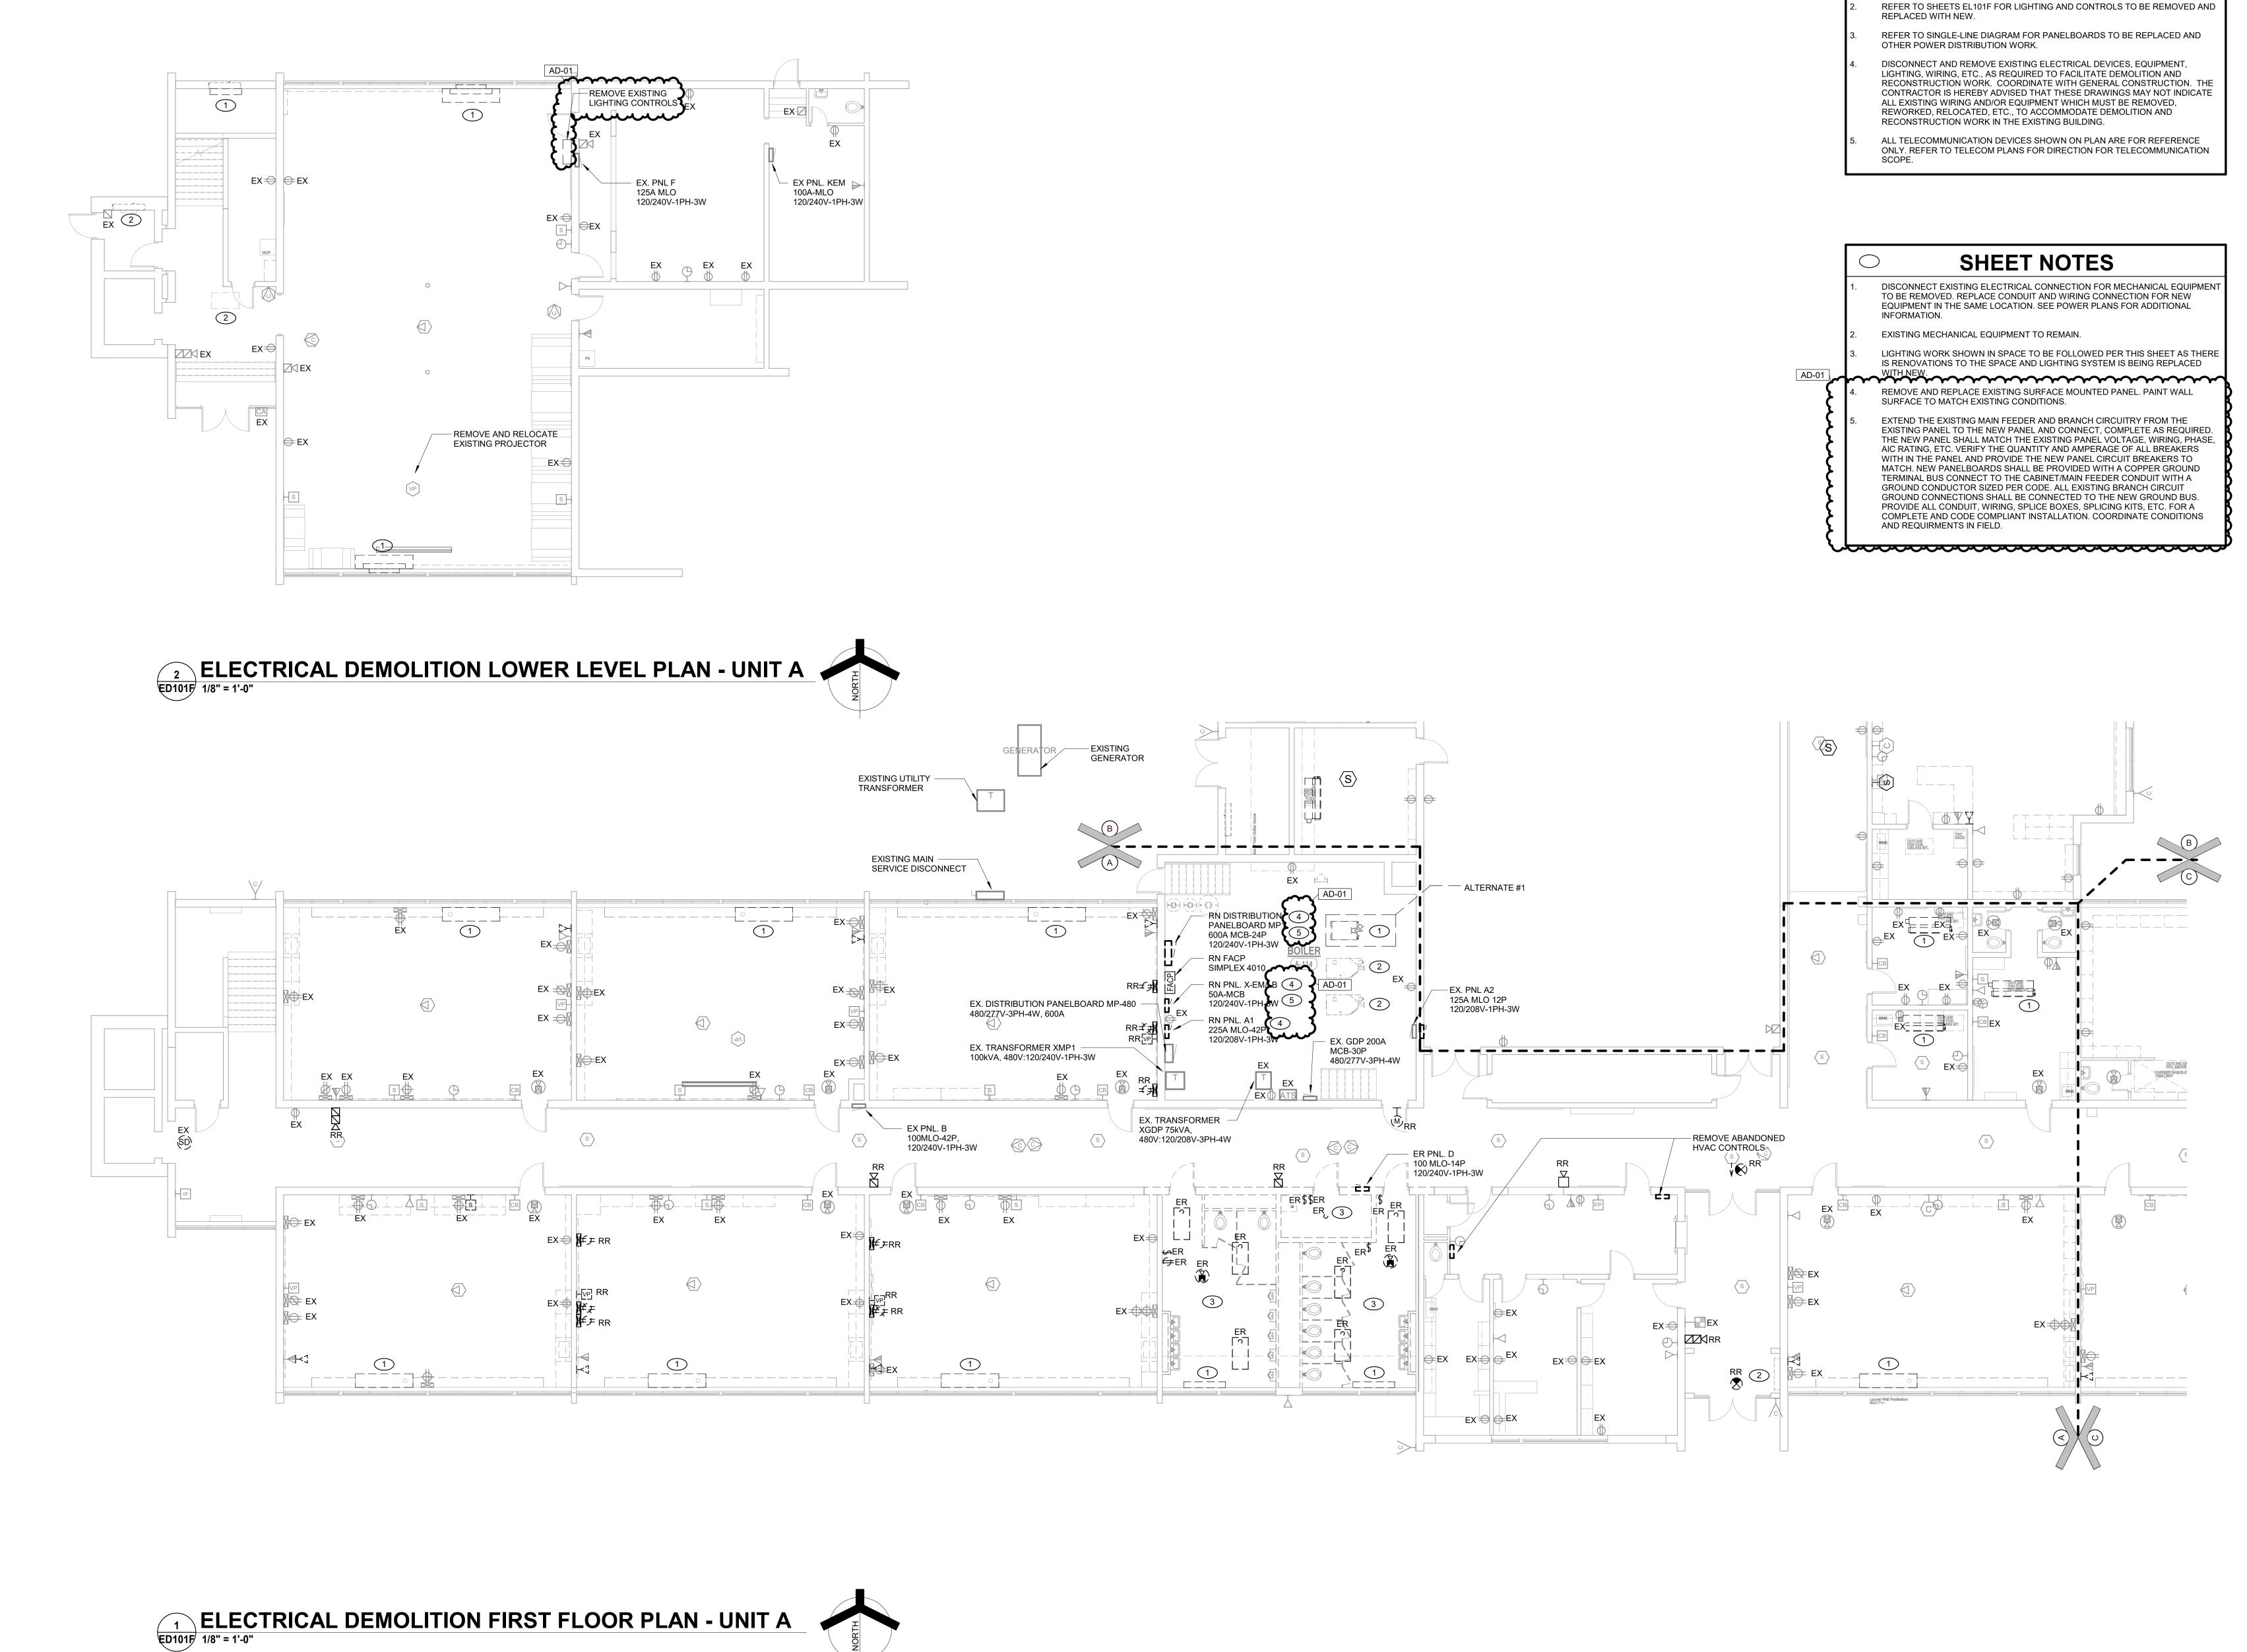



GIBRALTAR

PROJECT:

GENERAL NOTES

INDIVIDUAL ROOMS, ETC. COMPLETE AS REQUIRED.

CAREFULLY REVIEW EXISTING CONDUITS, DEVICES, ETC. IN ROOMS ALONG WIT DRAWINGS TO REVIEW FOR CONFLICTS. REMOVE AND RELOCATE CONDUITS, DEVICES, BOXES, CLOCKS, INTERCOM SPEAKERS, SOUND REINFORCEMENT SYSTEM SPEAKERS, BELLS, STRUCTURED CABLEING, FIRE ALARM, OTHER EXISTING ELECTRICAL SYSTEMS, ETC. AS REQUIRED TO ACCOMMODATE ARCHITECTURAL, CEILING WORK, MECHANICAL, CASEWORK REVISIONS IN

DESIGN

ARCHITECTURE • ENGINEERING • INTERIOR DESIGN

MILLIES
ENGINEERING GROUP
(219) 924-8400
www.milliesengineeringgroup.com

FRAZEE
ELEMENTARY
SCHOOL RENOVATIONS
AND RELATED
WORK

FOR:
FAYETTE COUNTY SCHOOLS
CORPORATION
CONNERSVILLE, INDIANA

UNIT B UNIT C

KEY PLAN

100% CONSTRUCTION DOCUMENTS

9102 N. Meridian St., Ste. 300
Indianapolis, IN 46260
Homepage: www.GibraltarDesign.com

PROJECT
23-152
DATE
05/15/24
COORDINATED BY
BK
DRAWN BY
BoK
CHECKED BY

COPYRIGHT NOTICE:

THE CONCEPTS, DESIGNS, PLANS, DETAILS, ETC, SHOWN ON THIS DOCUMENT ARE THE PROPERTY OF GIBRALTAR DESIGN AND WERE CREATED FOR USE ON THIS SPECIFIC PROJECT. NONE OF THIS INFORMATION SHALL BE USED BY ANY PERSON OR FIRM FOR ANY PURPOSE WITHOUT THE EXPRESS WRITTEN CONSENT OF GIBRALTAR DESIGN. THE OWNER MAY RETAIN COPIES FOR INFORMATION AND REFERENCE IN CONNECTION ONLY WITH THIS PROJECT.

REVISIONS

MARK DATE ISSUED FOR

AD-01 06/05/24 ADDENDUM 1

DRAWING
UNIT "A" ELECTRICAL
FIRST FLOOR AND LOWER
LEVEL DEMOLITION PLANS


PROJECT
FRAZEE ELEMENTARY SCHOOL RENOVATIONS AND RELATED
WORK

GIBRALTAR SHEET

A

Fig. 1

Copyright © 2024 Millies Engineering Group

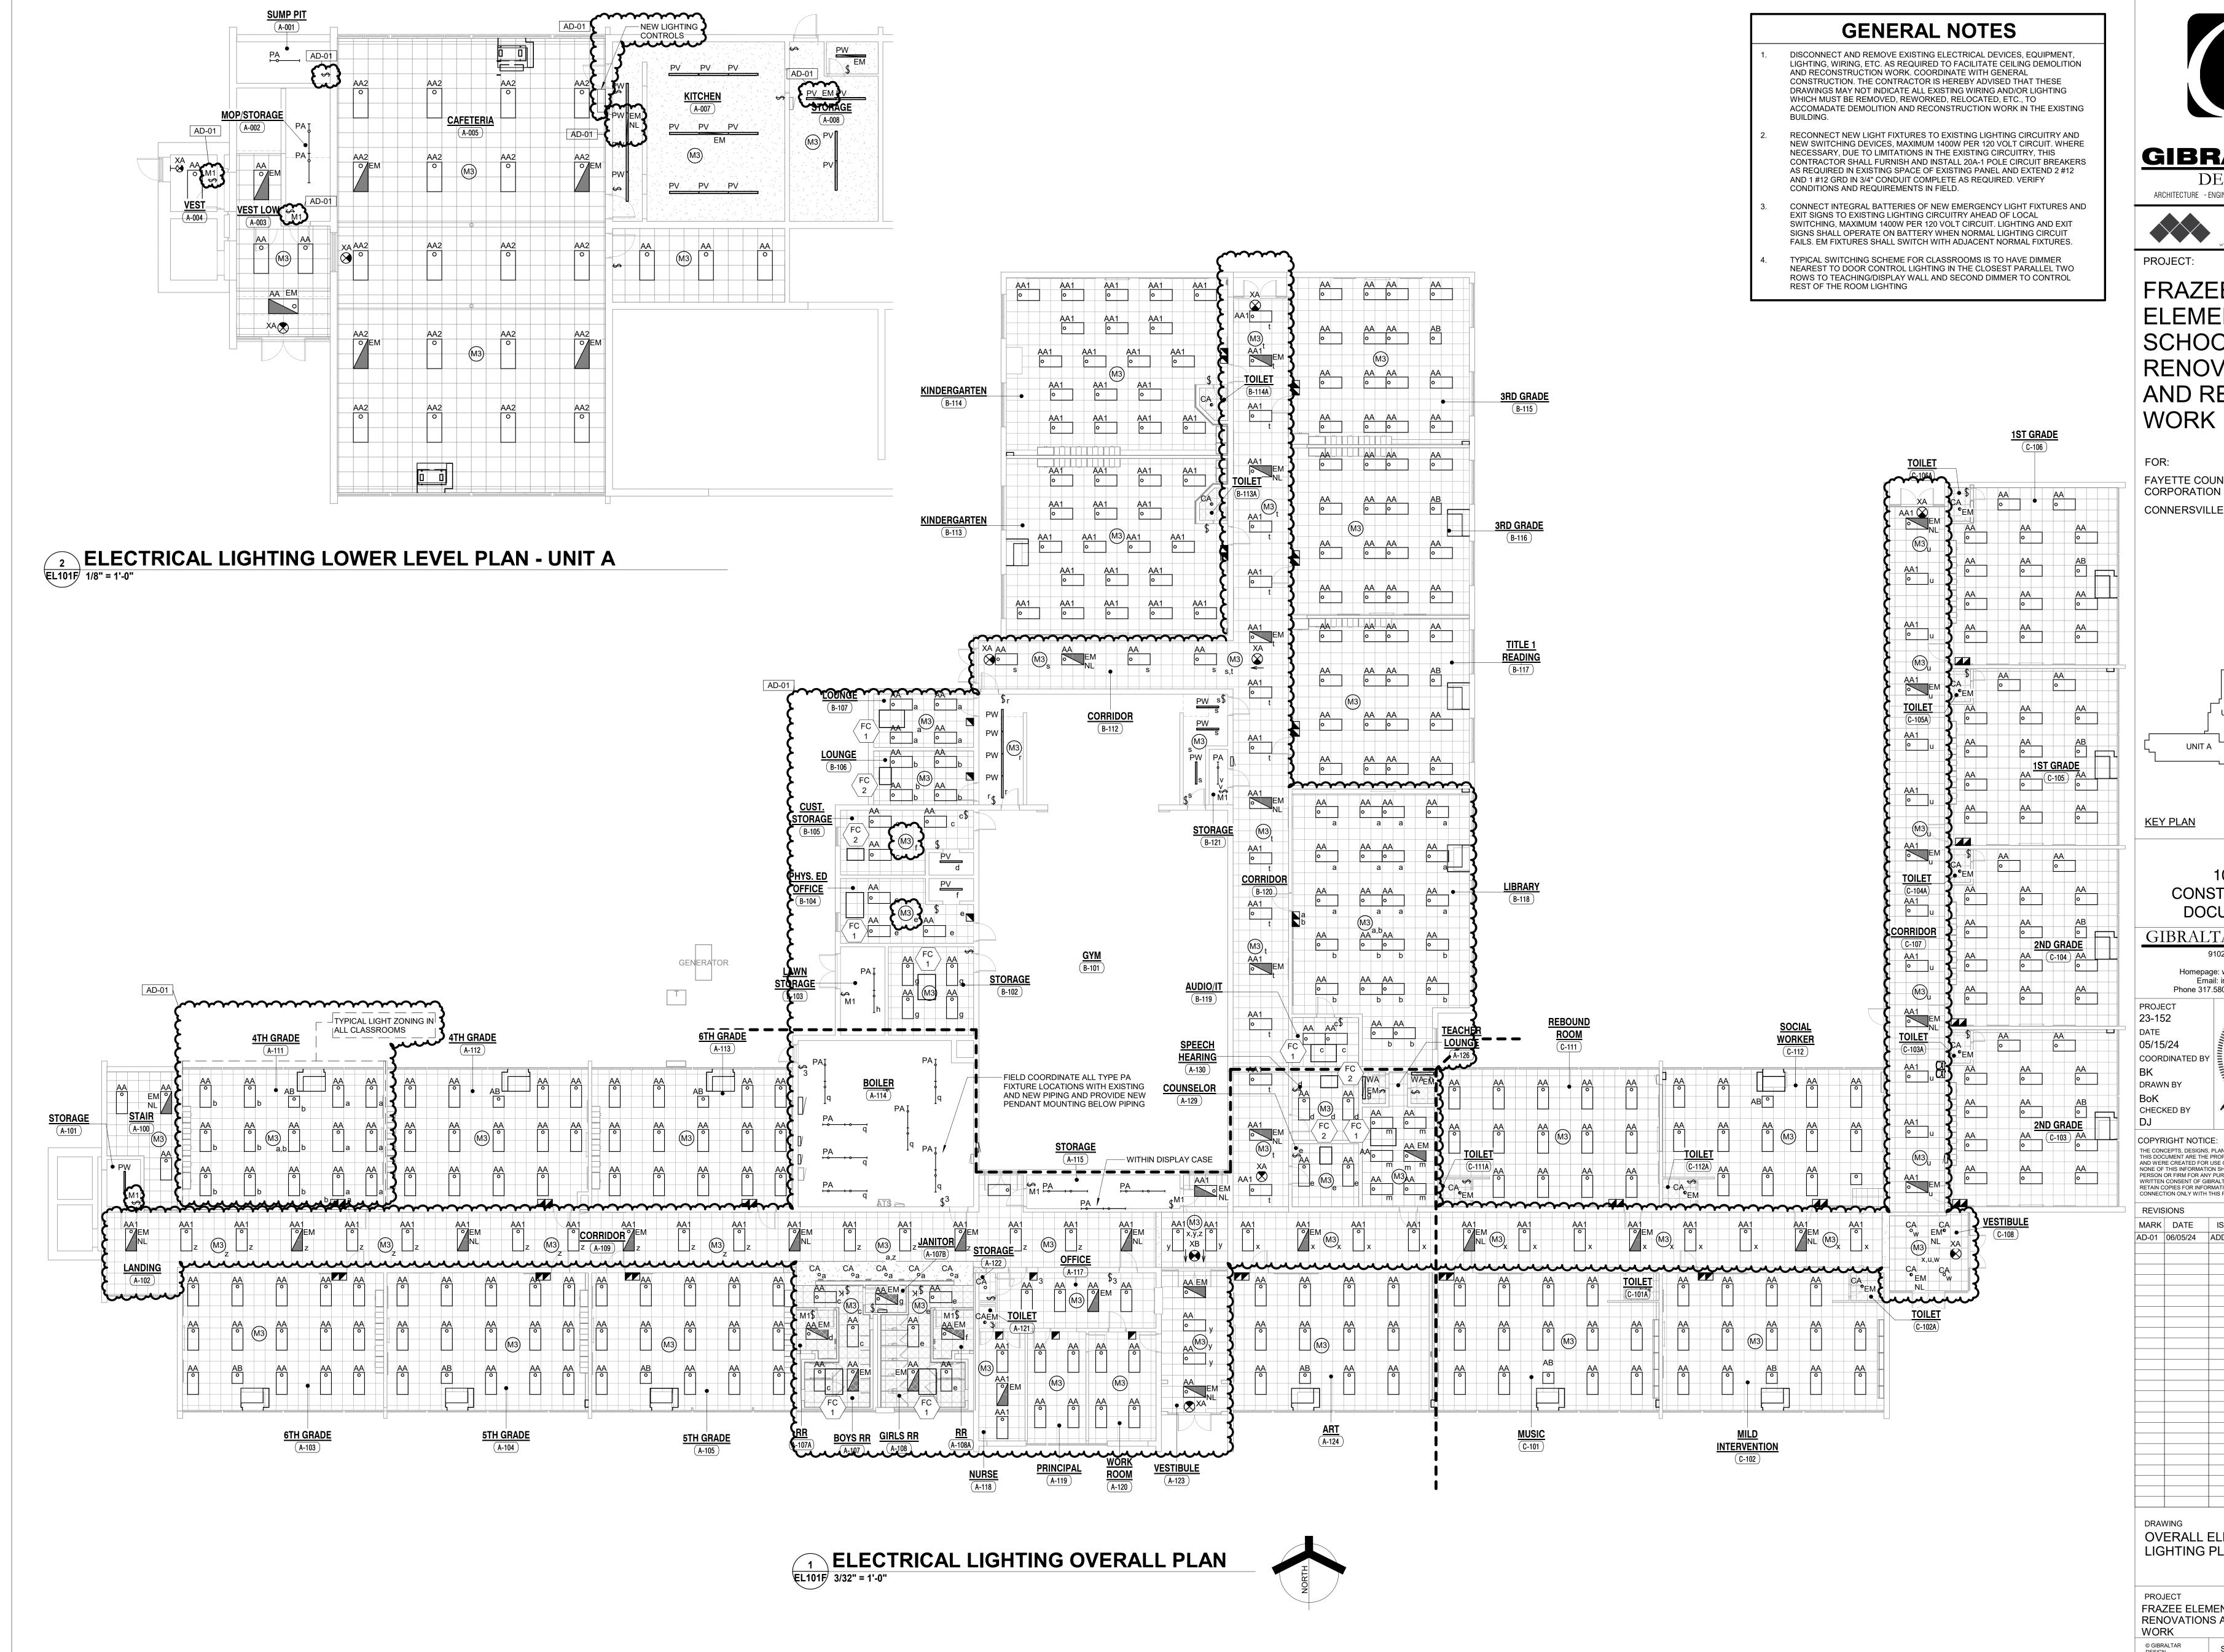


GIBRALTAR DESIGN

ARCHITECTURE • ENGINEERING • INTERIOR DESIGN

PROJECT:

FRAZEE ELEMENTARY SCHOOL -RENOVATIONS AND RELATED

FAYETTE COUNTY SCHOOLS CORPORATION CONNERSVILLE, INDIANA

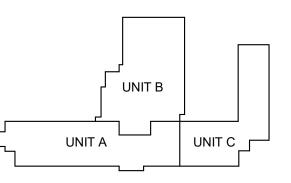

CONSTRUCTION DOCUMENTS

GIBRALTAR DESIGN 9102 N. Meridian St., Ste. 300 Indianapolis, IN 46260
Homepage: www.GibraltarDesign.com
Email: info@GibraltarDesign.com
Phone 317.580.5777 Fax 317.580.5778

COORDINATED BY DRAWN BY

COPYRIGHT NOTICE: THE CONCEPTS, DESIGNS, PLANS, DETAILS, ETC, SHOWN ON THIS DOCUMENT ARE THE PROPERTY OF GIBRALTAR DESIGN AND WERE CREATED FOR USE ON THIS SPECIFIC PROJECT. NONE OF THIS INFORMATION SHALL BE USED BY ANY PERSON OR FIRM FOR ANY PURPOSE WITHOUT THE EXPRESS WRITTEN CONSENT OF GIBRALTAR DESIGN. THE OWNER MAY RETAIN COPIES FOR INFORMATION AND REFERENCE IN CONNECTION ONLY WITH THIS PROJECT.

MARK DATE ISSUED FOR AD-01 06/05/24 ADDENDUM 1

DRAWING OVERALL ELECTRICAL LIGHTING PLAN

PROJECT FRAZEE ELEMENTARY SCHOOL RENOVATIONS AND RELATED

EL101F

GENERAL NOTES

 CIRCUIT ALL DEVICES TO PANEL INDICATED BY PANEL DIVISION LINES UNLESS OTHERWISE NOTED.

SHEET NOTES

- . EXISTING MECHANICAL EQUIPMENT TO REMAIN.
- 2. SEE MECHANICAL EQUIPMENT CONNECTION SCHEDULE FOR ALL SCHEDULING FOR CIRCUITING IN BOILER ROOM A-114.



DESIGN

ARCHITECTURE • ENGINEERING • INTERIOR DESIGN

MILLIES


ENGINEERING GROUP
(219) 924-8400

www.milliesengineeringgroup.

PROJECT:
FRAZEE

ELEMENTARY
SCHOOL RENOVATIONS
AND RELATED
WORK

FOR:
FAYETTE COUNTY SCHOOLS
CORPORATION
CONNERSVILLE, INDIANA

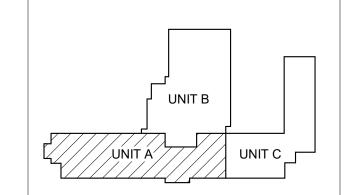

KEY PLAN

100% CONSTRUCTION DOCUMENTS

GIBRALTAR DESIGN

9102 N. Meridian St., Ste. 300
Indianapolis, IN 46260
Homepage: www.GibraltarDesign.com
Email: info@GibraltarDesign.com
Phone 317.580.5777 Fax 317.580.5778

PROJECT
23-152
DATE
05/15/24
COORDINATED BY
BK
DRAWN BY
BoK

CHECKED BY
DJ

COPYRIGHT NOTICE:

THE CONCEPTS, DESIGNS, PLANS, DETAILS, ETC, SHOWN ON THIS DOCUMENT ARE THE PROPERTY OF GIBRALTAR DESIGN AND WERE CREATED FOR USE ON THIS SPECIFIC PROJECT. NONE OF THIS INFORMATION SHALL BE USED BY ANY PERSON OR FIRM FOR ANY PURPOSE WITHOUT THE EXPRESS WRITTEN CONSENT OF GIBRALTAR DESIGN. THE OWNER MAY RETAIN COPIES FOR INFORMATION AND REFERENCE IN CONNECTION ONLY WITH THIS PROJECT.

RETAIN COPIES FOR INFORMATION AND REFERE CONNECTION ONLY WITH THIS PROJECT.

REVISIONS


MARK DATE ISSUED FOR


AD-01 06/05/24 ADDENDUM 1

DRAWING
UNIT "A" ELECTRICAL
POWER FIRST FLOOR AND
LOWER LEVEL PLANS


PROJECT
FRAZEE ELEMENTARY SCHOOL RENOVATIONS AND RELATED

A EP10

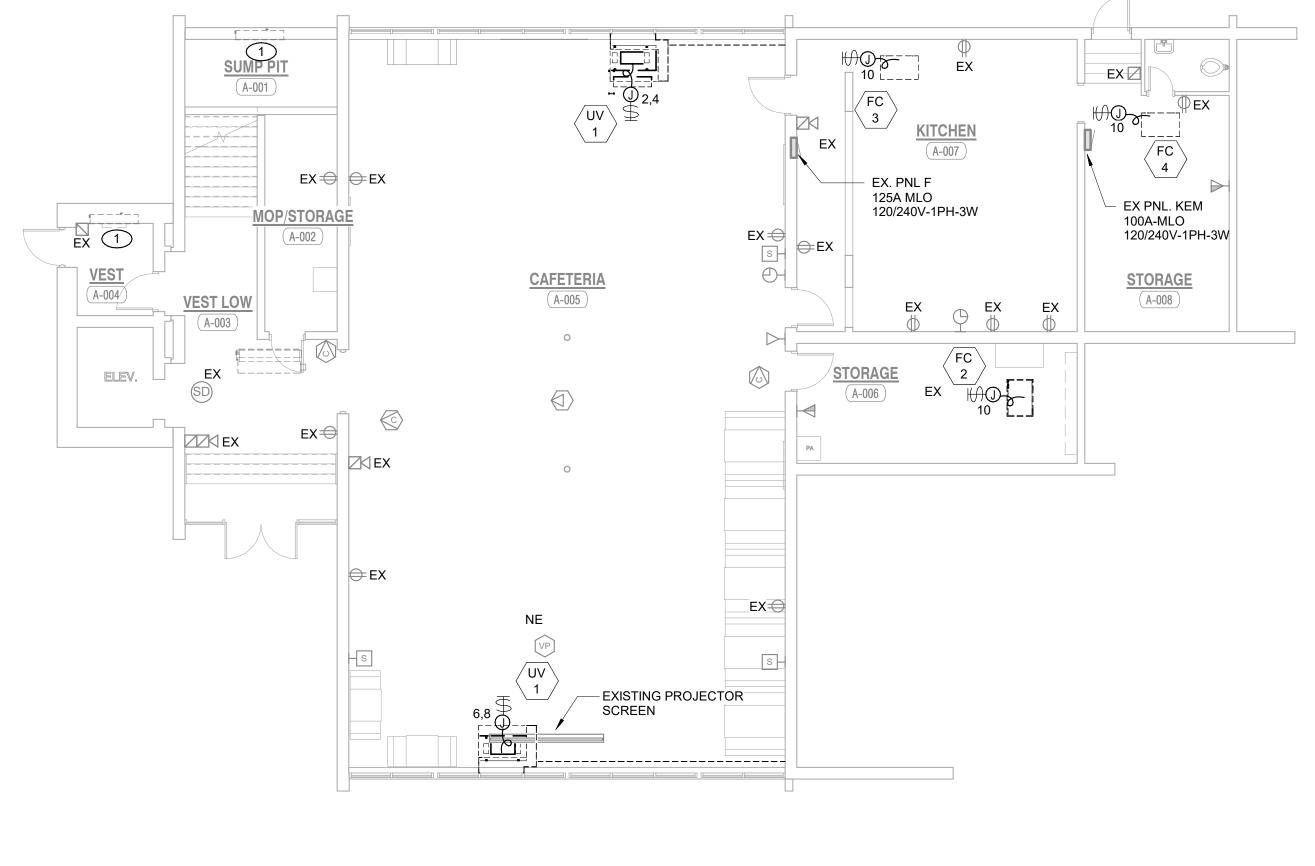

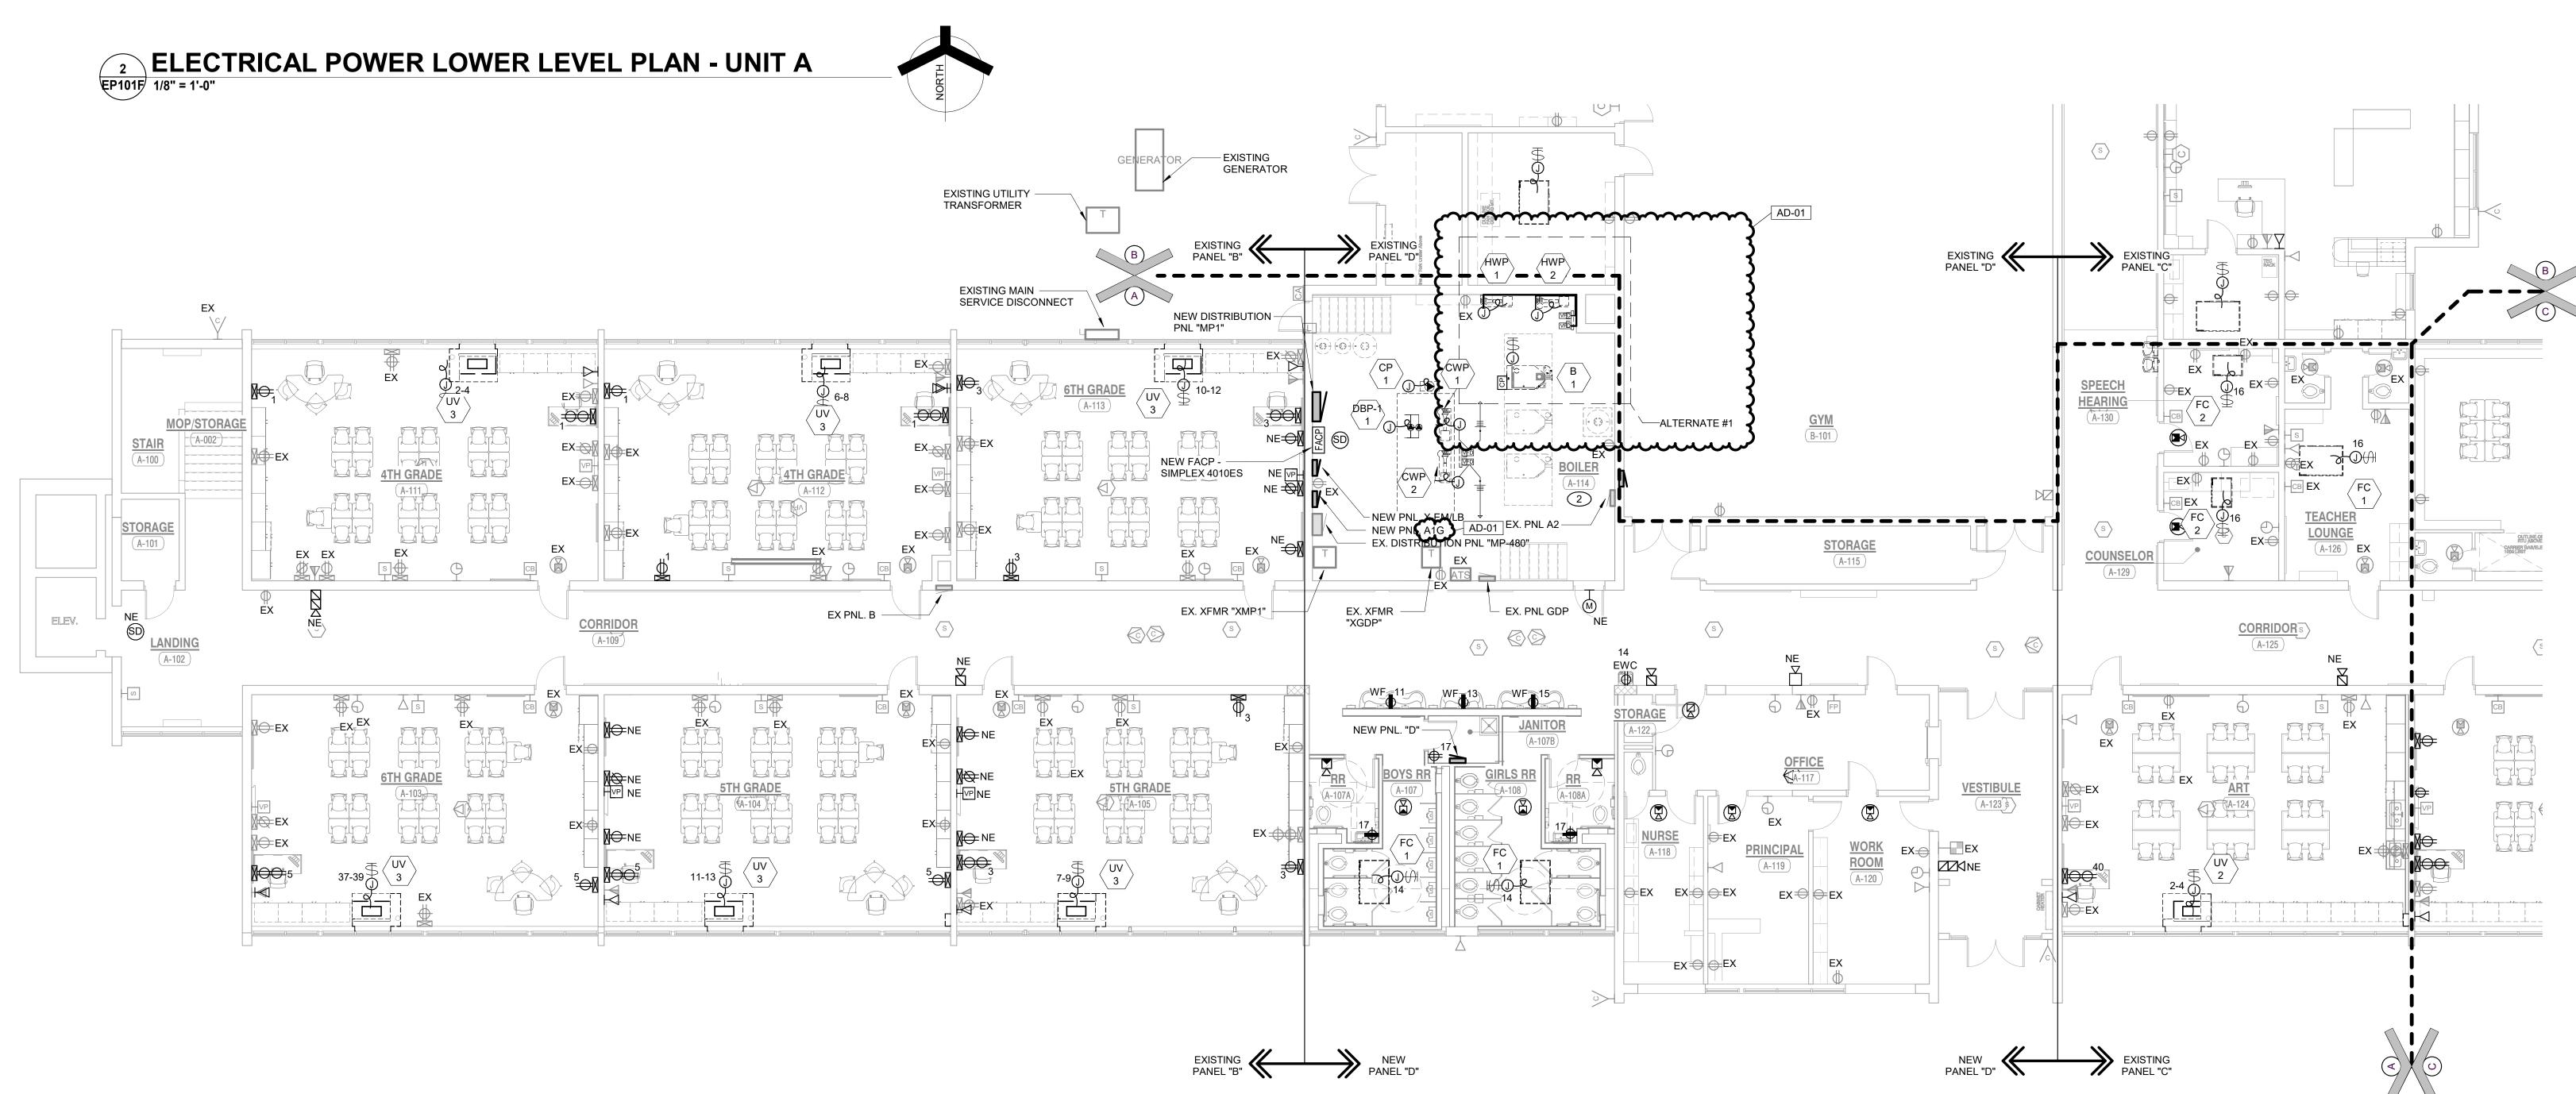



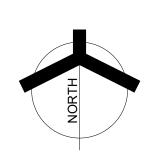

MECHANICAL	. EQI	JIPI	MEN	IT (CON	INE	CTI	ON	SCH	HEDU	JLE						
G DESCRIPTION			LOAD			МОСР	VOLT	PHASE	PANEL	CKT. NO.	FUSED SWITCH	FEEDER		STAR	TER BY:	LOCATION	REMARKS
	WATTS	HP	MCA	FLA	AMPS						C/B	CABLE	С	MC.	EC.		
-1 VERTICAL UNIT VENTILATOR - HOT WATER/CHILLED WATER - 4 PIPE	2220	-	9	-	-	15	240	1	VARIES	VARIES	20A/2P	3 #12 & 1 #12 GRD	3/4"	X	-	-	-
-2 VERTICAL UNIT VENTILATOR - HOT WATER/CHILLED WATER - 4 PIPE	2220	-	9	-	-	15	240	1	VARIES	VARIES	20A/2P	3 #12 & 1 #12 GRD	3/4"	Х	-	-	-
-3 VERTICAL UNIT VENTILATOR - HOT WATER/CHILLED WATER - 4 PIPE	1771.2	-	7	-	-	15	240	1	VARIES	VARIES	20A/2P	3 #12 & 1 #12 GRD	3/4"	Х	-	-	-
-4 VERTICAL UNIT VENTILATOR - HOT WATER/CHILLED WATER - 4 PIPE	2220	-	9	-	-	15	240	1	VARIES	VARIES	20A/2P	3 #12 & 1 #12 GRD	3/4"	Х	-	-	-
-5 VERTICAL UNIT VENTILATOR - HOT WATER/CHILLED WATER - 4 PIPE	2220	-	9	-	-	15	240	1	VARIES	VARIES	20A/2P	3 #12 & 1 #12 GRD	3/4"	Х	-	-	-
-6 VERTICAL UNIT VENTILATOR - HOT WATER/CHILLED WATER - 4 PIPE	2220	-	9	-	-	15	240	1	VARIES	VARIES	20A/2P	3 #12 & 1 #12 GRD	3/4"	Х	-	-	-
-7 VERTICAL UNIT VENTILATOR - HOT WATER/CHILLED WATER - 4 PIPE	2220	-	9	-	-	15	240	1	VARIES	VARIES	20A/2P	3 #12 & 1 #12 GRD	3/4"	Х	-	-	-
-1 HORIZONTAL RECESSED FAN COIL UNIT - CHW/HW 4 PIPE	228	-	-	1.9	-	-	120	1	VARIES	VARIES	20A/1P	2 #12 & 1 #12 GRD	3/4"	Х	-	-	-
2 HORIZONTAL RECESSED FAN COIL UNIT - CHW/HW 4 PIPE	180	-	-	1.5	-	-	120	1	VARIES	VARIES	20A/1P	2 #12 & 1 #12 GRD	3/4"	Х	-	-	-
-3 HORIZONTAL CABINET FAN COIL UNIT - CHW/HW 4 PIPE	576	-	-	4.8	-	15	120	1	VARIES	VARIES	20A/1P	2 #12 & 1 #12 GRD	3/4"	Х	-	-	-
-4 HORIZONTAL CABINET FAN COIL UNIT - CHW/HW 4 PIPE	252	-	-	2.1	-	-	120	1	VARIES	VARIES	20A/1P	2 #12 & 1 #12 GRD	3/4"	Х	-	-	-
1 CONDENSING HOT WATER BOILER	960	-	8	-	-	-	120	1	VARIES	VARIES	20A/1P	'2 #12 & 1 #12 GRD	3/4"	Х	-	-	-ALTERNATE
-1 ROOF MOUNTED TOILET EXHAUST FAN	864	-	7	-	-	15	120	1	VARIES	VARIES	20A/1P	2 #12 & 1 #12 GRD	3/4"	Х	-	-	-
DOMESTIC BOOSTER PUMP	-	5	-	-	-	0	480	3	MP-480	-	15A/3P	4 #12 & 1 #12 GRD	3/4"	Х	-	-	-

	PUMP EQUIPME	NT CO	NNC	IEC	TIO	N S	CHE	EDUL	.E					
									FUSED					
TAG	DESCRIPTION	LOAD	HP	МОСР	VOLT	PHASE	PANEL	CKT. NO.	SWITCH	FEEDER		STAR	TED BY: LOCATION	REMARKS
		WATTS							C/B	CABLE	С	MC.	EC.	
CWP-1	BASE MOUNTED CHILLED WATER DISTRIBUTION PUMP	9134	7 1/2	-	480	3	MP-480	-	40A/3P	4 #8 & 1 #10 GRD	3/4"	X		-
CWP-2	BASE MOUNTED CHILLED WATER DISTRIBUTION PUMP	9134	7 1/2	-	480	3	MP-480	-	40A/3P	4 #8 & 1 #10 GRD	3/4"	Х		-
CP-1	IN-LINE CHILLER PUMP	6311	5		480	3	MP-480		15A/3P	4 #12 & 1 #12 GRD	3/4"	X		·
HWP-1	BASE MOUNTED HOT WATER DISTRIBUTION PUMP - ALTERNATE	11626	10	-	480	3	MP-480		25A/3P	4 #10 & 1 #10 GRD	3/4"	X		ALTERNATE
HWP-2	BASE MOUNTED HOT WATER DISTRIBUTION PUMP - ALTERNATE	11626	10	_	480	3	MP-480	_	25A/3P	4 #10 & 1 #10 GRD	3/4"	X		ALTERNATE

DESIGN

ARCHITECTURE • ENGINEERING • INTERIOR DESIGN

MILLIES
ENGINEERING GROUP
(219) 924-8400

PROJECT:

FRAZEE
ELEMENTARY
SCHOOL RENOVATIONS
AND RELATED
WORK

FOR:
FAYETTE COUNTY SCHOOLS
CORPORATION
CONNERSVILLE, INDIANA

100% CONSTRUCTION DOCUMENTS

GIBRALTAR DESIGN

9102 N. Meridian St., Ste. 300
Indianapolis, IN 46260
Homepage: www.GibraltarDesign.com
Email: info@GibraltarDesign.com
Phone 317.580.5777 Fax 317.580.5778

Phone 317
PROJECT
23-152
DATE
05/15/24
COORDINATED BY
BK
DRAWN BY
BoK
CHECKED BY

BK
DRAWN BY
BoK
CHECKED BY
DJ

COPYRIGHT NOTICE:
THE CONCEPTS, DESIGNS, PLANS, DETAILS, ETC, SHOWN ON THIS DOCUMENT ARE THE PROPERTY OF GIBRALTAR DESIGN AND WERE CREATED FOR USE ON THIS SPECIFIC PROJECT.

THE CONCEPTS, DESIGNS, PLANS, DETAILS, ETC, SHOWN ON THIS DOCUMENT ARE THE PROPERTY OF GIBRALTAR DESIGN AND WERE CREATED FOR USE ON THIS SPECIFIC PROJECT. NONE OF THIS INFORMATION SHALL BE USED BY ANY PERSON OR FIRM FOR ANY PURPOSE WITHOUT THE EXPRESS WRITTEN CONSENT OF GIBRALTAR DESIGN. THE OWNER MAY RETAIN COPIES FOR INFORMATION AND REFERENCE IN CONNECTION ONLY WITH THIS PROJECT.

REVISIONS

MARK DATE ISSUED FOR

INLVIC	DIONO	
MARK	DATE	ISSUED FOR
AD-01	06/05/24	ADDENDUM 1
	1	

DRAWING ELECTRICAL SCHEDULES

PROJECT
FRAZEE ELEMENTARY SCHOOL RENOVATIONS AND RELATED

NORK

© GIBRALTAR

E-501F

LOCATION: JANITOR 107B AD-01 MOUNTING: Surface LENCKOBUPE: Type: **A.I.C. RATING**: 22000

VOLTS: 120/240 Single PHASES: MAINS TYPE: MCB MAIN RATING: 100A **BUSSING:** COPPER

			1		1	1	1		_				
СКТ	CIRCUIT DESCRIPTION	LEG.	TRIP	POLES	A	В	A	В	POLES	TRIP	LEG.	CIRCUIT DESCRIPTION	СК
1	EXISTING POWER		20 A	1	0		0		1	20 A		EXISTING POWER	2
3	EXISTING POWER		20 A	1		0		0	1	20 A		EXISTING POWER	4
5	EXISTING POWER		20 A	1	0		0		1	20 A		EXISTING POWER	6
7	EXISTING POWER		20 A	1		0		0	1	20 A		EXISTING POWER	8
9	EXISTING POWER		20 A	1	0		0		1	20 A		EXISTING POWER	10
11	WASH FOUNTAIN		20 A	1		1000		456	1	20 A		FC-1 - RM A-107/108	12
13	WASH FOUNTAIN		20 A	1	100		1000		1	20 A		EWC	14
15	WASH FOUNTAIN		20 A	1		1000		0	1	20 A		SPARE	16
17	REC - RM 107A/106A		20 A	1	400		0		1	20 A		SPARE	18
19	SPARE		20 A	1		0		0	1	20 A		SPARE	20
21	SPARE		20 A	1	0		0		1	20 A		SPARE	22
23	SPARE		20 A	1		0		0	1	20 A		SPARE	24
25	SPACE			1					1			SPACE	26
27	SPACE			1					1			SPACE	28
29	SPACE			1					1			SPACE	30

GC = PROVIDE GFI CIRCUIT BREAKER ST = PROVIDE SHUNT TRIP BREAKER LO = PROVIDE LOCKABLE DEVICE

	PANEL TOTAL	.S
	TOTAL CONNECTED LOAD PHASE A:	1500 VA
	TOTAL CONNECTED LOAD PHASE B:	3456 VA
	TOTAL CONNECTED LOAD:	4956 VA
REFER TO SPECIFICATIONS FOR ADDITIONAL INFORMATION	TOTAL CONNECTED AMPS:	21 A

120/240 Single

EX. C

LOCATION: VOLTS: SUPPLY FROM: PHASES: MOUNTING: Recessed MAINS TYPE: **ENCLOSURE: MAIN RATING:** A.I.C. RATING: BUSSING:

CKT	CIRCUIT DESCRIPTION	LEG.	TRIP	POLES	Α	В	Α	В	POLES	TRIP	LEG.	CIRCUIT DESCRIPTION	СКТ
1	EXISTING POWER		20 A	1	0		1120		2	20.4		UV-2 - RM A-124	2
3	EXISTING POWER		20 A	1		0		1120		20 A		UV-2 - RIVI A-124	4
5	EXISTING POWER		20 A	1	0		1120		2	20 A		UV-7 - RM A-112	6
7	SPARE		20 A	1		0		1120		20 A		UV-1 - RIVI A-112	8
9	LIV 2 DM C101		20.4	2	885		1120		2	20. 4		UV-6 - RM C-102	10
11	- UV-3 - RM C101		20 A	2		885		1120		20 A		0V-6 - RW C-102	12
13	EXISTING POWER		20 A	1	0		0		1	20 A		EXISTING POWER	14
15	EXISTING POWER		20 A	1		0		0	1	20 A		EXISTING POWER	16
17	EXISTING POWER		20 A	1	0		0		1	20 A		EXISTING POWER	18
19	EXISTING POWER		20 A	1		0		0	1	20 A		EXISTING POWER	20
21	EXISTING POWER		20 A	1	0		0		1	20 A		EXISTING POWER	22
23	EXISTING POWER		20 A	1		0		0	1	20 A		EXISTING POWER	24
25	EXISTING POWER		20 A	1	0		0		1	20 A		EXISTING POWER	26
27	EXISTING POWER		20 A	1		0		0	1	20 A		EXISTING POWER	28
29	EXISTING POWER		20 A	1	0		0		1	20 A		EXISTING POWER	30
31	EXISTING POWER		20 A	1		0		0	1	20 A		EXISTING POWER	32
33	EXISTING POWER		20 A	1	1600		0		1	20 A		EXISTING POWER	34
35	REC - RM C111		20 A	1		1000		0	1	20 A		EXISTING POWER	36
37	REC - RM C112		20 A	1	800		0		1	20 A		EXISTING POWER	38
39	REC - RM C102		20 A	1		0		1600	1	20 A		REC - RM C-101/102	40
41	SPARE		20 A	1	0		0		1	20 A		SPARE	42

LEGEND:

GC = PROVIDE GFI CIRCUIT BREAKER ST = PROVIDE SHUNT TRIP BREAKER LO = PROVIDE LOCKABLE DEVICE

	PANEL TOTAL	LS
	TOTAL CONNECTED LOAD PHASE A:	6645 VA
	TOTAL CONNECTED LOAD PHASE B:	6845 VA
	TOTAL CONNECTED LOAD:	13490 VA
REFER TO SPECIFICATIONS FOR ADDITIONAL INFORMATION	TOTAL CONNECTED AMPS:	56 A

NEW A

VOLTS: 120/240 Single **LOCATION**: GYM B-101 PHASES: SUPPLY FROM: MP-1 MOUNTING: Recessed MAINS TYPE: MCB **ENCLOSURE**: Type 1 MAIN RATING: 100A BUSSING: COPPER **A.I.C. RATING**: 22000

СКТ	CIRCUIT DESCRIPTION	LEG.	TRIP	POLES	Α	В	Α	В	POLES	TRIP	LEG.	CIRCUIT DESCRIPTION	C
1	EXISTING POWER		20 A	1	0		0		1	20 A		EXISTING POWER	
3	EXISTING POWER		20 A	1		0		0	1	20 A		EXISTING POWER	
5	EXISTING POWER		20 A	1	0		0		1	20 A		EXISTING POWER	
7	EXISTING POWER		20 A	1		0		0	1	20 A		EXISTING POWER	
9	EXISTING POWER		20 A	1	0		0		1	20 A		EXISTING POWER	1
11	EXISTING POWER		20 A	1		0		0	1	20 A		SPARE	1
13	EXISTING POWER		20 A	1	0		0		1	20 A		EXISTING POWER	1
15	EXISTING POWER		20 A	1		0		0	1	20 A		SPARE	1
17	EXISTING POWER		20 A	1	0		0		1	20 A		EXISTING POWER	1
19	SPARE		20 A	1		0		0	1	20 A		SPARE	2
21	SPARE		20 A	1	0		0		1	20 A		SPARE	2
23	SPARE		20 A	1		0		0	1	20 A		SPARE	2
25	SPARE		20 A	1	0		0		1	20 A		SPARE	2
27	SPARE		20 A	1		0		0	1	20 A		SPARE	2
29	SPARE		20 A	1	0		0		1	20 A		SPARE	3
31	SPARE		20 A	1		0		0	1	20 A		SPARE	3
33	SPARE		20 A	1	0		0		1	20 A		SPARE	3
35	SPARE		20 A	1		0		0	1	20 A		SPARE	3
37	SPARE		20 A	1	0		0		1	20 A		SPARE	3
39	SPARE		20 A	1		0		0	1	20 A		SPARE	4
41	SPARE FC-1/2 - RM B-102/4/5/6/7		20 A	1	0		0		1	20 A		SPARE	4

GC = PROVIDE GFI CIRCUIT BREAKER ST = PROVIDE SHUNT TRIP BREAKER LO = PROVIDE LOCKABLE DEVICE

	PANEL TOTAL	.S
	TOTAL CONNECTED LOAD PHASE A:	0 VA
	TOTAL CONNECTED LOAD PHASE B:	0 VA
	TOTAL CONNECTED LOAD:	0 VA
REFER TO SPECIFICATIONS FOR ADDITIONAL INFORMATION	TOTAL CONNECTED AMPS:	0 A

NEW 1L1

LOCATION: CORRIDOR C-107 VOLTS: 120/208 Single PHASES: MAINS TYPE: MCB **ENCLOSURE**: Type 1 MAIN RATING: 100A **A.I.C. RATING**: 22000 BUSSING: COPPER

СКТ	CIRCUIT DESCRIPTION	LEG.	TRIP	POLES	A	В	Α	В	POLES	TRIP	LEG.	CIRCUIT DESCRIPTION	СКТ
1	EXISTING POWER		20 A	1	0		0		1	20 A		EXISTING POWER	2
3	EXISTING POWER		20 A	1		0		0	1	20 A		EXISTING POWER	4
5	EXISTING POWER		20 A	1	0		0		1	20 A		EXISTING POWER	6
7	EXISTING POWER		20 A	1		0		0	1	20 A		EXISTING POWER	8
9	EXISTING POWER		20 A	1	0		0		1	20 A		EXISTING POWER	10
11	EXISTING POWER		20 A	1		0		0	1	20 A		EXISTING POWER	12
13	EXISTING POWER		20 A	1	0		0		1	20 A		EXISTING POWER	14
15	EXISTING POWER		20 A	1		0		0	1	20 A		EXISTING POWER	16
17	EXISTING POWER		20 A	1	0		0		1	20 A		EXISTING POWER	18
19	SPARE		20 A	1		0		0	1	20 A		SPARE	20
21	SPARE		20 A	1	0		0		1	20 A		SPARE	22
23	SPARE		20 A	1		0		1400	1	20 A		REC - RM C-104/105/106	24
25	SPARE		20 A	1	0		600		1	20 A		REC - RM C-103	26
27	UV-5 - RM C-103		20 A	2		1110		0	1	20 A		SPARE	28
29	- 0V-5 - RW C-105		20 A	2	1110		0		1	20 A		SPARE	30
31	UV-5 - RM C-104		20 A	2		1110		0	1	20 A		SPARE	32
33	- 0V-5 - RW C-104		20 A	2	1110		0		1	20 A		SPARE	34
35	UV-5 - RM C-105		20 A	2		1110		0	1	20 A		SPARE	36
37	- 0V-5 - RW C-105		20 A	2	1110		0		1	20 A		SPARE	38
39	UV-5 - RM C-106		20.4	2		1110		0	1	20 A		SPARE	40
41	- UV-3 - KIVI C-100		20 A	2	1110		0		1	20 A		SPARE	42

GC = PROVIDE GFI CIRCUIT BREAKER ST = PR

ST = PROVIDE SHUNT TRIP BREAKER LO = PROVIDE LOCKABLE DEVICE		
	PANEL TOTAL	LS
	TOTAL CONNECTED LOAD PHASE A:	5040 VA
	TOTAL CONNECTED LOAD PHASE B:	5840 VA
	TOTAL CONNECTED LOAD:	10880 VA
REFER TO SPECIFICATIONS FOR ADDITIONAL INFORMATION	TOTAL CONNECTED AMPS:	52 A

NEW FA

LOCATION: CORRIDOR B-120 **VOLTS**: 120/208 Single **SUPPLY FROM:** MP-1 PHASES: **MOUNTING**: RECESSED MAINS TYPE: MCB **ENCLOSURE**: Type 1 MAIN RATING: 225A **A.I.C. RATING**: 22000 **BUSSING:** COPPER

СКТ	CIRCUIT DESCRIPTION	LEG.	TRIP	POLES	Α	В	Α	В	POLES	TRIP	LEG.	CIRCUIT DESCRIPTION	CH
1	EXISTING POWER		20 A	1	0		0		1	20 A		EXISTING POWER	2
3	EXISTING POWER		20 A	1		0		0	1	20 A		EXISTING POWER	4
5	EXISTING POWER		20 A	1	0		0		1	20 A		EXISTING POWER	6
7	EXISTING POWER		20 A	1		0		0	1	20 A		EXISTING POWER	8
9	EXISTING POWER		20 A	1	0		0		1	20 A		EXISTING POWER	1
11	EXISTING POWER		20 A	1		0		0	1	20 A		EXISTING POWER	1:
13	EXISTING POWER		20 A	1	0		0		1	20 A		EXISTING POWER	14
15	EXISTING POWER		20 A	1		0		0	1	20 A		EXISTING POWER	10
17	EXISTING POWER		20 A	1	0		0		1	20 A		EXISTING POWER	1
19	EXISTING POWER		20 A	1		0		0	1	20 A		EXISTING POWER	20
21	EXISTING POWER		20 A	1	0		0		1	20 A		EXISTING POWER	2
23	EXISTING POWER		20 A	1		0		0	1	20 A		EXISTING POWER	2
25	EXISTING POWER		20 A	1	0		0		1	20 A		EXISTING POWER	20
27	EXISTING POWER		20 A	1		0		0	1	20 A		EXISTING POWER	2
29	EXISTING POWER		20 A	1	0		0		1	20 A		EXISTING POWER	30
31	EXISTING POWER		20 A	1		0		0	1	20 A		EXISTING POWER	3
33	EXISTING POWER		20 A	1	0		0		1	20 A		EXISTING POWER	34
35	EXISTING POWER		20 A	1		0		0	1	20 A		EXISTING POWER	3
37	EXISTING POWER		20 A	1	0		0		1	20 A		EXISTING POWER	3
39	EXISTING POWER		20 A	1		0		0	1	20 A		EXISTING POWER	40
41	EXISTING POWER		20 A	1	0		0		1	20 A		EXISTING POWER	4:
43	REC - RM B-113		20 A	1		0		800	1	20 A		REC - RM B-115	4
45	REC - RM B-114		20 A	1	0		1400		1	20 A		REC - RM B-116	4
47	SPARE		20 A	1		0		1400	1	20 A		REC - RM B-117	48
49	SPARE		20 A	1	0		0		1	20 A		SPARE	5
51	IN/ 2 DM D 442		00.4	0		585		0	1	20 A		SPARE	5
53	UV-3 - RM B-113		20 A	2	585		0		1	20 A		SPARE	5-
55	IN/ 4 DM D 444		00.4	0		1110		0	1	20 A		SPARE	5
57	UV-4 - RM B-114		20 A	2	1110		0		1	20 A		SPARE	5
59	IN/ 4 DM D 445		00.4	0		1110		0	1	20 A		SPARE	6
61	UV-4 - RM B-115		20 A	2	1110		0		1	20 A		SPARE	6:
63	IN 4 DM D 440		00.4	_		1110		0	1	20 A		SPARE	6
65	UV-4 - RM B-116		20 A	2	1110		0		1	20 A		SPARE	60
67	IN 7 DM D 447		00.4	_		1110		0	1	20 A		SPARE	6
69	UV-7 - RM B-117		20 A	2	1110		0		1	20 A		SPARE	7
71	LD 4 0 D 4 10					1110		0	1	20 A		SPARE	7.
73	UV-6 - RM B-118		20 A	2	1110		0		1	20 A		SPARE	7.
75	FC-1 - RM B-119		20 A	1		228		0	1	20 A		SPARE	7
77	SPACE			1					1			SPACE	78
79	SPACE			1					1			SPACE	8
81	SPACE			1					1			SPACE	82
83	SPACE			1					1			SPACE	84

PANEL TOTAL	<u>.S</u>
TOTAL CONNECTED LOAD PHASE A:	7535 VA
TOTAL CONNECTED LOAD PHASE B:	8563 VA
TOTAL CONNECTED LOAD:	16098 VA
TOTAL CONNECTED AMPS:	77 A
	TOTAL CONNECTED LOAD PHASE B: TOTAL CONNECTED LOAD:

EX.B LOCATION: VOLTS: 120/240 Single SUPPLY FROM: PHASES: MOUNTING: Recessed MAINS TYPE: MAIN RATING: **ENCLOSURE**: Type 1 BUSSING: A.I.C. RATING: LEG. TRIP POLES A B A B POLES TRIP LEG. CIRCUIT DESCRIPTION CKT 1 REC - RM A-111/112 UV-3 - RM A111 3 REC - RM A-113/105 20 A 1 885 5 REC - RM A-104/103 20 A 1 0 UV-3 - RM A112 UV-3 - RM A-105 UV-3 - RM A113 UV-3 - RM A-104 EXISTING POWER 15 EXISTING POWER 20 A 1 EXISTING POWER 17 EXISTING POWER EXISTING POWER

41 EXISTING POWER 20 A 1 0 GC = PROVIDE GFI CIRCUIT BREAKER ST = PROVIDE SHUNT TRIP BREAKER

20 A 1

20 A 1

20 A 1

20 A 1 0

19 EXISTING POWER

21 EXISTING POWER

23 EXISTING POWER

25 EXISTING POWER

27 EXISTING POWER

29 EXISTING POWER

31 EXISTING POWER

33 EXISTING POWER

35 EXISTING POWER

37 UV-3 - RM A-103

D = PROVIDE LOCKABLE DEVICE		
	PANEL TOTAL	.S
	TOTAL CONNECTED LOAD PHASE A:	3540 VA
	TOTAL CONNECTED LOAD PHASE B:	4425 VA
	TOTAL CONNECTED LOAD:	7965 VA
EFER TO SPECIFICATIONS FOR ADDITIONAL INFORMATION	TOTAL CONNECTED AMPS:	33 A



GIBRALTAR DESIGN

ENGINEERING GROUP (219) 924-8400

ARCHITECTURE • ENGINEERING • INTERIOR DESIGN

PROJECT:

FRAZEE ELEMENTARY SCHOOL -RENOVATIONS AND RELATED WORK

FAYETTE COUNTY SCHOOLS CORPORATION CONNERSVILLE, INDIANA

> 100% CONSTRUCTION **DOCUMENTS**

GIBRALTAR DESIGN 9102 N. Meridian St., Ste. 300 Indianapolis, IN 46260 Homepage: www.GibraltarDesign.com Email: info@GibraltarDesign.com Phone 317.580.5777 Fax 317.580.5778

05/15/24 COORDINATED BY DRAWN BY CHECKED BY

DJ COPYRIGHT NOTICE: THE CONCEPTS, DESIGNS, PLANS, DETAILS, ETC, SHOWN ON THE CONCEPTS, DESIGNS, PLANS, DETAILS, ETC, SHOWN ON THIS DOCUMENT ARE THE PROPERTY OF GIBRALTAR DESIGN AND WERE CREATED FOR USE ON THIS SPECIFIC PROJECT. NONE OF THIS INFORMATION SHALL BE USED BY ANY PERSON OR FIRM FOR ANY PURPOSE WITHOUT THE EXPRESS WRITTEN CONSENT OF GIBRALTAR DESIGN. THE OWNER MAY RETAIN COPIES FOR INFORMATION AND REFERENCE IN CONNECTION ONLY WITH THIS PROJECT.

DATE

BoK

32

36

38

40

EXISTING POWER

EXISTING POWER

0 1 20 A

0 | 1 | 20 A |

0 | 1 | 20 A |

1 20 A

REVISIONS MARK DATE ISSUED FOR AD-01 06/05/24 ADDENDUM 1

ELECTRICAL SCHEDULES

FRAZEE ELEMENTARY SCHOOL -RENOVATIONS AND RELATED $\sim\sim\sim\sim\sim$

NEW X-EM/LB

VOLTS: 120/240 Single LOCATION: BOILER SUPPLY FROM: PHASES: MOUNTING: SURFACE MAINS TYPE: MCB MAIN RATING: 225A **ENCLOSURE**: Type 1 **A.I.C. RATING**: 22000 BUSSING: COPPER

					_							
CIRCUIT DESCRIPTION	LEG.	TRIP	POLES	Α	В	A	В	POLES	TRIP	LEG.	CIRCUIT DESCRIPTION	СКТ
EXISTING POWER		20 A	1	0		0		1	20 A		EXISTING POWER	2
EXISTING POWER		20 A	1		0		0	1	20 A		EXISTING POWER	4
EXISTING POWER		20 A	1	0		0		1	20 A		EXISTING POWER	6
EXISTING POWER		20 A	1		0		0	1	20 A		EXISTING POWER	8
SPARE		20 A	1	0		0		1	20 A		SPARE	10
SPARE		20 A	1		0		0	1	20 A		SPARE	12
SPARE		20 A	1	0		0		1	20 A		SPARE	14
SPARE		20 A	1		0		0	1	20 A		SPARE	16
SPARE		20 A	1	0		0		1	20 A		SPARE	18
SPARE		20 A	1		0		0	1	20 A		SPARE	20
SPARE		20 A	1	0		0		1	20 A		SPARE	22
SPARE		20 A	1		0		0	1	20 A		SPARE	24
SPARE		20 A	1	0		0		1	20 A		SPARE	26
SPARE		20 A	1		0		0	1	20 A		SPARE	28
SPARE		20 A	1	0		0		1	20 A		SPARE	30
SPARE		20 A	1		0		0	1	20 A		SPARE	32
SPARE		20 A	1	0		0		1	20 A		SPARE	34
SPACE			1					1			SPACE	36
SPACE			1					1			SPACE	38
SPACE			1					1			SPACE	40
SPACE			1					1			SPACE	42
	EXISTING POWER EXISTING POWER EXISTING POWER EXISTING POWER SPARE SPACE SPACE	EXISTING POWER EXISTING POWER EXISTING POWER EXISTING POWER SPARE SPACE SPACE	EXISTING POWER 20 A EXISTING POWER 20 A EXISTING POWER 20 A EXISTING POWER 20 A SPARE 20 A SPACE SPACE SPACE	EXISTING POWER 20 A 1 SPARE 20 A 1 SPACE 1 SPACE 1	EXISTING POWER 20 A 1 0 SPARE 20 A 1 0 SPACE 1 1 SPACE 1 1	EXISTING POWER	EXISTING POWER					

LEGEND: GC = PROVIDE GFI CIRCUIT BREAKER ST = PROVIDE SHUNT TRIP BREAKER LO = PROVIDE LOCKABLE DEVICE

	PANEL TOTALS	
	TOTAL CONNECTED LOAD PHASE A: 0 V	Ά
	TOTAL CONNECTED LOAD PHASE B: 0 V	Ά
	TOTAL CONNECTED LOAD: 0 V	Ά
REFER TO SPECIFICATIONS FOR ADDITIONAL INFORMATION	TOTAL CONNECTED AMPS: 0 A	
	·	

NEW A1G

LOCATION: BOILER A-114 VOLTS: 120/208 Single **SUPPLY FROM**: A1G PHASES: MOUNTING: SURFACE MAINS TYPE: ENCLOSURE: Type 1 MAIN RATING: **A.I.C. RATING**: 22000 BUSSING: COPPER

СКТ	CIRCUIT DESCRIPTION	LEG.	TRIP	POLES	Α	В	Α	В	POLES	TRIP	LEG.	CIRCUIT DESCRIPTION	СКТ
1	EXISTING POWER		20 A	1	0		0		1	20 A		EXISTING POWER	2
3	EXISTING POWER		20 A	1		0		0	1	20 A		EXISTING POWER	4
5	EXISTING POWER		20 A	1	0		0		1	20 A		EXISTING POWER	6
7	EXISTING POWER		20 A	1		0		0	1	20 A		EXISTING POWER	8
9	EXISTING POWER		20 A	1	0		0		1	20 A		EXISTING POWER	10
11	EXISTING POWER		20 A	1		0		0	1	20 A		EXISTING POWER	12
13	EXISTING POWER		20 A	1	0		0		1	20 A		EXISTING POWER	14
15	EXISTING POWER		20 A	1		0		0	1	20 A		EXISTING POWER	16
17	EXISTING POWER		20 A	1	0		0		1	20 A		EXISTING POWER	18
19	EXISTING POWER		20 A	1		0		0	1	20 A		EXISTING POWER	20
21	EXISTING POWER		20 A	1	0		0		1	20 A		EXISTING POWER	22
23	EXISTING POWER		20 A	1		0		0	1	20 A		EXISTING POWER	24
25	EXISTING POWER		20 A	1	0		0		2	30 A		EXISTING POWER	26
27	- EXISTING POWER		20 A	2		0		0		30 A		EXISTING POWER	28
29	EXISTING POWER		20 A		0		0		1	20 A		EXISTING POWER	30
31	SPARE		20 A	1		0		0		60.4		CDADE	32
33	SPARE		20 A	1	0		0		2	60 A		SPARE	34
35	- EXISTING POWER		50 A	2		0		0	2	50 A		EXISTING POWER	36
37	EXISTING POWER		30 A		0		0] 2	50 A		EXISTING POWER	38
39	EXISTING PANEL KEM		100 4	2		0		0	1	20 A		EXISTING POWER	40
41	EAISTING PAINEL NEW		100 A	2	0		0		1	20 A		EXISTING POWER	42

LEGEND:
GC = PROVIDE GFI CIRCUIT BREAKER
ST = PROVIDE SHUNT TRIP BREAKER
LO = PROVIDE LOCKABLE DEVICE

	PANEL TOTALS
	TOTAL CONNECTED LOAD PHASE A: 0 VA
	TOTAL CONNECTED LOAD PHASE B: 0 VA
	TOTAL CONNECTED LOAD: 0 VA
REFER TO SPECIFICATIONS FOR ADDITIONAL INFORMATION	TOTAL CONNECTED AMPS: 0 A



DESIGN ARCHITECTURE • ENGINEERING • INTERIOR DESIGN

ENGINEERING GROUP (219) 924-8400

PROJECT:

FRAZEE ELEMENTARY SCHOOL -RENOVATIONS AND RELATED

WORK

FAYETTE COUNTY SCHOOLS CORPORATION CONNERSVILLE, INDIANA

> 100% CONSTRUCTION DOCUMENTS

GIBRALTAR DESIGN 9102 N. Meridian St., Ste. 300 Indianapolis, IN 46260 Homepage: www.GibraltarDesign.com Email: info@GibraltarDesign.com Phone 317.580.5777 Fax 317.580.5778

PROJECT 23-152 DATE 05/15/24 COORDINATED BY DRAWN BY BoK CHECKED BY

DJ

COPYRIGHT NOTICE: THE CONCEPTS, DESIGNS, PLANS, DETAILS, ETC, SHOWN ON THIS DOCUMENT ARE THE PROPERTY OF GIBRALTAR DESIGN AND WERE CREATED FOR USE ON THIS SPECIFIC PROJECT. NONE OF THIS INFORMATION SHALL BE USED BY ANY PERSON OR FIRM FOR ANY PURPOSE WITHOUT THE EXPRESS WRITTEN CONSENT OF GIBRALTAR DESIGN. THE OWNER MAY RETAIN COPIES FOR INFORMATION AND REFERENCE IN CONNECTION ONLY WITH THIS PROJECT.


REVISIONS


MARK DATE ISSUED FOR AD-01 06/05/24 ADDENDUM 1

ELECTRICAL SCHEDULES

FRAZEE ELEMENTARY SCHOOL - RENOVATIONS AND RELATED mmm

REY TO ELECTRICAL CIRCUIT WIRING PHASE CON DUCTOR(S), SWITCH LEG OR GO-BETWEEN NEUTRAL CONDUCTOR(S) GROUND CONDUCTOR(S) ALL CONDUCTORS #12 AWG NOTED UNLESS OTHERWISE 1. ALL WIRING SHALL BE #12 AWG, UNLESS OTHER WISE NOTED. 2. MINIMUM CONDUIT SIZE SH ALL BE 3/4" EXCEPT FOR THREE (3) WIRES OR LESS, OR CONTROL WIRING WITHIN BUILDINGS, WHICH MAY BE 1/2" CONDUIT. 3. 1/2" FLEXSTEEL, GREENFIELD OR SEALITE SHALL BE THE MINIMUM SIZE INSTALLED.

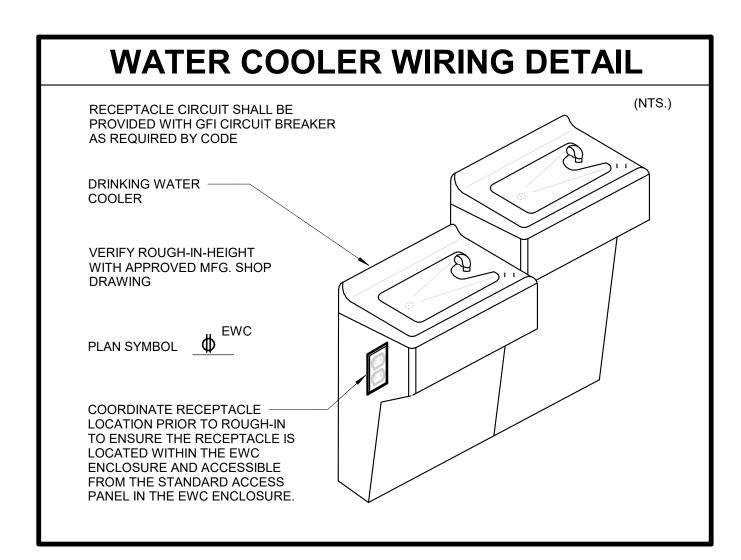

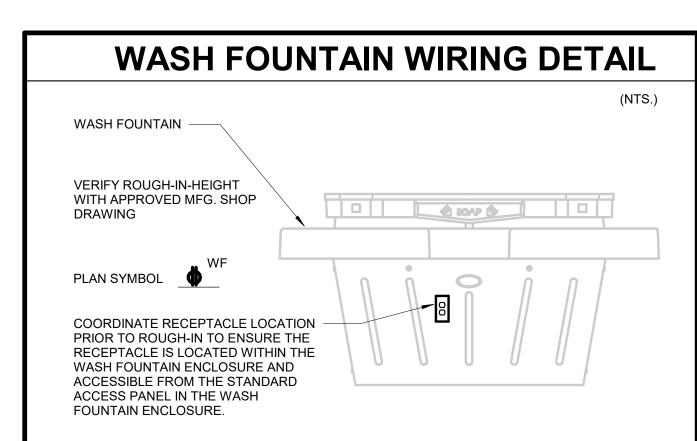

GENERAL NOTES

- A. WORK SHALL COMPLY WITH LOCAL, STATE AND NATIONAL ELECTRIC CODES, AMERICANS WITH DISABILITIES ACT.
- B. THE PANEL SCHEDULES ARE PROVIDED FOR ASSISTANCE ONLY IN UNDERSTANDING THE LOADING ON THE VARIOUS CIRCUITS AND THE CIRCUIT DESIGNATIONS DESIRED FOR THE PANEL DIRECTORIES. THE PANEL SCHEDULES MUST BE BALANCED UPON COMPLETION OF THE PROJECT TO COMPLY WITH CODE. IN ADDITION, THE PANEL SCHEDULES DO NOT IDENTIFY THE TYPES OF CIRCUIT BREAKERS TO BE USED (SUCH AS GFCI, HACR, SHUNT TRIP UNITS, ETC.) NOR DO THE SCHEDULES IDENTIFY CIRCUIT BREAKERS REQUIRED. (SUCH AS C/B'S FEEDING SURGE PROTECTION UNITS). REFER TO THE REST OF THE DRAWINGS AND THE SPECIFICATIONS FOR ADDITIONAL REQUIREMENTS AND DETAILED INFORMATION
- C. COORDINATE EQUIPMENT ELECTRICAL REQUIREMENTS (VOLTAGES, PHASE, LOAD, ETC.) TO AVOID CONFLICTS.
- D. REFER TO ARCHITECTURAL PLANS AND ELEVATIONS FOR ADDITIONAL ELECTRICAL INFORMATION AND REQUIREMENTS. IN ALL CASES DEVICE MOUNTING HEIGHTS AND LOCATIONS SHALL CONFORM TO THE LATEST AMERICANS WITH DISABILITIES FEDERAL STANDARDS.
- REFER TO THE PLANS FOR ADDITIONAL ELECTRICAL WORK AND REQUIREMENTS. FURNISH, INSTALL AND LOCATE DISCONNECT SWITCHES AT EQUIPMENT/MOTOR LOCATION, AS REQUIRED, AND IN ACCORDANCE WITH CODE. IF THE WORK OF OTHER TRADES CAUSES A LOSS OF CONTINUITY OF THE EXISTING ELECTRICAL DISTRIBUTION, GROUNDING SYSTEM OR CIRCUITRY, IT SHALL BE RECONNECTED OR REPAIRED AT NO ADDITIONAL COST.
- F. FIELD VERIFY IF EXISTING ASBESTOS WILL BE ENCOUNTERED PRIOR TO STARTING ANY WORK. IF ASBESTOS IS PRESENT, THE OWNER WILL PROVIDE FOR THE REMOVAL OF ANY MATERIAL CONTAINING ASBESTOS. SEE SPECIFICATIONS FOR FURTHER REQUIREMENTS
- G. COORDINATE PHASING OF WORK AND PROVIDE TEMPORARY POWER AND SERVICES AS REQUIRED FOR THE IMPLEMENTATION OF WORK WHILE MAINTAINING SERVICES TO PORTIONS OF BUILDING TO REMAIN OCCUPIED.
- H. SCHEDULE WORK TO AVOID DOWNTIME AND INCONVENIENCE TO OWNER. OWNER'S EXISTING FACILITY SHALL REMAIN IN OPERATION AT ALL TIMES, INCLUDING F/A AND OTHER SPECIAL SYSTEMS, ELECTRICAL POWER DISTRIBUTION, ETC. REQUIRED SHUTDOWN OF EXISTING FACILITY UTILITIES SHALL BE SCHEDULED WITH OWNER'S OPERATING PERSONNEL.

LAYOUT IS DIAGRAMMATIC AND INSTALL DEVICES, CONDUIT AND EQUIPMENT TO MEET ACTUAL FIELD CONDITIONS. REVIEW PROJECT SPECIFICATIONS BEFORE STARTING WORK AND SUBMIT COMPLETE SHOP DRAWINGS AS PER SPECIFICATIONS.

- J. VISIT SITE PRIOR TO BID TO DETERMINE AND VERIFY EXISTING INTERIOR AND EXTERIOR ELECTRICAL SYSTEMS TO VERIFY QUANTITIES AND LOCATIONS OF EXISTING SYSTEMS TO DETERMINE FULL EXTENT OF WORK. INCLUDE THE NECESSARY MODIFICATIONS TO THE EXISTING CONDITIONS (INCLUDING CEILINGS, WALLS, FLOORS, PIPES, CONDUIT, ROOF WORK, ETC.) AS REQUIRED, TO ALLOW FOR PROPER INSTALLATION OF WORK. ADJUST INSTALLATIONS TO MEET FIELD CONDITIONS AS REQUIRED FOR A COMPLETE AND PROPER INSTALLATION. NO EXTRAS WILL BE ALLOWED AFTER BIDDING FOR ANY REWORK OF EXISTING FIELD CONDITIONS TO RESOLVE CONFLICTS OR NOT FULLY UNDERSTANDING THE SCOPE OF THE WORK REQUIRED. EXISTING EQUIPMENT, CONDUIT, PIPING, ETC. SHALL BE REMOVED AS NOTED ON DRAWINGS AND AS REQUIRED TO MEET NEW SCOPE OF
- K. HIDDEN CONDITIONS IDENTIFIED THROUGH THE COURSE OF CONSTRUCTION SHALL BE IMMEDIATELY BROUGHT TO ATTENTION IN WRITTEN FORM FOR REVIEW AND DIRECTION. FAILURE TO DO SO SHALL REQUIRE THE CHANGES AND COSTS TO CORRECT SAID HIDDEN CONDITION TO BE COMPLETED AT NO COST. EXISTING EQUIPMENT NOT IDENTIFIED SHALL BE BROUGHT TO ATTENTION FOR REVIEW AS TO WHETHER THE EQUIPMENT SHALL REMAIN AND BE RECONNECTED TO THE NEW SERVICES, BE RELOCATED, BE ABANDONED, ETC.
- L. REMOVE AND REINSTALL EXISTING CEILINGS NOT BEING REPLACED (INCLUDING LIGHTS, MOTION SENSORS, FIRE ALARM DEVICES AND ANY OTHER ELECTRICAL DEVICES AS REQUIRED.) WHERE NECESSARY TO PERFORM WORK. THIS ALSO INCLUDES EXISTING CEILINGS OF PLASTER, DRYWALL, ETC. COORDINATE WORK IN CEILING SPACE SO AS TO MINIMIZE THE AMOUNT OF CEILINGS WHICH MUST BE REMOVED AND REINSTALLED. REVIEW THE ENTIRE SET OF CONTRACT DOCUMENTS IN ORDER TO FULLY UNDERSTAND AND INCLUDE CEILING WORK NECESSARY FOR WORK ON THE PROJECT. WHEN THE WORK IS COMPLETED IN THE SPACE, REINSTALL OR PATCH EXISTING CEILINGS, REINSTALL DEVICES AND EQUIPMENT AND REPAIR DAMAGE AS REQUIRED TO COMPLETELY MATCH EXISTING CONDITIONS. REPAIR OR REPLACE ANY DAMAGE CAUSED TO EXISTING CEILING AREAS.
- M. REMOVE EXISTING CONSTRUCTION AS REQUIRED AT EXISTING WALLS, FLOORS, PIPE CHASES, SURFACES, FINISHES, ETC. WHICH ARE AFFECTED. REPAIR EXISTING SURFACES AFFECTED, TO MATCH EXISTING SURFACE OF EQUAL OR BETTER QUALITY TO THE SATISFACTION OF THE OWNER'S REPRESENTATIVE.
- N. COORDINATE NEW INSTALLATIONS WITH EXISTING SYSTEMS. RELOCATE EXISTING LIGHTING, CONDUIT, EQUIPMENT, ETC., AS NECESSARY FOR NEW INSTALLATIONS.
- PROVIDE NEW PANEL DIRECTORIES IN EXISTING MODIFIED PANELBOARDS AND NEW PANELBOARDS TO CORRECTLY IDENTIFY EXISTING AND NEW LOADS. FINAL DIRECTORIES SHALL BE TYPE WRITTEN.

- P. EXISTING LIGHTING FIXTURES, ELECTRICAL DEVICES, CONDUIT, ETC., SHALL BE REMOVED AS NOTED ON DRAWINGS AND AS REQUIRED TO MEET NEW SCOPE OF WORK. EXISTING ELECTRICAL EQUIPMENT SHALL REMAIN PROPERTY OF THE OWNER AND SHALL BE PROPERLY STORED ON SITE, OR DESIGNATED TO BE ABANDONED AND REMOVED FROM SITE AS DIRECTED BY OWNER.
- Q. PERFORM CUTTING AND PATCHING OF EXISTING FLOOR SLABS AND WALLS AS REQUIRED FOR THE INSTALLATION OF ELECTRICAL SYSTEMS.
- R. EXISTING ELECTRICAL DEVICES (RECEPTACLES, SWITCHES, OUTLET BOXES, CONDUIT, ETC.) WITHIN WALLS TO BE REMOVED SHALL BE DISCONNECTED COMPLETELY. REROUTE AND EXTEND EXISTING CIRCUITRY, ELECTRICAL FEEDERS AND GROUNDING SYSTEMS AS REQUIRED TO MAINTAIN CIRCUIT, FEEDER AND GROUNDING SYSTEM INTEGRITY FOR ALL REMAINING DEVICES/EQUIPMENT. VERIFY EXACT CONDITIONS AND REQUIREMENTS IN FIELD.
- S. WHERE NEW CIRCUIT BREAKERS, FUSES AND SWITCHES ARE TO BE ADDED TO EXISTING PANELBOARDS, SWITCHBOARDS, ETC., THEY SHALL BE OF THE SAME MANUFACTURER AND DESIGN AS THE EXISTING BREAKERS OR SWITCHES IF NOT OBSOLETE AND SHALL BE OF THE SIZES AS INDICATED. REARRANGE CIRCUIT BREAKERS WITHIN THE EXISTING EQUIPMENT TO ACCOMMODATE THE NEW CIRCUIT BREAKERS OR SWITCHES. BRANCH CIRCUIT NUMBERS ASSIGNED TO EXISTING PANELBOARDS ARE ARBITRARY AND ARE INTENDED TO INDICATE BRANCH CIRCUIT REQUIREMENTS ONLY. ACTUAL PANEL NUMBER ASSIGNMENTS FOR DESIGNATED BRANCH CIRCUITS SHALL BE ADJUSTED TO MEET FIELD CONDITIONS. PROVIDE ADDITIONAL BUS, BUS EXTENSION, BOLTS AND HARDWARE, ENCLOSURE MODIFICATIONS, DIRECTORY MODIFICATIONS, ETC., AS REQUIRED TO ACCOMPLISH THE WORK.
- T. VERIFY CEILING STYLES/FRAMES AND TYPES BEFORE ORDERING FIXTURES AND CEILING MOUNTED DEVICES. PROVIDE APPROPRIATE STYLES/FRAMES AS REQUIRED TO MATCH CEILING STYLE AND TYPES.
- COORDINATE LIGHTING LAYOUTS WITH CEILING REGISTERS, GRILLES, DIFFUSERS, SPRINKLER HEADS AND CEILING GRID (SEE ARCHITECTURAL REFLECTED CEILING PLAN.)
 VERIFY LOCATION WITH OWNER'S REPRESENTATIVE IN FIELD PRIOR TO INSTALLATION.
- V. PROVIDE PLENUM RATED LIGHT FIXTURES IN PLENUM CEILING AREAS WHERE REQUIRED BY LOCAL OR NATIONAL CODES.
- W. SOME CEILING SPACES ARE RETURN AIR PLENUMS. EXAMINE PLENUM BEFORE CEILING IS INSTALLED (OR REPLACED) AND SEAL ALL OPENINGS AROUND CONDUIT, CABLE, ETC. PROVIDE PLENUM RATED CABLE (UNLESS IN CONDUIT), DEVICES AND EQUIPMENT PER
- THE MINIMUM DISTANCE BETWEEN SMOKE OR HEAT DETECTORS AND CEILING MOUNTED SUPPLY DIFFUSERS SHALL BE A MINIMUM OF 4 FEET AND WALL MOUNTED DIFUSERS SHALL BE 10 FEET
- Y. WHERE INDICATED ON THE DRAWINGS IN UNFINISHED SPACES, RUN EXPOSED RACEWAYS PARALLEL WITH OR AT RIGHT ANGLES TO WALL.

NO RACEWAYS SHALL BE INSTALLED WITHIN 6" OF STEAM, HOT WATER PIPES OR SIMILAR

- HEAT PRODUCING APPLIANCES.
- BB. COVERS OF JUNCTION OR PULL BOXES SHALL BE ACCESSIBLE AND IDENTIFIED PER SPECIFICATIONS. FIRE ALARM JUNCTION BOXES SHALL BE PAINTED RED. JUNCTION OR PULL BOXES AND THE LIKE SHALL BE INDEPENDENTLY SUPPORTED TO BUILDING STRUCTURE WITH NO WEIGHT BEARING ON RACEWAYS.
- CC. WIRE COLOR CODING SHALL BE COORDINATED THROUGHOUT THE ENTIRE

PROJECT/BUILDING FOR NEW AND EXISTING SYSTEMS.

AA. PROVIDE PULL WIRE IN EACH RACEWAY IN WHICH WIRING IS NOT INSTALLED.

- DD. IF MORE THAN THREE (3) PHASE (UNGROUNDED) CONDUCTORS ARE RUN IN THE SAME RACEWAY, CONDUCTOR AMPACITY SHALL BE DERATED IN ACCORDANCE WITH NEC
- EE. CONDUIT, LIGHTING, EQUIPMENT, ETC. SHALL NOT BE SUPPORTED FROM THE BOTTOM CHORD OF ENGINEERED JOISTS WITHOUT WRITTEN APPROVAL FROM THE STRUCTURAL ENGINEER. CONDUITS, ROUTED THROUGH AREAS WITH NO CEILING, SHALL BE ROUTED WITHIN THE WEBBING OF THE JOISTS AND SHALL NOT BE ROUTED BELOW THE BOTTOM CHORD OF THE JOIST.
- FF. SMOKE OR HEAT DETECTORS SHALL BE SURFACE MOUNTED TO CEILING, ROOF DECK MATERIALS, ETC. IN LIEU OF MOUNTING TO BOTTOM CHORD OF ENGINEERED JOIST OR ANY OTHER COMPONENTS NOT AN INTEGRAL PART OF THE HORIZONTAL CEILING.
- GG. VERIFY EXISTING AND NEW MECHANICAL, ELECTRICAL, FIRE PROTECTION SYSTEMS AND MEDICAL GAS SERVICES PRIOR TO START OF NEW CONSTRUCTION. COORDINATE AND ADJUST NEW WORK AS REQUIRED TO AVOID CONFLICTS WITH EXISTING SERVICES AND NEW SERVICES PROVIDED.
- HH. PROVIDE NECESSARY ROOFING COMPONENTS COMPATIBLE WITH EXISTING ROOFING SYSTEMS TO PROVIDE A WEATHERTIGHT INSTALLATION FOR THE ROOF PENETRATIONS AND ABANDONED HOLES FROM REMOVED ITEMS. PATCH ROOF OPENINGS FOR REMOVED PIPE PENETRATIONS, WITH RIGID ROOF INSULATION AND ROOF DECK MATERIAL FROM BELOW ROOF TO MATCH EXISTING ADJACENT MATERIALS. PROPERLY STRIP ROOFING MEMBRANE, ETC. AS REQUIRED, TO MATCH EXISTING ROOF SYSTEM WITH PROPER AND COMPATIBLE MATERIALS. PROVIDE A COMPLETE AND PROPER WEATHERTIGHT CONDITION.

- II. ROOF SUPPORTS FOR CONDUITS TO BE EQUIVALENT TO PORTABLE PIPE HANGER, INC. TYPE PP-10, WITH ROLLER GUIDE SUPPORT FOR SINGLE PIPES AND CHANNEL GUIDE SUPPORT FOR MULTIPLE PIPES. SUPPORTS TO HAVE HIGH DENSITY POLYPROPYLENE PLASTIC BASE WITH THREADED RODS FOR ADJUSTABLE HEIGHT ROLLER. SUPPORTS ARE TO SIT ON TOP OF ROOFING MEMBRANE. SUPPORTS ARE TO BE INSTALLED AS PER MANUFACTURER'S RECOMMENDATION AND TO BE COMPATIBLE WITH AND MAINTAIN THE INTEGRITY OF THE EXISTING OR NEW ROOF SYSTEM. WHERE CONDUITS AND WIRING ARE RUN IN EXTERIOR LOCATIONS OR EXPOSED TO SUNLIGHT, CONDUCTORS SHALL BE PROPERLY UPSIZED PER NEC 310.
- JJ. WIRING DEVICES SHOWN BACK-TO-BACK IN WALLS SHALL BE SEPARATED BY 8" MINIMUM.
- KK. UNLESS OTHERWISE NOTED, DEVICE ELEVATIONS REFER TO CENTER LINE OF JUNCTION BOX. VERIFY JUNCTION BOX LOCATIONS WITH FINAL EQUIPMENT LAYOUT PRIOR TO ROUGHING IN SAME.
- FURNISH AND INSTALL A GREEN GROUND WIRE IN POWER CONDUITS (NOT LIGHTING). ALL DEVICES, EQUIPMENT, FIXTURES AND THE LIKE, MUST BE GROUNDED.

 MECHANICAL/ELECTRICAL BONDS OF THE METALLIC RACEWAY SYSTEM SHALL BE
- MM. PROVIDE CONDUIT AND WIRE AND MAKE FINAL POWER CONNECTIONS AS REQUIRED TO EXHAUST FANS AND MISCELLANEOUS EQUIPMENT FURNISHED WITH MOTORIZED BACKDRAFT DAMPERS. DAMPERS SHALL BE CONNECTED TO EQUIPMENT 120 VOLT POWER CIRCUIT SO AS TO INTERLOCK THE MOTORIZED DAMPER WITH THE EXHAUST FAN. FOR THREE PHASE MOTORS, PROVIDE AN ADDITIONAL 120 VOLT CIRCUIT ROUTED THROUGH AN AUXILIARY CONTACT IN THE MOTOR STARTER.
- NN. AT NEW FIRE OR SMOKE/FIRE DAMPER LOCATIONS, WIRE EACH SMOKE/FIRE DAMPER TO NEAREST EMERGENCY PANEL, TO LOCAL ACTIVATION SMOKE DETECTORS ON EITHER SIDE OF THE DAMPER (WITHIN 3'-0") AND ALSO WIRE THE SAME TO THE FIRE ALARM CONTROL PANEL AS REQUIRED FOR A COMPLETE AND OPERATING SYSTEM. REFER TO MECHANICAL AND ARCHITECTURAL DRAWINGS FOR LOCATIONS WHERE DUCTS PASS THROUGH SMOKE OR FIRE BARRIERS.
- OO. MODIFY EXISTING FIRE ALARM SYSTEM AS INDICATED ON DRAWINGS AND SPECIFICATIONS AND AS REQUIRED FOR A COMPLETE, CODE COMPLIANT INSTALLATION. PROVIDE ADDITIONAL PARTS, ACCESSORIES AND CARDS AS REQUIRED TO COMPLETE THE WORK. FURNISH AND INSTALL INTERFACE WIRING INTEGRAL TO THE FIRE ALARM SYSTEM AS WELL AS INTERFACE TO NEW ELEVATOR CONTROL PANEL, BUILDING AUTOMATION SYSTEM, ETC. FOR A COMPLETE AND OPERATING INSTALLATION. FIRE ALARM DEVICES SHALL BE CONNECTED TO THE FIRE ALARM POWER SUPPLY AND BATTERIES OF THE SYSTEM AND SHALL NOT BE CONNECTED TO NORMAL POWER. QUESTIONS REGARDING THE REQUIREMENTS OF THE FIRE ALARM SYSTEM OR THE INTENT OF THE CODE SHALL BE DIRECTED TO THE ARCHITECT/ENGINEER FOR REVIEW PRIOR TO BID.
- PP. CONDUIT INSTALLED FOR LOW VOLTAGE SYSTEMS SHALL BE COORDINATED WITH THE LOW VOLTAGE INSTALLER IN FIELD, PRIOR TO ROUGH-IN. SUCH CONDUIT SHALL BE ROUTED TO MINIMIZE CABLE LENGTH AND COMPLY WITH LOW VOLTAGE CABLING DISTANCE LIMITATIONS.
- QQ. THE FLASH RATES FOR FIRE ALARM STROBES SHALL BE SYNCHRONIZED, COORDINATE ADDITIONAL REQUIREMENTS WITH NFPA 72.
- RR. REWORK EXISTING ELECTRICAL FEEDERS, CONDUIT AND LOW VOLTAGE WIRING AS REQUIRED FOR INSTALLATION OF NEW STRUCTURAL COMPONENTS REQUIRED TO SUPPORT NEW ROOF MOUNTED EQUIPMENT. FURNISH AND INSTALL ALL CONDUIT, WIRING AND SPLICE BOXES TO MAINTAIN CONTINUITY.
- SINGLE POLE CIRCUITS SHALL HAVE SEPARATE INDEPENDENT NEUTRAL CONDUCTORS (NON-NETWORKED), WHICH (PER CODE) ARE CONSIDERED CURRENT CARRYING CONDUCTORS. THEREFORE, IF MORE THAN THREE (3) CURRENT CARRYING CONDUCTORS ARE RUN IN THE SAME RACEWAY, CONDUCTOR AMPACITY SHALL BE DERATED IN ACCORDANCE WITH NEC ARTICLE 310. AS SUCH, MULTIPLE BRANCH CIRCUIT HOME RUNS SHALL, AT A MINIMUM, UTILIZE #10 AWG CONDUCTORS TO COMPLY WITH REQUIREMENTS HEREIN. COORDINATE REQUIREMENTS IN FIELD WITH SPECIFIC HOME RUN CONFIGURATION AND NEC REQUIREMENTS.
- TT. CONTRACTOR SHALL OBTAIN AVAILABLE FAULT CURRENT, UTILITY TRANSFORMER SIZE AND IMPEDANCE WITHIN 14 DAYS OF CONTRACT AWARD. ELECTRICAL PANEL AND GEAR SHOP DRAWINGS SHALL BE SUBMITTED ALONG WITH COORDINATION/ARC FLASH STUDY WITH 30 DAYS OF CONTRACT AWARD FOR REVIEW. ALL GEAR SHALL BE RATED TO PROPERLY WITHSTAND AVAILABLE FAULT CURRENT.
- UU. PRIOR TO THE START OF WORK AND THE ORDERING OF EQUIPMENT, CONTRACTOR SHALL CAREFULLY MEASURE AND VERIFY THE VOLTAGE, PHASE AND WIRING CONFIGURATION OF EXISTING PANELS AND EXISTING GEAR THAT ARE PART OF WORK AND SHALL CAREFULLY VERIFY THAT ALL ELECTRICAL CONNECTIONS, GEAR AND EQUIPMENT HAVE BEEN CAREFULLY COORDINATED TO ELIMINATE CONFLICTS. COORDINATE WITH OTHER TRADES AS REQUIRED TO ELIMINATE ELECTRICAL CONFLICTS PRIOR TO START OF WORK.
- CAREFULLY VERIFY COLOR TEMPERATURES OF FIXTURES WITH ARCHITECT PRIOR TO ORDERING.



GIBRALTAR DESIGN

ARCHITECTURE • ENGINEERING • INTERIOR DESIGN

MILLIES

ENGINEERING GROUP
(219) 924-8400

PROJECT:

FRAZEE

ELEMENTARY SCHOOL RENOVATIONS AND RELATED WORK

FOR:
FAYETTE COUNTY SCHOOLS
CORPORATION

CONNERSVILLE, INDIANA

100% CONSTRUCTION DOCUMENTS

9102 N. Meridian St., Ste. 300
Indianapolis, IN 46260
Homepage: www.GibraltarDesign.com
Email: info@GibraltarDesign.com
Phone 317.580.5777 Fax 317.580.5778

PROJECT
23-152
DATE
05/15/24
COORDINATED BY
BK
DRAWN BY
BoK
CHECKED BY

BoK
CHECKED BY
DJ

COPYRIGHT NOTICE:
THE CONCEPTS, DESIGNS, PLANS, DETAILS, ETC, SHOWN ON THIS DOCUMENT ARE THE PROPERTY OF GIBRALTAR DESIGN AND WERE CREATED FOR USE ON THIS SPECIFIC PROJECT. NONE OF THIS INFORMATION SHALL BE USED BY ANY PERSON OR FIRM FOR ANY PURPOSE WITHOUT THE EXPRESS

WRITTEN CONSENT OF GIBRALTAR DESIGN. THE OWNER MAY RETAIN COPIES FOR INFORMATION AND REFERENCE IN

CONNECTION ONLY WITH THIS PROJECT.

REVISIONS

MARK DATE ISSUED FOR

AD-01 06/05/24 ADDENDUM 1


DRAWING
ELECTRICAL DETAILS &
DIAGRAMS

PROJECT
FRAZEE ELEMENTARY SCHOOL
RENOVATIONS AND RELATED

WORK

E-601F

TAG	SYMBOL	DESCRIPTION	MANUFACTURER SERIES OR CATALOG NUMBER	VOLTAGE/ BALLAST	LAMPS/CROSS SECTION	MOUNTING	REMARKS
AA	•	2'X4' LED FLAT PANEL FIXTURE	LITHONIA #CPX-2x4-3000LM-80CRI-40K-SWL-MIN10 OR APPROVED EQUAL	120/277 VOLT 0-10V DIM - -	LED 4000 K MIN 3000 LM	RECESSED LAY-IN -	- - -
AA1	0	2'X4' LED FLAT PANEL FIXTURE	LITHONIA #CPX-2x4-4000LM-80CRI-40K-SWL-MIN10 OR APPROVED EQUAL	120/277 VOLT 0-10V DIM - -	LED 4000 K MIN 4000 LM	RECESSED LAY-IN -	- - -
AA2	•	2'X4' LED FLAT PANEL FIXTURE	LITHONIA #CPX-2x4-6000LM-80CRI-40K-SWL-MIN10 OR APPROVED EQUAL	120/277 VOLT 0-10V DIM - -	LED 4000 K MIN 6000 LM	RECESSED LAY-IN -	- - - -
AB	0	2'X2' LED FLAT PANEL FIXTURE	LITHONIA #CPX-2x2-1500LM-80CRI-40K-SWL-MIN10 OR APPROVED EQUAL AD-01	120/277 VOLT 0-10V DIM - - AD-0		RECESSED LAY-IN -	- - - -
CA	•	4" LED DOWNLIGHT FIXTURE	LITHONIA #LDN4-ALO2-40K-LO4-WR-MVOLT OR APPROVED EQUAL	120/277 VOLT 0-10V DIM - -	LED 4000 K MIN 4000 LM	RECESSED LAY-IN -	- - -
PA	├	4' LED STRIP FIXTURE	LITHONIA #CLX-L48-4000LM-SEF-XX-L/LENS-XX-MVOLT-80CRI OR APPROVED EQUAL	120/277 VOLT 0-10V DIM - -	LED 4000 K MIN 4000 LM	RECESSED LAY-IN -	- - -
PW		4' LED SURFACE WRAP FIXTURE	LITHONIA #BLWP4-40L-ADP-MVOLT-EZ1-LP40 OR APPROVED EQUAL AD-01	120/277 VOLT 0-10V DIM - -	LED 4000 K MIN 4000 LM	SURFACE MOUNT - AD-01	
PV		4' LED SURFACE VAPORTITE FIXTURE	LITHONIA #FEM-8000LM-XX-XX-MVOLT-GZ10-35K-80CRI OR APPROVED EQUAL	120/277 VOLT 0-10V DIM - -	LED 4000 K MIN 8000 LM	SURFACE MOUNT -	
WA		3' LED SURFACE MOUNT FIXTURE	LITHONIA #S4WID-LLP-3FT-MSL3-90CRI-40K-6000LMF-I80CRI-40K- 1600LMF-XX-SCT-MIN102-FLL-DC-MVOLT-WHTT-1E10WLCP- ZT OR APPROVED EQUAL	120/277 VOLT 0-10V DIM - -	LED 4000 K MIN 4000 LM	WALL MOUNT -	
EM		FIXTURE ON EMERGENCY CIRCUIT WITH 90 MINUTE, HIGH OUTPUT (MIN 1400LM) BATTERY UNIT OR INVERTER	FIXTURES LESS THAN 10000 LM: BODINE FACTORY INSTALLED BATTERY OR, AT CONTRACTOR'S DISCRETION, MYERS LV SERIES INVERTER (SIZE AND QUANTITY AS REQUIRED)	120/277 VOLT	-	IN FIXTURE/ REMOTE	-PROVIDE TEST SWITCH AND CHARGING INDICATOR

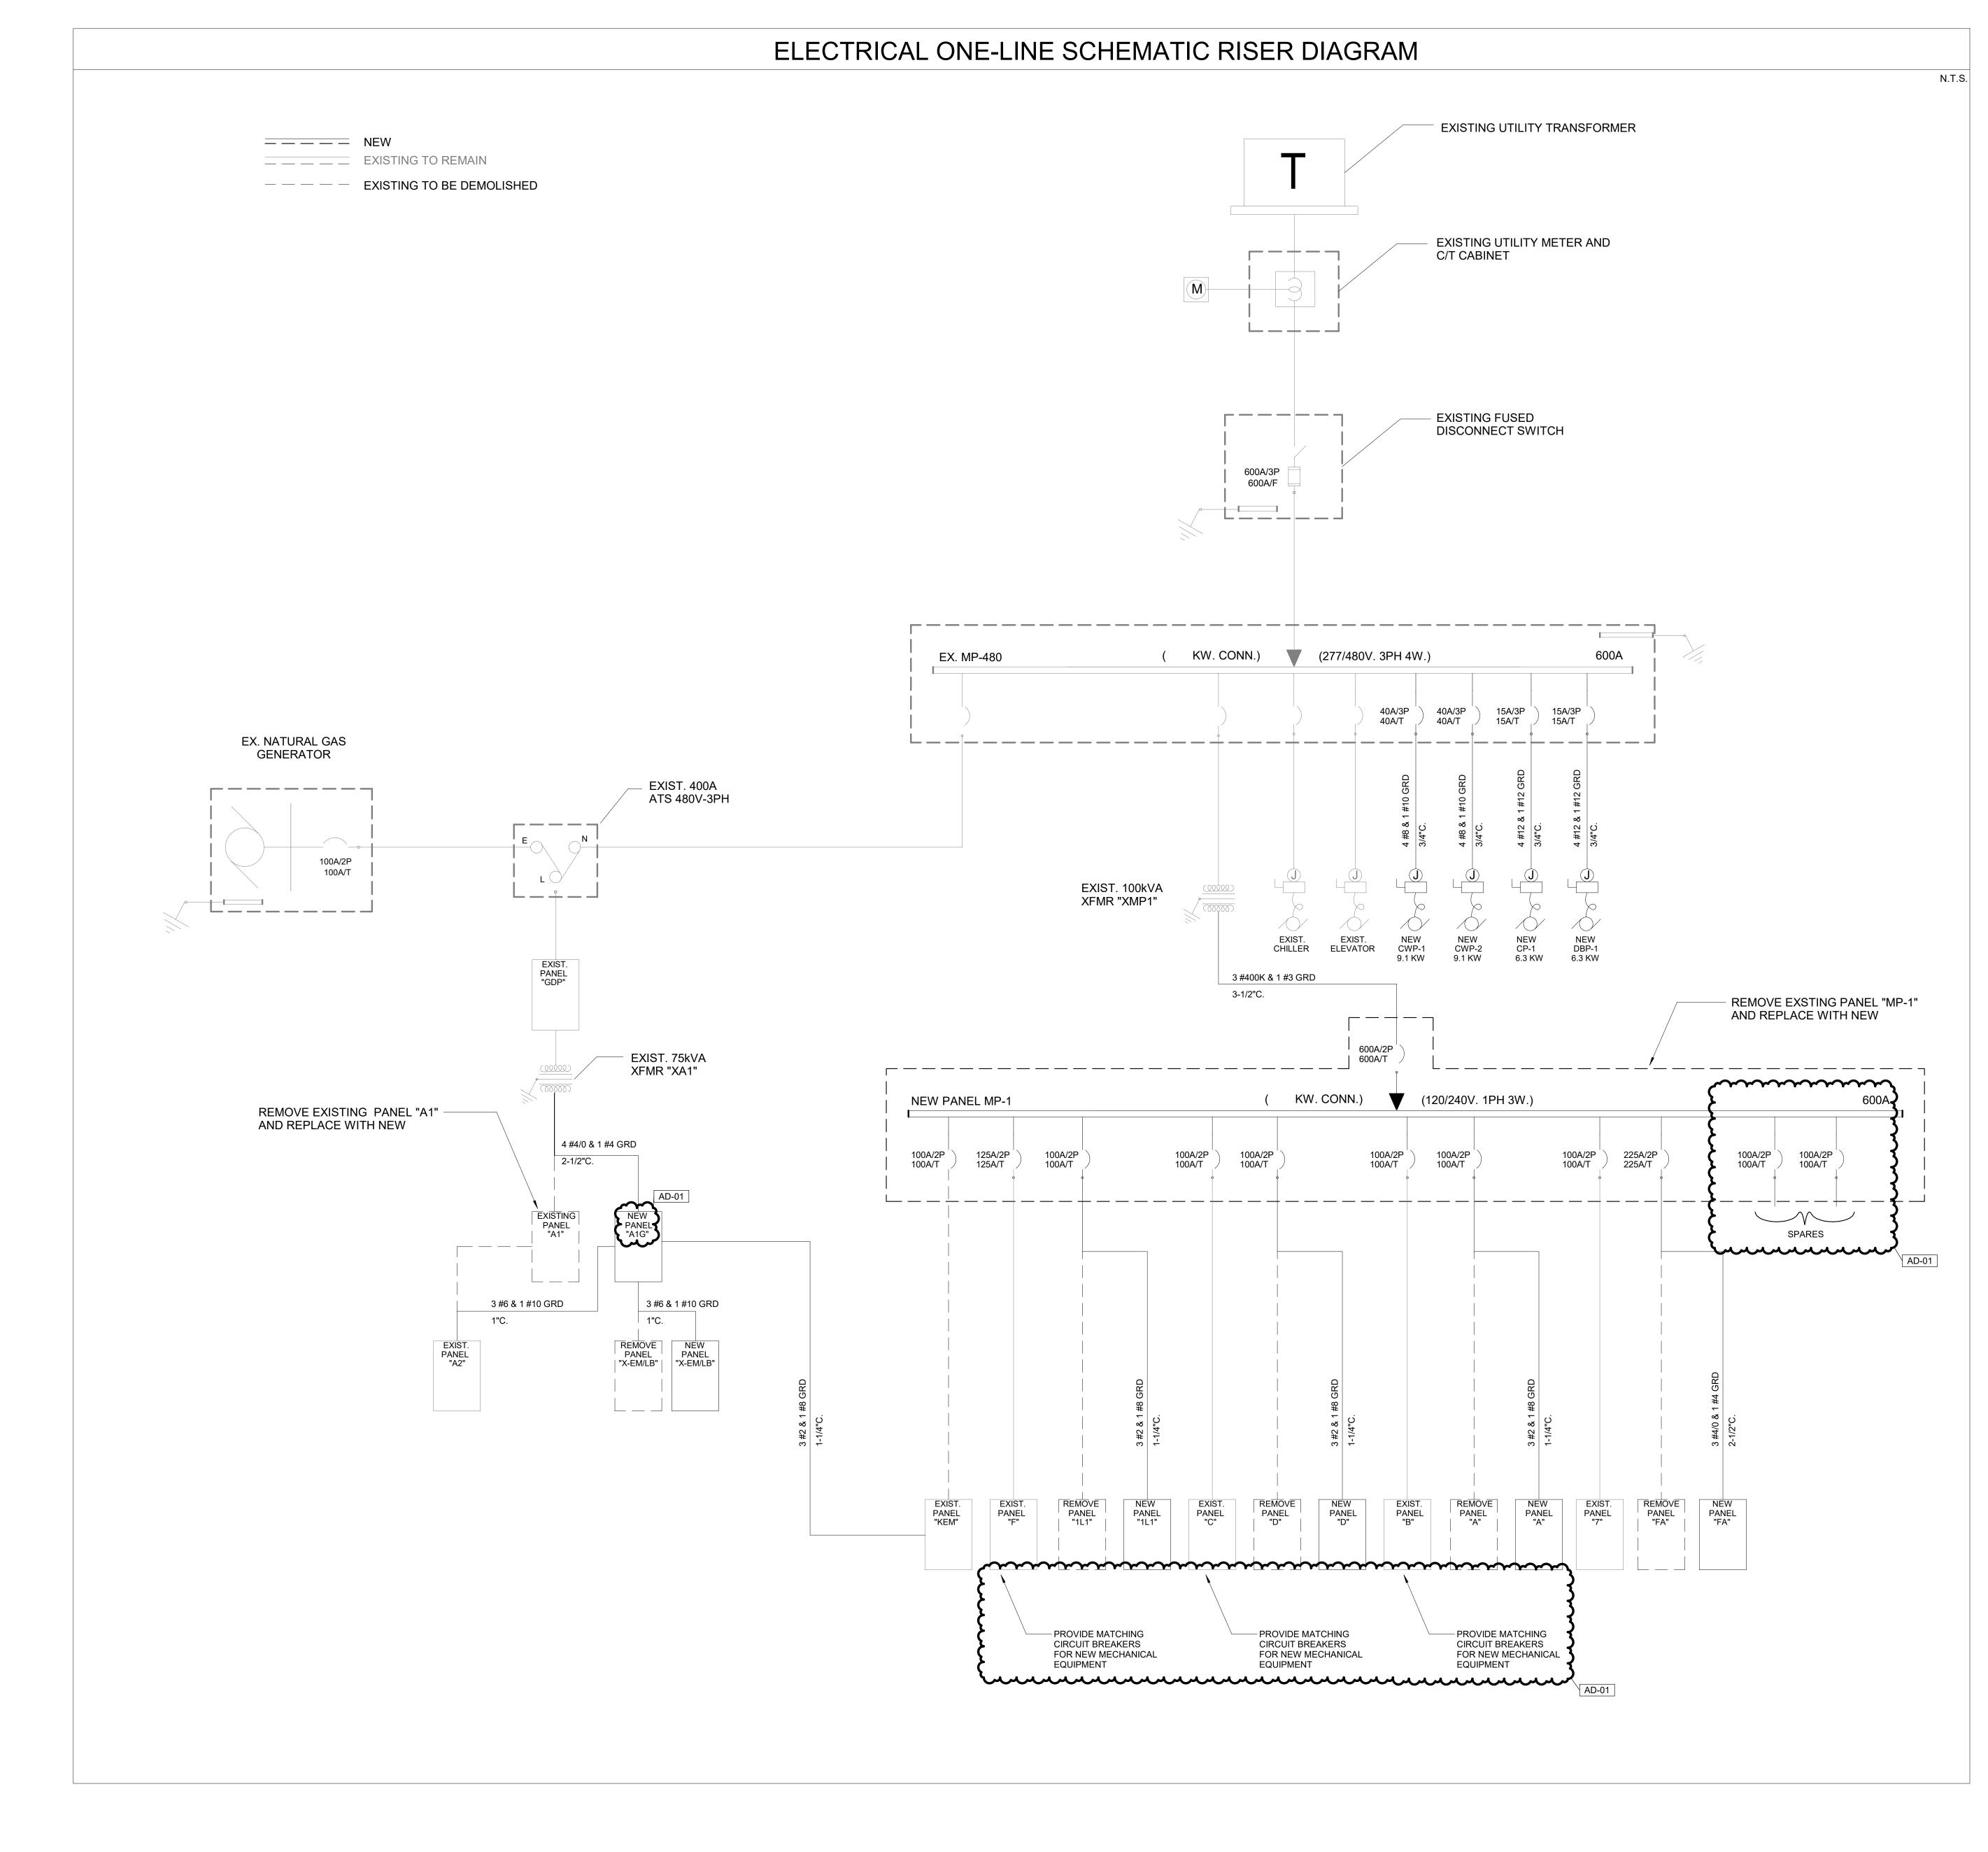



 $DESIGN \\ \text{ARCHITECTURE } \cdot \text{ENGINEERING} \cdot \text{INTERIOR DESIGN}$

MILLIES
ENGINEERING GROUP
(219) 924-8400

(219) 924-8400 www.milliesengineeringgro

FRAZEE
ELEMENTARY
SCHOOL RENOVATIONS
AND RELATED
WORK

FOR:
FAYETTE COUNTY SCHOOLS
CORPORATION
CONNERSVILLE, INDIANA

100% CONSTRUCTION DOCUMENTS

GIBRALTAR DESIGN

9102 N. Meridian St., Ste. 300
Indianapolis, IN 46260
Homepage: www.GibraltarDesign.com
Email: info@GibraltarDesign.com
Phone 317.580.5777 Fax 317.580.5778

PROJECT
23-152
DATE
05/15/24
COORDINATED BY
BK
DRAWN BY
BoK
CHECKED BY

COPYRIGHT NOTICE:

THE CONCEPTS, DESIGNS, PLANS, DETAILS, ETC, SHOWN ON THIS DOCUMENT ARE THE PROPERTY OF GIBRALTAR DESIGN AND WERE CREATED FOR USE ON THIS SPECIFIC PROJECT. NONE OF THIS INFORMATION SHALL BE USED BY ANY PERSON OR FIRM FOR ANY PURPOSE WITHOUT THE EXPRESS WRITTEN CONSENT OF GIBRALTAR DESIGN. THE OWNER MAY RETAIN COPIES FOR INFORMATION AND REFERENCE IN CONNECTION ONLY WITH THIS PROJECT.


REVISIONS

MARK DATE ISSUED FOR
AD-01 06/05/24 ADDENDUM 1

DRAWING
ELECTRICAL DETAILS &
DIAGRAMS

PROJECT
FRAZEE ELEMENTARY SCHOOL RENOVATIONS AND RELATED
WORK

E-602F

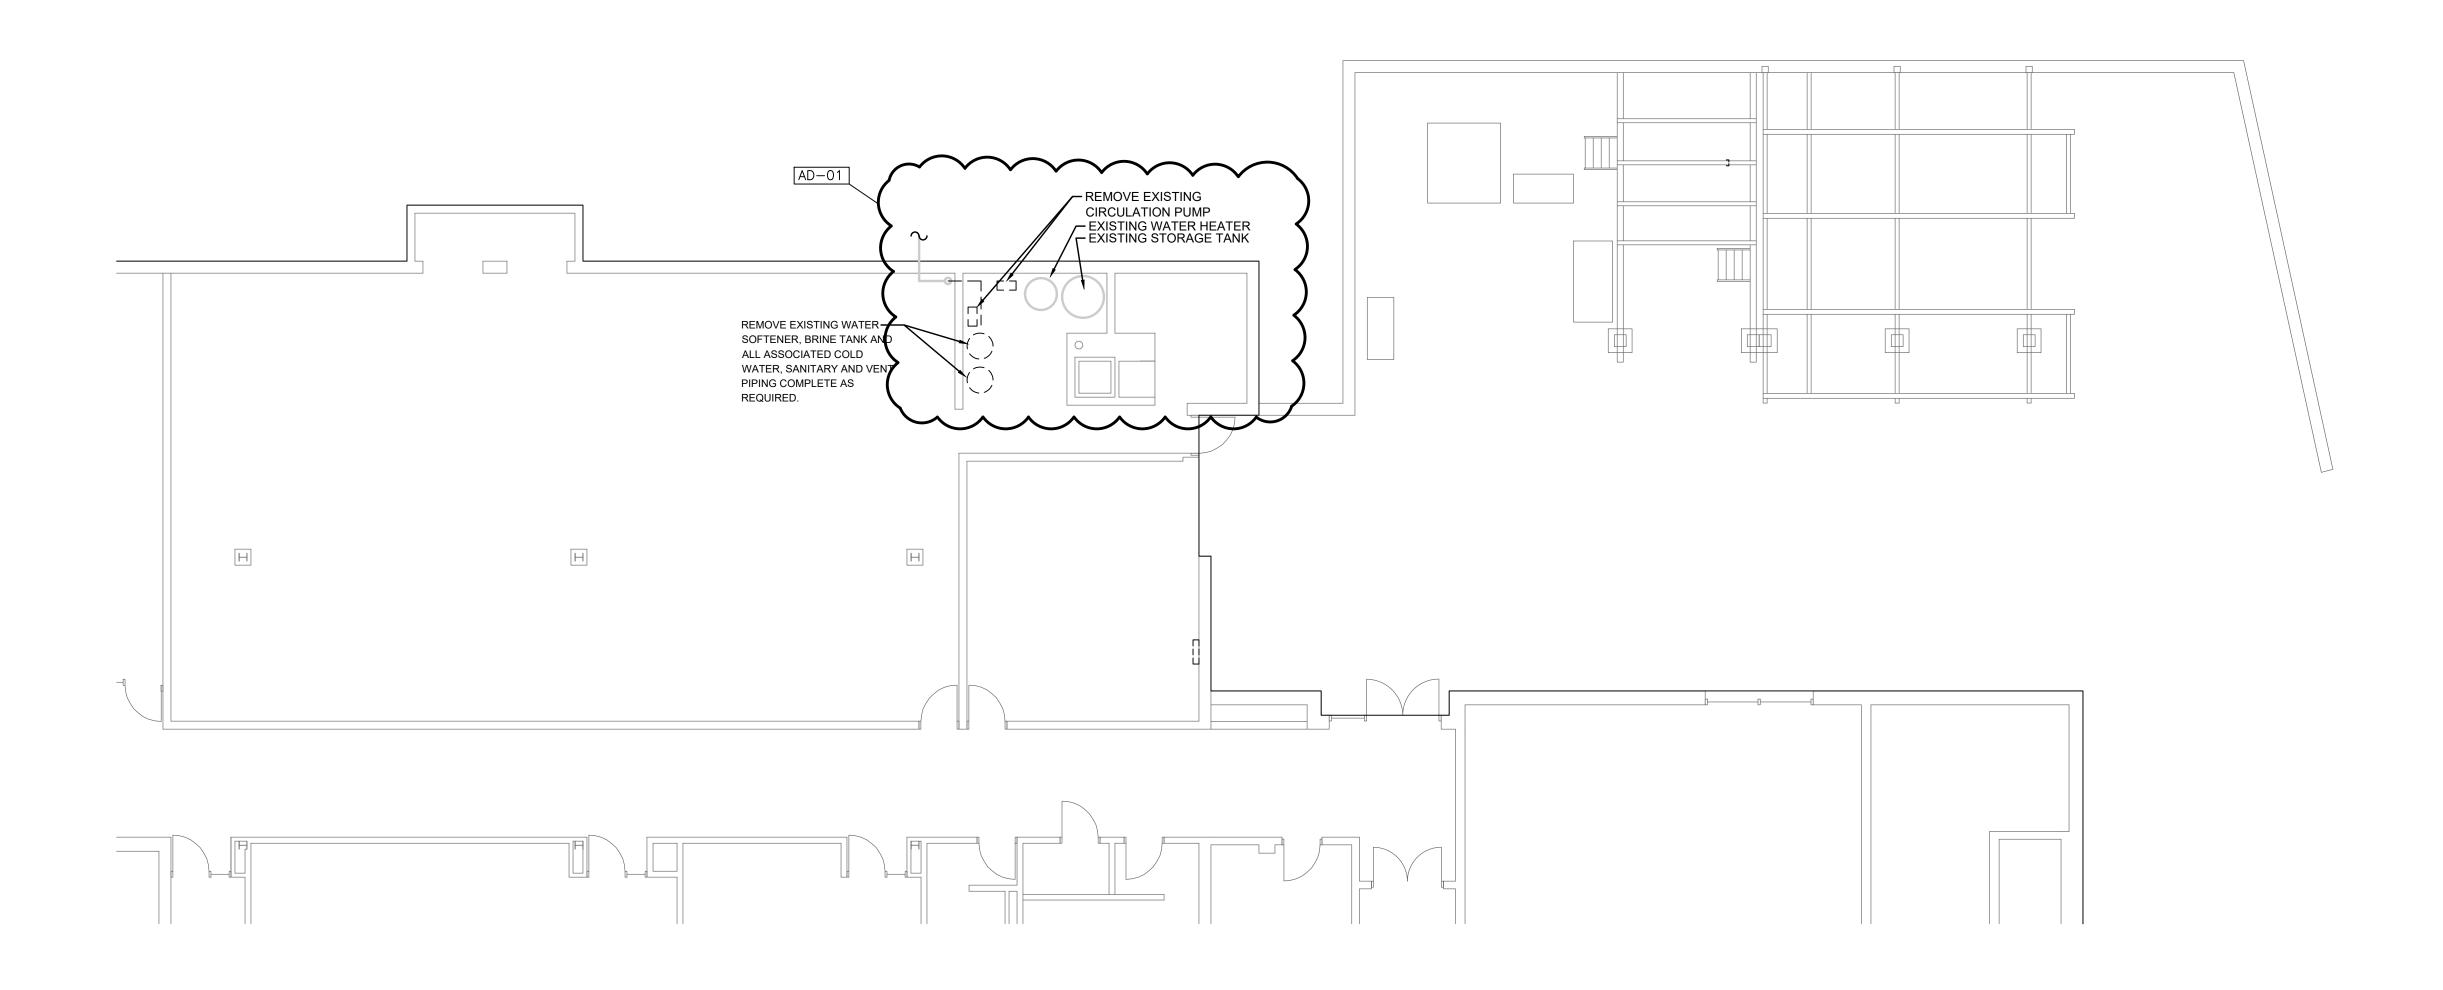

GROUND FLOOR PLUMBING DEMOLITION PLAN

SCALE: 1/8" = 1'-0"








PROJECT:

CONNERSVILLE NATATORIUM RENOVATION AND RELATED

FAYETTE COUNTY SCHOOL CORPORATION CONNERSVILLE, INDIANA

WORK

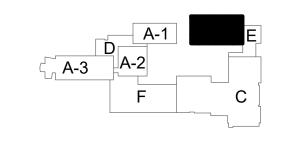


KEY PLAN



NORTH

GIBRALTAR DESIGN 9102 N. Meridian St., Ste. 300 Homepage: www.GibraltarDesign.com Email: info@GibraltarDesign.com Phone 317.580.5777 Fax 317.580.5778

COORDINATED BY DRAWN BY CHECKED BY

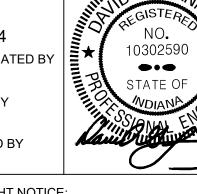

COPYRIGHT NOTICE: THE CONCEPTS, DESIGNS, PLANS, DETAILS, ETC, SHOWN ON THIS DOCUMENT ARE THE PROPERTY OF GIBRALTAR DESIGN AND WERE CREATED FOR USE ON THIS SPECIFIC PROJECT. NONE OF THIS INFORMATION SHALL BE USED BY ANY PERSON OR FIRM FOR ANY PURPOSE WITHOUT THE EXPRESS WRITTEN CONSENT OF GIBRALTAR DESIGN. THE OWNER MAY RETAIN COPIES FOR INFORMATION AND REFERENCE IN CONNECTION ONLY WITH THIS PROJECT.


REVISIONS


MARK DATE ISSUED FOR AD-01 06/05/2024 ADDENDUM 1

·	

GROUND FLOOR PLUMBING DEMOLITION

CONNERSVILLE HS NATATORIUM RENOVATION AND RELATED

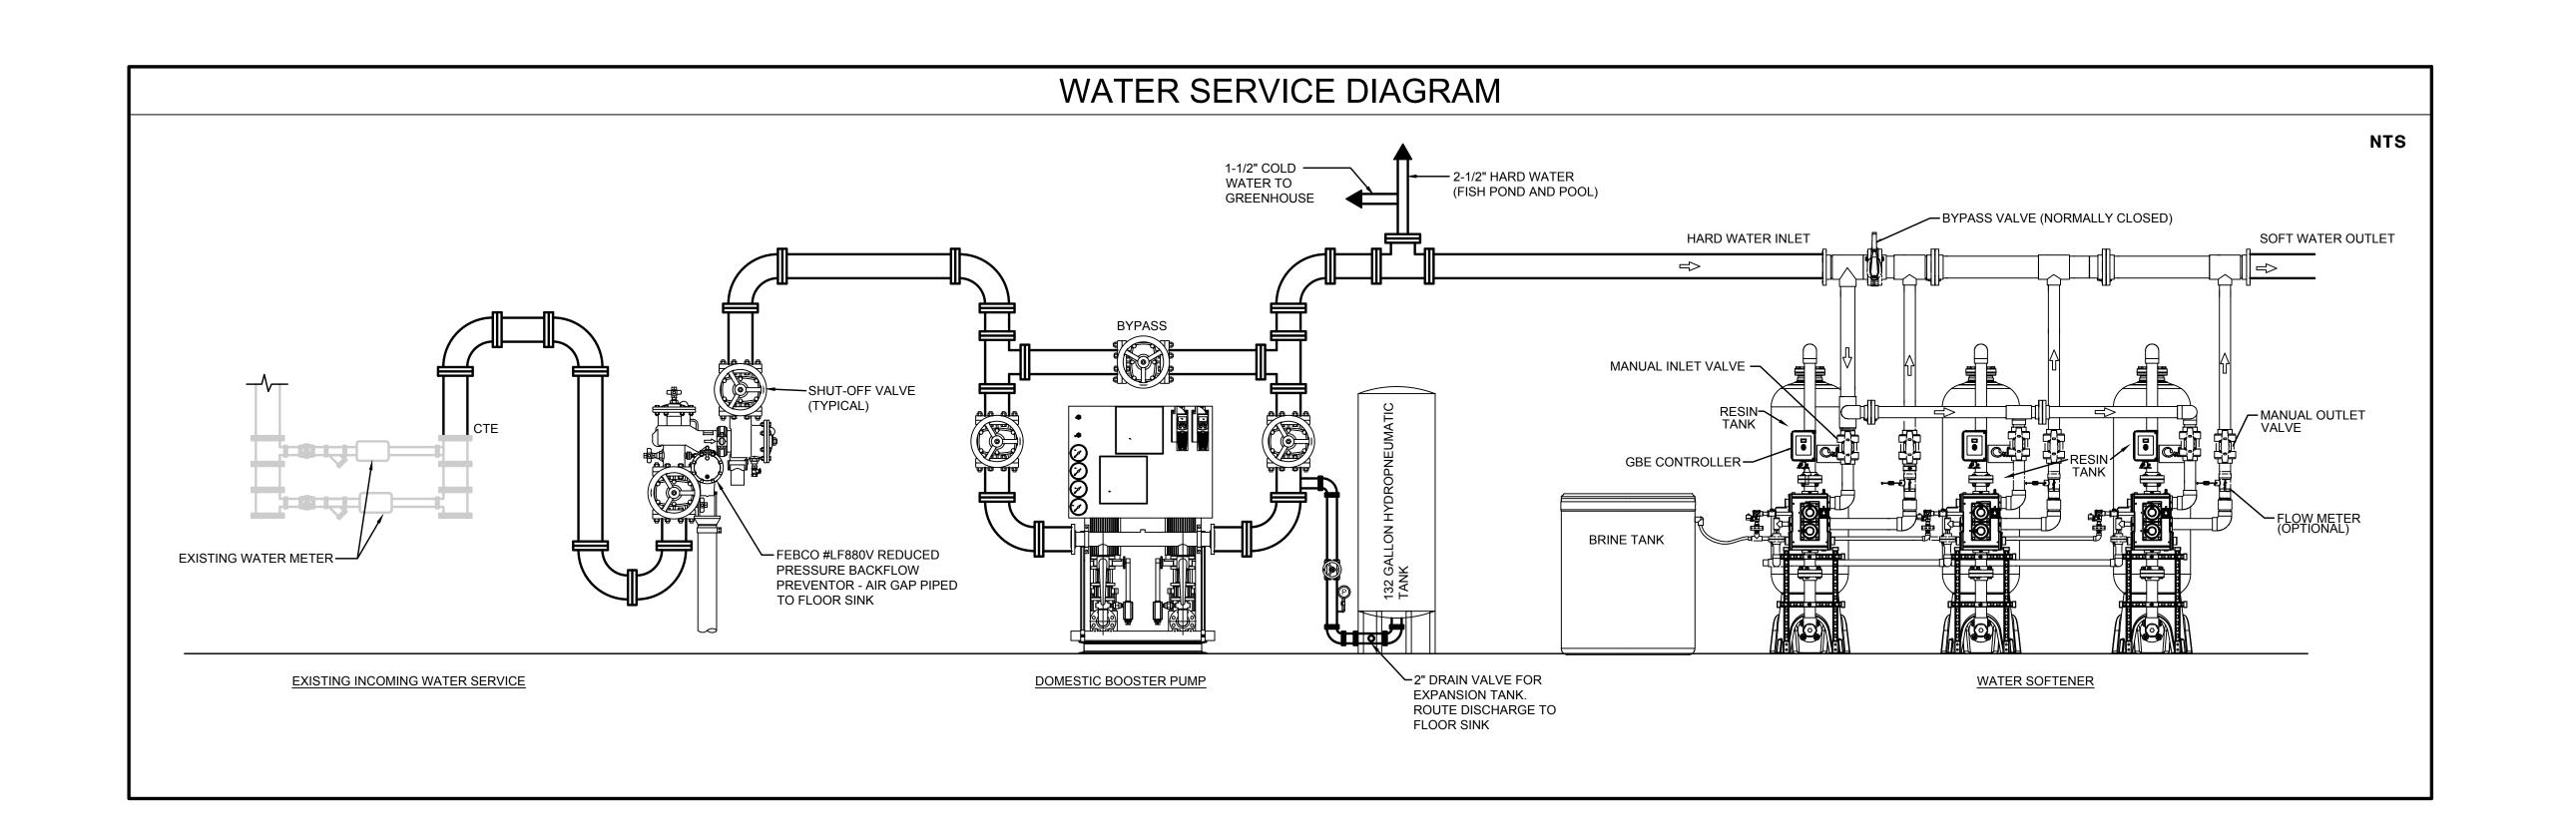

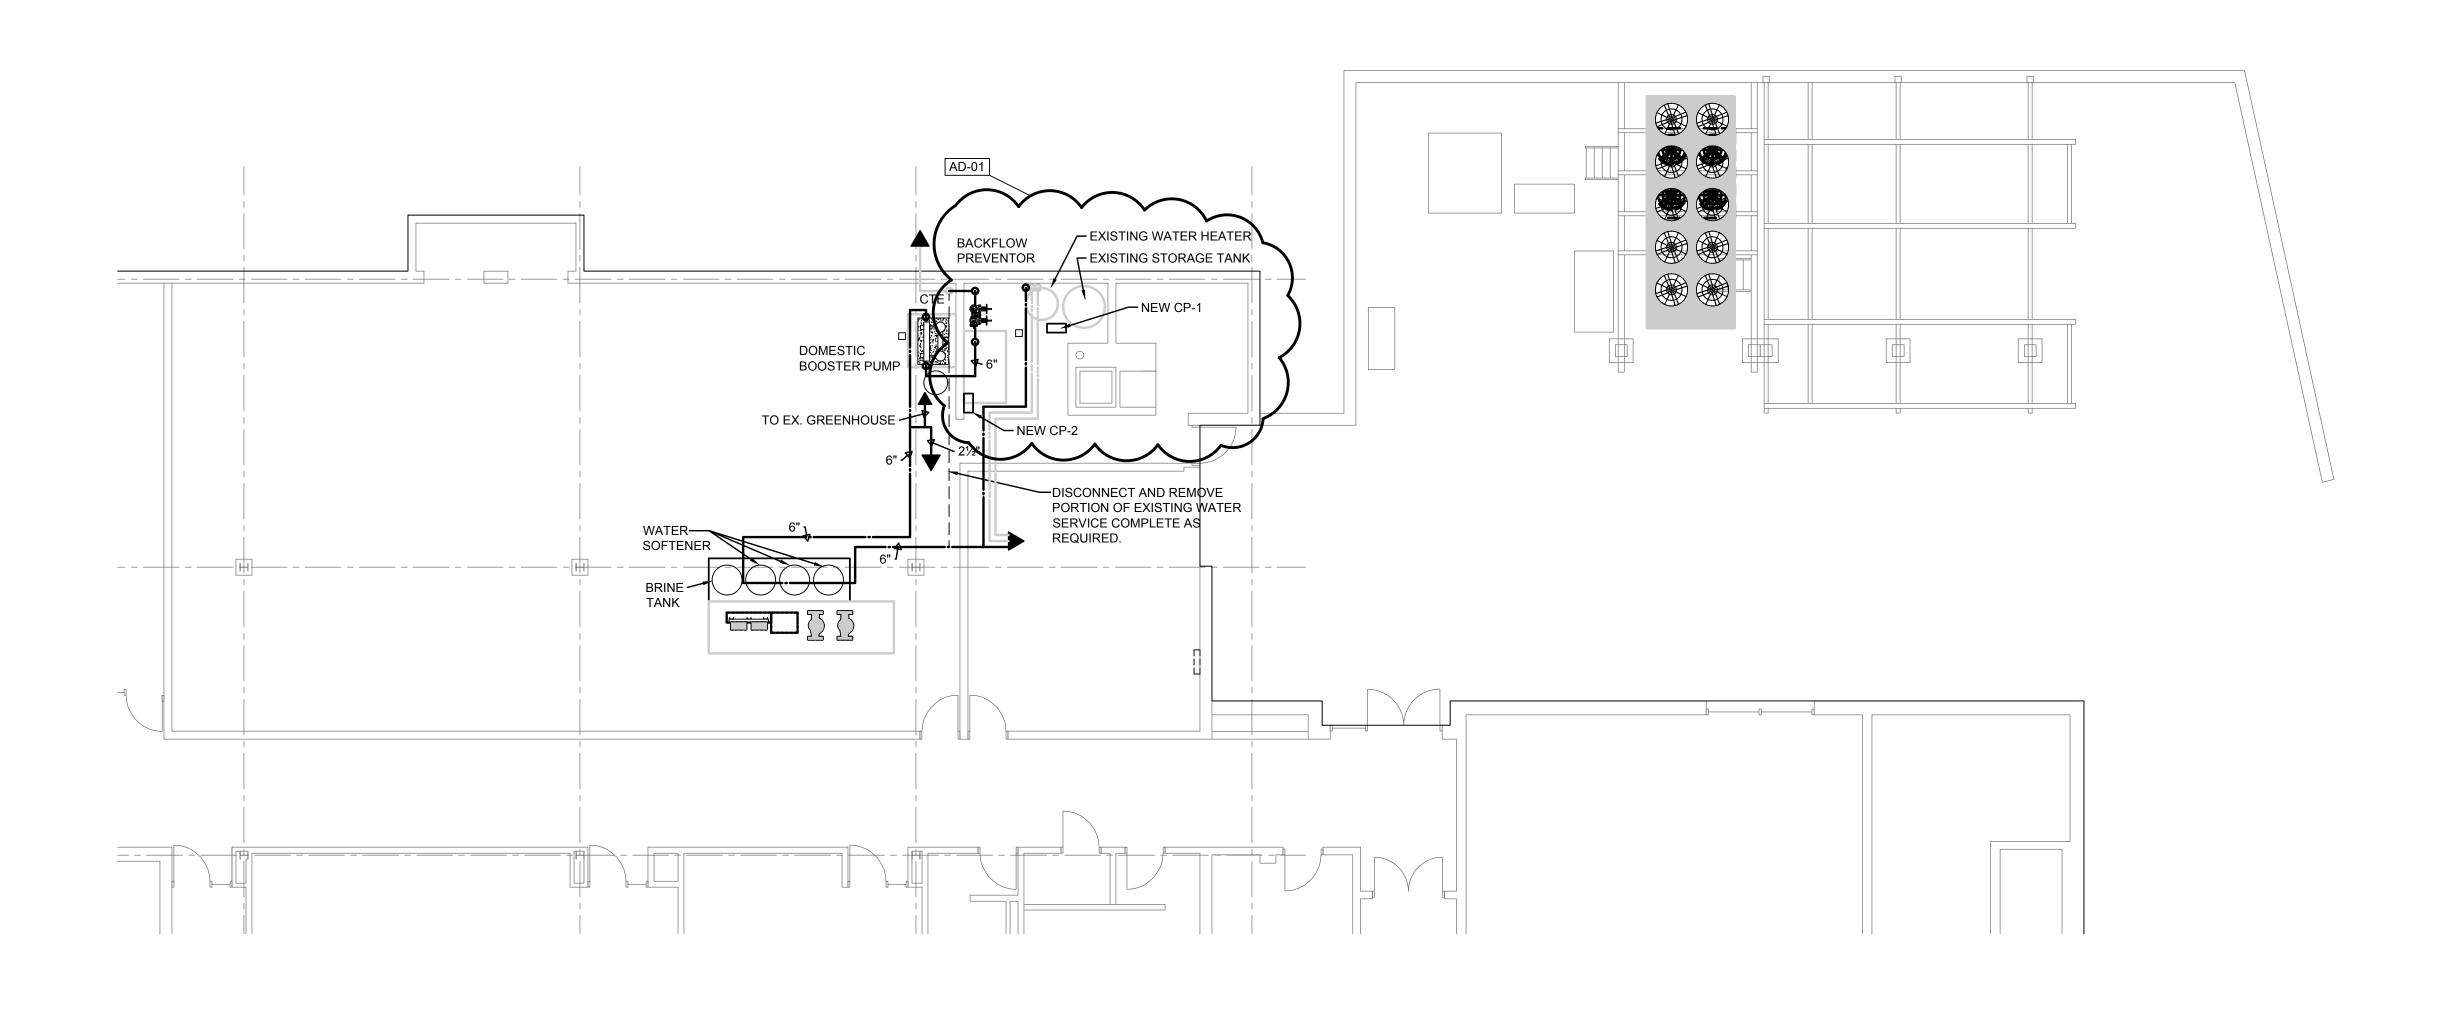

GROUND FLOOR PLUMBING PLAN

SCALE: 1/8" = 1'-0"




DESIGN ARCHITECTURE •ENGINEERING •INTERIOR DESIGN



PROJECT: CONNERSVILLE

NATATORIUM RENOVATION AND RELATED WORK

FAYETTE COUNTY SCHOOL CORPORATION CONNERSVILLE, INDIANA

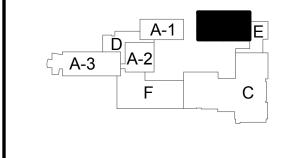


KEY PLAN



GIBRALTAR DESIGN
9102 N. Meridian St., Ste. 300 Indianapolis, IN 46260
Homepage: www.GibraltarDesign.com Email: info@GibraltarDesign.com
Phone 317.580.5777 Fax 317.580.5778

COORDINATED BY MDG

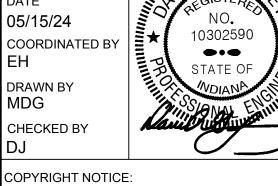


COPYRIGHT NOTICE: THE CONCEPTS, DESIGNS, PLANS, DETAILS, ETC, SHOWN ON THIS DOCUMENT ARE THE PROPERTY OF GIBRALTAR DESIGN AND WERE CREATED FOR USE ON THIS SPECIFIC PROJECT. NONE OF THIS INFORMATION SHALL BE USED BY ANY PERSON OR FIRM FOR ANY PURPOSE WITHOUT THE EXPRESS WRITTEN CONSENT OF GIBRALTAR DESIGN. THE OWNER MAY RETAIN COPIES FOR INFORMATION AND REFERENCE IN CONNECTION ONLY WITH THIS PROJECT.


REVISIONS												
MARK	DATE	ISSUED FOR										
AD-01	06/05/2024	ADDENDUM 1										


GROUND FLOOR PLUMBING PLAN


CONNERSVILLE HS NATATORIUM RENOVATION AND RELATED WORK


P-201C

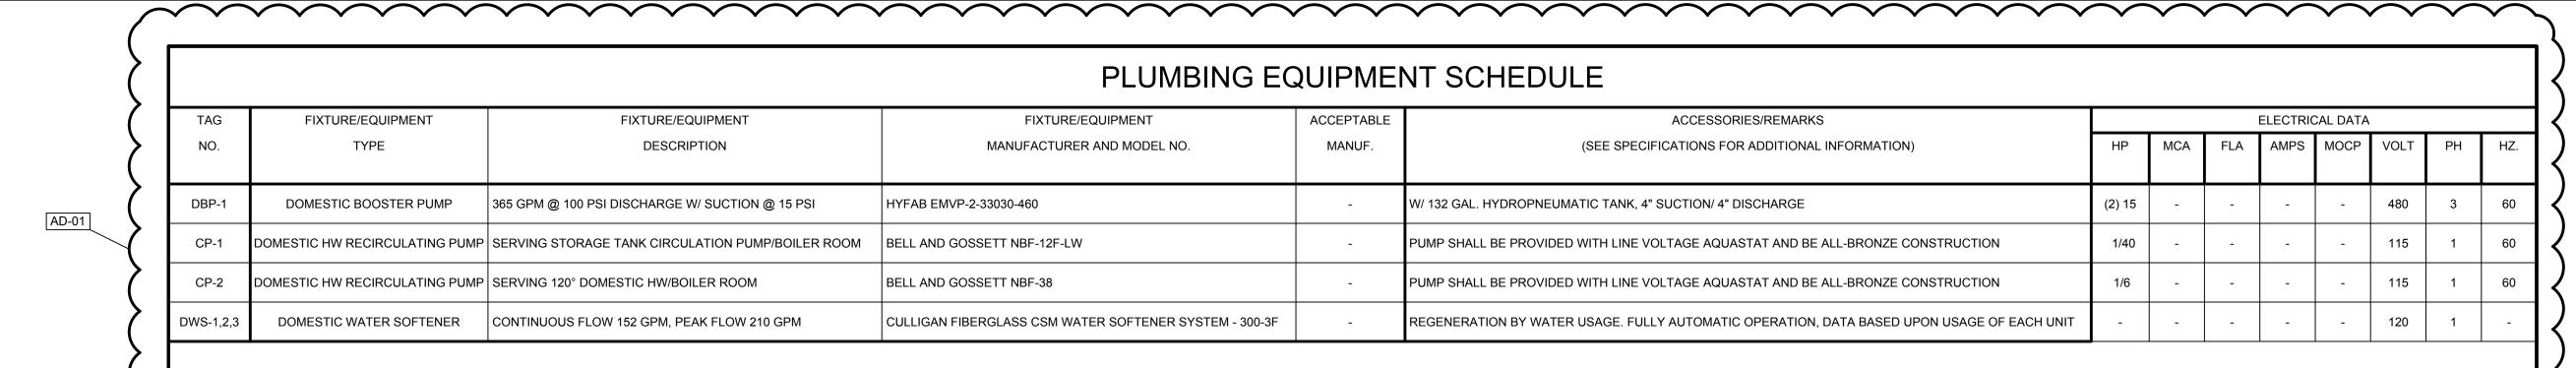


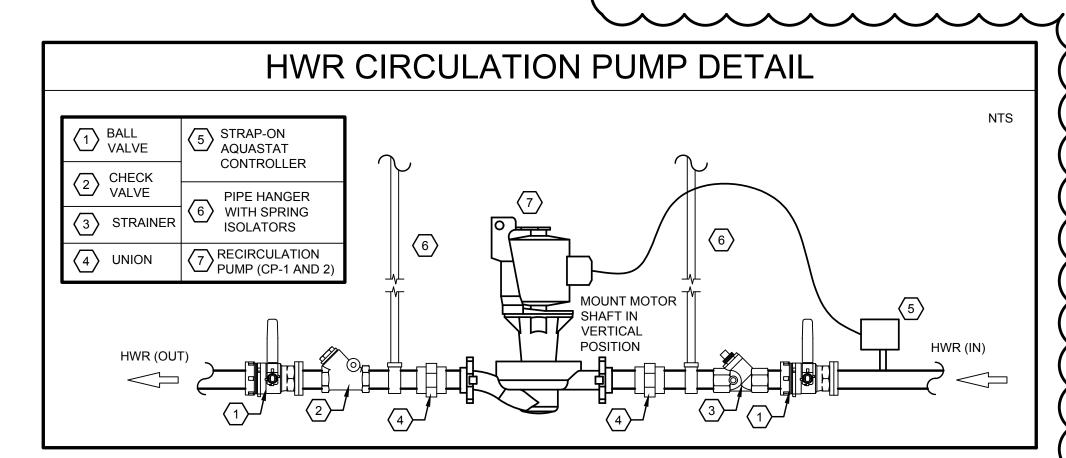

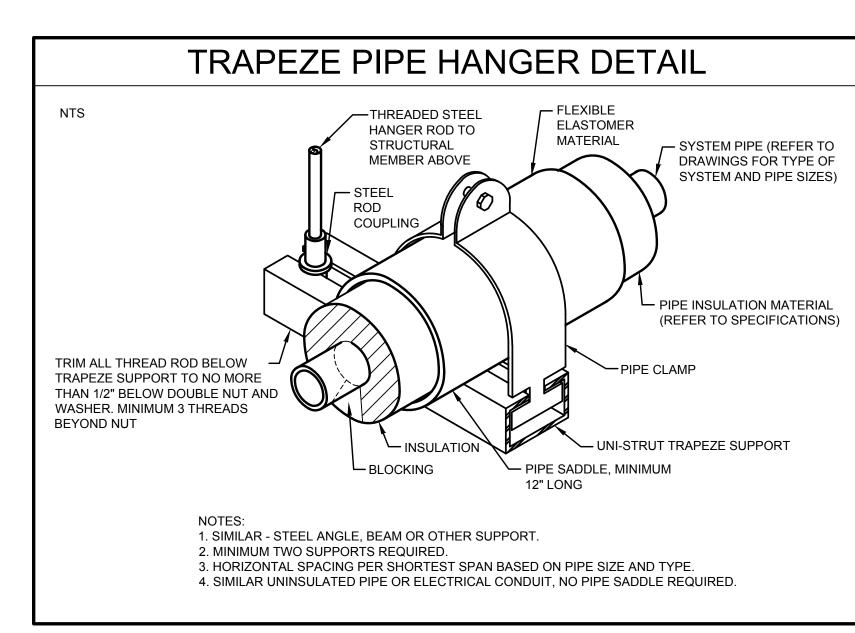

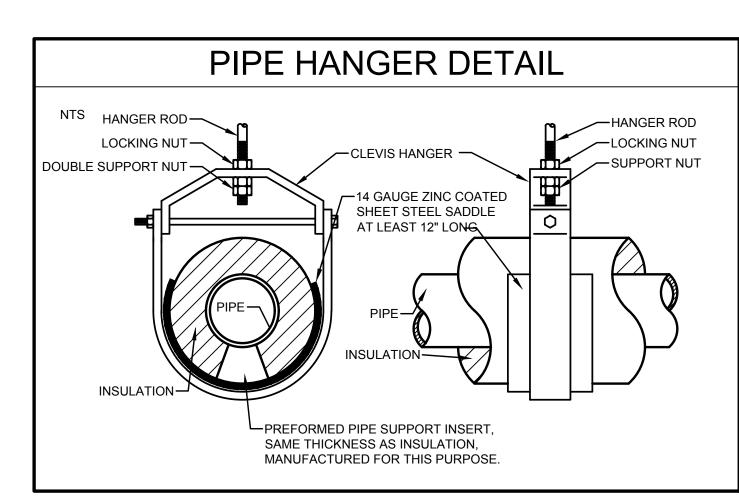

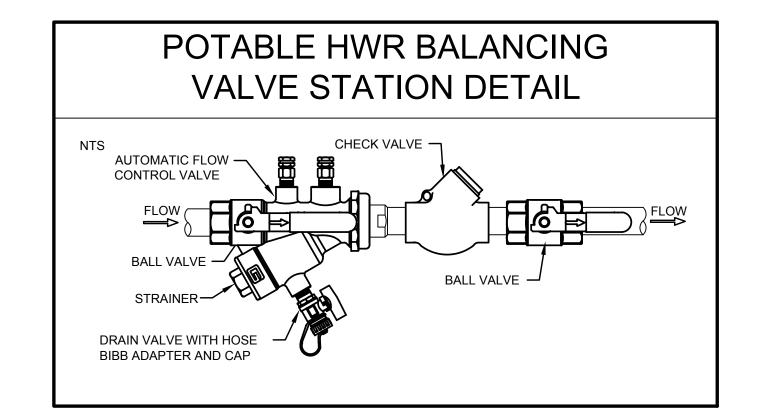

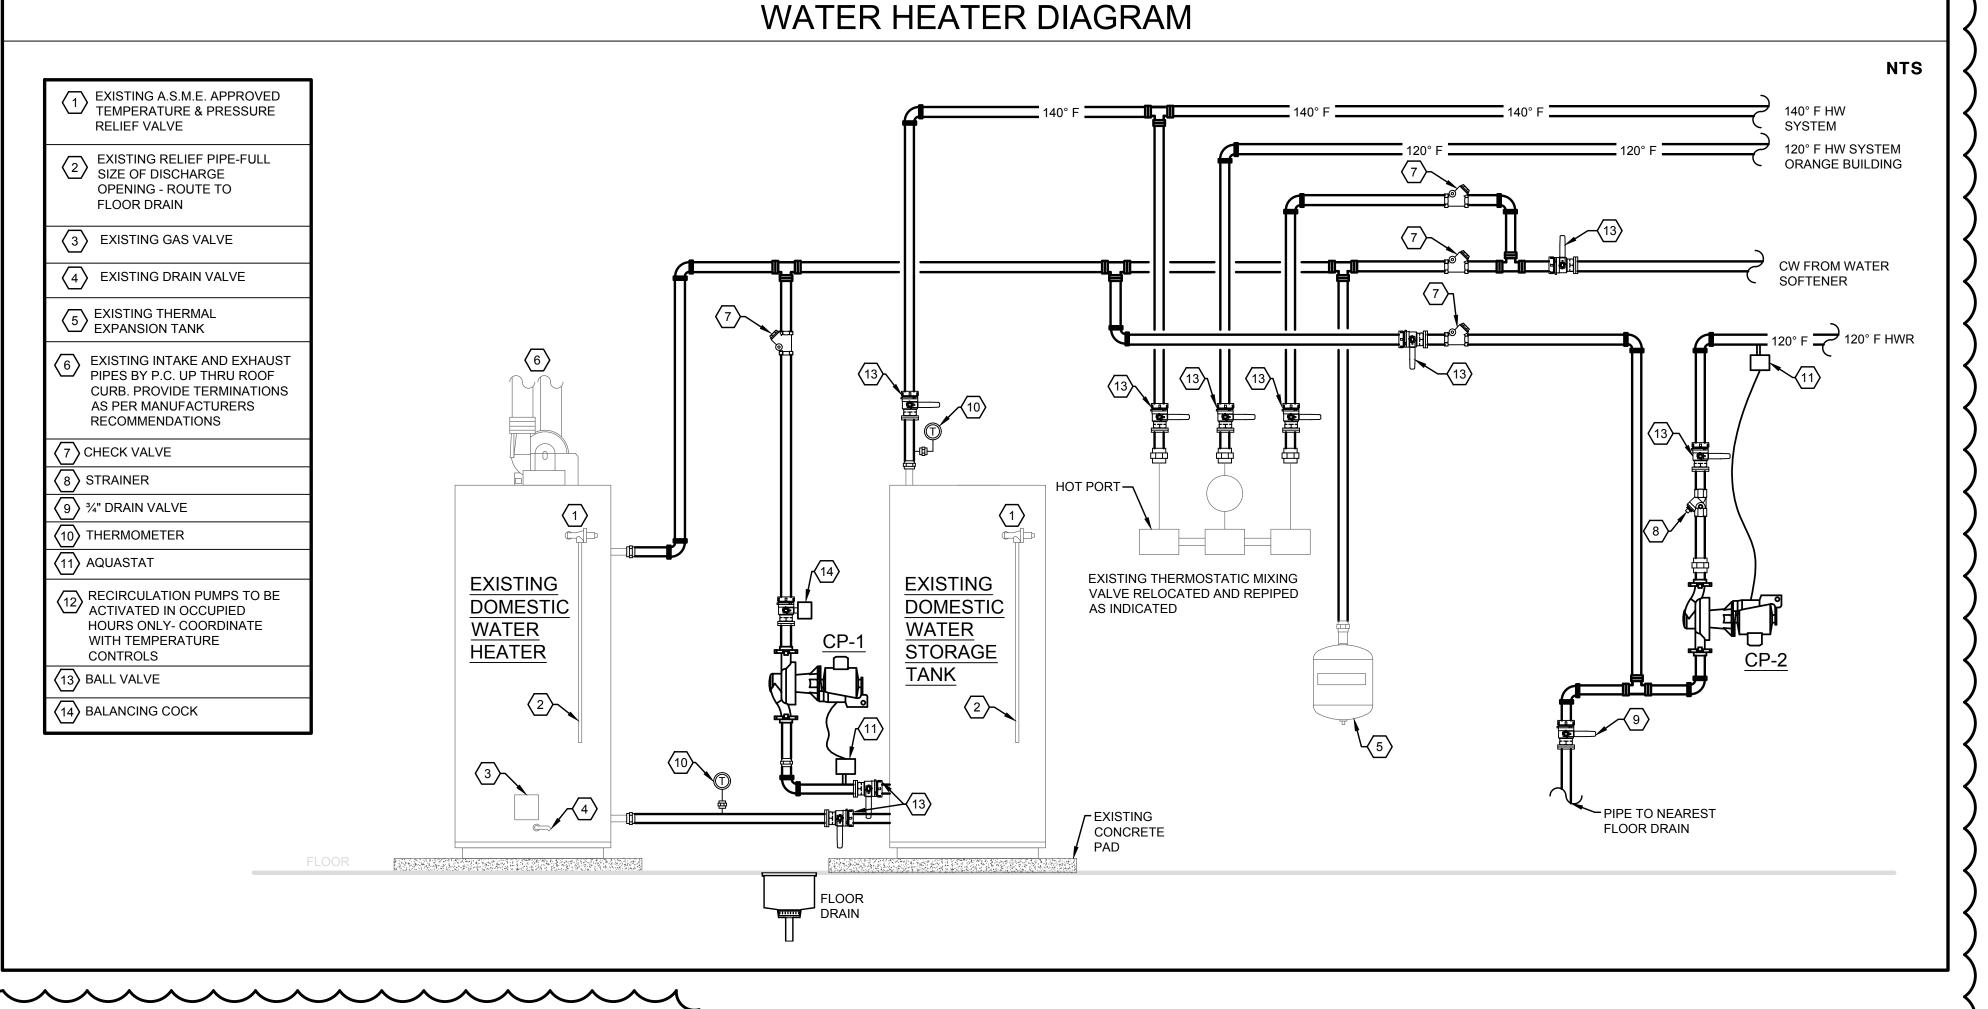

GENERAL PLUMBING NOTES

- PLUMBING CONTRACTOR IS RESPONSIBLE FOR ALL NEW WORK SHOWN ON THESE SHEETS AND IN THE SPECIFICATIONS, UNLESS OTHERWISE NOTED.
- PLUMBING CONTRACTOR SHALL FIELD VERIFY ALL EXISTING CONDITIONS PRIOR TO BID AND MODIFY WORK AS REQUIRED FOR ANY VARIATIONS OR DEVIATIONS FROM THOSE SHOWN ON THESE SHEETS.
- LINES IS EXISTING TO REMAIN CONDITIONS AND SHOULD BE USED FOR REFERENCE ONLY, AND MAY INDICATE NONEXISTENT OR INACCURATE CONDITIONS.

 4. ALL EQUIPMENT, DUCTWORK AND PIPING SHOWN WITH THICK DASHED LINES IS EXISTING TO BE

ALL WALLS, LIGHTS, EQUIPMENT, DUCTWORK, PIPING, ETC. SHOWN WITH THIN DOTTED OR SOLID

- REMOVED OR RELOCATED.
- 5. ALL EQUIPMENT, DUCTWORK AND PIPING SHOWN WITH THICK SOLID LINES IS NEW WORK.
- . REFER TO ARCHITECTURAL, STRUCTURAL, MECHANICAL AND ELECTRICAL SHEETS TO COORDINATE ALL WORK.

FIXTURES, JOISTS, BEAMS, ETC.


8. PROVIDE CEILING ACCESS PANELS FOR ACCESS TO SHUT-OFF VALVES, CONTROL VALVES, DRAIN VALVES, EQUIPMENT, ETC. LOCATED ABOVE NON-ACCESSIBLE CEILINGS (INCLUDES ALL EXISTING ITEMS REQUIRING ACCESS WHERE NEW NON-ACCESSIBLE CEILINGS OCCUR). COORDINATE ALL ACCESS PANELS WITH ARCHITECT.

ALL PLUMBING PIPING LOCATED ABOVE CEILINGS SHALL BE PLACED TO AVOID DUCTWORK, LIGHT

- 9. PLUMBING CONTRACTOR SHALL CORE DRILL HOLES THROUGH FLOORS, WALLS, DECKS, ETC. WHERE PASSAGE IS NOT AVAILABLE TO INSTALL NEW PIPING. PROVIDE PIPE SLEEVES AND PROPERLY SEAL ALL PIPE PENETRATIONS AS REQUIRED. REFER TO SPECIFICATIONS.
- 0. ALL DOMESTIC WATER PIPING HEADERS LOCATED IN PIPE CHASES SHALL BE SAME SIZE AS PIPE MAIN DROPS INTO CHASES, UNLESS OTHERWISE NOTED.
- 1. ALL DOMESTIC, BRANCH PIPING SHOWN WITHOUT SIZE INDICATED, SHALL BE A MINIMUM OF 3/4".
- 2. WATER HAMMER ARRESTORS SHALL BE SIZED AND INSTALLED PER PLUMBING AND DRAINAGE INSTITUTE (STANDARD PDI-WH 20), REQUIREMENTS IN ACCESSIBLE LOCATIONS ON THE COLD

WATER PIPING, AND WHERE FLUSH VALVES AND ANY OTHER QUICK CLOSING VALVES ARE USED

3. PLUMBING CONTRACTOR SHALL PROVIDE AND INSTALL VALVES IN ALL PIPING AS REQUIRED TO FACILITATE OPERATION OF VARIOUS SYSTEMS DURING CONSTRUCTION.

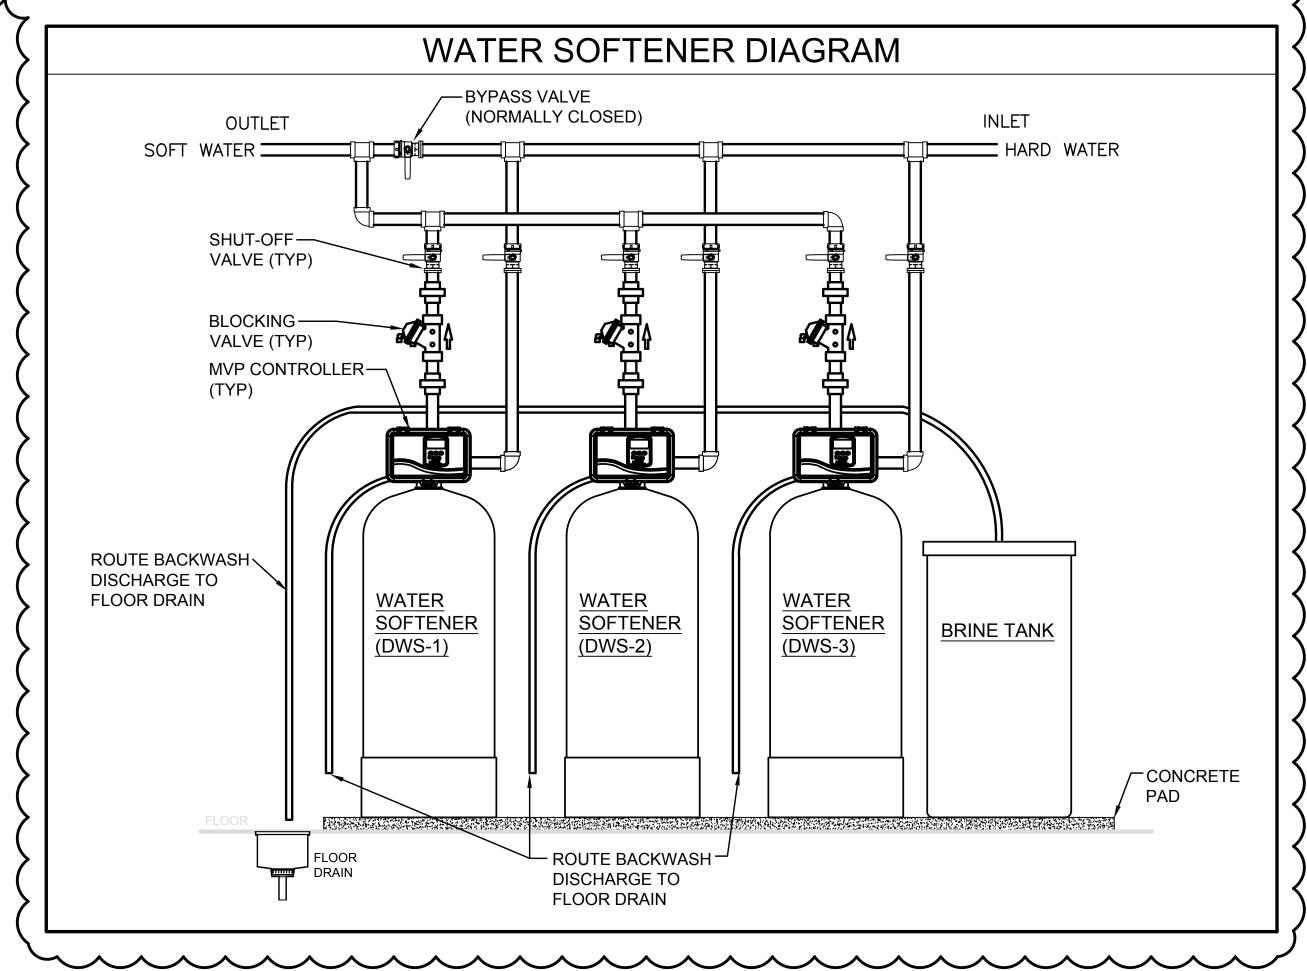



DESIGN

ARCHITECTURE • FINGINEERING • INTERIOR DESIGN

MILLIES
ENGINEERING GROUP
(219) 924-8400

PROJECT:

CONNERSVILLE
HS
NATATORIUM
RENOVATION
AND RELATED

FOR:
FAYETTE COUNTY SCHOOL
CORPORATION

CONNERSVILLE, INDIANA

WORK

100% CONSTRUCTION DOCUMENTS

GIBRALTAR DESIGN

9102 N. Meridian St., Ste. 300
Indianapolis, IN 46260
Homepage: www.GibraltarDesign.com
Email: info@GibraltarDesign.com
Phone 317.580.5777 Fax 317.580.5778

23-154

DATE
05/15/24

COORDINATED BY
EH

DRAWN BY
MDG
CHECKED BY

DINATED BY

STATE OF

STAT

COPYRIGHT NOTICE:

THE CONCEPTS, DESIGNS, PLANS, DETAILS, ETC, SHOWN ON THIS DOCUMENT ARE THE PROPERTY OF GIBRALTAR DESIGN AND WERE CREATED FOR USE ON THIS SPECIFIC PROJECT. NONE OF THIS INFORMATION SHALL BE USED BY ANY PERSON OR FIRM FOR ANY PURPOSE WITHOUT THE EXPRESS WRITTEN CONSENT OF GIBRALTAR DESIGN. THE OWNER MAY RETAIN COPIES FOR INFORMATION AND REFERENCE IN CONNECTION ONLY WITH THIS PROJECT.

REVISIONS

MARK DATE ISSUED FOR
AD-01 06/05/2024 ADDENDUM 1

DRAWING
PLUMBING SYMBOLS,


SCHEDULES AND GENERAL NOTES

PROJECT
CONNERSVILLE HS NATATORIUM
RENOVATION AND RELATED
WORK

SHEET

P-501C

Convigant © 2004 Millies Engineering Group

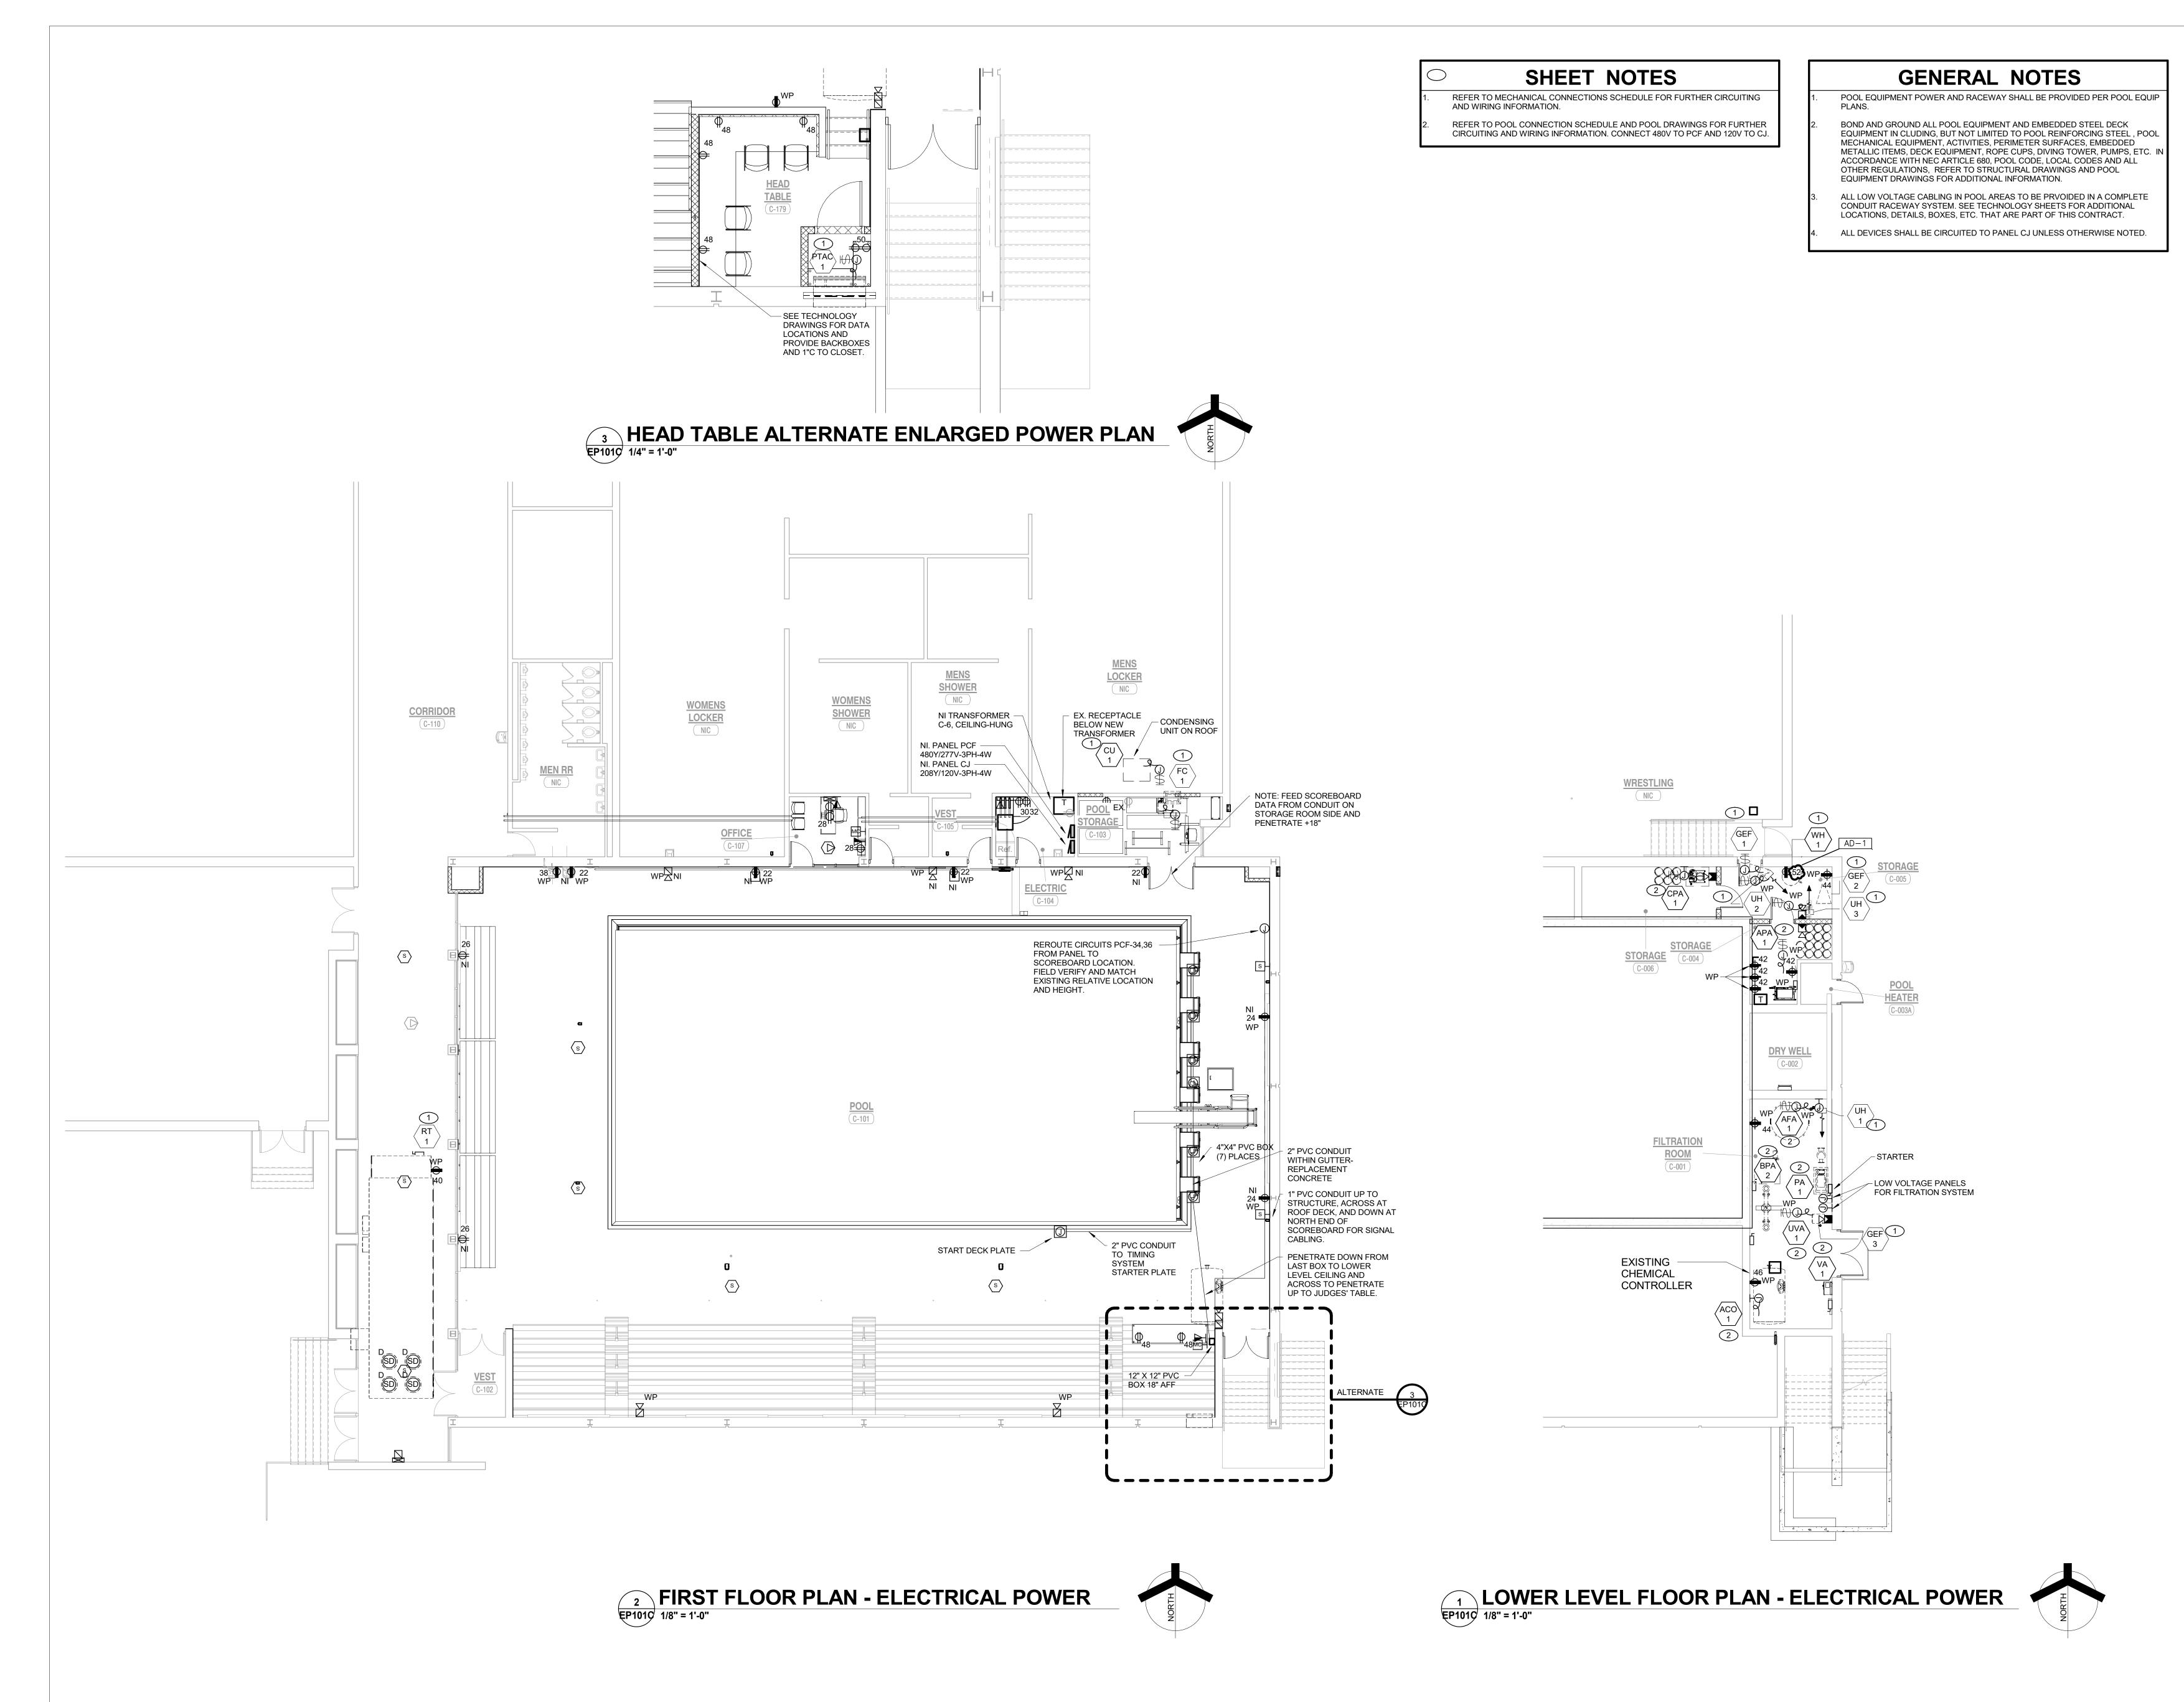

DESIGN


ADDITION OF THE PROPERTY OF THE PROPER

ARCHITECTURE • ENGINEERING • INTERIOR DESIGN

PROJECT:

CONNERSVILLE
HS
NATATORIUM
RENOVATION
AND RELATED
WORK

FOR:
FAYETTE COUNTY SCHOOL
CORPORATION
CONNERSVILLE, INDIANA

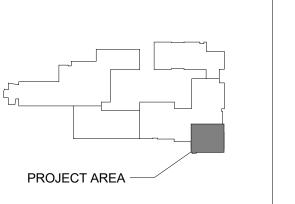

100%

CONSTRUCTION DOCUMENTS


GIBRALTAR DESIGN
9102 N. Meridian St., Ste. 300

Indianapolis, IN 46260
Homepage: www.GibraltarDesign.com
Email: info@GibraltarDesign.com
Phone 317.580.5777 Fax 317.580.5778

PROJECT
23-154
DATE

23-154
DATE
05/15/24
COORDINATED BY
BK
DRAWN BY
MH
CHECKED BY

KEY PLAN

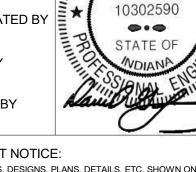

COPYRIGHT NOTICE:
THE CONCEPTS, DESIGNS, PLANS, DETAILS, ETC, SHOWN ON THIS DOCUMENT ARE THE PROPERTY OF GIBRALTAR DESIGN AND WERE CREATED FOR USE ON THIS SPECIFIC PROJECT. NONE OF THIS INFORMATION SHALL BE USED BY ANY PERSON OR FIRM FOR ANY PURPOSE WITHOUT THE EXPRESS WRITTEN CONSENT OF GIBRALTAR DESIGN. THE OWNER MAY RETAIN COPIES FOR INFORMATION AND REFERENCE IN CONNECTION ONLY WITH THIS PROJECT.

REVISIONS


MARK DATE ISSUED FOR

AD-01	06/05/2024	ADDENDUM 1
		· · · · · · · · · · · · · · · · · · ·

DRAWING
LOWER LEVEL FLOOR
PLAN - ELECTRICAL
POWER


PROJECT
CONNERSVILLE HS NATATORIUM
RENOVATION AND RELATED
WORK

EP101C

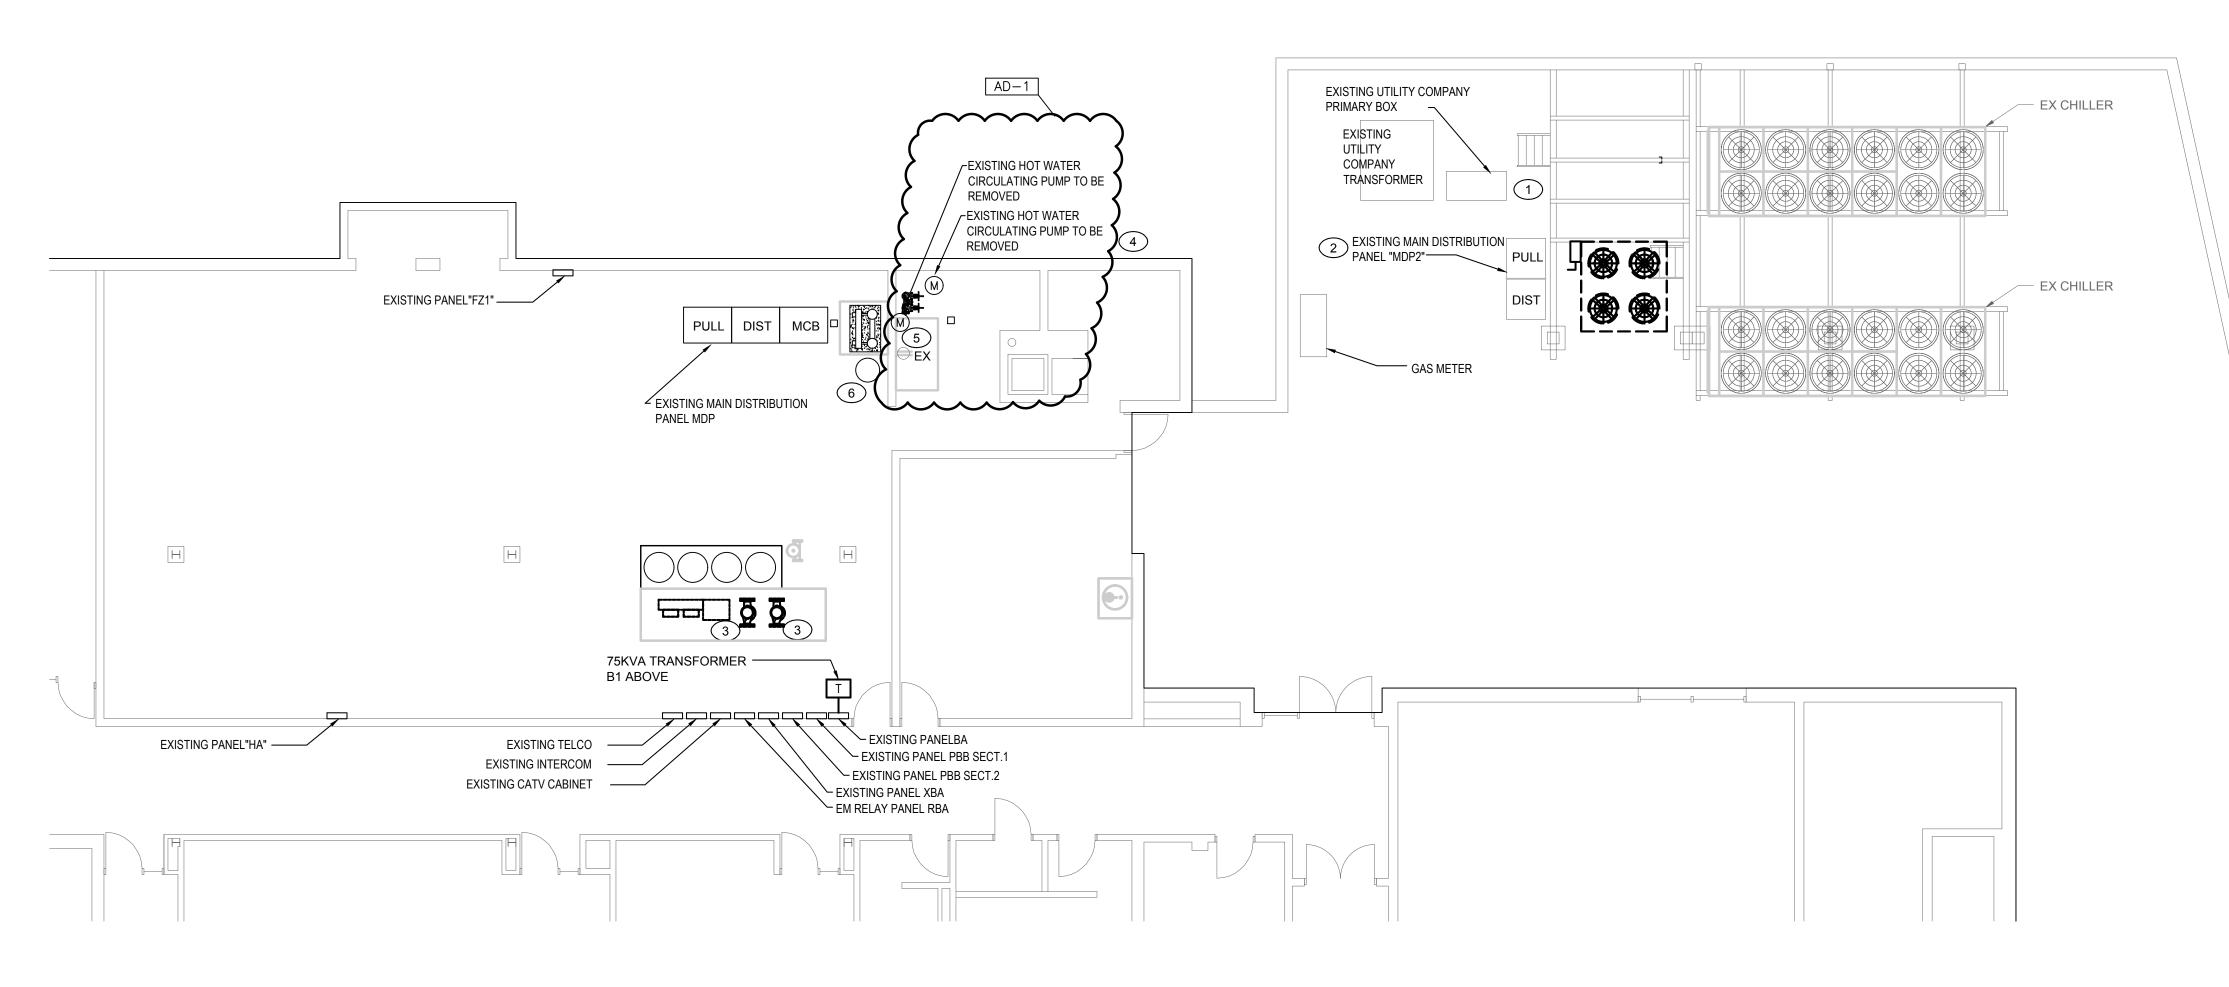

GROUND FLOOR ELECTRICAL DEMOLITION PLAN

SCALE: 1/8" = 1'-0"

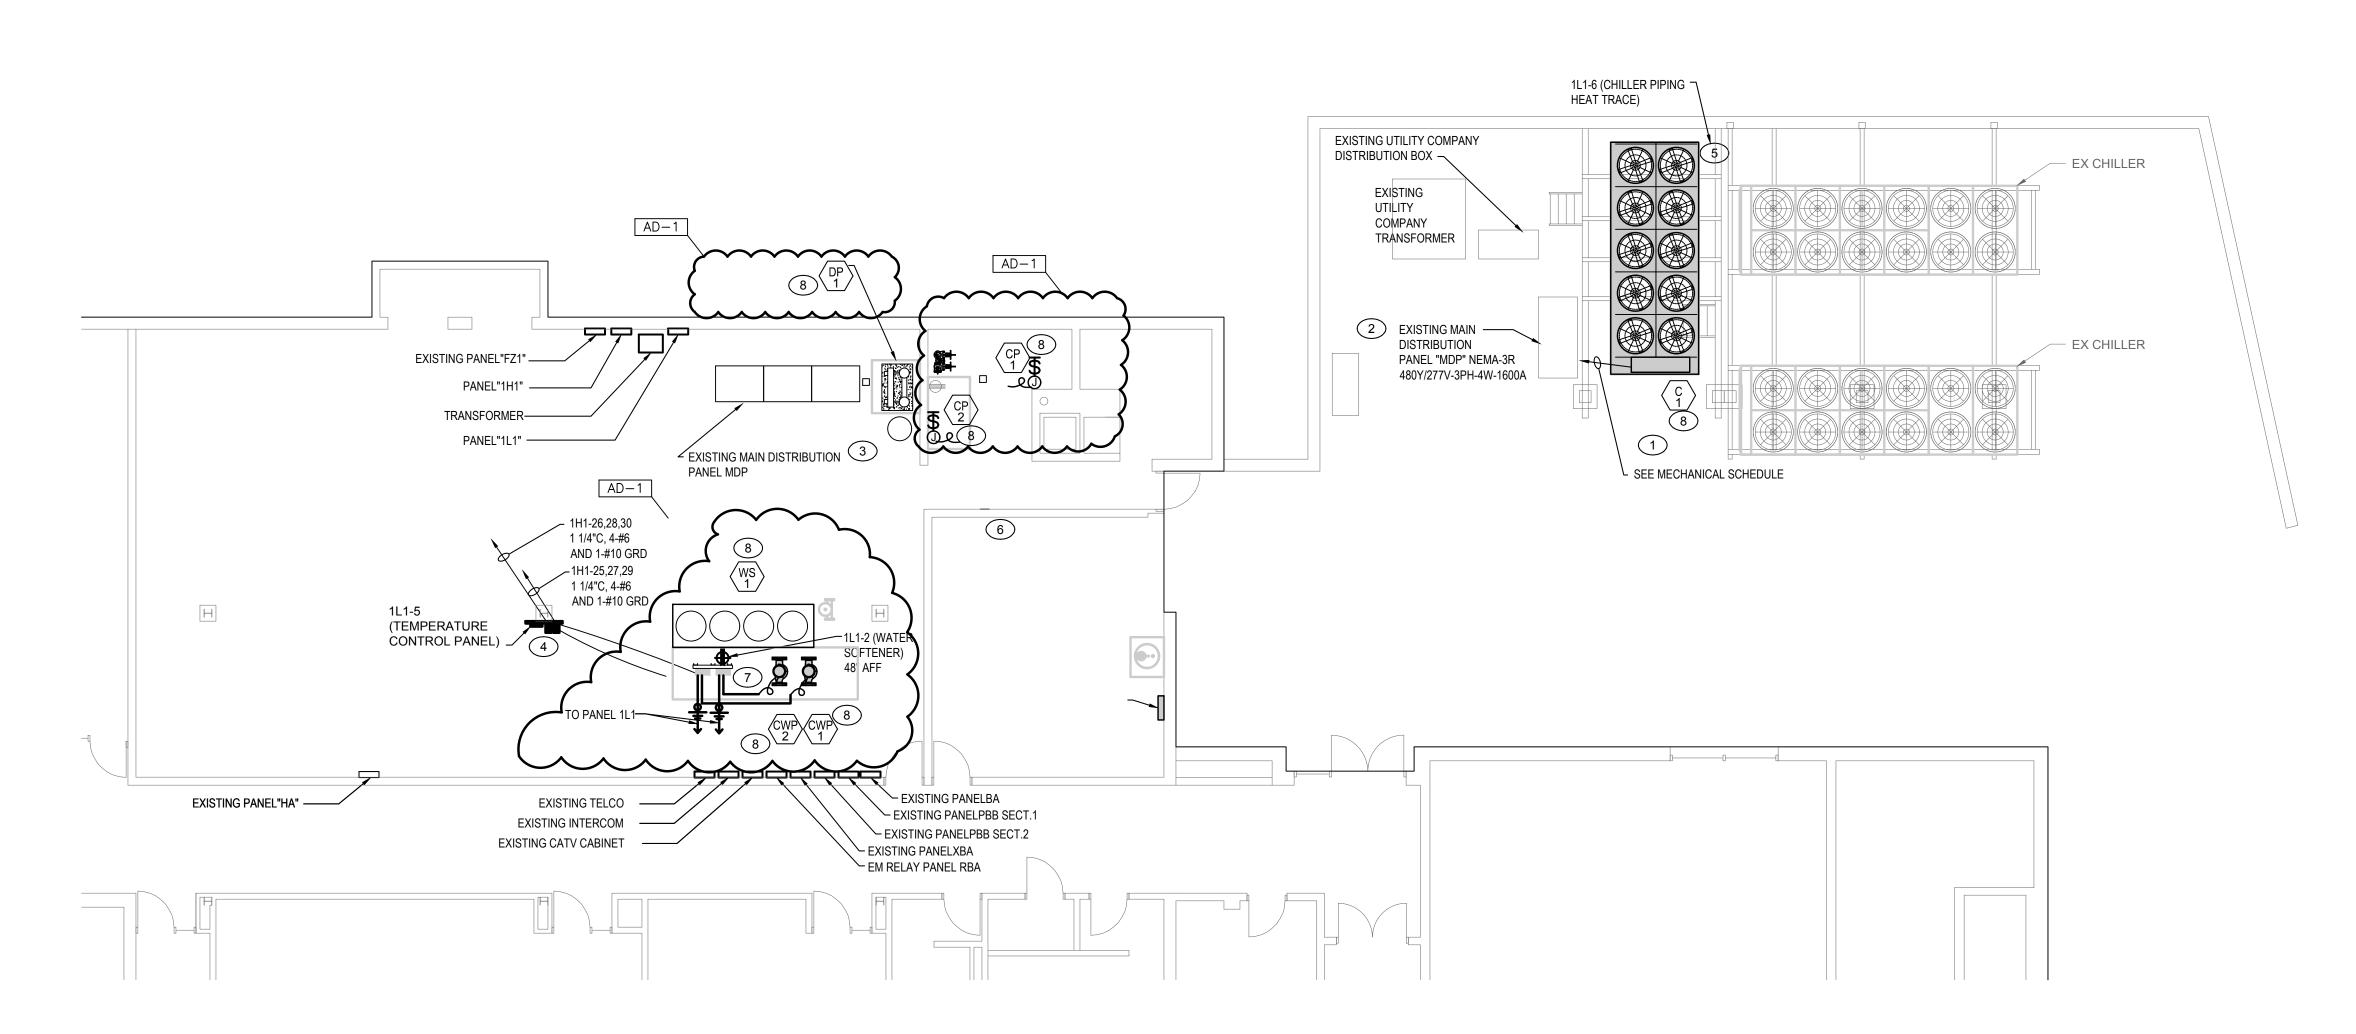

GROUND FLOOR ELECTRICAL POWER PLAN

SCALE: 1/8" = 1'-0"

DEMOLITION GENERAL NOTES

SEE E502 SHEET FOR ELECTRICAL POWER DISTRIBUTION DIAGRAMS, DETAILS AND SCHEDULES.

O DEMOLITION SHEET NOTES

- 1. DISCONNECT EXISTING ELECTRICAL SERVICE TO THE EXISTING CHILLER BEING REMOVED AND REMOVE ASSOCIATED CONDUIT AND WIRE BACK TO THE SOURCE, UNLESS OTHERWISE NOTED.
- 2. MODIFY EXISTING EXTERIOR MAIN DISTRIBUTION PANELBOARD/SWITCHBOARD THAT SERVES THE CHILLERS AS SHOWN ON THE EPOWER DISTRIBUTION DIAGRAM ON SHEET
- B. DISCONNECT EXISTING ELECTRICAL SERVICE TO THE EXISTING CIRCULATING PUMPS
- BEING REMOVED AND REMOVE ASSOCIATED CONDUIT AND WIRE BACK TO THE SOURCE, UNLESS OTHERWISE NOTED.
- 4. DISCONNECT EXISTING ELECTRICAL SERVICE TO THE EXISTING HOT WATER CIRCULATING PUMP BEING REMOVED. REMOVE ASSOCIATED CONTROLLER/DISCONNECT AND REMOVE ASSOCIATED CONDUIT AND WIRE BACK TO THE SOURCE, UNLESS OTHERWISE NOTED.
- 5. REMOVE EXISTING RECEPTACLE SERVING THE WATER SOFTENER BEING REMOVED AND REMOVE ASSOCIATED CONDUIT AND WIRE BACK TO THE SOURCE IN SUCH A MANNER AS TO KEEP ALL OTHER DEVICES/EQUIPMENT. THAT REMAIN, IN SERVICE.
- 6. MODIFY EXISTING MAIN DISTRIBUTION PANEL "MDP1" AS SHOWN ON THE POWER DISTRIBUTION DIAGRAM ON SHEET E-502.

POWER PLAN GENERAL NOTES

SEE E502 SHEET FOR ELECTRICAL POWER DISTRIBUTION DIAGRAMS, DETAILS AND SCHEDULES.

O POWER PLAN SHEET NOTES

- PROVIDE NEW FEEDER TO NEW CHILLER BEING PROVIDED AS SHOWN, REFER TO MECHANICAL CONNECTIONS SCHEDULE FOR MORE INFORMATION REGARDING CIRCUITING AND WIRING.
- 2. MODIFY EXISTING EXTERIOR MAIN DISTRIBUTION PANELBOARD/SWITCHBOARD "MDP2" THAT SERVES THE CHILLERS AS SHOWN ON THE POWER DISTRIBUTION DIAGRAM ON
- 3. MODIFY EXISTING MAIN DISTRIBUTION PANEL "MDP1" AS SHOWN ON THE POWER DISTRIBUTION DIAGRAM ON SHEET E-502.
- 4. VARIABLE FREQUENCY DRIVE CONTROLLER BY DIVISION 23.
- 5. CONNECT HEAT TRACE FOR THE CHILLER PIPING TO CIRCUIT FZ1-28 AS SHOWN.
- PROVIDE MANUAL MOTOR STARTERS WITH THERMAL OVERLOADS AND PILOTS LIGHTS AS SHOWN FOR HOT WATER RETICULATING PUMPS.

7. PROVIDE GFI TYPE RECEPTACLE FOR WATER SOFTENERS. COORDINATE EXACT LOCATION AND ELECTRICAL REQUIREMENTS WITH WATER SOFTENER INSTALLER AND ARCHITECT PRIOR TO ROUGHING-IN.

8. REFER TO MECHANICAL CONNECTIONS SCHEDULE FOR FURTHER CIRCUITING AND



DESIGN




PROJECT:

CONNERSVILLE HS NATATORIUM RENOVATION AND RELATED

FOR:
FAYETTE COUNTY SCHOOL
CORPORATION
CONNERSVILLE, INDIANA

WORK

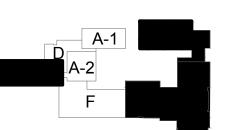

KEY PLAN

100% CONSTRUCTION

DOCUMENTS

GIBRALTAR DESIGN

9102 N. Meridian St., Ste. 300
Indianapolis, IN 46260

Homepage: www.GibraltarDesign.com
Email: info@GibraltarDesign.com
Phone 317.580.5777 Fax 317.580.5778

23-154

DATE

05/15/24

COORDINATED BY

BK

DRAWN BY

MH

CHECKED BY

CHECKED BY
DJ

COPYRIGHT NOTICE:

THE CONCEPTS, DESIGNS, PLANS, DETAILS, ETC, SHOWN ON THIS DOCUMENT ARE THE PROPERTY OF GIBRALTAR DESIGN AND WERE CREATED FOR USE ON THIS SPECIFIC PROJECT. NONE OF THIS INFORMATION SHALL BE USED BY ANY PERSON OR FIRM FOR ANY PURPOSE WITHOUT THE EXPRESS

WRITTEN CONSENT OF GIBRALTAR DESIGN. THE OWNER MARETAIN COPIES FOR INFORMATION AND REFERENCE IN

REVISIONS

MARK DATE ISSUED FOR

AD-01 06/05/2024 ADDENDUM 1

DRAWING GROUND FLOOR

ELECTRICAL PLANS

PROJECT
CONNERSVILLE HS NATATORIUM
RENOVATION AND RELATED
WORK

EP111

Copyright © 2024 Millies Engineering Group

	MECHANICAL EQUIPME	NT C	NNC	ECT	ION	SCH	EDU	JLE						/	AD-1			
TAG	DESCRIPTION	WATTO	.up	LOAD		11100	МОСР	VOLT	PHASE	PANEL	CKT. NO.	FUSED SWITCH	FEEDER		STARTI		LOCATION	REMARKS
C-1	GRADE MOUNTED AIR-COOLED CHILLER	264898	HP -	319	FLA -	AMPS -	350	480	3	MDP2	4	C/B 350A/3P	4 #500KCMIL & 1 #3 GRD	1/2"	MC.	EC.	-	-
RT-1	ROOF MOUNTED POOL HVAC UNIT - DX COOLING / GAS HEATING	100146	-	120.6	-	-	125	480	3	EX	EX	200A/3P	EX	2"	Х	-	-	REUSE EXISTING CONNECTIONS FROM PREVIOUS ROOFTOP J
RT-1A	ROOF MOUNTED POOL HVAC UNIT - DX COOLING / GAS HEATING - ALTERNATE	111274	-	134	-	-	150	480	3	EX	EX	200A/3P	EX	2"	х	-	-	REUSE EXISTING CONNECTIONS FROM PREVIOUS ROOFTOP J
FC-1	SUSPENDED HORIZONTAL FAN COIL UNIT - DX COOLING / HOT WATER HEATING	318	-	2.65	-	-	15	120	1	CJ	55	20A/2P	2 #12 & 1#12 GRD	3/4"	х	-	-	-
CU-1	ROOF MOUNTED AIR-COOLED CONDENSING UNIT	2454.4	-	11.8	-	-	20	208	1	CJ	37-39	20A/2P	3 #12 & 1 #12 GRD	3/4"	х	-	-	-
PTAC-1	ELECTRIC HEAT/DX COOLED PTAC - ALTERNATE	1040	-	-	-	5	-	208	1	CJ	33-35	20A/2P	3 #12 & 1 #12 GRD	3/4"	х	-	-	-
UH-1	SUSPENDED HOT WATER UNIT HEATER	216	-	1.8	-	-	15	120	1	CJ	21	20A/1P	2 #12 & 1#12 GRD	3/4"	х	-	-	-
UH-2	SUSPENDED HOT WATER UNIT HEATER	216	-	1.8	-	-	15	120	1	CJ	23	20A/1P	2 #12 & 1#12 GRD	3/4"	х	-	-	-
UH-3	SUSPENDED HOT WATER UNIT HEATER	216	-	1.8	-	-	15	120	1	CJ	25	20A/1P	2 #12 & 1#12 GRD	3/4"	х	-	-	-
GEF-1	INLINE GENERAL EXHAUST FAN (STORAGE C-006)	696	0.25	-	-	-	-	120	1	CJ	27	20A/1P	2 #12 & 1#12 GRD	3/4"	-	Х	-	-
GEF-2	INLINE GENERAL EXHAUST FAN (STORAGE C-004)	696	1/4	-	-	-	-	120	1	CJ	29	20A/1P	2 #12 & 1#12 GRD	3/4"	-	Х	-	-
GEF-3	INLINE GENERAL EXHAUST FAN (FILTRATION ROOM C-001)	199.2	1/15	~~~	~~~		~~~	120	1	CJ	31	20A/1P	2 #12 & 1#12 GRD	3/4"	· · · · ·	X		·
WH-1	WATER HEATER	16	-	-	-	-	-	120	1	CJ	52	20A/1P	2 #12 & 1#12 GRD	3/4"	х	-	-	-
DBP-1	DOMESTIC BOOSTER PUMP	17438.4	(2) 15	-	-	-	-	480	3	1H1	2-4-6	60A/3P	4 #4 & 1 #10 GRD	1"	-	-	-	-
CP-1	DOMESTIC HW RECIRCULATING PUMP	-	1/40	-	-	-	-	115	1	1L1	1	20A/1P	2 #12 & 1#12 GRD	3/4"	-	-	-	-
CP-2	DOMESTIC HW RECIRCULATING PUMP	-	1/6	-	-	-	-	115	1	1L1	3	20A/1P	2 #12 & 1#12 GRD	3/4"	-	-	-	-
DWS-1,2,3	DOMESTIC WATER SOFTENER	-	-	-	-	-	-	120	1	1L1	2	20A/1P	2 #12 & 1#12 GRD	3/4"	-	-	-	

N F F0	Ve: ==	100/000	CJ				}		INTERIOR	E/EXTERIOR LIGHT	ING L	JMINA	RE SC	HEDULE
ON: ELECTRIC C104 FROM: 45KVA NG: SURFACE GURE: NEMA 1 ATING: 10K	PHASES: MAINS TYPE: MAIN RATING:						AA AA		2'X4' LED DIRECT/INDIRECT FIXTURE	LITHONIA #2BLT4-48L-ADP-LP840-X-X METALUX #24ARS-L3C3-UNV OR APPROVED EQUAL	120/277 VOLT 0-10V DIM	LED 4000 K MIN 4800 LM 35W	RECESSED LAY-IN -	- - - -
							AB		1'X4' LED DIRECT/INDIRECT FIXTURE	LITHONIA #BLT4-48L-ADP-LP840-X-X OR APPROVED EQUAL	120/277 VOLT 0-10V DIM	LED 4000 K MIN 4800 LM 35W	RECESSED LAY-IN -	- - -
EX CIRCUITS EX CIRCUITS EX CIRCUITS	20 A 1	500 500		500	1 20 A 1 20 A	EX CIRCUITS 2 EX CIRCUITS 4	} TA		RAIL MOUNTED INDIRECT NATATORIUM FIXTURE	SPI LIGHTING #LRU12394-169W-40K-NAT OR APPROVED EQUAL	120/277 VOLT 0-10V DIM	LED 4000 K MIN 82293 LM 649W	RAIL MTD 22' AFF	- - -
EX CIRCUITS EX CIRCUITS EX CIRCUITS EX CIRCUITS EX CIRCUITS	20 A 1 20 A 1 20 A 1 20 A 1 20 A 1	500	500 500 500 500 500	500	1 20 A 1 20 A 1 20 A 1 20 A 1 20 A	EX CIRCUITS 6 EX CIRCUITS 8 EX CIRCUITS 10 EX CIRCUITS 12 EX CIRCUITS 14	TB		4' PENDANT INDIRECT NATATORIUM FIXTURE	LUX DYNAMICS #WAVEP-4-840-U10-WSA4-DEF4	120/277 VOLT 0-10V DIM	LED 4000 K MIN 14310 LM 861W	PENDANT MTD 22' AFF	- - -
EX CIRCUITS EX CIRCUITS EX CIRCUITS UH-1	20 A 1 20 A 1 20 A 1 20 A 1	500	500	500	1 20 A 1 20 A 1 20 A 1 20 A	EX CIRCUITS 16 EX CIRCUITS 18 EX CIRCUITS 20 REC POOL 22	TC	0	PENDANT INDIRECT NATATORIUM FIXTURE	VISIONAIRE #BHB-6-SW-90L-4K-VOLT @ 20' MTG.HT.(INDIRECT) 18 DEGREE TILT OR APPROVED EQUAL	120/277 VOLT 0-10V DIM	LED 4000 K MIN 9000 LM 625W	PENDANT MTD 22' AFF	- - -
UH-2 UH-3 GEF-1	20 A 1 20 A 1 20 A 1	216	216 40	400	1 20 A 1 20 A 1 20 A	REC POOL 24 REC POOL 26 REC OFFICE 107 28	EA	모	EXTERIOR WALL MOUNTED FIXTURE	OR APPROVED EQUAL	120/277 VOLT 0-10V DIM	LED 4000 K MIN 3000 LM 25W	WALL MTD - -	- - -
GEF-2 GEF-3 —PTAC-1	20 A 1 20 A 1 20 A 2	199	696 20	200 0 1200 1200	1 20 A 1 20 A 1 20 A 1 20 A	REC SOUND SYSTEM 30 REC SOUND SYSTEM 32 SCOREBOARD 34 SCOREBOARD 36	PA		48" LED LINEAR DIRECT/INDIRECT STRIP FIXTURE	LITHONIA #CLX-L48-4000LM-SEF-MVOLT-GZ1-XX-35K-80CRI OR APPROVED EQUAL	120/277 VOLT 0-10V DIM	LED 3500 K MIN 4000 LM 32 W	SURFACE	- - -
AC-1	20 A 2	1664	20		1 20 A 1 20 A 1 20 A 1 20 A	REC EWC 38 REC ROOF TOP 40 REC STORAGE C005 42	PB		48" LED LINEAR DIRECT/INDIRECT STRIP FIXTURE	HUBBELL CHALMIT #PR3I/07L/LE OR APPROVED EQUAL	120/277 VOLT 0-10V DIM	LED 3500 K MIN 6690 LM 44 W	PENDANT	- - -
UVA1 CPA1 APA1	30 A 3	834	1800	1200	1 20 A 1 20 A 1 20 A	REC STORAGE C005 44 EXISTING CHEMICAL CONTROLLER 46 REC HEAD TABLE ALTERNATE 48	PC	⊢⊖	24" LED LINEAR DIRECT/INDIRECT STRIP FIXTURE	LITHONIA #CLX-L24-4000LM-SEF-MVOLT-GZ1-XX-40K-80CRI OR APPROVED EQUAL	120/277 VOLT 0-10V DIM	LED 4000 K MIN 4000 LM 32 W	SURFACE	- - -
APA1 ACO1 FC-1	20 A 1 25 A 1 20 A 1 20 A 1	1800 240 318		800	1 20 A	WH-1 52 SPACE 56	CA		6" DIAMETER LED SQUARE DOWNLIGHT	CEILEO #CLO-35-80L-25-4K7-UNV-SQ-XX OR APPROVED EQUAL	120/277 VOLT 0-10V DIM	LED 3500 K 3200 LM 26 W	RECESSED	
SPACE SPACE END:	1				1	SPACE 58 SPACE 60	XA XA	⊗	EXIT SIGN WITH 6" RED LETTERS, POLY CARBONATE BODY, 90 MINUTE NI-CAD BATTERY BACK UP	EXITRONIX #WLTE-W-1-R-EL OR APPROVED EQUAL	MVOLT - - -	LED	CEILING/ WALL	-FURNISH WITH ARROWS AS REQ'D BY CODE -COORDINATE FACE QUANTITY WITH PLANS
= PROVIDE GFI CIRCUIT BREA = PROVIDE SHUNT TRIP BREAI = PROVIDE LOCKABLE DEVICE	KER			T		AD-1	EM		FIXTURE ON EMERGENCY CIRCUIT WITH 90 MINUTE, HIGH OUTPUT		120/277 VOLT	-	IN FIXTURE/ REMOTE	-PROVIDE TEST SWITCH AND CHARGING INDICATOR
				TOTAL CO	ONNECTED LOAD	NEL TOTALS PHASE A: 10631 VA PHASE B: 13930 VA PHASE C: 12266 VA 0: 36827 VA			BATTERY UNIT OR INVERTER					-INTEGRAL BATTERIES NOT ALLOWED IN FIXTURES WITH GREATER THAN 10000 LUMENS

AD-1

						スピック	HEDULE	\	FIXTUI CEILIN
AA		2'X4' LED DIRECT/INDIRECT FIXTURE	LITHONIA #2BLT4-48L-ADP-LP840-X-X METALUX #24ARS-L3C3-UNV OR APPROVED EQUAL	120/277 VOLT 0-10V DIM	LED 4000 K MIN 4800 LM 35W	RECESSED LAY-IN	- - -	}	15. FIXTU SUFFI REASO IN EXC
AB		1'X4' LED DIRECT/INDIRECT FIXTURE	LITHONIA #BLT4-48L-ADP-LP840-X-X OR APPROVED EQUAL	120/277 VOLT 0-10V DIM	LED 4000 K MIN 4800 LM 35W	RECESSED LAY-IN -	-	}	NECES ACCO
TA		RAIL MOUNTED INDIRECT NATATORIUM FIXTURE	SPI LIGHTING #LRU12394-169W-40K-NAT OR APPROVED EQUAL	120/277 VOLT 0-10V DIM	LED 4000 K MIN 82293 LM 649W	RAIL MTD 22' AFF	- - -		16. EVALU PROD CONTI 17. LIGHT
ТВ		4' PENDANT INDIRECT NATATORIUM FIXTURE	LUX DYNAMICS #WAVEP-4-840-U10-WSA4-DEF4	120/277 VOLT 0-10V DIM	LED 4000 K MIN 14310 LM 861W	PENDANT MTD 22' AFF	- - -	}	DOWN DEVIC COND
TC	0	PENDANT INDIRECT NATATORIUM FIXTURE	VISIONAIRE #BHB-6-SW-90L-4K-VOLT @ 20' MTG.HT.(INDIRECT) 18 DEGREE TILT OR APPROVED EQUAL	120/277 VOLT 0-10V DIM	LED 4000 K MIN 9000 LM 625W	PENDANT MTD 22' AFF	- - -		19. CARE
EA	모	EXTERIOR WALL MOUNTED FIXTURE	LITHONIA #WST-LED-P2-40K-VF-MVOLT-XX OR APPROVED EQUAL	120/277 VOLT 0-10V DIM	LED 4000 K MIN 3000 LM 25W	WALL MTD - -	- - - -	}	
PA		48" LED LINEAR DIRECT/INDIRECT STRIP FIXTURE	LITHONIA #CLX-L48-4000LM-SEF-MVOLT-GZ1-XX-35K-80CRI OR APPROVED EQUAL	120/277 VOLT 0-10V DIM	LED 3500 K MIN 4000 LM 32 W	SURFACE	- - -	SUP MOU ENC	ATION: ELECTRIC C104 PLY FROM: PANEL PCE JNTING: SURFACE LOSURE: NEMA 1
РВ		48" LED LINEAR DIRECT/INDIRECT STRIP FIXTURE	HUBBELL CHALMIT #PR3I/07L/LE OR APPROVED EQUAL	120/277 VOLT 0-10V DIM	LED 3500 K MIN 6690 LM 44 W	PENDANT		A.I.C	C. RATING: 10K
PC	⊢ o i	24" LED LINEAR DIRECT/INDIRECT STRIP FIXTURE	LITHONIA #CLX-L24-4000LM-SEF-MVOLT-GZ1-XX-40K-80CRI OR APPROVED EQUAL	120/277 VOLT 0-10V DIM	LED 4000 K MIN 4000 LM 32 W	SURFACE	- - -) CK1	CIRCUIT DESCRIPTIO
CA	0	6" DIAMETER LED SQUARE DOWNLIGHT	CEILEO #CLO-35-80L-25-4K7-UNV-SQ-XX OR APPROVED EQUAL	120/277 VOLT 0-10V DIM	LED 3500 K 3200 LM 26 W	RECESSED	- - -	3 5 7	SPARE SPARE
ХА	⊗	EXIT SIGN WITH 6" RED LETTERS, POLY CARBONATE BODY, 90 MINUTE NI-CAD BATTERY BACK UP	EXITRONIX #WLTE-W-1-R-EL OR APPROVED EQUAL	MVOLT - - -	LED - - -	CEILING/ WALL	-FURNISH WITH ARROWS AS REQ'D BY CODE -COORDINATE FACE QUANTITY WITH PLANS		BPA2
EM		FIXTURE ON EMERGENCY CIRCUIT WITH 90 MINUTE, HIGH OUTPUT (MIN 1400LM) BATTERY UNIT OR INVERTER		120/277 VOLT	-	IN FIXTURE/ REMOTE	-PROVIDE TEST SWITCH AND CHARGING INDICATOR -INTEGRAL BATTERIES NOT ALLOWED IN FIXTURES WITH GREATER THAN 10000	19 21 23 25 27	45KVA TRANSFORMER C-6 SPARE
							LUMENS	31	

FIXTURE GENERAL NOTES

- 1. INTERIOR FIXTURES, EXTERIOR FIXTURES AND POLE FINISHES AND COLORS TO BE SELECTED BY ARCHITECT. THE ARCHITECT MAY, AT THEIR DISCRETION, CHOOSE A CUSTOM COLOR AT NO ADDITIONAL CHARGE.
- 2. PENDANT FIXTURES SPECIFIED ON THIS PROJECT SHALL BE CAREFULLY COORDINATED WITH CONTRACT DOCUMENTS AND FIXTURE MANUFACTURER AS EACH PENDANT FIXTURE IS A CUSTOM MANUFACTURED FIXTURE. PROVIDE PENDANT EMERGENCY SECTIONS AND EMERGENCY CIRCUITS AS SHOWN. COORDINATE WITH FIXTURE MANUFACTURER AND PROVIDE ADDITIONAL ACCESSORIES FOR A COMPLETE AND PROPER INSTALLATION. PROVIDE PROPER FIXTURE LENGTH, FEEDS, SINGLE AND DUAL CIRCUITING AND SUSPENSION LENGTH AS SHOWN ON DRAWINGS. PROVIDE FABRICATION DRAWINGS FOR REVIEW AS PART OF THE SHOP DRAWING SUBMITTAL PROCESS.
- 3. LED FIXTURES (LESS THAN 10000 LUMENS) SHALL BE PROVIDED WITH FACTORY INSTALLED INTEGRAL EMERGENCY BATTERY UNITS BATTERY UNITS SHALL PROVIDE A MINIMUM OF 1400 LUMENS.
- 4. FIXTURES THAT CANNOT BE PROVIDED WITH EMERGENCY BALLASTS OR FIXTURES WITH GREATER THAN 10000 LUMENS SHALL BE PROVIDED WITH EMERGENCY INVERTER (MYERS #LV SERIES OR APPROVED EQUAL) WITH SUITABLE CAPACITY TO POWER FIXTURE FOR A MINIMUM OF 90 MINUTES PER CODE. VERIFY SIZING AND REQUIREMENTS WITH CONTRACT DOCUMENTS PRIOR TO ORDERING.
- 5. SHADED FIXTURES SHALL HAVE AN EMERGENCY SOURCE OF POWER AS SPECIFIED.

AS SPECIFIED.

- 6. FIXTURES WITH EMERGENCY BATTERIES SHALL BE PROVIDED WITH CONSTANT HOT SENSING WIRE SO THAT FIXTURE CAN BE SWITCHED ON AND OFF WITHOUT ACTIVATING EMERGENCY BALLAST. UPON LOSS OF POWER, THE FIXTURE SHALL BE ILLUMINATED FOR A MINIMUM OF 90 MINUTES REGARDLESS OF THE LIGHT SWITCH POSITION. PROVIDE TEST SWITCH AND CHARGING INDICATOR FOR EMERGENCY BATTERY
- 7. CAREFULLY COORDINATE MOUNTING REQUIREMENTS FOR FIXTURES WITH CONTRACT DOCUMENTS AND FIXTURE MANUFACTURER. PROVIDE APPROPRIATE MOUNTING FRAMES FOR LAY-IN OR GYPSUM CEILINGS. VERIFY CEILING REQUIREMENTS WITH FINAL ARCHITECTURAL REFLECTED CEILING PLAN.
- 8. COMPLETE PHOTOMETRICS OF THE INTERIOR AND EXTERIOR LIGHTING SHALL BE SUBMITTED ALONG WITH THE LIGHTING SHOP DRAWINGS FOR REVIEW. FOR FINISHED SPACES, 80/50/20 REFLECTANCES SHALL BE UTILIZED. FOR UNFINISHED SPACES 50/50/20 REFLECTANCE SHALL BE UTILIZED. THE LLD VALUE THAT SHALL BE UTILIZED FOR LED IS .81. EXTERIOR CALCULATIONS SHALL ACCOUNT FOR HOUSE SIDE SHIELDING AND SHALL CONFORM TO LOCAL REQUIREMENTS.
- 9. VERIFY FIXTURE MOUNTING HEIGHTS WITH ARCHITECT PRIOR TO ROUGH-IN.
- 10. VERIFY VOLTAGES OF EXISTING LIGHTING CIRCUITRY PRIOR TO ORDERING FIXTURES.
- 11. FOR FIXTURES INSTALLED IN CASEWORK, VERIFY FIXTURE FIT WITH CASEWORK SHOP DRAWINGS PRIOR TO ORDERING.
- 12. PROVIDE CUSTOM ANTI-SWAY BRACING FOR PENDANT TO ELIMINATE PENDANT MOVEMENT DUE TO AIR MOVEMENT OR ENVIRONMENTAL CAUSES.
- 13. COORDINATE LOCATIONS OF INTERIOR AND EXTERIOR LIGHTING FIXTURES WITH FINAL ARCHITECTURAL DRAWINGS. FIXTURES THAT ARE NOT INSTALLED IN THE CORRECT LOCATION SHALL BE RELOCATED AND REINSTALLED IN THE CORRECT LOCATION AT NO ADDITIONAL CHARGE.
- 14. FIXTURES SHALL BE PROVIDED WITH ESCUTCHEON PLATES AS REQUIRED TO COVER EXISTING HOLES FROM REMOVED FIXTURES. CANOPY CEILING AROUND NEW FIXTURES SHALL BE REFINISHED TO MATCH EXISTING SURROUNDING CANOPY CEILING SURFACES.
- 15. FIXTURES SHALL BE CAREFULLY COORDINATED WITH MANUFACTURER TO DELIVER THE SPECIFIED PRODUCT IN SUFFICIENT TIME TO MEET PROJECT DEADLINES. EQUIPMENT DELIVERY LEAD TIME SHALL NOT BE HELD AS A VALID REASON FOR REQUESTING LUMINAIRE SUBSTITUTION UNLESS LUMINAIRE LEAD TIME FROM SPECIFIED MANUFACTURER IS IN EXCESS OF 14 WEEKS. IT SHALL BE THE SOLE RESPONSIBILITY OF THE ELECTRICAL CONTRACTOR TO DETERMINE NECESSARY EQUIPMENT LEAD TIMES, DELIVER SUBMITTALS FOR REVIEW IN A TIMELY FASHION, AND PLACE ORDERS ACCORDINGLY TO ENSURE TIMELY DELIVERY.
- 16. EVALUATION OF APPROVED EQUALS SHALL BE AT THE SOLE DISCRETION OF THE ARCHITECT AND ENGINEER. IF THE PRODUCT SUBMITTED DURING THE REVIEW PROCESS IS NOT JUDGED AS AN EQUAL BY THE REVIEWING ENGINEER, THE CONTRACTOR SHALL PROVIDE THE PRODUCT SPECIFIED.
- 17. LIGHT FIXTURE TRANSFORMERS SHALL BE INTEGRAL STEP DOWN TRANSFORMERS PER NEC 210.6C. IF AN INTEGRAL STEP DOWN TRANSFORMER IS NOT AVAILABLE. PROVIDE A 120V CONNECTION FOR LIGHT FIXTURES AND ADDITIONAL CONTROL DEVICES AS REQUIRED TO PROPERLY CONTROL FIXTURES ALONG WITH OTHER 277 VOLT LIGHTING IN ROOM. VERIFY CONDITIONS AND REQUIREMENTS, COMPLETE AS REQUIRED.
- 18. CAREFULLY COORDINATE VOLTAGES OF FIXTURES PRIOR TO ORDERING FIXTURES.

VOLTS: 480/277 Wye

PHASES:

19. CAREFULLY VERIFY COLOR TEMPERATURE OF FIXTURES WITH ARCHITECT PRIOR TO ORDERING.

MOUNTING: SURFACE MAINS TYPE: MLO ENCLOSURE: NEMA 1 MAIN RATING: 225A A.I.C. RATING: 10K BUSSING: COPPER CKT | CIRCUIT DESCRIPTION | LEG. | TRIP | POLES | A | B | C | A | B | C | POLES | TRIP | LEG. | CIRCUIT DESCRIPTION | CKT | 1 | 20 A | POOL LTG 3 SPARE 5 SPARE 20 A | 6 | 1 20 A EXTERIOR LIGHTING LOWER LEVEL LIGHTING EMERGENCY LIGHTING INVERTER | 18 EXTERIOR WALLPACK 21 45KVA TRANSFORMER C-6 EXISTING CIRCUIT EXISTING CIRCUIT EXISTING CIRCUIT EXISTING CIRCUIT 29 SPARE **EXISTING CIRCUIT** 31 SPACE 1 20 A EXISTING CIRCUIT 33 SPACE 35 SPACE

LEGEND: GC = PROVIDE GFI CIRCUIT BREAKER ST = PROVIDE SHUNT TRIP BREAKER

37 SPACE

39 SPACE

41 SPACE

LOCATION: ELECTRIC C104

LO = PROVIDE LOCKABLE DEVICE PANEL TOTALS TOTAL CONNECTED LOAD PHASE A: 24711 VA TOTAL CONNECTED LOAD PHASE B: 25591 VA TOTAL CONNECTED LOAD PHASE C: 30830 VA TOTAL CONNECTED LOAD: 81132 VA REFER TO SPECIFICATIONS FOR ADDITIONAL INFORMATION TOTAL CONNECTED AMPS:

SPACE

	POOL EQUIPMENT CONNECTION SCHEDULE												
TAG	DESCRIPTION	LOAD		FLA	MOCP	VOLT	PHASE	PANEL	CKT. NO.	FUSED SWITCH	FEEDER		
		WATTS	HP							C/B	CABLE	С	
PA1	FILTRATION PUMP VIA VFD VA1	22420	20			480	3	PCF	7-9-11	60A/3P	4 #4 & 1 #10 GRD	1"	
BPA2	CHEMICAL BOOSTER PUMP	3986	3			480	3	PCF	13-15-17	20A/3P	4 #12 & 1 #12 GRD	3/4"	
ACO1	AIR COMPRESSOR	1800	2			120	1	CJ	53	20A/1P	3 #12 & 1 #12 GRD	3/4"	
UVA1	ULTRA VIOLET DISINFECTION	2500			30	208	3	CJ	41-43-45	30A/1P	4 #10 & 1 #10 GRD	3/4"	
CPA1	CHLORINE FEEDER	1800		15		120	1	CJ	47	20A/1P	2 #12 & 1 #12 GRD	3/4"	
APA1	PH FEEDER SCHEDULE	1800		15		120	1	CJ	49	20A/1P	2 #12 & 1 #12 GRD	3/4"	
AFA1	WATER LEVEL CONTROLLER	2400		20		120	1	CJ	51	25A/1P	2 #10 & 1 #10 GRD	3/4"	



GIBRALTAR DESIGN

> ARCHITECTURE •ENGINEERING •INTERIOR DESIGN (219) 924-8400

PROJECT:

CONNERSVILLE NATATORIUM RENOVATION AND RELATED

FAYETTE COUNTY SCHOOL CORPORATION

CONNERSVILLE, INDIANA

WORK

CONSTRUCTION **DOCUMENTS**

GIBRALTAR DESIGN 9102 N. Meridian St., Ste. 300 Indianapolis, IN 46260 Homepage: www.GibraltarDesign.com Email: info@GibraltarDesign.com Phone 317.580.5777 Fax 317.580.5778

23-154 DATE 05/15/24 COORDINATED BY DRAWN BY **CHECKED BY**

40

10302590


OPYRIGHT NOTICE: THE CONCEPTS, DESIGNS, PLANS, DETAILS, ETC, SHOWN ON THIS DOCUMENT ARE THE PROPERTY OF GIBRALTAR DESIGN AND WERE CREATED FOR USE ON THIS SPECIFIC PROJECT. NONE OF THIS INFORMATION SHALL BE USED BY ANY PERSON OR FIRM FOR ANY PURPOSE WITHOUT THE EXPRESS WRITTEN CONSENT OF GIBRALTAR DESIGN. THE OWNER MAY RETAIN COPIES FOR INFORMATION AND REFERENCE IN

ONNECTION ONLY WITH THIS PROJECT. REVISIONS MARK DATE ISSUED FOR D-01 06/05/2024 ADDENDUM 1

ELECTRICAL SCHEDULES

CONNERSVILLE HS NATATORIUM RENOVATION AND RELATED

E-501C

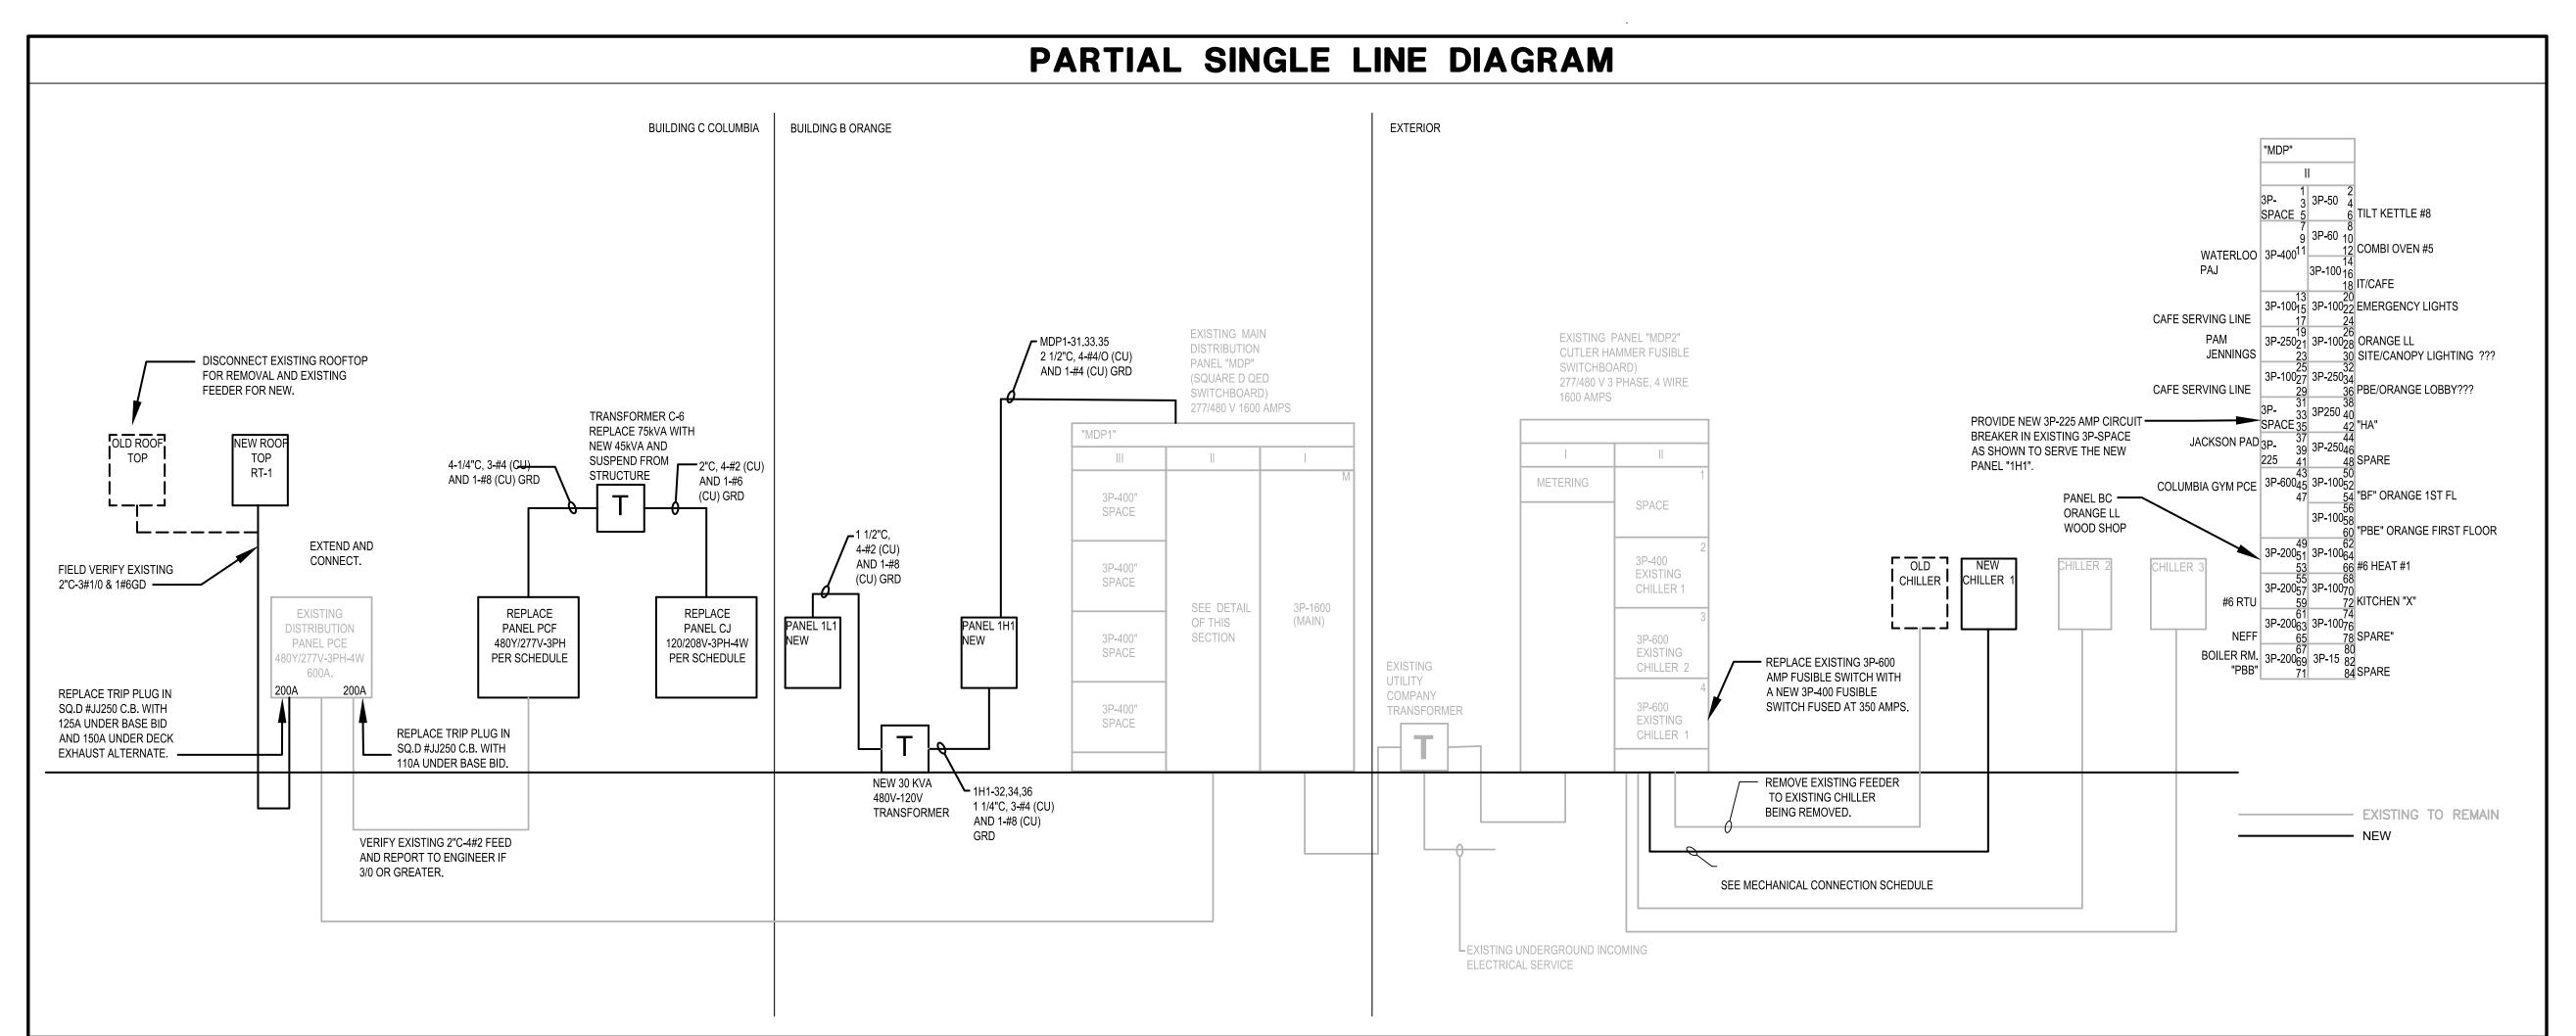

4

6

8

10

42

DOMESTIC BOOSTER PUMP

CHILLED WATER PUMP CHP-2

111659 VA

134 A

30 KVA XFMR

(PANEL "1L1")

PANEL TOTALS

1 20 A SPARE

1 20 A SPARE

20 A SPARE

20 A SPARE

TOTAL CONNECTED LOAD PHASE A: 37263 VA

TOTAL CONNECTED LOAD PHASE B: 37263 VA

TOTAL CONNECTED LOAD PHASE C: 37133 VA

1 20 A SPARE

0 1 20 A SPARE

TOTAL CONNECTED LOAD:

TOTAL CONNECTED AMPS:

LOCATION:

A.I.C. RATING:

1 SPARE

3 SPARE

5 SPARE

7 SPARE

9 SPARE

11 SPARE

13 SPARE

15 SPARE

17 SPARE

19 SPARE

21 SPARE 23 SPARE

31 SPARE

33 SPARE

35 SPARE

37 SPARE

39 SPARE

41 SPARE

CHILLED WATER PUMP CHP-1

GC = PROVIDE GFI CIRCUIT BREAKER

ST = PROVIDE SHUNT TRIP BREAKER

REFER TO SPECIFICATIONS FOR ADDITIONAL INFORMATION

LO = PROVIDE LOCKABLE DEVICE

SUPPLY FROM:MDP1

MOUNTING: SURFACE

ENCLOSURE: NEMA 1

BRANCH CIRCUITS SHALL BE CIRCUIT BREAKERS.

VOLTS: 480/277 Wye

PHASES: 3

CIRCUIT BREAKER SHALL HAVE MINIMUM 35,000 AMP INTERRUPTING CAPACITY.

MAINS TYPE: MLO

MAIN RATING: 225A

20 A | 1

20 A


BUSSING: COPPER

CKT | CIRCUIT DESCRIPTION | LEG. TRIP POLES | A | B | C | A | B | C | POLES TRIP LEG. | CIRCUIT DESCRIPTION | CKT

14410 14410

0 2630

20 A 1 0 0

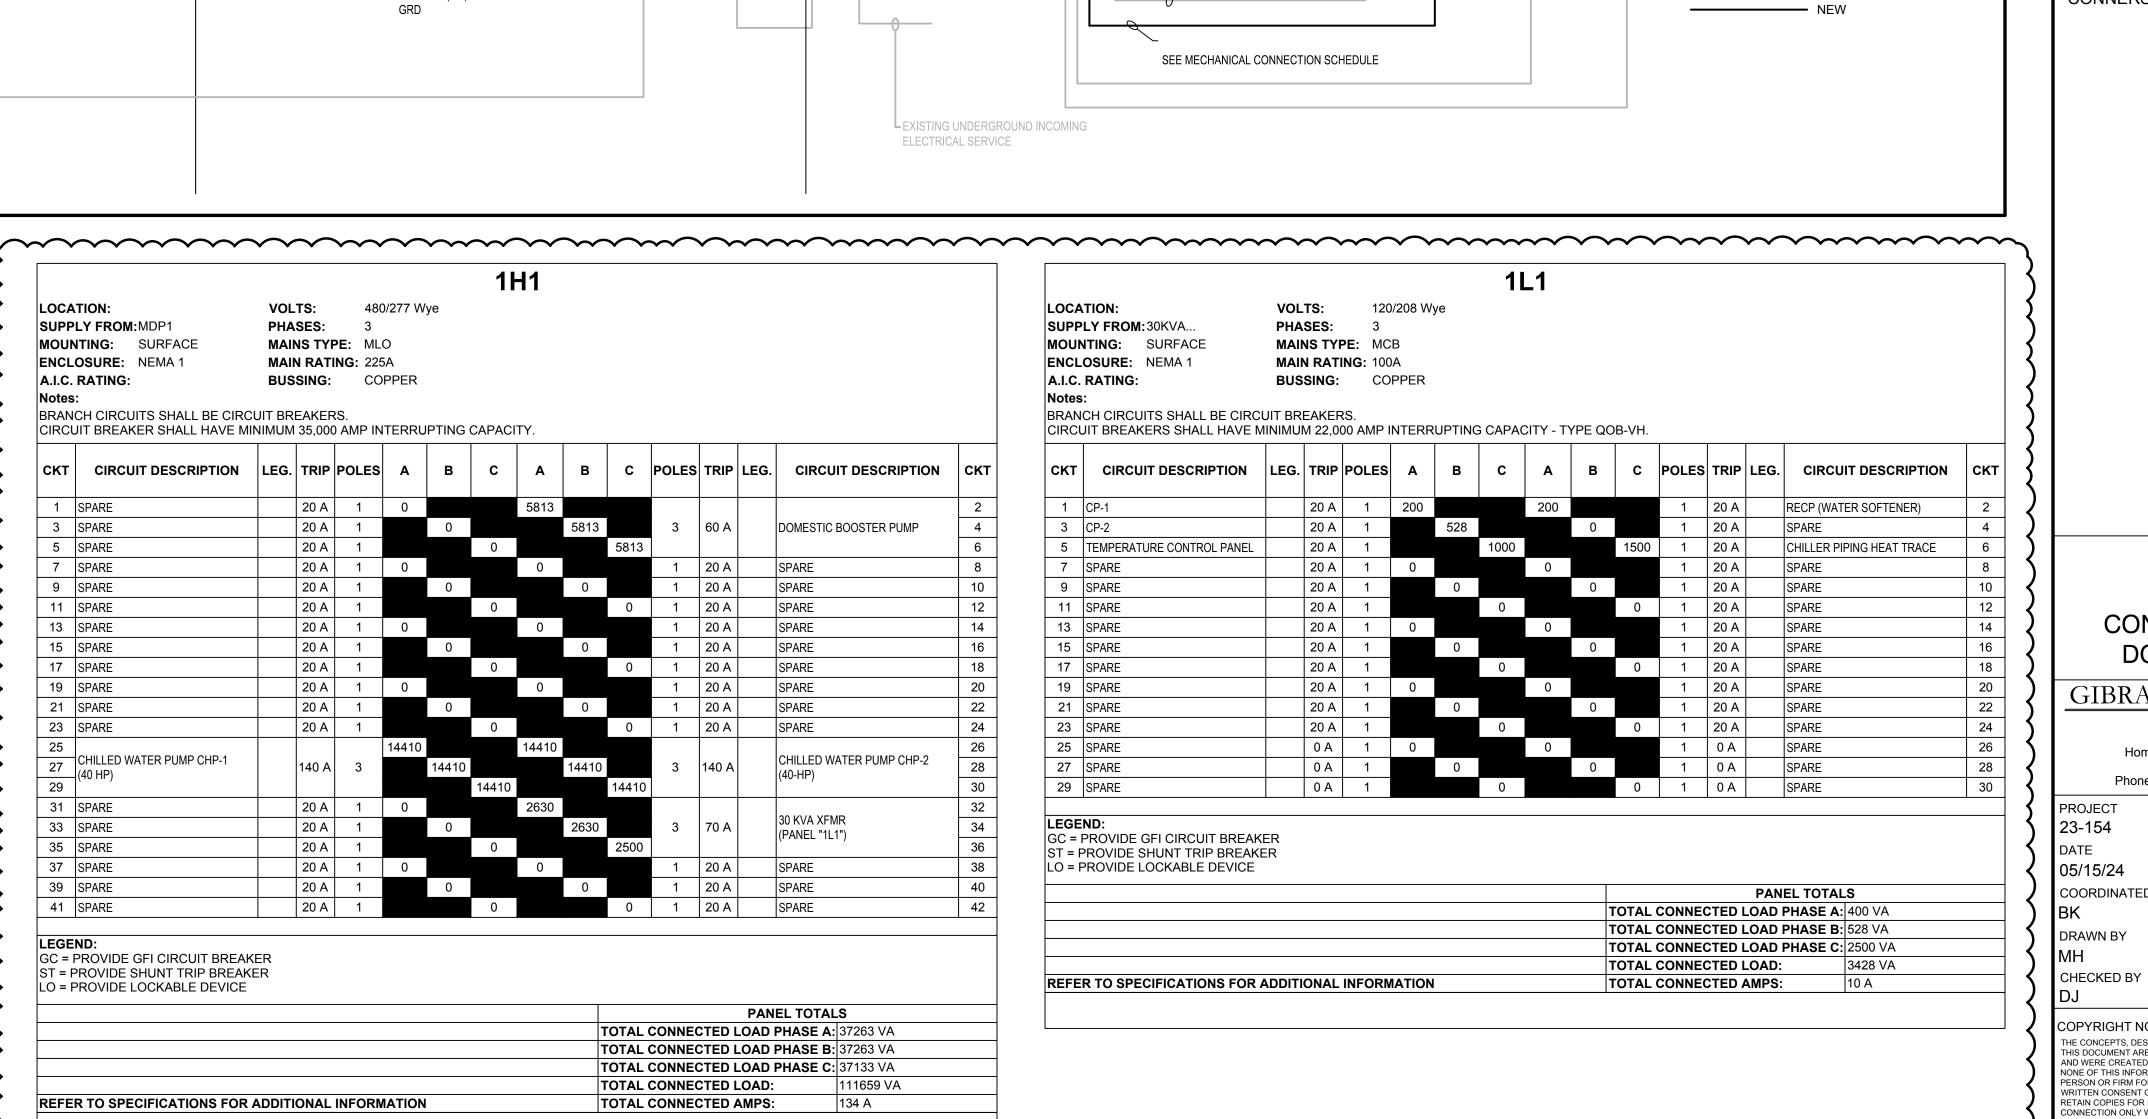

GIE	BRA	L	ΤΔΙ	
	DESI	GN		

ARCHITECTURE •ENGINEERING •INTERIOR DESIGN

ng**i**neering gro (219) 924-8400

PROJECT:

CONNERSVILLE HS NATATORIUM RENOVATION AND RELATED WORK

FAYETTE COUNTY SCHOOL CORPORATION CONNERSVILLE, INDIANA

> CONSTRUCTION DOCUMENTS

GIBRALTAR DESIGN 9102 N. Meridian St., Ste. 300 Indianapolis, IN 46260 Homepage: www.GibraltarDesign.com Email: info@GibraltarDesign.com

Phone 317.580.5777 Fax 317.580.5778 23-154 DATE 05/15/24 **COORDINATED BY** DRAWN BY

10302590

COPYRIGHT NOTICE: THE CONCEPTS, DESIGNS, PLANS, DETAILS, ETC, SHOWN ON THIS DOCUMENT ARE THE PROPERTY OF GIBRALTAR DESIGN AND WERE CREATED FOR USE ON THIS SPECIFIC PROJECT. NONE OF THIS INFORMATION SHALL BE USED BY ANY PERSON OR FIRM FOR ANY PURPOSE WITHOUT THE EXPRESS WRITTEN CONSENT OF GIBRALTAR DESIGN. THE OWNER MAY RETAIN COPIES FOR INFORMATION AND REFERENCE IN ONNECTION ONLY WITH THIS PROJECT.

REVISIONS MARK DATE ISSUED FOR AD-01 06/05/2024 ADDENDUM 1

ELECTRICAL SCHEDULES

CONNERSVILLE HS NATATORIUM

RENOVATION AND RELATED

E-601C