

# February 20, 2025

# PORTER COUNTY SHERIFF'S OFFICE AND JAIL FACILITY RENOVATIONS

# TO: ALL BIDDERS OF RECORD

This Addendum forms a part of and modifies the Bidding Requirements, Contract Forms, Contract Conditions, the Specifications, and the Drawings dated January 8, 2025 by DLZ. Acknowledge receipt of the Addendum in the space provided on the Bid Form. Failure to do so may subject the Bidder to disqualification.

This Addendum consists of Page ADD 2-1 through ADD 2-2 and attached Addendum No. 2 from DLZ dated February 19, 2025 and consisting of 3 pages, Questions and Clarifications Sheet, Revised Specification Sections: 00 00 02 - Table of Contents, 09 67 25 - Seamless Shower Coatings, 10 56 26 - Mobile Storage Shelving, 11 19 03 - Security Barriers, 23 73 13.13 - Indoor, Basic Air-Handling Units, 23 81 26 - Split-System Air-Conditioners, and 15 drawings.

# A. <u>SPECIFICATION SECTION 01 12 00 - MULTIPLE CONTRACT SUMMARY</u> Under 3.03 - Bid Categories

# B. BID CATEGORY NO. 2 - METAL STUDS, DRYWALL, CEILINGS

# 1. Revise:

Clarification No. 7:

The **Bid Category No. 2 Contractor** is to include in his bid, 40 manhours for replacement of stained or damaged ceiling tile to be performed by a skilled carpenter at the direction of the Construction Manager throughout the duration of the project. At the end of the project, unused hours will be converted into a dollar amount and returned to the Owner as a deduct Change Order.

# E. <u>BID CATEGORY NO. 5 - PLUMBING</u>

# **1.** Add:

Clarification No. 11:

All work associated with the underground rodding shown on the Plumbing Plans will be tracked under T&M and paid through the allowance.

# F. <u>BID CATEGORY NO. 6 - MECHANICAL</u>

# 1. Revise:

Clarification No. 10:

The **Bid Category No. 6 Contractor** is responsible to temporarily support all HVAC related items throughout when ceilings are removed. When the new ceilings are installed, the HVAC items are to be reinstalled or replaced per the contract documents.

# G. <u>BID CATEGORY NO. 7 - ELECTRICAL</u>

# **1. Add:**

Clarification No. 12:

The **Bid Category No. 7 Contractor** shall be responsible for the installation of the Static Uninterruptible Power Supply, as specified in Specification Section 26 33 53 and shown on the drawings. The materials for the Static Uninterruptible Power Supply has been procured by Porter County.


# B. <u>SPECIFICATION SECTION 01 21 00 - ALLOWANCES</u> Under 3.02 - Contingency Allowance

- 1. Revise:
  - E. Bid Category No. 5 Plumbing \$165,000

# ADDENDUM NO. 2

| PROJECT:  | <b>PORTER COUNTY SHERIFF'S OFFICE AND JAIL FACILITY RENOVATIONS</b><br>2755 State Road 49<br>Valparaiso, IN 46383      |
|-----------|--|
| TO:       | All Prospective Bidders and others to whom Plans and Specifications for the above referenced Project have been issued. |
| OWNER:    | PORTER COUNTY BOARD OF COMMISSIONERS<br>155 Indiana Avenue<br>Valparaiso, IN 46383                                     |
| ARCHITECT | <b>DLZ INDIANA, LLC</b><br>138 N. Delaware Street<br>Indianapolis, Indiana 46204                                       |
| DATE:     | February 19 <sup>th</sup> , 2025   |

The items included in this Addendum are to become a part of the original Contract Documents including Drawings and Project Manual dated January 08, 2025, as if included herein. Only these items are to be altered. The remainder of the original Drawings and Project Manual remain valid in their entirety. Bidders must acknowledge receipt of this Addendum in the space provided on the Proposal Form. Failure to do so may subject the Bidder to disqualification.

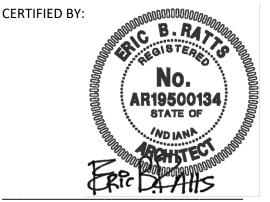

Eric B. Ratts, AIA Vice President State of Indiana No. 19500134

# PROJECT MANUAL

ITEM NO. 1. 000002 - TABLE OF CONTENTS

- a. Added SECTION 230548 VIBRATION CONTROLS FOR HVAC (spec section added in addendum 1)
- b. Replace the TABLE OF CONTENTS in all project manuals.

### ITEM NO. 2. 096725 - SEAMLESS SHOWER COATINGS

- a. Part 2.1,A: Replace "5132" with "5130"
- b. Replace entire specification with the attached.
- ITEM NO. 3. 105626 MOBILE STORAGE SHELVING
  - a. Part 2.1, A.1: Replace "Wheelhouse" with "Mechanical Assist System"
  - b. Replace entire specification with the attached.

ITEM NO. 4. SECTION 111903 - SECURITY BARRIERS

- a. Part 2.1,G.1.a: Add Color: Black.
- b. Part 2.2,K.1.a: Add Color: Black.
- c. Replace entire specification with the attached.

ITEM NO. 5. SECTION 237313.13 - INDOOR, BASIC AIR-HANDLING UNITS

- a. Added Daikin Applied to list of acceptable manufacturers.
- b. Replace entire specification with the attached.

ITEM NO. 6. SECTION 238126 - SPLIT-SYSTEM AIR-CONDITIONERS

- a. Added Daikin Applied to list of acceptable manufacturers.
- b. Replace entire specification with the attached.

# **DRAWINGS**

ITEM NO. 1. MO.1 – GENERAL INFORMATION

- a. Adjusted keynote 230013.
- b. Added keynote 230021.

ITEM NO. 2. M2.1A – FIRST FLOOR MECHANICAL INSTALLATION PLAN – AREA A

a. Indicated existing diffuser and grille tags for reference on air terminal schedule.

- b. Added existing exhaust ductwork serving EF-3.
- c. Removed unnecessary ductwork from exhaust ductwork serving evidence storage.
- ITEM NO. 3. M2.1B FIRST FLOOR MECHANICAL INSTALLATION PLAN AREA B

a. Indicated existing diffuser and grille tags for reference on air terminal schedule.

ITEM NO. 4. M2.1C - FIRST FLOOR MECHANICAL INSTALLATION PLAN - AREA C

- a. Indicated existing diffuser and grille tags for reference on air terminal schedule.
- b. Relocated chillers to be placed on existing housing pads.
- c. Added keynote 230021 for CH-1 and CH-2.
- d. Adjusted keynote 230013.
- e. Indicated existing fence and extension of fencing as shown.

ITEM NO. 5. M2.1D – FIRST FLOOR MECHANICAL INSTALLATION PLAN – AREA D

- a. Indicated existing diffuser and grille tags for reference on air terminal schedule.
- b. Added existing diffusers and grille in toilet C123 and Janitor C123A.
- c. Added existing exhaust ductwork serving EF-3.
- ITEM NO. 6. M2.1E FIRST FLOOR MECHANICAL INSTALLATION PLAN AREA E a. Indicated existing diffuser and grille tags for reference on air terminal schedule.
- ITEM NO. 7. M5.3 MECHANICAL DETAILS 3 a. Added drawing in its entirety.
- ITEM NO. 8. M6.2 MECHANICAL EQUIPMENT SCHEDULES II a. Adjusted exhaust fan schedule for EF-23.

# ATTACHMENTS:

# OTHER

1. Questions and Clarifications

#### PROJECT MANUAL

- 1. 000002 TABLE OF CONTENTS
- 2. 096725 SEAMLESS SHOWER COATINGS
- 3. 105626 MOBILE STORAGE SHELVING
- 4. 111903 SECURITY BARRIERS
- 5. 237313.13 INDOOR, BASIC AIR-HANDLING UNITS
- 6. 238126 SPLIT-SYSTEM AIR-CONDITIONERS

# DRAWINGS

- 1. M0.1 GENERAL INFORMATION
- 2. M2.1A FIRST FLOOR MECHANICAL INSTALLATION PLAN AREA A
- 3. M2.1B FIRST FLOOR MECHANICAL INSTALLATION PLAN AREA B
- 4. M2.1C FIRST FLOOR MECHANICAL INSTALLATION PLAN AREA C
- 5. M2.1D FIRST FLOOR MECHANICAL INSTALLATION PLAN AREA D
- 6. M2.1E FIRST FLOOR MECHANICAL INSTALLATION PLAN AREA E
- 7. M5.3 MECHANICAL DETAILS 3
- 8. M6.2 MECHANICAL EQUIPMENT SCHEDULES II

# **EXISTING KITCHEN DRAWINGS**

- 1. FS.1 KITCHEN EQUIPMENT PLAN
- 2. FS.2 KITCHEN EQUIPMENT PLAN
- 3. FS.3 KITCHEN EQUIPMENT PLAN
- 4. FS.4 KITCHEN MECHANICAL PLAN
- 5. FS.5 KITCHEN MECHANICAL PLAN
- 6. FS.6 KITCHEN ELECTRICAL PLAN
- 7. FS.7 KITCHEN ELECTRICAL PLAN

# **Questions and Clarifications**

# ITEM NO. 1.

Question:

- 1. Note 22306 on page MD2.1C Says to remove the chillers and says nothing for the pads. Note 230013 on page M2.1C Says to Provide New housekeeping pad for the Chiller. That note is at each chiller on the drawing (see attachment). Please Clarify if Each chiller will need a new Pad or if we are expected to reuse the 2 existing pads and extend them if necessary and pour 1 new pad for Chiller #3.
- 2. Is Fabric and Stone Required in the New Yard Area?
- 3. Please Provide Fencing Detail

# Answer:

- 1. CH-1 and CH-2 will reuse the existing pad, which will be expanded as necessary to fit the new equipment. CH-3 will have a new pad. Keynote 230021 will be added for CH-1 and CH-2 to indicate housing pad to be resized.
- 2. Stone pavement detail provided on M5.3 in addendum.
- 3. Fencing details provided on M5.3 in addendum.

# ITEM NO. 2.

Question:

- 1. Please provide a detail for installation of security grilles. welded, security fasteners, supports to structure, etc. If security grilles do need supported by structure or welded there are a few areas the ceilings are specifically called to be removed that will need to be.
- 2. Please clarify design intent of exhaust line on drawing M2.1A that does not appear on MD2.1A.
- 3. Multiple grilles are not tagged, but state to reference air terminal schedule.
- 4. Multiple fans have moved on the roof plans, but schedule and sheet notes state to reuse curbs/provide curb adapters. Please advise.
- 5. In the pre-bid we discussed more direction for duct cleaning. Have we seen anything else on this?

# Answer:

- 1. Security grilles to be installed as per manufacturer recommendations. Indicated ceiling for exhaust grilles in showers is called out to be replaced as necessary for new construction.
- 2. Exhaust line on M2.1A is new ductwork to exhaust fumes from evidence storage.
- 3. Existing grilles have been tagged.
- 4. Fans are to be replaced in place and in kind. Exhaust fan locations on M2.3 will be adjusted to match in this addendum.
- 5. Spec section 230130.52 contains direction on duct cleaning.

# ITEM NO. 3.

Question:Can you please confirm for item # 13 in division 114000, that we are to provide<br/>only, a complete new Hood system, which will be installed by others? This item is<br/>not shown on the FS drawings or equipment schedule.

# PORTER COUNTY SHERIFF'S OFFICE AND JAIL FACILITY RENOVATIONS

| Answer:     | The Specification calls out the written specification of ROOF TOP UNITS. There is no indication of a full hood system replacement. These units are to be purchased, delivered and turned over to the HVAC contractor for installation.  |
|-------------|---|
| ITEM NO. 4. |   |
| Question:   | Item # 1-states we are to remove all existing items, store, reset or dispose of.<br>Drawing FS 4 shows existing items to be removed and stored, however an<br>equipment schedule is needed to clearly define what this equipment is. The<br>written specs for item 1 reference items not being reused to be disposed of and<br>that we are responsible for re setting the equipment that is being reused. FS1<br>floor plan does not show any existing equipment being reused and FS 4 does not<br>identify what needs to be reset or disposed of. Further information on the<br>existing is needed in order to price accurately. |
| Answer:     | FS-4 Is the only existing plan available. The Pre-bid meeting would have resolved<br>many of these questions. The existing plans are adequate to assess the current<br>items. The FS-1 indicates the items that are new. The difference will be where<br>there is indication on FS-1 of new items. See attached existing Food Service<br>drawings which are provided for reference only.  |

#### VOLUME 1 OF 2: DIVISIONS 00 - 01

| 000001 | SEALS PAGE        |
|--------|-------------------|
| 000002 | TABLE OF CONTENTS |

#### **DIVISION 00 – PROCUREMENT AND CONTRACTING REQUIREMENTS (BY CM)**

| 000200 | NOTICE TO BIDDERS |
|--------|-------------------|
|        |                   |

- 001000 INSTRUCTIONS TO BIDDERS
- 001210 SUBSTITUTION REQUEST FORM
- 002000 INFORMATION AVAILABLE TO BIDDERS
- 003050 BIDDER REMINDER LIST
- 003100 BID FORM
- 003410 RESPONSIBLE BIDDING PRACTICES
- 003700 STANDARD FORMS
- 004100 BID BOND
- 004350 SUBCONTRACTORS AND PRODUCTS LIST
- 005000 STANDARD FORM OF AGREEMENT AIA 132 EXHIBIT A INSURANCE AND BONDS
  - SCHEDULE OF INSURANCE REQUIREMENTS
- 006100 PERFORMANCE BOND AND PAYMENT BOND
- 007000 AMENDED GENERAL CONDITIONS
- 008250 ESCROW AGREEMENT

### **DIVISION 01 – GENERAL REQUIREMENTS (BY CM)**

- 012000 MULTIPLE CONTRACT SUMMARY
- 012100 ALLOWANCES
- 012300 ALTERNATES
- 012500 CONTRACT MODIFICATION PROCEDURES
- 012800 SCHEDULE OF VALUES
- 012900 APPLICATION FOR PAYMENT
- 013100 PROJECT MEETINGS
- 013200 SCHEDULES AND REPORTS
- 013300 SUBMITTAL PROCEDURES
- 013310 ELECTRONIC MEDIA REQUEST FORM
- 013554 SECURITY REQUIREMENTS FOR WORK IN PENAL INSTITUTIONS
- 014000 QUALITY REQUIREMENTS
- 014510 TESTING LABORATORY SERVICES
- 015050 TEMPORARY FACILITIES AND CONTROLS
- 015110 TEMPORARY ELECTRICITY, LIGHTING AND WARNING SYSTEMS
- 015180 TEMPORARY FIRE PROTECTION
- 015260 RUBBISH CONTAINER
- 015320 TREE AND PLANT PROTECTION
- 015460 ENVIRONMENTAL PROTECTION
- 015620 DUST CONTROL
- 015690 HOUSEKEEPING AND SAFETY

| 015920 | OFFICES AND SHEDS   |
|--------|---------------------|
| 017150 | FINAL CLEANING      |
| 017250 | WORK LAYOUT         |
| 017310 | CUTTING AND PATCHIN |

- 017310 CUTTING AND PATCHING
- 017700 CONTRACT CLOSEOUT

# VOLUME 2 OF 3: DIVISIONS 02 – 12

### **DIVISION 02 – EXISTING CONDITIONS**

024119 SELECTIVE DEMOLITION

# **DIVISION 03 – CONCRETE**

033000 CAST-IN-PLACE CONCRETE 035416 HYDRAULIC CEMENT UNDERLAYMENT

# **DIVISION 04 – MASONRY**

042200 CONCRETE UNIT MASONRY

#### **DIVISION 05 – METALS**

| 050553 | SECURITY METAL FASTENINGS |
|--------|---------------------------|
| 051200 | STRUCTURAL STEEL FRAMING  |
| 055000 | METAL FABRICATIONS        |

### **DIVISION 06 – WOOD, PLASTICS AND COMPOSITES**

| 061053 | MISCELLANEOUS ROUGH CARPENTRY |
|--------|-------------------------------|
| 061600 | SHEATHING                     |

#### **DIVISION 07 – THERMAL AND MOISTURE PROTECTION**

079200 JOINT SEALANTS

# **DIVISION 08 – OPENINGS**

- 081113 HOLLOW METAL DOORS AND FRAMES
- 087100 DOOR HARDWARE
- 088853 SECURITY GLAZING

# **DIVISION 09 – FINISHES**

| 092216 | NON-STRUCTURAL METAL FRAMING   |
|--------|--------------------------------|
| 092900 | GYPSUM BOARD                   |
| 095113 | ACOUSTICAL PANEL CEILINGS      |
| 096513 | RESILIENT BASE AND ACCESSORIES |

- 096516 RESILIENT SHEET FLOORING
- 096519 RESILIENT TILE FLOORING
- 096725 SEAMLESS SHOWER COATINGS
- 097863 SAFETY PADDING
- 099123 INTERIOR PAINTING

# **DIVISION 10 – SPECIALTIES**

| 105114 | EVIDENCE STORAGE                   |
|--------|------------------------------------|
| 105143 | WIRE MESH TACTICAL STORAGE LOCKERS |
| 105613 | METAL STORAGE SHELVING             |
| 105626 | MOBILE STORAGE SHELVING            |

# **DIVISION 11 – EQUIPMENT**

| 111900 | DETENTION EQUIPMENT CONTRACTOR      |
|--------|-------------------------------------|
| 111901 | DETENTION FURNISHINGS AND EQUIPMENT |
| 111903 | SECURITY BARRIERS                   |
| 114000 | FOOD SERVICE EQUIPMENT              |

# **DIVISION 12 – FURNISHINGS**

- 123216 MANUFACTURED PLASTIC-LAMINATE-FACED CASEWORK
- 123661 SOLID SURFACING COUNTERTOPS

# **DIVISION 13 – SPECIAL CONSTRUCTION (NOT USED)**

# **DIVISION 14 – CONVEYING EQUIPMENT (NOT USED)**

# VOLUME 3 OF 3: DIVISIONS 21 – 28

# **DIVISION 21 – FIRE SUPPRESSION**

- 210500 COMMON WORK RESULTS FOR FIRE SUPPRESSION
- 210529 HANGERS AND SUPPORTS FOR FIRE-SUPPRESSION PIPING AND EQUIPMENT
- 210548.13 VIBRATION CONTROLS FOR FIRE-SUPPRESSION PIPING & EQUIPMENT
- 210553 IDENTIFICATION FOR FIRE-SUPPRESSION PIPING AND EQUIPMENT
- 211000 WATER-BASED FIRE-SUPPRESSION SYSTEM

#### **DIVISION 22 – PLUMBING**

- 220500 COMMON WORK RESULTS FOR PLUMBING
- 220523 GENERAL-DUTY VALVES FOR PLUMBING PIPING AND EQUIPMENT
- 220529 HANGERS AND SUPPORTS FOR PLUMBING PIPING AND EQUIPMENT
- 220553 IDENTIFICATION FOR PLUMBING PIPING AND EQUIPMENT
- 220593 TESTING, ADJUSTING AND BALANCING FOR PLUMBING
- 220719 PLUMBING PIPING INSULATION

- 220800 COMMISSIONING OF PLUMBING
- 221116 DOMESTIC WATER PIPING
- 221119 DOMESTIC WATER PIPING SPECIALTIES
- 221123.21 INLINE, DOMESTIC WATER PUMPS
- 221316 SANITARY WASTE AND VENT PIPING
- 221319 SANITARY WASTE PIPING SPECIALTIES
- 221319.13 SANITARY DRAINS
- 221723 FACILITY NATURAL-GAS PIPING
- 223400 FUEL-FIRED, DOMESTIC-WATER HEATERS
- 224200 COMMERCIAL PLUMBING FIXTURES
- 224600 SECURITY PLUMBING FIXTURES
- 224716 PRESSURE WATER COOLERS

# **DIVISION 23 – HEATING, VENTILATING AND AIR CONDITIONING**

| 230130.52 | EXISTING HVAC AIR DISTRIBUTION SYSTEM CLEANING     |
|-----------|--|
| 230500    | COMMON WORK RESULTS FOR HVAC                       |
| 230523    | GENERAL-DUTY VALVES FOR HVAC PIPING                |
| 230529    | HANGERS AND SUPPORTS FOR HVAC PIPING AND EQUIPMENT |
| 230548    | VIBRATION CONTROLS FOR HVAC                        |
| 230553    | IDENTIFICATION FOR HVAC PIPING AND EQUIPMENT       |
| 230593    | TESTING, ADJUSTING AND BALANCING FOR HVAC          |
| 230713    | DUCT INSULATION                                    |
| 230716    | HVAC EQUIPMENT INSULATION                          |
| 230719    | HVAC PIPING INSULATION                             |
| 230800    | COMMISSIONING OF HVAC                              |
| 230923    | DIRECT DIGITAL CONTROL (DDC) SYSTEM FOR HVAC       |
| 232113    | HYDRONIC PIPING                                    |
| 232116    | HYDRONIC PIPING SPECIALTIES                        |
| 232123    | HYDRONIC PUMPS                                     |
| 232300    | REFRIGERANT PIPING                                 |
| 232513    | WATER TREATMENT CLOSED-LOOP HYDRONIC SYSTEMS       |
| 233113    | METAL DUCTS  |
| 233300    | AIR DUCT ACCESSORIES                               |
| 233346    | FLEXIBLE DUCTS                                     |
| 233423    | HVAC POWER VENTILATORS                             |
| 233600    | AIR TERMINAL UNITS                                 |
| 233713.13 | AIR DIFFUSERS                                      |
| 233713.23 | REGISTERS AND GRILLES                              |
| 233713.43 | SECURITY REGISTERS AND GRILLES                     |
| 235123    | GAS VENTS  |
| 235216    | CONDENSING BOILERS                                 |
| 236423.13 | AIR-COOLED, SCROLL WATER CHILLERS                  |
| 237213    | HEAT WHEEL AIR-TO-AIR ENERGY RECOVERY UNITS        |
| 11711111  |  |

- 237313.13 INDOOR, BASIC AIR-HANDLING UNITS
- 238126 SPLIT-SYSTEM AIR-CONDITIONERS

# DIVISION 25 – INTEGRATED AUTOMATION (NOT USED) DIVISION 26 – ELECTRICAL

| 260010    | SUPPLEMENTAL REQUIREMENTS FOR ELECTRICAL                     |
|-----------|--|
| 260519    | LOW VOLTAGE ELECTRICAL POWER CONDUCTORS & CABLES             |
| 260523    | CONTROL-VOLTAGE ELECTRICAL POWER CABLES                      |
| 260526    | GROUNDING AND BONDING FOR ELECTRICAL SYSTEMS                 |
| 260529    | HANGERS AND SUPPORTS FOR ELECTRICAL SYSTEMS                  |
| 260533.13 | CONDUITS FOR ELECTRICAL SYSTEMS                              |
| 260533.16 | BOXES AND COVERS FOR ELECTRICAL SYSTEMS                      |
| 260544    | SLEEVES AND SLEEVE SEALS FOR ELECTRICAL RACEWAYS AND CABLING |
| 260553    | IDENTIFICATION FOR ELECTRICAL SYSTEMS                        |
| 260573.13 | SHORT-CIRCUIT STUDIES  |
| 260573.16 | COORDINATION STUDIES   |
| 260573.19 | ARC-FLASH HAZARD ANALYSIS                                    |
| 262726    | WIRING DEVICES   |
| 262813    | FUSES  |
| 262816    | ENCLOSED SWITCHES AND CIRCUIT BREAKERS                       |
| 262913.03 | MANUAL AND MAGNETIC MOTOR CONTROLLERS                        |
| 262923    | VARIABLE FREQUENCY MOTOR CONTROLLERS                         |
| 265119    | LED INTERIOR LIGHTING  |
|           |  |

# **DIVISION 27 – COMMUNICATIONS (NOT USED)**

# **DIVISION 28 – SAFETY AND SECURITY**

284621.11 ADDRESSABLE FIRE-ALARM SYSTEMS

#### END OF SECTION 000002

(THIS PAGE INTENTIONALLY LEFT BLANK)

# SECTION 096725 - SEAMLESS SHOWER COATINGS

# PART 1 - GENERAL

# 1.1 RELATED DOCUMENTS

A. Drawings and general provisions of the Contract, including General Conditions and Division 01 Specification Sections, apply to this Section.

#### 1.2 SUMMARY

- A. Section includes:
  - 1. Seamless resinous coatings for wall, ceiling and flooring applications.
    - a. Work includes surface preparation for resinous shower coatings.
- B. Related Sections:
  - 1. Section 079200 "Joint Sealants" for sealants installed at resinous systems' joints.

#### 1.3 REFERENCE STANDARDS

- A. ICRI No. 03732 | Selecting and Specifying Concrete Surface Preparation for Sealers, Coatings, and Polymer Overlays, CSP 1-9.
- B. ASTM F 2170 | Standard Test Method for Determining Relative Humidity in Concrete Slabs Using in situ Probes.
- C. SSPC Painting Volume 1 and 2.
- D. PDCA Standards 1-24.
- E. EPA Method 24.

#### 1.4 ADMINISTRATIVE REQUIREMENTS

- A. Pre-installation Meeting. Prior to the installation of the specified system, a meeting shall be held at the project site with the manufacturer's representative, the installer, the engineer/architect, construction manager, general contractor, and the Owner. General Contractor to document meeting discussions and furnish a copy to each participant. Meeting topics to include, but not be limited to:
  - 1. Planned start and completion timing for each mobilization.

- 2. Safety procedures.
- 3. Coordination of other trades in the area.
- 4. Existing and new slab conditions.
- 5. To discuss required testing.
- 6. Existing substrate conditions.
- 7. Surface preparation.
- 8. Required environmental conditions.
- 9. Installation sequencing and cure times.
- 10. Protection of completed work.

# 1.5 ACTION SUBMITTALS

- A. Product Data: For each type of product.
  - 1. Include product installation, application guide and SDS.
  - 2. Provide pertinent Detail Drawings including terminations, keyways, cove etc.
- B. Samples:
  - 1. Submit Samples for each resinous system specified herein, provide, when requested, a sample applied to a rigid backing, minimum size 3-inches x 3-inches.

# 1.6 QUALITY ASSURANCE

- A. References: Cited Standards are incorporated herein by reference and govern the work:
  - 1. Pamphlet No. 03732, International Concrete Repair Institute (Selecting and Specifying Concrete Surface Preparation for Sealers, Coatings and Polymer Overlays.
- B. Single Source Responsibility: Obtain primary resinous wall, floor and ceiling materials including hardening agents, finish or sealing coats from a single manufacturer with not less than five (5) years of successful experience in manufacturing and installing the principal materials described in this section. Provide secondary materials only of type and from a source recommended by the manufacturer of the primary material.
- C. Installer Qualifications: An authorized representative who is trained and approved by manufacturer. Provide the following proof of experience.
  - 1. Letter of training from the Approved Material manufacturer stating that contractor has been an approved installer for a minimum of five (5) years and has been successful in the installation of the manufacturers Approved Materials on ten (10) projects of similar complexity and size as this project.

- 2. List of ten (10) projects using the manufacturers Approved Materials on projects of similar complexity and size as this project including Owner's names, current phone number and list of material used on project.
- 3. Submit resume of the key person(s) who will be performing the actual work using the manufacturers Approved Materials and list a minimum of five (5) projects with different Owners including Owner's names, current phone number, and data sheets on the material used on project.
- D. Approved Manufacturer Supervision: A representative of the materials manufacturer must be present on site for the duration of the preparation and for all phases of the installation of the specified coating materials.

# 1.7 TOILET/SHOWER MOCKUP

- A. Apply a mockup of a shower unit for each coating system to establish a benchmark of finish, thickness, texture, process, color, and quality.
  - 1. Mockup location will be shown on the drawings.
  - 2. Mockup shall be applied to the specified substrate(s).
  - 3. Mockup shall show seamless shower coating terminations at floor, walls and ceiling.
  - 4. Mockup shall include a curb if required at seamless shower coating and adjacent floor transition.
  - 5. Mockup shall show seamless shower coating floor drain terminations.
  - 6. Approved mockups may become part of completed Work if undisturbed at the time of Substantial Completion.
  - 7. A 2-inch cant and 4-inch cove base to be included on the mockup.
  - 8. Cost of mockup shall be included in bid proposal.
  - 9. A meeting shall be held at the project site with the manufacturer's representative, the installer, the architect/engineer, general contractor, construction manager and owner's representative to review the completed mockup. General Contractor to document meeting discussions and furnish copy to each participant.

# 1.8 DELIVERY, STORAGE AND HANDLING

- A. Deliver materials to project site with labels legible and intact.
- B. Storage of materials:
  - 1. Store only acceptable project materials on site.
  - 2. Store in suitable location convenient to progress of work.
  - 3. Comply with health and fire regulations.
  - 4. Storage temperature shall be between 60 F and 90 F or such other ambient temperature conditions as may be specifically recommended by product manufacturer.

# 1.9 FIELD CONDITIONS

- A. Protection: Cover or otherwise protect finished work of other trades and surfaces not being coated concurrently or not to be coated.
- B. Lighting: Provide temporary lighting producing a minimum for 50-foot candles uniform distribution during resinous coating application.
- C. Mitigation of Damaging Conditions: Leaks from piping, condensate spills from air conditioning systems and other sources of intrusion upon the coating application area must be corrected prior to the commencement of the coating application.
- D. Environmental Limitations. Comply with coatings manufacturer's technical data sheet for acceptable substrate and ambient temperatures, concrete moisture levels, ventilation, and other environmental conditions that may negatively affect resinous flooring application or performance.
- E. Installation. Close spaces to traffic during coatings application and for not less that 48-hours after application unless manufacturer recommends a longer period.
- F. Airborne Contamination. Coating systems shall not be applied in areas where dust or other airborne particulate matter is being generated.

# 1.10 WARRANTY

- A. Manufacturer alone shall furnish a single, written warranty covering 100% of the material and labor costs protecting the Owner from delamination and product failure caused by defective product or defective installation for a period of five (5) years from date of installation. Joint warranties between manufacturer and installer not accepted.
  - 1. Issuance of warranty shall be a condition contingent on the receipt of final payment to the Installer.
  - 2. Extent of warranty shall be limited to the repair or replacement of defective surfaces at no cost to the Owner including both material and installation costs associated with any repairs or replacement of defective product or defective installation. The warranty shall not include any remedy for defects caused by abuse, improper maintenance, change of use or operation, or structural movement of building structure or moisture migration from the back side of coating system or by normal wear, tear and usage.
- B. The following items will not be included within the warranty: damage due to structural design deficiencies including, but not limited to, slab cracking from lateral, vertical or rotational movement, gouging from forklifts, heavy tools or other equipment, delamination caused by vapor transmission due to plumbing or external water issues effecting the moisture content of the substrate.

C. In cases of a warranty claim, the owner will notify the manufacturer/contractor in writing within thirty (30) days of the first appearance of problem. The owner will provide free and unencumbered access to the area during normal working hours for warranty rework. Property protection is also the owner's responsibility. Remedy is limited to direct repair of the manufacturer's system.

# PART 2 - PRODUCTS

# 2.1 SEAMLESS SHOWER COATING

- A. Basis-of-Design Product: Subject to compliance with requirements provide "5130 Seamless Shower Epoxy System" as manufactured by Prime Coat Coating Systems or a comparable product by one of the following:
  - 1. Decofloor Coating Systems.
  - 2. PPG Industries, Inc.
- B. Description: Consisting of 100% solids accelerated cycloaliphatic amine cured epoxy with chopped strand fiberglass and Kevlar® reinforcement with integrated Micro Guard anti-microbial topcoat.
  - 1. All components shall form a monolithic coating system that forms a continuous barrier with specified coating system without breaks in material including at interfaces of inside and outside corners and interfaces between walls and floors. System Characteristics/ Performance Requirements:
    - a. Color and Pattern. As selected by Owner from manufacturer's full range of flake colors.
    - b. Cant Base: 2-inch 45-degree style at showers.
    - c. Cove Base: 4-inch at Toilets.
    - d. System Thickness. Walls/Ceilings 60 mils WFT minimum, Floors 1/8-inch minimum.
    - e. VOC's. <50 g/lt per EPA Method 24 for each component.
    - f. Product Composition. 100% solids, cycloaliphatic, Bisphenol A epoxy with chopped strand fiberglass and Kevlar® reinforcement.
    - g. Wall Systems must be spray applied 100% solids with Fiberglass and Kevlar® strands premixed into both the Part A and Part B epoxy components. Must contain fiberglass strands sufficient to form a reinforced matrix/web within the resin.
    - h. High or Low Solids solvent based, and all water-based systems excluded.
    - i. Mat lay systems excluded.
    - j. Roller applied system excluded.
    - k. Integrated Micro Guard final finish as independently tested per JIS Z 2801 to reduce surface Microbes by 99.9997%.
    - I. Textures:

- 1) Walls/Ceilings: Texture A; Smooth.
- 2) Floors: Texture B; Mid-level slip resistant.
- 2. System Components:
  - a. Filler Coat: PC 615.
  - b. 2-inch Cant Cove: PC 311 TD.
  - c. Floor Primer Coat: PC 311 TD.
  - d. Broadcast Aggregate: PC 1332.
  - e. 2nd Primer Coat: PC 101 or PC 130.
  - f. Body Coat: PC 200 or PC 210.
  - g. Wear Coat: PC 280.
- 3. General Performance Requirements.
  - a. Resinous system shall meet minimum published standards in accordance with Prime Coat Coating Systems products as specified in this Section. In order, to create a true seamless environment, all coatings MUST be supplied and installed by one single manufacturer.
  - b. Resinous flooring system shall be properly sloped to drains to prevent ponding and may include a threshold if required to prevent water infiltration in the adjacent areas. Build-up system as required to provide a positive slope to the floor drains.
- B. Moisture Vapor Protection: All coatings applied to slab on grade shall include a moisture mitigation primer if there is no proof of an effective moisture vapor barrier in place. Moisture mitigation primer shall achieve a minimum rating of 0.1 PERM Rating for CLASS 1 Vapor Retarder per ASTM F 3010.
- C. Flexible Membrane: On all above grade showers manufacturer shall include in their system manufacturer's recommended fluid applied 30 mil flexible membrane to be attached directly to the concrete slab for added protection against micro cracking and protection against leaks.

# 2.2 MIXING

- A. Accomplish job mixing and application only when acceptable to the Architect/Engineer.
- B. Mix components only in containers furnished by the Manufacturer.
- C. Proportioning of two-part and three-part coatings shall be in strict accordance with methods recommended by the Manufacturer.
- D. Prime coat shall be mixed using a variable speed drill with a PS Jiffy blade. Parts A and B shall be mixed a minimum of two minutes. Ensure full blending of both parts with all material measured into the mixing container. Apply the mixed material within the pot life, induction times and temperatures recommended by the Manufacturer.

- E. Do not reseal mixed material. Permit final chemical set to occur in the container and when set has been achieved; dispose of hardened material by legal means.
- F. Do not apply any material that has exceeded shelf and pot life as determined by manufacturer.

# PART 3 - EXECUTION

#### 3.1 INSPECTION

- A. Examine surfaces scheduled to receive coating for conditions that will adversely affect execution, permanence or quality of work and which cannot be put into an acceptable condition through preparatory work as included in 3.2. Preparation of Surfaces.
- B. Notify Owner's agent immediately upon determination that surfaces scheduled to receive coating are unacceptable for proper adhesion or subsequent performance.
- C. Testing of Floor Slabs.
  - 1. Prior to the installation of resinous flooring, concrete should be tested for moisture content that could be detrimental to the long-term adhesion of coating materials. Tests below must be completed in accordance with the most recently revised Test Methods:
    - a. Relative Humidity in situ Testing per ASTM F 2170
    - b. Others as required by manufacturer or unique job conditions. If additional testing is required, additional costs may be incurred by Owner
- D. Testing Activities During Resinous Coating Application.
  - 1. Material Sampling. Owner's representative may at any time and any number of times during resinous coating application require the Owner's independent testing agency to collect material samples for testing for compliance with requirements.
    - a. Material samples will be taken, identified, sealed, and certified in presence of installer.
    - b. Testing agency will test samples for compliance with requirements at cost to the Owner, using applicable referenced testing procedures in addition to testing procedures listed in manufacturer's product data.
  - 2. If test results show applied materials do not comply with specified requirements, Installer shall correct all deficiencies of coating system in a method and manner acceptable to the manufacturer's recommendations.
- E. Do not proceed with surface preparation or coating application until conditions are suitable.

# 3.2 PREPARATION OF SURFACES

- A. General. Prepare and clean substrates in accordance with manufacturer's written instructions for substrate indicated.
- B. Concrete Floors: Concrete must be free of laitance, glaze, efflorescence, curing compounds, form-release agents, dust, dirt, grease, oil, and other contaminants, incompatible with floor coatings. Floor slabs shall be prepared as follows:
  - 1. Prepare per ICRI CSP 3-5, and diamond grind edges as required.
  - 2. Remove and legally dispose of all debris and contaminants generated by the surface preparation process.
  - 3. Steel media resulting from the shot blasted floor slab surface shall be removed from cracks, slab edges, construction joints, and corners by magnetic broom, vacuum, or stiff bristle broom.
  - 4. Chase cracks, non-moving joints with appropriate diamond blades.
  - 5. Cut and prepare keyway terminations per manufactures detailed drawings.
- C. Concrete Masonry Unit: Prior to installation of high-performance coatings, CMU walls shall receive a visual inspection by the onsite manufacturer's representative to assure that the substrate is acceptable for coating. The Masonry Contractor is to correct deficiencies.
  - 1. Mortar joints are struck clean and filled tightly to avoid gaps or holes and provide a neat, uniform appearance in accordance with procedures as outlined under Division 4 "Concrete Unit Masonry".
  - 2. Removal of all mortar spatter, protruding mortar edges, and other excessive mortar.
  - 3. All rough edges shall be ground smooth.
  - 4. CMU to be cleaned as specified under requirements as outlined under Division 4 "Concrete Unit Masonry".
  - 5. All surfaces shall be clean, dry and free of contaminants prior to installing coating system.
- D. Cement Board Ceilings: Prior to installation of high-performance coatings, cement board ceilings shall receive a visual inspection by the onsite manufacturer's representative to assure that the substrate is acceptable for coating. The Contractor is to correct deficiencies.
  - 1. All rough edges shall be ground smooth.
  - 2. Fill panel joints shall be filled tightly to avoid gaps for a neat, uniform appearance.

# 3.3 INSTALLATION

A. General Requirements: Apply components of resinous coating system according to manufacturer's written instructions to produce a uniform, monolithic wearing surface at the specified thickness. Coordinate application of components to provide optimum adhesion of resinous floor system to substrate.

- B. Installation:
  - 1. Do not apply initial coating until moisture content of surface is within limitations recommended by coating manufacturer and never install coatings when the substrate temperature is less than 5 degrees above dew point unless specifically approved, in writing, by the manufacturer.
  - 2. Keep all application equipment free from contaminates suitable for the finish required.
  - 3. Install moisture mitigation system to all slabs on grade as required.
  - 4. Install flexible waterproof membrane to all slabs that are above grade.
  - 5. Finish coats shall be smooth to the touch and free of skipped or missed areas. An orange peel texture with occasional fiberglass lumps is normal and acceptable.
  - 6. Floor texture to be approved by Owner through mock-up. Texture to be verified by Sullmair FSC200-1346 floor tester.
  - 7. Where walls, ceilings and floors abut and are both of a resinous material, obtain all coating materials from a single manufacturer being sure to meet all re-coat windows to insure a seamless installation.
  - 8. Make edges where adjoining other materials or colors, clean and sharp.
  - 9. Change colors at areas designated by Owner's agent and/or on color schedule where colors differ between adjoining spaces or rooms where door frames match wall colors.
  - 10. Prefill non-moving cracks, joints and keyways as needed to promote smooth floor transitions and terminations.
  - 11. Apply clear primer at 12 mils WFT or optional membrane at 30 mils DFT using 3/8-inch nap roller cover.
  - 12. Install 2-inch Cant cove to perimeter of shower room and 4-inch cove base at Toilets.
  - 13. When tacky (or next day), spray apply body coat at 45 mils WFT at right angles to substrates using good spray techniques. Check thickness often with wet film gauge.
  - 14. Sand off fiberglass and other imperfections using 120 grit or higher and then tack rag to remove dust.
  - 15. Apply pigmented wear coat at 8 mils WFT using 3/8" nap roller cover.
  - 16. Cut and fill dynamic joints as required/needed to allow for movement.
  - 17. Texture can be achieved in numerous ways. Make sure the texture has been demonstrated and approved prior to installation.

# 3.4 CURING

- A. Cure resinous flooring components according to manufacturer's written instructions.
  - 1. Temperatures shall be maintained at 65°F 85°F with less than 50% relative humidity.
  - 2. Water leaks must be prevented as they may damage finish sheen.
  - 3. Prevent contamination during curing processes

# 3.5 CLEANING

A. Remove debris promptly from work area and dispose of properly.

- B. Remove spilled, splashed, or splattered coating materials from all surfaces.
- C. Do not mar surface finish of items being cleaned.

END OF SECTION 096725

# SECTION 105626 – MOBILE STORAGE SHELVING

# PART 1 – GENERAL

#### 1.1 RELATED DOCUMENTS

A. Drawings and general provisions of the Contract, including General Conditions and Division 01 Specification Sections, apply to this Section.

#### 1.2 SUMMARY

- A. Section Includes:
  - 1. Mechanically assisted, carriage-mounted, high density mobile storage systems, including support rails, fabrication including leveling of support rails.
- B. Related Requirements:
  - 1. Section 033000 "Cast-in-Place Concrete".
    - a. Base floor capable of withstanding line load weight distribution created by load transfers from weight of system, storage housing, media and occupants.
    - b. Finished floor material and installation within system footprint.
  - 2. Sections in Division 9 Finishes, relating to finish floor and base materials.
- C. Related Work, Not Furnished:
  - 1. Finish floor covering materials and installation on concrete with recessed rail installation.

#### 1.3 REFERENCES

- A. American National Standards Institute (ANSI) Standards:
  - 1. Applicable standards for fasteners used for assembly.
- B. America Society of Testing and Materials (ASTM) Standards:
  - 1. Applicable standards for steel materials used for fabrication.
- C. American Institute of Steel Construction (AISC) Standards:
  - 1. Applicable standards for steel materials used for fabrication.

# 1.4 SYSTEMS DESCRIPTION

- A. General: The high-density mobile storage system consists of manufactured storage units mounted on manufacturer's track-guided carriages to form a compact storage system. System design permits access to any single aisle by manually moving units until the desired aisle is opened. The carriage/rail system provides uniform carriage movement along the total length of travel, even with unbalanced loads.
- B. Carriage System Design and Features: The welded carriage system with 3/4-inch recess consists of a formed structural steel frame with machined and balanced wheels riding on steel rails recessed mounted to the floor. Rails shall be types selected by the manufacturer to ensure smooth operation and self-centering of mobile storage units during travel without end play or binding. Rail types, quantities and spacing shall be selected by the manufacturer to suit installation conditions and requirements. All bearings used in the drive mechanism shall be permanently shielded and lubricated. Bolted carriages are unacceptable.
- C. Movement Controls: Triple arm operating wheels with rotating hand knobs shall be provided on the accessible (drive) ends of shelf units, centered on the end panel, located 40-inches from the base of each unit to permit units to be moved to create a single aisle opening. Turning the handle transmits power through chain drive to drive wheels on each carriage.
- D. Drive System: The system shall be designed with a positive type mechanically assisted drive which minimizes end play, ensures there is no play in the drive handle and that carriages will stop without drifting.
  - 1. System shall include a chain sprocket drive system for each movable carriage to ensure that carriages move uniformly along the total length of travel, even with unbalanced loads. All system components shall be selected to ensure a smooth, even movement along the entire carriage length. Drive system gearing shall be designed to permit 1 lb. of force applied to the drive-handle to move a minimum of 4,000 lbs. of load.
  - 2. A chain tensioning device shall be provided on each chain drive with provision for adjusting tension without removing end panels.
  - 3. All bearings used in the drive mechanism shall be permanently shielded and lubricated.
- E. Safety Features:
  - 1. Color-coded visual indicators shall provide verification that carriages are in a locked or unlocked mode.
  - 2. A single safety lock button, mounted on each operating wheel hub, will permit moving a carriage in either direction to create a new access aisle when pulled out (unlocked), or locking the carriage when pushed in.

- 3. Mechanical Sweep and Safety Stop (Non-Powered): Every potential aisle shall be protected with a 3-inch-high extruded aluminum safety sweep, hinged from the carriage using spring steel leaf springs, with the base edge maximum 3/4-inch from the floor. The carriage(s) shall stop when depressed at any location along the leading edge of the sweep surface. Activated safety sweep shall engage an impact-absorbing friction disk brake to protect occupants, stored media and the carriage system itself via a sheathed cable system comprised of aircraft-grade 3/64-inch stainless-steel core cables housed inside lined conduit. Safety sweep shall have bright, red and white safety identification tape applied full length marking its location. Safety sweep shall run full length of both sides of each moveable carriage for full aisle coverage.
- 4. Mechanical safety sweep shall automatically reset to enable mobile system users to freely and safely back carriages away from aisle obstructions simply by reversing the direction of the rotating handle.
- 5. Safety sweep shall be operational when the carriages are not moving. Should a sweep be activated in an open aisle, the carriage with the activated sweep will not close on that aisle. Safety sweep shall automatically reset if activated and then released when the carriages are not moving.
- 6. Safety sweeps shall require no electrical power or batteries to operate.
- F. Finishes:
  - 1. Fabricated Metal Components and Assembles: Manufacturer's standard powder coat paint finish.
  - 2. End Panels, Accessible Ends: Manufacturer's standard powder coat paint finish.

# 1.5 PERFORMANCE REQUIREMENTS

- A. Seismic Performance:
  - 1. Mobile shelving systems shall withstand the effects of earthquake motions determined according to ASCE/SEI7.
  - 2. Structural Performance:
    - a. Load per Linear Foot of Carriage and Rail: 1000 lb./ft.
    - b. Rail Deflection: Maximum not to exceed L/480.
- B. Ease of Movement:
  - 1. For mechanically assisted units capable of being moved by exerting a maximum horizontal force of 5 lbs. on the operating wheel.
- C. Design Requirements:
  - 1. Limit overall height to 102-inches.
  - 2. Limit overall length to 192-inches.

# 1.6 COORDINATION

- A. Recessed Tracks: Coordinate size and location of recesses in concrete with installation of recessed tracks.
  - 1. Include construction details, material descriptions, dimensions of individual components and profiles, and finishes for mobile shelving systems and accessories. This all must be verified prior to the installation of the concrete floor slab.

# 1.7 ACTION SUBMITTALS

- A. Product Data: Submit manufacturer's product literature and installation instructions for each type of shelving, track and installation accessory required. Include data substantiating that products to be furnished comply with requirements of the contract documents.
- B. Shop Drawings: Shop Drawings: Show fabrication, assembly, and installation details including descriptions of procedures and diagrams. Show complete extent of installation layout including clearances, spacings, and relation to adjacent construction in plan, elevation, details and sections. Indicate clear exit and access aisle widths; access to concealed components; assemblies, connections, attachments, reinforcement, and anchorage; and deck details, edge conditions, and extent of finish flooring within area where units are to be installed.
  - 1. Show installation details at non-standard conditions. Furnish floor layouts, technical and installation manuals for every unit shipment with necessary dimensions for rail layout and system configuration at the project site. Include installed weight, load criteria, furnished specialties, and accessories.
  - 2. Provide layout, dimensions, and identification of each unit corresponding to sequence of installation and erection procedures. Specifically include the following:
    - a. Location, position and configuration of tracks on all floors.
    - b. Plan layouts of positions of carriages, including all required clearances.
    - c. Details of shelving, indicating method and configuration of installation in carriages.
  - 3. Provide location and details of anchorage devices to be embedded in or fastened to other construction.
  - 4. Provide installation schedule and complete erection procedures to ensure proper installation.
- C. Samples:
  - 1. For each exposed product and for each color and texture specified, 6-inches in site.

- D. Samples for Initial Selections:
  - 1. For units with factory-applied finishes, 6-inches in size.
- 1.8 INFORMATIONAL SUBMITTALS:
  - A. Qualification Data:
    - 1. For Installer.
  - B. Sample Warranty:
    - 1. For manufacture's special warranty.

# 1.9 CLOSEOUT SUBMITTALS

A. Maintenance Data: For mobile shelving systems to include in maintenance manuals.

#### 1.10 MAINTENANCE MATERIALS SUBMITTALS

- A. Furnish extra materials that match products installed and that are packages with protective covering for storage and identified with labels describing contents.
  - 1. Shelf Units: Two (2) of each size and type indicated.

# 1.11 QUALITY ASSURANCE

- A. Installer Qualifications:
  - 1. Installer Qualifications: An entity that employs and supervisors who are trained and approved by manufacturer. Engage an experienced installer who is authorized by the manufacturer to install a high-density mobile system of this magnitude and has a minimum of two (2) year experience doing so.
    - a. Guaranteed 24-hour service response time.
- B. Manufacturer Qualifications:
  - 1. Engage an experienced manufacturer who is ISO 9001 certified for the design, production, installation and service of carriage mounted high-density mobile storage units and support rails. Furnish certificate attesting manufacturer's ISO 9001 quality system registration.
    - a. Manufacturer must have a minimum of ten (10)-years' experience in the manufacture of mechanically operated mobile storage systems.

# 1.12 FIELD CONDITIONS

- A. Field Measurements: Verify dimensions before fabrication. Indicate verified measurements on Shop Drawings. Coordinate fabrication and delivery to ensure no delay in progress of the Work.
- B. Established Dimensions: Where field measurements cannot be made without delaying the Work, establish dimensions and proceed with fabricating mobile storage units without field measurements. Coordinate construction to ensure actual dimensions correspond to established dimensions.

# 1.13 DELIVERY, STORAGE AND HANDLING

A. Follow manufacturer's instructions and recommendations for delivery, storage and handling requirements.

# 1.14 SEQUENCING AND SCHEDULING

- A. Coordinate the recessed steel rail locations, dimensions and details for the mobile storage units prior to the installation of the concrete floor slab in this area.
- B. Sequence high-density mobile storage system with adjoining work to minimize possibility of damage and soiling during entire construction period.
- C. Schedule installation of specified high-density mobile system after finishing operations, including painting have been completed.
- D. Delivery, Storage, and Handling:
  - 1. Comply with all instructions and recommendations made by manufacturer or manufacturer's representative for delivery, storage and handling requirements.
- E. Pre-installation Conference: Schedule and conduct conference on project site to review methods, procedures, and logistic details for coordination of installation of high-density mobile system.
  - 1. Required attendees:
    - a. Owner's representative.
    - b. Construction Manager or representatives.
    - c. Architect, engineer or person responsible for the layout design.
    - d. Manufacturer's representative
    - e. Subcontractors or installers whose work may affect or be affected by the installation of this system.

# 1.15 WARRANTY

- A. Special Warranty: Manufacturer agrees to repair or replace components of mobile shelving systems that fail in materials or workmanship within specified warranty period.
  - 1. Failures include, but are not limited to the following:
    - a. Deterioration of metals, metal finishes, and other materials beyond normal wear.
    - b. Structural failures including, but not limited to, excessive deflection.
    - c. Failure of operating components to function properly.
  - 2. Warranty Period:
    - a. Five (5) years for the entire movable compact shelving installation against defects in materials.
    - b. One (1) year from date of acceptance by Owner for workmanship.

# PART 2 - PRODUCTS

# 2.1 MANUFACTURERS

- A. Basis-of-Design Product:
  - 1. Subject to compliance with requirements provide "Mechanical Assist System" mobile storage shelving system as manufactured by Spacesaver Corporation or comparable products meeting the specification requirements by one of the following:
    - a. Datum Filing Systems, Inc.
    - b. Montel Inc.
    - c. Richard-Wilcox, Inc.
- B. Source Limitations: Obtain mobile storage systems including shelving from single manufacturer.

# 2.2 BASIC MATERIALS

A. General: Provide materials and quality of workmanship which meet or exceed established industry standards for products specified. Material thickness/gages are manufacturer's option unless indicated otherwise. Fabricated units from ASTM Class 1, cold-rolled commercial grade sheet or coil steel with all bends and radiuses consistent and true.

# 2.3 GROUT

- A. General:
  - 1. Shall be ready-mixed high strength; controlled expansive grout with superior dynamic load stability, which when mixed with water shall harden rapidly to produce a permanent foundation for the mobile storage system. Grout shall be non-corrosive, non-metallic a non-shrink. The grout after curing shall have a minimum strength of 8,000 pounds per square inch.

# 2.4 SYSTEMS AND COMPONENTS

- A. System Description: The system consists of manufactured storage units mounted on manufacturer's track-guided carriages to form a compact storage system. System design permits access to any single aisle by moving units until the desired aisle is opened. The manufacturer's proprietary unit interlock system shall prevent units from being moved while the open aisle is occupied. The carriage/rail system provides uniform carriage movement along the total length of travel, even with unbalanced loads.
- B. General: Provide manufacturer's standard mobile shelving systems and components. Where components are not otherwise indicated, provide manufacturer's standard components as required for a complete system.
- C. Rails:
  - 1. Rail shall be ASTM/AISI Type 1045 or 1035 steel of manufacturer's selection designed and manufactured to carry a load of 1,000 pounds per lineal foot of carriage length.
  - 2. Minimum Contact Surface: 5/8-inch wide.
  - 3. Provide rail sections in minimum 6-ft. lengths.
  - 4. Rail configuration shall permit attachment to top of structural floor system with provision for leveling rails to compensate for variations in floor surface level.
  - 5. Provide rail connections designed to provide horizontal and vertical continuity between rail sections, to gradually transfer for concentrated wheel point load to and from adjoining rail sections. Butt joints are not permitted.
  - 6. Rail Form Covers: Manufacturer shall provide for protection if required to prevent damage to rails during concrete back pours.
  - 7. Barrier free design.
- D. Carriages:
  - 1. Provide manufacturer's design movable carriages fabricated of welded or bolted steel construction. Galvanized structural components and/or riveted carriages are unacceptable.
  - 2. Provide fixed carriages of same construction and height as the movable carriages, anchored to rails. Setting fixed shelving directly on floors is not permitted.

- 3. When required, provide bolted carriage splices designed to maintain proper unit alignment and weigh load distribution.
- 4. Design carriages to allow the shelving uprights to recess and interlock into the carriage wheel section a minimum of 2-inches. Carriage design shall provide a minimum of two shelving retention rivets and two carriage bolts to securely retain each shelving post. Top mount carriages are unacceptable.
- 5. Provide each carriage with two (2) wheels per rail.
- E. Wheels:
  - 1. Low-Profile Wheel Section: Minimum 12 gage fixture-welded wheel sections to ensure that, once installed; bottom storage shelf is no higher than 4.25-inches above top of rail. Locate wheel assemblies under each upright to distribute loads directly to wheels.
  - 2. Wheel Size: Minimum 3-inches, outside diameter drive and lo wheels.
  - 3. Guide Wheels: All wheels and all locations
- F. Drive/Guide System:
  - 1. Guide Design: Provide drive system which prevents carriage whipping, binding and excessive wheel/rail wear under normal operation.
  - 2. Shafts: 1-inch solid steel connecting tube shafts.
  - 3. Shaft Connections: Secured couplings.
  - 4. Bearing Surfaces: Provide rotating load bearing members with ball or roller bearings. Provide shafts with pillow block or flanged self-aligning type bearings.
- G. End/Face Panels:
  - 1. Materials: Standard metal end panel.
  - 2. Finishes: Selected from manufacturer's standard paint colors.
- H. Operation:
  - 1. Hand push.
  - 2. Mechanical assist handles.
- I. Accessories:
  - 1. Optional Waist High Carriage Security Locks: Provide manufacturer's standard.

# 2.5 HIGH-DENSITY MOBILE STORAGE UNIT SHELVING

- A. Shelving Units: FIXED
  - 1. Type: Fixed Unit.
  - 2. Configuration: Single-faced units with full shelving back panels.
  - 3. Width: Refer to drawings.
  - 4. Height: Refer to drawings.

- 5. Shelf Depth: Refer to drawings.
- 6. Shelf Styles: Provide the following styles and numbers of adjustable shelves:
  - a. Bottom fixed with adjustable intermediate shelves, refer to drawings for number and location.
- 7 Carriage Heights: 5-15/16-inches.
- B. Mobile Shelving Units: MOBILE
  - 1. Type: Mobile Unit.
  - 2. Configuration: Double-faced units with full shelving back panels.
  - 3. Width: Refer to drawings.
  - 4. Height: Refer to drawings.
  - 5. Shelf Depth: Refer to drawings.
  - 6. Shelf Styles: Provided the following styles and numbers of adjustable shelves:
    - a. Bottom fixed with adjustable intermediate shelves, refer to drawings for number and location.
  - 7. Carriage Heights: 5-15/16-inches.

# 2.6 FABRICATION

- A. General: Coordinate fabrication and delivery to ensure no delay in progress of the Work.
- B. Wheels: Provide precision machined and balanced units with permanently shielded and lubricated bearings.
- C. Carriages: Fabricate to ensure no more than 1/4-inch maximum deviation from a true straight line. Splice and weld to ensure no permanent set or slippage in any spliced or welded joint when exposed to forces encountered in normal operating circumstances.
- D. Carriage Wheel Sections: Fabricate Carriage wheel sections to provide two heavy-duty 7 gage support plates to support the full weight of shelving posts.
- E. Carriage Side Profiles: Fabricate 14 gage die-formed carriage side profiles 2-3/4-inches tall each with four (4) shelving retention rivets.
- F. Rail Shims: Fabricate galvanized steel shims with interlocking tabs to prevent dislocation; interlocking tabs to interlock with rail and with other shims. For non-grouted systems only.

# 2.7 FINISHES

A. Colors: Selected from manufacturer's standard available colors.

B. Paint Finish: Provide factory applied electrostatic powder coat paint. Meet or exceed specifications of the American Library Association.

# PART 3 - EXECUTION

# 3.1 EXAMINATION:

- A. Examine areas, with Installer Present, for compliance with requirements for installation tolerances, location of framing and reinforcements and other conditions affecting performance of mobile shelving systems.
  - 1. For installations on existing floors, ensure that rail spacings indicated on shop drawings are in proper locations so existing load-bearing structural members are not over stressed.
- B. Proceed with installation only after unsatisfactory conditions have been corrected.
- C. Verify that intended installation locations of mobile storage units will not interfere with, nor block established required exit paths or similar means of egress once units are installed.
- 3.2 INSTALLTION:
  - A. Rails:
    - 1. Recessed Mount: Rail shall be ASTM/AISI 4140 steel bar 4-1/2-inches wide x 3/8-inch high with black zinc finish. Rail edges shall be beveled down to a maximum of 3/16-inch to allow for the rail to be transverse by material handling equipment. Rail shall disperse the wheel point loads to structural slab. Rail shall have two permanently mounted floor anchors maximum 15-inches on center. Recessed rails shall be installed on top of concrete slab and laid in a manor such that rail joints are staggered across all adjacent rail runs. Rail and carriage design allows concrete slab to be unleveled at the following maximum variation of 3/16-inch over any 2 ft. rail run and 1/4-inch maximum variation over any 10 ft. rail run.
    - 2. Lay out rails using full length units to the maximum extent possible. Use cut lengths only at the ends to attain total length required. Locate and position properly, following dimensions indicated on approved shop drawings. Verify thickness of finished floor materials to be installed (by others) and install level, 1/16-inch above finished floor surfaces.
    - 3. Set rails in full grout bed, completely filling any voids entire length of all rails, including rail connectors. Trim up sides flush with rails to ensure proper load transfer from rail to supporting floor. Using shims in lieu of full grouting is not permitted.
    - 4. Installation Tolerances: Do not exceed levelness of installed rails listed below:

- a. Maximum Variation from True Level Within Any Module: 3/32-inch.
- b. Maximum Variation Between Adjacent (Parallel) Rails: 1/16-inch, perpendicular to rail direction.
- c. Maximum Variation in Height: 1/32-inch, measured along any 10 ft. rail length.
- B. Shelving Units Installation:
  - 1. General: Follow layout and details shown on approved shop drawings and manufacturer's printed installation instructions. Position units level plumb; at proper location, relative to adjoining units and related work.
- C. Carriages:
  - 1. Position fixed carriage units to align with moveable units.
  - 2. Place movable carriages on rails. Ensure that all wheels track properly and centering wheels are properly seated on centering rails. Fasten multiple carriage units together to form single moveable base where required.
- D. Shelving Units:
  - 1. Permanently fasten shelving units to fixed and movable carriages with vibrationproof fasteners.
  - 2. Stabilize shelving units following manufacturer's written instructions. Reinforce shelving units to withstand the stress of movement where required and specified.
  - 3. Level and plumb shelving units to a tolerance of 1/8-inch in 96-inches.
  - 4. Starter/Adder Units: Connect groups together with standard fasteners according to manufacturer's written instructions, using concealed fasteners where possible.
  - 5. Install shelves in shelving units at locations indicated on Drawings and according to manufacturer's written instructions.
  - 6. Shelving Enclosure Panels: Install end panels and canopy tops with concealed fasteners

# 3.3 FIELD QUALITY CONTROL

- A. Verify shelving unit alignment and plumb after installation. Correct if required following manufacturer's instructions.
- B. Remove components which are chipped, scratched, or otherwise damaged and which do not match adjoining work. Replace with new matching units, installed as specified and in manner to eliminate evidence of replacement.

# 3.4 ADJUSTING

A. Adjust components and accessories to provide smoothly operating, visually acceptable installation.

# 3.5 CLEANING AND PROTECTING

- A. Repair or remove and replace defective work as described on completion of installation.
- B. Clean finished surfaces, touch up as required, and remove or refinish damaged or soiled areas to match original finish, as approved by Architect.
- C. Protect installed products from damage during remainder of the construction period.

# 3.5 DEMONSTRATION

- A. Engage a factory-authorized service representative to train Owner's maintenance personnel to adjust, operate, and maintain mobile storage shelving.
- B. Schedule and conduct maintenance training with Owner's maintenance personnel. Training session should include lecture and demonstration of all maintenance and repair procedures that end user personnel would normally perform.

# 3.6 PROTECTION

A. Protect system against damage during the remainder of construction period. Advise Owner of additional protection needed to ensure that system will be without damage or deterioration at time of substantial completion.

# END OF SECTION 105626

# (THIS PAGE INTENTIONALLY LEFT BLANK)

### SECTION 111903 - SECURITY BARRIERS

### PART 1 - GENERAL

### 1.1 RELATED DOCUMENTS

A. Prepare field quality-control certification endorsed by Detention Specialist that states installed products comply with requirements in the Contract Documents.

### 1.1 SUMMARY

- A. Section includes:
  - 1. Woven-rod-mesh security barriers at mezzanine walkways and stairways.
- B. Related Requirements:
  - 1. Section 050553 "Security Metal Fastenings" for anchoring or attaching building elements, furniture, equipment and fixtures within the secure perimeter.
  - 2. Section 051200 "Structural Steel Framing" for structural steel framing used for supporting the security barrier system.
  - 3. Section 055000 "Metal Fabrications" for miscellaneous steel framing and supports for the security barrier system.

### 1.2 REFERENCES

A. ASTM C423. Standard Test Method for Sound Absorption.

### 1.3 SUBMITTALS

- A. Shop Drawings: Manufacturer shall submit shop drawings, showing details of attachment to surround materials and elevations showing scope of the project.
- B. Samples of materials as may be requested without cost to owner: frame sections, woven rod panel, fasteners, mullion section, corner section, etc.

### 1.4 QUALIFICATIONS

A. Manufacturers bidding on this project must be actively engaged in the fabrication of specified items for a minimum of Ten (10) years prior to the bid date. Manufacturers requesting approval to bid their products as equal must submit to the Architect full-size drawings, including details of construction, and a complete full-size physical sample, Fourteen (14) days prior to the bid date.

### 1.5 SEQUENCING

- A. Sequence work to ensure security mesh and woven rod are not installed in interference or detriment of other trades.
- B. Install security units after interior wet work is dry.

### 1.6 DAYROOM MOCKUP

- A. Provide a mockup of a typical Dayroom to verify selections made under Sample submittals to set quality standards for materials and execution, to demonstrate aesthetic effects and set quality standards for materials and execution, and to set quality standards for installation.
  - 1. Mockup location will be shown on the drawings.
  - 2. Mockup should include stair and mezzanine security barrier systems and selected colors.
  - 3. A meeting shall be held at the project site with the manufacturer's representative, the installer, the architect/engineer, general contractor, and construction manager and owner to review the completed mockup. General Contractor to document meeting discussions and furnish copy to each participant.

### PART 2 - PRODUCTS

### 2.1 WOVEN ROD-MESH SECURITY BARRIERS **SB-1**

- A. Basis-of-Design Product: Subject to compliance with requirements provide "Model SV12Z Vantage Wall Barrier" at housing unit mezzanines and stairways as manufactured by Kane Innovations or an Architect/Owner approved comparable product prior to bidding.
- B. The main frame shall be built-up tubular type, measuring 1-3/4-inches by 2-1/2-inches with fixed concealment plates. The open channel frame members shall be formed of not less than 12-gage sheet steel and shall have individual slots along the inner edges to support the woven rod panel. The corners of the main frame shall be notched for self-aligning and robotically welded. Braces, which are similar to the frame, shall be furnished when required.
  - 1. Open Channel: Formed from 0.105-inch (12 gage) nominal-thickness steel sheet or channel with individual slots along inner edges to support woven-rod panels.
  - 2. Concealment Plates: Steel sheet to match open channel shall be welded to the back of the main frame approximately 8-inches on center to complete the tubular shape.
  - 3. Braces: Built-up tubular type measuring 1-1/4-inches x 2-1/2-inches with fixed concealment plates. Braces shall be formed of not less than 12-gage sheet steel and furnished when required.
- C. Rod Attachment-Woven rod panels shall be installed symmetrically into the slotted main frame. Slots shall be centered according to the rod pattern. Each rod shall penetrate each slot where it contacts the main frame. Every other rod shall be welded into the slot at both ends where it penetrates the main frame.

- D. Woven-Rod Panels: Formed from double crimped, 1/4-inch diameter steel rod, woven horizontally and vertically into a rigid grille with rods at 2-1/4-inches o.c.
  - 1. Steel Rod: Mild steel.
- E. Wall and Ceiling Anchors and Trim: Continuous mild-steel angle with 2-inches by-3/16-inch mild-steel flat bar.
- F. Materials:
  - 1. Mild-Steel Plates, Shapes, and Bars: ASTM A 36/A 36M.
  - 2. Steel Sheet: Cold-rolled ASTM A 1008/A 1008M or hot-rolled ASTM A 1011/A 1011M, CS (Commercial Steel), Type B; suitable for exposed applications.
  - 3. Steel Tubing: ASTM A 501 or ASTM A 513, Type B unless otherwise indicated.
- G. Finishes:
  - 1. Finish-All interior and exterior surfaces of the main frame, rods and concealment plates shall be thoroughly cleaned in a 5-step bonderizing process. The surfaces shall receive an electrostatically applied thermoplastic, polyester powder coating which shall be applied and baked to a hard mar-resistant finish: custom color selected by architect.
    - a. Color: Black

### 2.2 WOVEN ROD-MESH GLAZED SECURITY BARRIERS **SB-2**

- A. Basis-of-Design Product: Subject to compliance with requirements provide "Model S-G12-Z Level 8 Fixed Steel Secur-view Glazed Barrier" at housing unit mezzanines and stairways as manufactured by Kane Innovations or an Architect/Owner approved comparable product prior to bidding.
- B. The main frame shall be built-up tubular type, measuring 1-1/4-inches by 2-3/4-inches with fixed concealment plates. The open channel frame members shall be formed of not less than 12-gage sheet steel and shall have individual slots along the inner edges to support the woven rod panel. A glazing pocket 1/2-inch by 3/4-inch shall be opposite the rod panel. The corners of the main frame shall be notched for self-aligning and robotically welded.
- C. The 12 gage concealment plates shall be welded to the back of the main frame 8-inches o.c. to complete the tubular shape.
- D. Braces shall be built-up tubular, measuring 1-1/4-inch by 3-inches with fixed concealment plates. The 1/2-inch by 3/4-inch glazing pocket shall be opposite the woven rood panel. Braces shall be formed of not less than 12 gage sheet steel and furnished when required.
- E. The glazing covers of 12 gage steel shall be attached to the main frame approximately 12inches o.c. and be removable for glazing replacement.

- F. Perimeter Channel shall be a formed channel 1-inch by 1-17/32-inch by 1-inch of not less than 12 gage sheet steel. Channel provided in stock lengths with factory punched ¼-inch diameter holes approximately 12-inches o.c. for attachment to structure.
- G. Rods: Woven rood panels shall be fabricated from double crimped, low carbon, mild steel 1/4inch diameter rods, woven with 2-inch open space.
- H. Rod Attachment: Woven rod panels shall be installed symmetrically into the slotted main frame. Slots shall be centered according to the rod pattern. Each rod shall penetrate into each slot where it contacts the main frame. Every rod shall be welded into the slot at both ends where it penetrates the main frame.
- I. Glazing: 1/4-inch Polycarbonate.
- J. Materials:
  - 1. Mild-Steel Plates, Shapes, and Bars: ASTM A 36/A 36M.
  - 2. Steel Sheet: Cold-rolled ASTM A 1008/A 1008M or hot-rolled ASTM A 1011/A 1011M, CS (Commercial Steel), Type B; suitable for exposed applications.
  - 3. Steel Tubing: ASTM A 501 or ASTM A 513, Type B unless otherwise indicated.
- K. Finishes:
  - 1. Finish-All interior and exterior surfaces of the main frame, rods and concealment plates shall be thoroughly cleaned in a 5-step bonderizing process. The surfaces shall receive an electrostatically applied thermoplastic, polyester powder coating which shall be applied and baked to a hard mar-resistant finish: custom color selected by Architect.
    - a. Color: Black

### 2.3 ACCESSORIES

A. Touch-up Paint: Color to match screens and framing.

### 2.4 FABRICATION, GENERAL

- A. Shop Assembly: Preassemble items in shop to greatest extent possible to minimize field splicing and assembly. Disassemble units only as necessary for shipping and handling limitations. Use connections that maintain structural value of joined pieces. Clearly mark units for reassembly and coordinated installation.
- B. Coordinate dimensions and attachment methods of detention enclosures with those of adjoining construction to produce integrated assemblies with closely fitting joints and with edges and surfaces aligned unless otherwise indicated.
- C. Shear and punch metals cleanly and accurately. Remove burrs.

- D. Form and grind edges and corners to be free of sharp edges or rough areas.
- E. Form metal in maximum lengths to minimize joints. Form sheet-metal corners to smallest radius possible without causing grain separation or otherwise impairing the Work.
- F. Weld corners and seams continuously to comply with referenced AWS standard and the following:
  - 1. Use materials and methods that minimize distortion and develop strength and corrosion resistance of base metals.
  - 2. Obtain fusion without undercut or overlap.
  - 3. Remove welding flux immediately.
  - 4. Finish exposed welds and surfaces smooth and blended at exposed connections so that no roughness shows after finishing and contour of welded surface matches that of adjacent surface.
  - 5. Weld before finishing components to greatest extent possible. Remove weld spatter and welding oxides from exposed surfaces by descaling or grinding.
- G. Provide for anchorage of type indicated; coordinate with supporting structure. Fabricate and space anchoring devices to secure detention enclosures rigidly in place and to support indicated loads. Build in straps, plates, and brackets as needed to support and anchor fabricated items to adjoining construction. Reinforce formed-metal units as needed to attach and support other construction.
- H. Cut, reinforce, drill, and tap detention enclosures as indicated to receive hardware, security fasteners, and similar items.
- I. Form exposed work true to line and level with accurate angles, surfaces, and straight sharp edges.
- J. Form exposed connections with hairline joints flush and smooth using concealed fasteners where possible. Use exposed security fasteners of type indicated or, if not indicated, flat-head (countersunk) security screws. Locate joints where least conspicuous.

### 2.5 FABRICATION OF SECURITY BARRIERS

- A. Main Framing: Before inserting woven-rod panels, weld and grind smooth corners of open channel elements.
- B. Woven-Rod Panels: Insert panels symmetrically in main framing. Extend end of each rod at least 1-inch into main framing and, from inside of channel, weld into each slot where it contacts main framing.
- C. Concealment Plates: Weld plates to main framing with minimum 1-inch welds at minimum 10-inches o.c., staggered side to side and ground smooth, to form a fully enclosed tubular steel frame.

- D. Anchor Clips: For each enclosure panel, weld one anchor clip to secure side of main framing in line with vertical framing.
- E. Hardware Preparation: Mortise, reinforce, drill, and tap doors and main framings.
- F. Wire Cloth Attachment: Spot welded to the main frame 4-inches o.c.

### PART 3 - EXECUTION

- 3.1 EXAMINATION
  - A. Verify site conditions.
  - B. Verify that openings fit allowable tolerances, are plumb, level, provide a solid anchoring surface and comply with approved shop drawings.
- 3.2 INSTALLATION GENERAL
  - A. Install in accordance specifications and manufacturer's instructions.

### 3.3 INSTALLATION

- A. Install in accordance with approved shop drawings.
- B. Plumb and align faces in a single plane and erect barriers square and true, adequately anchored.
- C. After completion of installation, barriers shall be adjusted, in working order and clean.

### 3.4 ERECTION TOLERANCES

- A. Maximum Variation from Flat and Level Surface: 1/8-inch in 10 feet.
- B. Maximum Variation from Plumb of Grid Members Caused by Eccentric Loads: 2 degrees.

# END OF SECTION 111903

### SECTION 237313.13 - INDOOR, BASIC AIR-HANDLING UNITS

### PART 1 - GENERAL

### 1.1 SUMMARY

- A. Section Includes:
  - 1. Indoor, basic air-handling units.
  - 2. Unit casings.
  - 3. Fan, drive, and motor section.
  - 4. Coil section.
  - 5. Air filtration section.
  - 6. Dampers.

### 1.2 ACTION SUBMITTALS

- A. Product Data: For each air-handling unit.
  - 1. Include construction details, material descriptions, dimensions of individual components and profiles, and finishes.
  - 2. Include rated capacities, operating characteristics, electrical characteristics, and furnished specialties and accessories.
  - 3. Include unit dimensions and weight.
  - 4. Include cabinet material, metal thickness, finishes, insulation, and accessories.
  - 5. Fans:
    - a. Include certified fan-performance curves with system operating conditions indicated.
    - b. Include certified fan-sound power ratings.
    - c. Include fan construction and accessories.
    - d. Include motor ratings, electrical characteristics, and motor accessories.
  - 6. Include certified coil-performance ratings with system operating conditions indicated.
  - 7. Include filters with performance characteristics.
  - 8. Include dampers, including housings, linkages, and operators.
- B. Shop Drawings: For each type and configuration of indoor, basic, air-handling unit.
  - 1. Include plans, elevations, sections, and mounting details.
  - 2. Include details of equipment assemblies. Indicate dimensions, weights, loads, required clearances, method of field assembly, components, and location and size of each field connection.
  - 3. Detail fabrication and assembly of indoor, basic air-handling units, as well as procedures and diagrams.

- 4. Include diagrams for power, signal, and control wiring.
- C. Delegated Design Submittal: For vibration isolation, supports, and seismic restraints indicated to comply with performance requirements and design criteria, including analysis data signed and sealed by the qualified professional engineer responsible for their preparation.
  - 1. Design Calculations: Calculate requirements for selecting vibration isolators, supports, and for designing vibration isolation bases.

### 1.3 INFORMATIONAL SUBMITTALS

- A. Coordination Drawings: Floor plans and other details, or BIM model, drawn to scale, showing the items described in this Section, and coordinated with all building trades.
- B. Source quality-control reports.
- C. Startup service reports.
- D. Field quality-control reports.
- E. Sample Warranty: For manufacturer's warranty.

### 1.4 CLOSEOUT SUBMITTALS

A. Operation and Maintenance Data: For air-handling units to include in emergency, operation, and maintenance manuals.

### 1.5 MAINTENANCE MATERIAL SUBMITTALS

- A. Furnish extra materials that match products installed and that are packaged with protective covering for storage and identified with labels describing contents.
  - 1. Filters: One set(s) for each air-handling unit.
  - 2. Gaskets: One set(s) for each access door.
  - 3. Fan Belts: One set(s) for each air-handling unit fan.

### 1.6 WARRANTY

- A. Warranty: Manufacturer agrees to repair or replace components of indoor, basic, air-handling units that fail in materials or workmanship within specified warranty period.
  - 1. Warranty Period: Manufacturer's standard, but not less than one year(s) from date of Substantial Completion.

### PART 2 - PRODUCTS

### 2.1 PERFORMANCE REQUIREMENTS

- A. Electrical Components, Devices, and Accessories: Listed and labeled as defined in NFPA 70, by a qualified testing agency, and marked for intended location and application.
- B. NFPA Compliance: Comply with NFPA 90A for design, fabrication, and installation of airhandling units and components.
- C. ASHRAE 62.1 Compliance: Applicable requirements in ASHRAE 62.1, Section 5 "Systems and Equipment" and Section 7 "Construction and Startup."

"ASHRAE/IES 90.1 Compliance" Paragraph below may be required to comply with Project requirements or authorities having jurisdiction. Sustainable design may require minimum efficiency equal to requirements in ASHRAE/IES 90.1.

- D. ASHRAE/IES 90.1 Compliance: Applicable requirements in ASHRAE/IES 90.1, Section 6 "Heating, Ventilating, and Air-Conditioning."
- E. Delegated Design: Engage a qualified professional engineer, as defined in Section 014000 "Quality Requirements," to design vibration isolation, including comprehensive engineering analysis by a qualified professional engineer, using performance requirements and design criteria indicated.
- F. Structural Performance: Casing panels are to be self-supporting and capable of withstanding positive/negative 4-inch wg of internal static pressure, without exceeding a midpoint deflection of 0.005 inches/inch of panel span.

### 2.2 CAPACITIES AND CHARACTERISTICS

A. Refer to Mechanical Equipment Schedules for additional information.

### 2.3 INDOOR, BASIC AIR-HANDLING UNITS

- A. Manufacturers: Subject to compliance with requirements, provide products by one of the following:
  - 1. York, a Johnson Controls company.
  - 2. Trane.
  - 3. Carrier Corporation.
  - 4. Daikin Applied.
- B. Unit Casings:
  - 1. General Fabrication Requirements for Casings:
    - a. Forming: Form walls, roofs, and floors with at least two breaks at each joint.

- b. Joints: Sheet metal screws or pop rivets.
- c. Sealing: Seal all joints with water-resistant sealant. Hermetically seal at each corner and around entire perimeter.
- 2. Double-Wall Construction:
  - a. Outside Casing Wall: Galvanized steel, minimum 18 gauge thick, with manufacturer's standard finish.
  - b. Inside Casing Wall: G90 galvanized steel, solid, minimum 18 gauge thick.
  - c. Floor Plate: G90 galvanized steel, treadplate, minimum 18 gauge (1.3 mm) thick.
  - d. Casing Insulation:
    - 1) Materials: Glass-fiber blanket or board insulation, Type I or Type II ASTM C1071 or injected polyurethane foam insulation.
    - 2) Casing Panel R-Value: Minimum 12.
    - 3) Insulation Thickness: 1 inch.
    - 4) Thermal Break: Provide continuity of insulation with no through-casing metal in casing walls, floors, or roofs of air-handling unit.
- 3. Airstream Surfaces: Surfaces in contact with airstream are to comply with requirements in ASHRAE 62.1.
- 4. Panels and Doors:
  - a. Panels:
    - 1) Fabrication: Formed and reinforced with same materials and insulation thickness as casing.
    - 2) Fasteners: Two or more camlock type for panel lift-out operation. Arrangement is to allow panels to be opened against airflow.
    - 3) Gasket: Neoprene, applied around entire perimeters of panel frames.
    - 4) Size: Large enough to allow unobstructed access for inspection and maintenance of air-handling unit's internal components. At least 18 inches wide by full height of unit casing up to a maximum height of 72 inches.
  - b. Doors:
    - 1) Fabrication: Formed and reinforced with same materials and insulation thickness as casing.
    - 2) Hinges: A minimum of two ball-bearing hinges or stainless steel piano hinge and two wedge-lever-type latches, operable from inside and outside. Arrange doors to be opened against airflow. Provide safety latch retainers on doors so that doors do not open uncontrollably.
    - 3) Gasket: Neoprene, applied around entire perimeters of frame.
    - 4) Size: Large enough to allow for unobstructed access for inspection and maintenance of air-handling unit's internal components. At least 18 inches wide by full height of unit casing up to a maximum height of 60 inches
  - c. Locations and Applications:

- 1) Fan Section: Doors.
- 2) Coil Section: Panels.
- 3) Access Section: Doors.
- 4) Access Sections Immediately Upstream and Downstream of Coil Sections: Doors.
- 5) Damper Section: Doors.
- 6) Filter Section: Doors large enough to allow periodic removal and installation of filters.
- 7) Mixing Section: Doors.
- 5. Condensate Drain Pans:
  - a. Location: Each type of cooling coil.
  - b. Construction:
    - 1) Single-wall, stainless steel sheet.
  - c. Drain Connection:
    - 1) Located at lowest point of pan and sized to prevent overflow. Terminate with threaded nipple on both ends of pan.
    - 2) Minimum Connection Size: NPS 2.
  - d. Slope: Minimum 0.125 in./ft. slope, to comply with ASHRAE 62.1, in at least two planes to collect condensate from cooling coils (including coil piping connections, coil headers, and return bends) and from humidifiers, and to direct water toward drain connection.
  - e. Length: Extend drain pan downstream from leaving face for distance to comply with ASHRAE 62.1.
  - f. Width: Entire width of water producing device.
  - g. Depth: A minimum of 2 inches deep.
- C. Fan, Drive, and Motor Section:
  - 1. Fan and Drive Assemblies: Statically and dynamically balanced and designed for continuous operation at maximum-rated fan speed and motor horsepower.
  - 2. Fans: Centrifugal, galvanized steel; mounted on solid-steel shaft.
    - a. Shafts: With field-adjustable alignment.
      - 1) Turned, ground, and polished hot-rolled steel with keyway.
    - b. Shaft Bearings:
      - 1) Heavy-duty, self-aligning, pillow-block type with an L-50 rated life of minimum 200,000 hours in accordance with ABMA 9.
    - c. Housings: Formed- and reinforced-steel panels to form curved scroll housings with shaped cutoff and spun-metal inlet bell.

- 1) Bracing: Steel angle or channel supports for mounting and supporting fan scroll, wheel, motor, and accessories.
- d. Housings, Plenum Fans: Steel frame and panel; fabricated without fan scroll and volute housing. Provide inlet screens for Type SWSI fans.
- e. Forward-Curved, Centrifugal Fan Wheels: Inlet flange, backplate, and shallow blades with inlet and tip curved forward in direction of airflow and mechanically fastened to flange and backplate; steel hub swaged to backplate and fastened to shaft with setscrews.
- f. Airfoil, Centrifugal Fan Wheels (Plenum Fan Wheels): Smooth-curved inlet flange, backplate, and hollow die-formed airfoil-shaped blades continuously welded at tip flange and backplate; steel hub riveted to backplate and fastened to shaft with setscrews.
- g. Mounting: For internal vibration isolation. Factory-mount fans with manufacturer's standard vibration isolation mounting devices having a minimum static deflection of 1 inch.
- h. Shaft Lubrication Lines: Extended to a location outside the casing.
- Flexible Connector: Factory fabricated with a fabric strip minimum 3-1/2 inches (89 mm) wide, attached to two strips of minimum 2-3/4-inch- (70-mm-) wide by 0.028-inch- (0.7-mm-) thick, galvanized-steel sheet.
  - 1) Flexible Connector Fabric: Glass fabric, double coated with neoprene. Fabrics, coatings, and adhesives are to comply with UL 181, Class 1.
- 3. Drive, Direct: Factory-mounted, direct drive.
- 4. Drive, Belt: Factory-mounted, V-belt drive, with adjustable alignment and belt tensioning, and with [1.5] [1.25] service factor based on fan motor.
  - a. Pulleys: Cast iron or cast steel with split, tapered bushing, dynamically balanced at the factory.
  - b. Belts: Oil resistant, non-sparking and nonstatic; in matched sets for multiple-belt drives.
  - c. Belt Guards: Comply with requirements specified by OSHA and fabricate in accordance with SMACNA's "HVAC Duct Construction Standards"; 0.146-inch-thick, 3/4-inch diamond-mesh wire screen, welded to steel angle frame; prime coated.
- 5. Motors:
  - a. Comply with NEMA designation, temperature rating, service factor, and efficiency requirements for motors specified in Section 230500 "Common Work Results for HVAC."
  - b. Motor Sizes: Minimum size as indicated. If not indicated, large enough so driven load will not require motor to operate in service factor range above 1.0.
  - c. Enclosure Type: Totally enclosed, fan cooled.
  - d. Efficiency: Premium efficient as defined in NEMA MG 1.
  - e. NEMA Design: MG 1.

- f. Controllers, Electrical Devices, and Wiring: Comply with requirements for electrical devices and connections specified in electrical Sections.
- 6. Comply with Section 262923 "Variable-Frequency Motor Controllers."
- 7. Variable-Frequency Motor Controller: Serving all fans.
  - a. Manufactured Units: Pulse-width modulated; constant torque and variable torque for inverter-duty motors.
  - b. Output Rating: Three phase; 10 to 60 Hz, with voltage proportional to frequency throughout voltage range; maximum voltage equals input voltage.
  - c. Unit Operating Requirements:
    - 1) Internal Adjustability:
      - a) Minimum Speed: 5 to 25 percent of maximum rpm.
      - b) Maximum Speed: 80 to 100 percent of maximum rpm.
      - c) Acceleration: 0.1 to 999.9 seconds.
      - d) Deceleration: 0.1 to 999.9 seconds.
      - e) Current Limit: 30 to minimum of 150 percent of maximum rating.
    - 2) Self-Protection and Reliability Features:
      - a) Surge suppression.
      - b) Loss of input signal protection.
      - c) Under- and overvoltage trips.
      - d) Variable-frequency motor controller and motoroverload/overtemperature protection.
      - e) Critical frequency rejection.
      - f) Loss-of-phase protection.
      - g) Reverse-phase protection.
      - h) Motor-overtemperature fault.
    - 3) Bidirectional autospeed search.
    - 4) Torque boost.
    - 5) Motor temperature compensation at slow speeds.
      - a) Panel-mounted operator station.
      - b) Historical logging information and displays.
      - c) Digital indicating devices.
    - 6) Control Signal Interface: Electric.
    - 7) Proportional Integral Directive (PID) control interface.
    - 8) DDC system for HVAC Protocols for Network Communications: ASHRAE 135.
  - d. Line Conditioning:
    - 1) Input line conditioning.
    - 2) Output filtering.

### 3) EMI/RFI filtering.

- D. Coil Section:
  - 1. General Requirements for Coil Section:
    - a. Comply with AHRI 410.
    - b. Fabricate coil section to allow removal and replacement of coil for maintenance and to allow in-place access for service and maintenance of coil(s).
    - c. Coils are not to act as structural component of unit.
    - d. Hot-Water Coils: Continuous circuit.
      - 1) Piping Connections: Threaded or Flanged, same end of coil.
      - 2) Tube Material: Copper.
      - 3) Fin Type: Plate.
      - 4) Fin Material: Aluminum.
      - 5) Fin and Tube Joint: Silver brazed.
      - 6) Headers:
        - a) Cast iron with cleaning plugs and drain and air vent tappings extended to exterior of unit.
        - b) Seamless copper tube with brazed joints, prime coated.
        - c) Fabricated steel, with brazed joints, prime coated.
        - d) Provide insulated cover to conceal exposed outside casings of headers.
      - 7) Frames: Channel frame, minimum 0.052-inch- thick galvanized steel.
      - 8) Coil Working-Pressure Ratings: 200 psig
      - 9) Coating: Corrosion-resistant coating.
  - 2. Cooling Coils:
    - a. Chilled-Water Coils: Continuous circuit.
      - 1) Piping Connections: Threaded or Flanged, same end of coil.
      - 2) Tube Material: Copper.
      - 3) Fin Type: Plate.
      - 4) Fin Material: Aluminum.
      - 5) Fin and Tube Joint: Silver brazed.
      - 6) Headers:
        - a) Cast iron with cleaning plugs and drain and air vent tappings extended to exterior of unit.
        - b) Seamless copper tube with brazed joints, prime coated.
        - c) Fabricated steel, with brazed joints, prime coated.
        - d) Provide insulated cover to conceal exposed outside casings of headers.

- 7) Frames: Channel frame, minimum 0.052-inch- thick galvanized steel.
- 8) Coil Working-Pressure Ratings: 200 psig
- 9) Coating: Corrosion-resistant coating.
- E. Air Filtration Section:
  - 1. Particulate air filtration is specified in Section 234100 "Particulate Air Filtration."
  - 2. Panel Filters:
    - a. Description: Pleated factory-fabricated, self-supported disposable air filters with holding frames.
    - b. Filter Unit Class: UL 900.
    - c. Media: Interlaced glass, synthetic, or cotton fibers coated with nonflammable adhesive and antimicrobial coating.
    - d. Filter-Media Frame: High wet-strength beverage board with perforated metal retainer, or metal grid, on outlet side.
  - 3. Side-Access Filter Mounting Frames:
    - a. Particulate Air Filter Frames: Match inner casing and outer casing material, and insulation thickness. Galvanized steel track.
      - 1) Sealing: Incorporate positive-sealing device to ensure seal between gasketed material on channels to seal top and bottom of filter cartridge frames to prevent bypass of unfiltered air.
- F. Dampers:
  - 1. Outdoor- and Return-Air Dampers: Low-leakage, double-skin, airfoil-blade, galvanizedsteel dampers with compressible jamb seals and extruded-vinyl blade edge seals in opposed-blade arrangement with zinc-plated steel operating rods rotating in sintered bronze or nylon bearings mounted in a single galvanized-steel frame, and with operating rods connected with a common linkage. Leakage rate is not to exceed 4 cfm/sq. ft. at 1inch wg and 8 cfm/sq. ft. at 4-inch wg, tested, rated, and labeled in accordance with AMCA 511.
  - 2. Electronic Damper Operators:
    - a. Direct-coupled type designed for minimum 60,000 full-stroke cycles at rated torque.
    - b. Electronic damper position indicator is to have visual scale indicating percent of travel and 2- to 10-V dc, feedback signal.
    - c. Operator Motors:
      - Comply with NEMA designation, temperature rating, service factor, enclosure type, and efficiency requirements for motors specified in Section 230500 "Common Work Results for HVAC."
      - 2) Size to operate with sufficient reserve power to provide smooth modulating action or two-position action.
      - 3) Permanent Split-Capacitor or Shaded-Pole Type: Gear trains completely oil immersed and sealed. Equip spring-return motors with integral spiral-spring mechanism in housings designed for easy removal for service or

adjustment of limit switches, auxiliary switches, or feedback potentiometer.

- d. Nonspring-Return Motors for Dampers Larger Than 25 Sq. Ft. (2.3 sq. m): Size for running torque of 150 in. x lbf (16.9 N x m) and breakaway torque of 300 in. x lbf (33.9 N x m).
- e. Spring-Return Motors for Dampers Larger Than 25 Sq. Ft. (2.3 sq. m): Size for running and breakaway torque of 150 in. x lbf (16.9 N x m).
- f. Size dampers for running torque calculated as follows:
  - 1) Parallel-Blade Damper with Edge Seals: 7 inch-lb/sq. ft. (86.8 kg-cm/sq. m) of damper.
  - 2) Opposed-Blade Damper with Edge Seals: 5 inch-lb/sq. ft. (62 kg-cm/sq. m) of damper.
  - 3) Parallel-Blade Damper without Edge Seals: 4 inch-lb/sq. ft. (49.6 kgcm/sq. m) of damper.
  - 4) Opposed-Blade Damper without Edge Seals: 3 inch-lb/sq. ft. (37.2 kgcm/sq. m) of damper.
  - 5) Dampers with 2- to 3-Inch wg (500 to 750 Pa) of Pressure Drop or Face Velocities of 1000 to 2500 fpm (5 to 13 m/s): Increase running torque by 1.5.
  - 6) Dampers with 3- to 4-Inch wg (750 to 1000 Pa) of Pressure Drop or Face Velocities of 2500 to 3000 fpm (13 to 15 m/s): Increase running torque by 2.0.
- g. Coupling: V-bolt and V-shaped, toothed cradle.
- h. Overload Protection: Electronic overload or digital rotation-sensing circuitry.
- i. Fail-Safe Operation: Mechanical, spring-return mechanism with external, manual gear release on nonspring-return actuators.
- j. Power Requirements (Two-Position Spring Return): 24 V dc.
- k. Power Requirements (Modulating): Maximum 10 VA at 24 V ac or 8 W at 24 V dc.
- I. Proportional Signal: 2 to 10 V dc or 4 to 20 mA, and 2- to 10-V dc position feedback signal.
- m. Temperature Rating: Minus 22 to plus 122 deg F
- n. Run Time: 12 seconds open, 5 seconds closed.
- 3. Mixing Section: Multiple-blade, air-mixer assembly located immediately downstream of mixing section.
- 4. Combination Filter and Mixing Section:
  - a. Cabinet support members are to hold 2-inch- thick, pleated, flat, permanent or throwaway filters.
- G. Air Blenders:
  - 1. Multiple-blade, air-mixer assembly is to mix air to prevent stratification, located immediately downstream of mixing box.
- H. Materials:

- 1. Steel:
  - a. ASTM A36/A36M for carbon structural steel.
  - b. ASTM A568/A568M for steel sheet.
- 2. Stainless Steel:
  - a. Manufacturer's standard grade for casing.
  - b. Manufacturer's standard type, ASTM A240/A240M for bare steel exposed to airstream or moisture.
- 3. Galvanized Steel: ASTM A653/A653M.
- 4. Aluminum: ASTM B209.
  - a. Standards:
    - 1) ASTM B117 for salt spray.
    - 2) ASTM D2794 for minimum impact resistance of 100 in-lb (11.3 N-m).
    - 3) ASTM B3359 for cross hatch adhesion of 5B.
  - b. Application: Immersion.
  - c. Thickness: 1 mil.
  - d. Gloss: Minimum gloss of 60 on a 60-degree meter.
- 2.4 SOURCE QUALITY CONTROL
  - A. AHRI 430 Certification: Test, rate, and label air-handling units and their components in accordance with AHRI 430.
  - B. AHRI 260 or AMCA 311 Sound Performance Rating Certification: Test, rate, and label in accordance with AHRI 260 or AMCA 311.
  - C. Fan Aerodynamic Performance Rating: Factory test and rate fan performance for airflow, pressure, power, air density, rotation speed, and efficiency in accordance with AMCA 210.
  - D. Fan Energy Index (FEI): Test in accordance with AMCA 210 and rate in accordance with AMCA 99, AMCA 207, and AMCA 208.
  - E. Fan Operating Limits: Classify fans in accordance with AMCA 99, Section 14.
  - F. Water Coils: Factory tested to 300 psig (2070 kPa) in accordance with AHRI 410 and ASHRAE 33.

### PART 3 - EXECUTION

### 3.1 EXAMINATION

- A. Examine areas and conditions, with Installer present, for compliance with requirements for installation tolerances and other conditions affecting performance of the Work.
- B. Examine casing insulation materials and filter media before air-handling unit installation. Replace with new insulation materials and filter media that are wet, moisture damaged, or mold damaged.
- C. Examine roughing-in for steam, hydronic, and condensate drainage piping systems and electrical services to verify actual locations of connections before installation.
- D. Proceed with installation only after unsatisfactory conditions have been corrected.

### 3.2 INSTALLATION OF INDOOR, BASIC AIR-HANDLING UNITS

- A. Equipment Mounting:
  - 1. Install air-handling units on cast-in-place concrete equipment bases. Coordinate sizes and locations of concrete bases with actual equipment provided. Comply with requirements for equipment bases and foundations specified in Section 033000 "Cast-in-Place Concrete."
  - 2. Comply with requirements for vibration isolation devices specified in Section 230548.13 "Vibration Controls for HVAC."
- B. Arrange installation of units to provide access space around air-handling units for service and maintenance.
- C. Do not operate fan system until filters (temporary or permanent) are in place. Replace temporary filters used during construction and testing with new, clean filters.
- D. Connect duct to air-handling units with flexible connections. Comply with requirements in Section 233300 "Air Duct Accessories."

### 3.3 PIPING CONNECTIONS

- A. Piping installation requirements are specified in other Sections. Drawings indicate general arrangement of piping, fittings, and specialties.
- B. Where installing piping adjacent to air-handling unit, allow for service and maintenance.
- C. Connect piping to air-handling units mounted on vibration isolators with flexible connectors.

- D. Connect condensate drain pans using NPS 1-1/4, ASTM B88, Type M copper tubing. Extend to nearest equipment or floor drain. Construct deep trap at connection to drain pan and install cleanouts at changes in direction.
- E. Hot- and Chilled-Water Piping: Comply with applicable requirements in Section 232113 "Hydronic Piping" and Section 232116 "Hydronic Piping Specialties." Install shutoff valve and union or flange at each coil supply connection. Install balancing valve and union or flange at each coil return connection.

# 3.4 ELECTRICAL CONNECTIONS

- A. Connect wiring in accordance with Section 260519 "Low-Voltage Electrical Power Conductors and Cables."
- B. Ground equipment in accordance with Section 260526 "Grounding and Bonding for Electrical Systems."
- C. Install electrical devices furnished by manufacturer, but not factory mounted, in accordance with NFPA 70 and NECA 1.
- D. Install nameplate for each electrical connection, indicating electrical equipment designation and circuit number feeding connection.
  - 1. Nameplate is to be laminated acrylic or melamine plastic signs with a black background and engraved white letters at least 1/2 inch (13 mm) high.

### 3.5 CONTROL CONNECTIONS

- A. Install control and electrical power wiring to field-mounted control devices.
- B. Connect control wiring in accordance with Section 260523 "Control-Voltage Electrical Power Cables."

### 3.6 STARTUP SERVICE

- A. Engage a factory-authorized service representative to perform startup service.
  - 1. Complete installation and startup checks in accordance with manufacturer's written instructions.
  - 2. Verify that shipping, blocking, and bracing are removed.
  - 3. Verify that unit is secure on mountings and supporting devices and that connections to piping, ducts, and electrical systems are complete. Verify that proper thermal-overload protection is installed in motors, controllers, and switches.
  - 4. Verify proper motor rotation direction, free fan wheel rotation, and smooth bearing operations. Reconnect fan drive system, align belts, and install belt guards.
  - 5. Verify that bearings, pulleys, belts, and other moving parts are lubricated with factoryrecommended lubricants.

- 6. Verify that outdoor- and return-air mixing dampers open and close, and maintain minimum outdoor-air setting.
- 7. Comb coil fins for parallel orientation.
- 8. Verify that proper thermal-overload protection is installed for electric coils.
- 9. Install new, clean filters.
- 10. Verify that manual and automatic volume control and fire and smoke dampers in connected duct systems are in fully open position.
- B. Starting procedures for air-handling units include the following:
  - 1. Energize motor; verify proper operation of motor, drive system, and fan wheel. Adjust fan to indicated rpm. Replace fan and motor pulleys as required to achieve design conditions.
  - 2. Measure and record motor electrical values for voltage and amperage.
  - 3. Manually operate dampers from fully closed to fully open position and record fan performance.

### 3.7 ADJUSTING

- A. Adjust damper linkages for proper damper operation.
- B. Comply with requirements in Section 230593 "Testing, Adjusting, and Balancing for HVAC" for air-handling system testing, adjusting, and balancing.
- C. Occupancy Adjustments: When requested within 12 months from date of Substantial Completion, provide on-site assistance in adjusting system to suit actual occupied conditions. Provide up to two visits to Project during other-than-normal occupancy hours for this purpose.

### 3.8 CLEANING

A. After completing system installation and testing, adjusting, and balancing of air-handling unit and air-distribution systems, and after completing startup service, clean air-handling units internally to remove foreign material and construction dirt and dust. Clean fan wheels, cabinets, dampers, coils, and filter housings, and install new, clean filters.

### 3.9 FIELD QUALITY CONTROL

- A. Testing Agency: Contractor will engage a qualified testing agency to perform tests and inspections.
- B. Manufacturer's Field Service: Engage a factory-authorized service representative to test and inspect components, assemblies, and equipment installations, including connections.
- C. Perform the following tests and inspections with the assistance of a factory-authorized service representative:

- 1. Leak Test: After installation, fill water and steam coils with water, and test coils and connections for leaks.
- 2. Charge refrigerant coils with refrigerant and test for leaks.
- 3. Fan Operational Test: After electrical circuitry has been energized, start units to confirm proper motor rotation and unit operation.
- 4. Air-handling unit and components will be considered defective if unit or components do not pass tests and inspections.
- 5. Prepare test and inspection reports.

### 3.10 DEMONSTRATION

A. Engage a factory-authorized service representative to train Owner's maintenance personnel to adjust, operate, and maintain air-handling units.

END OF SECTION 237313.13

THIS PAGE INTENTIONALLY LEFT BLANK

### SECTION 238126 - SPLIT-SYSTEM AIR-CONDITIONERS

### PART 1 - GENERAL

### 1.1 RELATED DOCUMENTS

A. Drawings and general provisions of the Contract, including General Conditions and Division 01 Specification Sections, apply to this Section.

### 1.2 SUMMARY

A. Section includes split-system air-conditioning and heat-pump units consisting of separate evaporator-fan and compressor-condenser components.

### 1.3 ACTION SUBMITTALS

- A. Product Data: For each type of product indicated. Include rated capacities, operating characteristics, and furnished specialties and accessories. Include performance data in terms of capacities, outlet velocities, static pressures, sound power characteristics, motor requirements, and electrical characteristics.
- B. Shop Drawings: Include plans, elevations, sections, details, and attachments to other work.
  - 1. Detail equipment assemblies and indicate dimensions, weights, loads, required clearances, method of field assembly, components, and location and size of each field connection.
  - 2. Wiring Diagrams: For power, signal, and control wiring.

### 1.4 INFORMATIONAL SUBMITTALS

- A. Field quality-control reports.
- B. Warranty: Sample of special warranty.

### 1.5 CLOSEOUT SUBMITTALS

A. Operation and Maintenance Data: For split-system air-conditioning units to include in emergency, operation, and maintenance manuals.

### 1.6 MAINTENANCE MATERIAL SUBMITTALS

- A. Furnish extra materials that match products installed and that are packaged with protective covering for storage and identified with labels describing contents.
  - 1. Filters: One set(s) for each air-handling unit.
  - 2. Gaskets: One set(s) for each access door.
  - 3. Fan Belts: One set(s) for each air-handling unit fan.

### 1.7 QUALITY ASSURANCE

- A. Electrical Components, Devices, and Accessories: Listed and labeled as defined in NFPA 70, by a qualified testing agency, and marked for intended location and application.
- B. ASHRAE Compliance:
  - 1. Fabricate and label refrigeration system to comply with ASHRAE 15, "Safety Standard for Refrigeration Systems."
  - ASHRAE Compliance: Applicable requirements in ASHRAE 62.1, Section 4 "Outdoor Air Quality," Section 5 - "Systems and Equipment," Section 6 - " Procedures," and Section 7 -"Construction and System Start-up."
- C. ASHRAE/IES Compliance: Applicable requirements in ASHRAE/IES 90.1.

# 1.8 COORDINATION

- A. Coordinate sizes and locations of concrete bases with actual equipment provided. Cast anchorbolt inserts into bases. Concrete, reinforcement, and formwork are specified in Section 033000 "Cast-in-Place Concrete."
- B. Coordinate sizes and locations of roof curbs, equipment supports, and roof penetrations with actual equipment provided.

### 1.9 WARRANTY

- A. Special Warranty: Manufacturer's standard form in which manufacturer agrees to repair or replace components of split-system air-conditioning units that fail in materials or workmanship within specified warranty period.
  - 1. Warranty Period:
    - a. For Compressor: Five year(s) from date of Substantial Completion.
    - b. For Parts: Five year(s) from date of Substantial Completion.
    - c. For Labor: Five year(s) from date of Substantial Completion.

# PART 2 - PRODUCTS

### 2.1 MANUFACTURERS

- A. Manufacturers: Subject to compliance with requirements, provide products by one of the following:
  - 1. Carrier Corporation; a unit of United Technologies Corp.
  - 2. Mitsubishi Electric & Electronics USA, Inc.
  - 3. Samsung.
  - 4. Trane.
  - 5. YORK; a Johnson Controls company.
  - 6. LG.
  - 7. Daikin Applied.

# 2.2 INDOOR UNITS (5 TONS OR LESS)

- A. Concealed Evaporator-Fan Components:
  - 1. Chassis: Galvanized steel with flanged edges, removable panels for servicing, and insulation on back of panel.
  - 2. Insulation: Faced, glass-fiber duct liner.
  - 3. Refrigerant Coil: Copper tube, with mechanically bonded aluminum fins and thermalexpansion valve. Comply with ARI 206/110.
  - 4. Fan: Forward-curved, double-width wheel of galvanized steel; directly connected to motor.
  - 5. Fan Motors:
    - a. Comply with NEMA designation, temperature rating, service factor, enclosure type, and efficiency requirements specified in Section 230513 "Common Motor Requirements for HVAC Equipment."
    - b. Multitapped, multispeed with internal thermal protection and permanent lubrication.
    - c. Wiring Terminations: Connect motor to chassis wiring with plug connection.
  - 6. Airstream Surfaces: Surfaces in contact with the airstream shall comply with requirements in ASHRAE 62.1.
  - 7. Filters: Permanent, cleanable.
  - 8. Condensate Drain Pans:
    - a. Fabricated with one percent slope in at least two planes to collect condensate from cooling coils (including coil piping connections, coil headers, and return bends) and humidifiers, and to direct water toward drain connection.
      - 1) Length: Extend drain pan downstream from leaving face to comply with ASHRAE 62.1.
      - 2) Depth: A minimum of 2 inches (50 mm) deep.

- b. Single-wall, stainless-steel sheet.
- c. Drain Connection: Located at lowest point of pan and sized to prevent overflow. Terminate with threaded nipple on one end of pan.
  - 1) Minimum Connection Size: NPS 1 (DN 25).
- d. Pan-Top Surface Coating: Asphaltic waterproofing compound.

### 2.3 OUTDOOR UNITS (5 TONS OR LESS)

- A. Air-Cooled, Compressor-Condenser Components:
  - 1. Casing: Steel, finished with baked enamel in color selected by Architect, with removable panels for access to controls, weep holes for water drainage, and mounting holes in base. Provide brass service valves, fittings, and gage ports on exterior of casing.
  - 2. Compressor: Hermetically sealed with crankcase heater and mounted on vibration isolation device. Compressor motor shall have thermal- and current-sensitive overload devices, start capacitor, relay, and contactor.
    - a. Compressor Type: Scroll.
    - b. Two-speed compressor motor with manual-reset high-pressure switch and automatic-reset low-pressure switch.
    - c. Refrigerant: R-454B or R-32.
    - d. Refrigerant Coil: Copper tube, with mechanically bonded aluminum fins and liquid subcooler. Comply with ARI 206/110.
  - 3. Heat-Pump Components: Reversing valve and low-temperature-air cutoff thermostat.
  - 4. Fan: Aluminum-propeller type, directly connected to motor.
  - 5. Motor: Permanently lubricated, with integral thermal-overload protection.
  - 6. Low Ambient Kit: Permits operation down to 0 deg F.
  - 7. Mounting Base: Polyethylene.

### 2.4 ACCESSORIES

- A. Thermostat: Low voltage with subbase to control compressor and evaporator fan.
- B. Automatic-reset timer to prevent rapid cycling of compressor.
- C. Refrigerant Line Kits: Soft-annealed copper suction and liquid lines factory cleaned, dried, pressurized, and sealed; factory-insulated suction line with flared fittings at both ends.
- D. Drain Hose: For condensate.
- E. Monitoring:
  - 1. Monitor constant and variable motor loads.
  - 2. Monitor variable-frequency-drive operation.

- 3. Monitor economizer cycle.
- 4. Monitor cooling load.
- 5. Monitor air distribution static pressure and ventilation air volumes.

# 2.5 CAPACITIES AND CHARACTERISTICS

A. See schedule on drawings.

# PART 3 - EXECUTION

# 3.1 INSTALLATION

- A. Install units level and plumb.
- B. Install evaporator-fan components using manufacturer's standard mounting devices securely fastened to building structure.
- C. Equipment Mounting:
  - 1. Comply with requirements for vibration isolation devices specified in Section 230548.13 "Vibration Controls for HVAC."
- D. Install and connect precharged refrigerant tubing to component's quick-connect fittings. Install tubing to allow access to unit.

### 3.2 CONNECTIONS

- A. Piping installation requirements are specified in other Sections. Drawings indicate general arrangement of piping, fittings, and specialties.
- B. Where piping is installed adjacent to unit, allow space for service and maintenance of unit.

### 3.3 FIELD QUALITY CONTROL

- A. Manufacturer's Field Service: Engage a factory-authorized service representative to inspect, test, and adjust components, assemblies, and equipment installations, including connections.
- B. Perform tests and inspections.
  - 1. Manufacturer's Field Service: Engage a factory-authorized service representative to inspect components, assemblies, and equipment installations, including connections, and to assist in testing.
- C. Tests and Inspections:

- 1. Leak Test: After installation, charge system and test for leaks. Repair leaks and retest until no leaks exist.
- 2. Operational Test: After electrical circuitry has been energized, start units to confirm proper motor rotation and unit operation.
- 3. Test and adjust controls and safeties. Replace damaged and malfunctioning controls and equipment.
- D. Remove and replace malfunctioning units and retest as specified above.
- E. Prepare test and inspection reports.
- 3.4 STARTUP SERVICE
  - A. Engage a factory-authorized service representative to perform startup service.
    - 1. Complete installation and startup checks according to manufacturer's written instructions.

# 3.5 DEMONSTRATION

A. Engage a factory-authorized service representative to train Owner's maintenance personnel to adjust, operate, and maintain units.

# END OF SECTION 238126

| <u>MECH</u> | IANICAL INSTALLATION KEYNOTES   |
|-------------|---|
| 230001      | INSTALL NEW BOILERS IN PLACE OF EXISTING UNITS. RESIZE<br>EQUIPMENT PAD AS NECESSARY TO MAINTAIN 6" SPACE AROUNI<br>PERIMETER OF EQUIPMENT. REBALANCE EXISTING INLINE PUMP  |
| 230002      | INSTALL NEW EXHAUST FAN IN PLACE OF EXISTING EXHAUST FA<br>PROVIDE CURB ADAPTER AS NEEDED. CONNECT TO EXISTING<br>DUCTWORK. INTERFACE WITH NEW BMS INTERFACE AS PER<br>CONTROLS ON M7.1.  |
| 230004      | INSTALL NEW SMOKE EXHAUST FAN IN PLACE OF EXISTING SMO<br>EXHAUST FAN. PROVIDE CURB ADAPTER AS NEEDED. SYSTEM<br>COMPONENTS, CONTROLS, AND WIRING TO MEET REQUIREMENT<br>OF UL-864. CONNECT TO EXISTING DUCTWORK. INTERFACE WITH<br>NEW BMS INTERFACE AS PER CONTROLS ON SHEETS M7.7 AND<br>M7.8. |
| 230005      | INSTALL NEW AHU IN PLACE OF EXISTING AHU. CONNECT TO<br>EXISTING DUCTWORK AND PIPING AS SHOWN. RESIZE EQUIPMEN<br>PAD AS NECESSARY TO MAINTAIN 6" SPACE AROUND PERIMETEN<br>OF EQUIPMENT. REFER TO M.4 SERIES FOR MORE INFORMATION  |
| 230006      | INSTALL NEW ERV IN PLACE OF EXISTING ERV. CONNECT TO<br>EXISTING DUCTWORK AS SHOWN. INTERFACE WITH NEW BMS<br>SYSTEM AS PER CONTROLS ON SHEET 4/M7.2.   |
| 230007      | INSTALL NEW CHILLED WATER PUMP IN PLACE OF EXISTING PUM<br>CONNECT PIPING AS SHOWN. PROVIDE VFD WITH PUMP.<br>INTERFACE WITH NEW BMS SYSTEM AS PER CONTROLS ON DET/<br>1/M7.3.  |
| 230011      | INSTALL NEW RETURN FAN IN PLACE OF EXISTING RETURN FAN.<br>CONNECT TO EXISTING DUCTWORK AS SHOWN. INTERFACE WITI<br>NEW BMS SYSTEM AS PER CONTROLS ON 1/M7.2.   |
| 230012      | INSTALL NEW EXHAUST FAN AT EXISTING ROOF CURB. PROVIDE<br>CURB ADAPTER.   |
| 230013      | PROVIDE NEW HOUSING PAD FOR CHILLER ADJUST CHILLER YA<br>FENCING TO EXTEND NORTH TO ALIGN WITH WALL AS INDICATED<br>REFER TO M5.3 FOR FENCING DETAILS.  |
| 230014      | REUSE EXISTING PENETRATIONS FROM PREVIOUS BOILER FLUE<br>FOR NEW FLUES / COMBUSTION AIR INTAKES.  |
| 230015      | INSTALL NEW CONDENSING UNIT FOR NEW AHU-9 ON EXISTING<br>EQUIPMENT SUPPORT. CONTRACTOR TO ADJUST SUPPORT AS<br>NECESSARY TO MEET MANUFACTURER RECOMMENDATIONS.  |
| 230016      | INSTALL NEW DUCT MOUNTED COILS IN PLACE OF EXISTING.<br>CONNECT TO EXISTING PIPING AND DUCTWORK. PROVIDE DUCT<br>TRANSITIONS AS NECESSARY TO CONNECT TO EQUIPMENT.<br>PROVIDE NEW CONTROLS AS PER DETAIL 5/M7.2.  |
| 230017      | CONNECT NEW VAV BOX TO EXISTING DUCTWORK AND PIPING.<br>PROVIDE NEW CONTROLS FOR FAN POWERED TYPE VAV BOX AN<br>INTERFACE WITH BUILDING MANAGEMENT SYSTEM. REFER TO<br>DETAIL 2/M7.1.   |
| 230018      | CONNECT NEW DUCT MOUNTED COIL BOX TO EXISTING DUCTWO<br>AND PIPING. PROVIDE DUCT MOUNTED ACCESS DOOR UPSTREA<br>OF BOX. PROVIDE NEW CONTROLS FOR DUCT MOUNTED COILS A<br>PER CONTROLS SCHEMATIC 5/M7.2.   |
| 230019      | CONNECT WATER HEATER EXHAUST FLUE AND INTAKE TO<br>EXISTING EXHAUST/INTAKE DUCTWORK. REUSE EXISTING ROOF<br>PENETRATIONS. SIZE AND INSTALL FLUE AND INTAKE AS PER<br>MANUFACTURER RECOMMENDATIONS.  |
| 230021      | RESIZE EXISTING HOUSING PAD TO FIT NEW CHILLER.   |
| 230701      | CONNECT NEW GRILLE TO EXISTING EXHAUST DUCTWORK. LOC/<br>GRILLE TO ADJUST DUCTWORK AS MINIMALLY AS POSSIBLE.  |
| 230702      | CONNECT NEW DIFFUSER TO EXISTING DUCTWORK. LOCATE<br>DIFFUSER TO ADJUST DUCTWORK AS MINIMALLY AS POSSIBLE.  |
| 230703      | PROVIDE ELBOW WITHOUT TURNING VANES FOR TRANSFER AIR DUCT.  |
| 230704      | INSTALL NEW DUCTWORK FROM FPV TO EXISTING. VIELD VERIFY<br>TO MATCH TO EXISTING DUCTWORK SIZE.  |
| 230705      | REINSTALL EXISTING DIFFUSERS AND GRILLES AND CONNECT TO<br>EXISTING DUCTWORK IN ENTIRE SPACE. ALTERNATE BID: CONNE<br>NEW DIFFUSERS AND GRILLES TO EXISTING DUCTWORK. PROVID<br>DIFFUSER OR GRILLE AS INDICATED ON AIR TERMINAL SCHEDUL   |
| 230901      | PROVIDE NEW CONTROLS FOR THE FAN COIL UNIT AND INTERFA WITH BUILDING MANAGEMENT SYSTEM AS PER 3/M7.1.   |

| MEOL             |   |           |   | NE0              |  |  |
|------------------|---|-----------|---|------------------|--|--|
|                  | ANICAL INSTALLATION KEYNOTES  |           | ANICAL DEMOLITION KEYNOTES  |                  |  | EMOLITION KEYNOTES   |
| 230903           | PROVIDE NEW CONTROLS FOR VAV AHU AND INTERFACE WITH<br>BUILDING MANAGEMENT SYSTEM. REFER TO SHEET M2/7.5.   | 022301    | REMOVE EXISTING EXHAUST FAN FOR REPLACEMENT.<br>REMOVE DUCTWORK MINIMALLY AS NEEDED FOR<br>INSTALLATION OF NEW UNIT. REMOVE FROM CONTROLS<br>FRONT END. REFER TO INSTALLATION PLANS FOR | 022313           | FROM EXHAUST [   |  |
| 230904           | PROVIDE NEW CONTROLS FOR THE SHUTOFF TYPE VAV BOX AND<br>INTERFACE WITH BUILDING MANAGEMENT SYSTEM. REFER TO<br>DETAIL 1/M7.1.  | 022302    | ADDITIONAL INFORMATION.   | 022314           | DUCTWORK. TEM  | O REMOVE EXHAUST GRILLE FROM<br>PORARILY COVER DUCT OPENING.   |
| 230905           | PROVIDE NEW CONTROLS FOR FAN POWERED TYPE VAV BOX AND<br>INTERFACE WITH BUILDING MANAGEMENT SYSTEM. REFER TO<br>DETAIL 2/M7.1.  | 022002    | ACCESSORIES INCLUDING PUMPS. REMOVE EXISTING FLUE<br>AND INTAKE AS INDICATED. REMOVE PIPING AS INDICATED.<br>REMOVED FROM CONTROLS FRONT END. EQUIPMENT PAD                             | 022315           | GRILLE. PATCH W  | G TRANSFER AIR DUCT AND ASSOCIATED<br>ALL TO MATCH EXISTING CONDITIONS.  |
| 230906           | PROVIDE NEW CONTROLS FOR CHILLED WATER PUMPS AND<br>INTERFACE WITH NEW BUILDING MANAGEMENT SYSTEM. REFER TO   | 022303    | EXISTING TO REMAIN.<br>REMOVE EXISTING REMOTE EVAPORATOR AND ALL  | 022316<br>022317 | DUCTWORK. TEM  | ) REMOVE EXISTING VAV BOX FROM<br>PORARILY COVER DUCT OPENINGS.<br>G TEMPERATURE SENSOR AND WIRING   |
| 230907           | 1/M7.3 FOR ADDITIONAL INFORMATION.<br>PROVIDE NEW CONTROLS FOR HYDRONIC HOT WATER SYSTEM<br>AND INTERFACE WITH NEW BUILDING MANAGEMENT SYSTEM.  | 022304    | ASSOCIATED ACCESSORIES AND APPURTENANCES. REMOVE<br>ASSOCIATED PIPING COMPLETE. REMOVE FROM CONTROLS<br>FRONT END.<br>REMOVE AIR HANDLING UNIT COMPLETE, INCLUDING                      | 022317           | FROM RETURN DU<br>EXISTING TEMPER                      | CONNECT AND REMOVE RETURN GRILLE   |
| 230908           | REFER TO 1,2/M7.4 FOR ADDITIONAL INFORMATION.<br>PROVIDE NEW CONTROLS FOR HYDRONIC UNIT HEATER AND<br>INTERFACE WITH BUILDING MANAGEMENT SYSTEM. REFER TO<br>DETAIL 7/M7.1.                 | 022304    | DUCTWORK AS INDICATED, PIPING AS INDICATED,<br>CONTROLS, AND ACCESSORIES COMPLETE. EQUIPMENT PAD<br>EXISTING TO REMAIN. REFER TO MD4.X SERIES FOR MORE<br>INFORMATION.                  |                  | FROM CEILING. S/<br>ALTERNATE BID: F<br>REPLACEMENT.   | ALVAGE GRILLE FOR REINSTALLATION.<br>REMOVE EXISTING RETURN GRILLE FOR   |
| 230909           | PROVIDE NEW CONTROLS FOR FIN TUBE RADIATOR AND<br>INTERFACE WITH BUILDING MANAGEMENT SYSTEM. REFER TO<br>DETAIL 8/M7.6.   | 022305    | REMOVE EXISTING CONTROLS TO UNIT COMPLETE. REMOVE<br>ALL ASSOCIATED TUBING OR WIRING SERVING UNIT<br>CONTROLS. REMOVE UNIT FROM CONTROLS FRONT END.                                     | 022319           | FROM DUCTWORI<br>OPENING. SALVA<br>ALTERNATE BID: F    | SCONNECT AND REMOVE SUPPLY DIFFUSE<br>( AND CEILING. TEMPORARILY COVER DUC<br>GE DIFFUSER FOR REINSTALLATION.<br>REMOVE EXISTING SUPPLY DIFFUSER FOR<br>EMPORARILY COVER DUCT OPENING. |
| 230911           | PROVIDE NEW CONTROLS FOR CONSTANT VOLUME AHU AND<br>INTERFACE WITH BUILDING MANAGEMENT SYSTEM. REFER TO<br>DETAIL 2/M7.2.   | 022306    | REMOVE EXISTING CHILLER AND ALL ASSOCIATED<br>ACCESSORIES, ASSOCIATED REFRIGERANT PIPING AS<br>INDICATED, AND CONTROLS. REMOVE FROM CONTROLS<br>FRONT END.                              | 022320           |  | NSING UNIT SERVING AHU-9 TO BE<br>DING ANY ASSOCIATED PIPING AND WIRING<br>ID TO REMAIN.   |
| 230912           | PROVIDE NEW CONTROLS FOR CONSTANT VOLUME AHU AND<br>INTERFACE WITH BUILDING MANAGEMENT SYSTEM. REFER TO<br>DETAIL 1/M7.2.   | 022307    | REMOVE EXISTING THERMOSTAT AND WIRING. CONTRACTOR<br>TO FIELD VERIFY THERMOSTAT LOCATIONS.  | 022321           | COMPLETE. REMO<br>SERVING UNIT CO                      | MOVE EXISTING CONTROLS TO UNIT<br>IVE ALL ASSOCIATED TUBING OR WIRING<br>INTROLS. REMOVE UNIT FROM CONTROLS<br>PORARILY COVER DUCT OPENING UNTIL                                       |
| 230913           | PROVIDE NEW CONTROLS FOR CONSTANT VOLUME AHU AND<br>INTERFACE WITH BUILDING MANAGEMENT SYSTEM. REFER TO<br>DETAIL 1/M7.5.   | 022308    | REMOVE EXISTING CHILLED WATER PUMP AND ALL<br>ASSOCIATED ACCESSORIES, ASSOCIATED PIPING AS<br>INDICATED, AND CONTROLS. REMOVE FROM CONTROLS<br>FRONT END.                               | 022322           | NEW FPV IS INSTA<br>FPV UNIT TO BE T<br>REMOVE EXISTIN | ALLED.<br>EMPORARILY REMOVED AND RELOCATED.<br>G CONTROLS TO UNIT COMPLETE. REMOVE   |
| 230914           | PROVIDE NEW CONTROLS FOR VAV AHU AND INTERFACE WITH<br>BUILDING MANAGEMENT SYSTEM. REFER TO DETAIL 2/M7.5.  | 022309    | REMOVE EXISTING RETURN FAN COMPLETE, INCLUDING<br>DUCTWORK AS INDICATED, CONTROLS, AND ACCESSORIES<br>COMPLETE.   |                  | CONTROLS. REMO   | TUBING OR WIRING SERVING UNIT<br>DVE UNIT FROM CONTROLS FRONT END.<br>NG M2.1E FOR NEW INSTALL LOCATION.   |
| 230915           | PROVIDE TEMPERATURE SENSOR INSIDE RETURN DUCTWORK.<br>SENSOR TO CONTROL THE UNITS INDICATED.  | 022310    | REMOVE EXISTING KITCHEN MAKE UP AIR UNIT, INCLUDING<br>DUCTWORK TO HOOD AND CONTROLS. CURB TO REMAIN IN   | 022323           |  | O REMOVE EXISTING SUPPLY DIFFUSER FO<br>EMPORARILY COVER DUCT OPENING.   |
| 230918           | PROVIDE TEMPERATURE SENSOR INSIDE RETURN DUCTWORK.<br>REPAIR OR REPLACE INSULATION AFFECTED BY TEMPERATURE<br>SENSOR INSTALLATION. SENSOR TO CONTROL THE UNITS<br>INDICATED.                | 022311    | PLACE. TEMPORARILY COVER OPENINGS.  | 022324<br>022325 |  | G RETURN GRILLE FOR REPLACEMENT.<br>SCONNECT AND REMOVE EXHAUST GRILLE   |
| 230920           | PROVIDE THERMOSTAT IN SAME LOCATION AS EXISTING. MATCH<br>EXISTING WALL CONDITIONS AROUND THERMOSTAT IF<br>DIMENSIONS DO NOT MATCH.   | 022312    | EVAPORATOR AND CHILLER COMPLETE INCLUDING<br>SUPPORTS AND STANDS. TEMPORARILY COVER WALL<br>PENETRATION.<br>REMOVE EXISTING ERV AND ASSOCIATED DUCTWORK AS                              | 022323           | FROM DUCTWORI<br>SALVAGE GRILLE<br>REMOVE EXISTIN      | K. TEMPORARILY COVER DUCT OPENING.<br>FOR REINSTALLATION. ALTERNATE BID:<br>G EXHAUST GRILLE FOR REPLACEMENT.<br>VER DUCT OPENING.   |
| 230921           | PROVIDE TEMPERATURE SENSOR IN EXISTING EXHAUST<br>DUCTWORK.   |           | INDICATED. REMOVE FROM CONTROLS FRONT END.  | 022326           | REMOVE PIPING A  | ) REMOVE EXISTING DUCT MOUNTED COIL<br>ND DUCTWORK TRANSITIONS TO UNIT.<br>G CONTROLS TO UNIT COMPLETE. REMOVE   |
| 230922           | PROVIDE THERMOSTAT WITH SECURITY COVER IN SAME LOCATION<br>AS EXISTING. MATCH EXISTING WALL CONDITIONS AROUND<br>THERMOSTAT IF DIMENSIONS DO NOT MATCH.                                     |           |   | 022327           | ALL ASSOCIATED<br>UNIT FROM CONT                       | T FLUE AND INTAKE FROM EXISTING WATE   |
| 230923           | PROVIDE NEW THERMOSTAT WITH SECURITY COVER. LOCATION<br>INDICATED IS PLACEHOLDER. CONTRACTOR TO FIELD VERIFY<br>THERMOSTAT LOCATION AND REPLACE EXISTING AT SAME<br>LOCATION.               |           |   |                  |  | CATED. CAP DUCTWORK AT ROOF<br>R RECONNECTION.   |
| 230924           | PROVIDE NEW CONTROLS FOR THE ROOF HOOD UNIT. REFER TO M7.6 FOR CONTROLS.  |           |   |                  |  |  |
| 230925           | PROVIDE NEW EMERGENCY BOILER SHUTOFF BUTTON NEAR EXIT.<br>MOUNT BUTTON 4'-6" A.F.F. PER IFC SECTION 606. PROVIDE<br>CONTROLS TO ALLOW FOR EMERGENCY SHUTOFF THROUGH<br>CENTRAL WORKSTATION. | SYME      | BOLS  |                  |  |  |
| 230926           | PROVIDE NEW CONTROLS FOR EXISTING LOUVERS. REFER TO M7.7/M7.8 FOR CONTROLS.   | AxB       | 3 RECTANGULAR DUCT DIMENSION  |                  | ×  |  |
| 230927           | PROVIDE NEW CONTROLS FOR EXISTING LOUVER. REFER TO 8/M7.1<br>FOR CONTROLS.  | A/B       | FLAT-OVAL DUCT DIMENSION  |                  |  | THERMOSTAT<br>TEMPERATURE SENSOR   |
| 230928           | PROVIDE NEW FIREFIGHTER SMOKE CONTROL PANEL IN CENTRAL<br>CONTROL. CONTRACTOR TO CONFIRM LOCATION WITH EXISTING<br>EQUIPMENT.   | AØ<br>└── |   |                  |  | - EQUIPMENT TYPE (SEE ABBREVIATIONS<br>- SCHEDULE #  |
| 231101           | CONNECT EXISTING NATURAL GAS PIPE TO NEW MAKE UP AIR UNIT.<br>PROVIDE DUCTWORK TO EXISTING HOOD FROM MAKE UP AIR UNIT.<br>REUSE EXISTING ROOF CURB.   |           | RECTANGULAR SUPPLY OR OUTSIDE AIR DUCT - UP RECTANGULAR RETURN AIR DUCT - UP OR DOWN  | OR DOWN          | XXXXXX   | KEYNOTE  |
| 232101           | ROUTE CONDENSATE LINE DOWN TO MOP SINK.   |           | RECTANGULAR EXHAUST AIR DUCT - UP OR DOWN   |                  | TMV  | THERMOSTATIC MIXING VALVE<br>OUTLET TEMPERATURE SENSOR   |
| 232102           | PROVIDE STUB-OUT WITH SHUTOFF VALVES FOR EMERGENCY<br>CHILLED WATER CONNECTION. CAP OPEN ENDS.  |           | ROUND SUPPLY OR OUTSIDE AIR DUCT - UP OR DO   | WN.              | BPS  | BUILDING PRESSURE SENSOR   |
| 232103           | PROVIDE STUB-OUT WITH SHUTOFF VALVES FOR EMERGENCY<br>HEATING HOT WATER CONNECTION. CAP OPEN ENDS.  |           | ROUND RETURN AIR DUCT - UP OR DOWN.   |                  | СО   | CARBON MONOXIDE SENSOR   |
| 232104           | REBALANCE PUMPS AFTER INSTALLATION OF NEW BOILERS AND<br>AIR HANDLING UNITS.  |           | ROUND EXHAUST AIR DUCT - UP OR DOWN.  |                  | NO2  | NITROGEN DIOXIDE SENSOR  |
| 232105<br>232106 | PROVIDE MANUAL SHUTOFF VALVES FOR PIPING CROSSOVER.<br>SHUTOFF VALVE.   |           | SUPPLY AIR DIFFUSER (SQUARE)  |                  | CO2  | CARBON DIOXIDE SENSOR  |
| 233101           | CONNECT DUCTWORK TO EF-23. COORDINATE LOCATION WITH<br>EXISTING ROOF CURB.  |           | RETURN AIR GRILLE (SQUARE)  |                  | RL   | REFRIGERANT LIQUID   |
| 233301           | PROVIDE NEW SMOKE DAMPER ON DUCT UPSTREAM OF VAV BOX.   |           | RETURN AIR GRILLE OR EXHAUST REGISTER (RECT.  | ANGULAR)         | HWS  | HYDRONIC WATER SUPPLY  |
| 233302           | REFER TO M7.7/M7.8 FOR CONTROLS.<br>PROVIDE SMOKE DAMPER ON DUCTWORK FROM RETURN GRILLE.  |           | EXHAUST GRILLE (SQUARE)   |                  |  | R     —     HYDRONIC WATER RETURN       B     —     CHILLED WATER SUPPLY   |
| 233701           | REFER TO M7.7/M7.8 FOR CONTROLS.<br>REINSTALL EXISTING RETURN GRILLE IN SAME LOCATION AS  |           | S DUCT SMOKE DETECTOR   |                  | ——————————————————————————————————————                 |  |
| 233702           | PREVIOUSLY.<br>INSTALL NEW SUPPLY DIFFUSER IN SAME LOCATION AS<br>PREVIOUSLY. RECONNECT TO EXISTING DUCTWORK.   |           | BD BACKDRAFT DAMPER   |                  | CON  | D CONDENSATE LINE  |
|                  | PREVIOUSLY. RECONNECT TO EXISTING DUCTWORK.   |           | CONTROL DAMPER  |                  |  |  |
|                  |   |           | VOLUME DAMPER   |                  |  |  |
|                  |   |           | ROUND DIFFUSER  |                  |  |  |
|                  |   |           | SLOT DIFFUSER   |                  |  |  |
|                  |   |           | BALL VALVE  |                  |  |  |
|                  |   |           | BUTTERFLY VALVE   |                  |  |  |
|                  |   |           | GATE VALVE  |                  |  |  |
|                  |   |           | DISCONNECT FROM EXISTING  |                  |  |  |
|                  |   |           | CONNECT TO EXISTING   |                  |  |  |
|                  |   |           |   |                  |  |  |

# **ION KEYNOTES**

# RE SENSOR AND WIRING

ID REMOVE SUPPLY DIFFUSER . TEMPORARILY COVER DUCT FOR REINSTALLATION. TING SUPPLY DIFFUSER FOR COVER DUCT OPENING.

RVING AHU-9 TO BE OCIATED PIPING AND WIRING.

### IG CONTROLS TO UNIT CIATED TUBING OR WIRING 10VE UNIT FROM CONTROLS VER DUCT OPENING UNTIL

REMOVED AND RELOCATED. TO UNIT COMPLETE. REMOVE IRING SERVING UNIT M CONTROLS FRONT END. R NEW INSTALL LOCATION.

STING SUPPLY DIFFUSER FOR COVER DUCT OPENING.

TAKE FROM EXISTING WATER UCTWORK AT ROOF TION.

### ATIC MIXING VALVE IPERATURE SENSOR

# OXIDE SENSOR

### AMPS ADJ. ADJUSTABLE AUTOMATIC TEMPERATURE CONTROL AIR PRESSURE DROP APD A.F.F. ABOVE FINISHED FLOOR CUBIC FEET PER MINUTE COMPANY CFM COND. CONDENSATE DUCT STATIC PRESSURE DSP EXHAUST AIR ENTERING AIR TEMPERATURE EDB ENTERING DRY BULB EXHAUST FAN EFFICIENCY ELECT ELECTRICAL EXTERNAL STATIC PRESSURE ENTERING WET BULB EWB EWC ELECTRIC WATER COOLER FIRE DAMPER FEET PER MINUTE FPM FLOOR DRAIN GAL GALLON GPM GALLONS PER MINUTE GENERAL CONTRACTOR HEATING COI HORSE POWER HOUR HEATING HTG. IDENTIFICATION INTAKE HOOD INCH LOUVER LEAVING AIR TEMPERATURE LEAVING DRY BULB POUNDS LEAVING WET BULB LWB MAXIMUM MAX 1000 BRITISH THERMAL UNITS PER HOUR MBH MIN. MINIMUM NUMBER OUTSIDE AIR PLUMBING CONTRACTOR PHASE POUNDS PER SQUARE INCH RETURN AIR **RELIEF AIR FAN** RELIEF AIR HOOD ROOM ROOF TOP UNIT RTU SUPPLY AIR SMOKE EXHAUST SMOKE DAMPER SENS SENSIBLE TSP TOTAL STATIC PRESSURE VENT VARIABLE AIR VOLUME BOX VOLTAGE VOLTS VARIABLE FREQUENCY DRIVE

**ABBREVIATIONS** 

ATC

CO.

EA

FAT

FFF

HR

I.D.

IAT

OA

PSI.

RF

RM

VAV

VFD

W.C

WPD

AMPERES

**PIPE ABBREVIATIONS** 

WATER PRESSURE DROP

WATER COLUMN

WALL OPENING

| CHILLED WATER RETURN<br>CHILLED WATER SUPPLY<br>COMBUSION FLUE<br>COMBUSTION AIR INTAKE<br>CONDENSATE<br>COOLING TOWER RETURN | CWR<br>CWS<br>CF<br>CI<br>C<br>CTR |
|---|------------------------------------|
| COOLING TOWER SUPPLY  | CTS                                |
| HYDRONIC RETURN<br>HYDRONIC SUPPLY  | HWR<br>HWS                         |
| STEAM CONDENSATE  | LPC                                |
| STEAM RETURN - HIGH PRESSURE<br>STEAM SUPPLY - HIGH PRESSURE  | HPR<br>HPS                         |
| STEAM SUPPLY - LOW PRESSURE   | LPS                                |
|   |                                    |

| BASI      | HVAC<br>S OF DESIGN  |  |  |  |  |  |  |  |  |
|-----------|----------------------|--|--|--|--|--|--|--|--|
| (NEW DUCT | LESS SPLITS/FPV 6-5) |  |  |  |  |  |  |  |  |
| SUMMER    |                      |  |  |  |  |  |  |  |  |
| OUTDOOR   | 91°FDB, 75°F WB      |  |  |  |  |  |  |  |  |
| INDOOR    | 75°FDB, 63°F WB      |  |  |  |  |  |  |  |  |
|           | WINTER               |  |  |  |  |  |  |  |  |
| OUTDOOR   | -3°F DB              |  |  |  |  |  |  |  |  |
| INDOOR    | 70°F DB              |  |  |  |  |  |  |  |  |

# **GENERAL NOTES**

- 1. ALL MECHANICAL WORK SHALL BE IN ACCORDANCE WITH STATE OF INDIANA MECHANICAL CODE. LATEST APPLICABLE EDITION, THE AUTHORITY HAVING JURISDICTION AND AS SPECIFIED (WHICHEVER IS MORE STRINGENT).
- 2. IF NON-DESIGN BASE EQUIPMENT IS SELECTED, THIS CONTRACTOR SHALL BEAR ANY ADDITIONAL COSTS FOR MODIFICATION TO THE PROPOSED BUILDING SYSTEM CAUSED BY SELECTION OF THE NON-DESIGN BASE EQUIPMENT INCLUDING COSTS FOR ARCHITECT/ENGINEER REVIEW. DEVIATIONS FROM BASIS OF DESIGN THAT AFFECT OTHER TRADES ARE THE RESPONSIBILITY OF THIS CONTRACTOR. ADDITIONAL COSTS TO PROVIDE LARGER ELECTRICAL CIRCUITS, MORE FLOOR SPACE, ADDITIONAL SUPPORTS, ADDITIONAL MATERIALS, ETC. SHALL BE BORNE BY THIS CONTRACTOR. COORDINATE ALL WORK WITH OTHER TRADES.
- 3. DO NOT SCALE DRAWINGS FOR DIMENSIONS. REFER TO DIMENSIONED DRAWINGS. IF DIMENSIONS CANNOT BE ACCURATELY DETERMINED, REQUEST THE INFORMATION FROM THE ARCHITECT/ENGINEER.
- 4. KEY NOTES ARE MEANT AS A GENERAL GUIDE FOR TYPICAL LOCATIONS. CONTRACTOR TO PERFORM FULL EXTENT OF WORK REQUIRED TO ACCOMPLISH DESIGN INTENT.
- 5. CONTRACTOR IS RESPONSIBLE FOR ALL WORK IDENTIFIED ON ALL DRAWINGS AND INFORMATION IN THE PROJECT MANUAL, AS A COMPLETE PROJECT. IT SHALL BE THE CONTRACTOR'S RESPONSIBILITY TO DETERMINE THE SPECIFIC SCOPE OF WORK FOR ANY SUBCONTRACTORS FOR THIS PROJECT EXCEPT AS SPECIFICALLY NOTED.
- 6. CONTRACTOR SHALL PROVIDE ACCESS DOORS IN ALL WALLS AND CEILINGS WHERE SERVICE OR ADJUSTMENT TO MECHANICAL, PLUMBING, OR FIRE PROTECTION ITEMS MAY BE REQUIRED, WHETHER INDICATED ON THE PLANS OR NOT. ACCESS DOORS SHALL BE OF AN APPROPRIATE SIZE REQUIRED FOR EACH APPLICATION. WHERE APPLICABLE, ACCESS DOORS SHALL MATCH THE FIRE/SECURITY RATING OF THE WALL/CEILING ASSEMBLY.
- 7. DUCT AND PIPING LAYOUTS ARE SCHEMATIC IN NATURE. PROVIDE ADDITIONAL TRANSITIONS, ELBOWS, OFFSETS, AS NECESSARY AND COORDINATE ANY STRUCTURAL SUPPORTS FOR OPENINGS WITH STRUCTURAL TRADES.
- 8. DUCTWORK: A. ALL LISTED DUCTWORK DIMENSIONS ARE CLEAR AIR FLOW DIMENSIONS.
  - B. ALL DUCTS IN FINISHED ROOMS AND SPACES SHALL BE CONCEALED IN CHASES OR ABOVE THE CEILINGS, UNLESS OTHERWISE NOTED. C. FIELD VERIFY LOCATION OF BEAMS, GENERAL STRUCTURE, LIGHTING, PIPING, ETC., BEFORE
  - FABRICATION AND INSTALLATION OF DUCTWORK COORDINATE ELEVATIONS, OFFSETS, AND TRANSITIONS AS REQUIRED. D. MAXIMUM LENGTH OF FLEX DUCT SHALL BE 5'-0". FLEX DUCT SHALL NOT BE USED WHERE
  - DUCTWORK IS EXPOSED. THE LAST ELBOW BEFORE CONNECTION TO AN AIR DEVICE SHALL BE A HARD DUCT.
  - E. VOLUME DAMPERS SHALL BE INSTALLED IN ALL BRANCH DUCTS.
  - F. THE ELBOWS FOR DUCTWORK SHALL HAVE TURNING VANES UNLESS NOTED OTHERWISE. G. REFER TO ARCHITECTURAL REFLECTED CEILING PLAN FOR AIR DEVICE LOCATIONS.
  - H. ALL AIR DEVICES IN CMU WALLS SHALL MATCH BLOCK COURSING. I. CONTRACTOR SHALL REFER TO ARCHITECTURAL PLANS FOR LOCATIONS OF FIRE RATED WALLS, FLOORS AND SMOKE BARRIERS. CONTRACTOR SHALL PROVIDE FIRE DAMPERS, SMOKE DAMPERS IN ALL DUCTS PENETRATING SAID WALLS/FLOOR, WHETHER INDICATED ON THE MECHANICAL PLANS OR NOT.
- 9. ALL STRUCTURAL OPENINGS SHALL BE COORDINATED WITH THE STRUCTURAL DRAWING. COORDINATE ANY STRUCTURAL SUPPORTS FOR OPENINGS WITH STRUCTURAL TRADES.
- 10. ALL HANGER SYSTEMS FOR PIPING, DIFFUSERS, GRILLES AND EQUIPMENT SHALL BE SECURED TO BUILDING STRUCTURAL SYSTEM.
- 11. COORDINATE ALL WORK WITH EXISTING WORK TO PERMIT ACCESS AND SERVICE CLEARANCES TO ALL SYSTEMS, COORDINATE DUCT WITH ELECTRICAL J-BOXES TO PREVENT OBSTRUCTIONS.
- 12. CONNECTION TO EQUIPMENT SHALL CONFORM TO MANUFACTURER'S SPECIFICATION.
- 13. ALL MECHANICAL EQUIPMENT REQUIRING NATURAL GAS SHALL BE FURNISHED WITH PRESSURE REGULATOR. THE GAS PRESSURE REGULATOR SHALL REGULATE THE GAS PRESSURE BETWEEN THE INLET AND OPERATING PRESSURE OF THE EQUIPMENT. PROVIDE VENT TO OUTDOOR FROM EACH REGULATOR.
- 14. HVAC EQUIPMENT SHALL BE CONNECTED TO BUILDING MANAGEMENT SYSTEM.
- 15. REFER TO DETAIL SHEETS FOR ADDITIONAL INFORMATION ON INSTALLMENT METHODS.
- 16. ALL CONTROL SETPOINTS AND SETTINGS SHALL BE USER ADJUSTABLE. 17. ALL EXISTING CONTROLS INCLUDING SENSORS, CONTROL VALVES, ACTUATORS, PANELS, VFD'S, AND OTHER APPURTENANCES SHALL BE REMOVED AND REPLACED ACCORDING TO SCHEMATICS ON
- CONTROL DRAWINGS. PROVIDE NEW CONTROLS INCLUDING SENSORS, CONTROL VALVES, ACTUATORS, PANELS, VFD'S AND OTHER APPURTENANCES ACCORDING TO SCHEMATICS ON CONTROL DRAWINGS. 18. FOR VARIABLE AIR VOLUME BOXES, DIVISION 23 CONTRACTOR SHALL BE RESPONSIBLE FOR PROVIDING
- 277 V TRANSFORMERS AND CONTROL WIRIING DOWNSTREAM OF 277:24V STEP DOWN TRANSFORMER. PROVIDE NEW TRANSFORMERS IN PLACE OF EXISTING. DIVISION 26 CONTRACTOR SHALL BE RESPONSIBLE FOR ANY POWER WIRING UPSTREAM OF THE TRANSFORMER. ANY NEW TRANSFORMERS SHALL BE INSTALLED IN NEMA-1 ENCLOSURE.
- 19. ALL HVAC CONTROL WIRING SHALL BE PROVIDED WITH DIVISION 23 CONTRACTOR UNLESS OTHERWISE NOTED. EXPOSED CONTROL WIRING SHALL BE IN CONDUIT. TEMPERATURE CONTROL CONTRACTOR IS RESPONSIBLE FOR PROVIDING AND LOCATING ANY 24V TRANSFORMERS REQUIRED FOR CONTROL COMPONENTS. DIV 26 CONTRACTOR SHALL PROVIDE POWER WIRING UPSTREAM OF THE TRANSFORMER.

# GENERAL DEMOLITON NOTES

- 1. REFER TO DRAWINGS OF ALL OTHER DISCIPLINES FOR ADDITIONAL REMOVALS AND SELECTIVE DEMOLITION ACTIVITIES.
- 2. CONTRACTOR SHALL FIELD VERIFY ALL EXISTING CONDITIONS AND DIMENSIONS PRIOR TO SELECTIVE DEMOLITION ACTIVITIES. ANY ITEMS NOT INDICATED ON THE DRAWINGS OR SPECIFICATIONS THAT ARE IN CONFLICT WITH CONTRACT WORK SHALL BE BROUGHT TO THE ATTENTION OF THE ENGINEER PRIOR TO BID FOR CLARIFICATION.
- 3. FOR THE DURATION OF THE PROJECT, IF ANY EXISTING ITEM IS DAMAGED DURING CONSTRUCTION, IT SHALL BE REPAIRED AND RESTORED TO ITS ORIGINAL CONDITION AT NO ADDITIONAL COST TO THE OWNER.
- 4. CONTRACTOR IS RESPONSIBLE FOR ALL CUTTING AND PATCHING REQUIRED, INCLUDING ASSOCIATED REPAIR AND FINISHING TO MATCH ADJACENT SURFACES.
- 5. CONTRACTOR IS RESPONSIBLE FOR ALL TEMPORARY ENVIRONMENTAL CONTROL MEASURES INCLUDING ACCEPTABLE AIR QUALITY CONTROL MEASURES, DUST CONTROL, EROSION CONTROL AND OTHER MEASURES REQUIRED FOR PROTECTION OF THE PROPERTY DURING SELECTIVE DEMOLITON AND CONSTRUCTION ACTIVITIES.
- 6. CONTRACTOR IS SOLELY RESPONSIBLE FOR COORDINATING CONTRACT DRAWINGS WITH FIELD CONDITIONS AND WORK ASSOCIATED WITH EACH TRADE.
- 7. CONTRACTOR SHALL COORDINATE DEMOLITION ACTIVITIES WITH NEW WORK TO VERIFY DIMENSIONS AND EXTENT OF REMOVALS PRIOR TO BEGINING OF WORK.
- 8. CONTRACTOR IS RESPONSIBLE FOR REMOVAL, STORAGE AND REINSTALLATION OF REMAINING WALL MOUNTED DEVICES INTENDED FOR REUSE.
- 9. ALL DEMOLITION WORK SHALL BE PERFORMED IN STRICT ACCORDANCE WITH ALL APPLICABLE SECTIONS OF THE STATE OF INDIANA, LOCAL BUILDING CODES, OSHA AND NFPA
- 10. OWNER RESERVES THE RIGHT TO SALVAGE ANY EQUIPMENT OR MATERIAL INDICATED TO BE DEMOLISHED.
- 11. PLANS ARE FOR DIAGRAMMATIC PURPOSES ONLY. BASED ON LIMITED SITE OBSERVATIONS. CONTRACTOR TO REMOVE ANY UNUSED / ABANDONED DUCTWORK, EQUIPMENT, PIPING (GAS, REFRIGERANT ETC.). ASSOCIATED ACCESORIES WHETHER INDICATED ON THE PLANS OR NOT. CONTRACTOR TO VERIFY EXTENT OF DEMOLITION ON THE FIELD AND COORDINATE WITH THE ENGINEER (AT NO ADDITIONAL COST TO THE OWNER). PATCH WALLS AND/OR FLOOR TO MATCH ADJACENT CONDITIONS.

# 2/19/2025 ΣΣ





 $\overline{}$  $\overline{}$ N N N ≥ ∞ nΟ S ╡╙╴┝╸ COMM SOFI NO Щ ORMAT ERIFI ERIFI PROV Ľ SHI SHI IMF ш、 = ZCOUL ER ずて POR BOR

DRAWING NUMBER

M0.1

MECHANICAL

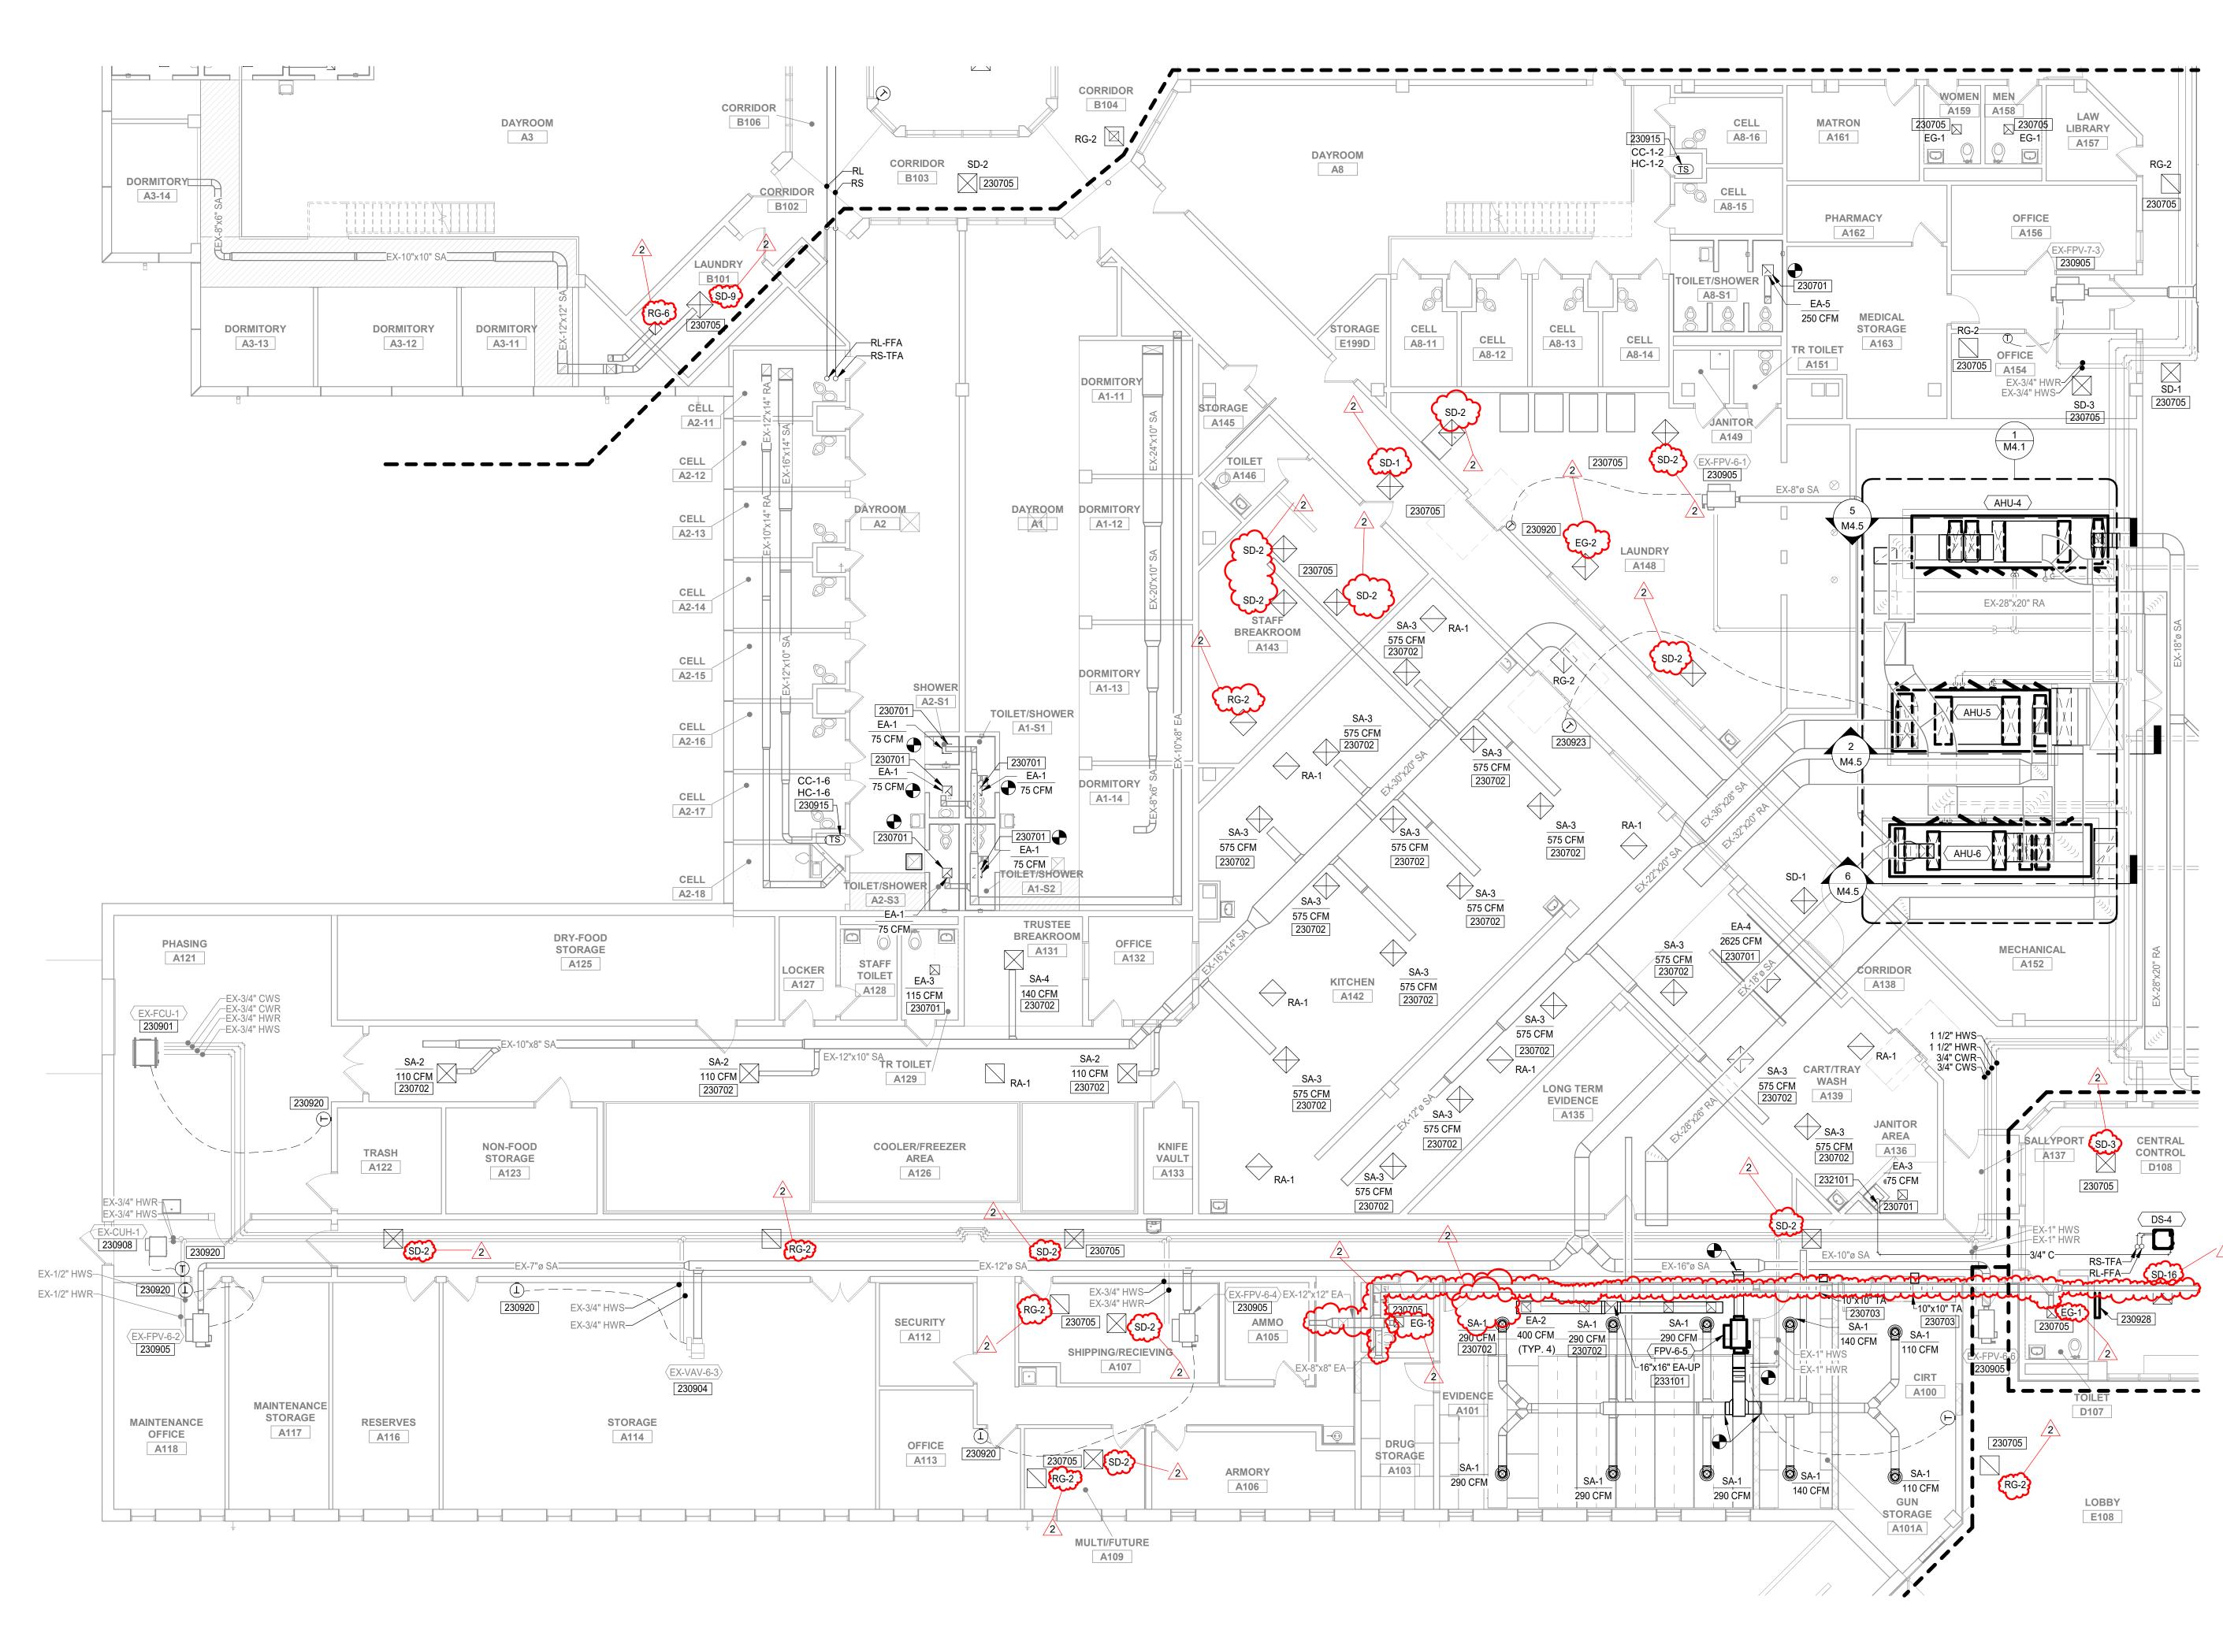

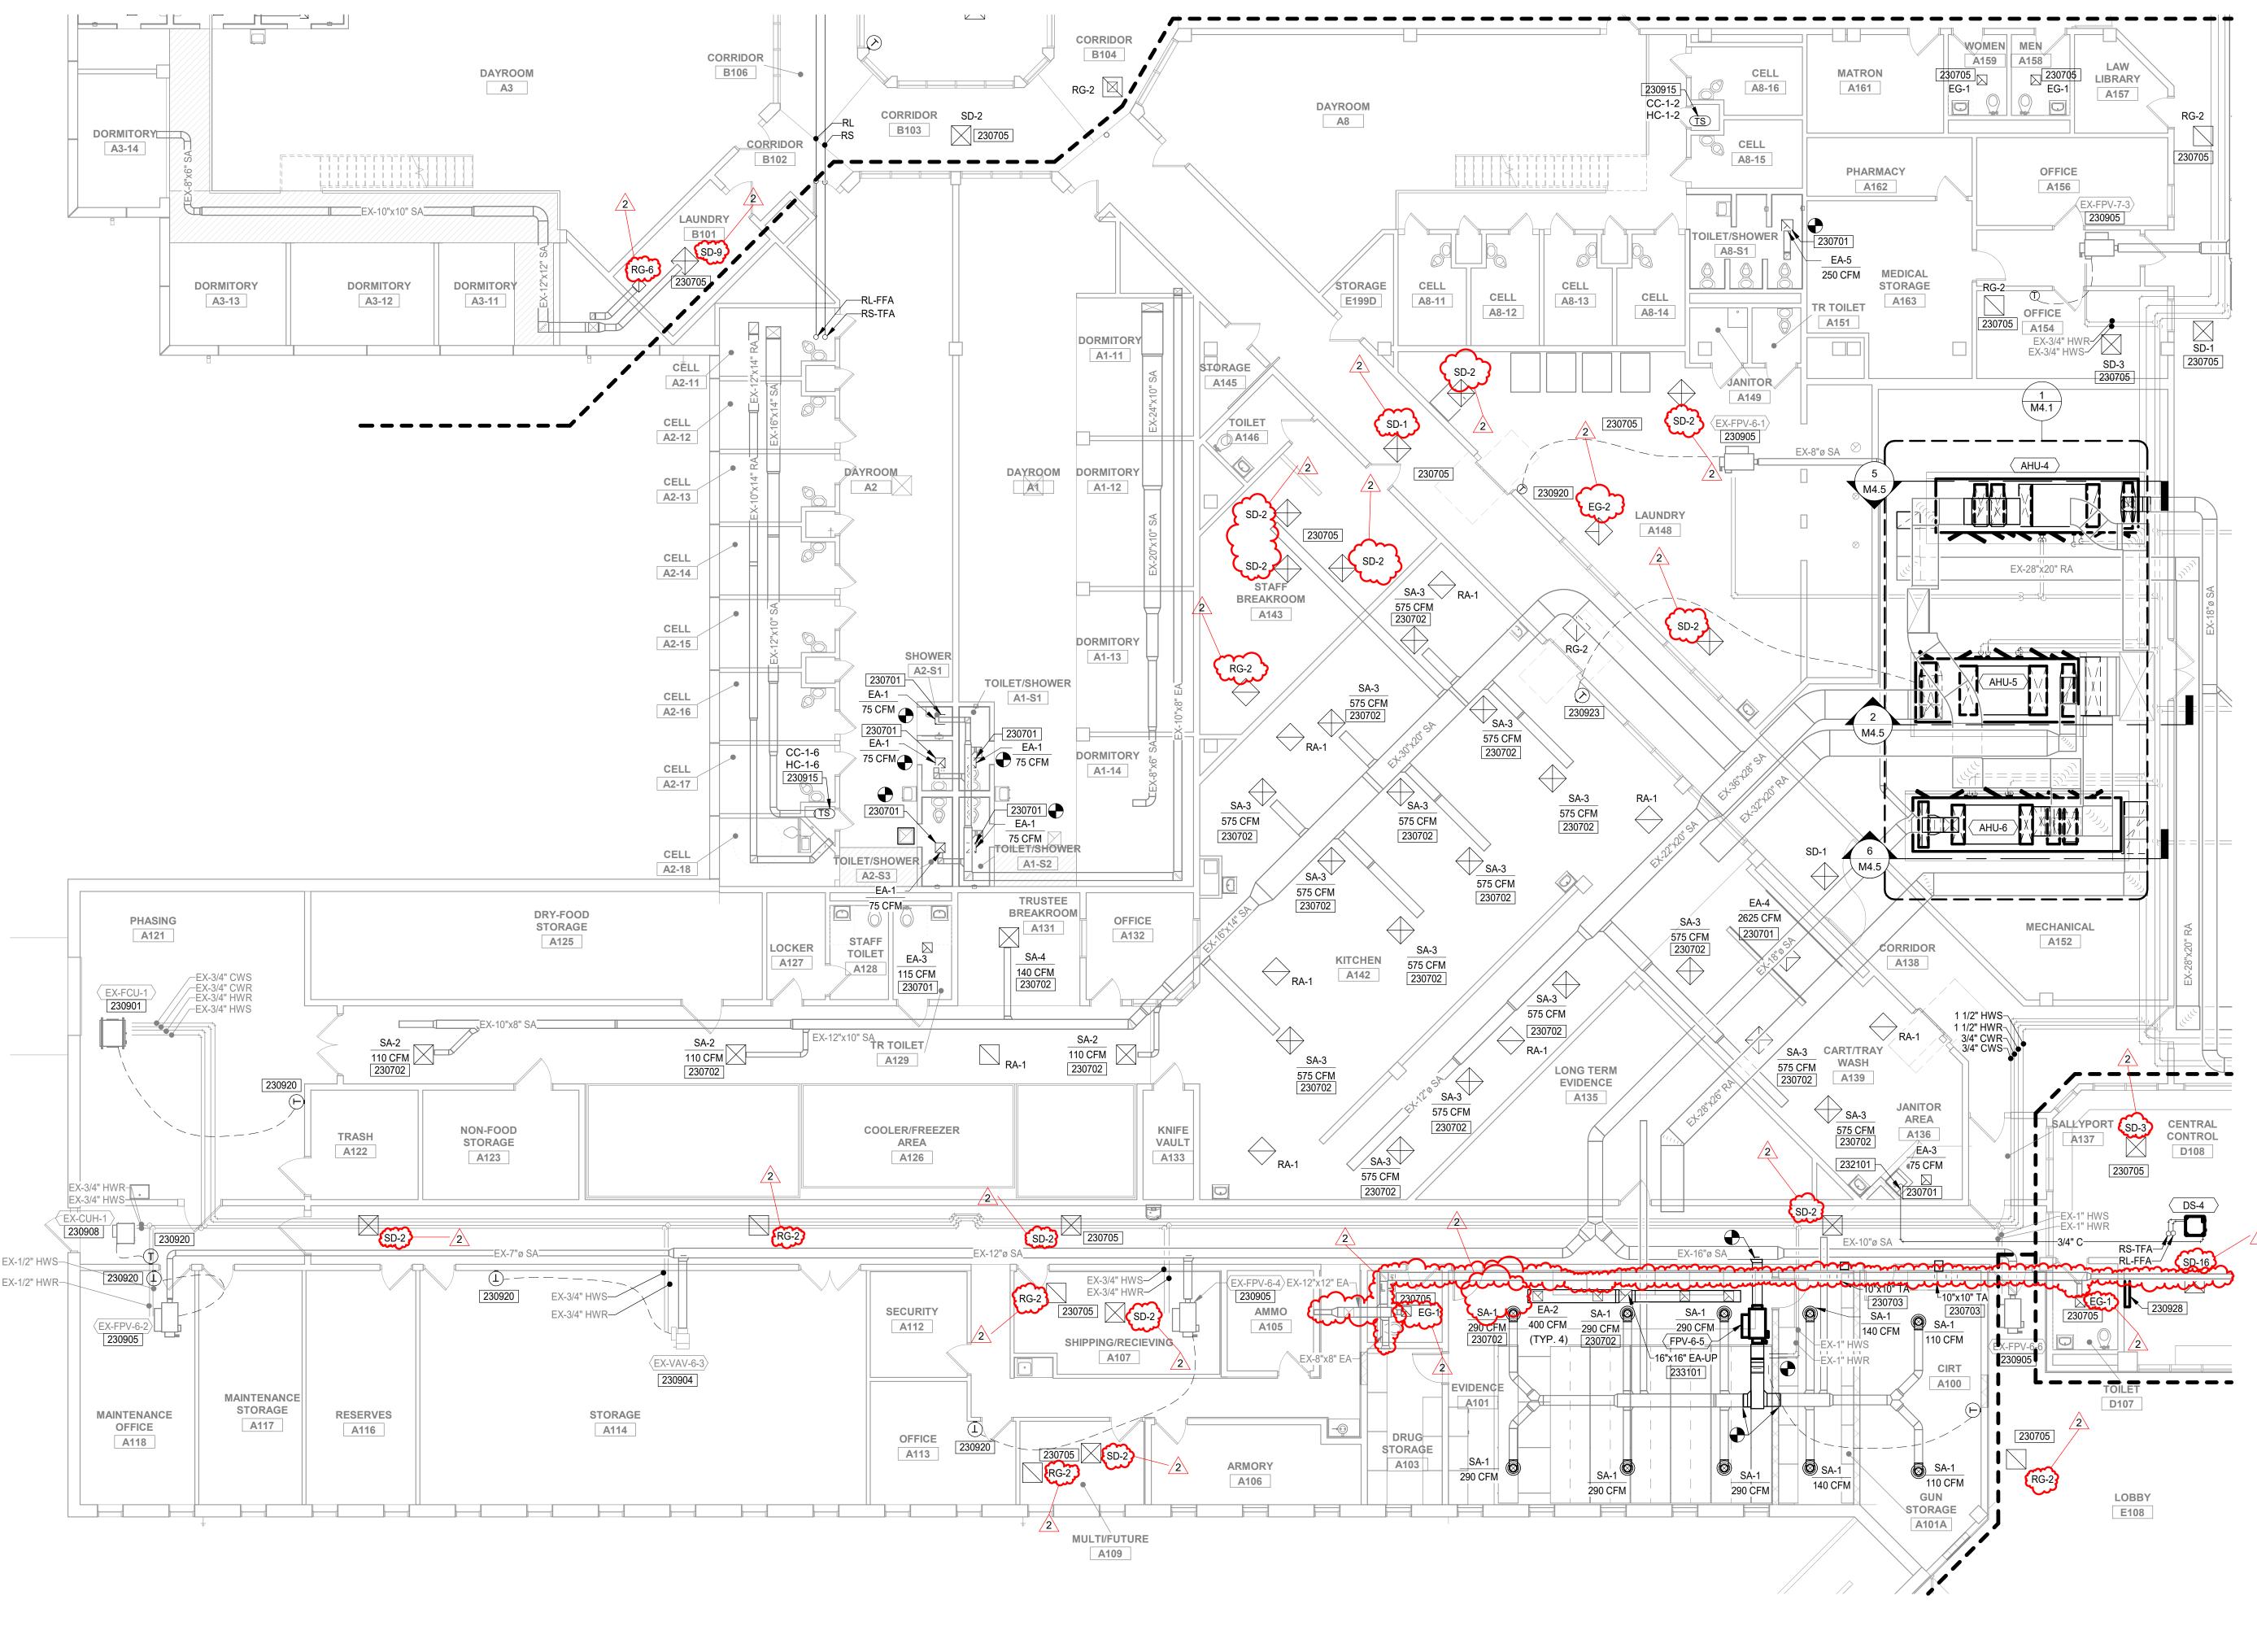


 FIRST FLOOR MECHANCIAL INSTALLATION PLAN


 SCALE: 1/8" = 1'-0"

- REQUIRED.

- DRAWINGS.


| 30701 | CONNECT NEW GRILLE TO E<br>DUCTWORK. LOCATE GRILL<br>AS MINIMALLY AS POSSIBLE  |
|-------|--|
| 30702 | CONNECT NEW DIFFUSER T<br>LOCATE DIFFUSER TO ADJU<br>MINIMALLY AS POSSIBLE.  |
| 30703 | PROVIDE ELBOW WITHOUT<br>TRANSFER AIR DUCT.  |
| 30705 | REINSTALL EXISTING DIFFU<br>CONNECT TO EXISTING DUC<br>ALTERNATE BID: CONNECT<br>GRILLES TO EXISTING DUCT<br>OR GRILLE AS INDICATED O<br>SCHEDULE. |
| 30901 | PROVIDE NEW CONTROLS F<br>INTERFACE WITH BUILDING<br>PER 3/M7.1.   |
| 30904 | PROVIDE NEW CONTROLS F<br>VAV BOX AND INTERFACE W<br>MANAGEMENT SYSTEM. RE   |
| 30905 | PROVIDE NEW CONTROLS F<br>VAV BOX AND INTERFACE W<br>MANAGEMENT SYSTEM. RE   |
| 30908 | PROVIDE NEW CONTROLS F<br>HEATER AND INTERFACE W<br>MANAGEMENT SYSTEM. REI   |
| 30915 | PROVIDE TEMPERATURE SE<br>DUCTWORK. SENSOR TO CO<br>INDICATED.   |
| 30920 | PROVIDE THERMOSTAT IN S<br>EXISTING. MATCH EXISTING<br>AROUND THERMOSTAT IF D  |
| 30923 | PROVIDE NEW THERMOSTA<br>LOCATION INDICATED IS PL<br>TO FIELD VERIFY THERMOS<br>REPLACE EXISTING AT SAM  |
| 80928 | PROVIDE NEW FIREFIGHTER<br>IN CENTRAL CONTROL. CON<br>LOCATION WITH EXISTING E   |
| 32101 | ROUTE CONDENSATE LINE  |
|       |  |

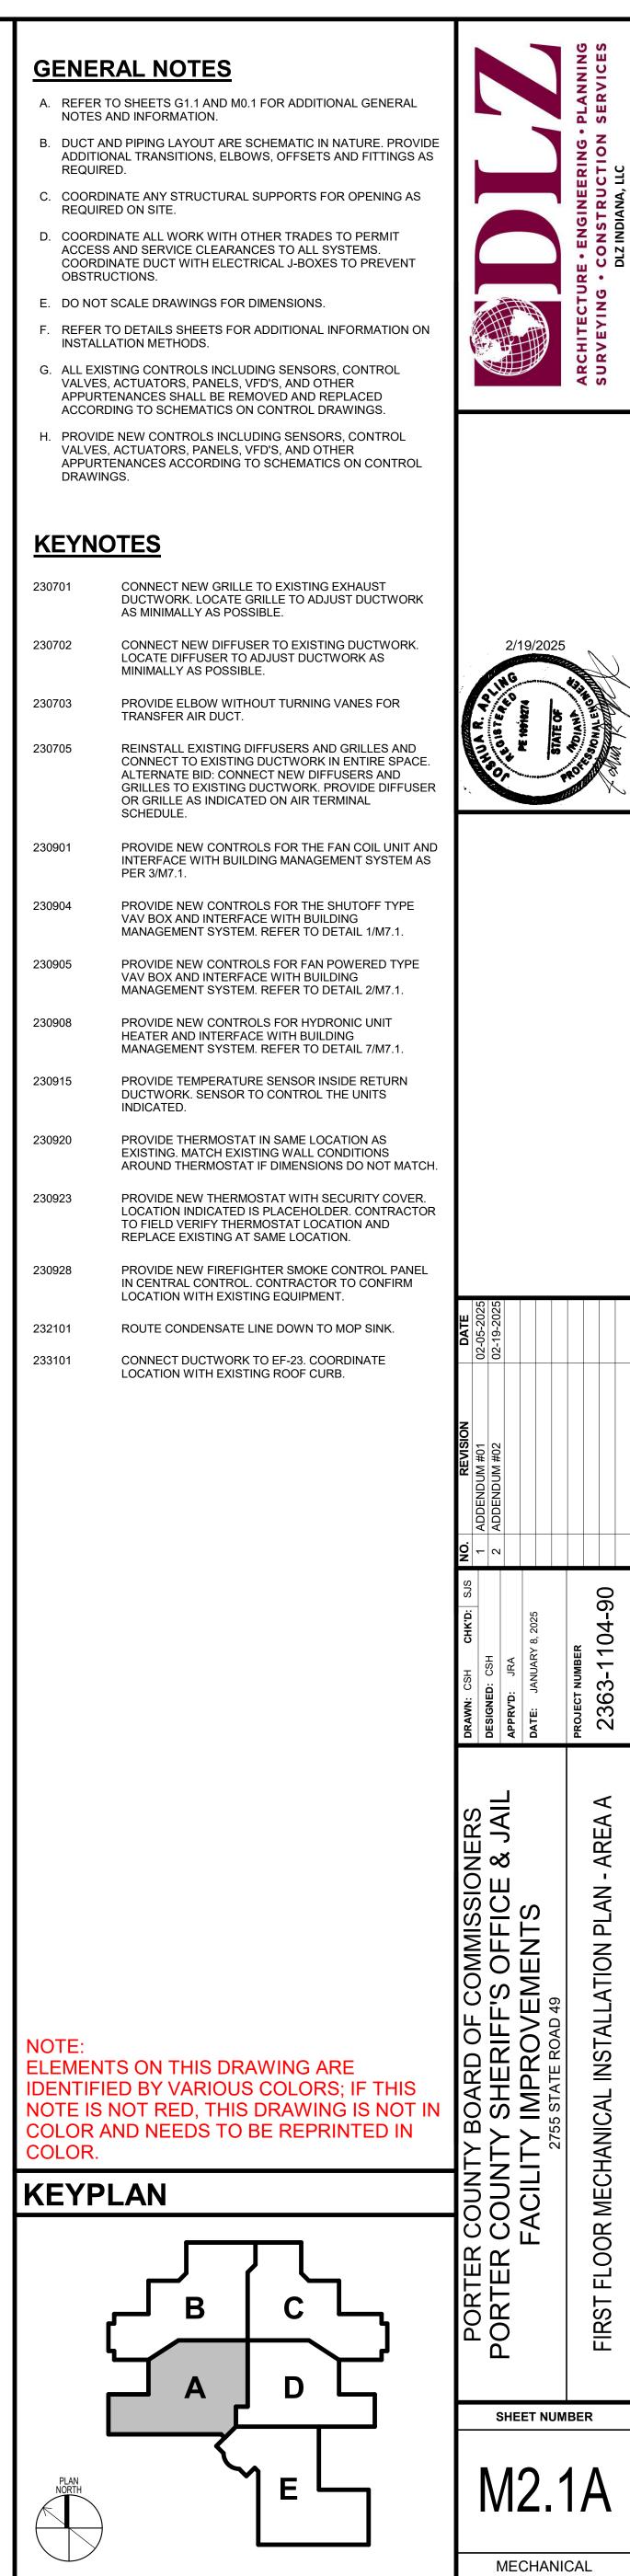

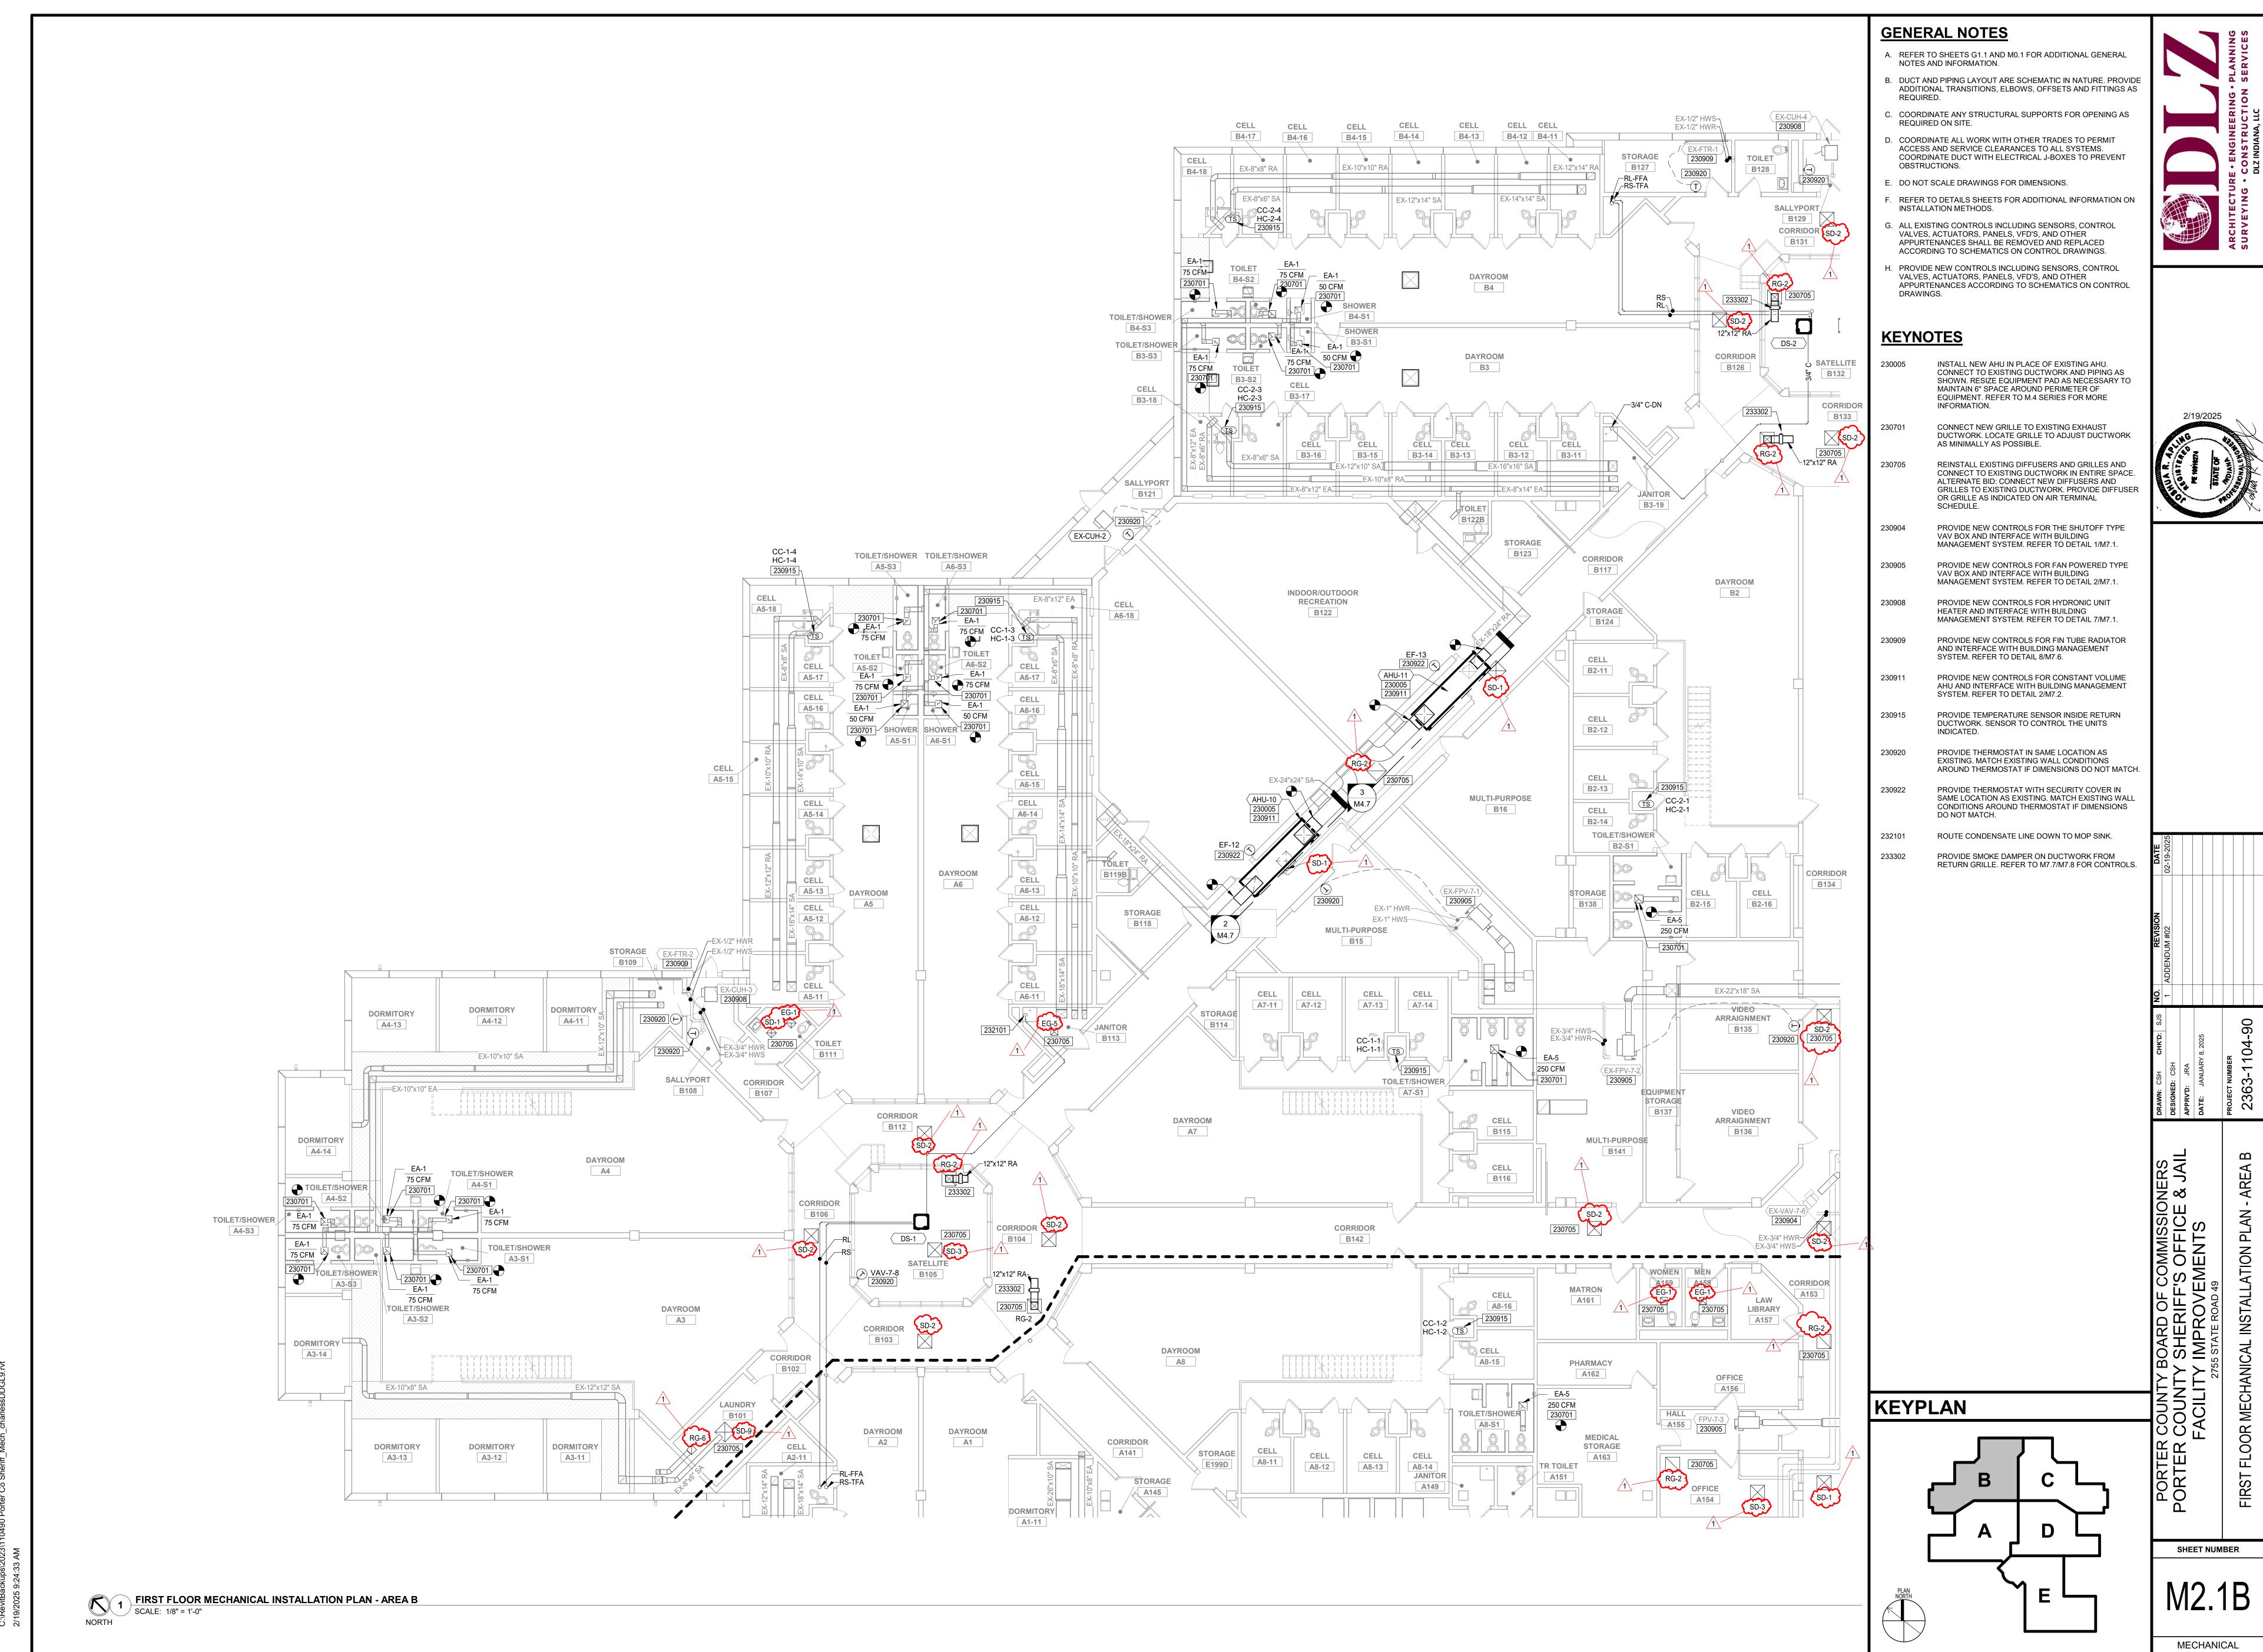


| 005 | INSTALL NEW AHU IN PLACE<br>CONNECT TO EXISTING DUC<br>SHOWN. RESIZE EQUIPMEN<br>MAINTAIN 6" SPACE AROUNI<br>EQUIPMENT. REFER TO M.4<br>INFORMATION. |
|-----|--|
| 701 | CONNECT NEW GRILLE TO E<br>DUCTWORK. LOCATE GRILL<br>AS MINIMALLY AS POSSIBLE  |
| 705 | REINSTALL EXISTING DIFFU<br>CONNECT TO EXISTING DUC<br>ALTERNATE BID: CONNECT I<br>GRILLES TO EXISTING DUCT<br>OR GRILLE AS INDICATED O<br>SCHEDULE. |
| 904 | PROVIDE NEW CONTROLS F<br>VAV BOX AND INTERFACE W<br>MANAGEMENT SYSTEM. REI  |
| 905 | PROVIDE NEW CONTROLS F<br>VAV BOX AND INTERFACE W<br>MANAGEMENT SYSTEM. REI  |
| 908 | PROVIDE NEW CONTROLS F<br>HEATER AND INTERFACE W<br>MANAGEMENT SYSTEM. REF   |
| 909 | PROVIDE NEW CONTROLS F<br>AND INTERFACE WITH BUILT<br>SYSTEM. REFER TO DETAIL  |
| 911 | PROVIDE NEW CONTROLS F<br>AHU AND INTERFACE WITH<br>SYSTEM. REFER TO DETAIL  |
| 915 | PROVIDE TEMPERATURE SE<br>DUCTWORK. SENSOR TO CO<br>INDICATED.   |
| 920 | PROVIDE THERMOSTAT IN S<br>EXISTING. MATCH EXISTING<br>AROUND THERMOSTAT IF D  |
| 922 | PROVIDE THERMOSTAT WIT<br>SAME LOCATION AS EXISTIN<br>CONDITIONS AROUND THER<br>DO NOT MATCH.  |
| 101 | ROUTE CONDENSATE LINE I  |
| 302 | PROVIDE SMOKE DAMPER C<br>RETURN GRILLE. REFER TO  |
|     |  |




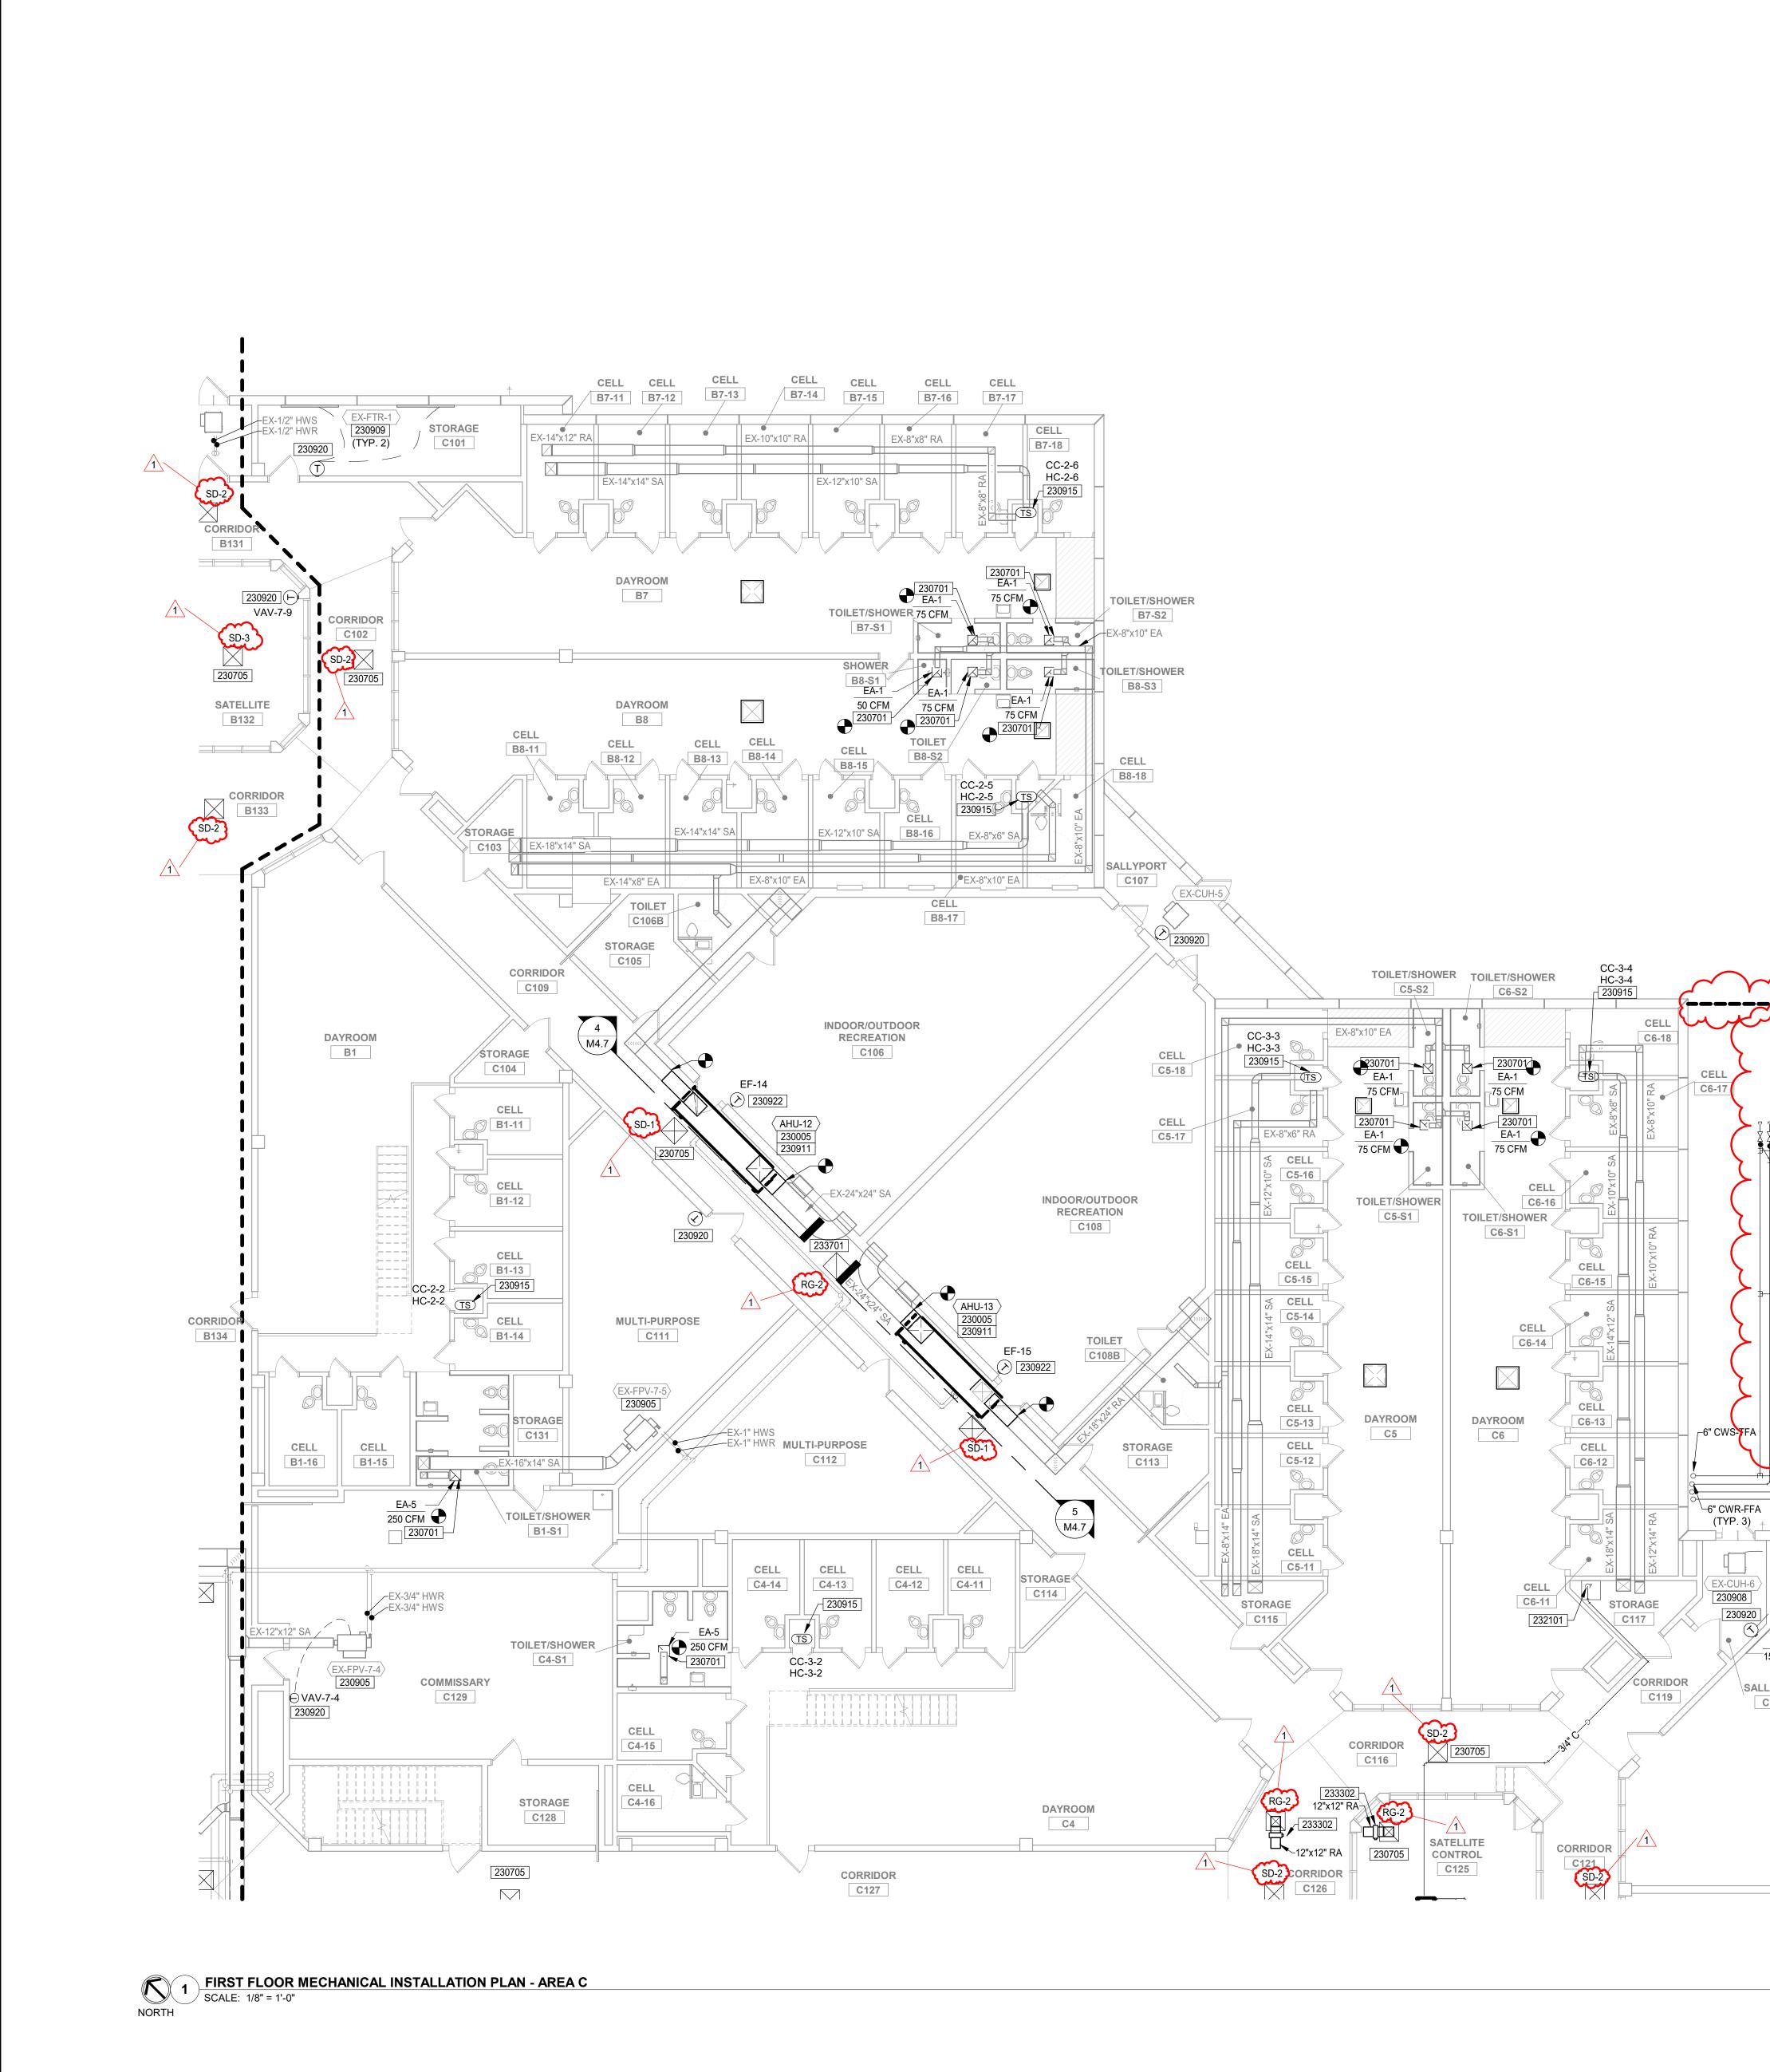

|   | GENERAL NOTES  |
|---|--|
|   | A. REFER TO SHEETS G1.1 AND M0.1 FOR A NOTES AND INFORMATION.  |
|   | B. DUCT AND PIPING LAYOUT ARE SCHEM/<br>ADDITIONAL TRANSITIONS, ELBOWS, OF<br>REQUIRED.  |
|   | <ul><li>C. COORDINATE ANY STRUCTURAL SUPPOREQUIRED ON SITE.</li><li>D. COORDINATE ALL WORK WITH OTHER T</li></ul>  |
|   | D. COORDINATE ALL WORK WITH OTHER T<br>ACCESS AND SERVICE CLEARANCES TO<br>COORDINATE DUCT WITH ELECTRICAL<br>OBSTRUCTIONS.  |
|   | <ul> <li>E. DO NOT SCALE DRAWINGS FOR DIMENS</li> <li>F. REFER TO DETAILS SHEETS FOR ADDITI<br/>INSTALLATION METHODS.</li> </ul>   |
|   | G. ALL EXISTING CONTROLS INCLUDING SE<br>VALVES, ACTUATORS, PANELS, VFD'S, A<br>APPURTENANCES SHALL BE REMOVED   |
|   | <ul> <li>ACCORDING TO SCHEMATICS ON CONT</li> <li>H. PROVIDE NEW CONTROLS INCLUDING S<br/>VALVES, ACTUATORS, PANELS, VFD'S, A<br/>APPURTENANCES ACCORDING TO SCHI<br/>DRAWINGS.</li> </ul> |
|   | <u>KEYNOTES</u>  |
| 2   | 230005<br>INSTALL NEW AHU IN PLACE C<br>CONNECT TO EXISTING DUCT<br>SHOWN. RESIZE EQUIPMENT I<br>MAINTAIN 6" SPACE AROUND I<br>EQUIPMENT. REFER TO M.4 SE<br>INFORMATION.                  |
| 2   | 230013<br>CHILLER YARD FENCING TO E<br>WITH WALL AS INDICATED. RE<br>FENCING DETAILS.  |
|   | 230021 RESIZE EXISTING HOUSING PA<br>230701 CONNECT NEW GRILLE TO EX<br>DUCTWORK. LOCATE GRILLE  |
| 2   | AS MINIMALLY AS POSSIBLE.<br>230705 REINSTALL EXISTING DIFFUSE<br>CONNECT TO EXISTING DUCT<br>ALTERNATE BID: CONNECT NE<br>GRILLES TO EXISTING DUCTW<br>OR GRILLE AS INDICATED ON          |
| 2   | 230905 PROVIDE NEW CONTROLS FO<br>VAV BOX AND INTERFACE WIT<br>MANAGEMENT SYSTEM. REFE   |
| 2   | 230908 PROVIDE NEW CONTROLS FO<br>HEATER AND INTERFACE WITI<br>MANAGEMENT SYSTEM. REFE   |
| 2   | 230909 PROVIDE NEW CONTROLS FO<br>AND INTERFACE WITH BUILDIN<br>SYSTEM. REFER TO DETAIL 8/   |
| 2   | 230911 PROVIDE NEW CONTROLS FO<br>AHU AND INTERFACE WITH BL<br>SYSTEM. REFER TO DETAIL 2/  |
| 2   | 230915 PROVIDE TEMPERATURE SEN<br>DUCTWORK. SENSOR TO CON<br>INDICATED.  |
| 2   | 230920 PROVIDE THERMOSTAT IN SA<br>EXISTING. MATCH EXISTING W<br>AROUND THERMOSTAT IF DIM  |
|   | 230922 PROVIDE THERMOSTAT WITH<br>SAME LOCATION AS EXISTING<br>CONDITIONS AROUND THERM<br>DO NOT MATCH.  |
|   | 232101 ROUTE CONDENSATE LINE DO<br>232102 PROVIDE STUB-OUT WITH SHU<br>EMERGENCY CHILLED WATER<br>ENDS.  |
| EXTEND EXISTING FENCE 2   | 233302 PROVIDE SMOKE DAMPER ON<br>RETURN GRILLE. REFER TO M  |
| 2   | 233701 REINSTALL EXISTING RETURN<br>LOCATION AS PREVIOUSLY.  |
| CELL CELL CELL CELL CELL CELL CT-15 CT-16 CT-17 CT-15 CT-16 CT-17 | KEYPLAN  |
| DAYROOM<br>C7<br>C7<br>C7<br>C7<br>C7<br>C7<br>C7<br>C7<br>C7<br>C7<br>C7<br>C7<br>C7   |  |

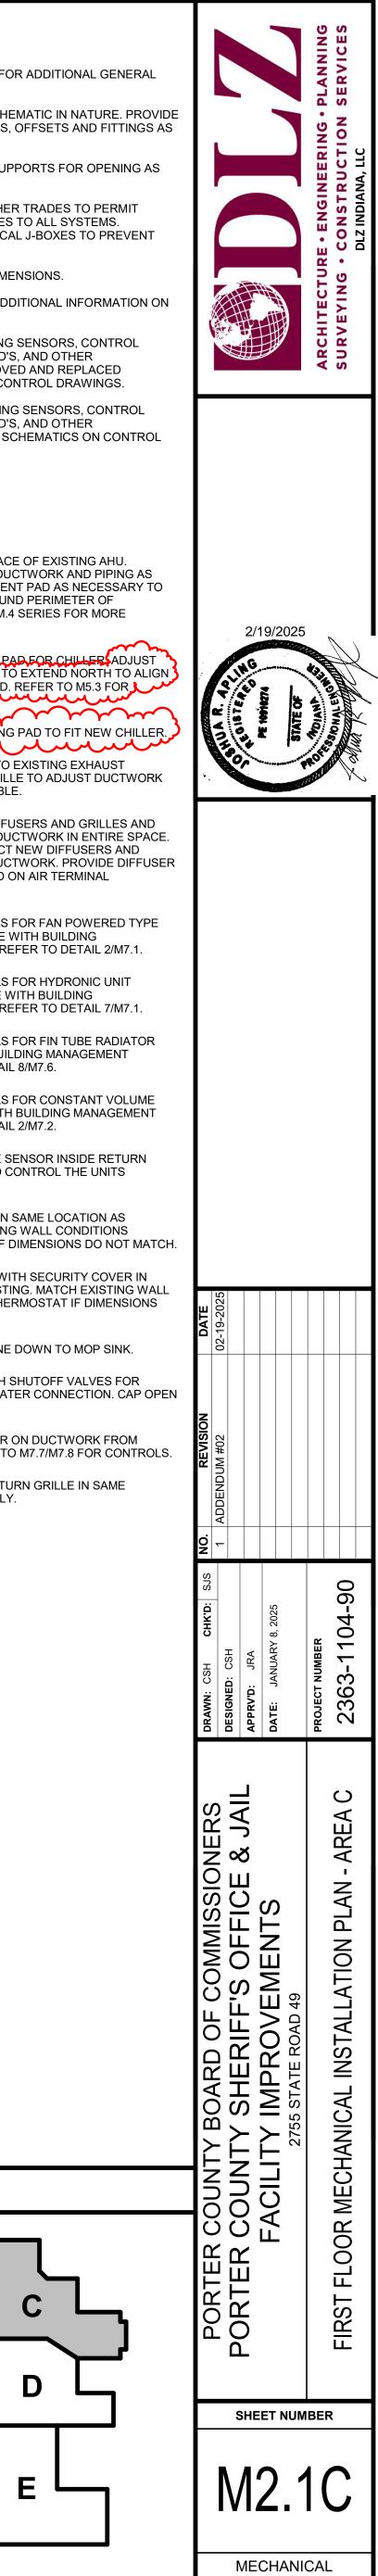




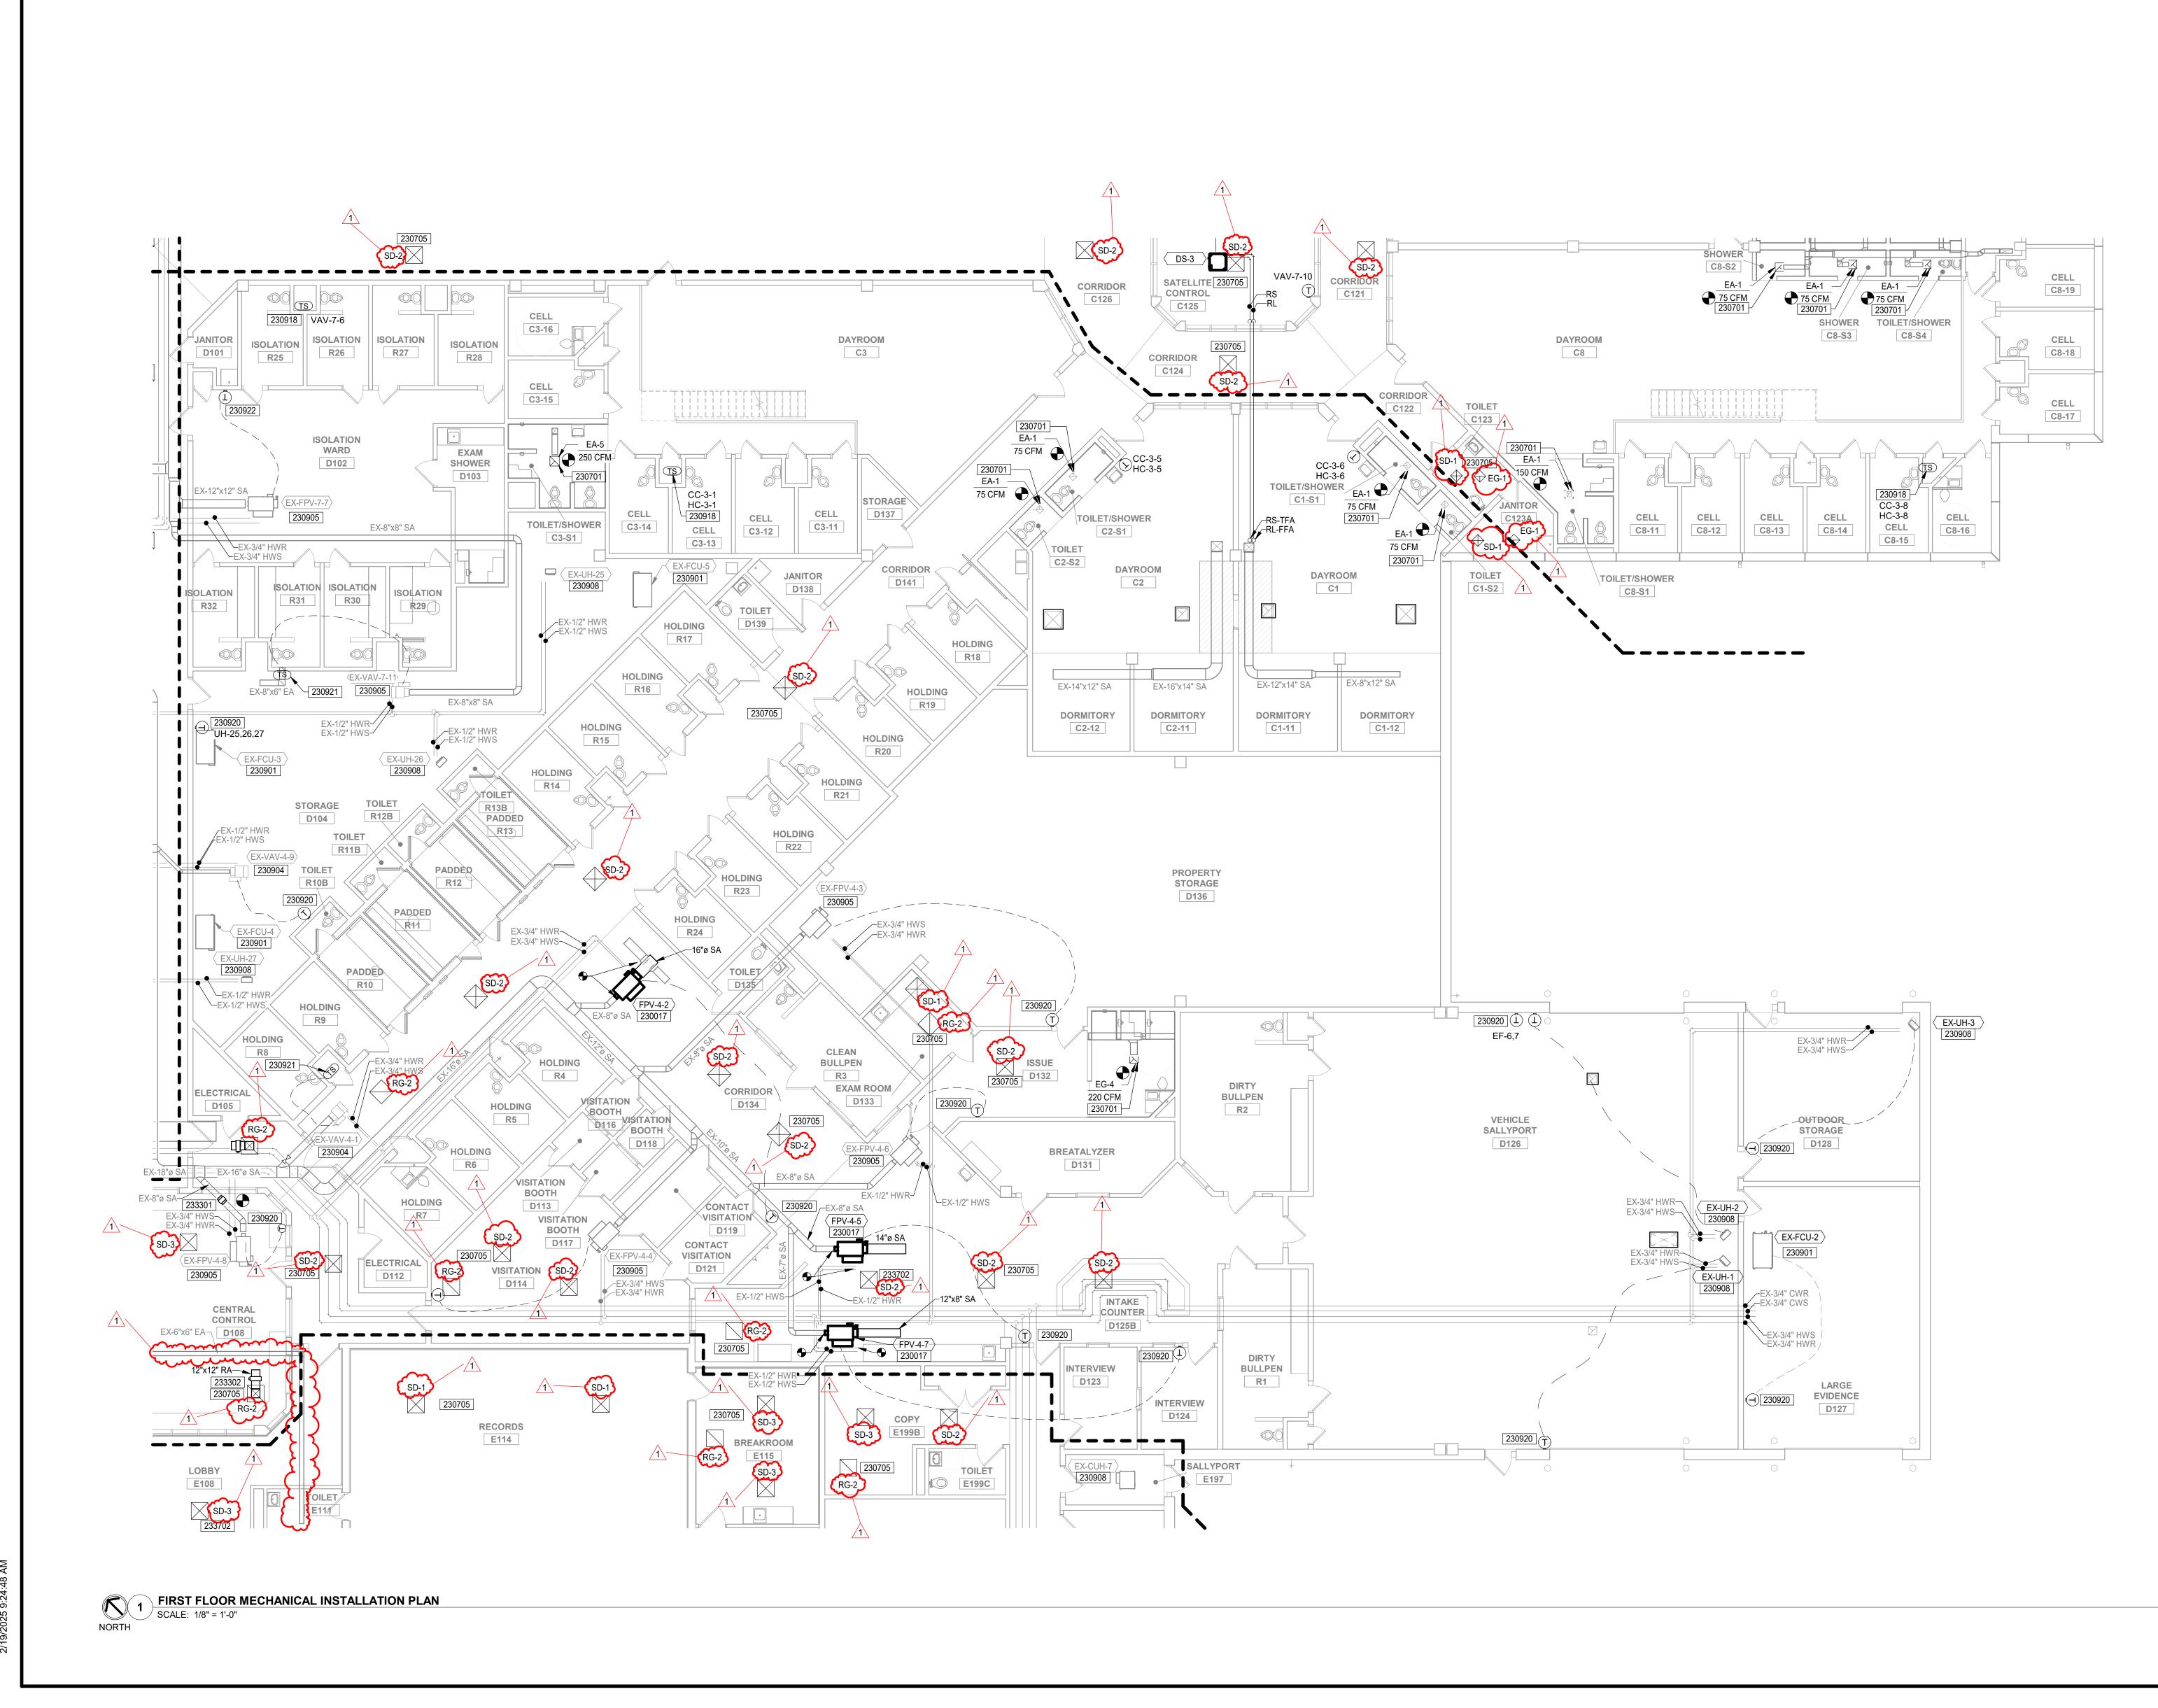


- INSTALLATION METHODS.


| 230017 | CONNECT NEW VAV BOX TO<br>PIPING. PROVIDE NEW CON<br>TYPE VAV BOX AND INTERFA<br>MANAGEMENT SYSTEM. REI  |
|--------|--|
| 230701 | CONNECT NEW GRILLE TO E<br>DUCTWORK. LOCATE GRILL<br>AS MINIMALLY AS POSSIBLE  |
| 230705 | REINSTALL EXISTING DIFFU<br>CONNECT TO EXISTING DUC<br>ALTERNATE BID: CONNECT<br>GRILLES TO EXISTING DUCT<br>OR GRILLE AS INDICATED O<br>SCHEDULE. |
| 230901 | PROVIDE NEW CONTROLS F<br>INTERFACE WITH BUILDING<br>PER 3/M7.1.   |
| 230904 | PROVIDE NEW CONTROLS F<br>VAV BOX AND INTERFACE W<br>MANAGEMENT SYSTEM. REI  |
| 230905 | PROVIDE NEW CONTROLS F<br>VAV BOX AND INTERFACE W<br>MANAGEMENT SYSTEM. REI  |
| 230908 | PROVIDE NEW CONTROLS F<br>HEATER AND INTERFACE W<br>MANAGEMENT SYSTEM. REI   |
| 230918 | PROVIDE TEMPERATURE SE<br>DUCTWORK. REPAIR OR RE<br>AFFECTED BY TEMPERATUR<br>SENSOR TO CONTROL THE  |
| 230920 | PROVIDE THERMOSTAT IN S<br>EXISTING. MATCH EXISTING<br>AROUND THERMOSTAT IF D  |
| 230921 | PROVIDE TEMPERATURE SE<br>EXHAUST DUCTWORK.  |
| 230922 | PROVIDE THERMOSTAT WIT<br>SAME LOCATION AS EXISTIN<br>CONDITIONS AROUND THEF<br>DO NOT MATCH.  |
| 233301 | PROVIDE NEW SMOKE DAM<br>OF VAV BOX. REFER TO M7.  |
| 233302 | PROVIDE SMOKE DAMPER C<br>RETURN GRILLE. REFER TO  |
| 233702 | INSTALL NEW SUPPLY DIFFU<br>PREVIOUSLY. RECONNECT  |

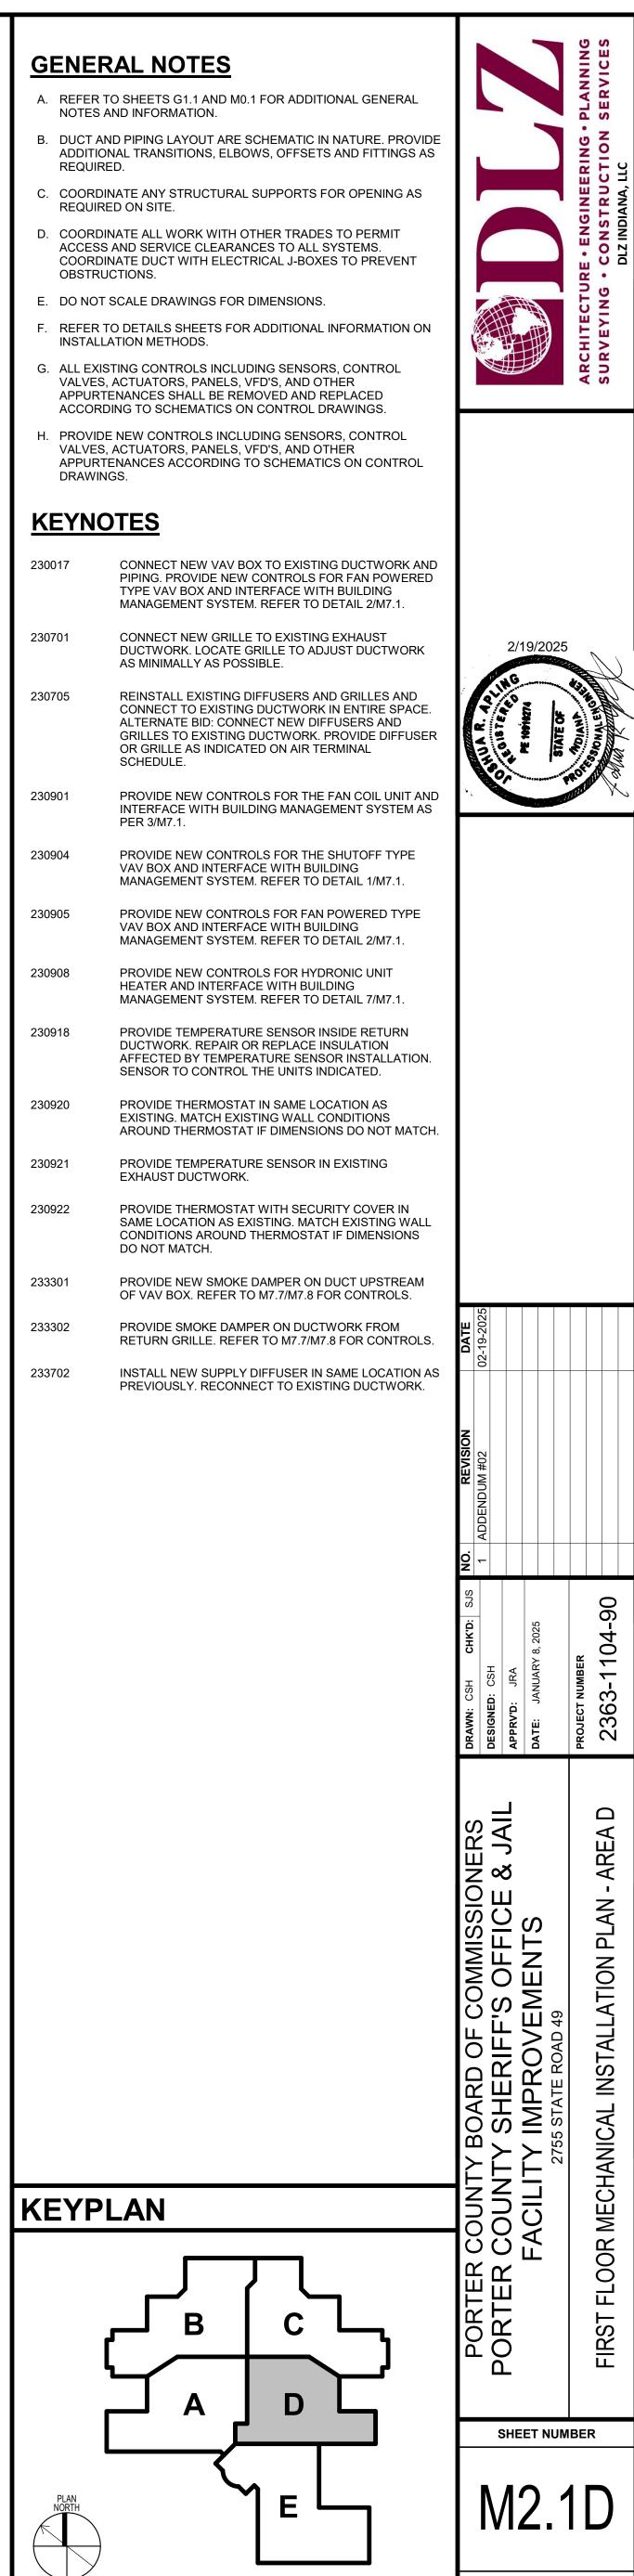

MECHANICAL

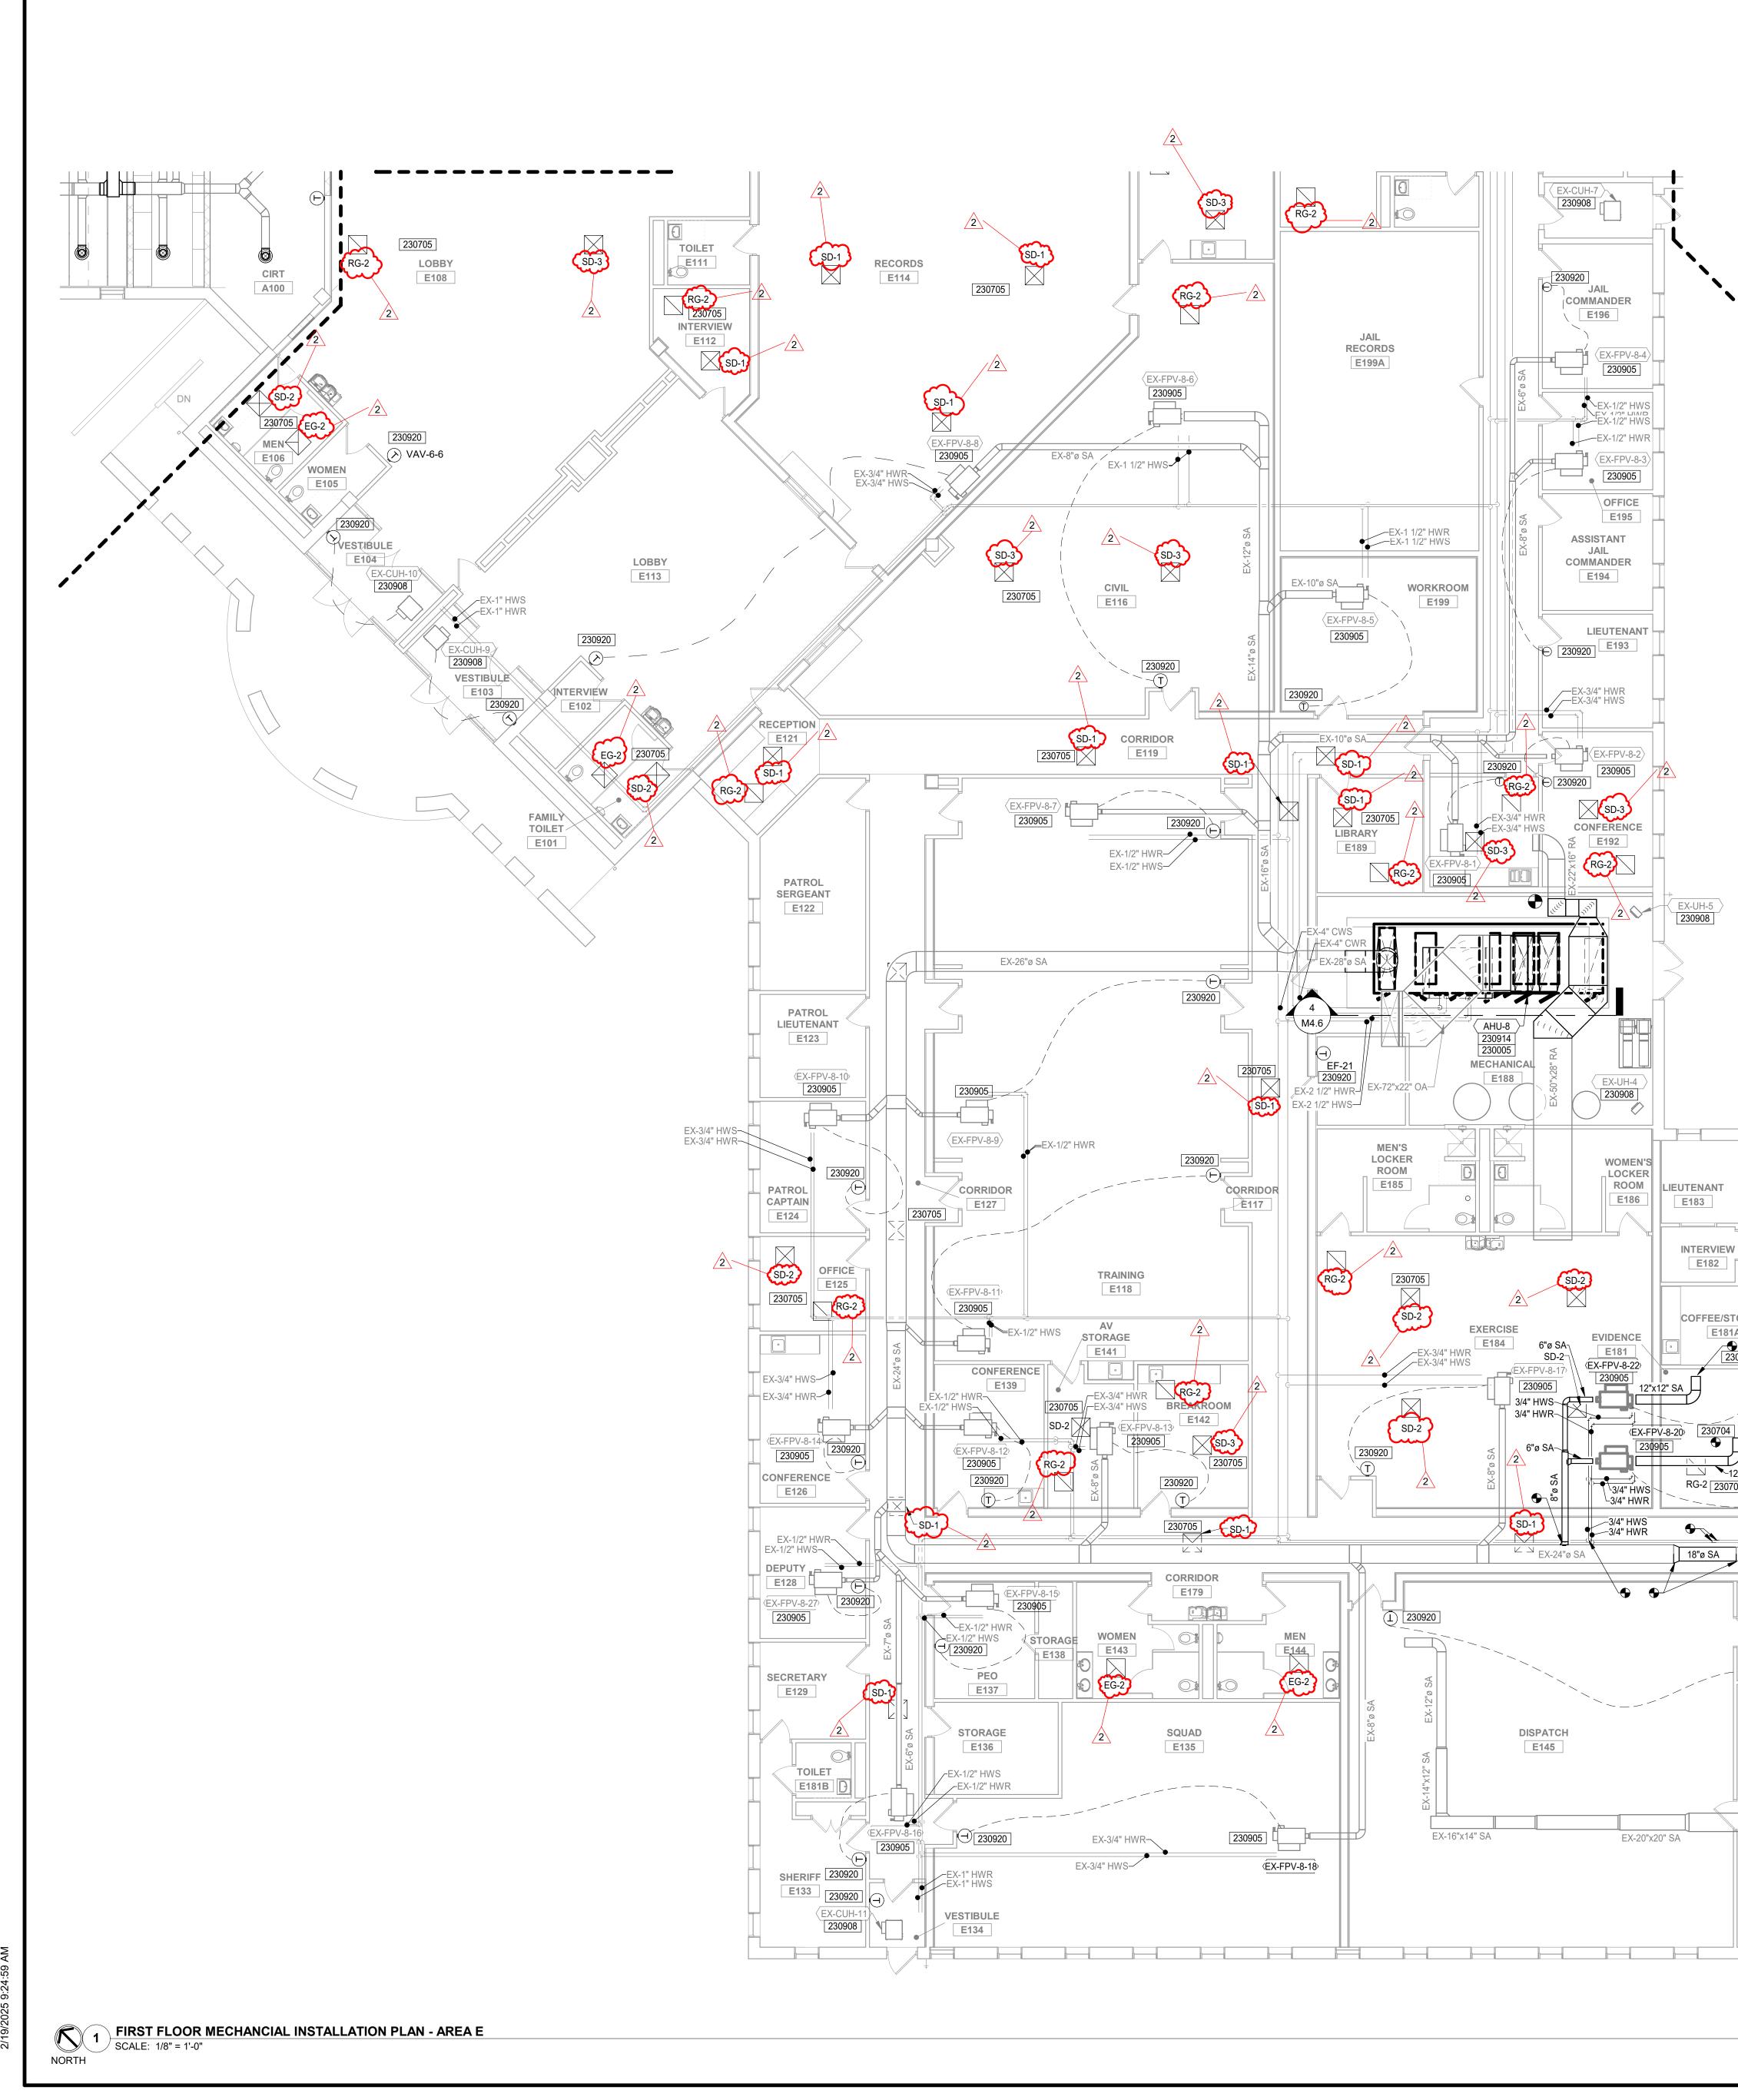



| ۰、   | <ul> <li>NOTES AND INFORMATION.</li> <li>B. DUCT AND PIPING LAYOUT ARE SCHEMATIC IN NATURE. PROVIDE<br/>ADDITIONAL TRANSITIONS, ELBOWS, OFFSETS AND FITTINGS AS<br/>REQUIRED.</li> <li>C. COORDINATE ANY STRUCTURAL SUPPORTS FOR OPENING AS<br/>REQUIRED ON SITE.</li> <li>D. COORDINATE ALL WORK WITH OTHER TRADES TO PERMIT<br/>ACCESS AND SERVICE CLEARANCES TO ALL SYSTEMS.<br/>COORDINATE DUCT WITH ELECTRICAL J-BOXES TO PREVENT<br/>OBSTRUCTIONS.</li> <li>E. DO NOT SCALE DRAWINGS FOR DIMENSIONS.</li> <li>F. REFER TO DETAILS SHEETS FOR ADDITIONAL INFORMATION ON<br/>INSTALLATION METHODS.</li> <li>G. ALL EXISTING CONTROLS INCLUDING SENSORS, CONTROL<br/>VALVES, ACTUATORS, PANELS, VFD'S, AND OTHER<br/>APPURTENANCES SHALL BE REMOVED AND REPLACED<br/>ACCORDING TO SCHEMATICS ON CONTROL DRAWINGS.</li> <li>H. PROVIDE NEW CONTROLS INCLUDING SENSORS, CONTROL<br/>VALVES, ACTUATORS, PANELS, VFD'S, AND OTHER<br/>APPURTENANCES SHALL BE REMOVED AND REPLACED<br/>ACCORDING TO SCHEMATICS ON CONTROL DRAWINGS.</li> <li>H. PROVIDE NEW CONTROLS INCLUDING SENSORS, CONTROL<br/>VALVES, ACTUATORS, PANELS, VFD'S, AND OTHER<br/>APPURTENANCES ACCORDING TO SCHEMATICS ON CONTROL<br/>DRAWINGS.</li> </ul> |
|--|---|
|  | KEYNOTES         230005       INSTALL NEW AHU IN PLACE OF EXISTING AHU.<br>CONNECT TO EXISTING DUCTWORK AND PIPING AS   |
|  | SHOWN. RESIZE EQUIPMENT PAD AS NECESSARY TO<br>MAINTAIN 6" SPACE AROUND PERIMETER OF<br>EQUIPMENT. REFER TO M.4 SERIES FOR MORE<br>INFORMATION.<br>230017 CONNECT NEW VAV BOX TO EXISTING DUCTWORK AND  |
|  | PIPING. PROVIDE NEW CONTROLS FOR FAN POWERED<br>TYPE VAV BOX AND INTERFACE WITH BUILDING<br>MANAGEMENT SYSTEM. REFER TO DETAIL 2/M7.1.  |
|  | 230704 INSTALL NEW DUCTWORK FROM FPV TO EXISTING.<br>VIELD VERIFY TO MATCH TO EXISTING DUCTWORK<br>SIZE.  |
|  | 230705 REINSTALL EXISTING DIFFUSERS AND GRILLES AND<br>CONNECT TO EXISTING DUCTWORK IN ENTIRE SPACE.<br>ALTERNATE BID: CONNECT NEW DIFFUSERS AND<br>GRILLES TO EXISTING DUCTWORK. PROVIDE DIFFUSER<br>OR GRILLE AS INDICATED ON AIR TERMINAL<br>SCHEDULE.   |
|  | 230905 PROVIDE NEW CONTROLS FOR FAN POWERED TYPE<br>VAV BOX AND INTERFACE WITH BUILDING<br>MANAGEMENT SYSTEM. REFER TO DETAIL 2/M7.1.   |
|  | 230908 PROVIDE NEW CONTROLS FOR HYDRONIC UNIT<br>HEATER AND INTERFACE WITH BUILDING<br>MANAGEMENT SYSTEM. REFER TO DETAIL 7/M7.1.<br>230914 PROVIDE NEW CONTROLS FOR VAV AHU AND  |
|  | INTERFACE WITH BUILDING MANAGEMENT SYSTEM.<br>REFER TO DETAIL 2/M7.5.230920PROVIDE THERMOSTAT IN SAME LOCATION AS<br>EXISTING. MATCH EXISTING WALL CONDITIONS   |
| 20000 CONFERENCE   |   |
| 34       EVIDENCE       EVIDENCE       Image: Constraint of the second   |   |
| E146<br>E146<br>E146<br>E146<br>E146<br>EX-FPV-8-26 <sup>3</sup><br>E157<br>E157<br>E157<br>E157<br>E157<br>E157<br>E157<br>E157<br>E157<br>E157<br>E157<br>E157<br>E157<br>E157<br>E157<br>E157<br>E157<br>E157<br>E157<br>E157<br>E157<br>E157<br>E157<br>E157<br>E157<br>E157<br>E157<br>E157<br>E157<br>E157<br>E157<br>E157<br>E157<br>E157<br>E157<br>E157<br>E157<br>E157<br>E157<br>E157<br>E157<br>E157<br>E157<br>E157<br>E157<br>E157<br>E157<br>E157<br>E157<br>E157<br>E157<br>E157<br>E157<br>E157<br>E157<br>E157<br>E157<br>E157<br>E157<br>E157<br>E157<br>E157<br>E157<br>E157<br>E157<br>E157<br>E157<br>E157<br>E157<br>E157<br>E157<br>E157<br>E157<br>E157<br>E157<br>E157<br>E157<br>E157<br>E157<br>E157<br>E157<br>E157<br>E157<br>E157<br>E157<br>E157<br>E157<br>E157<br>E157<br>E157<br>E157<br>E157<br>E157<br>E157<br>E157<br>E157<br>E157<br>E157<br>E157<br>E157<br>E157<br>E157<br>E157<br>E157<br>E157<br>E157<br>E157<br>E157<br>E157<br>E157<br>E157<br>E157<br>E157<br>E157<br>E157<br>E157<br>E157<br>E157<br>E157<br>E157<br>E157<br>E157<br>E157<br>E1 | NOTE:<br>ELEMENTS ON THIS DRAWING ARE<br>IDENTIFIED BY VARIOUS COLORS; IF THIS  |
| 230905     230905     EX-28"x24" RA     WOMEN     EST-1     230920     911       EX-28"x24" RA     EST-1     EST-1     EST-1     EST-1     EST-1     EST-1       EX-28"x24" RA     EST-1     EST-1     EST-1     EST-1     EST-1   | NOTE IS NOT RED, THIS DRAWING IS NOT IN<br>COLOR AND NEEDS TO BE REPRINTED IN<br>COLOR.   |
| MEN<br>5 E156 FPV-8-23 2 E152 MAP<br>E152 FPV-8-23 2 E152 F164   | KEYPLAN   |
| EX-26"x24" SA<br>EX-3/4" HWS<br>EX-3/4" HWS<br>EX-3   |   |

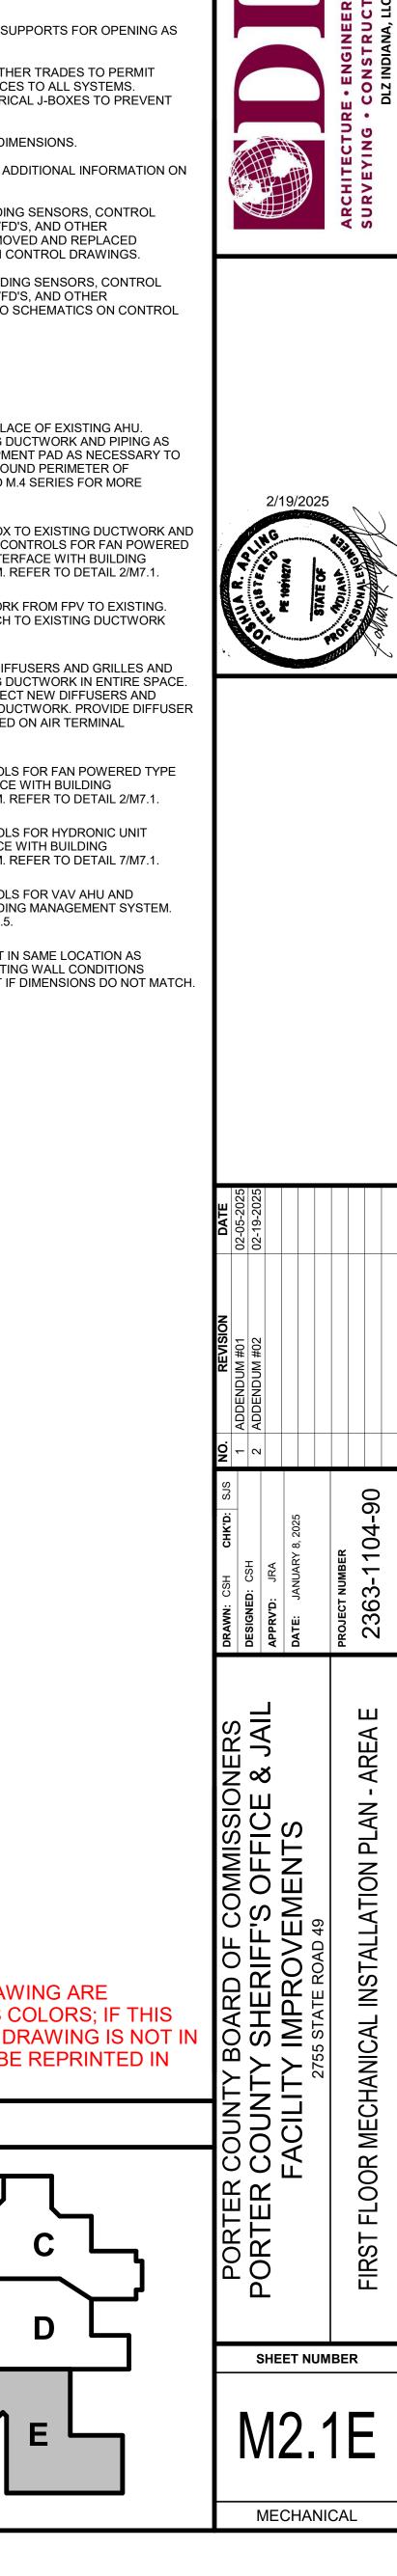


**GENERAL NOTES** 

A. REFER TO SHEETS G1.1 AND M0.1 FOR ADDITIONAL GENERAL

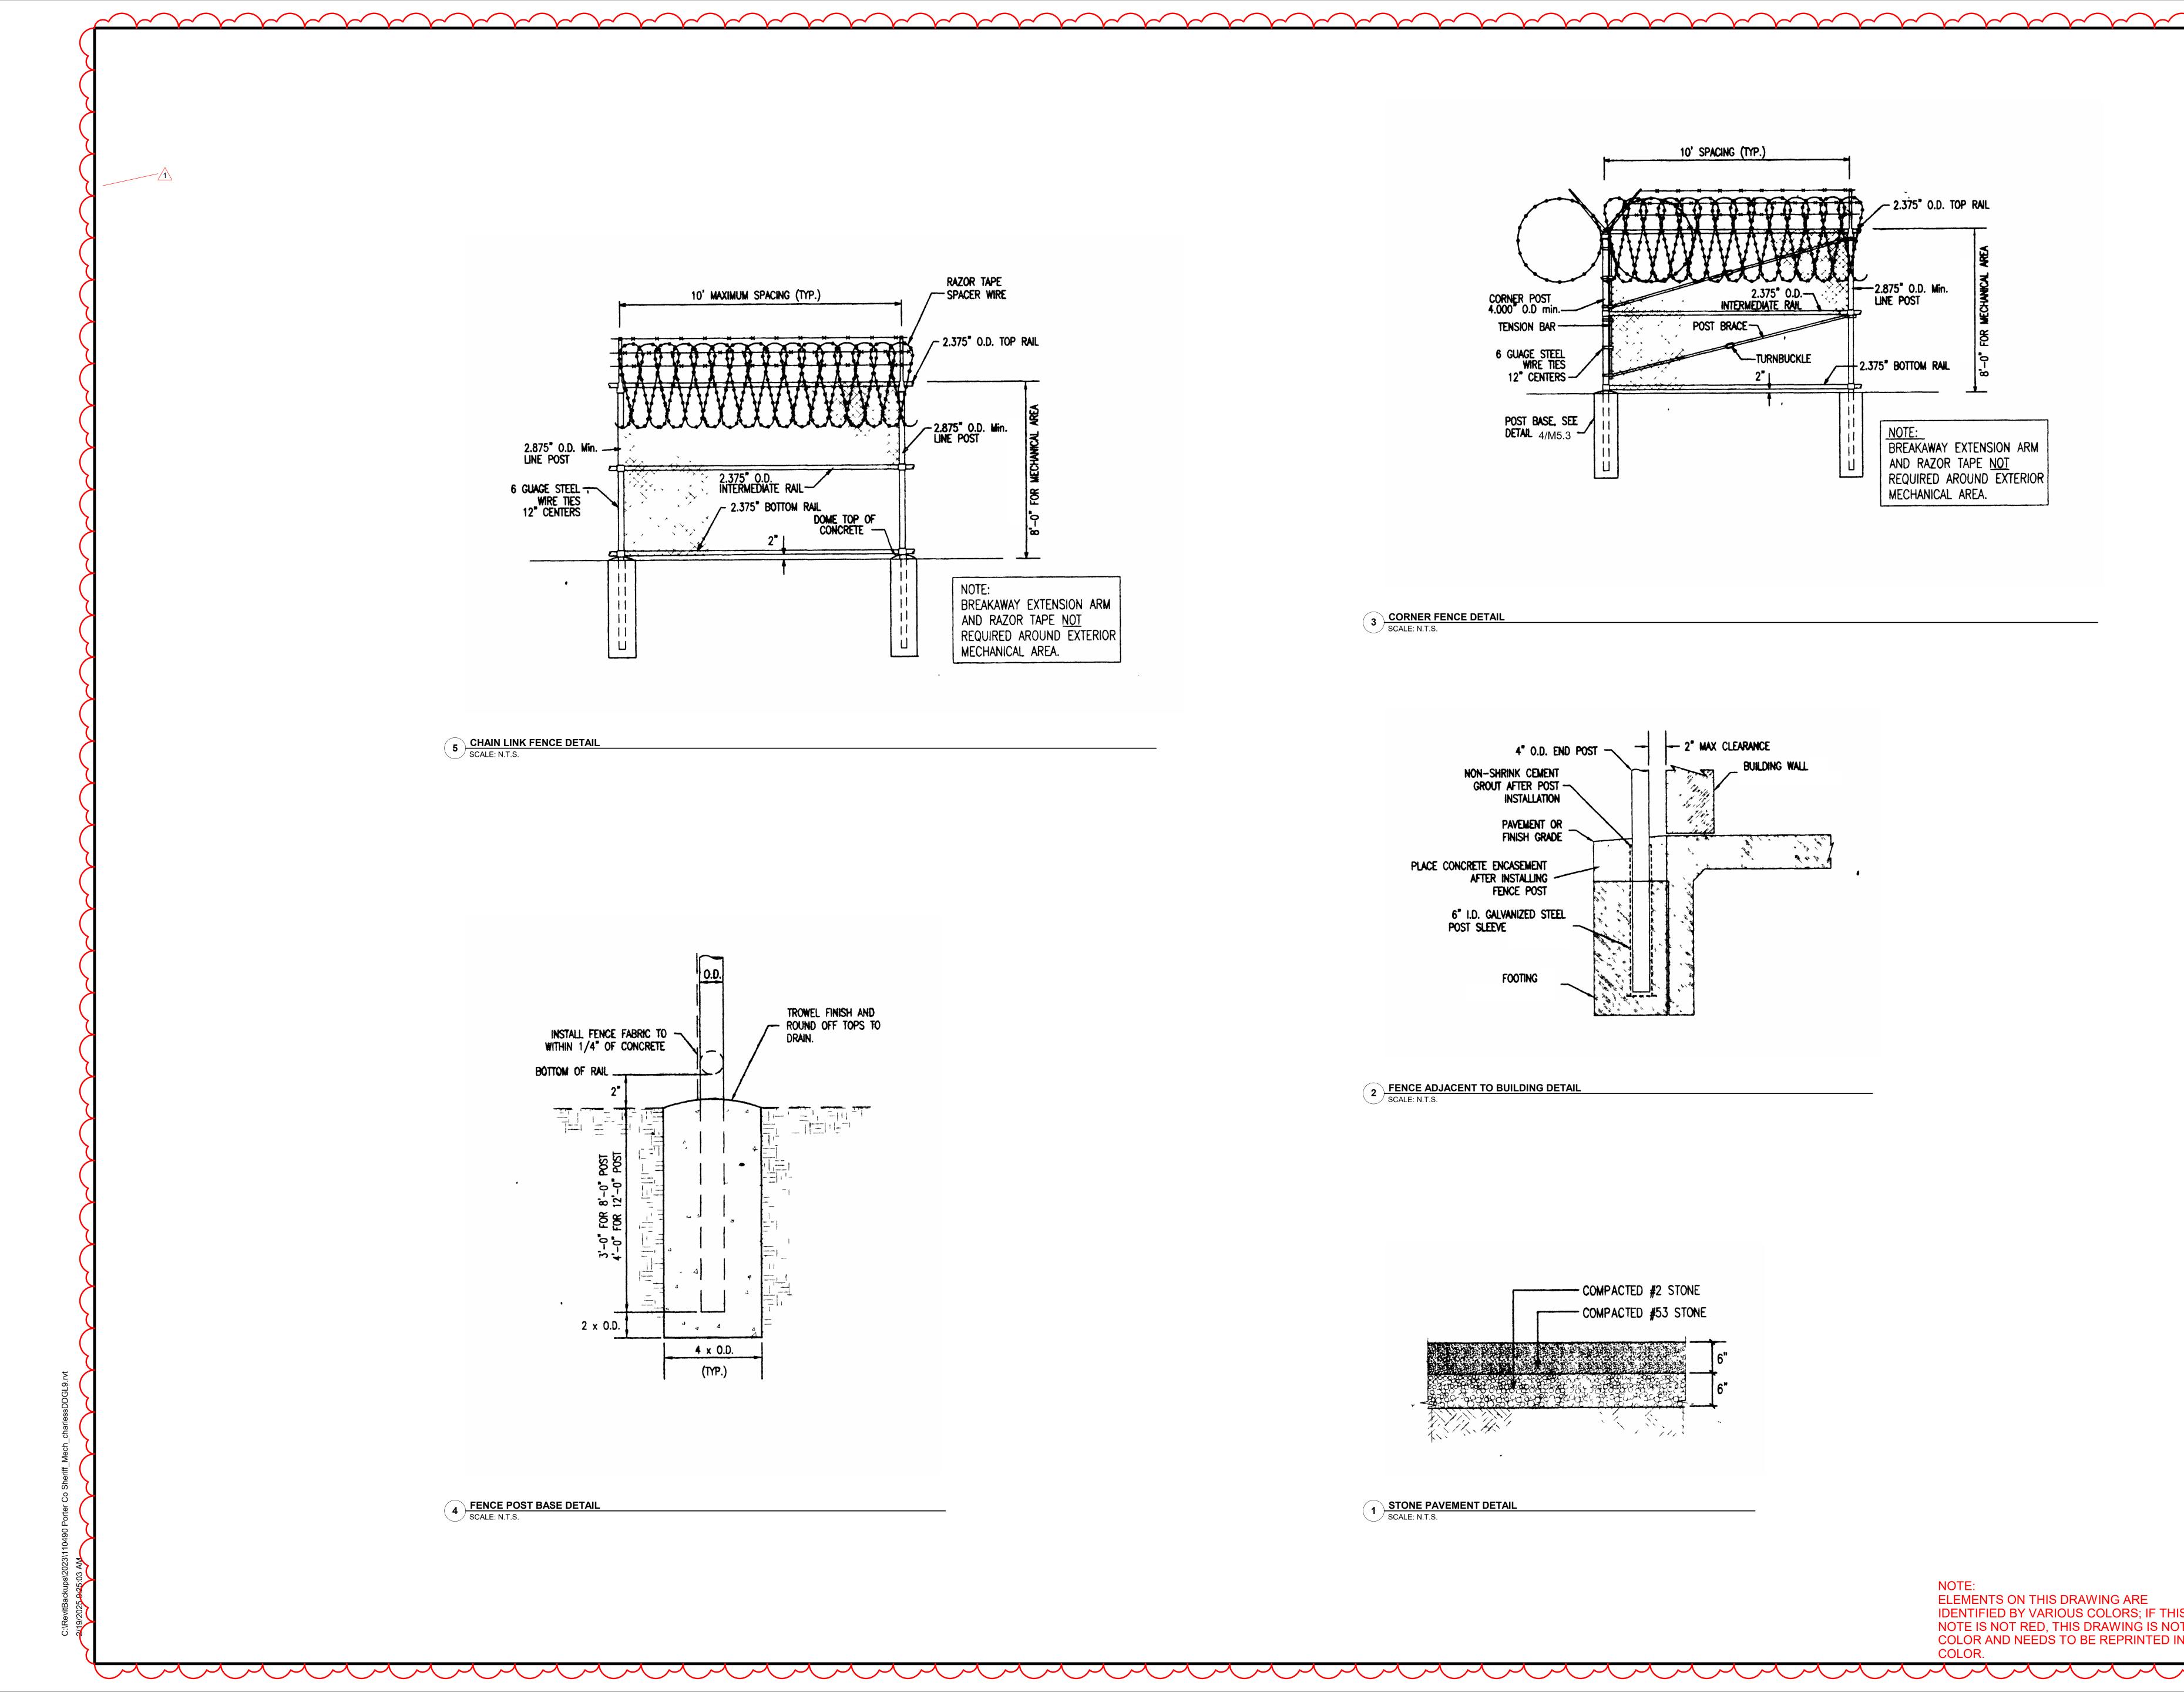


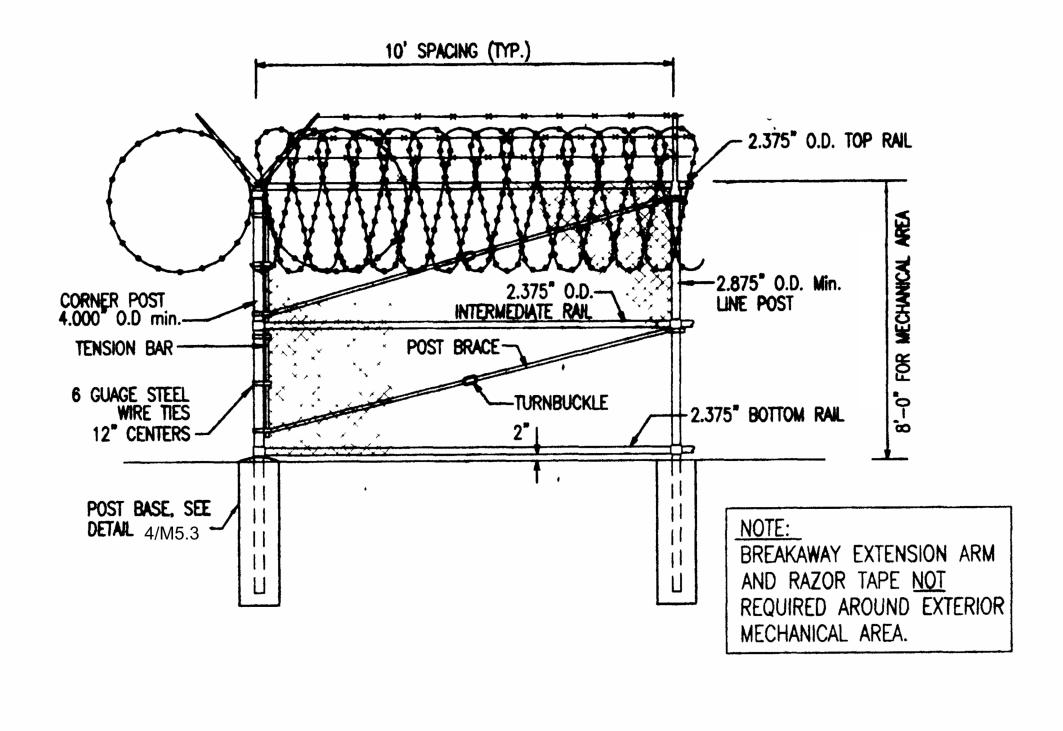

3 CORNER FENCE DETAIL SCALE: N.T.S.

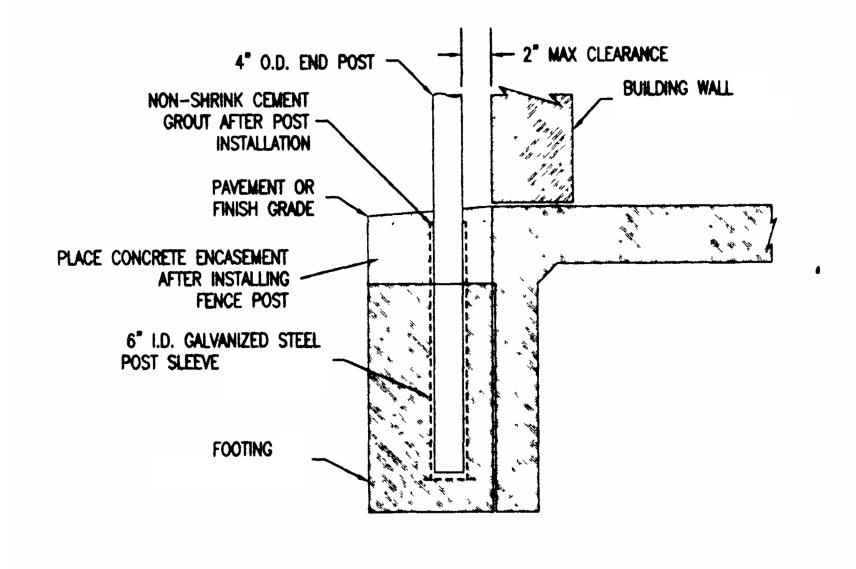


2 FENCE ADJACENT TO BUILDING DETAIL SCALE: N.T.S.

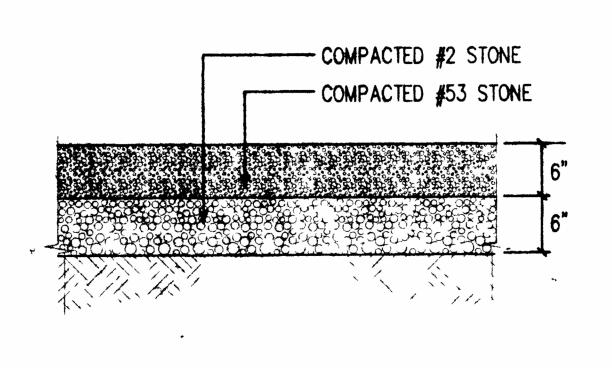

1 SCALE: N.T.S.



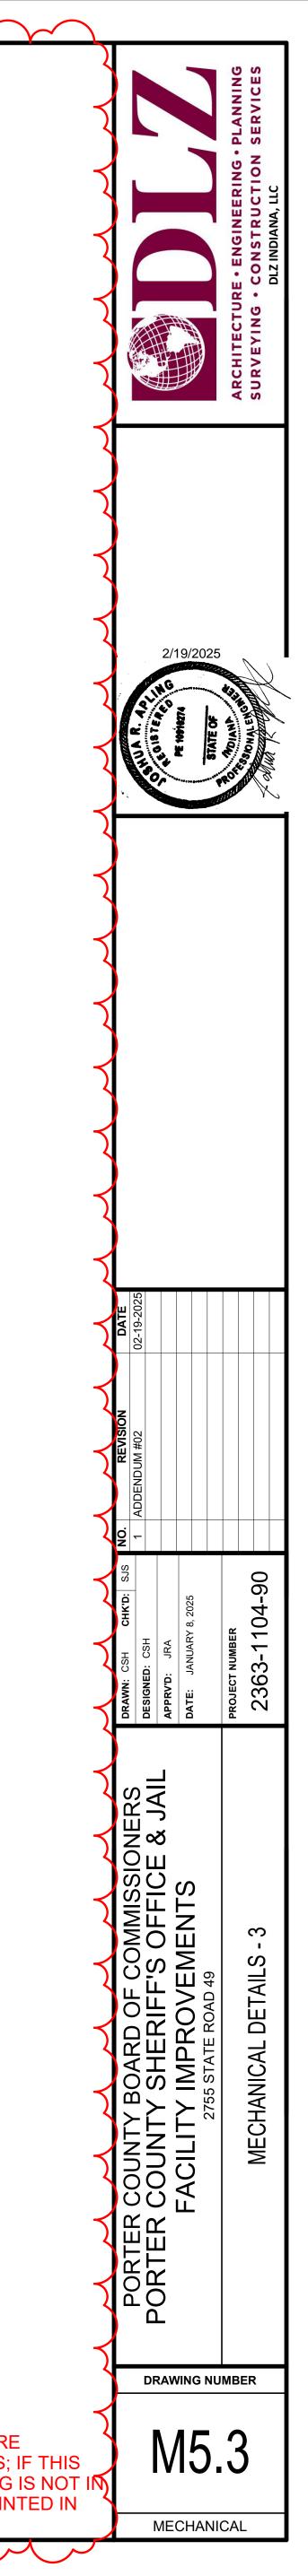

|  |              |                 |                 |       |       |                      |         |        |          |                   | AIF      | R COOLE | D CHILLEF           | R SCHEDULE  | Ξ                     |         |   |                   |                 |     |      |        |       |        |                 |               |
|--|--------------|-----------------|-----------------|-------|-------|----------------------|---------|--------|----------|-------------------|----------|---------|---------------------|-------------|-----------------------|---------|---|-------------------|-----------------|-----|------|--------|-------|--------|-----------------|---------------|
| TAG     WATER TEMPERATURE       FLOW RATE (GPM)     WATER PD (FT H2O)       WATER PD (FT H2O)     (°F)       NUMBER OF |              |                 |  | MANUFACTURER | MODEL           | NOMINAL<br>TONS | EER   | IPLV  | FLUID TYPE           | MINIMUM | DESIGN | TOTAL PD | EVAPORA<br>TOR PD | ENTERING | LEAVING | REFRIGERANT<br>TYPE | REFRIGERANT | NO. OF<br>COMPRESSORS | VOLTAGE |   | FREQUENCY<br>(HZ) | STARTER TYPE    | MCA | MOCP | LENGTH | WIDTH | HEIGHT | WEIGHT<br>(LBS) | NOTES         |
| 1  | YORK         | YLAA0136SJ46XFB | 122.6           | 9.815 | 17.68 | 30% PROPYLENE GLYCOL | 115     | 305.1  | 23.3     | 15.1              | 55       | 45      | R454B               | 2           | 6                     | 460     | 3 | 60                | ACROSS THE LINE | 290 | 300  | 187    | 88    | 94     | 7165            | 1,2,3,4,5,6,7 |
| 2  | YORK         | YLAA0136SJ46XFB | 122.6           | 9.815 | 17.68 | 30% PROPYLENE GLYCOL | 115     | 305.1  | 23.3     | 15.1              | 55       | 45      | R454B               | 2           | 6                     | 460     | 3 | 60                | ACROSS THE LINE | 290 | 300  | 187    | 88    | 94     | 7165            | 1,2,3,4,5,6,  |
| 3  | YORK         | YLAA0136SJ46XFB | 122.6           | 9.815 | 17.68 | 30% PROPYLENE GLYCOL | 115     | 305.1  | 23.3     | 15.1              | 55       | 45      | R454B               | 2           | 6                     | 460     | 3 | 60                | ACROSS THE LINE | 290 | 300  | 187    | 88    | 94     | 7165            | 1,2,3,4,5,6,7 |

NOTES: 1. PROVIDE STARTER/DISCONNECT PER DIVISION 26 SPECIFICATIONS AND MECHANICAL EQUIPMENT - ELECTRICAL CONNECTIONS SCHEDULE ON ELECTRICAL DRAWINGS. PROVIDE DISCONNECT IN NEMA 3R RATED ENCLOSURE AS PER DIVISION 26 SPECIFICATIONS.

 INIT SHALL BE RATED FOR 30% PROPYLENE GLYCOL.
 UNIT SHALL BE RATED FOR 30% PROPYLENE GLYCOL.
 PROVIDE ACCESSORIES AS NEEDED FOR LOW AMBIENT OPERATION. UNITS SHALL BE PROVIDED WITH HIGH EFFICIENCY FANS TO ALLOW FOR UNITS TO OPERATE VIA SOUND REDUCTION MODE. PROVIDE FACTORY INSTALLED ACOUSTICAL BLANKETS ON EACH COMPRESSOR FOR SOUND REDUCTION.
 UNIT SHALL HAVE A SINGLE POWER POINT ELECTRICAL CONNECTION. PROVIDE 10A, 115 V GFCI OUTLET IN CONTROL PANEL FOR SERVICING THE UNIT. OUTLET SHALL BE POWERED VIA SINGLE POWER POINT CONNECTION.
 UNIT SHALL HAVE A SINGLE POWER NO INSULATION FOR TOR COLL EVAPORATOR HEATER CIRCUIT SHALL BE FACTORY WIRED TO 115 V CIRCUIT IN CONTROL BOX.
 PROVIDE EVAPORATOR FOR SUM TO THE VALUE AND AND AND A SINGLE POWERED TO 115 V CIRCUIT IN CONTROL BOX. . PROVIDE FACTORY INSTALLED WATER FLOW SWITCH TO PREVENT EVAPORATOR FREEZEUP DURING LOW OR NO FLOW CONDITIONS. 8. UNIT SHALL BE PROVIDED WITH LOUVERS TO PROTECT AGAINST HAIL GUARD.

9. REFER TO DETAIL 1/M5.2 AND 16/M5.1 FOR ADDITIONAL INFORMATION. 10. REFER TO M7.3 FOR CONTROLS.

|          | FAN POWERED VAV SCHEDULE |       |      |          |          |            |         |            |       |          |                   |       |                |         |       |         |       |         |
|----------|--------------------------|-------|------|----------|----------|------------|---------|------------|-------|----------|-------------------|-------|----------------|---------|-------|---------|-------|---------|
| TAG      |                          |       |      | INLET    | All      | R FLOW (CF | M)      |            | COIL  | MAX COIL | WATER<br>PRESSURE | WATER | WA1<br>TEMPERA |         |       | FAN     |       |         |
|          |                          |       |      | DIAMETER |          | MAX        | MIN     | DOWNSTREAM |       | APD (IN  | DROP (FT          | FLOW  |                |         |       |         |       |         |
|          | MANUFACTURER             | MODEL | SIZE | (IN)     | FAN FLOW | PRIMARY    | PRIMARY | SP (IN WG) | (MBH) | WG)      | WG)               | (GPM) | ENTERING       | LEAVING | HP    | VOLTAGE | PHASE | NOTES   |
| FPV 4-2  | PRICE                    | FDC   | 30   | 8        | 1100     | 1100       | 90      | 0.5        | 41.6  | 0.32     | 1.54              | 2.26  | 180            | 150     | 1/2   | 277     | 1     | 1,2,3,4 |
| FPV 4-5  | PRICE                    | FDC   | 20   | 8        | 690      | 690        | 60      | 0.55       | 26.1  | 0.14     | 0.41              | 1.07  | 180            | 150     | 1/3   | 277     | 1     | 1,2,3,4 |
| FPV 4-7  | PRICE                    | FDC   | 10   | 8        | 590      | 590        | 270     | 0.5        | 22.3  | 0.34     | 0.27              | 1.09  | 180            | 150     | 1/3   | 277     | 1     | 1,2,3,4 |
| FPV 6-5  | PRICE                    | FDC   | 60   | 14       | 2180     | 2180       | 1080    | 0.6        | 45.6  | 0.24     | 0.27              | 1.11  | 180            | 150     | 2@3/4 | 277     | 1     | 1,2,3,4 |
| FPV 8-19 | PRICE                    | FDC   | 50   | 12       | 1625     | 1625       | 150     | 0.7        | 61.4  | 0.33     | 1.27              | 3.17  | 180            | 150     | 1     | 277     | 1     | 1,2,3,4 |
| FPV 8-25 |                          | FDC   | 10   | 4        | 160      | 160        | 15      | 0.5        | 6     | 0.04     | 0.01              | 0.2   | 180            | 150     | 1/3   | 277     | 1     | 1,2,3,4 |
| FPV 8-28 | PRICE                    | FDC   | 10   | 5        | 370      | 370        | 180     | 0.5        | 14    | 0.15     | 0.07              | 0.51  | 180            | 150     | 1/3   | 277     | 1     | 1,2,3,4 |

NOTES: 1. PROVIDE STARTER/DISCONNECT PER DIVISION 26 SPECIFICATIONS AND MECHANICAL EQUIPMENT - ELECTRICAL CONNECTIONS SCHEDULE ON ELECTRICAL DRAWINGS. 2. REFER TO DETAIL 11/M5.1. 3. REFER TO 2/M7.1 FOR CONTROLS. 4. PROVIDE 2-WAY VALVE FOR HEATING COIL.

|    | DUCTLESS SPLIT INDOOR UNIT SCHEDULE |              |            |         |          |          |         |       |     |      |        |         |  |  |
|----|-------------------------------------|--------------|------------|---------|----------|----------|---------|-------|-----|------|--------|---------|--|--|
| TA | TAG RATED RATED ELECTRICAL DATA     |              |            |         |          |          |         |       |     |      |        |         |  |  |
|    |                                     |              |            |         | COOLING  | HEATING  |         |       |     |      | _      |         |  |  |
|    |                                     |              |            | AIRFLOW | CAPACITY | CAPACITY |         |       |     |      | WEIGHT |         |  |  |
|    |                                     | MANUFACTURER | MODEL      | (CFM)   | (MBH)    | (MBH)    | VOLTAGE | PHASE | MCA | MOCP | (LBS)  | NOTES   |  |  |
| DS | 1                                   | TRANE        | PLA-AE12NL | 530     | 12       | 10.1     | 208     | 1     | 1.0 | 15   | 225    | 1,2,3,4 |  |  |
| DS | 2                                   | TRANE        | PLA-AE12NL | 530     | 12       | 10.1     | 208     | 1     | 1.0 | 15   | 225    | 1,2,3,4 |  |  |
| DS | 3                                   | TRANE        | PLA-AE12NL | 530     | 12       | 10.1     | 208     | 1     | 1.0 | 15   | 225    | 1,2,3,4 |  |  |
| DS | 4                                   | TRANE        | PLA-AE24NL | 810     | 24       | 13       | 208     | 1     | 1.0 | 25   | 225    | 1,2,3,4 |  |  |

<u>NOTES:</u> 1. REFER TO DETAIL 8/M5.1.

2. PROVIDE CONDENSATE PUMP WITH BUILT-IN CHECK VALVE. 3. INDOOR UNIT IS POWERED BY OUTDOOR UNIT. 4. UNIT IS INTENDED TO BACK-UP FOR EXISTING SYSTEM. REFER TO M7.7 AND M7.8 FOR CONTROLS. PROVIDE CONTROLS FOR UNITS TO TURN ON WHEN PRIMARY VAV SYSTEM TURNS OFF.

|      |      |           |           |      |                            |                               |                           |                      |               |        |          |          | DU                | CT MOU            | NTED CO          | <b>JIL SCHI</b>            | EDULE                     |                      |               |         |          |          |      |                |                  |       |        |        |                 |                |       |
|------|------|-----------|-----------|------|----------------------------|-------------------------------|---------------------------|----------------------|---------------|--------|----------|----------|-------------------|-------------------|------------------|----------------------------|---------------------------|----------------------|---------------|---------|----------|----------|------|----------------|------------------|-------|--------|--------|-----------------|----------------|-------|
| TAG  |      |           |           |      |                            |                               |                           |                      | COOLING       | G COIL |          |          |                   |                   |                  |                            |                           |                      |               | HEATING | G COIL   |          |      |                |                  |       |        |        |                 |                |       |
|      | MANU | UFACTURER | MODEL     | CFM  | TOTAL<br>CAPACITY<br>(MBH) | SENSIBLE<br>CAPACITY<br>(MBH) | MAX AIR<br>PD (IN<br>H20) | WATER PD<br>(IN H20) | FLOW<br>(GPM) | ROWS   | EWT (°F) | LWT (°F) | EAT<br>DB/WB (°F) | LAT<br>DB/WB (°F) | CONTROL<br>VALVE | TOTAL<br>CAPACITY<br>(MBH) | MAX AIR<br>PD (IN<br>H20) | WATER PD<br>(IN H20) | FLOW<br>(GPM) | ROWS    | EWT (°F) | LWT (°F) |      | LAT DB<br>(°F) | CONTROL<br>VALVE | WIDTH | LENGTH | HEIGHT | WEIGHT<br>(LBS) | AREA<br>SERVED | NOTES |
| DC 1 | -1   | YORK      | XTI-33X39 | 1985 | 46                         | 45                            | 0.65                      | 6.4                  | 12.0          | 8      | 45       | 55       | 75/60.4           | 53.3/52.0         | 2-WAY            | 102                        | 0.11                      | 0.4                  | 7.0           | 2       | 180      | 150      | 55.0 | 102.6          | 2-WAY            | 48    | 33     | 39     | 706             | BLOCK A7       | 1,2   |
| DC 1 | -2   | YORK      | XTI-33X39 | 2065 | 46                         | 46                            | 0.68                      | 6.4                  | 12.0          | 8      | 45       | 55       | 75/60.4           | 53.6/52.1         | 2-WAY            | 104                        | 104                       | 0.4                  | 7.0           | 2       | 180      | 150      | 55.0 | 101.7          | 2-WAY            | 48    | 33     | 39     | 706             | BLOCK A8       | 1,2   |
| DC 1 | -3   | YORK      | XTI-33X39 | 1775 | 37                         | 37                            | 0.34                      | 4.7                  | 10.0          | 8      | 45       | 55       | 75/60.4           | 55.0/52.8         | 2-WAY            | 93                         | 0.09                      | 0.3                  | 6.0           | 2       | 180      | 150      | 55.0 | 103.5          | 2-WAY            | 48    | 33     | 39     | 680             | BLOCK A6       | 1,2   |
| DC 1 | -4   | YORK      | XTI-33X39 | 1720 | 31                         | 31                            | 0.24                      | 3.0                  | 9.0           | 6      | 45       | 55       | 75/60.4           | 57.6/53.8         | 2-WAY            | 92                         | 0.09                      | 0.3                  | 6.0           | 2       | 180      | 150      | 55.0 | 104.4          | 2-WAY            | 46    | 33     | 39     | 615             | BLOCK A5       | 1,2   |
| DC 1 | -5   | YORK      | XTI-33X39 | 1755 | 37                         | 37                            | 0.33                      | 4.7                  | 10.0          | 8      | 45       | 55       | 75.0/60.4         | 54.9/52.7         | 2-WAY            | 93                         | 0.09                      | 0.3                  | 6.0           | 2       | 180      | 150      | 55.0 | 103.8          | 2-WAY            | 48    | 33     | 39     | 680             | BLOCK A1       | 1,2   |
| DC 1 |      | YORK      | XTI-33X36 | 1580 | 33                         | 33                            | 0.32                      | 3.8                  | 9.0           | 8      | 45       | 55       | 75.0/60.4         | 55.0/52.7         | 2-WAY            | 77                         | 0.12                      | 0.1                  | 5.0           | 2       | 180      | 150      | 55.0 | 100.3          | 2-WAY            | 48    | 33     | 36     | 644             | BLOCK A2       | 1,2   |
|      | -7   | YORK      | XTI-36X39 | 2465 | 52                         | 52                            | 0.4                       | 3.8                  | 16.0          | 8      | 45       | 55       | 75.0/60.4         | 55.0/52.7         | 3-WAY            | 120                        | 0.12                      | 0.2                  | 8.0           | 2       | 180      | 150      | 55.0 | 100.1          | 3-WAY            | 48    | 36     | 39     | 747             | BLOCK A4       | 1,2   |
|      | -8   | YORK      | XTI-36X42 | 2800 | 58                         | 58                            | 0.41                      | 4.4                  | 17.0          | 8      | 45       | 55       | 75.0/60.4         | 55.2/52.8         | 3-WAY            | 137                        | 0.12                      | 0.3                  | 9.0           | 2       | 180      | 150      | 55.0 | 100.3          | 3-WAY            | 48    | 36     | 42     | 785             | BLOCK A3       | 1,2   |
| DC 2 |      | YORK      | XTI-33X39 | 2075 | 41                         | 39                            | 0.45                      | 4.9                  | 12.0          | 6      | 45       | 55       | 75.0/62.7         | 57.4/55.9         | 2-WAY            | 103                        | 0.13                      | 0.2                  | 7.0           | 2       | 180      | 150      | 55.0 | 100.8          | 2-WAY            | 46    | 33     | 39     | 627             | BLOCK B2       | 1,2   |
| DC 2 |      | YORK      | XTI-33X39 | 2055 | 42                         | 39                            | 0.5                       | 4.9                  | 12.0          | 6      | 45       | 55       | 75.0/62.7         | 57.0/55.6         | 2-WAY            | 102                        | 0.13                      | 0.2                  | 7.0           | 2       | 180      | 150      | 55.0 | 101.1          | 2-WAY            | 46    | 33     | 39     | 630             | BLOCK B1       | 1,2   |
|      | -3   | YORK      | XTI-33X39 | 1725 | 36                         | 33                            | 0.34                      | 3.6                  | 10.0          | 6      | 45       | 55       | 75.0/62.7         | 56.8/55.6         | 2-WAY            | 85                         | 0.09                      | 0.1                  | 6.0           | 2       | 180      | 150      | 55.0 | 100.4          | 2-WAY            | 46    | 33     | 39     | 626             | BLOCK B3       | 1,2   |
| DC 2 |      | YORK      | XTI-33X36 | 1535 | 31                         | 29                            | 0.34                      | 2.9                  | 9.0           | 6      | 45       | 55       | 75.0/62.7         | 56.9/55.7         | 3-WAY            | 75                         | 0.11                      | 0.1                  | 5.0           | 2       | 180      | 150      | 55.0 | 100.0          | 3-WAY            | 46    | 33     | 36     | 593             | BLOCK B4       | 1,2   |
|      | -5   | YORK      | XTI-33X39 | 1725 | 36                         | 33                            | 0.34                      | 3.6                  | 10.0          | 6      | 45       | 55       | 75.0/62.7         | 56.8/55.6         | 2-WAY            | 85                         | 0.09                      | 0.1                  | 6.0           | 2       | 180      | 150      | 55.0 | 100.4          | 2-WAY            | 46    | 33     | 39     | 626             | BLOCK B8       | 1,2   |
| DC 2 |      | YORK      | XTI-33X36 | 1545 | 31                         | 29                            | 0.34                      | 2.9                  | 9.0           | 6      | 45       | 55       | 75.0/62.7         | 57.0/55.7         | 3-WAY            | 75                         | 0.11                      | 0.1                  | 5.0           | 2       | 180      | 150      | 55.0 | 99.8           | 2-WAY            | 46    | 33     | 36     | 593             | BLOCK B7       | 1,2   |
| DC 3 |      | YORK      | XTI-33X39 | 2085 | 42                         | 40                            | 0.49                      | 4.9                  | 12.0          | 6      | 45       | 55       | 75.0/62.3         | 56.8/55.3         | 2-WAY            | 103                        | 0.13                      | 0.2                  | 7.0           | 2       | 180      | 150      | 55.0 | 100.7          | 2-WAY            | 46    | 33     | 39     | 630             | BLOCK C3       | 1,2   |
| DC 3 |      | YORK      | XTI-33X39 | 1985 | 40                         | 38                            | 0.41                      | 4.9                  | 12.0          | 6      | 45       | 55       | 75.0/62.3         | 56.8/55.2         | 2-WAY            | 101                        | 0.12                      | 0.2                  | 7.0           | 2       | 180      | 150      | 55.0 | 102.0          | 2-WAY            | 46    | 33     | 39     | 627             | BLOCK C4       | 1,2   |
| DC 3 |      | YORK      | XTI-33X39 | 1800 | 36                         | 34                            | 0.35                      | 3.6                  | 10.0          | 6      | 45       | 55       | 75.0/62.3         | 56.9/55.3         | 2-WAY            | 90                         | 0.1                       | 0.1                  | 6.0           | 2       | 180      | 150      | 55.0 | 101.1          | 2-WAY            | 46    | 33     | 39     | 627             | BLOCK C5       | 1,2   |
| DC 3 |      | YORK      | XTI-30X36 | 1590 | 34                         | 32                            | 0.6                       | 4.9                  | 11.0          | 6      | 45       | 55       | 75.0/62.3         | 56.0/54.8         | 2-WAY            | /8                         | 0.11                      | 0.3                  | 5.0           | 2       | 180      | 150      | 55.0 | 100.3          | 2-WAY            | 46    | 30     | 36     | 565             | BLOCK C6       | 1,2   |
| DC 3 |      | YORK      | XTI-33X36 | 1480 | 52                         | 30                            | 0.41                      | 2.9                  | 9.0           | 6      | 45       | 55       | 75.0/62.3         | 55.7/54.7         | 2-WAY            | 71                         | 0.09                      | 0.1                  | 5.0           | 2       | 180      | 150      | 55.0 | 99.6           | 2-WAY            | 46    | 33     | 36     | 606             | BLOCK C2       | 1,2   |
|      | -6   | YORK      | XTI-27X30 | 960  | 26                         | 22                            | 0.52                      | 4.1                  | 10.0          | 6      | 45       | 55       | 75.0/62.3         | 53.4/52.5         | 2-WAY            | 48                         | 0.16                      | 0.1                  | 3.5           | 2       | 180      | 150      | 55.0 | 101.2          | 2-WAY            | 46    | 27     | 30     | 476             | BLOCK C1       | 1,2   |
| DC 3 |      | YORK      | XTI-39X42 | 2850 | 68                         | 60                            | 0.56                      | 6.0                  | 17.0          | 6      | 45       | 55       | 75.0/62.3         | 55.2/53.9         | 2-WAY            | 141                        | 0.18                      | 0.3                  | 10.0          | 2       | 180      | 150      | 55.0 | 100.8          | 3-WAY            | 46    | 39     | 42     | /6/             | BLOCK C7       | 1,2   |
| DC 3 | -8   | YORK      | XTI-42X42 | 3120 | /5                         | 66                            | 0.53                      | 5.8                  | 18.0          | 6      | 45       | 55       | 75.0/62.3         | 55.1/53.8         | 3-WAY            | 158                        | 0.17                      | 0.6                  | 10.0          | 2       | 180      | 150      | 55.0 | 101.9          | 3-WAY            | 46    | 42     | 42     | 813             | BLOCK C8       | 1,2   |

<u>NOTES:</u> 1. REFER TO 5/M7.2 FOR CONTROLS. 2. COOLING COILS RATED FOR 30% PROPYLENE GLYCOL.

|    | EXPANSION TANK SCHEDULE |                |       |        |                          |                         |                       |                      |                         |                        |                  |           |       |
|----|-------------------------|----------------|-------|--------|--------------------------|-------------------------|-----------------------|----------------------|-------------------------|------------------------|------------------|-----------|-------|
| TA | ٩G                      | _              |       | SYSTEM | TANK FILL<br>TEMPERATURE | TANK MAX<br>TEMPERATURE | TANK FILL<br>PRESSURE | TANK MAX<br>PRESSURE | REQUIRED<br>TANK VOLUME | REQUIRED<br>ACCEPTANCE |                  | TANK      |       |
|    |                         | MANUFACTURER   | MODEL | SERVED | (°F)                     | (°F)                    | (PSI)                 | (PSI)                | (GAL)                   | VOLUME (GAL)           | TANK ORIENTATION | TYPE      | NOTES |
| ET | 1                       | BELL & GOSSETT | D280  | CW     | 40                       | 100                     | 60                    | 80                   | 190                     | 40                     | VERTICAL         | DIAPHRAGM | 1,2,3 |

<u>NOTES</u>: 1. TANK TO BE ASME RATED. 2. EQUIPMENT SHALL BE RATED FOR 30% PROPYLENE GLYCOL. 3. REFER TO DETAIL 1/M5.2 FOR ADDITIONAL INFORMATION

| TA     | ٩G |              |              |                            | DRIVE  | AIRFLOW | EXTERNAL SP | MOTOR       | MOTOR | ELEC      | TRICAL DA | ΛTA | WEIGHT |     |
|--------|----|--------------|--------------|----------------------------|--------|---------|-------------|-------------|-------|-----------|-----------|-----|--------|-----|
|        |    | MANUFACTURER | MODEL        | ROOM SERVED                | TYPE   | (CFM)   | (IN WG)     | (RPM)       | (HP)  | VOLTAGE   | PHASE     | FLA | (LBS)  | NC  |
| EF     | 1  | GREENHECK    | G-090-VG     | KITCHEN TOILETS            | DIRECT | 585     | 0.46        | 1680        | 1/10  | 115       | 1         | 1.5 | 41     | 1,  |
| EF     | 2  | GREENHECK    | GB-160       | BOOKING CELLS              | BELT   | 1535    | 0.45        | 828         | 1/3   | 115       | 1         | 7.2 | 90     | 1,  |
| EF     | 3  | GREENHECK    | G-095-VG     | AMMO                       | DIRECT | 685     | 0.52        | 1640        | 1/6   | 115       | 1         | 2.8 | 43     | 1,  |
| EF     | 4  | GREENHECK    | G-090-VG     | LOBBY TOILETS              | DIRECT | 460     | 0.41        | 1459        | 1/10  | 115       | 1         | 1.5 | 41     | 1,2 |
| EF     | 5  | GREENHECK    | G-120-VG     | BOOKING BULLPENS           | DIRECT | 1015    | 0.44        | 1127        | 1/4   | 115       | 1         | 3.8 | 67     | 1,2 |
| EF     | 6  | GREENHECK    | GB-160       | SALLYPORT                  | BELT   | 2000    | 0.34        | 868         | 1/3   | 115       | 1         | 7.2 | 90     | 1,2 |
| EF     | 7  | GREENHECK    | GB-160       | SALLYPORT                  | BELT   | 2000    | 0.34        | 969         | 1/3   | 115       | 1         | 7.2 | 90     | 1,2 |
| EF     | 8  | GREENHECK    | G-095-VG     | EXERCISE TOILETS           | DIRECT | 660     | 0.5         | 1600        | 1/6   | 115       | 1         | 2.8 | 43     | 1,2 |
| EF     | 9  | GREENHECK    | GB-200       | KITCHEN CART WASH          | BELT   | 2625    | 0.41        | 680         | 1/2   | 115       | 1         | 9.8 | 120    | 1,2 |
| EF     | 10 | GREENHECK    | G-095-VG     | DISPATCH TOILETS           | DIRECT | 575     | 0.45        | 1474        | 1/6   | 115       | 1         | 2.8 | 43     | 1,2 |
| EF     | 11 | GREENHECK    | G-095-VG     | ADMIN TOILETS              | DIRECT | 475     | 0.41        | 1347        | 1/6   | 115       | 1         | 2.8 | 43     | 1,2 |
| EF     | 12 | GREENHECK    | GB-160       | REC                        | BELT   | 2000    | 0.34        | 868         | 1/3   | 115       | 1         | 7.2 | 90     | 1,2 |
| EF     | 13 | GREENHECK    | GB-160       | REC                        | BELT   | 2000    | 0.34        | 868         | 1/3   | 115       | 1         | 7.2 | 90     | 1,2 |
| EF     | 14 | GREENHECK    | GB-160       | REC                        | BELT   | 2000    | 0.34        | 868         | 1/3   | 115       | 1         | 7.2 | 90     | 1,2 |
| EF     | 15 | GREENHECK    | GB-160       | REC                        | BELT   | 2000    | 0.34        | 868         | 1/3   | 115       | 1         | 7.2 | 90     | 1,2 |
| EF     | 16 | GREENHECK    | G-095-VG     | LAUNDRY TOILETS            | DIRECT | 700     | 0.53        | 1664        | 1/6   | 115       | 1         | 2.8 | 43     | 1,2 |
| EF     | 17 | GREENHECK    | GB-130       | ISOLATION CELLS            | BELT   | 1335    | 0.53        | 1225        | 1/4   | 115       | 1         | 5.8 | 70     | 1,2 |
| EF     | 18 | GREENHECK    | G-140-B      | EVIDENCE                   | DIRECT | 1400    | 0.62        | 1140        | 1/3   | 115       | 1         | 7.2 | 83     | 1,2 |
| EF     | 19 | GREENHECK    | G-140-B      | SMALL EVIDENCE             | DIRECT | 1400    | 0.62        | 1140        | 1/3   | 115       | 1         | 7.2 | 83     | 1,2 |
| EF     | 20 | GREENHECK    | GB-160       | MECHANICAL                 | BELT   | 1980    | 0.58        | 988         | 1/2   | 115       | 1         | 9.8 | 87     | 1,2 |
| EF     | 21 | GREENHECK    | G-080-VG     | RADIO/TRANS                | DIRECT | 200     | 0.31        | 1262        | 1/10  | 115       | 1         | 1.5 | 40     | 1,2 |
| - F-F- | 22 |              | G-095-VG     | MANUTOFFICE                | DIRECT | 309     | Q48         | 1326<br>911 | 1/6   | math from |           | 2.8 | 43     | 1.  |
| EF     | 23 | GREENHECK    | G-160-VG     | LONG TERM EVIDENCE STORAGE |        | 1600    | 0.59        |             | 1     | 480       | . 3       | 3.2 | 90     | 1,2 |
| EF     | 24 | CAPTIVEARE   | DU180HFA     | KITCHENHOOD                | DIRECT | 2708    |             | 1268        | min   | 480       | uzu       | 3.9 | 215    |     |
| EF     | 25 | CAPTIVEAIRE  | DU180HFA     | KITCHEN HOOD               | DIRECT | 2708    | 1.5         | 1268        | 2     | 480       | 3         | 3.3 | 215    | 4,5 |
| EF     | 26 | CAPTIVEAIRE  | DU180HFA     | KITCHEN HOOD               | DIRECT | 2708    | 1.5         | 1268        | 2     | 480       | 3         | 3.3 | 215    | 4,5 |
| EF     | 27 | GREENHECK    | CUBE-200-VGD | DISHWASHER EXHAUST         | DIRECT | 750     | 0.5         | 1032        | 0.25  | 115       | 1         | 3.8 | 71     | 1,2 |

2. REFER TO DETAIL 9/M5.1 FOR ADDITIONAL INFORMATION. 3. REFER TO CONTROLS ON DRAWING M7.1. REUSE EXISTING ROOF CURB.
 PROVIDE GREASE CUP WITH DRAIN.

PROVIDE VFD/DISCONNECT AS PER DIVISION 26 SPECIFCATIONS AND MECHANICAL EQUIPMENT - ELECTRICAL CONNECTIONS SCHEDULE.
 UNIT SHALL BE PROVIDED WITH MANUFACTURER CONTROLS VIA A PROGRAMMABLE CONTROLLER. UNIT AND CONTROLS SHALL BE BACNET COMPATIBLE.

|                                   |  |  |  |  | AIR CO          | OLED CO               | NDEN      | ISING UN    | IT SCHE     | DULE         |                   |      |      |            |
|-----------------------------------|--|--|--|--|-----------------|-----------------------|-----------|-------------|-------------|--------------|-------------------|------|------|------------|
| TA                                | G  |  |  |  |                 | DESIGN                |           |             |             | E            | ELECTRICAL DAT    | A    |      |            |
|                                   |  | MANUFACTURER   | MODEL  | EQUIPMENT<br>SERVED                          | NOMINAL<br>TONS | AMBIENT<br>TEMP. (°F) | SEER      | REF. TYPE   | VOLTAGE     | PHASE        | FREQUENCY<br>(HZ) | MCA  | MOCP | WEI<br>(LE |
| ACC                               | 1  | TRANE  | PUZ-AK12NL   | DS-1   | 1               | 95                    | 27.0      | R-454B      | 208         | 1            | 60                | 11.0 | 28   | 10         |
| ACC                               | 2  | TRANE  | PUZ-AK12NL   | DS-2   | 1               | 95                    | 27.0      | R-454B      | 208         | 1            | 60                | 11.0 | 28   | 10         |
| ACC                               | 3  | TRANE  | PUZ-AK12NL   | DS-3   | 1               | 95                    | 27.0      | R-454B      | 208         | 1            | 60                | 11.0 | 28   | 10         |
| ACC                               | 4  | TRANE  | PUZ-AK24NL   | DS-4   | 2               | 95                    | 24.2      | R-454B      | 208         | 1            | 60                | 19.0 | 26   | 17         |
| ACC                               | 9  | YORK   | KC120C00A4GLB1   | AHU-9  | 10              | 95                    | 15.5      | R-454B      | 460         | 3            | 60                | 20.5 | 30   | 43         |
| 2. PR<br>3. SIZ<br>4. RE<br>5. UN | Rovid<br>Rovid<br>Ze an<br>Fer<br>Nit Is | E STARTER/DISCONNECT<br>E CRANKCASE HEATER, H<br>D INSTALL REFRIGERANT<br>TO DETAIL 8/M5.1 FOR AD<br>INTENDED TO BACK-UP F<br>IATE BID ITEM. | IAIL GUARD, LOW-AMI<br>PIPING AS PER MANU<br>DITIONAL INFORMATIC | BIENT KIT, WINTER<br>IFACTURER'S RECO<br>DN. | START KIT AND   | WIND BAFFLE.<br>S.    | LECTRICAL | CONNECTIONS | SCHEDULE ON | ELECTRICAL E | DRAWINGS.         |      |      |            |

| ~ | SCH | HEDUL | E        |
|---|-----|-------|----------|
| • |     |       | a Barren |

|       |             |           | CFM    | PANEL     | NECK SIZE | 077/17           |              | =                 | PRESSURE |    |       |       |
|-------|-------------|-----------|--------|-----------|-----------|------------------|--------------|-------------------|----------|----|-------|-------|
| TAG M | ANUFACTURER | MODEL     | RANGE  | SIZE (IN) | (IN)      | STYLE            | INSTALLATION | FINISH            | (IN.)    | NC | THROW | NOTES |
| EA-1  | PRICE       | MSRRP     | 0-150  | 8x8       | -         | MAXIMUM SECURITY | CEILING      | BRUSHED ALUMINUM  | 0.124    | 25 | -     | 3     |
| EA-2  | PRICE       | 80 SERIES | 0-720  | 12X12     | -         | EGGCRATE         | DUCT         | WHITE POWDER COAT | 0.085    | 20 | -     | -     |
| EA-3  | PRICE       | 80 SERIES | 0-720  | 12X12     | -         | EGGCRATE         | CEILING      | BRUSHED ALUMINUM  | 0.085    | 20 | -     | -     |
| EA-4  | PRICE       | 80 SERIES | 0-2625 | 24X24     | -         | EGGCRATE         | CEILING      | BRUSHED ALUMINUM  | 0.085    | 20 | -     | -     |
| EA-5  | PRICE       | MSRRP     | 0-250  | 14X14     | -         | MAXIMUM SECURITY | CEILING      | BRUSHED ALUMINUM  | 0.124    | 25 | -     | 2,3   |
| EG-1  | PRICE       | 80 SERIES | 0-720  | 12X12     | -         | EGGCRATE         | CEILING      | BRUSHED ALUMINUM  | 0.085    | 20 | -     | 3     |
| RA-1  | PRICE       | 80 SERIES | 0-2500 | 24X24     | -         | EGGCRATE         | CEILING      | BRUSHED ALUMINUM  | 0.085    | 20 | -     | -     |
| SA-1  | PRICE       | RCD       | 0-550  | 12 Ø      | 8         | ROUND CONE       | DUCT         | WHITE POWDER COAT | 0.085    | 23 | 7     | -     |
| SA-2  | PRICE       | SCD       | 0-175  | 24X24     | 6         | SQUARE CONE      | CEILING      | WHITE POWDER COAT | 0.076    | 19 | 7     | -     |
| SA-3  | PRICE       | SCD       | 0-620  | 24X24     | 12        | SQUARE CONE      | CEILING      | BRUSHED ALUMINUM  | 0.091    | 24 | 8     | -     |
| SA-4  | PRICE       | SCD       | 0-275  | 24X24     | 8         | SQUARE CONE      | CEILING      | WHITE POWDER COAT | 0.065    | 19 | 9     | -     |
| EG-1  | PRICE       | 80 SERIES | 0-720  | 12X12     | -         | EGGCRATE         | CEILING      | WHITE POWDER COAT | 0.085    | 20 | -     | 1     |
| EG-2  | PRICE       | 80 SERIES | 0-2625 | 24X24     | -         | EGGCRATE         | CEILING      | BRUSHED ALUMINUM  | 0.085    | 20 | -     | 1     |
| EG-4  | PRICE       | MSRRP     | 0-250  | 14X14     | -         | MAXIMUM SECURITY | CEILING      | BRUSHED ALUMINUM  | 0.124    | 25 | -     | 1     |
| EG-5  | PRICE       | MSRRP     | 0-250  | 12X12     | -         | EGGCRATE         | CEILING      | WHITE POWDER COAT | 0.124    | 25 | -     | 1     |
| RG-2  | PRICE       | 80 SERIES | 0-2500 | 24X24     | -         | EGGCRATE         | CEILING      | WHITE POWDER COAT | 0.085    | 20 | -     | 1     |
| RG-6  | PRICE       | MSRRP     | 0-250  | 14X14     | -         | MAXIMUM SECURITY | CEILING      | WHITE POWDER COAT | 0.124    | 25 | -     | 1     |
| SD-1  | PRICE       | SCD       | 0-150  | 24X24     | 6         | SQUARE CONE      | CEILING      | WHITE POWDER COAT | 0.076    | 19 | 7     | 1     |
| SD-2  | PRICE       | SCD       | 0-225  | 24X24     | 8         | SQUARE CONE      | CEILING      | WHITE POWDER COAT | 0.065    | 19 | 7     | 1     |
| SD-3  | PRICE       | SCD       | 0-380  | 24X24     | 10        | SQUARE CONE      | CEILING      | WHITE POWDER COAT | 0.091    | 24 | 8     | 1     |
| SD-9  | PRICE       | MSRRCD    | 0-195  | 16X16     | 8         | MAXIMUM SECURITY | CEILING      | WHITE POWDER COAT | 0.022    | -  | 11    | 1,2   |
| SD-16 | PRICE       | SCD       | 0-575  | 24X24     | 12        | SQUARE CONE      | CEILING      | WHITE POWDER COAT | 0.091    | 24 | 9     | 1     |


PROVIDE WITH SECURITY BARS.
 PROVIDE FRONT OPERATED DAMPER.


|     |    |              |            |                  | _       |             |       |       |         |            |     |        |            |
|-----|----|--------------|------------|------------------|---------|-------------|-------|-------|---------|------------|-----|--------|------------|
| TA  | G  |              |            |                  | AIRFLOW | EXTERNAL SP | MOTOR | MOTOR | ELE     | CTRICAL DA | TA  | WEIGHT |            |
|     |    | MANUFACTURER | MODEL      | AREA SERVED      | (CFM)   | (IN WG)     | (RPM) | (HP)  | VOLTAGE | PHASE      | FLA | (LBS)  | NOTE       |
| SEF | 1  | GREENHECK    | CUBE-130   | CELLBLOCK A1     | 1295    | 0.125       | 1022  | 0.25  | 115     | 1          | 5.8 | 75     | 1, 2, 3,   |
| SEF | 2  | GREENHECK    | CUBE-130   | CELLBLOCK A2     | 1200    | 0.125       | 957   | 0.25  | 115     | 1          | 5.8 | 75     | 1, 2, 3,   |
| SEF | 3  | GREENHECK    | QEI-27     | CELLBLOCK A3     | 10130   | 0.875       | 887   | 3     | 460     | 3          | 4.8 | 674    | 1, 2, 3, 4 |
| SEF | 4  | GREENHECK    | QEI-27     | CELLBLOCK A4     | 10315   | 0.875       | 897   | 3     | 460     | 3          | 4.8 | 674    | 1, 2, 3,   |
| SEF | 5  | GREENHECK    | CUBE-130   | CELLBLOCK A5     | 1180    | 0.125       | 944   | 0.25  | 115     | 1          | 5.8 | 75     | 1, 2, 3,   |
| SEF | 6  | GREENHECK    | CUBE-130   | CELLBLOCK A6     | 965     | 0.125       | 802   | 0.25  | 115     | 1          | 5.8 | 75     | 1, 2, 3,   |
| SEF | 7  | GREENHECK    | QEID-18-95 | CELLBLOCK B1     | 3805    | 0.875       | 1170  | 1     | 460     | 3          | 2.1 | 244    | 1, 2, 3,   |
| SEF | 8  | GREENHECK    | QEID-18-95 | CELLBLOCK B2     | 3805    | 0.875       | 1170  | 1     | 460     | 3          | 2.1 | 244    | 1, 2, 3,   |
| SEF | 9  | GREENHECK    | CUBE-130   | CELLBLOCK B3     | 1070    | 0.125       | 871   | 0.25  | 115     | 1          | 5.8 | 75     | 1, 2, 3,   |
| SEF | 10 | GREENHECK    | CUBE-130   | CELLBLOCK B4     | 1300    | 0.125       | 1025  | 0.25  | 115     | 1          | 5.8 | 75     | 1, 2, 3,   |
| SEF | 11 | GREENHECK    | CUBE-130   | CELLBLOCK B7     | 1180    | 0.125       | 944   | 0.25  | 115     | 1          | 5.8 | 75     | 1, 2, 3,   |
| SEF | 12 | GREENHECK    | CUBE-130   | CELLBLOCK B8     | 955     | 0.125       | 796   | 0.25  | 115     | 1          | 5.8 | 75     | 1, 2, 3,   |
| SEF | 13 | GREENHECK    | CUBE-130   | CELLBLOCK C1     | 890     | 0.125       | 755   | 0.25  | 115     | 1          | 5.8 | 75     | 1, 2, 3,   |
| SEF | 14 | GREENHECK    | GB-099     | CELLBLOCK C2     | 370     | 0.125       | 692   | 0.25  | 115     | 1          | 5.8 | 69     | 1, 2, 3,   |
| SEF | 15 | GREENHECK    | QEI-27     | CELLBLOCKS C3/C8 | 10545   | 0.875       | 910   | 3     | 460     | 3          | 4.8 | 674    | 1, 2, 3,   |
| SEF | 16 | GREENHECK    | QEI-27     | CELLBLOCKS C4/C7 | 10470   | 0.875       | 906   | 3     | 460     | 3          | 4.8 | 674    | 1, 2, 3,   |
| SEF | 17 | GREENHECK    | CUBE-130   | CELLBLOCK C5     | 830     | 0.125       | 717   | 0.25  | 115     | 1          | 5.8 | 75     | 1, 2, 3,   |
| SEF | 18 | GREENHECK    | CUBE-130   | CELLBLOCK C6     | 1135    | 0.125       | 914   | 0.25  | 115     | 1          | 5.8 | 75     | 1, 2, 3,   |

NOTES: 1. PROVIDE STARTER/DISCONNECT AS PER DIVISION 26 SPECIFICATIONS AND REFER TO MECHANICAL EQUIPMENT - ELECTRICAL CONNECTIONS SCHEDULE ON ELECTRICAL DRAWINGS. 2. REFER TO CONTROLS ON DRAWINGS M7.7 AND M7.8. 3. REFER TO DETAIL 10/M5.1 FOR ADDITIONAL INFORMATION. 4. FANS SHALL BE UL LISTED FOR SMOKE CONTROL.

|       | GLYCOL FEED TANK SCHEDULE                            |         |           |    |    |    |    |     |           |  |  |  |
|-------|--|---------|-----------|----|----|----|----|-----|-----------|--|--|--|
| TA    | TAG SYSTEM DIAMETER HEIGHT TANK VOLUME HORSE POWER   |         |           |    |    |    |    |     |           |  |  |  |
|       | MANUFACTURER MODEL SERVED (IN) (IN) (GAL) (HP) NOTES |         |           |    |    |    |    |     |           |  |  |  |
| GFT   | 1  | WESSELS | GMP-15050 | CW | 34 | 45 | 50 | 1/2 | 1,2,3,4,5 |  |  |  |
| NOTES |  |         |           |    |    |    |    |     |           |  |  |  |


2. PROVIDE LOW WATER CUT-OFF ALARM, HIGH LEVEL ALARM, HOA CONTROLS, MAGNETIC STARTER, PRESSURE GAUGE AND SYSTEM ISOLATION VALVE. 3. PROVIDE 120V CIRCUIT FOR GLYCOL PUMP. UNIT SHALL BE ACCOMPANIED WITH A REMOTE ALARM (LIGHT AND HORN). UNIT SHALL HAVE A SINGLE POWER POINT CONNECTION. REMOTE ALARMS SHALL BE POWERED THROUGH THE SAME ELECTRICAL CONNECTION. COORDINATE LOCATION OF REMOTE ALARM WITH THE OWNER. 4. REFER TO DETAIL 12/M5.1 FOR ADDITIONAL INFORMATION. 5. REFER TO DETAIL 1/M5.2 FOR ADDITIONAL INFORMATION.

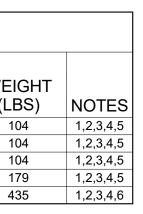

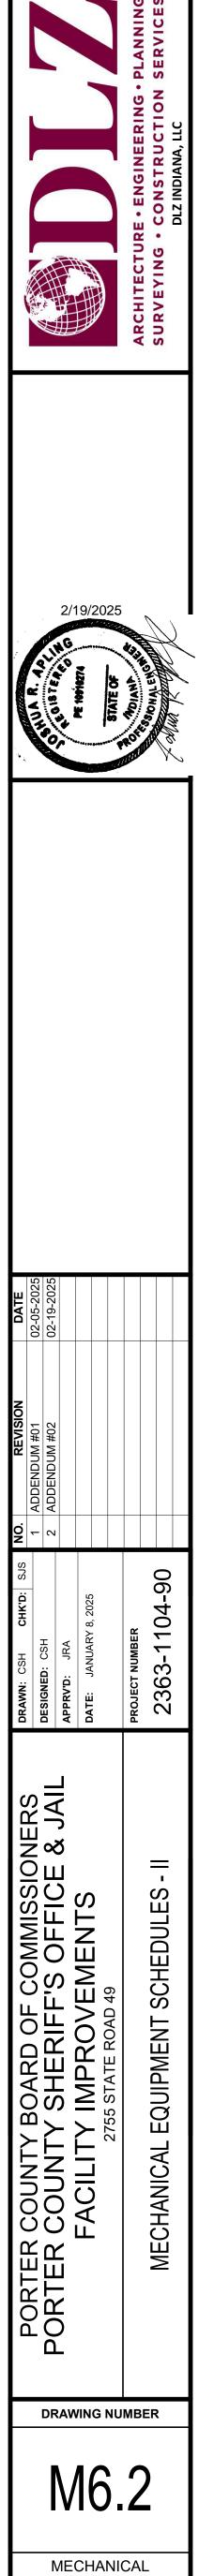

SCANNED JANUARY 2009 PORTER COUNTY SURVEYOR'S OFFICE 155 Indiana Avenue Suite 303 Valparaiso, Indiana 46383 (219) 465.3560 Kevin D. Breitzke, P.E.,L.S. - Porter County Surveyor · · · · · 
 Image: Constraint of the state
 Image: Constraint of the state
 Image: Constraint of the state

 Image: Constraint of the state
 Image: Constraint of the state
 Image: Constraint of the state COMMISSARY C-129 0 **(a)** Ð . SCHEDULE EQL IPMENT MARK QUAN. DESCRIPTION MANUFACTURER 4 MODEL AIR CURTAIN MARS 72 NCH 1 2 AIR CURTAIN MARS 48 NCH 2 TRASH BIN, MOBILE RUBBERMAID 1315 3 PLATFORM TRUCK, MOBILE RUBBERMAID 4471 4 BEAM SCALE BY OWNER 5 6 CHECKERS DESK LYON 2250 DUNNAGE PLATFORM LOT NEW AGE 2009 ٦ HI DENSITY SHELF SYSTEM 8 LOT METRO MAX TOP TRACK 9 Ø HI DENSITY SHELF SYSTEM METRO MAX TOP TRACK LOT SHELF UNIT, MOBILE METRO MAX 11 LOT 12 LOT WALK IN COOLER-FREEZER ELLIOTT WILLIAMS 13 Bohn Adt-520 13A gooler coil a 138 COOLER COIL B BOHN LP-90 13C FREEZER COIL C BOHN LET-120 13D COOLER COMPRESSOR A COPELAND E3AMA@75 COOLER COMPRESSOR B 13E COPELAND C3AMAK00 13F FREEZER COMPRESSOR C COPPELAND CJAL0300 UTILITY CART, MOBILE NEW AGE NS145 14 5 ۰. : DISPOSER IN SINK ERATOR 35125/CC101 B VEGETABLE PREPARATION SINK NORTHERN STAINLESS 16 17 ----18 work table, mobile NORTHERN STAINLESS 19 1 20 21 SLICER HOBART 2912 1 ISLAND WORK CENTER NORTHERN STAINLESS 22 HAND SINK, STAINLESS STEEL BY DIVISION IS. LOT 23

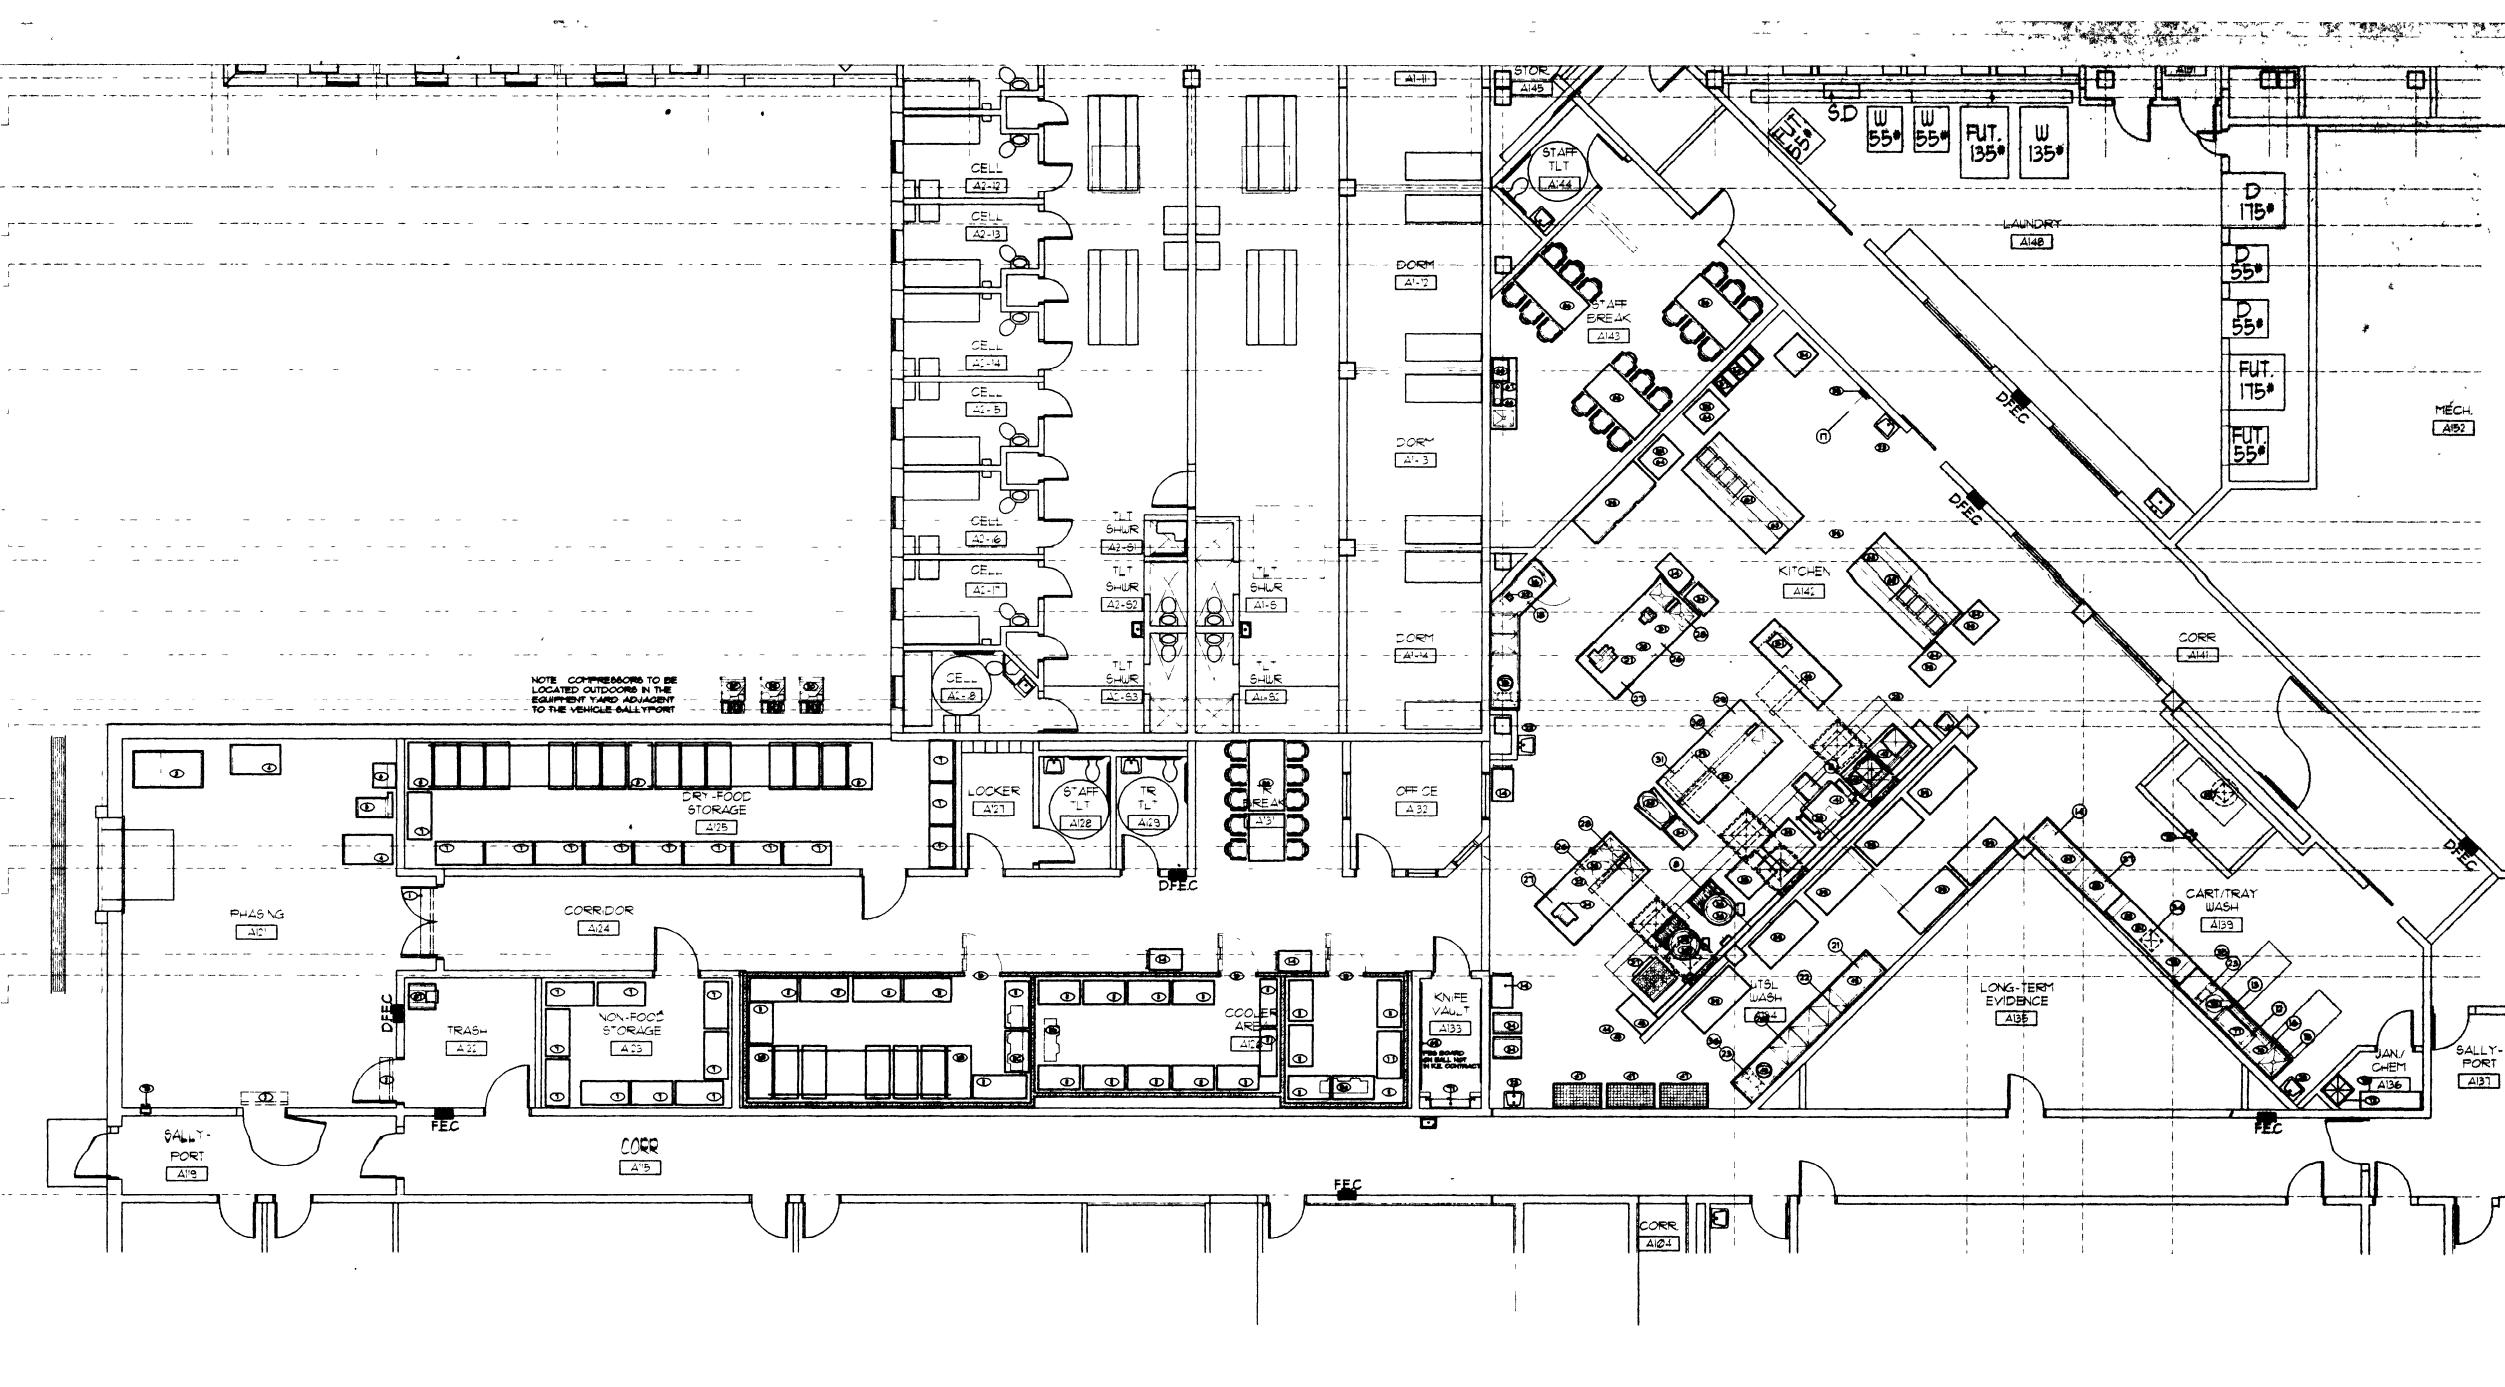

| EC |       | oment s                    | CHEDUL                     |
|----|-------|----------------------------|----------------------------|
|    | QUAN. | DESCRIPTION                | MANUFACTURER 4 MO          |
| 24 | 1     | BAGGER                     | AUTO BAG HB25              |
| 25 | 1     | ISLAND WORK CENTER         | NORTHERN STAINLESS         |
| 26 |       |                            |                            |
| 27 |       |                            |                            |
| 28 | 1     | ISLAND WORK TABLE          | NORTHERN STAINLESS         |
| 29 | 5     | INGREDIENT BIN, MOBILE     | RUBBERMAID 3602            |
| 3Ø |       |                            |                            |
| 31 | 1     | FOOD PROCESSOR             | HOBART FP350               |
| 32 | 1     | CAN OPENER, ELECTRIC       | EDLUND 270                 |
| 33 | 1     | CAN OPENER, MANUAL         | EDLUND SII                 |
| 34 | 4     | PAN RACK, MOBILE           | CRES COR 200-1841          |
| 35 | 1     | COMBIOVEN STEAMER          | BLODGETT COS-1015          |
| 36 | 2     | KETTLE, 40 GALLON          | GROEN HH4-40               |
| 37 | 1     | Range, Modile              | South Bend 1363-1          |
| 38 | 3     | DRAIN TROUGH               | NORTHERN STAINLESS         |
| 39 | 1     | CONVECTION OVEN, MOBILE    | SOUTH BEND GS-25-CC        |
| 40 |       |                            |                            |
| 41 | 1     | TILT SKILLET               | GROEN NHFP-4               |
| 42 | 2     | GRIDDLE WITH STAND, MOBILE | LANG GGB-36TI              |
| 43 | 1     | UTILITY RACEWAY            |                            |
| 44 | 1     | WALL VENTILATION SYSTEM    | AVTEC                      |
| 45 | 1     | FIRE CONTROL SYSTEM        | AVTEC MIST A FIRE          |
| 46 | 1     | PASS THRU FOOD WARMER      | SECO S-2203-INORTHERN      |
| 41 | 3     | PAN STORAGE RACK, MOBILE   | METRO MAX                  |
| 48 | 1     | DISPOSER                   | IN SINK ERATOR SSI23/CC101 |
| 49 | ١     | utensil washing sink       | NORTHERN STAINLESS         |
| 50 |       |                            |                            |
| 51 | 1     | CONVEYOR TOASTER           | SAVORY C-40VS              |
| 52 | 1     | TOASTER TABLE, MOBILE      | NORTHERN STAINLESS         |

| EC        |        | oment sc   | CHEDULE                    |
|-----------|--------|--|----------------------------|
| MARK      | QUAN.  | DESCRIPTION  | MANUFACTURER 4 MODEL       |
| 53        | 1      | REFRIGERATOR, REACH IN   | VICTORY RSA-3D-57          |
| 54        | 1      | ICE MAKER WITH BIN   | MANITOWOC QD-0602A/5570    |
| 55        | 1      | FILL STATION   | NORTHERN STAINLESS         |
| 56        | 2      | CONTAINER RACK, MOBILE   | METRO MAX                  |
| 57        | LOT    | WATER-ICE BEVERAGE CONTAINER                                   | CAMBRO 500LCD              |
| 58<br>58A | 2<br>2 | HOT BOX STORAGE UNIT, MOBILE<br>COLD TRAY STORAGE UNIT, MOBILE |                            |
| 59        | 8      | TRAY DELIVERY CART   | CRES COR                   |
| 60        |        |  |                            |
| 61        | 1      | COLD FOOD TABLE  | COLOR POINT 60-CFM         |
| 62        | 1      | HOT FOOD TABLE   | COLOR POINT BE4-CPA        |
| 63        | 2      | UTILITY TABLE, MOBILE  | COLOR POINT 60-ST          |
| 64        | 500    | TRAY SYSTEM  | JONES ZYLON                |
| 65        | 1      | MIXER, 60 QT.  | HOBART H600                |
| 66        | 1      | Counter W/CAB. BASE  | Northern Stainless         |
| 67        | 1      | Coffee Brewer  | BUNN O MATIC VPS           |
| 68        | 1      | MICRO WAVE OVEN  | PANASONIC NE8031           |
| 69        | LOT    | WALL FEGBOARD  | NOT IN K.E. CONTRACT       |
| ъ         |        |  |                            |
| וד        | 1      | KNIFE STORAGE CABINET  | NORTHERN STAINLESS         |
| 72        | 1      | Shelf Unit   | BY OTHERS                  |
| 73        | 1      | Mor Sink   | BY DIVISION 15             |
| 74        |        |  |                            |
| 75        | 2      | HOT & COLD WATER HOSE STATION                                  | BY DIVISION IB             |
| 76        | 1      | SOILED DISHTABLE   | NORTHERN STAINLESS         |
| TT .      | 1      | RACKING SHELF  | NORTHERN STAINLESS         |
| 78        | 1      | DISPOSER   | IN SINK ERATOR 05500/CCI01 |
| er        | 1      | DISHWASHER   | HOBART CRS-86A             |
| 80        |        |  |                            |
| 81        | 1      | DISHWASHER EXHAUST SYSTEM                                      | MASTER AIR CDER            |
|           |        |  | í                          |


| EC   | 2011  | SMENT                 | SCHEDULE                 |
|------|-------|-----------------------|--------------------------|
|      | QUAN. | DESCRIPTION           | MANUFACTURER & MODEL     |
| 82   | 1     | DETERGENT INJECTOR    | BY SOAP VENDOR           |
| 83   | 1     | BOOSTER HEATER        | HATCO 536                |
| 84   | 1     | CLEAN DISHTABLE       | NORTHERN STAINLESS       |
| 85   | 1     | CART WASH VENT SYSTEM | BY DIVISION IS           |
| 86   | LOT   | TABLE & CHAIR         | NOT IN KE. CONTRACT      |
| 87   | 1     | CAN CRUSHER           | BY OUNER                 |
| 88   | -41   | Commissary shelf unit | METRO SUPER ERECTA SHELF |
| ITEM |       |                       |                          |
| ITEM |       |                       | •                        |
| ITEM |       |                       | ,                        |
| ITEM |       |                       |                          |
| ITEM |       |                       |                          |
| ITEM |       |                       |                          |
| ITEM |       |                       | <b>ب</b> ب               |
| ITEM |       |                       |                          |
| ITEM |       |                       |                          |
| ITEM |       | -                     |                          |
| ITEM |       |                       |                          |
| ITEM |       |                       |                          |
| ITEM |       |                       |                          |
| ITEM | -     |                       |                          |
| ITEM |       |                       | Α                        |
| ITEM |       |                       |                          |
| ITEM |       |                       |                          |
| ITEM |       | 1<br>1                |                          |
| ITEM |       |                       |                          |
|      |       | s                     |                          |
|      |       | a. *                  |                          |


\* \*


n ti ji ti

\*

6 Z HIL CY. (T) ALPARAISC K 2 d L E O Ш ШТ ÊSĞ **XITC** 

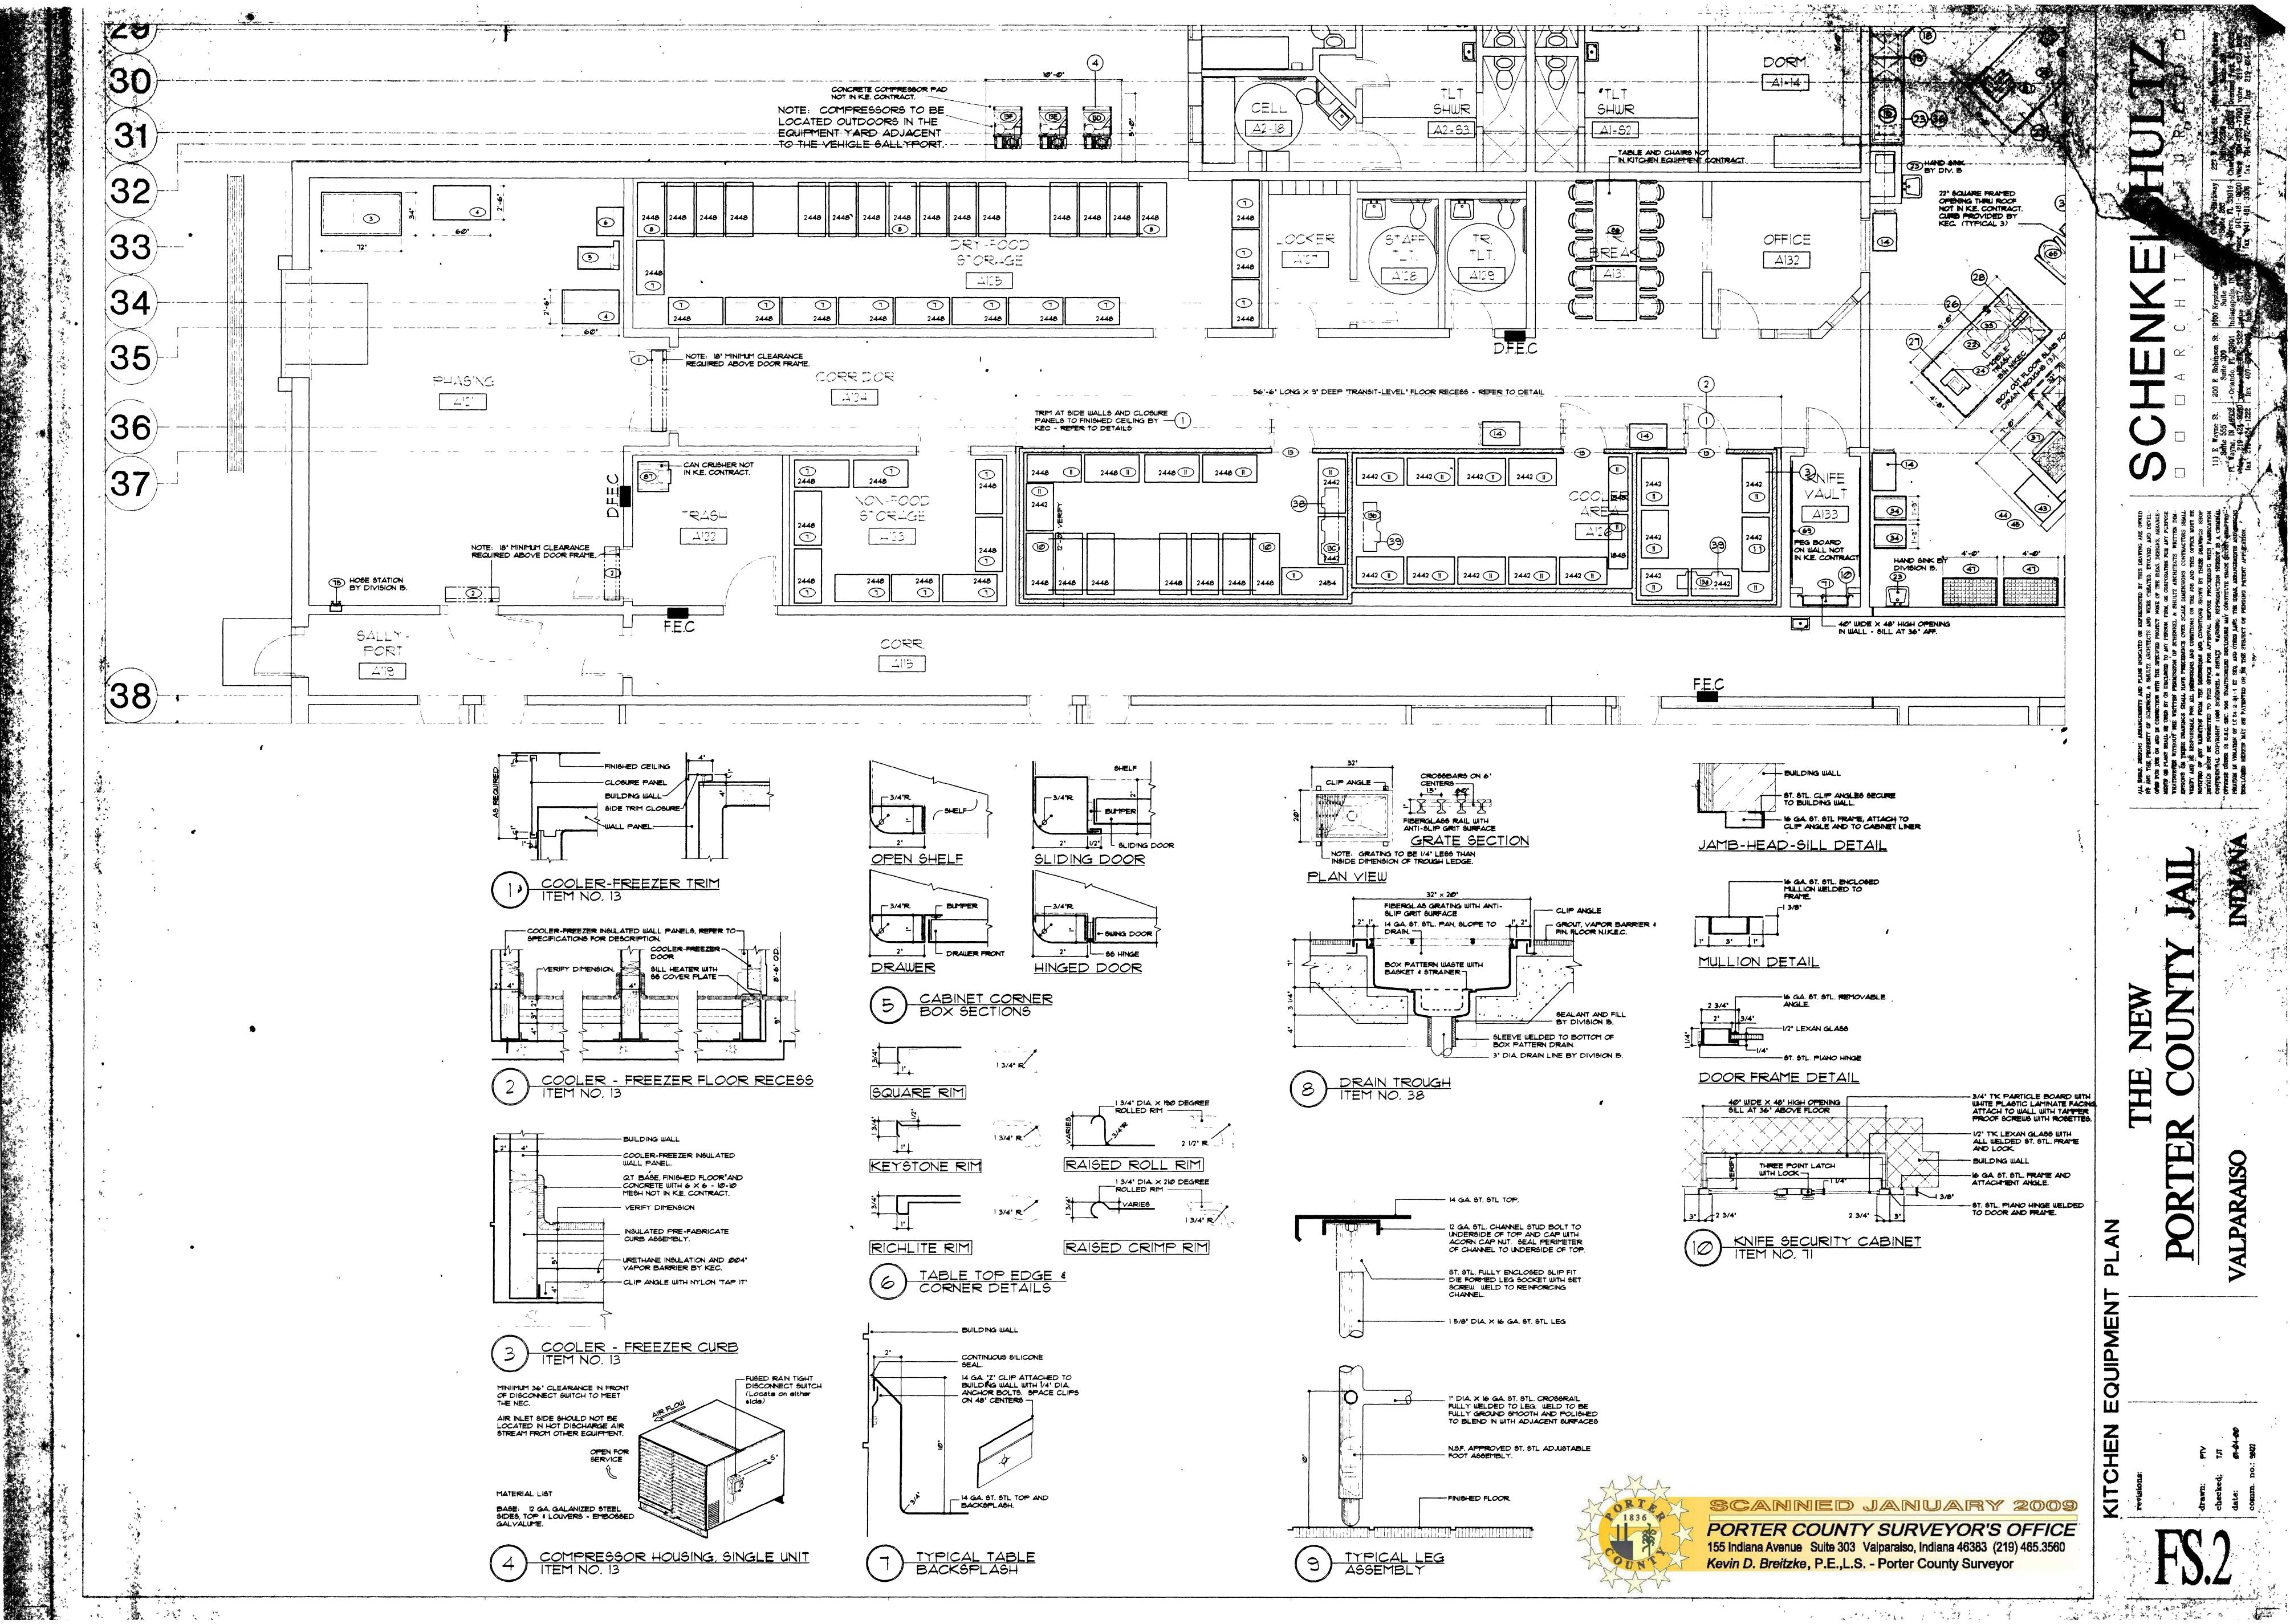

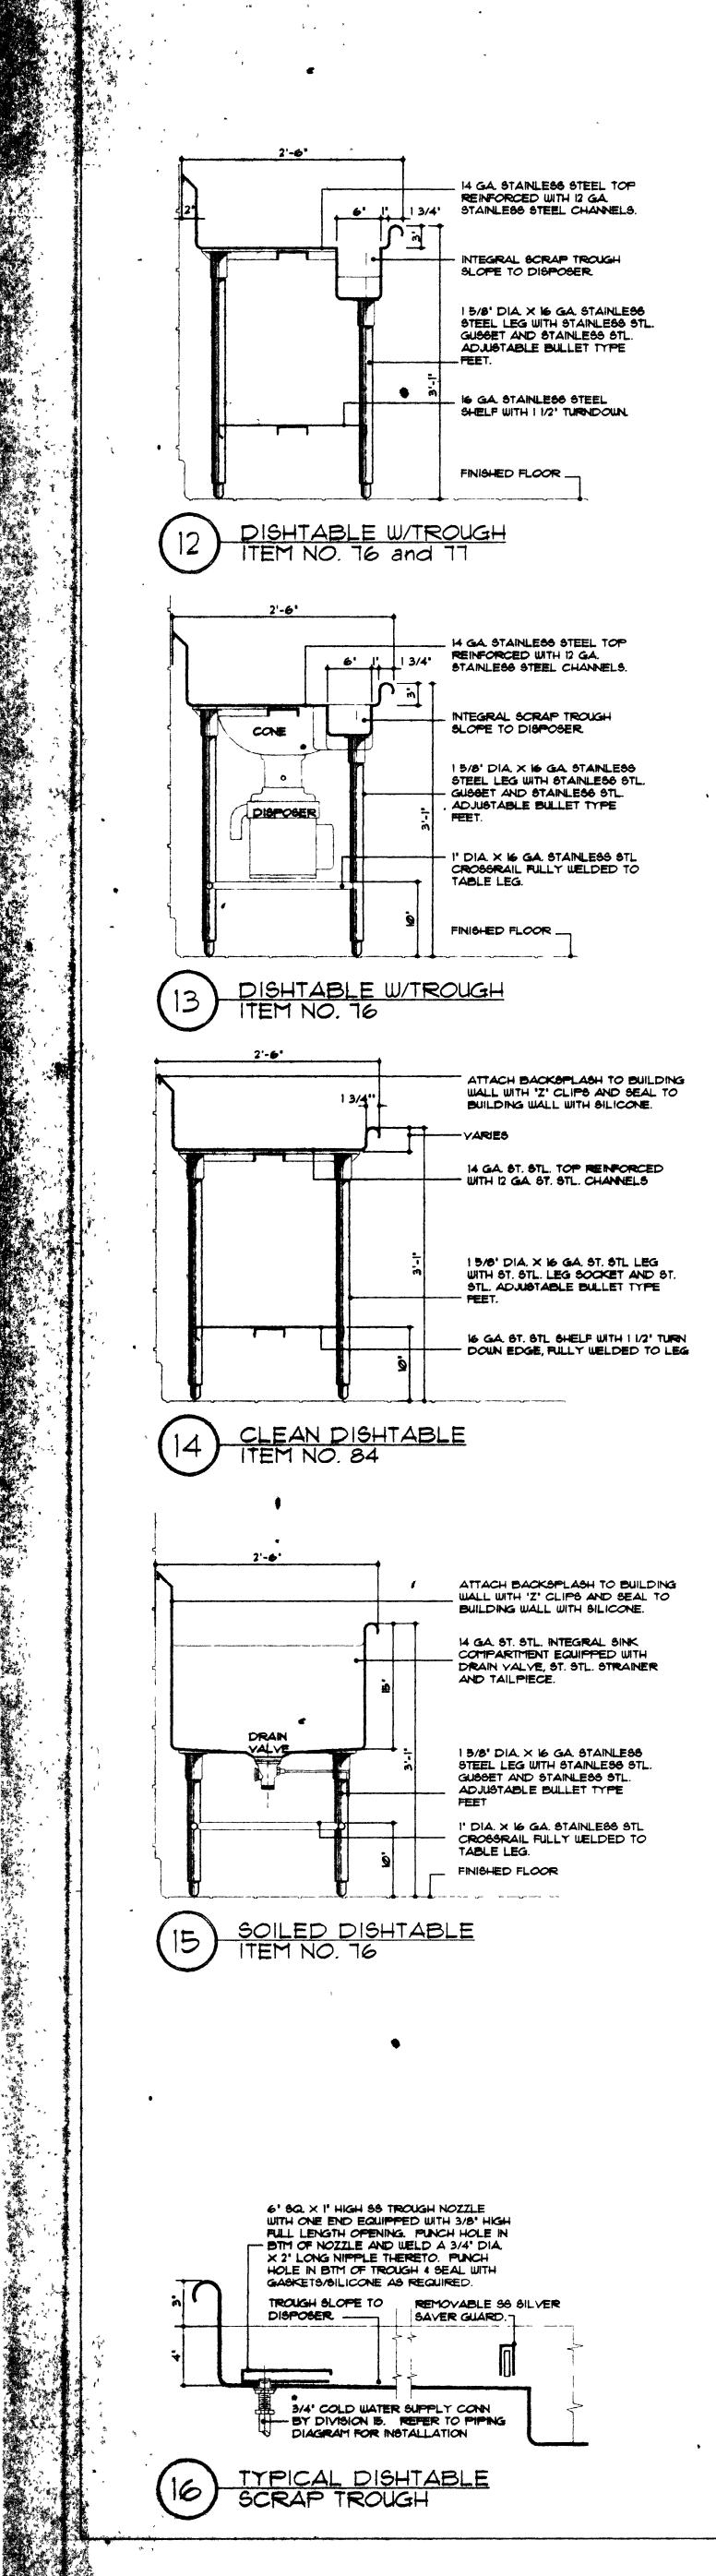


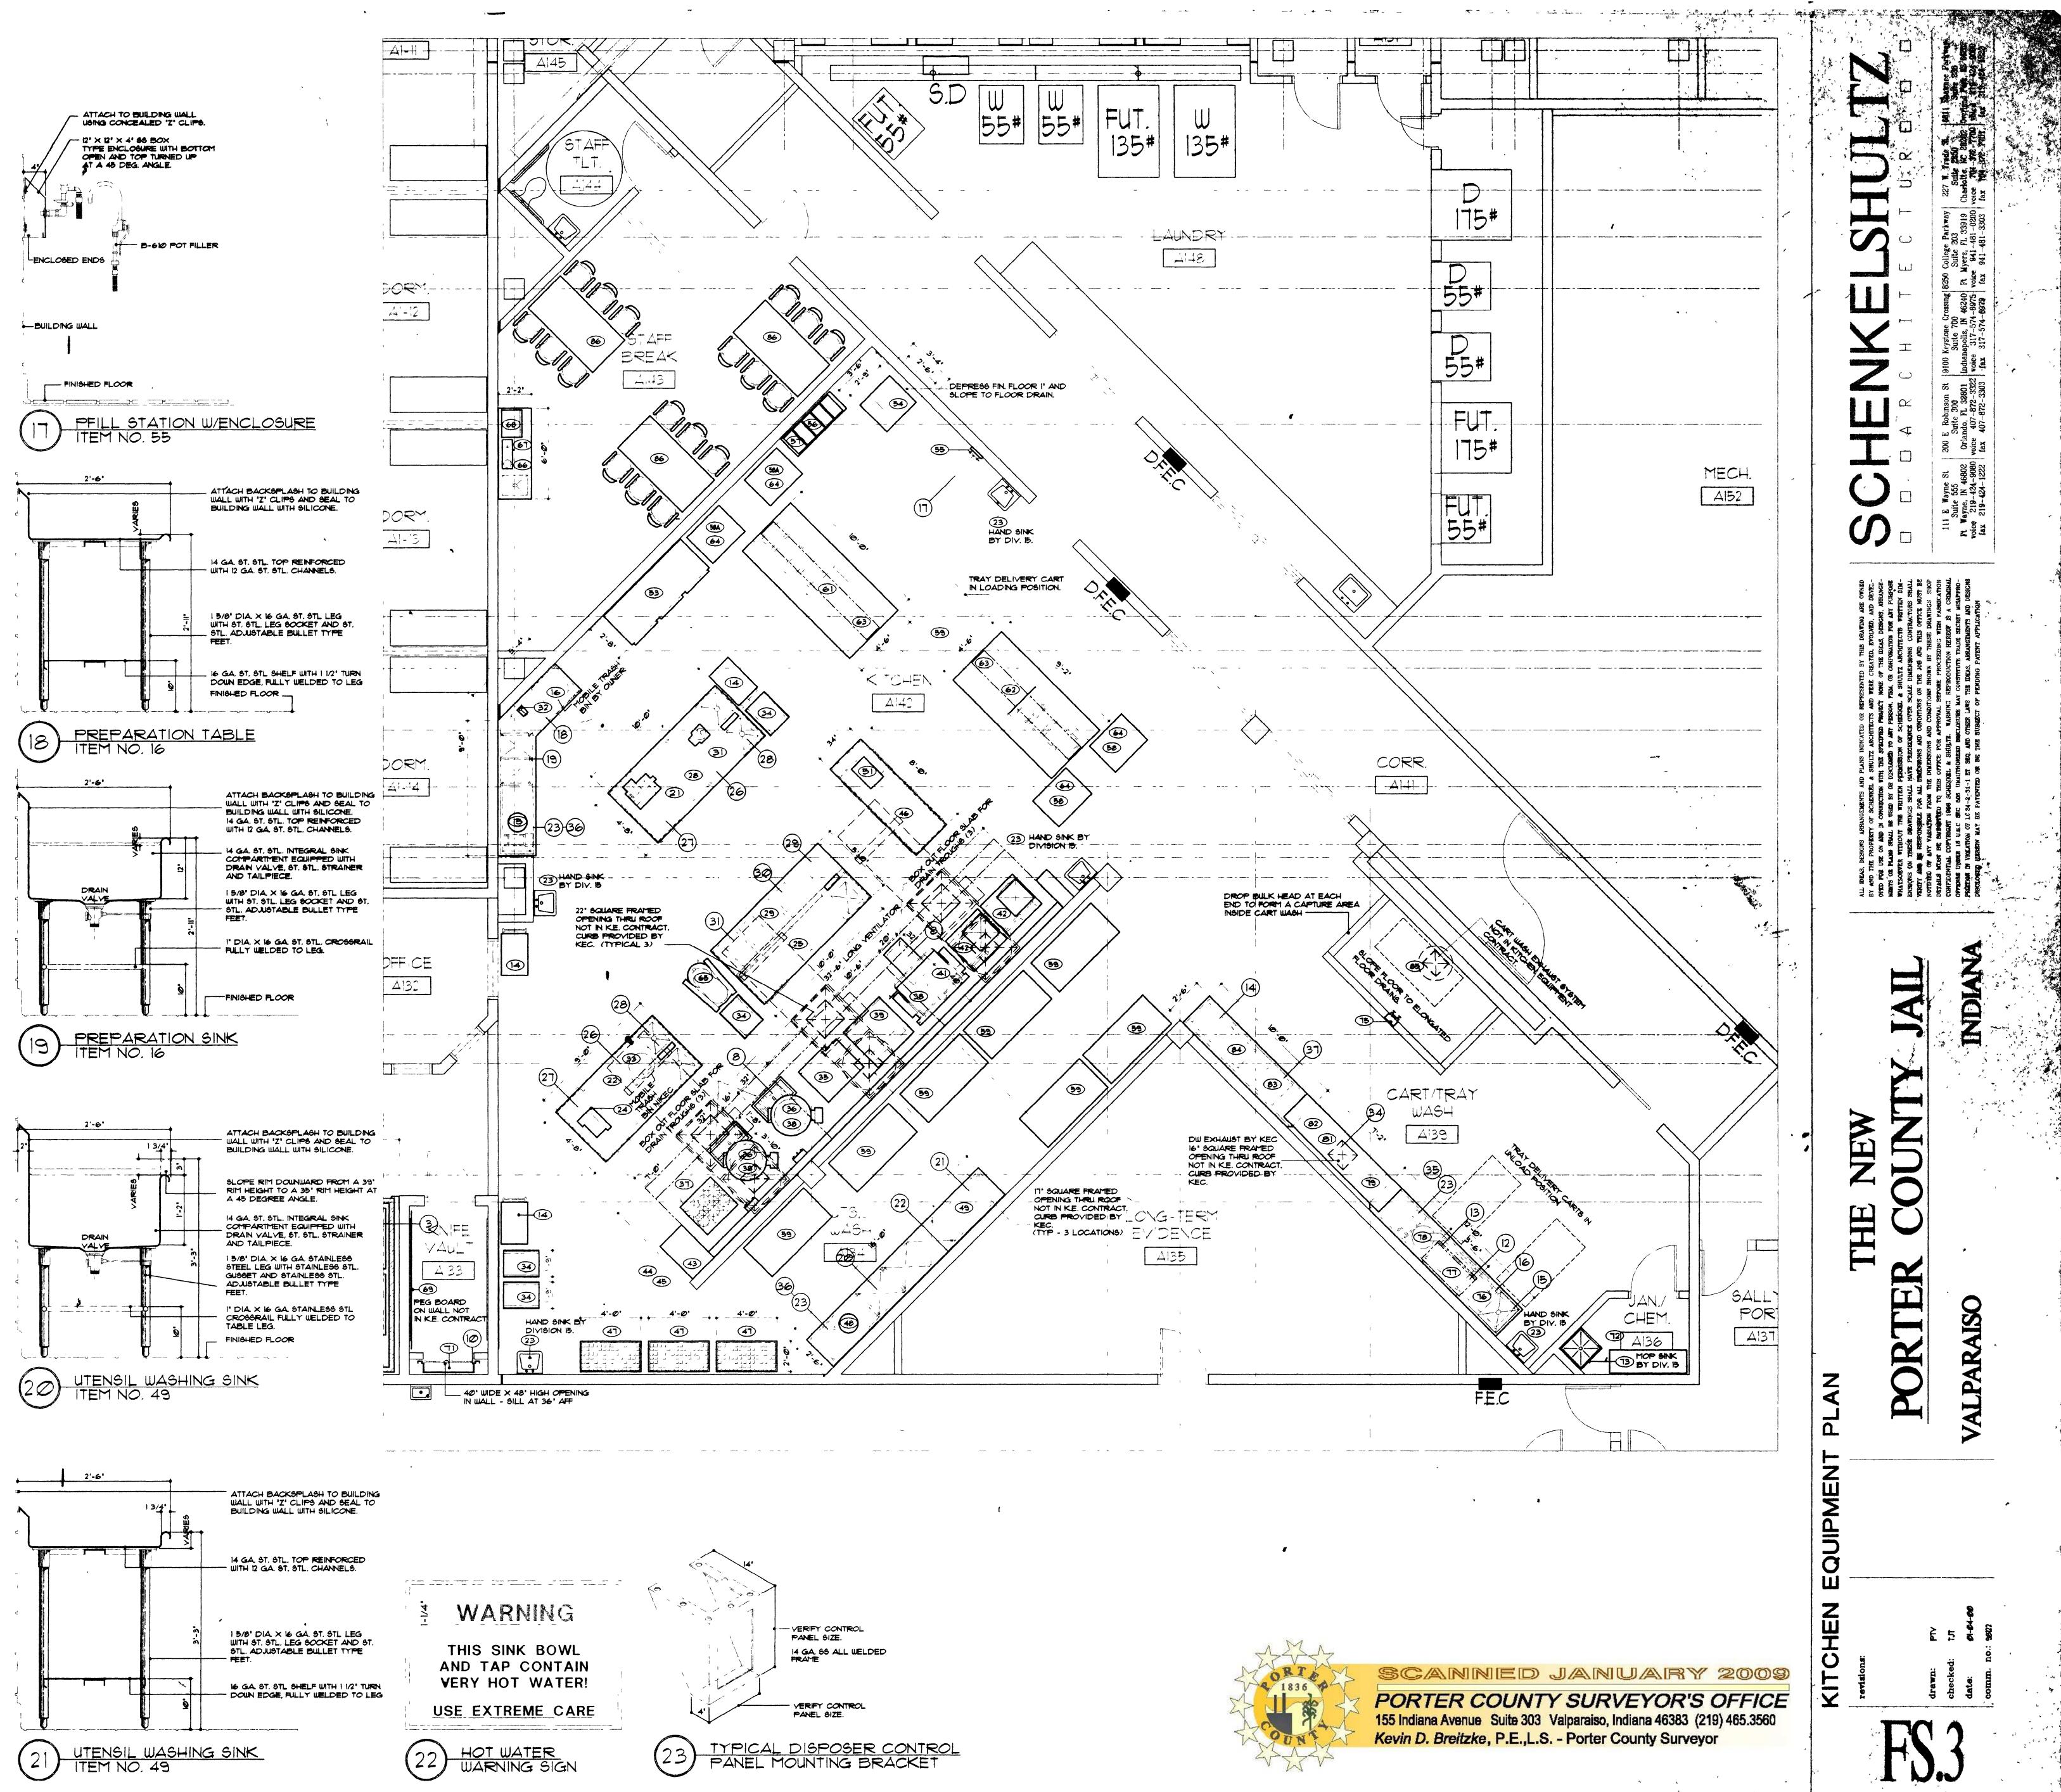


e to to it. A state it.

ر می<sup>6</sup> جمعی م


1 1

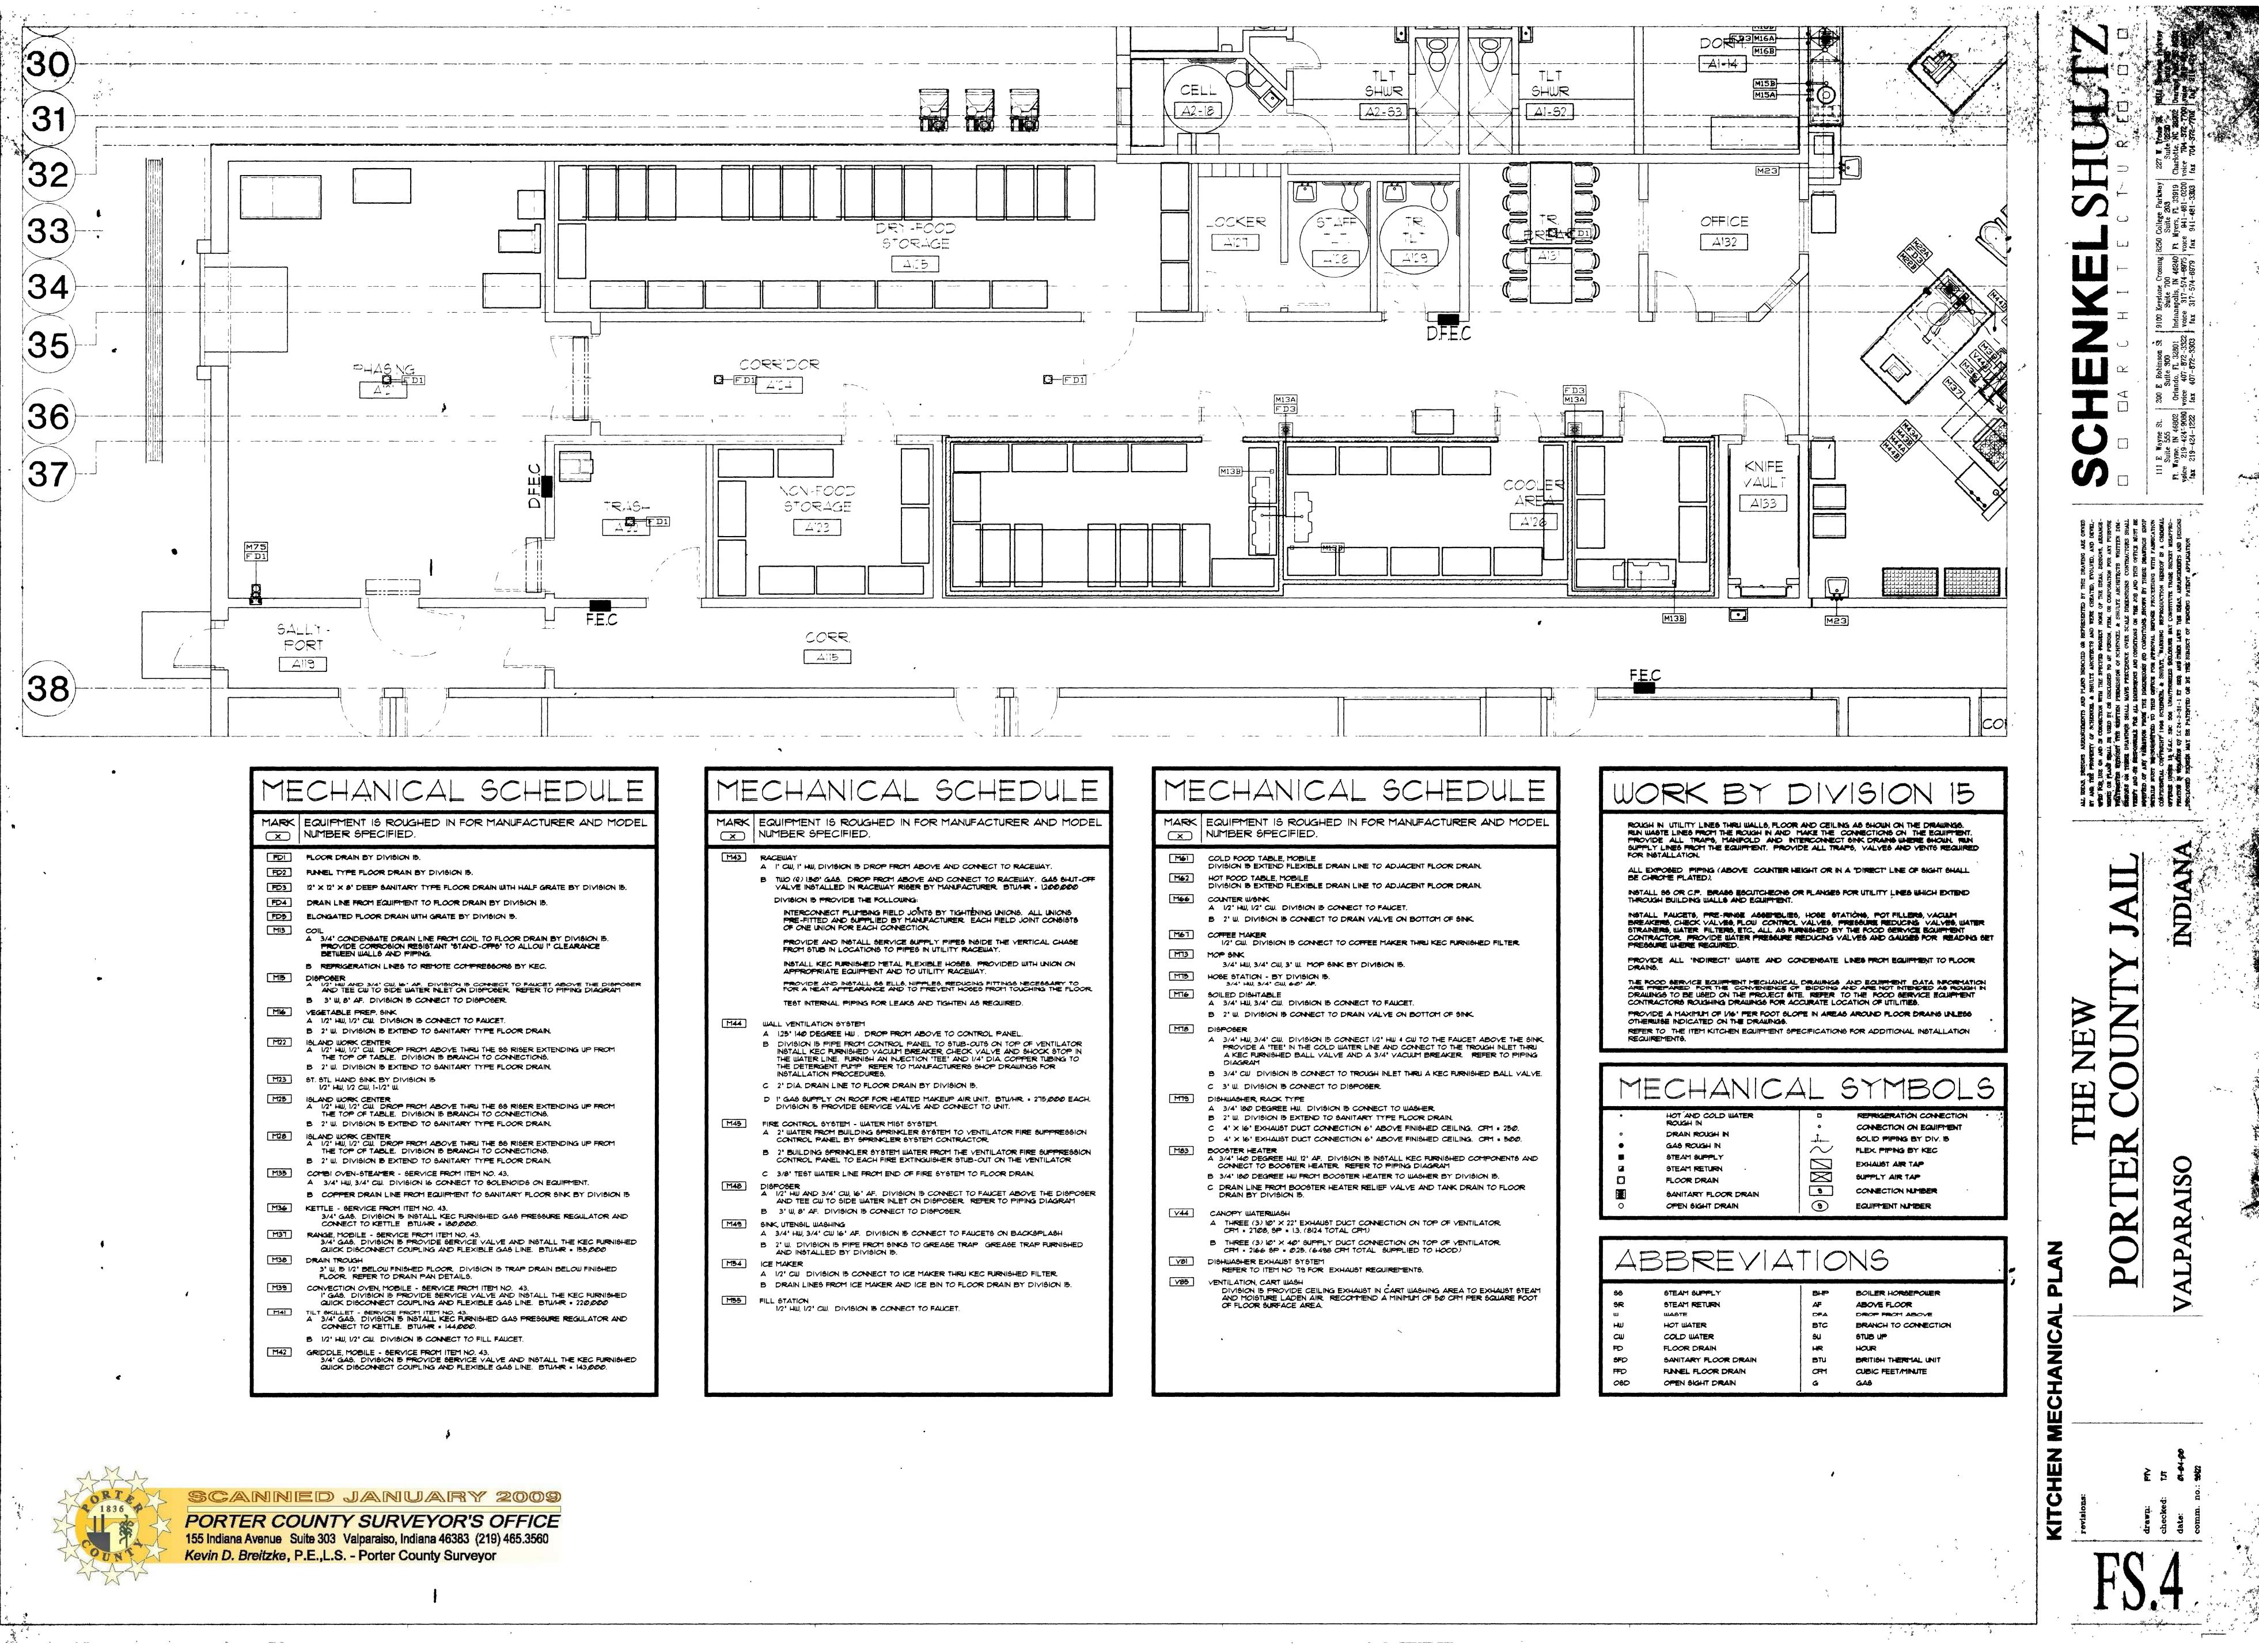

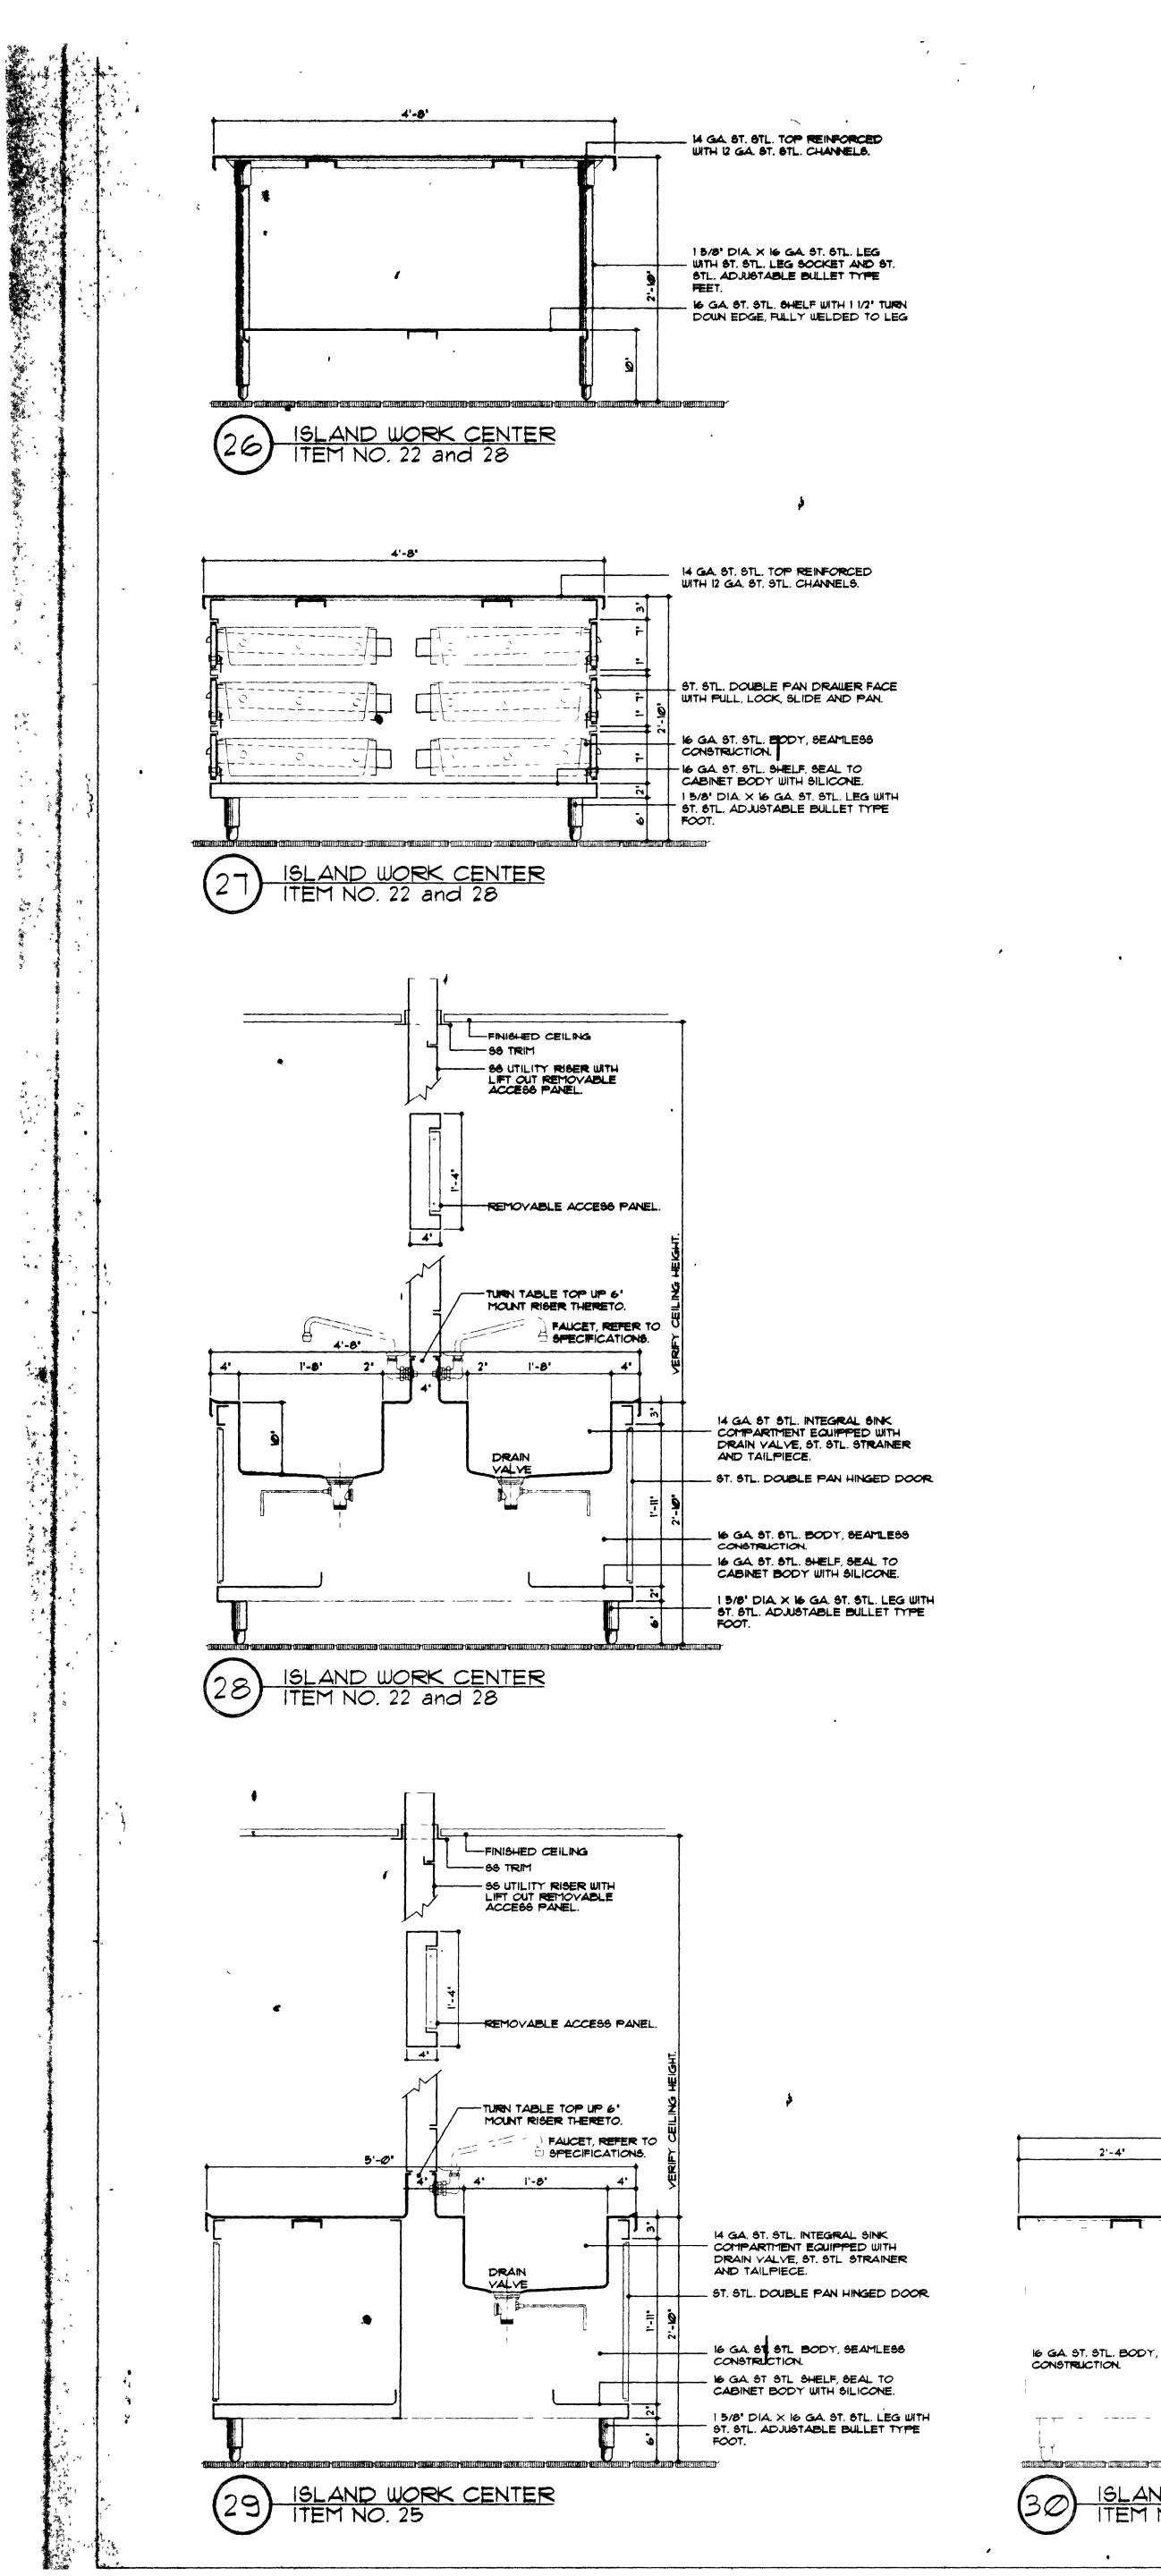



S SSE SS -----582 ¥ ഗ ALL LUTA ALL LUTA AND TA AND T NEW THE  $\mathbf{\mathcal{C}}$ TT) R Ω • | | L L dat chr 

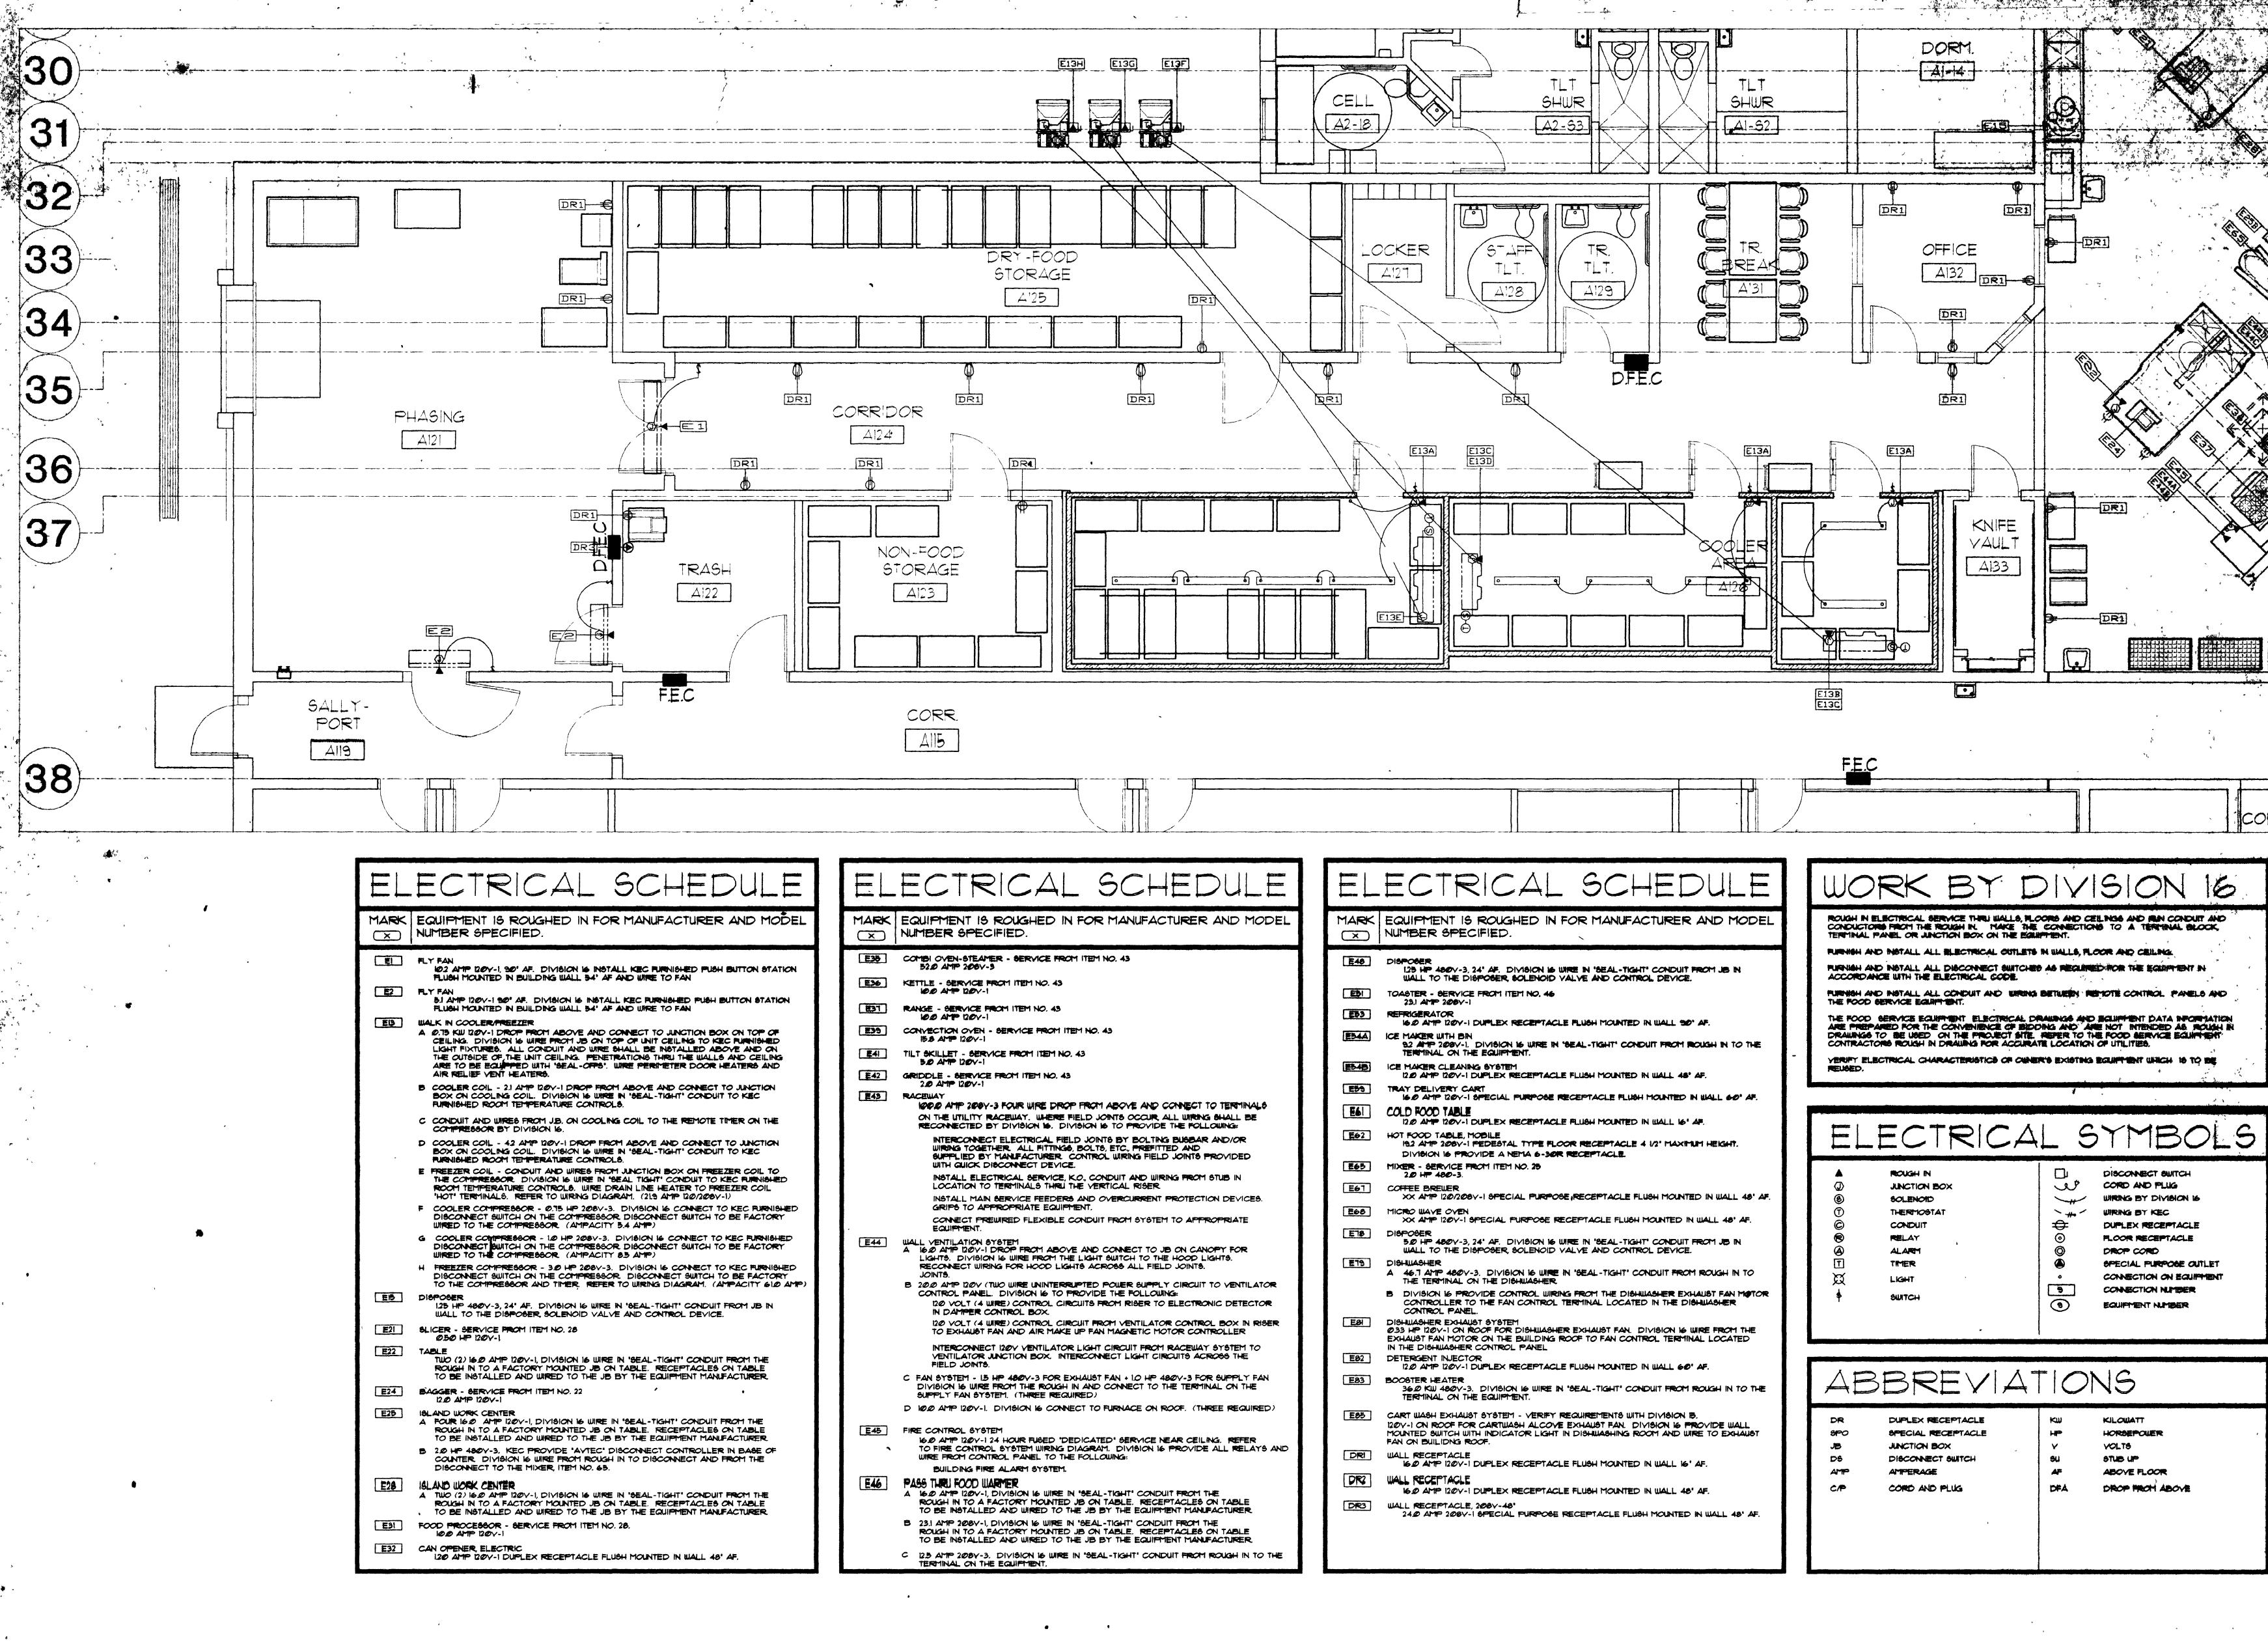

# SCANNED JANUARY 2009

**PORTER COUNTY SURVEYOR'S OFFICE** 155 Indiana Avenue Suite 303 Valparaiso, Indiana 46383 (219) 465.3560 Kevin D. Breitzke, P.E., L.S. - Porter County Surveyor



1 2 x x + 1 + 1 + 1

TT TT]  $\bigcirc$ TT . 2 C . A.Y.

