

ADDENDUM NO. 8

October 24, 2025

**Interior Finishes for New Lodge at Potato Creek State Park
25601 State Road 4
North Liberty, IN 46554**

TO: ALL BIDDERS OF RECORD

This Addendum forms a part of and modifies the Bidding Requirements, Contract Forms, Contract Conditions, the Specifications and the Drawings dated September 29, 2023, by HA FER. Acknowledge receipt of the Addendum in the space provided on the Bid Form. Failure to do so may subject the Bidder to disqualification.

This Addendum consists of Pages ADD 8-1 through ADD 8-3, Revised specification sections 00 31 00 Bid Form and 01 23 00 Alternates, Reissued Drawing Sheets: ID2.4, ID2.5, ID2.6, ID2.7, ID2.8, ID2.9, ID2.10, ID2.11, ID2.12, & ID2.13 and attached Hafer Addendum No. 8, dated October 24, 2025, consisting of 2 pages.

BID OPENING DATE AND TIME - REMINDER

The Bid Opening on Thursday, November 6, 2025, at 2:00 PM Eastern Time, will **ONLY** be available to watch via MS Teams Meeting; see meeting link below:

Microsoft Teams [Need help?](#)

[Join the meeting now](#)

Meeting ID: 259 985 924 300 2

Passcode: or2SZ9b8

Dial in by phone

[+1 317-762-3960,,534321217#](#) United States, Indianapolis

[Find a local number](#)

Phone conference ID: 534 321 217#

[+1 317-762-3960,534321217#](#)

A. GENERAL INFORMATION

1. All RFI's are to be directed to Derek Anderson at dmanderson@skillman.com & Scott Rogers at srogers@skillman.com.

B. SPECIFICATION SECTION 00 31 00 – BID FORM

1. Replace:

Specification Section 00 31 00 - Bid Form with the attached revised section.

C. SPECIFICATION SECTION 01 12 00 MULTIPLE CONTRACT SUMMARY

1. Paragraph 3.03A Bid Categories

A. BID CATEGORY NO. 9 – HARD TILE

Add the following clarifications:

8. Shower depressions in Units A&B have been depressed 2” below finish floor elevations. The Bid Category No. 9 Contractor shall provide all work required from this elevation to finish floor elevations.

B. BID CATEGORY NO. 10 – FLOORING

Delete the following specification sections:

Section 09 67 23 Resinous Flooring

Delete the following clarifications:

6. Provide solid surface thresholds at areas as indicated.

C. BID CATEGORY NO. 12 – MILLWORK & CASEWORK

Add the following specification sections:

Section 09 67 23 Resinous Flooring

Add the following clarifications:

12. Provide solid surface thresholds and curbs at areas indicated.
13. The **Bid Category No. 12 Contractor** shall provide shower enclosures (AC-28) indicated on sheet ID10.01.
14. The **Bid Category No. 12 Contractor** shall provide the shower benches as described in Alternate No. 9.
15. Provide cleaning of all concrete floors that are scheduled to receive resinous flooring, etc. provided by **Bid Category No. 12 Contractor**. Use a sanding machine to remove all traces of plaster, grit, foreign substances, paint, trowel marks and any other deficiencies. Vacuum all floors to ensure the removal of all dust and debris prior to the

Delete the following clarifications:

3. Provide caulking at all hollow metal door frames and FRP door frames.

D. SPECIFICATION SECTION 01 23 00 - ALTERNATES

1. Replace:

Specification Section 01 23 00 - Alternates with the attached revised section.

CONTRACTOR'S BID FOR PUBLIC WORKS FORM NO. 96

Format (Revised 2013)
(Amended for DNR)

**Interior Finishes for New Lodge
at Potato Creek State Park**

Indiana Department of Administration
Division of Public Works
St. Joseph County

PART I

(To be completed for all bids. Please type or print)

Date (month, day, year): _____

BIDDER (Firm) _____

Address _____ P.O. Box _____

City/State/Zip _____

Telephone Number: _____ Email Address: _____

Person to contact regarding this Bid _____

Pursuant to notices given, the undersigned offers to furnish labor and/or materials necessary to complete the public works project of:

Insert Category No. (s) and Name(s)

Of public works project, *Interior Finishes for New Lodge at Potato Creek State Park*, in accordance with Plans and Specifications prepared by *Hafer, 21 SE Third Street, Evansville, IN 47708*, as follows:

BASE BID

For the sum of _____
(Sum in words)

_____ DOLLARS (\$ _____)
(Sum in figures)

The undersigned acknowledges receipt of the following Addenda:

Receipt of Addenda No. (s) _____

PROPOSAL TIME

Bidder agrees that this Bid shall remain in force for a period of sixty (60) consecutive calendar days from the due date, and Bids may be accepted or rejected during this period. Bids not accepted within said sixty (60) consecutive calendar days shall be deemed rejected.

Attended pre-bid conference YES _____ NO _____

Has visited the jobsite YES _____ NO _____

The Bidder has reviewed the Guideline Schedule in Section 01 32 00 and the intent
Of the schedule can be met. YES _____ NO _____

Bidder has included their Written Drug Testing Plan that covers all employees of the bidder who
will perform work on the public work project and meets or exceeds the requirements set in IC 4-
13-18-5 or IC 4-13-18-6. YES _____ NO _____

The Skillman Corporation's diversity initiative is to create a program to encourage, assist and
measure the active participation of Minority- Owned, Women-Owned, Veteran – Owned and
Disabled Individual-Owned Businesses. The Program is to ensure that MWVDBEs are
provided full and equal opportunity to participate in all Skillman Corporation's Projects.

Bidder has included: MBE: YES _____ % NO _____
 WBE: YES _____ % NO _____
 IVOSB: YES _____ % NO _____

The undersigned further agrees to furnish a bond or certified check with this Bid for an amount
specified in the Notice to Bidders. If Alternate Bids apply, submit a proposal for each in
accordance with the Plans and Specifications.

If additional units of material included in the contract are needed, the cost of units must be the
same as that shown in the original contract if accepted by the governmental unit. If the bid is to
be awarded on a unit bases, the itemization of the units shall be shown on a separate attachment.

The contractor and his subcontractors, if any, shall not discriminate against or intimidate any
employee, or applicant for employment, to be employed in the performance of this contract, with
respect to any matter directly or indirectly related to employment because of race, religion, color,
sex, national origin or ancestry. Breach of this covenant may be regarded as a material breach of
the contract.

I, the undersigned bidder or agent as a contractor on a public works project, understand my statutory obligation to use steel products made in the United States (I.C. 5-16-8-2). I hereby certify that I and all subcontractors employed by me for this project will use U.S. steel on this project if awarded. I understand that violations hereunder may result in forfeiture of contractual payments.

ALTERNATE BIDS

A blank entry or an entry of "No Bid", "N/A", or similar entry on any Alternate will cause the bid to be rejected as non-responsive only if that Alternate is selected. If no change in the bid amount is required, indicate "No Change".

****MARK "ADD" OR "DEDUCT" FOR EACH ALTERNATE****

Alternate Bid No. 1 – WC-01 Area D

Change the Base Bid the sum of _____
(sum in words)

_____ DOLLARS (\$_____) ADD
(sum in figures) DEDUCT

Alternate Bid No. 2 – WC-08 Ballroom

Change the Base Bid the sum of _____
(sum in words)

_____ DOLLARS (\$_____) ADD
(sum in figures) DEDUCT

Alternate Bid No. 3 – WC—07 at Meeting Rooms and Prefunction

Change the Base Bid the sum of _____
(sum in words)

_____ DOLLARS (\$_____) ADD
(sum in figures) DEDUCT

Alternate Bid No. 4 – WC-01 at Corridor E119

Change the Base Bid the sum of _____
(sum in words)

_____ DOLLARS (\$_____) ADD
(sum in figures) DEDUCT

Alternate Bid No. 5 – T-13/T-23 at Pool Locker Walls

Change the Base Bid the sum of _____
(sum in words)

_____ DOLLARS (\$_____) ADD
(sum in figures) DEDUCT

Alternate Bid No. 6 – VWC-03 Guest Room Corridors

Change the Base Bid the sum of _____
(sum in words)

_____ DOLLARS (\$_____) ADD
(sum in figures) DEDUCT

Alternate Bid No. 7 – Painted Wood Cladding

Change the Base Bid the sum of _____
(sum in words)

_____ DOLLARS (\$_____) ADD
(sum in figures) DEDUCT

Alternate Bid No. 8 – Stained Wood Veneer Cladding

Change the Base Bid the sum of _____
(sum in words)

_____ DOLLARS (\$_____) ADD
(sum in figures) DEDUCT

Alternate Bid No. 9 – Shower Benches

Change the Base Bid the sum of _____
(sum in words)

_____ DOLLARS (\$_____) ADD
(sum in figures) DEDUCT

PART II

(For projects of \$150,000 or more – IC 36-1-12-4)

These statements to be submitted under oath by each bidder with and as a part of his bid. (Attach additional pages for each section as needed.)

SECTION I EXPERIENCE QUESTIONNAIRE

1. What public works projects has your organization completed for the period of one (1) year prior to the date of the current bid?

Contract Amount	Class of Work	Completion Date	Name and Address of Owner

2. What public works projects are now in process of construction by your organization?

Contract Amount	Class of Work	Completion Date	Name and Address of Owner

3. Have you ever failed to complete any work awarded to you?_____If so, where and why?

4. List references from private firms for which you have performed work.

SECTION II PLAN AND EQUIPMENT QUESTIONNAIRE

1. Explain your plan or layout for performing proposed Work. (Examples could include a narrative of when you could begin, complete the project, number of workers, etc. and any other information which you believe would enable the governmental unit to consider your bid.)

2. Please list the names and addresses of all subcontractors (i.e. persons or firms outside your own firm who have performed part of the work) that you have used on public works projects during the past five (5) years along with a brief description of the work done by each subcontractor.

3. If you intend to sublet any portion of the work, state the name and addresses of each subcontractor, equipment to be used by the subcontractor, and whether you will required a bond. However, if you are unable to currently provide a listing, please understand a listing must be provided prior to contract approval. Until the completion of the proposed project, you are under a continuing obligation to immediately notify the governmental unit in the event that you subsequently determine that you will use a subcontractor on the proposed project.

4. What equipment do you have available to use for the proposed Project? Any equipment used by subcontractors may also be required to be listed by the governmental unit.

5. Have you into contracts or received offers for all materials which substantiate the prices used in preparing your proposal? If not, please explain the rationale used which corroborate the process listed.

SECTION III CONTRACTOR'S FINANCIAL STATEMENT

Attachment of Bidder's financial statement is mandatory. Any Bid submitted without said financial statement as required by statute shall thereby be rendered invalid. The financial statement provided hereunder to the governing body awarding the Contract must be specific enough in detail so that said governing body can make a proper determination of the Bidder's capability for completing the Project if awarded.

SECTION IV CONTRACTOR NON-COLLUSION AFFIDAVIT

The undersigned Bidder or agent, being duly sworn on oath, says that he has not, nor has any other member, representative, or agent of the firm, company, corporation or partnership represented by him, entered into any combination, collusion or agreement with any person relative to the price to be bid by anyone at such letting nor to prevent any person from bidding nor to induce anyone to refrain from bidding, and that this Bid is made without reference to any other bid and without any agreement, understanding or combination with any other person in reference to such bidding.

He further says that no person or persons, firms, or corporations has, have, or will receive directly or indirectly, any rebate, fee, gift, commission, or thing of value on account of such contract.

SECTION V OATH AND AFFIRMATION

I HEREBY AFFIRM UNDER THE PENALTIES OF PERJURY THAT THE FACTS AND INFORMATION CONTAINED IN THE FOREGOING BID FOR PUBLIC WORKS ARE TRUE AND CORRECT

Dated at _____ this _____ day of _____, 20

(Name of Organization)

By

(Title of Person Signing)

ACKNOWLEDGEMENT

STATE OF _____)
) SS:
COUNTY OF _____)

Before me, a Notary Public, personally appeared the above-named

Swore that the statements contained in the foregoing document are true and correct.

Subscribed and sworn to before me this _____ day of _____,

(Title)

Notary Public

My Commission Expires: _____

County of Residence: _____

END OF SECTION 00 31 00

SECTION 01 23 00 - ALTERNATES

PART 1 - GENERAL

1.01 RELATED DOCUMENTS

- A. Drawings and general provisions of the Contract, including amended General Conditions and other Division 1 Specification Sections, apply to work of this Section.

1.02 PURPOSE

- A. The Bids for the Alternates described herein are required in order for the Owner to obtain information necessary for the proper consideration of the Project in its entirety.

1.03 ALTERNATES

- A. Definitions: Alternates are defined as alternate products, materials, equipment, installations or systems for the Work, which may, at Owner's option and under terms established by Instructions to Bidders, be selected and recorded in the Owner-Contractor Agreement to either supplement or displace corresponding basic requirements of Contract Documents. Alternates may or may not substantially change scope and general character of the Work; and must not be confused with "allowances", "unit prices", "change orders", "substitutions", and other similar provisions.

1.04 SCHEDULE OF ALTERNATES

- A. ALTERNATE NO. 1: WC-01 AREA D
 - 1. Base Bid: Provide PT-24 painted walls indicated on sheets ID3.1D, ID6.04 and ID6.11.
 - 2. Alternate: State cost to provide materials, labor, and equipment to provide WC-01 at walls indicated on sheets ID3.1D, ID6.04 and ID6.11.
- B. ALTERNATE NO. 2: WC-08 BALLROOM
 - 1. Base Bid: Provide PT-02 painted Ballroom walls indicated on sheets ID3.1F and ID6.10.
 - 2. Alternate: State cost to provide materials, labor, and equipment to provide WC-08 at Ballroom walls indicated on sheets ID3.1F and ID6.10.

C. ALTERNATE NO. 3: WC—07 MEETING ROOMS AND PREFUNCTION

1. Base Bid: Provide PT-01 painted Meeting Room and Prefunction walls indicated on sheets ID3.1F, ID6.06, and ID6.08.
2. Alternate: State cost to provide materials, labor, and equipment to provide WC-07 at Meeting Room and Prefunction walls indicated on sheets ID3.1F, ID6.06, and ID6.08.

D. ALTERNATE NO. 4: WC-01 CORRIDOR E119

1. Base Bid: Provide PT-24 painted Corridor E119 walls indicated on sheets ID3.1E and ID6.04.
2. Alternate: State cost to provide materials, labor, and equipment to provide WC-01 at Corridor E119 walls indicated on sheets ID3.1E and ID6.04.

E. ALTERNATE NO. 5: T-13/T-23 POOL LOCKER WALLS

1. Base Bid: Provide HPC-01 and HPC-03 painted walls at Pool Locker Room C113 indicated on sheets ID3.1C, ID6.12 and ID6.13.
2. Alternate: State cost to provide materials, labor, and equipment to provide T-13 and T-23 tile walls at Pool Locker Room C113 indicated on sheets ID3.1C, ID6.12 and ID6.13.

F. ALTERNATE NO. 6: VWC-03 GUEST ROOM CORRIDORS

1. Base Bid: Provide PT-25 painted walls at the Area A Guest Room Corridors indicated on sheets ID6.17, ID6.18 and ID6.19.
2. Alternate: State cost to provide materials, labor, and equipment to provide VWC-03 at the Area A Guest Room Corridors indicated on sheets ID6.17, ID6.18 and ID6.19.

G. ALTERNATE NO. 7: PAINTED WOOD CLADDING

1. Base Bid: Provide HPC paint at all exposed tube steel, both vertical and horizontal, at the Ballroom ceiling indicated on sheet ID4.1F. Paint color to be selected by Architect.
2. Alternate: State cost to provide materials, labor, and equipment to provide painted wood cladding at all exposed tube steel, both vertical and horizontal, at the Ballroom ceiling indicated on sheet ID4.1F.

H. ALTERNATE NO. 8: STAINED WOOD VENEER CLADDING

1. Base Bid: Provide HPC paint at all exposed tube steel, both vertical and horizontal, at the Ballroom ceiling indicated on sheet ID4.1F. Paint color to be selected by Architect.
2. Alternate: State cost to provide materials, labor, and equipment to provide stained wood veneer cladding at all exposed tube steel, both vertical and horizontal, at the Ballroom ceiling indicated on sheet ID4.1F.

I. ALTERNATE NO. 9: SHOWER BENCHES

1. Base Bid: No shower bench included – Provide continuous shower pan to back wall of shower.
2. Alternate: Shower bench with stone finish on top and sides. Stone edges to be mitered. All exposed edges to be eased off.

PART 2 - PRODUCTS, PART 3 - EXECUTION (Not Used)

END OF SECTION 01 23 00

ADDENDUM

Project:	New Lodge: Potato Creek State Park North Liberty, Indiana	Addendum No.:	008
		Date:	October 24, 2025
Owner:	State of Indiana Department of Natural Resources	Project Number:	2111-295
		DAPW #	71013000-22-003-01
		Contract for:	All Disciplines

The original specifications dated September 2023 and the drawings dated September 2025 for the project noted above are amended as noted in this Addendum Number 008. Receipt of this addendum and any subsequent addenda must be acknowledged on the final bid documents. This addendum consists of Seven (7) items and zero (0) attachments.

8-1 QUESTIONS AND ANSWERS:

Q: 06 20 23.A1 INTERIOR WOOD TRIM referenced on drawings; On the Bid Cat and spec its 06 40 23 Interior Architectural Woodwork

A: All references to Keynote 06 20 23.A1 should read 06 40 23.

Q: In the main lobby d102, is the tl-02 tile just in the area that is highlighted?

A: Tile T-02 only occurs at the center of the Main Lobby as indicated by alternate hatch pattern on Finish Plan - ID-3.1D. The accent tile - T-02 - is to be in a staggered feature of approximately 7'-4" wide as indicted on drawings. Tile T-01 is to be cut to fit into staggered feature.

Please note Tile T-02 also occurs in the Dining Room - E118.

Q: We need elevations for the wall tiles t04/t05 in multipurpose room d116.

A: Wall Tile T-04 & T-05 are shown in Elevation 1 / ID6.03 and Elevation 2 / ID9.03. Tile to be installed in stack bond running vertically.

Q: Public restrooms d117/118-----vanity wall tile is sown to be t03 on id7.02 and t-09 on id7.05. Please clarify.

A: Vanity Wall Tile - T-09 - has been eliminated from the project in VE Revisions. Wall above stone to be painted.

Q: We need elevation for t-07 wall tile on buffet wall.

A: Tile T-07 is a 6"x10" tile to be installed in a 1/3 offset running bond pattern across the full width and height of the wall (approximately 29'-8" Wide X 9'-0" High).

Q: Substitution request Artifex Enterprises LLC, dba Custom Millwork and Display for Sections 064023; 064116; 123661.16; 123661.19; 123663

A: No exception taken by IIG. No exceptions taken by Hafer.

Q: In regards to tile base tl-03 [base for guestroom baths]. Elevations show a 4" piece. Should this just be a cut tile or a cut with a schluter cap on top?

A: Base to be cut tile with a schluter strip - TS-01.

Q: Please clarify what the finish at these shower curbs is intended to be.

A: Shower curbs to be Quartz - ST-08.

Q: TL-10 is shown as wall tile in rooms d117/d118 but there is no designation for this tile on the material finish schedule.

A: There is an error in the revised Finish Schedule

T-09 was to be eliminated from the project

T-10 remains in the project – Please see spec for T-10 below

T-10

CERAMIC TECHNICS

PRODUCT: ALTAMIRA MOROCCO

COLOR: TERRACOTTA

SIZE: 6" X 6"

THICKNESS: 7MM

GROUT JOINT: 1/8"

GROUT: MAPEI

GROUT COLOR: TBD

FINISH: GLOSSY

CONTACT

TIMOTHY CURRY

(312) 579-7415

TCURRY@CERAMICTECHNICS.COM

Attachments: n/a

By: Luke Johnson, Marc Fugnitto

CC: Jeff Justice, Jennifer Kissel, Tom Blythe, Chris Muvceski

BACK OF HOUSE FINISH LEGEND:



MATERIAL TAG	MATERIAL INFO	DESCRIPTION
064116	PLASTIC-LAMINATE-CLAD ARCHITECTURAL CABINETS	
PL-01	MFG: WILSONART STYLE: NMBR COLOR:	CABINETS @ BOH
095123	ACOUSTICAL TILE CEILINGS	
ACT-02	MFG: ARMSTRONG STYLE: CIRRIUS SQUARE LAY-IN COLOR: WHITE NMBR: 574 SIZE: 24"L X 24"W X 3/4"D GRID: 15/16" PRELUDE SUSPENSION SYSTEM	ACOUSTICAL CEILING TILE @ BOH
ACT-03	MFG: ARMSTRONG STYLE: KITCHEN ZONE COLOR: WHITE NMBR: 673 SIZE: 24"L X 24"W X 5/8"D GRID: 15/16" PRELUDE SUSPENSION SYSTEM NOTE: USE CLIP DOWN SYSTEM	ACOUSTICAL CEILING TILE @ BOH KITCHEN
096513	RESILIENT BASE AND ACCESSORIES	
RB-03	MFG: JOHNSONITE / TARKETT STYLE: TRADITIONAL VINYL NMBR: MW XX F COLOR: 29 MOONROCK SIZE: 4-1/8" H	RUBBER BASE @ BOH
096723	RESINOUS FLOORING	
RF-01	MFG: SHERWIN WILLIAMS STYLE: FASTOP MULTI TOP FLOOR SL45 FLOOR COATING	FLOORING @ BOH KITCHEN
RF-02	MFG: SHERWIN WILLIAMS STYLE: RESUFLOOR 3746	FLOORING @ LAUNDRY AND SERVICE CORRIDORS
CT-02	MFG: SHERWIN WILLIAMS STYLE: ARMORSEAL 8100 WATERBASED EPOXY FLOOR COATING	FLOORING @ MECHANICAL, STORAGE, I.T.
096813	TILE CARPETING	
CPT-05	MFG: SHAW CONTRACT STYLE: WRITTEN TILE COLOR: STORY SIZE: 9X9 INSTALLATION METHOD: STAGGER	CARPET @ BOH
WO-01	MFG: MILLIKEN STYLE: DBEX SERIES: CUTX DRIFT COLOR: TBD WIDTH: 50CM X 50CM PATTERN REPEAT: 24"-0" X 20" INSTALL: ASHLAR	WALK OFF CARPET TILE
099123	INTERIOR PAINTING	
PT-01	MFG: BENJAMIN MOORE COLOR: BALLET WHITE NMBR: CC-9	PAINT @ STAIRS
PT-17	MFG: BENJAMIN MOORE COLOR: DECORATOR'S WHITE	PAINT @ PUBLIC AREA BATHROOM CEILING AND LOCKER ROOM CEILING
PT-19	MFG: BENJAMIN MOORE COLOR: BALLET WHITE NMBR: CC-9	PAINT @ BOH AREAS
099600	HIGH PERFORMANCE COATING	
HPC-04	MFG: TNEPEC COLOR: TBD, TO MATCH SHERWIN WILLIAMS PT-18 FINISH: HIGH PERFORMANCE, TO BE COORDINATED WITH AOR	HIGH PERFORMANCE PAINT @ BOH
HPC-05	MFG: TNEPEC COLOR: TBD, TO MATCH SHERWIN WILLIAMS PT-01 FINISH: HIGH PERFORMANCE, TO BE COORDINATED WITH AOR	HIGH PERFORMANCE PAINT @ BOH
102123	CUBICLE CURTAIN (FABRIC)	
CC-01	MFG: STANDARD TEXTILE STYLE: OTHELLO COLOR: TBD WIDTH: 42", 72"	LOWER LEVEL EMPLOYEE LOCKER SHOWER CURTAINS
102600	WALL & DOOR PROTECTION	
SF-10	MFG: PANOLAM DESC.: FIBERGLASS REINFORCED PLASTIC PANEL COLOR: WHITE FINISH: EMBOSSED SUSTAINABILITY: GREENGUARD GOLD CERTIFIED THICKNESS: 0.09" SIZE: 4' X 8' PANELS; INSTALLED FULL HEIGHT	FRP @ BOH KITCHEN WALLS
SF-11	MFG: INPRO DESC.: NUTREE DIAMOND PLATE SHEET CONTENT: MEDIMUM DENSITY POLYETHYLENE (MDPE) COLOR: TBD THICKNESS: 3/16" SIZE: 4' X 8' PANELS MOUNT: 4' HIGH, ALL WALLS	WALL CHECKERPLATE @ BOH SERVICE CORRIDORS
CG-8.1	MFG: INPRO STYLE: SURFACE MOUNT SS CORNER GUARD TYPE: 304 - 16 GAUGE MATERIAL: STAINLESS STEEL LEG LENGTH: 3" HEIGHT: 4" ADHESIVE: PL PREMIUM HEAVY DUTY ADHESIVE	CORNER GUARDS @ BOH
CG-8.2	MFG: INPRO STYLE: SURFACE MOUNT SS CORNER GUARD TYPE: 304 - 16 GAUGE MATERIAL: STAINLESS STEEL LEG LENGTH: 3" HEIGHT: 4" ADHESIVE: PL PREMIUM HEAVY DUTY ADHESIVE	CORNER GUARDS @ BOH
RB-04	MFG: THE CORNER GUARD STORE STYLE: 0.60 DIAMOND PLATE ALUMINUM COVE BASE MOLDING NMBR: C6M-B-0PA-4.75-48 CONTENT: ALUMINUM SIZE: 4.75" X 4"	CHECKERPLATE WALL BASE @ SERVICE CORRIDORS
123661.13	SOLID SURFACE COUNTERTOPS	
SS-01	MFG: CORIAN NMBR: GRADE B COLOR:	COUNTERTOPS @ BOH

BACK OF HOUSE ROOM FINISH SCHEDULE

NUMBER	NAME	Level	FLOOR	BASE	N	S	E	W	CEILING MATL	COMMENTS
A050	STORAGE	LOWER FLOOR	CT-02	RB-03	PT-19	PT-19	PT-19	PT-19	ACT-02	
B052	SOILED LINEN	LOWER FLOOR	RF-02	RB-03	PT-19	PT-19	PT-19	PT-19	ACT-02	2
B053	LAUNDRY	LOWER FLOOR	RF-02	RB-03	PT-19	PT-19	PT-19	PT-19		
B054	CLEAN LINEN	LOWER FLOOR	RF-02	RB-03	PT-19	PT-19	PT-19	PT-19	ACT-02	
B055	DRYER	LOWER FLOOR	RF-02	RB-03	HPC-05	HPC-05	HPC-05	HPC-05	HPC-04	2
B056	CUSTODIAL	LOWER FLOOR	RF-02	RB-03	PT-19	PT-19	PT-19	PT-19	--	
B057	GENERAL BUILDING STORAGE	LOWER FLOOR	RF-02	RB-03	PT-19	PT-19	PT-19	PT-19		
B058	UNIFORMS	LOWER FLOOR	RF-02	RB-03	PT-19	PT-19	PT-19	PT-19	ACT-02	
B059	SUMP PUMP	LOWER FLOOR	RF-02	RB-03	HPC-05	HPC-05	HPC-05	HPC-05	--	2
B060	HOUSE KEEPING OFFICE	LOWER FLOOR	RF-02	RB-03	PT-19	PT-19	PT-19	PT-19	ACT-02	
B061	PUMP ROOM	LOWER FLOOR	RF-02	RB-03	HPC-05	HPC-05	HPC-05	HPC-05	--	2
B062	ACID RM	LOWER FLOOR	RF-02	RB-03	HPC-05	HPC-05	HPC-05	HPC-05	--	2
B063	CHLORINE	LOWER FLOOR	RF-02	RB-03	HPC-05	HPC-05	HPC-05	HPC-05	--	2
CO-B1	CORR	LOWER FLOOR	RF-02	RB-04	PT-19	PT-19	PT-19	PT-19	--	1, 2
CO-B2	CORR	LOWER FLOOR	RF-02	RB-04	PT-19	PT-19	PT-19	PT-19	--	1, 2
CO-F1	CORR	LOWER FLOOR	RF-02	RB-04	PT-19	PT-19	PT-19	PT-19	--	2
CO-F2	CORR	LOWER FLOOR	RF-02	RB-04	PT-19	PT-19	PT-19	PT-19		
CO-F3	CORR	LOWER FLOOR	RF-02	RB-03	PT-19	PT-19	PT-19	PT-19	PT-17	
CO-F4	CORR	LOWER FLOOR	RF-02	RB-04	PT-19	PT-19	PT-19	PT-19	--	2
CO-T1	TUNNEL	LOWER FLOOR	RF-02	RB-04	PT-19	PT-19	PT-19	PT-19	--	2
CO-T2	TUNNEL	LOWER FLOOR	RF-02	RB-04	PT-19	PT-19	PT-19	PT-19	--	2
DO-B	DATA	LOWER FLOOR	CT-02	RB-03	PT-19	PT-19	PT-19	PT-19	--	2
DO-F	DATA	LOWER FLOOR	CT-02	RB-03	PT-19	PT-19	PT-19	PT-19	--	2
EO-A	ELEC	LOWER FLOOR	CT-02	RB-03	PT-19	PT-19	PT-19	PT-19	--	2
EO-B1	ELEC	LOWER FLOOR	CT-02	RB-03	PT-19	PT-19	PT-19	PT-19	--	2
EO-B2	POOL EQUIP ELEC	LOWER FLOOR	RF-02	RB-03	PT-19	PT-19	PT-19	PT-19	--	2
EO-F1	ELEC	LOWER FLOOR	CT-02	RB-03	PT-19	PT-19	PT-19	PT-19	--	2
EO-F2	ELEC	LOWER FLOOR	RF-02	RB-03	PT-19	PT-19	PT-19	PT-19	--	2
F070	STORAGE	LOWER FLOOR	CT-02	RB-03	PT-19	PT-19	PT-19	PT-19	--	2
F071	JAN / STOR	LOWER FLOOR	CT-02	RB-03	PT-19	PT-19	PT-19	PT-19		
F072	BREAK ROOM	LOWER FLOOR	RF-02	RB-03	PT-19	PT-19	PT-19	PT-19	ACT-02	
F073	WOMEN'S LOCKER	LOWER FLOOR	RF-02	RB-03	PT-19	PT-19	PT-19	PT-19	ACT-02/PT-17	
F073B	CLOSET	LOWER FLOOR	CT-02	RB-03	PT-19	PT-19	PT-19	PT-19	--	2
F074	BATHROOM	LOWER FLOOR	CT-02	RB-03	HPC-05	HPC-05	HPC-05	HPC-05	HPC-04	
F075	MEN'S LOCKER	LOWER FLOOR	RF-02	RB-03	PT-19	PT-19	PT-19	PT-19	ACT-02/PT-17	
F076	RECEIVE	LOWER FLOOR	RF-02	RB-03	PT-19	PT-19	PT-19	PT-19	--	2
F077	FIRE PUMP	LOWER FLOOR	RF-02	RB-03	PT-19	PT-19	PT-19	PT-19	--	2
F078	MECH	LOWER FLOOR	RF-02	RB-03	PT-19	PT-19	PT-19	PT-19	--	2
F079	OFFICES	LOWER FLOOR	RF-02	RB-03	PT-19	PT-19	PT-19	PT-19	--	2
F080	OFFICE	LOWER FLOOR	CPT-05	RB-03	PT-19	PT-19	PT-19	PT-19	ACT-02	
F081	STORAGE	LOWER FLOOR	RF-02	RB-03	PT-19	PT-19	PT-19	PT-19		
S-A	STAIR A	LOWER FLOOR	CPT-01	RB-03	PT-01	PT-01	PT-01	PT-01	PT-17	
S-F	STAIR	LOWER FLOOR	CT-02	RB-03	PT-19	PT-19	PT-19	PT-19	PT-17	
A150	CORR	1ST FLOOR	WO-01	RB-03	PT-01	PT-01	PT-01	PT-01	ACT-02	
B152	LINEN	1ST FLOOR	RF-02	RB-03	PT-19	PT-19	PT-19	PT-19	ACT-02	
C101	CORR	1ST FLOOR	WO-01	PT-01	PT-01	PT-01	PT-01	PT-01	ACT-02	
C105	CL	1ST FLOOR	RF-02	RB-03	HPC-05	HPC-05	HPC-05	HPC-05	HPC-04	2
C106	JAN	1ST FLOOR	RF-02	RB-03	HPC-05	HPC-05	HPC-05	HPC-05	HPC-04	2
C114	STORAGE	1ST FLOOR	RF-02	RB-03	HPC-05	HPC-05	HPC-05	HPC-05	--	2
D1-A3	DATA	1ST FLOOR	CT-02	RB-03	PT-19	PT-19	PT-19	PT-19		
D1-F	DATA	1ST FLOOR	CT-02	RB-03	PT-19	PT-19	PT-19	PT-19	ACT-02	
D105	WORK ROOM	1ST FLOOR	CPT-05	RB-03	PT-19	PT-19	PT-19	PT-19	ACT-02	
D106	CASHIER	1ST FLOOR	CPT-05	RB-03	PT-19	PT-19	PT-19	PT-19	ACT-02	
D107	WORK ROOM	1ST FLOOR	CPT-05	RB-03	PT-19	PT-19	PT-19	PT-19	ACT-02	
D108	GENERAL MANAGER	1ST FLOOR	CPT-05	RB-03	PT-19	PT-19	PT-19	PT-19	ACT-02	
D109	ASST. MGR.	1ST FLOOR	CPT-05	RB-03	PT-19	PT-19	PT-19	PT-19	ACT-02	
D110	MDF	1ST FLOOR	CPT-05	RB-03	PT-19	PT-19	PT-19	PT-19	ACT-02	
D111	STORAGE	1ST FLOOR	CPT-05	RB-03	PT-19	PT-19	PT-19	PT-19	ACT-02	
D112	ACCOUNTING & HR	1ST FLOOR	CPT-05	RB-03	PT-19	PT-19	PT-19	PT-19	ACT-02	
D120	JAN CL	1ST FLOOR	CT-02	RB-03	PT-19	PT-19	PT-19	PT-19	ACT-02	
D123	STORAGE	1ST FLOOR	CT-02	RB-03	PT-19	PT-19	PT-19	PT-19	ACT-02	
E1-A	ELEC	1ST FLOOR	CT-02	RB-03	PT-19	PT-19	PT-19	PT-19	--	2
E1-B	ELEC	1ST FLOOR	CT-02	RB-03	PT-19	PT-19	PT-19	PT-19	--	2
E117	KITCHEN	1ST FLOOR	RF-01	RF-01	SF-10/PT-19	SF-10/PT-19	SF-10/PT-19	SF-10/PT-19	ACT-03	
F101	BOH CORRIDOR	1ST FLOOR	RF-02	RB-04	PT-19	PT-19	PT-19	PT-19	ACT-02	1
F102	PANTRY	1ST FLOOR	RF-02	RB-03	PT-19	PT-19	PT-19	PT-19	ACT-03	
F106	STORAGE	1ST FLOOR	RF-02	RB-03	PT-19	PT-19	PT-19	PT-19	ACT-02	
F113	ELEV LOBBY	1ST FLOOR	RF-02	RB-03	PT-19	PT-19	PT-19	PT-19	ACT-02	1
F114	STORAGE	1ST FLOOR	CT-02	RB-03	PT-19	PT-19	PT-19	PT-19	ACT-02	
F115	BOH CORRIDOR	1ST FLOOR	RF-02	RB-03	PT-19	PT-19	PT-19	PT-19	ACT-03	1
F116	STORAGE	1ST FLOOR	RF-02	RB-03	PT-19	PT-19	PT-19	PT-19	ACT-02	
F117	STORAGE	1ST FLOOR	RF-02	RB-03	PT-19	PT-19	PT-19	PT-19	ACT-02	
RA-D	ROOF ACCESS	1ST FLOOR	CT-02	RB-03	PT-19	PT-19	PT-19	PT-19	--	2
RA-F	ROOF ACCESS	1ST FLOOR	CT-02	RB-03	PT-19	PT-19	PT-19	PT-19	--	2
S-B	STAIR B	1ST FLOOR	CPT-01	RB-03	PT-01	PT-01	PT-01	PT-01	PT-17	
S-F	STAIR F	1ST FLOOR	CT-02	RB-03	PT-19	PT-19	PT-19	PT-19	ACT-02	
A250	STORAGE	2ND FLOOR	CT-02	RB-03	PT-19	PT-19	PT-19	PT-19	ACT-02	3
B252	LINEN	2ND FLOOR	CT-02	RB-03	PT-19	PT-19	PT-19	PT-19	ACT-02	3
B260	ELEC	2ND FLOOR	CT-02	RB-03	PT-19	PT-19	PT-19	PT-19	--	2
D2-AB	DATA	2ND FLOOR	CT-02	RB-03	PT-19	PT-19	PT-19	PT-19	--	2
E2-A	ELEC	2ND FLOOR	CT-02	RB-03	PT-19	PT-19	PT-19	PT-19	--	2
E2-B	ELEC	2ND FLOOR	CT-02	RB-03	PT-19	PT-19	PT-19	PT-19	--	2
A350	STORAGE	3RD FLOOR	CT-02	RB-03	PT-19	PT-19	PT-19	PT-19	ACT-02	
B352	LINEN	3RD FLOOR	CT-02	RB-03	PT-19	PT-19	PT-19	PT-19	ACT-02	
B360	ELEC	3RD FLOOR	CT-02	RB-03	PT-19	PT-19	PT-19	PT-19	--	2
D3-AB	DATA	3RD FLOOR	CT-02	RB-03	PT-19	PT-19	PT-19	PT-19	--	2
E3-A	ELEC	3RD FLOOR	CT-02	RB-03	PT-19	PT-19	PT-19	PT-19	--	2
M3-B1	EQUIP DECK	EQUIPMENT DECK	CT-02	RB-03	PT-19	PT-19	PT-19	PT-19	--	2
M3-B2	PASSAGE	EQUIPMENT DECK	CT-02	RB-03	PT-19	PT-19	PT-19	PT-19	--	2

GENERAL INTERIOR FINISH NOTES

- REFER TO REMAINDER OF ID SHEETS FOR FRONT OF HOUSE FINISHES.
- ALL INTERIORS NOTES, SCHEDULES AND LEGENDS REFERENCE ABCD LEGEND. REFER TO VIEW HEADER OF ROOM FINISH SCHEDULE.
- PROVIDE RESILIENT OR METAL TRANSITION STRIP AT ALL FLOORING MATERIAL JUNCTURES. WHERE MATERIALS TRANSITION AT DOORS CENTER OF TRANSITION TO BE LOCATED ON CENTER OF DOOR. REFER TO DETAILS FOR TYPICAL FLOOR MATERIAL TRANSITIONS. COLOR SELECTED BY ARCHITECT FROM MANUFACTURES FULL RANGE OF COLORS.
- ALL EXPOSED GYP. CEILINGS AS WELL AS UNDERSIDE AND FACES OF BULKHEADS, AND SOFFITS TO BE PAINTED, REFER TO FINISH SCHEDULE FOR CEILING FINISHES AND REFLECTED CEILING PLANS FOR CEILING MATERIAL EXTENTS AND FINISH REQUIREMENTS. COORDINATE ANY PAINT FINISHES WITH ARCHITECT IN FIELD BEFORE PROCEEDING WITH FINISH WORK.
- REFER TO DOOR SCHEDULE FOR CLARIFICATION OF DOOR MATERIALS. ALL HOLLOW METAL DOORS AND HOLLOW METAL FRAMES TO BE PAINTED BOTH SIDES. [PT TBD]
- ALL EXPOSED GYP WALLS TO BE PAINTED UNLESS NOTED OTHERWISE.
- ALL DIFFUSERS TO BE PAINTED TO MATCH ADJACENT WALL FINISH. VERIFY COLOR WITH ARCHITECT IN FIELD.
- PAIN FINISH SHEEN SCHEDULE: WALLS - EGGSHELL, ACRYLIC LATEX; HOLLOW METAL DOORS AND FRAMES - SEMI

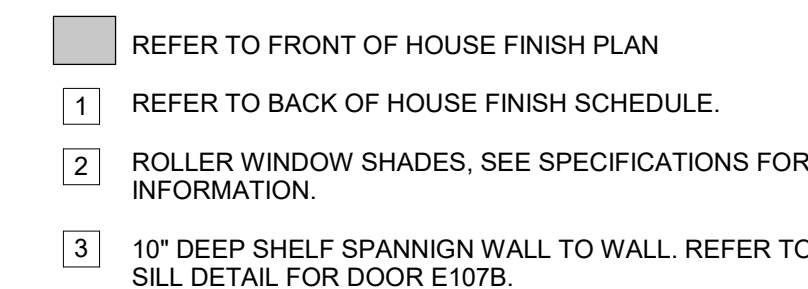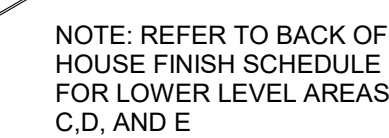
$$\frac{1}{8}'' = 1'-0''$$

$$\frac{1}{8}'' = 1'-0''$$

In association with:

Associate Architect:



319 N. Main, Suite 200
Springfield, MO 65806
T: 417.865.6100

T: 417.865.61

Interior Design:



10681 Beacon Hill Drive
Crown Point, IN 46307
T: 219.322.7841

Civil/Structural Engineering



9365 Counselors Row
Suite 116
Indianapolis, IN 46240
T: 317.617.4270

Landscape Architect:



618 E. Market St.
Indianapolis, IN 46202
T: 317.263.0127

Aquatics Design:




100 Park Avenue
Beaver Dam, WI 53910
T: 920.887.7375

Food Service:



302 N. East Street
Studio One
Indianapolis, IN 46202
T: 317.637.3204

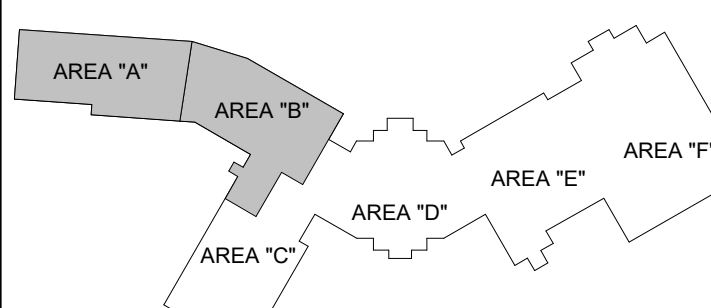

KEY PLAN





**BID SET
SEPTEMBER, 2023**

Revisions

[illegible]

Designed By

Drawn By	
----------	--

Checked By	
------------	--

The drawings, specifications and other documents, including those in electronic form prepared by Hafer for this project are instruments of service and may be used solely in respect to this project. The documents may be reproduced or modified by a third party without first obtaining the express written consent of Hafer. Authorized use of electronic media or file does guarantee that these files contain complete and accurate information. In order to insure the accuracy of the information contained and that no changes or modifications have been made, these files must be compared to the project's contract documents with stamped and sealed certification and applicable approved modifications.

Sheet title:

LOWER LEVEL BACK-OF-HOUSE
AREA 'A' & 'B' FINISH PLAN

Architect's Project No:

Date:

2111-295

September, 2023

Drawing No:

ID2.5

In association with:

Associate Architect:



319 N. Main, Suite 200
Springfield, MO 65806
T: 417.865.6100

Interior Design:



10681 Beacon Hill Drive
Crown Point, IN 46307
T: 219.322.7841

Civil/Structural Engineering:



9365 Counsellors Row
Suite 116
Indianapolis, IN 46240
T: 317.617.4270

Landscape Architect:



618 E. Market St.
Indianapolis, IN 46202
T: 317.263.0127

Aquatics Design:



100 Park Avenue
Beaver Dam, WI 53916
T: 920.887.7375


Food Service:



302 N. East Street
Studio One
Indianapolis, IN 46202
T: 317.637.3204


BACK OF HOUSE FINISH PLAN
REFERENCE NOTES:

- REFER TO FRONT OF HOUSE FINISH PLAN
- 1 REFER TO BACK OF HOUSE FINISH SCHEDULE.
- 2 ROLLER WINDOW SHADES, SEE SPECIFICATIONS FOR INFORMATION.
- 3 10" DEEP SHELF SPANNIGN WALL TO WALL. REFER TO SILL DETAIL FOR DOOR E107B.

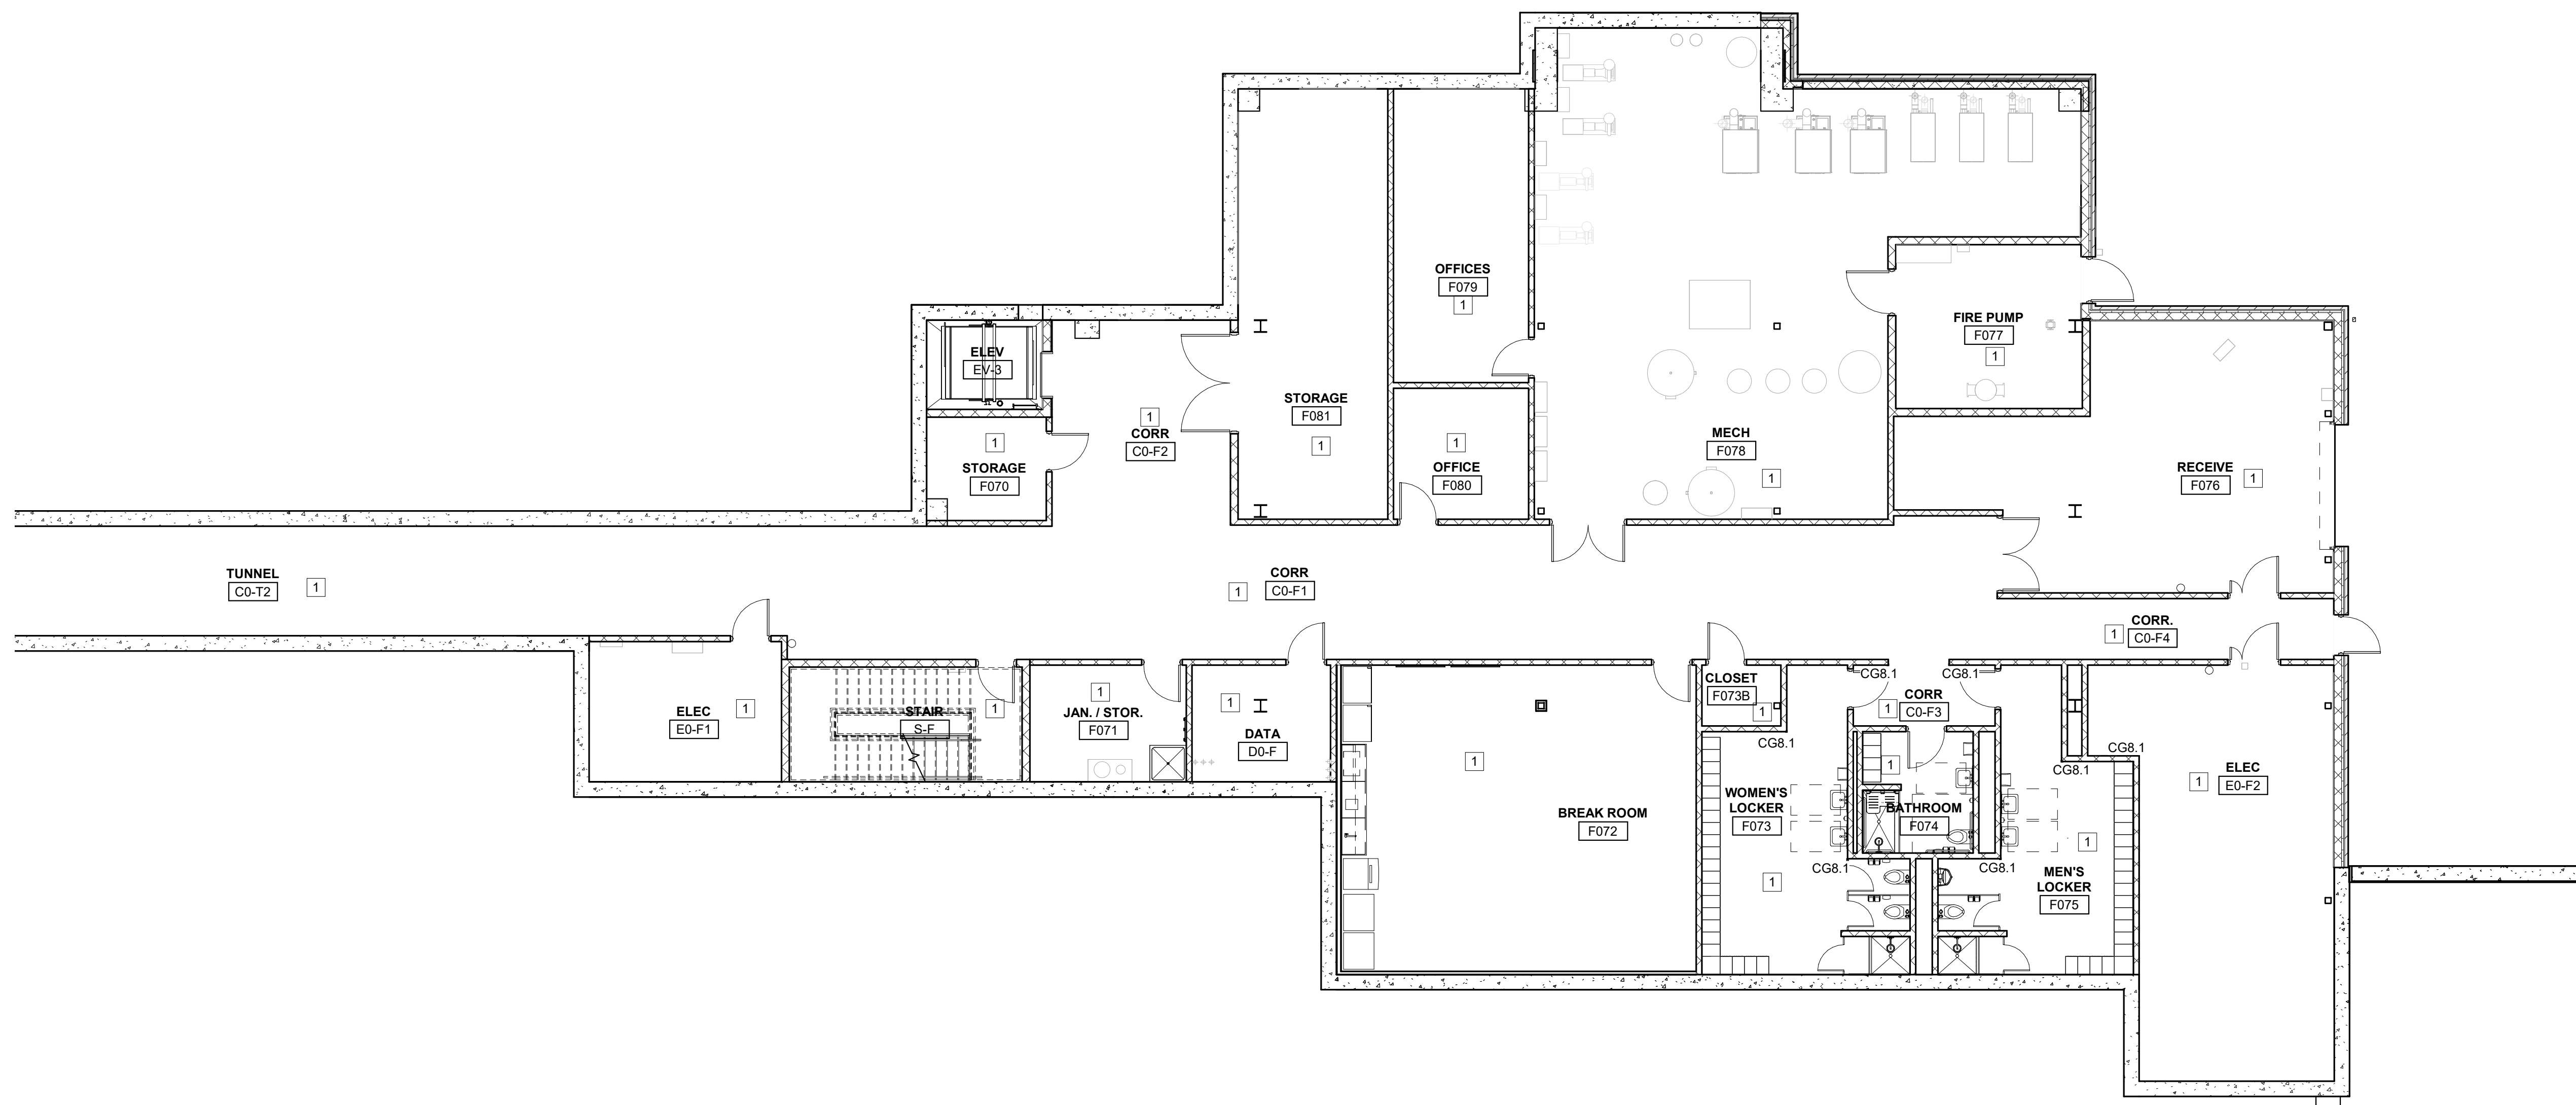


1 LOWER LEVEL BACK OF HOUSE FINISH PLAN - AREA 'F'

1/8" = 1'-0"

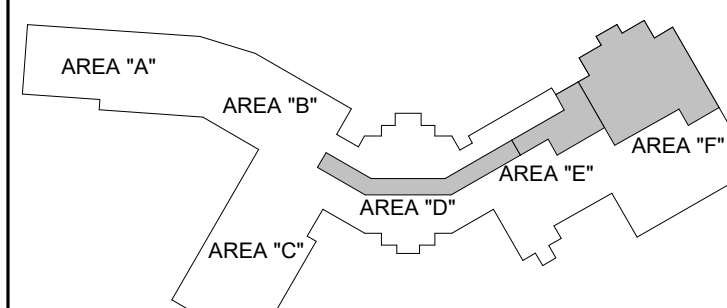

KEY PLAN

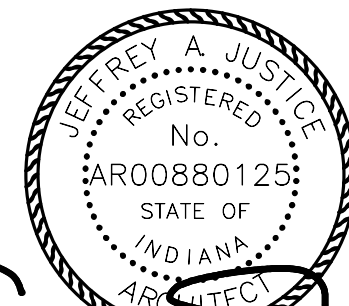

Jeffrey A. Justel

BID SET
SEPTEMBER, 2023

Revisions:		
#	Description	Date

Designed By:	Drawn By:	Checked By:

The drawings, specifications and other documents, including those in electronic form prepared by Hafer for this project are instruments of Service, and may be used solely with respect to this project. The documents may not be reproduced or modified by a third party without first obtaining the express written consent of Hafer. Authorized use of electronic media or file does not guarantee that these files contain complete and accurate information. In order to insure the accuracy of the information contained and that no changes or modifications have been made, these files must be compared to the project's contract documents with stamped and sealed certification and applicable approved modifications.

Sheet title:

LOWER LEVEL BACK-OF-HOUSE
AREA 'F'

Architect's Project No: Date:

2111-295 September, 2023

Drawing No:

ID2.6

In association with:

Associate Architect:



319 N. Main, Suite 200
Springfield, MO 65806
T: 417.865.6100

Interior Design:



10681 Beacon Hill Drive
Crown Point, IN 46307
T: 219.322.7841

Civil/Structural Engineering:



9365 Counselors Row
Suite 116
Indianapolis, IN 46240
T: 317.617.4270

Landscape Architect:



618 E. Market St.
Indianapolis, IN 46202
T: 317.263.0127

Aquatics Design:




100 Park Avenue
Beaver Dam, WI 53916
T: 920.887.7375

Food Service:



302 N. East Street
Studio One
Indianapolis, IN 46202
T: 317.637.3204

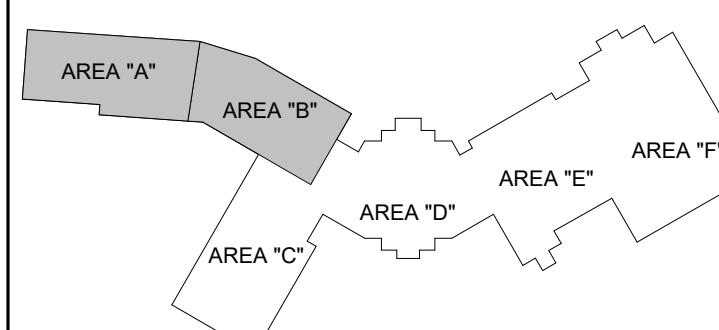

KEY PLAN



Jeffrey A. Justel

BID SET
SEPTEMBER, 2023

Revisions:		
#	Description	Date
1	PR-006	07/26/24

Designed By: Drawn By: Checked By:

The drawings, specifications and other documents, including those in electronic form prepared by Haffer for this project are instruments of Service, and may be used solely with respect to this project. The documents may not be reproduced or modified by a third party without first obtaining the express written consent of Haffer. Authorized use of electronic media or file does not guarantee that these files contain complete and accurate information. In order to insure the accuracy of the information contained and that no changes or modifications have been made, these files must be compared to the project's contract documents with stamped and sealed certification and applicable approved modifications.

Sheet title:

FIRST FLOOR BACK-OF-HOUSE
AREA 'A' & 'B' FINISH PLANS

Architect's Project No: Date:


2111-295 September, 2023

Drawing No:

ID2.7


BACK OF HOUSE FINISH PLAN
REFERENCE NOTES:

- REFER TO FRONT OF HOUSE FINISH PLAN
- REFER TO BACK OF HOUSE FINISH SCHEDULE.
- ROLLER WINDOW SHADES, SEE SPECIFICATIONS FOR INFORMATION.
- 10" DEEP SHELF SPANNING WALL TO WALL. REFER TO SILL DETAIL FOR DOOR E107B.

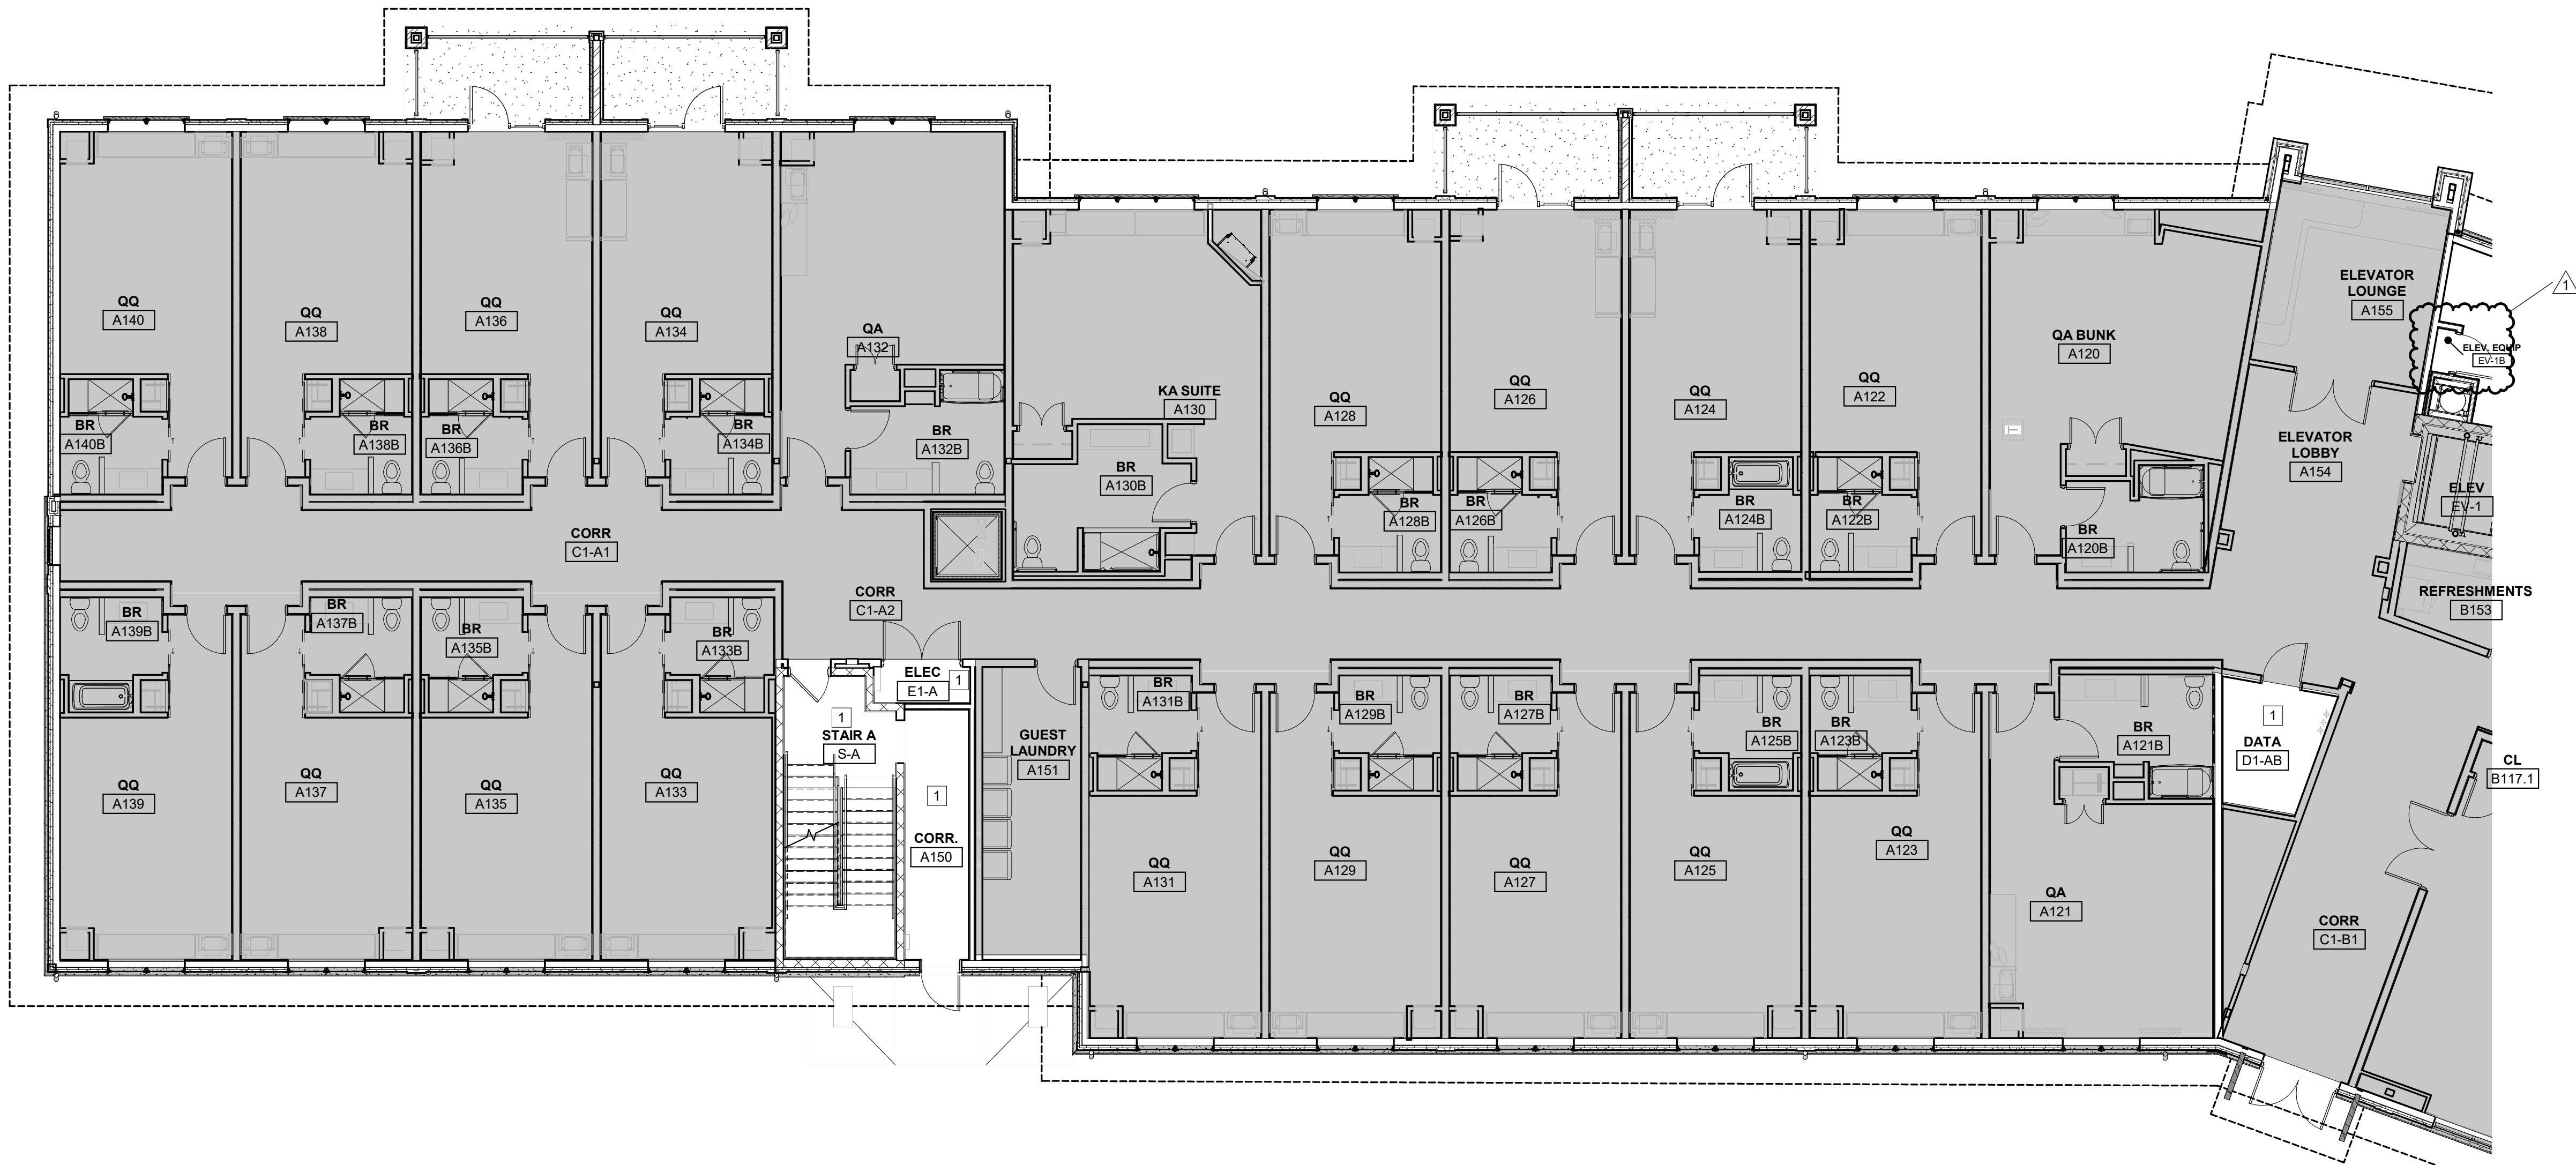


FIRST FLOOR BACK OF HOUSE FINISH PLAN - AREA 'A'

1/8" = 1'-0"

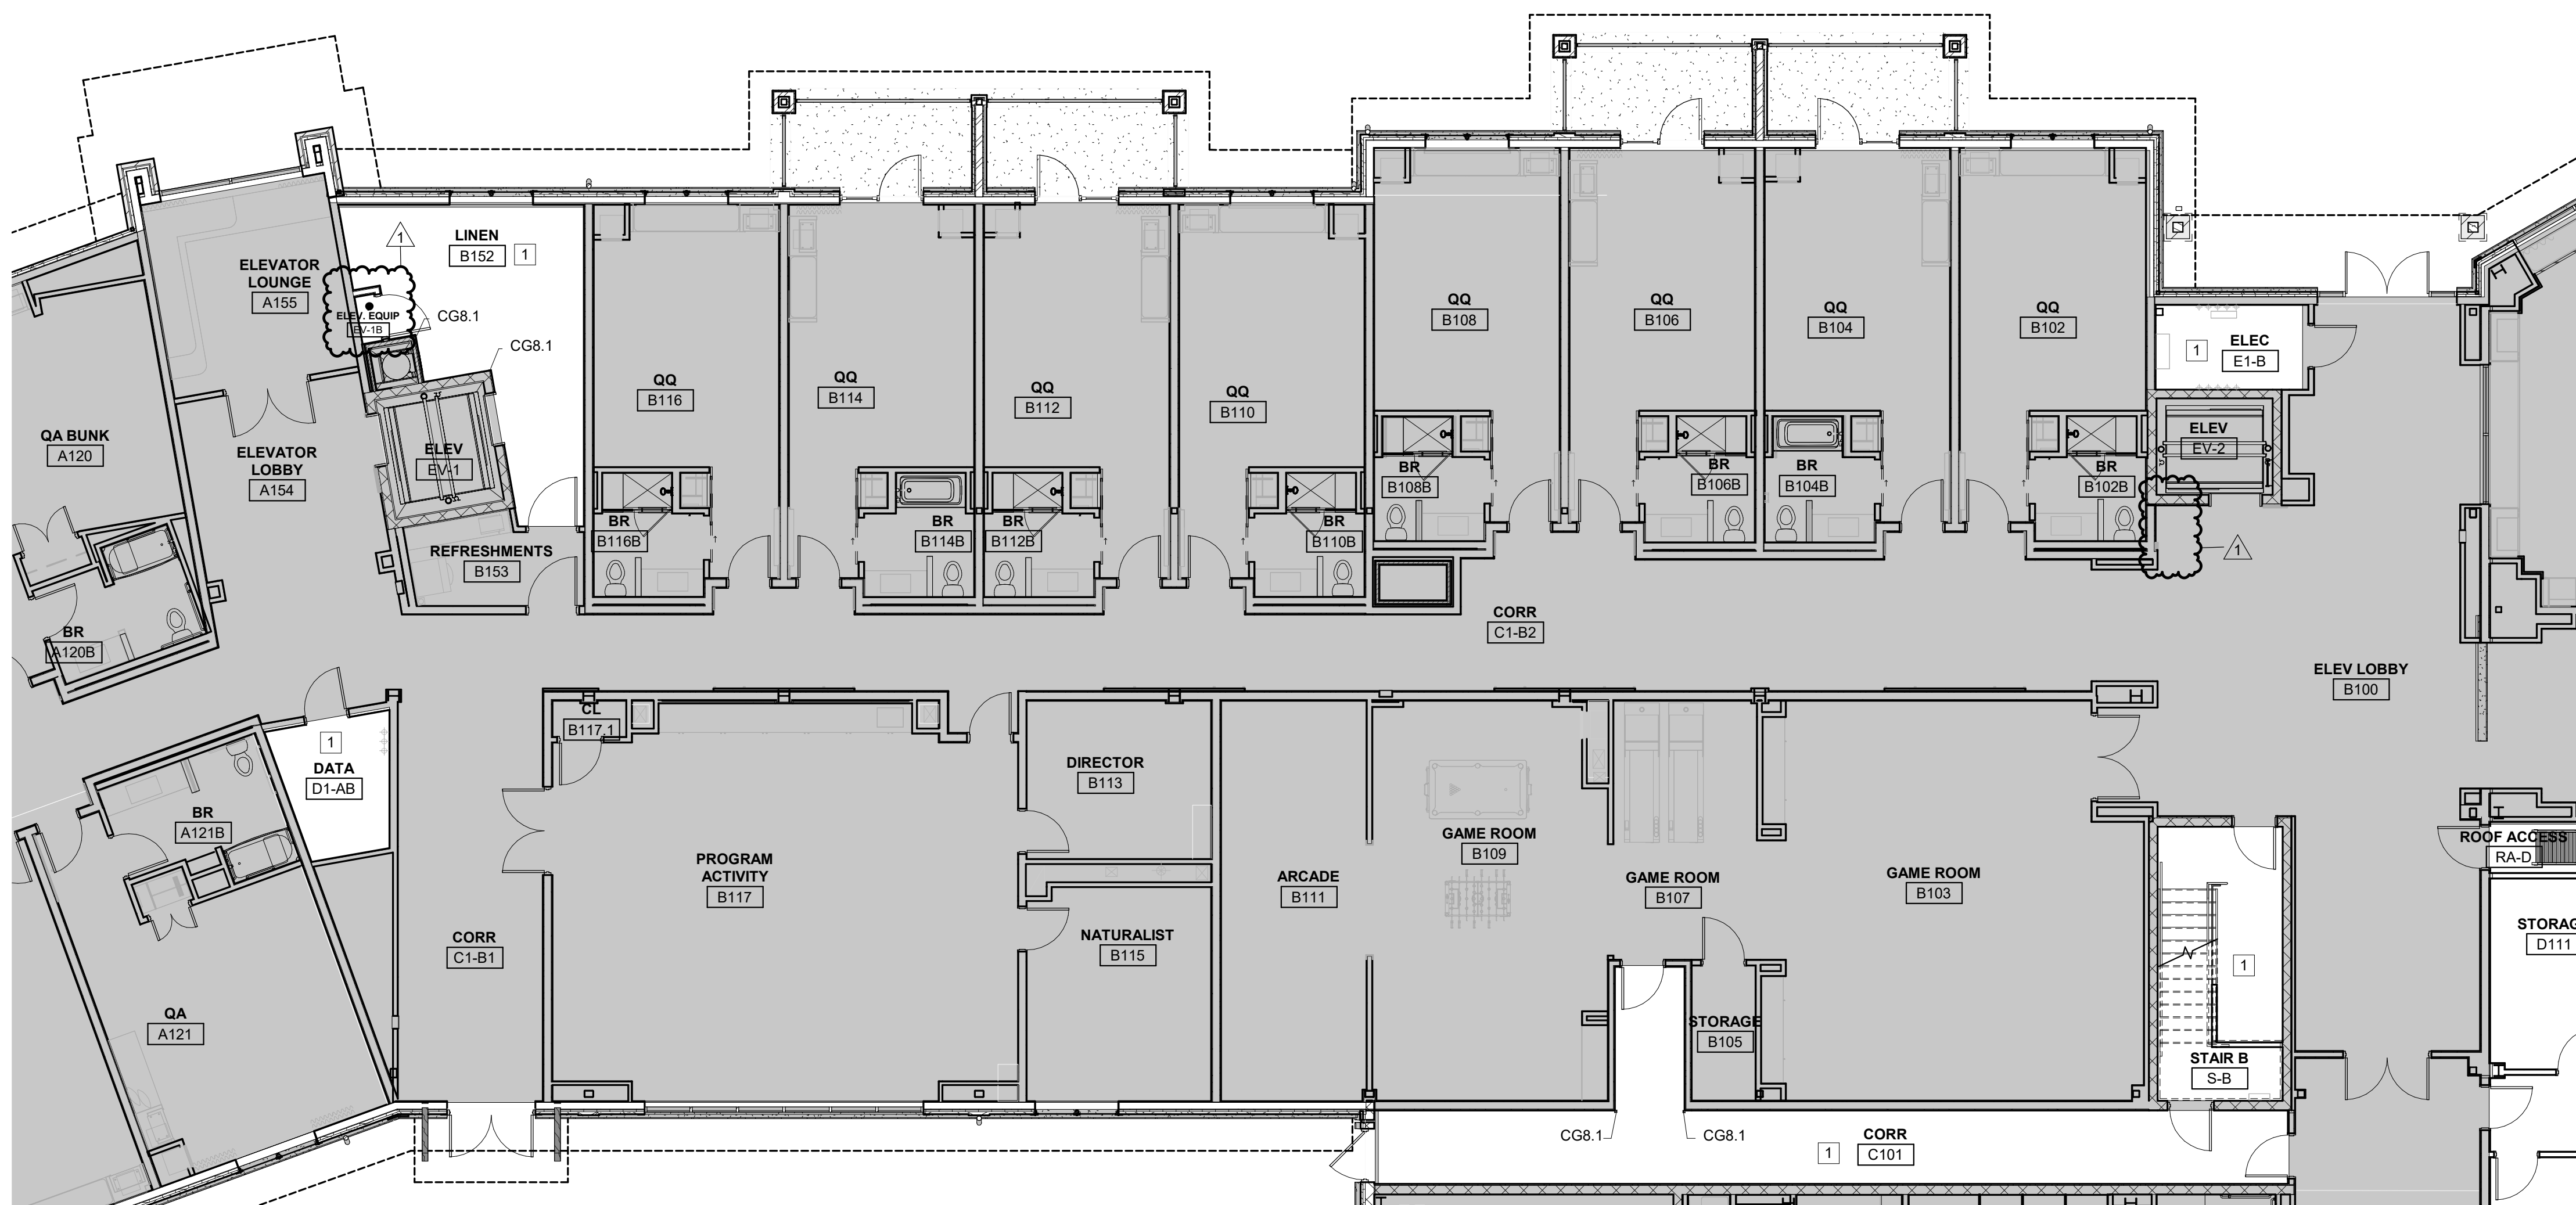

FIRST FLOOR BACK OF HOUSE FINISH PLAN - AREA 'B'

1/8" = 1'-0"


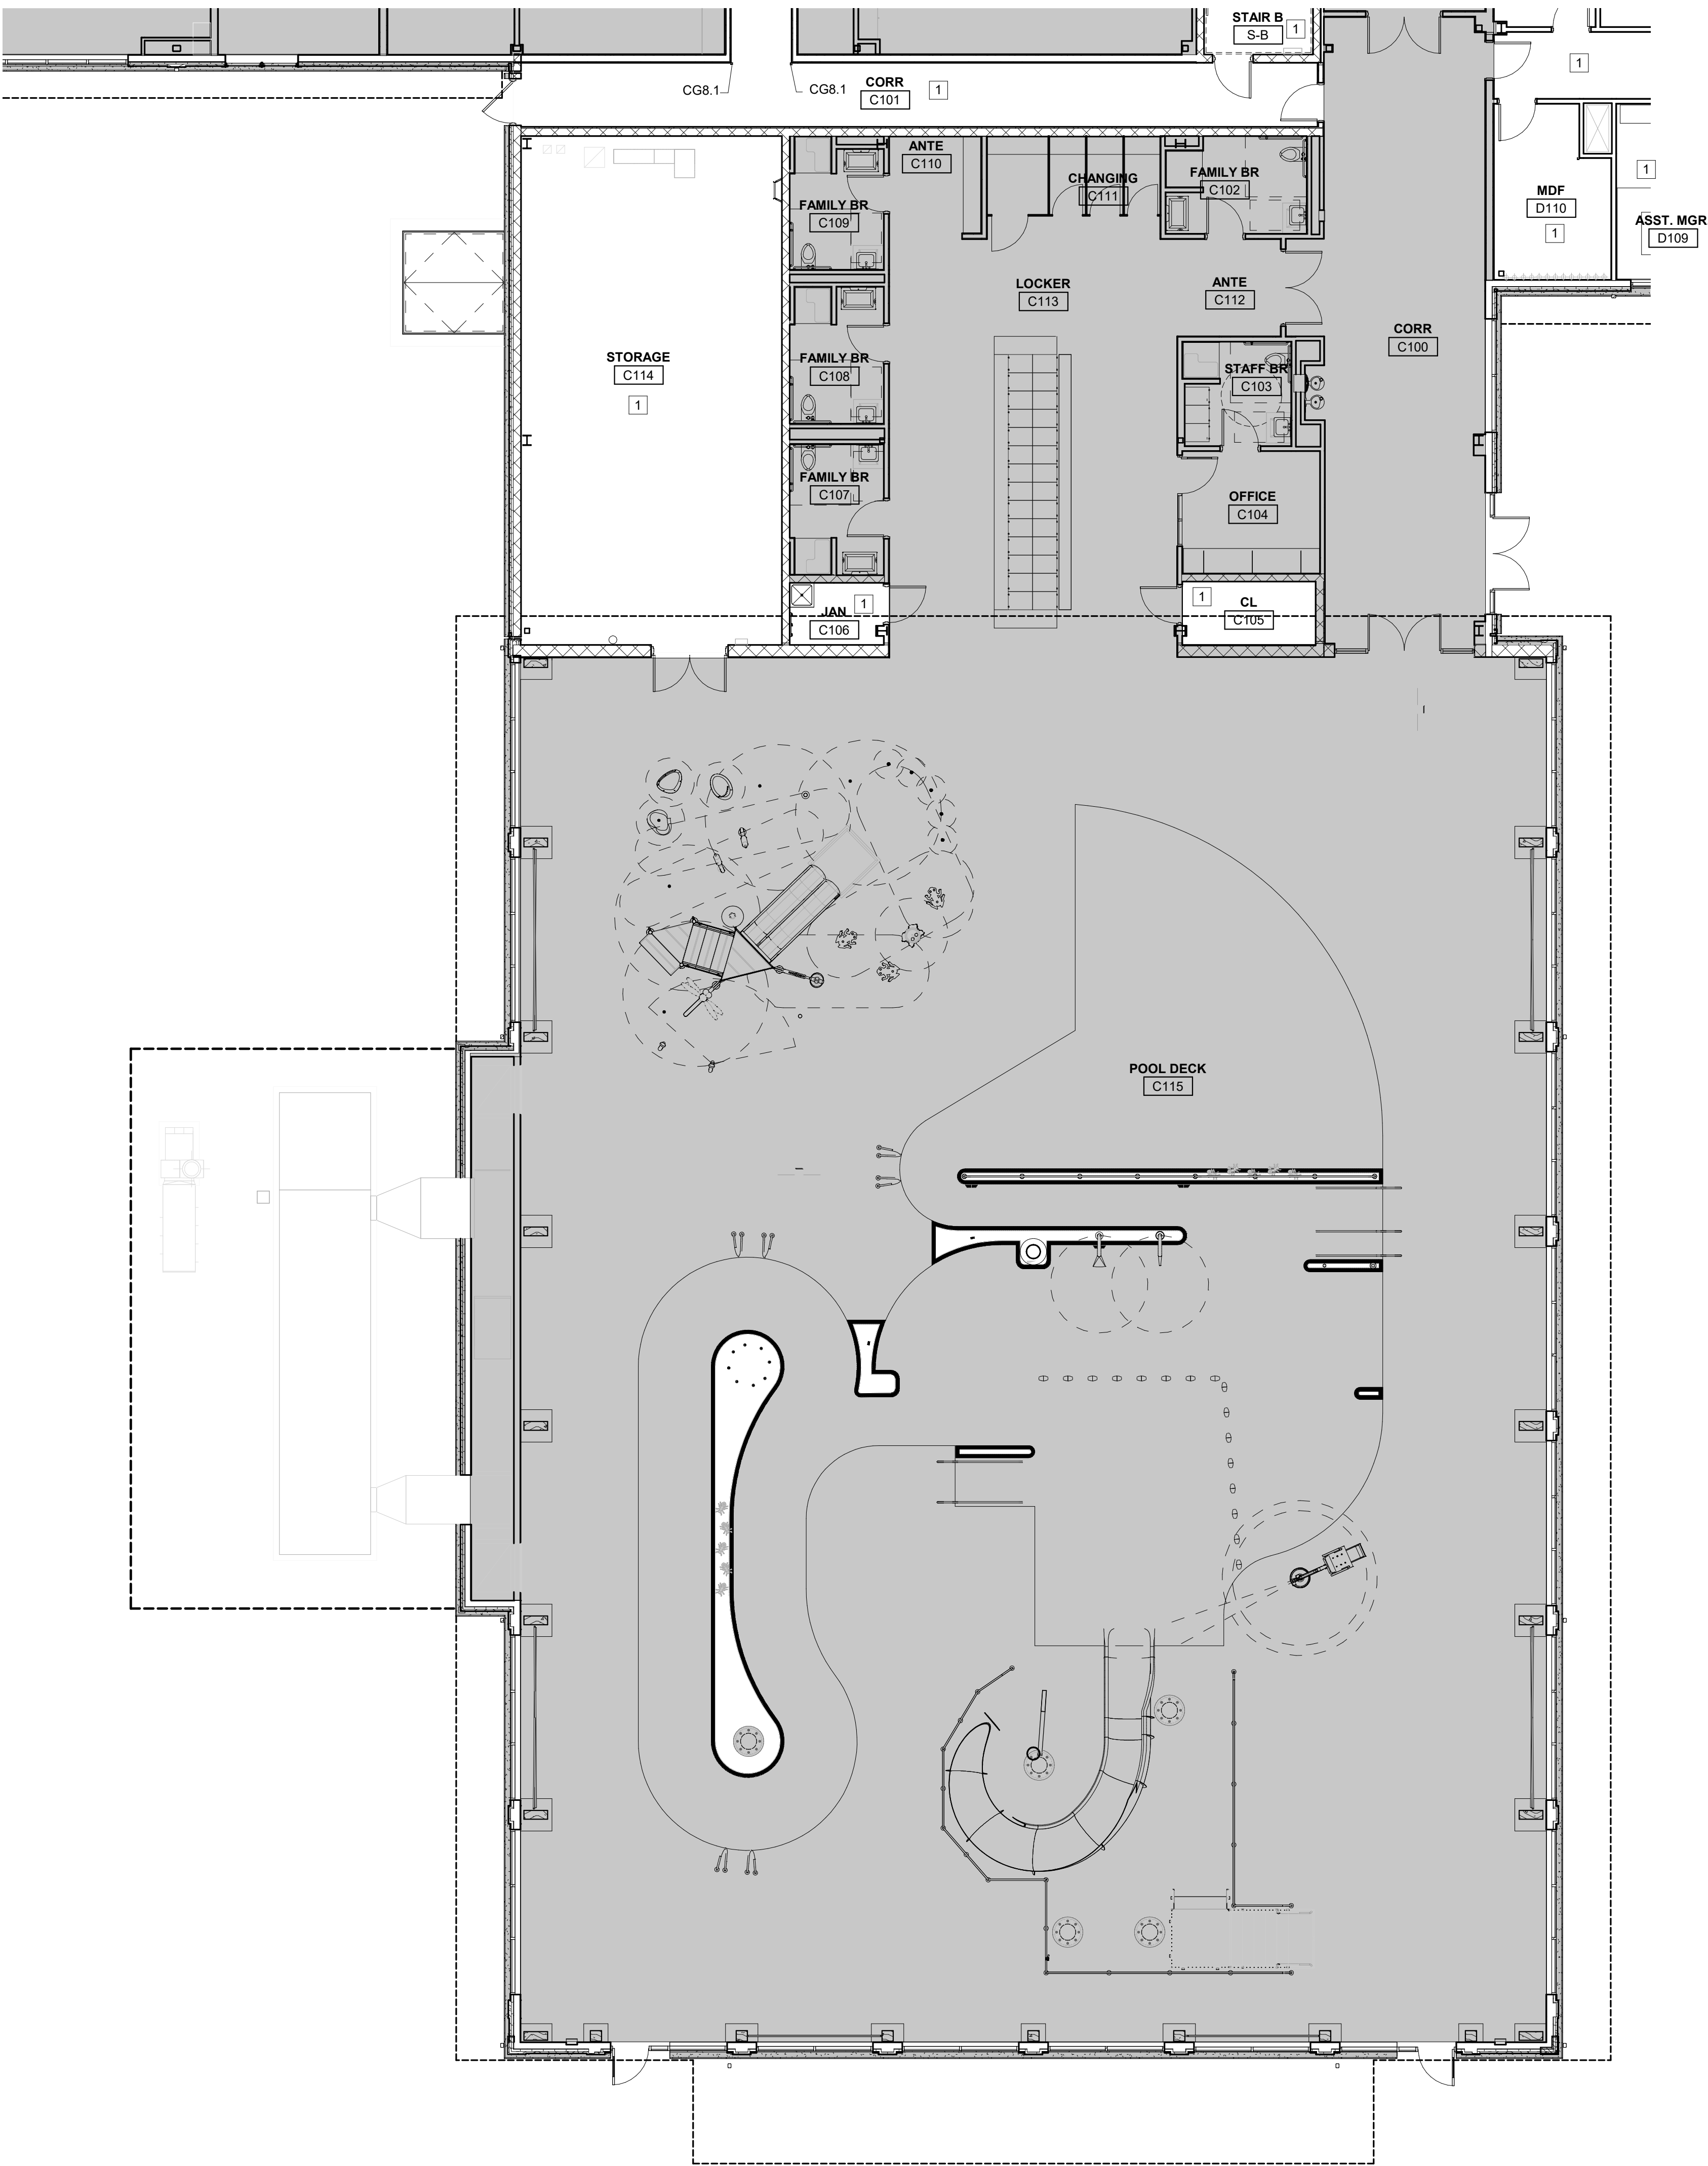


FIRST FLOOR BACK OF HOUSE FINISH PLAN - AREA 'C'

1/8" = 1'-0"

BACK OF HOUSE FINISH PLAN
REFERENCE NOTES:

- 1 REFER TO FRONT OF HOUSE FINISH PLAN
- 2 REFER TO BACK OF HOUSE FINISH SCHEDULE.
- 3 ROLLER WINDOW SHADES, SEE SPECIFICATIONS FOR INFORMATION.
- 4 10" DEEP SHELF SPANNING WALL TO WALL. REFER TO SILL DETAIL FOR DOOR E107G.

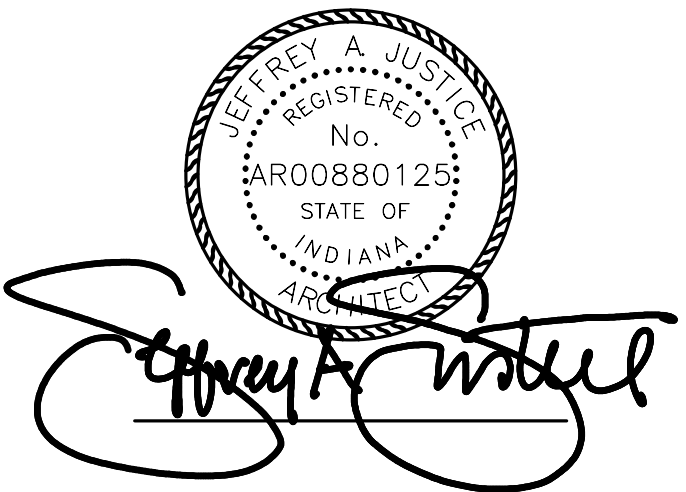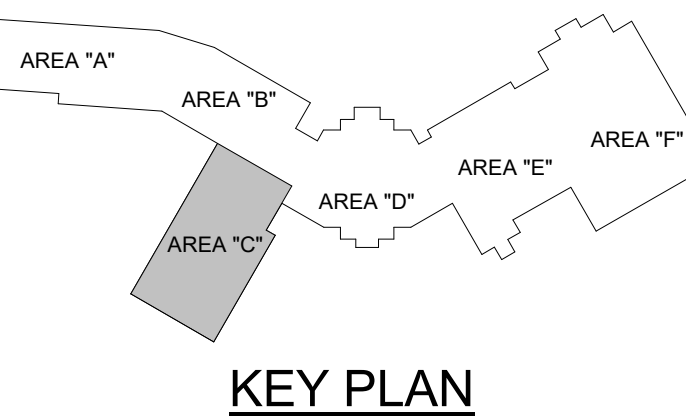

BID SET
SEPTEMBER, 2023

Revisions:		
#	Description	Date

Designed By:	Drawn By:	Checked By:

The drawings, specifications and other documents, including those in electronic form prepared by Haffer for this project are instruments of Service, and may be used solely with respect to this project. The documents may not be reproduced or modified by a third party without first obtaining the express written consent of Haffer. Authorized use of electronic media or file does not guarantee that these files contain complete and accurate information. In order to insure the accuracy of the information contained and that no changes or modifications have been made, these files must be compared to the project's contract documents with stamped and sealed certification and applicable approved modifications.


Sheet title:
FIRST FLOOR BACK-OF-HOUSE
AREA 'C' FINISH PLAN

Architect's Project No: Date:

2111-295 September, 2023

Drawing No:



ID2.8

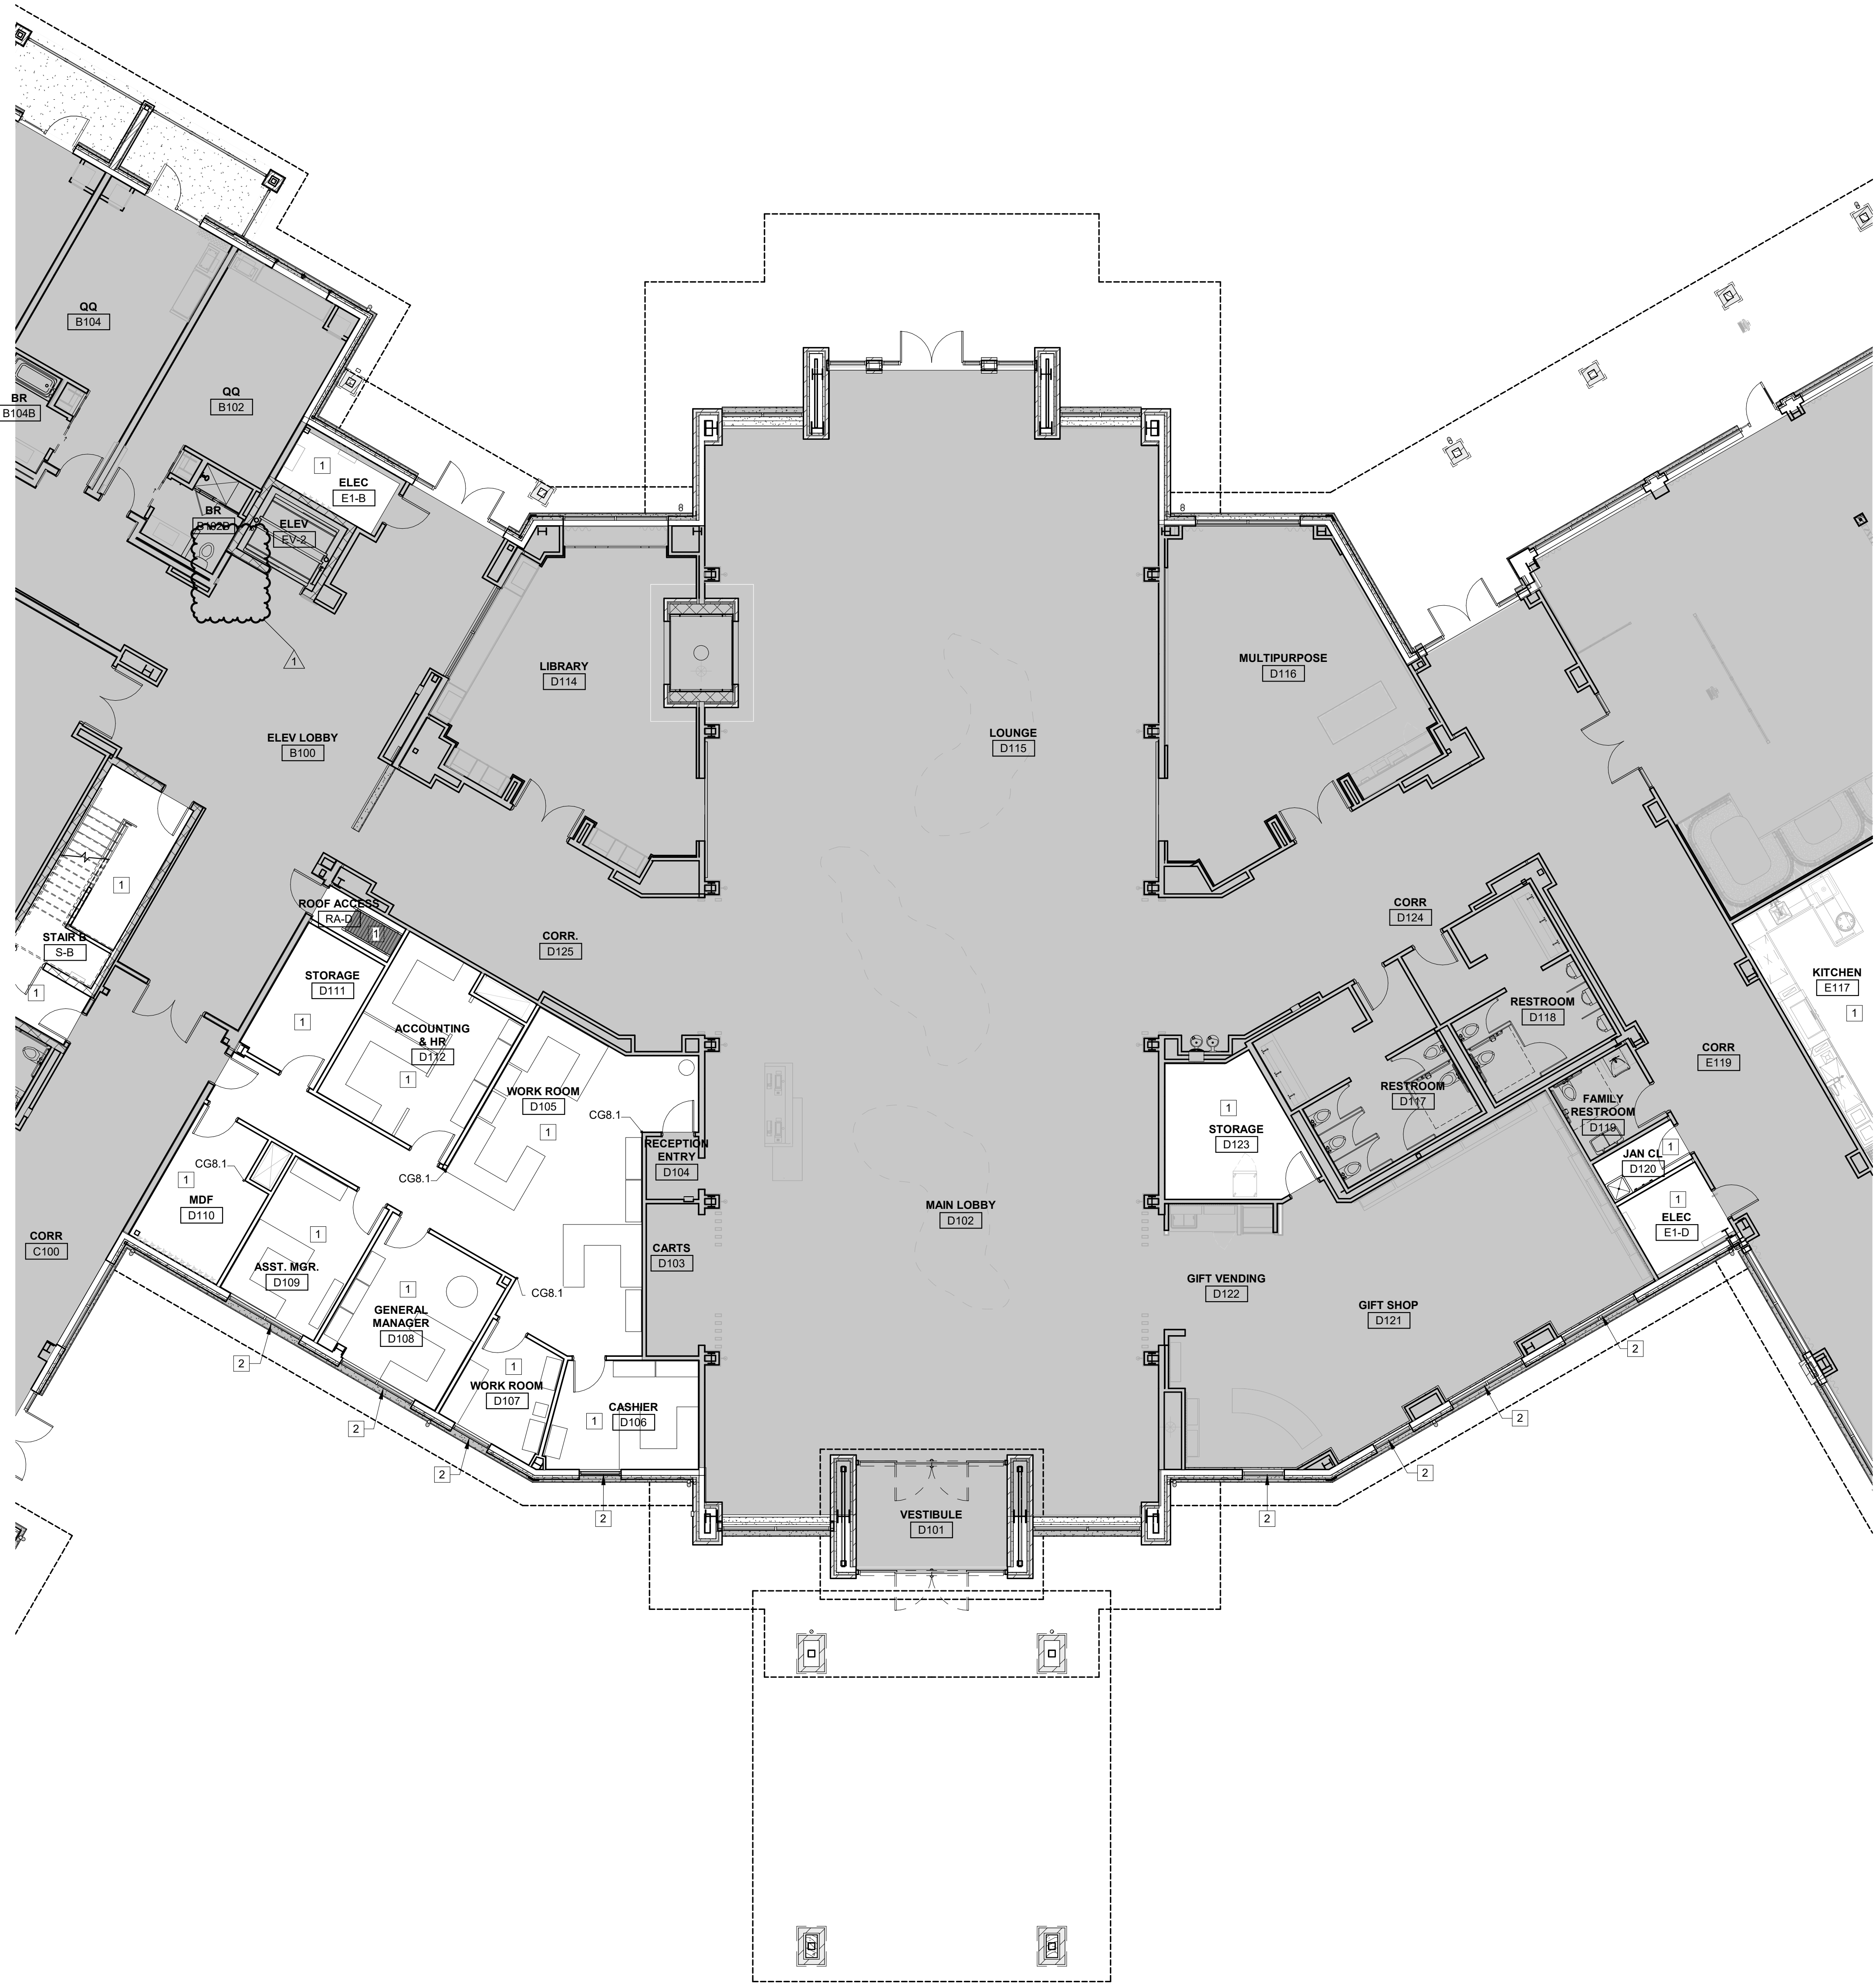

FIRST FLOOR BACK OF HOUSE FINISH PLAN - AREA 'D'
1/8" = 1'-0"

**BACK OF HOUSE FINISH PLAN
REFERENCE NOTES:**

- REFER TO FRONT OF HOUSE FINISH PLAN
- REFER TO BACK OF HOUSE FINISH SCHEDULE.
- ROLLER WINDOW SHADES, SEE SPECIFICATIONS FOR INFORMATION.
- 10" DEEP SHELF SPANNING WALL TO WALL. REFER TO SILL DETAIL FOR DOOR E107G.

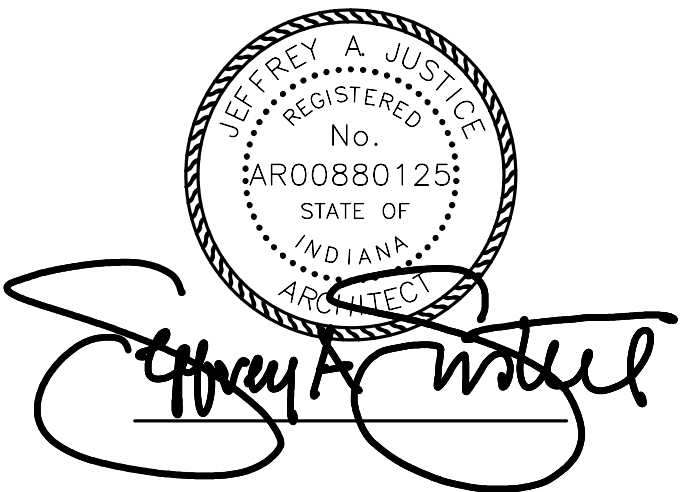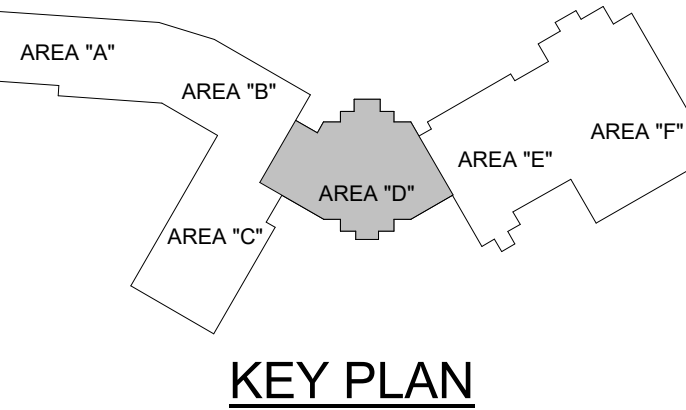

**BID SET
SEPTEMBER, 2023**

Revisions:		
#	Description	Date
1	PR-006	07/26/24

Designed By: Drawn By: Checked By:

The drawings, specifications and other documents, including those in electronic form prepared by Haffer for this project are instruments of Service, and may be used solely with respect to this project. The documents may not be reproduced or modified by a third party without first obtaining the express written consent of Haffer. Authorized use of electronic media or file does not guarantee that these files contain complete and accurate information. In order to insure the accuracy of the information contained and that no changes or modifications have been made, these files must be compared to the project's contract documents with stamped and sealed certification and applicable approved modifications.

Sheet title:
**FIRST FLOOR BACK-OF-HOUSE
AREA 'D' FINISH PLAN**

Architect's Project No: Date:

2111-295 September, 2023

Drawing No:

ID2.9

25601 State Road 4
North Liberty, IN 46554

21 SE Third Street,
Suite 800
Evansville, IN 47708
T: 812.422.4187
F: 812.421.6776
www.haferdesign.com

In association with:

Associate Architect:

319 N. Main, Suite 200
Springfield, MO 65806
T: 417.865.6100

Interior Design:

10681 Beacon Hill Drive
Crown Point, IN 46307
T: 219.322.7841

Civil/Structural Engineering

9365 Counselors Row
Suite 116
Indianapolis, IN 46240
T: 317 617 4270

Landscape Architect:


618 E. Market St.
Indianapolis, IN 46202
T: 317.263.0127

Aquatics Design:

100 Park Avenue
Beaver Dam, WI 53916
T: 920.887.7375

Food Service:

302 N. East Street
Studio One
Indianapolis, IN 46202
T: 317.637.3204

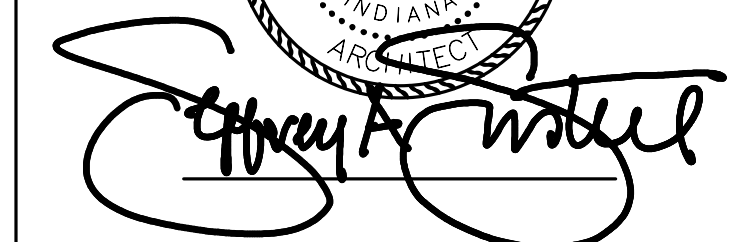

Revisions:

Designed By:	Drawn By:	Checked By:
--------------	-----------	-------------

The drawings, specifications and other documents, including those in electronic form prepared by Haefl for this project are instruments of Service and may be used solely with respect to this project. The documents may not be reproduced or modified by a third party without first obtaining the express written consent of Haefl. Authorized use of electronic media or file does not guarantee that these files contain complete and accurate information. In order to insure the accuracy of the information contained and that no changes or modifications have been made, these files must be compared to the project's contract documents with stamped and sealed certification and applicable approved modifications.

Sheet title:

Architect's Project No. _____

3111 305

Date: _____

2111-295

September, 2023

Drawing No:

ID2.10


REFER TO FRONT OF HOUSE FINISH PLAN

REFER TO FRONT OF HOUSE FINISH PLAN

1 REFER TO BACK OF HOUSE FINISH SCHEDULE

2 ROLLER WINDOW SHADES, SEE SPECIFICATIONS FOR

3 10" DEEP SHELF SPANNIGN WALL TO WALL. REFER TO SILL DETAIL FOR DOOR E107B.

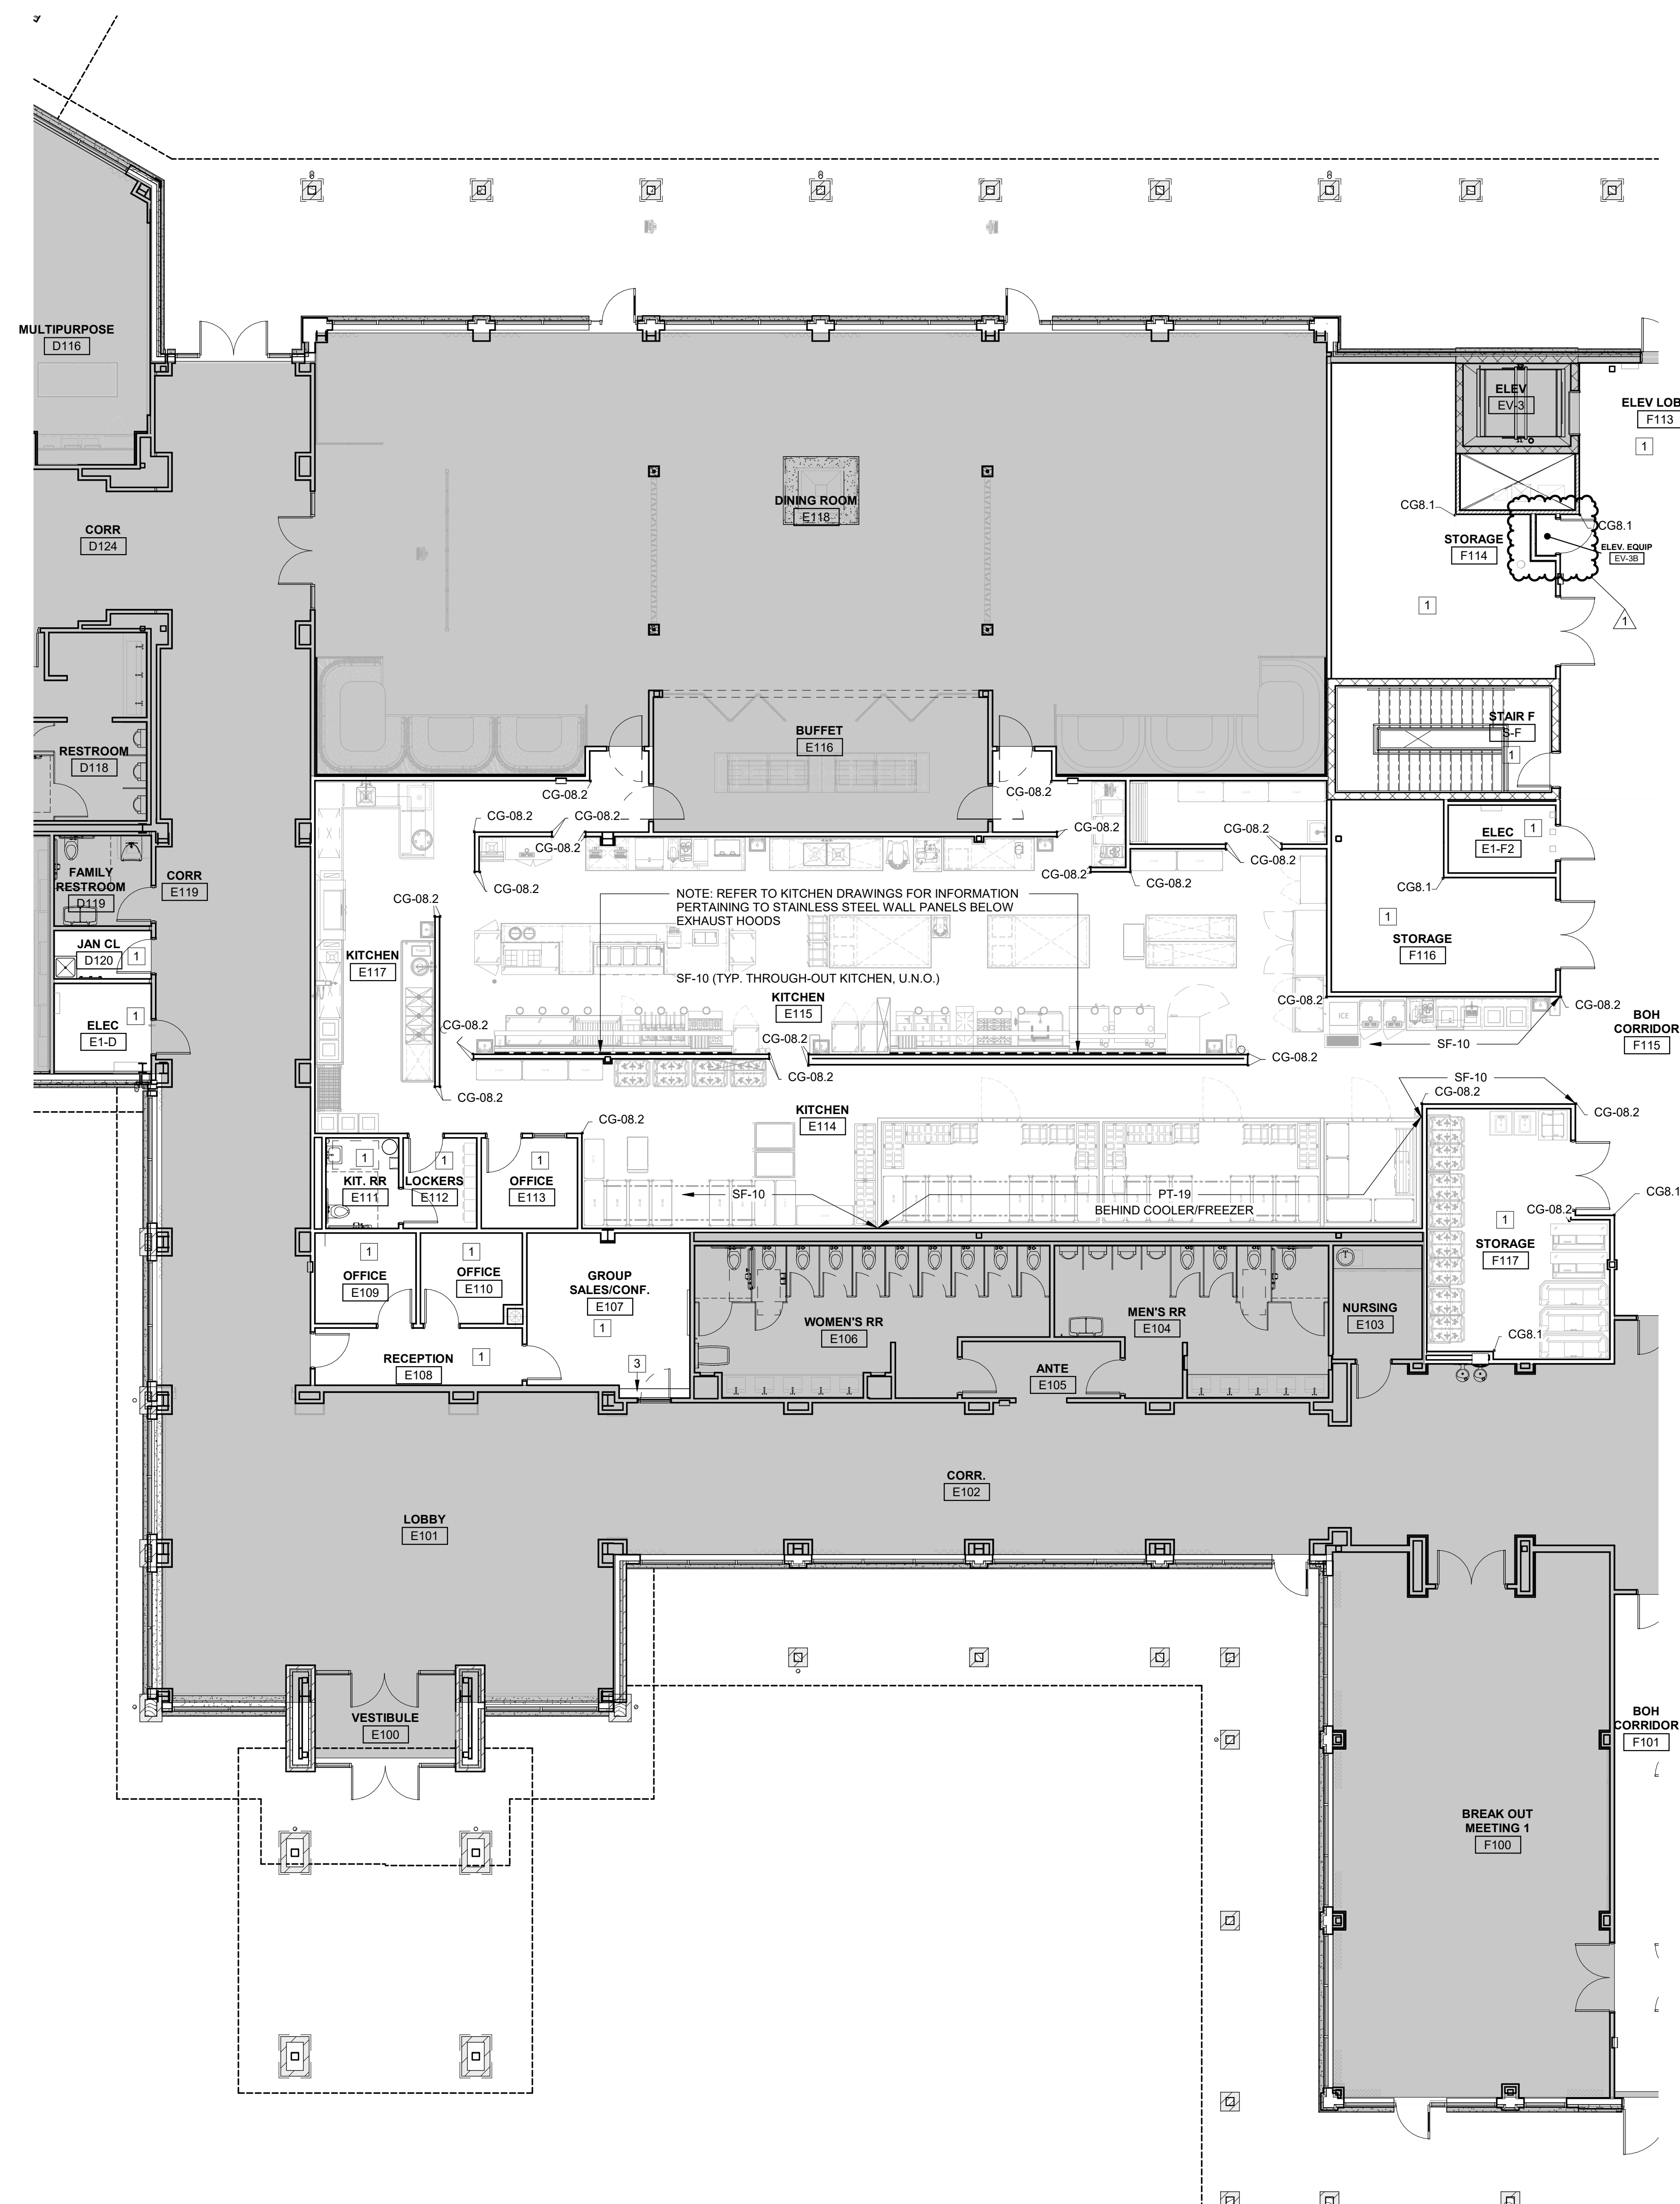


FIRST FLOOR BACK OF HOUSE FINISH PLAN - AREA 'E'

$1/8'' = 1'-0''$

BACK OF HOUSE FINISH PLAN
REFERENCE NOTES:

- REFER TO FRONT OF HOUSE FINISH PLAN
- 1 REFER TO BACK OF HOUSE FINISH SCHEDULE.
- 2 ROLLER WINDOW SHADES, SEE SPECIFICATIONS FOR INFORMATION.
- 3 10" DEEP SHELF SPANNING WALL TO WALL. REFER TO SILL DETAIL FOR DOOR E107G.

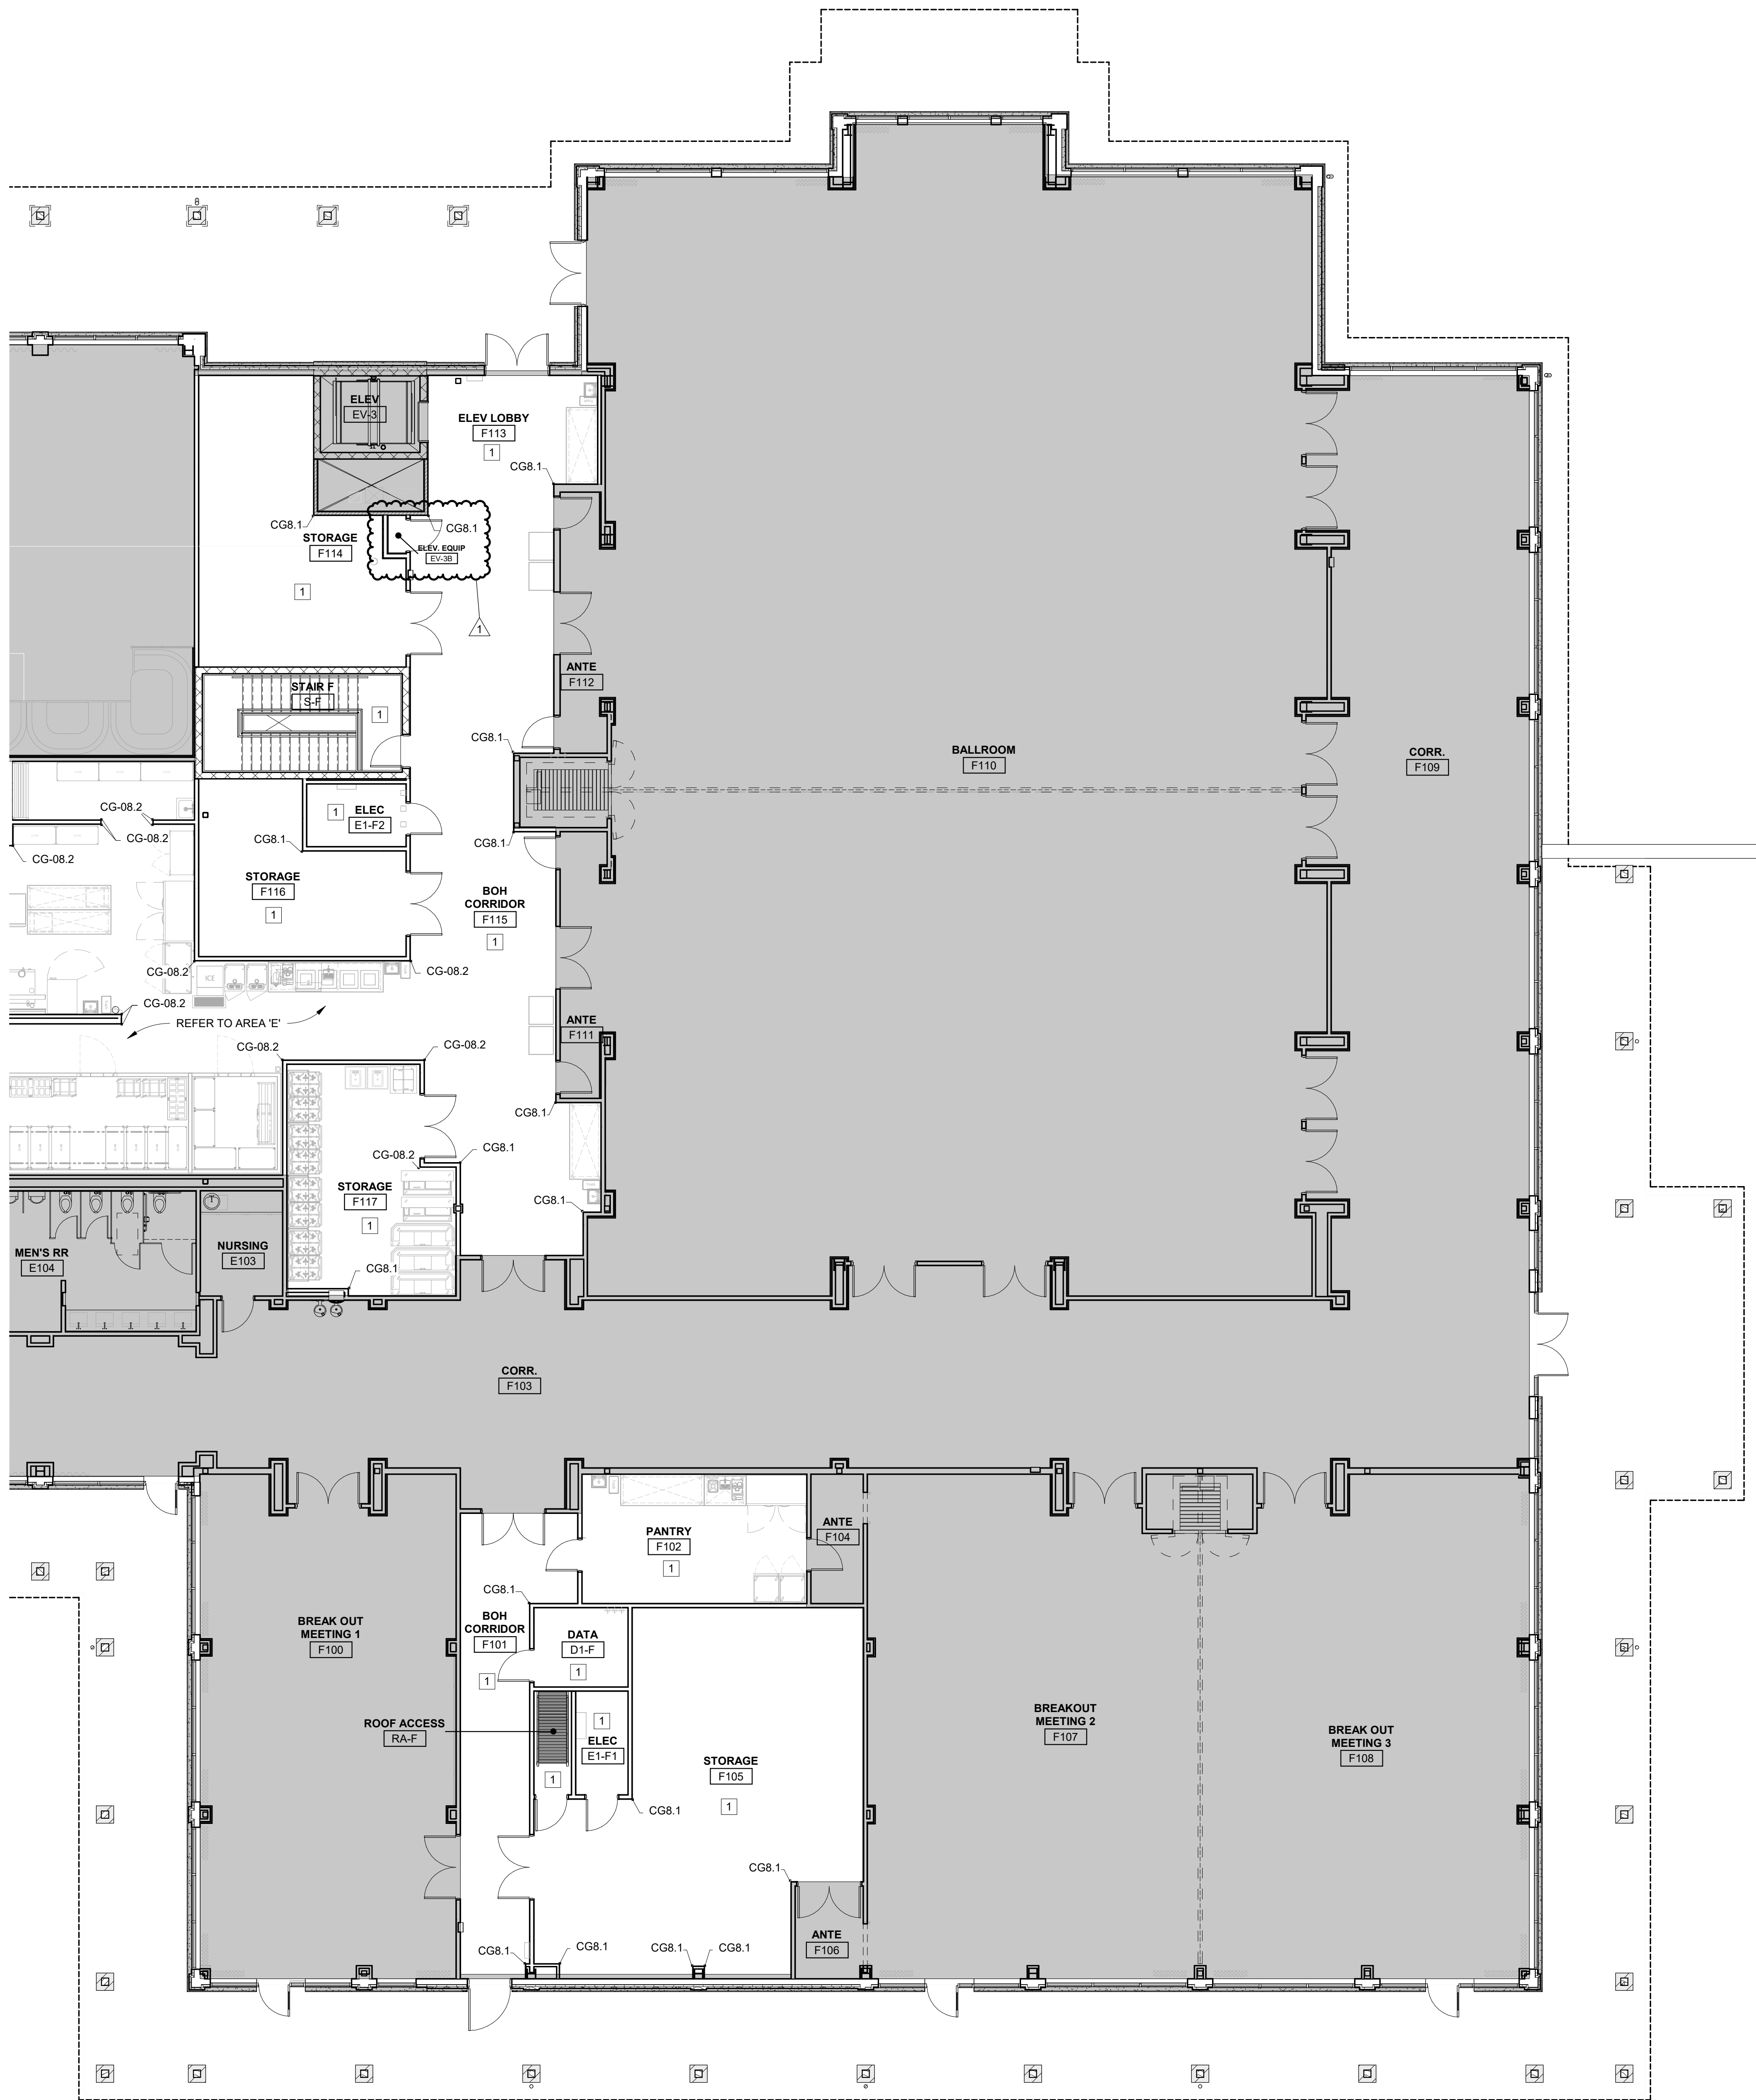

FIRST FLOOR BACK OF HOUSE FINISH PLAN - AREA 'F'

1/8" = 1'-0"

DNR

Indiana Department
of Natural Resources

New Lodge:
Potato Creek State Park
25601 State Road 4
North Liberty, IN 46554

State of Indiana
Department of Administration
Public Works Project
No. 71013000-22-003-D1

HAFFER
architects • designers • engineers

21 SE Third Street,
Suite 800
Evansville, IN 47708
T: 812.422.4187
F: 812.421.6776
www.hafferdesign.com

In association with:

Associate Architect:

brp
ARCHITECTS

319 N. Main, Suite 200
Springfield, MO 65806
T: 417.865.6100

Interior Design:

interior
image
group

10681 Beacon Hill Drive
Crown Point, IN 46307
T: 219.322.7841

Civil/Structural Engineering:

CONSULTING
ENGINEERS

9365 Counselors Row
Suite 116
Indianapolis, IN 46240
T: 317.617.4270

Landscape Architect:

REA
LANDSCAPE ARCHITECTS

618 E. Market St.
Indianapolis, IN 46202
T: 317.263.0127

Aquatics Design:


WTI
WATER TECHNOLOGY INC.

100 Park Avenue
Beaver Dam, WI 53916
T: 920.887.7375

Food Service:

REITANO
DESIGN GROUP

302 N. East Street
Studio One
Indianapolis, IN 46202
T: 317.637.3204

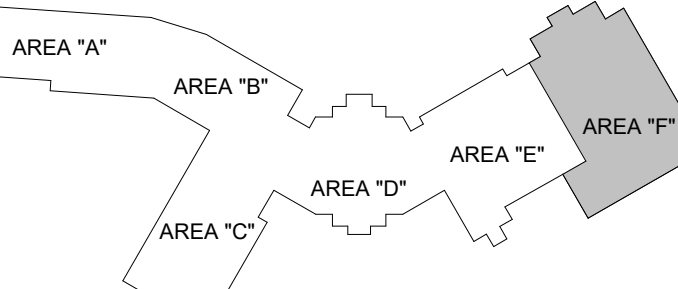

KEY PLAN



Jeffrey A. Justice

BID SET
SEPTEMBER, 2023

Revisions:		
#	Description	Date
1	PR-006	07/26/24

Designed By: Drawn By: Checked By:

The drawings, specifications and other documents, including those in electronic form prepared by Haffer for this project are instruments of Service, and may be used solely with respect to this project. The documents may not be reproduced or modified by a third party without first obtaining the express written consent of Haffer. Authorized use of electronic media or file does not guarantee that these files contain complete and accurate information. In order to insure the accuracy of the information contained and that no changes or modifications have been made, these files must be compared to the project's contract documents with stamped and sealed certification and applicable approved modifications.

Sheet title:


FIRST FLOOR BACK-OF-HOUSE
AREA 'F' FINISH PLAN

Architect's Project No: Date:

2111-295 September, 2023


Drawing No:

ID2.11

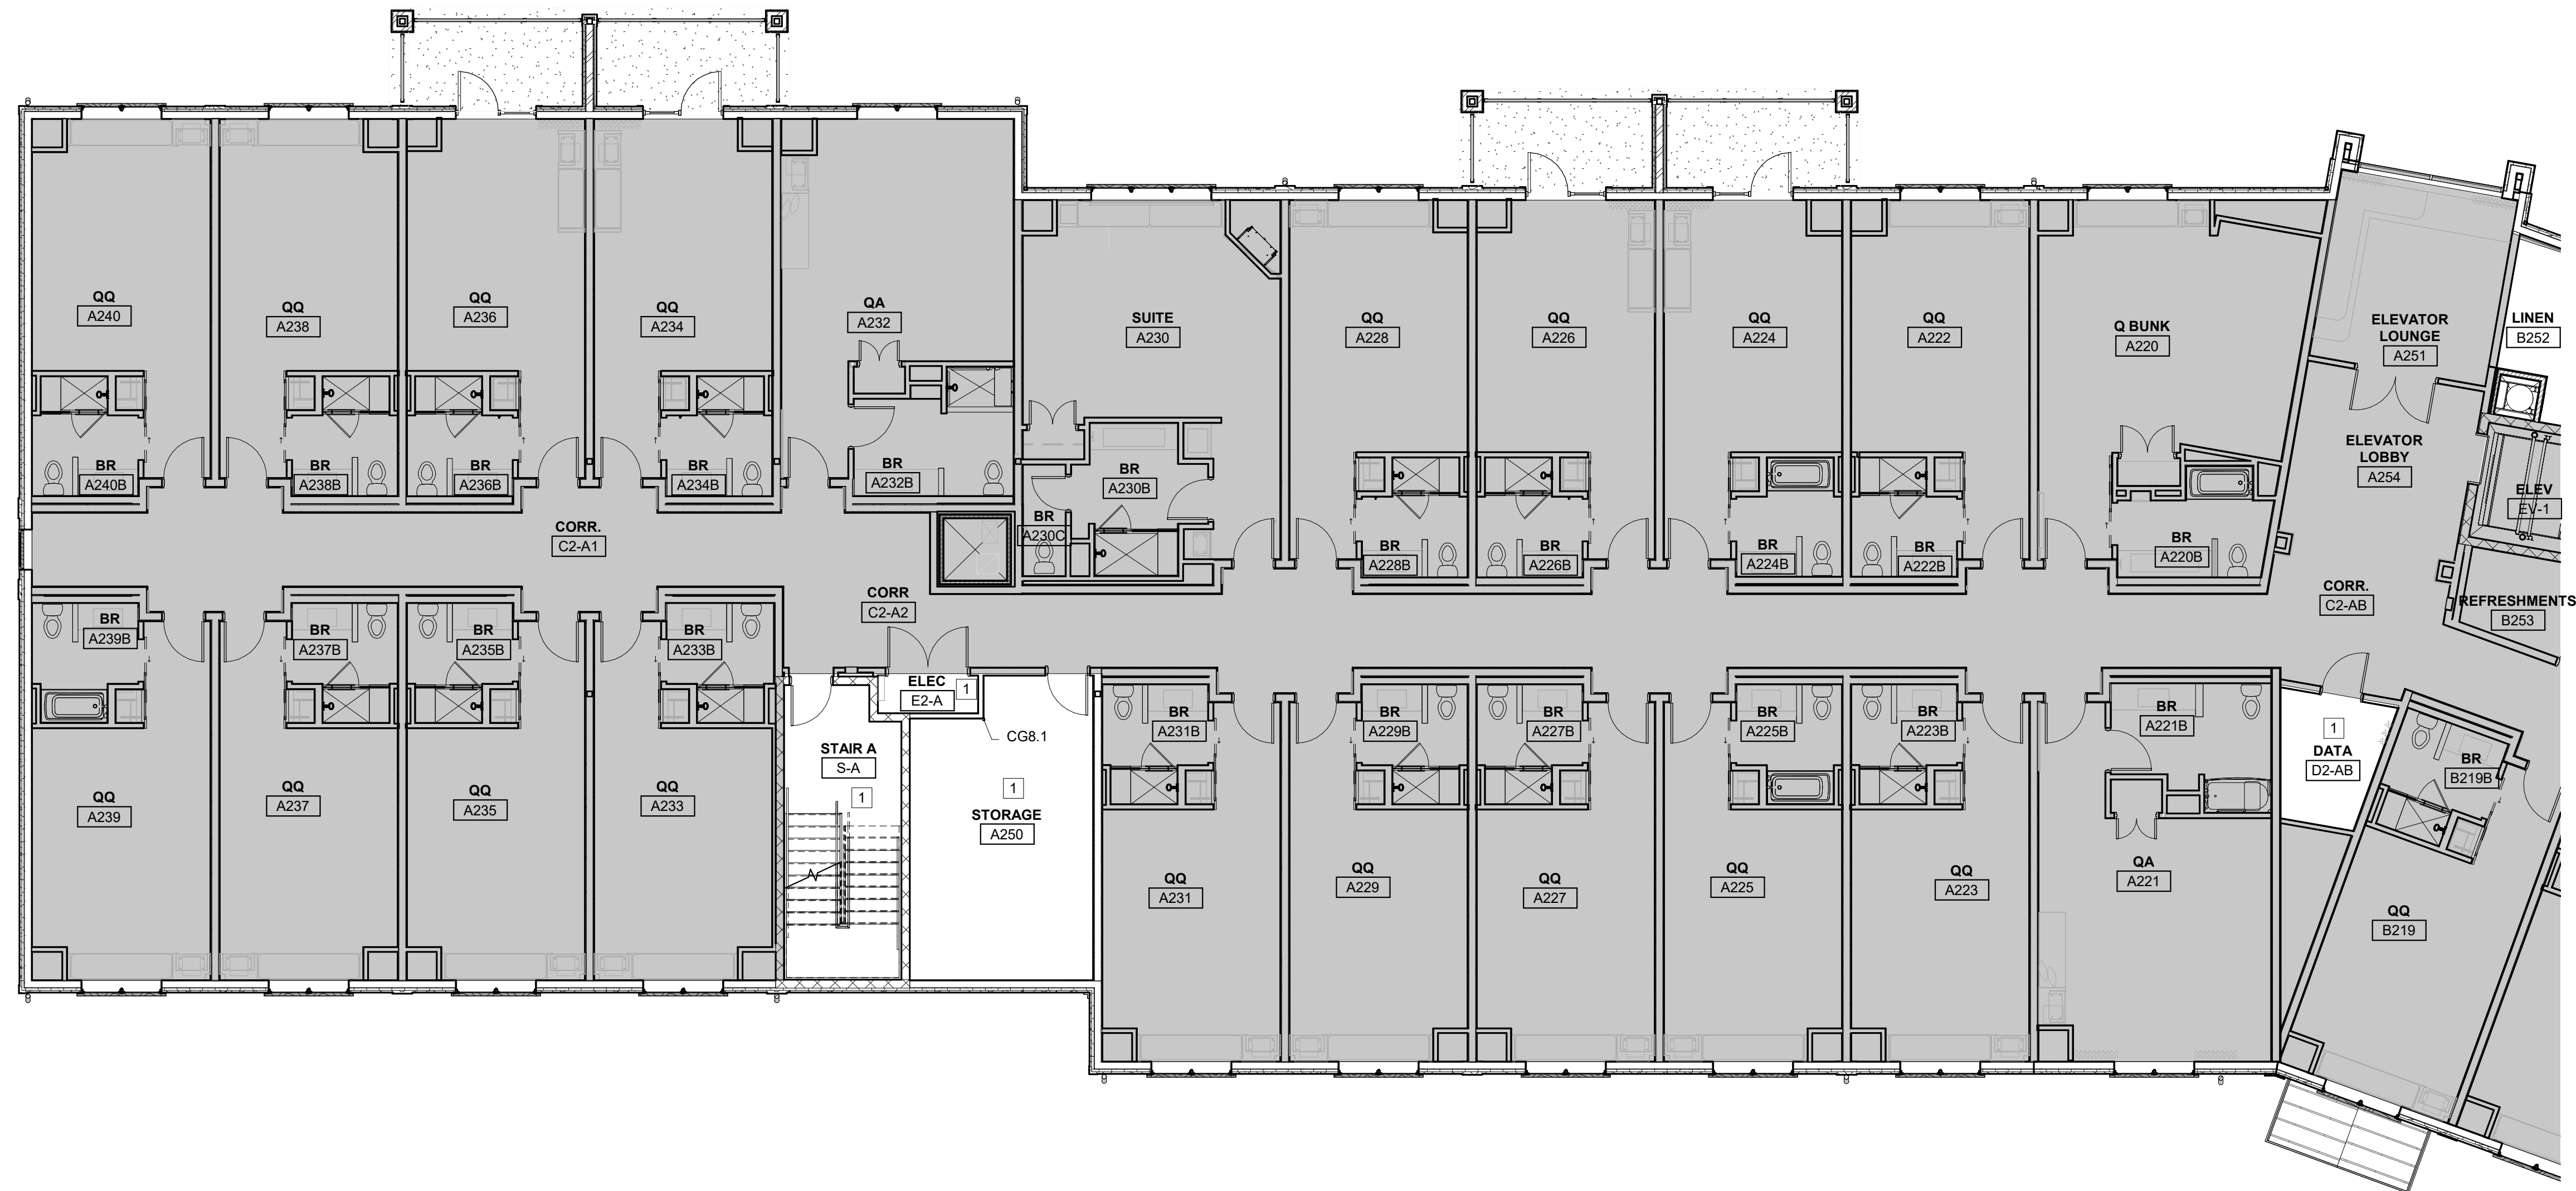

SECOND FLOOR BACK OF HOUSE FINISH PLAN - AREA 'A'

1/8" = 1'-0"

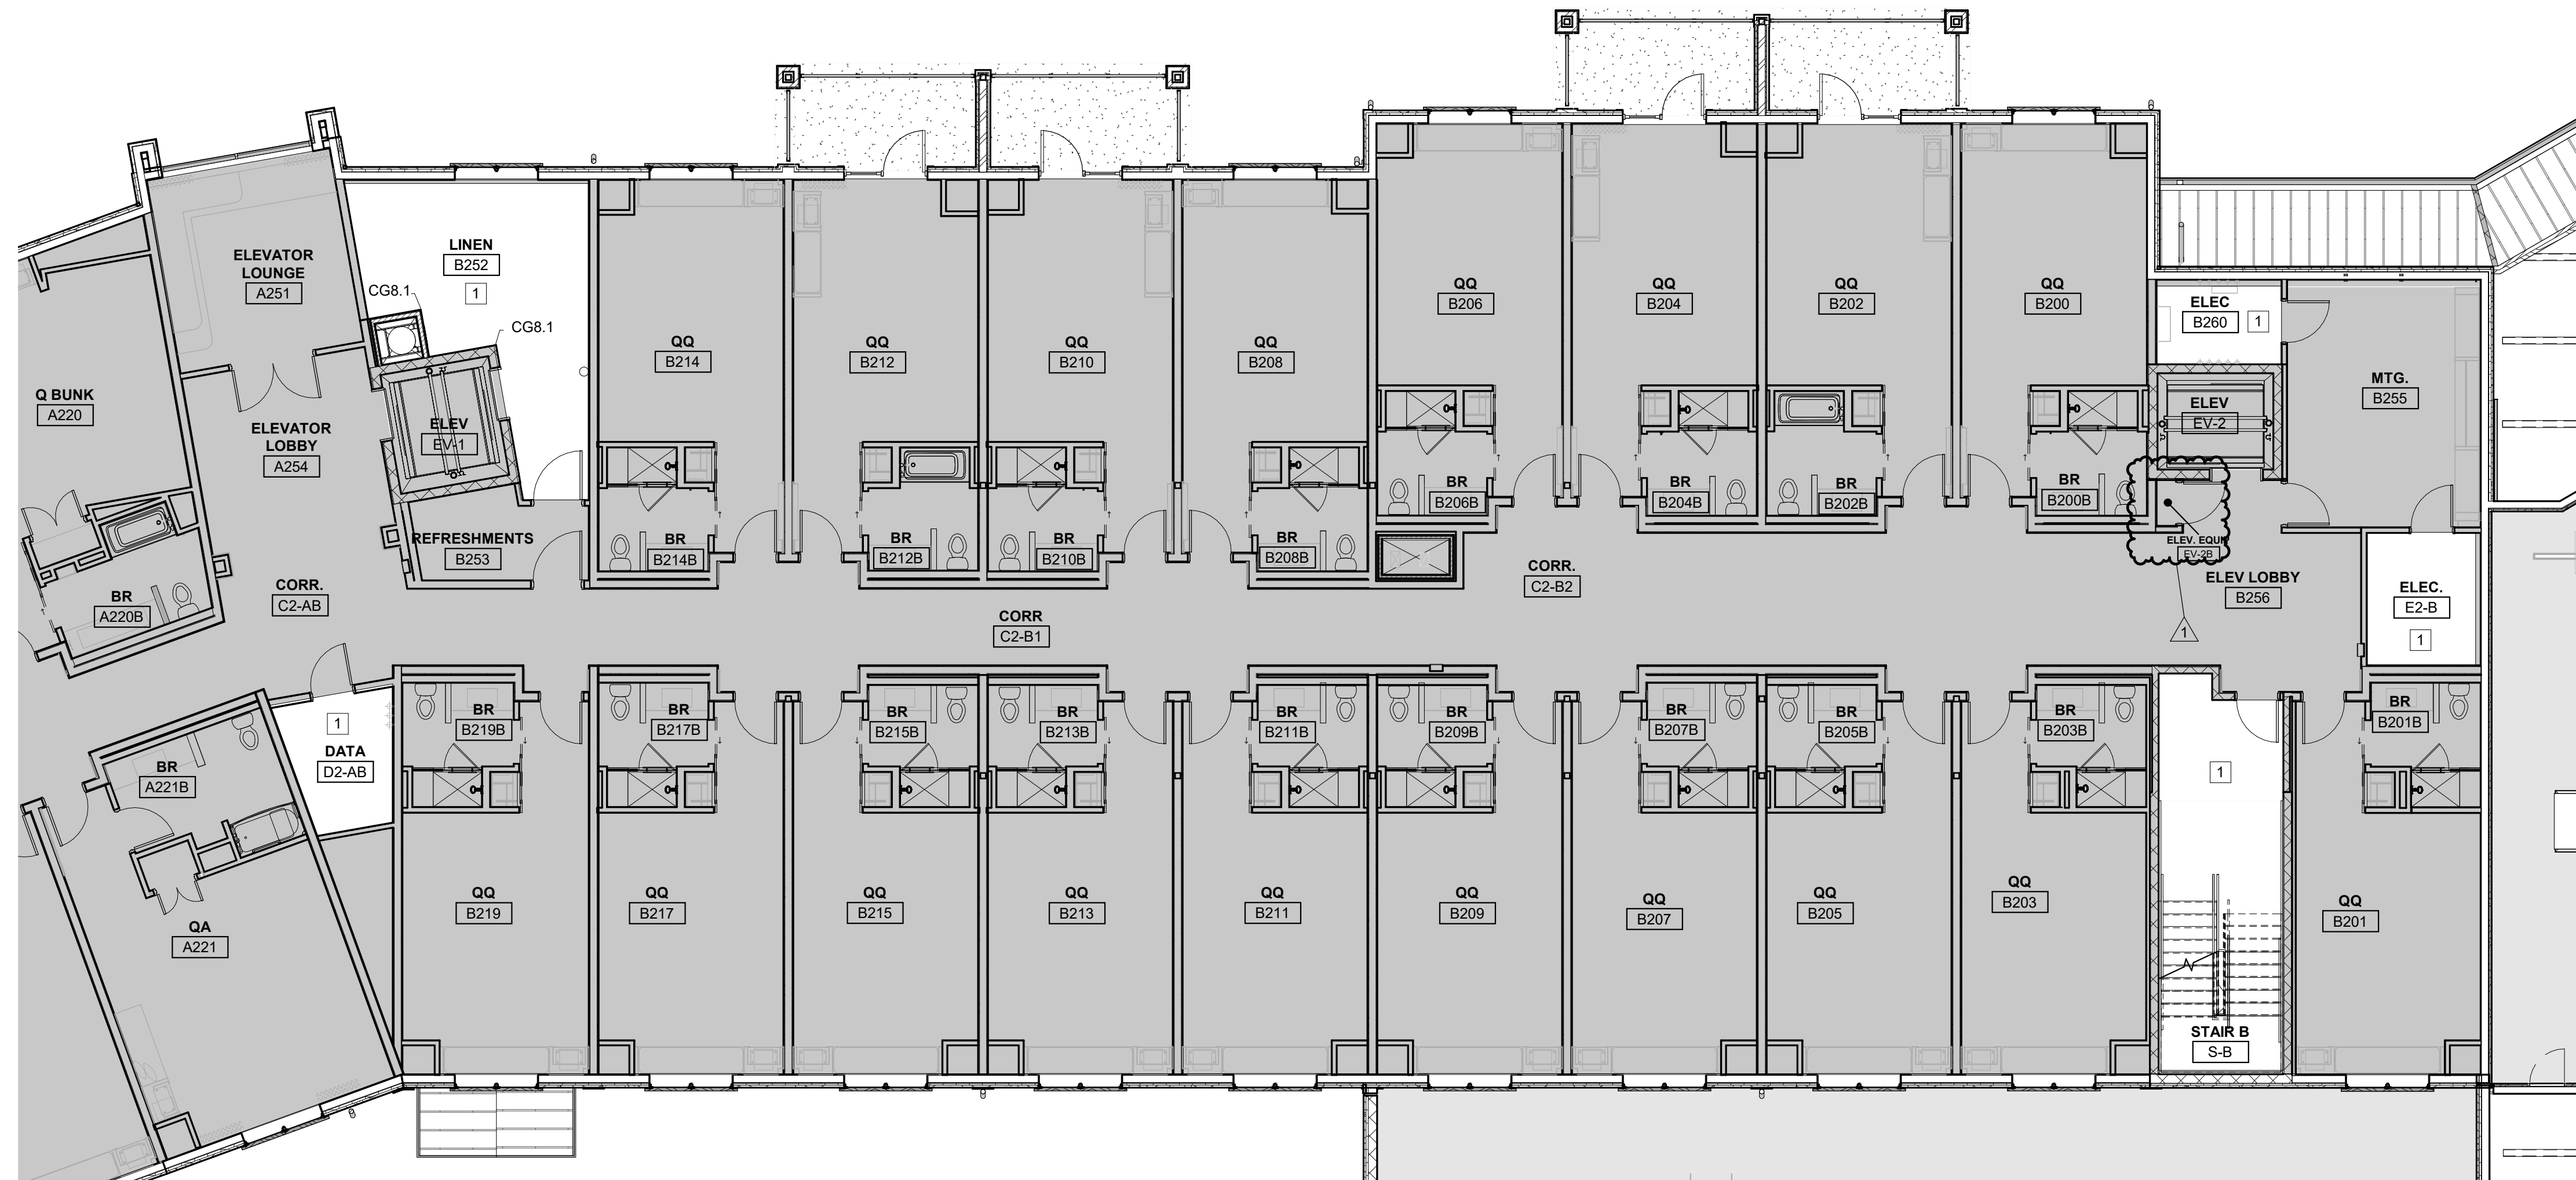


SECOND FLOOR BACK OF HOUSE FINISH PLAN - AREA 'B'


1/8" = 1'-0"

BACK OF HOUSE FINISH PLAN
REFERENCE NOTES:

- 1 REFER TO FRONT OF HOUSE FINISH PLAN
- 2 REFER TO BACK OF HOUSE FINISH SCHEDULE.
- 3 ROLLER WINDOW SHADES, SEE SPECIFICATIONS FOR INFORMATION.
- 4 10" DEEP SHELF SPANNING WALL TO WALL. REFER TO SILL DETAIL FOR DOOR E107B.

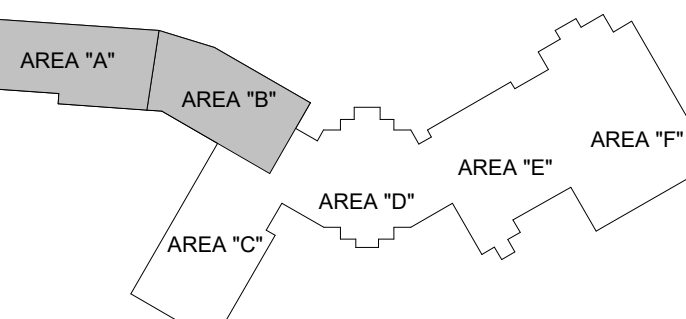

KEY PLAN

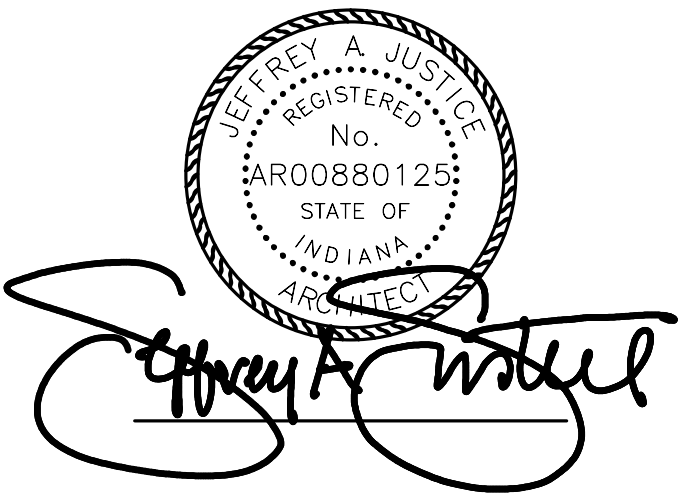

**BID SET
SEPTEMBER, 2023**

Revisions:		
#	Description	Date
1	PR-006	07/26/24

Designed By: Drawn By: Checked By:

The drawings, specifications and other documents, including those in electronic form prepared by Hafer for this project are instruments of Service, and may be used solely with respect to this project. The documents may not be reproduced or modified by a third party without first obtaining the express written consent of Hafer. Authorized use of electronic media or file does not guarantee that these files contain complete and accurate information. In order to insure the accuracy of the information contained and that no changes or modifications have been made, these files must be compared to the project's contract documents with stamped and sealed certification and applicable approved modifications.

Sheet title:

SECOND FLOOR BACK-OF-HOUSE
AREA 'A' & 'B' FINISH PLANS

Architect's Project No: Date:


2111-295 September, 2023

Drawing No:

ID2.12


BACK OF HOUSE FINISH PLAN
REFERENCE NOTES:

- REFER TO FRONT OF HOUSE FINISH PLAN
- 1 REFER TO BACK OF HOUSE FINISH SCHEDULE.
- 2 ROLLER WINDOW SHADES, SEE SPECIFICATIONS FOR INFORMATION.
- 3 10" DEEP SHELF SPANNING WALL TO WALL. REFER TO SILL DETAIL FOR DOOR E107B.

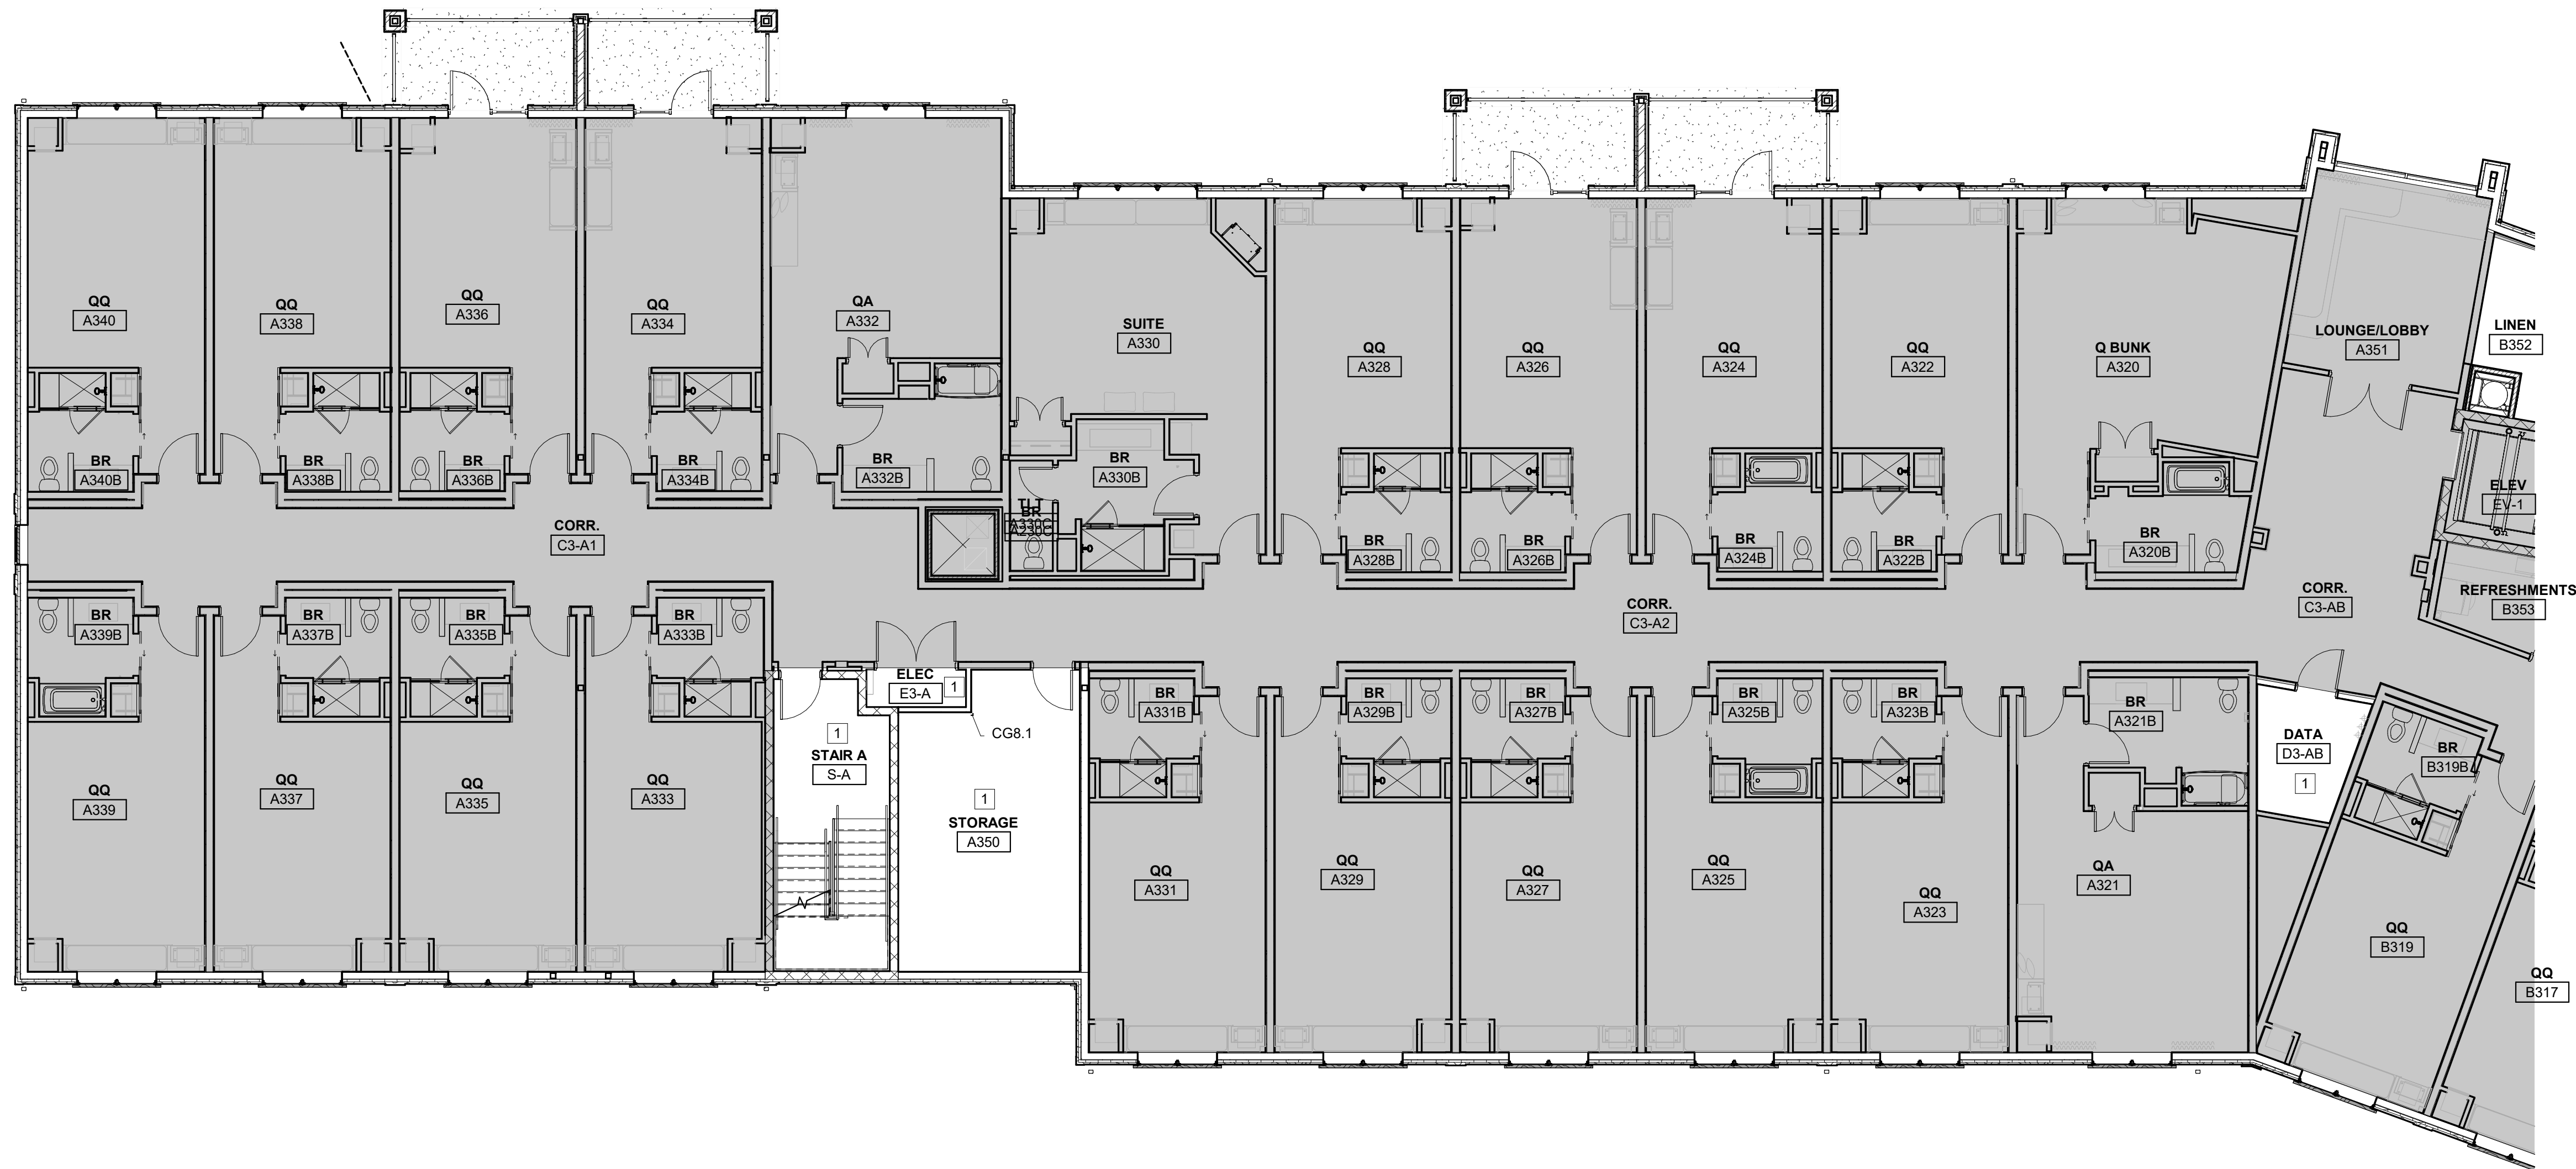



THIRD FLOOR BACK OF HOUSE FINISH PLAN - AREA 'A'

1/8" = 1'-0"

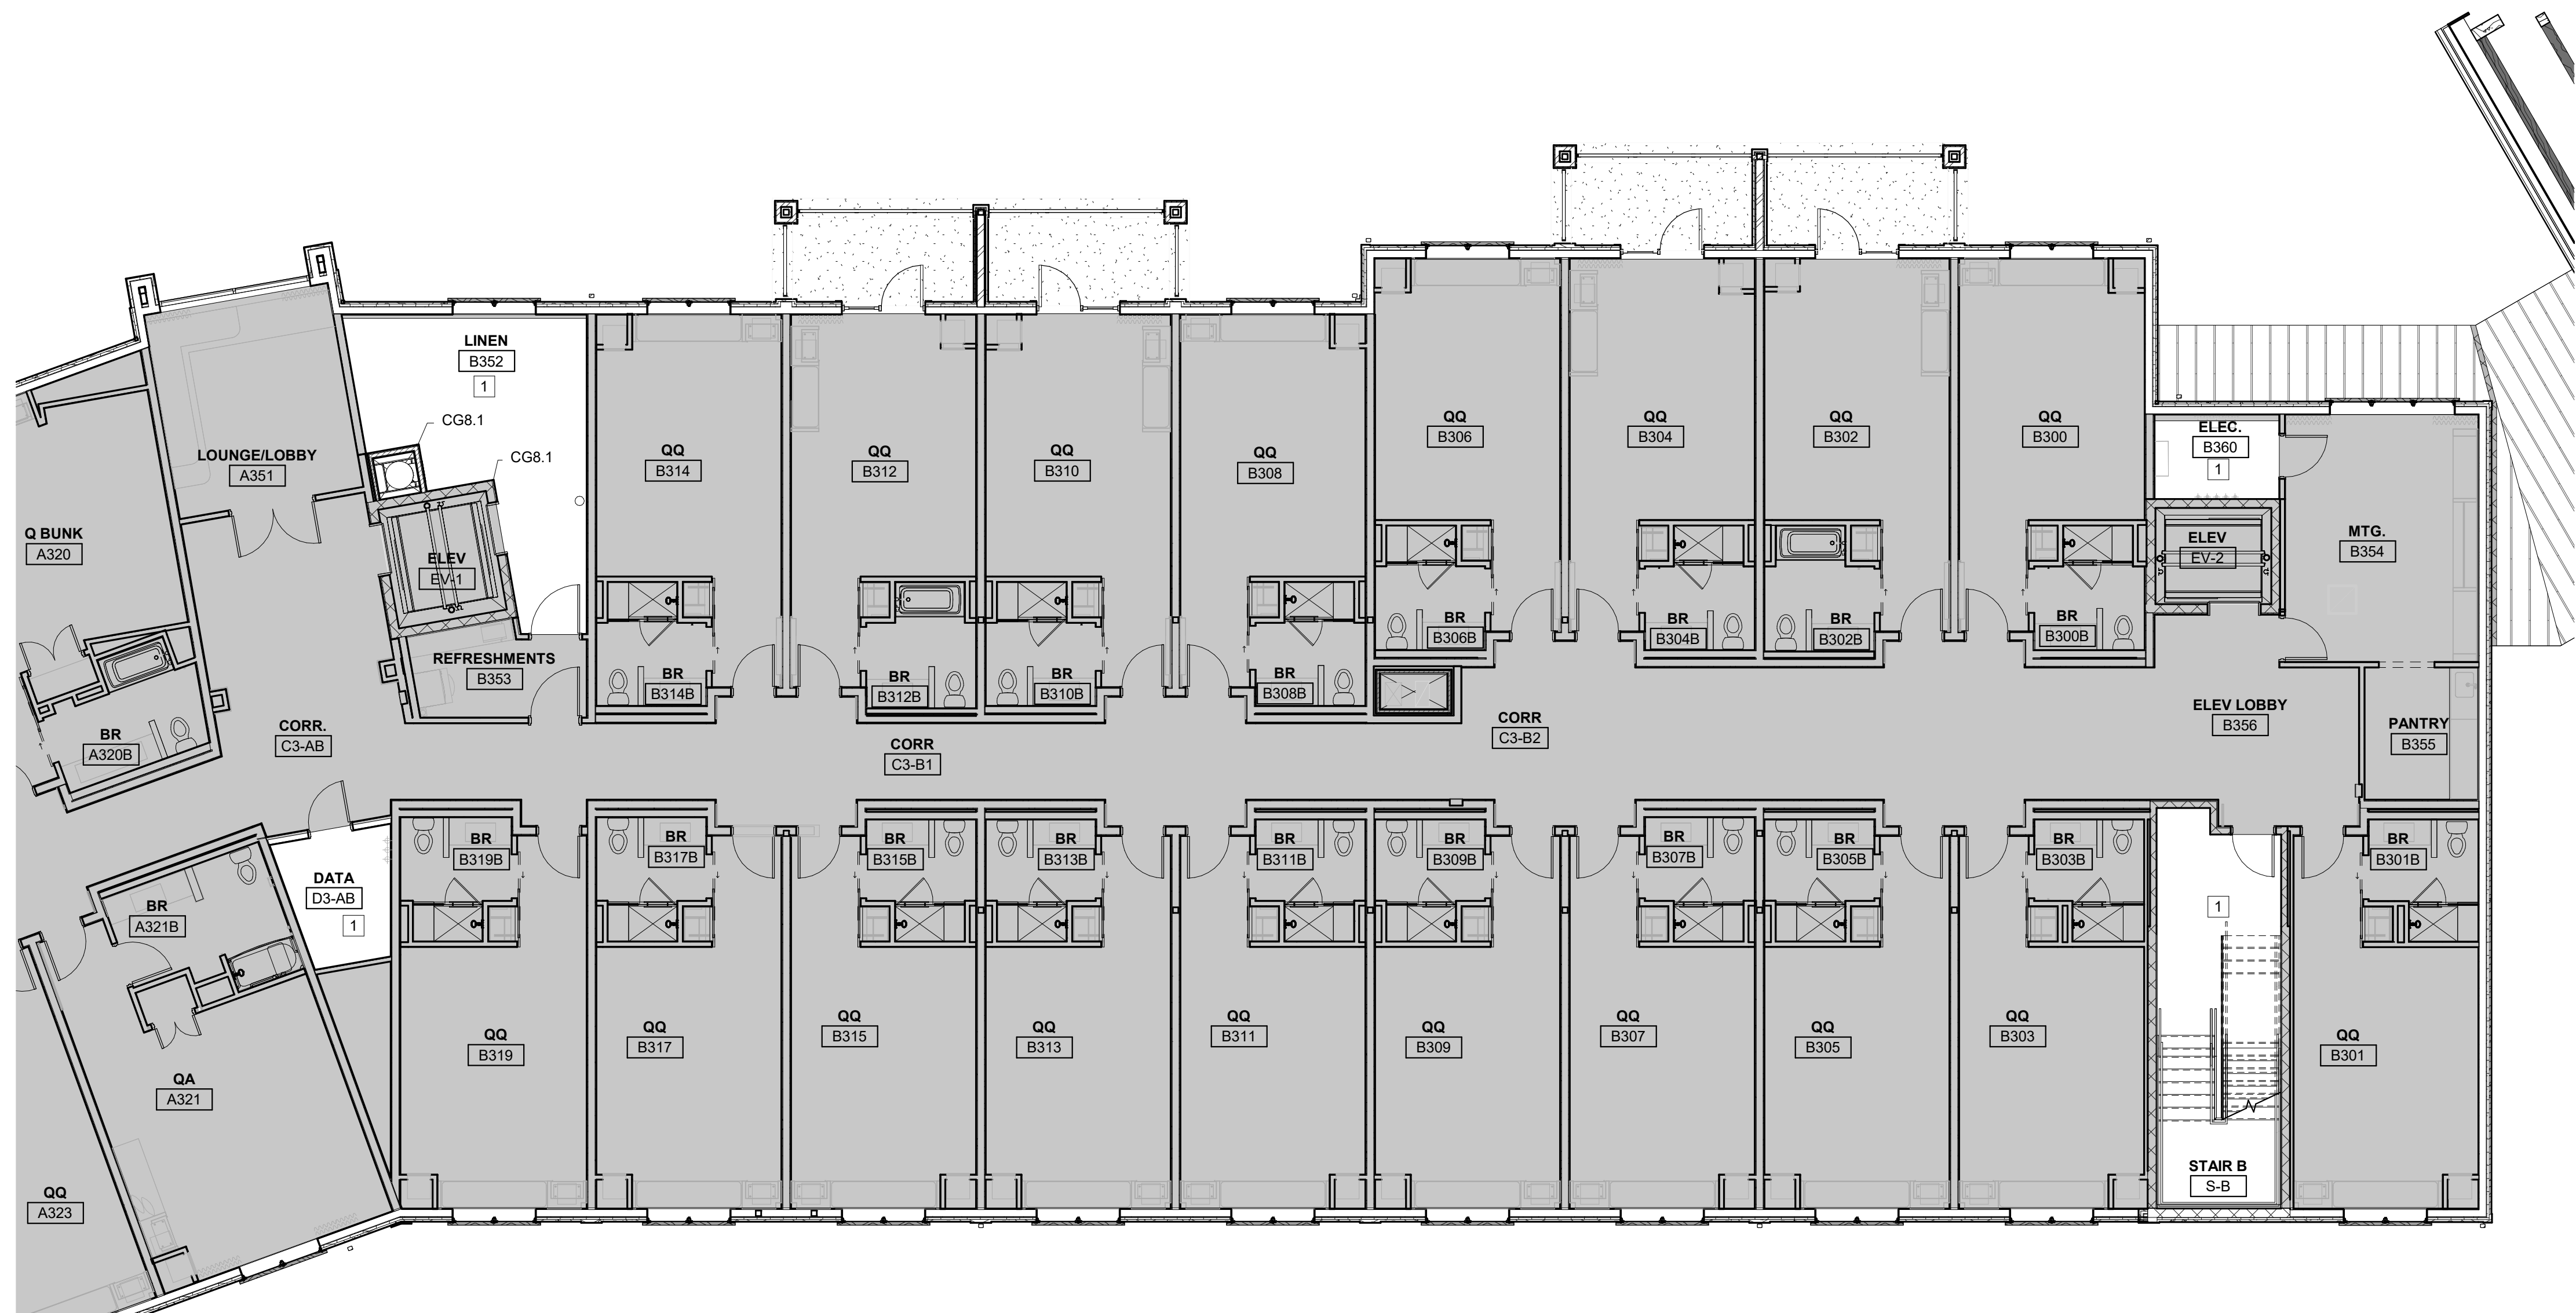

THIRD FLOOR BACK OF HOUSE FINISH PLAN - AREA 'B'

1/8" = 1'-0"

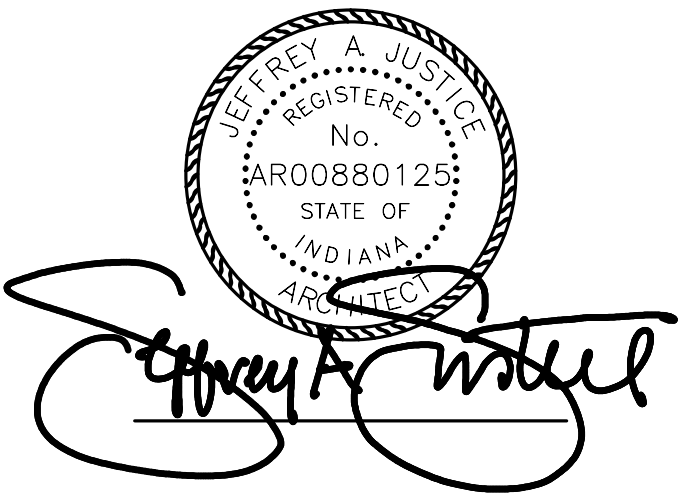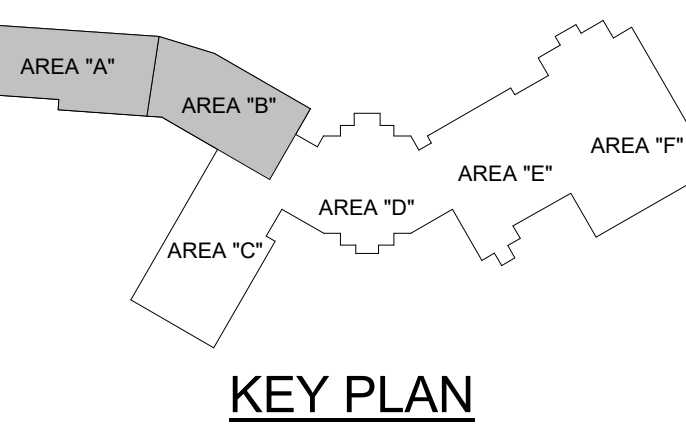

**BID SET
SEPTEMBER, 2023**

Revisions:		
#	Description	Date

Designed By: Drawn By: Checked By:

The drawings, specifications and other documents, including those in electronic form prepared by Haffer for this project are instruments of Service, and may be used solely with respect to this project. The documents may not be reproduced or modified by a third party without first obtaining the express written consent of Haffer. Authorized use of electronic media or file does not guarantee that these files contain complete and accurate information. In order to insure the accuracy of the information contained and that no changes or modifications have been made, these files must be compared to the project's contract documents with stamped and sealed certification and applicable approved modifications.

Sheet title:

THIRD FLOOR BACK-OF-HOUSE
AREA 'A' & 'B' FINISH PLANS

Architect's Project No: Date:

2111-295 September, 2023

Drawing No:

ID2.13