

ADDENDUM NO. 2

July 10, 2026

SCHOOL CITY OF HOBART VARSITY BASEBALL AND SOFTBALL TURF FIELDS PROJECT

TO: ALL BIDDERS OF RECORD

This Addendum forms a part of and modifies the Bidding Requirements, Contract Forms, Contract Conditions, the Specifications, and the Drawings dated June 29, 2026 by Gibraltar Design. Acknowledge receipt of the Addendum in the space provided on the Bid Form. Failure to do so may subject the Bidder to disqualification.

This Addendum consists of page ADD 2-1 and attached and attached Addendum No. 2 from Gibraltar Design dated July 10, 2026, consisting of 2 pages and 3 Drawings.

ADDENDUM TWO

Addendum Two (AD.02) to the drawings and specifications prepared by Gibraltar Design for **Hobart High School Baseball and Softball Field Replacement and Related Work** for School City of Hobart, Hobart, Indiana.

All Contractors bidding on this project shall read all of the items covered below and shall comply with all of the requirements as set forth, including any necessary refinements or additions generated by this Addendum and required by the intent of the original contract documents. All Contractors shall acknowledge on their bid form that they have received this Addendum, Addendum #1, and include the appropriate content of same within their bid proposal.

SPECIFICATIONS

- 1. Specification Section 13 34 16 Grandstands**
 - A. Add Paragraph 2.1.B.5. as follows: "5. Southeastern Seating, Inc., Tampa, Florida." as an acceptable manufacturer.
- 2. Specification Section 32 18 12 Synthetic Turf System**
 - A. Add Paragraph 2.1.A.6. as follows: "6. SportTurf, Dalton, Georgia" as an acceptable manufacturer.
 - B. Add Paragraph 2.1.A.7. as follows: "7. Midwest Sport and Turf System, a TenCate Company, Plainfield, Illinois" as an acceptable manufacturer..
- 3. Specification Section 32 31 13 Chain Link Fences and Gates**
 - A. Revise Paragraph 1.5.B.1. as follows: Delete the last sentence of the paragraph, and Paragraph 1.5.B.2. as follows: Delete the word 'Windscreens' from Additional Factors. Fencing design will not be required to utilize windscreens in their delegated design. The Owner will be advised to utilize break-away zip-ties if they elect to install windscreens in the future.

DRAWINGS

- 4. Sheet C-102**
 - A. Clarification to sheet not attached in this addendum. Change note #3 to read as note #2 at existing gate on north east corner of Varsity Baseball Field, previously modified in addendum no. 01,
- 1. Sheet C-202**
 - A. Refer to full-size drawing for clarification to EMS Sidewalk Alternate Scope fencing.
- 2. Sheet C-301**
 - A. Refer to full-size drawing for revisions to site grading at Varsity Softball Field.
- 3. Sheet C-401**
 - A. Refer to full-size drawing for revision to detail 9/C-401



GIBRALTAR

DESIGN

SC Hobart – Hobart HS Baseball & Softball Field
Replacement and Related Work

26-122

Pages 1 through 2, inclusive, and three (3) Full-Size Drawings, constitute the total makeup of **Addendum Two**.



GIBRALTAR

DESIGN

Y:\26-122 SC Hobart - Hobart HS BB and SB FIELD REPLACEMENT\SPCS\AD02\AD02.DOCX

GENERAL DEMOLITION NOTES:

- A. SITE SURVEY INFORMATION IS PROVIDED BY TORRENGA ENGINEERING. CONTRACTOR IS TO VERIFY ALL ELEVATIONS AND NOTIFY CONSTRUCTION MANAGER AND ARCHITECT OF ANY DISCREPANCIES.
- B. UNDERGROUND UTILITIES ARE SHOWN IN APPROXIMATE LOCATIONS BASED ON INFORMATION AT THE TIME OF SURVEY. CONTRACTOR IS RESPONSIBLE FOR DETERMINING EXACT LOCATIONS OF ALL EXISTING UNDERGROUND UTILITIES TO REMAIN AND REPAIRING OR REPLACING ANY DAMAGE DUE TO CONSTRUCTION ACTIVITY. CONTRACTOR IS TO NOTIFY CM AND ARCHITECT OF ANY DISCREPANCIES.
- C. CONTRACTOR IS TO MATCH UP TO ALL EXISTING CONCRETE SLABS, DUG-OUT WALLS/SLABS, ETC. TO THE GREATEST DEGREE POSSIBLE WHILE MAINTAINING TRUE ALIGNMENT OF THE PERIMETER LAYOUT OF FENCING.
- D. CONTRACTOR IS REQUIRED TO MATCH EXISTING GRADES TO THE GREATEST DEGREE POSSIBLE - REFER TO GRADING PLANS.
- E. CONTRACTOR IS RESPONSIBLE FOR COSTS ASSOCIATED WITH DISCONNECTING, REMOVING, OR RELOCATING/RECONNECTING EXISTING UTILITIES ALONG WITH CONNECTING NEW UTILITIES ASSOCIATED WITH CONSTRUCTION SCOPE.
- F. VALVES, MANHOLES, HAND-HOLES, UTILITY BOXES, AND SIMILAR STRUCTURES NOT DESIGNATED FOR REMOVAL, SHALL BE PROTECTED AND ADJUSTED TO NEW FINISH ELEVATIONS BY CONTRACTOR.
- G. CONTRACTOR IS TO VERIFY ALL DIMENSIONS, VERTICALLY AND HORIZONTALLY BETWEEN EXISTING AND NEW CONSTRUCTION, AND NOTIFY CONSTRUCTION MANAGER/ARCHITECT IF ANY DISCREPANCIES.
- H. CONTRACTOR IS TO PROVIDE TOTAL ARTIFICIAL TURF INSTALL COMPLETE, NEW TURF, NEW TURF DRAINAGE SYSTEM, NEW INFILL, NEW 2X4 PERIMETER TREATED WOOD BLOCKING, AND NEW LOGOS/TEXT AS INDICATED.
- I. CONTRACTOR IS TO COORDINATE AND PROVIDE FOR SUB-TURF ACCESS TO ANY EXISTING VALVES, HAND-HOLES, OR UTILITY BOXES AS REQUIRED.

LEGEND:

- INDICATES AREA OF NEW CONCRETE SLAB FOR NEW SLAB ON GRADE OR INFILL AT FENCING, NETTING POLE LOCATION, ELECTRICAL RUNS.
- INDICATES AREA OF NEW GRAVEL.

SITE LAYOUT NOTES


(ALL PLAN NOTES MAY NOT BE INDICATED ON THIS SHEET.)

- 1 PROVIDE NEW SYNTHETIC TURF AND SUB-BASE DRAINAGE SYSTEMS AS SPECIFIED. FULL PERIMETER CONCRETE CURB AND FENCING WITH 2X4 TREATED WOOD NAILER FOR TURF.
- 2 NEW SYNTHETIC TURF AND SUB-BASE DRAINAGE SYSTEM AS SPECIFIED INFIELD AND WARNING TURF.
- 3 ARTIFICIAL TURF BULLPEN.
- 4 INLAID TURF LOGO. REFER TO SPECIFICATIONS.
- 5 EXISTING BATTING CAGE TO REMAIN, PROVIDE NEW CARPET ON EXISTING CONCRETE.
- 6 RAISED PITCHING MOUND - WITH CONCRETE SUB-BASE WITH FIBER REINFORCING IN LIEU OF STONE SUB-BASE. CONTOUR CONCRETE SUB-BASE SIMILAR TO STONE MOUND SLOPING AWAY FROM PITCHING RUBBER. PROVIDE INSERT FOR PITCHING RUBBER ANCHORAGE. SET CONTOURED CONCRETE INTEGRATED INTO A 4" CONCRETE SLAB BELOW MOUND ON A MINIMUM OF 4" STONE DRAINAGE FILL.
- 7 NEW 4" OF #8 STONE IN THIS AREA.
- 8 NEW CONCRETE SLAB INFILL AND STONE BASE.
- 9 EXISTING FENCING TO REMAIN.
- 10 NEW 4'-0" TALL BLACK VINYL COATED FENCING SET IN CONCRETE.
- 11 NEW 6'-0" TALL BLACK VINYL COATED FENCING SET IN PERIMETER CONCRETE CURB.
- 12 RETAINING WALL NAILER CURB AT VARSITY SOFTBALL OUTFIELD WITH 6'-0" TALL BLACK VINYL FENCE. REFER TO GRADING PLAN.
- 13 VARSITY BASEBALL DUGOUT FENCING. 3'-6" TALL BLACK VINYL COATED.
- 14 VARSITY SOFTBALL DUGOUT FENCING. 3'-6" TALL BLACK VINYL COATED. PROVIDE OPENING ON BOTH ENDS OF EXISTING DUGOUT.
- 15 NEW 4'-0" BLACK VINYL COATED FENCING TIED INTO EXISTING.
- 16 NEW 6'-0" BLACK VINYL COATED FENCING TIED INTO EXISTING.
- 17 NEW 6'-0" HIGH BY 4'-0" WIDE BLACK VINYL COATED GATE TIED INTO DUGOUT CORNER.
- 18 NEW 6'-0" HIGH BY 12'-0" WIDE BLACK VINYL COATED DOUBLE GATE.
- 19 NEW 6'-0" HIGH BY 20'-0" WIDE SLIDING BLACK VINYL COATED GATE.
- 20 EXISTING DUGOUT. MASONRY WALL CONSTRUCTION WITH WOOD FRAMED ROOF TO REMAIN.
- 21 RELOCATE EXISTING SOFTBALL FLAG POLE TO THIS LOCATION. PROVIDE NEW FOUNDATION FOR EXISTING FLAGPOLE.
- 22 NEW FOUL POLE.
- 23 ATHLETIC LIGHTS, REFER TO ELECTRICAL.
- 24 EXISTING FLAGPOLE TO REMAIN.
- 25 NEW 6'-0" TALL GALVANIZED FENCE TIED INTO EXISTING GALVANIZED FENCING.
- 26 NEW 30'-0" BLACK NETTING BACKSTOP WITH SS CABLE SUPPORTS.
- 27 NEW 40'-0" TALL BLACK NETTING BACKSTOP WITH SS CABLE SUPPORTS.
- 28 APPROXIMATE LOCATION OF NEW NETTING POLE SUPPORT FOR BACKSTOP AND SAFETY NETTING SYSTEM OVER SPECTATOR SEATING AND CONCESSIONS. EXACT LOCATION OF NETTING POLES TO BE DETERMINED BY BACKSTOP NETTING DESIGNER AND ENGINEER. REFER TO SPECIFICATIONS TO DELEGATED DESIGN REQUIREMENTS.
- 29 CONCRETE SUB-BASE AT PITCHERS' CIRCLE - PROVIDE 4" FLAT SLAB OF CONCRETE WITH FIBER MESH REINFORCEMENT, AND MINIMUM OF 4" COMPACTED DRAINAGE STONE BELOW SLAB. SIZE OF SLAB IS TO COVER SIZE OF STANDARD PITCHING CIRCLE. INSTALL PITCHING RUBBER INTO MOUND, PROVIDE INSERT FOR PITCHING RUBBER ANCHORAGE.

ALTERNATE - SITE LAYOUT NOTES

(ALL PLAN NOTES MAY NOT BE INDICATED ON THIS SHEET.)

- A SCOREBOARDS: REMOVE AND RELOCATE EXISTING VARSITY FIELD SCOREBOARDS TO JUNIOR VARSITY BALL FIELDS, PER SPECIFICATIONS. PROVIDE NEW SCOREBOARD FOR VARSITY FIELDS, PER SPECIFICATIONS.
- VARSBASEBALL: DEMO EXISTING BASEBALL SCOREBOARD, SUPPORTS, AND ELECTRICAL IN ITS ENTIRETY. NEW SCOREBOARD TO BE INSTALLED IN NEW LOCATION INDICATED ON LAYOUT PLAN.
- VARSBASEBALL: DEMO EXISTING SUPPORTS IN THEIR ENTIRETY AND PROVIDE NEW SUPPORTS FOR NEW BOARD AT EXISTING LOCATION.
- JUNIOR VARSITY SOFTBALL AND BASEBALL: PROVIDE RELOCATED SCOREBOARDS ON TWO EXISTING SUPPORTS AND PROVIDE TWO NEW STRUCTURAL SUPPORTS FOR RELOCATED SCOREBOARDS, PER SPECIFICATIONS. CONTRACTOR IS TO PAINT ALL EXISTING STRUCTURAL STEEL THAT IS TO BE REUSED.
- B ELECTRIC POWER BOX SET IN SYNTHETIC TURF. REFER TO ELECTRICAL.
- C NEW MASONRY WALL FOR NETTING BACKSTOP
- D EMS ACCESS: PROVIDE NEW VEHICLE ACCESS RAMP ON EXISTING SIDEWALK. WIDEN EXISTING SIDEWALK BY 6'-0" WITH NEW CONCRETE WALK WITH TURN DOWN EDGE OF SLAB TO EXTENTS INDICATED DUE TO GRADE CHANGE. REFER TO GRADING PLAN. PROVIDE NEW 12'-0" DOUBLE BLACK VINYL COATED GATE IN NEW FENCE.
- E GRANDSTANDS: RELOCATE EXISTING FIXED ALUMINUM GRANDSTANDS FROM VARSITY BALL FIELDS TO JUNIOR VARSITY FIELDS. PROVIDE NEW GRANDSTANDS, ON EXISTING CONCRETE PAD, ELEVATED 4'-0" AT VARSITY SOFTBALL FIELD. PROVIDE NEW GRANDSTANDS, ON EXISTING CONCRETE PAD, AT VARSITY BASEBALL FIELD.
- F PROVIDE NEW CONCRETE SLAB IN LIEU OF GRAVEL IN THIS LOCATION BETWEEN VARSITY AND JUNIOR VARSITY FIELDS.

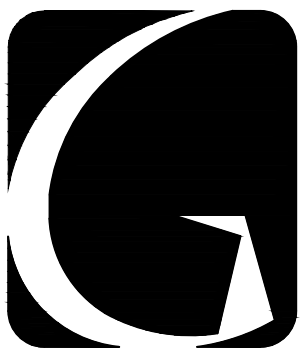

GIBALTAR
DESIGN
ARCHITECTURE • ENGINEERING • INTERIOR DESIGN

PROJECT
**HOBART HS
BASEBALL AND
SOFTBALL FIELD
REPLACEMENT
AND RELATED
WORK**

FOR:
SCHOOL CITY OF HOBART
32 E. 7TH STREET, HOBART, IN
46342

**100% CONSTRUCTION
DRAWINGS
06/29/2026**

GIBALTAR DESIGN
4030 Vincennes Rd, Suite 100,
Indianapolis, IN 46268
Homepage www.GibraltarDesign.com
Email: info@GibraltarDesign.com
Phone: (317) 550-5777

PROJECT
26-122
DATE
06/29/26

COORDINATED BY
JPB

DRAWN BY
CND

CHECKED BY
JPB

COPYRIGHT NOTICE:
THE CONCEPTS, DESIGNS, PLANS, DETAILS, ETC. SHOWN ON THIS DOCUMENT ARE THE PROPERTY OF GIBALTAR DESIGN AND WERE CREATED FOR USE ON THIS SPECIFIC PROJECT. NONE OF THIS INFORMATION SHALL BE USED BY ANY PERSON OR FIRM FOR ANY PURPOSE WITHOUT THE EXPRESS WRITTEN CONSENT OF GIBALTAR DESIGN. THE OWNER MAY RETAIN COPIES FOR INFORMATION AND REFERENCE IN CONNECTION ONLY WITH THIS PROJECT.

REVISIONS

MARK	DATE	ISSUED FOR
AD.01	07/07/26	ADDENDUM NO. 01
AD.02	07/10/26	ADDENDUM NO. 02

DRAWING
**VARSBASEBALL TURF
LAYOUT PLAN**

PROJECT
**HOBART HS BASEBALL & SOFTBALL
FIELD REPLACEMENT AND RELATED
WORK**

GIBALTAR DESIGN

SHEET

C-202



PROJECT
HOBART HS
BASEBALL AND
SOFTBALL FIELD
REPLACEMENT
AND RELATED
WORK

FOR:
SCHOOL CITY OF HOBART
32 E. 7TH STREET, HOBART, IN
46342

GENERAL PLAN NOTES:

1. THE CONTRACTOR IS RESPONSIBLE TO VERIFY ALL EXISTING SITE CONDITIONS AND SHALL NOTIFY THE ARCHITECT/ENGINEER IMMEDIATELY OF ANY DISCREPANCIES BETWEEN THE EXISTING CONDITIONS AND ALL PROPOSED IMPROVEMENTS IN THE CONSTRUCTION DRAWINGS.
2. THE LOCATION OF THE IRRIGATION SPRINKLER SYSTEM AND SUB SURFACE (UNDERDRAIN) SEWER SYSTEM IS DEPICTED AS SHOWN ON THE 01/26/2006 DRAWING SET FOR THE HOBBART HIGH SCHOOL PREPARED BY GIBRLALTAR DESIGN. THE LOCATIONS SHOWN WERE PROPOSED AND ARE NOT AS-BUILT. THE LOCATIONS ARE APPROXIMATE AND SHOULD BE FIELD VERIFIED BY THE CONTRACTOR.
3. TEMPORARY BENCH MARKS FOR CONSTRUCTION ARE:
 - 1) TBM #1, THE NORTH RIM OF THE EXISTING MANHOLE WITH BEEHIVE CASTING LOCATED NORTHWEST OF THE VARSITY SOFTBALL FIELD.
ELEVATION = 628.68
 - 2) TBM #2, THE NORTH RIM OF THE EXISTING MANHOLE WITH BEEHIVE CASTING LOCATED NORTHEAST OF THE VARSITY SOFTBALL FIELD.
ELEVATION = 629.88
 - 3) TBM #3, THE NORTH RIM OF THE EXISTING BEEHIVE CATCH BASIN LOCATED NORTHWEST OF THE VARSITY BASEBALL FIELD.
ELEVATION = 629.70
 - 4) TBM #4, THE NORTH RIM OF THE EXISTING BEEHIVE CATCH BASIN LOCATED NORTHEAST OF THE VARSITY BASEBALL FIELD.
ELEVATION = 629.57

LEGEND
PROPOSED

C	CONCRETE
CB	CATCH BASIN
MH	MANHOLE
OG	OPEN GRATE
TC	TOP OF CURB
TU	TOP OF ARTIFICIAL TURF
	GRADE
	DRAINAGE FLOW
	NEW MANHOLE / NEW CATCH BASIN
	NEW STORM SEWER
	CONTOUR

LEGEND
EXISTING

	MANHOLE
	SANITARY MANHOLE
	CATCH BASIN/INLET
	FOUL BALL POLE
	POWER POLE
	LIGHT POLE
	WATER VALVE
	FIRE HYDRANT
	GAS VALVE
	PVC PIPING W/ SIZE (APPROX.)
	SPRINKLER HEADS
	CONTROL VALVE
	GATE VALVE
	WINTER BLOWOUT CONNECTION
	BACKFLOW PREVENTER
	GAS LINE
	ELECTRIC LINE
	CHAIN LINK FENCE
	UNDERDRAIN PIPE SYSTEM
	EXISTING SANITARY SEWER
	EXISTING STORM SEWER
	EXISTING WATER MAIN
	CONTOUR
	EXISTING SPOT ELEVATION

100% CONSTRUCTION
DRAWINGS
06/29/2026

GIBRALTAR DESIGN

4030 Vincennes Rd, Suite 100,
Indianapolis, IN 46268
Homepage www.GibraltarDesign.com
Email: info@GibraltarDesign.com
Phone: (317) 580-5777

PROJECT
26-122
DATE
06/29/26
COORDINATED BY
DCT
DRAWN BY
DCT EM
CHECKED BY
DCT

COPYRIGHT NOTICE:
THE CONCEPTS, DESIGNS, PLANS, DETAILS, ETC., SHOWN ON THIS DOCUMENT ARE THE PROPERTY OF GIBRALTAR DESIGN AND WERE CREATED FOR USE ON THIS SPECIFIC PROJECT. NONE OF THIS INFORMATION SHALL BE USED BY ANY PERSON OR FIRM FOR ANY PURPOSE WITHOUT THE EXPRESS WRITTEN CONSENT OF GIBRALTAR DESIGN. THE OWNER MAY RETAIN COPIES FOR INFORMATION AND REFERENCE IN CONNECTION ONLY WITH THIS

[illegible]

DRAWING
VARSITY SOFTBALL TURF GRADING
PLAN

PROJECT
HOBART HS BASEBALL & SOFTBALL
FIELD REPLACEMENT AND RELATED
WORK

© GIBRALTAR DESIGN

C-301

Z:\2026-5017 Hobart High School BB & SB Fields\dwg\2026-5017.dwg 7/6/2026 12:04:32 PM CDT



GIBRALTAR
DESIGN
ARCHITECTURE • ENGINEERING • INTERIOR DESIGN

PROJECT
**HOBBART HS
BASEBALL AND
SOFTBALL FIELD
REPLACEMENT
AND RELATED
WORK**

FOR:
SCHOOL CITY OF HOBBART
32 E. 7TH STREET, HOBBART, IN
46342

100% CONSTRUCTION
DRAWINGS
06/29/2026

GIBRALTAR DESIGN

4030 Vincennes Rd., Suite 100,
Indianapolis, IN 46268
Homepage: www.GibraltarDesign.com
Email: info@GibraltarDesign.com
Phone: (317) 580-5777

PROJECT
26-122
DATE
06/29/26
COORDINATED BY
JPB
DRAWN BY
CND
CHECKED BY
JPB


COPYRIGHT NOTICE:
THE CONCEPTS, DESIGNS, PLANS, DETAILS, ETC., SHOWN ON
THIS DOCUMENT ARE THE PROPERTY OF GIBRALTAR DESIGN AND
WILL BE ISSUED WITH VECTOR FILES FOR INLAID TURF LOGOS POST BID AWARDS
FOR ANY PURPOSE WITHOUT THE EXPRESS WRITTEN CONSENT
OF GIBRALTAR DESIGN. THE OWNER MAY RETAIN COPIES FOR
INFORMATION AND REFERENCE IN CONNECTION ONLY WITH THIS
PROJECT.

REVISIONS	MARK	DATE	ISSUED FOR
AD.02	07/10/26	ADDENDUM NO. 2	

DRAWING
**ARTIFICIAL TURF AND
ATHLETIC EQUIPMENT
DETAILS**


PROJECT
**HOBBART HS BASEBALL & SOFTBALL
FIELD REPLACEMENT AND RELATED
WORK**

© GIBRALTAR DESIGN SHEET
C-401

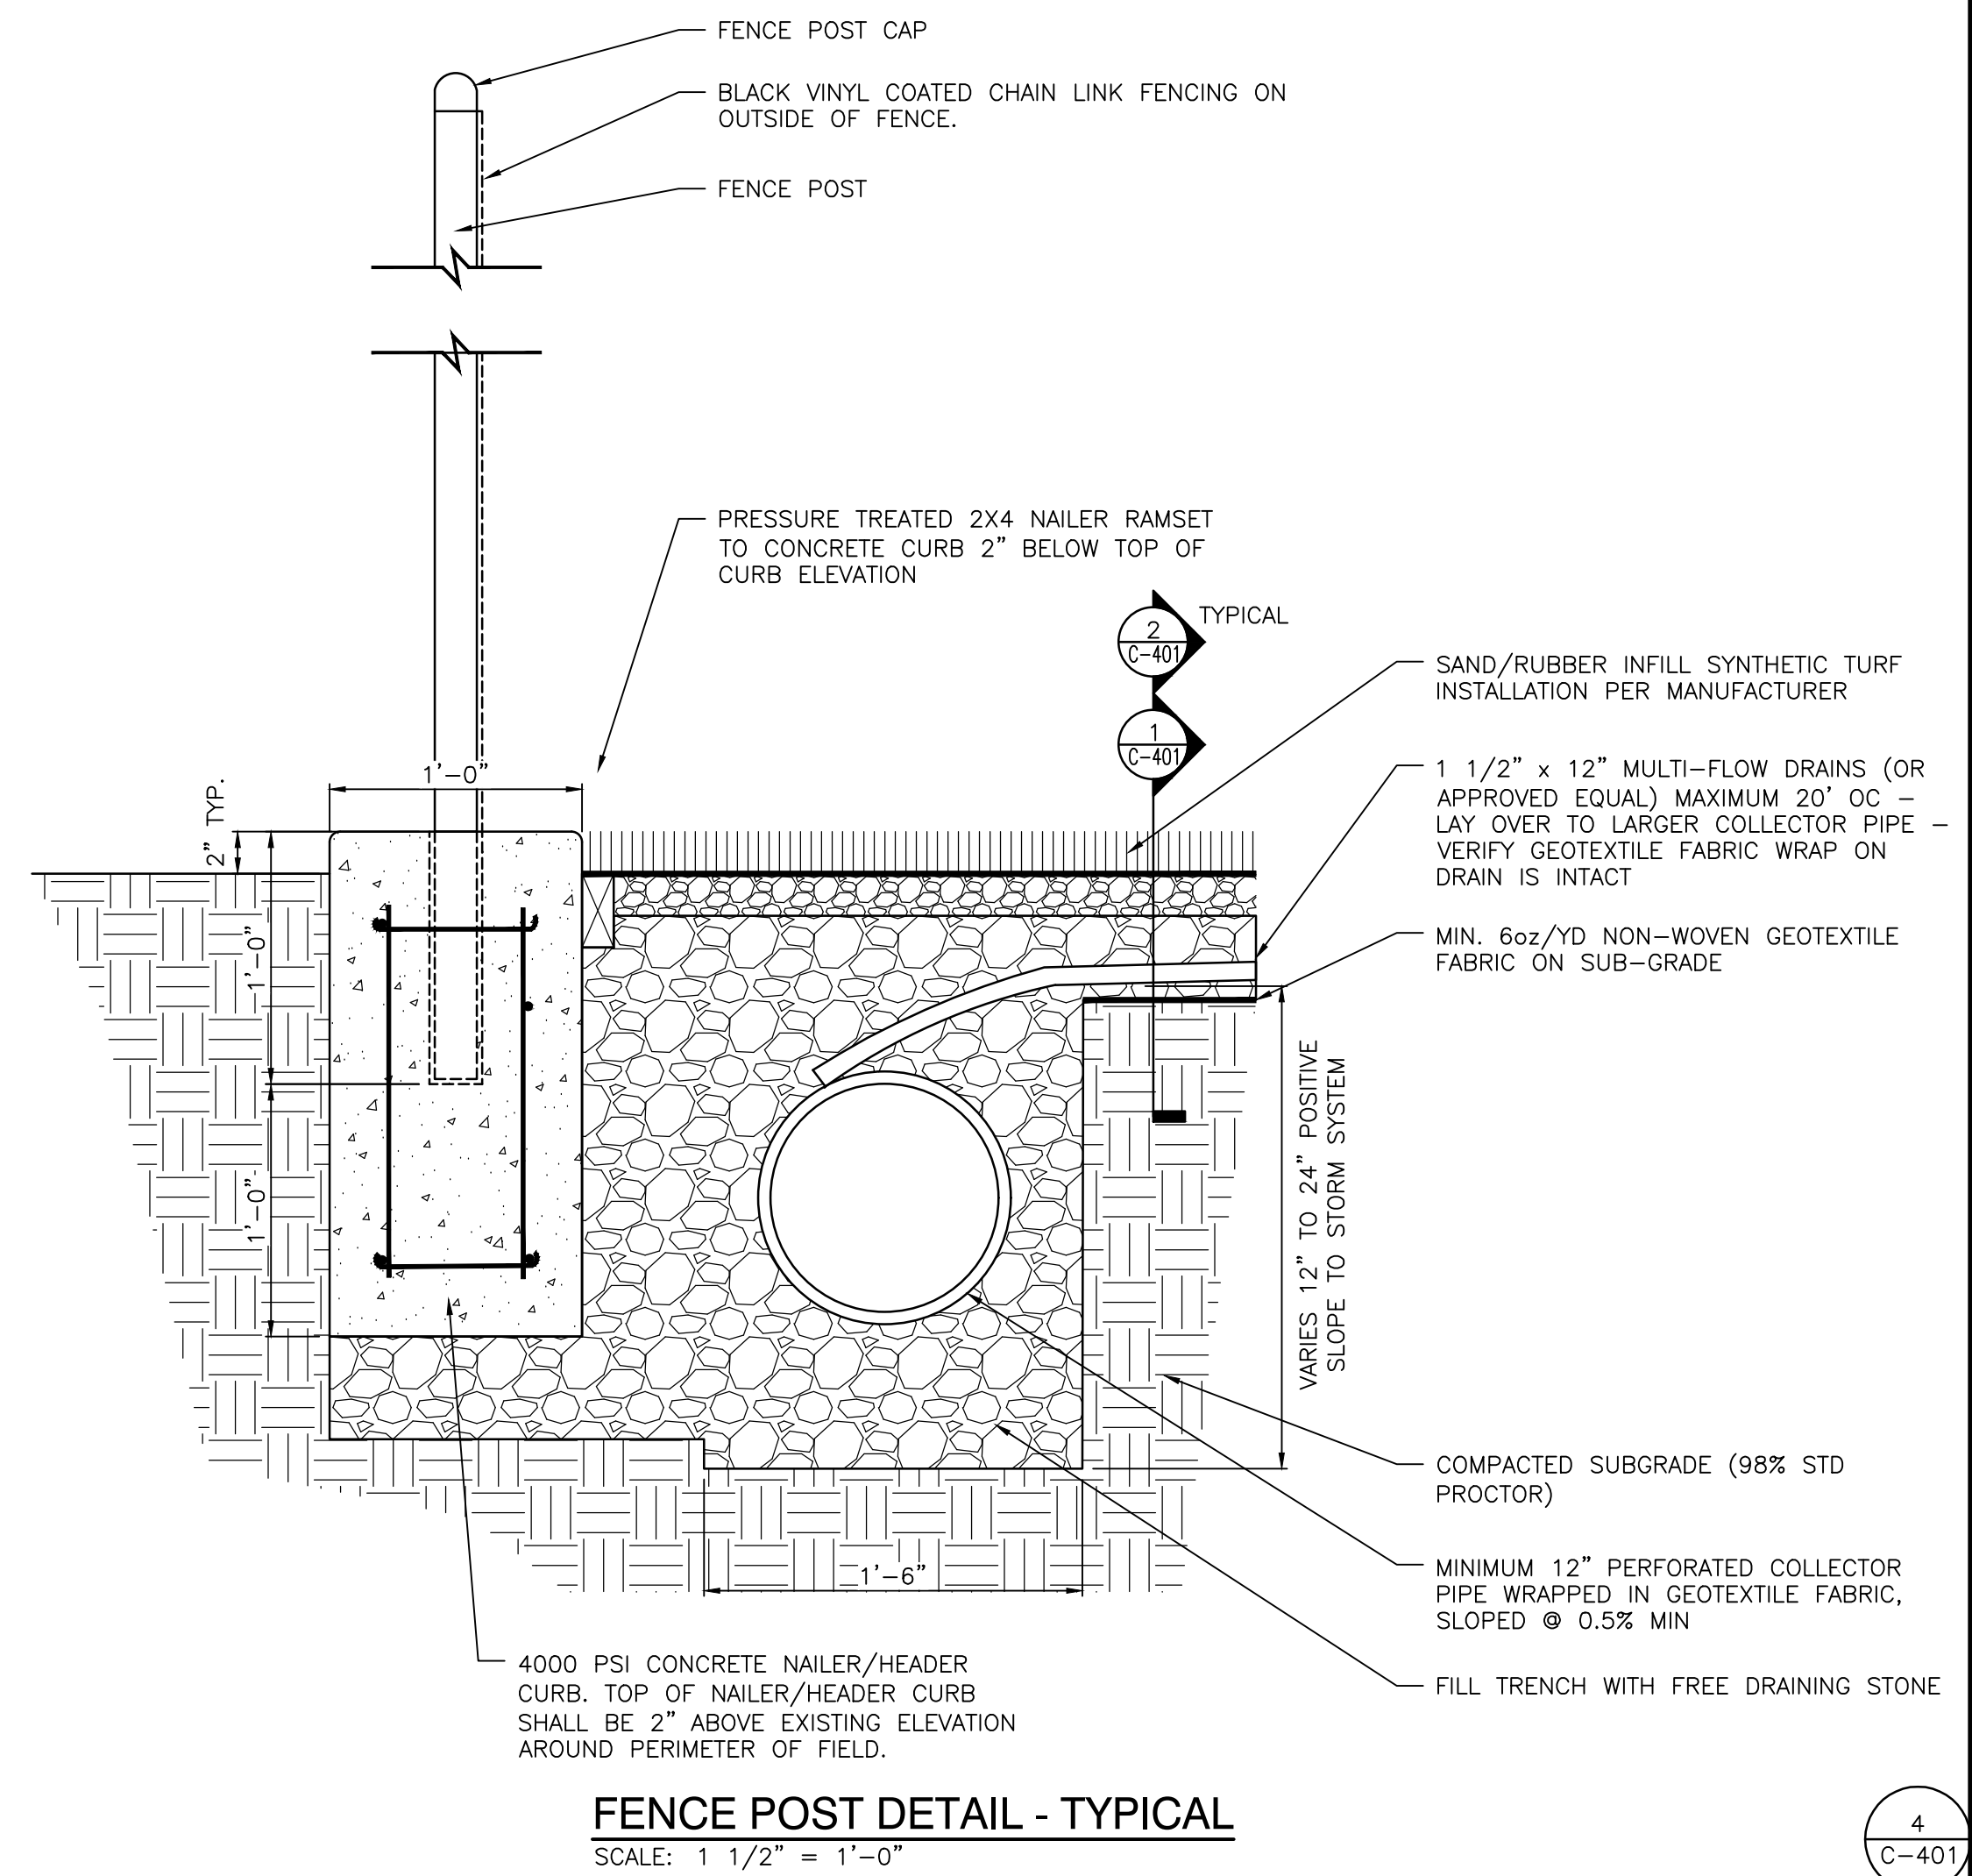


FENCE POST DETAIL - TYPICAL

SCALE: 1 1/2" = 1'-0"

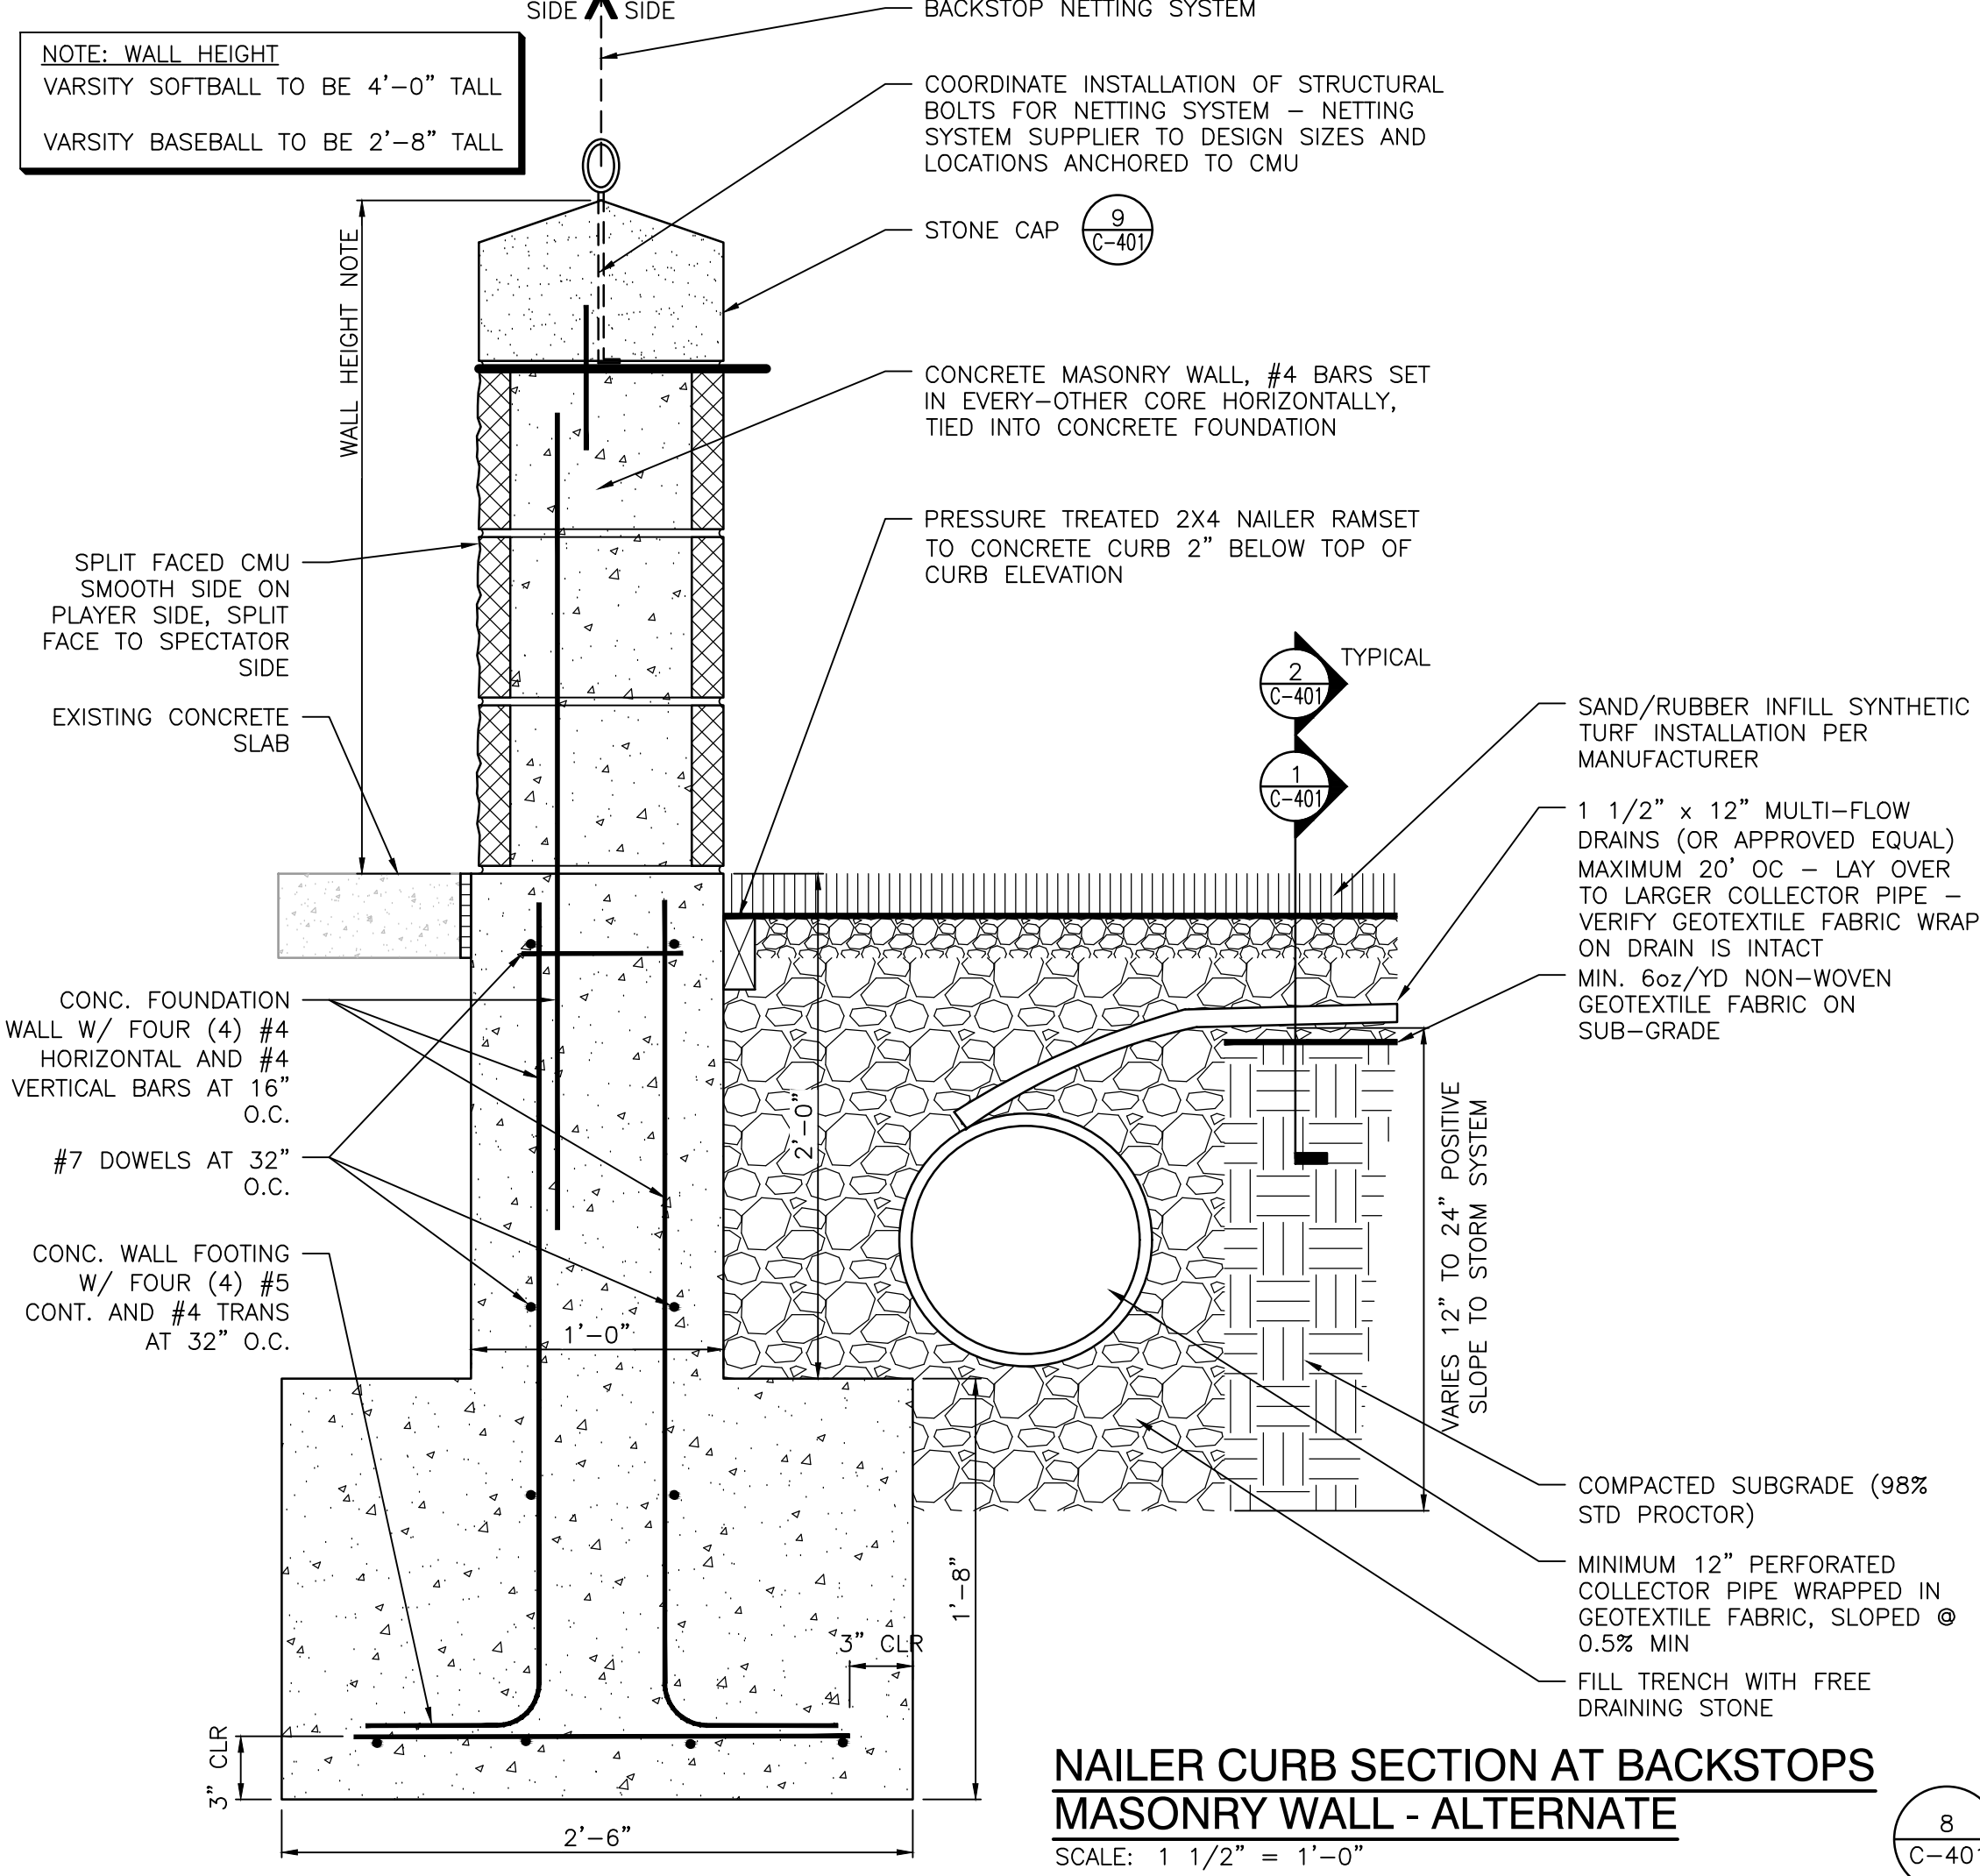


**NAILER CURB SECTION AT BACKSTOPS
MASONRY WALL - ALTERNATE**

SCALE: 1 1/2" = 1'-0"

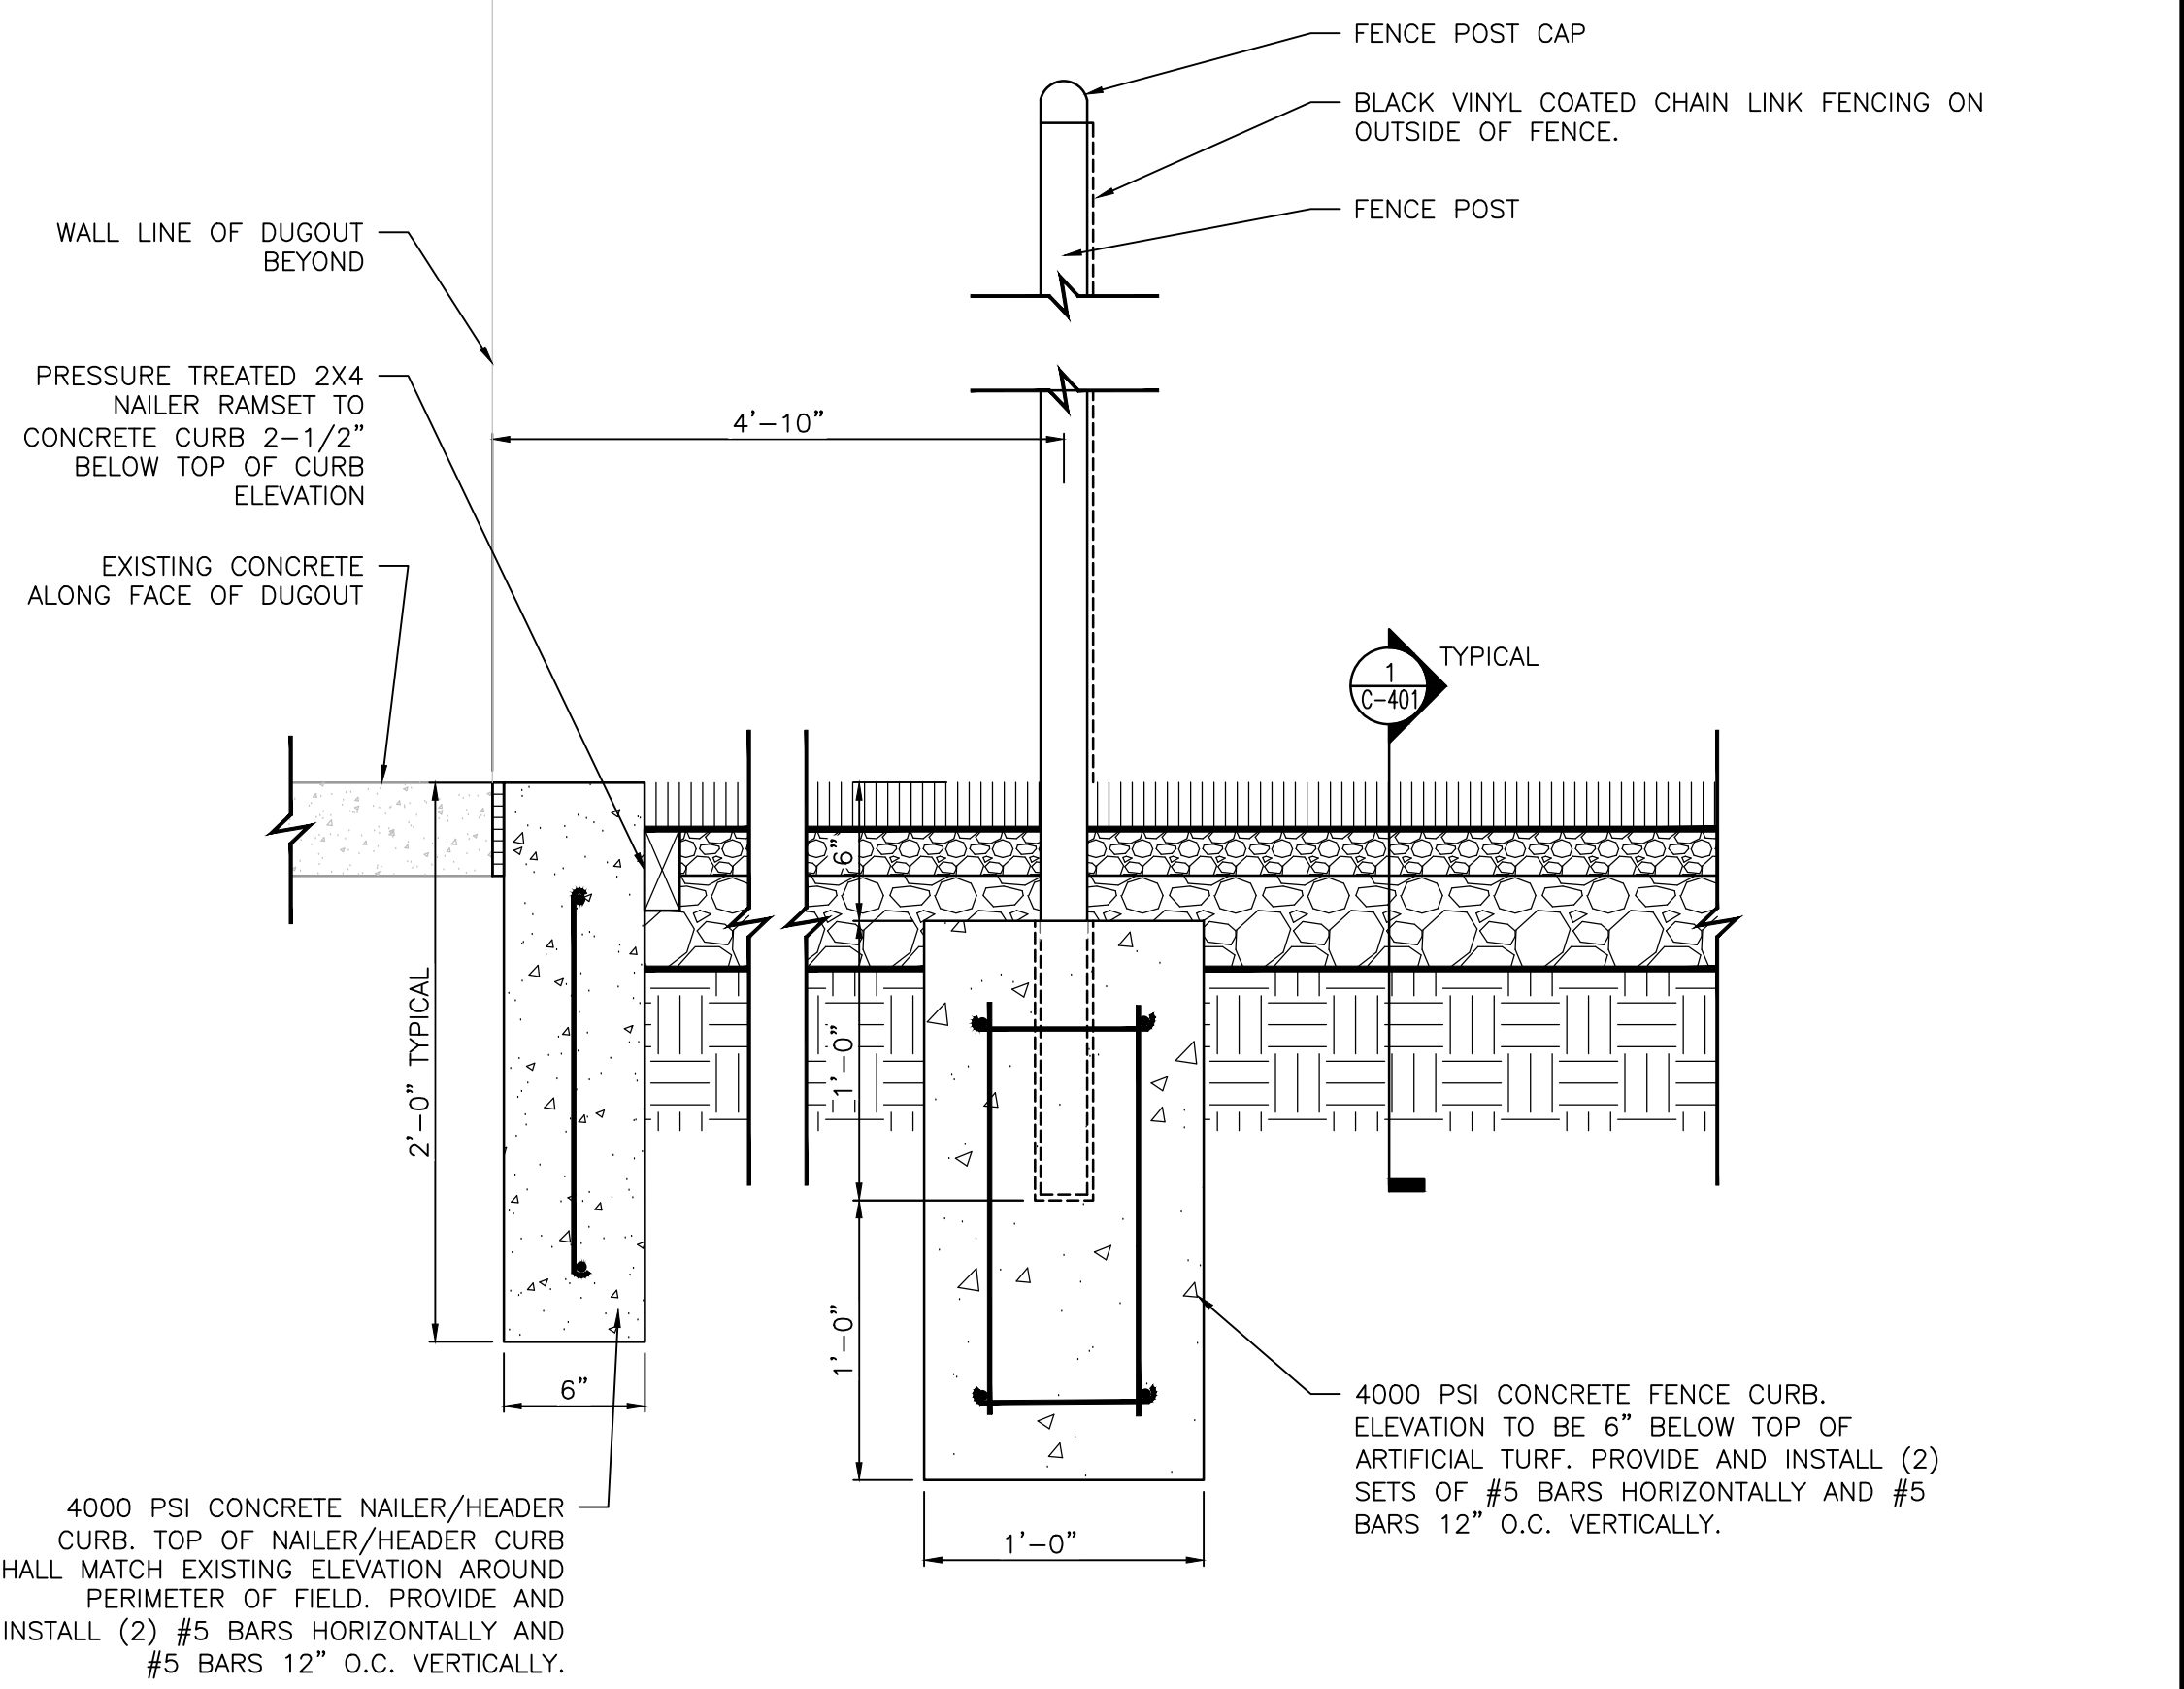


FENCE POST DETAIL AT DUGOUT - VARSITY BASEBALL

SCALE: 1 1/2" = 1'-0"

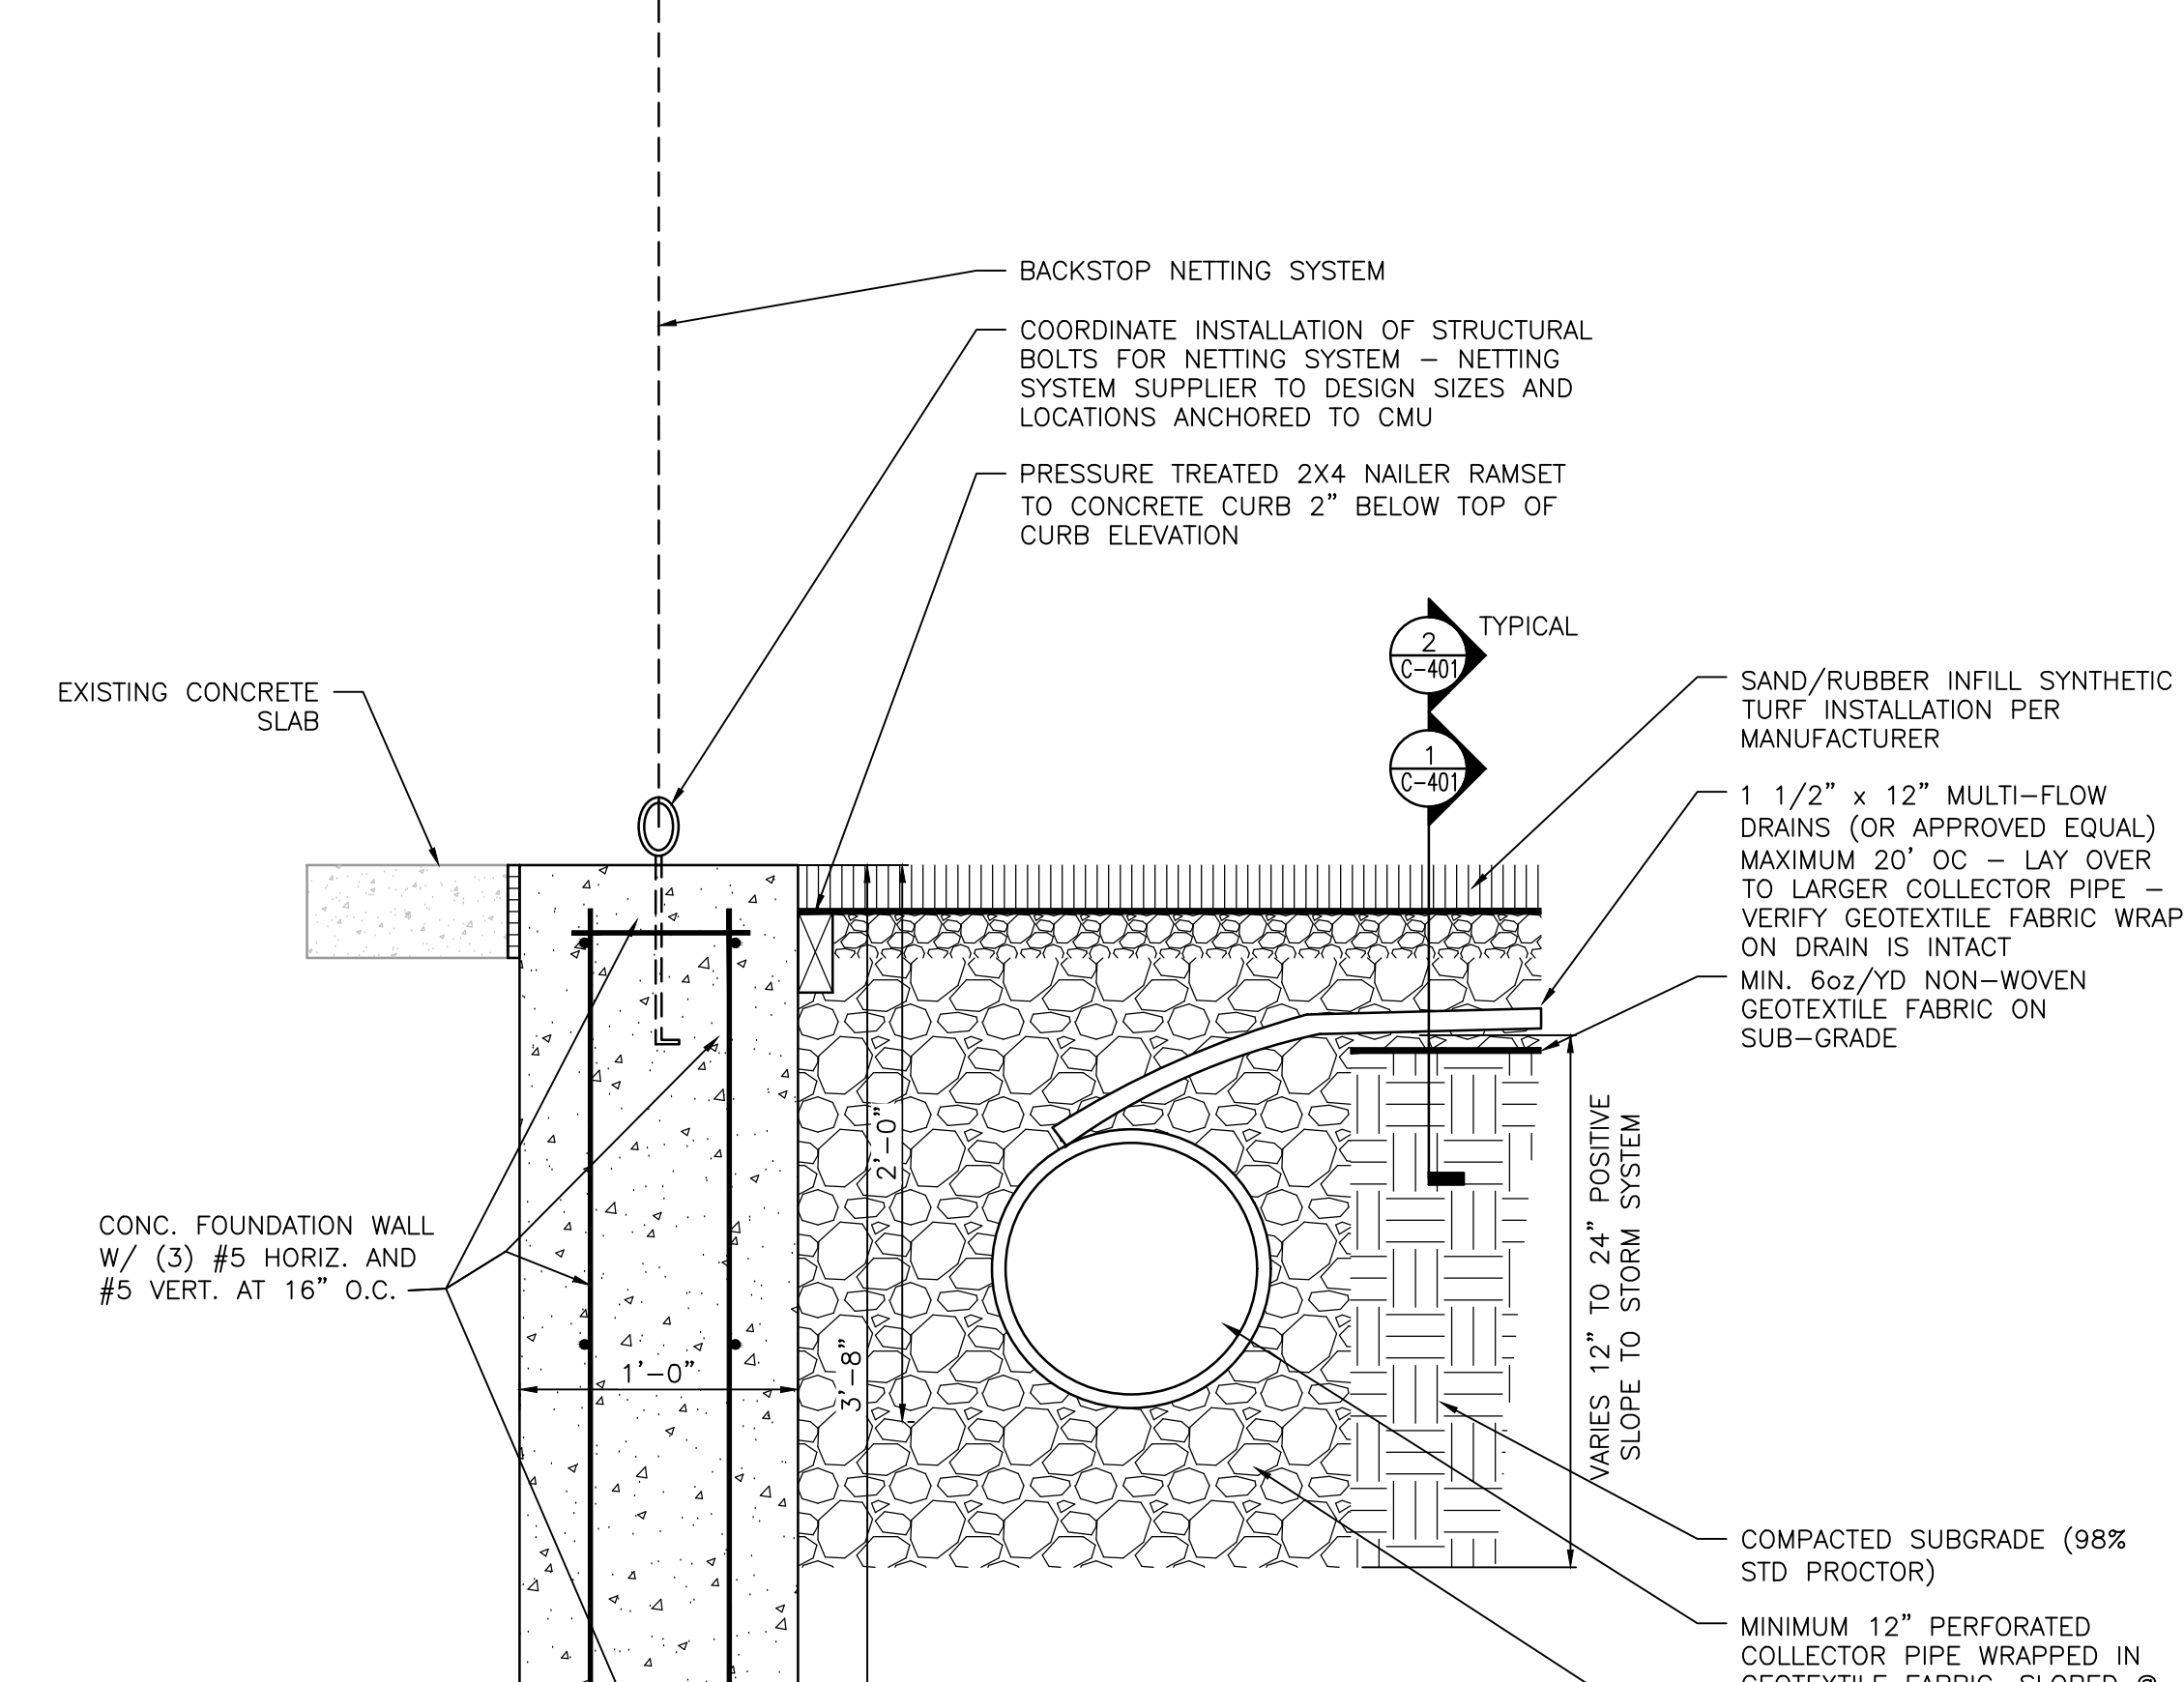


**NAILER CURB SECTION AT BACKSTOPS
MASONRY WALL - ALTERNATE**

SCALE: 1 1/2" = 1'-0"

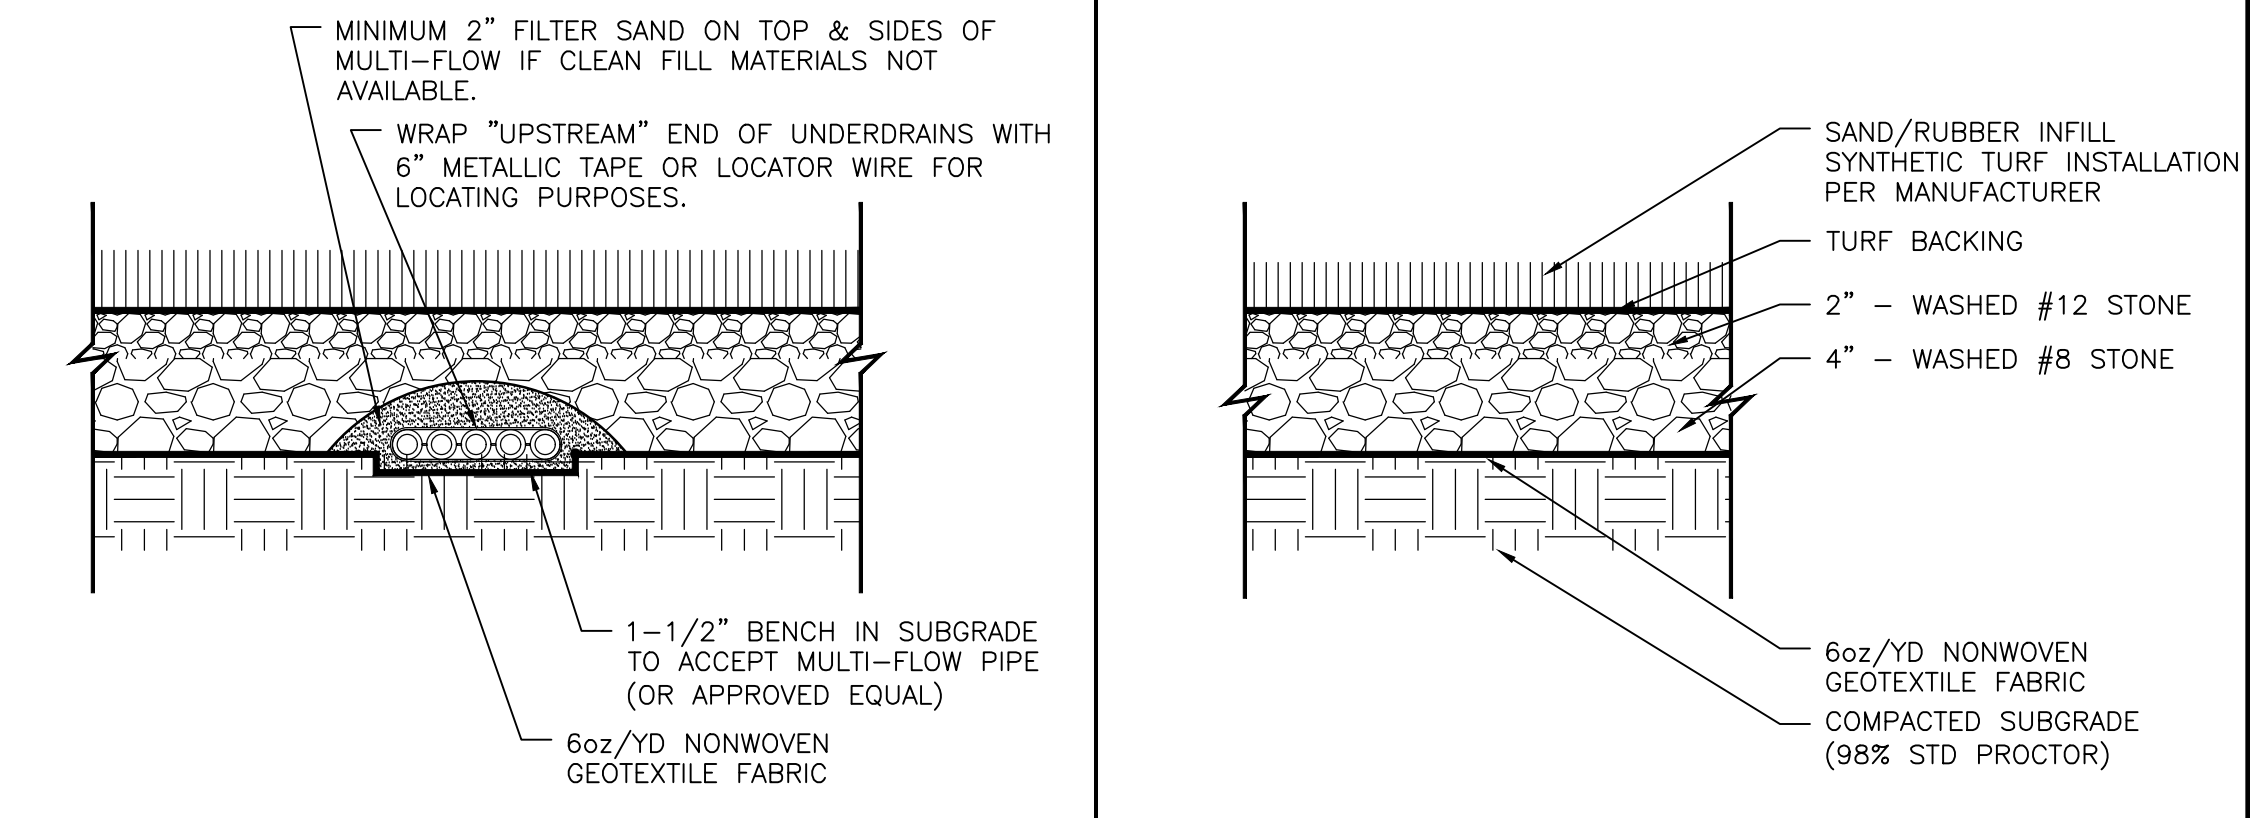


TYPICAL TURF DETAIL

SCALE: 1 1/2" = 1'-0"

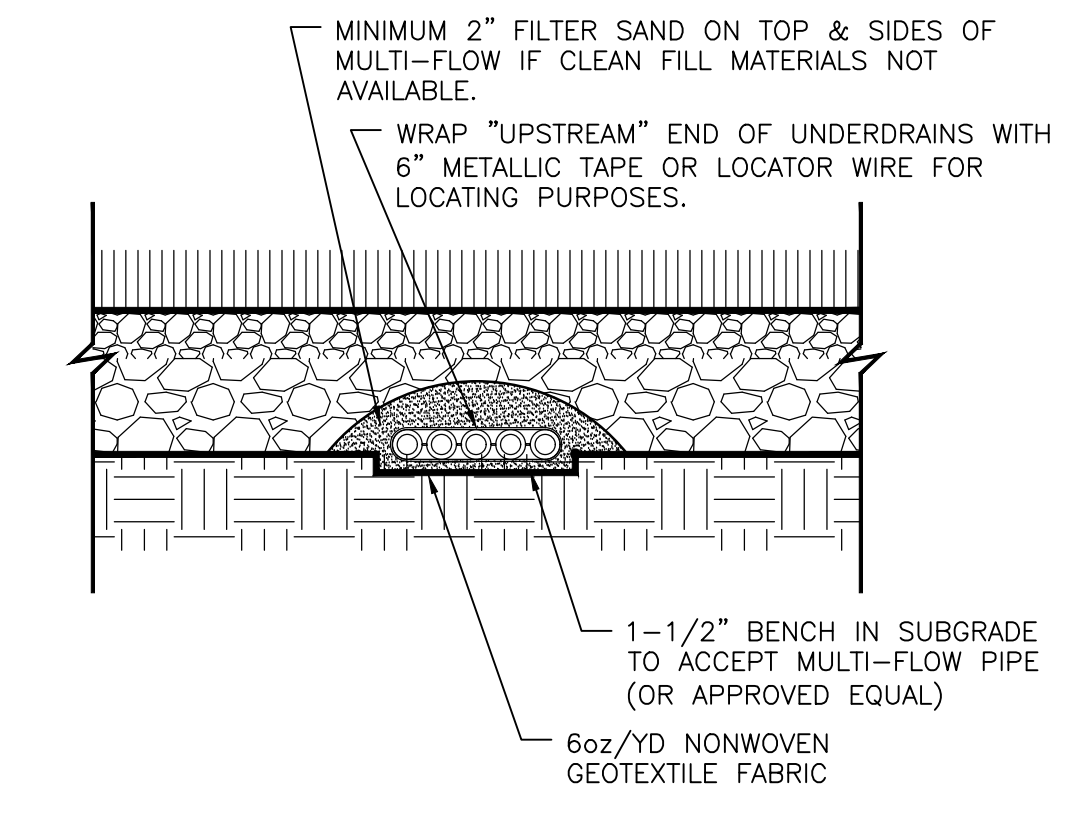


12\"/>

SCALE: NTS

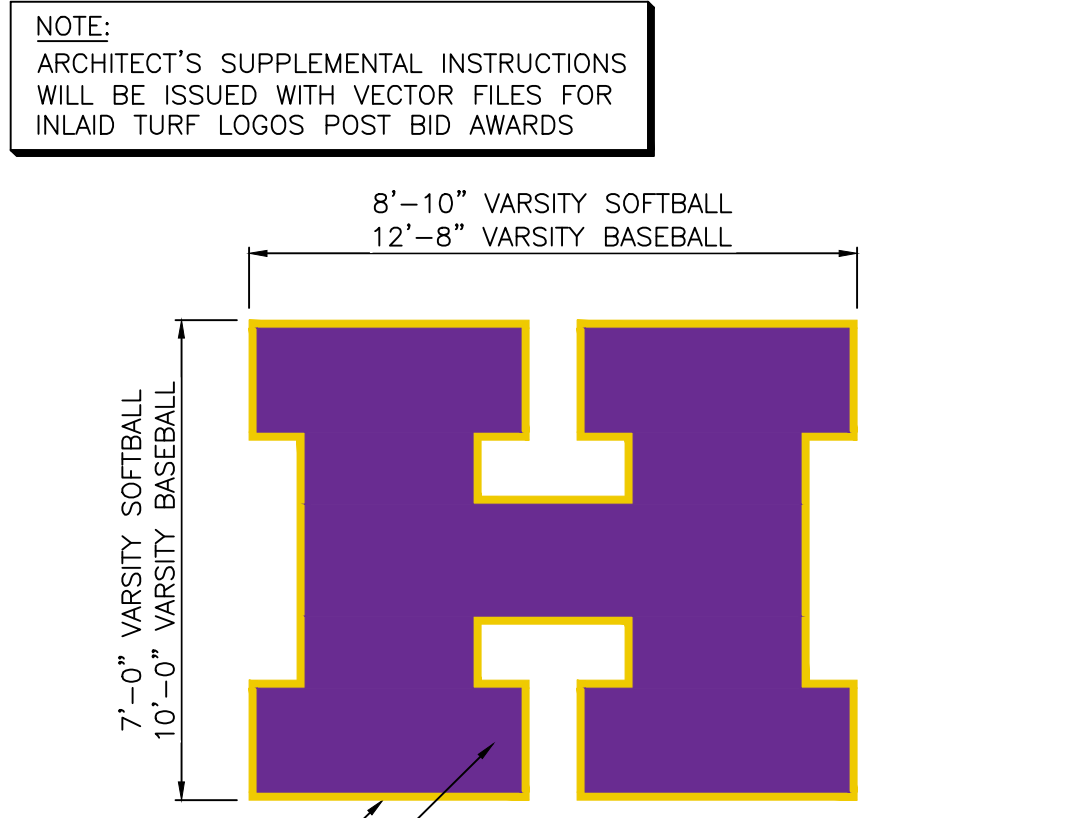


**VARSITY SOFTBALL
INLAID LOGO "H"**

SCALE: 1/4" = 1'-0"

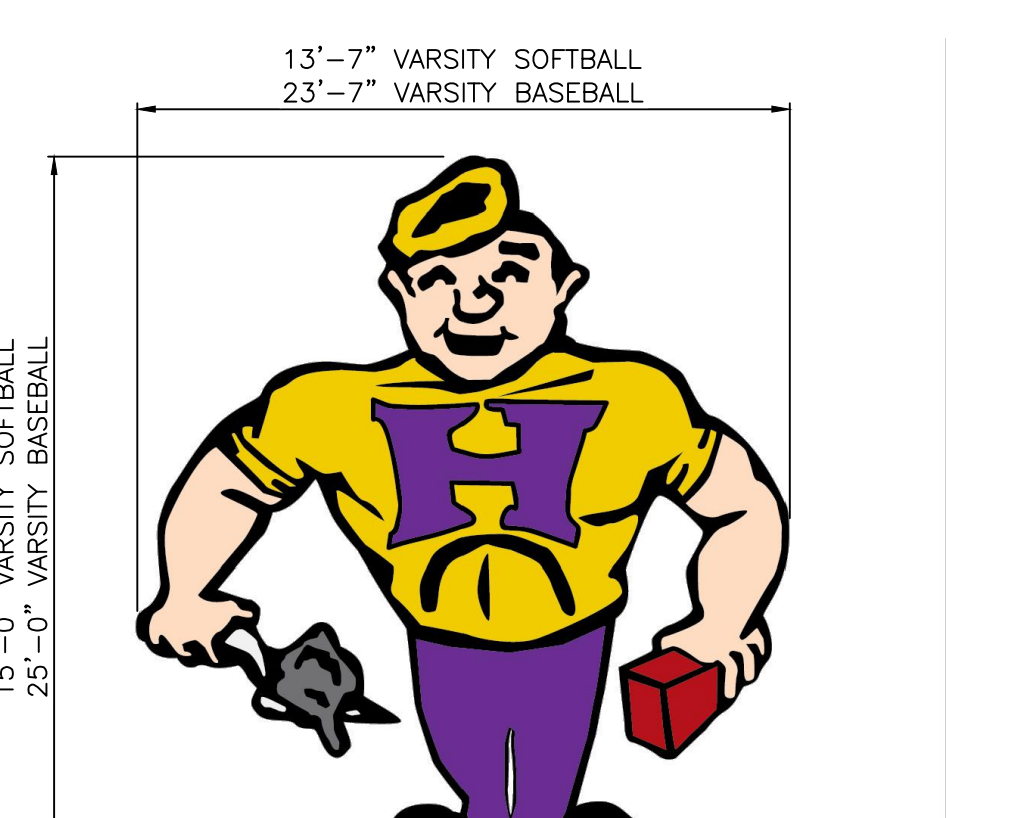


INLAID TURF LOGO "YOHAN"

SCALE: 1/4" = 1'-0"

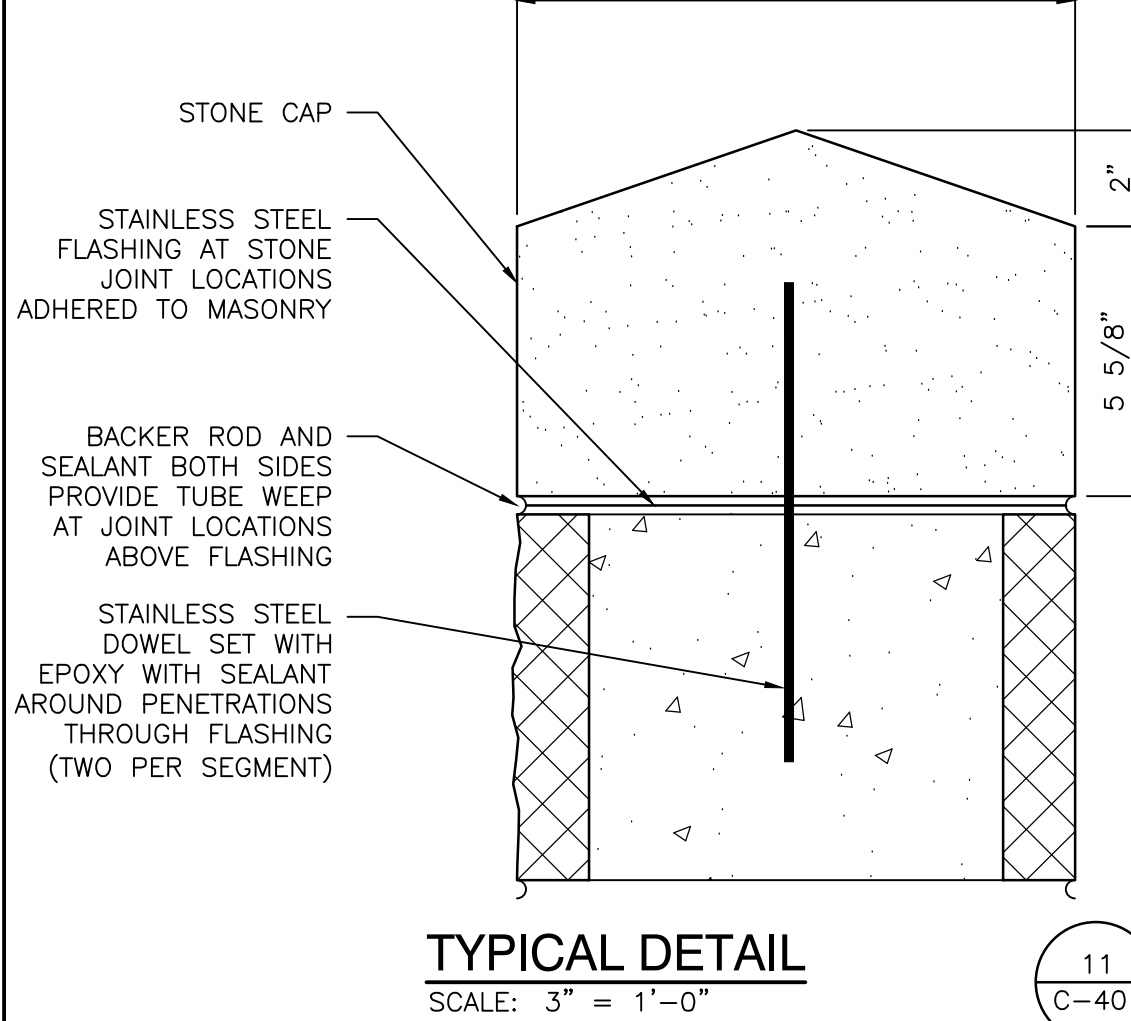


TYPICAL DETAIL

SCALE: 3" = 1'-0"

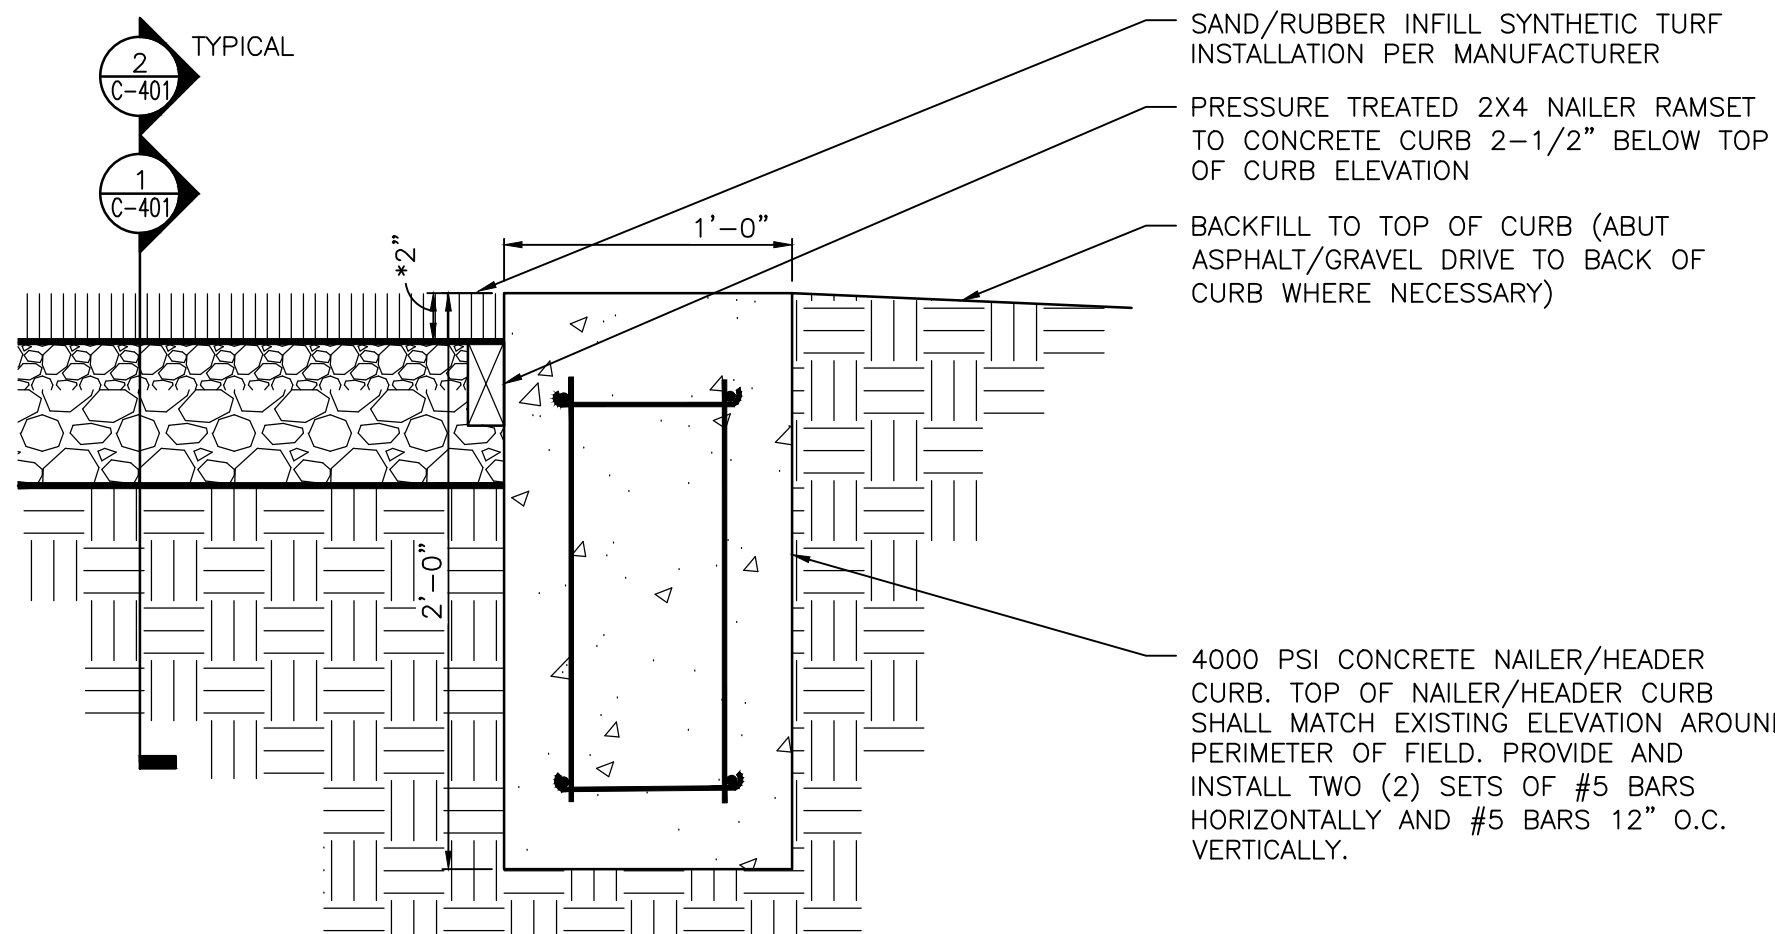

NAILER CURB SECTION - TYPICAL

SCALE: 1 1/2" = 1'-0"

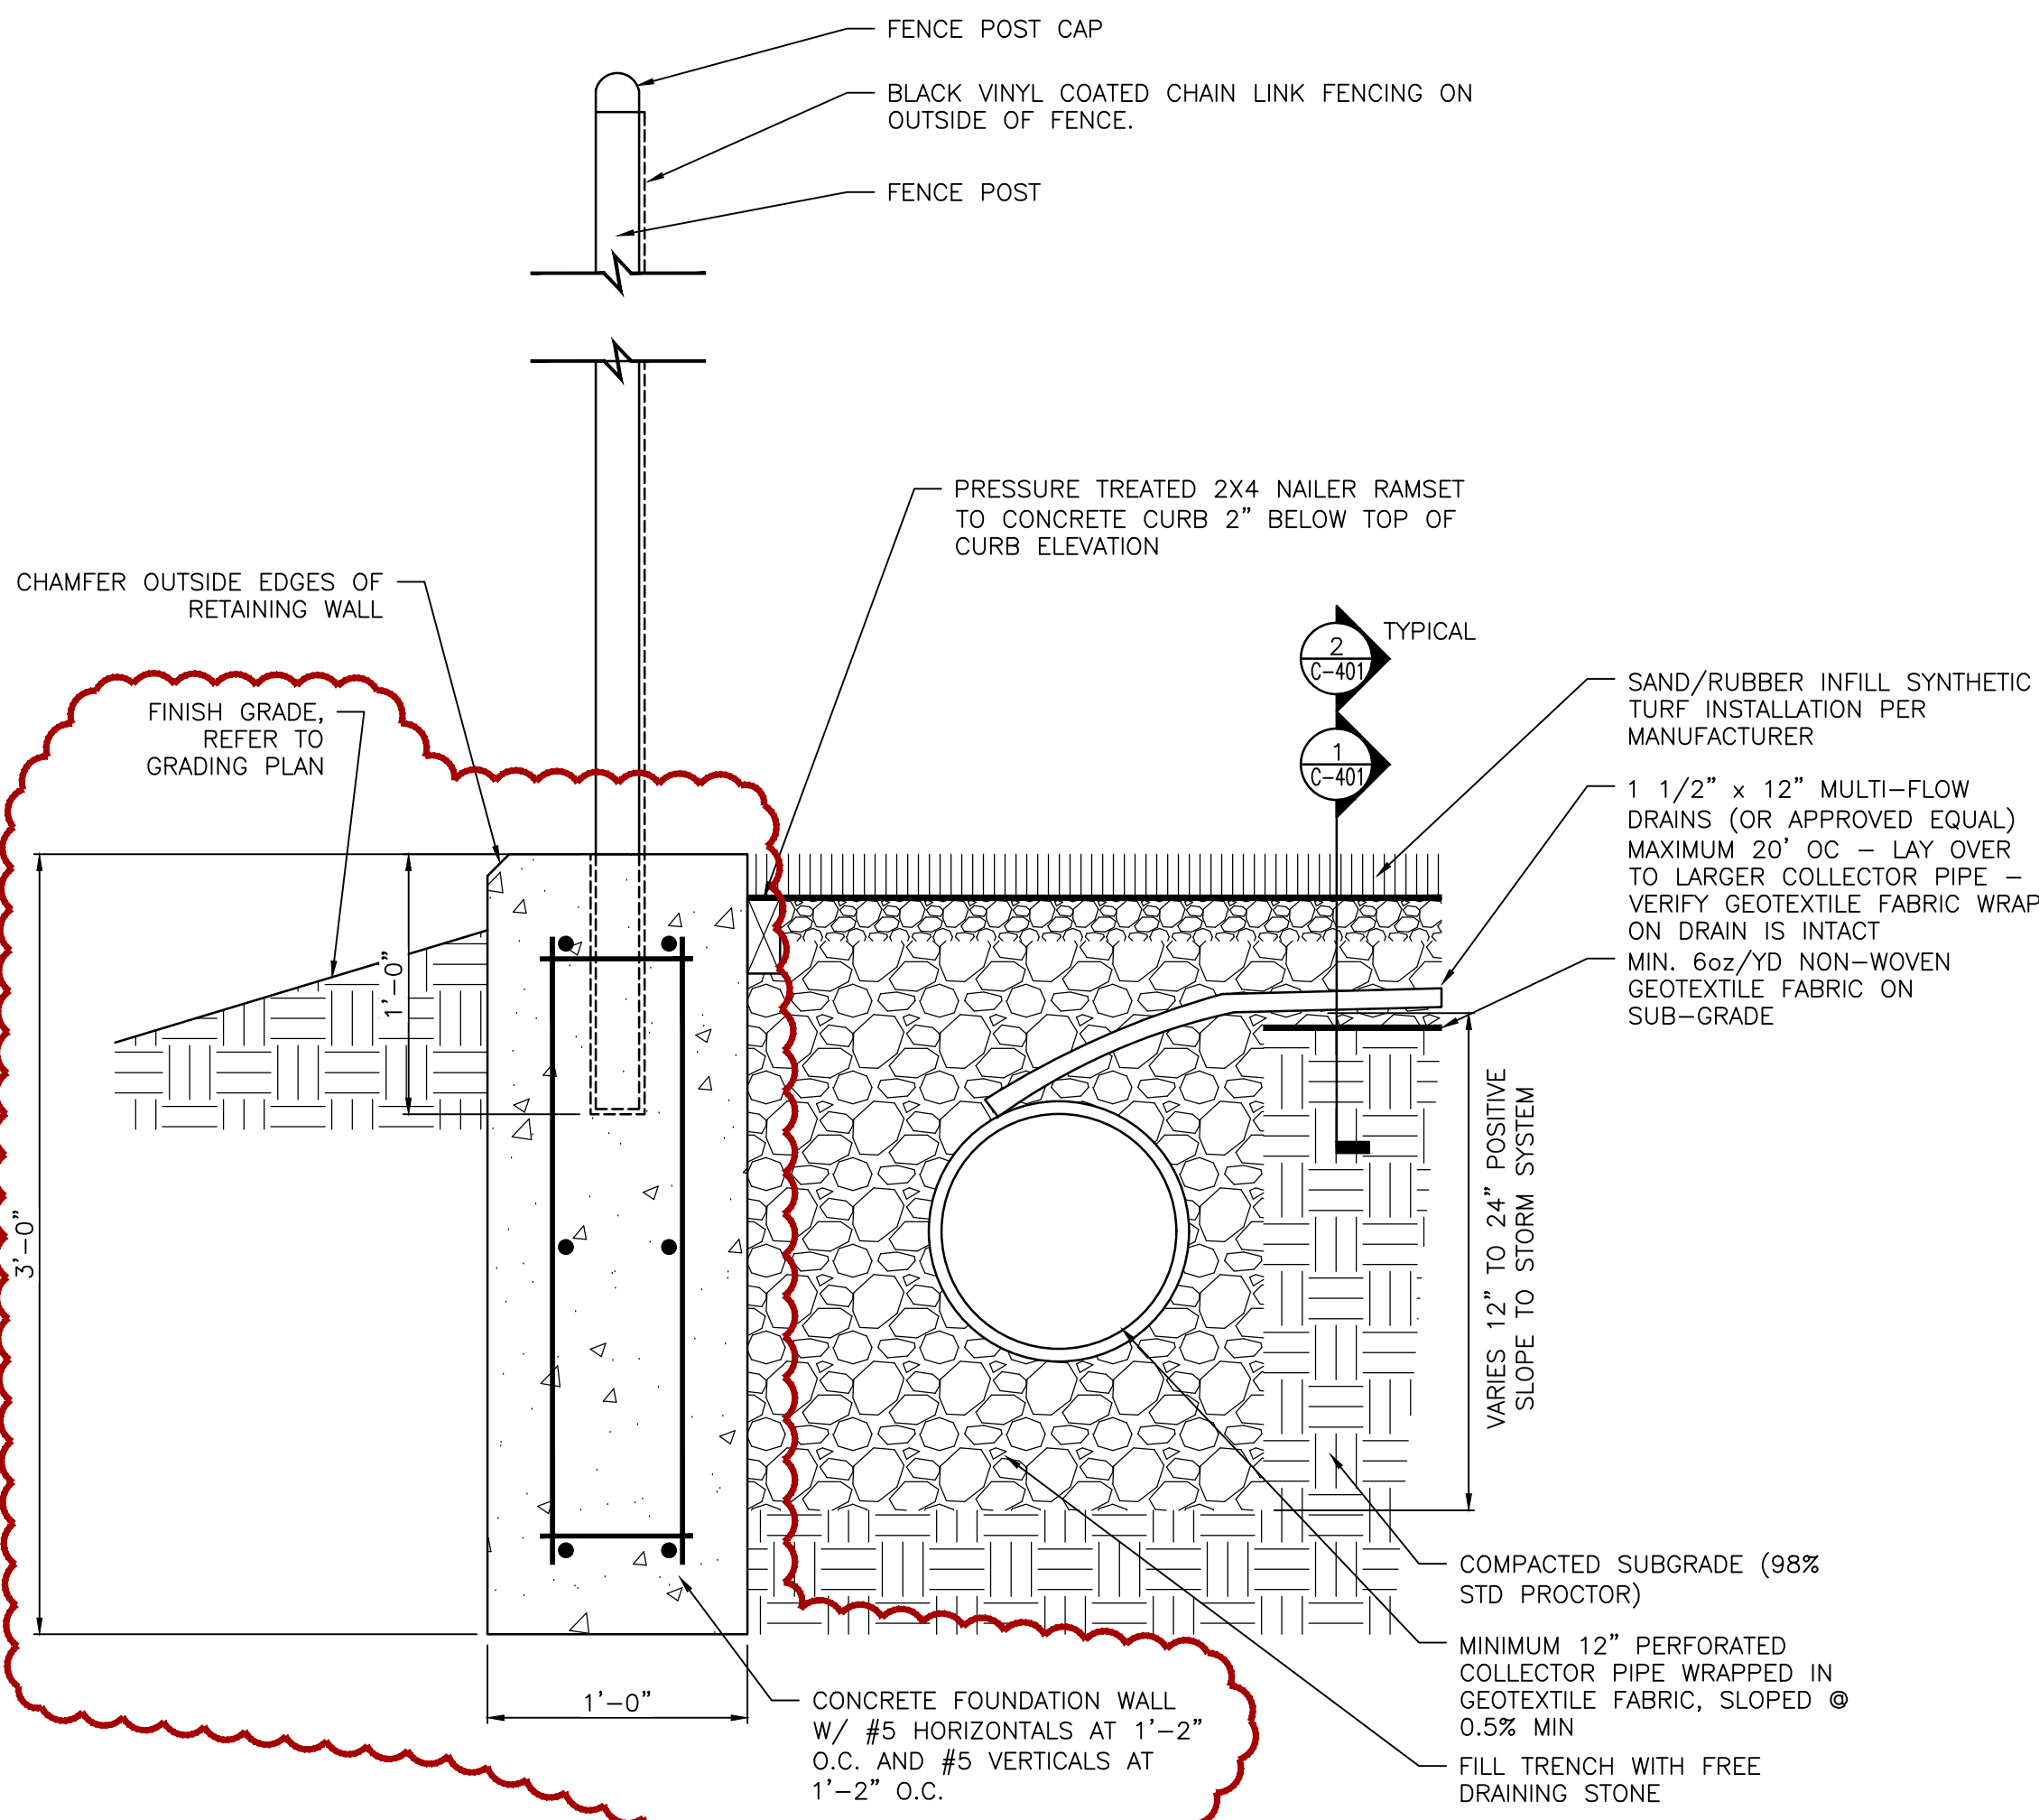

**NAILER CURB / GRADE BEAM
AT VARSITY SOFTBALL OUTFIELD.**

SCALE: 1 1/2" = 1'-0"