

[illegible]

ROOF EXHAUST FAN SCHEDULE												
S	AREA EXHAUSTED	FAN TYPE NUMBER	BACK SHEET NUMBER	C.F.M.	SP. SPEED W.G.	MOTOR DATA			POWER CIRCUIT	CONTROL NOTE #1	SEE NOTE	
						R.P.M.	H.P.	VOLTS				
1	1-11-13 1-15	EXHAUST	16" x 16"	1700	1/4	970	1/3	115	1	1L-31	M	1,2
2	1-1-17	EXHAUST	12" x 12"	140	1/4	750	1/6	115	1	1L1-29	ZONE #1	1,2,3
3	1-8-15 1-14	EXHAUST	12" x 12"	890	1/4	950	1/6	115	1	1L1-29	ZONE #1	1,2,3
4	1-1-17	EXHAUST	12" x 12"	180	1/4	750	1/6	115	1	1L1-27	T	1,2

NOTES:

1. FAN DESIGNATION (ZONE #1) CAN BE CONTROLLED BY PRESSURE CONTROL CONTRACTOR AND SHOWN.
2. FAN #1 CAN BE CONTROLLED BY MANUAL SWITCH PROVIDED BY THERMOSTAT CONTRACTOR.
3. FAN #2 CAN BE CONTROLLED BY THERMOSTAT CONTRACTOR.
4. FAN #3 AND #4 PROVIDED BY GENERAL CONTRACTOR.
5. TEMPERATURE CONTROL CONTRACTOR SHALL PROVIDE PRESSURE SWITCHES TO CONTROL EXHAUST FANS AS FOLLOWS:

DATE: 11/1/82 BY: R. B. BENTON

UNIT HEATER SCHEDULE									
NO.	ROOM SERVED	MOTOR AMPS	TYPE AND ARRANGEMENT	M.B.H.	FAN SPEED R.P.M.	W. X. H.	POWER CIRCUIT	C.F.M. STANDARD AIR	SEE NOTE
1	A-204	60-5	HORIZONTAL	34.6	1550	3.5	114-11	815	1,2
2	A-205	60-5	HORIZONTAL	34.6	1550	3.5	114-11	815	1,2
3	A-201 A-201A	60-5	HORIZONTAL	34.6	1550	3.5	113-14	815	1,2
4	A-202	60-5	HORIZONTAL	34.6	1550	3.5	112-15	815	1,2
5	A-203	60-5	HORIZONTAL	34.6	1550	3.5	111-21	815	1,2

NOTES:

- HEATING CAPACITIES ARE BASED ON 70°F. ENTERING AIR AND 110°F. ENTERING WATER. FINAL AIR TEMPERATURE SHALL BE 110°F. TO 140°F..
- MOTORS SHALL BE MULTI-SPEED, 120 VOLTS, 1 PHASE, 60 HERTZ.

CLASSROOM UNIT VENTILATOR SCHEDULE														
NO.	ROOM SERVED	TYPE	FRAME MODEL NUMBER	MINIMUM OF OUTDOOR AIR	MOTOR DATA		HEATING CAPACITY		OUTDOOR AIR INTAKE SIZE	POWER CIRCUIT	COOLING CAPACITY		SEE NOTE	
					H. P.	V.	Q	MBH			GPM	MBH		GPM
1	A-131	TN	TUV12	12½	1/4	115	1	32.1	1	BY OTHERS	1L4-12	36.3	8	1, 2, 3, 4, 5
2	A-132	TN	TUV12	12½	1/4	115	1	32.1	1	BY OTHERS	1L4-10	36.3	8	1, 2, 3, 4, 5
3	A-133	TN	TUV12	12½	1/4	115	1	32.1	1	BY OTHERS	1L4-10	36.3	8	1, 2, 3, 4, 5

NOTES:

1. HEATING CAPACITIES ARE BASED ON ONE ROW AUXILIARY HEATING COIL, 70°F RETURN AIR, -10°F OUTDOOR AIR AND 210°F ENTERING WATER. COOLING CAPACITIES ARE BASED ON 42°F ENTERING WATER.
2. MOTOR SHALL BE MULTI-SPEED.
3. PROVIDE ACCESSIBLE HOSE BIBB IN CABINET FOR SYSTEM DRAIN.
4. OUTDOOR AIR INTAKE LOUVER BY ROOFING CONTRACTOR.
5. HIGH CAPACITY COIL.

FAN COIL UNIT SCHEDULE													
NO.	ROOM SERVED	FRAME MODEL NUMBER	CABINET TYPE	POWER CIRCUIT	C.F.M.	COOLING CAPACITIES			HEATING CAPACITIES			WALL RECESS DEPTH	SEE NOTE
						SENSIBLE MBH	TOTAL MBH	GPM	SENSIBLE MBH	TOTAL MBH	GPM		
1	A-138	B22A.03	VERTICAL	1L1-32	300	6.95	9.90	1.95	18.0	2.0	--	1, 2, 3	
2	A-139	B22A.02	VERTICAL	1L1-32	200	4.65	5.90	1.25	15.0	2.0	--	1, 2, 3	
3	B-102	B22A.03	VERTICAL	1L1-32	300	6.95	9.90	1.95	18.0	2.0	--	1, 2, 3	

NOTES:

- HEATING CAPACITIES ARE BASED ON ONE ROW AUXILIARY HEATING COIL, 70°F ENTERING AIR, 210°F ENTERING WATER AND HIGH SPEED OPERATION.
- COOLING CAPACITIES ARE BASED ON 42° ENTERING WATER.
- MOTOR SHALL BE MULTI-SPEED, 120 VOLTS, 1 PHASE, 60 HERTZ.

NO.	ROOM SERVED	IRANE MODEL NUMBER	TYPE AND ARRANGEMENT	MBH	FAN SPEED RPM	WATER RATE GPM	POWER CIRCUIT	CFM STANDARD AIR	WALL RECESS DEPTH	SEE NOTE
1	A-103	D16A006	HORIZONTAL CABINET	35.8	700	1.50	1L4-7	370	---	1, 2, 3
2	A-105	D16A002	HORIZONTAL CABINET	13.1	700	0.75	1L3-10	145	---	1, 2, 3
3	A-135	E46A002	HORIZONTAL RECESSED	13.1	700	0.75	1L3-10	145	---	1, 2, 3
4	A-108	E46A003	HORIZONTAL RECESSED	19.7	700	1.00	1L3-9	200	---	1, 2, 3
5	A-123	E46A003	HORIZONTAL RECESSED	19.7	700	1.00	1L2-14	200	---	1, 2, 3
6	A-125	E46A008	HORIZONTAL RECESSED	48.3	525	3.00	1L2-11	570	---	1, 2, 3
7	A-127	D16A002	HORIZONTAL CABINET	13.1	700	0.75	1L2-11	145	---	1, 2, 3
8	A-134	E46A008	HORIZONTAL RECESSED	48.3	525	3.00	1L4-7	570	---	1, 2, 3
9	A-112	H46A002	VERTICAL RECESSED	13.1	700	0.75	1L3-9	145	9"	1, 2, 3
10	A-117	H46A002	VERTICAL RECESSED	13.1	700	0.75	1L2-14	145	9"	1, 2, 3
11	B-101	E46A008	HORIZONTAL RECESSED	48.3	525	3.00	1L1-33	570	---	1, 2, 3
12	B-101	E46A008	HORIZONTAL RECESSED	48.3	525	3.00	1L1-33	570	---	1, 2, 3
13	B-101	E46A008	HORIZONTAL RECESSED	48.3	525	3.00	1L1-33	570	---	1, 2, 3
14	B-101	E46A008	HORIZONTAL RECESSED	48.3	525	3.00	1L1-34	570	---	1, 2, 3
15	B-104	E46A008	HORIZONTAL RECESSED	48.3	525	3.00	1L1-34	570	---	1, 2, 3
16	B-104	E46A008	HORIZONTAL RECESSED	48.3	525	3.00	1L1-34	570	---	1, 2, 3

NOTES:

- HEATING CAPACITIES ARE BASED ON 70°F. ENTERING AIR, AND 210°F. ENTERING WATER AT LOW SPEED OPERATION. FINAL AIR TEMPERATURE SHALL BE 110°F. TO 140°F.
- MOTORS SHALL BE MULTI-SPEED 115 VOLT, 1 PHASE, 60 HERTZ.
- PROVIDE ACCESSIBLE HOSE BIBB IN CABINET FOR SYSTEM DRAIN.

NO.	ROOM SERVED	AIR THERM. MOUNT NUMBER	DEPTH	LENGTH	HEIGHT	M. B. H.	WALL RECESS DEPTH	SEE NOTE
1	A-102	FRG	4"	36"	24"	3.9	4"	1, 2
2	A-106	FRG	4"	48"	32"	6.4	4"	1, 2
3	A-107	FRG	4"	48"	32"	6.4	4"	1, 2
4	A-110	FRG	4"	20"	24"	1.9	4"	1, 2
5	A-114	FRG	4"	20"	24"	1.9	4"	1, 2
6	A-118	FRG	4"	20"	24"	1.9	4"	1, 2
7	A-121	FRG	4"	20"	24"	1.9	4"	1, 2
8	A-126	FRG	4"	36"	24"	3.9	4"	1, 2
9	A-136	FRG	4"	20"	24"	1.9	4"	1, 2
10	A-140	FRG	4"	20"	24"	1.9	4"	1, 2
11	A-141	FRG	4"	20"	24"	1.9	4"	1, 2
12	B-115	FRG	4"	36"	24"	3.9	4"	1, 2
13	B-103	FRG	4"	20"	24"	1.9	4"	1, 2
14	B-107	FRG	4"	20"	24"	1.9	4"	1, 2
15	B-108	FRG	4"	44"	32"	5.8	4"	1, 2
16	A-109	FRG	4"	20"	24"	1.9	4"	1, 2

NOTES:

- HEATING CAPACITIES ARE BASED ON 20°F. WATER TEMPERATURE DROP, 70°F. ENTERING AIR 210°F. ENTERING WATER TEMPERATURE.
- PROVIDE ACCESSIBLE HOSE BIBB IN CABINET FOR SYSTEM DRAIN.

PLUMBING FIXTURE SCHEDULE						
ITEM	FIXTURE	WASTE	VENT	C.W.	H.W.	FIXTURE MOUNTING HEIGHT
P-1	WATER CLOSET	4"	2"	1"	---	15" TO RIM
P-2	URINAL	2"	1 1/2"	3/4"	---	20" TO RIM
P-3	LAVATORY	1 1/2"	1 1/2"	1/2"	1/2"	31" TO RIM
P-4	LAVATORY	1 1/2"	1 1/2"	1/2"	1/2"	31" TO RIM
P-5	SERVICE SINK	3"	1 1/2"	3/4"	3/4"	STANDARD
P-6	MOP SINK	3"	1 1/2"	3/4"	3/4"	FLOOR MOUNTED
P-7	WATER COOLER	1 1/2"	1 1/2"	1/2"	---	40" TO RIM
P-8	DRINKING FOUNTAIN & CUSPIDOR	1 1/2"	1 1/2"	1/2"	---	40" TO RIM
P-9	SHOWER HEAD & MIXING VALVE	---	---	1/2"	1/2"	6'-0" TO SHOWER HEAD
P-10	SHOWER HEAD & SHUT-OFF VALVE	---	---	1/2"	1/2"	6'-0" TO SHOWER HEAD
P-11	CABINET SINK	1 1/2"	1 1/2"	1/2"	1/2"	STANDARD
P-12	CABINET SINK	1 1/2"	1 1/2"	1/2"	1/2"	STANDARD
P-13	WHEEL CHAIR WATER FOUNTAIN	1 1/2"	1 1/2"	1/2"	---	33" TO SPOUT
P-14	ICE MACHINE	---	---	1/2"	---	---

NOTES:

- ALL BRANCH SIZES SHOWN IN THE ABOVE SCHEDULE ARE INDIVIDUAL BRANCH SIZES TO FLOOR VALVES, FAUCETS, BUBBLERS, ETC.
- WATER CLOSETS AND URINALS SHALL BE FLUSH VALVE OPERATED.
- MECHANICAL CONTRACTOR SHALL CONSULT WITH THE ARCHITECT'S REPRESENTATIVE BEFORE ROUGHING-IN ANY WATER CLOSURES.
- ALL FIXTURES, INCLUDING DRINKING FOUNTAINS AND WATER COOLERS, SHALL HAVE A CHROME-PLATED KEY OPERATED VALVE EXPOSED AT THE FIXTURE.
- PROVIDE 1/4" CHROME-PLATED HOSE BIBB UNDER EACH BATTERY OF LAVATORIES.

C O P P E R F I N T U B E R A D I A T I O N S C H E D U L E								
TYPE	SHAW-WALKER'S MODEL NUMBER	BTU PER FOOT	TUBE DIA.	FIN SIZE	NUMBER OF ROWS	FIN'S PER FOOT	TYPE OF COVER	SEE NOTES
A	DCL-1	1750	1 1/4"	4 1/4" X 4 1/4"	1	40	CROWNLINE	1

NOTES:

- HEATING CAPACITIES ARE BASED ON 70°F. ENTERING AIR, 20°F. TEMPERATURE DROP, 210°F. ENTERING WATER TEMPERATURE.

AIR HANDLING UNIT SCHEDULE									
NO.	AREA SERVED	TYPE	TRANE MODEL NUMBER	CFM STANDARD AIR	MAXIMUM FAN OUTLET VELOCITY FPM	MINIMUM EXTERNAL STATIC PRESSURE W/ WATER COLUMN	MINIMUM FAN MOTOR HP	MINIMUM PERCENT OF OUTDOOR AIR	SEE NOTES
A-1	GYMNASIUM	HEATING & VENTILATING	25	16000	820	1.0	15	20%	1, 2, 3.
A-2	GYMNASIUM	HEATING & VENTILATING	25	16000	820	1.0	15	20%	1, 2, 3.
A-3	GYMNASIUMS	HEATING & VENTILATING	6	3650	728	1.0	3	20%	1, 2, 3.
A-4	GYMNASIUMS	HEATING & VENTILATING	6	3650	728	1.0	3	20%	1, 2, 3.
A-5	WRESTLING	HEATING & VENTILATING	8	5000	674	1.0	5	25%	1, 2, 3.
A-6	LOCKER ROOMS	HEATING & VENTILATING	12	6750	642	1.0	5	0-100%	1, 2, 3.

NOTES:

1. ALL EQUIPMENT SHALL BE SELECTED IN STRICT ACCORDANCE WITH THE MAXIMUM AND MINIMUM QUANTITIES SHOWN.
2. UNIT SHALL HAVE BLOW-THRU ARRANGEMENT.
3. MOTOR DATA: 460 VOLTS, 3 PHASE, 60 HERTZ, 1750 RPM.
4. UNITS SHOULD BE COMPLETE WITH FULL DRAIN PAN TO FACILITATE FUTURE CLEANING AND WASHDOWN.

AIR HANDLING UNIT HEATING COIL SCHEDULE											
NO.	CFM STANDARD AIR	TOTAL LOAD BTU	ENTERING AIR DRY BULB °F.	LEAVING AIR DRY BULB °F.	WATER		AIR FRICTION LOSS IN. W.C.	MAXIMUM FACE VELOCITY FPM	FINS PER FOOT	NUMBER OF ROWS	SEE NOTE
					MAXIMUM GPM	MAXIMUM PRESSURE DROP (FT. L)					
A-1	16000	885,360	54°	105°	45.6	1.7	0.27	665	162	2	1,2,3
A-2	16000	885,360	54°	105°	45.6	1.7	0.27	665	162	2	1,2,3
A-3	3650	201,970	54°	105°	10.4	0.1	0.33	649	86	2	1,2,3
A-4	3650	201,970	54°	105°	10.4	0.1	0.33	649	86	2	1,2,3
A-5	5000	298,400	50°	105°	15.4	0.1	0.37	667	101	2	1,2,3
A-6	6750	256,300	70°	105°	13.2	0.1	0.17	578	118	2	1,2,3

NOTES:

- CAPACITIES ARE BASED ON -10 F OUTDOOR AIR, 70 F ROOM AIR AND 210° F ENTERING WATER.
- ALL EQUIPMENT SHOULD BE SELECTED IN STRICT ACCORDANCE WITH THE MAXIMUM AND MINIMUM QUANTITIES SHOWN.
- STANDARD SERPENTINE COIL.

NO.	AREA EXHAUSTED	JENN-AIR MODEL NUMBER	C.F.M.	SP. VELOCITY	MOTOR DATA				POWER CIRCUIT	CONTROL NO. #1	SEE NOTE
					R.P.M.	H.P.	VOLTS	Ø			
1	A-112	1251LB	2096	3/8"	1800	3/4	460	3	1H2-3	ZONE #3	1, 2, 3
2	A-108, A-107, A-110 A-113, A-114	1211LB	680	3/8"	800	1/6	115	1	1L3-11	ZONE #3	1, 2, 3
3	A-117	1243LB	1348	3/8"	1300	1/3	115	1	1L3-11	ZONE #3	1, 2, 3
4	A-115, A-116	1221LB	881	3/8"	1060	1/4	115	1	1L3-13	ZONE #3	1, 2, 3
5	A-118, A-119, A-121	1211LB	541	3/8"	900	1/6	115	1	1L3-13	ZONE #3	1, 2, 3
6	A-126, A-127	1231LB	1279	3/8"	1260	1/3	115	1	1L2-7	ZONE #5	1, 2, 3
7	A-105, A-135, A-137	1231LB	1348	3/8"	1348	1/3	115	1	1L3-17	ZONE #2	1, 2, 3
8	A-102, A-103	1221LB	1174	3/8"	1200	1/4	115	1	1L4-13	ZONE #1	1, 2, 3
9	A-101 VENTILATION TRENCH	1231LB	1531	3/8"	1410	1/3	115	1	1L3-15	H	1, 2, 3
	A-128 VENTILATION TRENCH	1221LB	1280	3/8"	1260	1/4	115	1	1L2-18	H	1, 2, 3

NOTES:

- CONTROL DESIGNATIONS: (1)ZONE # 1 FAN TO BE CONTROLLED AUTOMATICALLY BY TEMPERATURE CONTROL ZONE SHOWN. (2) FAN TO BE CONTROLLED BY MANUAL SWITCH PROVIDED BY THE ELECTRICAL CONTRACTOR; (3) FAN TO BE CONTROLLED BY HUMIDISTAT, PROVIDED BY ELECTRICAL CONTRACTOR.
- FAN SHALL HAVE VIBRATION ISOLATORS AS RECOMMENDED BY THE FAN MANUFACTURER AND AS APPROVED BY THE ARCHITECT.
- ALL HANGERS, RODS, PLATFORMS, ETC., REQUIRED TO SUPPORT FANS SHALL BE FURNISHED BY THE VENTILATING CONTRACTOR.
- FAN IS CONTROLLED AUTOMATICALLY BY HUMIDISTAT FURNISHED BY ELECTRICAL CONTRACTOR AND INSTALLED IN THE WOOD FLOOR VENTILATION TRENCH.

DIFFUSER SCHEDULE					
TYPE	KRUEGER MODEL NUMBER	NECK SIZE	PATTERN	DAMPER SIZE	SEE NOTE
A	SH-4-0BD-FR23	9" x 9"	4-WAY	9" X 9"	1
B	SH-4-0BD-FR23	15" X 15"	4-WAY	15" X 15"	1
C	SH-2-0BD-FR23	18" X 18"	4-WAY	18" X 18"	1
D	SH-4-0BD-FR23	21" X 21"	4-WAY	24" X 24"	1

NOTES:

1. DIFFUSER SHALL BE FULLY ADJUSTABLE.

- GENERAL NOTES
(APPLY TO ALL SHEETS)
1. ALL WORK SHOWN IS NEW AND BY THE MECHANICAL TRADES UNLESS OTHERWISE NOTED.
2. ALL EXISTING BUILDING SURFACES, WALLS, FLOORS, ETC., WHICH ARE TO BE EXPOSED, DISTURBED, CUT OR PARTIALLY REMOVED BY THE MECHANICAL TRADES IN ABANDONING, REMOVING, RELOCATING, REPLACING OR INSTALLING MECHANICAL EQUIPMENT, PIPING, DUCTWORK, ETC., WILL BE PATCHED AND REPAIRED BY THE PROPER CONTRACTOR AND PAID FOR BY THE MECHANICAL TRADES UNLESS OTHERWISE NOTED ON THE DRAWINGS. THE MECHANICAL TRADES SHALL CORRODATE THIS WORK WITH THE OTHER CONTRACTORS AND SHALL ONLY EXPOSE, DISTURB, CUT, OR REMOVE THE MINIMUM AREA OF SUCH SURFACES NECESSARY TO PERFORM HIS WORK.
3. ALL DASHED LINES NOT OTHERWISE NOTED ON THE PLANS INDICATE LOCATION OF BULKHEADS, CANNOPES, OR ROOF OVERHANGS PROVIDED BY OTHERS.
4. ALL WATER AND WASTE LINES UNDER THE FLOOR SLAB SHALL CONTINUE FULL SIZE OF THE HORIZONTAL RUN. THE VERTICAL SUPPLY RISER TO FIXTURES SHALL BE REDUCED TO THE SIZE REQUIRED BY THE FIXTURE FLUSH AT THE FLOOR OR WALL SURFACE.
5. THE MECHANICAL CONTRACTOR SHALL VERIFY ALL EXISTING CONDITIONS AT THE JOB SITE AND ADJUST HIS WORK ACCORDING TO ANY VARIATIONS OR DEVIATIONS TO CONDITIONS SHOWN ON THE DRAWINGS.
6. ALL THERMOSTATS SHALL BE APPROXIMATELY 4'-8" ABOVE FINISHED FLOOR AND LINED UP VERTICALLY WITH LIGHT SWITCHES UNLESS OTHERWISE NOTED OR DIRECTED BY THE ARCHITECT.
7. ARROWS ON HOT WATER AND CHILLED WATER MAINS INDICATE DIRECTION OF FLOW. PITCH MAINS UP A MINIMUM OF 1" IN 50'-0" IN DIRECTION OF SUPPLY WATER FLOW.
8. ALL AUTOMATIC TEMPERATURE REGULATING VALVES SHALL BE SIZED FOR FIVE POUND WATER PRESSURE DROP.
9. PROVIDE DRAIN VALVES INSIDE ENCLOSURES OF ALL HEATING OR COOLING UNITS WHICH ARE SUPPLIED FROM OVERHEAD MAINS.
10. ALL FAN COIL UNIT CONDENSATE DRAINS ABOVE GRADE SHALL BE TYPE "L" HARD COPPER TUBING AND SHALL BE SIZED AS FOLLOWS: 1" DRAIN FOR ONE COIL, 1-1/4" DRAIN FOR TWO COILS, 1-1/2" DRAIN FOR THREE COILS, 2" DRAIN FOR FOUR OR MORE COILS. ALL BELOW GRADE DRAINS SHALL BE 2" EXTRA HEAVY CAST IRON SOIL PIPE AND SHALL SLOPE 1/8" PER FOOT UNLESS OTHERWISE NOTED.
11. HEATING AND COOLING RUNOUTS TO CONVECTORS AND FAN COIL UNITS SHALL BE 3/4" FOR UNITS UNDER 4 GPM AND 1" FOR UNITS OVER 4 GPM, AND 1" TO ALL FINNED TUB CABINET HEATERS, AND UNIT HEATERS UNLESS OTHERWISE NOTED.
12. ALL OUTDOOR AIR INTAKE DUCTWORK SHALL BE LINED WITH 1" INSULATION, ALL LOW VELOCITY HEATING AND VENTILATING SUPPLY DUCTWORK TERMINATING AT DIFFUSERS AND REGISTERS SHALL BE LINED WITH 1/2" INSULATION. ALL RETURN DUCTWORK SHALL BE FINISHED WITH 1/2" INSULATION. ALL EXHAUST DUCTWORK SHALL BE INSULATED WHERE NOTED ON DRAWINGS.
13. ALL DUCTWORK AND PIPING RUN ABOVE CEILING SHALL BE RUN TO AVOID LIGHTING FIXTURES, JOISTS, BEAMS, ETC., AS APPROVED BY THE ARCHITECT.
14. ALL SHEET METAL DUCTWORK RUN ABOVE THE ROOF SHALL BE 20 GAUGE (MINIMUM) UNLESS OTHERWISE NOTED.
15. PROVIDE ACCESS PANEL AND BAFFLES IN ALL AIR HAND TO UNIT MIXING BOXES.
16. ALL SANITARY AND STORM DRAINS INSIDE OF THE BUILDING SHALL SLOPE A MINIMUM OF 1/4" PER FOOT UNLESS OTHERWISE NOTED.
17. ALL DOMESTIC WATER BRANCH PIPING SHOWN RUNNING HORIZONTALLY IN CEILING SPACE BELOW FLOOR SLAB, ETC. SHALL BE A MINIMUM 3/4" DIA.
18. ALL STORM SEWERS 12" IN DIAMETER AND LARGER SHALL BE CONCRETE PIPE, SEE SPECIFICATIONS.
19. VALVE ALL CHILLED WATER, HEATING SYSTEM WATER AND DOMESTIC WATER BRANCHES IN FAN ROOMS AND MECHANICAL ROOMS. THE MECHANICAL CONTRACTOR SHALL ALSO PROVIDE AND INSTALL VALVES IN ALL SYSTEMS AS REQUIRED TO FACILITATE THE OPERATION OF VARIOUS SYSTEMS DURING CONSTRUCTION.
20. ALL PIPING IN PIPE SPACES AND TUNNELS SHALL BE RUN AS CLOSE TO WALLS AS POSSIBLE TO ALLOW MAXIMUM ACCESS.
21. ALL DOMESTIC WATER PIPING HEADERS LOCATED IN PIPE CHAMBERS SHALL BE THE SAME SIZE AS THE BRANCH MAIN DROPS INDICATED ON THE DRAWINGS AND ALL AIR CHAMBERS LOCATED IN PIPE CHAMBERS SHALL BE ONE PIPE SIZE LARGER THAN THE BRANCH MAIN DROPS.
22. THERMOSTATS IN MECHANICAL EQUIPMENT ROOMS SHALL BE SET AT 50°F.

241 North Meridian Street, Indianapolis, Indiana 46202

RECEIVED
9/9/67
J.D.

LETTER OF TRANSMITTAL

EVERETT I. BROWN, Competent
Architects & Engineers

DATE: 9/4/67

TO: MR. JACK OKEY
LAWRENCE TWP. MSD
7601 EAST 56TH
INDIANAPOLIS, INDIANA
46226

LAWRENCE CENTRAL
HIGH SCHOOL

WE ARE SENDING YOU ☒ Attached ☐ Under separate cover via _____ the following items:

☐ Shop drawings	☐ Prints	☐ Plans	☐ Samples	☐ Specifications
☐ Copy of letter	☐ Change order	☐ Consultant's Comments		
☐ First Submittal	☐ Resubmittal	☐ Final Submittal		

[illegible]

THESE ARE TRANSMITTED as checked below:

☐ For approval	☐ Approved as submitted	☐ Resubmit_____copies for approval
☒ For your use	☐ Approved as noted	☐ Submit_____copies for distribution
☐ As requested	☐ Returned for corrections	☐ Return_____corrected prints
☐ For review and comment	☐ _____	

☐ FOR BIDS DUE _____, 19____ ☐ PRINTS RETURNED AFTER LOAN TO US

REMARKS _____

COPY TO _____

SIGNED: W. H. C. [Signature]


If enclosures are not as noted, kindly notify us at once.

If enclosures are not as noted, kindly notify us at once.


ETT : I. BROWN COMPANY

941 NORTH MERIDIAN STREET •
LAWRENCE CENTRAL HIGH SCHOOL

NO. M-1
OF 9

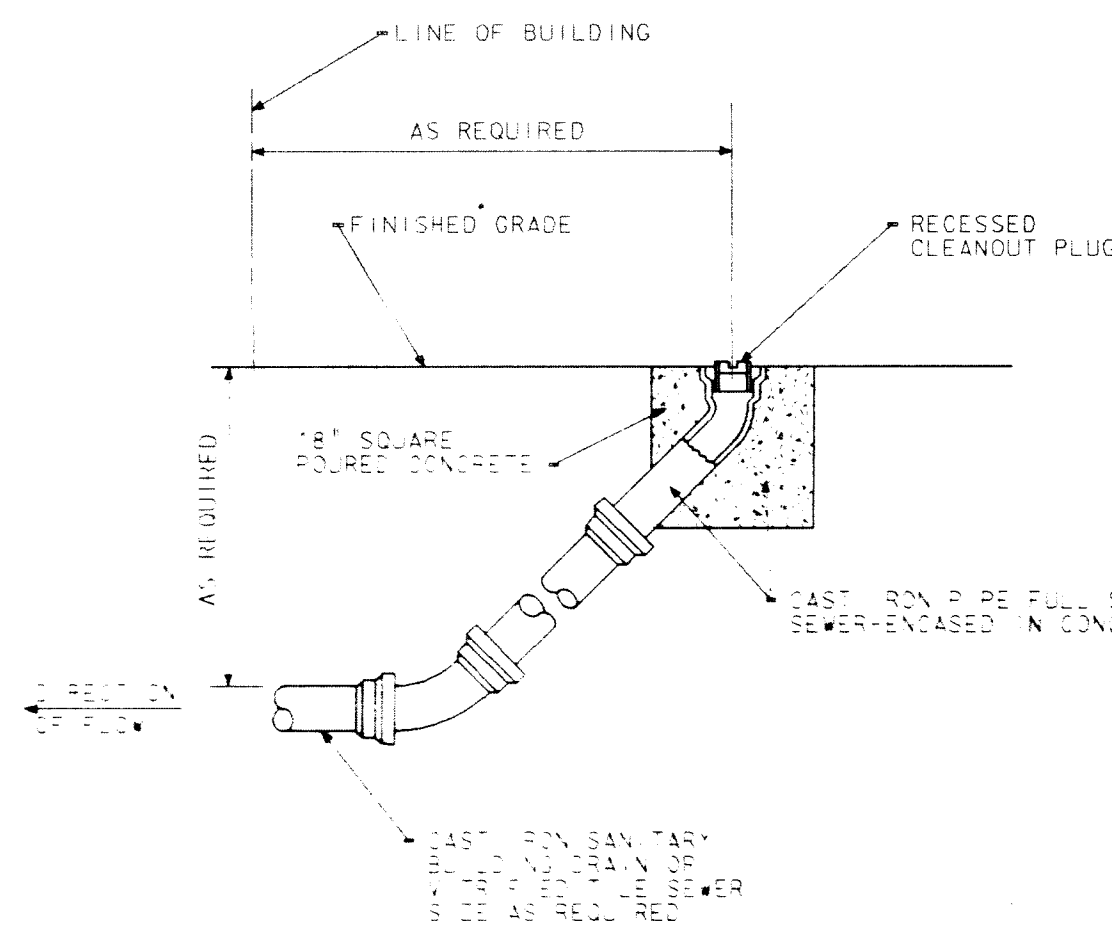


DETAIL OF TYPICAL OUTSIDE CLEANOUT
NO SCALE

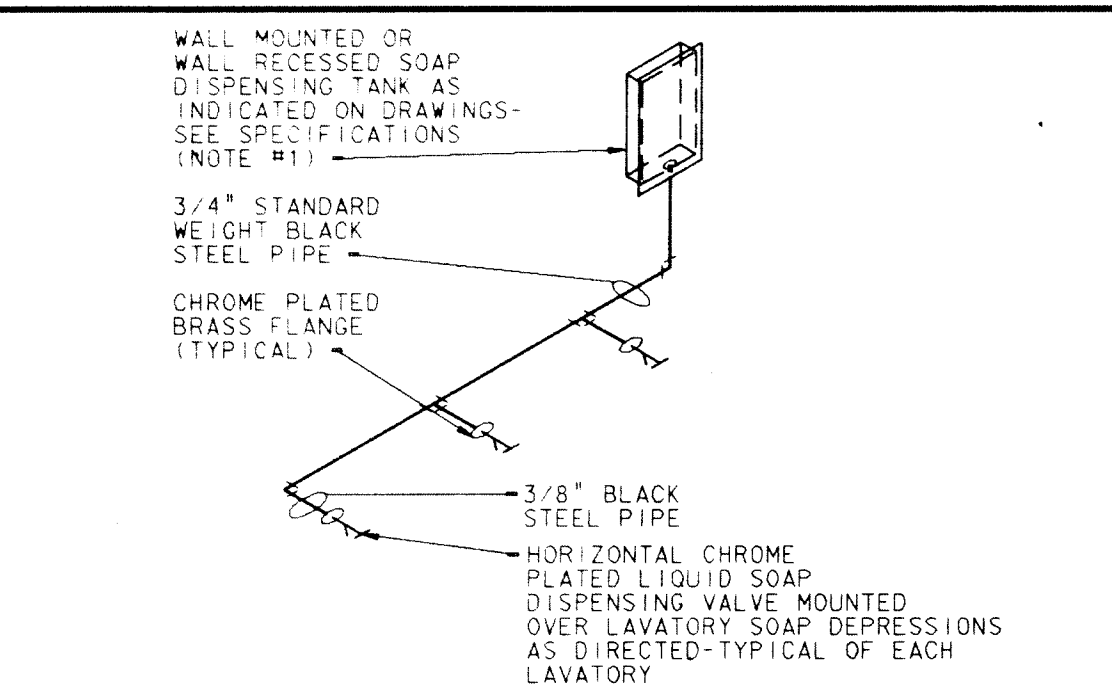


SOAP DISPENSING SYSTEM
INSTALLATION DIAGRAM
NO SCALE



NOTES:
1. TOP OF SOAP TANK SHALL BE LOCATED 6'-6" ABOVE FLOOR.
2. THE NUMBER OF SOAP DISPENSING VALVES AND PIPING LAYOUT VARIES ACCORDING TO INDIVIDUAL TANK LOCATIONS AS SHOWN ON THE PLANS. SOAP SUPPLY PIPE HEADERS IS 3/4" STANDARD WEIGHT BLACK STEEL WITH 3/8" BLACK STEEL PIPE BRANCHES TO INDIVIDUAL SOAP DISPENSING VALVES AT ALL LOCATIONS.

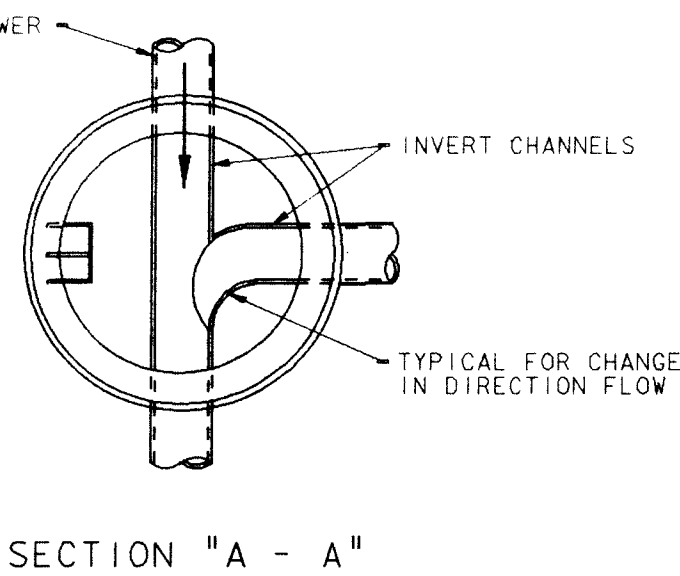

TYPICAL MANHOLE
NO SCALE

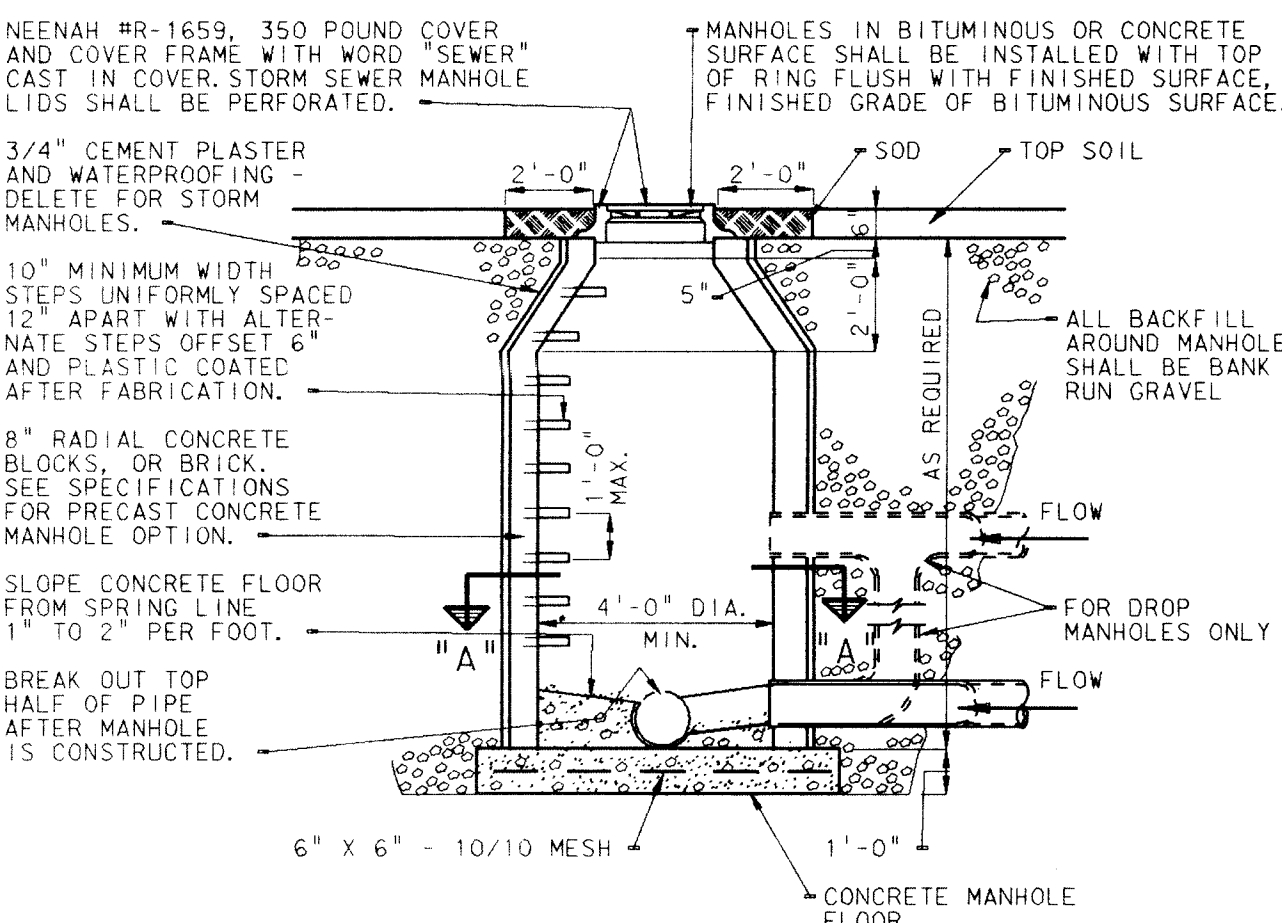


ROOF OVERFLOW DRAIN
NO SCALE

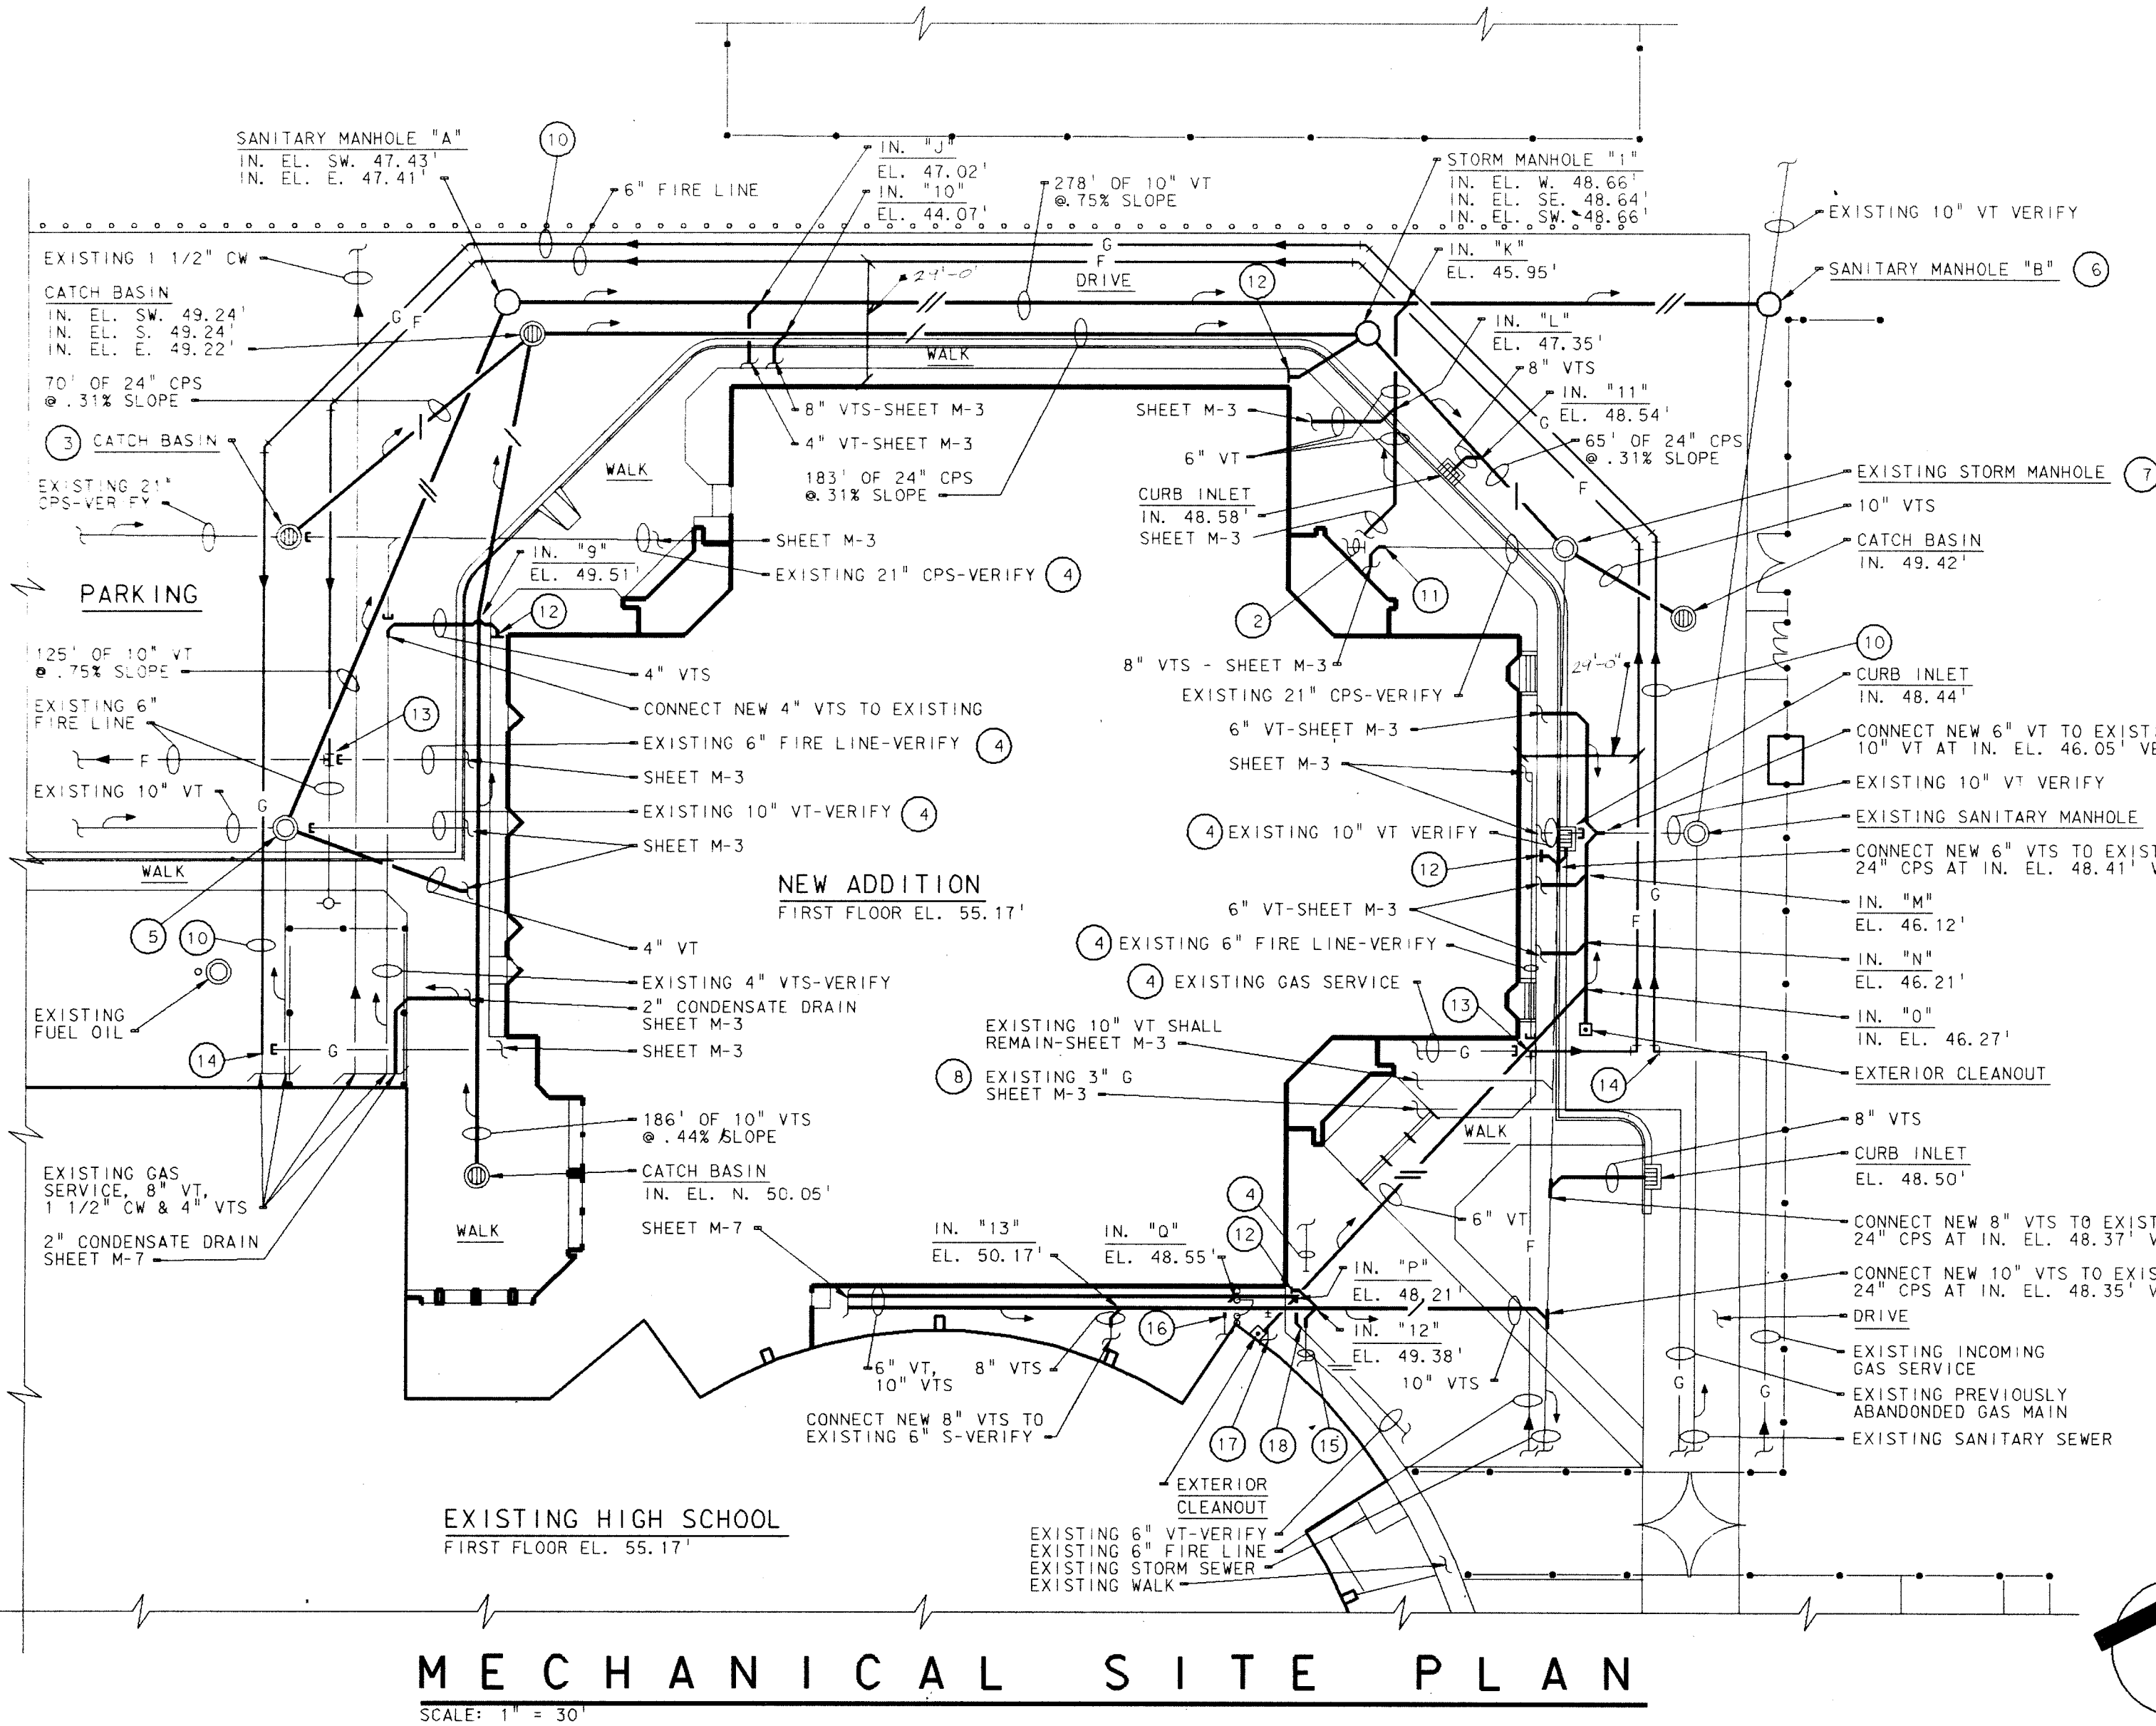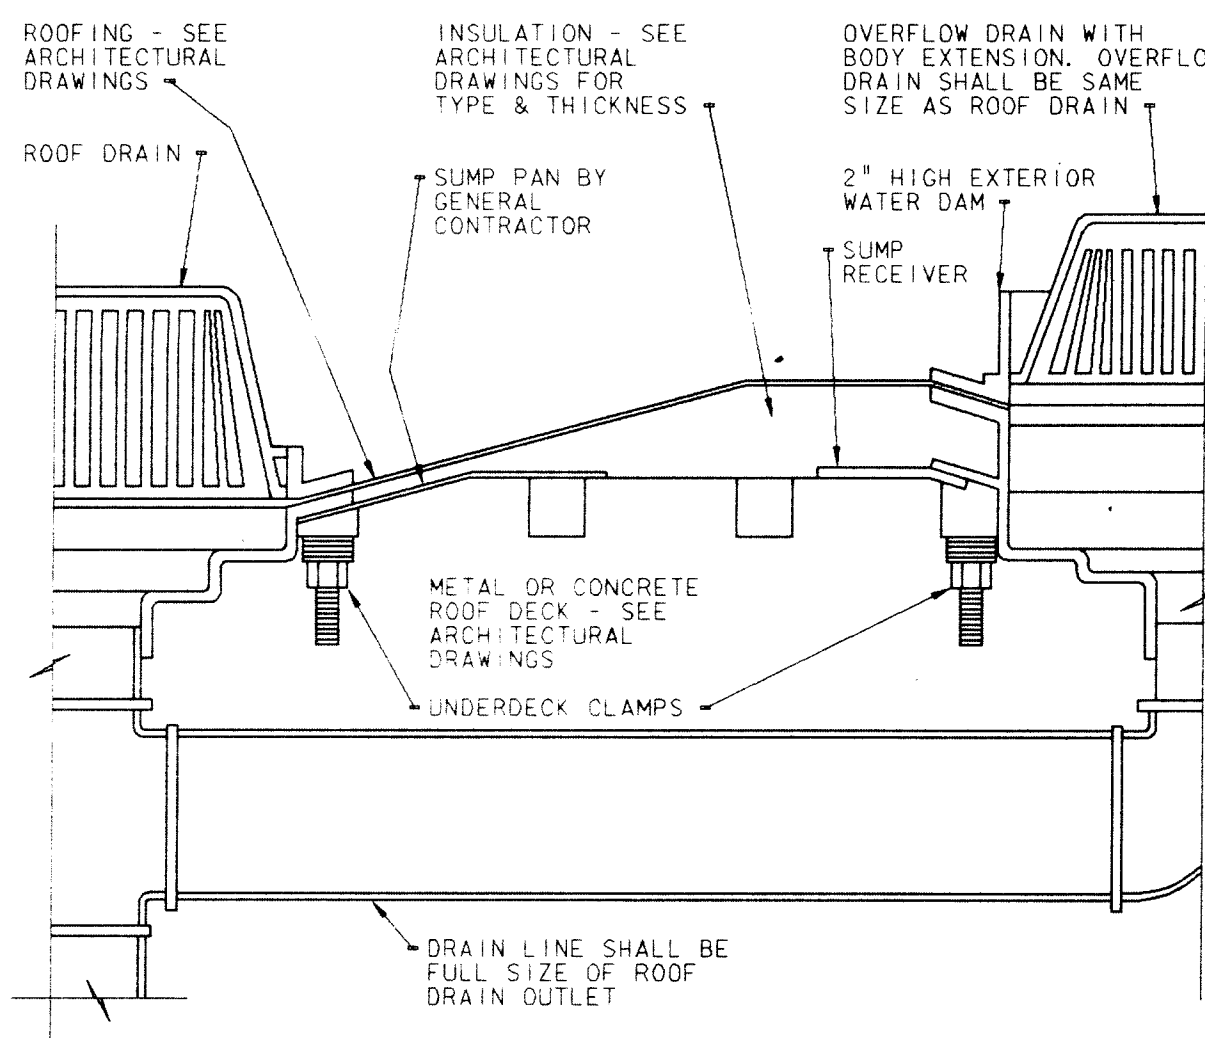


MECHANICAL SITE PLAN
SCALE: 1" = 30'

SITE PLAN NOTES:

- SEE SHEET M-1 FOR GENERAL NOTES, LEGEND AND SCHEDULES.
- ALL CATCH BASINS AND CURB INLETS WILL BE PROVIDED BY OTHERS.
- NEW CATCH BASIN IS TO BE CONSTRUCTED OVER EXISTING 21" CPS. COORDINATE WITH GENERAL CONTRACTOR. EXISTING IN. EL. W. 49.48' VERIFY. PLUG IN. EL. E. IN. EL. NE. 49.44'.
- EXISTING UTILITY SHALL REMAIN IN SERVICE UNTIL NEW CONSTRUCTION IS COMPLETE THEN SHALL BE CUT, PLUGGED, CAPPED AND ABANDONED IN PLACE OUT OF SERVICE. REMOVE ANY PART OF EXISTING UTILITY THAT INTERFERES WITH NEW MECHANICAL CONSTRUCTION.
- EXISTING SANITARY MANHOLE AND 10" VT AT IN. EL. 48.36' VERIFY. PLUG IN. EL. E. CONNECT NEW 10" VT AT IN. EL. NE. 48.35' AND NEW 4" VT AT IN. EL. SE. 48.37'.
- CONSTRUCT NEW SANITARY MANHOLE OVER EXISTING 10" VT. EXISTING 10" VT IN. EL. 45.84' VERIFY. IN. EL. W. 45.95'.
- CONNECT NEW 24" CPS TO EXISTING STORM MANHOLE AT IN. EL. NW. 48.46' VERIFY. CONNECT NEW 10" VT AT IN. EL. SE. 49.29'.
- REMOVE ANY PART OF PREVIOUSLY ABANDONED GAS THAT INTERFERES WITH NEW MECHANICAL CONSTRUCTION.
- ALL SEWERS LOCATED WITHIN 10 FEET ON EITHER SIDE OF A WATER MAIN SHALL BE CONSTRUCTED OF MECHANICAL JOINT WATER WORKS GRADE CAST IRON PIPE.
- NEW INCOMING GAS SERVICE BY CITIZENS GAS COMPANY. ALL COSTS INVOLVED IN REROUTING THE INCOMING GAS SERVICE SHALL BE PAID FOR BY THE OWNER.
- CUT EXISTING 21" CPS AND CONNECT NEW 8" VTS AT IN. EL. 48.64' VERIFY.
- CONNECT 6" VTS TO PERIMETER DRAIN PROVIDED BY G.C. - SEE SHEET S-1.
- CONNECT NEW 6" FIRE LINE TO EXISTING. CAP AND ABANDON EXISTING UNUSED FIRE LINE. SEE NOTE #4.
- CONNECT NEW INCOMING GAS SERVICE TO EXISTING. SEE NOTE #10.
- EXISTING 8" VTS. CONNECT NEW 8" VTS AT IN. EL. 51.17'.
- EXISTING 4" W VERIFY. DISCONNECT EXISTING 6" VT AND CONNECT NEW 6" VT.
- EXISTING 2" W. DISCONNECT EXISTING 4" VT AND CONNECT NEW 6" VT AT IN. EL. 49.55' VERIFY.
- EXISTING 6" VT. CUT AND CONNECT NEW 6" VT AT IN. EL. 49.60' VERIFY.

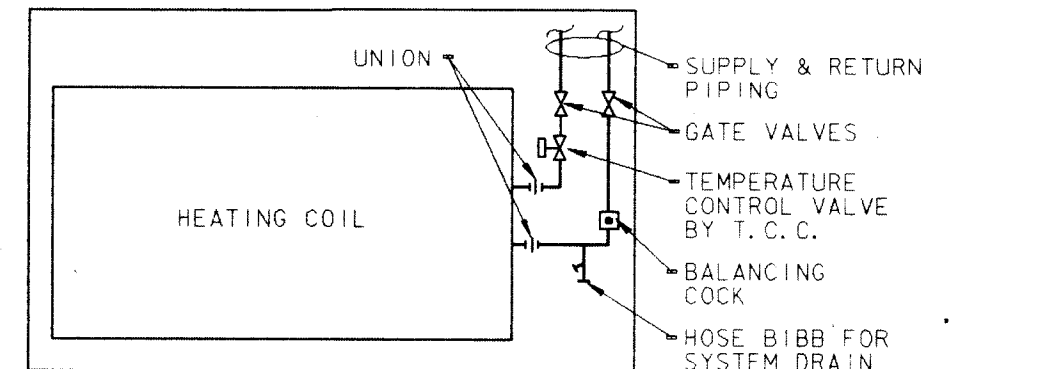


CABINET HEATER PIPING DIAGRAM
NO SCALE

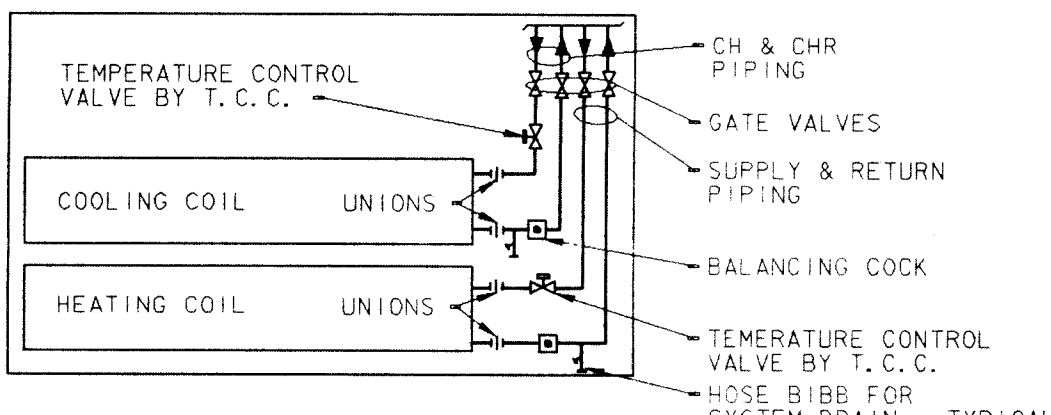

FAN COIL PIPING DIAGRAM
NO SCALE (HEATING, COOLING & PIPE SYSTEM)


ROOF PLAN NOTES:

- ALL VENTS NOT OTHERWISE NOTED ARE 3" PLUMBING VENTS.
- ALL WORK SHOWN ON THIS SHEET IS BY MECHANICAL TRADES UNLESS OTHERWISE NOTED.
- PROVIDE DECK CLAMPS FOR ALL ROOF DRAINS. INSTALLED IN METAL DECK OR SIMILAR ROOF CONSTRUCTION. OVERFLOW DRAINS SHALL BE PROVIDED WITH DECK CLAMPS. SUMP RECEIVERS, DRAIN BODY EXTENSIONS AND 2" HIGH EXTERIOR WATER DAM. SEE DETAIL ON THIS SHEET. ALL ROOF DRAINS SHALL HAVE OVERFLOW DRAINS.
- NO ROOF DRAIN SHALL BE SET WITHOUT PRIOR CONSULTATION WITH THE ARCHITECT'S FIELD REPRESENTATIVE. IN GENERAL, ALL ROOF DRAINS SHALL BE SET ON THE STRUCTURAL DECK AND NOT ON THE ROOF INSULATION.
- THE MECHANICAL CONTRACTOR SHALL FIELD CUT THE SMALL ROOF OPENINGS REQUIRED FOR PLUMBING VENTS AND ROOF DRAIN OVERFLOW LINES.

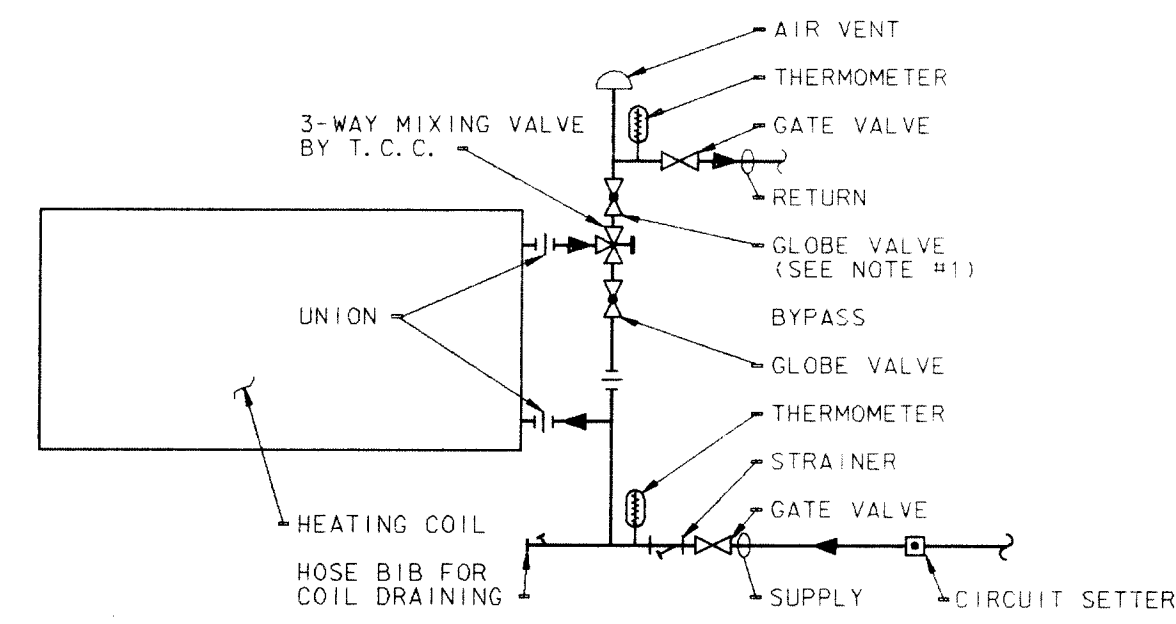


TYPICAL HOT WATER HEATING COIL PIPING DIAGRAM
NO SCALE (3-WAY VALVE)


TYPICAL HOT WATER HEATING COIL PIPING DIAGRAM
NO SCALE (3-WAY VALVE)

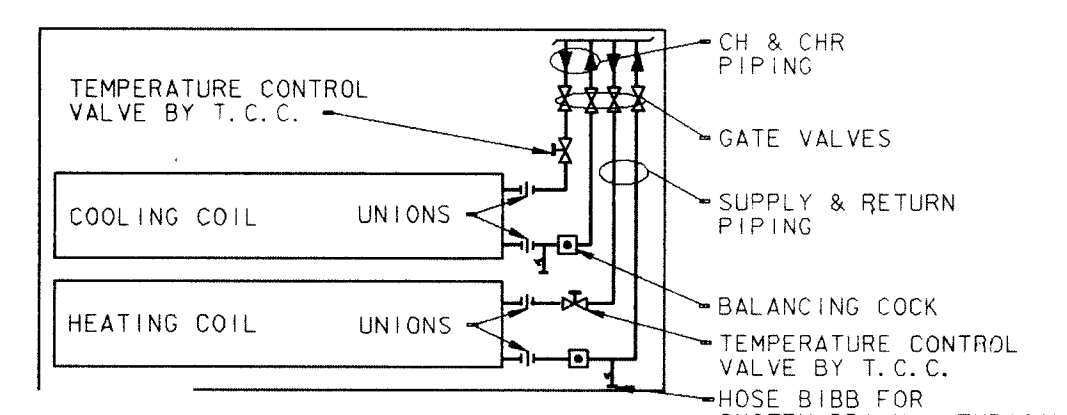

UNIT VENTILATOR PIPING DIAGRAM
NO SCALE (HEATING & COOLING)

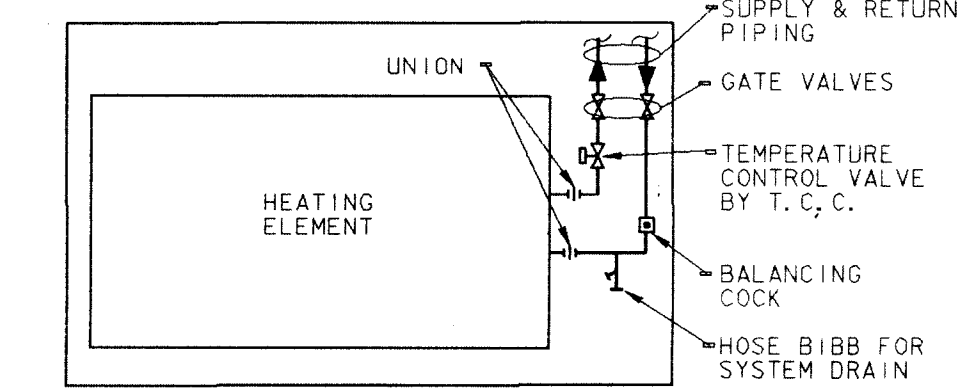


CONVECTOR PIPING DIAGRAM
NO SCALE

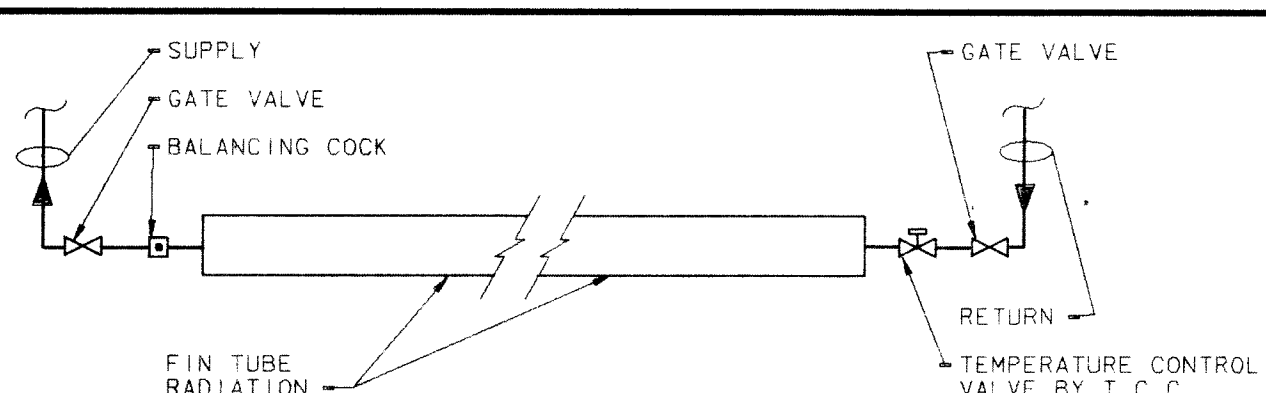


TYPICAL FIN TUBE RADIATION PIPING DIAGRAM
NO SCALE

AS-BUILT

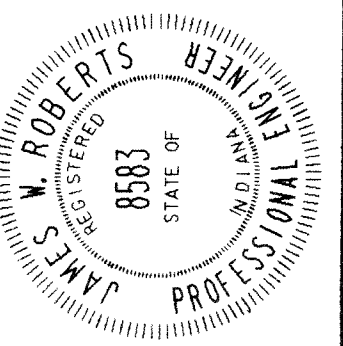


PROJECT	851-190
DATE	MAR. 24, 1986
REVISED	


NO. M-2
OF 9

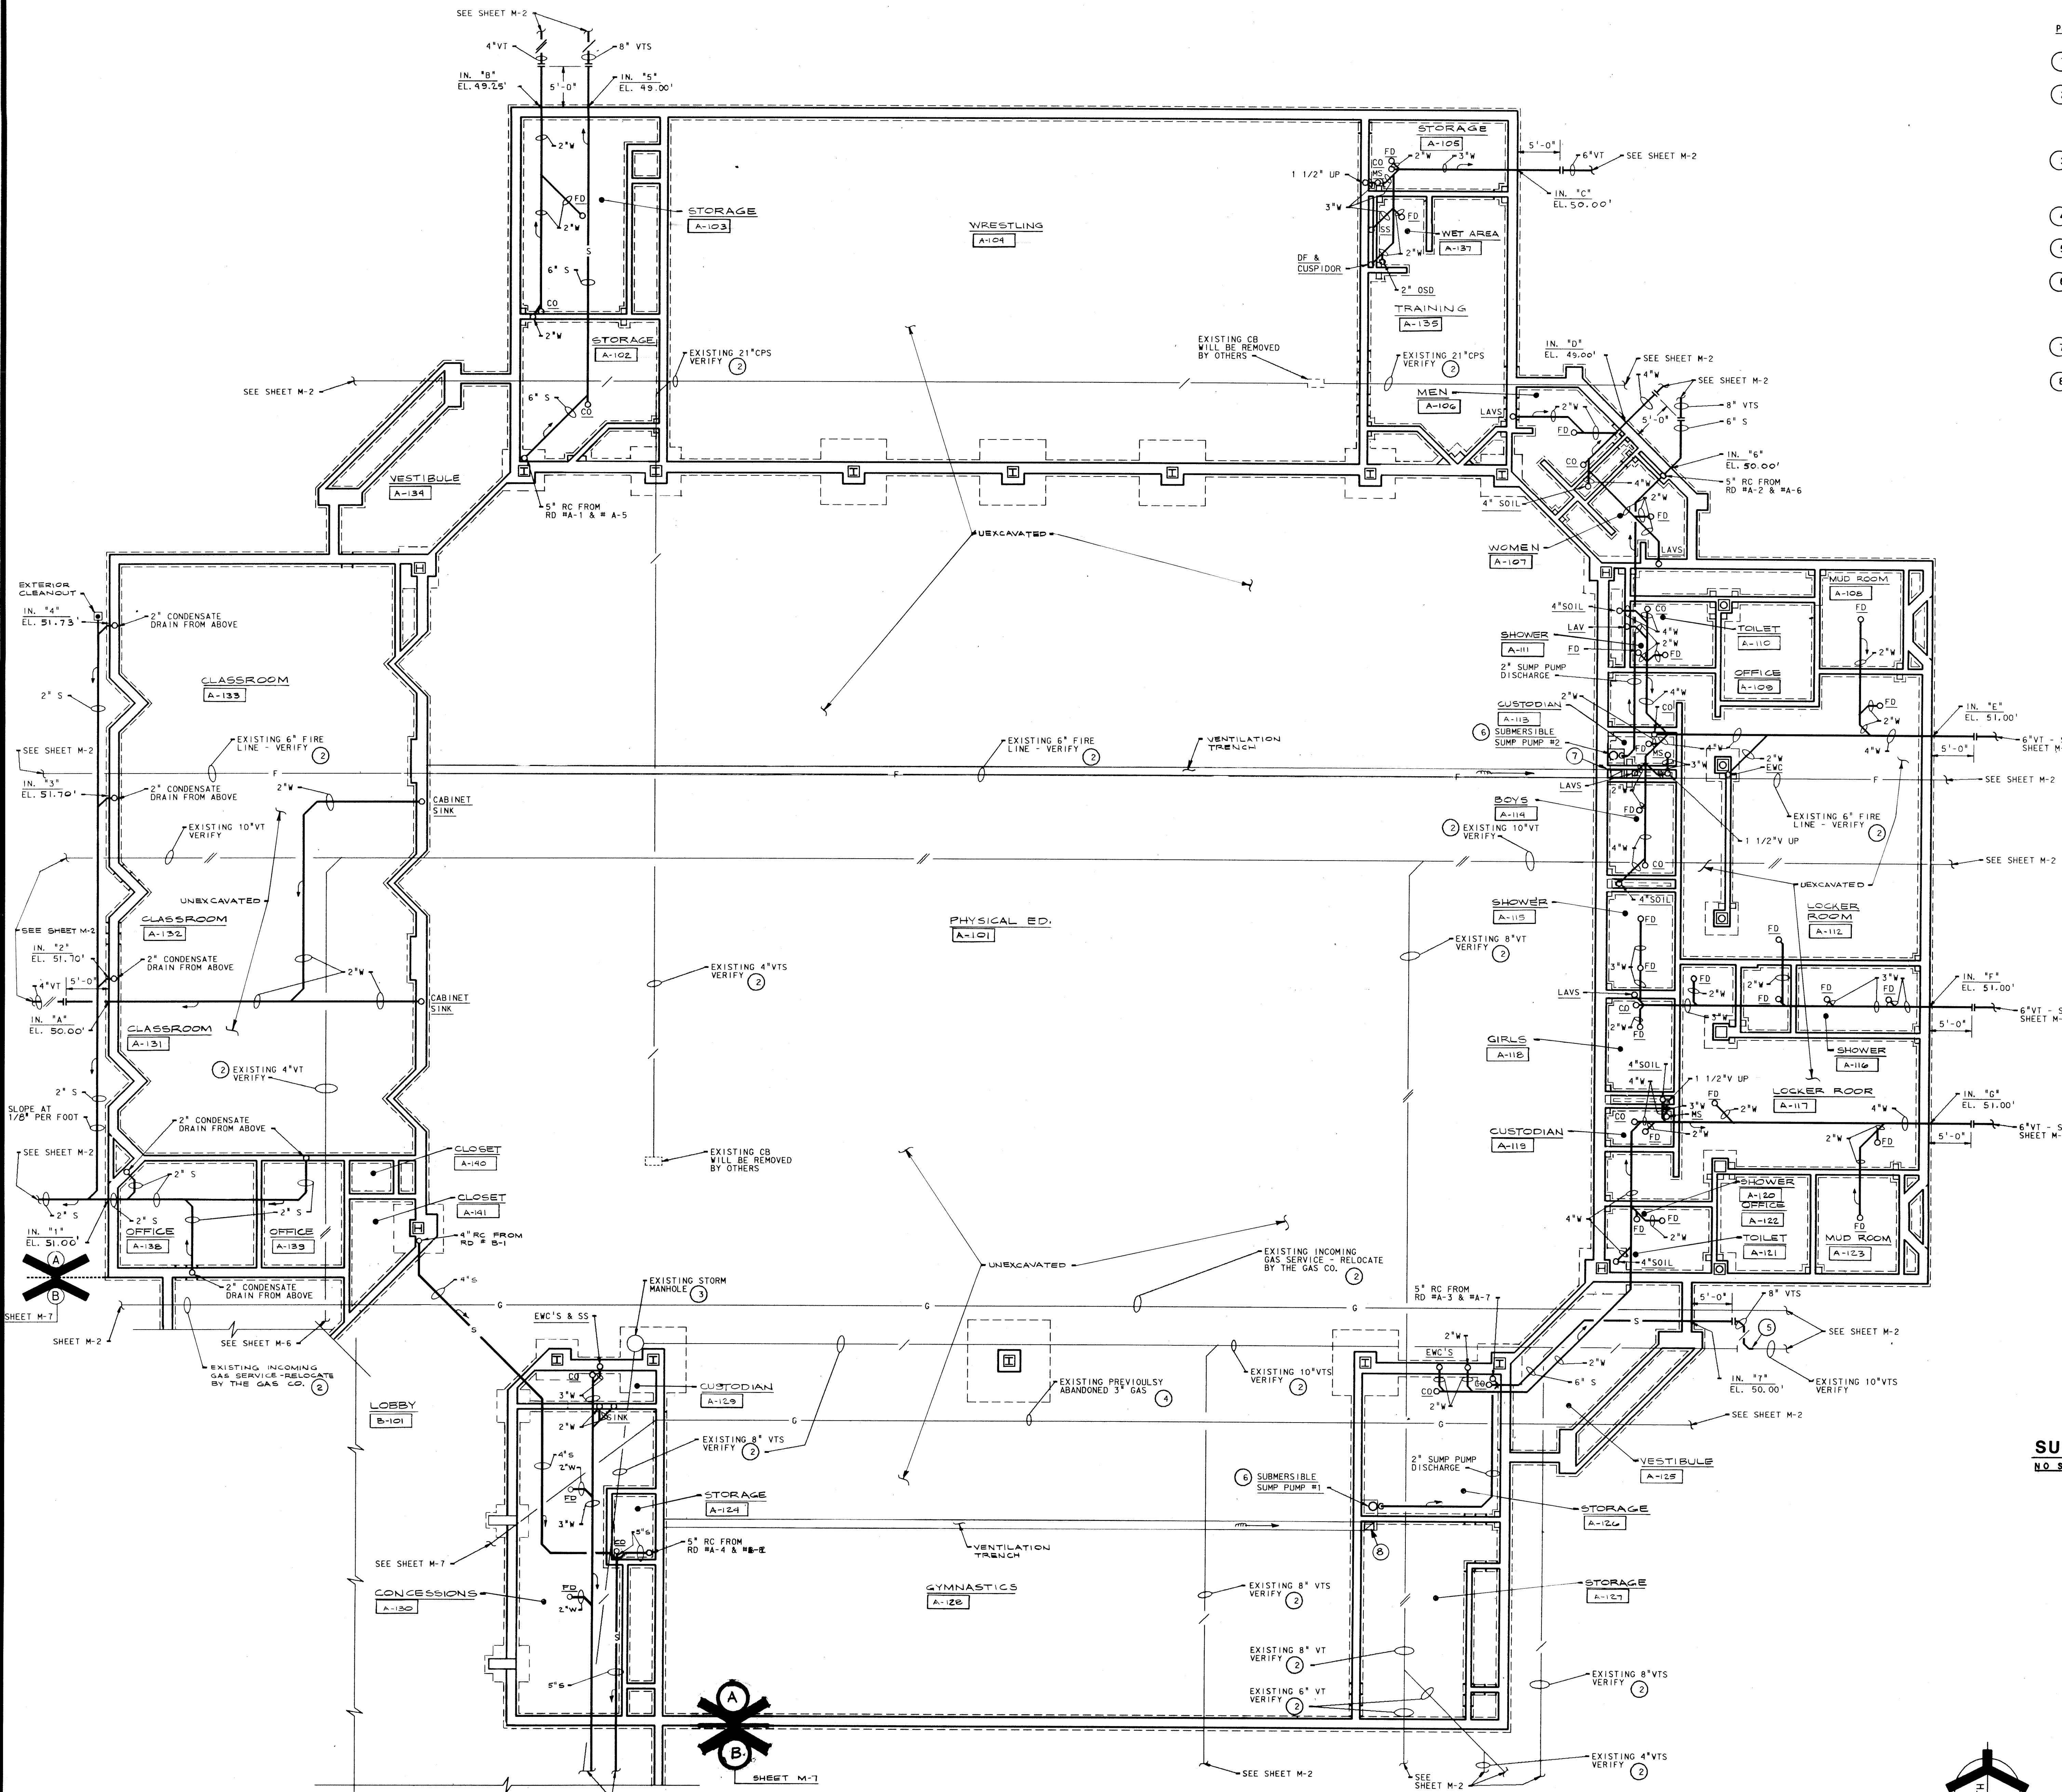


- PLAN NOTES**
- SEE SHEET M-1 FOR GENERAL MECHANICAL NOTES, LEGEND AND SCHEDULES.
 - EXISTING UTILITY SHALL REMAIN IN SERVICE UNTIL NEW CONSTRUCTION IS COMPLETE THEN SHALL BE CUT, PLUGGED, CAPPED AND ABANDONED IN PLACE OUT OF SERVICE. REMOVE ANY PART OF EXISTING UTILITY THAT INTERFERES WITH NEW MECHANICAL CONSTRUCTION.
 - EXISTING STORM MANHOLE VERIFY. REMOVE COVER AND RIM AND TURN OVER TO OWNER. FILL INVERTS WITH CEMENT. FILL MANHOLE WITH SAND, BREAK IN TOP AND ABANDON IN PLACE OUT OF SERVICE.
 - REMOVE ANY PART OF EXISTING PREVIOUSLY ABANDONED GAS THAT INTERFERES WITH NEW MECHANICAL CONSTRUCTION.
 - CONNECT NEW 8" VITRIFIED TILE SEWER TO EXISTING 10" VITRIFIED TILE SEWER AT INVERT ELEVATION 49.51'.
 - SUBMERSIBLE SUMP PUMPS #1 AND #2 SHALL BE ENPO COMPANY MODEL #AU, OR AN APPROVED EQUAL. HAVING THE CAPACITY TO PUMP 30 GPM AT 8 FEET OF HEAD. MOTOR DATA: 1/3 HP, 115 VOLT, 1-PHASE, 60 HERTZ, 1750 RPM. PROVIDE GATE AND CHECK VALVE IN PUMP DISCHARGE LINE.
 - STUB 18" X 12" EXHAUST DUCT INTO OPENING AT FLOOR LEVEL. SEAL AIRTIGHT. SEE SHEET M-9 FOR CONTINUATION.
 - STUB 14" X 12" EXHAUST DUCT INTO OPENING AT FLOOR LEVEL. SEAL AIRTIGHT. SEE SHEET M-8 FOR CONTINUATION.

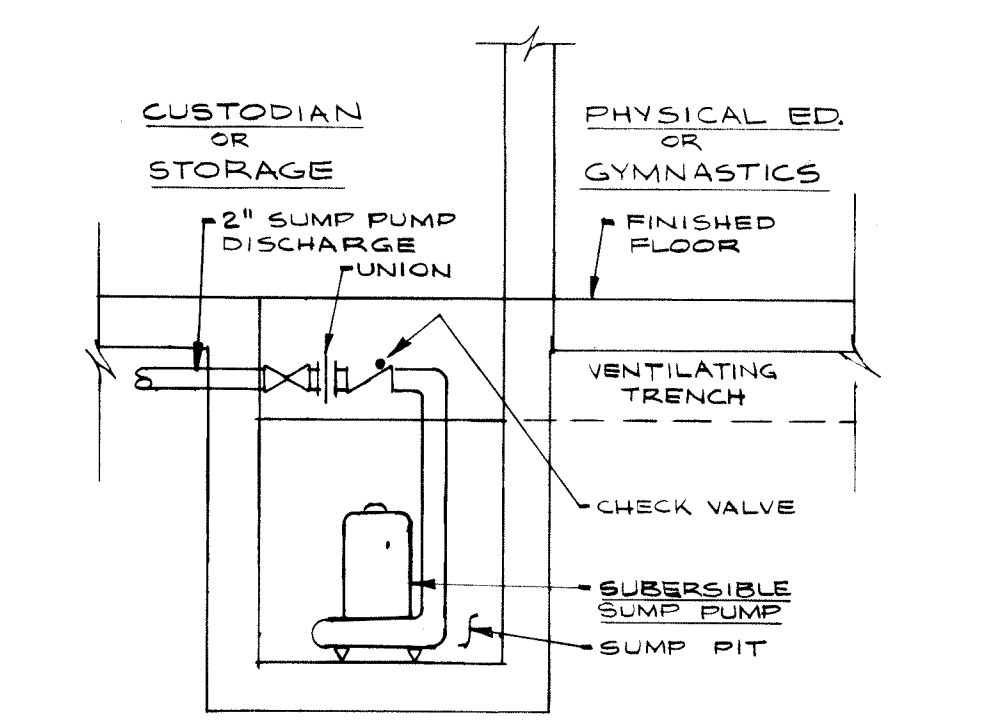


SUBMERSIBLE SUMP PUMP DETAIL
NO SCALE

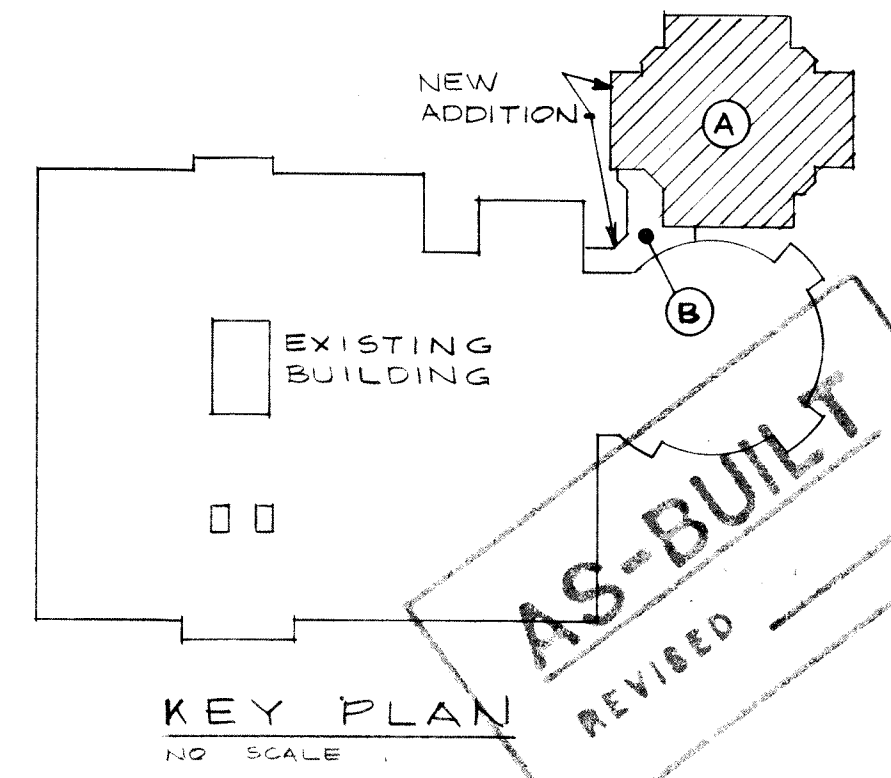

UNIT "A" VENTILATING & PLUMBING FOUNDATION PLAN
SCALE: 1/8" = 1'-0"

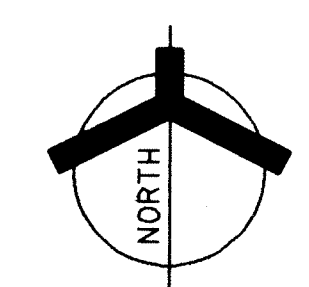

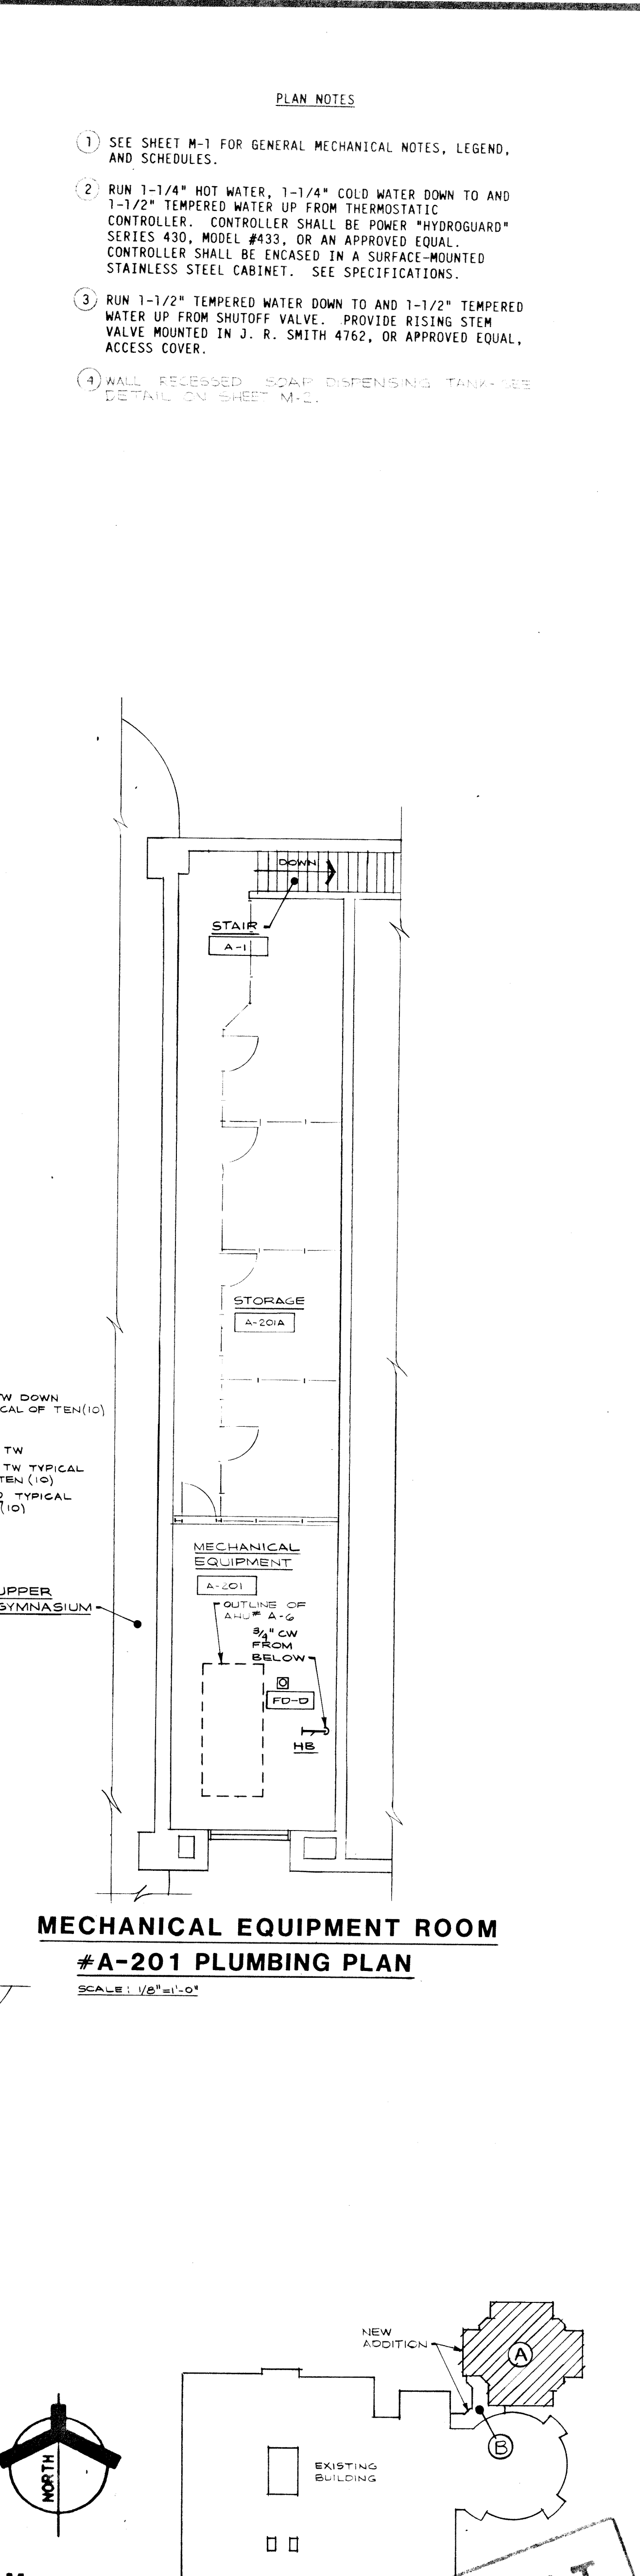

MECHANICAL EQUIPMENT ROOM
#A-202 PLUMBING PLAN
SCALE: 1/8" = 1'-0"

MECHANICAL EQUIPMENT ROOM
#A-201 PLUMBING PLAN
SCALE: 1/8"=1'-0"

James W. Roberts




PROJECT	851-190
DATE	MARCH 24, 1986
REVISED	

NO. M-5
OF 9

NO. M-6
OF 9


- ① SEE SHEET M-1 FOR GENERAL NOTES, LEGEND AND SCHEDULES.
- ② 12" X 12" TRANSFER AIR GRILLES IN CEILING CONNECTED BY A 12" X 8" DUCT. PROVIDE FIRE DAMPER WHERE DUCT PASSES THROUGH WALL.
- ③ CONNECT NEW 4" SUPPLY AND RETURN TO EXISTING 8" SUPPLY AND RETURN AS REQUIRED.
- ④ CONNECT NEW 2" CHILLED WATER AND CHILLED WATER RETURN TO EXISTING 8" CHILLED WATER AND CHILLED WATER RETURN AS REQUIRED.
- ⑤ TEMPERATURE CONTROL AIR COMPRESSOR AND AFTERCOOLER SHALL BE PROVIDED AND INSTALLED BY THE TEMPERATURE CONTROL CONTRACTOR. AIR COMPRESSOR SHALL BE A DUPLEX AIR DISPLACING TYPE MOUNTED ON A 200 GALLON HORIZONTAL RECEIVER - SEE SPECIFICATIONS. MOTOR DATA: (2) 5 H.P., 460 VOLTS, 3-PHASE, 60 HERTZ. AFTERCOOLER: 1 1/2 HP, 115 VOLT, 1-PHASE, 60 HERTZ. SEE SPECIFICATIONS.
- ⑥ DISCONNECT AND REMOVE EXISTING TEMPERATURE CONTROL AIR COMPRESSOR AND AFTERCOOLER AND TURN OVER TO THE OWNER.
- ⑦ DISCONNECT AND REMOVE EXISTING COMBUSTION AIR DUCTWORK FROM EXISTING WALL LOUVER. EXISTING LOUVER WILL BE REMOVED BY OTHERS.
- ⑧ CONNECT NEW COMBUSTION AIR DUCT TO EXISTING AS REQUIRED.
- ⑨ CONNECT NEW 7'-6" WIDE X 4'-6" HIGH X 3'-6" LONG PLENUM TO EXISTING OUTDOOR AIR INTAKE WALL OPENING AND PROVIDE AIRTIGHT JOINT. VERIFY EXISTING WALL OPENING SIZE BEFORE FABRICATING NEW DUCT. EXISTING OUTDOOR AIR INTAKE LOUVER IN EXISTING OPENING WILL BE REMOVED BY OTHERS.
- ⑩ 80" X 20" OUTDOOR INTAKE DUCT UP AND TERMINATE IN 8"-Ø X 3"-Ø X 2'-6" HIGH OUTDOOR AIR INTAKE PENENTROUS PROVIDED BY OTHERS. PROVIDE AIRTIGHT DUCT CONNECTION TO PENENTROUS AS REQUIRED.
- ⑪ THERMOSTAT SHALL CONTROL ROOF EXHAUST FAN #4 OPERATION


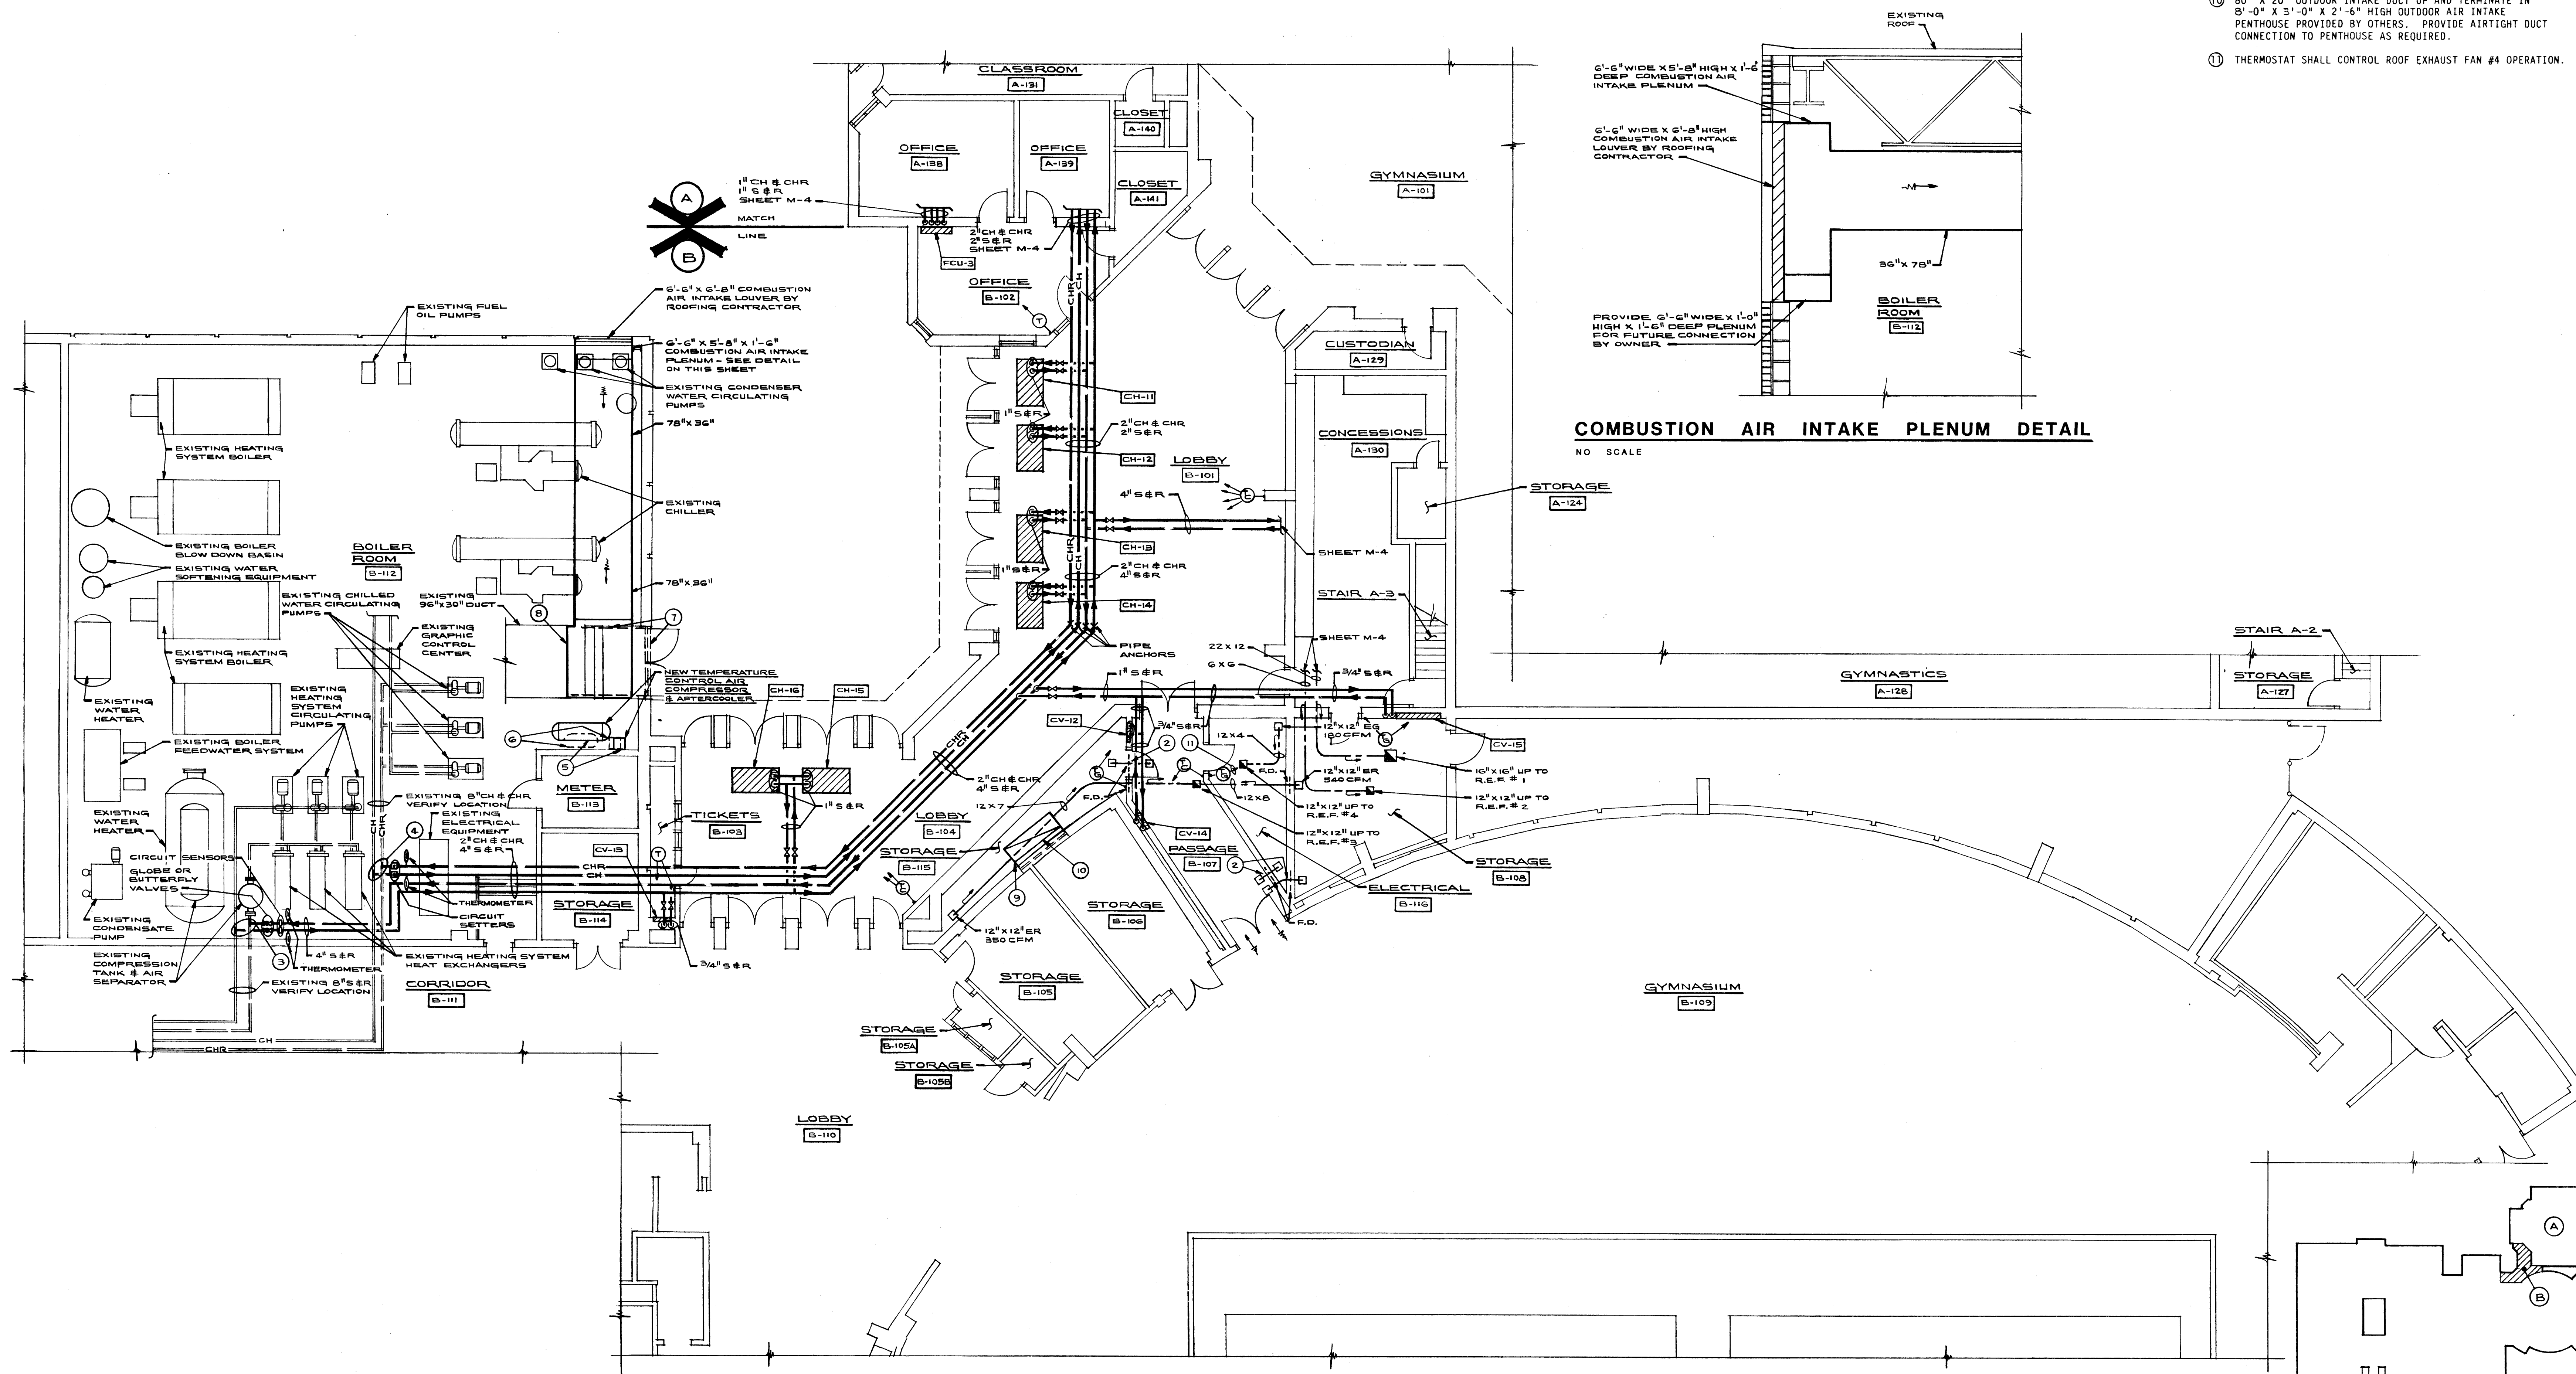


UNIT "B" HEATING, VENTILATING & AIR CONDITIONING FIRST FLOOR PLAN





AS-BUILT
REVISED

KEY PLAN
NO SCALE

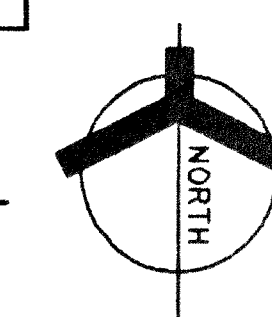

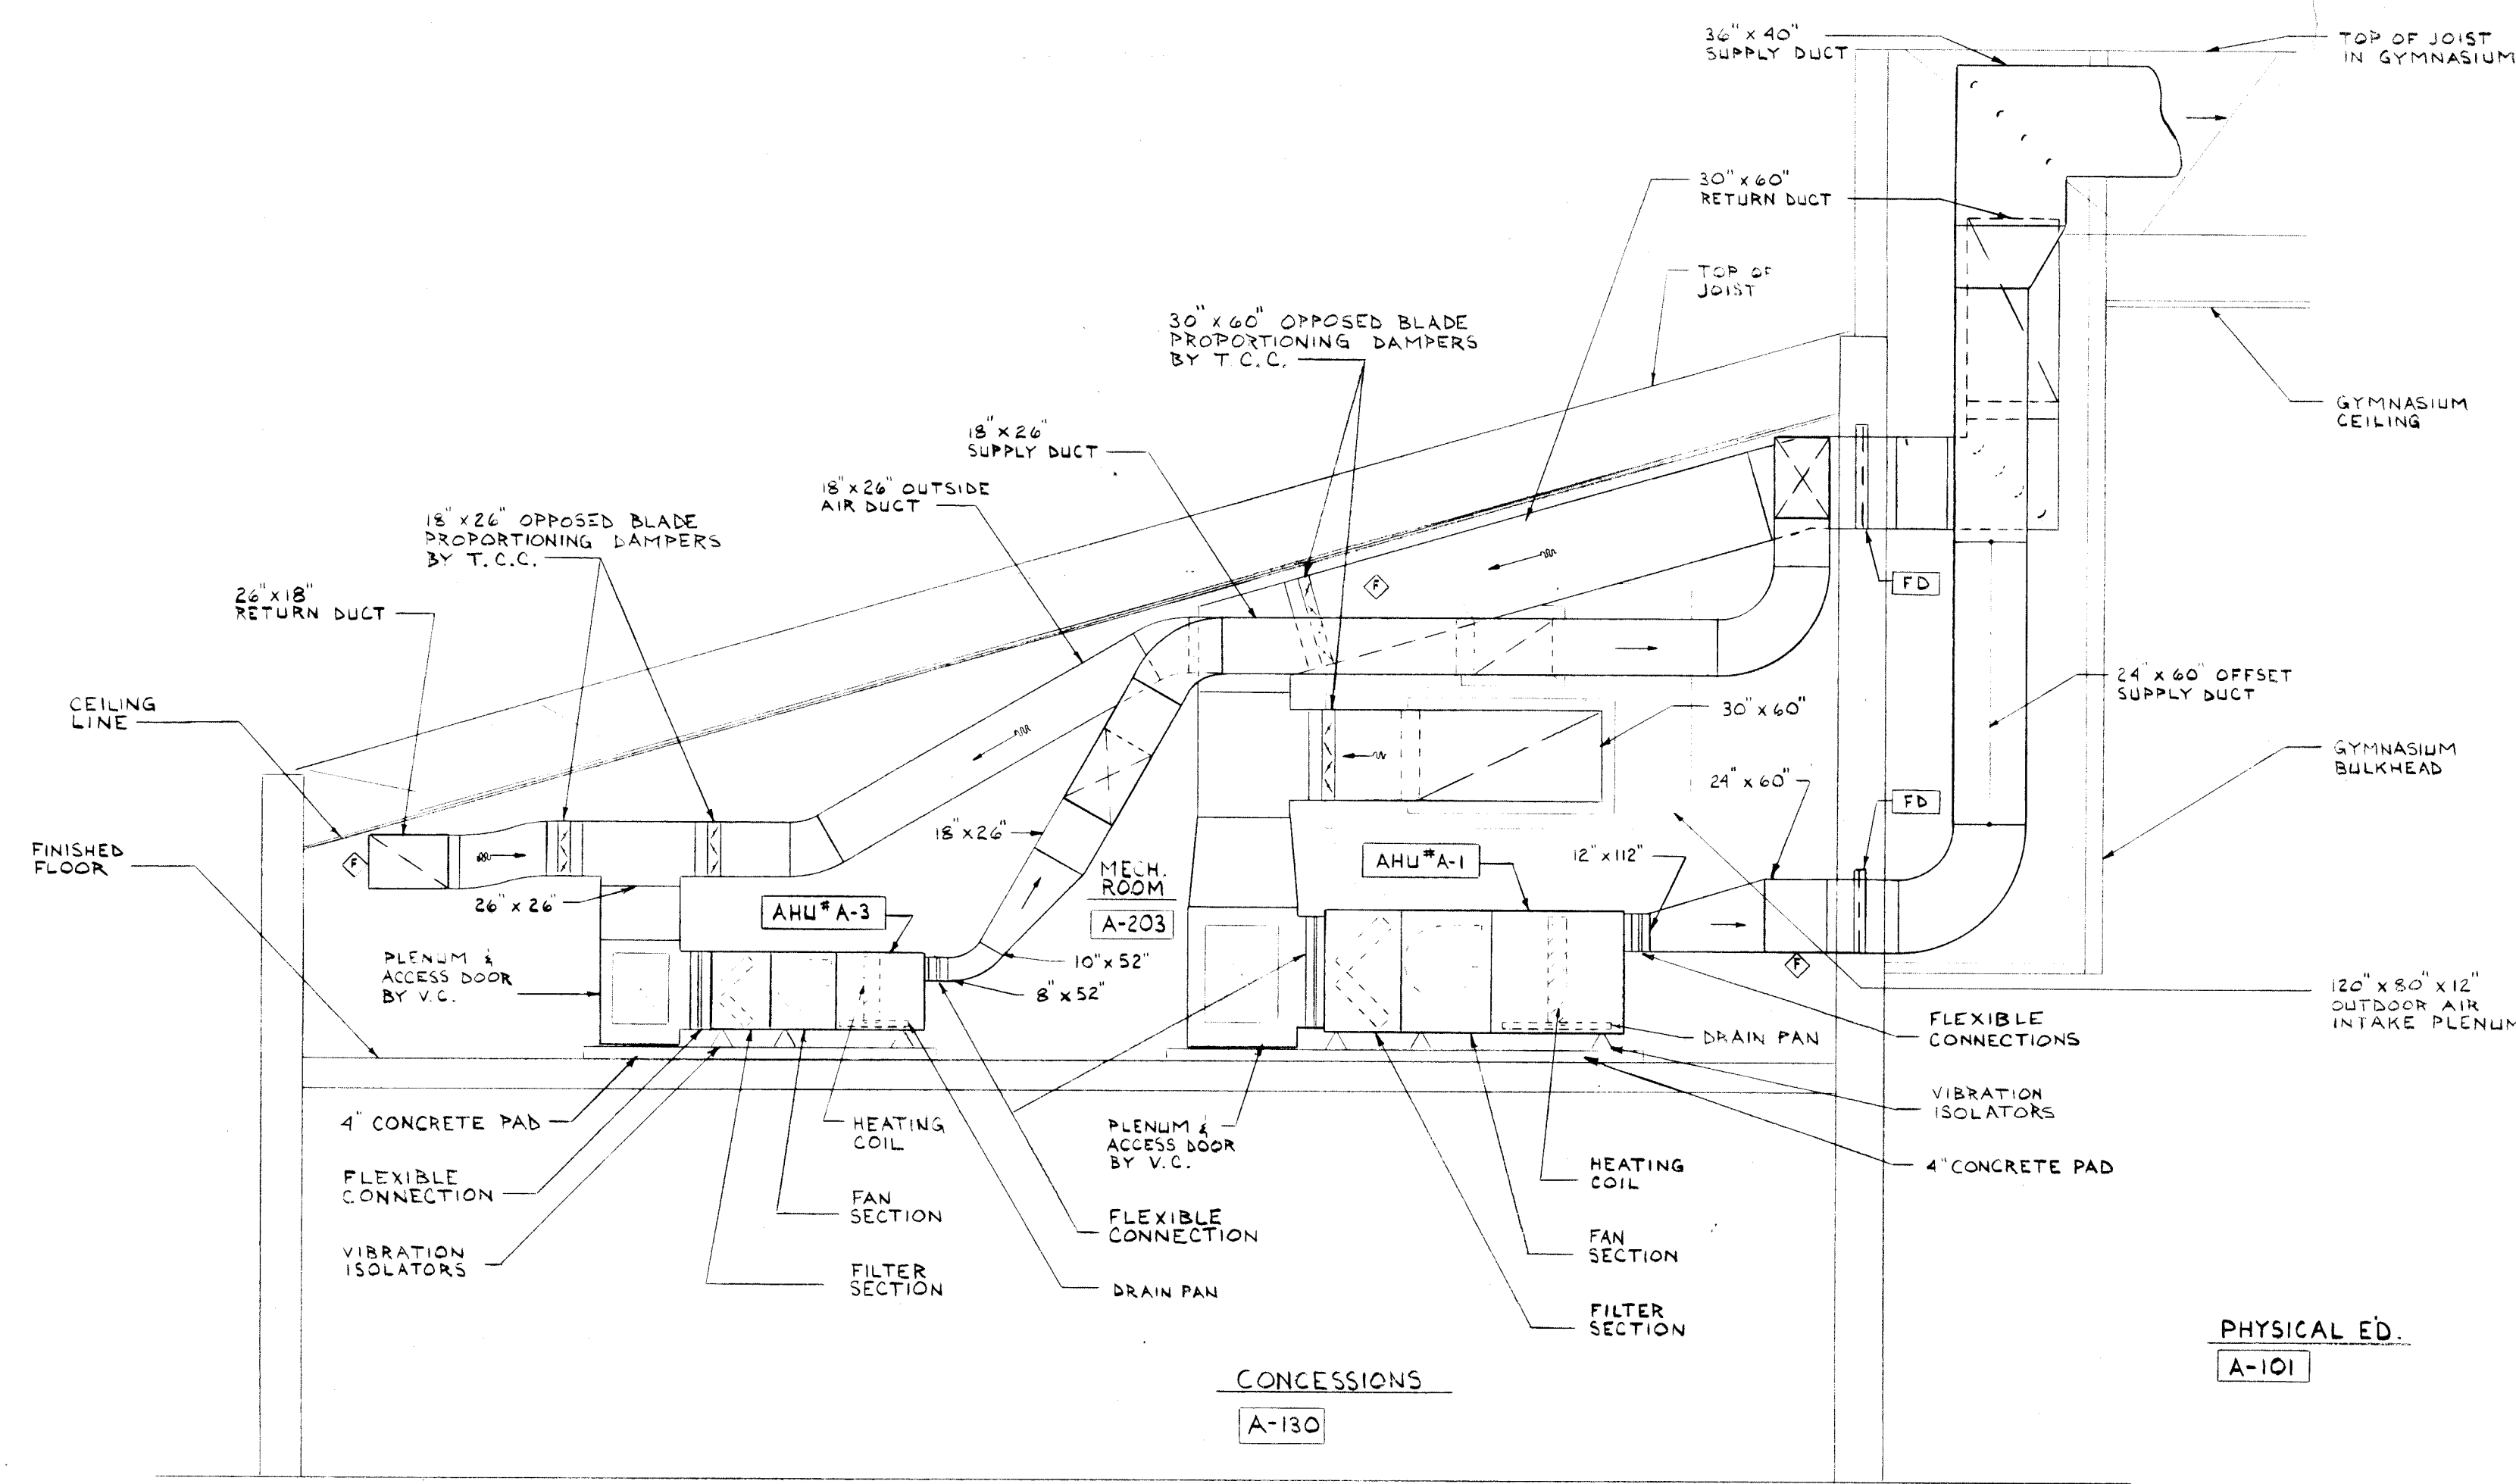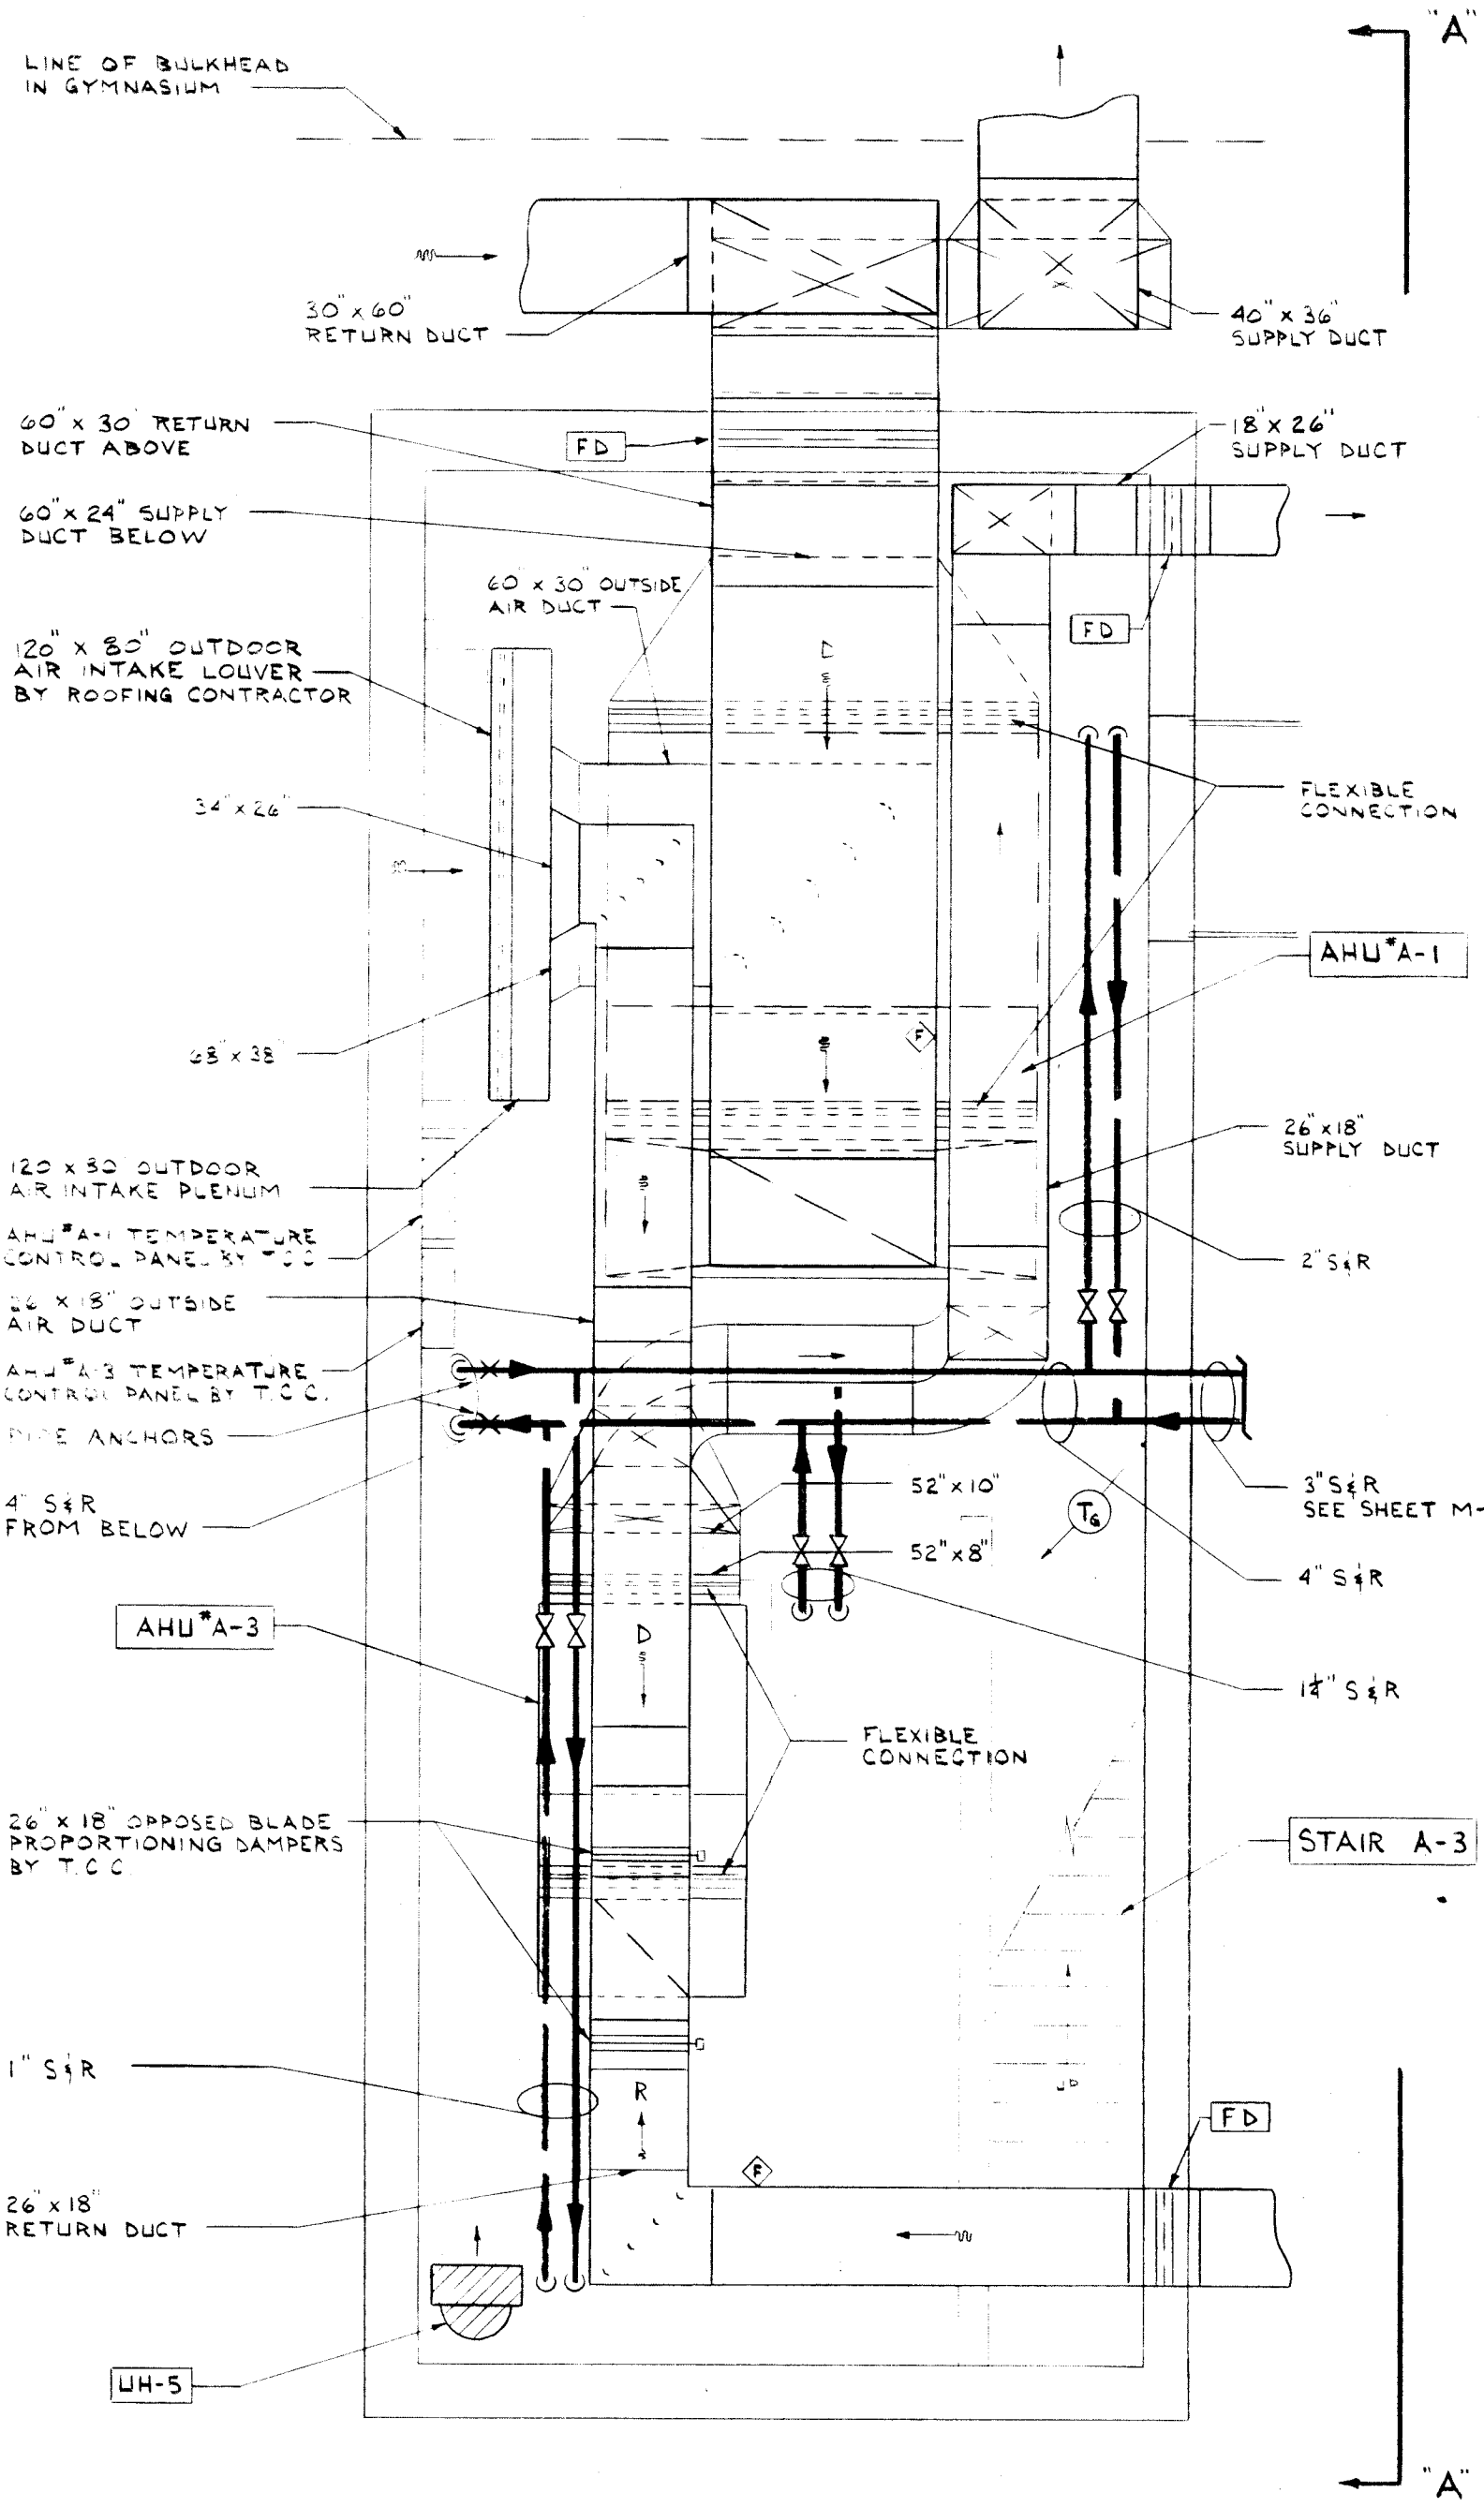

- PLAN NOTES:
- ALL LOW PRESSURE SUPPLY AND RETURN DUCTWORK SHALL BE LINED WITH 1/2" DUCT LINER.
 - ALL DIMENSIONS SHOWN ARE SHEET METAL DIMENSIONS.
 - ALL EXHAUST DISCHARGE DUCT FROM INLINE EXHAUST FANS SHALL BE COVERED WITH 1" INSULATION.
 - ALL SUSPENDED UNITS TO BE SUPPORTED FROM TOP CHORD OF JOIST.
 - ALL DUCT PENETRATIONS THROUGH MECHANICAL ROOM FLOORS AND WALLS SHALL HAVE FIRE DAMPERS WITH ACCESS DOORS.
 - CURB OPENING SIZES TO BE VERIFIED FROM FIRE DAMPER SCHEDULE WHERE TYPE "B" FIRE DAMPERS ARE REQUIRED.
 - PROVIDE DRAIN PAN FOR ALL AIR HANDLING UNIT HEATING COILS WITH 1-1/4" DRAIN LINE TERMINATING OVER NEAREST DRAIN.

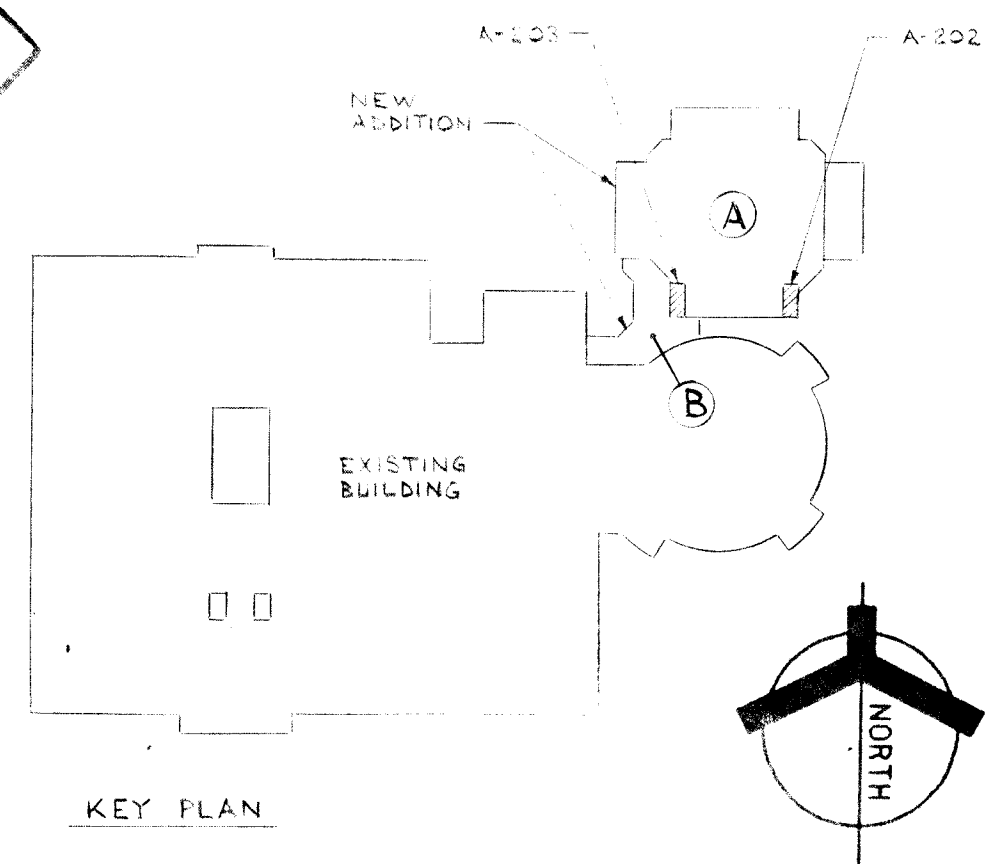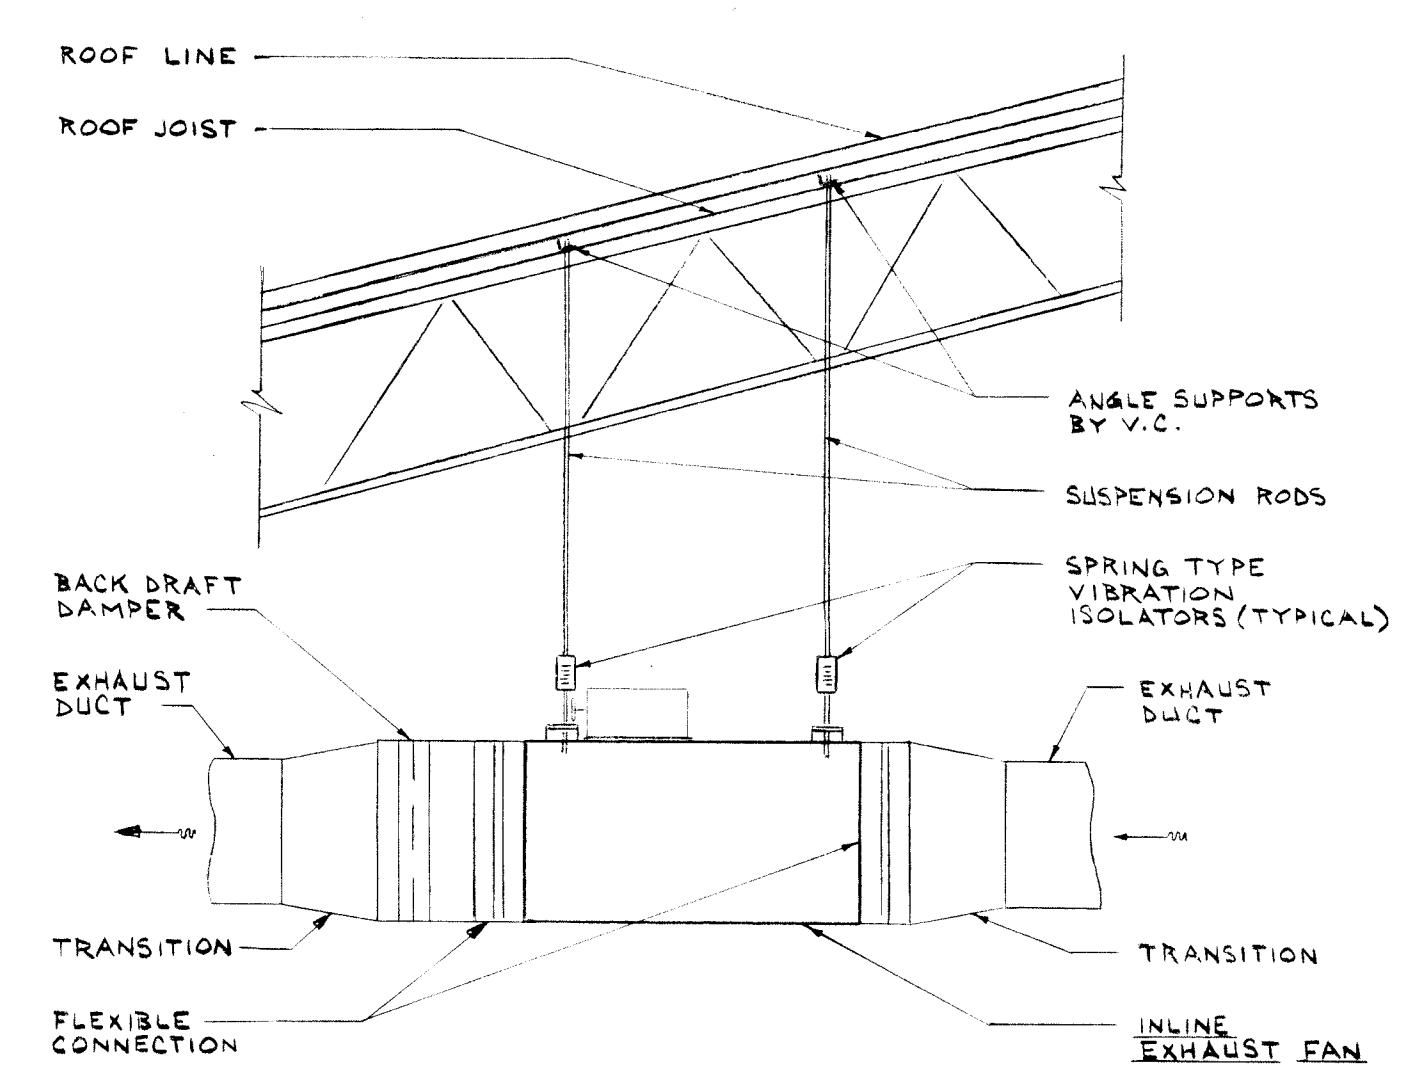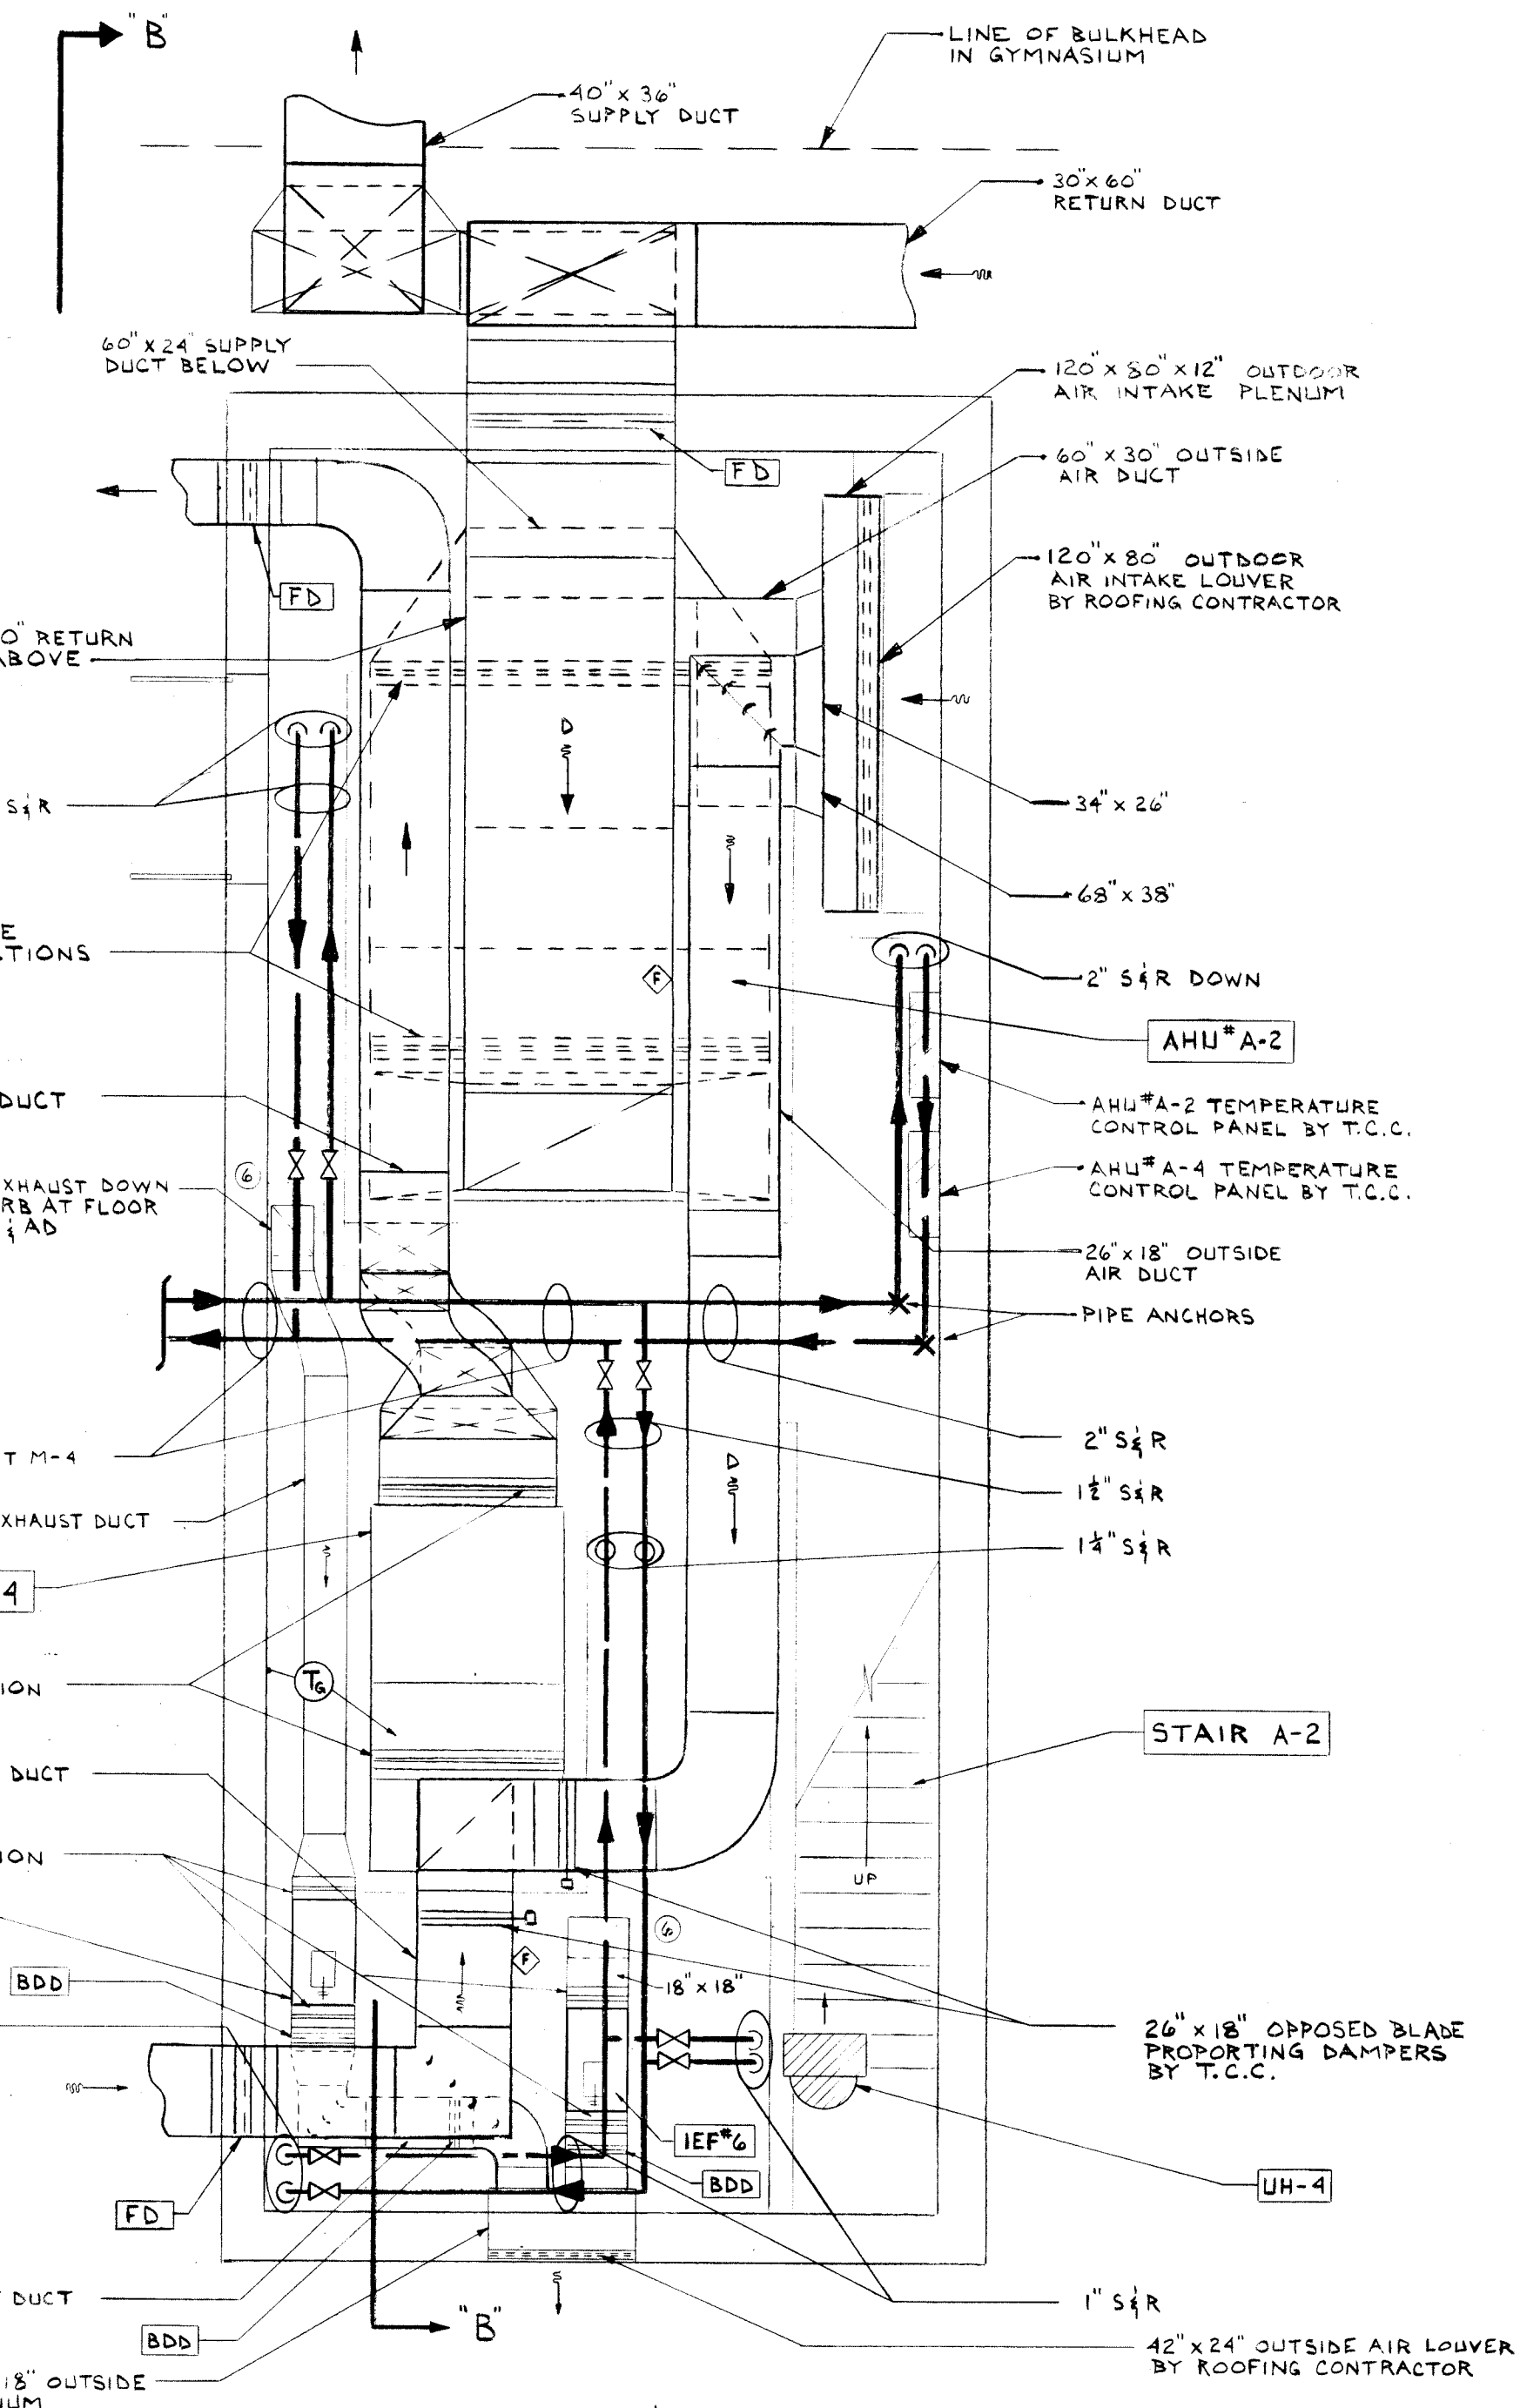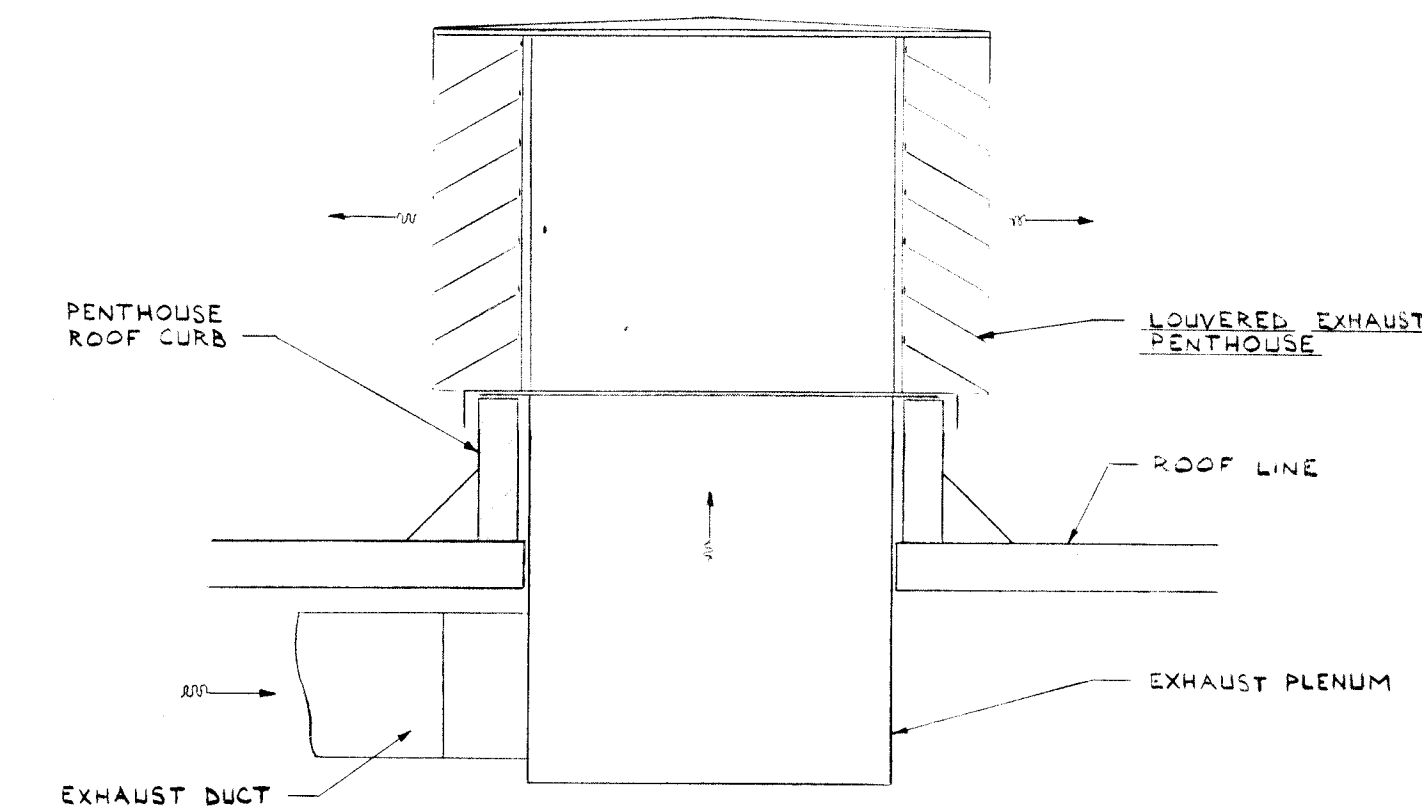


EVERETT · I · BROWN COMPANY ARCHITECTS ENGINEERS

941 NORTH MERIDIAN STREET · INDIANAPOLIS, INDIANA · 46204

LAWRENCE CENTRAL HIGH SCHOOL

James W. Roberts

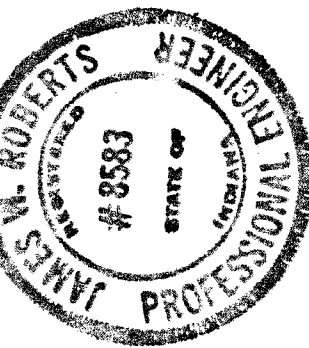

PROJECT: 851-180

DATE: MARCH 24, 1986

NO. M-2

OF

