

**ADDENDUM
NO. 2**

August 23, 2021

**SCHOOL CITY OF HAMMOND -
2021 RENOVATIONS TO MORTON HIGH SCHOOL
AND SCOTT MIDDLE SCHOOL
Hammond, IN 46320**

TO: ALL BIDDERS OF RECORD

This Addendum forms a part of and modifies the Bidding Requirements, Contract Forms, Contract Conditions, the Specifications, and the Drawings dated July 26, 2021 by Schmidt Associates. Acknowledge receipt of the Addendum in the space provided on the Bid Form. Failure to do so may subject the Bidder to disqualification.

This Addendum consists of page ADD 2-1 through ADD 2-3 and Addendum No. 2 from Schmidt Associates dated August 18, 2021 and consisting of 5 pages and 53 Drawings.

A. SPECIFICATION SECTION 00 31 00 – INDIANA BID FORM

1. Replace:

Specification Section 00 31 00 - Indiana Bid Form with the attached revised form.

B. SPECIFICATION SECTION 01 12 00 - MULTIPLE CONTRACT SUMMARY

Under 3.03 Bid Categories make the following adjustments:

1. BID CATEGORY NO. 1 - GENERAL TRADES

a. Add:

Specification Section 01 56 80 - Erosion Control
Specification Section 01 57 60 - Project Signs

- b. Revise:

BID CATEGORY NO. 1 - GENERAL TRADES

Clarification No. 17:

Regarding Specification Section 09 68 13 - Tile Carpeting and Section 09 68 16 - Sheet Carpeting: the Owner will FURNISH the Carpet material ONLY. The **Bid Category No. 1 Contractor** is to install this material and provide all other accessories, adhesives, materials, base, etc. required to accomplish a complete system.

- c. **Add:**

Clarification No. 19:

The **Bid Category No. 1 Contractor** shall provide plywood covered frames for window openings, overhead door openings, and hinged plywood at door openings to maintain temperatures necessary to perform the work and provide security in the normal phased sequence. Provide protection against adverse weather so that the building and materials will not be damaged, and against unauthorized entry. The **Bid Category No. 3 Contractor** shall remove the temporary plywood for the installation of their work in the normal phased sequence.

2. BID CATEGORY NO. 3 - GLAZING AND ALUMINUM STOREFRONTS

- a. **Add:**

Clarification No. 6:

The **Bid Category No. 1 Contractor** shall provide plywood covered frames for window openings, overhead door openings, and hinged plywood at door openings to maintain temperatures necessary to perform the work and provide security in the normal phased sequence. Provide protection against adverse weather so that the building and materials will not be damaged, and against unauthorized entry. The **Bid Category No. 3 Contractor** shall remove the temporary plywood for the installation of their work in the normal phased sequence.

3. BID CATEGORY NO. 5 - HVAC

- a. **Add:**

Clarification No. 13:

Regarding sheet M-420, the **Bid Category No. 5 Contractor** shall provide temporary cooling within the classrooms starting on April 4, 2022 until June 30, 2022.

4. **BID CATEGORY NO. 6 - ELECTRICAL**

a. **Add:**

Clarification No. 13:

Regarding sheet A-420 Scott Middle School, the **Bid Category No. 6 Contractor** shall provide temporary power and lighting within the temporary classrooms starting on September 15, 2021 until June 30, 2022.

C. **SPECIFICATION SECTION 01 23 00 - BID ALTERNATES**

1. **Replace:**

Specification Section 01 23 00 - Bid Alternates with the attached revised section.

CONTRACTOR'S BID FOR PUBLIC WORKS FORM NO. 96

Format (Revised 2013)
(Amended for SCH)

**Morton High School and
Scott Middle School Renovations**
School City of Hammond and
Hammond Multi-School Building Corporation
Hammond, IN

PART I

(To be completed for all bids. Please type or print)

Date (month, day, year): _____

BIDDER (Firm) _____

Address _____ P.O. Box _____

City/State/Zip _____

Telephone Number: _____ Email Address: _____

Person to contact regarding this Bid _____

Pursuant to notices given, the undersigned offers to furnish labor and/or materials necessary to complete the public works project of:

Insert Category No. (s) and Name(s)

Of public works project, ***Morton High School and Scott Middle School Renovations***, in accordance with Plans and Specifications prepared by ***Schmidt Associates, 415 Massachusetts Ave., Indianapolis, IN 46204***, as follows:

BASE BID

For the sum of _____
(Sum in words)

_____ DOLLARS (\$ _____)
(Sum in figures)

The undersigned acknowledges receipt of the following Addenda:

Receipt of Addenda No. (s) _____

PROPOSAL TIME

Bidder agrees that this Bid shall remain in force for a period of sixty (60) consecutive calendar days from the due date, and Bids may be accepted or rejected during this period. Bids not accepted within said sixty (60) consecutive calendar days shall be deemed rejected.

Attended pre-bid conference YES _____ NO _____

Has visited the jobsite YES _____ NO _____

The Bidder has reviewed the Guideline Schedule in Section 01 32 00 and the intent Of the schedule can be met.

YES _____ NO _____

Bidder has included their Written Drug Testing Plan that covers all employees of the bidder who will perform work on the public work project and meets or exceeds the requirements set in IC 4-13-18-5 or IC 4-13-18-6.

YES _____ NO _____

The Skillman Corporation’s diversity initiative is to create a program to encourage, assist and measure the active participation of Minority- Owned, Women-Owned, Veteran – Owned and Disabled Individual-Owned Businesses. The Program is to ensure that MWVDBEs are provided full and equal opportunity to participate in all Skillman Corporation’s Projects.

Bidder has included: DBE: YES _____ % NO _____
 MBE: YES _____ % NO _____
 WBE: YES _____ % NO _____
 VBE: YES _____ % NO _____

The undersigned further agrees to furnish a bond or certified check with this Bid for an amount specified in the Notice to Bidders. If Alternate Bids apply, submit a proposal for each in accordance with the Plans and Specifications.

If additional units of material included in the contract are needed, the cost of units must be the same as that shown in the original contract if accepted by the governmental unit. If the bid is to be awarded on a unit bases, the itemization of the units shall be shown on a separate attachment.

The contractor and his subcontractors, if any, shall not discriminate against or intimidate any employee, or applicant for employment, to be employed in the performance of this contract, with respect to any matter directly or indirectly related to employment because of race, religion, color, sex, national origin, or ancestry. Breach of this covenant may be regarded as a material breach of the contract.

CERTIFICATION OF USE OF UNITED STATES STEEL PRODUCTS
(if applicable)

I, the undersigned bidder, or agent as a contractor on a public works project, understand my statutory obligation to use steel products made in the United States (I.C. 5-16-8-2). I hereby certify that I and all subcontractors employed by me for this project will use U.S. steel on this project if awarded. I understand that violations hereunder may result in forfeiture of contractual payments.

ALTERNATE BIDS

A blank entry or an entry of "No Bid", "N/A", or similar entry on any Alternate will cause the bid to be rejected as non-responsive only if that Alternate is selected. If no change in the bid amount is required, indicate "No Change".

****MARK "ADD" OR "DEDUCT" FOR EACH ALTERNATE****

Alternate Bid No. 1 – Scott Middle School Auditorium Seating

Change the Base Bid the sum of _____
(sum in words)

_____ DOLLARS (\$_____) ADD
(sum in figures) DEDUCT

Alternate Bid No. 2 – Scott Middle School Acoustical Ceilings

Change the Base Bid the sum of _____
(sum in words)

_____ DOLLARS (\$_____) ADD
(sum in figures) DEDUCT

Alternate Bid No. 3 – Scott Middle School Storefronts

Change the Base Bid the sum of _____
(sum in words)

_____ DOLLARS (\$_____) ADD
(sum in figures) DEDUCT

PART II

(For projects of \$150,000 or more – IC 36-1-12-4)

These statements to be submitted under oath by each bidder with and as a part of his bid. (Attach additional pages for each section as needed.)

SECTION I EXPERIENCE QUESTIONNAIRE

1. What public works projects has your organization completed for the period of one (1) year prior to the date of the current bid?

Contract Amount	Class of Work	Completion Date	Name and Address of Owner

2. What public works projects are now in process of construction by your organization?

Contract Amount	Class of Work	Completion Date	Name and Address of Owner

3. Have you ever failed to complete any work awarded to you? _____ If so, where and why?

4. List references from private firms for which you have performed work.

SECTION II PLAN AND EQUIPMENT QUESTIONNAIRE

1. Explain your plan or layout for performing proposed Work. (Examples could include a narrative of when you could begin, complete the project, number of workers, etc. and any other information which you believe would enable the governmental unit to consider your bid.)

2. Please list the names and addresses of all subcontractors (i.e. persons or firms outside your own firm who have performed part of the work) that you have used on public works projects during the past five (5) years along with a brief description of the work done by each subcontractor.

3. If you intend to sublet any portion of the work, state the name and addresses of each subcontractor, equipment to be used by the subcontractor, and whether you will require a bond. However, if you are unable to currently provide a listing, please understand a listing must be provided prior to contract approval. Until the completion of the proposed project, you are under a continuing obligation to immediately notify the governmental unit in the event that you subsequently determine that you will use a subcontractor on the proposed project.

4. What equipment do you have available to use for the proposed Project? Any equipment used by subcontractors may also be required to be listed by the governmental unit.

5. Have you into contracts or received offers for all materials which substantiate the prices used in preparing your proposal? If not, please explain the rationale used which corroborate the process listed.

SECTION III CONTRACTOR'S FINANCIAL STATEMENT

Attachment of Bidder's financial statement is mandatory. Any Bid submitted without said financial statement as required by statute shall thereby be rendered invalid. The financial statement provided hereunder to the governing body awarding the Contract must be specific enough in detail so that said governing body can make a proper determination of the Bidder's capability for completing the Project if awarded.

SECTION IV CONTRACTOR NON-COLLUSION AFFIDAVIT

The undersigned Bidder or agent, being duly sworn on oath, says that he has not, nor has any other member, representative, or agent of the firm, company, corporation or partnership represented by him, entered into any combination, collusion or agreement with any person relative to the price to be bid by anyone at such letting nor to prevent any person from bidding nor to induce anyone to refrain from bidding, and that this Bid is made without reference to any other bid and without any agreement, understanding or combination with any other person in reference to such bidding.

He further says that no person or persons, firms, or corporations has, have, or will receive directly or indirectly, any rebate, fee, gift, commission, or thing of value on account of such contract.

SECTION 01 23 00 - ALTERNATES

PART 1 - GENERAL

1.01 RELATED DOCUMENTS

- A. Drawings and general provisions of the Contract, including amended General Conditions and other Division 1 Specification Sections, apply to work of this Section.

1.02 PURPOSE

- A. The Bids for the Alternates described herein are required in order for the Owner to obtain information necessary for the proper consideration of the Project in its entirety.

1.03 ALTERNATES

- A. Definitions: Alternates are defined as alternate products, materials, equipment, installations or systems for the Work, which may, at Owner's option and under terms established by Instructions to Bidders, be selected and recorded in the Owner-Contractor Agreement to either supplement or displace corresponding basic requirements of Contract Documents. Alternates may or may not substantially change scope and general character of the Work; and must not be confused with "allowances", "unit prices", "change orders", "substitutions", and other similar provisions.

1.04 SCHEDULE OF ALTERNATES

- A. ALTERNATE NO. 1: State the cost to provide new auditorium seating for Scott Middle School as listed in the Contract Documents.
- B. ALTERNATE NO. 2: State the cost to provide new acoustical ceilings for Scott Middle School as listed in the Contract Documents.
- C. ALTERNATE NO. 3: State the cost to provide new storefront systems for Scott Middle School as listed in the Contract Documents.

PART 2 - PRODUCTS, PART 3 - EXECUTION (Not Used)

END OF SECTION 01 23 00

ADDENDUM NO. 2

AUGUST 18, 2021

PREPARED BY SCHMIDT ASSOCIATES FOR:
MORTON HS AND SCOTT MS RENOVATIONS
HAMMOND, SCHOOL CITY OF

This Addendum consists of 5 Addendum pages and 53 attachment pages totaling 58 pages.

Acknowledge receipt of this Addendum by inserting its number on the Bid Form. Failure to do so may subject the Bid to disqualification. This Addendum is part of the Contract Documents.

Bidder is encouraged to verify with reprographer of record all Addenda issued (do not rely exclusively on third party plan room services).

PART 1 - CHANGES TO PRIOR ADDENDA (NOT APPLICABLE)

PART 2 - CHANGES TO THE PROJECT MANUAL

Modifications described herein shall be incorporated in the Project Manual. All other Work shall remain unchanged.

2.1 DIVISION 09 – FINISHES

A. Section 096466 “WOOD ATHLETIC FLOORING”

1. ADD Subparagraphs 2.1 A.3 & 4 as follows:
“3. Acer Flooring; Anchored PowerSleeper SE
4. Action Flooring System; Power Channel”

2.2 DIVISION 10 – SPECIALTIES

A. Section 101100 “VISUAL DISPLAY UNITS”

1. ADD Subparagraph 2.2.A.1.d. as follows:
“d. K-Pro Specialty Products”

2.3 DIVISION 11 – EQUIPMENT

A. Section 115313 “LABORATORY FUME HOODS”

1. Add Subparagraph 2.1, A., 7. as follows:
"7. Hamilton Laboratory Solutions"

2.4 DIVISION 12 – FURNISHINGS

A. Section 126100 "FIXED AUDIENCE SEATING"

1. ADD Subparagraph 2.2.A.1. c. as follows:
"c. Davis Seating, Convention T35, Black"

2.5 DIVISION 23 - HEATING, VENTILATING, AND AIR-CONDITIONING(HVAC)

A. Section 230713 "DUCT INSULATION"

1. DELETE Subparagraph 1.2.B.3 in its entirety,

B. Section 230900 "DIRECT DIGITAL CONTROL SYSTEMS"

1. DELETE AND REPLACE Text within 1.7 Table with the following:
"Manufacturer C – Schneider installed by branch office only"

C. Section 233113 "METAL DUCTS"

1. DELETE & REPLACE Paragraph 3.8A with the following: "
"A. Clean existing duct system(s) associated with RTU H-15 before testing, adjusting and balancing."

PART 3 - CHANGES TO THE DRAWINGS

Modifications described herein shall be incorporated in the Drawings. All other Work shall remain unchanged.

3.1 DRAWING SHEETS: ADDITIONS, DELETIONS AND REPLACEMENTS (MORTON HIGH SCHOOL)

DRAWING NO.	INDICATE ACTION: REPLACE (R), ADD (A), DELETE (D)
A-SERIES DRAWINGS	
MHS - AF1A1	DELETE AND REPLACE
M-SERIES DRAWINGS	
MHS -MH1A1	DELETE AND REPLACE
MHS -MH2A1	DELETE AND REPLACE
MHS -MH1B1	DELETE AND REPLACE

E-SERIES DRAWINGS

MHS – EL1A1	DELETE AND REPLACE
MHS – EL1B1	DELETE AND REPLACE
MHS – EL1H1	DELETE AND REPLACE
MHS – EL1A2	DELETE AND REPLACE
MHS – EP1A2	DELETE AND REPLACE
MHS – EP1B1	DELETE AND REPLACE
MHS – E-601	DELETE AND REPLACE
MHS – E-602	DELETE AND REPLACE
MHS – E-603	DELETE AND REPLACE

3.2 DRAWING SHEETS: ADDITIONS, DELETIONS AND REPLACEMENTS (SCOTT MIDDLE SCHOOL)

DRAWING NO.	INDICATE ACTION: REPLACE (R), ADD (A), DELETE (D)
G-SERIES DRAWINGS	
SMS - G-001	DELETE AND REPLACE
SMS - G-003	ADD
SMS - G-004	ADD
A-SERIES DRAWINGS	
SMS - AD1D1	DELETE AND REPLACE
SMS - AF1B1	DELETE AND REPLACE
SMS - AF1C1	DELETE AND REPLACE
SMS - AF1E1	DELETE AND REPLACE
SMS - AD1C1	DELETE AND REPLACE
SMS - A-420	ADD
M-SERIES DRAWINGS	
SMS -MH1B1	DELETE AND REPLACE
SMS -MH1C1	DELETE AND REPLACE
SMS -MH1D1	DELETE AND REPLACE
SMS -MR101	DELETE AND REPLACE
SMS -M-420	DELETE AND REPLACE
SMS -M-601	DELETE AND REPLACE
P-SERIES DRAWINGS	
SMS -P-601	DELETE AND REPLACE
SMS -P-902	DELETE AND REPLACE
SMS -P-903	DELETE AND REPLACE

E-SERIES DRAWINGS

SMS -ES101	ADD
SMS -ED1C1	DELETE AND REPLACE
SMS -EL1A1	DELETE AND REPLACE
SMS -EL1B1	DELETE AND REPLACE
SMS -EL1C1	DELETE AND REPLACE
SMS -EL1D1	DELETE AND REPLACE
SMS -EP101	DELETE AND REPLACE
SMS -EP1A1	DELETE AND REPLACE
SMS -EP1B1	DELETE AND REPLACE
SMS -EP1D1	DELETE AND REPLACE
SMS -ER1C1	DELETE AND REPLACE
SMS -ER1D1	DELETE AND REPLACE
SMS -E-420	ADD
SMS -E-501	DELETE AND REPLACE
SMS -E-601	DELETE AND REPLACE
SMS -E-602	DELETE AND REPLACE
SMS -E-603	DELETE AND REPLACE
SMS -E-604	DELETE AND REPLACE

T-SERIES DRAWINGS

SMS -TF1C1	DELETE AND REPLACE
SMS - T-420	ADD

3.3 P-SERIES DRAWINGS

A. Drawing Number PD1B1 (SCOTT MS)

1. MODIFY Note #5 as follows:

“REMOVE EXISTING WATER METER AND PIPING BACK TO MAIN SHUTOFF VALVE.
PROVIDE NEW PIPING AND INSTALL NEW WATER METER WITH BACKFLOW PREVENTER.”

3.4 E-SERIES DRAWINGS

A. Drawing Number ED1A1 (MORTON HS)

1. MODIFY note at panel J as follows:
“REMOVE 20-CIRCUIT PANELBOARD. PRESERVE FEEDER FOR REUSE IN NEW WORK.
TAG CIRCUITS, PROTECT BRANCH CIRCUIT WIRING, RECONNECT BRANCH CIRCUITS TO
NEW PANEL. CUT CMU WALL TO RECEIVE NEW 30-CIRCUIT PANELBOARD.”

B. Drawing Number EP1C1 (SCOTT MS)

1. MODIFY Drawing EP1C1 as follows:
On south wall of office 52A adjacent to FAAP, add quadraplex receptacle at 48” A.F.F. to
CL to serve new intercom rack equipment. Coordinate with T-Series drawings.

END OF ADDENDUM 2

AVAILABLE PROJECT INFORMATION

The following Bidders' questions are being made available to Bidders for informational purposes only and is not a part of the Addendum.

Morton High School and Scott Middle School Renovations and Addition Project

Bidder's Questions – Addendum #2

1. can you clarify if the ductwork gets liner or wrap? Calls out both in the spec Response:
Externally Wrapped
2. Scott MS: I can't find the depth of the existing pool to determine how much granular fill is required. Response: See Addendum #2. The existing drawings of the swimming pool has been provide for reference only.
3. Scott MS: Demo dwgs, Note 29 state to remove pool equipment but everything is covered and can't determine how much pool equipment is below wood sub floor. Can we get more information? Response: See Addendum #2, Drawing Sheet AD1D1.
4. Scott MS: Demo dwgs, Note 28 state to remove wood subfloor and sleepers. Can you give a narrative on how they framed over the pool to support the plywood sheathing? Response: See Addendum #2, Drawing Sheet AD1D1.
5. Scott MS: What is the height of the roof deck in unit D in Scott Middle School? Please clarify if there is more than one deck elevation. Response: According to the existing Structural Roof Framing Plans, the majority of the top of steel for unit D is between 118'-0" to 117'-7". The Gymnasium is 129'-8".
6. Scott MS: What is the height of the roof deck in unit A, B, C in Scott Middle School? Please clarify if there is more than one deck elevation. Response: According to the existing Structural Roof Framing Plans, the top of steel is between 112'-7" and 113'-0".
7. Scott MS: Please clarify the scope of work for the electrostatic painting of the lockers. There is a section in the specs for electrostatic painting, but no description of what is painted. Response: See Plan Note #9 on the AF-Series Drawings for Scott Middle School. All of the existing metal lockers (inside and outside) are to be electrostatic painted.
8. Morton HS: Filling 112A shows a door frame to be removed (AD1A1), later to be infilled (AF1A1), but shows no Plan Note. What is this to be infilled with? Response: See Addendum #2, AF1A1.
9. Morton HS: AD1A1 shows a section of wall to be removed near door112A, for what looks to be a new door, but AF1A1 shows nothing in that area. Please clarify. Response: See Addendum #2, AF1A1.
10. Scott MS: Plumbing 41 (AD1B1, Note 17) shows door removed and (AF1B1) shows that opening to be infilled. Do you happen to know the makeup of the surrounding walls, and the size of the existing door? Response: According to the existing drawings, the existing surrounding walls are 6" glazed block/tile and the door is a 30" wide door. Bidders can visit the site to verify existing conditions. Coordinate visit with CM.
11. Scott MS: Corridor 92 (AF1D1) show miscellaneous infills to match in areas around perimeter where existing doors/wood window wall (AD1D1, Notes 4 & 16) were removed. Do you know makeup of these walls and sizes? Response: Contractor is responsible to verify the existing construction in the field. Bidders can visit the site to verify. Coordinate visit with CM.
12. Scott MS: Unit D has infill in areas with structural glazed tile per note 2 sheet AF1D1. Is SGT required for the infill? Response: Yes, contractor are to match the adjacent construction as stated on the Plan Note.

13. Who is the current Temperature Control Contractor that the school uses? Response: Precision.
14. Spec. Section 233113 -3.8 calls for cleaning current and existing duct. Existing Duct is not shown completely. How are we to price this? Response: Only duct system to be cleaned shall be duct system connected to RTU unit H-15. See revised spec in addendum #2.
15. Scott MS: Sheet EL1D1 shows EM fixtures fed from lighting inverter MI-D1, however, MI-D1's location isn't shown nor is it listed on the Central Battery Equipment schedule on Sheet E-602. Please advise. Response: See Addendum #2.
16. Scott MS: Sheet ER1C1 – it is assumed that RTU H-15 is to receive a new 480V circuit from the existing MSB, is this correct? Additionally, I feel this sheet indicates there is an existing, spare, 3P-100A breaker for this feed in the MSB, is this correct? This was discussed during the walkthrough, but I'd like clarification. Response: See Addendum #2.
17. Scott MS: Sheet ER1D1 – It is assumed that RTU H-18 is to receive a new 480V circuit from the existing MSB, is this correct? This was discussed during the walkthrough, but I'd like clarification. Response: See Addendum #2.
18. Scott MS: A couple of the Roof Plan Power drawings call out a receptacle circuit for roof top air handling units. However, these circuits are labeled 'unnamed'. Please advise. Response: See Addendum #2.

School City of Hammond Scott Middle School - Renovations

2020-154.SMS

3635 173rd Street
Hammond, IN 46323



School City of Hammond


07.26.2021

2020-154.SMS

Vicinity Map



Thoroughfare Map

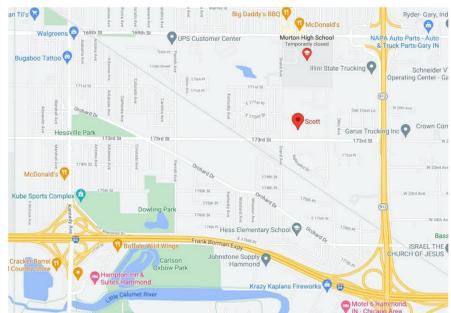

General Notes

Nothing set forth in these Drawings shall release any Contractor from responsibility to provide appropriate quantities, field measurements, dimensional stability, installation, anchorage and coordination with other trades, or waive the Contractor's responsibility to identify and resolve deviations from the requirements of the Contract Documents, or waive the Contractor's responsibility to alert the Architect to errors or omissions contained therein.

Each Contractor shall verify in the field all existing applicable conditions and dimensions shown on the Drawings and as pertinent to the intent of these Drawings. Any discrepancy discovered shall be brought to the attention of the Architect prior to the commencement of any Work affected by, or related to, such discrepancy.

Each Contractor shall be responsible for all costs associated with, or caused by failure to comply with requirement.


Each Contractor shall review in advance all portions of the Work to verify that the Work will not prohibit completion of the Project as intended in these Contract Documents. Any questions shall be promptly referred to the Architect for resolution.

Each Contractor shall refer to the Project Manual for cleaning and disposal requirements.

Each Contractor shall be responsible for the protection of all surfaces and finishes at interior and exterior of building. Damaged surfaces and finishes resulting from the performance of the Work shall be repaired at no cost to the Owner by the responsible Contractor to match existing to the satisfaction of the Owner.

Each Contractor shall coordinate respective cutting and patching Work with the other Prime Contractors.

Each Contractor shall become completely familiar with all aspects of the Work, even those areas designated to be provided by others. This familiarization includes full and complete understanding of the Work described on all Sheets of the Drawings and in all Sections of the Project Manual. Failure by the Contractor to become completely familiar and cognizant of all aspects of the Work shall not relieve the Contractor of the responsibility to provide materials, assemblies, or services indicated in the Contract Documents.

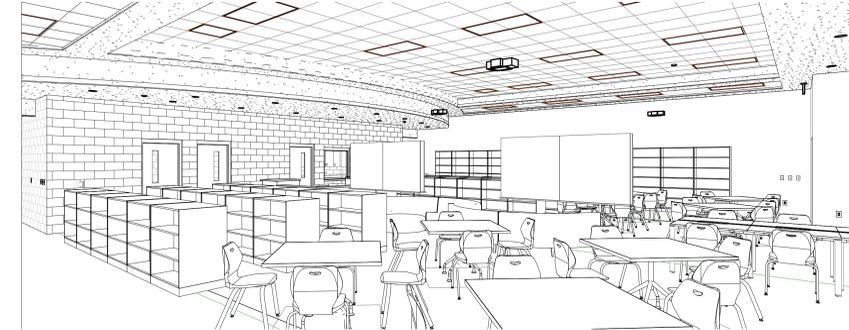

SHEET INDEX

Number	Sheet Name
1 - General	
C-01	Cover
G-001	COVER SHEET
S-002	FIRE AND LIFE SAFETY PLANS
G-003	EXISTING 1968 POOL DRAWINGS
G-004	EXISTING 1968 POOL DRAWINGS
2 - Site	
C-001	SITE GENERAL NOTES AND ABBREVIATIONS
1 OF 1	Survey
CD101	SITE DEMOLITION PLAN
CL101	SITE LAYOUT PLAN
CL501	SITE LAYOUT DETAILS
CS101	SITE GRADING PLAN
CU101	UTILITY PLAN
CU501	UTILITY DETAILS
3 - Structural	
S001	STRUCTURAL NOTES
S100	STRUCTURAL PLANS
S400	TYPICAL DETAILS & SECTIONS
4 - Architectural	
A-001	ARCHITECTURAL GENERAL NOTES AND ABBREVIATIONS
A-002	WALL TYPES
AD101	OVERALL FIRST FLOOR DEMOLITION PLAN
AD1A1	FIRST FLOOR DEMOLITION PLAN - UNIT A
AD1B1	FIRST FLOOR DEMOLITION PLAN - UNIT B
AD1C1	FIRST FLOOR DEMOLITION PLAN - UNIT C
AD1D1	FIRST FLOOR DEMOLITION PLAN - UNIT D
AD1E1	FIRST FLOOR DEMOLITION PLAN - UNIT E
ADR101	DEMOLITION ROOF PLAN
AD311	DEMO WALL SECTIONS AND DETAILS
AF101	OVERALL FIRST FLOOR PLAN
AF1A1	FIRST FLOOR PLAN - UNIT A
AF1B1	FIRST FLOOR PLAN - UNIT B
AF1C1	FIRST FLOOR PLAN - UNIT C
AF1D1	FIRST FLOOR PLAN - UNIT D
AF1E1	FIRST FLOOR PLAN - UNIT E
AC101	OVERALL FIRST FLOOR REFLECTED CEILING PLAN
AC1A1	FIRST FLOOR REFLECTED CEILING PLAN - UNIT A
AC1B1	FIRST FLOOR REFLECTED CEILING PLAN - UNIT B
AC1C1	FIRST FLOOR REFLECTED CEILING PLAN - UNIT C
AC1D1	FIRST FLOOR REFLECTED CEILING PLAN - UNIT D
AC1E1	FIRST FLOOR REFLECTED CEILING PLAN - UNIT E
AR101	ROOF PLAN
A-320	WALL SECTION DETAILS
A-420	TEMPORARY CLASSROOM PLAN
A-480	ENLARGED PLANS
A-600	DOOR & FRAME SCHEDULE
5 - Interiors	
IN1A1	FIRST FLOOR INTERIOR FINISH PLAN - UNIT A
IN1B1	FIRST FLOOR INTERIOR FINISH PLAN - UNIT B
IN1C1	FIRST FLOOR INTERIOR FINISH PLAN - UNIT C
IN1D1	FIRST FLOOR INTERIOR FINISH PLAN - UNIT D
IN1E1	FIRST FLOOR INTERIOR FINISH PLAN - UNIT E
I-201	INTERIOR ELEVATIONS
I-601	INTERIOR FINISH LEGEND

SHEET INDEX


Number	Sheet Name
7 - Mechanical	
M-001	MECHANICAL SYMBOLS AND ABBREVIATIONS
MD1A1	FIRST FLOOR DEMOLITION PLAN - UNIT A
MD1B1	FIRST FLOOR DEMOLITION PLAN - UNIT B
MD1C1	FIRST FLOOR DEMOLITION PLAN - UNIT C
MD1D1	FIRST FLOOR DEMOLITION PLAN - UNIT D
MD1E1	FIRST FLOOR DEMOLITION PLAN - UNIT E
MD101	ROOF DEMOLITION PLAN - UNIT C
MD102	ROOF DEMOLITION PLAN - UNIT D
MH1A1	FIRST FLOOR HVAC PLAN - UNIT A
MH1B1	FIRST FLOOR HVAC PLAN - UNIT B
MH1C1	FIRST FLOOR HVAC PLAN - UNIT C
MH1D1	FIRST FLOOR HVAC PLAN - UNIT D
MR101	ROOF HVAC PLAN - UNIT A
MR102	ROOF HVAC PLAN - UNIT B
MR103	ROOF HVAC PLAN - UNIT C
MR104	ROOF HVAC PLAN - UNIT D
M-420	HVAC TEMPORARY CLASSROOM WORK - UNIT D
M-504	MECHANICAL DETAILS
M-601	MECHANICAL SCHEDULES
M-701	TEMPERATURE CONTROLS SCHEMATICS
M-702	TEMPERATURE CONTROLS SCHEMATICS
8 - Plumbing	
P-001	PLUMBING SYMBOLS AND ABBREVIATIONS
PD101	DEMOLITION FIRST FLOOR PLUMBING PLAN - UNIT B
PD1C1	DEMOLITION FIRST FLOOR PLUMBING PLAN - UNIT C
PD1D1	DEMOLITION FIRST FLOOR PLUMBING PLAN - UNIT D
PF1A1	FOUNDATION PLUMBING PLAN - UNIT A
PF1B1	FOUNDATION PLUMBING PLAN - UNIT B
PF1C1	FOUNDATION PLUMBING PLAN - UNIT C
PF1D1	FOUNDATION PLUMBING PLAN - UNIT D
PP1C1	FIRST FLOOR PLUMBING PLAN - UNIT C
PP1D1	FIRST FLOOR PLUMBING PLAN - UNIT D
P-601	PLUMBING DETAILS AND SCHEDULES
P-601	DOMESTIC WATER ISOMETRIC - UNIT A
P-902	WASTE AND VENT ISOMETRIC - UNIT A
P-903	PLUMBING ISOMETRICS - UNIT B
P-904	PLUMBING ISOMETRICS - UNITS C AND D
9 - Electrical	
E-001	SYMBOLS & ABBREVIATIONS
ES101	SITE PLAN
ED1A1	FIRST FLOOR DEMOLITION PLAN - UNIT A
ED1B1	FIRST FLOOR DEMOLITION PLAN - UNIT B
ED1C1	FIRST FLOOR DEMOLITION PLAN - UNIT C
ED1D1	FIRST FLOOR DEMOLITION PLAN - UNIT D
EL1A1	FIRST FLOOR LIGHTING PLAN - UNIT A
EL1B1	FIRST FLOOR LIGHTING PLAN - UNIT B
EL1C1	FIRST FLOOR LIGHTING PLAN - UNIT C
EL1D1	FIRST FLOOR LIGHTING PLAN - UNIT D
EL1E1	FIRST FLOOR LIGHTING PLAN - UNIT E
EP101	OVERALL FIRST FLOOR POWER PLAN
EP1A1	FIRST FLOOR POWER PLAN - UNIT A
EP1B1	FIRST FLOOR POWER PLAN - UNIT B
EP1C1	FIRST FLOOR POWER PLAN - UNIT C
EP1D1	FIRST FLOOR POWER PLAN - UNIT D
EP1E1	FIRST FLOOR POWER PLAN - UNIT E
ER1A1	ROOF PLAN - UNIT A
ER1B1	ROOF PLAN - UNIT B
ER1C1	ROOF PLAN - UNIT C
ER1D1	ROOF PLAN - UNIT D
ER1E1	ROOF PLAN - UNIT E
E-420	PARTIAL FIRST FLOOR UNIT D PLANS
E-504	DETAILS
E-601	SCHEMATICS
E-602	LIGHTING SCHEDULES
E-603	EQUIPMENT SCHEDULES
E-604	PANELBOARD SCHEDULES
10 - Telecommunications	
T-001	TELECOMMUNICATIONS SYMBOLS AND ABBREVIATIONS
T-420	TEMPORARY CLASSROOMS TELECOMMUNICATIONS PLAN - UNIT D
TF1A1	FIRST FLOOR TELECOMMUNICATIONS PLAN - UNIT A
TF1B1	FIRST FLOOR TELECOMMUNICATIONS PLAN - UNIT B
TF1C1	FIRST FLOOR TELECOMMUNICATIONS PLAN - UNIT C
TF1D1	FIRST FLOOR TELECOMMUNICATIONS PLAN - UNIT D
TF1E1	FIRST FLOOR TELECOMMUNICATIONS PLAN - UNIT E
T-501	TELECOMMUNICATIONS DETAILS
T-502	TELECOMMUNICATIONS DETAILS



SCHMIDT ASSOCIATES
415 Massachusetts Avenue
Indianapolis, IN 46204
www.schmidt-arch.com




School City of Hammond
Scott Middle School - Renovations

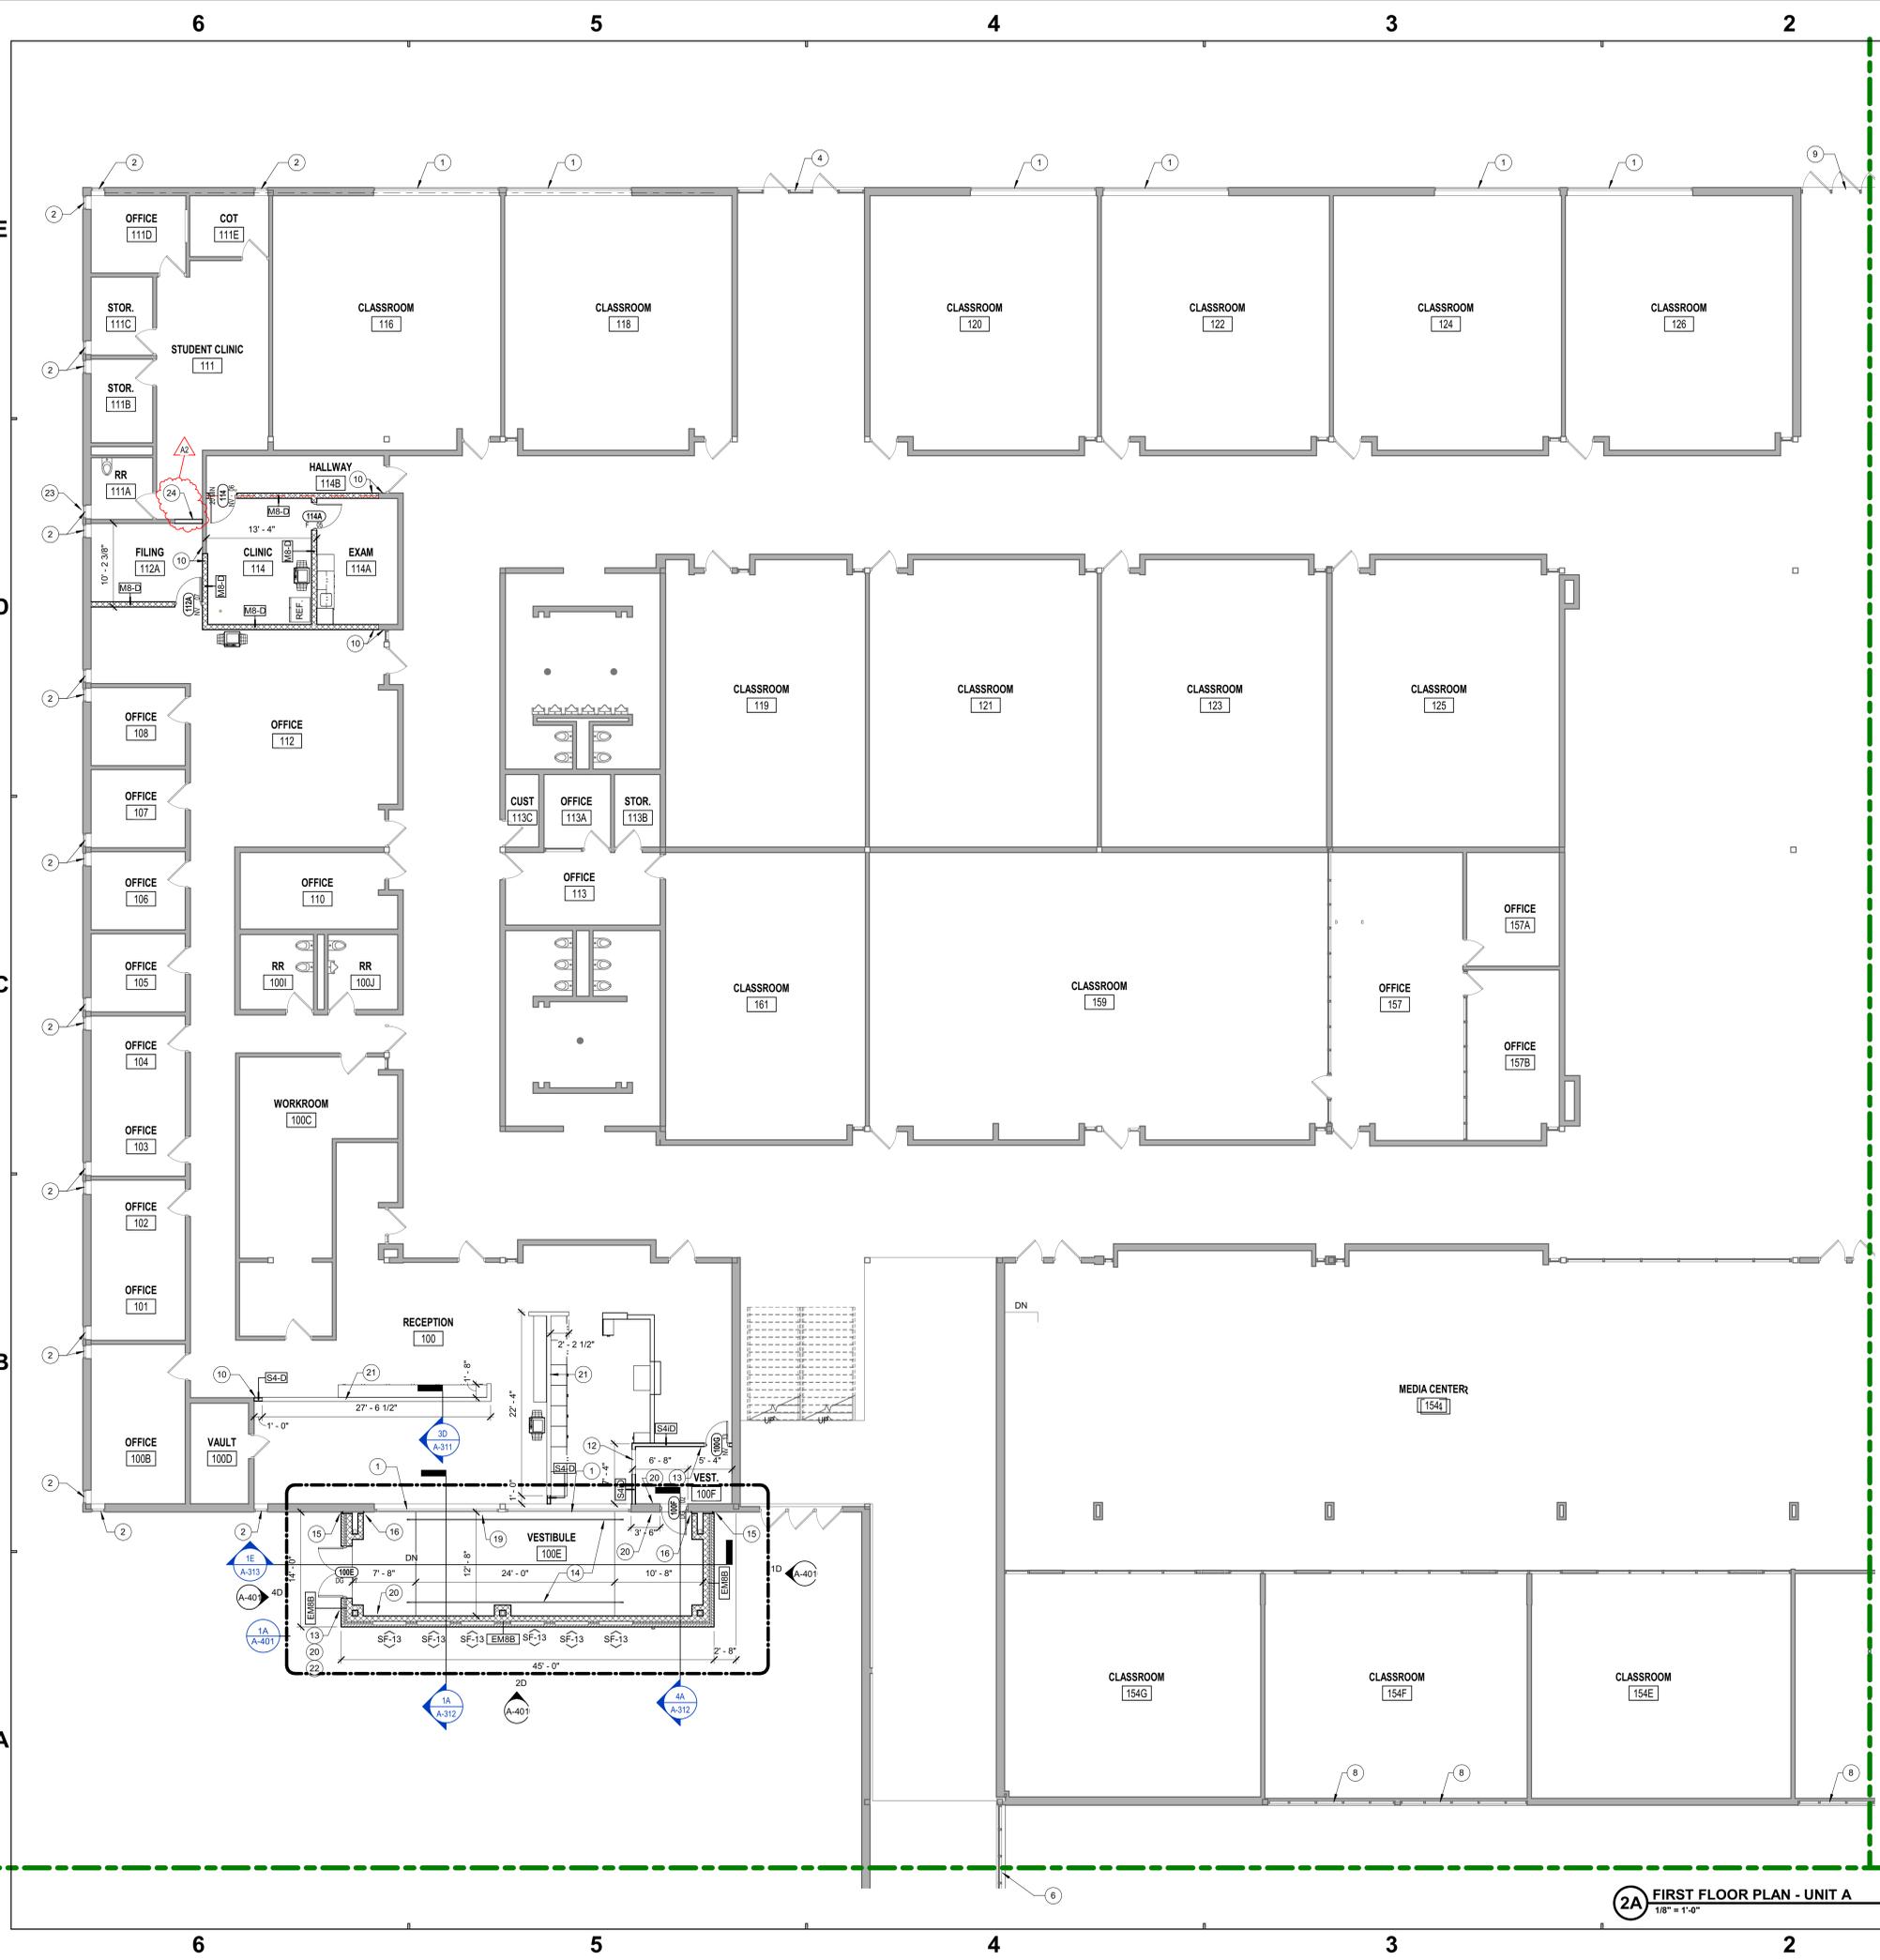



#	Note
1	EXISTING STEEL TEE FRAME CURTAIN WALL 'XCW-01'. SEE EXISTING WINDOW FRAME ELEVATIONS 1A/A-600. PROVIDE ALUMINUM STOREFRONT WINDOW 'SF-01'. SEE STOREFRONT WINDOW FRAME ELEVATIONS 1B/A-600. REFERENCE SPEC SECTION 084113 - ALUMINUM-FRAMED ENTRANCES AND STOREFRONTS AND 088000 - GLAZING.
2	EXISTING STEEL TEE FRAME CURTAIN WALL 'XCW-02'. SEE EXISTING WINDOW FRAME ELEVATIONS 1A/A-600. PROVIDE ALUMINUM STOREFRONT WINDOW 'SF-02'. SEE STOREFRONT WINDOW FRAME ELEVATIONS 1B/A-600. REFERENCE SPEC SECTION 084113 - ALUMINUM-FRAMED ENTRANCES AND STOREFRONTS AND 088000 - GLAZING.
3	EXISTING STEEL TEE FRAME CURTAIN WALL 'XCW-03'. SEE EXISTING WINDOW FRAME ELEVATIONS 1A/A-600. PROVIDE ALUMINUM STOREFRONT WINDOW 'SF-03'. SEE STOREFRONT WINDOW FRAME ELEVATIONS 1B/A-600. REFERENCE SPEC SECTION 084113 - ALUMINUM-FRAMED ENTRANCES AND STOREFRONTS AND 088000 - GLAZING.
4	EXISTING STEEL TUBE FRAME CURTAIN WALL 'XCW-04'. SEE EXISTING WINDOW FRAME ELEVATIONS 1A/A-600. PROVIDE ALUMINUM STOREFRONT WINDOW 'SF-04', 'SF-05', 'SF-06' AND 'SF-07'. SEE STOREFRONT WINDOW FRAME ELEVATIONS 1B/A-600. REFERENCE SPEC SECTION 084113 - ALUMINUM-FRAMED ENTRANCES AND STOREFRONTS AND 088000 - GLAZING.
5	EXISTING STEEL TUBE FRAME CURTAIN WALL 'XCW-05'. SEE EXISTING WINDOW FRAME ELEVATIONS 1A/A-600. PROVIDE ALUMINUM STOREFRONT WINDOW 'SF-09' AND 'SF-10'. SEE STOREFRONT WINDOW FRAME ELEVATIONS 1B/A-600. REFERENCE SPEC SECTION 084113 - ALUMINUM-FRAMED ENTRANCES AND STOREFRONTS AND 088000 - GLAZING.
6	EXISTING STEEL TUBE FRAME CURTAIN WALL 'XCW-06'. SEE EXISTING WINDOW FRAME ELEVATIONS 1A/A-600. PROVIDE ALUMINUM STOREFRONT WINDOW 'SF-11' AND 'SF-12'. SEE STOREFRONT WINDOW FRAME ELEVATIONS 1B/A-600. REFERENCE SPEC SECTION 084113 - ALUMINUM-FRAMED ENTRANCES AND STOREFRONTS AND 088000 - GLAZING.
7	EXISTING STEEL TUBE FRAME CURTAIN WALL 'XCW-07'. SEE EXISTING WINDOW FRAME ELEVATIONS 1A/A-600. PROVIDE ALUMINUM STOREFRONT WINDOW 'SF-11' AND 'SF-12'. SEE STOREFRONT WINDOW FRAME ELEVATIONS 1B/A-600. REFERENCE SPEC SECTION 084113 - ALUMINUM-FRAMED ENTRANCES AND STOREFRONTS AND 088000 - GLAZING.
8	EXISTING STEEL TUBE FRAME CURTAIN WALL 'XCW-08'. SEE EXISTING WINDOW FRAME ELEVATIONS 1A/A-600. PROVIDE ALUMINUM STOREFRONT WINDOW 'SF-14' AND 'SF-15'. SEE STOREFRONT WINDOW FRAME ELEVATIONS 1B/A-600. REFERENCE SPEC SECTION 084113 - ALUMINUM-FRAMED ENTRANCES AND STOREFRONTS AND 088000 - GLAZING.
9	EXISTING STEEL TUBE FRAME CURTAIN WALL 'XCW-09'. SEE EXISTING WINDOW FRAME ELEVATIONS 1A/A-600. PROVIDE ALUMINUM STOREFRONT WINDOW 'SF-16'. SEE STOREFRONT WINDOW FRAME ELEVATIONS 1B/A-600. REFERENCE SPEC SECTION 084113 - ALUMINUM-FRAMED ENTRANCES AND STOREFRONTS AND 088000 - GLAZING.
10	ALIGN FACE OF NEW WALL WITH FACE OF EXISTING WALL FACE.
11	NEW FLOOR SLAB. SEE S-SERIES DWGS.
12	088653 - SECURITY TRANSACTION WINDOW, T1. REFERENCE WINDOW ELEVATION ON SHEET A-600.
13	ACCESS CONTROL CARD READER. REFERENCE T-SERIES DWGS.
14	055213 - METAL PIPE HANDRAIL. SEE RAILING ELEVATION 1D/A-313.
15	079500 - EXTERIOR EXPANSION CONTROL JOINT SYSTEM, 2 INCH.
16	079500 - INTERIOR WALL-TO-WALL CORNER EXPANSION JOINT COVER SYSTEM.
17	096486 - WOOD ATHLETIC FLOORING SYSTEM. REFERENCE I-SERIES DWGS FOR COURT STRIPING LOCATION AND COLORS.
18	EXISTING TELESCOPING BLEACHER SYSTEM. REINSTALL BLEACHERS TO THEIR ORIGINAL LOCATION PER BLEACHER MANUFACTURER'S MOUNTING RECOMMENDATIONS.
19	CLEAN EXISTING EXPOSED WALL AND LIMESTONE PANEL.
20	ADA OPERATOR. SEE T-SERIES DWGS.
21	METAL STUD AND GWB HALF WALL. SEE WALL SECTION 3D/A-311.
22	APHONE. SEE T-SERIES DWGS.
23	088000 - PROVIDE PRIVACY-FROSTED GLASS IN RESTROOM WINDOWS. TYPICAL.
24	INFILL OPENING WITH WALL CONSTRUCTION TO MATCH SURROUNDING ADJACENT WALL CONSTRUCTION. VERIFY EXISTING WALL CONDITIONS/CONSTRUCTION AND DIMENSIONS IN THE FIELD. ALIGN THE FACE OF THE NEW INFILL WALL WITH THE ADJACENT EXISTING WALL FACE.



Project No. 2020-153.MHS
 Project Date 07.26.2021
 Produced TYN

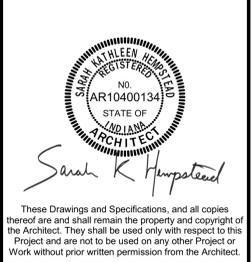

#	Revision	Date
A2	Addendum #2	8/18/2021

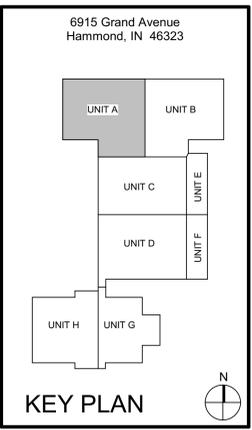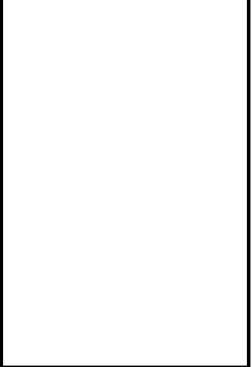

School City of Hammond

 Morton High School - Renovations and Addition

FIRST FLOOR PLAN - UNIT A
 AF1A1

2A FIRST FLOOR PLAN - UNIT A
 1/8" = 1'-0"

6 5 4 3 2 1

GENERAL HVAC NOTES

A. REFER TO MODEL (UNIT A) AND MODEL (UNIT B) FOR EXISTING CONDITIONS.

B. DIFFUSER COUNT TO BE DETERMINED BY NUMBER OF TAPS SERVING EACH ROOM. ONE TAP PER DIFFUSER. CURRENT DIFFUSER COUNT IS BASED ON EXISTING DRAWINGS REFERENCED ON M-002 AND M-003. FIELD VERIFY TO ESTABLISH CORRECT COUNT.

MECHANICAL HVAC PLAN NOTES

NOTE

1. CONNECT SUPPLY GRILLE TO EXISTING 5" FLEX DUCTWORK.

2. CONNECT RETURN GRILLE TO EXISTING DUCTWORK. EXTEND EXISTING DUCTWORK AS NEEDED TO MISS NEW CONSTRUCTION.

3. ADD BMS SPACE TEMPERATURE MONITORING, ALARM TO BE ENERGIZED IF THE SPACE TEMPERATURE FALLS BELOW 45°F OR RISES ABOVE 85°F.

4. CONNECT RETURN GRILLE TO EXISTING DUCTWORK.


5. CONNECT EXHAUST GRILLE TO EXISTING DUCTWORK.



Project No. 2020-15.MHS
 Project Date 07.26.2021
 Produced CSM / CSM



#	Revision	Date
A2	ADDENDUM #2	8/18/2021

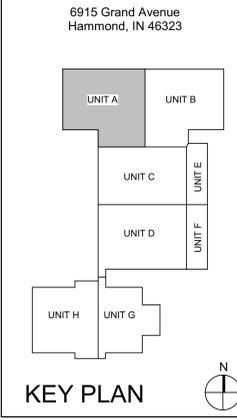

School City of Hammond

A Morton High School - Renovations and Addition

FIRST FLOOR HVAC PLAN - UNIT A

MH1A1



1 FIRST FLOOR - HVAC PLAN - UNIT A
 1/8" = 1'-0"

6 5 4 3 2 1

E
D
C
B
A

2021.08.10 10:28 AM C:\Users\jhammond\OneDrive\Documents\Projects\2020-15.MHS\Drawings\101-MH1A1-01-10.dwg
 2021.08.10 10:28 AM C:\Users\jhammond\OneDrive\Documents\Projects\2020-15.MHS\Drawings\101-MH1A1-01-10.dwg
 2021.08.10 10:28 AM C:\Users\jhammond\OneDrive\Documents\Projects\2020-15.MHS\Drawings\101-MH1A1-01-10.dwg

6 5 4 3 2 1

GENERAL HVAC NOTES

A. REFER TO M-002 (UNIT A) AND M-003 (UNIT B) FOR EXISTING CONDITIONS.

B. DIFFUSER COUNT TO BE DETERMINED BY NUMBER OF TAPS SERVING EACH ROOM, ONE TAP PER DIFFUSER. CURRENT DIFFUSER COUNT IS BASED ON EXISTING DRAWINGS REFERENCED ON M-002 AND M-003. FIELD VERIFY TO ESTABLISH CORRECT COUNT.

MECHANICAL HVAC PLAN NOTES

NOTE

1. CONNECT SUPPLY GRILLE TO EXISTING 5" FLEX DUCTWORK.

2. CONNECT RETURN GRILLE TO EXISTING DUCTWORK. EXTEND EXISTING DUCTWORK AS NEEDED TO MISS NEW CONSTRUCTION.

3. ADD BMS SPACE TEMPERATURE MONITORING, ALARM TO BE ENERGIZED IF THE SPACE TEMPERATURE FALLS BELOW 45°F OR RISES ABOVE 85°F.

4. CONNECT RETURN GRILLE TO EXISTING DUCTWORK.

5. CONNECT EXHAUST GRILLE TO EXISTING DUCTWORK.




Project No. 2020-15.MHS
 Project Date 07.26.2021
 Produced CSM / CSM



These Drawings and Specifications, and all copies thereof are and shall remain the property and copyright of the Architect. They shall be used only with respect to this Project and are not to be used on any other Project or Work without prior written permission from the Architect.

#	Revision	Date
A2	ADDENDUM #2	8/18/2021

6915 Grand Avenue
 Hammond, IN 46323

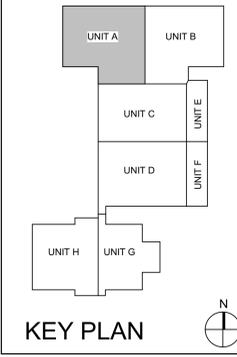


School City of Hammond



Morton High School - Renovations an Addition

SECOND FLOOR HVAC PLAN - UNIT A

MH2A1

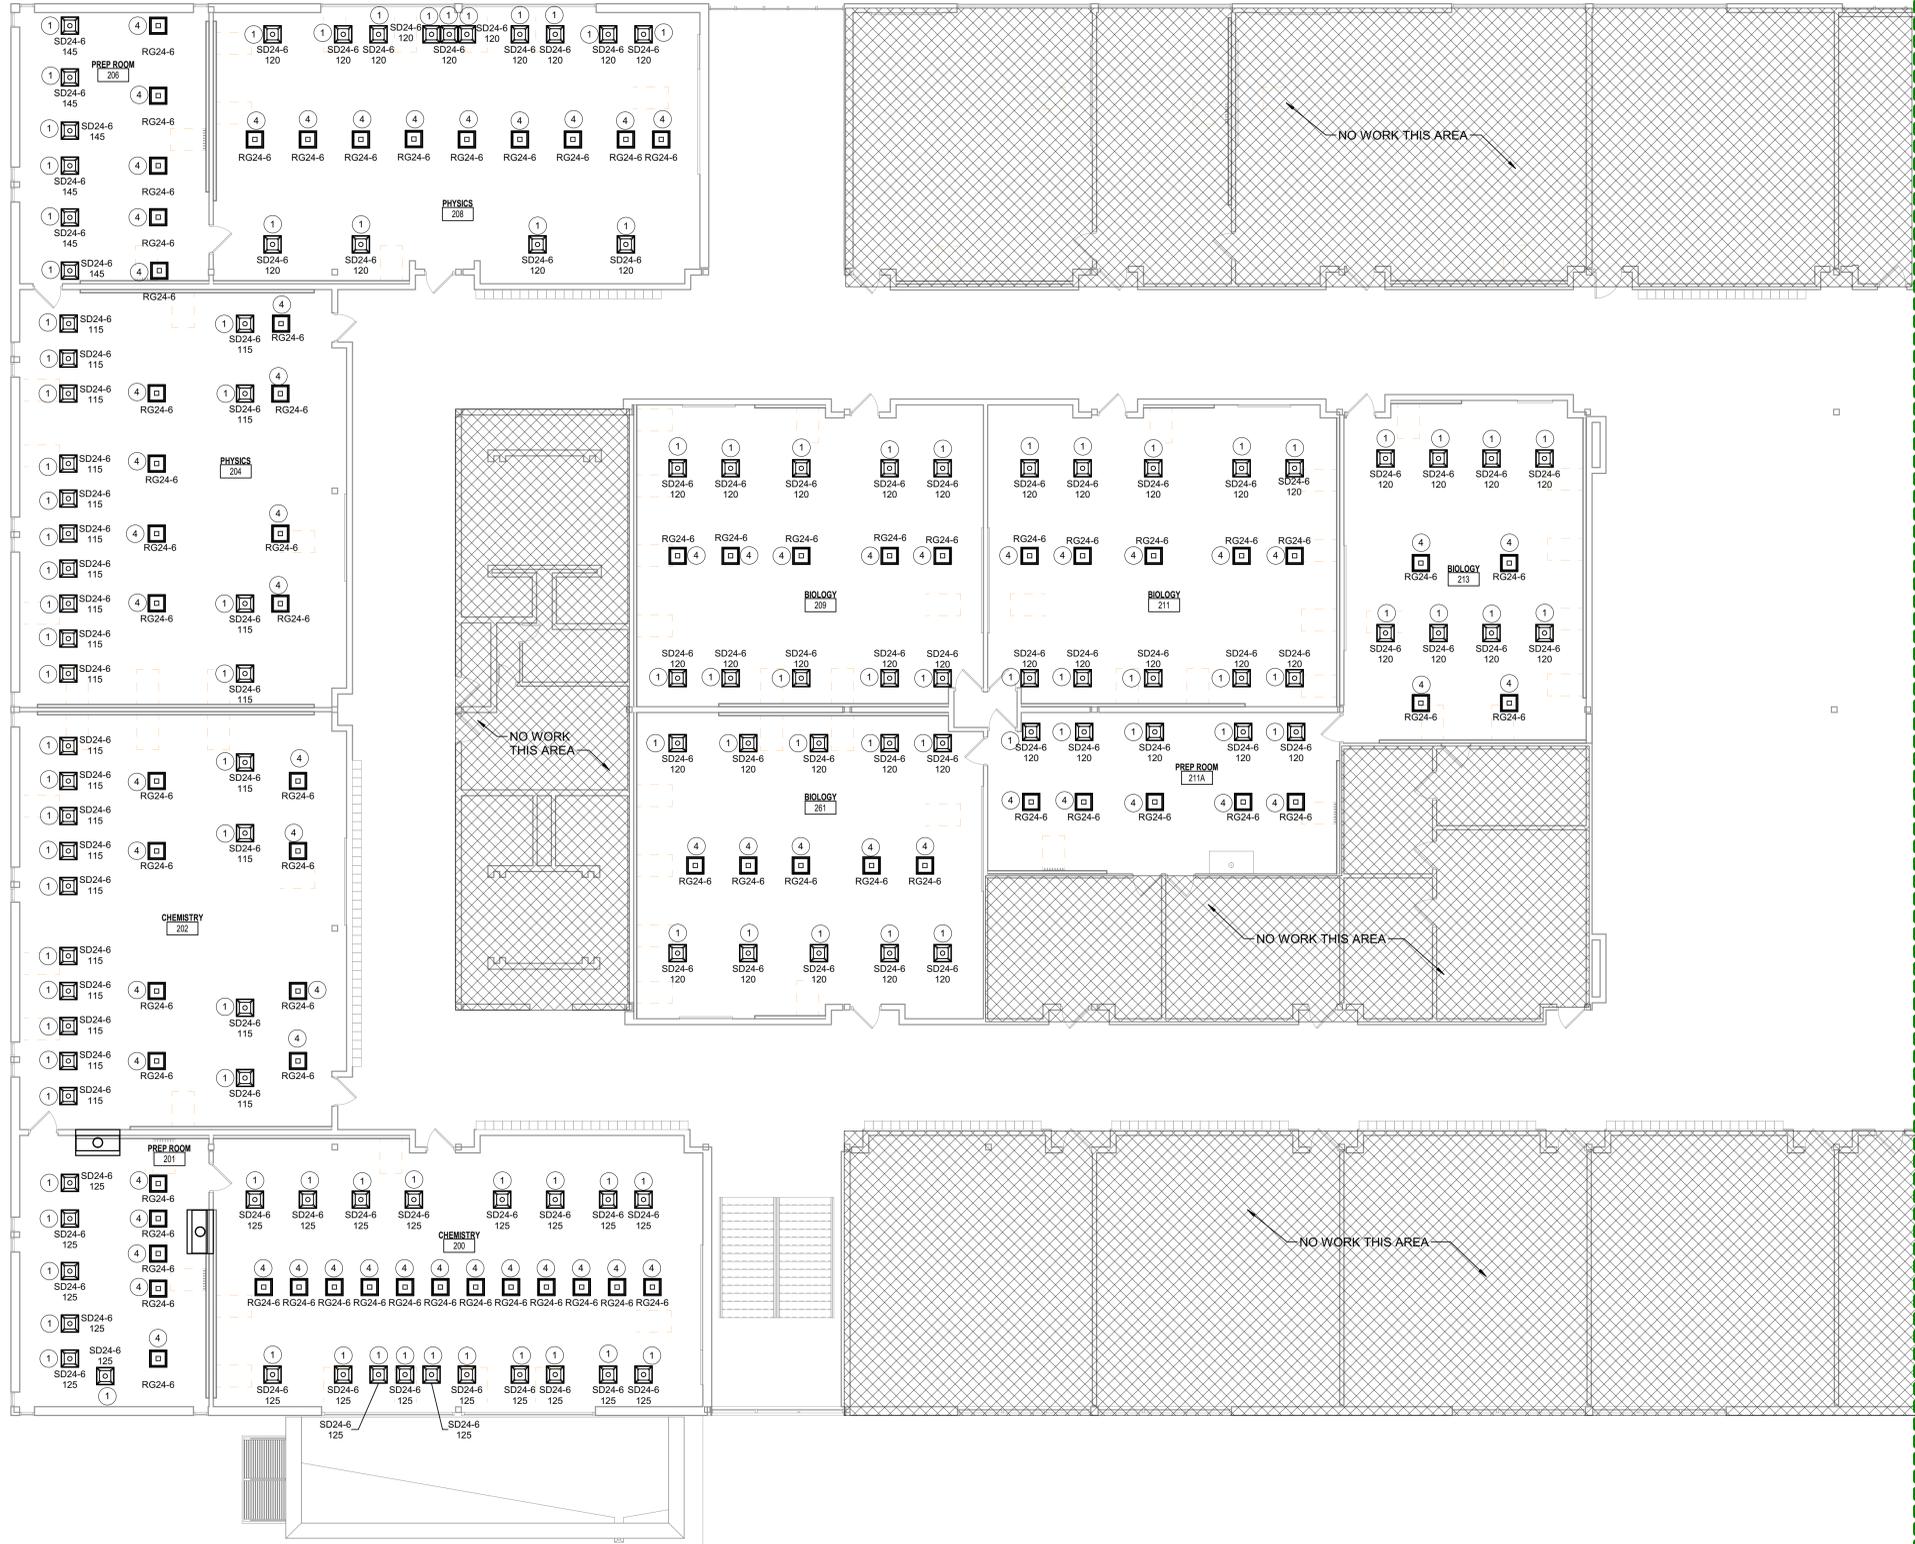

1 SECOND FLOOR - HVAC PLAN - UNIT A
 1/8" = 1'-0"

6 5 4 3 2 1

E
D
C
B
A

E
D
C
B
A

2020-15.MHS - Morton High School - Renovations and Addition - Unit A
 2021-08-18 - Second Floor HVAC Plan - Unit A
 1/8" = 1'-0"



GENERAL LIGHTING NOTES	
#	NOTES
A	REFER TO SHEET E-001 FOR ADDITIONAL INFORMATION.

LIGHTING PLAN NOTES	
#	NOTES
1	PROVIDE LOCKABLE HOFFMAN BOX TO COVER EXISTING LIGHTING CONTROL. ROUGH OPENING. LOCATE GYMNASIUM LIGHTING CONTROLS INSIDE HOFFMAN BOX. VERIFY HOFFMAN BOX DIMENSIONS IN FIELD. EXTEND EXISTING LIGHTING CONTROLS CONTROLLING EXISTING TO REMAIN GYMNASIUM LIGHT FIXTURES INTO NEW HOFFMAN BOX.
2	CONNECT LIGHT FIXTURES TO EXISTING LIGHTING CIRCUIT SERVING THIS ROOM COMPLETE.
3	CONNECT LIGHT FIXTURE TO EXISTING LIGHTING CIRCUIT SERVING EXTERIOR BUILDING MOUNTED LIGHTING. SWITCH LIGHT FIXTURE FROM EXISTING CONTROLS SERVING EXISTING BUILDING MOUNTED LIGHTING.
4	CONNECT LIGHT FIXTURES TO EXISTING LIGHTING CIRCUIT SERVING ADMINISTRATION AREA. CONNECT COMPLETE.
5	CONNECT GYMNASIUM COURT LIGHT FIXTURES TO EXISTING LIGHTING CIRCUIT SERVING GYMNASIUM COURT AREA. CONNECT COMPLETE.


SCHMIDT ASSOCIATES
415 Massachusetts Avenue
Indianapolis, IN 46204
www.schmidt-arch.com

Project No. 2020-153.MHS
Project Date 07.26.2021
Produced JH GL

Sarah K. Hempstead

These Drawings and Specifications, and all copies thereof are and shall remain the property and copyright of the Architect. They shall be used only with respect to this Project and are not to be used on any other Project or Work without prior written permission from the Architect.

#	Revision	Date
A2	Addendum 2	08.18.2021

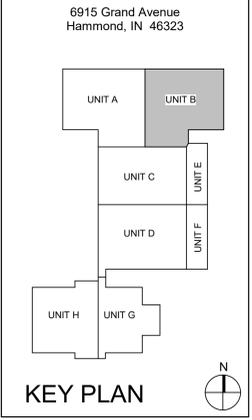


School City of Hammond

A Morton High School - Renovations and Addition

FIRST FLOOR LIGHTING PLAN - UNIT B
EL1B1

2A FIRST FLOOR LIGHTING PLAN - UNIT B
1/8" = 1'-0"

EL1B1 - FIRST FLOOR LIGHTING PLAN - UNIT B
2020-153.MHS - Morton High School - Renovations and Addition
Project No. 2020-153.MHS
Project Date 07.26.2021
Produced JH GL

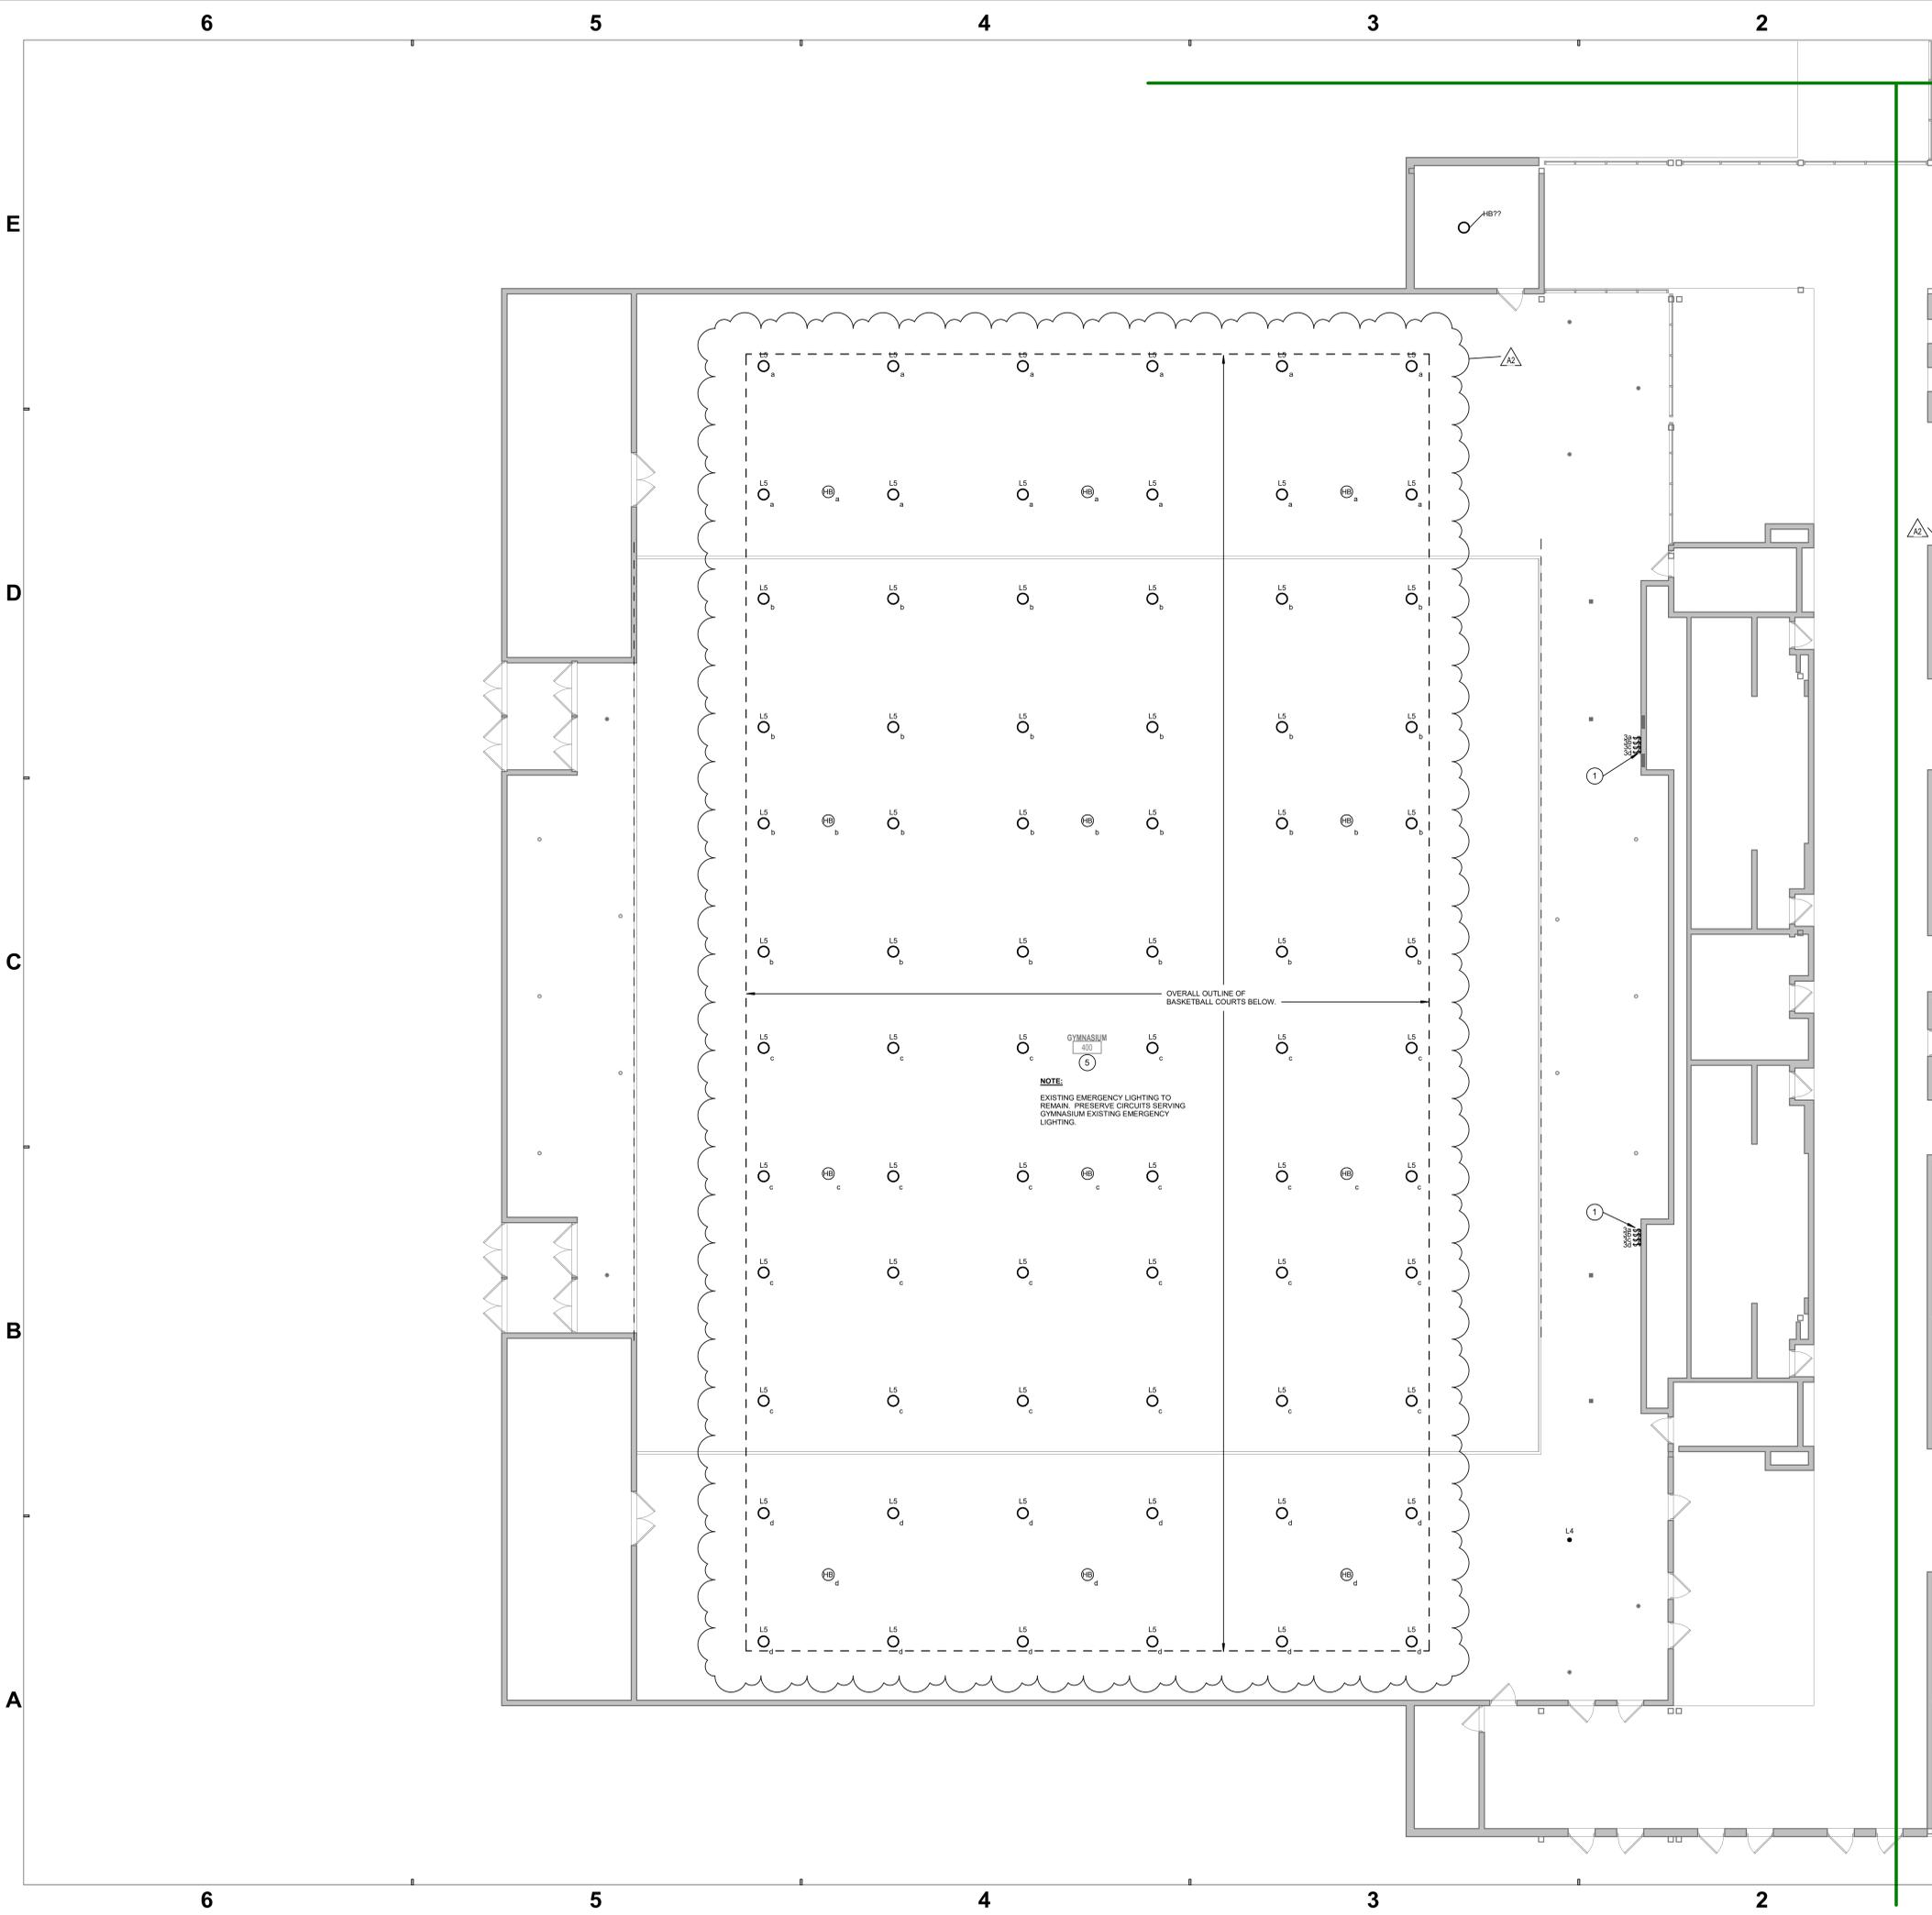

GENERAL LIGHTING NOTES	
#	NOTES
A	REFER TO SHEET E-001 FOR ADDITIONAL INFORMATION.


LIGHTING PLAN NOTES	
#	NOTES
1	PROVIDE LOCKABLE HOFFMAN BOX TO COVER EXISTING LIGHTING CONTROL ROUGH OPENING. LOCATE GYMNASIUM LIGHTING CONTROLS INSIDE HOFFMAN BOX. VERIFY HOFFMAN BOX DIMENSIONS IN FIELD. EXTEND EXISTING LIGHTING CONTROLS CONTROLLING EXISTING TO REMAIN GYMNASIUM LIGHT FIXTURES INTO NEW HOFFMAN BOX.
2	CONNECT LIGHT FIXTURES TO EXISTING LIGHTING CIRCUIT SERVING THIS ROOM COMPLETE.
3	CONNECT LIGHT FIXTURE TO EXISTING LIGHTING CIRCUIT SERVING EXTERIOR BUILDING MOUNTED LIGHTING. SWITCH LIGHT FIXTURE FROM EXISTING CONTROLS SERVING EXISTING BUILDING MOUNTED LIGHTING.
4	CONNECT LIGHT FIXTURES TO EXISTING LIGHTING CIRCUIT SERVING ADMINISTRATIVE AREA. CONNECT COMPLETE.
5	CONNECT GYMNASIUM COURT LIGHT FIXTURES TO EXISTING LIGHTING CIRCUIT SERVING GYMNASIUM COURT AREA. CONNECT COMPLETE.

SCHMIDT ASSOCIATES
415 Massachusetts Avenue
Indianapolis, IN 46204
www.schmidt-arch.com

Project No. 2020-153.MHS
Project Date 07.26.2021
Produced JH GL

These Drawings and Specifications, and all copies thereof are and shall remain the property and copyright of the Architect. They shall be used only with respect to this Project and are not to be used on any other Project or Work without prior written permission from the Architect.

#	Revision	Date
A2	Addendum 2	08.18.2021

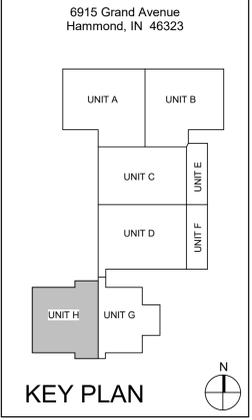

School City of Hammond

SCH
School City of Hammond

A Morton High School - Renovations and Addition

FIRST FLOOR LIGHTING PLAN - UNIT H

EL1H1

2A FIRST FLOOR LIGHTING PLAN - UNIT H
1/8" = 1'-0"

EL1H1 - FIRST FLOOR LIGHTING PLAN - UNIT H
2020-153.MHS - Morton High School - Renovations and Addition
Project No. 2020-153.MHS
Project Date 07.26.2021
Produced JH GL



GENERAL LIGHTING NOTES	
#	NOTES
A	REFER TO SHEET E-001 FOR ADDITIONAL INFORMATION.

LIGHTING PLAN NOTES	
#	NOTES
1	PROVIDE LOCKABLE HOFFMAN BOX TO COVER EXISTING LIGHTING CONTROL ROUGH OPENING. LOCATE GYMNASIUM LIGHTING CONTROLS INSIDE HOFFMAN BOX. VERIFY HOFFMAN BOX DIMENSIONS IN FIELD. EXTEND EXISTING LIGHTING CONTROLS CONTROLLING EXISTING TO REMAIN GYMNASIUM LIGHT FIXTURES INTO NEW HOFFMAN BOX.
2	CONNECT LIGHT FIXTURES TO EXISTING LIGHTING CIRCUIT SERVING THIS ROOM COMPLETE.
3	CONNECT LIGHT FIXTURE TO EXISTING LIGHTING CIRCUIT SERVING EXTERIOR BUILDING MOUNTED LIGHTING. SWITCH LIGHT FIXTURE FROM EXISTING CONTROLS SERVING EXISTING BUILDING MOUNTED LIGHTING.
4	CONNECT LIGHT FIXTURES TO EXISTING LIGHTING CIRCUIT SERVING ADMINISTRATION AREA. CONNECT COMPLETE.
5	CONNECT GYMNASIUM COURT LIGHT FIXTURES TO EXISTING LIGHTING CIRCUIT SERVING GYMNASIUM COURT AREA. CONNECT COMPLETE.


SCHMIDT ASSOCIATES
415 Massachusetts Avenue
Indianapolis, IN 46204
www.schmidt-arch.com

Project No. 2020-153.MHS
Project Date 07.26.2021
Produced JH GL

Sarah K. Hempstead

These Drawings and Specifications, and all copies thereof are and shall remain the property and copyright of the Architect. They shall be used only with respect to this Project and are not to be used on any other Project or Work without prior written permission from the Architect.

#	Revision	Date
A1	Addendum 1	08.11.2021
A2	Addendum 2	08.18.2021

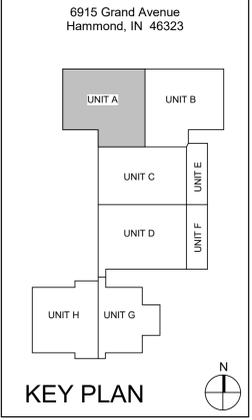

School City of Hammond


School City of Hammond

A Morton High School - Renovations and Addition

SECOND FLOOR LIGHTING PLAN - UNIT A
EL1A2

2A SECOND FLOOR LIGHTING PLAN - UNIT A
1/8" = 1'-0"

NO. 2020-153.MHS UNIT A
20210818 School City of Hammond
20210818 School City of Hammond
20210818 School City of Hammond
20210818 School City of Hammond

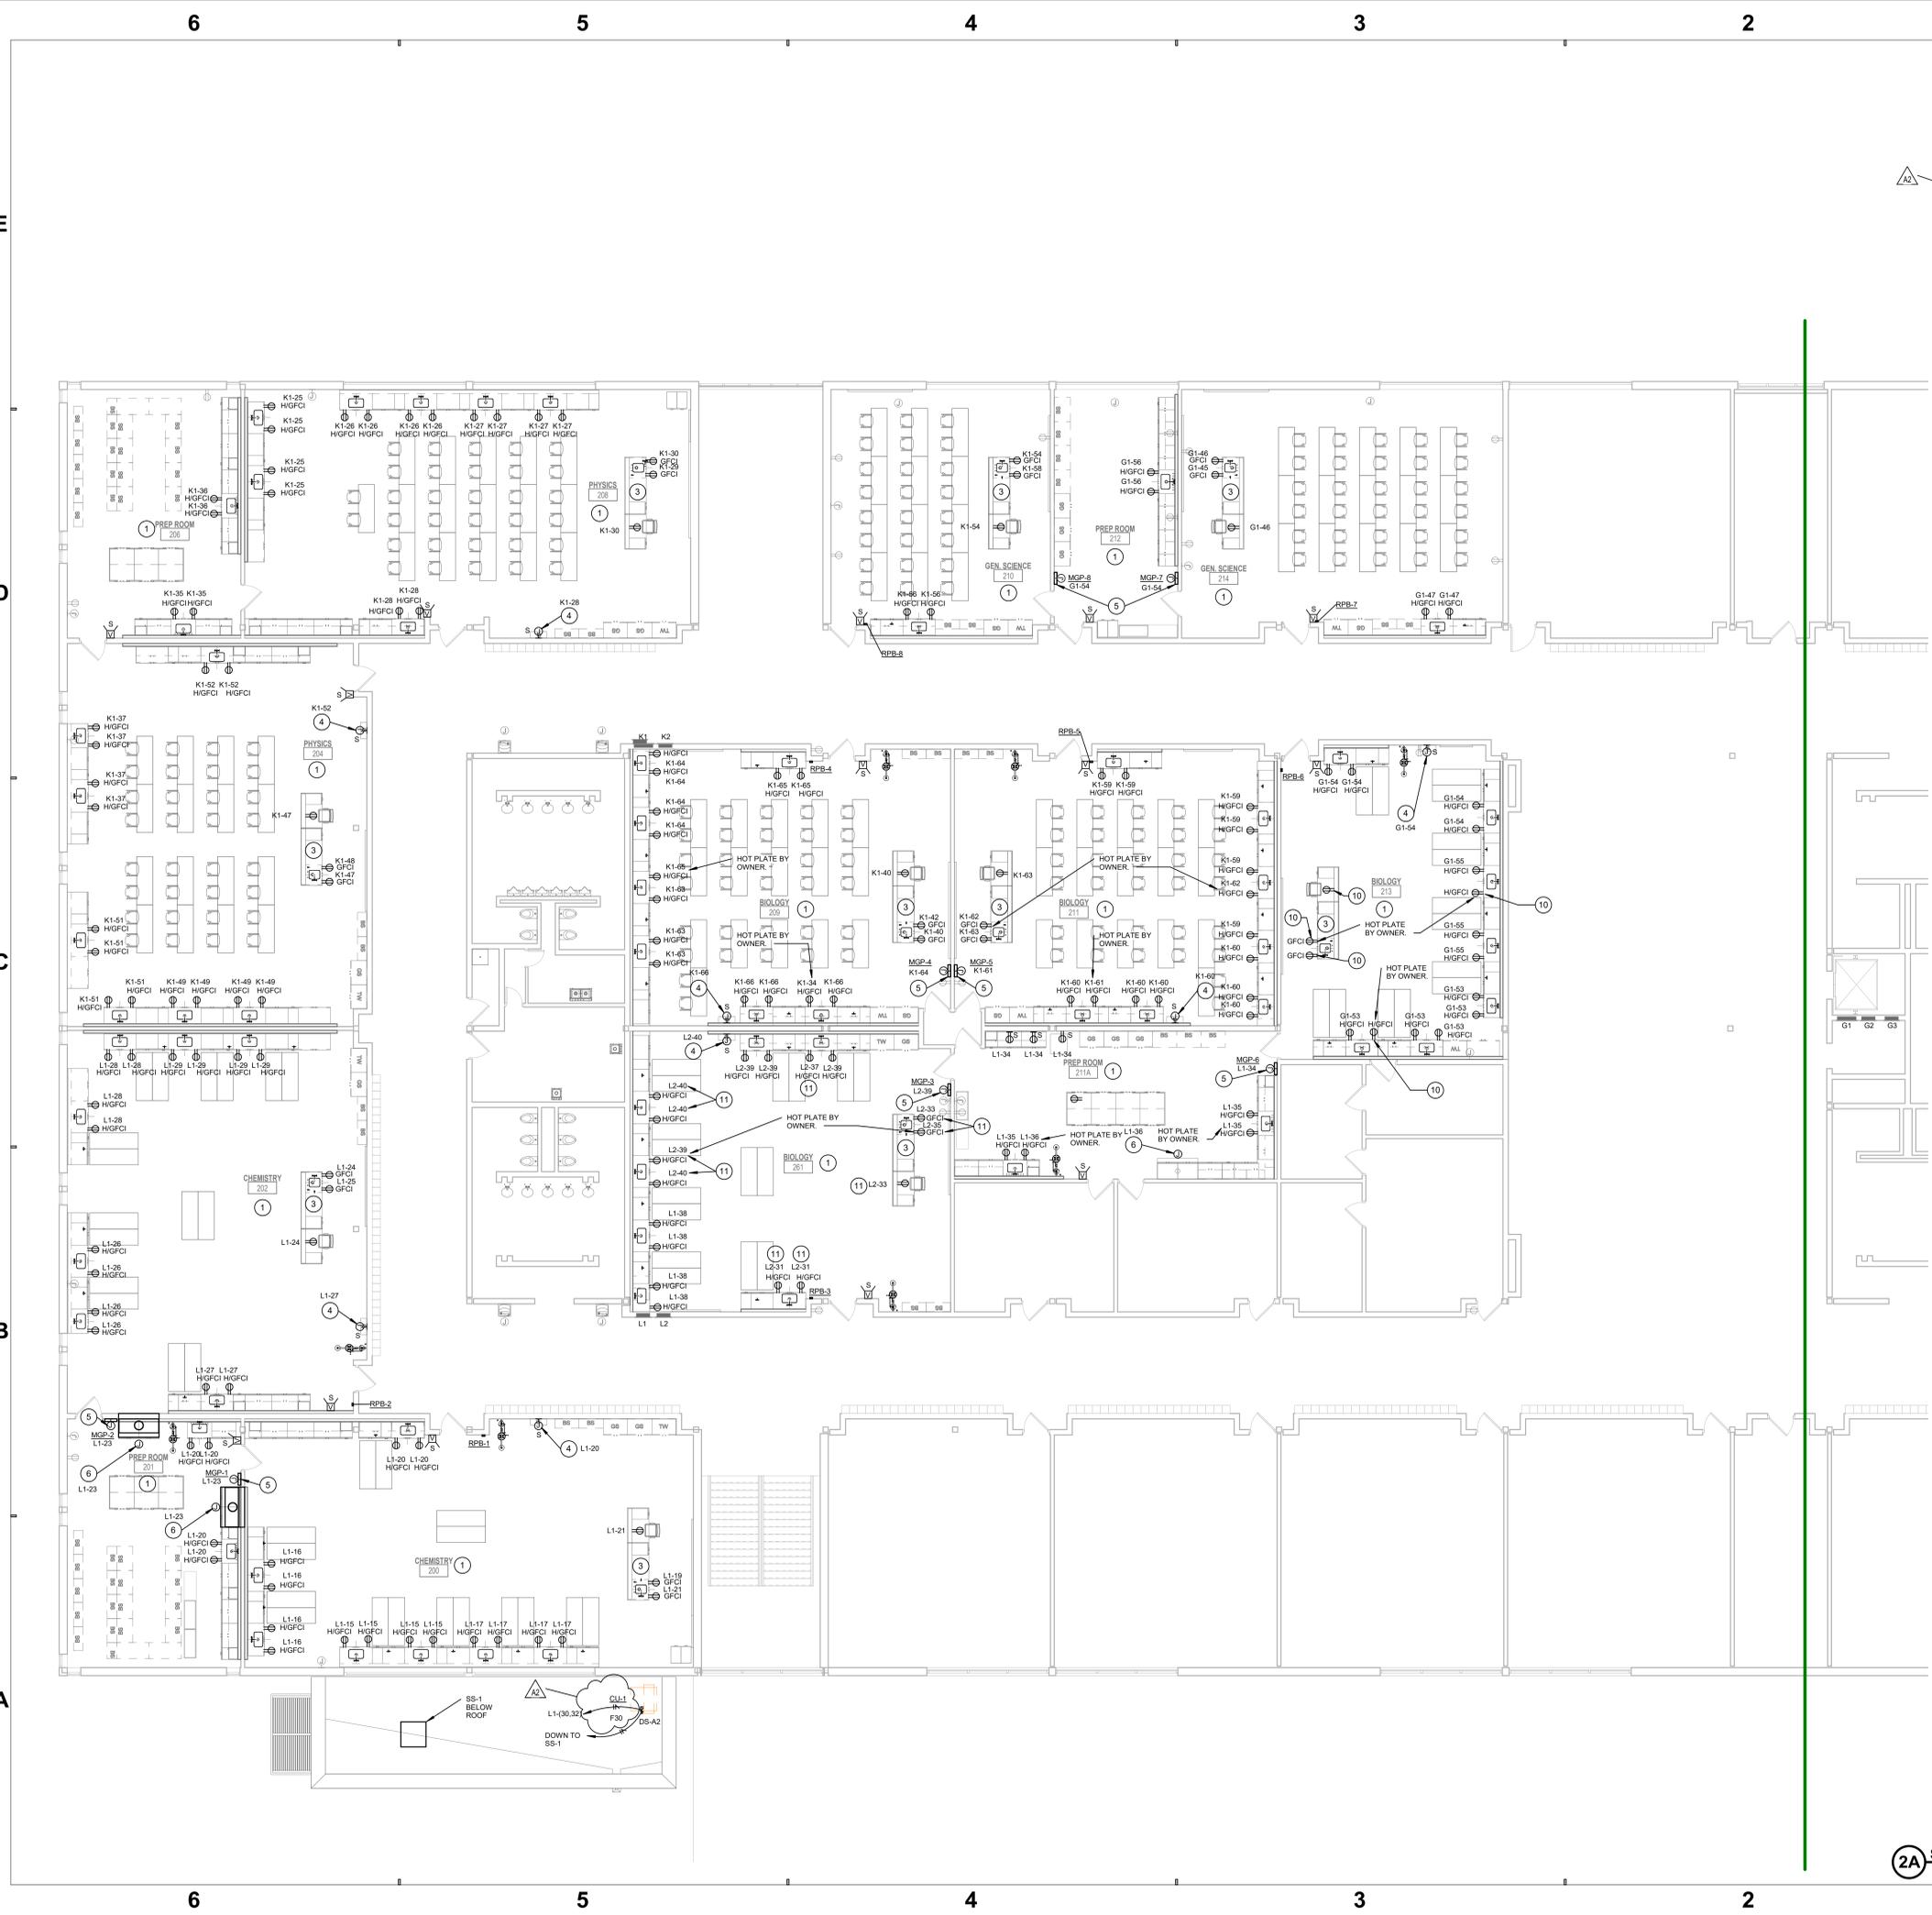

GENERAL POWER NOTES

#	NOTES
A	REFER TO SHEET E-001 FOR ADDITIONAL INFORMATION.
B	CONTRACTOR TO CHANNEL FLOOR OR EXTEND CIRCUITS DOWN TO FIRST FLOOR ABOVE CEILING. PROVIDE POKE THROUGH FIRE RATED ASSEMBLIES. REFER TO SPECIFICATION SECTION 282726.2.
C	REFER TO INTERIORS DRAWINGS FOR ELEVATIONS SHOWING 20 AMP DUPLEX GFCI ROUGH-INS IN SCIENCE ROOM FURNITURE.
D	PROVIDE TAMPER PROOF 20 AMP DUPLEX GFCI RECEPTACLES IN HORIZONTAL POSITION IN ALL SCIENCE ROOM FURNITURE.
E	REFER TO PLUMBING GAS ISOMETRIC IN P-SERIES DRAWINGS. COORDINATE POWER REQUIREMENTS FOR GAS EMERGENCY CONTROL PANELS AND SOLENOID VALVES.

POWER PLAN NOTES


#	NOTES
1	CONNECT NEW POWER RECEPTACLES TO EXISTING POWER CIRCUITS.
2	REFRIGERATOR. PROVIDE GFCI BREAKER.
3	PROVIDE POKE THROUGH TO FEED DEMO TABLES. TYPICAL. REFER TO E-500 SERIES DRAWINGS FOR ADDITIONAL POKE THROUGH INFORMATION. COORDINATE WITH T-SERIES DRAWINGS.
4	CIRCUIT CONNECTION FOR GOGGLE CABINET.
5	CIRCUIT CONNECTION FOR GAS EMERGENCY CONTROL PANEL.
6	CIRCUIT CONNECTION FOR FUME HOOD.
7	PROVIDE GFCI CIRCUIT BREAKER TO SERVE REFRIGERATOR.
8	PROVIDE 1P-20A CIRCUIT BREAKERS IN PANELBOARD H2 TO SERVE THIS AREA.
9	CIRCUIT CONNECTION FOR AUTOMATIC DOOR OPERATOR.
10	PANELBOARD G3 (TAIL PANEL). PROVIDE FOUR (4) 1P-20A BREAKERS IN PANEL.
11	PANELBOARD L2. PROVIDE (1) 2P-30A CIRCUIT BREAKER IN SPACES 34.36. PROVIDE (6) 1P-20A CIRCUIT BREAKERS IN SPACES 31, 33, 35, 37, 39, AND 41.



Project No. 2020-153.MHS
 Project Date 07.26.2021
 Produced JH GL



#	Revision	Date
A1	Addendum 1	08.11.2021
A2	Addendum 2	08.18.2021

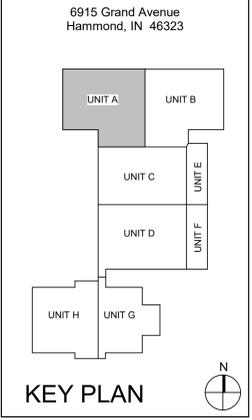

School City of Hammond


School City of Hammond

A Morton High School - Renovations and Addition

SECOND FLOOR POWER PLAN - UNIT A

EP1A2

2A SECOND FLOOR POWER PLAN - UNIT A
 1/8" = 1'-0"

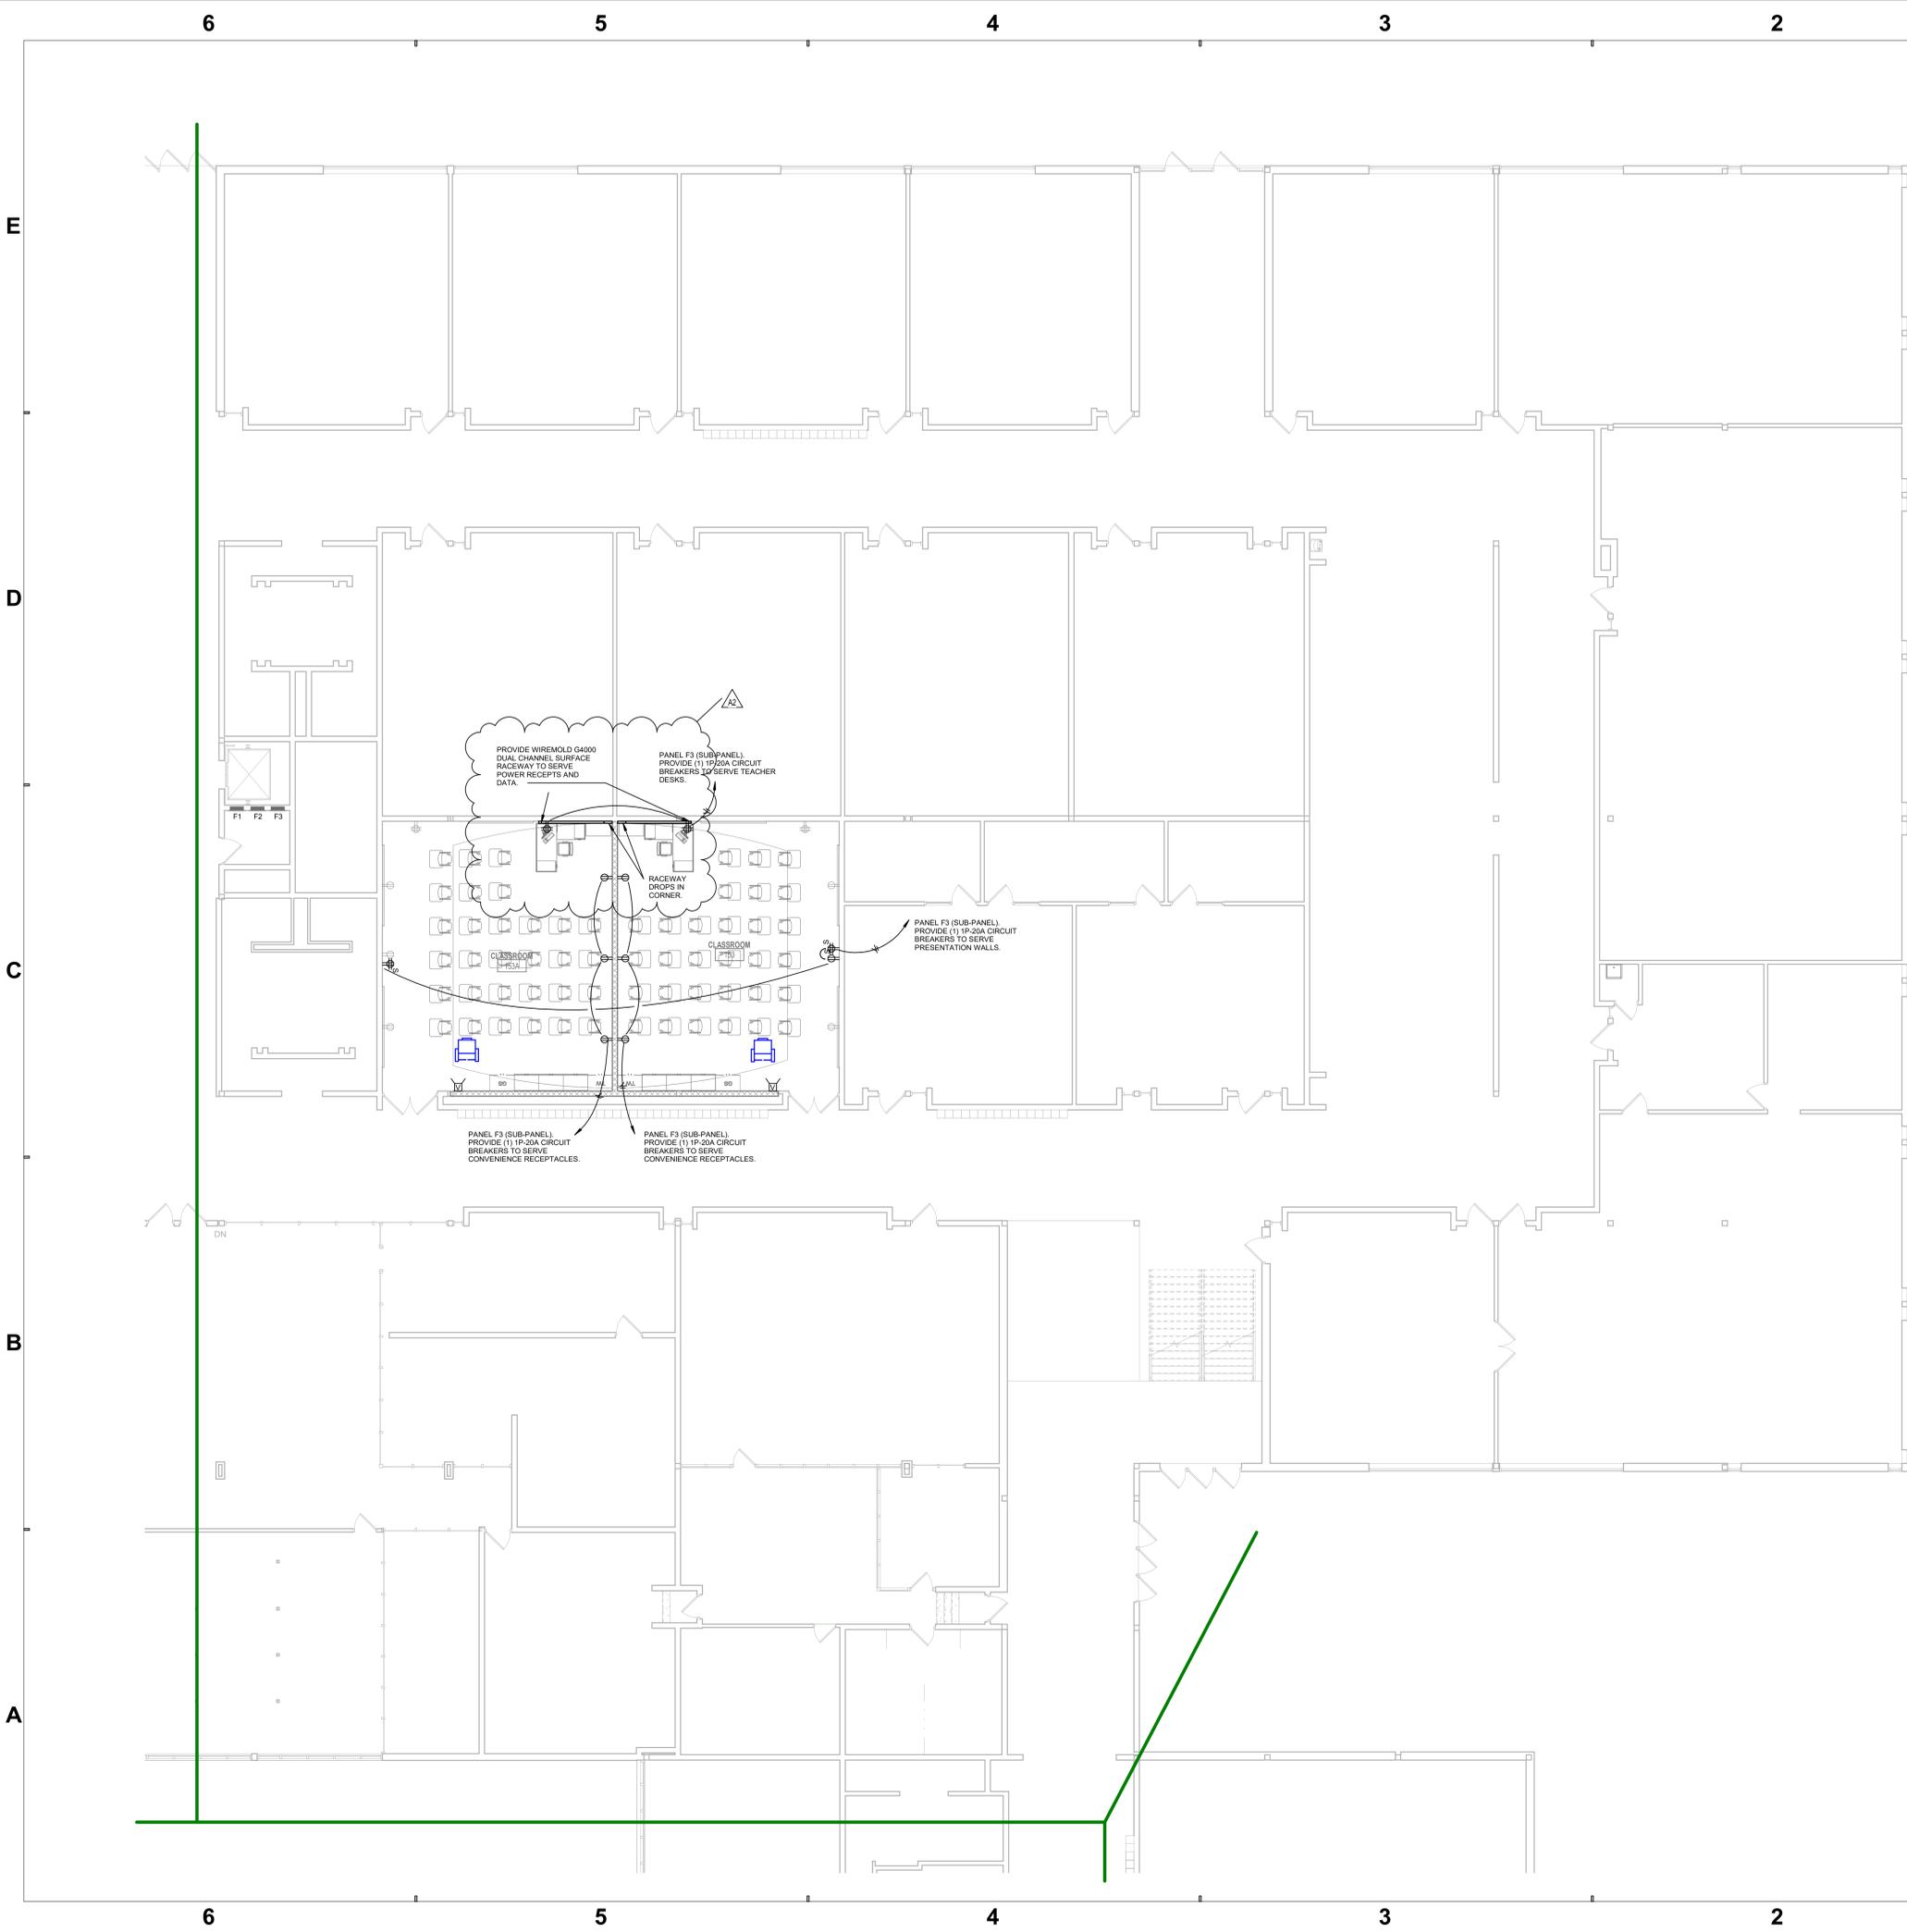

GENERAL POWER NOTES	
#	NOTES
A	REFER TO SHEET E-001 FOR ADDITIONAL INFORMATION.
B	CONTRACTOR TO CHANNEL FLOOR OR EXTEND CIRCUITS DOWN TO FIRST FLOOR ABOVE CEILING. PROVIDE POKE THROUGH FIRE RATED ASSEMBLIES. REFER TO SPECIFICATION SECTION 292726.2.8.
C	REFER TO INTERIORS DRAWINGS FOR ELEVATIONS SHOWING 20 AMP DUPLX GFCI ROUGH-INS IN SCIENCE ROOM FURNITURE.
D	PROVIDE TAMPER PROOF 20 AMP DUPLX GFCI RECEPTACLES IN HORIZONTAL POSITION IN ALL SCIENCE ROOM FURNITURE.
E	REFER TO PLUMBING GAS ISOMETRIC IN P-SERIES DRAWINGS. COORDINATE POWER REQUIREMENTS FOR GAS EMERGENCY CONTROL PANELS AND SOLENOID VALVES.

POWER PLAN NOTES	
#	NOTES
1	CONNECT NEW POWER RECEPTACLES TO EXISTING POWER CIRCUITS.
2	REFRIGERATOR. PROVIDE GFCI BREAKER.
3	PROVIDE POKE THROUGH TO FEED DEMO TABLES. TYPICAL. REFER TO E-500 SERIES DRAWINGS FOR ADDITIONAL POKE THROUGH INFORMATION. COORDINATE WITH T-SERIES DRAWINGS.
4	CIRCUIT CONNECTION FOR GOOGLE CABINET.
5	CIRCUIT CONNECTION FOR GAS EMERGENCY CONTROL PANEL.
6	CIRCUIT CONNECTION FOR FUME HOOD.
7	PROVIDE GFCI CIRCUIT BREAKER TO SERVE REFRIGERATOR.
8	PROVIDE 1P-20A CIRCUIT BREAKERS IN PANELBOARD H2 TO SERVE THIS AREA.
9	CIRCUIT CONNECTION FOR AUTOMATIC DOOR OPERATOR.
10	PANELBOARD G3 (TAIL PANEL). PROVIDE FOUR (4) 1P-20A BREAKERS IN PANEL.
11	PANELBOARD L2. PROVIDE (1) 2P-30A CIRCUIT BREAKER IN SPACES 34,36. PROVIDE (6) 1P-20A CIRCUIT BREAKERS IN SPACES 31, 33, 35, 37, 39, AND 41.


SCHMIDT ASSOCIATES
415 Massachusetts Avenue
Indianapolis, IN 46204
www.schmidt-arch.com

Project No. 2020-153.MHS
Project Date 07.26.2021
Produced JH GL

Sarah K. Hempstead

These Drawings and Specifications, and all copies thereof are and shall remain the property and copyright of the Architect. They shall be used only with respect to this Project and are not to be used on any other Project or Work without prior written permission from the Architect.

#	Revision	Date
A1	Addendum 1	08.11.2021
A2	Addendum 2	08.18.2021

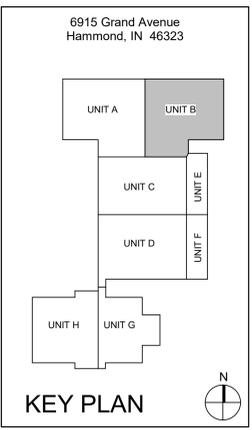

School City of Hammond

School City of Hammond

A Morton High School - Renovations and Addition

FIRST FLOOR POWER PLAN - UNIT B

EP1B1

2A FIRST FLOOR POWER PLAN - UNIT B
1/8" = 1'-0"

DATE: 08/18/2021 10:45 AM
DRAWN BY: JH
CHECKED BY: GL
PROJECT: 2020-153.MHS
SHEET: EP1B1

DESIGNATION: L2 LOCATION: Space 154RRR MOUNTING: FLUSH SUPPLY FROM: AIC RATING: 10,000 AIC

BRANCH PANELBOARD SCHEDULE

CKT NO.	CIRCUIT ROOM #	CIRCUIT TYPE	TRIP	P	A	B	C	P	TRIP	CIRCUIT TYPE	CIRCUIT ROOM #	CKT NO.	
1	EXISTING	20 A	1	0.00	0.00			1	20 A	EXISTING	2	2	
3	EXISTING	20 A	1					1	20 A	EXISTING	4	4	
5	EXISTING	20 A	1					1	20 A	EXISTING	6	6	
7	EXISTING	20 A	1	0.00	0.00			1	20 A	EXISTING	8	8	
9	EXISTING	20 A	1		0.00	0.00		1	20 A	EXISTING	10	10	
11	EXISTING	20 A	1				0.00	0.00	1	20 A	EXISTING	12	12
13	EXISTING	20 A	1	0.00	0.00			1	20 A	EXISTING	14	14	
15	EXISTING	20 A	1		0.00	0.00		1	20 A	EXISTING	16	16	
17	EXISTING	20 A	1				0.00	0.00	1	20 A	EXISTING	18	18
19	EXISTING	20 A	1	0.00	0.00			1	20 A	EXISTING	20	20	
21	EXISTING	20 A	1			0.00	0.00	1	20 A	EXISTING	22	22	
23	EXISTING	20 A	1				0.00	0.00	1	20 A	EXISTING	24	24
25	EXISTING	20 A	1	0.00	0.00			1	20 A	EXISTING	26	26	
27	EXISTING	20 A	1		0.00	0.00		1	20 A	EXISTING	28	28	
29	EXISTING	20 A	1			0.00	0.00	1	20 A	EXISTING	30	30	
31	BIOLOGY 261	RECEPTS	20 A	1	0.36	0.00		1	20 A	EXISTING	32	32	
33	BIOLOGY 261 DEMO TABLE	RECEPTS	20 A	1		0.36	0.00	1	20 A	EXISTING	34	34	
35	BIOLOGY 261 DEMO TABLE	RECEPTS	20 A	1			0.18	0.00	1	20 A	EXISTING	36	36
37	BIOLOGY 261	RECEPTS	20 A	1	0.18	0.00		1	20 A	EXISTING	38	38	
39	BIOLOGY 261	RECEPTS	20 A	1		0.72	0.54	1	20 A	RECEPTS	BIOLOGY 261 DEMO TABLE	40	40
41	EXISTING	20 A	1				0.00	0.00	1	20 A	EXISTING	42	42
TOTAL LOAD:					0.54 kVA	1.62 kVA	0.18 kVA						
TOTAL AMPS:					5 A	14 A	2 A						
TOTAL CONNECTED LOAD:					2.34 kVA								
TOTAL CONNECTED AMPS:					14 A								
TOTAL DEMAND LOAD:								2.34 kVA					
TOTAL DEMAND AMPS:								6 A					

LOAD CLASSIFICATION: Receptacle - General 2340 VA

DEMAND FACTOR: 100.00%

ESTIMATE DEMAND (VA): 2340 VA

NOTES: 1. EXISTING PANELBOARD TO BE REUSED.

DESIGNATION: K1 LOCATION: Space 154RRR MOUNTING: FLUSH SUPPLY FROM: AIC RATING: 10,000 AIC

BRANCH PANELBOARD SCHEDULE

CKT NO.	CIRCUIT ROOM #	CIRCUIT TYPE	TRIP	P	A	B	C	P	TRIP	CIRCUIT TYPE	CIRCUIT ROOM #	CKT NO.		
1	EXISTING	20 A	1	0.00	0.00			1	20 A	EXISTING	2	2		
3	EXISTING	20 A	1					1	20 A	EXISTING	4	4		
5	EXISTING	20 A	1					1	20 A	EXISTING	6	6		
7	EXISTING	20 A	1	0.00	0.00			1	20 A	EXISTING	8	8		
9	EXISTING	20 A	1		0.00	0.00		1	20 A	EXISTING	10	10		
11	EXISTING	20 A	1				0.00	0.00	1	20 A	EXISTING	12	12	
13	EXISTING	20 A	1	0.00	0.00			1	20 A	EXISTING	14	14		
15	EXISTING	20 A	1		0.00	0.00		1	20 A	EXISTING	16	16		
17	EXISTING	20 A	1				0.00	0.00	1	20 A	EXISTING	18	18	
19	EXISTING	20 A	1	0.00	0.00			1	20 A	EXISTING	20	20		
21	EXISTING	20 A	1			0.00	0.00	1	20 A	EXISTING	22	22		
23	EXISTING	20 A	1				0.00	0.00	1	20 A	EXISTING	24	24	
25	PHYSICS 208	RECEPTS	20 A	1	0.72	0.72		1	20 A	RECEPTS	PHYSICS 208	26	26	
27	PHYSICS 208	RECEPTS	20 A	1		0.72	0.36	1	20 A	RECEPTS	PHYSICS 208	28	28	
29	PHYSICS 208 DEMO TABLE	RECEPTS	20 A	1			0.18	0.36	1	20 A	RECEPTS	PHYSICS 208 DEMO TABLE	30	30
31	EXISTING	20 A	1	0.00	0.00			1	20 A	EXISTING	32	32		
33	EXISTING	20 A	1			0.00	0.18	1	20 A	RECEPTS	BIOLOGY 209	34	34	
35	PREP ROOM 206	RECEPTS	20 A	1			0.36	0.36	1	20 A	RECEPTS	PREP ROOM 206	36	36
37	PHYSICS 204	RECEPTS	20 A	1	0.72	0.00		1	20 A	EXISTING	38	38		
39	EXISTING	20 A	1			0.00	0.36	1	20 A	RECEPTS	BIOLOGY 209 DEMO TABLE	40	40	
41	EXISTING	20 A	1				0.00	0.18	1	20 A	RECEPTS	BIOLOGY 209 DEMO TABLE	42	42
43	EXISTING	20 A	1	0.00	0.00			1	20 A	EXISTING	44	44		
45	EXISTING	20 A	1			0.00	0.00	1	20 A	EXISTING	46	46		
47	PHYSICS 204 DEMO TABLE	RECEPTS	20 A	1			0.36	0.18	1	20 A	RECEPTS	PHYSICS 204 DEMO TABLE	48	48
49	PHYSICS 204	RECEPTS	20 A	1	0.72	0.00		1	20 A	EXISTING	50	50		
51	PHYSICS 204	RECEPTS	20 A	1		0.72	0.36	1	20 A	RECEPTS	PHYSICS 204	52	52	
53	EXISTING	20 A	1			0.00	0.36	1	20 A	RECEPTS	GEN SCIENCE 210 DEMO TABLE	54	54	
55	EXISTING	20 A	1	0.00	0.36			1	20 A	RECEPTS	GEN SCIENCE 210	56	56	
57	EXISTING	20 A	1			0.00	0.18	1	20 A	RECEPTS	GEN SCIENCE 210 DEMO TABLE	58	58	
59	BIOLOGY 211	RECEPTS	20 A	1			1.08	1.08	1	20 A	EXISTING	60	60	
61	BIOLOGY 211	RECEPTS	20 A	1	0.18	0.36		1	20 A	RECEPTS	BIOLOGY 211 HOT PLATE	62	62	
63	BIOLOGY 209	RECEPTS	20 A	1	0.90	0.72		1	20 A	RECEPTS	BIOLOGY 209 HOT PLATE	64	64	
65	BIOLOGY 209 DEMO TABLE	RECEPTS	20 A	1			0.54	0.54	1	20 A	RECEPTS	BIOLOGY 209, 261	66	66
67	EXISTING	20 A	1	0.00	0.00			1	20 A	EXISTING	68	68		
69	EXISTING	20 A	1			0.00	0.00	1	20 A	EXISTING	70	70		
71	EXISTING	20 A	1			0.00	0.00	1	20 A	EXISTING	72	72		
73	EXISTING	20 A	1	0.00	0.00			1	20 A	EXISTING	74	74		
75	EXISTING	20 A	1			0.00	0.00	1	20 A	EXISTING	76	76		
77	EXISTING	20 A	1				0.00	0.00	1	20 A	EXISTING	78	78	
79	EXISTING	20 A	1	0.00	0.00			1	20 A	EXISTING	80	80		
81	EXISTING	20 A	1			0.00	0.00	1	20 A	EXISTING	82	82		
83	EXISTING	20 A	1			0.00	0.00	1	20 A	EXISTING	84	84		
TOTAL LOAD:					3.78 kVA	4.50 kVA	5.58 kVA							
TOTAL AMPS:					32 A	38 A	47 A							
TOTAL CONNECTED LOAD:					13.86 kVA									
TOTAL CONNECTED AMPS:					47 A									
TOTAL DEMAND LOAD:								11.93 kVA						
TOTAL DEMAND AMPS:								33 A						

LOAD CLASSIFICATION: Receptacle - General 13860 VA

DEMAND FACTOR: 86.08%

ESTIMATE DEMAND (VA): 11930 VA

NOTES: 1. EXISTING PANELBOARD TO BE REUSED.

DESIGNATION: G1 LOCATION: Space 154RRR MOUNTING: FLUSH SUPPLY FROM: AIC RATING: 10,000 AIC

BRANCH PANELBOARD SCHEDULE

CKT NO.	CIRCUIT ROOM #	CIRCUIT TYPE	TRIP	P	A	B	C	P	TRIP	CIRCUIT TYPE	CIRCUIT ROOM #	CKT NO.		
1	EXISTING	20 A	1	0.00	0.00			1	20 A	EXISTING	2	2		
3	EXISTING	20 A	1					1	20 A	EXISTING	4	4		
5	EXISTING	20 A	1					1	20 A	EXISTING	6	6		
7	EXISTING	20 A	1	0.00	0.00			1	20 A	EXISTING	8	8		
9	EXISTING	20 A	1			0.00	0.00	1	20 A	EXISTING	10	10		
11	EXISTING	20 A	1				0.00	0.00	1	20 A	EXISTING	12	12	
13	EXISTING	20 A	1	0.00	0.00			1	20 A	EXISTING	14	14		
15	EXISTING	20 A	1			0.00	0.00	1	20 A	EXISTING	16	16		
17	EXISTING	20 A	1				0.00	0.00	1	20 A	EXISTING	18	18	
19	EXISTING	20 A	1	0.00	0.00			1	20 A	EXISTING	20	20		
21	EXISTING	20 A	1				0.00	0.00	1	20 A	EXISTING	22	22	
23	EXISTING	20 A	1			0.00	0.00	1	20 A	EXISTING	24	24		
25	EXISTING	20 A	1	0.00	0.00			1	20 A	EXISTING	26	26		
27	EXISTING	20 A	1			0.00	0.00	1	20 A	EXISTING	28	28		
29	EXISTING	20 A	1				0.00	0.00	1	20 A	EXISTING	30	30	
31	EXISTING	20 A	1	0.00	0.00			1	20 A	EXISTING	32	32		
33	EXISTING	20 A	1			0.00	0.00	1	20 A	EXISTING	34	34		
35	EXISTING	20 A	1				0.00	0.00	1	20 A	EXISTING	36	36	
37	EXISTING	20 A	1	0.00	0.00			1	20 A	EXISTING	38	38		
39	EXISTING	20 A	1			0.00	0.00	1	20 A	EXISTING	40	40		
41	EXISTING	20 A	1				0.00	0.00	1	20 A	EXISTING	42	42	
43	EXISTING	20 A	1	0.00	0.00			1	20 A	EXISTING	44	44		
45	GENERAL SCIENCE 214	RECEPTS	20 A	1	0.18	0.36		1	20 A	RECEPTS	GENERAL SCIENCE 214	46	46	
47	GENERAL SCIENCE 214	RECEPTS	20 A	1			0.36	0.00	1	20 A	EXISTING	48	48	
49	EXISTING	20 A	1	0.00	0.00			1	20 A	EXISTING	50	50		
51	EXISTING	20 A	1			0.00	0.00	1	20 A	EXISTING	52	52		
53	BIOLOGY 213	RECEPTS	20 A	1			0.54	0.22	1	20 A	POWER	PREP ROOM 212	54	54
55	BIOLOGY 213	RECEPTS	20 A	1	0.54	0.36		1	20 A	RECEPTS	PREP ROOM 212	56	56	
57	EXISTING	20 A	1			0.00	0.00	1	20 A	EXISTING	58	58		
59	EXISTING	20 A	1				0.00	0.00	1	20 A	EXISTING	60	60	
61	EXISTING	20 A	1	0.00	0.00			1	20 A	EXISTING	62	62		
63	EXISTING	20 A	1			0.00	0.00	1	20 A	EXISTING	64	64		
65	EXISTING	20 A	1				0.00	0.00	1	20 A	EXISTING	66	66	
67	EXISTING	20 A	1	0.00	0.00			1	20 A	EXISTING	68	68		
69	EXISTING	20 A	1			0.00	0.00	1	20 A	EXISTING	70	70		
71	EXISTING	20 A	1			0.00	0.00	1	20 A	EXISTING	72	72		
73	EXISTING	20 A	1	0.00	0.00			1	20 A	EXISTING	74	74		
75	EXISTING	20 A	1			0.00	0.00	1	20 A	EXISTING	76	76		
77	EXISTING	20 A	1				0.00	0.00	1	20 A	EXISTING	78	78	
79	EXISTING	20 A	1	0.00	0.00			1	20 A	EXISTING	80	80		
81	EXISTING	20 A	1			0.00	0.00	1	20 A	EXISTING	82	82		
83	EXISTING	20 A	1			0.00	0.00	1	20 A	EXISTING	84	84		
TOTAL LOAD:					0.90 kVA	0.54 kVA	1.98 kVA							
TOTAL AMPS:					8 A	5 A	17 A							
TOTAL CONNECTED LOAD:					3.42 kVA									
TOTAL CONNECTED AMPS:					17 A									
TOTAL DEMAND LOAD:								3.42 kVA						
TOTAL DEMAND AMPS:								9 A						

LOAD CLASSIFICATION: Receptacle - General 3420 VA

DEMAND FACTOR: 100.00%

ESTIMATE DEMAND (VA): 3420 VA

NOTES: 1. EXISTING PANELBOARD TO BE REUSED.



SCHMIDT ASSOCIATES
 415 Massachusetts Avenue
 Indianapolis, IN 46204
 www.schmidt-arch.com


Project No. 2020-154-SMS
 Project Date 07.26.2021
 Produced TYN

FOR REFERENCE - NOT FOR CONSTRUCTION

These Drawings and Specifications, and all copies thereof are and shall remain the property and copyright of the Architect. They shall be used only with respect to this Project and are not to be used on any other Project or Work without prior written permission from the Architect.

#	Revision	Date
A2	Revision 2	8/18/2021

3635 173rd Street
 Hammond, IN 46323

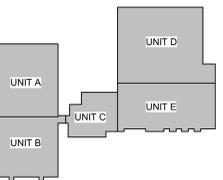

KEY PLAN

School City of Hammond




Scott Middle School - Renovations


EXISTING 1968 POOL DRAWINGS

G-003

THIS DRAWING IS PROVIDED FOR REFERENCE ONLY.

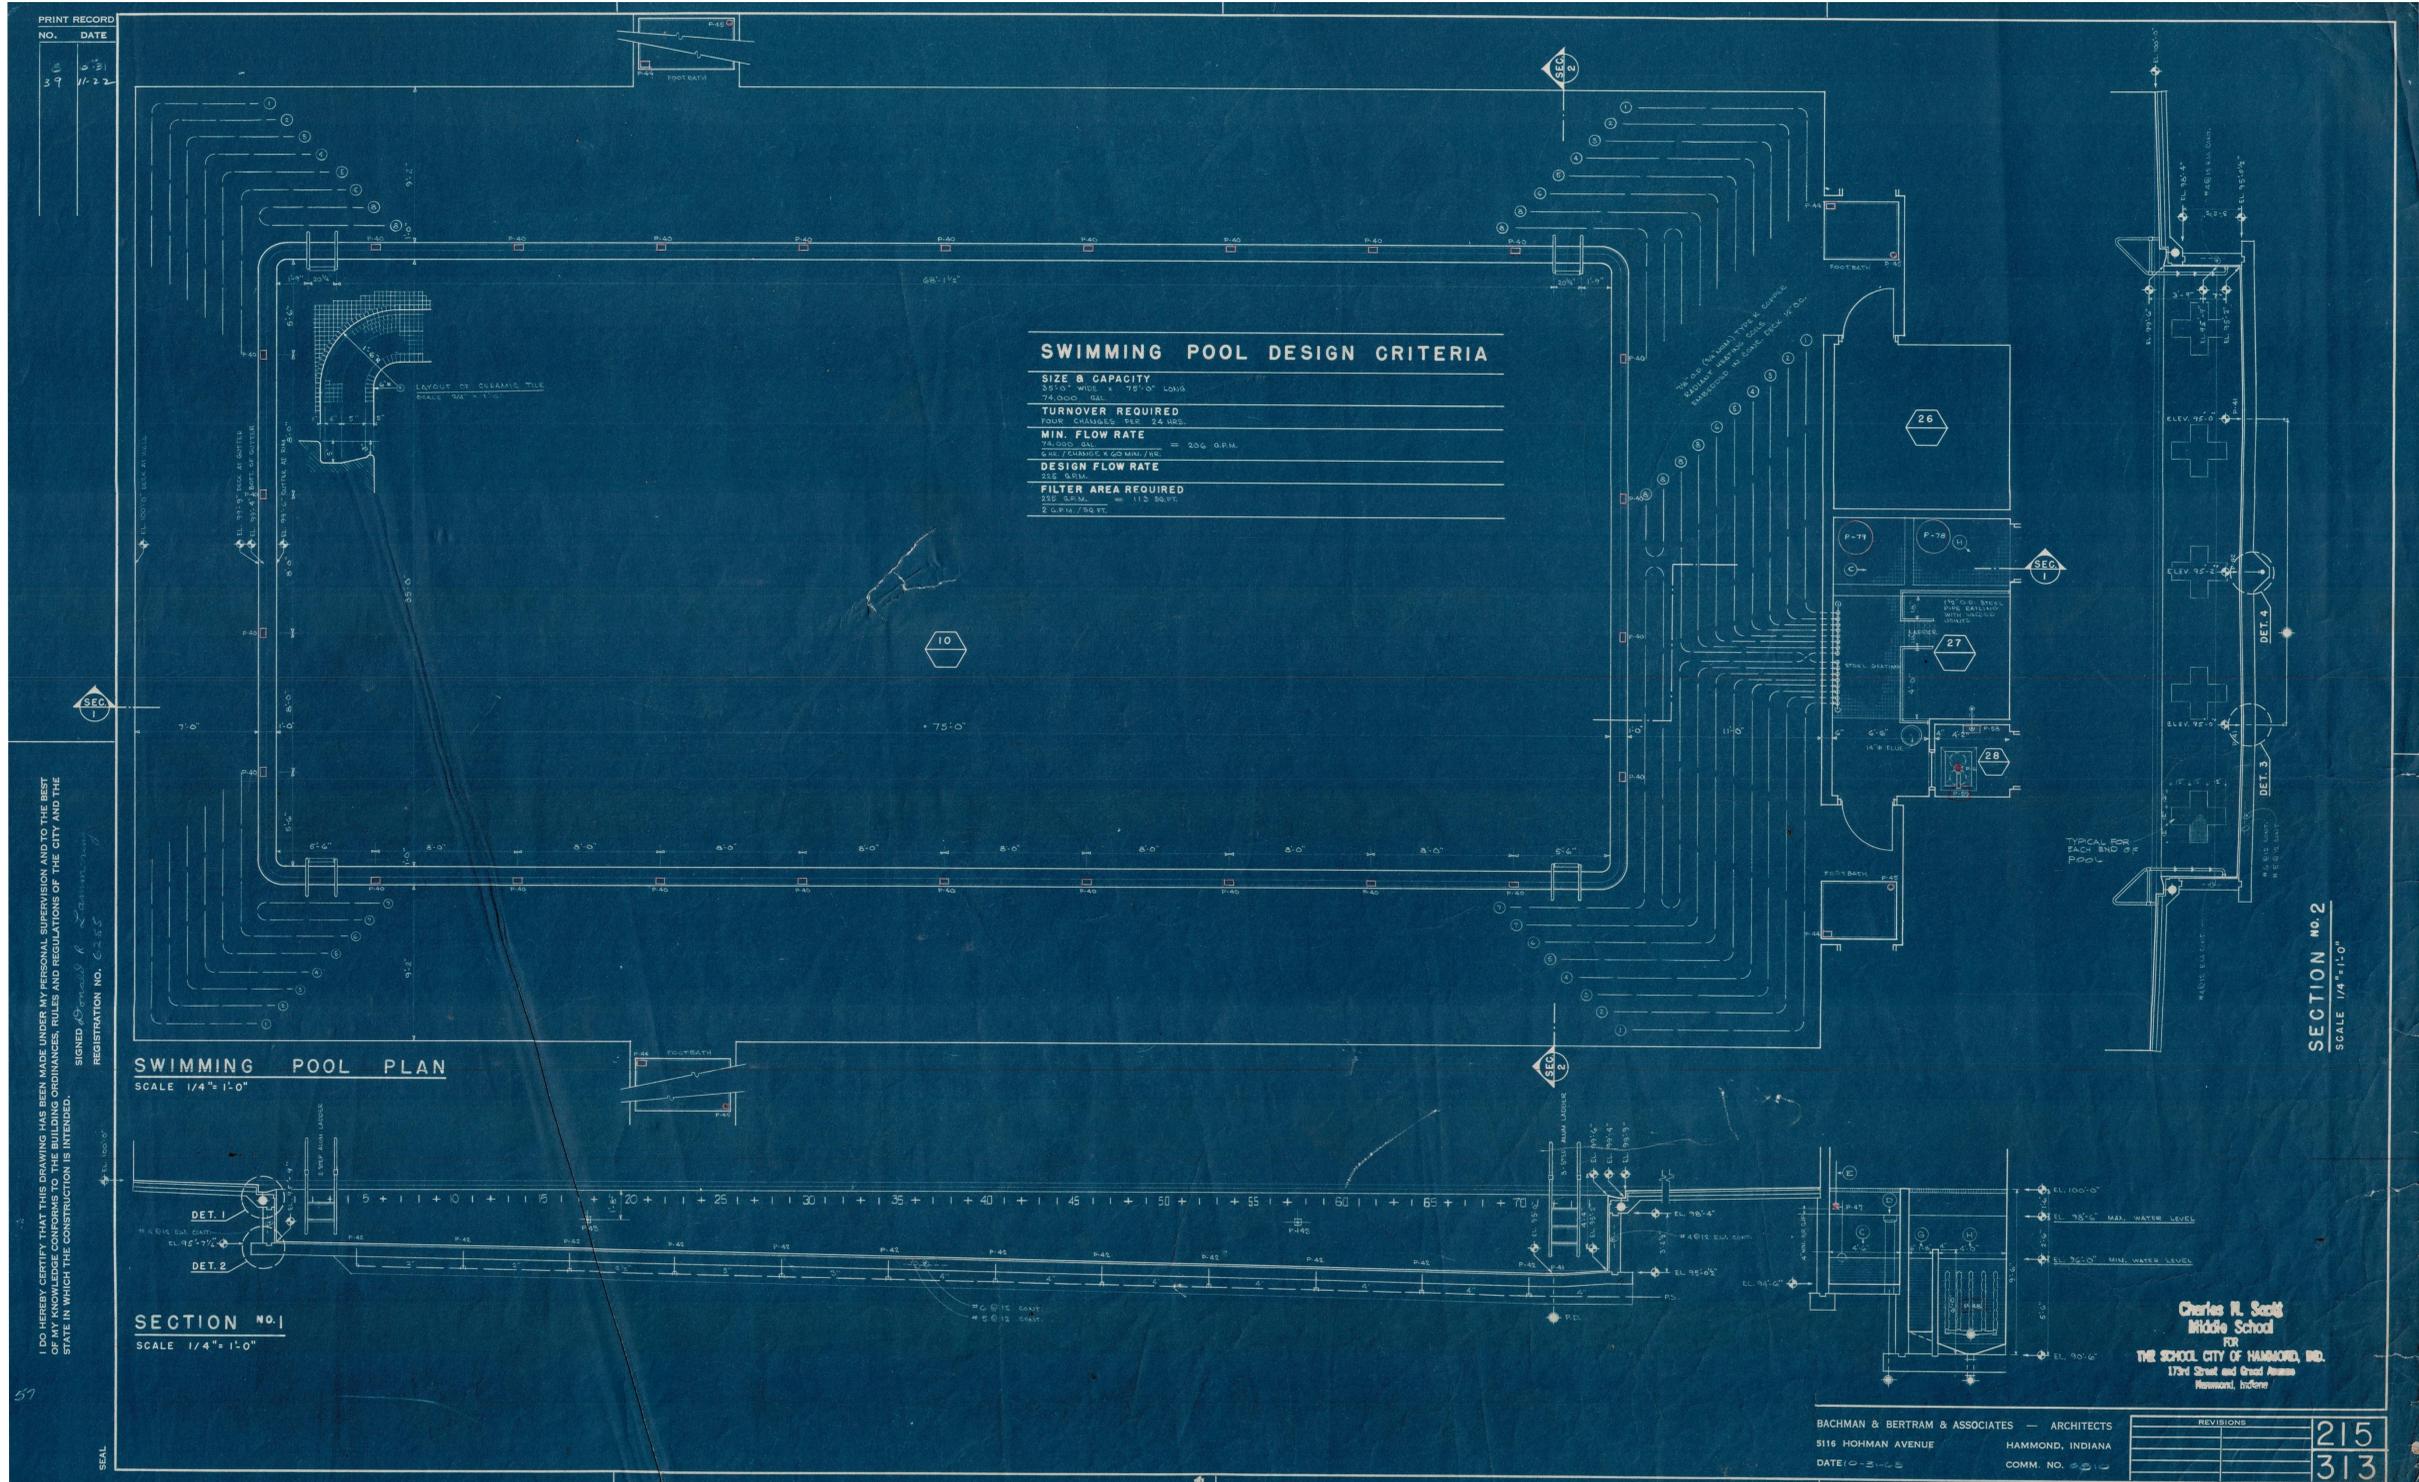

I DO HEREBY CERTIFY THAT THIS DRAWING HAS BEEN MADE UNDER MY PERSONAL SUPERVISION AND TO THE BEST OF MY KNOWLEDGE CONFORMS TO THE BUILDING ORDINANCES, RULES AND REGULATIONS OF THE CITY AND THE STATE IN WHICH THE CONSTRUCTION IS INTENDED.
 SIGNED: [Signature]
 REGISTRATION NO. 6235

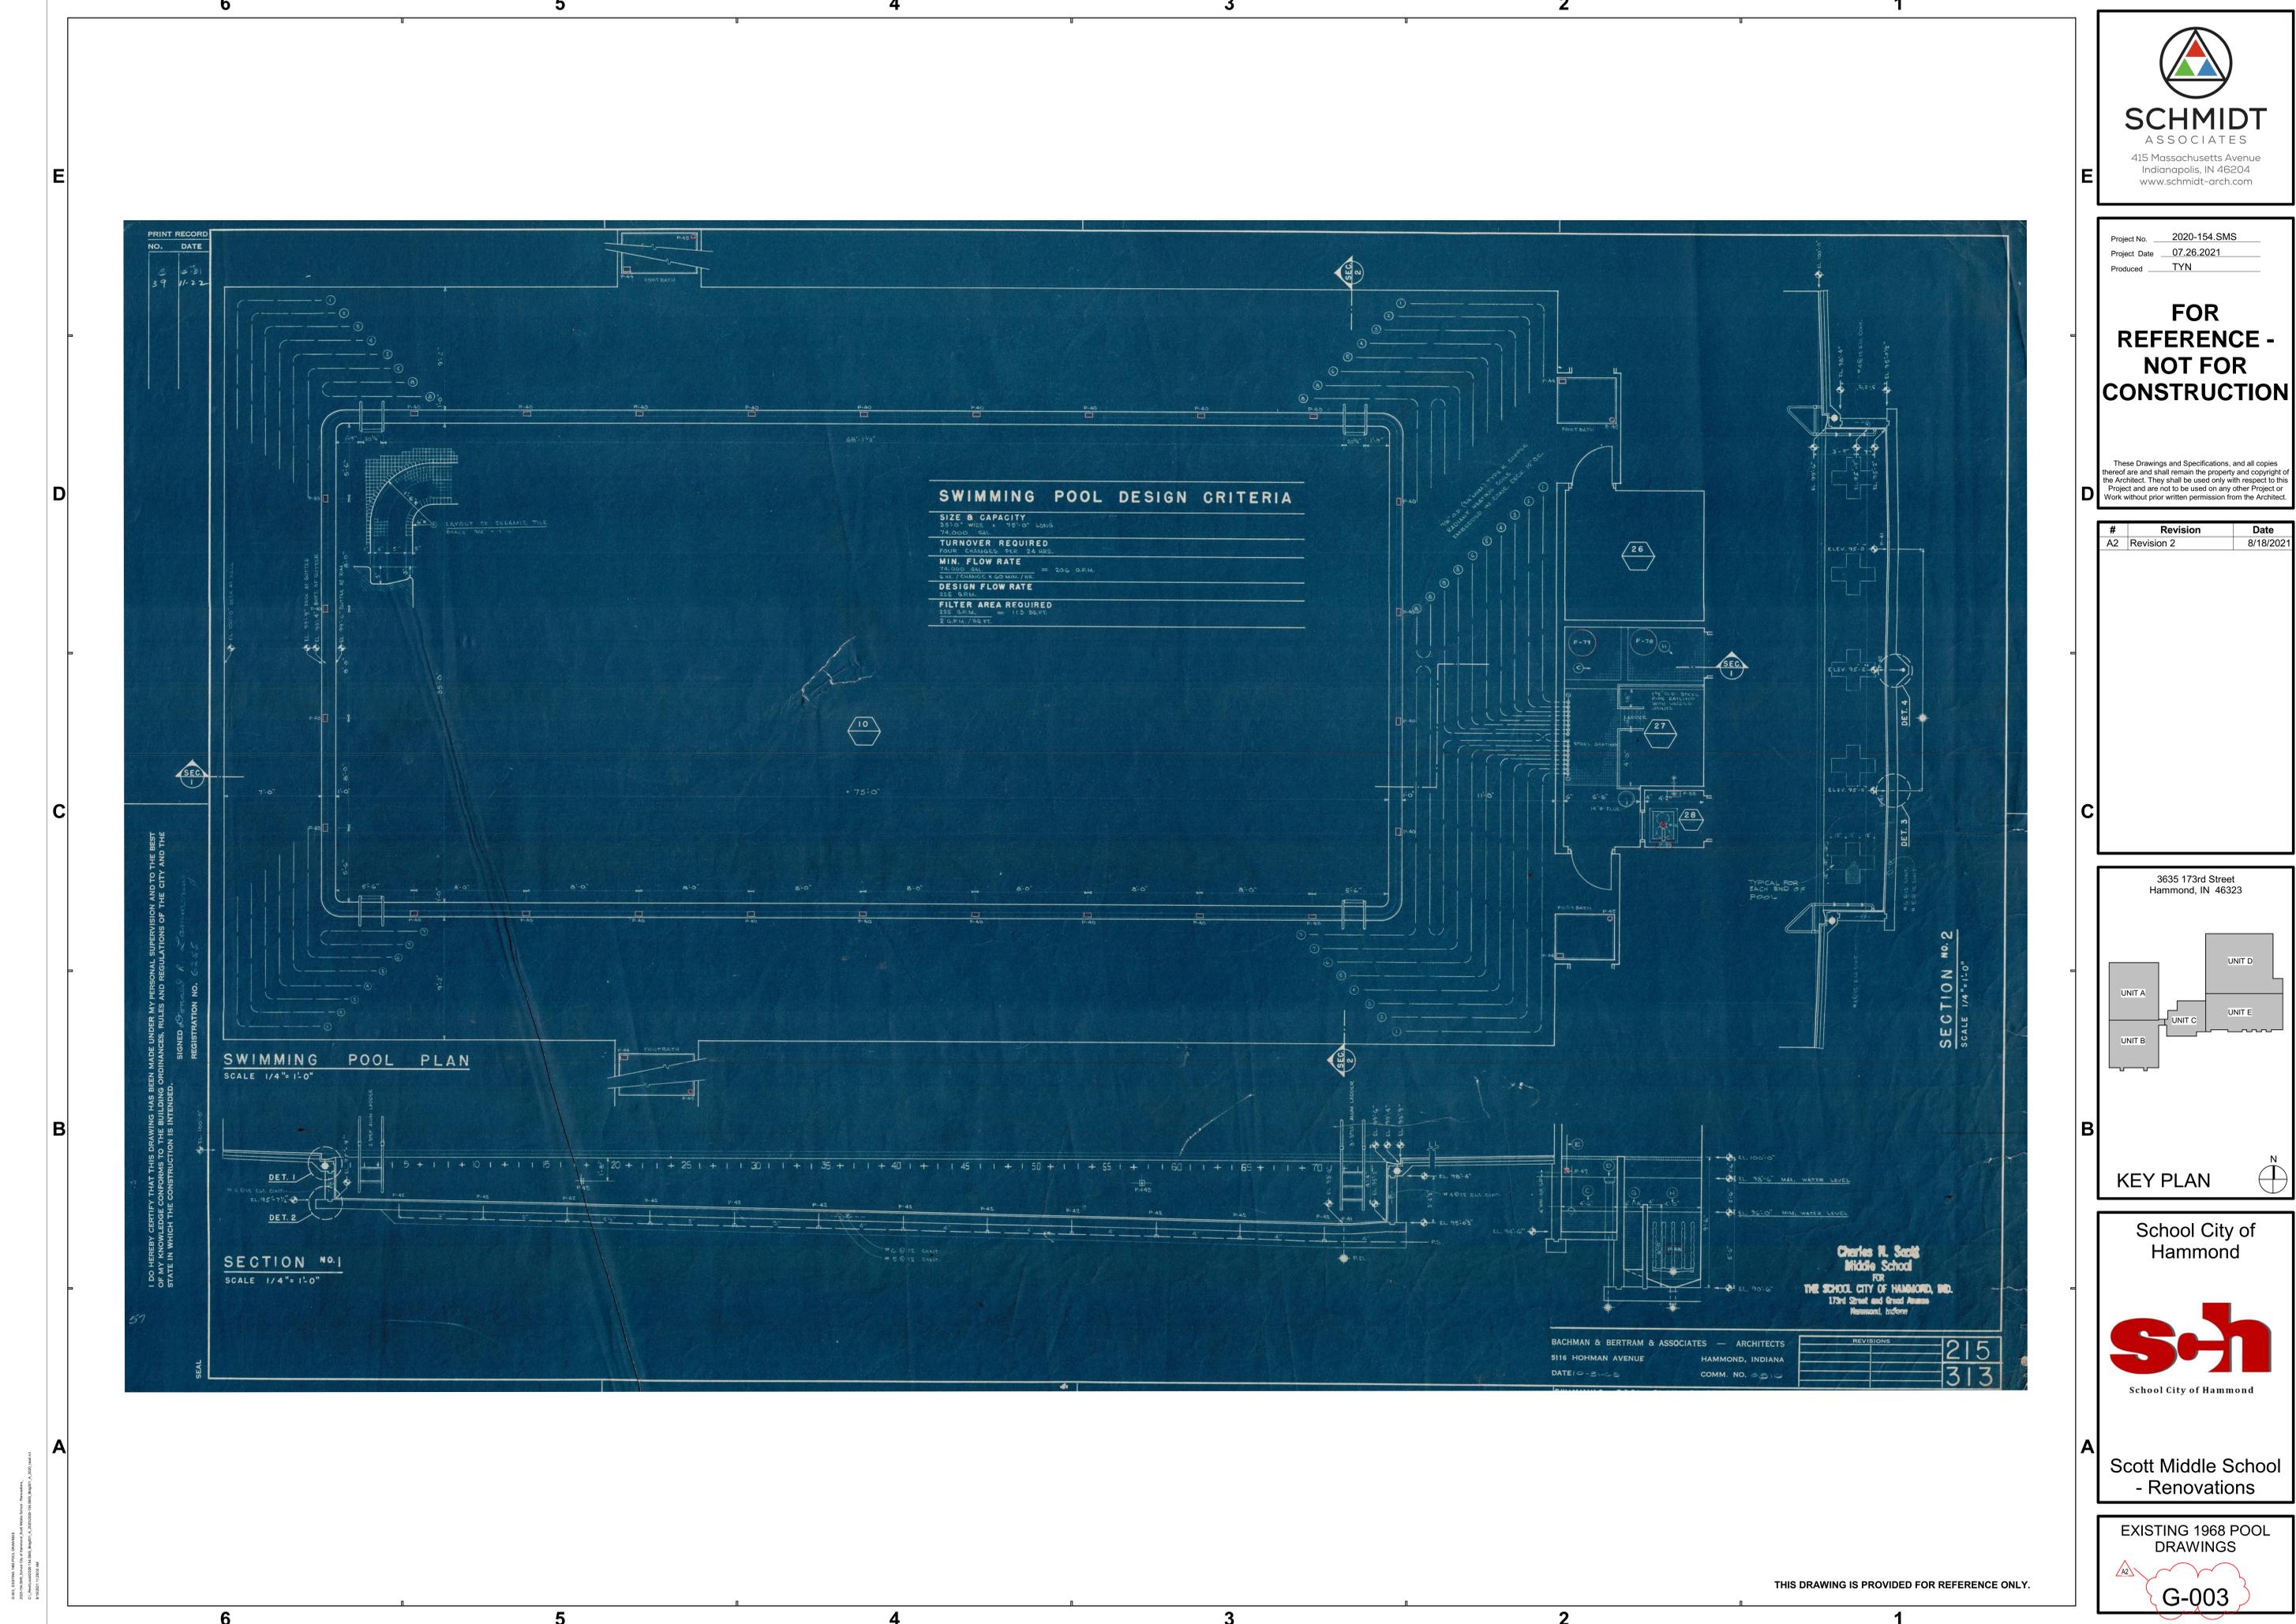



SCHMIDT ASSOCIATES
 415 Massachusetts Avenue
 Indianapolis, IN 46204
 www.schmidt-arch.com


Project No. 2020-154.SMS
 Project Date 07.26.2021
 Produced TYN

**FOR REFERENCE
 NOT FOR
 CONSTRUCTION**

These Drawings and Specifications, and all copies thereof are and shall remain the property and copyright of the Architect. They shall be used only with respect to this Project and are not to be used on any other Project or Work without prior written permission from the Architect.

#	Revision	Date
A2	Revision 2	8/18/2021

3635 173rd Street
 Hammond, IN 46323

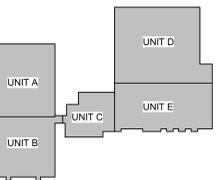

KEY PLAN

School City of Hammond





Scott Middle School
 - Renovations

EXISTING 1968 POOL
 DRAWINGS

G-004

NOMENCLATURE

- (A) 8" POOL WATER RETURN LINE
- (B) 4" DECK & HOLDING TANK DRAIN LINE
- (C) 310 CU. FT. HOLDING TANK
- (D) 4" HOLDING TANK OVERFLOW
- (E) 2" MAKE-UP WATER SUPPLY LINE
- (F) 8" BALANCING LINE
- (G) STILLING CHAMBER
- (H) FILTER TANK
- (I) 3" PRE-COAT LINE
- (J) 4" FILTERED WATER SUPPLY LINE
- (K) 2 1/2" VACUUM LINE

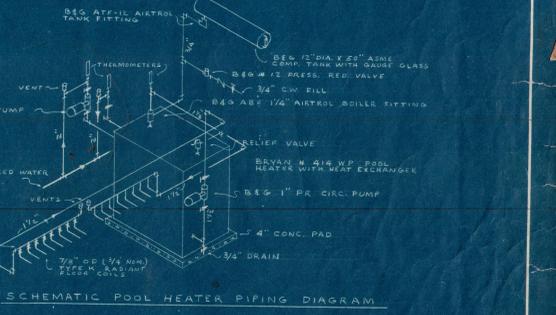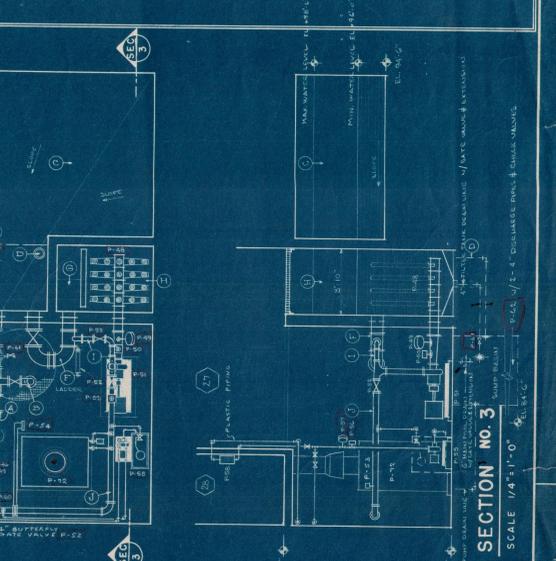


APPROVED


Charles N. Scott
 Middle School
 FOR THE SCHOOL CITY OF HAMMOND, IND.
 173rd Street and Grand Avenue
 Hammond, Indiana

BACHMAN & BERTRAM & ASSOCIATES — ARCHITECTS
 5116 HORMAN AVENUE
 DATE 10-25-18
 HAMMOND, INDIANA
 COMM. NO. C-20-18

REVISIONS	DATE
216	
314	

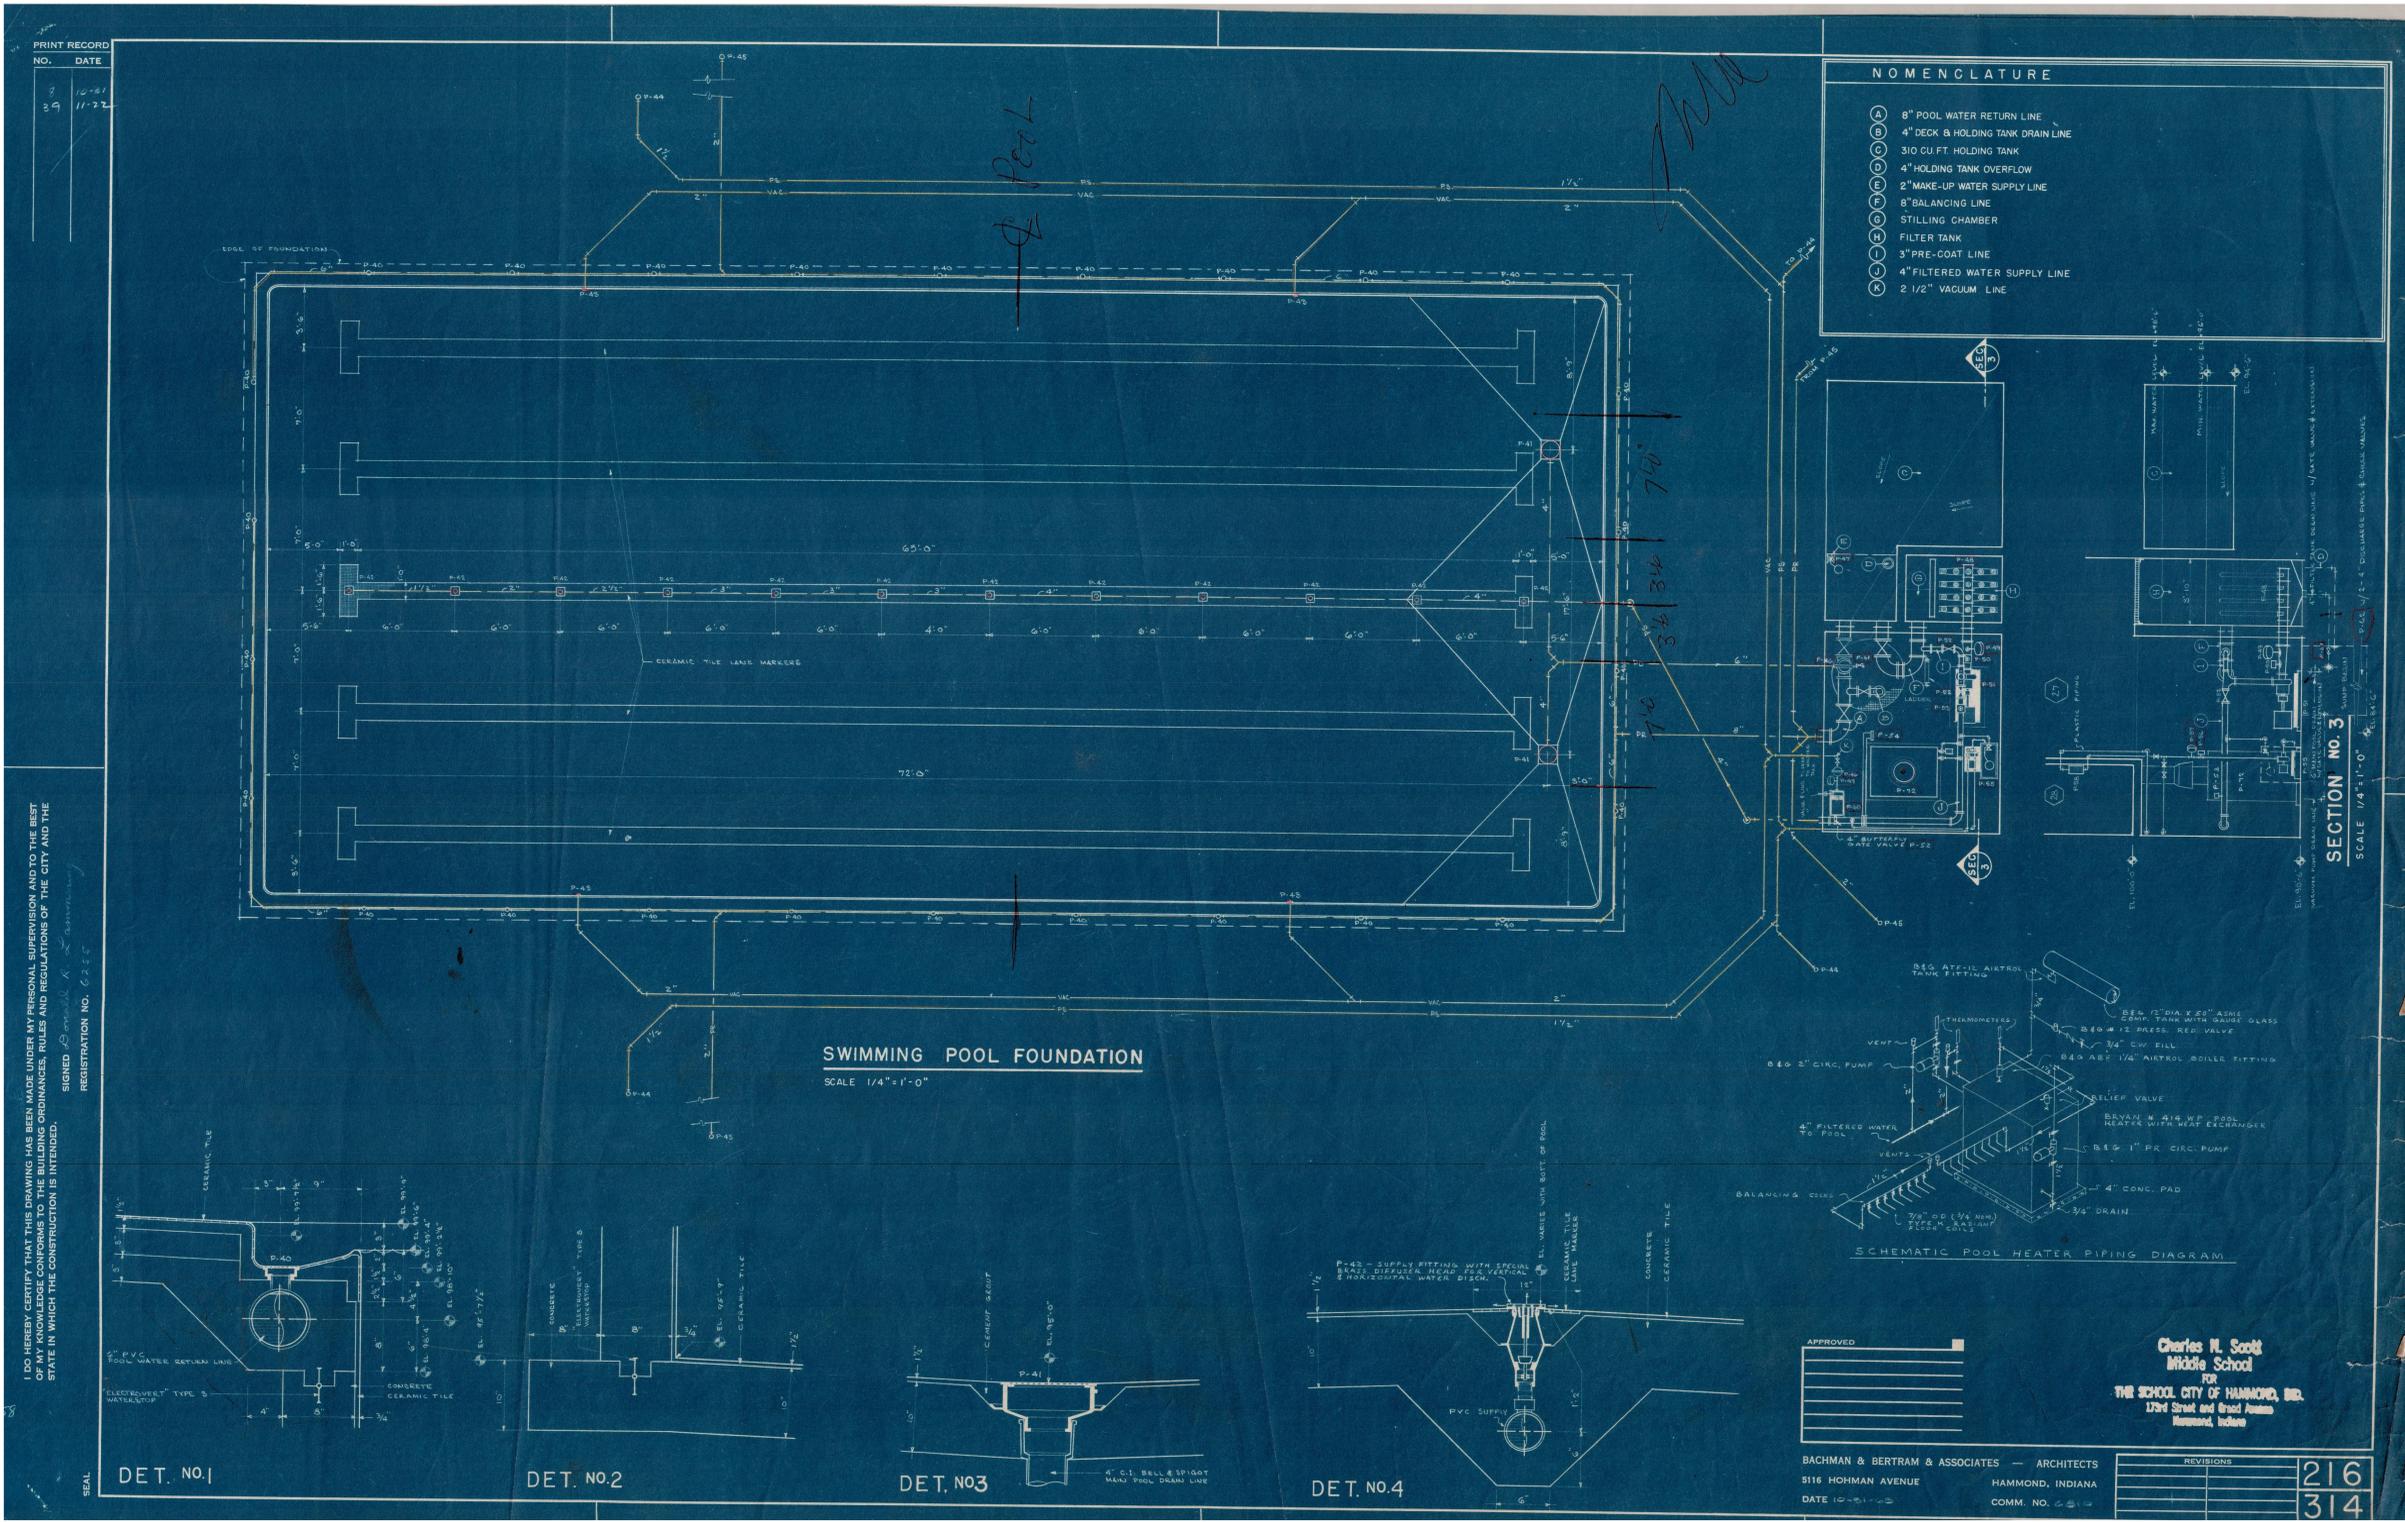

SWIMMING POOL FOUNDATION
 SCALE 1/4" = 1'-0"

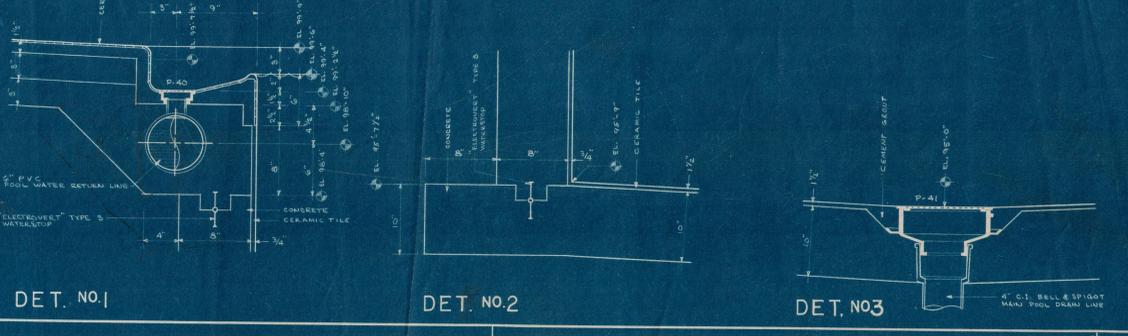

PRINT RECORD

NO.	DATE
3.0	10-21
3.1	11-22


I DO HEREBY CERTIFY THAT THIS DRAWING HAS BEEN MADE UNDER MY PERSONAL SUPERVISION AND TO THE BEST OF MY KNOWLEDGE CONFORMS TO THE BUILDING ORDINANCES, RULES AND REGULATIONS OF THE CITY AND THE STATE IN WHICH THE CONSTRUCTION IS INTENDED.
 SIGNED [Signature]
 REGISTRATION NO. C-2318

THIS DRAWING IS PROVIDED FOR REFERENCE ONLY.

6 5 4 3 2 1

E
D
C
B
A

#	Note
1	ALIGN FACE OF NEW WALL/FILL WITH ADJACENT WALL FACE.
2	INFILL OPENING WITH WALL CONSTRUCTION TO MATCH SURROUNDING/ADJACENT WALL CONSTRUCTION. VERIFY EXISTING WALL CONDITIONS/CONSTRUCTION AND DIMENSIONS IN THE FIELD. ALIGN THE FACE OF THE NEW INFILL WALL WITH THE ADJACENT EXISTING WALL FACE.
3	ACCESS CARD READER. REFERENCE T-SERIES DRAWINGS.
4	RELOCATED PA SYSTEM CABINET. SEE T-SERIES DRAWINGS.
5	084113 - PROVIDE STOREFRONT SYSTEM INTO EXISTING WALL OPENING. VERIFY DIMENSIONS AND EXISTING WALL CONDITIONS IN THE FIELD.
6	096466 - WOOD ATHLETIC FLOORING SYSTEM. REFERENCE I-SERIES DWGS FOR COURT STRIPING LOCATION AND COLORS.
7	1102123 - CUBICLE CURTAINS AND TRACK SYSTEM.
8	1126600 - TELESCOPING BLEACHER SYSTEM.
9	099123 - CLEAN, PREP AND REPAINT EXISTING METAL LOCKER WITH ELECTROSTATIC PAINT SYSTEM.
10	PROVIDE AUDITORIUM SEATING AND FLOOR FINISH. SEE I-SERIES DWGS.
11	EXTEND EXISTING WALL TO DECK. SEE 10A-320.
12	085653 - SECURITY SLIDING GLASS WINDOW W1. SEE FRAME ELEVATION ON SHEET A-600.
13	INSTALL SALVAGED LOCKERS TO THIS LOCATION. CONTRACTOR SHALL VERIFY ALL DIMENSIONS AND EXISTING WALL CONDITIONS IN THE FIELD.
14	092900 - PREP EXISTING CMU WALL AND ADHERE TILE BACKER PANEL TO EXISTING WALL FROM CEILING TO FLOOR. PREP TILE BACKER PANEL FOR NEW TILE FINISH. REFERENCE I-SERIES DWGS.
15	096623 - REPAIR EXISTING CONCRETE SLAB AND TERRAZZO FLOORING. SEE P-SERIES DWGS AND I-SERIES DWGS.
16	033000 - PROVIDE CONCRETE FLOOR SLAB/INFILL TO BRING FLOOR SLAB TO MATCH THE HEIGHT OF THE EXISTING FIRST FLOOR LEVEL AND LEVEL WITH THE ADJACENT FLOORS. SEE S-SERIES DWGS. PREP FLOOR SURFACE FOR NEW FLOORING. SEE I-SERIES DWGS FOR NEW FINISH.
17	CLEAN, PREP, PRIME AND PAINT EXISTING NEW STRUCTURAL GLAZE TILE WALL SURFACE TO LIMITS INDICATED (FLOOR TO CEILING).

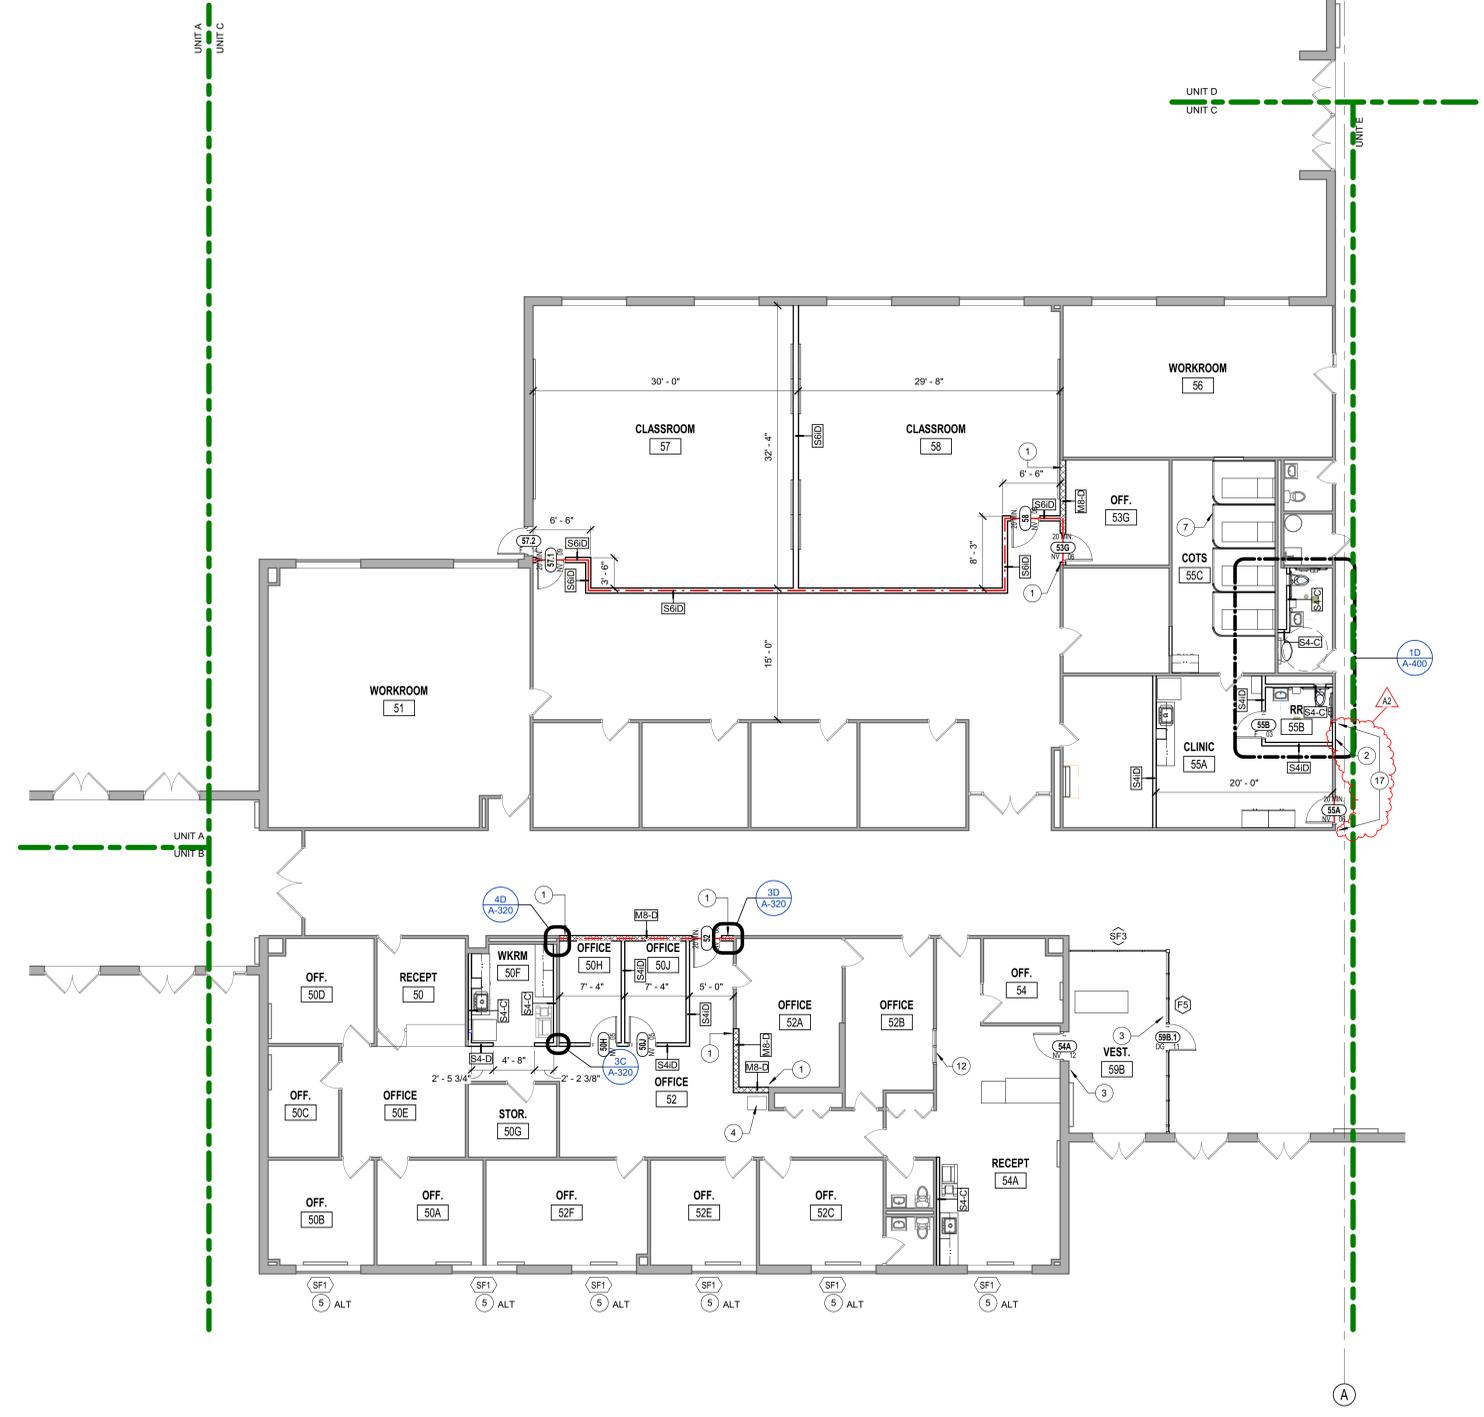

2A FIRST FLOOR PLAN - UNIT C
1/8" = 1'-0"




Project No. 2020-154.SMS
Project Date 07.26.2021
Produced TYN



These Drawings and Specifications, and all copies thereof are and shall remain the property and copyright of the Architect. They shall be used only with respect to this Project and are not to be used on any other Project or Work without prior written permission from the Architect.

#	Revision	Date
A2	Revision 2	8/18/2021

3635 173rd Street
Hammond, IN 46323

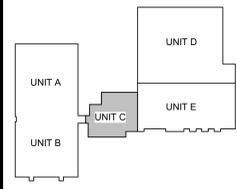

KEY PLAN

School City of Hammond



Scott Middle School - Renovations

FIRST FLOOR PLAN - UNIT C

AF1C1

6 5 4 3 2 1

10/22/21 10:23:28 AM
 2020-154.SMS
 10/22/21 10:23:28 AM
 2020-154.SMS
 10/22/21 10:23:28 AM
 2020-154.SMS

6 5 4 3 2 1

#	Note
1	ALIGN FACE OF NEW WALL/INFILL WITH ADJACENT WALL FACE.
2	INFILL OPENING WITH WALL CONSTRUCTION TO MATCH SURROUNDING/ADJACENT WALL CONSTRUCTION. VERIFY EXISTING WALL CONDITIONS/CONSTRUCTION AND DIMENSIONS IN THE FIELD. ALIGN THE FACE OF THE NEW INFILL WALL WITH THE ADJACENT EXISTING WALL FACE.
3	ACCESS CARD READER. REFERENCE T-SERIES DRAWINGS.
4	RELOCATED PA SYSTEM CABINET. SEE T-SERIES DRAWINGS.
5	084113 - PROVIDE STOREFRONT SYSTEM INTO EXISTING WALL OPENING. VERIFY DIMENSIONS AND EXISTING WALL CONDITIONS IN THE FIELD.
6	096466 - WOOD ATHLETIC FLOORING SYSTEM. REFERENCE I-SERIES DWGS FOR COURT STRIPING LOCATION AND COLORS.
7	102123 - CUBICLE CURTAINS AND TRACK SYSTEM.
8	126800 - TELESCOPING BLEACHER SYSTEM.
9	099123 - CLEAN, PREP AND REPAINT EXISTING METAL LOCKER WITH ELECTROSTATIC PAINT SYSTEM.
10	PROVIDE AUDITORIUM SEATING AND FLOOR FINISH. SEE I-SERIES DWGS.
11	EXTEND EXISTING WALL TO DECK. SEE 10A-A-320.
12	085653 - SECURITY SLIDING GLASS WINDOW W/1. SEE FRAME ELEVATION ON SHEET A-600.
13	INSTALL SALVAGED LOCKERS TO THIS LOCATION. CONTRACTOR SHALL VERIFY ALL DIMENSIONS AND EXISTING WALL CONDITIONS IN THE FIELD.
14	092900 - PREP EXISTING CMU WALL AND ADHERE TILE BACKER PANEL TO EXISTING WALL FROM CEILING TO FLOOR. PREP TILE BACKER PANEL FOR NEW TILE FINISH. REFERENCE I-SERIES DWGS.
15	096623 - REPAIR EXISTING CONCRETE SLAB AND TERRAZZO FLOORING. SEE P-SERIES DWGS AND I-SERIES DWGS.
16	033000 - PROVIDE CONCRETE FLOOR SLAB/INFILL TO BRING FLOOR SLAB TO MATCH THE HEIGHT OF THE EXISTING FIRST FLOOR LEVEL AND LEVEL WITH THE ADJACENT FLOORS. SEE S-SERIES DWGS. PREP FLOOR SURFACE FOR NEW FLOORING. SEE I-SERIES DWGS FOR NEW FINISH.
17	CLEAN, PREP, PRIME AND PAINT EXISTING NEW STRUCTURAL GLAZE TILE WALL SURFACE TO LIMITS INDICATED (FLOOR TO CEILING).




Project No. 2020-154.SMS
 Project Date 07.26.2021
 Produced TYN



These Drawings and Specifications, and all copies thereof are and shall remain the property and copyright of the Architect. They shall be used only with respect to this Project and are not to be used on any other Project or Work without prior written permission from the Architect.

#	Revision	Date
A2	Revision 2	8/18/2021

3635 173rd Street
 Hammond, IN 46323

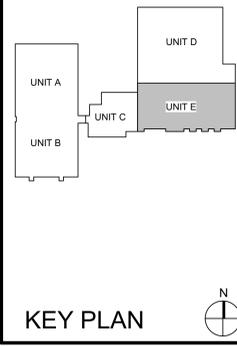


School City of Hammond



Scott Middle School - Renovations

FIRST FLOOR PLAN - UNIT E

AF1E1

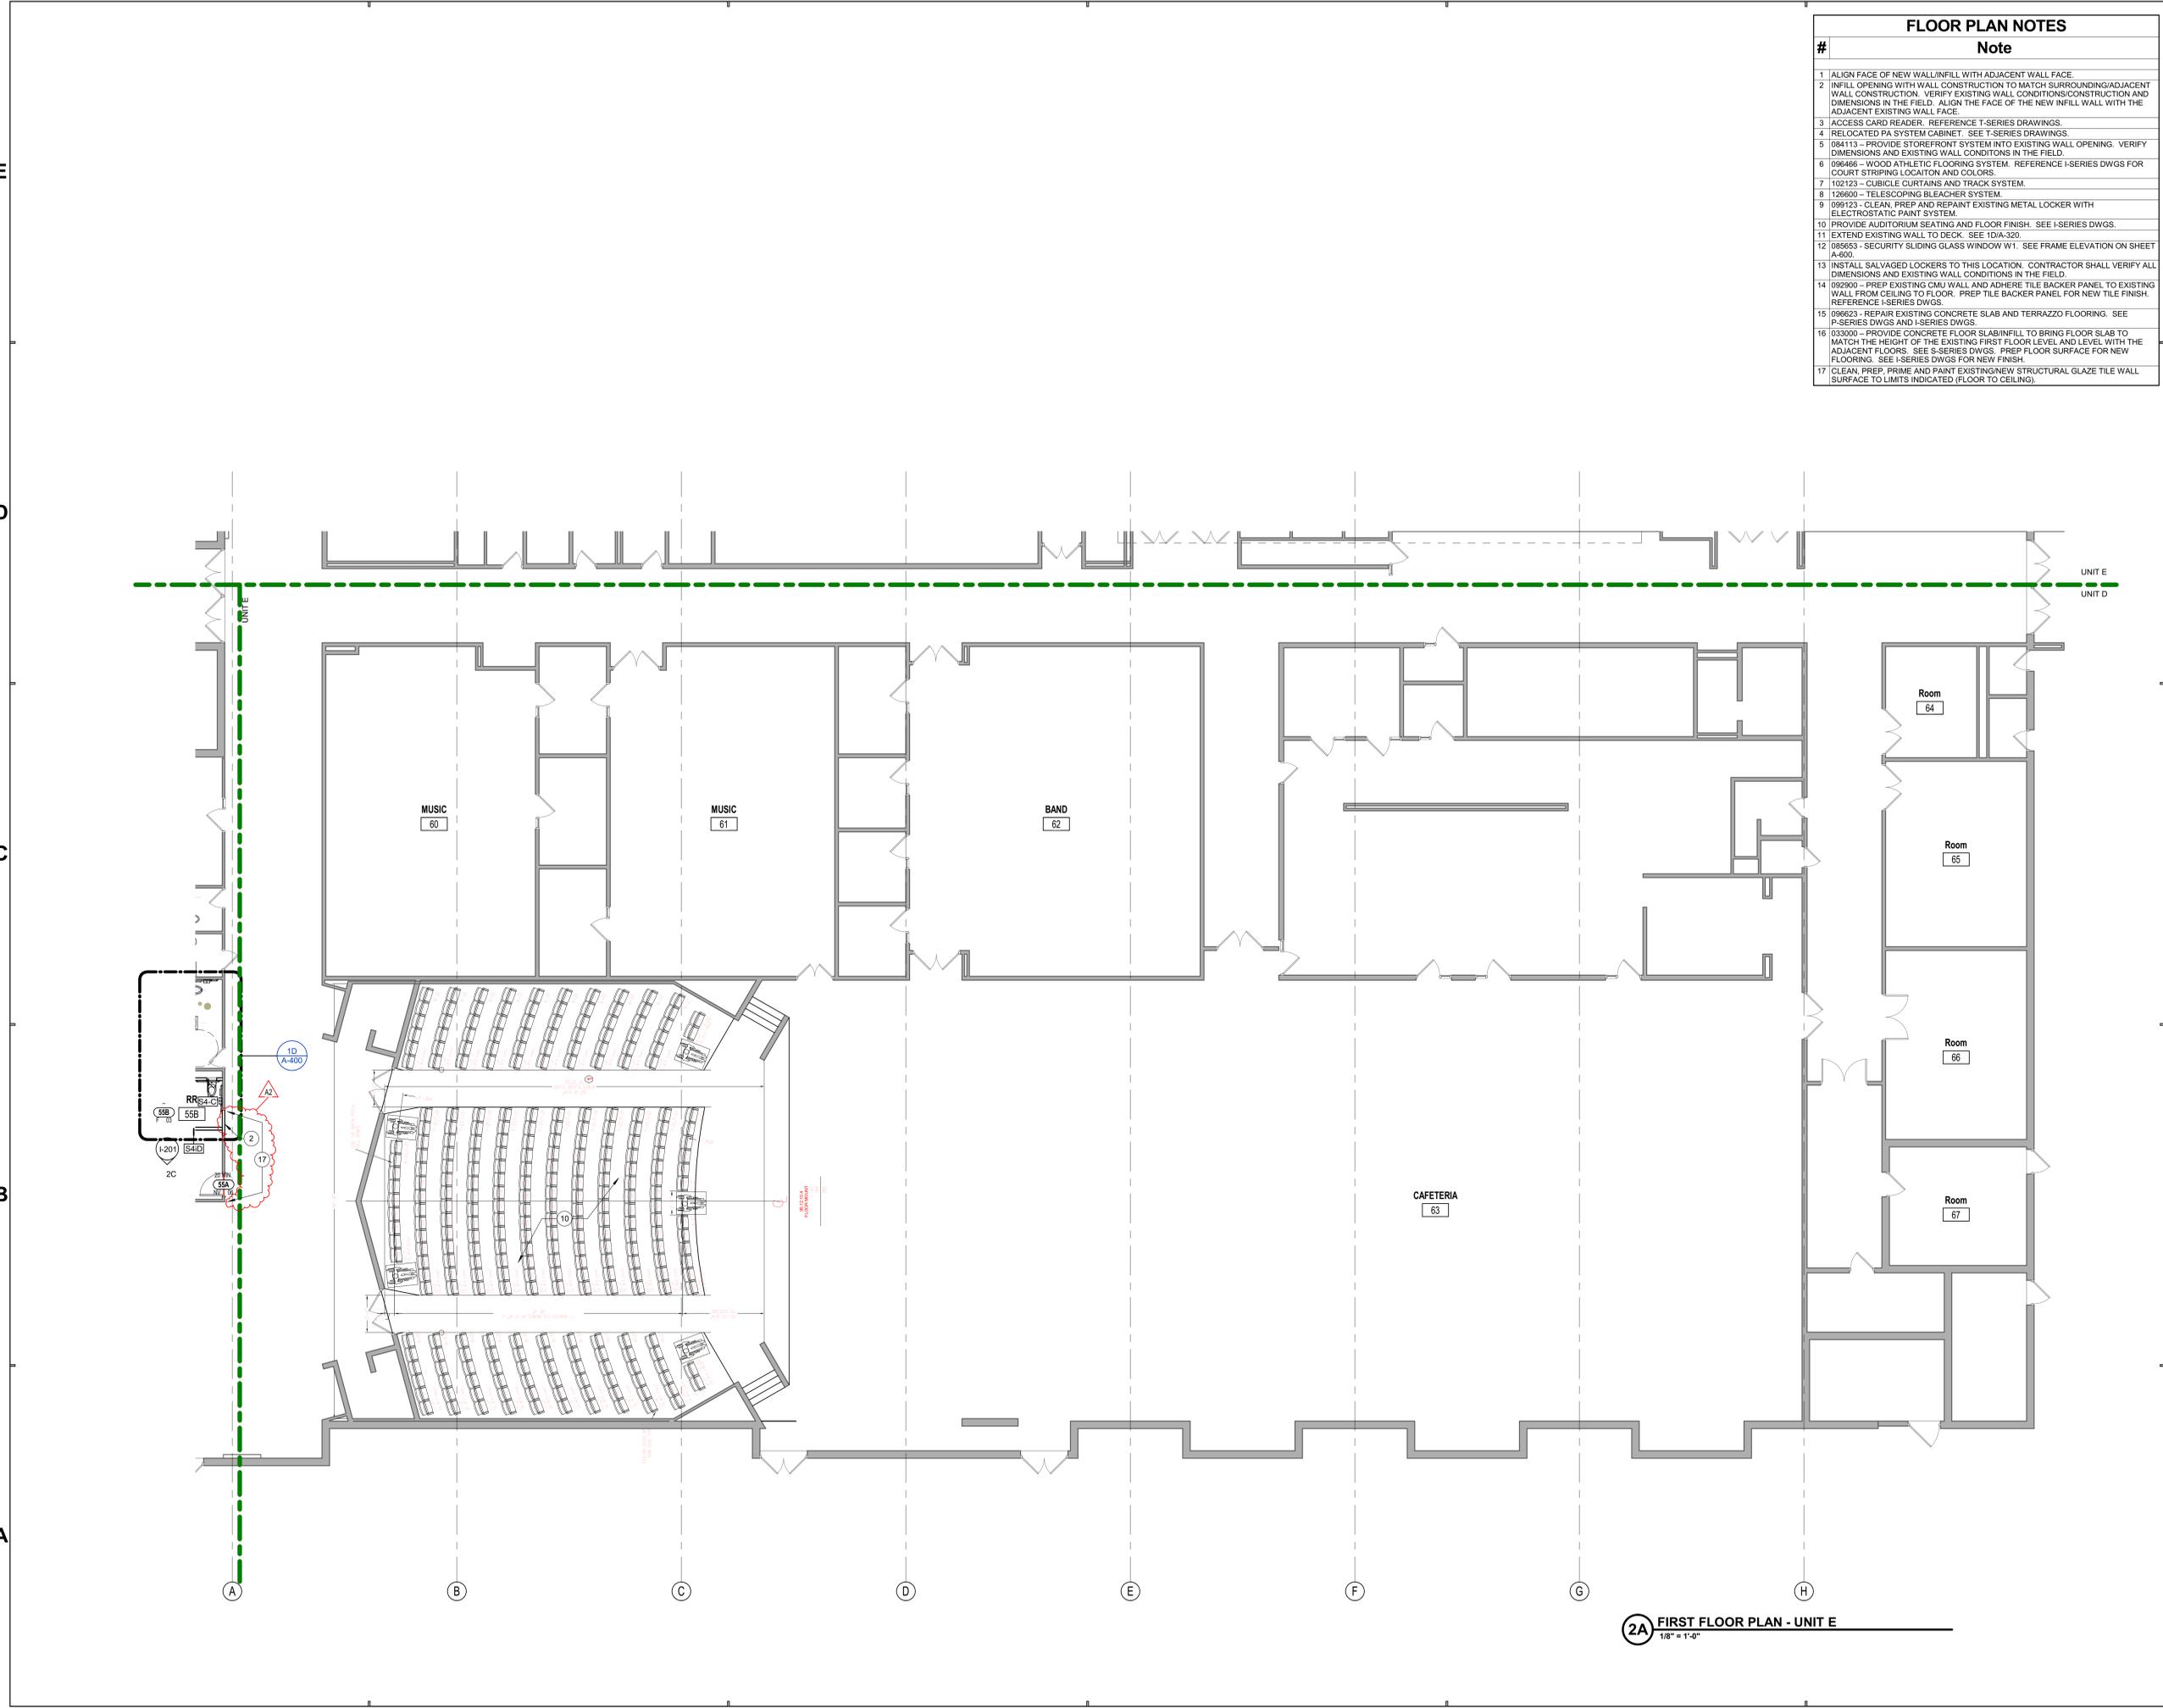

2A FIRST FLOOR PLAN - UNIT E
 1/8" = 1'-0"

8/18/2021 10:45 AM
 2020-154.SMS
 3635 173rd Street Hammond, IN 46323
 SCHMIDT ASSOCIATES ARCHITECTS

6

5

4

3

2

1


E

D

C

B

A

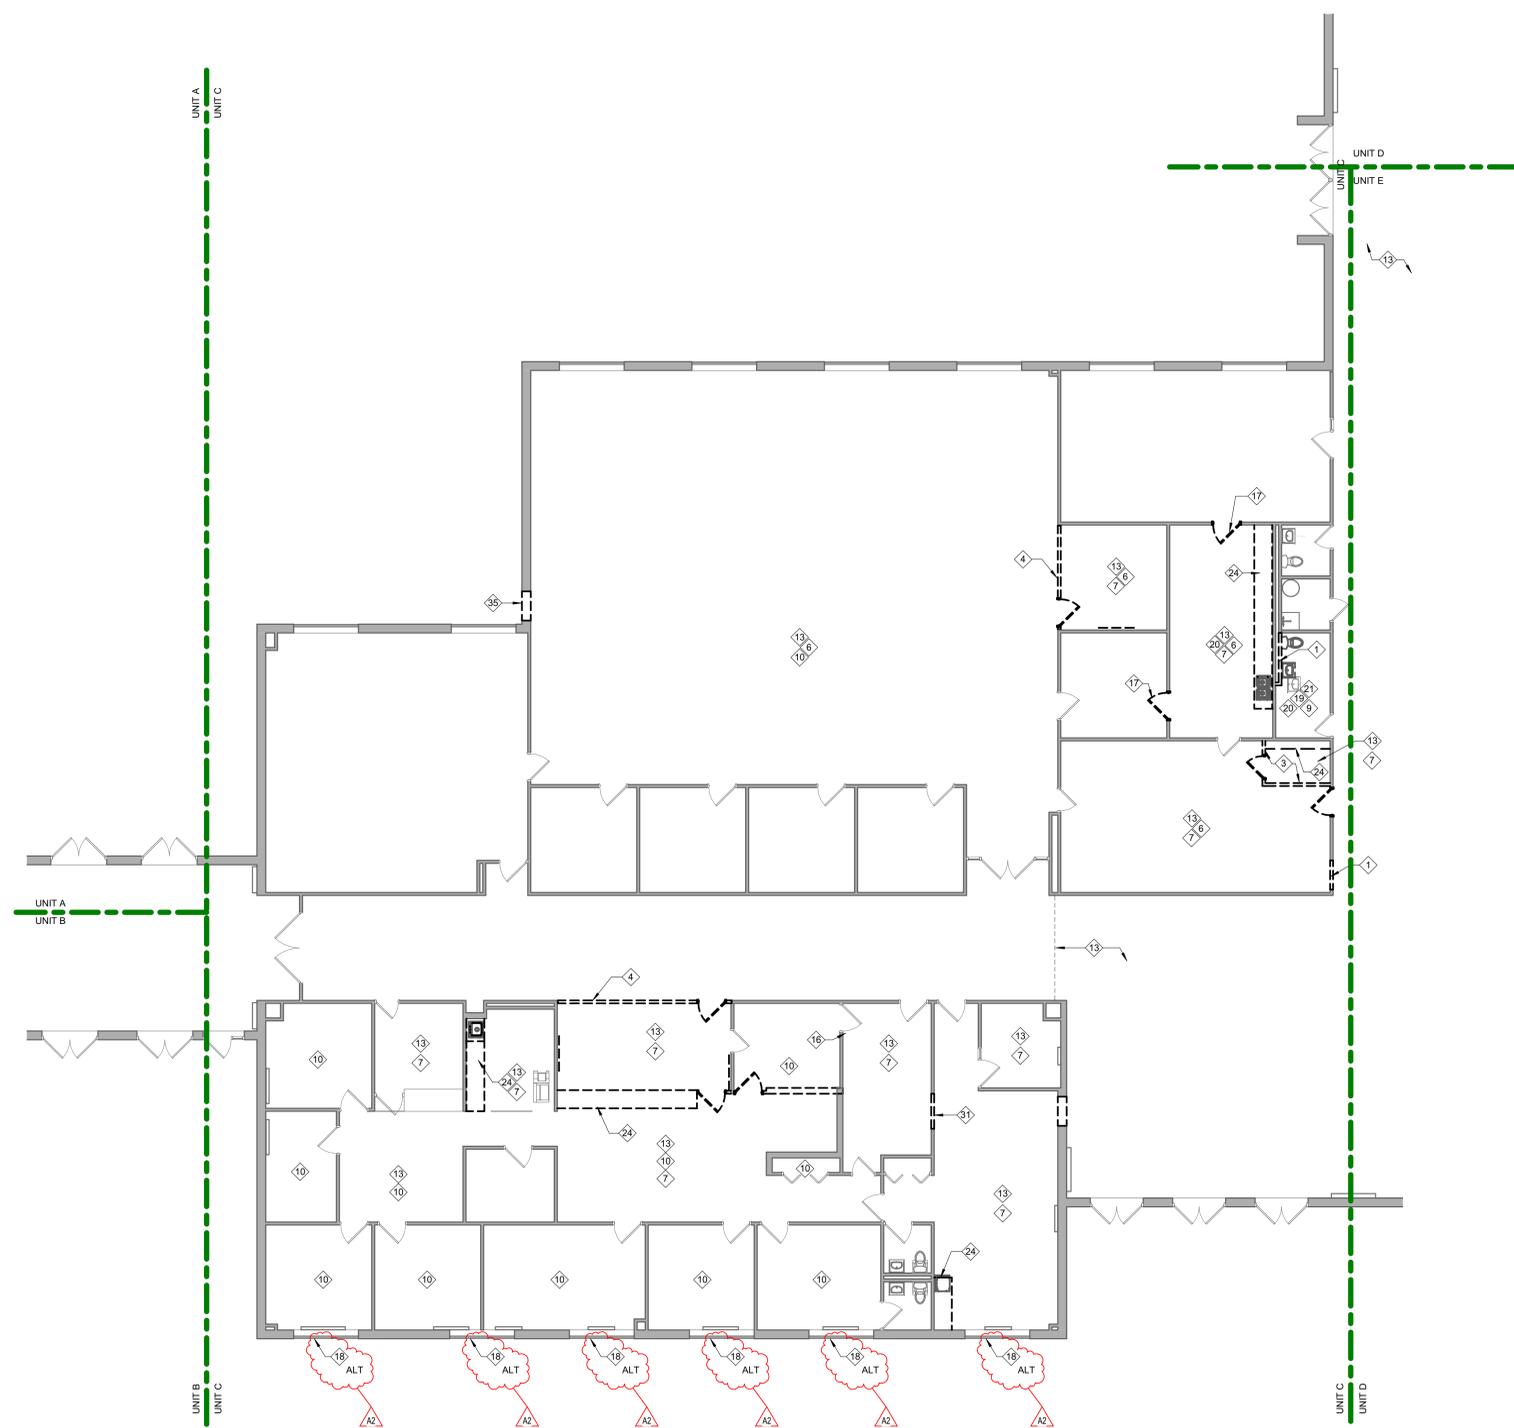


3A FIRST FLOOR DEMOLITION PLAN - UNIT C
1/8" = 1'-0"

DEMOLITION FLOOR PLAN NOTES	
#	NOTE
1	REMOVE EXISTING INTERIOR MASONRY WALL CONSTRUCTION IN ITS ENTIRETY TO LIMITS INDICATED INCLUDING, BUT NOT LIMITED TO DOORS, FRAMES, DEVICES AND ALL MISCELLANEOUS FRAMING. FIELD VERIFY ALL EXISTING WALL CONSTRUCTION PRIOR TO DEMOLITION. REFER TO ARCHITECTURAL AND INTERIOR FLOOR PLANS FOR FINISH CONDITIONS AND DIMENSIONS. NEW CONSTRUCTION TO TOOTH-IN TO EXISTING MASONRY COURSING WHERE APPLICABLE. PATCH AND REPAIR EXISTING ADJACENT SURFACES TO REMAIN AND PREP FOR NEW CONSTRUCTION.
2	REMOVE EXISTING INTERIOR MASONRY WALL CONSTRUCTION IN ITS ENTIRETY TO LIMITS INDICATED INCLUDING, BUT NOT LIMITED TO DOORS, FRAMES, WINDOWS AND ALL MISCELLANEOUS FRAMING. FIELD VERIFY ALL EXISTING WALL CONSTRUCTION PRIOR TO DEMOLITION. REFER TO ARCHITECTURAL AND INTERIOR FLOOR PLANS FOR FINISH CONDITIONS AND DIMENSIONS. NEW CONSTRUCTION TO TOOTH-IN TO EXISTING MASONRY COURSING WHERE APPLICABLE. PATCH AND REPAIR EXISTING ADJACENT SURFACES TO REMOAN AND PREP FOR NEW CONSTRUCTION. SEE DEMO WALL SECTION XXAD311.
3	REMOVE EXISTING INTERIOR WALL CONSTRUCTION IN ITS ENTIRETY TO LIMITS INDICATED INCLUDING, BUT NOT LIMITED TO DOORS, FRAMES, WINDOWS AND ALL MISCELLANEOUS FRAMING. FIELD VERIFY ALL EXISTING WALL CONSTRUCTION PRIOR TO DEMOLITION. REFER TO ARCHITECTURAL AND INTERIOR FLOOR PLANS FOR FINISH CONDITIONS AND DIMENSIONS. PATCH AND REPAIR EXISTING ADJACENT SURFACES TO REMAIN AND PREP FOR NEW CONSTRUCTION.
4	REMOVE EXISTING INTERIOR WOOD WINDOW WALL IN ITS ENTIRETY INCLUDING, BUT NOT LIMITED TO DOORS, FRAMES, WINDOWS AND ALL MISCELLANEOUS FRAMING. FIELD VERIFY ALL EXISTING WALL CONSTRUCTION PRIOR TO DEMOLITION. REFER TO ARCHITECTURAL AND INTERIOR FLOOR PLANS FOR FINISH CONDITIONS AND DIMENSIONS. PATCH AND REPAIR EXISTING ADJACENT SURFACES TO REMAIN AND PREP FOR NEW CONSTRUCTION.
5	REMOVE EXISTING WOOD/GYPSUM WALL PANEL SYSTEM IN ITS ENTIRETY INCLUDING THE WALL PANEL AND ALL RELATED FRAMING AND SUPPORTS. EXPOSE THE EXISTING LOCKER CAVITY AND PREP FOR INSTALLATION OF RELOCATED LOCKERS. CONTRACTOR SHALL TAKE CARE NOT TO DAMAGE THE EXISTING CLERESTORY WINDOW SYSTEM OR THE EXISTING TERRAZZO WALL BASE.
6	PREP ALL EXISTING WALL SURFACES FOR NEW FINISH. SEE I-SERIES DRAWINGS FOR NEW CONSTRUCTION/FINISH.
7	REMOVE EXISTING VAT FLOORING IN ITS ENTIRETY INCLUDING, BUT NOT LIMITED TO THE VAT, ADHESIVES, TRANSITION STRIPS AND ALL ASSOCIATED WALL BASE. PATCH AND REPAIR EXISTING SURFACES TO REMAIN AND PREP FOR NEW CONSTRUCTION/FINISH. CONTRACTOR SHALL REMOVE AND DISPOSE OF EXISTING VAT PER LOCAL, STATE AND FEDERAL REQUIREMENTS.
8	REMOVE EXISTING VCT FLOORING IN ITS ENTIRETY INCLUDING, BUT NOT LIMITED TO THE VCT, ADHESIVES, TRANSITION STRIPS AND ALL ASSOCIATED WALL BASE. PATCH AND REPAIR EXISTING SURFACES TO REMAIN AND PREP FOR NEW CONSTRUCTION/FINISH.
9	REMOVE EXISTING CERAMIC TILE FLOORING IN ITS ENTIRETY INCLUDING, BUT NOT LIMITED TO THE CERAMIC TILE, GROUT, ADHESIVE AND RELATED WALL BASE. PATCH AND REPAIR EXISTING FLOOR SLAB AND WALL SURFACE FOR NEW CONSTRUCTION/FINISH.
10	REMOVE EXISTING CARPET FLOOR FINISH IN ITS ENTIRETY INCLUDING, BUT NOT LIMITED TO THE CARPET, ADHESIVES/TACK STRIPS, TRANSITION STRIPS AND ALL ASSOCIATED WALL BASE. PATCH AND REPAIR EXISTING SURFACES TO REMAIN AND PREP FOR NEW CONSTRUCTION/FINISH.
11	REMOVE EXISTING WOOD ATHLETIC FLOORING SYSTEM IN ITS ENTIRETY INCLUDING BUT NOT LIMITED TO THE WOOD FLOORBOARD, WOOD SUBFLOOR, VENTED WALL BASE, THRESHOLDS AND ALL RELATED ANCHORS. PREP EXISTING CONCRETE FLOOR AND WALL SURFACES TO REMAIN FOR NEW CONSTRUCTION/FINISH.
13	REMOVE EXISTING SUSPENDED LAY-IN PANEL CEILING SYSTEM IN ITS ENTIRETY INCLUDING, BUT NOT LIMITED TO THE CEILING PADS, GRID, SUSPENSION WIRES, AND ALL RELATED ANCHORS. PATCH AND REPAIR EXISTING SURFACES TO REMAIN AND PREP FOR NEW CONSTRUCTION/FINISH.
14	REMOVE EXISTING SUSPENDED METAL ACOUSTICAL CEILING SYSTEM IN ITS ENTIRETY INCLUDING, BUT NOT LIMITED TO THE METAL CEILING PANELS, GRIDS, INSULATION, SUSPENSION WIRES, AND ALL RELATED ANCHORS. PATCH AND REPAIR EXISTING SURFACES TO REMAIN AND PREP FOR NEW CONSTRUCTION/FINISH.
15	REMOVE EXISTING DOOR AND ALL RELATED HARDWARE. PROTECT EXISTING DOOR FRAME TO REMAIN. PREP EXISTING DOOR FRAME FOR NEW CONSTRUCTION.
16	REMOVE EXISTING DOOR SYSTEM IN ITS ENTIRETY INCLUDING, BUT NOT LIMITED TO THE DOOR, FRAME, SIDELIGHTS, GLAZING, HARDWARE AND ALL RELATED ANCHORS. PREP EXISTING OPENING FOR NEW CONSTRUCTION. PATCH AND REPAIR ALL ADJACENT SURFACES TO REMAIN FOR NEW CONSTRUCTION/FINISH.
17	REMOVE EXISTING DOOR SYSTEM IN ITS ENTIRETY INCLUDING, BUT NOT LIMITED TO THE DOOR, FRAME, SIDELIGHTS, TRANSOM, GLAZING, HARDWARE AND ALL RELATED ANCHORS. PREP EXISTING OPENING FOR NEW CONSTRUCTION. PATCH AND REPAIR ALL ADJACENT SURFACES TO REMAIN FOR NEW CONSTRUCTION/FINISH.
18	REMOVE EXISTING CURTAIN WALL SYSTEM IN ITS ENTIRETY INCLUDING, BUT NOT LIMITED TO THE GLAZING, FRAMING, SEALANTS, HARDWARE, BLINDS AND ALL RELATED ANCHORS. PATCH AND REPAIR ADJACENT SURFACES TO REMAIN AND PREP FOR NEW CONSTRUCTION/FINISH.
19	REMOVE EXISTING TOILET PARTITIONS AND URINAL PARTITIONS IN THEIR ENTIRETY. PATCH AND REPAIR EXISTING SURFACES TO REMAIN AND PREP FOR NEW CONSTRUCTION/FINISH.
20	REMOVE EXISTING TOILETS, SINKS, URINALS AND ALL RELATED ACCESSORIES IN THEIR ENTIRETY INCLUDING, BUT NOT LIMITED TO TOILET PAPER DISPENSERS, GRAB BARS, MIRRORS AND SOAP DISPENSERS. PATCH AND REPAIR ALL EXISTING SURFACES TO REMAIN. PREP FOR NEW CONSTRUCTION/FINISH. SEE P-SERIES DRAWINGS FOR PLUMBING SCOPE.
21	REMOVE EXISTING GYP PLASTER CEILING SYSTEM IN ITS ENTIRETY. PREP EXISTING SURFACES TO REMAIN FOR NEW CONSTRUCTION/CEILING SYSTEM.
22	REMOVE EXISTING WASHFOUNTAIN IN ITS ENTIRETY. PREP EXISTING WALL SURFACE TO REMAIN FOR NEW CONSTRUCTION/FINISH. SEE P-SERIES DWGS.
23	REMOVE EXISTING DRINKING FOUNTAIN(S) IN ITS ENTIRETY INCLUDING, BUT NOT LIMITED TO THE DRINKING FOUNTAIN, SEALANTS, PIPING, POWER AND ALL RELATED ANCHORS. PATCH AND REPAIR EXISTING WALL TO REMAIN. PREP FOR NEW CONSTRUCTION/FINISH. SEE P-SERIES DRAWINGS.
24	REMOVE EXISTING CASEWORK IN ITS ENTIRETY INCLUDING, BUT NOT LIMITED TO WALL CABINETS, BASE CABINETS, COUNTERTOPS, FILL PANELS, SINKS AND ALL RELATED TRIMS. PATCH AND REPAIR ALL EXISTING ADJACENT SURFACES TO REMAIN AND PREP FOR NEW CONSTRUCTION/FINISH.
25	REMOVE EXISTING METAL LOCKERS FOR RELOCATION. CONTRACTOR SHALL REMOVE EXISTING METAL LOCKER BANK WITH CARE AND PREP LOCKERS FOR REINSTALLATION.
26	REMOVE EXISTING WALL MOUNTED TACK BOARDS, MARKERBOARDS, CHALKBOARDS ADHESIVES, BRACKETS, ANCHORS AND ALL RELATED ACCESSORIES IN THEIR ENTIRETY. PATCH AND REPAIR EXISTING SURFACES TO REMAIN AND PREP FOR NEW CONSTRUCTION/FINISH. SEE I-SERIES AND H-SERIES DRAWINGS.
27	REMOVE ALL EXISTING AUDITORIUM SEATS IN ITS ENTIRETY. PATCH EXISTING FLOOR AS REQUIRED AND PREP FOR NEW CONSTRUCTION.
28	REMOVE EXISTING WOOD SUBFLOOR AND SLEEPER SUPPORT SYSTEM IN ITS ENTIRETY DOWN TO THE EXISTING TILED POOL DECK AND POOL TANK. REMOVE THE EXISTING POOL DECK TILE AND THICKSET MORTAR BED DOWN TO THE EXISTING CONCRETE FLOOR SLAB AND PREP FOR NEW CONSTRUCTION.
29	REMOVE ALL EXISTING POOL EQUIPMENT INCLUDING BUT NOT LIMITED TO THE STAINLESS STEEL POOL GUTTER, EQUIPMENT INSERTS/SLEEVES. CORE-DRILL HOLES AT BOTTOM OF EXISTING POOL SLABS. REFER TO S-SERIES DWGS.
30	REMOVE ALL EXISTING TILE AND GROUT DOWN TO THE EXISTING CONCRETE FLOOR SLAB. PREP CONCRETE SLAB FOR NEW INFILL.
31	REMOVE EXISTING WALL AS REQUIRED FOR INSTALLATION OF NEW TRANSACTION WINDOW. SEE FLOOR PLANS.
32	REMOVE EXISTING GYPSUM BOARD CEILING SYSTEM IN ITS ENTIRETY INCLUDING, BUT NOT LIMITED TO THE GYPSUM BOARD, SUSPENDED FRAMING AND ALL RELATED ANCHORS/FASTENERS. PATCH AND REPAIR EXISTING SURFACES TO REMAIN AND PREP FOR NEW CONSTRUCTION/FINISH.
33	REMOVE EXISTING MOTORIZED TELESCOPING GYMNASIUM BLEACHER SYSTEM IN ITS ENTIRETY. DISCONNECT ALL EXISTING POWER AS REQUIRED. PREP EXISTING WALL SURFACES TO REMAIN FOR NEW CONSTRUCTION/FINISH.
34	REMOVE EXISTING SHOWER COLUMN IN ITS ENTIRETY. SEE P-SERIES DWGS. PATCH EXISTING FLOOR TO MATCH ADJACENT FLOOR.
35	REMOVE EXISTING EXTERIOR WALLS CONSTRUCTION TO 8" BELOW FINISH FLOOR IN ITS ENTIRETY TO ACCOMMODATE NEW DOOR SYSTEM. SEE FLOOR PLAN FOR NEW WORK.
36	REMOVE EXISTING EXISTING TERRAZZO FLOORING AND CONCRETE FLOOR SLAB FOR PLUMBING. SEE P-SERIES DWGS FOR FINAL LOCATION AND SIZE.




Project No. 2020-154.SMS
Project Date 07.26.2021
Produced TYN

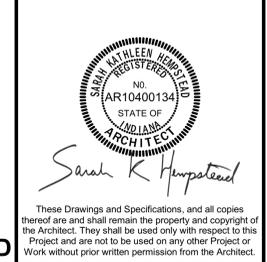

#	Revision	Date
A2	Revision 2	8/18/2021

3635 173rd Street
Hammond, IN 46323

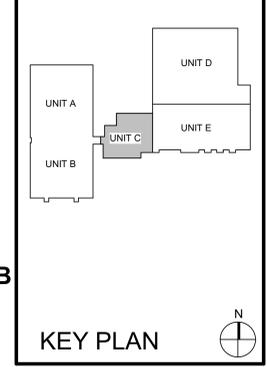

Scott Middle School
- Renovations

FIRST FLOOR
DEMOLITION PLAN - UNIT
C
AD1C1

6

5

4

3

2

1



SCHMIDT ASSOCIATES
 415 Massachusetts Avenue
 Indianapolis, IN 46204
 www.schmidt-arch.com


Project No. 2020-154.SMS
 Project Date 07.26.2021
 Produced TYN



Sarah K. Hempstead

These Drawings and Specifications, and all copies thereof are and shall remain the property and copyright of the Architect. They shall be used only with respect to this Project and are not to be used on any other Project or Work without prior written permission from the Architect.

#	Revision	Date
A2	Revision 2	8/18/2021

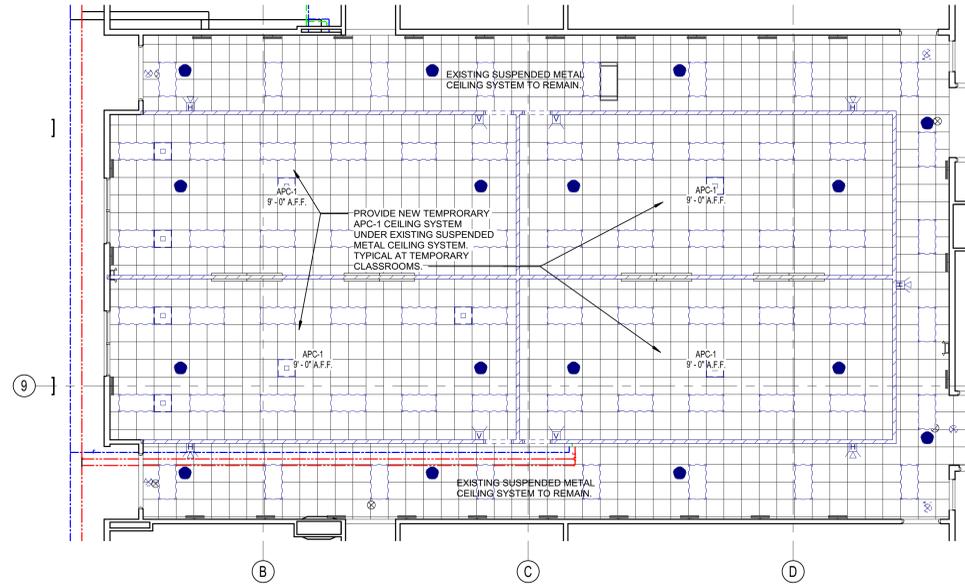


1C TEMPORARY CLASSROOM CEILING PLAN
 1/8" = 1'-0"

TEMPORARY CLASSROOM GENERAL NOTES:


1. DOOR HARDWARE SET FOR TEMPORARY CLASSROOM DOORS
 HARDWARE GROUP NO.
 FOR USE ON DOOR #(S):
 T-01, T-02, T-03, T-04

PROVIDE EACH OPENING WITH THE FOLLOWING:

QTY	DESCRIPTION	CATALOG NUMBER	FINISH	MFR
3	EA HINGE	5BB1HW 4.5 X 4.5	652	IVE
1	EA CLASSROOM SECURITY LOCK	L90771J106A L283-711	626	SCH
2	EA CORE, EVEREST RESTRICTED	23-030 EV D	626	SCH
1	EA KICK PLATE	8400 10" X 1 1/2" LDW B-CS	630	IVE
1	EA MOP PLATE	8400 10" X 1 1/2" LDW B-CS	630	IVE
1	EA WALL STOP	WS406407CVX	630	IVE
3	EA SILENCER	SR64	GRY	IVE

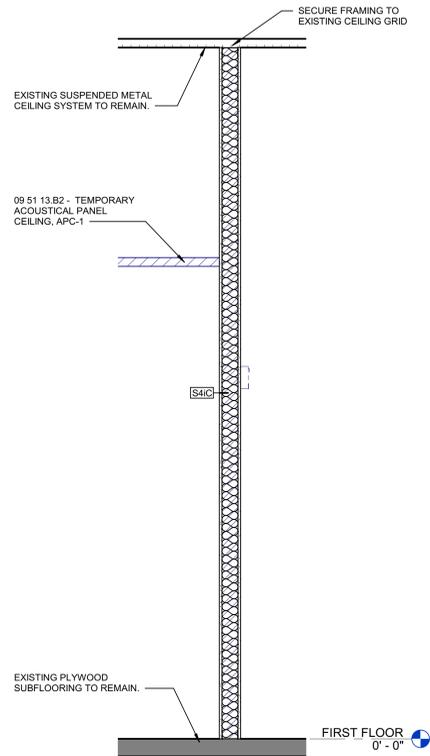


4A TEMPORARY CLASSROOM WALL SECTION
 3/4" = 1'-0"

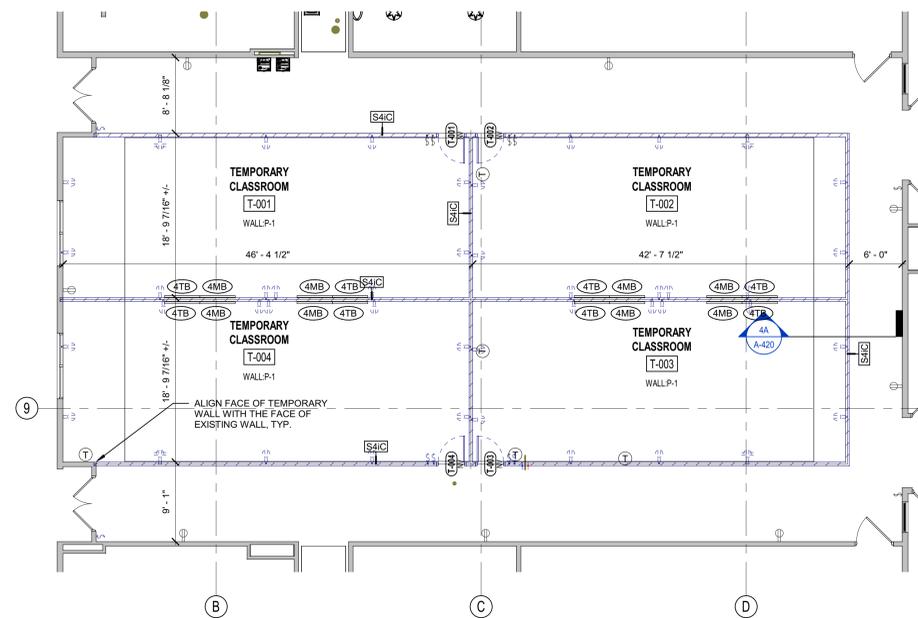

1A TEMPORARY CLASSROOM PLAN
 1/8" = 1'-0"

3635 173rd Street
 Hammond, IN 46323

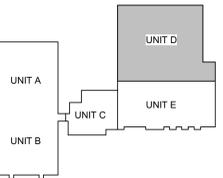

KEY PLAN

School City of Hammond



Scott Middle School
 - Renovations

TEMPORARY CLASSROOM PLAN

A-420

6

5

4

3

2

1

E

D

C

B

A

6

5

4

3

2

1

A-420 - Temporary Classroom Plan
 2020-154.SMS - School City of Hammond - Scott Middle School - Renovations
 08/18/2021 10:58:11 AM
 TYN

#	NOTE
1	COORDINATE WITH CEILING GRID CONTRACTOR TO ENSURE PROPER FIT (33"x33") AND PLACEMENT OF CU-1. PLACEMENT OF CU-1 SHALL NOT BE ADJACENT TO ANY LIGHT FIXTURE.
2	RECONNECT DIFFUSER TO EXISTING DUCTWORK AND BALANCE AS NOTED. CONNECTION TO BE HARD CONNECTION. SEE DETAIL 1A ON M503 FOR EXISTING CONNECTION.
3	EXTEND 16"x10" DUCT AS REQUIRED TO CONNECT NEW 16"10 GRILLE FLUSH WITH NEW WALL.
4	EXTEND 20"x10" DUCT AS REQUIRED TO CONNECT NEW 20"10 GRILLE FLUSH WITH NEW WALL.
5	PROVIDE VOLUME DAMPER IN 6" DUCT DROP.
6	CONNECT NEW DIFFUSER WITH NEW FLEX DUCT AND BALANCE AS NOTED. SEE DETAIL 1A-M-501 FOR EXISTING CONNECTION.
7	INSTALL NEW EGGRATE GRILLE AND ENSURE EXHAUST GRILLE HAS A CLEAR UNOBSTRUCTIVE AIR PATH TO RETURN PLENUM.
8	TO BE PART OF ALTERNATE BID.
9	INSTALL NEW AVERAGING THERMOSTAT TO BE TIED TO 26 THERMOSTAT IN ROOM 57.
10	ROUTE CONDENSATE TO NEAREST FLOOR DRAIN, MOP SINK OR OPEN-SITE DRAIN.
11	ROUTE CONDENSATE TO EXTERIOR OF BUILDING COPPER PIPE TURNED DOWN 4" ABOVE GRADE TO SPLASHBLOCK.





Project No. 2020-154-SMS
 Project Date 07.26.2021
 Produced CSM / CSM



These Drawings and Specifications, and all copies thereof are and shall remain the property and copyright of the Architect. They shall be used only with respect to this Project and are not to be used on any other Project or Work without prior written permission from the Architect.

#	Revision	Date
A2	ADDENDUM #2	08/18/2021

3635 173rd Street
 Hammond, IN 46323

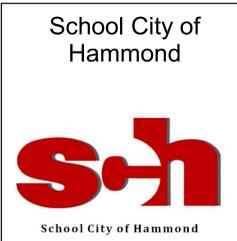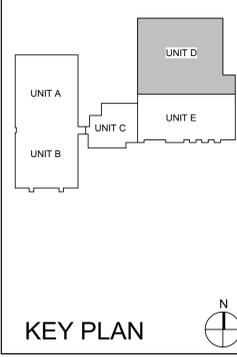

Scott Middle School
 - Renovations

FIRST FLOOR HVAC PLAN
 - UNIT D

MH1D1



2A FIRST FLOOR HVAC PLAN - UNIT D
 1/8" = 1'-0"

DATE: 08/18/2021 10:48 AM
 PROJECT: 2020-154-SMS
 DRAWING: FIRST FLOOR HVAC PLAN - UNIT D
 SHEET: MH1D1

GENERAL HVAC NOTES

A. BLUE DASHED LINES INDICATE TEMPORARY DUCTS, DEVICES AND DIFFUSERS THAT SHALL BE INSTALLED PRIOR TO THE RENOVATION WORK INDICATED ON SHEET M41D1.



SCHMIDT ASSOCIATES
415 Massachusetts Avenue
Indianapolis, IN 46204
www.schmidt-arch.com

Project No. 2020-154.SMS
Project Date 07.26.2021
Produced CSM / CSM




Sarah K. Hempstead

These Drawings and Specifications, and all copies thereof are and shall remain the property and copyright of the Architect. They shall be used only with respect to this Project and are not to be used on any other Project or Work without prior written permission from the Architect.

#	Revision	Date
A2	ADDENDUM #2	08/18/2021

3635 173rd Street
Hammond, IN 46323

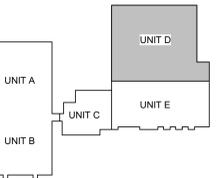

KEY PLAN


School City of Hammond



Scott Middle School - Renovations

HVAC TEMPORARY CLASSROOM WORK - UNIT D

M-420

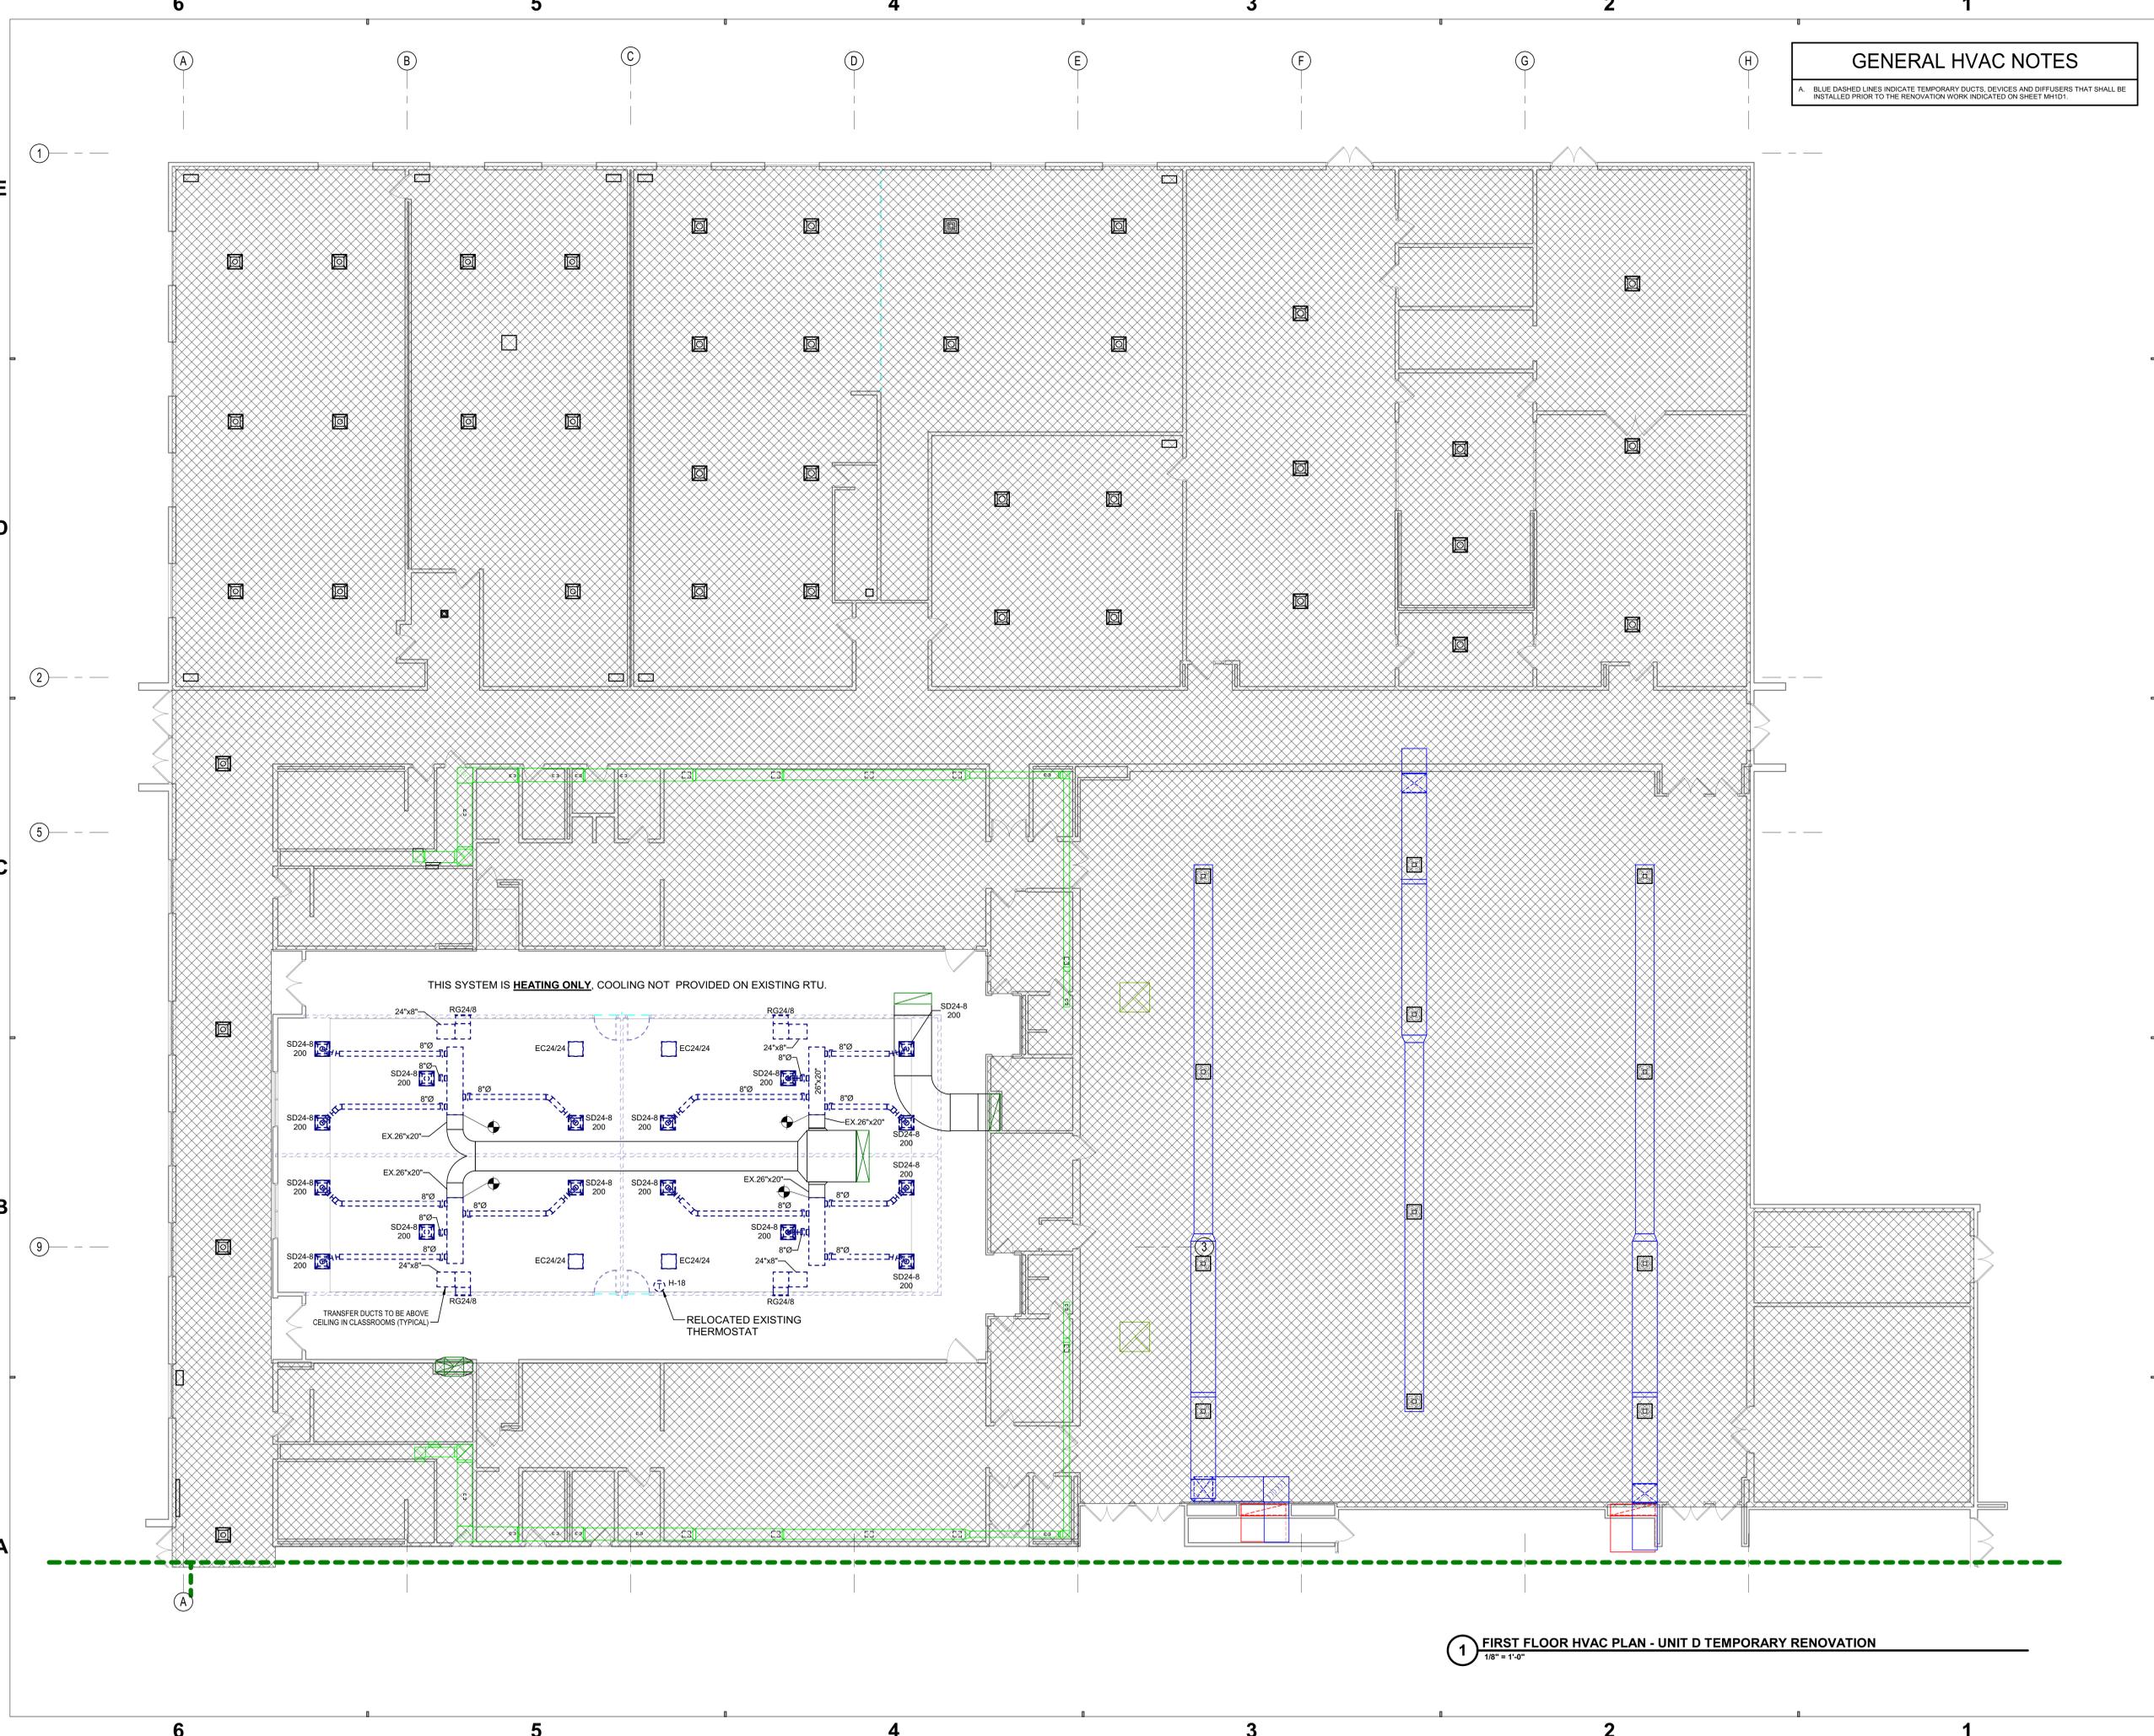

1 FIRST FLOOR HVAC PLAN - UNIT D TEMPORARY RENOVATION
1/8" = 1'-0"

10/20/2021 10:58 AM
 2020-154.SMS
 3635 173rd Street
 Hammond, IN 46323
 317.241.1111
 www.schmidt-arch.com

EXHAUST FAN SCHEDULE - 23 34 23																		
IDENTITY DATA				FAN DATA				SOUND CRITERIA			ELECTRICAL DATA		UNIT CONTROL	NOTES				
MARK	MANUFACTURER	MODEL	SERVICES	WEIGHT (LBS)	FAN TYPE	DRIVE TYPE	AIRFLOW (CFM)	ESP (IN-WG)	RPM	HP	BHP	SONES			DBA	VOLTS (V)	PH	FREQ (HZ)
EF-1	GREENHECK	CUJ-140HP-A	RESTROOMS	67	UPBLAST CENTRIFUGAL	DIRECT	450	1.50	1725	0.50	0.41	14.7	64	115	1	60	OCC SENSOR	1-4
EF-2	GREENHECK	CUJ-140HP-A	RESTROOMS	67	UPBLAST CENTRIFUGAL	DIRECT	450	1.50	1725	0.50	0.41	14.7	64	115	1	60	OCC SENSOR	1-4

- EXHAUST FAN SCHEDULE NOTES:**
- DISCONNECT BY MANUFACTURER.
 - SEE M-700 SERIES SHEETS FOR TEMPERATURE CONTROL INFORMATION.
 - FAN SPEED CONTROLLER FOR BALANCING.
 - INTERLOCK FAN WITH LIGHTING OCCUPANCY SENSOR TO RUN WHILE LIGHTS ARE ENERGIZED AS OCCUPANCY IS SENSED.

SPLIT SYSTEM FAN COIL UNIT SCHEDULE - 23 81 26																																						
INDOOR UNIT													OUTDOOR UNIT																									
IDENTITY DATA			DIMENSIONS			COOLING CAPACITY			AIRFLOW DATA			ELECTRICAL DATA				IDENTITY DATA			COOLING DATA			HEATING DATA			ENERGY DATA			ELECTRICAL DATA				NOTES						
MARK	MANUFACTURER	MODEL	WEIGHT (LBS)	L	W	H	TOTAL (BTUH)	SENSIBLE (BTUH)	CAPACITY (BTUH)	MIN (CFM)	MAX (CFM)	DESIGN (CFM)	EXT. STATIC (IN-WG)	REF. TYPE	VOLTS (V)	PH	FREQ (HZ)	FLA (A)	MOCP (A)	MARK	MODEL	SERIES	WEIGHT (LBS)	NOMINAL (TONS)	AMBIENT (°F)	CAPACITY (BTUH)	AMBIENT (°F)	COP	EER	SEER	REF. TYPE		VOLTS (V)	PH	FREQ (HZ)	MCA (A)	MOCP (A)	
SS-1	DAIKIN	FCQ18TAVJU	63	33"	33"	10"	18,000	16,100	18,000	477	742	500	0.00	R-410A	208	1	60	0.6	15	15	RZQ18TAVJUA	SS-1	172	1.5	95	20,000.0	47	-	13.0	16.6	-	R-410A	208	1	60	16.5	20.0	1.2,3
SS-2	DAIKIN	FCQ24TAVJU	70	33"	33"	11.75"	48,000	35,000	48,000	742	1,218	1,000	0.00	R-410A	208	1	60	1.8	15	15	RZQ24TAVJUA	SS-2	225	4.0	95	54,000.0	47	-	9.0	17.0	-	R-410A	208	1	60	29.1	30.0	1.2,3
SS-3	DAIKIN	FAQ24TAVJU	31	41"	11"	9"	24,000	18,000	24,000	470	635	600	0.00	R-410A	208	1	60	0.6	15	15	RZQ24TAVJUA	SS-3	172	2.0	95	-	-	-	10.2	17.6	-	R-410A	208	1	60	16.5	20.0	1.2,3
SS-4	DAIKIN	FAQ18TAVJU	31	41"	11"	9"	18,000	13,700	24,000	400	500	400	0.00	R-410A	208	1	60	0.5	15	15	RZR18TAVJUA	SS-4	172	1.5	95	-	-	-	11.9	17.0	-	R-410A	208	1	60	16.5	20.0	1.2,3
SS-5	DAIKIN	FAQ18TAVJU	31	41"	11"	9"	18,000	13,700	24,000	400	500	400	0.00	R-410A	208	1	60	0.5	15	15	RZR18TAVJUA	SS-4	172	1.5	95	-	-	-	11.9	17.0	-	R-410A	208	1	60	16.5	20.0	1.2,3

- SPLIT SYSTEMS UNIT SCHEDULE NOTES:**
- PROVIDE SINGLE POINT POWER CONNECTION FOR INDOOR/OUTDOOR UNITS.
 - PROVIDE CONDENSATE REMOVAL PUMP.
 - PROVIDE WITH WIND BAFFLES FOR CONDENSING UNIT.


VAV BOX WITH ELECTRIC REHEAT SCHEDULE - 23 36 00																			
IDENTITY DATA			AIRFLOW DATA				NOISE DATA			REHEAT COIL DATA			ELECTRICAL DATA					NOTES	
MARK	MANUFACTURER	MODEL	INLET DIAMETER	COOLING MAX AIRFLOW (CFM)	HEATING MAX AIRFLOW (CFM)	OCCUPIED MINIMUM AIRFLOW (CFM)	STATIC INLET (IN-WG)	MAX DISCH.	MAX RAD.	EAT (°F)	LAT (°F)	CAPACITY (KW)	STAGES	VOLTS (V)	PH	FREQ (HZ)	MCA (A)		MOCP (A)
VAV-90	KRUEGER	LMHS	14"	2,800	840	840	1.5	30	27	55	91	9.5	1	208	1	60	57.1	60.0	1
VAV-90A	KRUEGER	LMHS	4"	225	225	225	1.5	31	25	55	90	2.5	1	208	1	60	15.0	15.0	1
VAV-91	KRUEGER	LMHS	14"	1,170	230	1,170	1.5	30	14	15	89	2.5	1	208	1	60	15.0	15.0	1
VAV-91A	KRUEGER	LMHS	5"	230	230	230	1.5	25	17	55	89	2.5	1	208	1	60	15.0	15.0	1

- VAV BOX WITH ELECTRIC REHEAT SCHEDULE NOTES:**
- PROVIDE WITH DISCONNECT.

AIR HANDLING UNIT SCHEDULE																		
IDENTITY DATA				DIMENSIONS				SUPPLY FAN				RETURN FAN						
MARK	MANUFACTURER	MODEL	LOCATION	AREA SERVED	WEIGHT (LBS)	L	W	H	AIRFLOW (CFM)	ESP (IN-WG)	RPM	QTY	HP EACH	BHP EACH	RPM	QTY	HP EACH	BHP EACH
H-15	TEMPMASTER	CV2SS3DH2S1CJP12H1	ROOF	UNIT - C	2,555	144"	89"	57"	8,600	1.5	1,209	2	6.1	10.0	1,075	1	0.8	-
H-18	TEMPMASTER	ZQT15N30F4B4B24A4A3	ROOF	UNIT - D	3,000	181"	92"	53"	4,425	0.7	856	2	5.0	5.8	1,768	1	10.0	-

AIR HANDLING UNIT SCHEDULE (CONTINUED)																							
GAS-FIRED HEATING DATA						DX COOLING DATA						DX COOLING COIL DATA						ELECTRICAL DATA					
MARK	INPUT (BTUH)	OUTPUT (BTUH)	EDB (°F)	LDB (°F)	STAGES	TYPE	TOTAL CAP. (BTUH)	SENSIBLE CAP. (BTUH)	EDB (°F)	EWB (°F)	LDB (°F)	LWB (°F)	EER	ROWS	FINS PER IN	FACE AREA (SQFT)	MIN OA (CFM)	VOLTS (V)	PH	FREQ (HZ)	MCA (A)	MOCP (A)	NOTES
H-15	400,000	324,000	-40.0	75.0	2	INDIRECT	292,500	212,800	80.0	67.0	57.1	56.2	10.0	4	14	25.0	7,500	460	3	73.4	90	2.4	
H-18	300,000	240,000	60.0	110.0	2	INDIRECT	177,000	117,000	80.0	67.0	55.5	54.0	12.0	4	15	26.0	-	460	3	37.6	40	1.4	

- AIR HANDLING UNIT SCHEDULE NOTES:**
- PROVIDE WITH 14" ROOF CURB 1RC0437.
 - PROVIDE WITH MERV-13 AIR FILTERS.
 - UNITS PROVIDED WITH RECEPTICLES: 120V 1 PH. BY E.C.
 - BOTH SUPPLY AND RETURN / EXHAUST FAN SUPPLIED WITH VFD FROM FACTORY. WIRED AND PROGRAMMED.

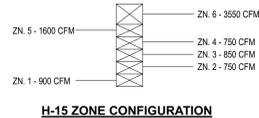

233713 DIFFUSERS, REGISTERS, AND GRILLES - TEMPORARY CLASSROOM WORK								
IDENTITY DATA				NECK SIZE (IN)	MODULE SIZE		MATERIAL	NOTES
MARK	DESCRIPTION	MANUFACTURER	MODEL	Ø	W	L		
EC24/24	EGG CRATE FACE RETURN	PRICE	80		24"	24"	TEMP	
RQ24/8	LOUVER FACE RETURN GRILLE	TITUS	23RL		24"	8"	TEMP	
SD24-8	SQUARE CONE DIFFUSER	PRICE	ASCD	8"	24"	24"	TEMP	

233713 DIFFUSERS, REGISTERS, AND GRILLES									
IDENTITY DATA				NECK SIZE (IN)	MODULE SIZE		MATERIAL	NOTES	
MARK	DESCRIPTION	MANUFACTURER	MODEL	Ø	W	L			
EC9/4	EGG CRATE FACE RETURN	PRICE	80		4"	8"			
EC10/4	EGG CRATE FACE RETURN	PRICE	80		4"	10"			
EC10/8	EGG CRATE FACE RETURN	PRICE	80		6"	10"			
EC12/4	EGG CRATE FACE RETURN	PRICE	80		4"	12"			
EC12/5	EGG CRATE FACE RETURN	PRICE	80		5"	12"			
EC12/6	EGG CRATE FACE RETURN	PRICE	80		6"	12"			
EC12/8	EGG CRATE FACE RETURN	PRICE	80		8"	12"			
EC12/10	EGG CRATE FACE RETURN	PRICE	80		10"	12"			
EC12/12	EGG CRATE FACE RETURN	PRICE	80		12"	12"			
EC24/24	EGG CRATE FACE RETURN	PRICE	80		14"	10"			
EC14/12	EGG CRATE FACE RETURN	PRICE	80		14"	12"			
EC20/12	EGG CRATE FACE RETURN	PRICE	80		20"	12"			
EC24/12	EGG CRATE FACE RETURN	PRICE	80		24"	12"			
EC12/24	EGG CRATE FACE RETURN	PRICE	80		24"	12"			
EC24/24	EGG CRATE FACE RETURN	PRICE	80		24"	24"			
EG12/10	LOUVER FACE GRILLE EXHAUST	PRICE	530		12"	10"			
EG18/10	LOUVER FACE GRILLE EXHAUST	PRICE	530		16"	10"			
EG20/10	LOUVER FACE GRILLE EXHAUST	PRICE	530		20"	10"			
EG12/12	LOUVER FACE GRILLE EXHAUST	PRICE	530		12"	12"			
EG24/24	LOUVER FACE GRILLE EXHAUST	PRICE	630		24"	24"			
SD12-06	SQUARE CONE DIFFUSER	PRICE	ASCD	6"	12"	12"			
SD24-6	SQUARE CONE DIFFUSER	PRICE	ASCD	6"	24"	24"			
SD12-8	SQUARE CONE DIFFUSER	PRICE	ASCD	8"	12"	12"			
SD24-8	SQUARE CONE DIFFUSER	PRICE	ASCD	8"	24"	24"			
SD24-10	SQUARE CONE DIFFUSER	PRICE	ASCD	10"	24"	24"			
SD24-12	SQUARE CONE DIFFUSER	PRICE	ASCD	12"	24"	24"			
SD24-14	SQUARE CONE DIFFUSER	PRICE	ASCD	14"	24"	24"			




Project No. 2020-154-SMS
 Project Date 07.26.2021
 Produced CSM / CSM



These Drawings and Specifications, and all copies thereof are and shall remain the property and copyright of the Architect. They shall be used only with respect to this Project and are not to be used on any other Project or Work without prior written permission from the Architect.

#	Revision	Date
A2	ADDENDUM #2	08/18/2021

3635 173rd Street
 Hammond, IN 46323

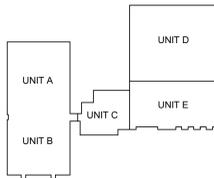


KEY PLAN




Scott Middle School - Renovations

MECHANICAL SCHEDULES


M-601

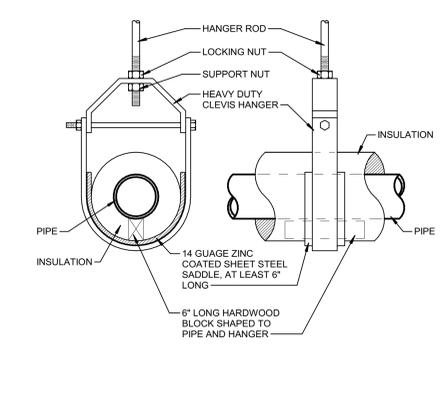


6D PIPE HANGER (6" & SMALLER) DETAIL
NOT TO SCALE

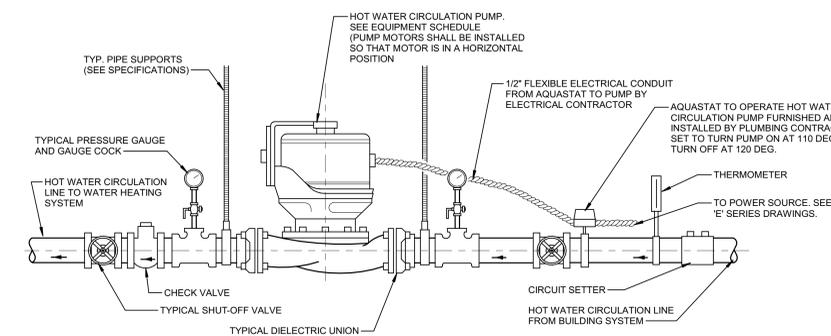


4D HOT WATER RECIRCULATION PUMP
NOT TO SCALE

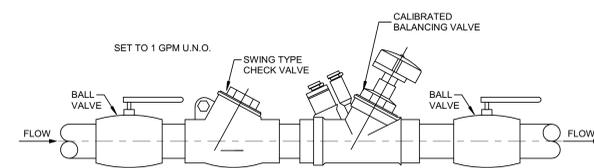

6C HOT WATER BALANCING VALVE STATION DETAIL
NOT TO SCALE

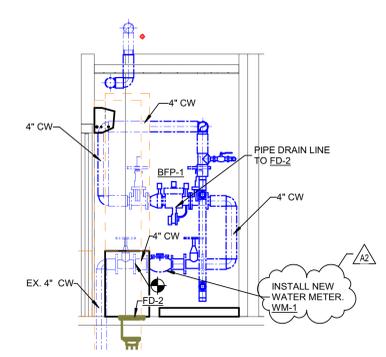

6B DOMESTIC WATER ENTRANCE DETAIL
NOT TO SCALE

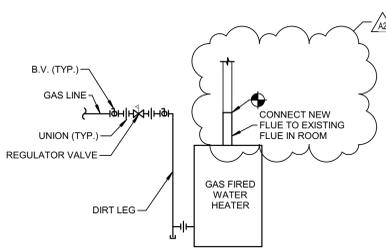

6A WATER HEATER GAS CONNECTION DETAIL
NOT TO SCALE

MIXING, METERING, AND PRESSURE REDUCING VALVES (221119)						
IDENTITY DATA						
MARK	MANUFACTURER	MODEL	DESCRIPTION	FLOW RATE	PRESSURE DROP	
TRP-1	RYAN VALVES	#STRT 982	REDUCED PRESSURE BACKFLOW PREVENTER	315 GPM	150 psi	
TVM-1	SYMONS	#7-200	TEMPERATURE-ACTUATED WATER MIXING VALVE	7 GPM	5.00 psi	
WM-1	BADGER METER		RECORDAL COMPOUND SERIES METER, LEAD-FREE BRONZE ALLOY, 3" WATER METER			

CIRCULATION AND SUMP PUMPS									
IDENTITY DATA				PLUMBING			ELECTRICAL		
MARK	MANUFACTURER	MODEL	DESCRIPTION	FLOW RATE (GPM)	PUMP HEAD (TDH)	VOLTAGE	PHASE	RPM	HP
HWC-1	BELL AND GOSSETT	#COCIRC 19-16	120" DOMESTIC HOT WATER CIRCULATION PUMP, STAINLESS STEEL, SET VARIABLE CONTROL TO 2 GPM MAX.	3	11	115	1	VARIABLE	1/12

FUEL-FIRED, DOMESTIC WATER HEATERS						
IDENTITY DATA						NATURAL GAS
MARK	MANUFACTURER	MODEL	DESCRIPTION	LOCATION	GPH RECOVERY	INPUT (BTU/H)
DWH-1	LOCHINVAR	#GTN050-50	ENERGY SAVER GAS WATER HEATER	PLUMB #41	54	50,000

TANKS AND INTERCEPTORS SCHEDULE						
IDENTITY DATA						
MARK	MANUFACTURER	MODEL	DESCRIPTION	LOCATION	CAPACITY	
ET-1	AMTRCO	S15-C-000	DOMESTIC HOT WATER EXPANSION TANK	PLUMB #41	2 GALLON TANK VOLUME, 0.45 GALLON MAX. ACCEPT. VOLUME	
ET-2	TIGERFLOW	#065-1A-132-E	EXPANSION TANK, BLADDER TYPE	PLUMB #41	132 GALLON TANK VOLUME, 150 PSI WORKING PRESSURE	

221123.13 - DOMESTIC WATER PACKAGED BOOSTER PUMPS									
IDENTITY DATA				PLUMBING			ELECTRICAL		
MARK	MANUFACTURER	MODEL	DESCRIPTION	FLOW RATE (GPM) (PER PUMP)	PUMP HEAD (TDH)	VOLTAGE	PHASE	RPM	HP
BP-1	TIGERFLOW	#DVMV-7.5TF-A2-S3-VM-P-VFD	DUPLEX DOMESTIC BOOSTER PUMP w/ VERTICAL STACK COMPACT SKID	80	123	460	3	3600	7.5

DOMESTIC WATER PIPING SPECIALTIES SCHEDULE (221119)						
IDENTITY DATA				FIXTURE CONNECTION		MOUNTING
MARK	MANUFACTURER	MODEL	DESCRIPTION	CW	HW	W
HB-1	ZURN	#21330-XL	HOSE BIB WITH RECESSED BOX	3/4"		
IMB-1	GUY GRAY	#SSIB2AB	ICEMAKER OUTLET BOX	1/2"		

SANITARY WASTE PIPING SPECIALTIES SCHEDULE (221319)						
IDENTITY DATA				W CONNECTION	NOTES	
MARK	MANUFACTURER	MODEL	DESCRIPTION			
FD-1	ZURN	#24159-ZB	DUCO CAST IRON BODY WITH FLASHING COLLAR, ADJUSTABLE ROUND STRAINER HEAD, POLISHED BRONZE STRAINER	2"	TRAPGUARD BY PROSET, NO SUBSTITUTIONS	
FD-2	ZURN	#2662-DG	DUCO CAST IRON BODY WITH FLASHING COLLAR AND CAST IRON GRATE, SQUARE GRATE AND SEDIMENT BUCKET	4"		

COMMERCIAL WATER CLOSET SCHEDULE (224213.13)													
FLUSHOMETER													
MARK	MANUFACTURER	MODEL	DESCRIPTION	MANUFACTURER	MODEL	OPERATION	GPF	TOILET SEAT	FIXTURE CONNECTION			MOUNTING	
WC-1	ZURN	#25615-BWL	WALL-MOUNTED, TOP SPUD WATER CLOSET	SLOAN	ROYAL #111-1.6	MANUAL	1.6	CLOSED BACK OPEN FRONT	1"	4"	2"	15"	No
WC-2	ZURN	#25615-BWL	WALL-MOUNTED, TOP SPUD, ACCESSIBLE WATER CLOSET	SLOAN	ROYAL #111-1.6	MANUAL	1.6	CLOSED BACK OPEN FRONT	1"	4"	2"	17"	Yes

COMMERCIAL URINAL SCHEDULE (224213.16)												
FLUSHOMETER												
MARK	MANUFACTURER	MODEL	DESCRIPTION	MANUFACTURER	MODEL	OPERATION	GPF	TOILET SEAT	FIXTURE CONNECTION			MOUNTING
UR-1	ZURN	#25755-U	WALL-HUNG, BACK OUTLET, WASHOUT, ACCESSIBLE	SLOAN	ROYAL #196-05	MANUAL	0.5	3/4"	2"	1 1/2"	24"	No
UR-2	ZURN	#25755-U	WALL-HUNG, BACK OUTLET, WASHOUT, ACCESSIBLE	SLOAN	ROYAL #196-0.5	MANUAL	0.5	3/4"	2"	1 1/2"	17"	Yes

COMMERCIAL LAVATORY SCHEDULE (224216.13)													
TRIM													
MARK	MANUFACTURER	MODEL	DESCRIPTION	MANUFACTURER	MODEL	OPERATION	GPM	TOILET SEAT	FIXTURE CONNECTION			MOUNTING	
L-1	AMERICAN STANDARD	LUCERNE #0355.012	VITREOUS CHINA, WALL MOUNTED, WITH BACK	CHICAGO FAUCET	#902-244BCP	MANUAL	0.5	1/2"	1/2"	1 1/2"	1 1/2"	34"	Yes


COMMERCIAL SINK SCHEDULE (224216.16)												
TRIM												
MARK	MANUFACTURER	MODEL	DESCRIPTION	MANUFACTURER	MODEL	OPERATION	GPM	TOILET SEAT	FIXTURE CONNECTION			MOUNTING
MB-1	ZURN	#21998-24	PLASTIC, FLOOR MOUNTED (RECESSED) MOP BASIN	CHICAGO FAUCET	#540-LD897SWXFBBCP	MANUAL	2.2	3/4"	3/4"	3"	1 1/2"	FLOOR MOUNTED
SK-1	ELKAY	#LR2219	STAINLESS STEEL, ONE BOWL, COUNTER MOUNTED SINK	CHICAGO FAUCET	#201-AHAXKBCP	MANUAL	2.2	1/2"	1/2"	1 1/2"	1 1/2"	COUNTER MOUNTED
SK-2	ELKAY	#LRAD221955	STAINLESS STEEL, ONE BOWL, COUNTER MOUNTED SINK	CHICAGO FAUCET	#786-HR8AE3V317XK4B	MANUAL	2.2	1/2"	1/2"	1 1/2"	1 1/2"	COUNTER MOUNTED

PRESSURE WATER COOLER SCHEDULE (224716)									
IDENTITY DATA				FIXTURE CONNECTION			MOUNTING	ADA COMPLIANT	NOTES
MARK	MANUFACTURER	MODEL	DESCRIPTION	CW	W	V	(FLOOR TO RIM)		
EWC-1	ELKAY	#LMABFWSSK	FILTERED, ELECTRIC WATER COOLER/BOTTLE FILLER. SATIN FINISHED STAINLESS STEEL BOWL AND CABINET. BOTTLE FILLING UNIT INCLUDES AN ELECTRONIC SENSOR FOR NO-TOUCH ACTIVATION. TRIM: ADJUSTABLE P-TRAP WITH CLEANOUT, 1/2" ANGLE STOP WITH LOOSE KEY HANDLE, 1/2" O.D. CHROME PLATED SUPPLY.	3/4"	1 1/2"	1 1/2"	41" A.F.F.	No	
EWC-2	ELKAY	#LMABFWSSK	FILTERED, ELECTRIC WATER COOLER/BOTTLE FILLER. SATIN FINISHED STAINLESS STEEL BOWL AND CABINET. BOTTLE FILLING UNIT INCLUDES AN ELECTRONIC SENSOR FOR NO-TOUCH ACTIVATION. TRIM: ADJUSTABLE P-TRAP WITH CLEANOUT, 1/2" ANGLE STOP WITH LOOSE KEY HANDLE, 1/2" O.	1/2"	1 1/2"	1 1/2"	36"	Yes	



WATER HAMMER ARRESTER (221119)						
MARK	IPS	F.U. RATING	J.R. SMITH NO.	WADE NO.	ZURN NO.	REMARKS
A	3/4"	1-11	5005	W-5	100	P.D.I. CERTIFIED
B	1"	12-32	5010	W-10	200	P.D.I. CERTIFIED
C	1"	33-60	5020	W-20	300	P.D.I. CERTIFIED
D	1"	61-113	5030	W-50	400	P.D.I. CERTIFIED
E	1"	114-154	5040	W-75	500	P.D.I. CERTIFIED



Project No. 2020-154.SMS
Project Date 07.26.2021
Produced JH / IOP

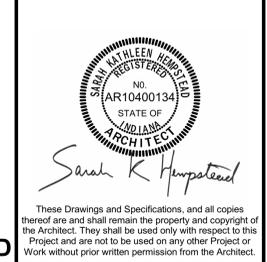

#	Revision	Date
A2	ADDENDUM #2	08/18/2021

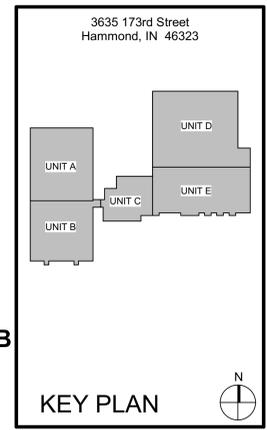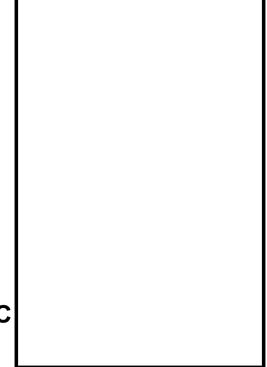

School City of Hammond

Scott Middle School - Renovations

PLUMBING DETAILS AND SCHEDULES

P-601

6 5 4 3 2 1

PLUMBING GENERAL NOTES

1. WALK-THRU CHASES ARE DESIGNED FOR MAINTENANCE PURPOSES. NO PIPING PERMITTED TO CROSS FROM A COMMON HEADER BELOW 8'-0" A.F.F.
2. CONTRACTOR SHALL JET AND THOROUGHLY FLUSH EXISTING SANITARY SEWERS WHERE DOCUMENTS CALL FOR NEW WASTE PIPE CONNECTIONS.
3. WHERE PLUMBING FIXTURE ROUGH-IN PIPING IS SHOWN TO BE ABANDONED IN WALLS OR BELOW FLOOR SLAB, ROUGH-INS SHALL BE REMOVED TO A POINT BEYOND THE FINISHED SURFACE AND CAPPED. PATCH SURFACE TO MATCH EXISTING FINISH.
4. CONDUCT SANITARY WASTE SCOPING TO CONFIRM PIPE ROUTING PRIOR TO CUTTING FLOOR SLAB.
5. SAW CUT AND PATCH FLOOR AS NEEDED FOR NEW ROUTING OF UNDERSLAB WASTE PIPING. ROUTE NEW WASTE PIPING TO EXISTING UNDERSLAB WASTE OF EQUAL OR LARGER PIPE DIAMETER AND CONNECT.
6. WHERE SANITARY VENT THROUGH ROOF IS NOT USED, REMOVE COMPLETE. WHERE SANITARY VENT THROUGH ROOF IS TO BE ABANDONED IN PLACE, CONTRACTOR SHALL PERMANENTLY CAP PIPE ABOVE AND BELOW ROOF FOR A WATER TIGHT SEAL.
7. EXISTING PIPE ROUTING, AS SHOWN ON DRAWINGS, IS BASED UPON RECORD DOCUMENTS AND FIELD SURVEYS. ACTUAL ROUTE OF CONCEALED PIPING MAY VARY. CONTRACTOR IS RESPONSIBLE TO FIELD VERIFY PIPE ROUTING PRIOR TO SAW CUTTING OF FLOOR SLABS.
8. IN AREAS WHERE A FULL REMODEL IS INDICATED ON THE DRAWINGS, CONTRACTOR SHALL REMOVE ALL OVERHEAD PIPING AND HANGERS COMPLETE UNLESS OTHERWISE INDICATED.

PLUMBING FIXTURE ROUGH-IN LEGEND

MARK	FIXTURE CONNECTION			
	CW	HW	W	V
EWC-1	3/4"		1 1/2"	1 1/2"
EWC-2	1/2"		1 1/2"	1 1/2"
FD-1			2"	
FD-2			4"	
L-1	1/2"	1/2"	1 1/2"	1 1/2"
HB-1	3/4"			
MB-1	3/4"	3/4"	3"	1 1/2"
SK-1	1/2"	1/2"	1 1/2"	1 1/2"
SK-2	1/2"	1/2"	1 1/2"	1 1/2"
UR-1	3/4"		2"	1 1/2"
UR-2	3/4"		2"	1 1/2"
WC-1	1"		4"	2"
WC-2	1"		4"	2"




Project No. 2020-154-SMS
 Project Date 07.26.2021
 Produced JH / IOP



These Drawings and Specifications, and all copies thereof are and shall remain the property and copyright of the Architect. They shall be used only with respect to this Project and are not to be used on any other Project or Work without prior written permission from the Architect.

#	Revision	Date
A2	ADDENDUM #2	08/18/2021

3635 173rd Street
 Hammond, IN 46323

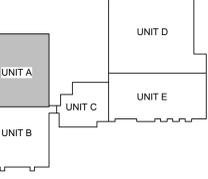

KEY PLAN


School City of Hammond



Scott Middle School - Renovations

WASTE AND VENT ISOMETRIC - UNIT A

P-902

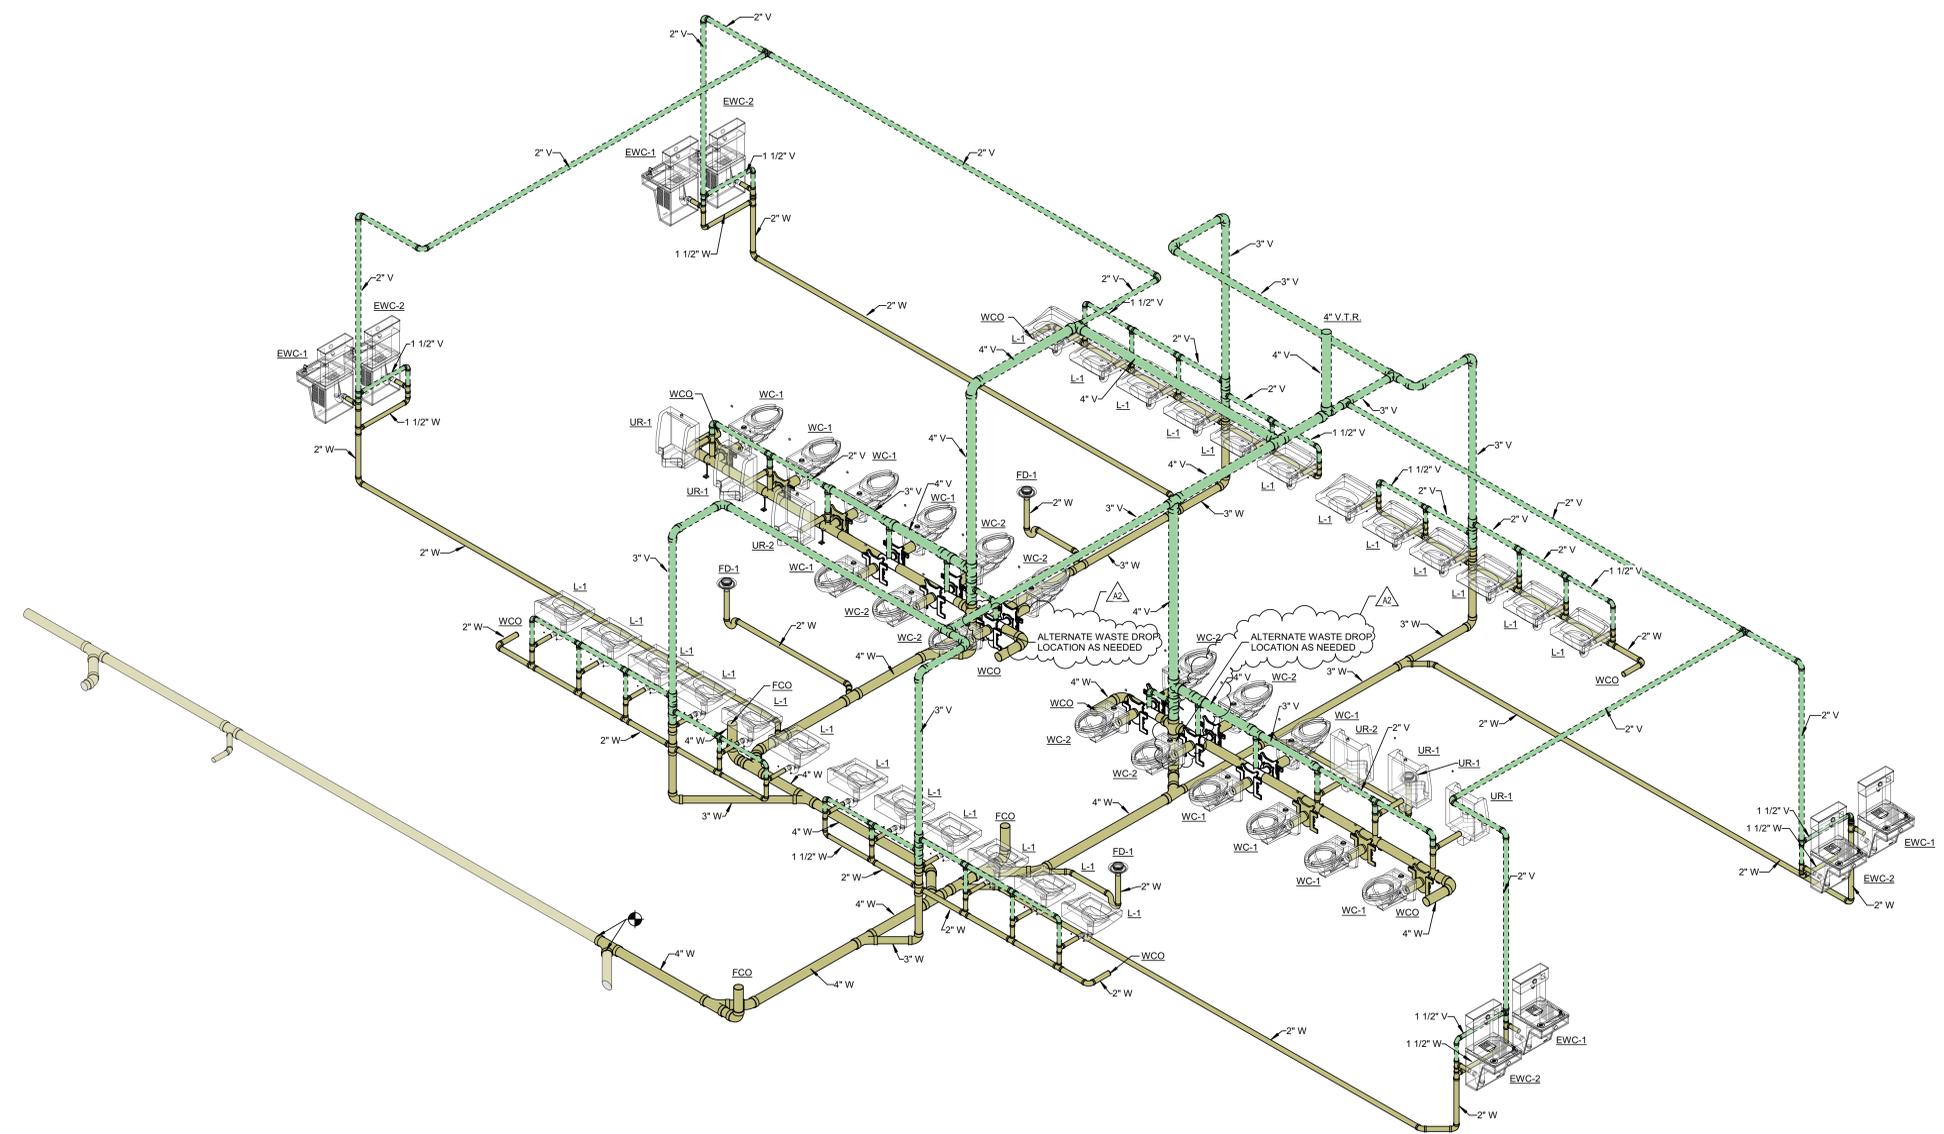

2A UNIT A WASTE AND VENT ISOMETRIC
 NOT TO SCALE

6 5 4 3 2 1

E
D
C
B
A

PLUMBING GENERAL NOTES
 1. WALK-THRU CHASES ARE DESIGNED FOR MAINTENANCE PURPOSES. NO PIPING PERMITTED TO CROSS FROM A COMMON HEADER BELOW 8'-0" A.F.F.
 2. CONTRACTOR SHALL JET AND THOROUGHLY FLUSH EXISTING SANITARY SEWERS WHERE DOCUMENTS CALL FOR NEW WASTE PIPE CONNECTIONS.
 3. WHERE PLUMBING FIXTURE ROUGH-IN PIPING IS SHOWN TO BE ABANDONED IN WALLS OR BELOW FLOOR SLAB, ROUGH-INS SHALL BE REMOVED TO A POINT BEYOND THE FINISHED SURFACE AND CAPPED. PATCH SURFACE TO MATCH EXISTING FINISH.
 4. CONDUCT SANITARY WASTE SCOPING TO CONFIRM PIPE ROUTING PRIOR TO CUTTING FLOOR SLAB.
 5. SAW CUT AND PATCH FLOOR AS NEEDED FOR NEW ROUTING OF UNDERSLAB WASTE PIPING. ROUTE NEW WASTE PIPING TO EXISTING UNDERSLAB WASTE OF EQUAL OR LARGER PIPE DIAMETER AND CONNECT.
 6. WHERE SANITARY VENT THROUGH ROOF IS NOT USED, REMOVE COMPLETE. WHERE SANITARY VENT THROUGH ROOF IS TO BE ABANDONED IN PLACE, CONTRACTOR SHALL PERMANENTLY CAP PIPE ABOVE AND BELOW ROOF FOR A WATER TIGHT SEAL.
 7. EXISTING PIPE ROUTING, AS SHOWN ON DRAWINGS, IS BASED UPON RECORD DOCUMENTS AND FIELD SURVEYS. ACTUAL ROUTE OF CONCEALED PIPING MAY VARY. CONTRACTOR IS RESPONSIBLE TO FIELD VERIFY PIPE ROUTING PRIOR TO SAW CUTTING OF FLOOR SLABS.
 8. IN AREAS WHERE A FULL REMODEL IS INDICATED ON THE DRAWINGS, CONTRACTOR SHALL REMOVE ALL OVERHEAD PIPING AND HANGERS COMPLETE UNLESS OTHERWISE INDICATED.

PLUMBING GENERAL NOTES

1. WALK-THRU CHASES ARE DESIGNED FOR MAINTENANCE PURPOSES. NO PIPING PERMITTED TO CROSS FROM A COMMON HEADER BELOW 8'-0" A.F.F.
2. CONTRACTOR SHALL JET AND THOROUGHLY FLUSH EXISTING SANITARY SEWERS WHERE DOCUMENTS CALL FOR NEW WASTE PIPE CONNECTIONS.
3. WHERE PLUMBING FIXTURE ROUGH-IN PIPING IS SHOWN TO BE ABANDONED IN WALLS OR BELOW FLOOR SLAB, ROUGH-INS SHALL BE REMOVED TO A POINT B EYOND THE FINISHED SURFACE AND CAPPED. PATCH SURFACE TO MATCH EXISTING FINISH.
4. CONDUCT SANITARY WASTE SCOPING TO CONFIRM PIPE ROUTING PRIOR TO CUTTING FLOOR SLAB.
5. SAW CUT AND PATCH FLOOR AS NEEDED FOR NEW ROUTING OF UNDERSLAB WASTE PIPING. ROUTE NEW WASTE PIPING TO EXISTING UNDERSLAB WASTE OF EQUAL OR LARGER PIPE DIAMETER AND CONNECT.
6. WHERE SANITARY VENT THROUGH ROOF IS NOT USED, REMOVE COMPLETE. WHERE SANITARY VENT THROUGH ROOF IS TO BE ABANDONED IN PLACE, CONTRACTOR SHALL PERMANENTLY CAP PIPE ABOVE AND BELOW ROOF FOR A WATER TIGHT SEAL.
7. EXISTING PIPE ROUTING, AS SHOWN ON DRAWINGS, IS BASED UPON RECORD DOCUMENTS AND FIELD SURVEYS. ACTUAL ROUTE OF CONCEALED PIPING MAY VARY. CONTRACTOR IS RESPONSIBLE TO FIELD VERIFY PIPE ROUTING PRIOR TO SAW CUTTING OF FLOOR SLABS.
8. IN AREAS WHERE A FULL REMODEL IS INDICATED ON THE DRAWINGS, CONTRACTOR SHALL REMOVE ALL OVERHEAD PIPING AND HANGERS COMPLETE UNLESS OTHERWISE INDICATED.

PLUMBING FIXTURE ROUGH-IN LEGEND

MARK	FIXTURE CONNECTION		
	CW	HW	V
EW-1	3/4"	1 1/2"	1 1/2"
EW-2	1/2"	1 1/2"	1 1/2"
FD-1		2"	
FD-2		4"	
L-1	1/2"	1/2"	1 1/2"
MB-1	3/4"		
IMB-1	1/2"		
MB-1	3/4"	3/4"	1 1/2"
SK-1	1/2"	1/2"	1 1/2"
SK-2	1/2"	1/2"	1 1/2"
UR-1	3/4"	2"	1 1/2"
UR-2	3/4"	2"	1 1/2"
WC-1	1"	4"	2"
WC-2	1"	4"	2"




Project No. 2020-154-SMS
 Project Date 07.26.2021
 Produced JH / IOP




These Drawings and Specifications, and all copies thereof are and shall remain the property and copyright of the Architect. They shall be used only with respect to this Project and are not to be used on any other Project or Work without prior written permission from the Architect.


#	Revision	Date
A2	ADDENDUM #2	08/18/2021

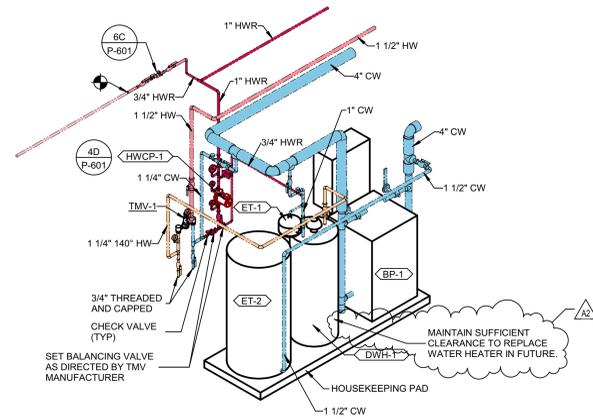

5D UNIT B DOMESTIC WATER ISOMETRIC - PLUMB #41
 NOT TO SCALE

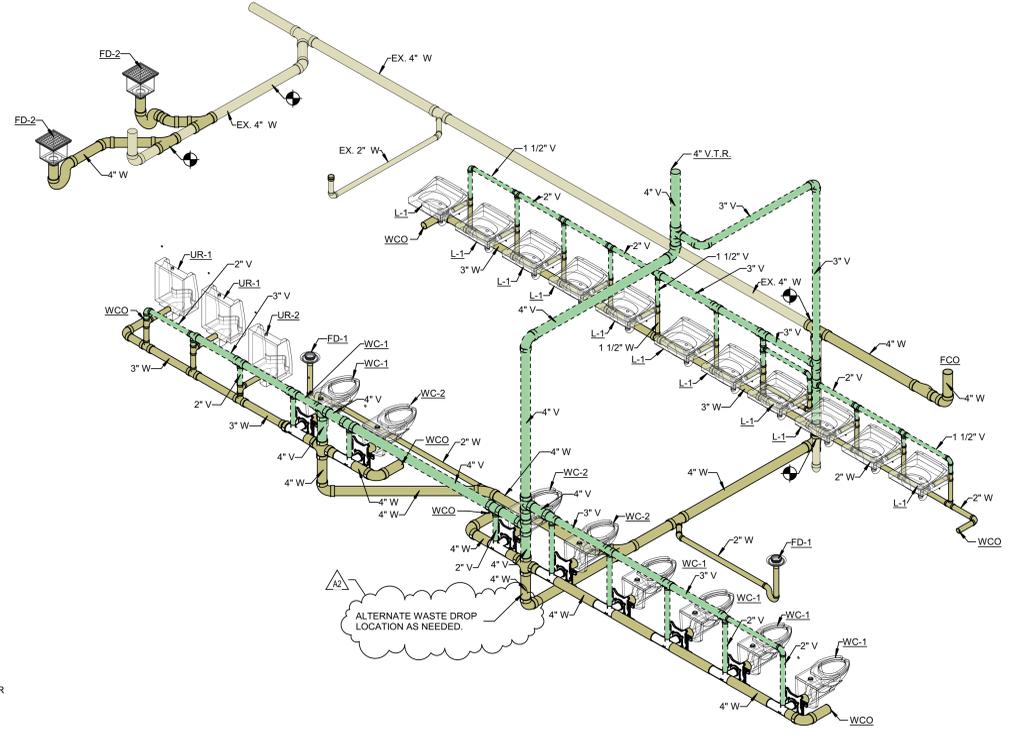

2B UNIT B WASTE AND VENT ISOMETRIC
 NOT TO SCALE

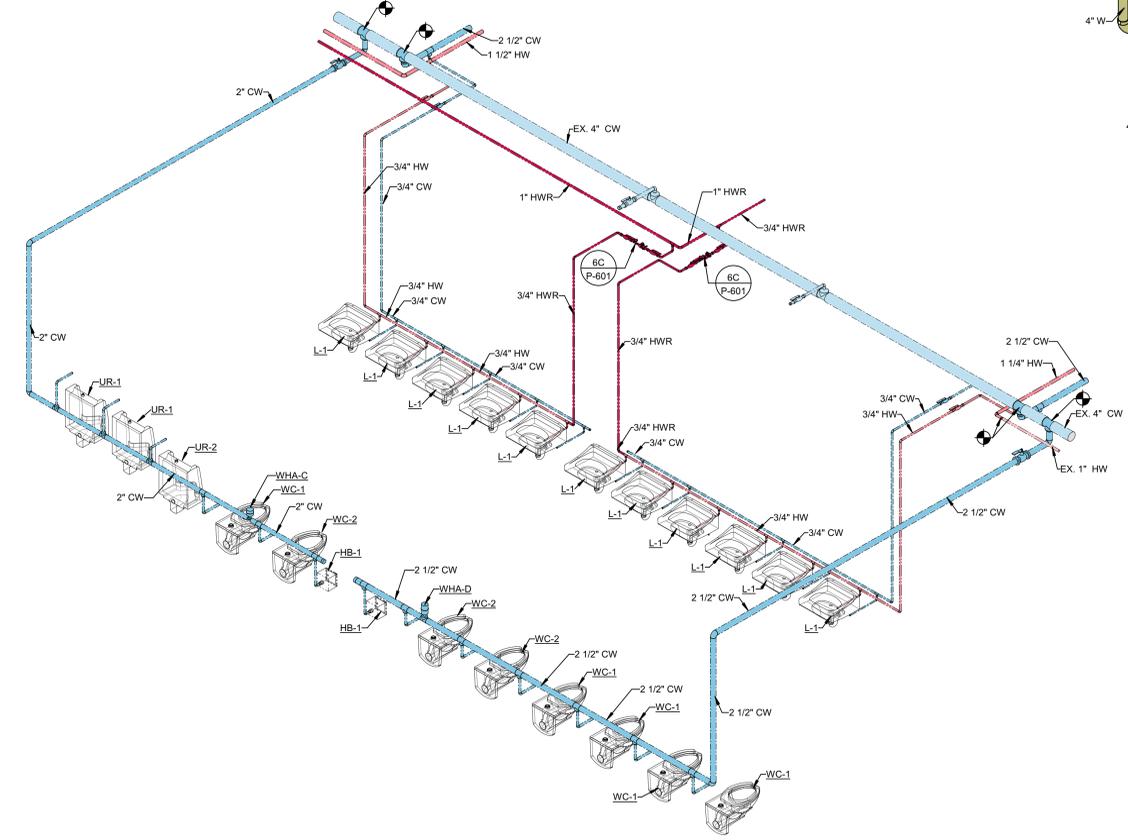


4A UNIT B DOMESTIC WATER ISOMETRIC
 NOT TO SCALE



3635 173rd Street
 Hammond, IN 46323

KEY PLAN

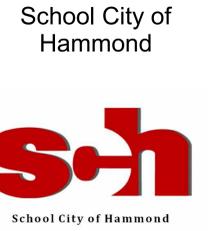

Scott Middle School
 - Renovations


PLUMBING ISOMETRICS - UNIT B

P-903

FILED: 08/18/2021 10:00 AM
 2021-08-18 10:00 AM
 2021-08-18 10:00 AM
 2021-08-18 10:00 AM

6 5 4 3 2 1

F
D
C
B
A

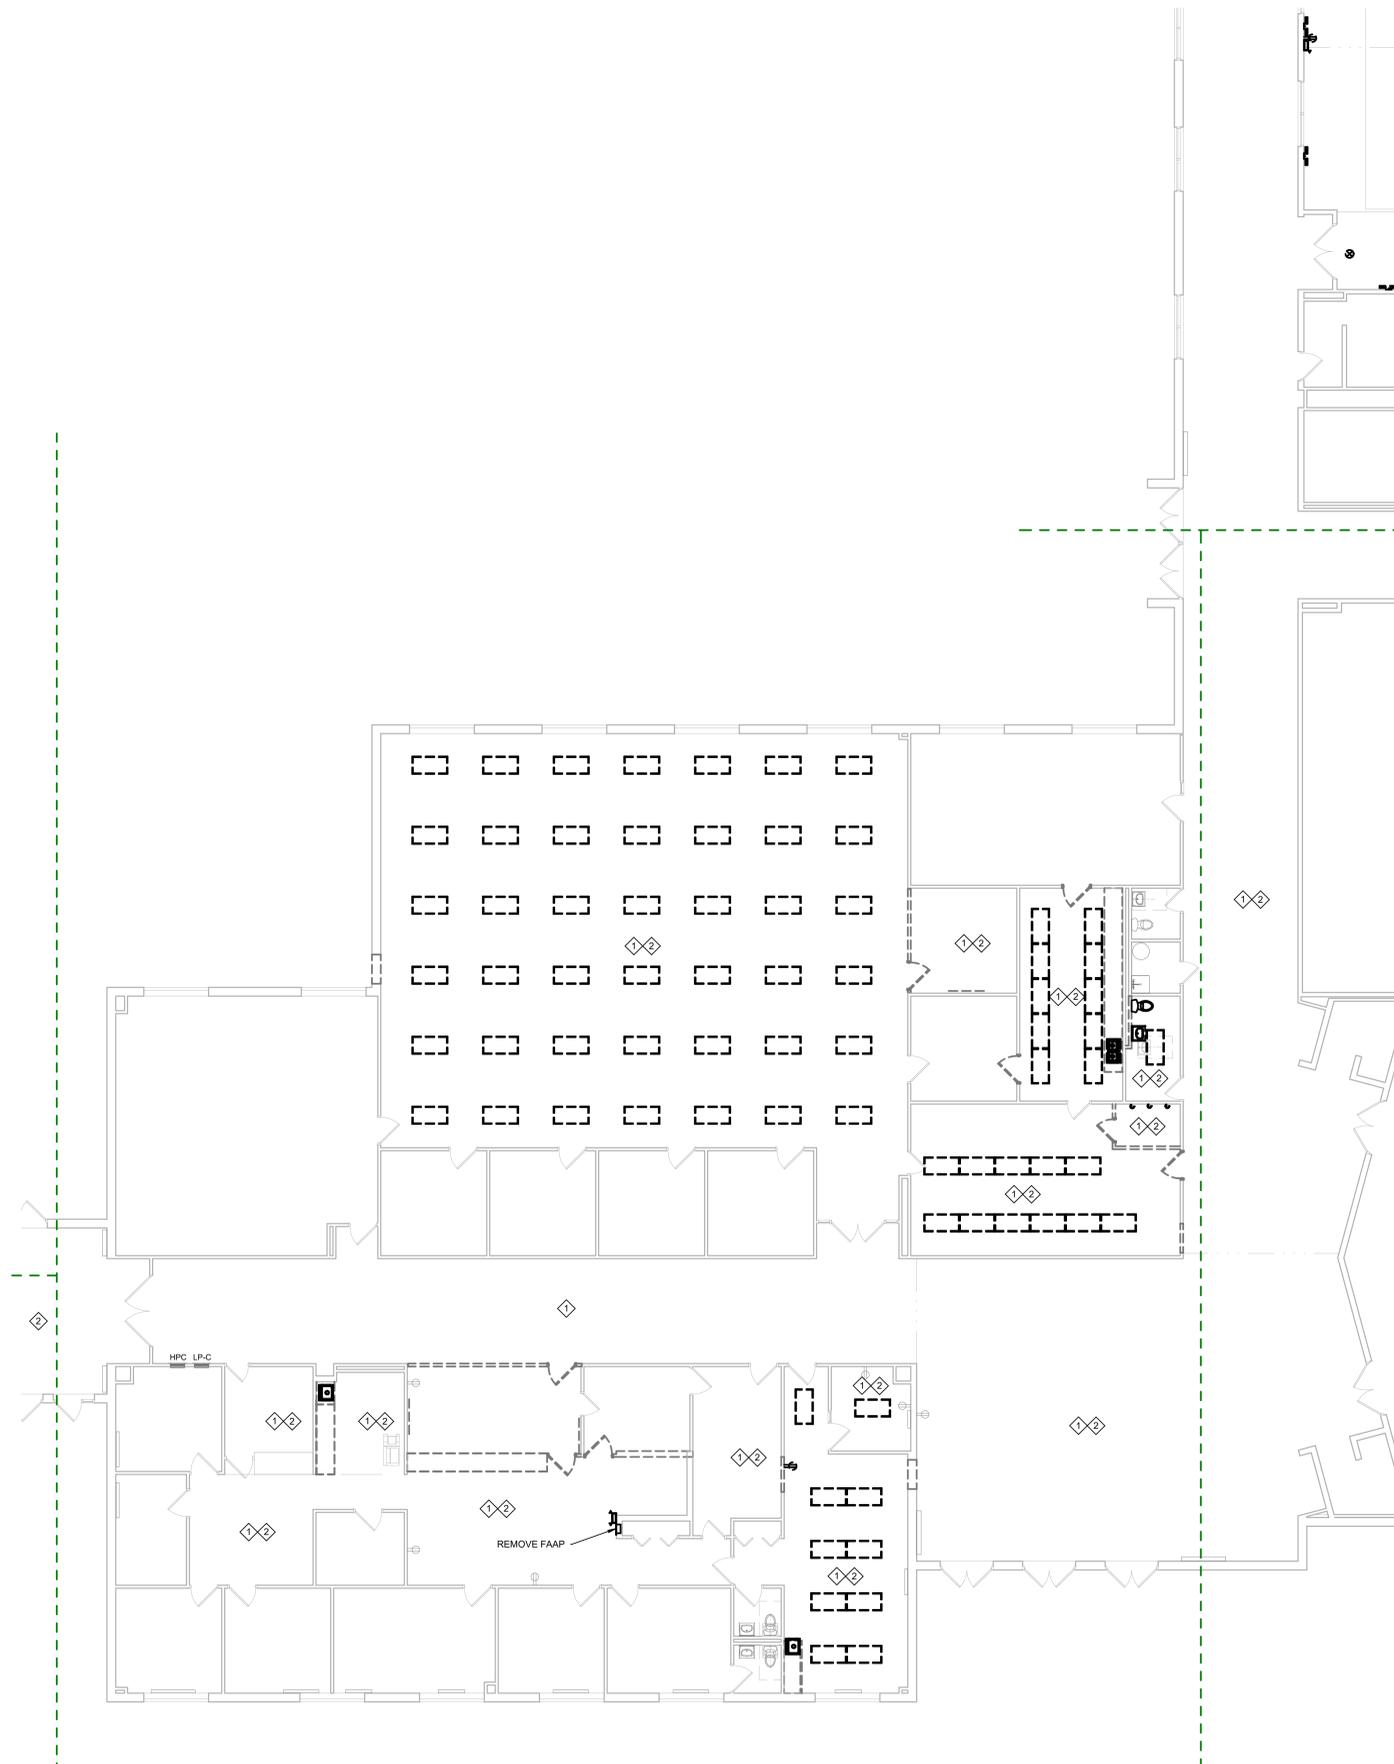

GENERAL DEMOLITION NOTES	
#	NOTES
A	REFER TO SHEET E-001 FOR ADDITIONAL INFORMATION.
B	THIS DRAWING REPRESENTS INFORMATION OBTAINED FROM ORIGINAL CONTRACT DRAWINGS AND FIELD SURVEY. VERIFY BY ON-SITE OBSERVATION THE EXTENT OF WORK PRIOR TO SUBMISSION OF BID.
C	CONTRACT DOCUMENTS CONSIST OF BOTH PROJECT MANUAL AND DRAWINGS AND ARE MEANT TO BE COMPLEMENTARY. ANYTHING APPEARING ON EITHER MUST BE EXECUTED THE SAME AS IF SHOWN ON BOTH.
D	THOROUGHLY EXAMINE THE WORK OF OTHER CONTRACTORS AND PROPERLY INSTALL ALL WORK REQUIRED FOR THE PROJECT.
E	THE OWNER HOLDS RIGHT OF FIRST REFUSAL FOR ALL DEMOLISHED ELECTRICAL EQUIPMENT.
F	ALL ELECTRICAL ITEMS SHOWN WITH LIGHT LINWORK ARE EXISTING TO REMAIN.
G	REMOVE ALL ELECTRICAL ITEMS SHOWN WITH BOLD/DASHED LINWORK COMPLETE.
H	COORDINATE AND DISCONNECT ALL ARCHITECTURAL, MECHANICAL, AND PLUMBING EQUIPMENT AS NOTED FOR REMOVAL BY OTHERS. REMOVE ALL ASSOCIATED ELECTRICAL EQUIPMENT, RACEWAYS, CONDUCTORS, ETC. SERVING THE EQUIPMENT.
I	PROVIDE ALL CUTTING AND PATCHING AS REQUIRED FOR THE REMOVAL OF EXISTING ELECTRICAL EQUIPMENT. REFER TO SPECIFICATIONS.
J	PROVIDE A BLANK COVERPLATE FOR ALL EXISTING WALL OPENINGS WHERE ELECTRICAL EQUIPMENT HAS BEEN REMOVED AND NOT REPLACED. IN AREAS RECEIVING NEW WALL TREATMENTS, PATCH THE EXISTING OPENING.
K	REFER TO A, M, AND P-SERIES DRAWINGS FOR AREAS WITH ABOVE CEILING WORK AND/OR CEILING REMOVAL. TEMPORARILY SUPPORT ALL ELECTRICAL DEVICES, FIXTURES, ETC. AS REQUIRED. RE-INSTALL ELECTRICAL ITEMS FOLLOWING THE COMPLETION OF WORK IN THE NEW OR EXISTING CEILINGS.

DEMOLITION PLAN NOTES	
#	NOTES
1	REMOVE LIGHTING AND LIGHTING CONTROLS IN THIS ROOM.
2	PRESERVE LIGHTING CIRCUITS FOR REUSE IN NEW WORK.


SCHMIDT ASSOCIATES
415 Massachusetts Avenue
Indianapolis, IN 46204
www.schmidt-arch.com

Project No. 2020-154.SMS
Project Date 07.26.2021
Produced JH GL

Sarah K. Hempstead

These Drawings and Specifications, and all copies thereof are and shall remain the property and copyright of the Architect. They shall be used only with respect to this Project and are not to be used on any other Project or Work without prior written permission from the Architect.

#	Revision	Date
A2	Addendum 2	08.18.2021

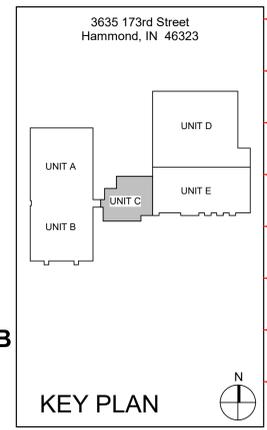

School City of Hammond

School City of Hammond

Scott Middle School - Renovations

FIRST FLOOR
DEMOLITION PLAN - UNIT C
ED1C1

2A FIRST FLOOR DEMOLITION PLAN - UNIT C
1/8" = 1'-0"

6 5 4 3 2 1

EDC: 08/18/2021 10:00 AM
 2020-154.SMS - School City of Hammond - Public Works Dept - Renovations
 3635 173rd Street Hammond, IN 46323
 31 AUG 2021 10:00 AM

GENERAL LIGHTING NOTES
 # NOTES
 A REFER TO SHEET E-001 FOR ADDITIONAL INFORMATION.



SCHMIDT ASSOCIATES
 415 Massachusetts Avenue
 Indianapolis, IN 46204
 www.schmidt-arch.com

Project No. 2020-154.SMS
 Project Date 07.26.2021
 Produced JH GL




Sarah K. Hempstead
 These Drawings and Specifications, and all copies thereof are and shall remain the property and copyright of the Architect. They shall be used only with respect to this Project and are not to be used on any other Project or Work without prior written permission from the Architect.

LIGHTING PLAN NOTES
 # NOTES
 1 PROVIDE 2-GANG SURFACE MOUNT BOX TO ACCOMMODATE (2) DECORA LINE VOLTAGE DIMMERS. OUTLET BOX COLOR TO MATCH EXISTING SWITCH FACEPLATE COLOR.
 2 CONNECT AISLE LIGHTS TO EXISTING CIRCUIT SERVING AUDITORIUM LIGHTING. FEED AISLE LIGHTS FROM TRANSFORMER. COORDINATE FINAL TRANSFORMER LOCATION IN FIELD WITH OWNER. CONTROL AISLE LIGHTS FROM EXISTING AUDITORIUM LIGHTING CONTROL SYSTEM. CONNECT COMPLETE.
 3 CARPET TO FLOOR TYPE AISLE LIGHT FIXTURE.
 4 CARPET TO WALL TYPE AISLE LIGHT FIXTURE. INSTALL LIGHT FIXTURE CONTINUOUSLY ON STEP TREAD AND RISERS.
 5 TRENCH FLOOR TO WALL FOR CONDUIT PATHWAY. TRANSITION TO SINGLE CHANNEL RACEWAY UP WALL. TRANSITION TO CONDUIT IN CONCEALED ACCESSIBLE CEILING.
 6 CIRCUIT NEW LIGHT FIXTURES TO EXISTING CIRCUIT SERVING THIS ROOM/AREA COMPLETE.


#	Revision	Date
A1	Addendum 1	08.11.2021
A2	Addendum 2	08.18.2021

E
D
C
B
A

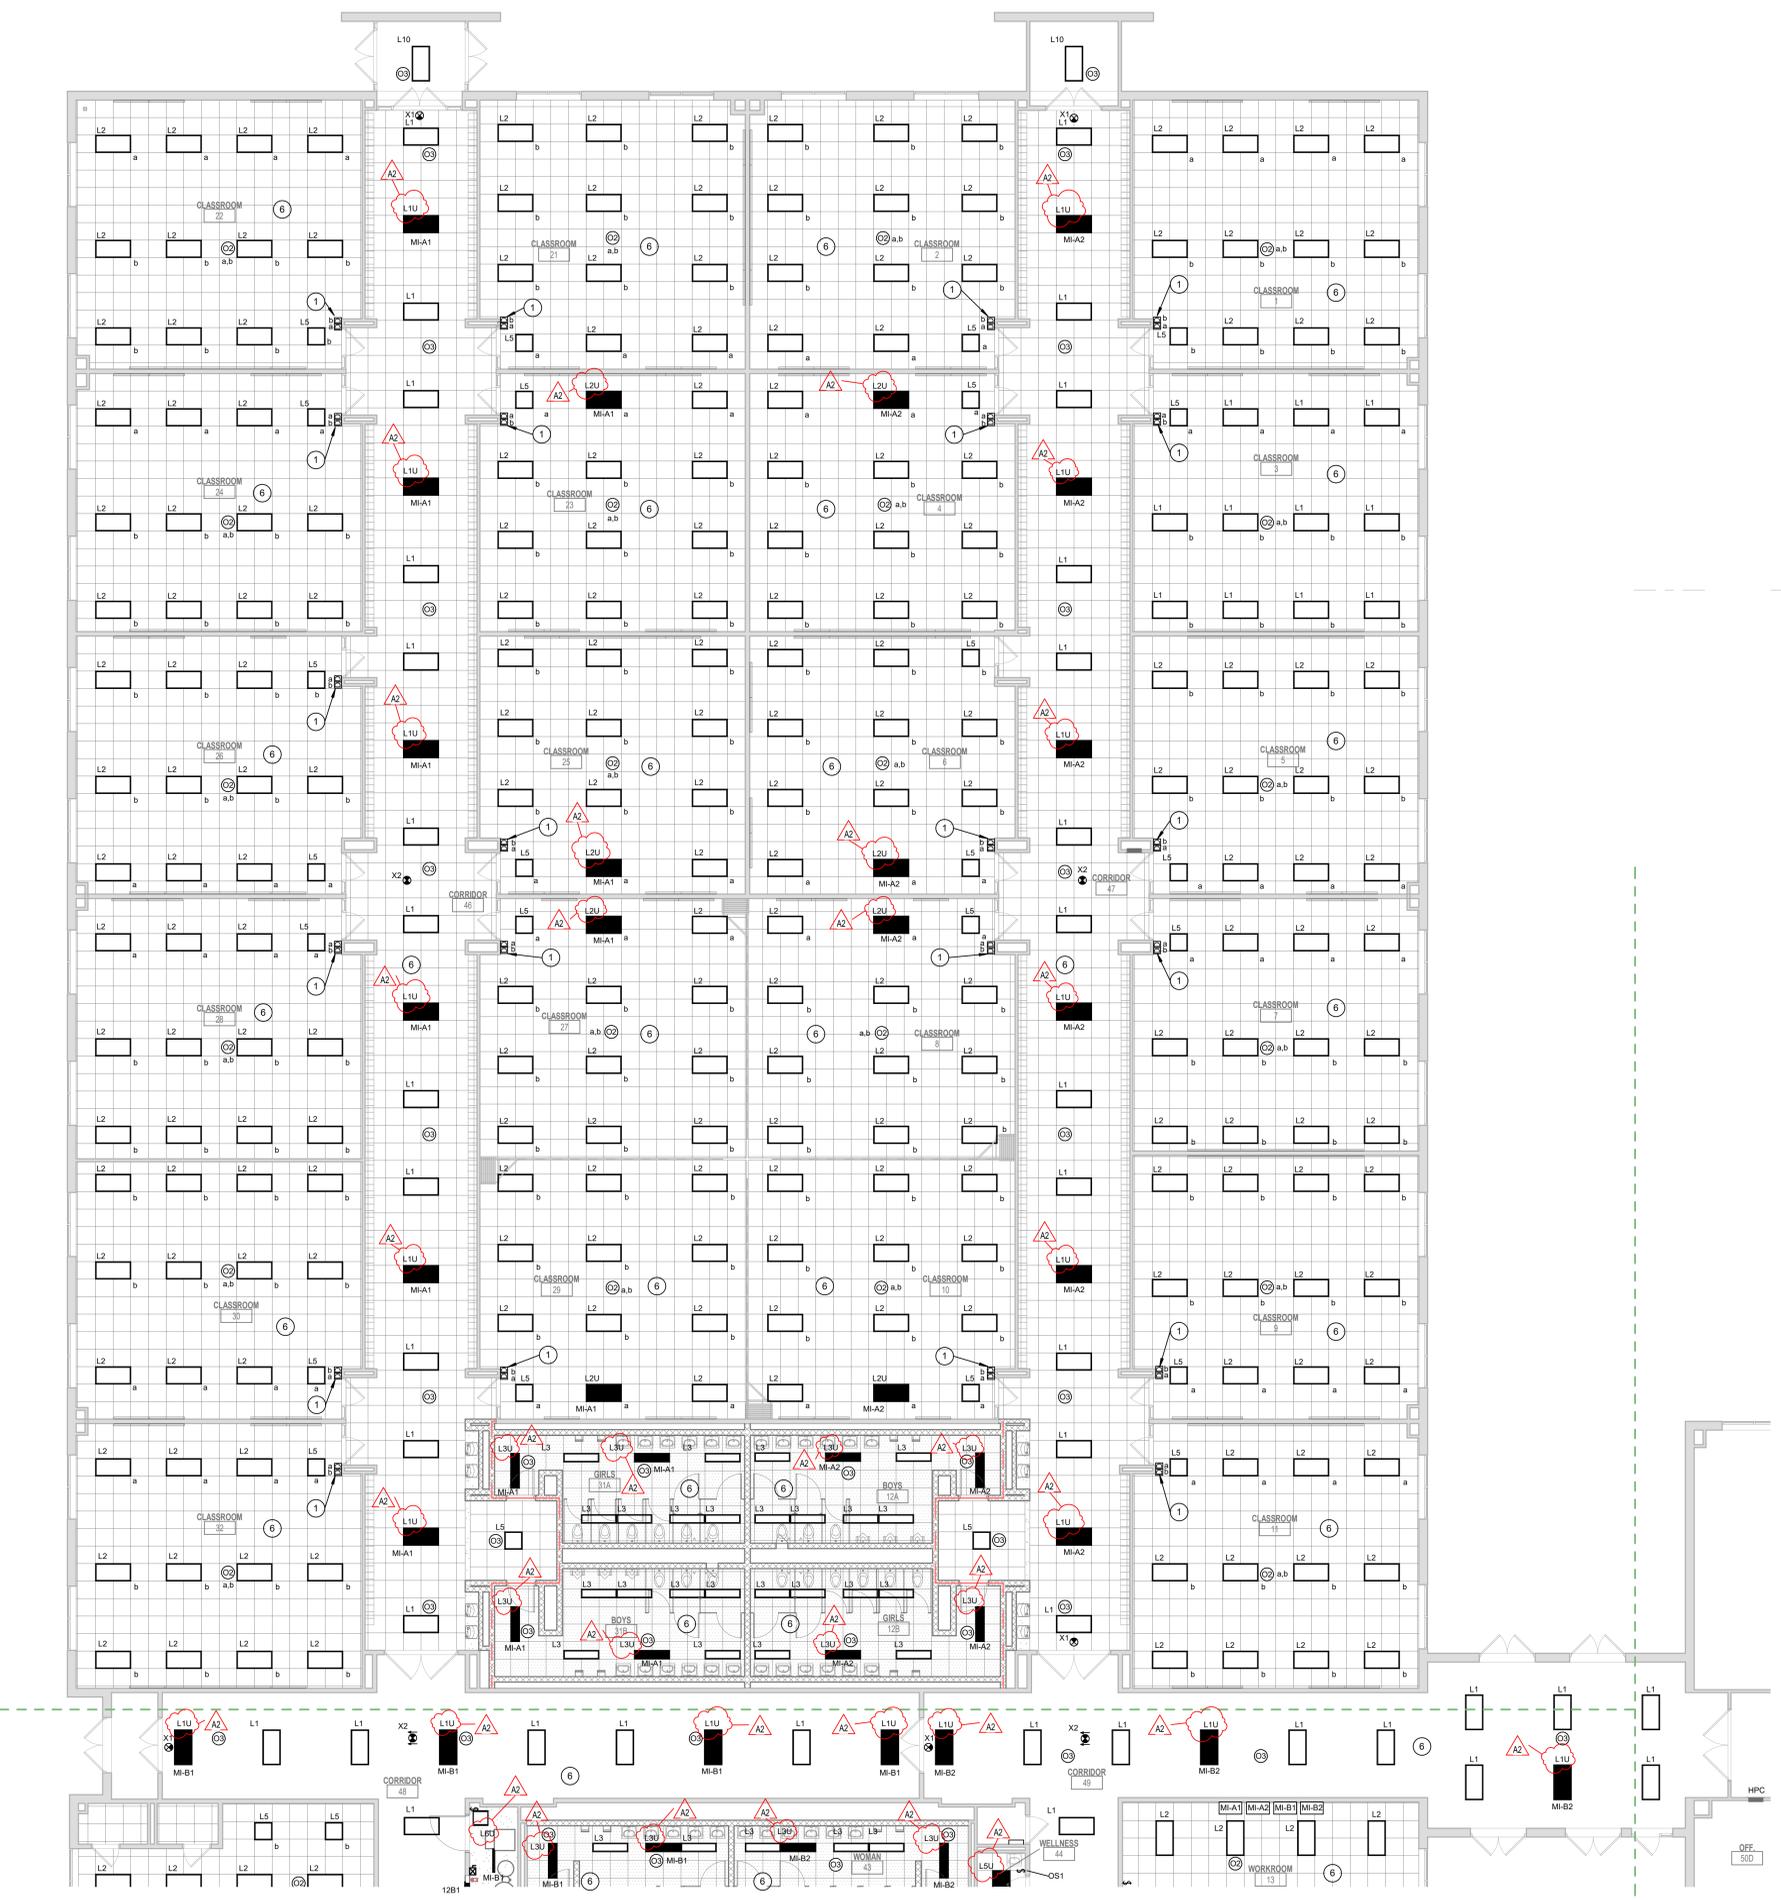

3

3635 173rd Street
 Hammond, IN 46323

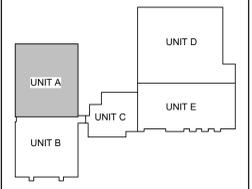

KEY PLAN

School City of Hammond

 School City of Hammond


Scott Middle School - Renovations

FIRST FLOOR LIGHTING PLAN - UNIT A

EL1A1

2A FIRST FLOOR LIGHTING PLAN - UNIT A
 1/8" = 1'-0"

SCALE: 1/8" = 1'-0"
 DATE: 08/11/2021
 DRAWN BY: JH
 CHECKED BY: GL
 PROJECT: SCOTT MIDDLE SCHOOL RENOVATIONS
 SHEET: EL1A1

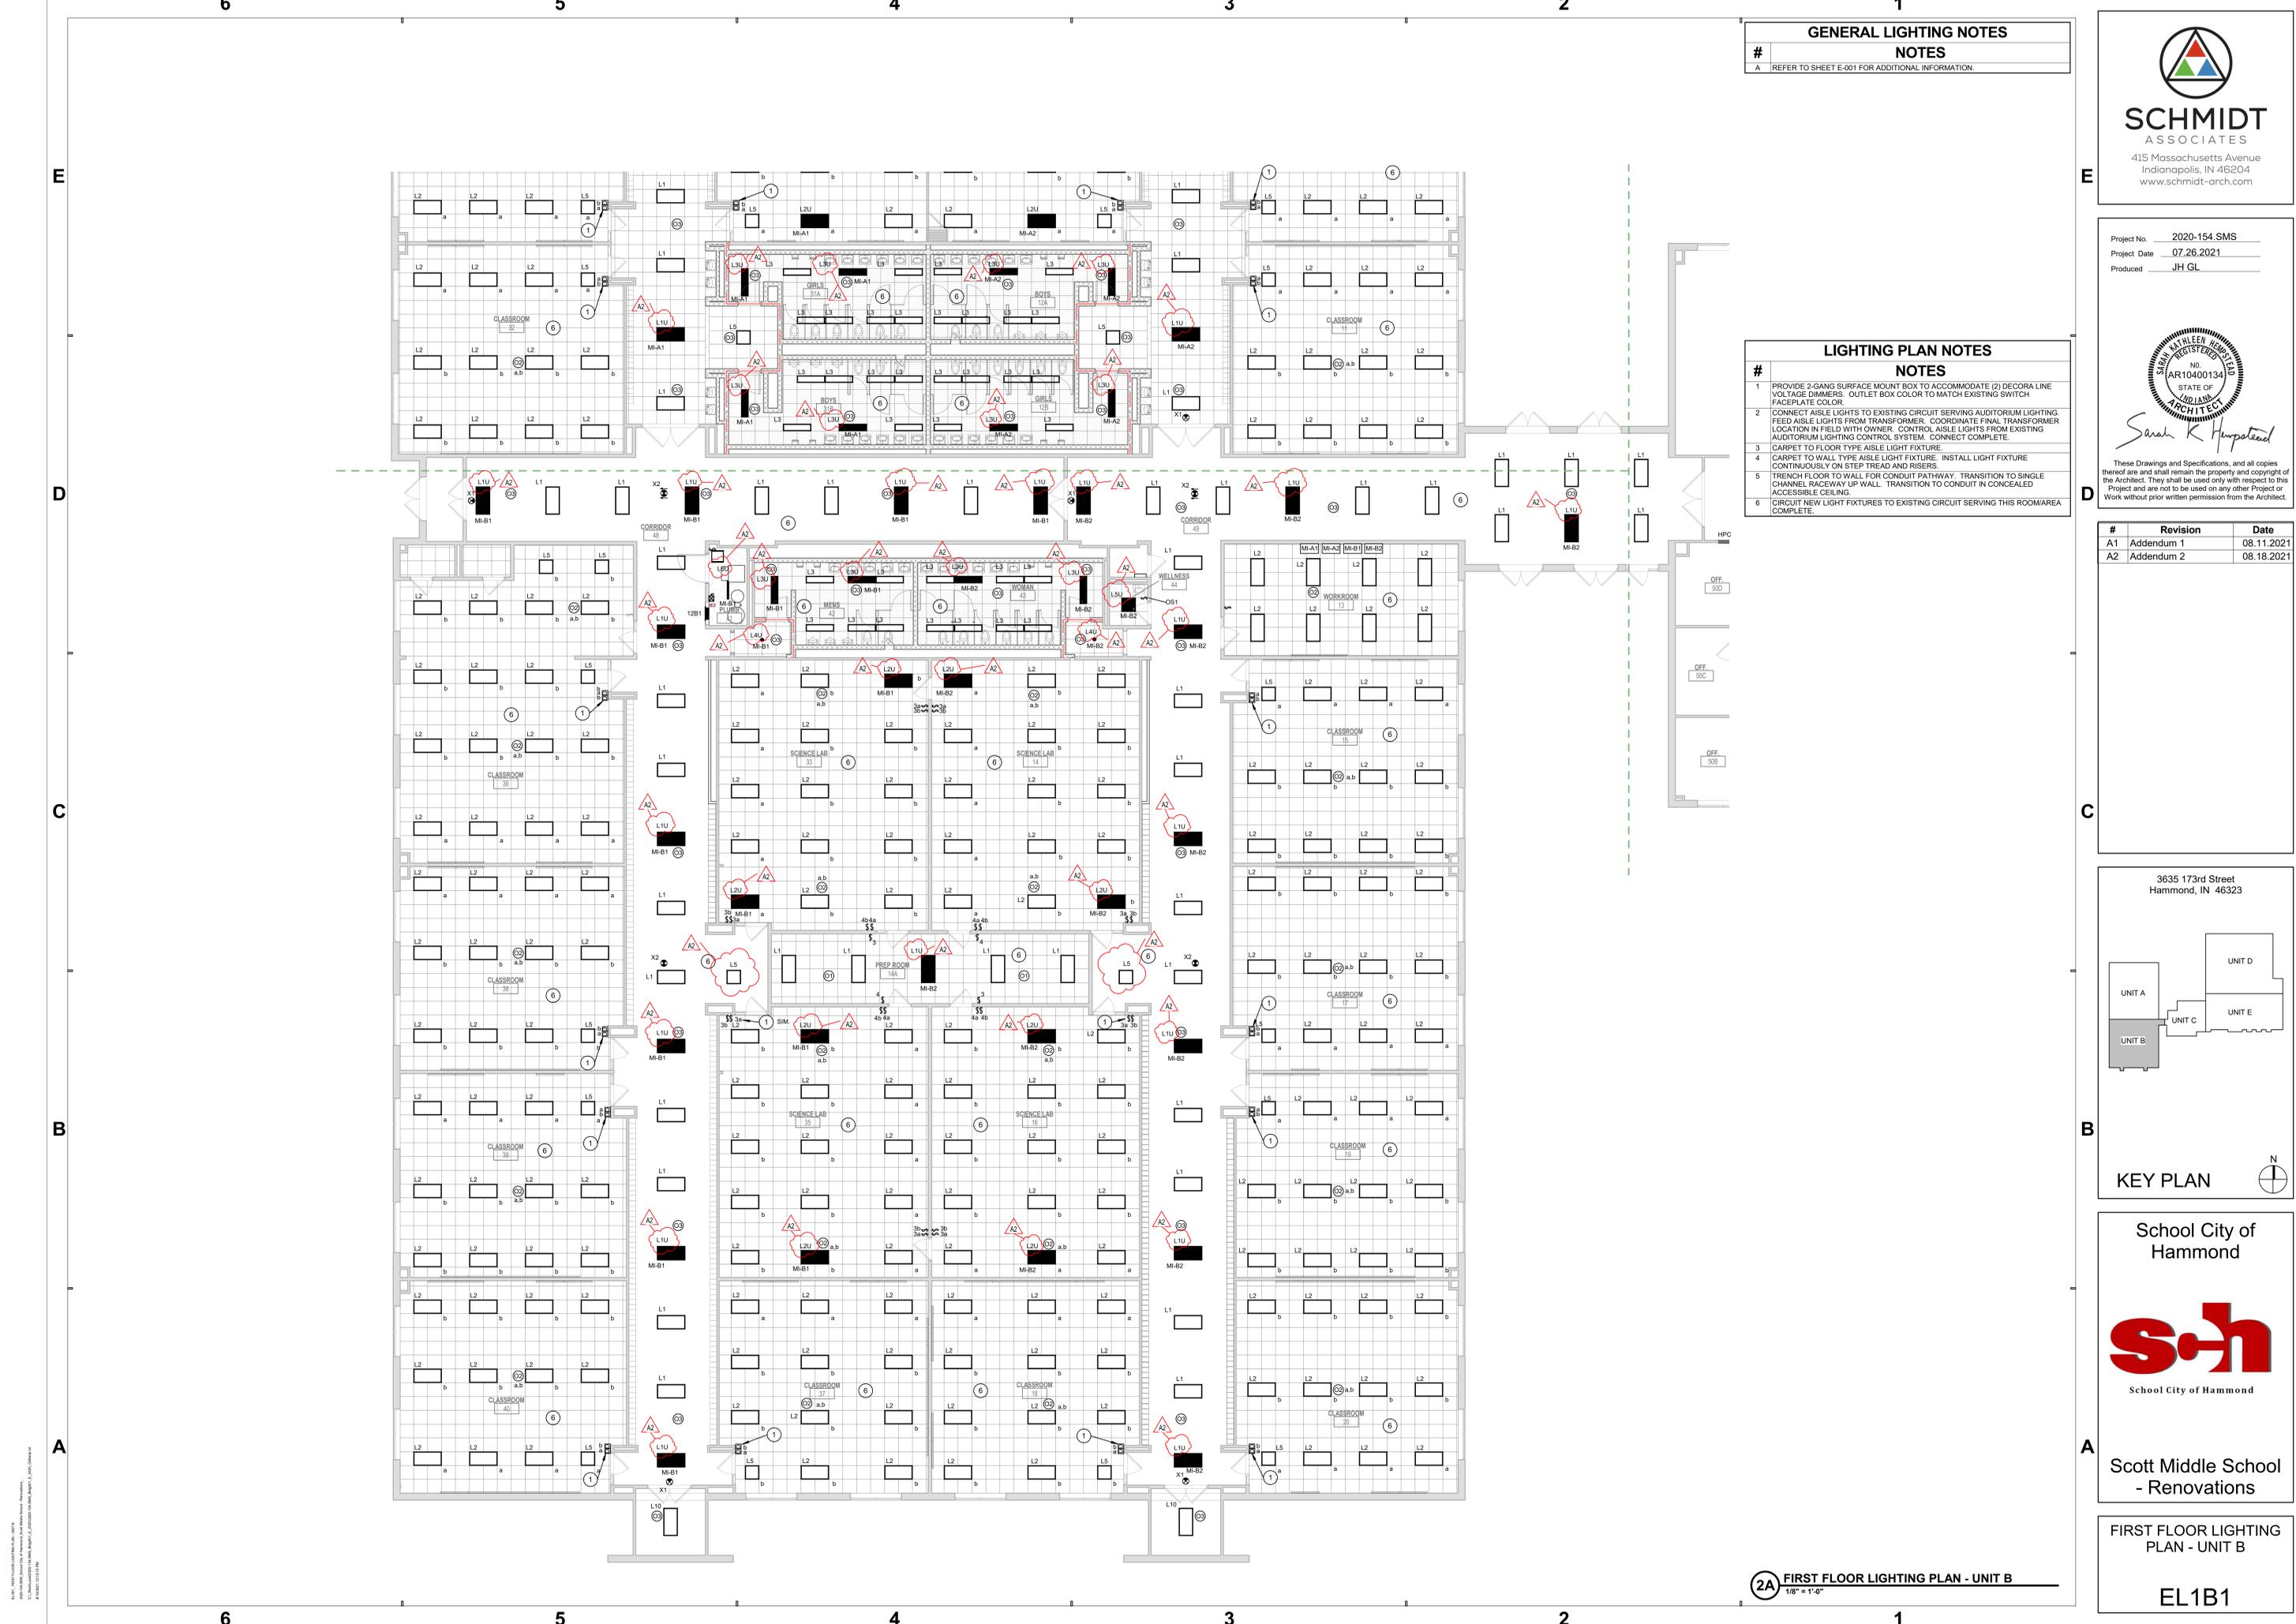

GENERAL LIGHTING NOTES

#	NOTES
A	REFER TO SHEET E-001 FOR ADDITIONAL INFORMATION.

LIGHTING PLAN NOTES

#	NOTES
1	PROVIDE 2-GANG SURFACE MOUNT BOX TO ACCOMMODATE (2) DECORA LINE VOLTAGE DIMMERS. OUTLET BOX COLOR TO MATCH EXISTING SWITCH FACEPLATE COLOR.
2	CONNECT AISLE LIGHTS TO EXISTING CIRCUIT SERVING AUDITORIUM LIGHTING. FEED AISLE LIGHTS FROM TRANSFORMER. COORDINATE FINAL TRANSFORMER LOCATION IN FIELD WITH OWNER. CONTROL AISLE LIGHTS FROM EXISTING AUDITORIUM LIGHTING CONTROL SYSTEM. CONNECT COMPLETE.
3	CARPET TO FLOOR TYPE AISLE LIGHT FIXTURE.
4	CARPET TO WALL TYPE AISLE LIGHT FIXTURE. INSTALL LIGHT FIXTURE CONTINUOUSLY ON STEP TREAD AND RISERS.
5	TRENCH FLOOR TO WALL FOR CONDUIT PATHWAY. TRANSITION TO SINGLE CHANNEL RACEWAY UP WALL. TRANSITION TO CONDUIT IN CONCEALED ACCESSIBLE CEILING.
6	CIRCUIT NEW LIGHT FIXTURES TO EXISTING CIRCUIT SERVING THIS ROOM/AREA COMPLETE.


SCHMIDT ASSOCIATES
 415 Massachusetts Avenue
 Indianapolis, IN 46204
 www.schmidt-arch.com

Project No. 2020-154.SMS
 Project Date 07.26.2021
 Produced JH GL

Sarah K. Hempstead

These Drawings and Specifications, and all copies thereof are and shall remain the property and copyright of the Architect. They shall be used only with respect to this Project and are not to be used on any other Project or Work without prior written permission from the Architect.

#	Revision	Date
A1	Addendum 1	08.11.2021
A2	Addendum 2	08.18.2021

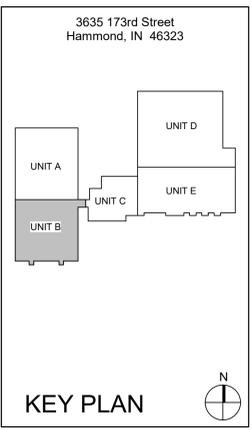

School City of Hammond

School City of Hammond

Scott Middle School - Renovations

FIRST FLOOR LIGHTING PLAN - UNIT B

EL1B1

2A FIRST FLOOR LIGHTING PLAN - UNIT B
 1/8" = 1'-0"

1/8" = 1'-0"
 2020-154.SMS
 07/26/2021
 JH GL

6

5

4

3

2

1

GENERAL LIGHTING NOTES	
#	NOTES
A	REFER TO SHEET E-001 FOR ADDITIONAL INFORMATION.

LIGHTING PLAN NOTES	
#	NOTES
1	PROVIDE 2-GANG SURFACE MOUNT BOX TO ACCOMMODATE (2) DECORA LINE VOLTAGE DIMMERS. OUTLET BOX COLOR TO MATCH EXISTING SWITCH FACEPLATE COLOR.
2	CONNECT AISLE LIGHTS TO EXISTING CIRCUIT SERVING AUDITORIUM LIGHTING. FEED AISLE LIGHTS FROM TRANSFORMER. COORDINATE FINAL TRANSFORMER LOCATION IN FIELD WITH OWNER. CONTROL AISLE LIGHTS FROM EXISTING AUDITORIUM LIGHTING CONTROL SYSTEM. CONNECT COMPLETE.
3	CARPET TO FLOOR TYPE AISLE LIGHT FIXTURE.
4	CARPET TO WALL TYPE AISLE LIGHT FIXTURE. INSTALL LIGHT FIXTURE CONTINUOUSLY ON STEP TREAD AND RISERS.
5	TRENCH FLOOR TO WALL FOR CONDUIT PATHWAY. TRANSITION TO SINGLE CHANNEL RACEWAY UP WALL. TRANSITION TO CONDUIT IN CONCEALED ACCESSIBLE CEILING.
6	CIRCUIT NEW LIGHT FIXTURES TO EXISTING CIRCUIT SERVING THIS ROOM/AREA COMPLETE.



SCHMIDT ASSOCIATES
415 Massachusetts Avenue
Indianapolis, IN 46204
www.schmidt-arch.com

Project No. 2020-154.SMS
Project Date 07.26.2021
Produced JH GL




Sarah K. Hempstead

These Drawings and Specifications, and all copies thereof are and shall remain the property and copyright of the Architect. They shall be used only with respect to this Project and are not to be used on any other Project or Work without prior written permission from the Architect.

#	Revision	Date
A1	Addendum 1	08.11.2021
A2	Addendum 2	08.18.2021

3635 173rd Street
Hammond, IN 46323

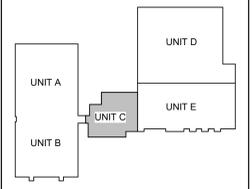

KEY PLAN

School City of Hammond



School City of Hammond

Scott Middle School - Renovations

FIRST FLOOR LIGHTING PLAN - UNIT C

EL1C1



2A FIRST FLOOR LIGHTING PLAN - UNIT C
1/8" = 1'-0"

6

5

4

3

2

1

EL1C1 - FIRST FLOOR LIGHTING PLAN - UNIT C
 2020-154.SMS - School City of Hammond Public Works Department - Hammond, Indiana
 08/18/2021 10:58:00 AM
 1/8" = 1'-0"



GENERAL LIGHTING NOTES

#	NOTES
A	REFER TO SHEET E-001 FOR ADDITIONAL INFORMATION.

LIGHTING PLAN NOTES

#	NOTES
1	PROVIDE 2-GANG SURFACE MOUNT BOX TO ACCOMMODATE (2) DECORA LINE VOLTAGE DIMMERS. OUTLET BOX COLOR TO MATCH EXISTING SWITCH FACEPLATE COLOR.
2	CONNECT AISLE LIGHTS TO EXISTING CIRCUIT SERVING AUDITORIUM LIGHTING. FEED AISLE LIGHTS FROM TRANSFORMER. COORDINATE FINAL TRANSFORMER LOCATION IN FIELD WITH OWNER. CONTROL AISLE LIGHTS FROM EXISTING AUDITORIUM LIGHTING CONTROL SYSTEM. CONNECT COMPLETE.
3	CARPET TO FLOOR TYPE AISLE LIGHT FIXTURE.
4	CARPET TO WALL TYPE AISLE LIGHT FIXTURE. INSTALL LIGHT FIXTURE CONTINUOUSLY ON STEP TREAD AND RISERS.
5	TRENCH FLOOR TO WALL FOR CONDUIT PATHWAY. TRANSITION TO SINGLE CHANNEL RACEWAY UP-WALL. TRANSITION TO CONDUIT IN CONCEALED ACCESSIBLE CEILING.
6	CIRCUIT NEW LIGHT FIXTURES TO EXISTING CIRCUIT SERVING THIS ROOM/AREA COMPLETE.

SCHMIDT ASSOCIATES
415 Massachusetts Avenue
Indianapolis, IN 46204
www.schmidt-arch.com


Project No. 2020-154.SMS
Project Date 07.26.2021
Produced JH GL

Sarah K. Hempstead

These Drawings and Specifications, and all copies thereof are and shall remain the property and copyright of the Architect. They shall be used only with respect to this Project and are not to be used on any other Project or Work without prior written permission from the Architect.

#	Revision	Date
A1	Addendum 1	08.11.2021
A2	Addendum 2	08.18.2021

3635 173rd Street
Hammond, IN 46323

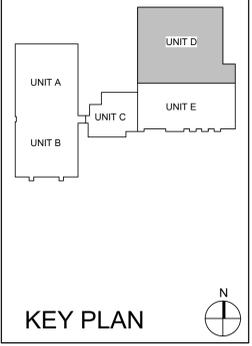

School City of Hammond

School City of Hammond


Scott Middle School
- Renovations

FIRST FLOOR LIGHTING PLAN - UNIT D

EL1D1

2A FIRST FLOOR LIGHTING PLAN - UNIT D
1/8" = 1'-0"

EL1D1 - FIRST FLOOR LIGHTING PLAN - UNIT D
2020-154.SMS - School City of Hammond Public Works Department - Renovations
DATE PLOTTED: 08/18/2021 10:58:50 AM
DRAWN BY: JH GL

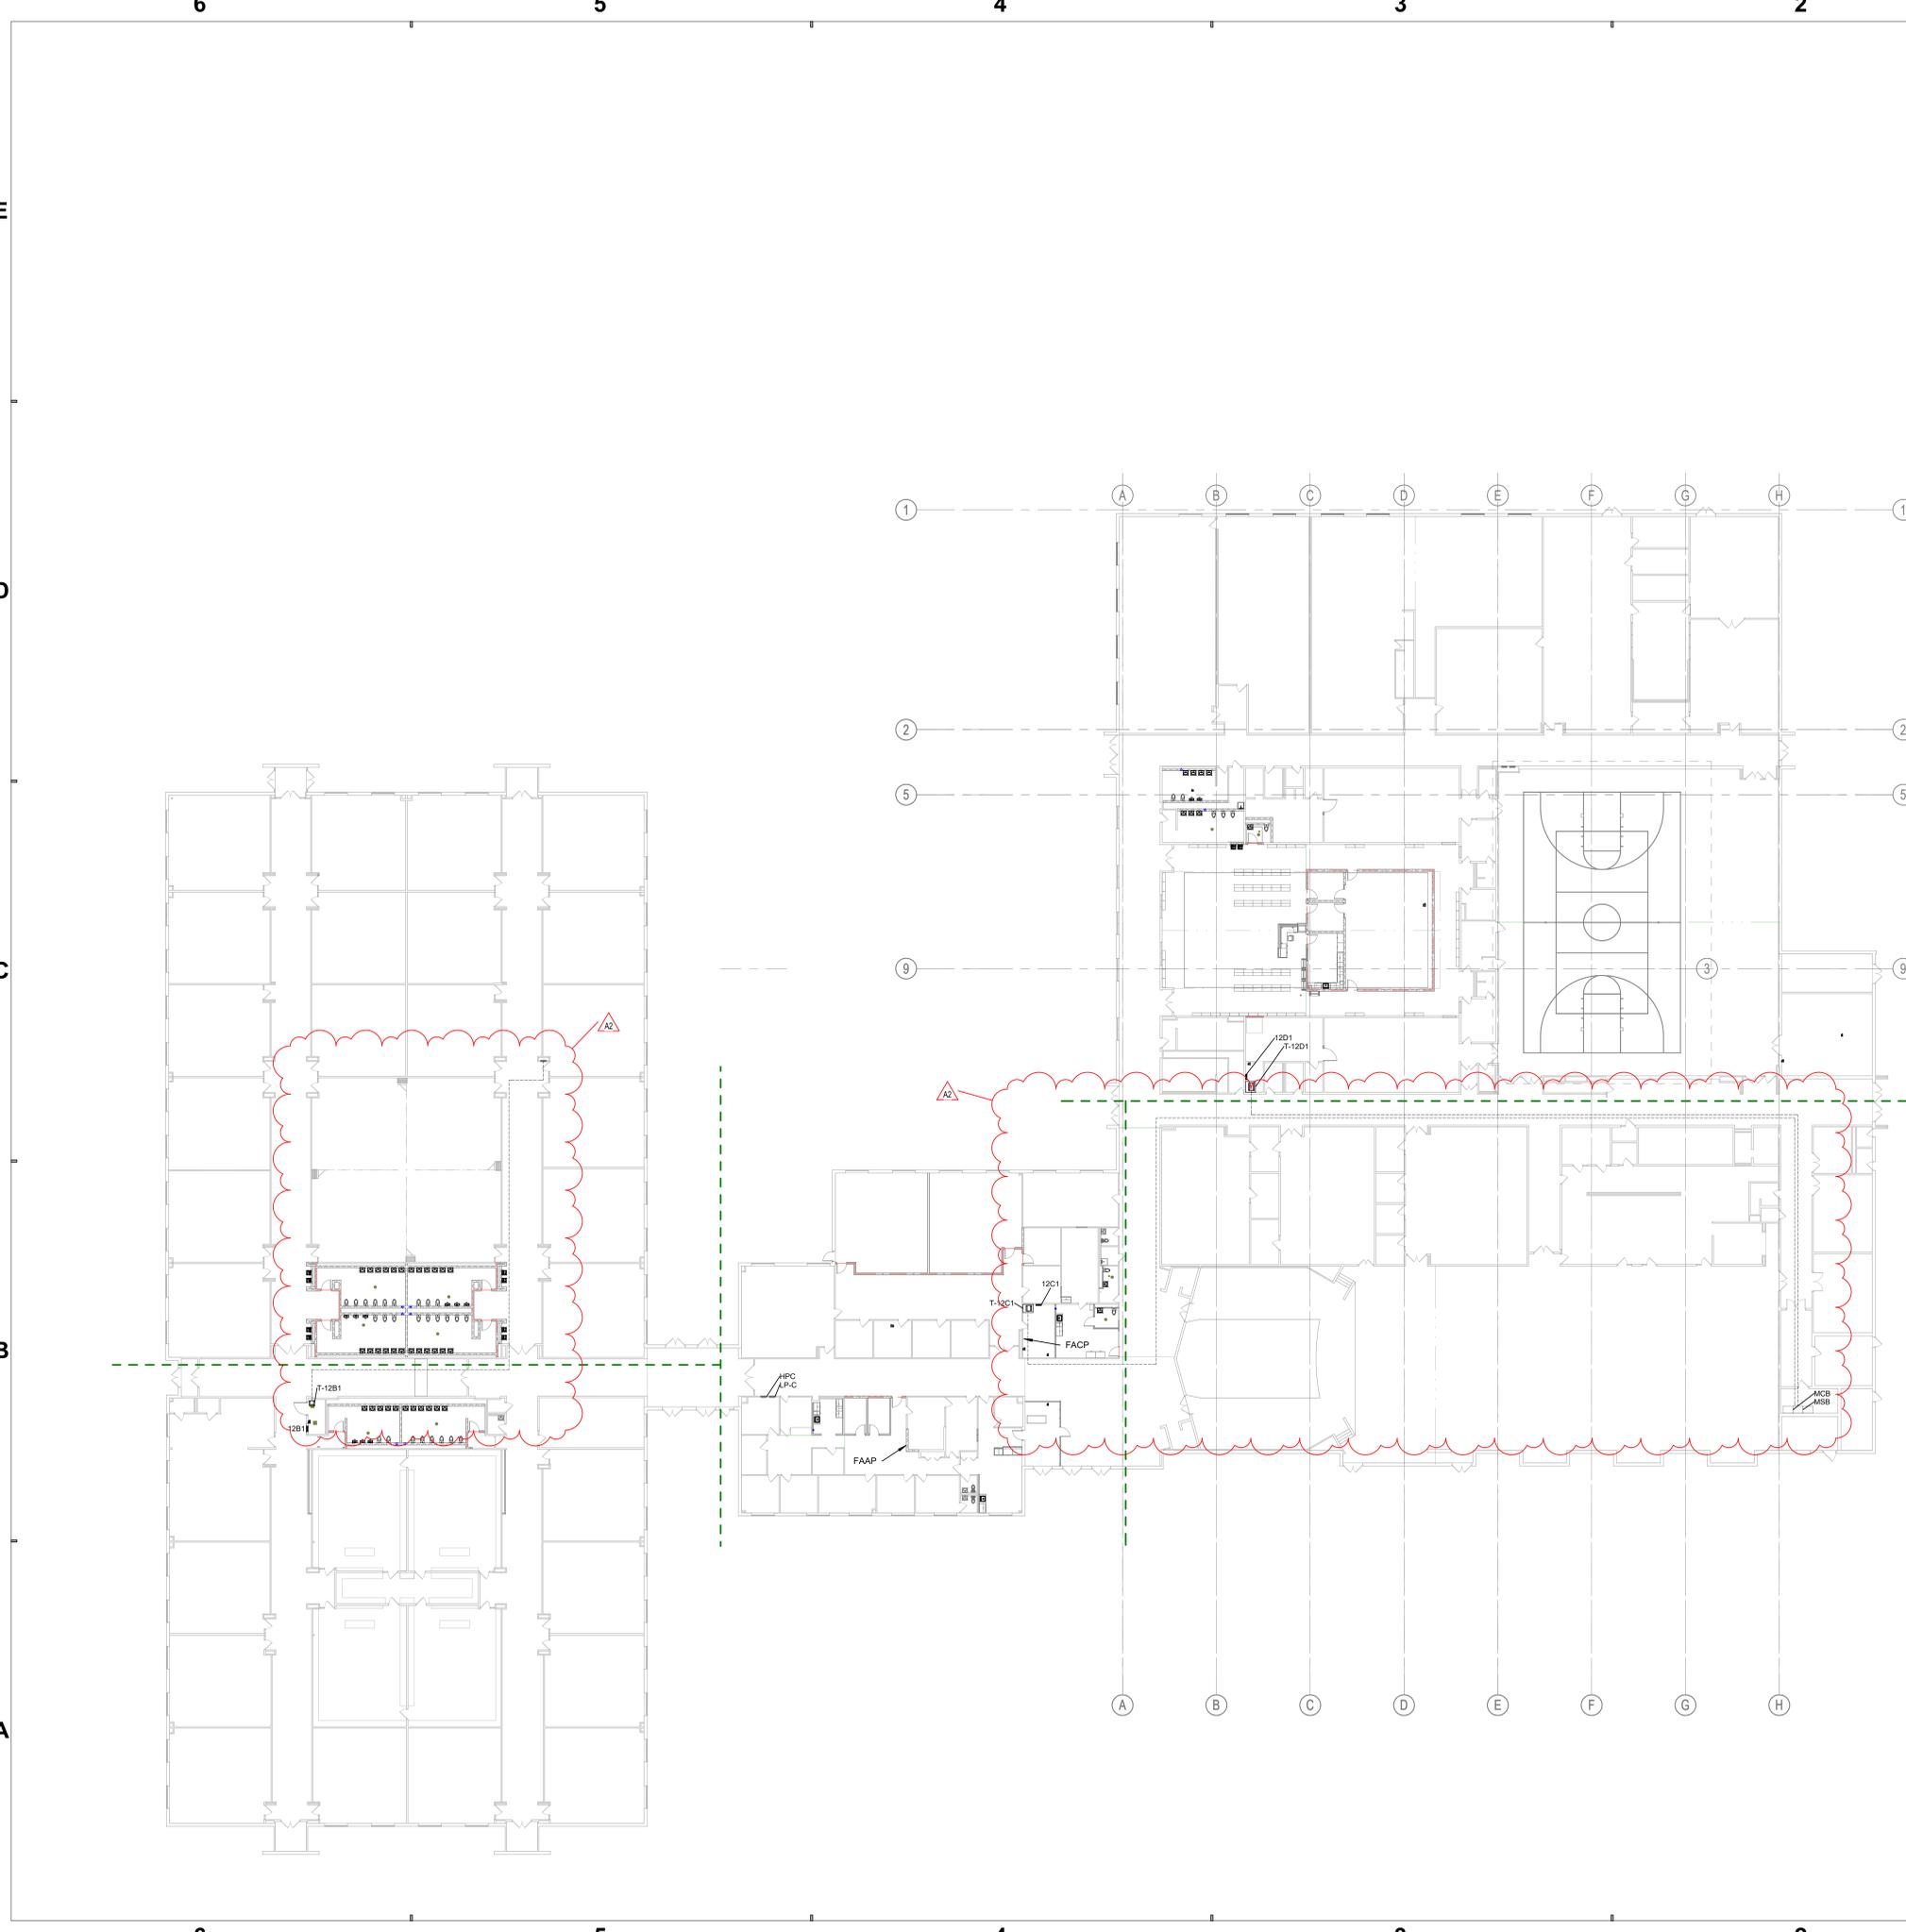

GENERAL POWER NOTES	
#	NOTES
A	REFER TO SHEET E-001 FOR ADDITIONAL INFORMATION.

POWER PLAN NOTES	
#	NOTES
1	PROVIDE QUADRAPLEX POWER RECEPTACLE TO SERVE WALL MOUNT SMART DISPLAY. CONNECT POWER RECEPTACLE TO EXISTING POWER CIRCUIT SERVING EXISTING PROJECTOR / SMARTBOARD. COORDINATE FINAL ROUGH-IN LOCATION WITH T-SERIES DRAWINGS PRIOR TO ROUGH-IN.
2	PROVIDE GFCI CIRCUIT BREAKER.
3	PROVIDE FLEXIBLE WIRING FROM OUTLET BOX ON WALL TO DEVICE LOCATED ON BLEACHERS.
4	INSTALL RECEPTACLE ON BOTTOM RISER OF BLEACHERS. CONNECT TO FLEXIBLE CABLE FROM WALL OUTLET BOX.
5	INSTALL SCOREBOARD OUTLET IN BOTTOM RISER OF BLEACHERS. CONNECT TO FLEXIBLE CABLE FROM WALL OUTLET BOX.
6	12" X 12" X 6" JUNCTION BOX FOR MOTORIZED BLEACHERS. INSTALL BOX AT +5'-0" A.F. TO CL. INSTALL IN LOCATION AS RECOMMENDED BY BLEACHER MANUFACTURER. CONTACTORS AND CONTROLLERS ARE PROVIDED AND WIRED BY THE MANUFACTURER. INSTALL (1) 3/4" C BETWEEN JUNCTION BOX AND ADJACENT DISCONNECT SWITCH. CONNECT COMPLETE.
7	INSTALL (1) 1" CONDUIT FROM OUTLET BOX TO SCOREBOARD FOR CONTROL WIRING.
8	PROVIDE QUADRAPLEX RECEPTACLE TO SERVE WALL MOUNT DISPLAY. COORDINATE FINAL OUTLET BOX LOCATION WITH OWNER PRIOR TO ROUGH-IN.
9	PROVIDE FLOOR BOX. REFER TO EQUIPMENT SCHEDULES FOR ADDITIONAL INFORMATION. VERIFY FINAL FLOOR BOX LOCATION IN FIELD WITH OWNER PRIOR TO INSTALLATION.
10	FEED DISCONNECT SWITCH FROM CORRESPONDING ROOF MOUNTED CONDENSING UNIT (CU). CONNECT COMPLETE TO SPLIT SYSTEM UNIT (SS).


SCHMIDT ASSOCIATES
415 Massachusetts Avenue
Indianapolis, IN 46204
www.schmidt-arch.com

Project No. 2020-154.SMS
Project Date 07.26.2021
Produced Designer Author

Sarah K. Hempstead

These Drawings and Specifications, and all copies thereof are and shall remain the property and copyright of the Architect. They shall be used only with respect to this Project and are not to be used on any other Project or Work without prior written permission from the Architect.

#	Revision	Date
A1	Addendum 1	08.11.2021
A2	Addendum 2	08.18.2021

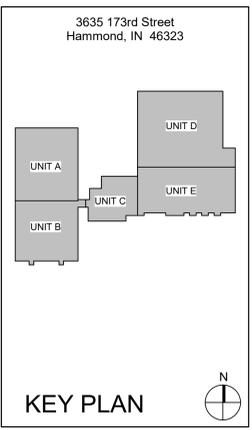

School City of Hammond

School City of Hammond


Scott Middle School
- Renovations

OVERALL FIRST FLOOR
POWER PLAN

EP101

2A FIRST FLOOR ROUTING PLAN
3/64" = 1'-0"

DATE: 07/26/2021 10:42 AM
PROJECT: 2020-154.SMS
SHEET: EP101
DRAWN BY: [Name]
CHECKED BY: [Name]
APPROVED BY: [Name]

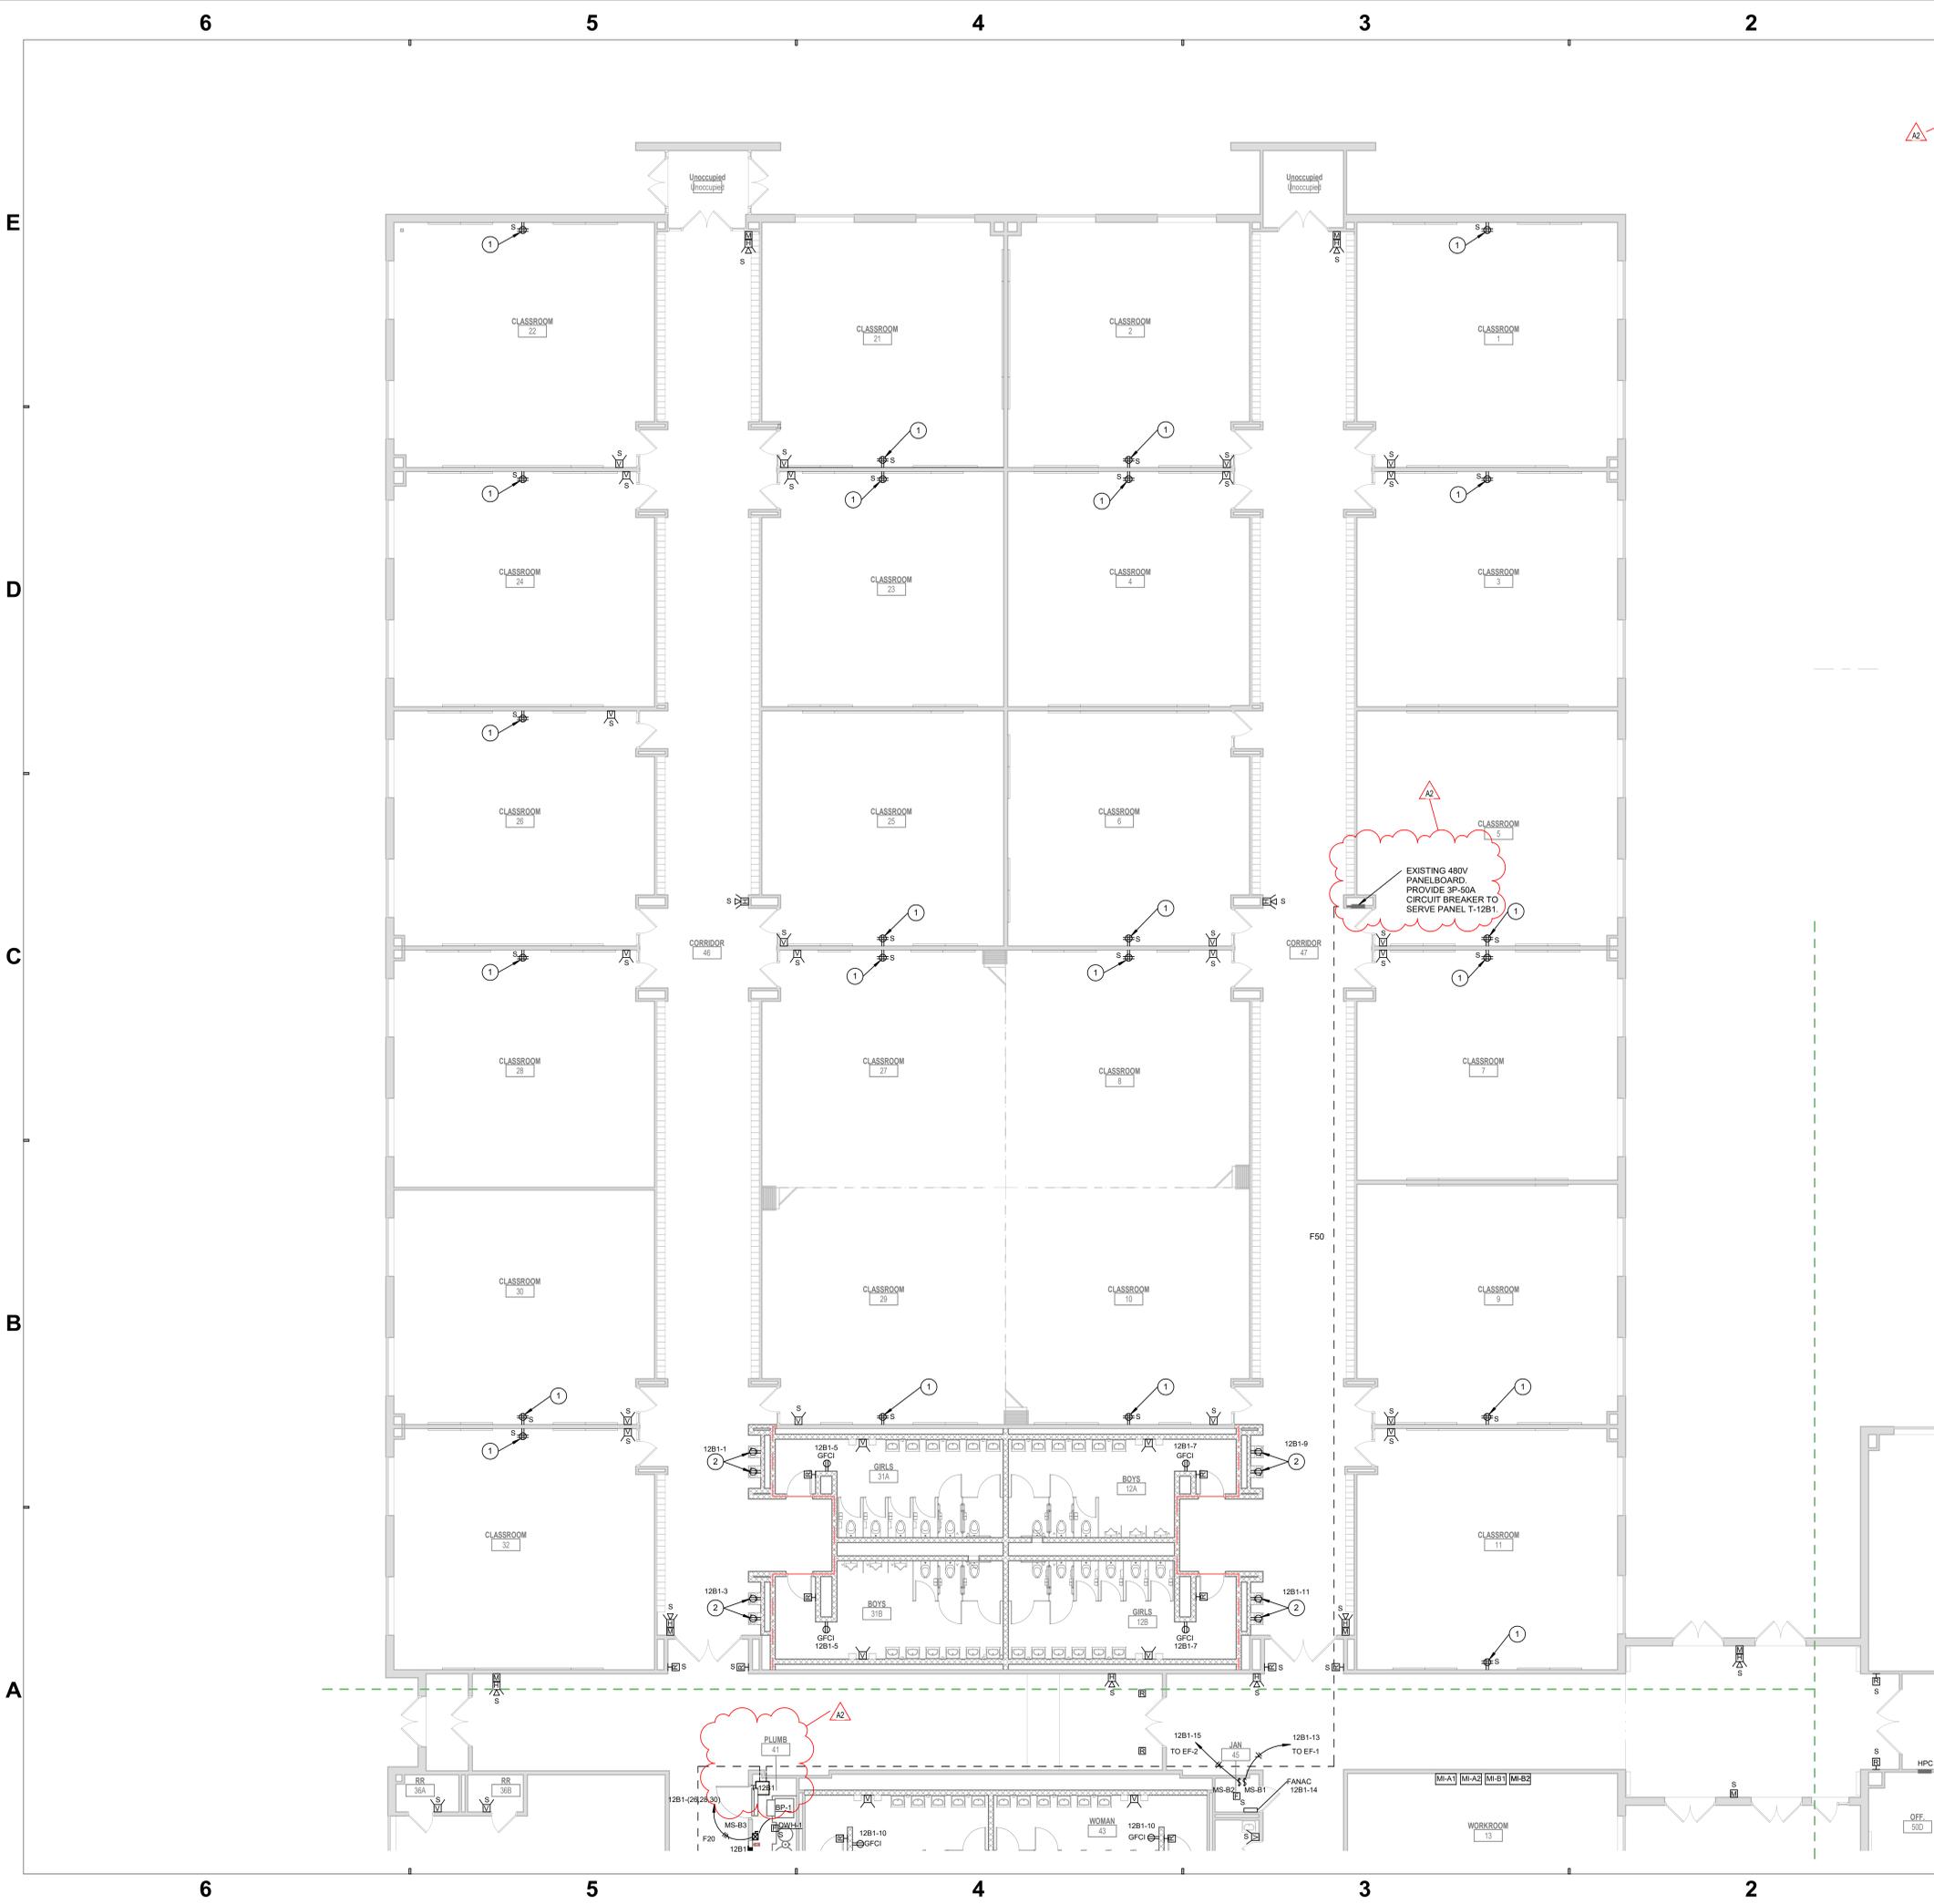

GENERAL POWER NOTES

#	NOTES
A	REFER TO SHEET E-001 FOR ADDITIONAL INFORMATION.

POWER PLAN NOTES

#	NOTES
1	PROVIDE QUADRAPLEX POWER RECEPTACLE TO SERVE WALL MOUNT SMART DISPLAY. CONNECT POWER RECEPTACLE TO EXISTING POWER CIRCUIT SERVING EXISTING PROJECTOR / SMARTBOARD. COORDINATE FINAL ROUGH-IN LOCATION WITH T-SERIES DRAWINGS PRIOR TO ROUGH-IN.
2	PROVIDE GFCI CIRCUIT BREAKER.
3	PROVIDE FLEXIBLE WIRING FROM OUTLET BOX ON WALL TO DEVICE LOCATED ON BLEACHERS.
4	INSTALL RECEPTACLE ON BOTTOM RISER OF BLEACHERS. CONNECT TO FLEXIBLE CABLE FROM WALL OUTLET BOX.
5	INSTALL SCOREBOARD OUTLET IN BOTTOM RISER OF BLEACHERS. CONNECT TO FLEXIBLE CABLE FROM WALL OUTLET BOX.
6	12" X 12" X 6" JUNCTION BOX FOR MOTORIZED BLEACHERS. INSTALL BOX AT +5'-0" A.F. TO CL. INSTALL IN LOCATION AS RECOMMENDED BY BLEACHER MANUFACTURER. CONTACTORS AND CONTROLLERS ARE PROVIDED AND WIRED BY THE MANUFACTURER. INSTALL (1) 3/4" C BETWEEN JUNCTION BOX AND ADJACENT DISCONNECT SWITCH. CONNECT COMPLETE.
7	INSTALL (1) 1" CONDUIT FROM OUTLET BOX TO SCOREBOARD FOR CONTROL WIRING.
8	PROVIDE QUADRAPLEX RECEPTACLE TO SERVE WALL MOUNT DISPLAY. COORDINATE FINAL OUTLET BOX LOCATION WITH OWNER PRIOR TO ROUGH-IN.
9	PROVIDE FLOOR BOX. REFER TO EQUIPMENT SCHEDULES FOR ADDITIONAL INFORMATION. VERIFY FINAL FLOOR BOX LOCATION IN FIELD WITH OWNER PRIOR TO INSTALLATION.
10	FEED DISCONNECT SWITCH FROM CORRESPONDING ROOF MOUNTED CONDENSING UNIT (CU). CONNECT COMPLETE TO SPLIT SYSTEM UNIT (SS).


SCHMIDT ASSOCIATES
415 Massachusetts Avenue
Indianapolis, IN 46204
www.schmidt-arch.com

Project No. 2020-154.SMS
Project Date 07.26.2021
Produced JH GL

Sarah K. Hempstead

These Drawings and Specifications, and all copies thereof are and shall remain the property and copyright of the Architect. They shall be used only with respect to this Project and are not to be used on any other Project or Work without prior written permission from the Architect.

#	Revision	Date
A1	Addendum 1	08.11.2021
A2	Addendum 2	08.18.2021

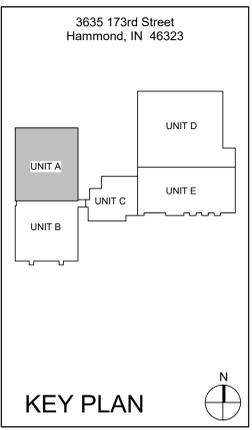

School City of Hammond

School City of Hammond


Scott Middle School - Renovations

FIRST FLOOR POWER PLAN - UNIT A

EP1A1

2A FIRST FLOOR POWER PLAN - UNIT A
1/8" = 1'-0"

DATE: 08/18/2021 10:00 AM
DRAWN BY: JH
CHECKED BY: GL
PROJECT: 2020-154.SMS
SHEET: EP1A1

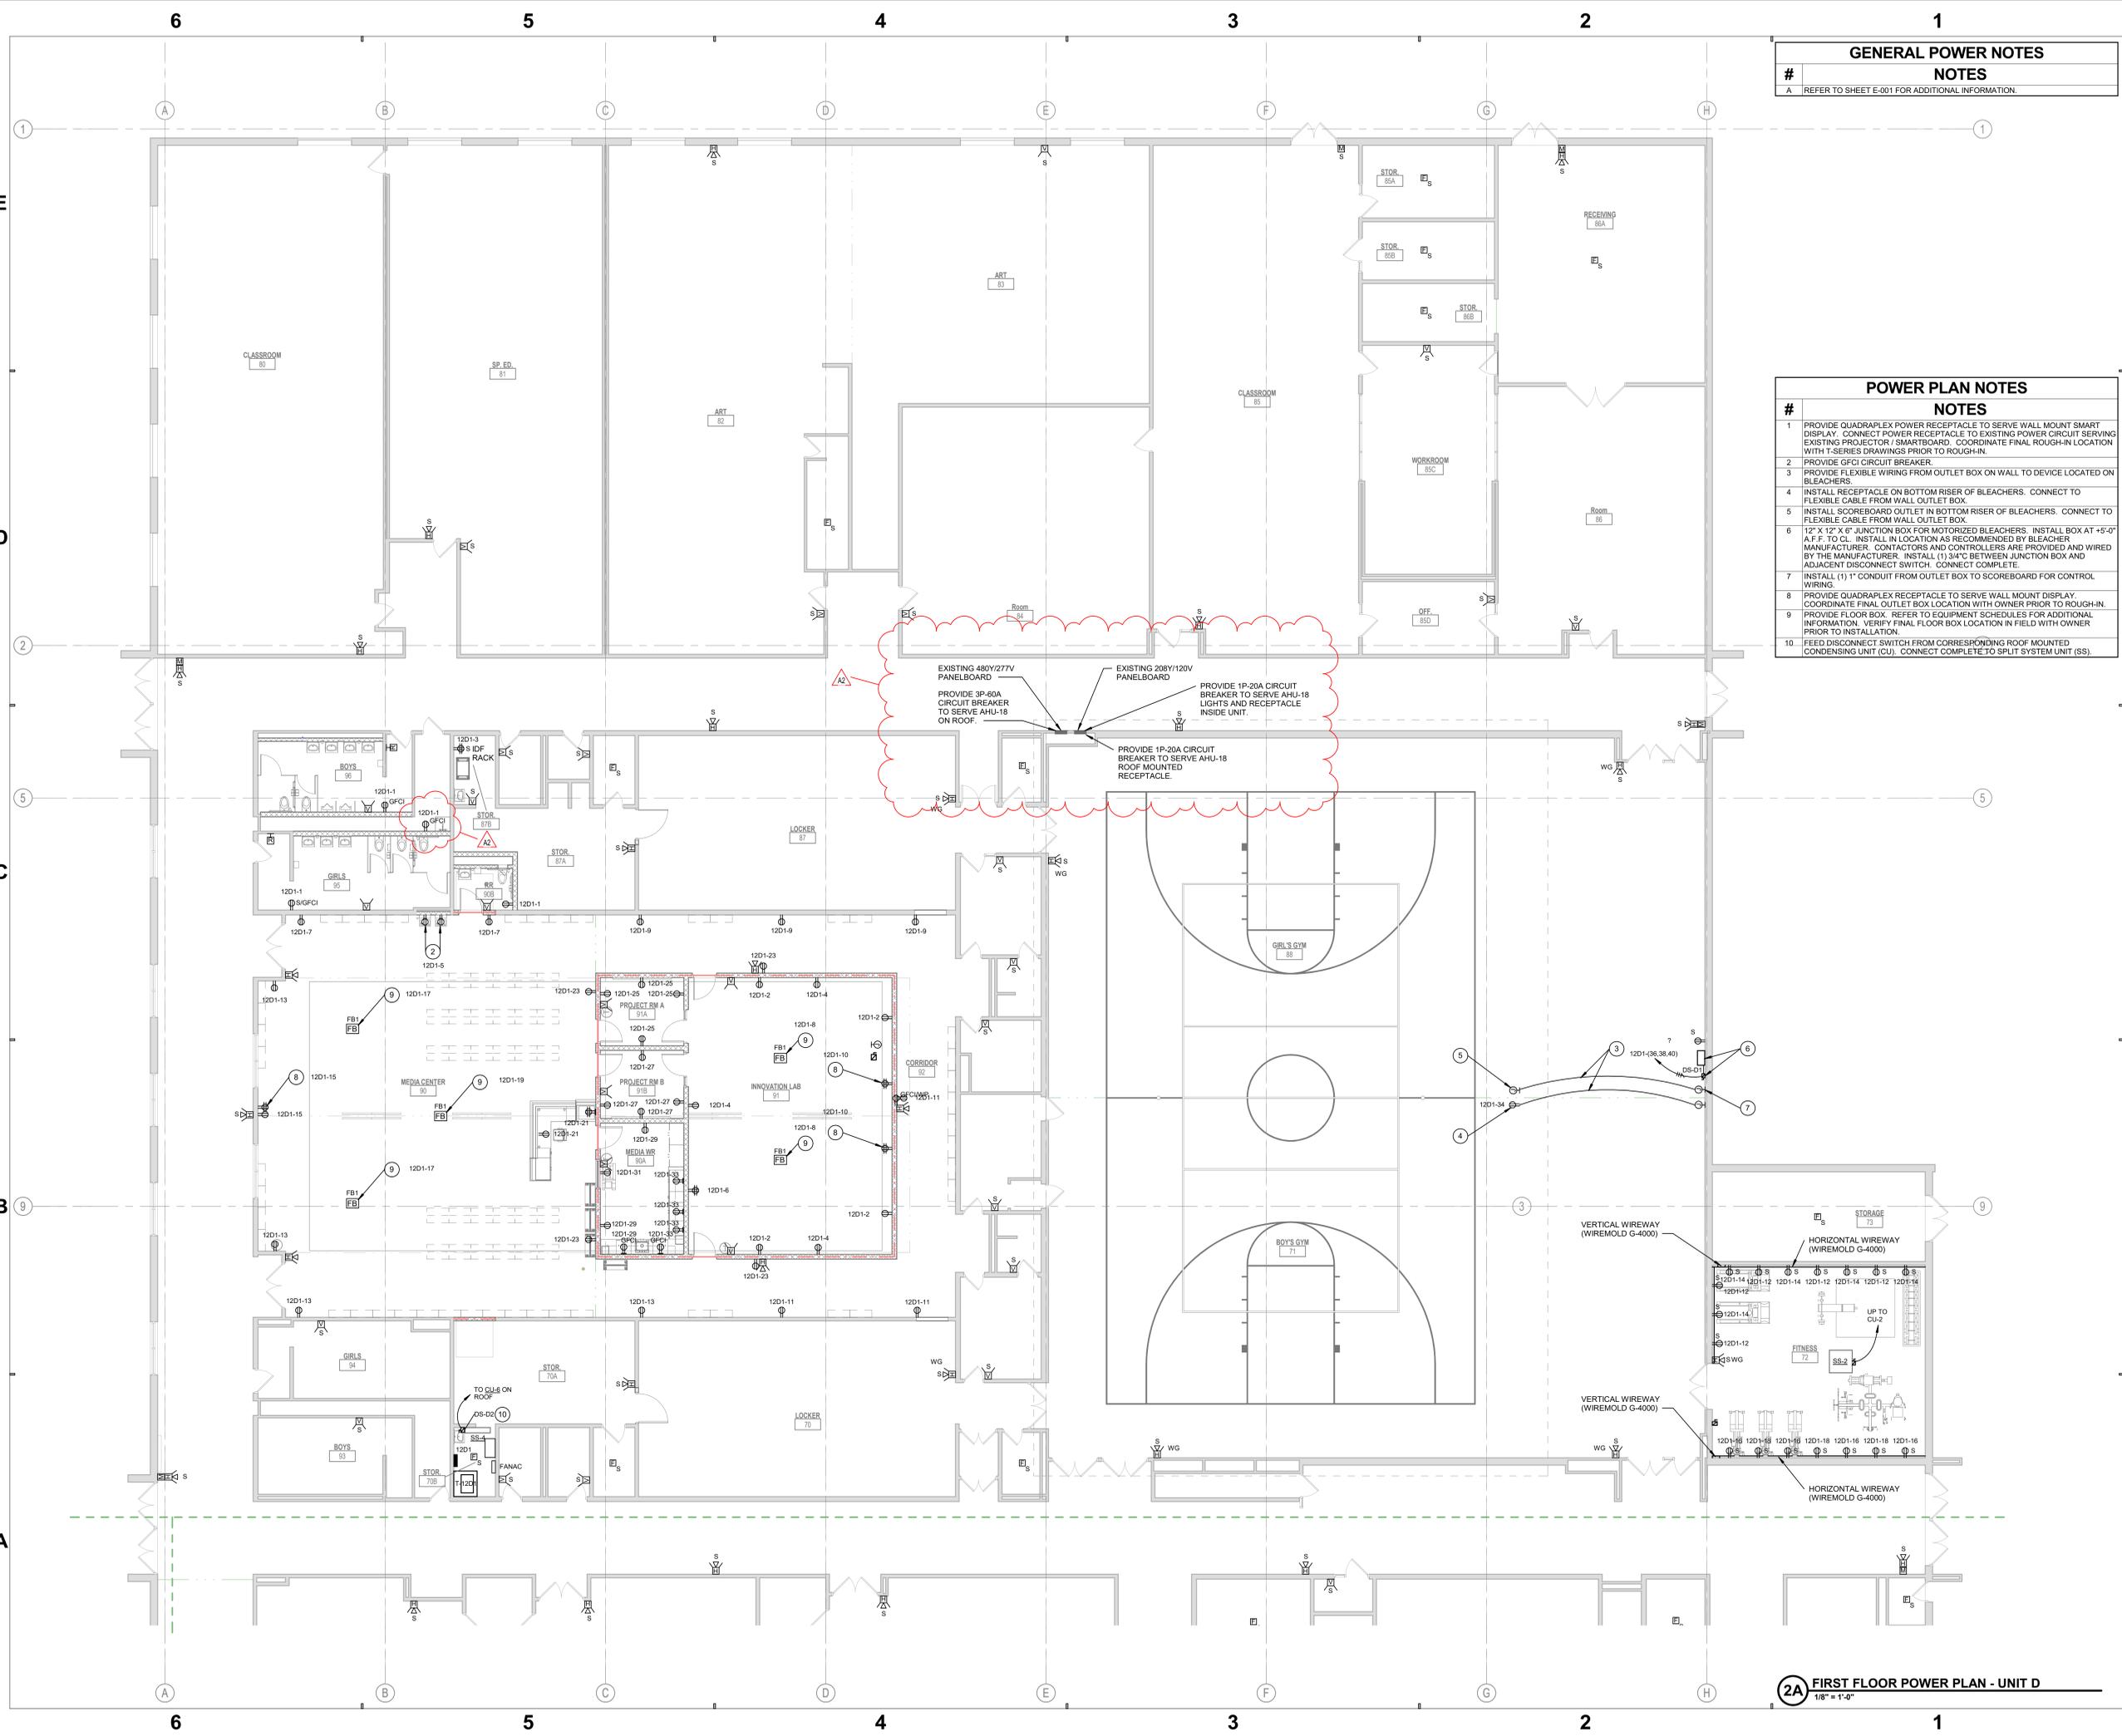

GENERAL POWER NOTES	
#	NOTES
A	REFER TO SHEET E-001 FOR ADDITIONAL INFORMATION.

POWER PLAN NOTES	
#	NOTES
1	PROVIDE QUADRAPLEX POWER RECEPTACLE TO SERVE WALL MOUNT SMART DISPLAY. CONNECT POWER RECEPTACLE TO EXISTING POWER CIRCUIT SERVING EXISTING PROJECTOR / SMARTBOARD. COORDINATE FINAL ROUGH-IN LOCATION WITH T-SERIES DRAWINGS PRIOR TO ROUGH-IN.
2	PROVIDE GFCI CIRCUIT BREAKER.
3	PROVIDE FLEXIBLE WIRING FROM OUTLET BOX ON WALL TO DEVICE LOCATED ON BLEACHERS.
4	INSTALL RECEPTACLE ON BOTTOM RISER OF BLEACHERS. CONNECT TO FLEXIBLE CABLE FROM WALL OUTLET BOX.
5	INSTALL SCOREBOARD OUTLET IN BOTTOM RISER OF BLEACHERS. CONNECT TO FLEXIBLE CABLE FROM WALL OUTLET BOX.
6	12" X 12" X 6" JUNCTION BOX FOR MOTORIZED BLEACHERS. INSTALL BOX AT +5'-0" A.F.F. TO CL. INSTALL IN LOCATION AS RECOMMENDED BY BLEACHER MANUFACTURER. CONTACTORS AND CONTROLLERS ARE PROVIDED AND WIRED BY THE MANUFACTURER. INSTALL (1) 3/4" C BETWEEN JUNCTION BOX AND ADJACENT DISCONNECT SWITCH. CONNECT COMPLETE.
7	INSTALL (1) 1" CONDUIT FROM OUTLET BOX TO SCOREBOARD FOR CONTROL WIRING.
8	PROVIDE QUADRAPLEX RECEPTACLE TO SERVE WALL MOUNT DISPLAY. COORDINATE FINAL OUTLET BOX LOCATION WITH OWNER PRIOR TO ROUGH-IN.
9	PROVIDE FLOOR BOX. REFER TO EQUIPMENT SCHEDULES FOR ADDITIONAL INFORMATION. VERIFY FINAL FLOOR BOX LOCATION IN FIELD WITH OWNER PRIOR TO INSTALLATION.
10	FEED DISCONNECT SWITCH FROM CORRESPONDING ROOF MOUNTED CONDENSING UNIT (CU). CONNECT COMPLETE TO SPLIT SYSTEM UNIT (SS).

SCHMIDT ASSOCIATES
415 Massachusetts Avenue
Indianapolis, IN 46204
www.schmidt-arch.com


Project No. 2020-154.SMS
Project Date 07.26.2021
Produced JH GL

Sarah K. Hempstead

These Drawings and Specifications, and all copies thereof are and shall remain the property and copyright of the Architect. They shall be used only with respect to this Project and are not to be used on any other Project or Work without prior written permission from the Architect.

#	Revision	Date
A1	Addendum 1	08.11.2021
A2	Addendum 2	08.18.2021

3635 173rd Street
Hammond, IN 46323

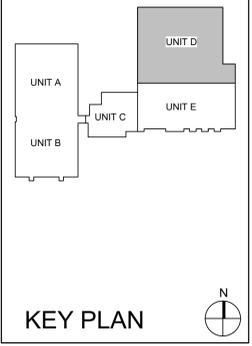

School City of Hammond

School City of Hammond


Scott Middle School
- Renovations

FIRST FLOOR POWER PLAN - UNIT D

EP1D1

2A FIRST FLOOR POWER PLAN - UNIT D
1/8" = 1'-0"

DATE: 08/11/2021 10:00 AM
DRAWN BY: JH
CHECKED BY: GL
PROJECT: 2020-154.SMS
SHEET: EP1D1

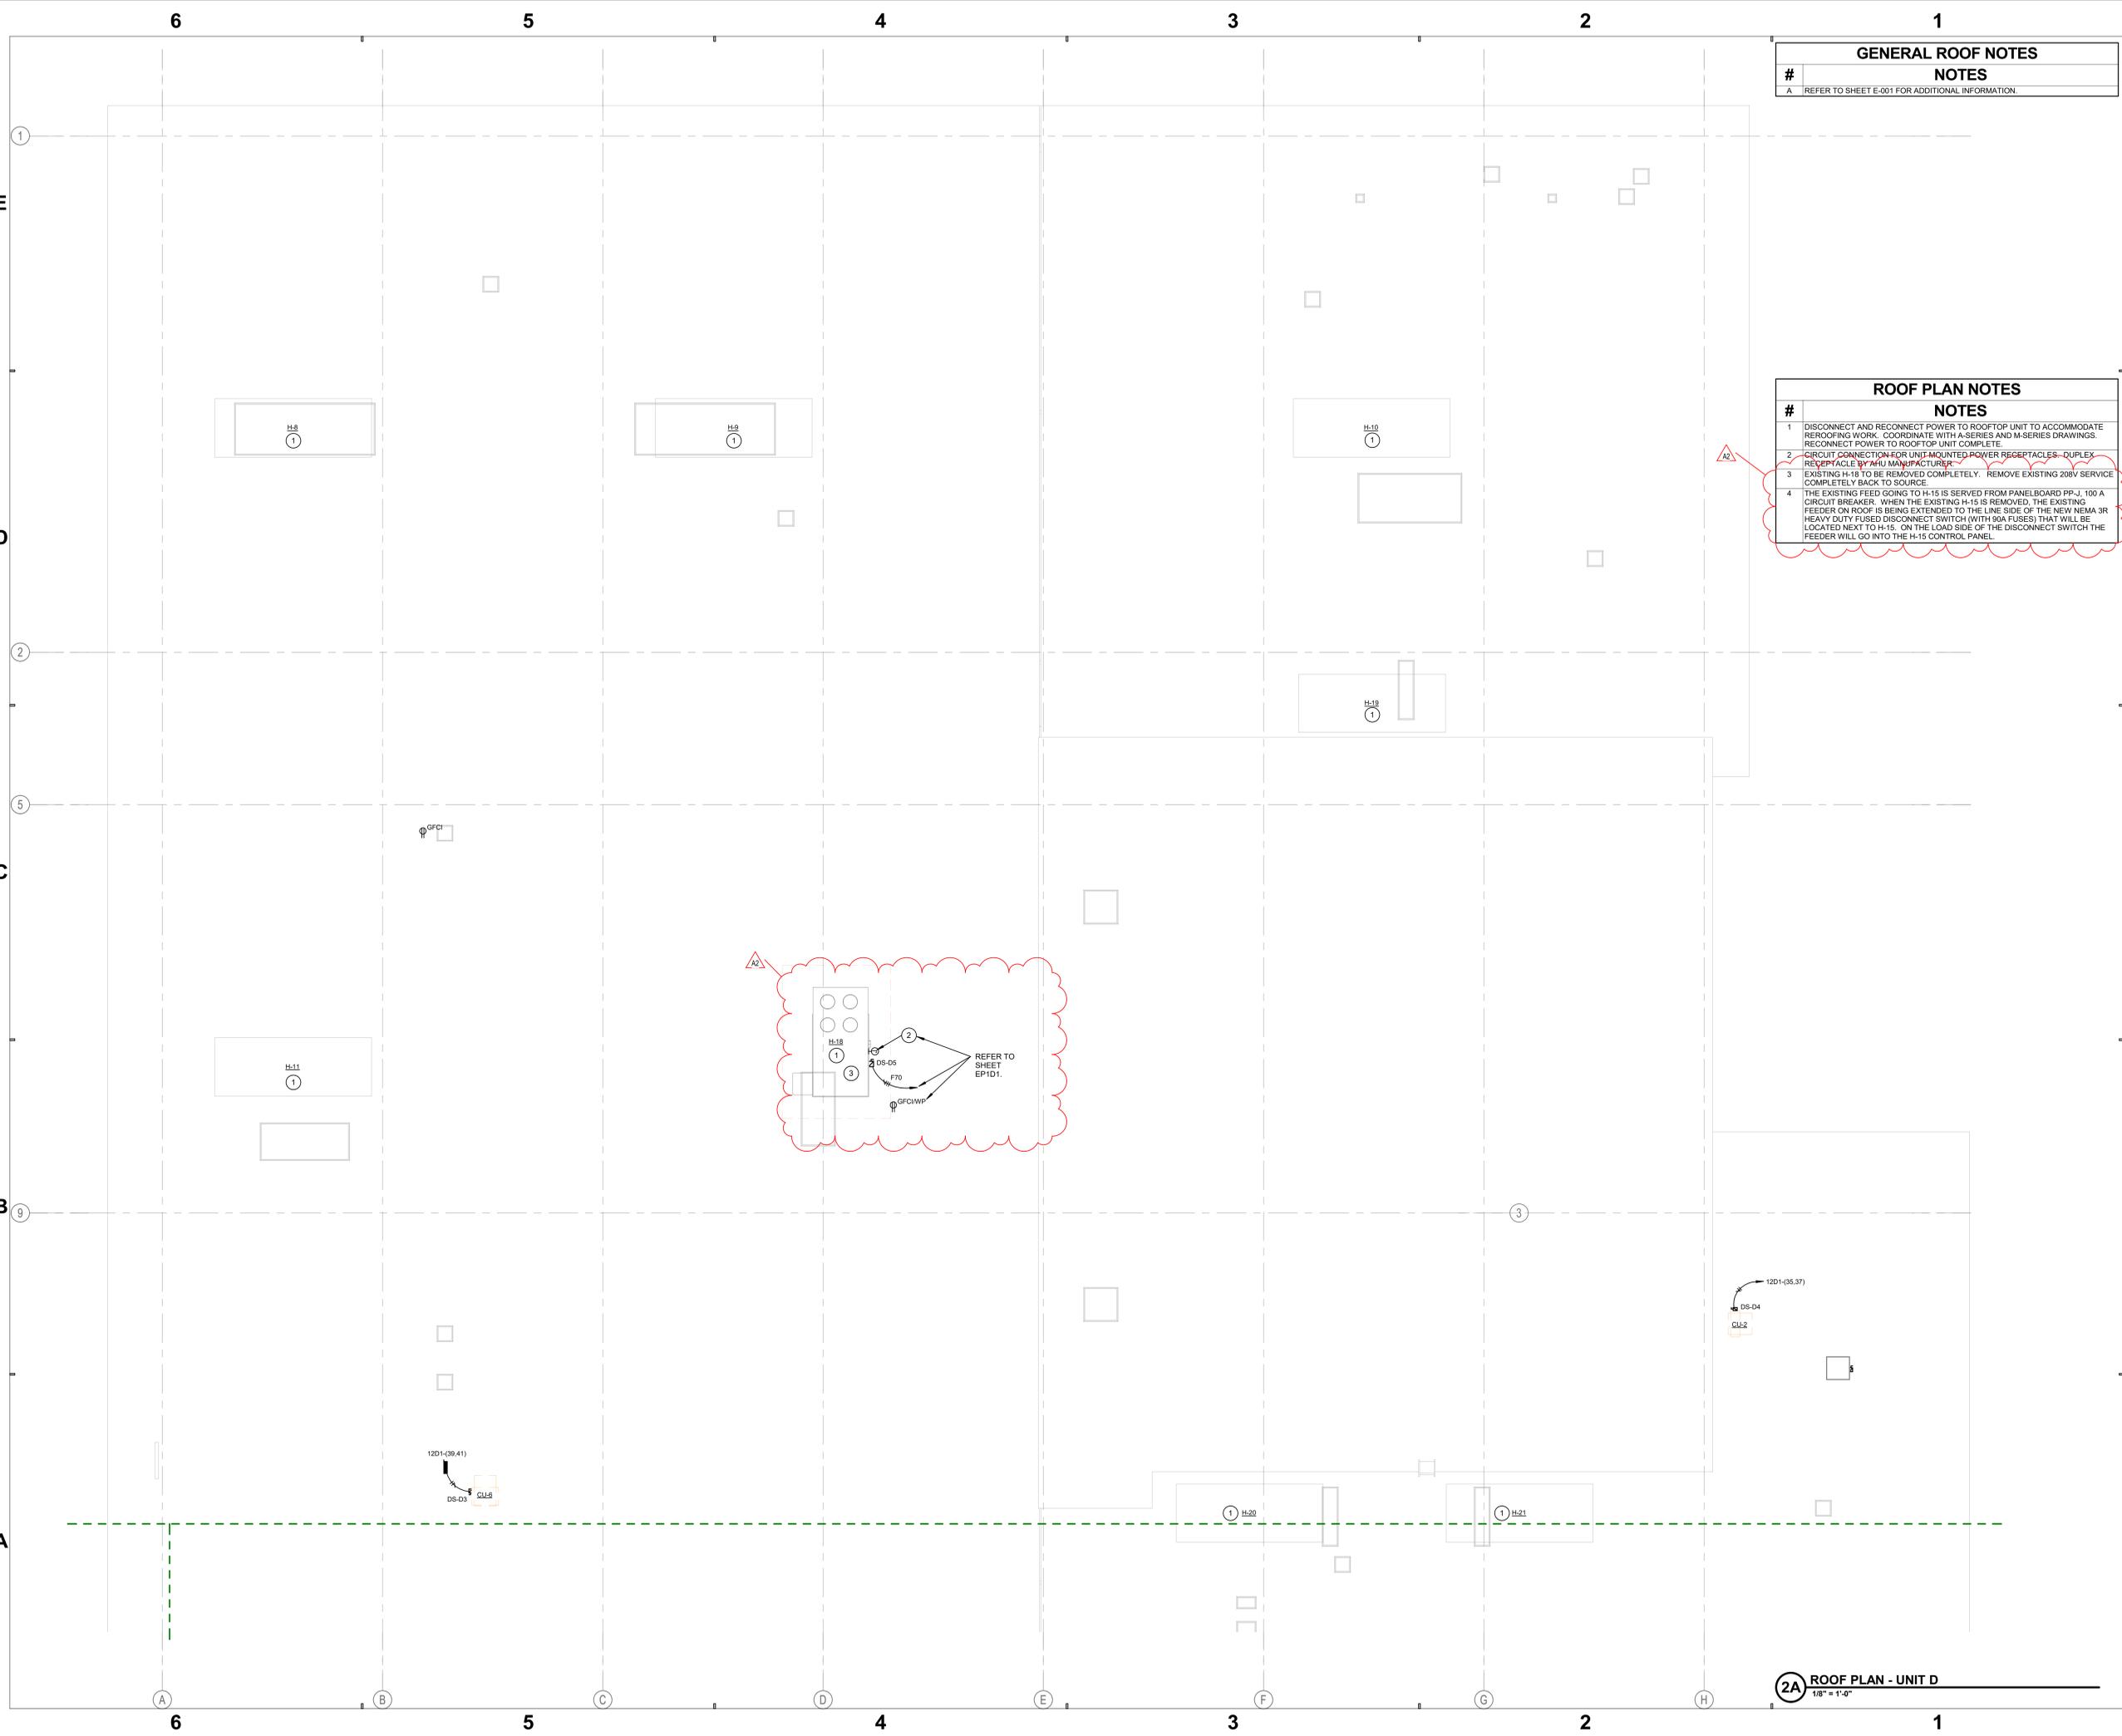


GENERAL ROOF NOTES

#	NOTES
A	REFER TO SHEET E-001 FOR ADDITIONAL INFORMATION.

ROOF PLAN NOTES



#	NOTES
1	DISCONNECT AND RECONNECT POWER TO ROOFTOP UNIT TO ACCOMMODATE REROOFING WORK. COORDINATE WITH A-SERIES AND M-SERIES DRAWINGS. RECONNECT POWER TO ROOFTOP UNIT COMPLETE.
2	CIRCUIT CONNECTION FOR UNIT MOUNTED POWER RECEPTACLES - DUPLEX RECEPTACLE BY MJJ MANUFACTURING.
3	EXISTING H-18 TO BE REMOVED COMPLETELY. REMOVE EXISTING 208V SERVICE COMPLETELY BACK TO SOURCE.
4	THE EXISTING FEED GOING TO H-15 IS SERVED FROM PANELBOARD PP-J. 100 A CIRCUIT BREAKER. WHEN THE EXISTING H-15 IS REMOVED, THE EXISTING FEEDER ON ROOF IS BEING EXTENDED TO THE LINE SIDE OF THE NEW NEMA 3R HEAVY DUTY FUSED DISCONNECT SWITCH (WITH 90A FUSES) THAT WILL BE LOCATED NEXT TO H-15. ON THE LOAD SIDE OF THE DISCONNECT SWITCH THE FEEDER WILL GO INTO THE H-15 CONTROL PANEL.

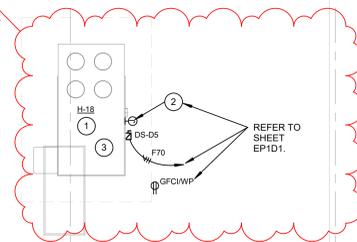

Project No. 2020-154.SMS
 Project Date 07.26.2021
 Produced JH GL



#	Revision	Date
A1	Addendum 1	08.11.2021
A2	Addendum 2	08.18.2021

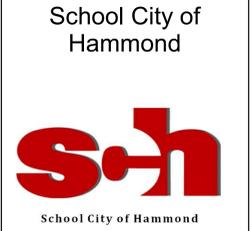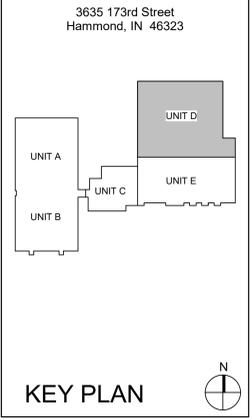

Scott Middle School - Renovations

ROOF PLAN - UNIT D


ER1D1

2A ROOF PLAN - UNIT D
 1/8" = 1'-0"

8/25/21 08:51 AM 10/1/21
 2020-154.SMS School City of Hammond
 3635 173rd Street Hammond, IN 46323
 311.222.2222
 www.schmidt-arch.com


GENERAL LIGHTING NOTES
NOTES
A REFER TO SHEET E-001 FOR ADDITIONAL INFORMATION.

BRANCH PANELBOARD SCHEDULE												
DESIGNATION: 12D1-T		VOLTS: 208Y/120 V				MAINS RATING: 125 A						
LOCATION: Space 205		PHASES: 3				MAINS TYPE: MCB						
MOUNTING: SURFACE		WIRES: 4										
SUPPLY FROM:		AIC RATING:										
QCT NO.	CIRCUIT ROOM #	CIRCUIT TYPE	TRIP	P	A	B	C	P	TRIP	CIRCUIT TYPE	CIRCUIT ROOM #	QCT NO.
1	CLASSROOM LIGHTING	LIGHTING	20 A	1	1.20	0.00			1	20 A	SPARE	2
3	CLASSROOM LIGHTING	LIGHTING	20 A	1		1.20	0.00		1	20 A	SPARE	4
5	CORRIDOR LIGHTING	LIGHTING	20 A	1			1.00	0.00	1	20 A	SPARE	6
7	CLASSROOM TEACHER DESK	RECEPT	20 A	1	1.00	0.00			1	20 A	SPARE	8
9	CLASSROOM CONVENIENCE	RECEPT	20 A	1		1.00	0.00		1	20 A	SPARE	10
11	CLASSROOM CONVENIENCE	RECEPT	20 A	1			0.00	0.00	1	20 A	SPARE	12
13	CLASSROOM TEACHER DESK	RECEPT	20 A	1	1.00	0.00			1	20 A	SPARE	14
15	CLASSROOM CONVENIENCE	RECEPT	20 A	1		0.00	0.00		1	20 A	SPARE	16
17	CLASSROOM CONVENIENCE	RECEPT	20 A	1			0.00	0.00	1	20 A	SPARE	18
19	CLASSROOM TEACHER DESK	RECEPT	20 A	1	0.00	0.00			1	20 A	SPARE	20
21	CLASSROOM CONVENIENCE	RECEPT	20 A	1		0.00	0.00		1	20 A	SPARE	22
23	CLASSROOM CONVENIENCE	RECEPT	20 A	1			0.00	0.00	1	20 A	SPARE	24
25	CLASSROOM TEACHER DESK	RECEPT	20 A	1	0.00	0.00			1	20 A	SPARE	26
27	CLASSROOM CONVENIENCE	RECEPT	20 A	1		0.00	0.00		1	20 A	SPARE	28
29	CLASSROOM CONVENIENCE	RECEPT	20 A	1			0.00	0.00	1	20 A	SPARE	30
31	SPARE		20 A	1	0.00	0.00			1	20 A	SPARE	32
33	SPARE		20 A	1		0.00	0.00		1	20 A	SPARE	34
35	SPARE		20 A	1			0.00	0.00	1	20 A	SPARE	36
37	SPARE		20 A	1	0.00	0.00			1	20 A	SPARE	38
39	SPARE		20 A	1		0.00	0.00		1	20 A	SPARE	40
41	SPARE		20 A	1			0.00	0.00	1	20 A	SPARE	42
TOTAL LOAD:					3.20 kVA	2.20 kVA	1.00 kVA					
TOTAL AMPS:					28 A	20 A	8 A					
TOTAL CONNECTED LOAD:					6.40 kVA			TOTAL DEMAND LOAD:				
TOTAL CONNECTED AMPS:					28 A			TOTAL DEMAND AMPS:				
PANELBOARD & CIRCUIT BREAKER OPTIONS		LOAD CLASSIFICATION		CONNECTED LOAD (VA)		DEMAND FACTOR		ESTIMATE DEMAND (VA)				
("O" COLUMN / MCB OPTIONS ABBREVIATIONS)		Spare		6400 VA		100.00%		6400 VA				
C	CONTACTOR CONTROLLED											
G	GFCI PROTECTED											
P	HANDLE LOCKING DEVICE											
S	SHUNT TRIP											
X	80% RATED MAIN CIRCUIT BREAKER WITH LSI											
Y	100% RATED MAIN CIRCUIT BREAKER WITH LSI											
Z	100% RATED MAIN CIRCUIT BREAKER WITH LSI/G											
FEED THROUGH LUGS (FTL)												
SUB FEED LUGS (SFL)												
NOTES: 1. THESE CIRCUITS ARE PANELBOARD 12D1 TEMPORARY CIRCUITS TO SERVE TEMPORARY CLASSROOMS. REFER TO PANEL 12D1 FOR FINAL CIRCUIT CONFIGURATIONS. PANELBOARD 12D1 AND 12D1-T ARE THE SAME PANELBOARD.												

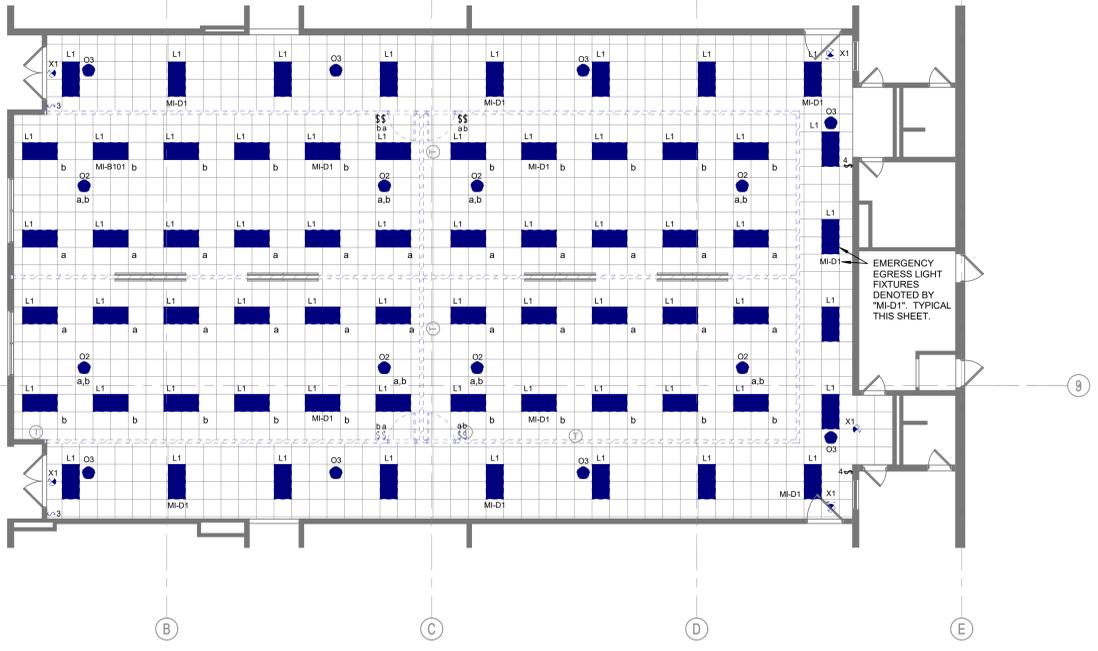

4D TEMPORARY FIRST FLOOR LIGHTING PLAN - UNIT D
1/8" = 1'-0"

GENERAL POWER NOTES
NOTES
A REFER TO SHEET E-001 FOR ADDITIONAL INFORMATION.

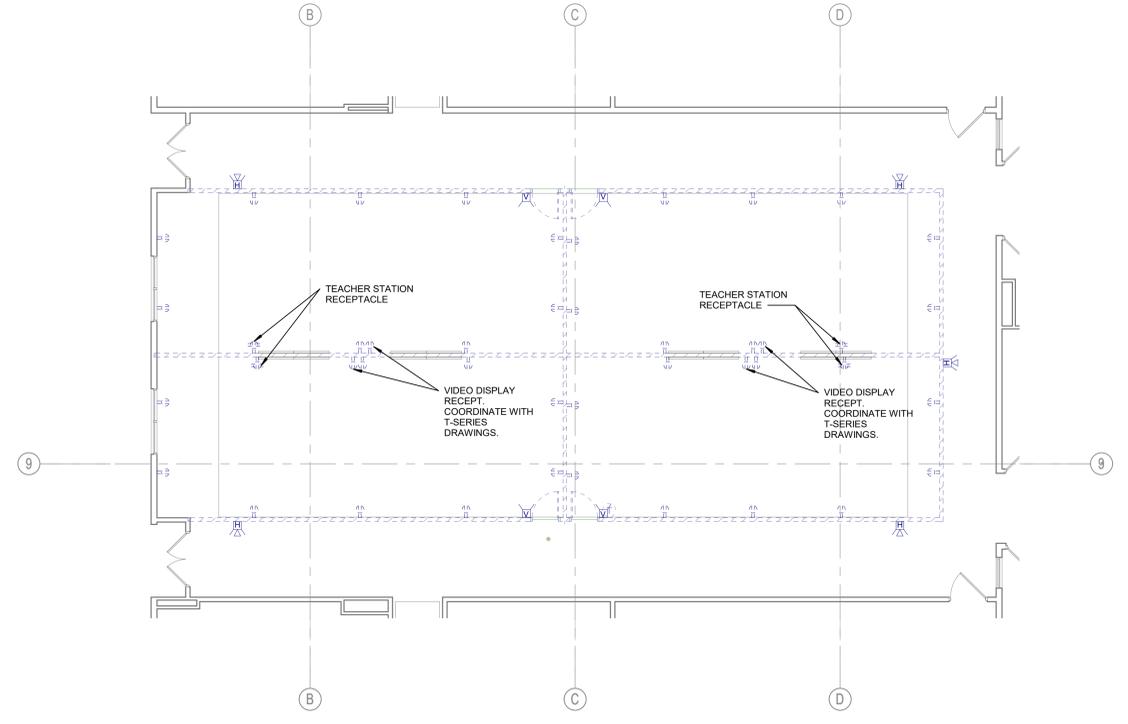

4A TEMP FIRST FLOOR POWER PLAN - UNIT D
1/8" = 1'-0"





Project No. 2020-154-SMS
Project Date 07.26.2021
Produced JH GL



These Drawings and Specifications, and all copies thereof are and shall remain the property and copyright of the Architect. They shall be used only with respect to this Project and are not to be used on any other Project or Work without prior written permission from the Architect.


#	Revision	Date
A2	Addendum 2	08.18.2021

3635 173rd Street
Hammond, IN 46323

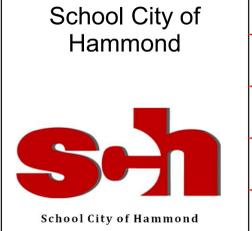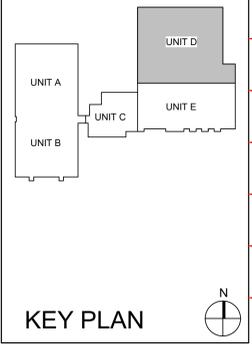


Scott Middle School
- Renovations


PARTIAL FIRST FLOOR
UNIT D PLANS

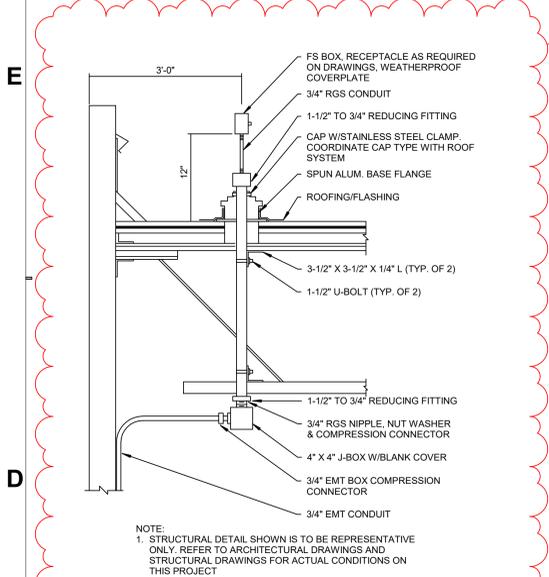



5D ROOF MOUNTED RECEPTACLE MOUNTING DETAIL
N.T.S.

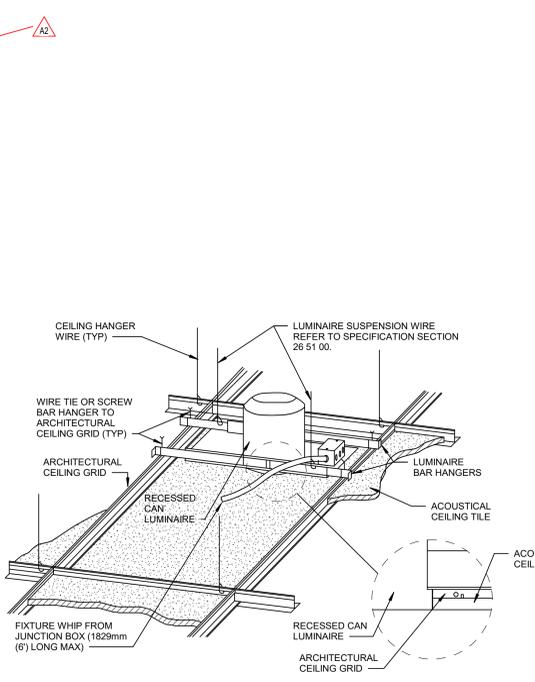


3D EXIT SIGN MOUNTING - LAY-IN CEILING DETAIL
N.T.S.

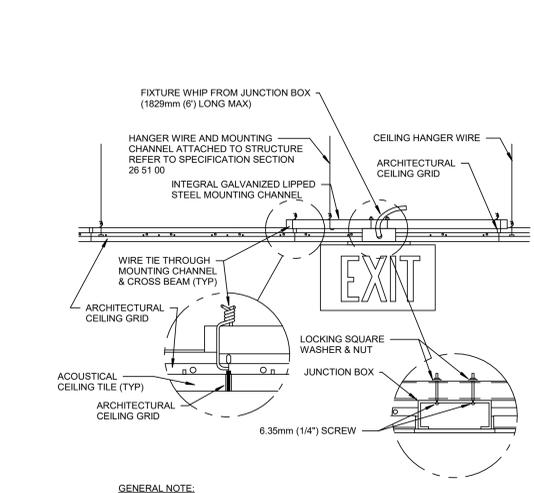


1D RECESSED LIGHTING INSTALLATION
N.T.S.

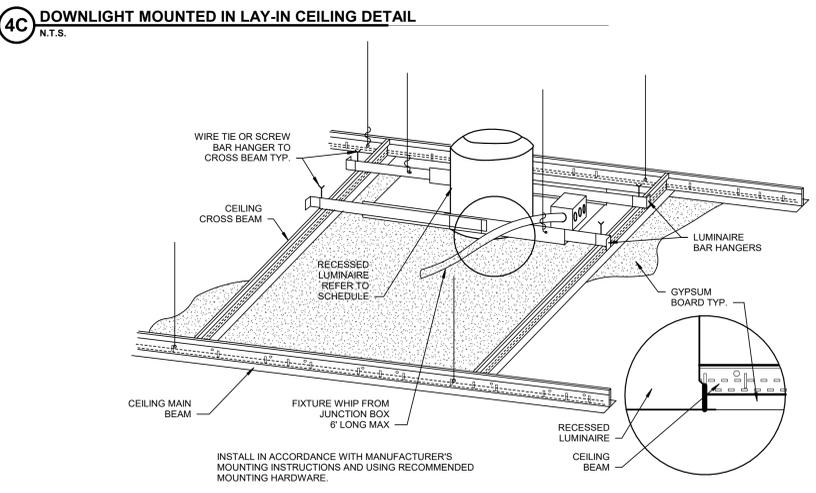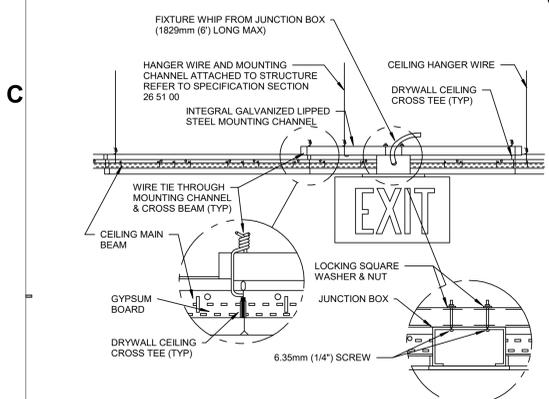

3B DOWNLIGHT MOUNTED IN GYPBOARD CEILING DETAIL
N.T.S.

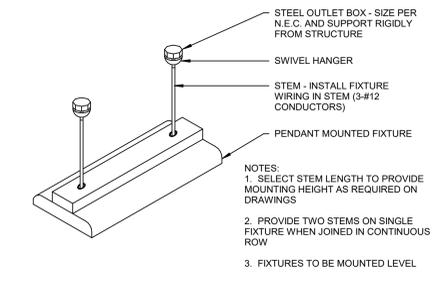


2C STEM MOUNTED LIGHTING INSTALLATION
N.T.S.

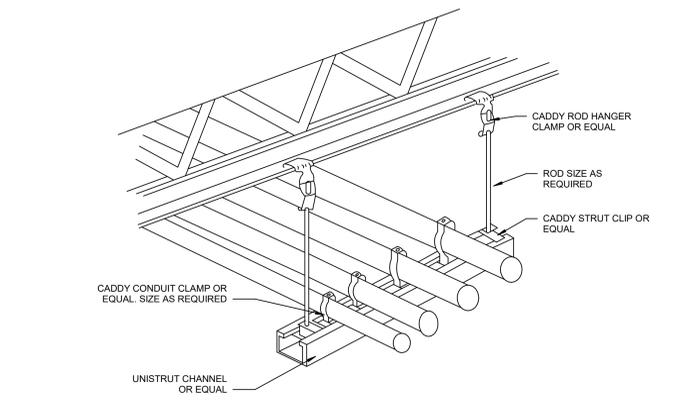


1C CONDUIT 2-1/2\"/>




5B EXIT SIGN MOUNTING - GYPBOARD CEILING DETAIL
N.T.S.

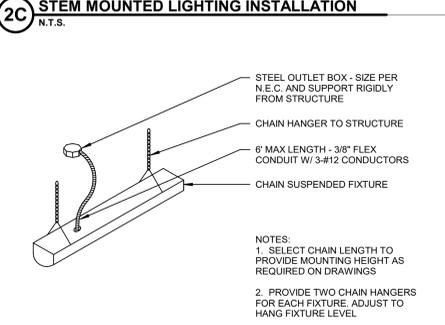


2B CHAIN SUSPENDED LIGHTING INSTALLATION
N.T.S.

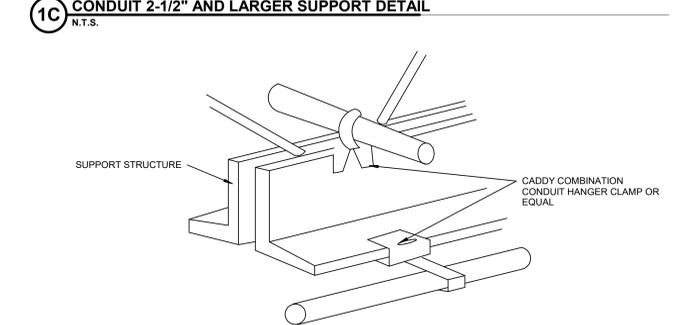


1B CONDUIT 2\"/>

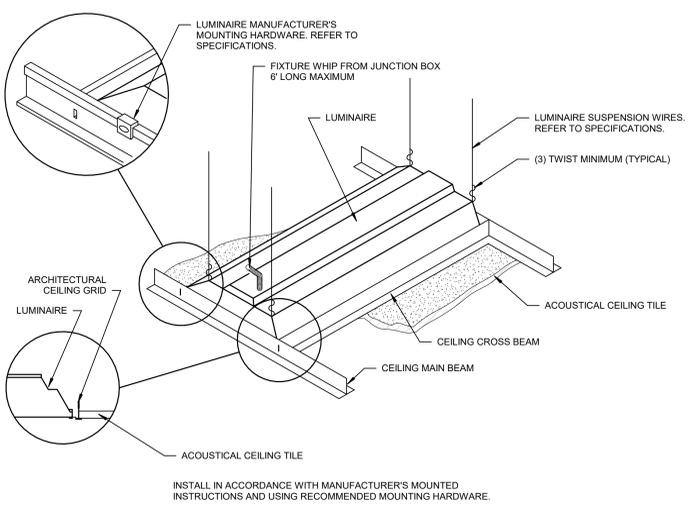

4A LUMINAIRE MOUNTED IN LAY-IN CEILING DETAIL
N.T.S.

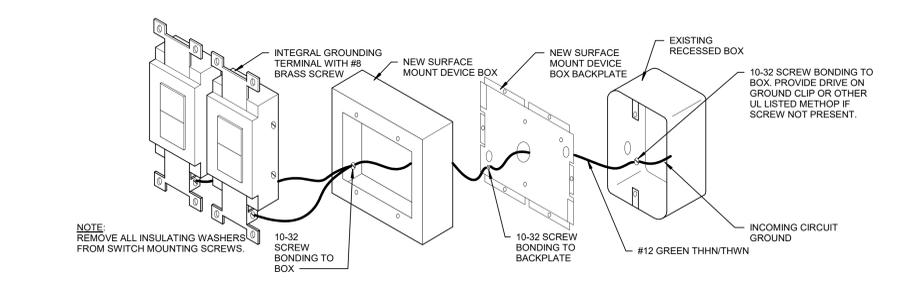

2A GROUNDING DETAIL FOR SURFACE-MOUNTED LIGHT SWITCH OVER EXISTING RECESSED BOX
N.T.S.

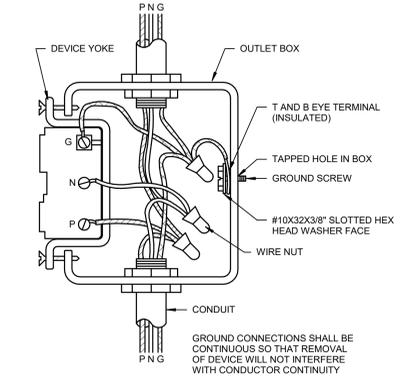

1A DEVICE GROUNDING DETAIL
N.T.S.


SCHMIDT ASSOCIATES
415 Massachusetts Avenue
Indianapolis, IN 46204
www.schmidt-arch.com

Project No. 2020-154.SMS
Project Date 07.26.2021
Produced Designer Author

These Drawings and Specifications, and all copies thereof are and shall remain the property and copyright of the Architect. They shall be used only with respect to this Project and are not to be used on any other Project or Work without prior written permission from the Architect.

#	Revision	Date
A2	Addendum 2	08.18.2021

3635 173rd Street
Hammond, IN 46323

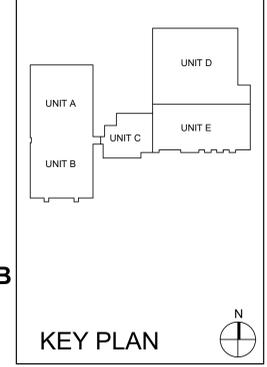

School City of Hammond

School City of Hammond

Scott Middle School - Renovations

DETAILS
E-501

1800 07/2021
 2020-154.SMS School City of Hammond Public Works Dept - Renovations
 1800 07/2021
 2020-154.SMS School City of Hammond Public Works Dept - Renovations
 1800 07/2021



SCHMIDT ASSOCIATES
 415 Massachusetts Avenue
 Indianapolis, IN 46204
 www.schmidt-arch.com

Project No. 2020-154-SMS
 Project Date 07.26.2021
 Produced Designer Author




Sarah K. Hempstead

These Drawings and Specifications, and all copies thereof are and shall remain the property and copyright of the Architect. They shall be used only with respect to this Project and are not to be used on any other Project or Work without prior written permission from the Architect.

#	Revision	Date
A2	Addendum 2	08.18.2021


HEATING and for COOLING UNITS SCHEDULE												
MARK	ITEM	TOTAL CFM	CFM F.A. MIN.	HEATING INPUT MBH	HEATING OUTPUT MBH	COOLING OUTPUT MBH	FAN H.P.	EXT. S.P.	COND. UNIT	NO. ZONES	NO. DAMPER MOTORS	REMARKS
H-1	MULTIZONE H.V. & A.C.	7500	1875	500	375	275	5	1/2"	C-24	6	6	
H-2	MULTIZONE H.V. & A.C.	8500	2125	500	375	275	5	1/2"	C-24	7	7	
H-3	MULTIZONE H.V. & A.C.	7500	1875	500	375	275	5	1/2"	C-24	6	6	
H-4	MULTIZONE H.V. & A.C.	7250	1810	500	375	275	5	1/2"	C-24	6	6	
H-5	MULTIZONE H.V. & A.C.	8000	2000	500	375	275	5	1/2"	C-24	8	8	
H-6	MULTIZONE H.V. & A.C.	7250	1810	500	375	275	5	1/2"	C-24	6	6	
H-7	MULTIZONE H.V. & A.C.	6000	1500	500	375	205	2	1/2"	C-17	4	4	
H-8	MULTIZONE H.V. & A.C.	6000	1500	500	375	205	2	1/2"	C-22	2	2	
H-9	MULTIZONE H.V. & A.C.	6900	1600	500	375	205	3	1/2"	C-22	4	4	
H-10	MULTIZONE H.V. & A.C.	9000	2250	500	375	275	5	1/2"	C-24	3	3	
H-11	MULTIZONE H.V. & A.C.	7000	1750	500	375	275	5	1/2"	C-24	8	8	
H-12	MULTIZONE H.V. & A.C.	7000	1750	500	375	275	7/2"	1/2"	C-24	5	5	
H-13	MULTIZONE H.V. & A.C.	9000	2250	500	375	275	7/2"	1/2"	C-24	6	6	
H-14	MULTIZONE H.V. & A.C.	8000	2000	500	375	275	5	1/2"	C-24	4	4	
H-15	MULTIZONE H.V. & A.C.	6725	1675	500	375	205	3	1/2"	C-22	7	7	
H-16	MULTIZONE H.V. & A.C.	6100	1525	940	700	200	3	1/2"	HSA1-200	1	1	
H-17	HEATING & VENT.	13000	3250	1250	1000		7 1/2"	5/8"				
H-18	HEATING & VENT.	9000	2250	1250	1000		5	1/2"				
H-19	HEATING & VENT.	9000	2250	1250	1000		5	1/2"				
H-20	HEATING & VENT.	9000	2250	1250	1000		5	1/2"				
H-21	HEATING & VENT.	9000	2250	1250	1000		5	1/2"				
H-22	UNIT HEATER	1250		115.0	92.0			1/8"				
H-23	ELEC. HEATER				15.00							
H-24	ELEC. HEATER				7.00							
H-25	ELEC. HEATER				20.49							

NOTE:
 PROVIDE DUCT DETECTORS TO SERVE RETURN DUCTS OF HVAC UNITS OVER 2000CFM.
 ASSUME TWO (2) DUCT DETECTORS PER HVAC UNIT.

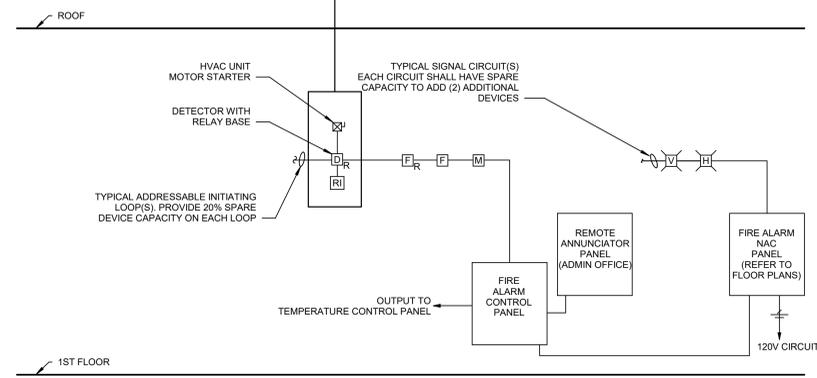


3A FIRE ALARM SCHEMATIC
 N.T.S.

NOTES:
 1. REFER TO FLOOR PLANS FOR DEVICE QUANTITIES
 2. ALL VISUAL DEVICES AND SPEAKER/STROBES TO BE SYNCHRONIZED FLASH

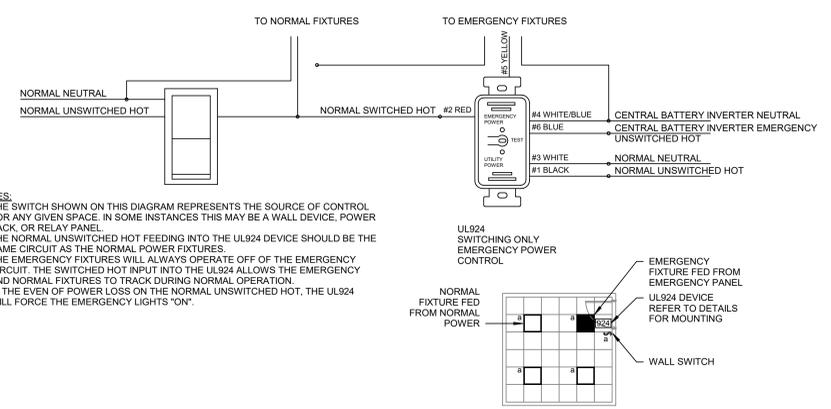


1C TYPICAL UL924 WIRING SCHEMATIC
 1/8" = 1'-0"

NOTES:
 • THE SWITCH SHOWN ON THIS DIAGRAM REPRESENTS THE SOURCE OF CONTROL FOR ANY GIVEN SPACE. IN SOME INSTANCES THIS MAY BE A WALL DEVICE, POWER PACK, OR RELAY PANEL.
 • THE NORMAL UNSWITCHED HOT FEEDING INTO THE UL924 DEVICE SHOULD BE THE SAME CIRCUIT AS THE NORMAL POWER FIXTURES.
 • THE EMERGENCY FIXTURES WILL ALWAYS OPERATE OFF OF THE EMERGENCY CIRCUIT. THE SWITCHED HOT INPUT INTO THE UL924 ALLOWS THE EMERGENCY AND NORMAL FIXTURES TO TRACK DURING NORMAL OPERATION.
 • IN THE EVENT OF POWER LOSS ON THE NORMAL UNSWITCHED HOT, THE UL924 WILL FORCE THE EMERGENCY LIGHTS "ON".

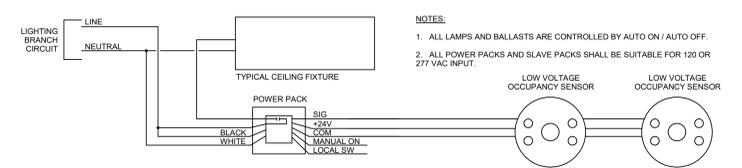

1B OCCUPANCY SENSOR LIGHTING CONTROL CORRIDOR SWITCHING SCHEMATIC
 N.T.S.


NOTES:
 1. ALL LAMPS AND BALLASTS ARE CONTROLLED BY AUTO ON / AUTO OFF.
 2. ALL POWER PACKS AND SLAVE PACKS SHALL BE SUITABLE FOR 120 OR 277 VAC INPUT.

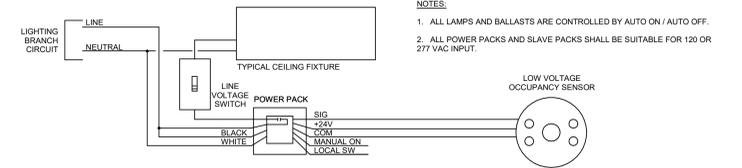

1A OCCUPANCY SENSOR LIGHTING CONTROL SCHEMATIC
 N.T.S.

NOTES:
 1. ALL LAMPS AND BALLASTS ARE CONTROLLED BY AUTO ON / AUTO OFF.
 2. ALL POWER PACKS AND SLAVE PACKS SHALL BE SUITABLE FOR 120 OR 277 VAC INPUT.

3635 173rd Street
 Hammond, IN 46323

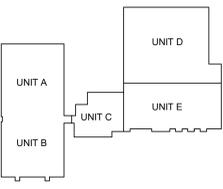

KEY PLAN

School City of Hammond

 School City of Hammond

Scott Middle School
 - Renovations

SCHEMATICS

E-601

14101-00000000
 2020-10-08 10:00 AM
 14101-00000000
 2020-10-08 10:00 AM
 14101-00000000

6 5 4 3 2 1

265119/265619/26213.1 - INTERIOR/EXTERIOR/EMERGENCY & EXIT LIGHT FIXTURES SCHEDULE

LABEL	DESCRIPTION	VOLTAGE	SOURCE				MOUNTING	LENS/REFLECTOR	CERTIFICATIONS	ACCEPTABLE MANUFACTURERS	LABEL
			TYPE	LUMENS	WATTS	CCT					
L1	2X4 LED FLAT PANEL, 0-10V DIMMING.	120/277 V	LED	5,000 LM	40 W	3500 K	RECESSED IN XXX	WHITE FROST ACRYLIC	DLC	METALUX 24FP COLUMBIA CFP24 LITHONIA EPANL 24	L1
L1U	2X4 LED FLAT PANEL, 0-10V DIMMING. PROVIDE UL 924 DEVICE TO SERVE EMERGENCY LIGHT FIXTURE.	120/277 V	LED	5,000 LM	40 W	3500 K	RECESSED IN XXX	WHITE FROST ACRYLIC	DLC	METALUX 24FP COLUMBIA CFP24 LITHONIA EPANL 24	L1U
L2	2X4 LED FLAT PANEL, 0-10V DIMMING.	120/277 V	LED	6,600 LM	60 W	3500 K	RECESSED IN XXX	WHITE FROST ACRYLIC	DLC	METALUX 24FP COLUMBIA CFP24 LITHONIA EPANL 24	L2
L2U	2X4 LED FLAT PANEL, 0-10V DIMMING.	120/277 V	LED	6,600 LM	60 W	3500 K	RECESSED IN XXX	WHITE FROST ACRYLIC	DLC	METALUX 24FP COLUMBIA CFP24 LITHONIA EPANL 24	L2U
L3	1X4 LED FLAT PANEL, 0-10V DIMMING.	120/277 V	LED	3,000 LM	25 W	3500 K	RECESSED IN XXX	WHITE FROST ACRYLIC	DLC	METALUX 14FP COLUMBIA CFP14 LITHONIA EPANL 14	L3
L3U	1X4 LED FLAT PANEL, 0-10V DIMMING.	120/277 V	LED	3,000 LM	25 W	3500 K	RECESSED IN XXX	WHITE FROST ACRYLIC	DLC	METALUX 14FP COLUMBIA CFP14 LITHONIA EPANL 14	L3U
L4U	4" ROUND LED DOWNLIGHT, SELF-FLANGED TRIM, MEDIUM DISTRIBUTION (50°), 0-10V DIMMING. PROVIDE UL 924 DEVICE TO SERVE EMERGENCY LIGHT FIXTURE.	120/277 V	LED	2,000 LM	22 W	3500 K	RECESSED IN DRYWALL	SEMI-SPECULAR CLEAR	ES	PORTFOLIO LDB8 PRESCOLITE LF4SL GOTHAM EVO	L4U
L5	2X2 LED FLAT PANEL, 0-10V DIMMING.	120/277 V	LED	4,600 LM	40 W	3500 K	RECESSED IN XXX	WHITE FROST ACRYLIC	DLC	METALUX 22FP COLUMBIA CFP22 LITHONIA EPANL 22	L5
L5U	2X2 LED FLAT PANEL, 0-10V DIMMING.	120/277 V	LED	4,600 LM	40 W	3500 K	RECESSED IN XXX	WHITE FROST ACRYLIC	DLC	METALUX 22FP COLUMBIA CFP22 LITHONIA EPANL 22	L5U
L6U	4" LENSED LED STRIP LIGHT, 0-10V DIMMING, WHITE FINISH, INTEGRAL BATTERY INVERTER. PROVIDE UL 924 DEVICE TO SERVE EMERGENCY LIGHT FIXTURE.	120/277 V	LED	5,400 LM	45 W	3500 K	CHAIN MOUNTED TO STRUCTURE	SEMI-FROSTED LENS	N/A	METALUX SMLD COLUMBIA NIPS LITHONIA ZL1D	L6U
L7	1X4 LED FLAT PANEL, 0-10V DIMMING.	120/277 V	LED	4,500 LM	40 W	3500 K	RECESSED IN XXX	WHITE FROST ACRYLIC	DLC	METALUX 14FP COLUMBIA CFP14 LITHONIA EPANL 14	L7
L7U	1X4 LED FLAT PANEL, 0-10V DIMMING. PROVIDE UL 924 DEVICE TO SERVE EMERGENCY LIGHT FIXTURE.	120/277 V	LED	4,500 LM	40 W	3500 K	RECESSED IN XXX	WHITE FROST ACRYLIC	DLC	METALUX 14FP COLUMBIA CFP14 LITHONIA EPANL 14	L7U
L8	4" ROUND LED DOWNLIGHT, SELF-FLANGED TRIM, WIDE DISTRIBUTION (75°), 0-10V DIMMING.	120/277 V	LED	4,000 LM	42 W	3500 K	RECESSED IN DRYWALL	SEMI-SPECULAR CLEAR	ES	PORTFOLIO LDB8 PRESCOLITE LF4SL GOTHAM EVO	L8
L9	4" SQUARE LED DOWNLIGHT, SELF-FLANGED TRIM, 0-10V DIMMING.	120/277 V	LED	2,000 LM	22 W	3500 K	RECESSED IN DRYWALL	SEMI-SPECULAR CLEAR	ES	PORTFOLIO LDB8 PRESCOLITE LF4SL GOTHAM EVO	L9
L10	2X4 LED FLAT PANEL, 0-10V DIMMING.	120/277 V	LED	3,600 LM	30 W	3500 K	RECESSED IN XXX	WHITE FROST ACRYLIC	DLC	METALUX 24FP COLUMBIA CFP24 LITHONIA EPANL 24	L10
L10U	2X4 LED FLAT PANEL, 0-10V DIMMING.	120/277 V	LED	3,600 LM	30 W	3500 K	RECESSED IN XXX	WHITE FROST ACRYLIC	DLC	METALUX 24FP COLUMBIA CFP24 LITHONIA EPANL 24	L10U
L11	2X2 LED FLAT PANEL, 0-10V DIMMING.	120/277 V	LED	3,500 LM	28 W	3500 K	RECESSED IN XXX	WHITE FROST ACRYLIC	DLC	METALUX 22FP COLUMBIA CFP22 LITHONIA EPANL 22	L11
L11U	2X2 LED FLAT PANEL, 0-10V DIMMING. PROVIDE UL 924 DEVICE TO SERVE EMERGENCY LIGHT FIXTURE.	120/277 V	LED	3,500 LM	28 W	3500 K	RECESSED IN XXX	WHITE FROST ACRYLIC	DLC	METALUX 22FP COLUMBIA CFP22 LITHONIA EPANL 22	L11U
L12U	24" LONG, LED STAIR FIXTURE, 18 GAUGE STEEL, INTEGRAL ULTRASONIC ZONELESS ACTIVATED SENSOR, BLACK FINISH. PROVIDE UL 924 DEVICE TO SERVE EMERGENCY LIGHT FIXTURE.	120/277 V	LED	4,000 LM	25 W	3500 K	HORIZONTAL ON WALL	CLEAR PRISMATIC	N/A	LUMINAIRE TSL9 NEW STAR LIGHTING VIC2W KENALL MLH48	L12U
L13	CARPET-TO-FLOOR PATHWAY LIGHT WITH AMBER LED'S, 6" ON CENTER, PROVIDE 12 VOLT TRANSFORMERS AS REQUIRED.	120/277 V	LED	N/A	10 W	AMBER	FLOOR	CLEAR LENS	N/A	CELESTIAL GEM-1900 TIVOLI	L13
L14	CARPET-TO-WALL PATHWAY LIGHT WITH AMBER LED'S, 6" ON CENTER, PROVIDE 12 VOLT TRANSFORMERS AS REQUIRED.	120/277 V	LED	N/A	10 W	AMBER	FLOOR	CLEAR LENS	N/A	CELESTIAL GEM-2000 TIVOLI	L14
L15	LED RECTANGULAR, CLEAR RIGID POLYCARBONATE TUBE IN PVC EXTRUSION WITH AMBER LED'S, 6" ON CENTER INSTALLED FLUSH WITH TOP OF FLOOR, PROVIDE 12 VOLT TRANSFORMERS AS REQUIRED.	120/277 V	LED	N/A	10 W	AMBER	FLOOR	CLEAR LENS	N/A	CELESTIAL TIVOLI	L15
X1	LED EXIT LIGHT, MATTE BLACK DIE-CAST ALUMINUM HOUSING, BRUSHED ALUM. SINGLE FACE, STENCIL FACE, RED LETTERS, SELF-POWERED, NICKEL-CADMIUM BATTERY, SELF-DIAGNOSTIC/SELF-TESTING MODULE.	120/277 V	LED	N/A	5 W	N/A	UNIVERSAL	N/A	N/A	SURE-LITES CX DUAL-LITE SE LITHONIA LE	X1
X2	LED EXIT LIGHT, MATTE BLACK DIE-CAST ALUMINUM HOUSING, BRUSHED ALUM. DUAL FACE, STENCIL FACE, RED LETTERS, SELF-POWERED, NICKEL-CADMIUM BATTERY, SELF-DIAGNOSTIC/SELF-TESTING MODULE.	120/277 V	LED	N/A	5 W	N/A	UNIVERSAL	N/A	N/A	SURE-LITES CX DUAL-LITE SE LITHONIA LE	X2

263323.1 - CENTRAL BATTERY EQUIPMENT FOR EMERGENCY LIGHTING SCHEDULE

LABEL	LOCATION		EQUIPMENT RATINGS				INPUT/OUTPUT CIRCUIT		ACCESSORIES	REMARKS
	NUMBER	NAME	VOLTAGE	MINIMUM OUTPUT FOR 90-MINUTES (WVA)	MOUNT	NEMA ENCL	PANEL	CIRCUIT		
MI-A1	41	Space	120/277V	1500	SURFACE	1	12B1	2	SELF-DIAGNOSTICS OVERRIDE FOR 0-10V DIMMING SYSTEM	
MI-A2	41	Space	120/277V	1500	SURFACE	1	12B1	4	SELF-DIAGNOSTICS OVERRIDE FOR 0-10V DIMMING SYSTEM	
MI-B1	41	Space	120/277V	1500	SURFACE	1	12B1	6	SELF-DIAGNOSTICS OVERRIDE FOR 0-10V DIMMING SYSTEM	
MI-B2	41	Space	120/277V	1500	SURFACE	1	12B1	8	SELF-DIAGNOSTICS OVERRIDE FOR 0-10V DIMMING SYSTEM	
MI-G1	56	Space	120/277V	1500	SURFACE	1	12C1	16	SELF-DIAGNOSTICS OVERRIDE FOR 0-10V DIMMING SYSTEM	
MI-D1	100	Space	120/277V	1500	SURFACE	1			SELF-DIAGNOSTICS OVERRIDE FOR 0-10V DIMMING SYSTEM	




Project No. 2020-154-SMS
Project Date 07.26.2021
Produced Designer Author




These Drawings and Specifications, and all copies thereof are and shall remain the property and copyright of the Architect. They shall be used only with respect to this Project and are not to be used on any other Project or Work without prior written permission from the Architect.

#	Revision	Date
A1	Addendum 1	08.11.2021
A2	Addendum 2	08.18.2021

3635 173rd Street
Hammond, IN 46323

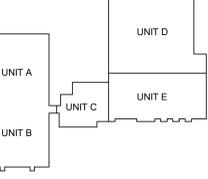

KEY PLAN

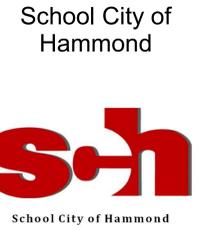

Scott Middle School
- Renovations

LIGHTING SCHEDULES

E-602

6 5 4 3 2 1

1:482 - 08/11/2021
 2:000 - 08/11/2021
 3:000 - 08/11/2021
 4:000 - 08/11/2021
 100:000 - 08/11/2021

6 5 4 3 2 1

E
D
C
B
A

Δ2

DISCONNECT SWITCH SCHEDULE										
LABEL	LOCATION		EQUIPMENT SERVED	VOLTAGE	AMPERAGE	POLES	FUSED	FUSE SIZE	NEMA ENCL	SOLID NEUTRAL
	NUMBER	NAME								
DS-B5	73	Space		208 V	30 A	2	Yes			No
DS-C1	136	Space	AHU H-15	480 V	100 A	3	Yes	90 A	3R	No
DS-C2	50	Space	CJ-1	208 V	30 A	2	Yes	20 A	3R	No
DS-C3	56	Space	CJ-3	208 V	30 A	2	Yes	20 A	3R	No
DS-D1	74	Space	BLEACHERS	208 V	30 A	3	Yes	20 A	1	No
DS-D2	100	Space	SS-2	120 V	30 A	1	Yes	20 A	1	No
DS-D3			CJ-6	208 V	30 A	2	Yes	20 A	3R	No
DS-D4			SS-2	208 V	30 A	2	Yes	30 A	3R	No
DS-D5	70	Space	AHUI H-18	480 V	60 A	3	Yes	60 A	3R	No
DS-D6	73	Space	SS-2	120 V	30 A	1	Yes			Yes
DS-D7	56	Space		120 V	30 A	1	Yes			Yes

MOTOR CONTROLLER/STARTER/VFD SCHEDULE														
LABEL	LOCATION		EQUIPMENT SERVED	EQUIPMENT DATA				STARTER		DISCONNECT SWITCH		NEMA ENCL	REMOTE CAPACITOR	REMARKS
	NUMBER	NAME		VOLTAGE	PHASE	HP	FLA	TYPE	NEMA SIZE	TYPE	FUSE SIZE			
MS-B1	124	Space	EF-1	120 V	1	1/2	9.8 A	-	-	-	-	1	-	THERMAL RATED TOGGLE SWITCH
MS-B2	124	Space	EF-2	120 V	1	1/2	9.8 A	-	-	-	-	1	-	THERMAL RATED TOGGLE SWITCH
MS-B3	44	Space	BP-1	208 V	3	3/4	3.7 A	FVNR	1	FUSIBLE	6.25	1	-	

TRANSFORMER SCHEDULE											
LABEL	LOCATION		KVA	PHASE	VOLTAGE		CONNECTION		MOUNT	TYPE	LOAD(S) SERVED
	NUMBER	NAME			PRIMARY	SECONDARY	PRIMARY	SECONDARY			
T-12B1	44	Space	30	3	480 V	208Y/120	DELTA	WYE	FLOOR	DRY	12B1
T-12C1	56	Space	30	3	480 V	208Y/120	DELTA	WYE	FLOOR	DRY	
T-12D1	100	Space	75	3	480 V	208Y/120	DELTA	WYE	FLOOR	DRY	

262719.1 - MULTI-OUTLET ASSEMBLIES							
LABEL	DESCRIPTION	ELECTRICAL REQUIREMENTS			TELECOM REQUIREMENTS		REMARKS
		P	N	G	POWER	DATA	
FB1	6-GANG FLOOR BOX, ON-GRADE PAN.	1	1	1	(2) DUPLEX RECEPTACLES	T-SERIES DWGS.	T-SERIES DWGS. REFER TO T-SERIES DRAWINGS FOR CONDUIT PATHWAY INFORMATION.




Project No. 2020-154.SMS
 Project Date 07.26.2021
 Produced Designer Author



These Drawings and Specifications, and all copies thereof are and shall remain the property and copyright of the Architect. They shall be used only with respect to this Project and are not to be used on any other Project or Work without prior written permission from the Architect.

#	Revision	Date
A1	Addendum 1	08.11.2021
A2	Addendum 2	08.18.2021

3635 173rd Street
 Hammond, IN 46323

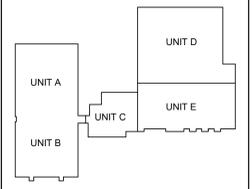

KEY PLAN



Scott Middle School - Renovations

EQUIPMENT SCHEDULES

E-603

6 5 4 3 2 1

© 2021 SCHMIDT ASSOCIATES
 262719.1-01-2021-08-18-2021
 10/2021 08/18/2021

BRANCH PANELBOARD SCHEDULE

DESIGNATION: 12D1
LOCATION: Space 100
MOUNTING: SURFACE
SUPPLY FROM:

VOLTS: 208Y/120 V
PHASES: 3
WIRES: 4
AIC RATING: 10KAIC

MAINS RATING: 225 A
MAINS TYPE: MCB

CKT NO.	CIRCUIT ROOM #	CIRCUIT TYPE	TRIP	P	A	B	C	P	TRIP	CIRCUIT TYPE	CIRCUIT ROOM #	CKT NO.		
1	RR 90B 95 96	RECEPT	20 A	1	0.72	0.72			1	20 A	RECEPT	INNOVATION LAB 91	2	
3	STOR 87B IDF RACK	RECEPT	20 A	1		0.36	0.54		1	20 A	RECEPT	INNOVATION LAB 91	4	
5	MEDIA CENTER 90 EWC	RECEPT	20 A	1				1.00	0.36	1	20 A	RECEPT	INNOVATION LAB 91	6
7	MEDIA CENTER 90	RECEPT	20 A	1	0.36	0.72				1	20 A	RECEPT	INNOVATION LAB 91	8
9	CORRIDOR 92	RECEPT	20 A	1		0.54	0.72		1	20 A	RECEPT	INNOVATION LAB 91	10	
11	CORRIDOR 92	RECEPT	20 A	1				0.54	0.90	1	20 A	RECEPT	FITNESS 72	12
13	MEDIA CENTER 90	RECEPT	20 A	1	0.72	0.90				1	20 A	RECEPT	FITNESS 72	14
15	MEDIA CENTER 90	RECEPT	20 A	1		0.54	0.72			1	20 A	RECEPT	FITNESS 72	16
17	MEDIA CENTER 90 FLOOR BOX	RECEPT	20 A	1				0.72	0.54	1	20 A	RECEPT	FITNESS 72	18
19	MEDIA CENTER 90 FLOOR BOX	RECEPT	20 A	1	0.36	0.36				1	20 A	LIGHTING	FITNESS 72	20
21	MEDIA CENTER	RECEPT	20 A	1		0.54	0.00			1	20 A	SPARE		22
23	CORRIDOR 92	RECEPT	20 A	1				0.72	0.42	1	20 A	LIGHTING	RESTROOM 90B, 95, 96	24
25	PROJECT RM 90A	RECEPT	20 A	1	0.72	1.65				1	20 A	LIGHTING	MEDIA CENTER 90	26
27	PROJECT RM 91B	RECEPT	20 A	1		0.72	0.00			1	20 A	SPARE		28
29	MEDIA WR 90A	RECEPT	20 A	1				0.54	0.77	1	20 A	LIGHTING	PROJ RM 91A, 91B, CORR 92, WR	30
31	MEDIA WR 90A COPIER	RECEPT	20 A	1	1.20	0.60				1	20 A	LIGHTING	INNOVATION LAB 91	32
33	MEDIA WR 90A	RECEPT	20 A	1			0.72	0.18		1	20 A	RECEPT	SYN	34
35	CU-2 ON ROOF	MOTOR	20 A	2				3.03	1.92	3	20 A	MOTOR	BLEACHER MOTOR	36
37	--	--	--	--	--	--	--	--	--	--	--	--	--	38
39	CU-6 ON ROOF	MOTOR	20 A	2		3.03	1.92			--	--	--	--	40
41	--	--	--	--	--	--	--	1.72	1.92	1	20 A	--	--	42
43	SPARE	20 A	1	0.00	0.00			1.72	0.00	1	20 A	SPARE		44
45	SPARE	20 A	1			0.00	0.00			1	20 A	SPARE		46
47	SPARE	20 A	1				0.00	0.00	0.00	0.00	1	20 A	SPARE	48
49	SPARE	20 A	1	0.00	0.00					1	20 A	SPARE		50
51	SPARE	20 A	1			0.00	0.00			1	20 A	SPARE		52
53	SPARE	20 A	1					0.00	0.00	1	20 A	SPARE		54
TOTAL LOAD:					13.97 kVA	9.22 kVA		13.17 kVA						
TOTAL AMPS:					77 A			115 A						
TOTAL CONNECTED LOAD:					36.38 kVA			33.65 kVA						
TOTAL CONNECTED AMPS:					122 A			93 A						
TOTAL DEMAND AMPS:														

BRANCH PANELBOARD SCHEDULE

DESIGNATION: 12B1
LOCATION: Space 81
MOUNTING: FLUSH
SUPPLY FROM:

VOLTS: 208Y/120 V
PHASES: 3
WIRES: 4
AIC RATING: 10 KAIC

MAINS RATING: 100 A
MAINS TYPE: MCB 100 A

CKT NO.	CIRCUIT ROOM #	CIRCUIT TYPE	TRIP	P	A	B	C	P	TRIP	CIRCUIT TYPE	CIRCUIT ROOM #	CKT NO.		
G 1	CORRIDOR 46 EWC	MOTOR	20 A	1	1.00	1.20			1	20 A	POWER	WORKROOM 13 INVERTER A1	2	
G 3	CORRIDOR 46 EWC	MOTOR	20 A	1		1.00	1.20		1	20 A	POWER	WORKROOM 13 INVERTER A2	4	
S	GIRLS 31A, BOYS 31B	RECEPTS	20 A	1			0.36	1.20	1	20 A	POWER	WORKROOM 13 INVERTER B1	6	
7	BOYS 12A, GIRLS 12B	RECEPTS	20 A	1	0.36	1.20			1	20 A	POWER	WORKROOM 13 INVERTER B2	8	
G 9	CORRIDOR 47 EWC	RECEPTS	20 A	1		1.00	0.36		1	20 A	RECEPTS	MENS 42, WOMEN 43	10	
G 11	CORRIDOR 47 EWC	RECEPTS	20 A	1			1.00	0.36	1	20 A	RECEPTS	PLUMBING 41	12	
13	JANITOR 45 EF-1	MOTOR	20 A	1	1.18	0.00			1	20 A	POWER	JANITOR 45 FANAC	14	
15	JANITOR 45 EF-2	MOTOR	20 A	1		1.18	0.00		1	20 A	SPARE		16	
--	17 SPARE	20 A	1				0.00	0.00	1	20 A	SPARE		18	
--	19 SPARE	20 A	1	0.00	0.00				1	20 A	SPARE		20	
--	21 SPARE	20 A	1			0.00	0.00		1	20 A	SPARE		22	
--	23 SPARE	20 A	1				0.00	0.00	1	20 A	SPARE		24	
--	25 SPARE	20 A	1	0.00	0.44		0.00	0.44		3	20 A	MOTOR	BP-1	26
--	27 SPARE	20 A	1							--	--	--	28	
--	29 SPARE	20 A	1							--	--	--	30	
TOTAL LOAD:					5.38 kVA	5.18 kVA		3.36 kVA						
TOTAL AMPS:					47 A	46 A		28 A						
TOTAL CONNECTED LOAD:					13.93 kVA			13.93 kVA						
TOTAL CONNECTED AMPS:					47 A			39 A						
TOTAL DEMAND AMPS:														

BRANCH PANELBOARD SCHEDULE

DESIGNATION: 12C1
LOCATION: Space 56
MOUNTING: SURFACE
SUPPLY FROM:

VOLTS: 208Y/120 V
PHASES: 3
WIRES: 4
AIC RATING: 10KAIC

MAINS RATING: 100 A
MAINS TYPE: MCB

CKT NO.	CIRCUIT ROOM #	CIRCUIT TYPE	TRIP	P	A	B	C	P	TRIP	CIRCUIT TYPE	CIRCUIT ROOM #	CKT NO.	
1	COTS 55C	RECEPT	20 A	1	0.36	0.90			1	20 A	RECEPT	OFFICE 52A	2
3	CLINIC 55A	RECEPT	20 A	1		1.20	0.72		1	20 A	RECEPT	OFFICE 52B	4
5	CLINIC 55A	RECEPT	20 A	1			0.18	1.20	1	20 A	RECEPT	RECEPT 54A	6
7	CLINIC 55A	RECEPT	20 A	1	0.36	0.72			1	20 A	RECEPT	RECEPT 54A	8
9	55A, 55B, IDF	RECEPT	20 A	1		0.54	0.18		1	20 A	RECEPT	RECEPT 54A	10
11	FACP	RECEPT	20 A	1			0.00	0.36	1	20 A	RECEPT	VEST 59B	12
13	CLASSROOM 58	RECEPT	20 A	1	0.72	0.36			1	20 A	RECEPT	OFFICE 52	14
15	CLASSROOM 58	RECEPT	20 A	1		0.54	1.20		1	20 A	POWER	UNIT C INVERTER	16
17	CLASSROOM 58	RECEPT	20 A	1			0.36	0.36	1	20 A	RECEPT	OFFICE 52 INTERCOM	18
19	CLASSROOM 57	RECEPT	20 A	1	0.36	0.00			1	20 A	RECEPT	H-15 ON ROOF	20
21	CLASSROOM 57	RECEPT	20 A	1			0.72	0.18	1	20 A	RECEPT	ROOFTOP	22
23	CLASSROOM 57	RECEPT	20 A	1			0.54	1.72	2	20 A	MOTOR	CU-1 ON ROOF	24
25	RECEPT 50 OFFICE 50E	RECEPT	20 A	1	0.72	1.72			--	--	--	--	26
G 27	WORKROOM 50F	RECEPT	20 A	1		1.20	1.72		2	20 A	MOTOR	CU-3 ON ROOF	28
29	WORKROOM 50F	RECEPT	20 A	1			1.20	1.72	--	--	--	--	30
31	WORKROOM 50F	RECEPT	20 A	1	0.36	0.00			1	20 A	SPARE		32
33	OFFICE 50H	RECEPT	20 A	1		0.54	0.00		1	20 A	SPARE		34
35	OFFICE 50J	RECEPT	20 A	1			0.72	0.00	1	20 A	SPARE		36
--	37 SPARE	20 A	1	0.00	0.00				1	20 A	SPARE		38
--	39 SPARE	20 A	1			0.00	0.00		1	20 A	SPARE		40
--	41 SPARE	20 A	1				0.00	0.00	1	20 A	SPARE		42
TOTAL LOAD:					6.58 kVA	8.74 kVA		8.35 kVA					
TOTAL AMPS:					55 A	75 A		72 A					
TOTAL CONNECTED LOAD:					23.66 kVA			20.86 kVA					
TOTAL CONNECTED AMPS:					75 A			68 A					
TOTAL DEMAND AMPS:													

PANELBOARD ABBREVIATIONS

#	NOTES
FTL	FEED THROUGH LUGS
MCB	MAIN CIRCUIT BREAKER
MFS	MAIN FUSED SWITCH
MLO	MAIN LUGS ONLY
SFL	SUB FEED LUGS
SPD	SURGE PROTECTION DEVICE

SWITCHBOARD/PANELBOARD NOTES

#	NOTES
A	VERIFY SIZE AND QUANTITY OF LUGS REQUIRED PER ONE-LINE DIAGRAM.
B	VERIFY PANEL / LUG SIZE REQUIRED FOR FEEDERS INDICATED ON ONE-LINE DIAGRAM. MODIFY AS REQUIRED FOR LARGER FEEDERS.
C	VERIFY CONDUIT ENTRY LOCATION ON EACH PANEL.
D	CONFIRM FINAL ROOM NAMES AND NUMBERS WITH OWNER PRIOR TO CREATING FINAL PANELBOARD DIRECTORIES.
E	MODIFY AIC RATINGS INDICATED ON SCHEDULES, AS REQUIRED, PER SPECIFICATION SECTION 060574.09.

SWITCHBOARD SCHEDULE

DESIGNATION: MSB
LOCATION: Space 187
MOUNTING: FLOOR
SUPPLY FROM:

VOLTS: 480Y/277 V
PHASES: 3
WIRES: 4
AIC RATING:

MAINS RATING: 1600 A
MAINS TYPE: MCB
MCB RATING: 1600 A
MCB OPTIONS:

CKT NO.	CIRCUIT DESCRIPTION	P	FRAME SIZE	TRIP RATING	A	B	C	LOAD	REMARKS
--	1 EXISTING	3	--	0 A	--	--	--	0.00	
--	2 EXISTING	3	--	0 A	--	--	--	0.00	
--	3 EXISTING	3	--	0 A	--	--	--	0.00	
--	4 EXISTING	3	--	0 A	--	--	--	0.00	
--	5 60A SPARE SWITCH FUSED AT 50A	3	--	0 A	--	--	--	0.00	
--	6 EXISTING	3	--	0 A	--	--	--	0.00	
--	7 EXISTING	3	--	0 A	--	--	--	0.00	
--	8 100A SPARE SWITCH FUSED AT 90A	3	--	0 A	--	--	--	0.00	
--	9 EXISTING	3	--	0 A	--	--	--	0.00	
--	10 EXISTING	3	--	0 A	--	--	--	0.00	
--	11 EXISTING	3	--	0 A	--	--	--	0.00	
--	12 EXISTING	3	--	0 A	--	--	--	0.00	
--	13 EXISTING	3	--	0 A	--	--	--	0.00	
--	14 EXISTING	3	--	0 A	--	--	--	0.00	
--	15 EXISTING	3	--	0 A	--	--	--	0.00	
--	16 EXISTING	3	--	0 A	--	--	--	0.00	
--	17 EXISTING	3	--	0 A	--	--	--	0.00	
--	18 EXISTING	3	--	0 A	--	--	--	0.00	
--	19 EXISTING	3	--	0 A	--	--	--	0.00	
--	20 EXISTING	3	--	0 A	--	--	--	0.00	
TOTAL LOAD: 0.00 kVA, 0.00 kVA, 0.00 kVA									
TOTAL AMPS: 0 A, 0 A, 0 A									
TOTAL CONNECTED LOAD: 0.00 kVA									
TOTAL CONNECTED AMPS: 0 A									
TOTAL DEMAND LOAD: 0.00 kVA									
TOTAL DEMAND AMPS: 0 A									

SWITCHBOARD & CIRCUIT BREAKER OPTIONS

LOAD CLASSIFICATION	CONNECTED LOAD (VA)	DEMAND FACTOR	ESTIMATE DEMAND (VA)
C CONTACTOR CONTROLLED	17320 VA	78.87%	13660 VA
G GFCI PROTECTED	3791 VA	125.00%	4739 VA
M MECHANICAL MOTOR	15249 VA	100.00%	15249 VA
S SHUNT TRIP			
X 80% RATED MAIN CIRCUIT BREAKER WITH LSI			
Y 100% RATED MAIN CIRCUIT BREAKER WITH LSI			
Z 100% RATED MAIN CIRCUIT BREAKER WITH LSI			

SWITCHBOARD & CIRCUIT BREAKER OPTIONS

LOAD CLASSIFICATION	CONNECTED LOAD (VA)	DEMAND FACTOR	ESTIMATE DEMAND (VA)
C CONTACTOR CONTROLLED	6440 VA	100.00%	6440 VA
G GFCI PROTECTED	3690 VA	100.00%	3690 VA
M MECHANICAL MOTOR	4800 VA	100.00%	4800 VA
P HANDLE LOCKING DEVICE	0 VA	0.00%	0 VA
S SHUNT TRIP			
X 80% RATED MAIN CIRCUIT BREAKER WITH LSI			
Y 100% RATED MAIN CIRCUIT BREAKER WITH LSI			
Z 100% RATED MAIN CIRCUIT BREAKER WITH LSI			

SWITCHBOARD & CIRCUIT BREAKER OPTIONS

LOAD CLASSIFICATION	CONNECTED LOAD (VA)	DEMAND FACTOR	ESTIMATE DEMAND (VA)
C CONTACTOR CONTROLLED	15600 VA	82.05%	12800 VA
G GFCI PROTECTED	6864 VA	100.00%	6864 VA
M MECHANICAL MOTOR	1200 VA	100.00%	1200 VA
P HANDLE LOCKING DEVICE	0 VA	0.00%	0 VA
S SHUNT TRIP			
X 80% RATED MAIN CIRCUIT BREAKER WITH LSI			
Y 100% RATED MAIN CIRCUIT BREAKER WITH LSI			
Z 100% RATED MAIN CIRCUIT BREAKER WITH LSI			



Project No. 2020-154.SMS
Project Date 07.26.2021
Produced Designer Author



GENERAL TELECOMMUNICATIONS NOTES	
#	NOTES
A	REFER TO SHEET T-001 FOR ADDITIONAL INFORMATION.

TELECOMMUNICATIONS PLAN NOTES	
#	NOTES
1	EXISTING AUDIO PHONE AND CARD READER TO REMAIN.
2	EXISTING DOOR RELEASE MASTER STATION TO BE RELOCATED FROM EXISTING ADMIN DESK TO HERE.
3	OWNER PROVIDED PROMETHEAN MONITOR. CONTRACTOR TO INSTALL. PROVIDE A/V ROUGH-IN AND POWER AT 5'-8" A.F.F.
4	NEW DOOR RELEASE MASTER STATION LOCATION.
5	EXISTING TELECOM CABINET FROM STORAGE/BATHROOM TO BE RELOCATED HERE. PROVIDE NEW BACKBONE FIBER AND NEW HORIZONTAL DATA CABLING AS REQUIRED.
6	RE-USE OR PROVIDE NEW UTP DATA CABLING IF EXISTING DATA CABLING IS NOT ABLE TO BE RELOCATED TO NEW CABINET LOCATION.
7	PROVIDE DATA AND POWER AT 6'-10" A.F.F. FOR OWNER PROVIDED MONITOR.
8	NEW SOUND SYSTEM EQUIPMENT RACK. COORDINATE FINAL LOCATION WITH OWNER.
9	PROVIDE A/V ROUGH-IN AND POWER AT 5'-0" A.F.F. FOR FUTURE MONITORS.
10	PROVIDE (4) OVERHEAD MICROPHONES AS SPECIFIED.
11	PROVIDE WIRED MICROPHONE JACK IN EXISTING FLOORBOX.
12	EXISTING INTERCOM CENTRAL EQUIPMENT AND CABINET TO BE RELOCATED HERE. REROUTE EXISTING SPEAKER WIRING TO THIS LOCATION. SPLICE IN NEW SPEAKER WIRING AS REQUIRED.




Project No. 2020-154-SMS
 Project Date 07.26.2021
 Produced MD



These Drawings and Specifications, and all copies thereof are and shall remain the property and copyright of the Architect. They shall be used only with respect to this Project and are not to be used on any other Project or Work without prior written permission from the Architect.

#	Revision	Date
A2	Addendum 2	08.18.2021

3635 173rd Street
 Hammond, IN 46323

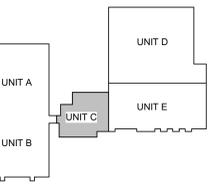

KEY PLAN


School City of Hammond



Scott Middle School - Renovations

FIRST FLOOR TELECOMMUNICATIONS PLAN - UNIT C

TF1C1

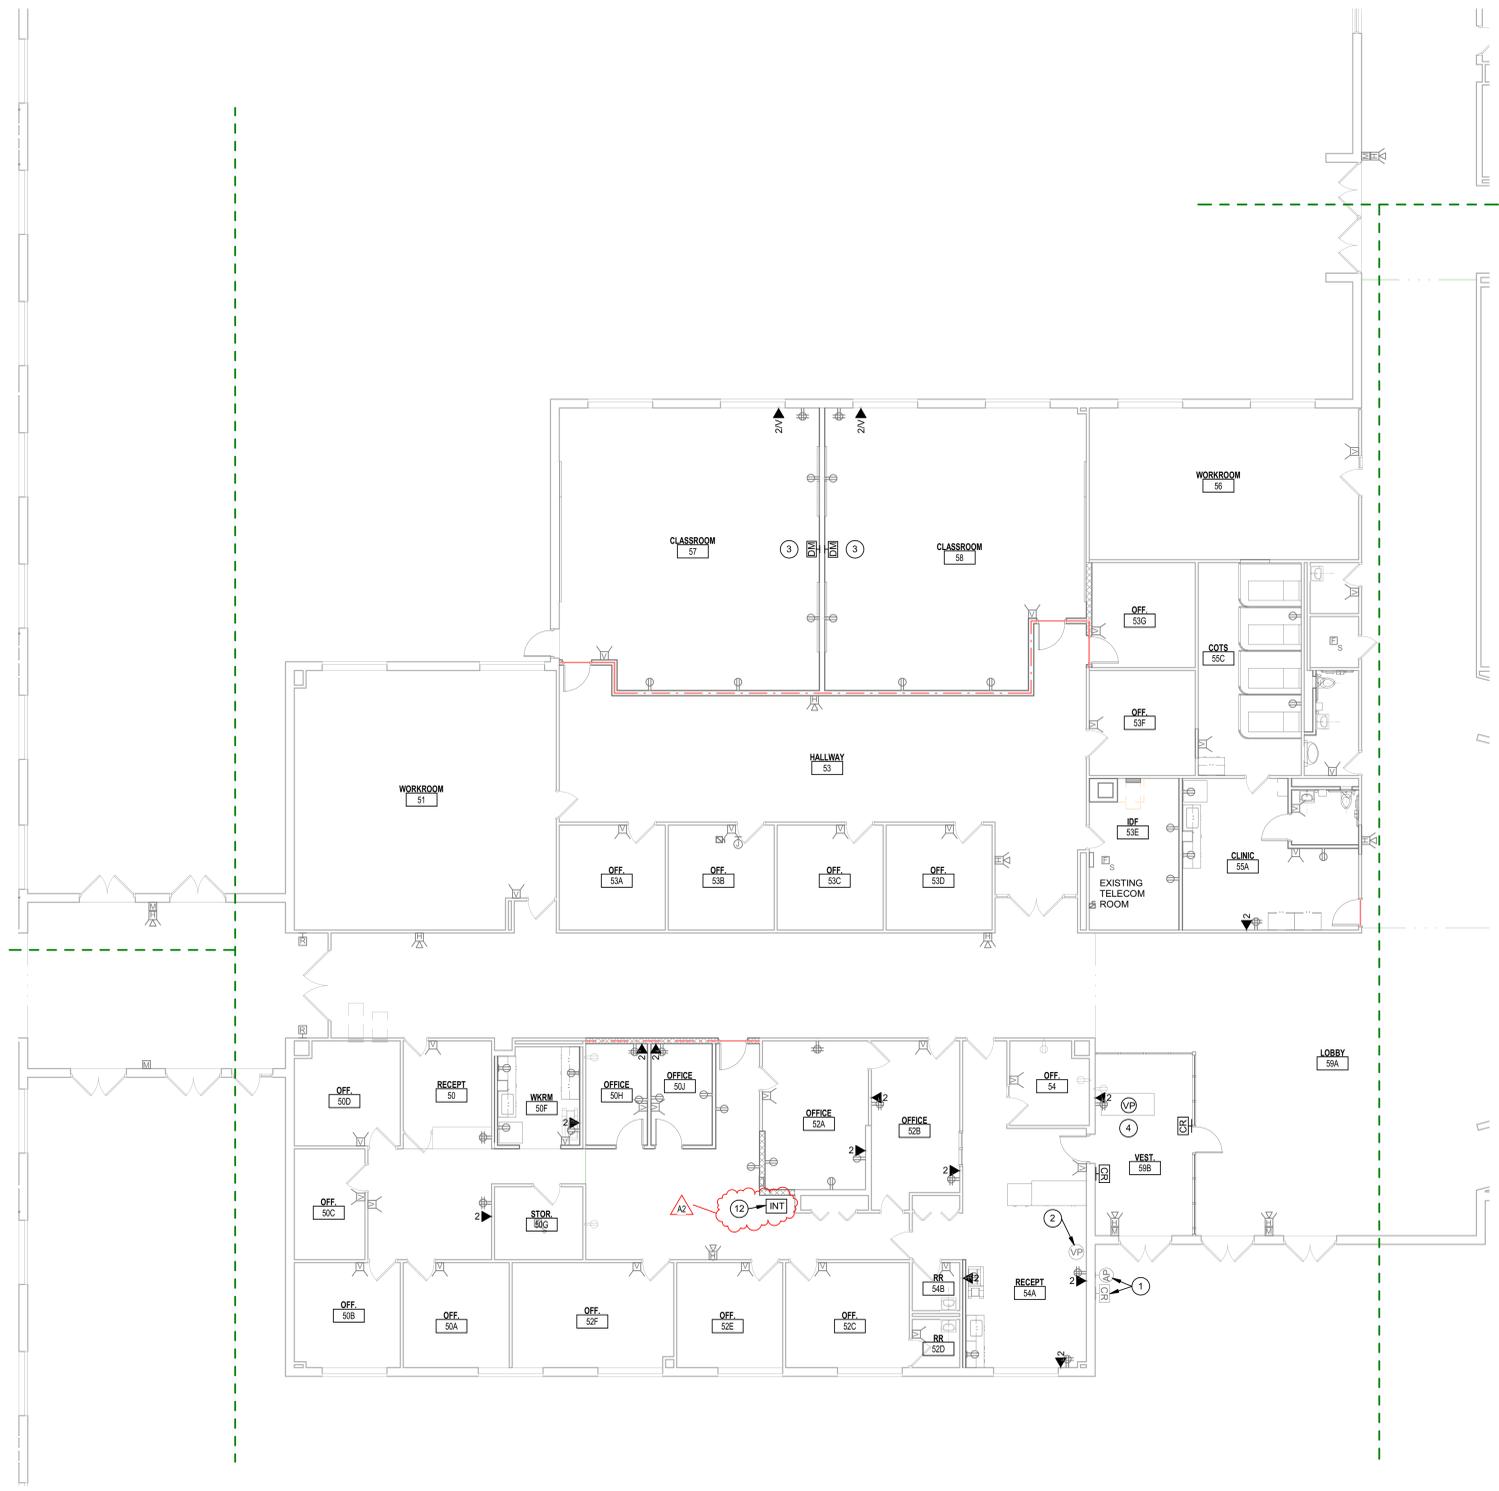

1 FIRST FLOOR TELECOMMUNICATIONS PLAN - UNIT C
 1/8" = 1'-0"

PROJECT: 2020-154-SMS, SCOTT MIDDLE SCHOOL RENOVATIONS, UNIT C
 SHEET: TF1C1, FIRST FLOOR TELECOMMUNICATIONS PLAN
 DATE: 08/18/2021
 DRAWN BY: [Name]
 CHECKED BY: [Name]
 PROJECT MANAGER: [Name]