

**ADDENDUM
NO. 4**

April 21, 2022

**RIVER VALLEY HIGH, MIDDLE, & ELEMENTARY SCHOOLS
ADDITIONS & RENOVATIONS
15480 Three Oaks Road
Three Oaks, MI, 49128**

TO: ALL BIDDERS OF RECORD

This Addendum forms a part of and modifies the Bidding Requirements, Contract Forms, Contract Conditions, the Specifications, and the Drawings dated March 22, 2022, by Cordogan Clark & Associates. Acknowledge receipt of the Addendum in the space provided on the Bid Form. Failure to do so may subject the Bidder to disqualification.

This Addendum consists of Pages ADD 4-1, RFI Log, and Cordogan Clark Addendum No. 4, dated April 20, 2022, consisting of 5 pages, and Revised Drawings: C8, A6.6, A8.4, A9.2, M1.1D, M2.1A, M2.1D, M2.2B, M4.0, P2.1D, E2.1A, E2.1B, E2.1C, E2.2A, E2.2B, and E2.2C.

****REMINDER BIDS DUE APRIL 26, 2022****

A. RFI LOG AND SUBSTITUTION REQUESTS

Refer to the attached RFI Log, dated April 21, 2022.

River Valley School District - School Consolidation

Pre-Bid RFI Log

Date - 4/21/2022

CC=Cordogan Clark TSC=The Skillman Corp.



| RFI # | Company Submitting RFI | Date Received | RFI Description | RFI Response |
|-------|--------------------------|---------------|---|--|
| 1 | Hunter-Prell | 3/23/2022 | Fire Suppression Specs. 211313-14 3.2 A. Connect sprinkler piping to building's interior water-distribution piping. Will the site contractor bring the water supply for fire system into building in riser room 12" AFF? | TSC: Bid Category No. 2 Sitework will bring the water supply to within 5' of the building. Bid Category No. 10 Mechanical will connect and bring water service into the building and provide supply line for Fire Suppression connection and piping. |
| 2 | Hunter-Prell | 3/23/2022 | Fire Suppression specs. 211313-19 3.15 C. Standard-pressure, wet-pipe sprinkler system, NPS and smaller Number 3. Thin wall or Schedule 10 black-steel pipe On the fire plan FP2.1D Note number 2 Line piping to be schedule 40. Which statement is correct? Can line pipe be sch. 10? | CC: Line pipe shall be schedule 40. |
| 3 | Hunter-Prell | 3/23/2022 | 3) Fire suppression plan FP2.1D Keynote 3: Provide and install Fire Protection Riser sized to fully sprinkler the High School and include (4) Fire Protection zone assemblies in the riser (3) zones assemblies shall be used for future projects. What consists of "Zone assemblies"? | CC: Fire protection zone assemblies shall include a water pressure gauge, 2" main drain valve, check valve, and water flow switch. |
| 4 | S.A.Mormon | 3/25/2022 | 081416 Flush Wood Doors and/or A9.0 Door Schedule - There is no mention in the Specifications if Factory Glazing is required for Wood Doors with Lites. If Factory Glazing is required – A9.0 Door Schedule notes "I-GL1-T" at Door Types D5 and D6. This glass type does not appear in 08800 Glazing Specifications. If factory glazing is required for Wood Doors with Lites please clarify specific glass required. | CC: Glazing type I-GL1-T refers to Monolithic "B. Glass Type: Clear fully tempered float glass. 1. Minimum Thickness: 6 mm. 2. Safety glazing required." |
| 5 | S.A.Mormon | 3/25/2022 | 081113 Hollow Metal Doors and Frames and/or A9.0 Door Schedule - A9.0 Door Schedule list numerous Hollow Metal Doors as Type D1. Door Elevations show Type D1 Doors to be Exterior Doors. Specifications call for Exterior Hollow Metal Doors to be 16 Gauge Curries 777 Trio-E Series (fairly expensive doors) while Interior Hollow Metal Doors are specified as 18 Gauge Curries 707 (typical "standard" hollow metal door). The only Exterior Hollow Metal Door is Opening E2. Should the other Eight Hollow Metal Doors indicated to be Type D1 actually be Type D4 Interior Door? | CC: REVISE ALL INTERIOR HM DOORS TO TYPE D4 |
| 6 | S.A.Mormon | 3/25/2022 | 081113 Hollow Metal Doors and Frames and/or A9.0 Door Schedule - A9.0 Door Schedule - Openings D103A, D118, D124, D129 and D129A are indicated on the Door Schedule to have a 2 Hour Fire-Rating (these are also the only Openings indicated to have a fire-rating). Due to the 2 Hour Rating are these Hollow Metal Doors/Frames required to be "E119" Fire Rated Systems (Note: extremely expensive with extended lead-times)? | CC: REFER TO 081113 1.4.C, 2.3.C.1.a, & 2.4.E FOR FIRE DOOR REQUIREMENTS. DOORS ASSEMBLIES LOCATED IN A 2HR WALL REQUIRE 1 1/2 HR RATING AND "SHALL BE TESTED IN ACCORDANCE WITH NFPA 525 OR UL10C" |
| 7 | Balfrey & Johnston, Inc. | 3/28/2022 | Request approval to bid Navien's Wall Hung Condensing Water Heater as an equal to the water heater with tank specified (refer to 3/28 Email). | CC: Rejected |
| 8 | Pearson | 3/29/2022 | What bid category will 07 4213.23 "Composite Metal Panels" be assigned? They are currently in the site package? | TSC: Composite Metal Panels will be assigned to Bid Category No. 1 General Trades. Refer to Addendum No. 1. |
| 9 | Pearson | 3/29/2022 | Section 01 72 00 Field Engineering ? | TSC: Bid Category No. 1 General Trades shall provide and maintain Reference Points (benchmarks & control points) and provide Certified Survey at completion of foundation walls and other major improvements for ALL Contractors to utilize for their respective "Work Layout-Section 01 72 50". Refer to Section 01 72 00 Field Engineering, Part 3.04. |
| 10 | Pearson | 3/29/2022 | Will 10% retention remain as part of the contract along with the additional scheduled items such as closeout that essentially increases retention to an amount >10%. Is 5% acceptable? | TSC: No. Ten (10%) Retainage is part of the agreement. There are provisions including in the General Conditions affording Contractors the opportunity to request reduction in retainage. |
| 11 | Pearson | 3/29/2022 | The elevations noted on the civil drawings differ from those noted in the subsurface investigation. | CC: The elevations shown on the Civils should be used. They are shown per the Topographic Survey which uses 2 different NAVD88 datum benchmarks, and are consistent with the GIS contours. |
| 12 | Pearson | 3/29/2022 | Is the removal and reinstallation of fencing required for Alternate #4 the responsibility of the site package as defined by cutting and patching? | TSC: The removal and replacement of existing fencing for access to perform Alternate No. 4 work shall be provided by Bid Category No. 13 Asphalt Paving. |
| 13 | Pearson | 3/29/2022 | What bid category will be responsible for asphalt patching and line striping? | TSC: Refer to Addendum No. 1, new Bid Category No. 13 Asphalt Paving. |
| 14 | Pearson | 3/29/2022 | Please verify who is responsible for the basketball hoops noted in the Activity Area on sheet C-2. It states "by others" | TSC: The Owner will provide the basketball hoops. |
| 15 | Pearson | 3/29/2022 | What category will be responsible for the black vinyl fence noted on sheet c-2? | TSC: Bid Category No. 1 General Trades shall provide the black vinyl chain link fence and gates as shown on sheet C-2. |
| 16 | Herman & Goetz | 4/1/2022 | Drawing sheet E4.2- Is there a panel/breaker schedule for the new 1600 amp switchgear in room D144? | CC: To be issued via addendum 01. The board will be relocated. |
| 17 | Herman & Goetz | 4/1/2022 | Drawing sheet E4.2- Is the existing 3000 amp switchboard being replaced (room B-43A)? Detail 1A & 1B show different breaker/switch counts. | CC: To be clarified via Addendum 01. |
| 18 | Herman & Goetz | 4/1/2022 | Drawing sheet E4.2- Detail 1B shows new panels E & F. Are these replacing existing panels? Detail 1A show these as existing 400 amp panels and detail 1B show them as new 600 amp panels. Also new panel F is shown to be in room B16. We cannot locate B16. Panel schedules would be helpful too. Please clarify. | CC: Both panels will be partially replaced. One 400-amp tub will remain on the existing feeder; one 400-amp tub will be refed with a new 400-amp feeder and will receive new interior and cover. |

| | | | | |
|----|-------------------------|----------|---|--|
| 19 | Herman & Goetz | 4/1/2022 | Drawing sheet E4.3- Can you confirm that the new panel PPO in room D144 is being fed from existing gear in room B-43A as shown on the drawings? There are no spare switches in the existing gear. | CC: To be clarified via Addendum 01. |
| 20 | Herman & Goetz | 4/1/2022 | Drawing sheet E4.3- Does panel PPO need to be GE brand as shown on the drawing? | CC: G.E. or Square D. |
| 21 | Herman & Goetz | 4/1/2022 | In regards to the Lift Station mentioned at the walkthrough. We have not been able to find where it is located or where it is supposed to be fed from. Please confirm if there is one. | CC: REFER TO C-5 WEST OF PLAYGROUND AND C-11 FOR SANITARY LIFT STATION PLAN. |
| 22 | Herman & Goetz | 4/1/2022 | Drawing sheet E1.1D - There is no circuiting shown for the lighting in the new addition. Can you confirm which panel will feed that lighting? Panel LP-0 in that area does not show any lighting circuits on the panel schedule. | CC: Provide (3) 120v lighting branch circuits on panel LP-0 on 39,41,40. 39: "24-HR NIGHT LIGHTING, EXIT SIGNS, AND EXTERIOR EXIT LIGHTING". 41,40: will be used for the rest of the lighting for the addition. |
| 23 | Herman & Goetz | 4/1/2022 | Drawing sheet E4.2 – Can you provide the location of the new utility pad mount transformer and pad mount CT cabinet? Drawing shows us tying into the existing utility transformer on the opposite side of the building from the new addition. Is it expected to run through the building or underground around the outside of the building? | CC: To be clarified via Addendum 01. |
| 24 | Pearson | 4/1/2022 | What trade is responsible for fire separation of the work and temporary egress plans. Will these requirements be paid for by allowance or more specifically detailed if desired to be included in the base bid by bid categories? | TSC: Bid Category No. 1 General Trades shall provide maintain and remove required construction separations for construction phasing. Allow for six (6) 1 hour construction separations including provisions for temporary frame and doors. |
| 25 | Pearson | 4/1/2022 | What deciphers Between 2022 and 2023 for the work summer work scheduled in phase 2 noted in light blue ? | TSC: Refer to Guideline Schedule. |
| 26 | Pearson | 4/1/2022 | Please clarify if section 08 88 00 is required by both General Trades Package 1 and Aluminum Package 6? If so please clarify the separation between these packages. | TSC: Refer to Addendum No. 1 |
| 27 | Pearson | 4/1/2022 | Please clarify section 01 53 10 Fences, Quantities are given in this section to provide 500' of two different types of fencing, The site logistics plans shows the temp fencing desired for site layout. Please verify if we bid temp fencing per the site logistics plan or as quantified in the specification section. | TSC: Refer to Addendum No. 1. Revise Section 01 53 10 - Fences, Part 2.01, A. (Allow for 1,000 Lineal Feet). Part 3.01 Installation, D. revise to one (1) 20' wide gate and two (2) 4' wide man gates. |
| 28 | Pearson | 4/1/2022 | Field Engineering Services, section 01 72 00. Work described in this section seems very broad along with describing work that is either stated will be provided by the owner, "property lines" or has previously been performed by the civil engineer, or not applicable to this construction project, "anchor bolt survey". Can you clarify the specific work to be provided by this section along with how the costs for replacing established control points if damaged? | TSC: Refer to Section 01 72 00 Field Engineering, Part 3.04. The Owner will identify existing benchmark, control points and property corners. Bid Category No. 1 General Trades shall provide the required work as outlined in 3.04 B., C., and D. Include cost to reestablish Control Points and Bench Marks two (2) times. |
| 29 | ASI Signage Innovations | 4/1/2022 | Can you confirm there is only a need for dimensional lettering at River Valley Elementary School? Additionally, the lines directing to the lettering on drawing A5.1D are off. Please confirm RIVER VALLEY is to be 18" and ELEMENTARY SCHOOL is to be 8". Also please confirm font. | CC: YES ONLY DIMENSIONAL LETTERING. CONFIMED 18" RIVER VALLEY, 8" ELEMENTARY. ALSO PLEASE NOTE LINE UNDER ELEMENTARY. FONT TO BE CHOSEN BY OWNER THROUGH SHOP DRAWINGS FROM MFG. STANDARD FONTS. |
| 30 | MWG | 4/4/2022 | Is bid package #1 or #6 to provide the glass for the hollow metal frames? | TSC: Glazing for Hollow Metal Frames shall be provided by Bid Category No. 6 Aluminum Glass and Glazing, specified in Section 08 80 00-Glazing. Bid Category No. 1 General Trades shall provide Glazing for Hollow Metal Doors, specified in Section 08 11 13-Hollow Metal Doors and Frames, Part 1.2, A. 4. Light frames and glazing in hollow metal doors. |
| 31 | MWG | 4/4/2022 | Are the wood doors factory glazed? | CC:FACTORY GLAZING IS NOT REQUIRED. |
| 32 | KMI | 4/5/2022 | Multiple locations. Example sheets, M1.1A and A1.1A. The mechanical sheets show removal of electric finned tube at 6 locations. The architectural sheets do not show any work associated with them. Will wall patching or painting be required at removed finned tubes? If so, which bid package will be responsible for this work? | CC: YES PATCHING AND PAINTING WILL BE REQUIRED. TSC: Depending on the existing wall type and condition, scope of required patching, prepping and painting will be required by respective Bid Category, ie: existng CMU wall patching by Bid Category No. 4 Masonry and Painting by Bid Category No. 8. |
| 33 | KMI | 4/5/2022 | Reference sheet A1.1B. Math Room B114. Only a portion of the ceiling is shown to be removed. This entire ceiling should be removed to facilitate duct demo. It is not clear why only a portion of the ceiling is being removed in this room, when the adjacent rooms B117 and B119 have full removal and have the same amount of above ceiling demo required. | TSC: Bid Category No. 1 General Trades shall remove the entire existing ceiling system, Bid Category No. 11 shall remove and/or suspend existing lights and reinstall lights and Bid Category No. 8 Interior Finishes shall provide a new ceiling system. |
| 34 | KMI | 4/5/2022 | Reference sheet M1.1C. media center/tech lab area. There is an existing ceiling AHU that is to be removed. The plan, Note 3, calls for the louver to be removed. Nothing is mentioned about patching the opening. The architectural demo sheet A1.1C does not have any notes about this. How should this opening be patched and what bid package is responsible? | CC: DME0 NOTED 4/A1.4, INFILL NOTED 1/A5.1C. REFER TO DETAIL 8/A6.6. TSC: Refer to sheet A6.6 for "typical" details for patching conditions in existing wall assemblies. Scope for patching shall be as assigned as required for new assembly and condition. |
| 35 | KMI | 4/5/2022 | The new mechanical design incorporates many new duct penetrations through existing walls. I do not see a structural drawing showing these penetrations. Please confirm which duct openings will require lintels and which bid category will be responsible for providing and installing the lintels. | CC: REFER TO MASONRY UNIT NOTE #16 S1.1 FOR LINTEL REQUIREMENTS. TSC: Lintels are provided by Bid Category No. 5 Structural & Miscellaneous Steel. |

| | | | | |
|----|-------------------------|----------|---|--|
| 36 | KMI | 4/5/2022 | I would like to request a more thorough explanation of the delineations between the base bid mechanical work and the Alternate No. 1 mechanical work. For example, sheet M2.1A, science lab A133. a. Our understanding of base bid: remove existing UV and replace. Add new roof intake hood and duct. b. Our understanding of the Alternate No.1: Remove existing UV, patch wall. Add new RTU and duct system. Omit the new UV, intake hood, and duct shown. | CC: Typical base bid is to remove and replace the existing unit vent, louver, and install the relief hood with associated ductwork. Alternate 1 shall remove the existing UV and patch the wall. Install the new RTU and associated duct system. Omit the new UV, relief hood and its associated ductwork. |
| 37 | KMI | 4/5/2022 | Reference sheets M1.1A and M2.1A. Room A100. Please clarify the intent of the base bid versus the alternate. The demo plan shows the UVs to be removed. The new work shows only an RTU system to be installed, but then shows a Note 1, indicating it is part of the alternate. What will the base bid scope of work be? No work in this room? Or should the RTU be the base bid? | CC:RTU IS BASE BID FOR ROOM A100. |
| 38 | Pearson | 4/6/2022 | RFI #35 response issued with addendum 1 states lintels are to be supplied by bid package 5 Structural Steel: Item #3 of the masonry clarification under Bid Pack 4 state lintels are supplied by the mason. Please clarify, | TSC: Refer to Bid Category Clarifications issued in Addendum No. 2. |
| 39 | Pearson | 4/6/2022 | Does the supply of lintels include the W8 x 24 lintels shown at openings on sheet S2.1D or just the LX type of lintel? | TSC: Refer to Bid Category Clarifications issued in Addendum No. 2. |
| 40 | Pearson | 4/6/2022 | Can you confirm if the W8 x 24 lintels are loose laid or set on a bearing plate and welded. It is a requirement of the steel contractor to engineer all connections per the general notes? Are the LX type lintels loose laid? | CC: Refer to details 10 & 11 on S4.1 and structural general notes sheet. |
| 41 | Pearson | 4/6/2022 | Will connections engineering be required by the masonry contractor as well if there is more than loose laid lintel? | TSC: Refer to Structural Steel notes on S1.1. |
| 42 | Pearson | 4/6/2022 | TESTING, Per the Multiple Contract Summary, Testing is provided by the owner. Specification section 033000 issued via addendum lists several testing requirements for both the PIA and FF/FL requirements. Please confirm all these testing items will be provided under the owner testing. | TSC: Yes, all required field related construction material testing will be provided by the Owner through the CM. |
| 43 | EMC Electric | 4/7/2022 | On M4.0 there is an electric heater schedule (3 items located in the D section of the building). None of these heaters show up on the power page, or in LPO panel schedule (the 120/208 panel servicing the addition). Clarification requested. | CC: Refer to Adendum 2. |
| 44 | EMC Electric | 4/7/2022 | On M4.0 there is an indoor coil unit schedule (A,C, and D sections) I cannot find them on the E-drawings, or a panel designation for them. Clarification requested. | CC: Refer to Adendum 2. |
| 45 | EMC Electric | 4/7/2022 | On M4.0 there is a remote air cooled condensing unit schedule. (both above kitchen). They are labeled B112, and B113 on M4.0 schedule, and B11 and 112 on E pages. No feeder location is provided (panel/ circuit number) Clarification requested. | CC: Refer to Adendum 2. |
| 46 | EMC Electric | 4/7/2022 | On M4.0 there is an electric duct heater schedule. (A,B,C, and D areas). They are not found on the E power plans, or in any panel schedules. Clarification requested. | CC: Refer to Adendum 2. |
| 47 | EMC Electric | 4/7/2022 | UV B100 shows up on E power pages, but not on E4.3 mechanical connection schedule. Clarification requested. | CC: Refer to Adendum 2. |
| 48 | EMC Electric | 4/7/2022 | E4.3 mechanical connection schedule shows UV B113, A127, and A 125 but these do not show up on existing 3-pole breaker space in their local panels. New panel location and circuitry numbers are not on E power pages, or panel schedule. Clarification requested. | CC: Refer to Adendum 2. |
| 49 | Mainline Fire Sprinkler | 4/7/2022 | The only fire suppression that I am seeing is a new riser and piping and heads in a kindergarden room, is this correct? | CC: The addition shall be provided a fully sprinkler system. The riser shall include a total of 4 fire protection zone assemblies. |
| 50 | Gibson-Lewis | 4/7/2022 | Specification Section 114000 – Foodservice Equipment is assigned to the General Trades bid package. The spec describes stainless steel shelving and tables, however I cannot locate these items on the drawings. Please advise. | CC: REFER TO DETAILS 1-5 SHEET A8.3 RELATED TO FOOD SERVICE A124. QTY (3) SS TABLES AND QTY (2) SHELVES. |
| 51 | Columbia Lockers | 4/7/2022 | The plans seem to only list new Lockers/Cubbies for Area D; Pages A2.1D & A8.7. Please confirm. | CC: YES SEE SPECIFICATIONS FOR QUANTITY |
| 52 | MCS | 4/7/2022 | In regards to the plastic laminate cabinets, some of the tall storage cabinets have totes. I can provide those, but cannot find the exact ones they need dimensional wise. I did find some that are very close. See Drawings 8/A8.10 - requesting totes that are 13" W x 18 1/4" D x 4 1/4" H - Is this acceptable? | CC: Yes. |
| 53 | Gibson-Lewis | 4/7/2022 | Regrading Spec 124113 window shades, Floorplans show finish keynotes #F9 & F10 call out manual or motorized Shades, have not been able to find those called out anywhere. Sheet A3.2 #16 & #17 show head details one being new shade the other existing, those on shown on RCPs. Are those manual or motorized and what type of shade, are those the only areas then that get new shades? | CC: All manual shades - should be called out via 16&17/A3.2. |

| | | | | |
|----|-----------------------|-----------|---|---|
| 54 | EMC Electric | 4/8/2022 | Unit ventilators being removed are all under 20-amp according to schedule on E4.3. new units are up to 50-amp units. Which will need new conduit and wire to support the new units. Care was taken on fire alarm routes, and feeders moved onto roof to keep from running down hallways above drop ceiling. How should we plan on this piping to be installed from their respective panel to the UV's? | CC: For bidding purposes, assume new branch raceways as needed are routed exposed if the existing raceway is too small or unavailable. |
| 55 | EMC Electric | 4/8/2022 | In addendum 1 on new page E2.2 on the left side of the building there is a note for approximate location of new pad mount/main for the new 120/208V 1600A service. This is between 440' and 500' depending on route. To take this 1600A secondary wiring that distance with noted XHHW wiring, cost for material alone would be over \$175,000.00. is there an ability to directional bore from existing transformer to new addition location for utility wiring, place new transformer and main disconnect there, and shrink secondary 1600A feeder length down to 30/40' length? | CC: Refer to Addendum 2. |
| 56 | Columbia Lockers | 4/8/2022 | Columbia Locker Product Substitution Request. | CC: Approved |
| 57 | Pearson | 4/8/2022 | Please clarify where and the extent of the type C barrier curb shown on sheet C-8 goes. | CC: See Addendum 002, sheet C-2 for call out |
| 58 | Hollerbach Excavating | 4/8/2022 | Alt. #2-State the Cost to do Site Work on the westside of project. Q-Where does Base Bid end and Alt #2 begin? Appears to be very vague. | TSC: Refer to C series drawings and descriptions in Addendum No. 2. |
| 59 | Hollerbach Excavating | 4/8/2022 | Who is responsible for footing excavation and backfilling the addition? | TSC: Refer to Clarifications added in Addendum No. 2. Bid Category No. 2 Sitework shall provide all required building excavation, backfilling, and compaction work. |
| 60 | Hollerbach Excavating | 4/8/2022 | Who is responsible for fence removal and nets at tennis court for Alt.#4? | TSC: Bid Category No. 2 Sitework shall provide site demolition work for Alternate No. 4, including fencing, nets and post removal. Reinstallation of fencing, nets and posts for Alternate 4 work, shall be provided by Bid Category No. 1 General Trades. |
| 61 | Hollerbach Excavating | 4/8/2022 | Who is responsible for 8" watermain to be brought into addition and stubbed up for Fire Protection. | TSC: Please refer to RFI Log, Q & A No. 1. |
| 62 | Hollerbach Excavating | 4/8/2022 | Utility Plan Sheet C-5-Calls for 8" DIWM. Q-Specifications says C-900 PVC pipe can be used. Is this acceptable? | CC: Yes, as long as it is approved by the municipality |
| 63 | Hollerbach Excavating | 4/8/2022 | Who is responsible for Berrien County Drain Commission Soil Erosion Permit? | CC: Watermark is making the submittal. Refer to Section 01 12 00 Multiple Contract Summary Section, Part 1.09 Permits, Fees and Notices. Each Contractor shall secure and pay for all other permits, fees and licenses necessary for the proper execution and completion of the Contractors Work. Bid Category No. 2 Sitework shall procure and pay for all required permits to execute your work. |
| 64 | Hollerbach Excavating | 4/8/2022 | Is Snow Removal included in Site Work Bid Category | TSC: Refer to Section 01 50 50-Temporary Facilities and Controls. Any general snow removal required beyond what is specified in this Section will be handled on a time and material basis and allocated against the Contractor's Allowance. |
| 65 | Control Solutions | 4/8/2022 | Control Solutions Substitution Request. | CC: Approved |
| 66 | Ritsema | 4/11/2022 | On ceiling drawing A3.1C in the Media Center, there looks to be some suspended drywall clouds. I am not finding any details on the construction of these clouds or an edge detail. Can this be provided? | CC: Cloud edge detail similar to 3/A3.2, provide Armstrong axiom trim or equal. |
| 67 | Midwest Tile | 4/14/2022 | The Tile speed is no longer available. | CC: For tile we can use up their 400 sf in 1 or 2 of the small single user toilets. Then we can use the same size/style of 4x4 ceramic and choose new colors in the others |
| 68 | Midwest Tile | 4/14/2022 | Please provide spec section for Carpet Tile. | CC: 096813 spec is performance based and we will choose pattern/color from the submitted mfg. through submittal/shop drawings |
| 69 | Marshall & Wells | 4/14/2022 | Gravity Ventilation Schedule: 1) GV-D121, GV-D107, GV-A125, GV-A109, GV-A100 (Scheduled but NOT Drawn) -Where are they located? -Should I still Quote if they can't be found? 2)GV-A104, GV-A128, GV-B100, GV-C119 (Drawn but NOT Scheduled) -Do these need to be quoted? -if they do need to be quoted, what size? | CC: Refer to addendum 004; GV-D107 has been added to the roof plan. Remove GV-A100, GV-A125, and GV-D121 from schedule and project. Revise GC-A109 to GC-A104 in gravity ventilation schedule. |
| 70 | Marshall & Wells | 4/14/2022 | Gravity Ventilation Schedule: GV-A104, GV-A128, GV-B100, GV-C119 (Drawn but NOT Scheduled) -Do these need to be quoted? -if they do need to be quoted, what size? | CC: Revise GC-A109 to GC-A104 in gravity ventilation schedule. |
| 71 | Marshall & Wells | 4/14/2022 | Louver Schedule: 1)Am I only quoting the unit ventilator Louvers with NOTE #2 tagged, even though they're all Scheduled as Ruskin EME520DD? -We do not supply UV's, so I would Exclude all Louvers with Note #1 2)What size within the Louver schedule Should I quote? -Note 2 states Louver in Window opening, but the Existing Window Opening is not lining up with the (3) 36"x16" intake and (3) 36"x17" Exhaust 3) Does the Quantity Column mean we need that many Louvers for Intake and Exhaust? -Exterior Elevations Does not show the same number of louvers as Scheduled for every UV | CC: The unit ventilator equipment manufacture shall provide louver and wall boxes at locations where the louver can be installed in the wall (brick). The mechanical contractor shall provide louver and wall boxes at locations where the louvers shall be installed in a window system. 2. Provide the louver size listed as Width and Height. The new louvers will increase in size to accommodate the packaged cooling/heating unit ventilator. The existing width and height is the existing overall panel opening. 3. The quantity indicates the number of louvers needed at each equipment location. Refer to sheet A6.6 detail 3 and Detail 7. Detail 3 shall be revised to indicate (2) louvers within each panel opening. |
| 72 | Marshall & Wells | 4/14/2022 | Electric Duct heater Schedule: 1)All Electric Duct Heaters are Scheduled but NOT Drawn/Tagged -Where are they located? - If you want quoted: - what duct size? -What Voltage/Phase? (Thermolec TER Heaters are not available in 460/3) | CC: Refer to M2.1A for location of EHD-A104A and EHD-A104B. Adjust EDH-A109A and EDH-A109B to EDH-104A and EDH-104B. Remove EDH-B103 , FC-C119, EDH-D107 from the project. Adjust EDH(s) power requirements to 208 / 3. ADD EDH-A128A and EDH-128B to project. |

| | | | | | | | | | | | | | | | | | | | | | | | | | | | | | | | | | | | | | | | | |
|---|
| 73 | Marshall & Wells | 4/14/2022 | Exhaust Fan Schedule: 1) EF-1 is Scheduled but NOT Drawn -Where is it Located? - Should I still Quote if they can't be found? 2) EF-D143 is Drawn but NOT Scheduled -Does this need to be Quoted? -If you want quoted, what is the performance needed? What Size? | CC: Revise exhaust fan schedule tag EF-1 to EF-D104. 2. Provide EF-D143 exhaust fan by loren cook model number C101C15M, 220 CFM, 0.4 ESP, .125 HP, and note 1. | | | 74 | S.A.Mormon | 4/14/2022 | RFI #31 asked basically the same question regarding factory glazing for wood doors and the response was "factory glazing is not required." For Final Clarification please state if Wood Doors are Factory Glazed or Not. | CC: Yes some of the doors are glazed (refer to door types), but we do not care if the glazing is installed in a factory or in the field. | | | 75 | S.A.Mormon | 4/14/2022 | Addendum 2 added an Exterior Hollow Metal Door (E5) with Hardware to be determined. Hardware information is required to properly provide preps for the Door and Frame. Pleas provide a Hardware Set for Opening E5. | <p style="text-align: center;">Set 41</p> <p>Doors: <u>Exterior</u> Exterior: Rim Exit Device (storeroom) x Overhead Stop x Door Closer</p> <table border="0"> <tr> <td>Hinge (qty per spec)</td> <td>T443386 (size per spec, NRP as applicable)</td> <td>US32D</td> <td>MK</td> </tr> <tr> <td>1 Rim Exit Device, Storeroom</td> <td>LD 19 43 8806 ETL</td> <td>US32D</td> <td>SA</td> </tr> <tr> <td>1 Surf Overhead Stop</td> <td>9-X36</td> <td>G30</td> <td>RF</td> </tr> <tr> <td>CC: 1 Surface Closer</td> <td>PRO7500</td> <td>G89</td> <td>NO</td> </tr> <tr> <td>1 Kick Plate</td> <td>K1050 10" High CSK BEV</td> <td>US32D</td> <td>RO</td> </tr> <tr> <td>1 Rain Guard</td> <td>346_</td> <td></td> <td>PE</td> </tr> <tr> <td>1 Sweep</td> <td>345_PK</td> <td></td> <td>PE</td> </tr> <tr> <td>1 Threshold</td> <td>252x_FG</td> <td></td> <td>PE</td> </tr> <tr> <td>1 Kerf Weather Seal</td> <td>by frame manufacturer</td> <td></td> <td>CR</td> </tr> </table> | Hinge (qty per spec) | T443386 (size per spec, NRP as applicable) | US32D | MK | 1 Rim Exit Device, Storeroom | LD 19 43 8806 ETL | US32D | SA | 1 Surf Overhead Stop | 9-X36 | G30 | RF | CC: 1 Surface Closer | PRO7500 | G89 | NO | 1 Kick Plate | K1050 10" High CSK BEV | US32D | RO | 1 Rain Guard | 346_ | | PE | 1 Sweep | 345_PK | | PE | 1 Threshold | 252x_FG | | PE | 1 Kerf Weather Seal | by frame manufacturer | | CR |
| Hinge (qty per spec) | T443386 (size per spec, NRP as applicable) | US32D | MK | | | | | | | | | | | | | | | | | | | | | | | | | | | | | | | | | | | | | |
| 1 Rim Exit Device, Storeroom | LD 19 43 8806 ETL | US32D | SA | | | | | | | | | | | | | | | | | | | | | | | | | | | | | | | | | | | | | |
| 1 Surf Overhead Stop | 9-X36 | G30 | RF | | | | | | | | | | | | | | | | | | | | | | | | | | | | | | | | | | | | | |
| CC: 1 Surface Closer | PRO7500 | G89 | NO | | | | | | | | | | | | | | | | | | | | | | | | | | | | | | | | | | | | | |
| 1 Kick Plate | K1050 10" High CSK BEV | US32D | RO | | | | | | | | | | | | | | | | | | | | | | | | | | | | | | | | | | | | | |
| 1 Rain Guard | 346_ | | PE | | | | | | | | | | | | | | | | | | | | | | | | | | | | | | | | | | | | | |
| 1 Sweep | 345_PK | | PE | | | | | | | | | | | | | | | | | | | | | | | | | | | | | | | | | | | | | |
| 1 Threshold | 252x_FG | | PE | | | | | | | | | | | | | | | | | | | | | | | | | | | | | | | | | | | | | |
| 1 Kerf Weather Seal | by frame manufacturer | | CR | | | | | | | | | | | | | | | | | | | | | | | | | | | | | | | | | | | | | |
| 76 | Ritsema | 4/14/2022 | On page A2.1D there are a few locations where it calls out wall type H2, such as Rooms D117 and D102. The partition types plan A2.0 says for wall type H, that it is not used. Please clarify wall type H2. | CC: REVISE H2 TAGS TO K2 - REFER TO ADDENDUM 4 | | | 77 | CAMVPN | 4/14/2022 | Please provide sheets P2.0B and P2.0C. | CC: REMOVE SHEETS P2.0B & P2.0C FROM SHEET LIST. | | | 78 | Indiana Earth | 4/14/2022 | How does the engineer want the storm pipe that is required to be insulated? Could a detail be provided? | CC: See Addendum 4. | | | 79 | Indiana Earth | 4/14/2022 | I spoke to my pipe vendor and he is telling me that perforated pvc pipe has a very long lead time. Can we substitute this with perforated N-12 HDPE pipe? | CC: | | | 80 | Indiana Earth | 4/14/2022 | Drawings for sheet C-11 Sanitary Lift Station plan. 1. The sheet doesn't have elevation. 2. Sizes of Wetwell, Valve Vault. 3. Control panel spec. 4. Voltage and phase. 5. Piping size. 6. Force Main, Discharge Manhole. 7. Location Of Lift Station. | <p>CC:</p> <ol style="list-style-type: none"> 1. Refer to sheet C-5 for all pipe inverts and rim elevation. 2. Pump basin shall be 60" I.D. x 144" concrete structure. 3. Mount and locate the control panel on the exterior wall on the high school closes to the lift station. The Control panel shall be Weil Pump Series 8100DS, NEMA-4X, Stainless Steel Enclosure, DDDF, duplex, UL Listed, with a main disconnect, transformer, starters, O.L. blocks, H-O-A switches, run lights and alarm horn and light with silence push-button, and dry remote alarm contacts. Float control shall be, (4) Weil Pump Model 8200DS submersible float switches with 80'-0" foot cables to control pump "off", "on", "lag", and "high water alarm" level. 4. The voltage and phase shall be 460 / 3. 5. The pump discharge shall be (2) 4" discharge pipes. Refer to Duplex wastewater valve assembly and civil plans. Also the pumps shall be mounted on a Weil Pump Co. Model 2613-4DS quick removal system with base elbows and upper guide bracket. Contractor to furnish 2" diameter stainless steel guide rails. Each pump requires (2) guide rails provided by contractor. On pump discharge piping, contractor shall provide and install Weil Pump Co model 2616-4" duplex valve assembly. 6. Discharge basin shall be 48" I.D. x 60" concrete structure. 7. Refer to sheet C-5 for location of lift station (near bus turn around). | | | 81 | Trout | 4/15/2022 | Should the six SF2 frames on page A8.4 be SF4? | CC: REFER TO REVISED SHEETS IN ADDENDUM 4 | | | 82 | Pearson | 4/18/2022 | Can you confirm the base bid concrete scope of work for walks on the south and west side. I am uncertain of the extend of concrete walks in the base bid if alternate 2 is not accepted. | CC: BASE BID SHOULD INCLUDE ALL SIDEWALKS EAST OF THE SOUTHWEST CORNER OF THE BUILDING AND A 10' SIDEWALK CONNECTING THEM TO THE EXISTING WEST PARKING LOT. | | 
ARCHITECT'S ADDENDUM

Addendum Number: 004

Date: 04.20.22

RE: River Valley School Consolidation

Prepared By: Cayce Horton
Cordogan, Clark & Associates

CCA Project No.: 21346

To: Prospective Bidders

Subject: Addendum No. 004 to the Construction Documents for the River Valley School Consolidation Project.

This Addendum forms a part of the Construction Documents and modifies the original Construction Documents, dated 03.22.22. Acknowledge receipt of this Addendum in space provided on the Bid Form. Failure to do so may subject Bidder to disqualification.

THE FOLLOWING ITEMS ARE TO BE INCLUDED IN THE PROPOSAL.

Clarifications To The Specifications:

087100 – DOOR HARDWARE

- ADD HARDWARE SET 4.1

Set: 4.1

Doors: E5

Exterior: Rim Exit Device (storeroom) x Overhead Stop x Door Closer

| | | | |
|------------------------------|--|-------|----|
| Hinge (qty per spec) | T4A3386 (size per spec, NRP as applicable) | US32D | MK |
| 1 Rim Exit Device, Storeroom | LD 19 43 8806 ETL | US32D | SA |
| 1 Surf Overhead Stop | 9-X36 | 630 | RF |
| 1 Surface Closer | PRO7500 | 689 | NO |
| 1 Kick Plate | K1050 10" high CSK BEV | US32D | RO |
| 1 Rain Guard | 346 | | PE |
| 1 Sweep | 345_PK | | PE |
| 1 Threshold | 252x_FG | | PE |
| 1 Kerf Weather Seal | by frame manufacturer | | CR |

230900 INSTRUMENTATION AND CONTROL FOR HVAC

- SECTION 2.2A1 – REVISE to the following “ Johnson Facility Explorer – (Tridium Niagara 4.11) with supervisory controller to be JACE 8000 Series.”
- SECTION 2.2A2 – ADD the following “ Distech – (Tridium Niagara 4.11) with supervisory controller to be JACE 8000 Series.”

Clarifications To The Drawings:

Sheet C8

- ADD pipe insulation detail

Sheet C11 SANITARY LIFT STATION PLAN

- REVISE PER ATTACHED CUT SHEETS AND SYSTEM DESCRIPTION

Sheet T0.0

- REMOVE SHEET P2.0B from sheet list.
- REMOVE SHEET P2.0C from sheet list

Sheet A2.1A, A2.1B, A2.1C, A2.1D

- REVISE all H2 wall type tags to K2.

Sheet A6.6

- REVISE wall section detail 3 “TYPICAL LOUVER SILL DETAIL IN WINDO PANEL SYSTEM”.

Sheet A8.4

- REVISE glazing tags.

Sheet A9.0

- ADD DOOR E5: HARDWARE SET 4.1.

Sheet A9.2

- REVISE required number of storefronts type SF4 to qty. 10

Sheet M1.1A

- ADD the room temperature sensor symbol associated to the (2) demod unit ventilators in room A121.

Sheet M1.1B

- ADD the room temperature sensor symbol associated to the demod unit ventilator in room B100

Sheet M1.1C

- ADD the room temperature sensor symbol associated to the demod unit ventilator in room C114.

Sheet M1.1D

- ADD the following keynote 6. ‘Disconnect and remove the existing exhaust fan with associated ductwork, hangers, and controls.’

- ADD and tag the existing exhaust duct system located near room D107 with keynote 6.

Sheet M2.1A

- ADD EDH-A104A to the outside air intake ductwork associated to FC-A104. Also include a motorized damper.
- ADD EDH-A104B to the supply air ductwork associated to FC-A104.
- ADD space sensor for FC-A104 with-in room.
- ADD EDH-A128A to the outside air intake ductwork associated to FC-A128. Also include a motorized damper.
- ADD EDH-A128B to the supply air ductwork associated to FC-A128.

Sheet M2.1B

- ADD space sensor for RTU-B112 with-in room.

Sheet M2.1C

- ADD space sensor for RTU-C100 with-in room.
- ADD space sensor for FC-C119 with-in room.
- ADD motorized damper on outside air intake on FC-C119.

Sheet M2.1D

- ADD space sensor for RTU-D107 with-in room.
- ADD motorized damper on outside air intake on FC-D107.
- ADD tag B at 85 cfm, 8" diameter N.K. in room D106.
- ADD space sensor for RTU-D121 with-in room.

Sheet M2.2A

- REVISE location of GV-A104.

Sheet M2.2B

- REVISE gas line size tag from 1-1/4" to 1-1/2". The gas main services RTU-B100 and RTU-C100.

Sheet M2.2D

- ADD GV-D107 to roof plan.

Sheet M4.0

- REVISE HP-A104, HP-C119, HP-D107, HP-A128

Sheet M4.0.2

- ADD the following to the exhaust fan schedule EF-D143, restroom group, 220 cfm, 0.4 ESP, 0.125 HP, Roof, direct drive, 115/1, Loren Cook, C101C15M, BAS-OCC schedule, and note 1.
- REVISE the model number for the following FC-A104, FC-C119, FC-D107, FC-A128 to NTXDKS12A112AA.
- REVISE the model number for the following HP-A104, HP-C119, HP-D107, HP-A128 to NTXSKH12A112AA.
- REVISE equipment tag EF-1 to EF-D104.

- REVISE equipment tag EDH-A109A and EDH-A109B to EDH-A104A and EDH-A104B.
- REVISE all electric duct heaters to 208,3 power.
- REVISE equipment tag GC-A109 to GC-A104.
- REMOVE GV-A100, GV-A125, GV-D121 from the schedule.

Sheet M4.2

- ADD electric heating coil on the outside air intake (if present). Enable electric heater if the amb temperutre drops below 35 degrees.

Sheet P2.1D

- REVISE and increase HW line tag to 1-1/4" vs 1". The revised tag is located in the corridor D129 near columne line 6D.
- REVISE and increase HW line tag to 1-1/4" vs 1". The revised tag is located in the corridor D129 near columne line 9D.
- REVISE and increase HW line tag to 1" vs 3/4". The revised tag is located in Janitor D114.
- ADD 6" OD-1 and 6" RD-1 with associated 6" SD and OSD piping to the plan west of D133. See plans for details
- REVISE existing RD-1 and OD-1 locations to correspond with locations shown on architectural plans. See attached for exact location.
- REVISE and increase the 6" DS-1 tag to 8" vs 6". The revised tag is located plan east of D131

Sheet E2.1A, E2.1B, E2.1C

- ADD Mechanical Equipment tags. Schedules for new PP-E and PP-F are deleted in favor of existing tubs being reworked and partially refed per E4.2.

Sheet E2.2A, E2.2B, E2.2C

- ADD New feeders and branch circuit wiring to new mechanical equipment to be ganged as much as possible with new feeders indicated on E2.2. Mechanical equipment in Area D can be fed concealed above new ceilings.

Sheet E4.2

- ADD panel LP-HP to roof a of building fed from new MSB2. Panel LP-HP to be 400amp 3phase 4W 42 CCT. Provide 4#500 THHN 1#3G 3'C feed from MSB2 to panel LP-HP. Provide additaonl 400/3 breaker in new MSB2. Located panel LP-HP on the roof in optimal location to serve new heat pumps and electric duct heaters.

Sheet E4.3

- PROVIDE complaint hookup to heatpumps HP-A104, HP-C119, HP-D107 on separate 30 amp circuits from panel LP-HP. PROVIDE (3) 30 amp 2-pole breakers in panel LP-HP. MIN 2#10 1#10G 1/2"c. Local disconnect integrated by manufacture. See mechincal plans for locations of heatpumps
- PROVIDE complaint hookup to indoor fan coil units FC-A104, FC-C119, FC-D017 from panel LP-HP. PROVIDE (1) 20 amp 2-pole breaker in panel LP-HP. MIN 2#12 1#12G 1/2"C. Indoor fan coil units to share common feed from single 20 amp circuit. Provide local disconnect.
- PROVIDE complaint hookup to electric duct heater EDH-A104A, EDH-A104B, EDH-A128A, EDH-A128B on separate 30amp circuit from panel LP-HP. PROVIDE (4) 30 amp 2-pole

breakers in panel LP-HP. MIN 2#10 1#10G ½"C. local disconnect integrated by manufacture.

- PROVIDE complaint hookup to heatpump HP-B103/FC-B103 from panel LP-HP. PROVIDE (1) 30 amp 2-pole breakers in panel LP-HP. MIN 2#10 1#10G ½"c. Provide local 30amp 2-pole WP fusible disconnect with fuses matching equipment nameplate rating. Indoor fan coil fed from outdoor unit terminal strips. Provide wiring from outdoor unit to indoor unit per manufacture specifications. See mechanical plans for locations of heatpumps
- PROVIDE complaint hookup to duplex wastewater pump from existing panel F. Provide new 20amp 3-pole breaker. Min 3#12 1#12G ½"C. Provide local 30amp combination starter/disconnects with Nema size '0' starter. See civil plans for pump location on site.
- ADD duct detectors as required for RTU's B-117, B-121, C-114, C-115. Provide compliant connection to photocatalytic oxidizers from nearest 120-volt panel; feed integral convenience receptacle from nearest 120-volt panel.


Sheet E4.5

- ADD duct detectors as required for RTU's B-117, B-121, C-114, C-115; show initiation circuit extended from RTU-C100 to additional detectors. Program for alarm or supervisory per local AHJ.

Attachments:


REVISED SANITARY LIFT STATION CUT SHEETS
 REVISED SANITARY LIFT STATION SYSTEM DESCRIPTION
 REVISED C8 PROJECT DETAILS
 REVISED A6.6 WALL SECTION DETAILS
 REVISED A8.4 ENLARGED PLANS & ELEVATIONS - E.S. OFFICES
 REVISED A9.2 STOREFRONT & WINDOW TYPES
 REVISED M1.1D PARTIAL FIRST FLOOR MECHANICAL DEMOLITION PLAN - AREA D
 REVISED M2.1A PARTIAL FIRST FLOOR MECHANICAL PLAN - AREA A
 REVISED M2.1D PARTIAL FIRST FLOOR MECHANICAL PLAN - AREA D
 REVISED M2.2B PARTIAL ROOF MECHANICAL PLAN - AREA B
 REVISED M4.0 MECHANICAL SCHEDULES AND DETAILS
 REVISED P2.1D PARTIAL FIRST FLOOR PLUMBING PLAN - AREA D
 REVISED E2.1A ELECTRICAL POWER PLAN – AREA A
 REVISED E2.1B ELECTRICAL POWER PLAN – AREA B
 REVISED E2.1C ELECTRICAL POWER PLAN – AREA C
 REVISED E2.2A ELECTRICAL POWER PLAN - ROOF AREA A
 REVISED E2.2B ELECTRICAL POWER PLAN - ROOF AREA B
 REVISED E2.2C ELECTRICAL POWER PLAN - ROOF AREA C

End Of Addendum No. 004

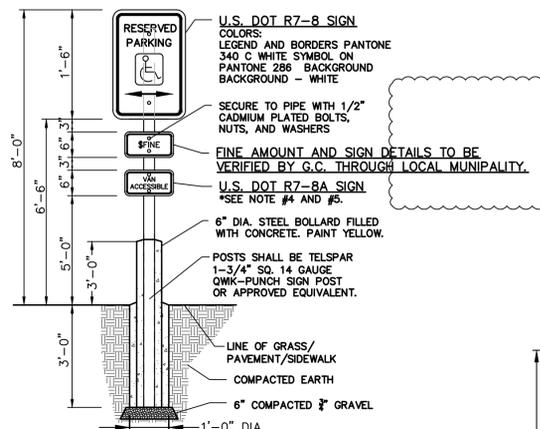


ACCESSIBLE PARKING SPACE BOLLARD SIGN DETAIL

- FINE AMOUNT AND SIGN DETAILS TO BE VERIFIED BY G.C. THROUGH LOCAL MUNICIPALITY.
- THIS PLATE MAY BE MOUNTED DIRECTLY BELOW THE R7-8 SIGN OR COMBINED WITH THAT SIGN ON A SINGLE 12 INCH BY 24 INCH PANEL ON THE RESERVED PARKING SIGN. THE ARROW SHOULD BE OMITTED WHERE THERE IS ONLY ONE SPACE. THE ARROW MAY ALSO BE MADE TO POINT IN ONLY ONE DIRECTION. THE ARROW MAY ALSO BE REPLACED BY "TIME" SUCH AS 9 AM-5 PM WHERE A PART TIME RESTRICTION EXISTS. ONE IN EVERY SIX ACCESSIBLE SPACES, BUT NOT LESS THAN ONE, SHALL BE SERVED BY AN ACCESS AISLE 8 FEET WIDE MINIMUM AND SHALL BE DESIGNATED "VAN ACCESSIBLE".
- THE LOWEST BOTTOM EDGE OF THE LOWEST REQUIRED SIGN SHALL BE MOUNTED AT 60" ABOVE FINISHED GRADE.

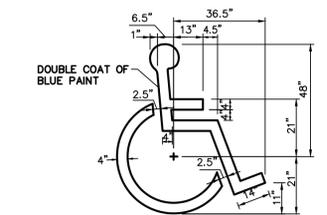


ACCESSIBLE PARKING SPACE SYMBOL


- SYMBOL IS CENTERED ON WIDTH OF PARKING STALL AND 2' FROM THE END OF THE STALL.

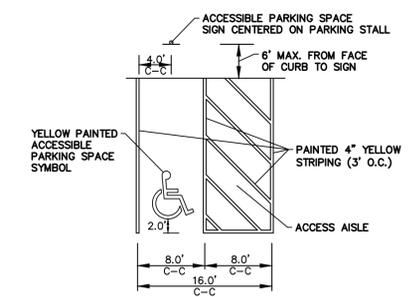


ACCESSIBLE PARKING SPACE DETAIL

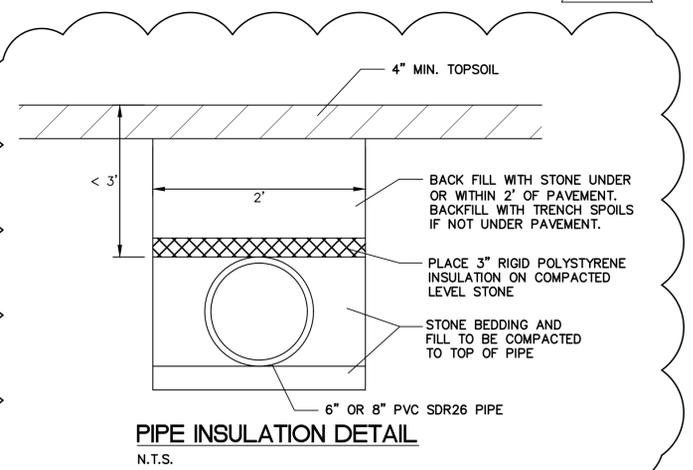


PIPE INSULATION DETAIL

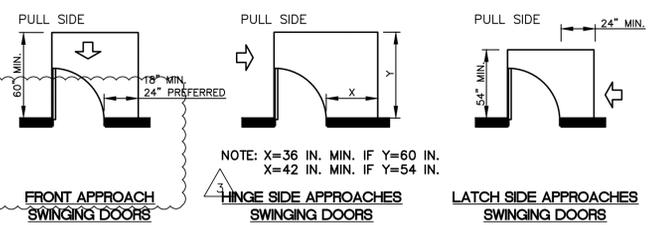

TYPICAL ACCESSIBLE LANDING AREA DETAIL

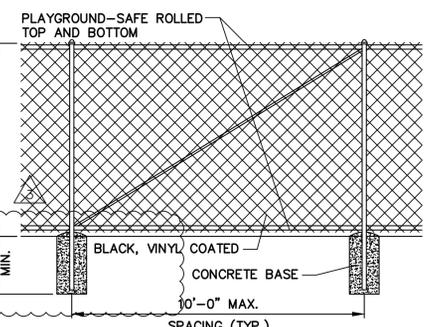


TYPICAL CHAIN LINK FENCE

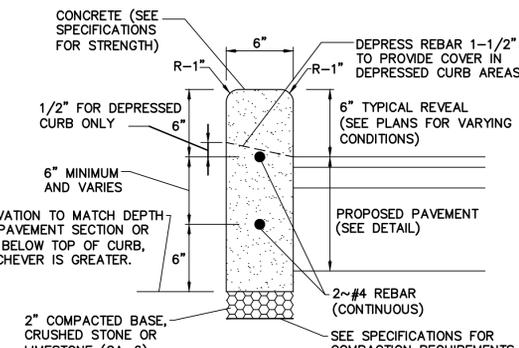


TYPE 'C' BARRIER CURB

- PROVIDE 1/2" EXPANSION JOINTS EVERY 45' O.C.
- PROVIDE HAND TOOLED CONTRACTION JOINTS EVERY 15' O.C.

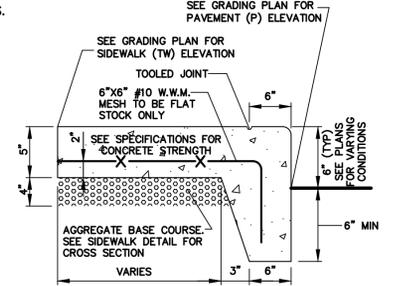


TURNED DOWN EDGE SIDEWALK

- PROVIDE TOOLED JOINTS AT 5' O.C.
- PROVIDE CONTRACTION JOINTS AT 15' O.C.
- PROVIDE EXPANSION JOINTS AT 45' O.C.
- ROUND EXPOSED CORNERS WITH 1/2" RADIUS.

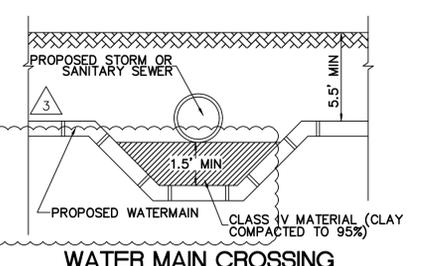


WATER MAIN CROSSING

- NOTE: 1. USE MIN. 21 L.F. OF WATERMAIN CLASS PIPES (MIN. 10' ON EACH SIDE OF THE CROSSING). SEE SPECIFICATIONS FOR PIPE AND JOINT SPECIFICATIONS.

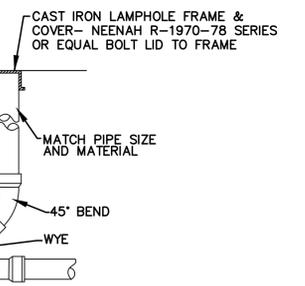


CLEANOUT DETAIL

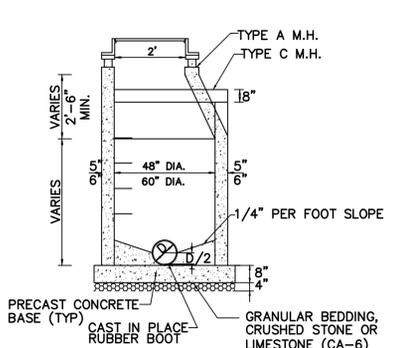


SANITARY MANHOLE (IEPA TYPES A AND C)

- NOTES:
- PROVIDE EXTERNAL CHIMNEY SEAL ON ALL SANITARY MANHOLES.
 - USE TYPE A UNLESS SPECIFIED IN SEWER CALLOUT.
 - OUTSIDE OF SANITARY MANHOLE SHALL BE MOISTURE PROOFED WITH TWO COATS OF BITUMINOUS MATERIAL.

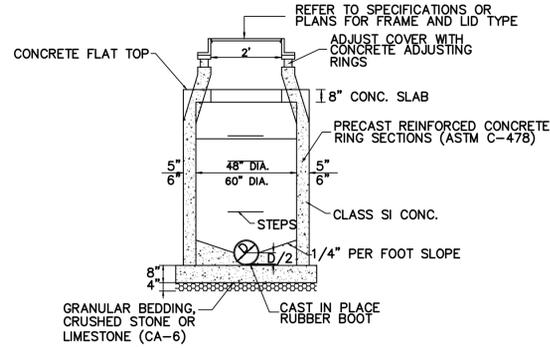


SANITARY MANHOLE (CONCENTRIC)

- NOTES:
- PROVIDE EXTERNAL CHIMNEY SEAL ON ALL SANITARY MANHOLES.
 - USE TYPE A UNLESS SPECIFIED IN SEWER CALLOUT.
 - OUTSIDE OF SANITARY MANHOLE SHALL BE MOISTURE PROOFED WITH TWO COATS OF BITUMINOUS MATERIAL.

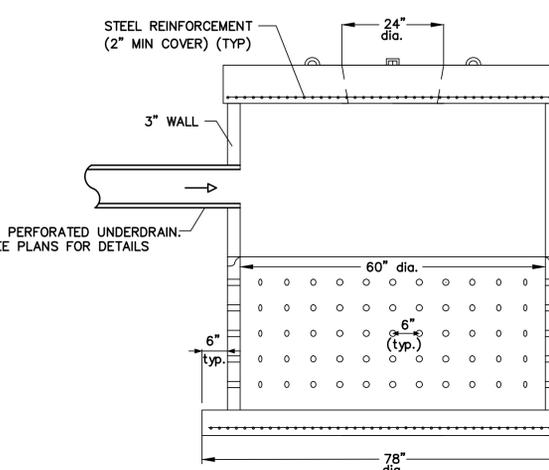


DRYWELL DETAIL


- NOTES:
- DRYWELL IS CONCRETE AND REINFORCED WITH #2 STEEL REBAR AND 1.5" FIBRILLATED POLYPROPYLENE FIBRE.
 - WALLS ARE 3" THICK AND LID IS 9" REINFORCED WITH #4 STEEL REBAR AND 1.5" FIBRILLATED POLYPROPYLENE FIBRE.
 - TEST STRENGTH OF CONCRETE IS 4,500 - 5,000 PSI.
 - BASE IS 6" REINFORCED CONCRETE WITH #4 STEEL REBAR AND 1.5" FIBRILLATED POLYPROPYLENE FIBRE.
 - SEE PLAN FOR BOTTOM AND RIM ELEVATION AND DIAMETER OF EACH DRYWELL.
 - OPENINGS TO BE 1 1/2" DIAMETER AND START WHEN SOILS CONSIST OF MOSTLY SAND.

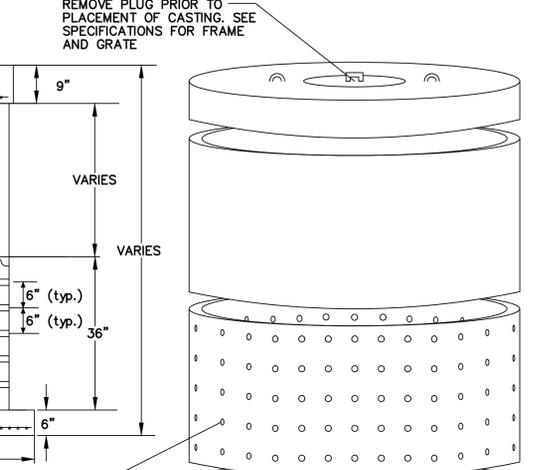

TYPICAL VALVE BOX INSTALLATION

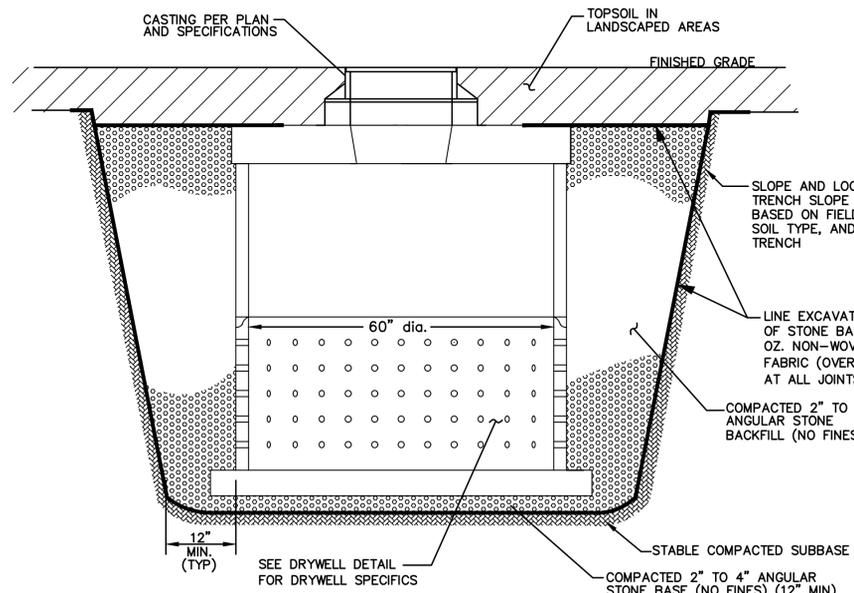

DRYWELL INSTALLATION DETAIL

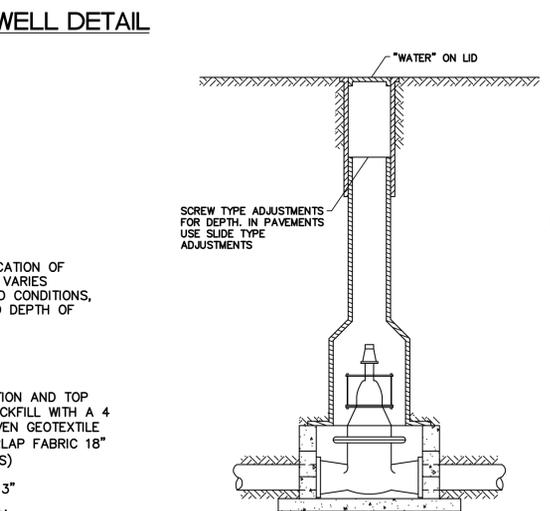

TYPICAL VALVE BOX INSTALLATION

| | |
|-----------------|---------------------|
| DATE | 3/3/22 |
| REVISIONS | 95% CD PROGRESS SET |
| NO. | 1 |
| CD BID SET | 4/12/22 |
| NO. | 2 |
| ADDITIONAL BIDS | NONE |
| NO. | 3 |
| ADDITIONAL BIDS | NONE |
| NO. | 4 |
| ADDITIONAL BIDS | NONE |

Prepared For:

CORDOGAN CLARK AND ASSOCIATES
960 Ridgeway Road
Aurora, IL 60506

RIVER VALLEY K-12 SCHOOL - THREE OAKS
15480 Three Oaks Road
Three Oaks, Michigan

Prepared By:

J. MILLER

H. WITTENKELLER

K. SACK

NOVEMBER 23, 2021

SCALE: NONE

PROJECT NO.: 21-073

watermark-engineering.com | 2631 Ginger Woods Pkwy | Aurora, IL 60502 | (630) 375-1800

watermark-engineering.com | 2631 Ginger Woods Pkwy | Aurora, IL 60502 | (630) 375-1800

SYSTEM DESCRIPTION

River Valley H.S. – Michigan


DUPLEX WASTEWATER LIFT STATION (SE-1)

Provide and install Weil Pump Co. duplex pump system, including (2) Weil Pump Model 2500DS heavy duty 4" discharge submersible non clog pumps capable of passing 3" solids. Pump shall be constructed with carbon-ceramic mechanical seal, cast iron impeller and 80 ft. power cables. Pump to be rated 150 GPM at 18 FT TDH, with air filled, 2 hp, 1750 rpm, 60 HZ, three phase, 460-volt non-overloading motor. Oil filled motors which are less efficient than air filled motors, and oil filled motors which can create an environmental hazard due to oil leakage during operation and maintenance shall not be considered equal or allowed. Pumps shall be provided as a packaged system. Pumps, controls and accessories shall be supplied by one source to maintain consistency and uniformity of the system. From the manufacturer, each pumping system must have its own serial number indicated on the pumps and control panel and be inventoried for a minimum of 20 years for future service inquiries. the entire system will be AARA (American Recovery and Reinvestment Act) certified. all equipment shall be supplied by Daugherty sales, Arlington Heights, IL. (847)-956-8844.


Control panel shall be Weil Pump Series 8100DS, NEMA-4X, Stainless Steel Enclosure, DDDF, duplex, UL Listed, with a main disconnect, transformer, starters, O.L. blocks, H-O-A switches, run lights and alarm horn and light with silence push-button, and dry remote alarm contacts. Float control shall be, (4) Weil Pump Model 8200DS submersible float switches with 80'-0" foot cables to control pump "off", "on", "lag", and "high water alarm" level. Contractor to provide suspension pipe to mount float switches and shall coordinate with electrical and provide submergent rated junction boxes as needed between the pump basin and the control panel only if the panel distance is beyond the 80'-0" cable lengths provided.

Pumps shall be mounted on a Weil Pump Co. Model 2613-4DS quick removal system with base elbows and upper guide bracket. Contractor to furnish 2" diameter stainless steel guide rails. Each pump requires (2) guide rails provided by contractor. On pump discharge piping, contractor shall provide and install Weil Pump Co model 2616-4" duplex valve assembly. Refer to drawings and details for further information.


Pump basin shall be 60" I.D. x 144" concrete structure. Contractor shall install/secure the Weil Pump Co. removal stud base plate to the basin bottom to anchor removal elbows and to locate proper orientation of the equipment in the wet well. Hatch Style Cover: Aluminum diamond plate. Angle Frame: 1/4" (7mm) aluminum with continuous anchor flange. Load Rating: H-20. Uniform live load with a maximum allowable deflection of 1/150 of the span. Locking System: Type 316 stainless steel slam lock with removable key. Cover equipped with the following stainless-steel features: spring assists, T-316 heavy duty hinges, T-316 tamper proof attaching hardware, automatic T-316 hold open arm with aluminum latch. Removal System Hardware: Aluminum nut rail to span the width of the hatch opening and T316 stainless steel spring nuts (2) per pump. Contractor to coordinate the length of the guide rails needed in the field after precast work has been completed, and hatch is set in final location. Contractor shall be required to coordinate all below cover discharge and conduit runs as shown on underground drawing plans.

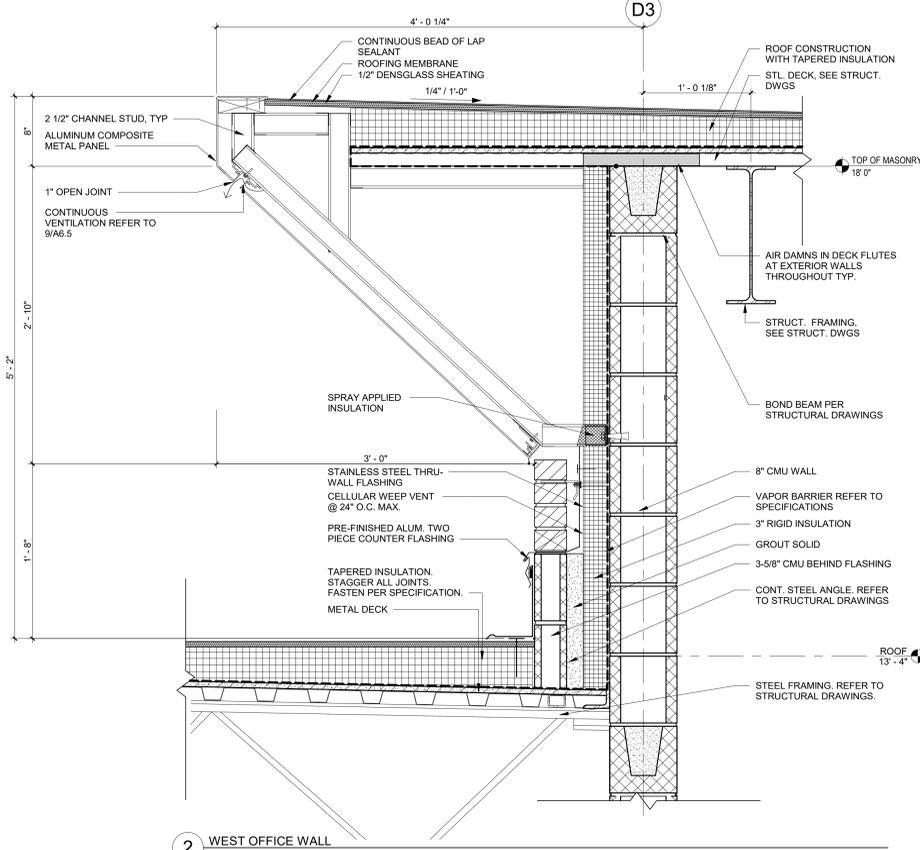


2 WEST OFFICE WALL
1 1/2" = 1'-0"

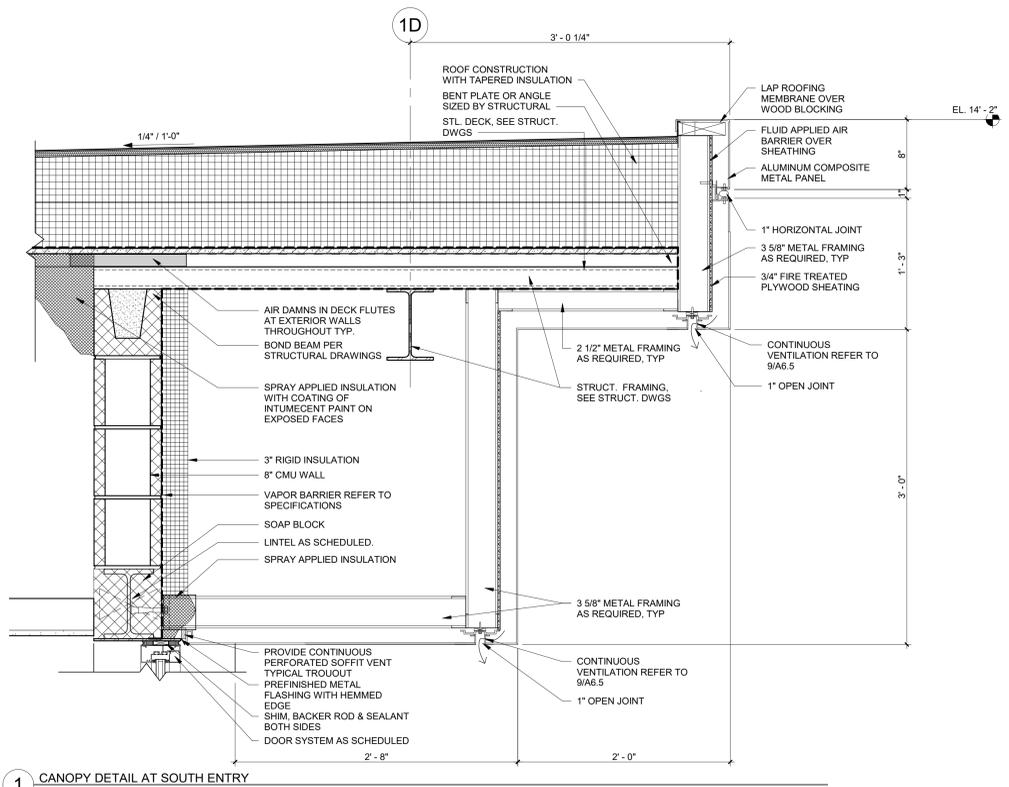


1 CANOPY DETAIL AT SOUTH ENTRY
1 1/2" = 1'-0"

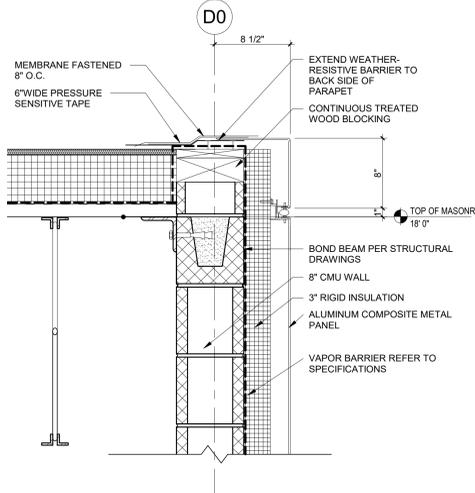


6 COPED EDGE AT ACM PANEL DETAIL
1 1/2" = 1'-0"

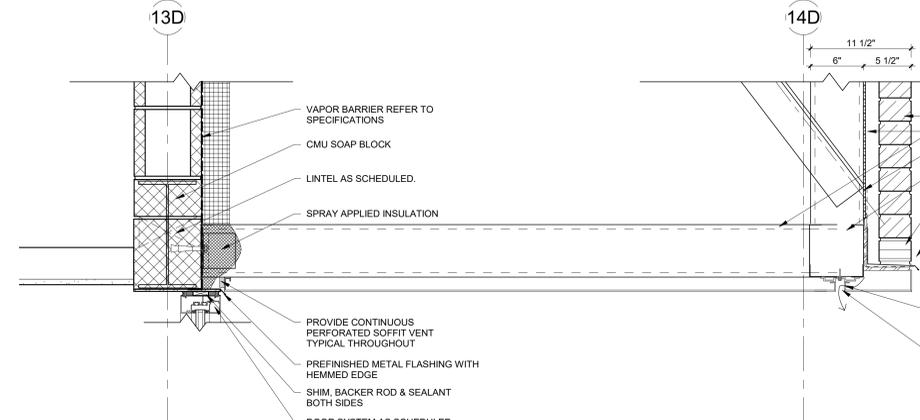


5 ACM SOFFIT AT NORTH ENTRY
1 1/2" = 1'-0"

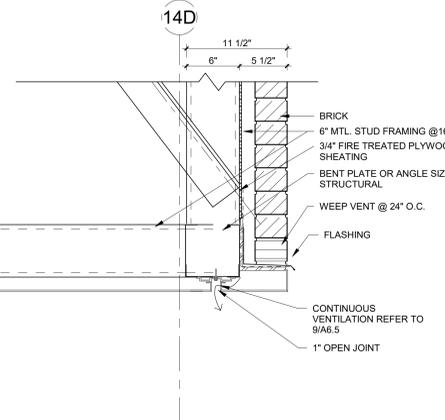


4 TYPICAL LOUVER WINDOW PANEL INFILL
1 1/2" = 1'-0"

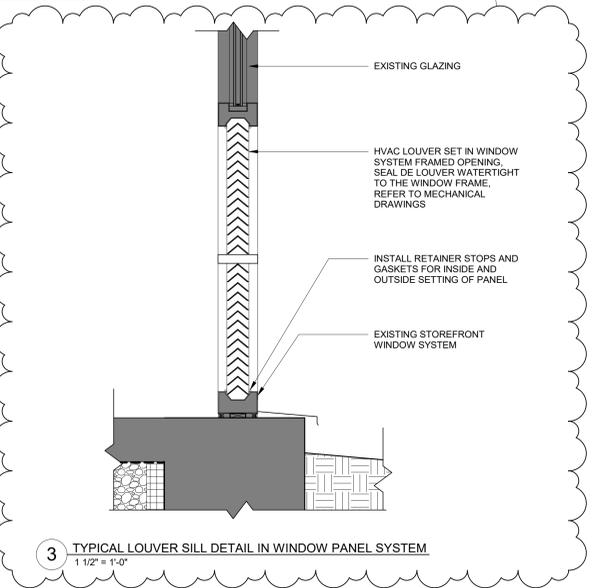


3 TYPICAL LOUVER SILL DETAIL IN WINDOW PANEL SYSTEM
1 1/2" = 1'-0"

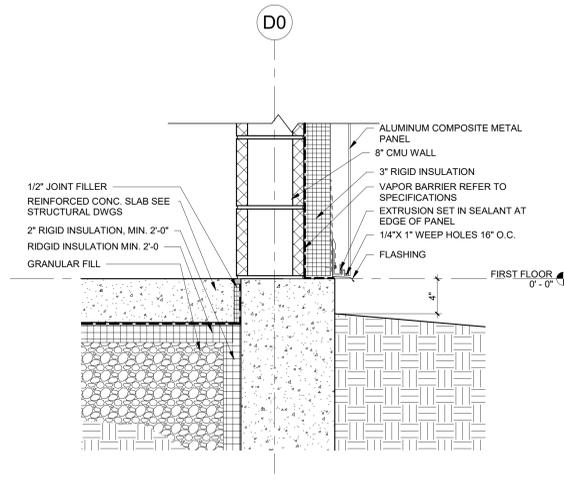


10 BASE AT ACM PANEL DETAIL
1 1/2" = 1'-0"

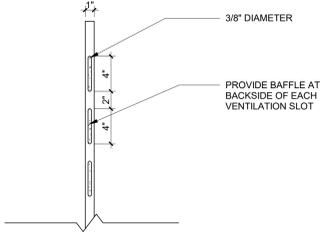


9 ACM PANEL VENTILATION SLOT DETAIL
1 1/2" = 1'-0"

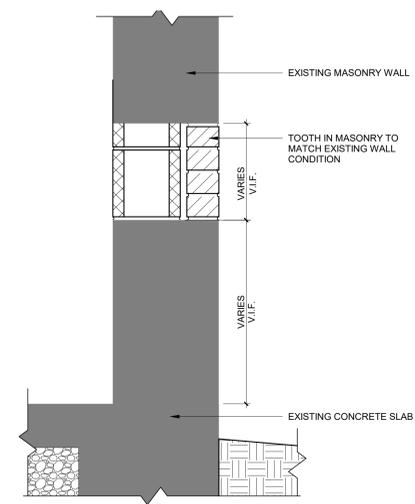


8 TYPICAL LOUVER WALL INFILL DETAIL
1 1/2" = 1'-0"

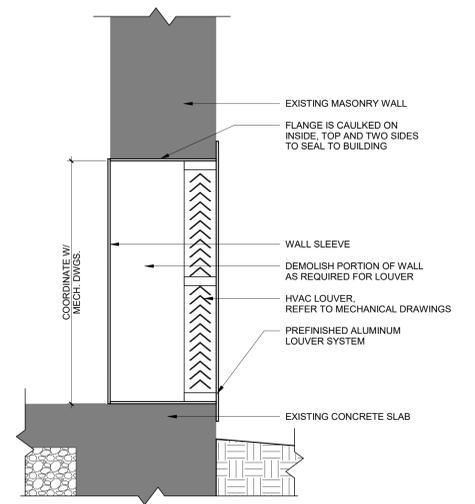


7 TYPICAL LOUVER SILL DETAIL IN EXISTING WALL
1 1/2" = 1'-0"

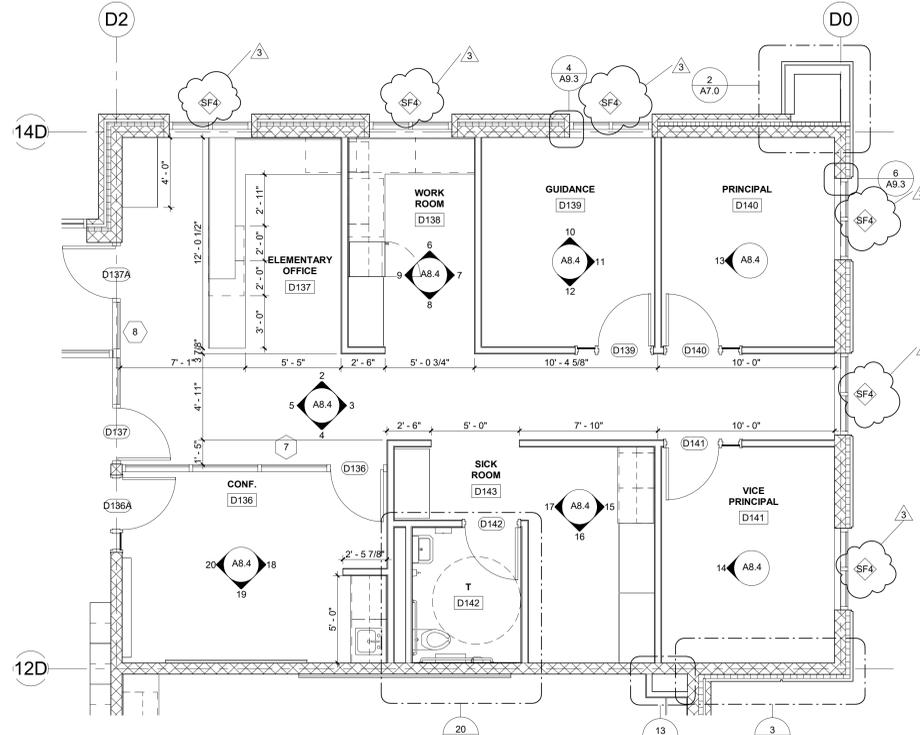


1 ENLARGED PLAN - OFFICE
1/4" = 1'-0"

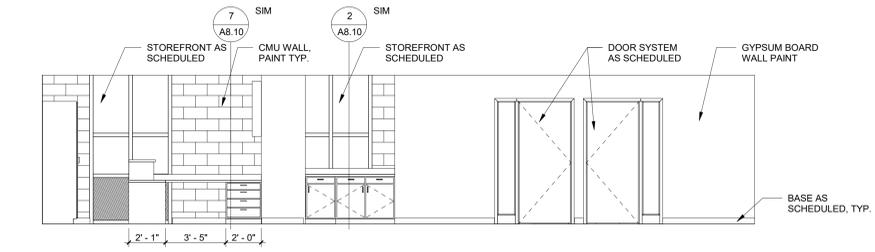


2 NORTH ELEVATION - D137 - OFFICE
1/4" = 1'-0"

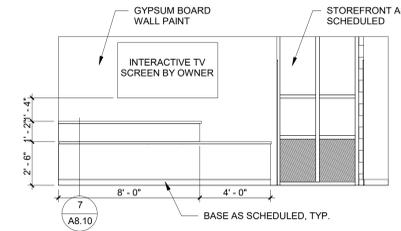


3 EAST ELEVATION - D137 - OFFICE
1/4" = 1'-0"

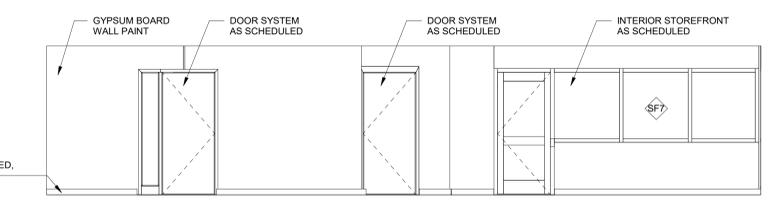


4 SOUTH ELEVATION - D137 - OFFICE
1/4" = 1'-0"

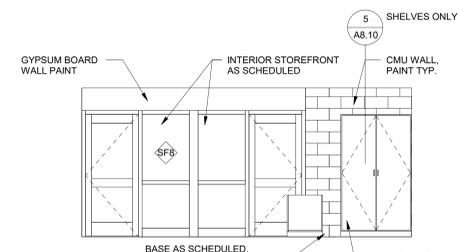


5 WEST ELEVATION - D137 - OFFICE
1/4" = 1'-0"

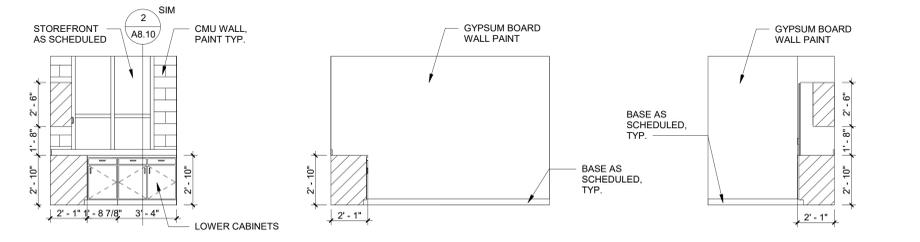


6 NORTH ELEVATION - D138 - WORK
1/4" = 1'-0"

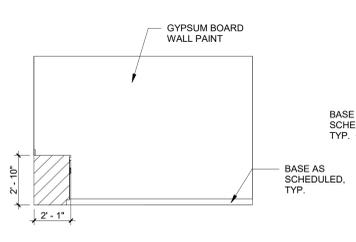


7 EAST ELEVATION - D138 - WORK
1/4" = 1'-0"

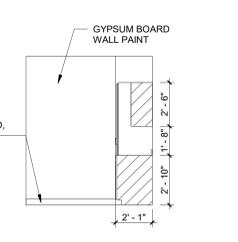


8 SOUTH ELEVATION - D138 - WORK
1/4" = 1'-0"

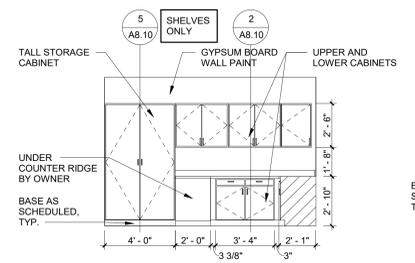


9 WEST ELEVATION - D138 - WORK
1/4" = 1'-0"

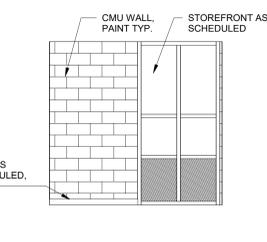


10 NORTH ELEVATION - D139 - GUIDANCE
1/4" = 1'-0"

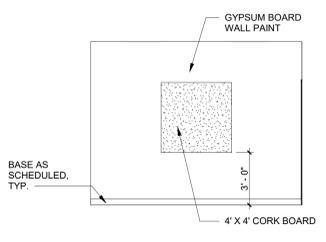


11 EAST ELEVATION - D139 - GUIDANCE
1/4" = 1'-0"

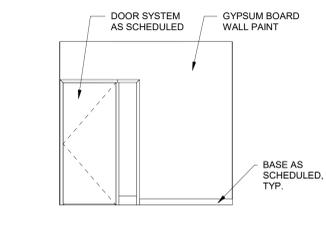


12 SOUTH ELEVATION - D139 - GUIDANCE
1/4" = 1'-0"

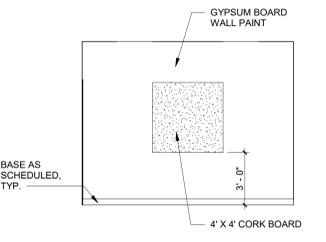


13 WEST ELEVATION - D140 - PRINCIPAL
1/4" = 1'-0"

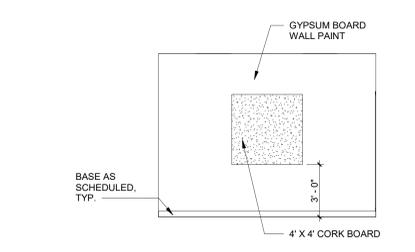


14 WEST ELEVATION - D141 - VICE PRINCIPAL
1/4" = 1'-0"

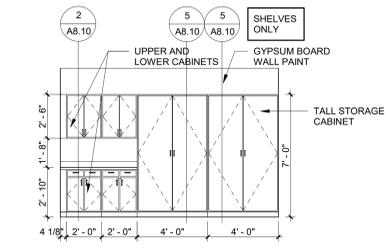


15 EAST ELEVATION - D143 - SICK
1/4" = 1'-0"

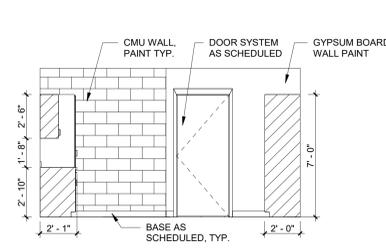


16 SOUTH ELEVATION - D143 - SICK
1/4" = 1'-0"

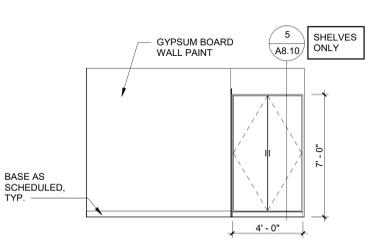


17 WEST ELEVATION - D143 - SICK
1/4" = 1'-0"

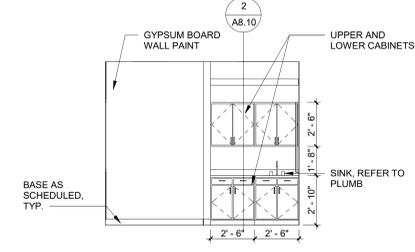

18 EAST ELEVATION - D136 - CONFERENCE
1/4" = 1'-0"

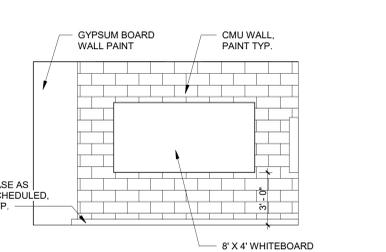


19 SOUTH ELEVATION - D136 - CONFERENCE
1/4" = 1'-0"

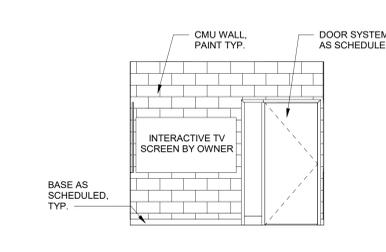


20 WEST ELEVATION - D136 - CONFERENCE
1/4" = 1'-0"

- GENERAL NOTES**
- COORDINATE CASEWORK DIMENSIONS WITH ARCHITECTURAL PLANS. FIELD VERIFY ALL DIMENSIONS PRIOR TO FABRICATION.
 - ALL UPPER CABINETS SHALL MATCH LOWER CABINETS IN WIDTH, U.N.O.
 - ALL EXPOSED SURFACES OF CASEWORK, CABINETRY, SHELVING, END PANELS, HARDWARE AND SUPPORT BRACKETS SHALL BE FINISHED.
 - WHERE CABINETS RUN WALL-TO-WALL, PROVIDE EQUAL FILLER STRIP AT EACH END.
 - COORDINATE MOUNTING DIMENSIONS OF MAGNETIC MARKER BOARDS, GLASS MARKER BOARDS, TACK BOARDS, CLOCKS, SPEAKERS, EQUIPMENT, ETC... WITH OWNER.
 - PROVIDE ALL REQUIRED IN-WALL BLOCKING AND BACKING FOR ALL WALL-MOUNTED CASEWORK, COUNTERTOPS, BACKSPASHES, MAGNETIC MARKER BOARDS, GLASS MARKER BOARDS, CLOCKS, SPEAKERS, EQUIPMENT, ETC...
 - PROVIDE PAINT STRIPING AND LOGOS ON WALLS AS SHOWN IN DOCUMENTS. FINAL ARTWORK / DESIGN SUBJECT TO CHANGE.


COORDINATE FINISHED FACE DIMENSIONS OF STRUCTURAL COLUMNS, SHAFTS, ETC. PROTRUDING FROM WALLS WITH FINAL CASEWORK AND COUNTERTOP LAYOUTS PRIOR TO FABRICATION. IT IS EXPECTED THAT CASEWORK AND COUNTERTOPS MAY NEED TO BE SCRIBED, NOTCHED AND / OR FITTED AROUND THESE PROTRUSIONS IN SOME AREAS. FIELD CUTTING AND PATCHING OF CASEWORK WILL NOT BE ACCEPTED. TYPICAL AT ALL CASEWORK AND COUNTERTOP LOCATIONS.

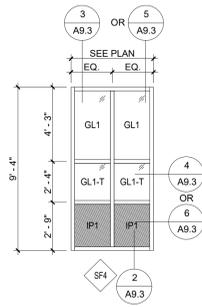


4 SF4 X 10
1/4" = 1'-0"

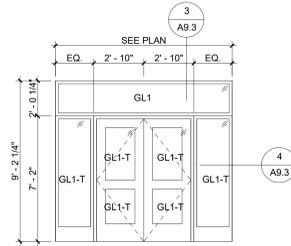

3 SF3 X 2
1/4" = 1'-0"

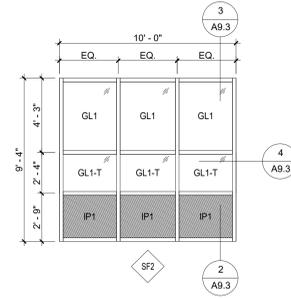

1 SF1 X 1
1/4" = 1'-0"

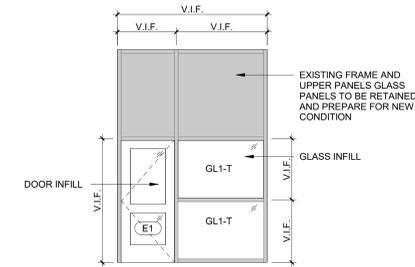

EXTERIOR GLAZING NOTES

1. ALL GLASS BELOW 3'-0" A.F.F. IS TO BE TEMPERED.
2. ALL GLASS ADJACENT TO A DOOR IS TO BE TEMPERED.
3. ALL GLASS WHERE THE BOTTOM EDGE IS LESS THAN 5'-0" ABOVE STAIR LANDINGS IS TO BE TEMPERED.
4. DIMENSIONS ARE APPROXIMATE. FIELD VERIFY ALL DIMENSIONS PRIOR TO FABRICATION. SHOP DRAWINGS DIMENSIONS WILL NOT QUALIFY UNLESS THEY ARE CERTIFIED FIELD DIMENSIONS.
5. COORDINATE LOCATIONS OF SPANDREL GLAZING WITH EXTERIOR ELEVATIONS, SECTIONS AND DETAILS.
6. PROVIDE BACKER ROD AND SEALANT AT ALL FRAMES AS REQUIRED.

GLAZING TYPES LEGEND

REFER TO SPECIFICATION SECTION 088000 FOR FURTHER DETAIL ON GLAZING TYPES AND ASSEMBLIES.

- GL1 INSULATED LOW-E COATED CLEAR VISION GLASS
- GL1-T INSULATED LOW-E COATED CLEAR TEMPERED VISION GLASS
- GL1-S INSULATED LOW-E COATED SPANDREL GLAZING WITH PAINTED GLASS
- IP1 2" INSULATED METAL PANEL REFER TO SPECIFICATIONS
- I-GL1-T NON-INSULATED CLEAR TEMPERED GLAZING


ABBREVIATIONS

- GL1 - GLAZING #
- T - TEMPERED
- S - SPANDREL
- I (PREFIX) - INTERIOR


ALTERNATES KEYNOTES

WORK RELATED WITH THE FOLLOWING ALTERNATES:


- A1 ROOF TOP UNITS IN LIEU OF UNIT VENTILATION AT EXISTING.
- A2 SITE WORK ON WEST SIDE OF THE BUILDING.
- A3 ADDITIONAL PAVEMENT REPLACEMENT.
- A4 TENNIS COURT SURFACE REPLACEMENT.
- A5 SINKS IN ELEMENTARY CLASSROOMS.
- A6 CLERESTORY OMISSION.

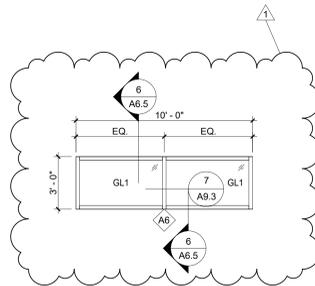


6 SF6 X 2
1/4" = 1'-0"

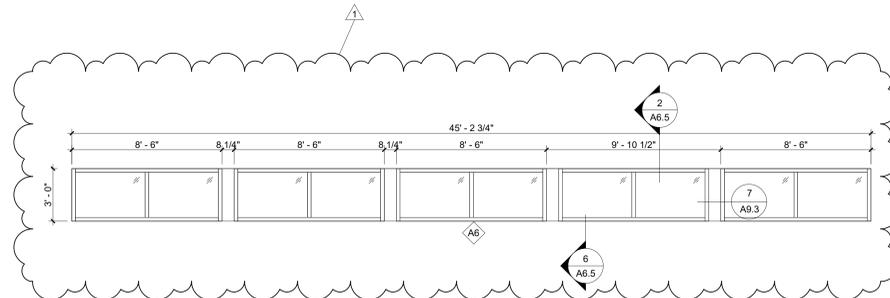


5 SF5 X 1
1/4" = 1'-0"

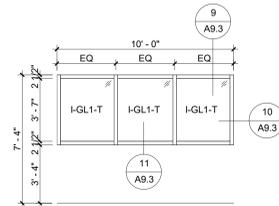


9 SF9 - ART ROOM DISPLAY
1/4" = 1'-0"

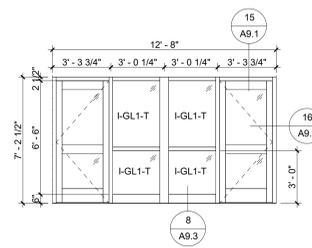


8 SF8 - RECEPTION WEST WALL
1/4" = 1'-0"

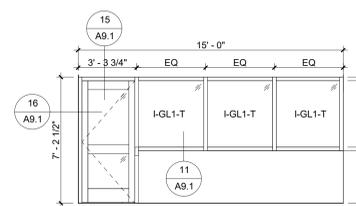

7 SF7 - RECEPTION SOUTH WALL
1/4" = 1'-0"

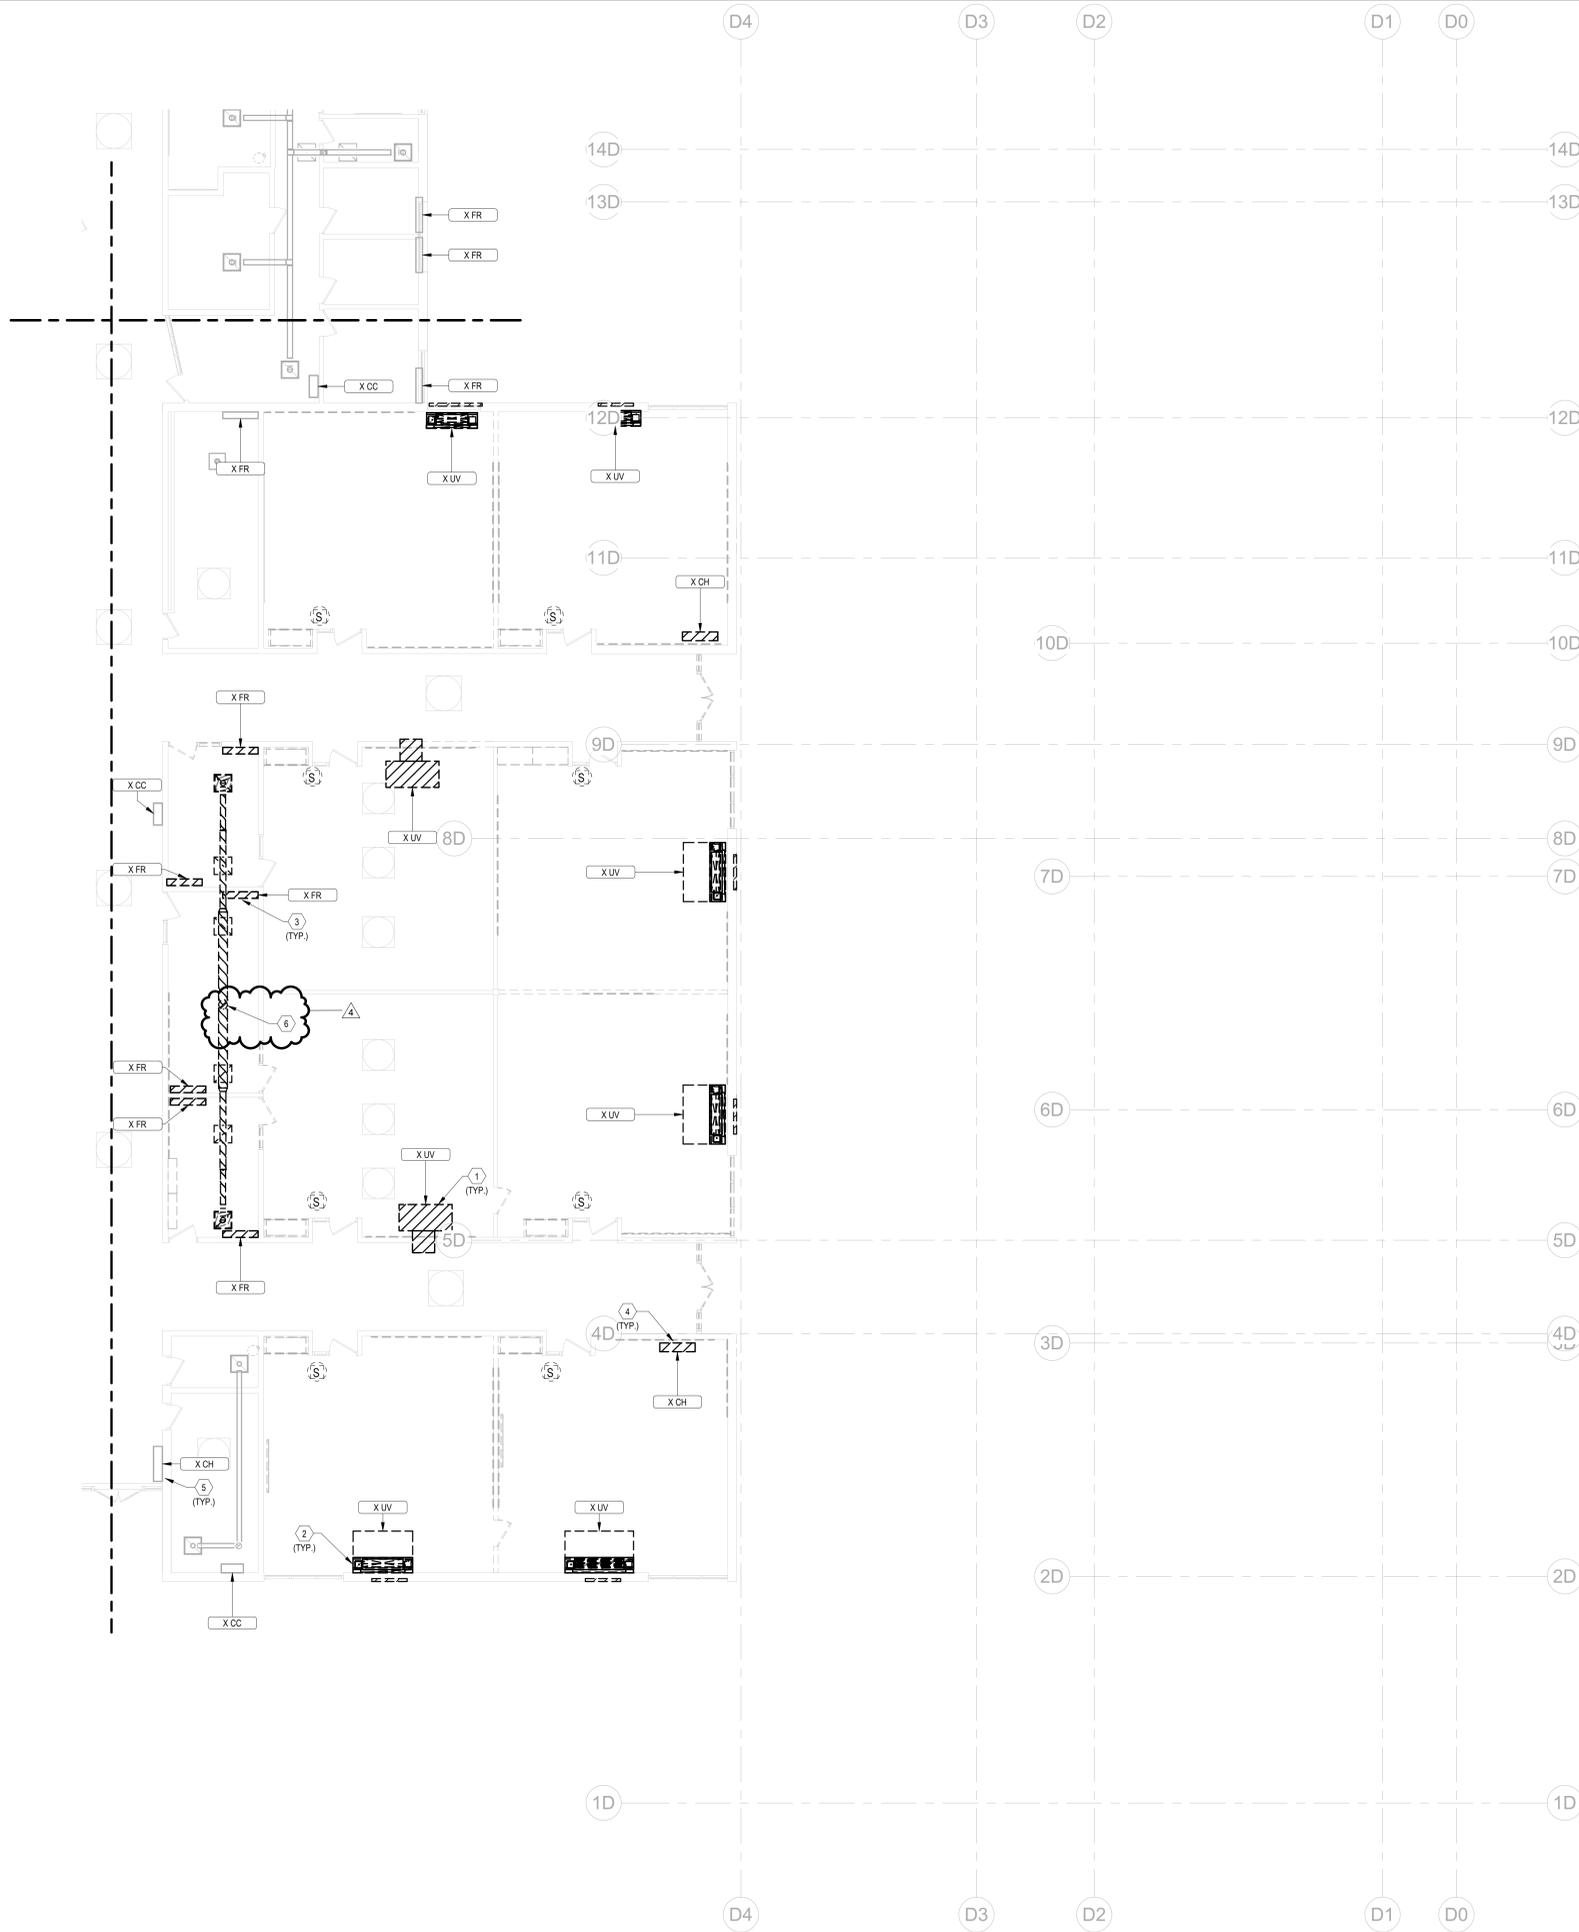


- KEYNOTES**
- 1 DISCONNECT AND REMOVE THE EXISTING CEILING MOUNTED UNIT VENTILATOR (XUV) WITH ITS ASSOCIATED CONTROL AND HANGERS AS REQUIRED.
 - 2 DISCONNECT AND REMOVE THE EXISTING FLOOR MOUNTED UNIT VENTILATOR (XUV) WITH ITS ASSOCIATED WALL BOX/LOUVER AND CONTROL AND HANGERS AS REQUIRED.
 - 3 DISCONNECT AND REMOVE THE EXISTING FIN RADIATOR (XFR) WITH ASSOCIATED CONTROLS.
 - 4 DISCONNECT AND REMOVE THE EXISTING CABINET HEATER (XCH) WITH ASSOCIATED CONTROLS.
 - 5 DISCONNECT AND REMOVE THE EXISTING EXHAUST FAN WITH ASSOCIATED DUCTWORK, HANGERS, AND CONTROLS.
 - 6 DISCONNECT AND REMOVE THE EXISTING EXHAUST FAN WITH ASSOCIATED DUCTWORK, HANGERS, AND CONTROLS.

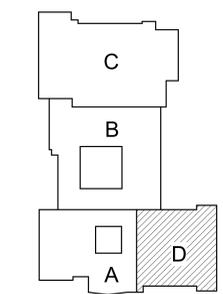

KEY PLAN
NOT TO SCALE


| | |
|-----------------|------------|
| JOB NUMBER | 21-346 |
| DATE | 03.22.2022 |
| REVISIONS: | 04.20.2022 |
| 4. ADDENDUM 004 | |

- KEYNOTES**
- 1 ALTERNATE 1: PACKAGED ROOFTOP UNIT, GAS PIPING, ASSOCIATED DUCTWORK AND CONTROL.
 - 2 ROUTE 1" CONDENSATE DRAIN TO EXTERIOR AND TERMINATE 12" ABOVE GRADE WITH A 90 DEGREE ELBOW.
 - 3 PROVIDE AND INSTALL (2) DIFFUSERS TAG B FOR RELIEF SYSTEM WITH 22x22 N.K.
 - 4 ROUTE 8" DIAMETER UP TO QV-A104
 - 5 ROUTE 1" CONDENSATE LINE TO THE EXTERIOR. TERMINATE 12" ABOVE GRADE WITH A 90 DEGREE ELBOW.
 - 6 EXISTING TO REMAIN
 - 7 PROVIDE FIRE DAMPER WITH ACCESS DOOR.

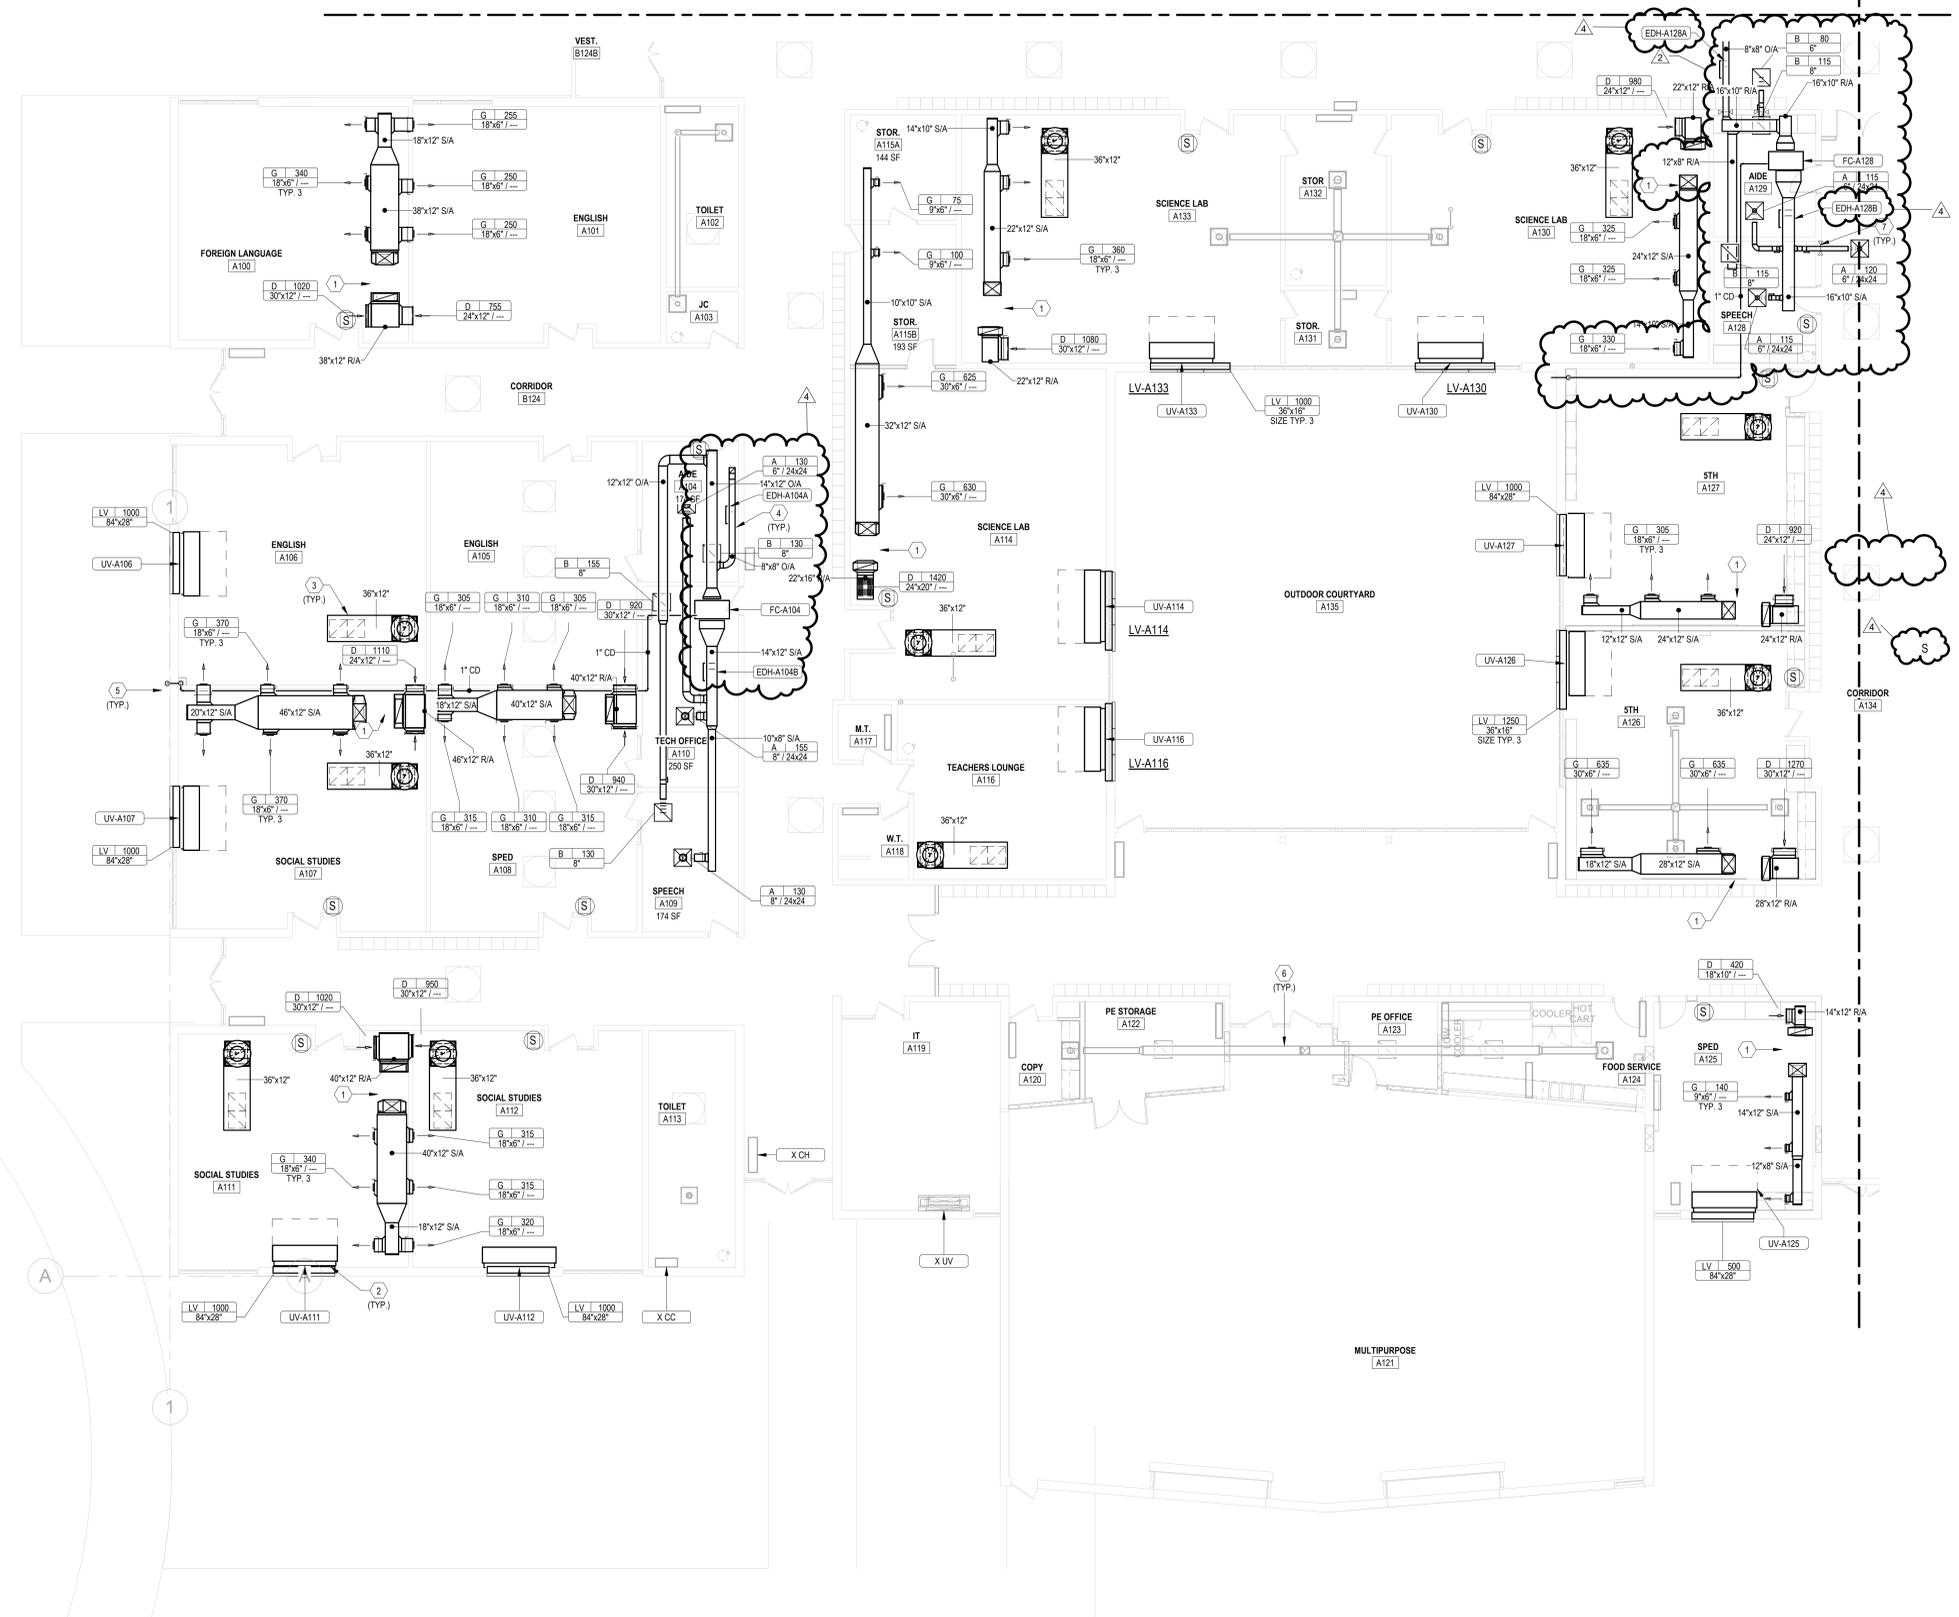


4/19/2022 11:14:02 PM
 COPYRIGHT © 2022. ALL RIGHTS RESERVED

1 PARTIAL ROOF MECHANICAL PLAN - AREA B
 1/8" = 1'-0"

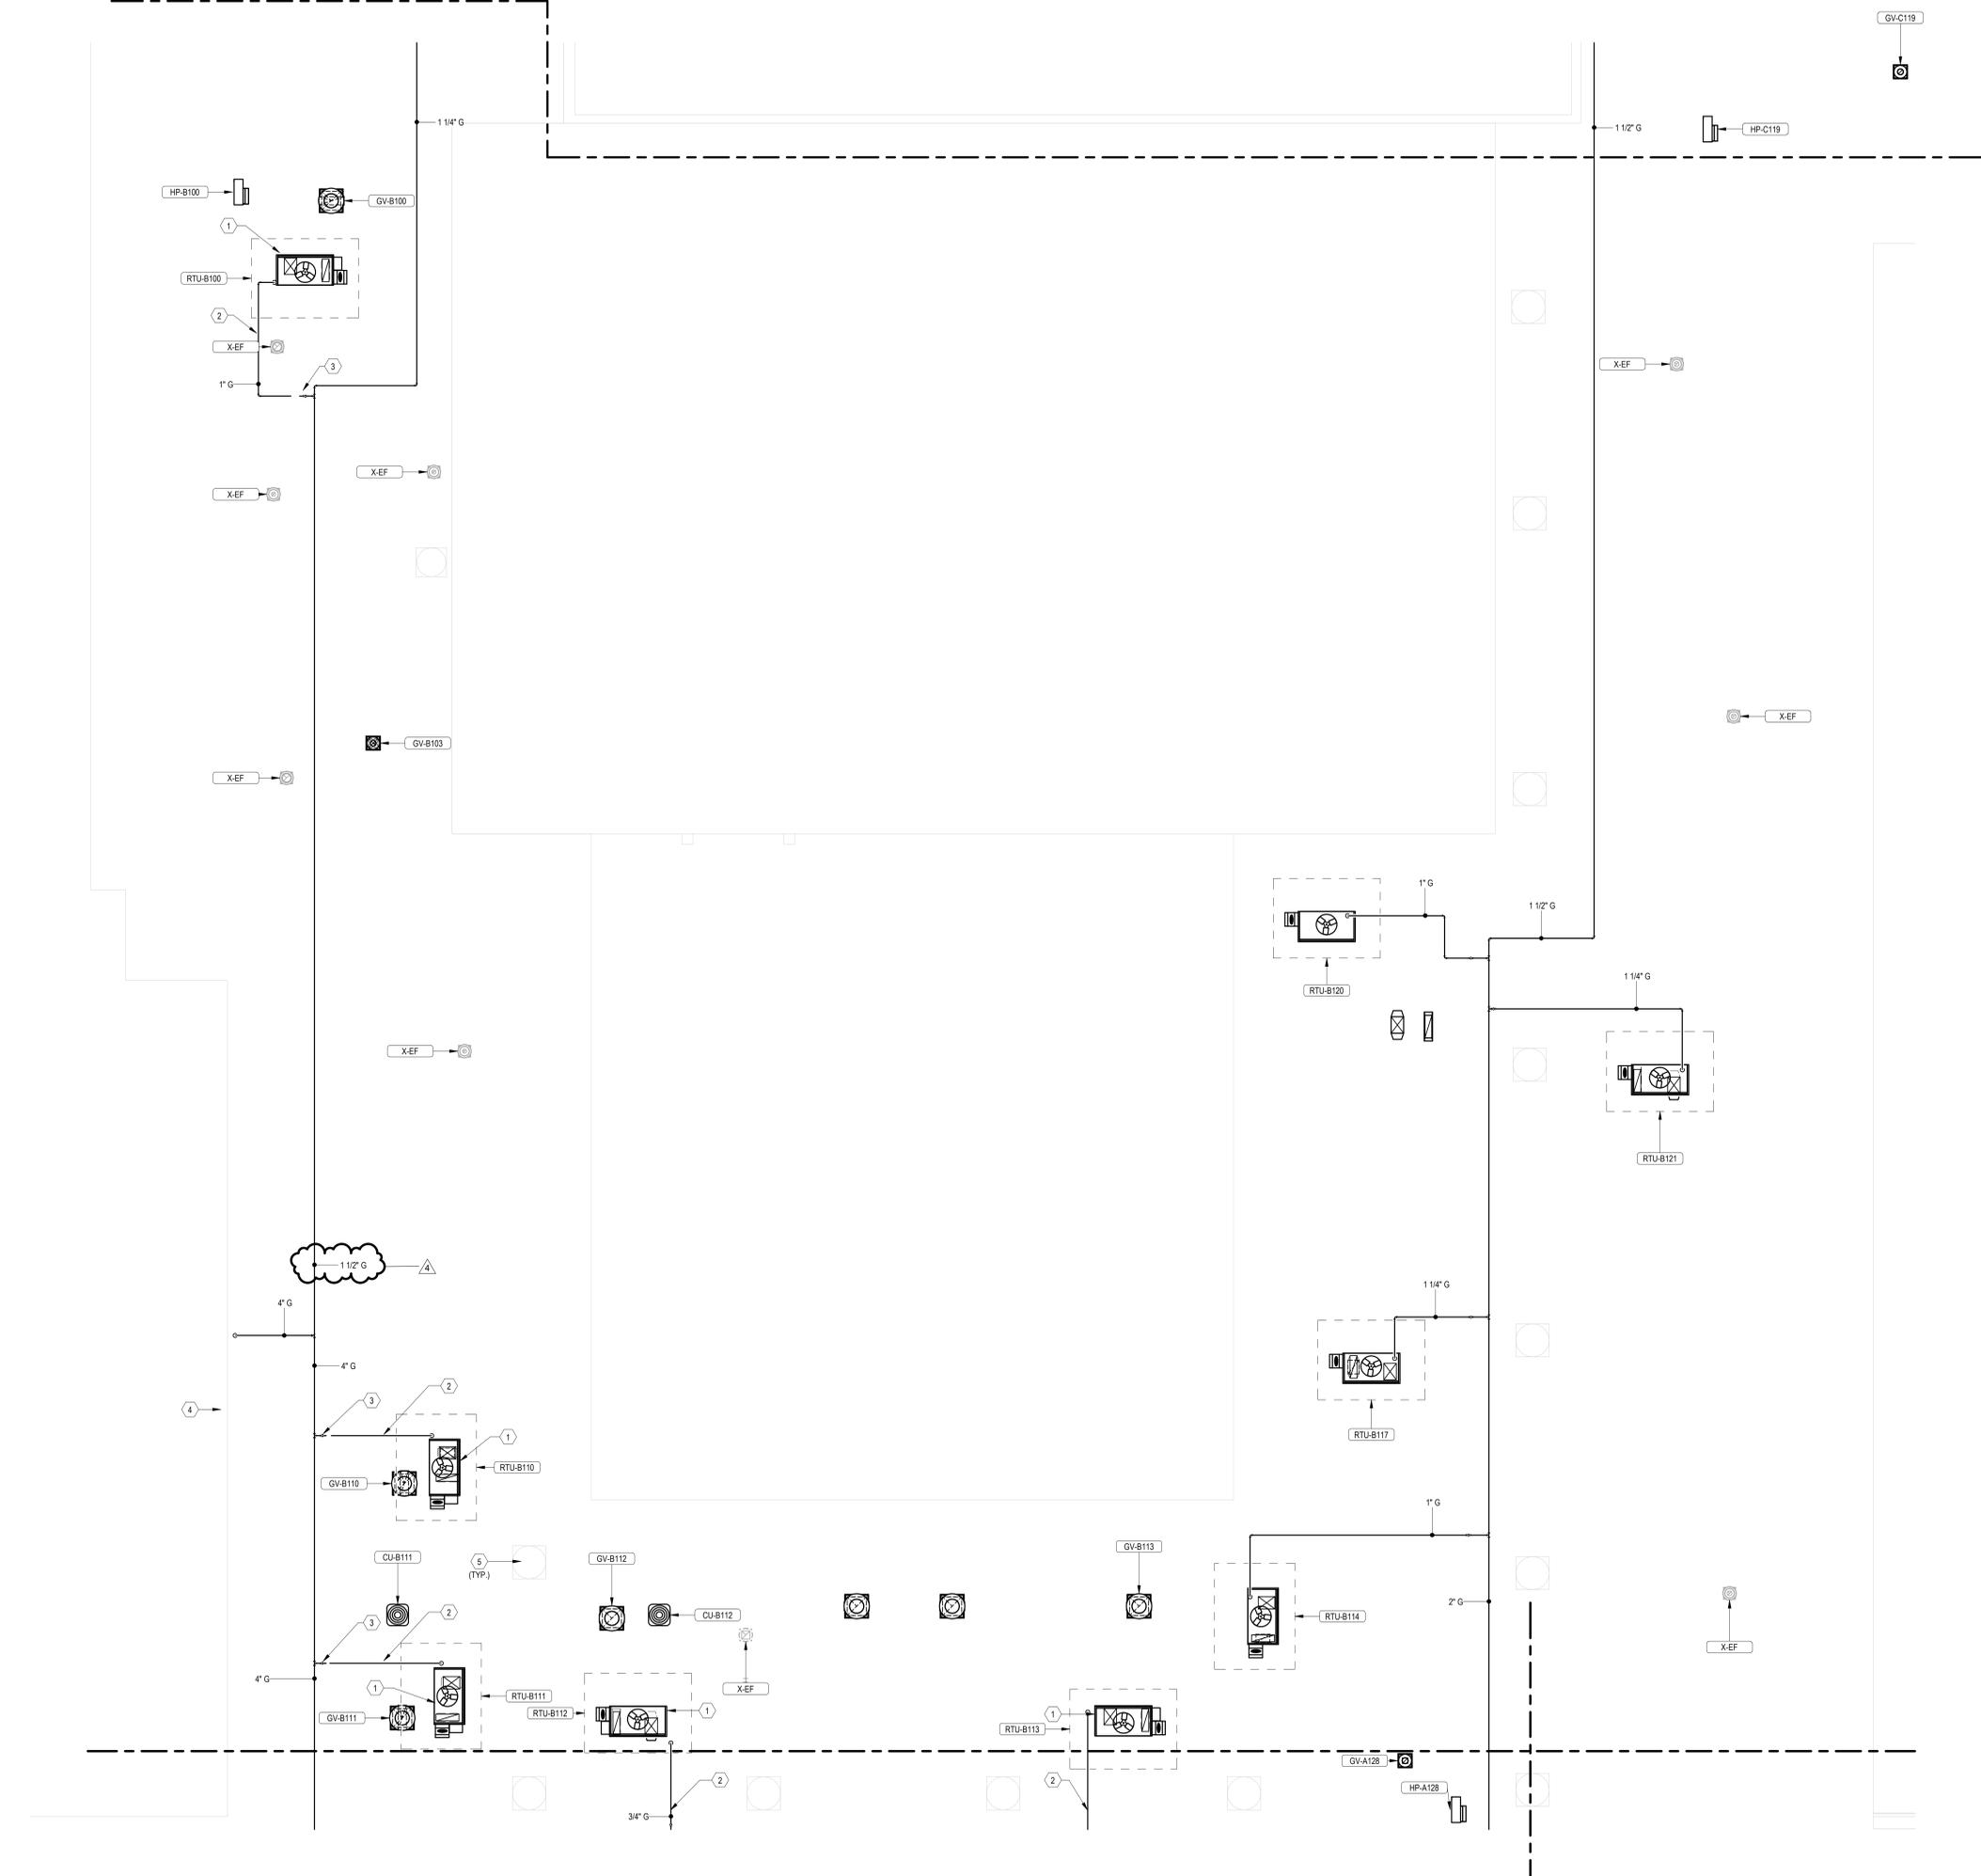

- KEYNOTES**
- 1 ALTERNATE 1: PACKAGED ROOFTOP UNIT, GAS PIPING, ASSOCIATED DUCTWORK, AND CONTROL.
 - 2 ALTERNATE 1: ROOF MOUNTED GAS PIPING TO THE ASSOCIATED ROOFTOP EQUIPMENT.
 - 3 PROVIDE FUTURE 1" GAS CONNECTION WITH SHUT-OFF VALVE AND FLANGE.
 - 4 ROUTE 4" GAS LINE UP FROM GAS METER BELOW.
 - 5 EXISTING TO REMAIN

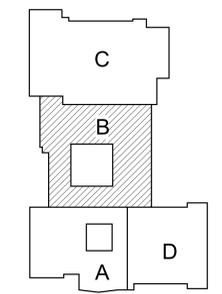

KEY PLAN
 NOT TO SCALE

| TAG | SERVICE | CFM | TYPE | MAX PD (IN) | THROAT | MFR | MODEL |
|----------|------------------|-------|--------|-------------|--------|-------|-------|
| GV-A106 | CLASSROOM A106 | 1,000 | RELIEF | 0.05 | 20X20 | TITUS | PR20 |
| GV-A107 | CLASSROOM A107 | 1,000 | RELIEF | 0.05 | 20X20 | TITUS | PR20 |
| GV-A104 | SPEECH A104 | 160 | INTAKE | 0.05 | 8x8 | TITUS | PR8 |
| GV-A111 | CLASSROOM A111 | 1,000 | RELIEF | 0.05 | 20X20 | TITUS | PR20 |
| GV-A112 | CLASSROOM A112 | 1,000 | RELIEF | 0.05 | 20X20 | TITUS | PR20 |
| GV-A114 | CLASSROOM A114 | 1,250 | RELIEF | 0.05 | 20X20 | TITUS | PR20 |
| GV-A116 | CLASSROOM A116 | 500 | RELIEF | 0.05 | 12x12 | TITUS | PR12 |
| GV-A126 | CLASSROOM A126 | 1,250 | RELIEF | 0.05 | 20X20 | TITUS | PR20 |
| GV-A127 | CLASSROOM A127 | 1,000 | RELIEF | 0.05 | 20X20 | TITUS | PR20 |
| GV-A129 | SPED A125 | 50 | RELIEF | 0.05 | 8x8 | TITUS | PR8 |
| GV-A130 | SCIENCE A130 | 1,000 | RELIEF | 0.05 | 20X20 | TITUS | PR20 |
| GV-A133 | SCIENCE A133 | 1,000 | RELIEF | 0.05 | 20X20 | TITUS | PR20 |
| GV-B103 | FOOD OFFICE B103 | 30 | RELIEF | 0.05 | 8x8 | TITUS | PR8 |
| GV-B110 | SPED B110 | 1,000 | RELIEF | 0.05 | 20X20 | TITUS | PR20 |
| GV-B111 | CLASSROOM B111 | 1,250 | RELIEF | 0.05 | 20X20 | TITUS | PR20 |
| GV-B112A | KITCHEN B112 | 1,500 | INTAKE | 0.05 | 18X16 | TITUS | PR16 |
| GV-B113A | KITCHEN B113 | 1,000 | INTAKE | 0.05 | 20X20 | TITUS | PR20 |
| GV-B112B | KITCHEN B112 | 1,500 | RELIEF | 0.05 | 18X16 | TITUS | PR16 |
| GV-B113B | KITCHEN B113 | 1,000 | RELIEF | 0.05 | 20X20 | TITUS | PR20 |
| GV-C120 | SPED C120 | 1,000 | RELIEF | 0.05 | 20X20 | TITUS | PR20 |
| GV-D107 | AIDE D107 | 50 | INTAKE | 0.05 | 8x8 | TITUS | PR8 |
| GV-D123 | CLASSROOM D123 | 1,250 | RELIEF | 0.05 | 20X20 | TITUS | PR20 |

NOTES:

- ROOF MOUNTED GRAVITY VENT. ALL ALUMINUM. ALUMINUM INSECT SCREEN. HINGED BASE. 30" INSULATED ROOF CURB WITH DAMPER TRAY. PROVIDE RUSKIN TED-50 INSULATED MOTORIZED DAMPER WITH 24V BELMO ACTUATOR WITH FEEDBACK AND SWITCH AND DDC CONTROL INPUTS.

| TAG | SERVICE | KW | MBH | CFM | H.P. | VOLTAGE | AMPS | MFR | MODEL | NOTES |
|----------|-------------------|----|------|-----|------|---------|------|-------|-----------|-------|
| EUH-D122 | VESTIBULE 30 | 4 | 13.6 | 100 | - | 208 / 3 | 11.2 | QMARK | FRC42023F | 1 |
| EUH-D127 | SPRINKLER ROOM 35 | 4 | 13.6 | 100 | - | 208 / 3 | 11.2 | QMARK | FRC42023F | 1 |
| EUH-D128 | TRASH ROOM 36 | 4 | 13.6 | 100 | - | 208 / 3 | 11.2 | QMARK | FRC42023F | 1 |

NOTES:

- WALL MOUNTED ELECTRIC HEATER. 14 GA WHITE SECURITY FRONT COVER. FRAME FOR RECESSED MOUNTING. UNIT MOUNTED THERMOSTAT. AND DISCONNECT.

| TAG | SYSTEM LOCATION | AIR SYSTEM | AIRFLOW (CFM) | QTY. | WIDTH (IN) | HEIGHT (IN) | EX. WIDTH (IN) | EX. HEIGHT (IN) | EXISTING LOUVER LOCATION | P.D. | MFR | MODEL | NOTES |
|---------|---------------------|------------|---------------|------|-------------|-------------|----------------|-----------------|--------------------------|--------|--------|----------|-------|
| UV-A106 | CLASSROOM A106 | INTAKE | 1,000 | 1 | 84 | 28 | 48 | 12 | WALL | 0.011" | RUSKIN | EMES200D | 1 |
| UV-A107 | CLASSROOM A107 | INTAKE | 1,000 | 1 | 84 | 28 | 48 | 12 | WALL | 0.011" | RUSKIN | EMES200D | 1 |
| UV-A111 | CLASSROOM A111 | INTAKE | 1,000 | 1 | 84 | 28 | 48 | 12 | WALL | 0.011" | RUSKIN | EMES200D | 1 |
| UV-A112 | CLASSROOM A112 | INTAKE | 1,000 | 1 | 84 | 28 | 48 | 12 | WALL | 0.011" | RUSKIN | EMES200D | 1 |
| UV-A114 | CLASSROOM A114 | INTAKE | 1,250 | 3 | 36X16 (LOW) | | 72 | 16 | WINDOW | 0.011" | RUSKIN | EMES200D | 2 |
| UV-A116 | TEACHER LOUNGE A116 | INTAKE | 500 | 3 | 36X16 (LOW) | | 21 | 12 | WALL | 0.011" | RUSKIN | EMES200D | 2 |
| UV-A126 | SPED A125 | INTAKE | 500 | 3 | 36X16 (LOW) | | 72 | 16 | WINDOW | 0.011" | RUSKIN | EMES200D | 2 |
| UV-A128 | CLASSROOM A126 | INTAKE | 1,250 | 1 | 72 | 33 | N/A | N/A | N/A | 0.011" | RUSKIN | EMES200D | 1 |
| UV-A127 | CLASSROOM A127 | INTAKE | 1,000 | 3 | 36X16 (LOW) | | 36 | 16 | WINDOW | 0.011" | RUSKIN | EMES200D | 2 |
| UV-A130 | SCIENCE A130 | INTAKE | 1,000 | 3 | 36X16 (LOW) | | 72 | 16 | WINDOW | 0.011" | RUSKIN | EMES200D | 2 |
| UV-A133 | SCIENCE A133 | INTAKE | 1,000 | 3 | 36X16 (LOW) | | 72 | 16 | WINDOW | 0.011" | RUSKIN | EMES200D | 2 |
| UV-B100 | BUSINESS B100 | INTAKE | 1,000 | 3 | 36X16 (LOW) | | 72 | 16 | WINDOW | 0.011" | RUSKIN | EMES200D | 2 |
| UV-B110 | SPED B110 | INTAKE | 1,000 | 3 | 36X16 (LOW) | | 32 | 16 | WINDOW | 0.011" | RUSKIN | EMES200D | 2 |
| UV-B111 | CLASSROOM B111 | INTAKE | 1,250 | 3 | 36X16 (LOW) | | 68 | 16 | WINDOW | 0.011" | RUSKIN | EMES200D | 2 |
| UV-C120 | SPED C120 | INTAKE | 1,000 | 3 | 36X16 (LOW) | | 62 | 16 | WINDOW | 0.011" | RUSKIN | EMES200D | 2 |
| UV-C122 | STORAGE ROOM C122 | INTAKE | 400 | 1 | 72 | 33 | 16 | 12 | WALL | 0.011" | RUSKIN | EMES200D | 1 |
| UV-D121 | SPED / AIDE D102 | INTAKE | 500 | 1 | 72 | 33 | 48 | 12 | WALL | 0.011" | RUSKIN | EMES200D | 1 |
| UV-D123 | CLASSROOM D123 | INTAKE | 1,250 | 1 | 84 | 28 | 48 | 12 | WALL | 0.011" | RUSKIN | EMES200D | 1 |

NOTES:

- EQUIPMENT MANUFACTURE PROVIDED FLANGED LOUVER WITH WALL BOX, BIRD SCREEN, AND ALUMINUM CONSTRUCTION.
- PROVIDED LOUVER INSTALLED IN WINDOW OPENING WITH A FIELD MANUFACTURES CUSTOM WALL BOX INCLUDING A DIVING PANEL TO SEPERTAE THE AIR PAHTS TO THE UNIT. BIRD SCREEN, AND ALUMINUM CONSTRUCTION. COORDINATE WITH THE SUBMITTED EQUIPMENT MANUFACTURE AND EXISTING WINDOW MANUFACTURE FOR A COMPLETE SYSTEM. PROVIDE AN INSULATED BLANK-OFF PANEL AS REQUIRED TO INSTALL EQUIPMENT PER MANUFACTURES RECOMMENDATIONS.

| TAG | SERVICE | COOL MBH | CFM | SEER | INDOOR MCA / MOCP | OUTDOOR MCA / MOCP | OUTDOOR VOLTAGE | AMBIENT TEMP | MFR | OA (CFM) | INDOOR MODEL | OUTDOOR MODEL | ACCESSORIES | NOTES |
|-------------------|--------------------------|----------|-----|------|-------------------|--------------------|-----------------|--------------|------------|----------|---------------|---------------|-------------|-------|
| FC-B103 / HP-B103 | FOOD SERVICE OFFICE B103 | 12 | 425 | 18.5 | 1 / 15 | 14 / 24 | 208/1 | -13 / 115 | MITSUBISHI | 20 | NTXSKS09A12AA | NTXSKH0912AA | WIND BAFFLE | 1 |

NOTES:

- PROVIDE BACNET INTERFACE AND SIMPLE MA CONTROLLER. MOUNT OUTDOOR UNIT TO EXTERIOR WALL. ORIENT CONDENSER FAN DISCHARGE AWAY FROM PREVAILING WIND. ROUTE REFRIGERANT PIPING BETWEEN INDOOR AND OUTDOOR UNIT PER MFR'S REQUIREMENTS. INTERIOR REF PIPING TO BE CONCEALED. PROVIDE LINE HIDE FOR EXTERIOR REF PIPING. PROVIDE BLUE DIAMOND MINI CONDENSATE PUMP. ROUTE CONDENSATE TO NEAREST DRAIN U.N.O.

| TAG | SERVICE | CFM | EAT | LAT | KW | VOLTAGE | MFR | MODEL | NOTES |
|-----------|---------|-----|-----|-----|----|---------|-----------|-------|-------|
| EDH-A104A | FC-A104 | 160 | -10 | 50 | 3 | 208 / 1 | THERMOLEC | TER | 1 |
| EDH-A104B | FC-A104 | 405 | 55 | 75 | 3 | 208 / 1 | THERMOLEC | TER | 1 |
| EDH-A128A | FC-A128 | 160 | -10 | 50 | 3 | 208 / 1 | THERMOLEC | TER | 1 |
| EDH-A128B | FC-A128 | 405 | 55 | 75 | 3 | 208 / 1 | THERMOLEC | TER | 1 |

NOTES:

- VERTICAL AIR FLOW ELECTRIC DUCT HEATER WITH DISCHARGE AIR TEMPERATURE SENSOR. OUTSIDE AIR TEMPERATURE SENSOR. SCR CONTROLLER. AND BUILT-IN DISCONNECT SWITCH. CONTROLLER SHALL MAINTAIN A DISCHARGE AIR TEMPERATURE OF 45. WHEN THE OUTSIDE AIR TEMPERATURE DROPS BELOW 30.

| DUCT TYPE | INSULATION TYPE | R-VALUE |
|----------------------------------|-----------------------|---------|
| ROUND SUPPLY | 2-1/2" WRAP | 8 |
| ROUND SUPPLY (GYM) | 1-1/2" LINER | 6 |
| RECTANGULAR SUPPLY | 1-1/2" LINER | 6 |
| ROUND RETURN | 1-1/2" LINER | 6 |
| OUTSIDE AIR | 3" WRAP | 8 |
| DOUBLE WALL RECTANGULAR DUCTWORK | PERFORATED LINER | 6 |
| DOUBLE WALL ROUND DUCTWORK | PERFORATED LINER | 6 |
| EXTERIOR DUCT | DOUBLE WALL + POLYISO | 12 |
| EXHAUST DUCT | NONE | NA |

NOTE: INSULATION SHALL HAVE A FLAME SPREAD INDEX NOT MORE THAN 25 AND A SMOKE-DEVELOPED INDEX NOT MORE THAN 50 WHEN TESTED IN ACCORDANCE WITH ASTM E 84 OR UL 723. WRAP INSULATION TO HAVE INTEGRAL VAPOR BARRIER.

NOTE: DUCT SIZES SHOWN ON PLAN ARE SHEETMETAL SIZES U.N.O. REFER TO PLANS FOR AREAS WITH SPECIAL REQUIREMENTS. SUCH AS DOUBLE WALL DUCT.

NOTE: DOUBLE WALL DUCT SIZES SHOWN ON PLAN ARE INSIDE SHEETMETAL DIMENSION.

WRAP FIRST 5' OF EXHAUST DUCT FROM EXTERIOR WITH 1" INSULATION.

| TAG | NOMINAL CAPACITIES | DESIGN CAPACITIES | ELECTRICAL | WEIGHT (LBS.) | MODEL NUMBER | MFR. | ACCESSORIES | NOTES |
|---------|------------------------------------|---|-------------------------|---------------|--------------|---------------|------------------------|-------|
| HP-A104 | COOLING (MBH) 12, HEATING (MBH) 18 | COOLING O.A. (BTU) 95, HEATING O.A. (BTU) 5 | 12.0, 15.0, 208 / 1, 14 | 30 | 150 | NTXSKH12A12AA | MITSUBISHI WIND BAFFLE | 1 |
| HP-C119 | COOLING (MBH) 12, HEATING (MBH) 18 | COOLING O.A. (BTU) 95, HEATING O.A. (BTU) 5 | 12.0, 15.0, 208 / 1, 14 | 30 | 150 | NTXSKH12A12AA | MITSUBISHI WIND BAFFLE | 1 |
| HP-A128 | COOLING (MBH) 12, HEATING (MBH) 18 | COOLING O.A. (BTU) 95, HEATING O.A. (BTU) 5 | 12.0, 15.0, 208 / 1, 14 | 30 | 150 | NTXSKH12A12AA | MITSUBISHI WIND BAFFLE | 1 |

NOTES:

- PROVIDE OUTDOOR HEAT PUMP WITH WIND BAFFLE. 14" EQUIPMENT RAILS, AND DISCONNECT. ORIENT CONDENSER FAN DISCHARGE AWAY FROM PREVAILING WIND.



| TAG | SERVICE | NOM. TONS | REF. TYPE | QTY | CIRCUITS | STAGES | VOLT. | MCA | MOCP | SEER | MFR. | MODEL | NOTES |
|---------|--------------|-----------|-----------|-----|----------|--------|---------|------|------|------|--------|------------|-------|
| CU-B112 | KITCHEN B112 | 4 | R-410A | 1 | 1 | 2 | 208 / 1 | 19.7 | 30 | 16 | DAIKIN | DX18TC0481 | 1 |
| CU-B113 | KITCHEN B113 | 3 | R-410A | 1 | 1 | 2 | 208 / 1 | 19.7 | 30 | 16 | DAIKIN | DX18TC0361 | 1 |

NOTES:

- TWO STAGE AIR COOLED CONDENSING UNIT WITH SCROLL COMPRESSOR. COMPRESSOR SHORT CYCLE PROTECTION. COMPRESSOR START ASSIST. UNIT MOUNTED DISCONNECT. AND REFRIGERANT PIPING AS REQUIRED PER MANUFACTURE RECOMMENDATION.

| TAG | SERVICE | TOT CFM | E.S.P. | HP | TOT / SENS MBH | EAT DB / WB | LAT DB / WB | # COMP / STAGES | REHEAT | HEATING | ELECTRICAL | OA CFM | EER | WEIGHT (LBS.) | MFR. | MODEL | NOTES | | | | |
|----------|----------------------------|---------|--------|----|----------------|---------------|---------------|-----------------|------------|-------------|------------|--------|---------|---------------|------|-------|-------|-------|------|-----------------|-----------------|
| RTU-A101 | CLASSROOM A100 / A101 | 1,775 | 0.5 | 2 | 71.8 / 51.3 | 82.9 / 68.3 | 57.1 / 55.4 | MOD | 75 / 60.62 | 140 / 113.4 | 91.5 | MOD | 460 / 3 | 21 | 30 | 880 | 11.2 | 1,600 | AAON | RQ-006-3-V-FA09 | 1, 2, 4, 5 & 6 |
| RTU-A108 | CLASSROOM A105 / A108 | 1,860 | 0.5 | 2 | 59.6 / 46.0 | 78.6 / 64.9 | 57.0 / 54.6 | MOD | 75 / 61.98 | 100 / 81 | 92.3 | MOD | 460 / 3 | 19 | 25 | 815 | 13.2 | 1,700 | AAON | RQ-005-3-V-FA09 | 1, 2, 4, 5 & 6 |
| RTU-B114 | MATH B114 | 1,045 | 0.5 | 1 | 41.69 / 29.84 | 82.04 / 67.6 | 56.18 / 54.72 | MOD | 75 / 60.9 | 100 / 81 | 106 | MOD | 460 / 3 | 15 | 20 | 460 | 13.5 | 1,500 | AAON | RN-008-3-E-FA09 | 1, 3, 4, 5, & 6 |
| RTU-B117 | MATH B117 | 2,130 | 0.8 | 2 | 92.4 / 63.4 | 82.3 / 67.9 | 54.9 / 53.5 | MOD | 75 / 61.1 | 150 / 120 | 93.9 | MOD | 460 / 3 | 23 | 35 | 760 | 11.5 | 1,900 | AAON | RN-008-3-E-FA09 | 1, 3, 4, 5, & 6 |
| RTU-B120 | SPED B119 / B120 | 1,140 | 0.5 | 1 | 41.3 / 30.6 | 80.8 / 66.7 | 56.2 / 54.6 | MOD | 75 / 61.1 | 100 / 81 | 108 | MOD | 460 / 3 | 15 | 20 | 400 | 13.5 | 1,500 | AAON | RQ-003-3-V-FA09 | 1, 3, 4, 5, & 6 |
| RTU-B121 | ART B121 | 2,060 | 0.5 | 1 | 58.14 / 38.32 | 84.38 / 69.41 | 56.33 / 54.60 | MOD | 75 / 61.66 | 140 / 113.4 | 103.5 | MOD | 460 / 3 | 19 | 25 | 620 | 11.6 | 1,700 | AAON | RQ-005-3-V-FA09 | 1, 2, 4, 5 & 6 |
| RTU-C100 | MEDIA CENTER C100 | 3,835 | 0.75 | 2 | 116.86 / 83.13 | 81.9 / 67.5 | 57.6 / 55.5 | MOD | 75 / 61.9 | 292.5 / 234 | 102.3 | MOD | 460 / 3 | 27 | 30 | 1,400 | 11.2 | 2,400 | AAON | RN-611-3-S-FA09 | 1, 2, 4, 5 & 6 |
| RTU-C114 | BAND C114 | 2,610 | 0.5 | 2 | 92.9 / 63.9 | 82.3 / 67.8 | 55.4 / 53.7 | MOD | 75 / 61.2 | 210 / 168 | 105.4 | MOD | 460 / 3 | 23 | 35 | 1,000 | 11.5 | 1,900 | AAON | RN-008-3-E-FA09 | 1, 2, 4, 5 & 6 |
| RTU-C115 | CHORR C115 | 2,130 | 0.5 | 2 | 72.8 / 52.96 | 83.1 / 68.5 | 58.1 / 56.3 | MOD | 75 / 62.5 | 160 / 129.6 | 93.4 | MOD | 460 / 3 | 21 | 30 | 950 | 11.6 | 1,600 | AAON | RN-006-3-E-FA09 | 1, 2, 4, 5 & 6 |
| RTU-D102 | CLASSROOM D101 / D102 | 1,330 | 0.5 | 1 | 49.9 / 36.4 | 81.1 / 66.9 | 56.6 / 54.8 | MOD | 75 / 61.55 | 100 / 81 | 95.7 | MOD | 460 / 3 | 18 | 25 | 650 | 13.55 | 1,600 | AAON | RQ-004-3-V-FA09 | 1, 2, 4, 5 & 6 |
| RTU-D103 | CLASSROOM D103 | 1,500 | 0.5 | 1 | 55.5 / 42.1 | 81.9 / 67.6 | 56.9 / 55.8 | MOD | 75 / 62.1 | 140 / 113.4 | 105.4 | MOD | 460 / 3 | 18 | 25 | 525 | 13.3 | 1,500 | AAON | RQ-004-3-V-FA09 | 1, 2, 4, 5 & 6 |
| RTU-D110 | ART D109 / MEDIA D110 | 1,860 | 0.5 | 2 | 67.7 / 49.4 | 80.8 / 66.7 | 57.4 / 55.1 | MOD | 75 / 62.2 | 140 / 113.4 | 97.2 | MOD | 460 / 3 | 21 | 30 | 680 | 13.2 | 1,600 | AAON | RQ-006-3-V-FA09 | 1, 2, 4, 5 & 6 |
| RTU-D115 | CLASSROOM D115 | 1,835 | 0.5 | 1 | 53.7 / 42.1 | 80.8 / 66.7 | 58.1 / 56.3 | MOD | 75 / 62.1 | 100 / 81 | 99.1 | MOD | 460 / 3 | 15 | 20 | 500 | 13.5 | 1,500 | AAON | RQ-004-3-V-FA09 | 1, 2, 4, 5 & 6 |
| RTU-D117 | CLASSROOM D117, D111, D112 | 1,170 | 0.5 | 1 | 50.6 / 34.9 | 84.3 / 69.3 | 57.1 / 55.6 | MOD | 75 / 62.02 | 140 / 113.4 | 113.2 | MOD | 460 / 3 | 17 | 25 | 720 | 12.9 | 1,600 | AAON | RQ-004-3-V-FA09 | 1, 2, 4, 5 & 6 |
| RTU-D126 | CLASSROOM D126 | 1,795 | 0.75 | 2 | 60.5 / 45.8 | 80.8 / 66.7 | 57.9 / 55.5 | MOD | 75 / 62.5 | 140 / 113.4 | 105.8 | MOD | 460 / 3 | 17 | 25 | 590 | 13.3 | 1,500 | AAON | RQ-005-3-V-FA09 | 1, 2, 4, 5 & 6 |
| RTU-D130 | CLASSROOM D130 / D131 | 1,650 | 0.75 | 2 | 72.1 / 49.9 | 84.5 / 69.5 | 57.5 / 55.8 | MOD | 75 / 62.3 | 160 / 129.6 | 95.2 | MOD | 460 / 3 | 21 | 30 | 980 | 11.6 | 1,600 | AAON | RQ-006-3-V-FA09 | 1, 2, 4, 5 & 6 |
| RTU-D132 | CLASSROOM D132 / D133 | 1,470 | 0.75 | 2 | 64.2 / 44.7 | 83.7 / 68.9 | 56.5 / 55 | MOD | 75 / 61.9 | 140 / 113.4 | 97.9 | MOD | 460 / 3 | 19 | 25 | 800 | 12.4 | 1,600 | AAON | RQ-005-3-V-FA09 | 1, 2, 4, 5 & 6 |
| RTU-D134 | CLASSROOM D134 / D135 | 1,470 | 0.75 | 2 | 64.2 / 44.7 | 83.7 / 68.9 | 56.5 / 55 | MOD | 75 / 61.9 | 140 / 113.4 | 97.9 | MOD | 460 / 3 | 19 | 25 | 800 | 12.4 | 1,600 | AAON | RQ-005-3-V-FA09 | 1, 2, 4, 5 & 6 |
| RTU-D137 | OFFICE AREA D137 | 1,400 | 0.8 | 1 | 48.6 / 36.8 | 78.4 / 64.8 | | | | | | | | | | | | | | | |


- KEYNOTES**
- 1 ROUTE 3/4" CW LINE UP TO RH-1. ROUTE 1" DRAIN TO NEAREST MOP BASIN AS REQUIRED.
 - 2 ALTERNATE 5" PLUMBING SERVICES SUPPORTING SINKS WITHIN THE CLASSROOM SHALL BE INCLUDED IN THE ALTERNATE.
 - 3 ROUTE COLD WATER, HOT WATER, AND HOT WATER RETURN PIPING WITHIN SOFFIT.
 - 4 ROUTE COLD WATER PIPING WITHIN SOFFIT.

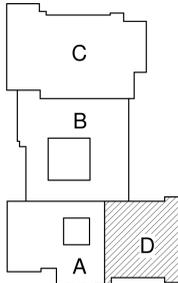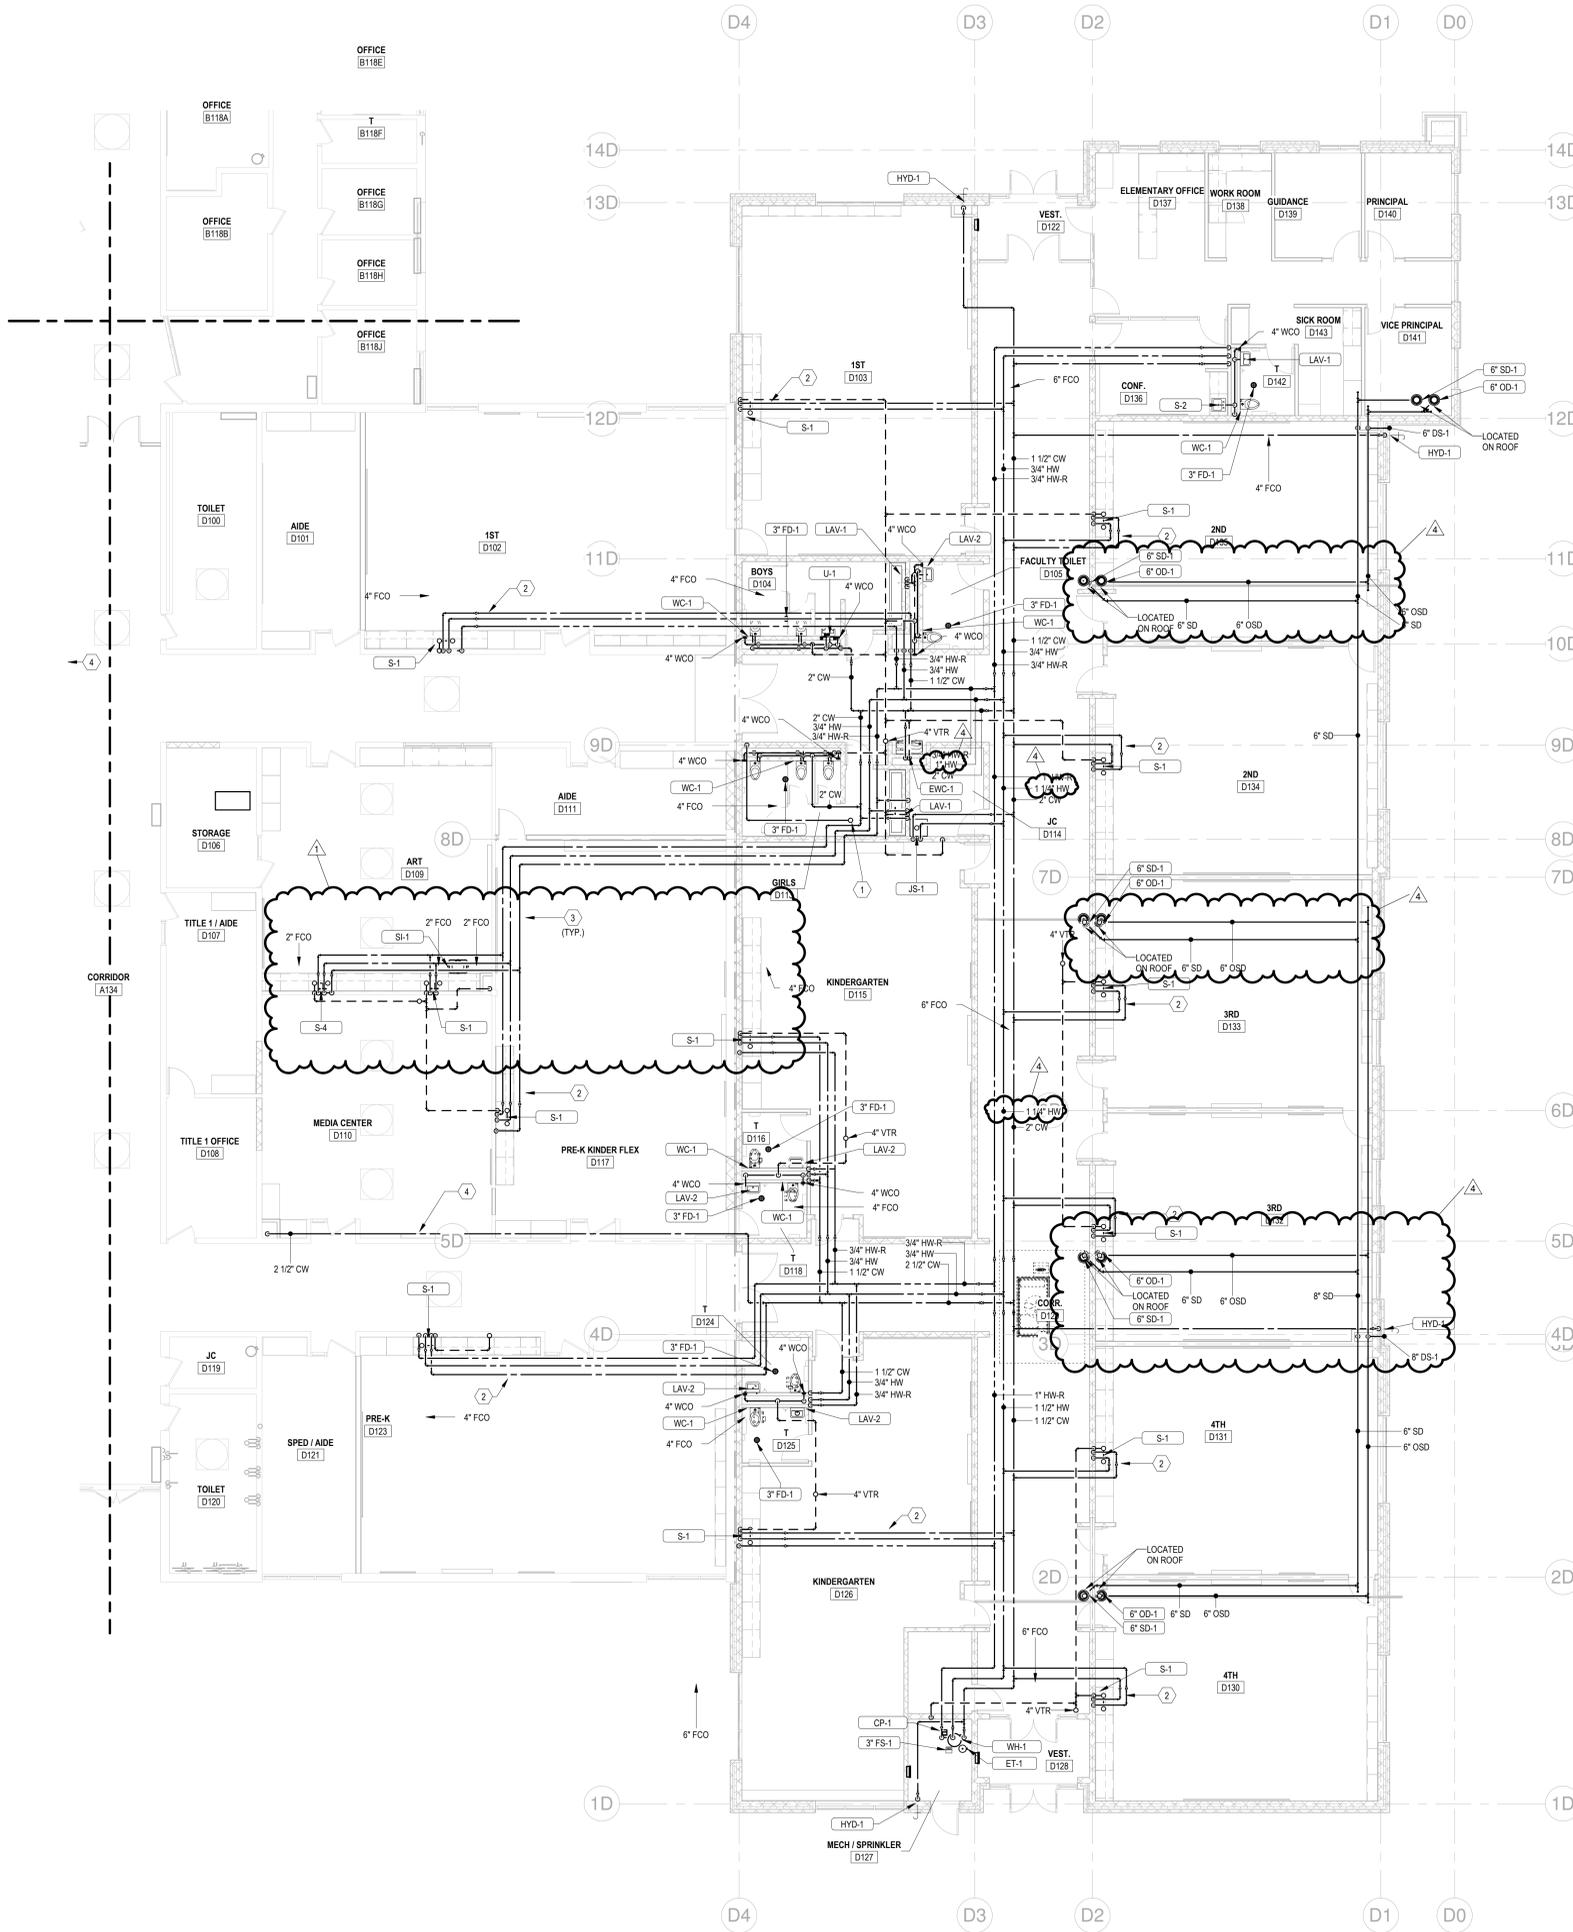

KEY PLAN
NOT TO SCALE

| | |
|----------------|--------------------------|
| JOB NUMBER | 21-346 |
| DATE | 03.22.2022 |
| REVISIONS: | 03.30.2022 04.20.2022 |
| 1 ADDENDUM 001 | |
| 4 ADDENDUM 004 | |

PARTIAL FIRST FLOOR PLUMBING PLAN - AREA D
1/8" = 1'-0"

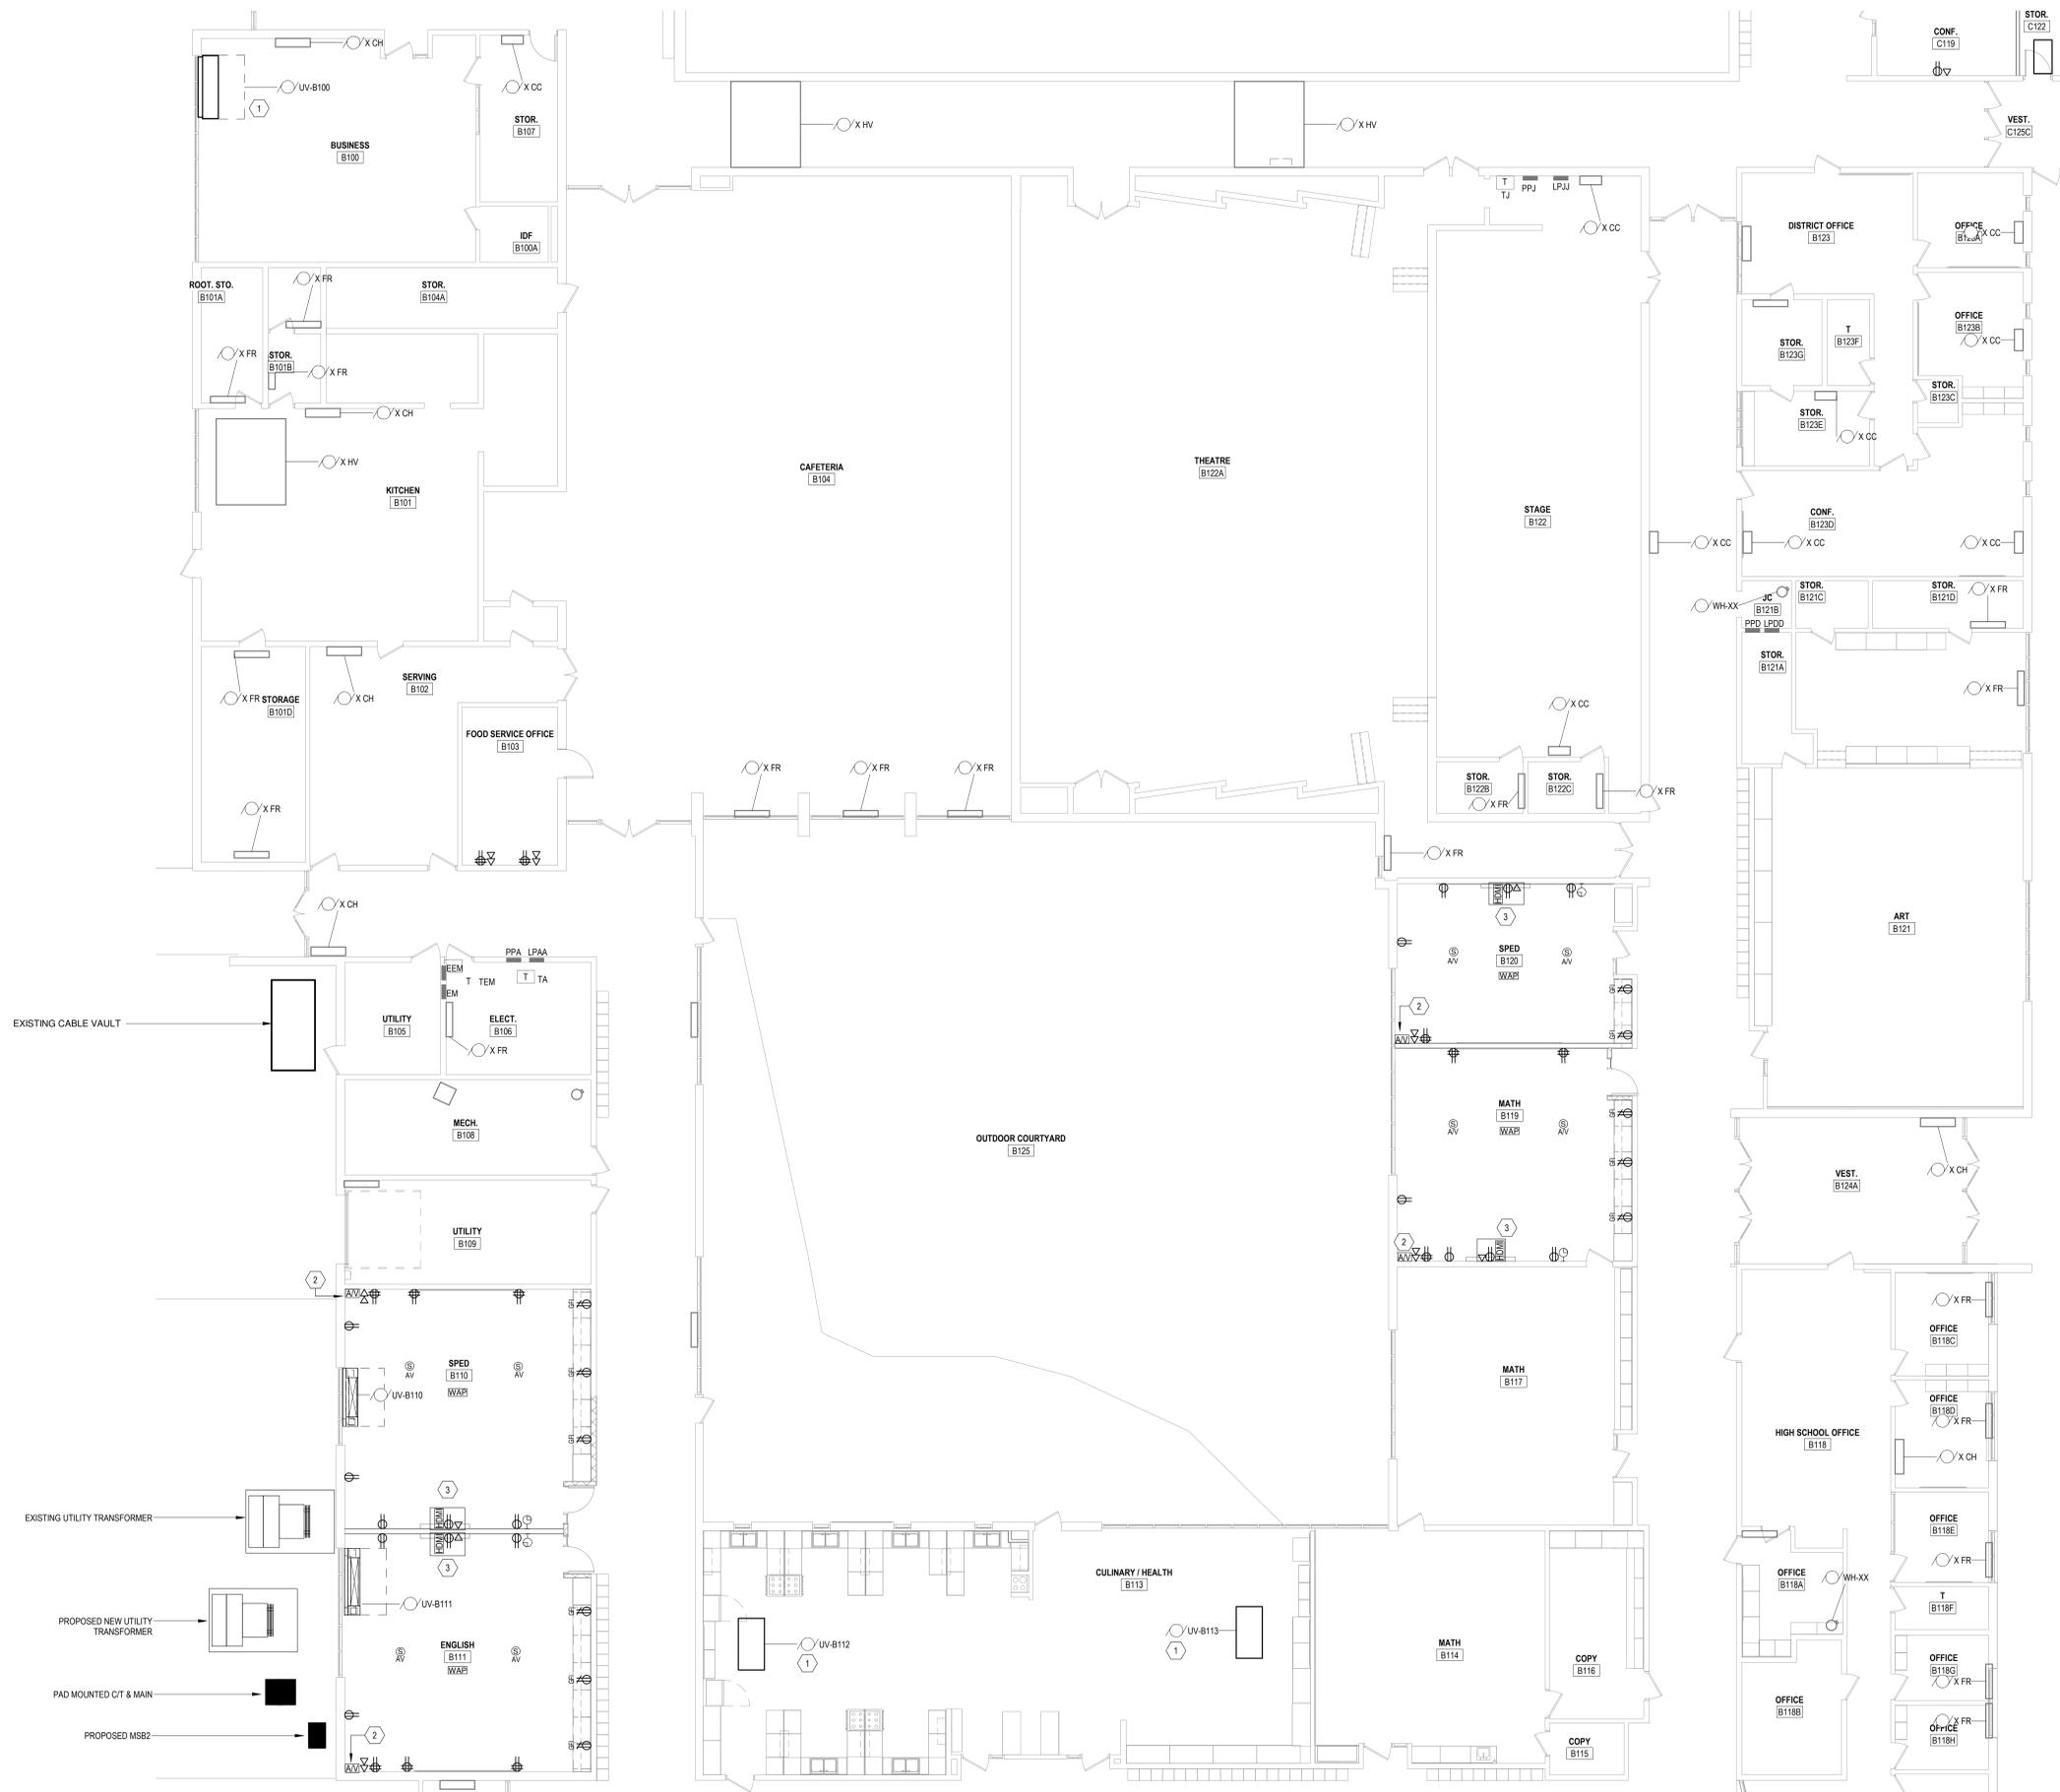


GENERAL LIGHTING & POWER NOTES

- REFER TO ARCHITECTURAL, MECHANICAL, PLUMBING, & FIRE PROTECTION PLANS FOR ADDITIONAL INFORMATION ON EXACT POWER, WIRING, & ROUGH-IN REQUIREMENTS AND LOCATIONS OF DEVICES.
- MINIMUM NEW CIRCUIT WIRING SHALL CONSIST OF 2#12, 1#12G, 1#2" C. WHERE HOME RUNS EXCEED 75' OR CONTINUOUS LOAD EXCEEDS 85% OF CIRCUIT RATING, MINIMUM CIRCUIT SIZE SHALL CONSIST OF 2#10G, 1#2" C. ALL NEW CIRCUITS SHALL INCLUDE A CONTINUOUS EQUIPMENT GROUNDING CONDUCTOR.
- CIRCUITS BEING CONTROLLED BY VARIABLE DIMMING EQUIPMENT SHALL ROUTED WITH SEPARATED DEDICATED NEUTRALS
- CONTRACTOR SHALL VERIFY EXACT LOCATIONS OF ALL RECESSED LIGHTING FIXTURES WITH ARCHITECTURAL REFLECTED CEILING PLANS PRIOR TO INSTALLATION. VERIFY CEILING CONSTRUCTION WITH ARCHITECT IN ALL AREAS. CONTRACTOR SHALL BE RESPONSIBLE FOR ORDERING FIXTURES WITH CORRECT TRIMS, ETC. TO ASSURE COMPATIBILITY WITH CEILING STRUCTURE.
- WHERE MORE THAN ONE SWITCH IS INDICATED AT A LOCATION, CONTRACTOR SHALL INSTALL CO-LOCATED LIGHT SWITCHES IN A COMMON FACERPLATE. USE MULTI-GANG BACKBOXES. VERIFY MOUNTING HEIGHT WITH ADA REQUIREMENTS. PROVIDE STEEL BARRIES BETWEEN SWITCHES FOR EACH CIRCUIT WHERE MANDATED BY CODE.
- COORDINATE INSTALLATION OF LIGHTING FIXTURES IN MECHANICAL AREAS, EQUIPMENT ROOM, ETC. ADJUST FIXTURE HEIGHTS AND LOCATIONS AS NECESSARY TO OFFSET CONFLICTS
- FOR EXISTING AREAS WITH NEW REPLACEMENT LIGHTING.
 - E.C. TO REWORK AND EXTEND EXISTING LIGHTING CIRCUIT TO NEW REPLACEMENT FIXTURES IN LOCATIONS AS SHOWN.
 - REPLACEMENT WALL CONTROLS SHALL BE INSTALLED IN EXISTING SWITCH LOCATIONS WITH NEW FACEPLATES MATCHING NEW DEVICES. EXTEND NEW NEUTRAL TO SWITCH LOCATION AS REQUIRED FOR NEW WALL STATION LIGHTING CONTROLS.

ELECTRICAL POWER KEYNOTES

- SEE E4.3 FOR GENERAL SCOPE. PROVIDE NEW BRANCH WIRING, RACEWAY, AND BREAKER TO SERVE NEW EQUIPMENT FROM THE EXISTING POWER PANEL, SERVING THIS AREA.
- TYPICAL TEACHERS WALL DEVICES. SEE DETAIL E4.1 #4
- THREE-GANG RECESSED TV BOX (ARLINGTON STEEL TVB5507)

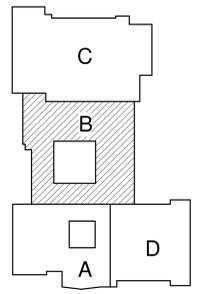

KEY PLAN
NOT TO SCALE

1 ELECTRICAL POWER PLAN - AREA B
1/8" = 1'-0"

4/20/2022 11:02:18 AM
COPYRIGHT © 2022. ALL RIGHTS RESERVED

CORDOGAN CLARK
ARCHITECTS
18 North West Chicago, L. 0308
PO BOX 1020
RIVER VALLEY, IL 60171

RIVER VALLEY SCHOOL DISTRICT

RIVER VALLEY HIGH SCHOOL
15480 THREE OAKS RD
THREE OAKS, IL 60178

ELECTRICAL POWER PLAN - AREA B

JOB NUMBER 21-346
DATE 03/22/2022

REVISIONS:
03.29.2022 ADDED 01
04.12.2022 ADDED 02

STATE OF MICHIGAN
John C. Cordogan
Architect
No. 1301035965
LICENSED ARCHITECT

E2.1B



CD BID SET

GENERAL LIGHTING & POWER NOTES


- REFER TO ARCHITECTURAL, MECHANICAL, PLUMBING, & FIRE PROTECTION PLANS FOR ADDITIONAL INFORMATION ON EXACT POWER, WIRING, & ROUGH-IN REQUIREMENTS AND LOCATIONS OF DEVICES.
- MINIMUM NEW CIRCUIT WIRING SHALL CONSIST OF 2#12-1#12G, 1/2" C. WHERE HOME RUNS EXCEED 75' OR CONTINUOUS LOAD EXCEEDS 65% OF CIRCUIT RATING, MINIMUM CIRCUIT SIZE SHALL CONSIST OF 2#10G, 1/2" C. ALL NEW CIRCUITS SHALL INCLUDE A CONTINUOUS EQUIPMENT GROUNDING CONDUCTOR.
- CIRCUITS BEING CONTROLLED BY VARIABLE DIMMING EQUIPMENT SHALL ROUTED WITH SEPARATED DEDICATED NEUTRALS
- CONTRACTOR SHALL VERIFY EXACT LOCATIONS OF ALL RECESSED LIGHTING FIXTURES WITH ARCHITECTURAL REFLECTED CEILING PLANS PRIOR TO INSTALLATION. VERIFY CEILING CONSTRUCTION WITH ARCHITECT IN ALL AREAS. CONTRACTOR SHALL BE RESPONSIBLE FOR ORDERING FIXTURES WITH CORRECT TRIMS, ETC. TO ASSURE COMPATIBILITY WITH CEILING STRUCTURE.
- WHERE MORE THAN ONE SWITCH IS INDICATED AT A LOCATION, CONTRACTOR SHALL INSTALL CO-LOCATED LIGHT SWITCHES IN A COMMON FACEPLATE. USE MULTI-GANG BACKBOXES. VERIFY MOUNTING HEIGHT WITH ADA REQUIREMENTS. PROVIDE STEEL BARRIERS BETWEEN SWITCHES FOR EACH CIRCUIT WHERE MANDATED BY CODE.
- COORDINATE INSTALLATION OF LIGHTING FIXTURES IN MECHANICAL AREAS, EQUIPMENT ROOM, ETC; ADJUST FIXTURE HEIGHTS AND LOCATIONS AS NECESSARY TO OFFSET CONFLICTS
- FOR EXISTING AREAS WITH NEW REPLACEMENT LIGHTING.
 - E.C. TO REWORK AND EXTEND EXISTING LIGHTING CIRCUIT TO NEW REPLACEMENT FIXTURES IN LOCATIONS AS SHOWN
 - REPLACEMENT WALL CONTROLS SHALL BE INSTALLED IN EXISTING SWITCH LOCATIONS WITH NEW FACEPLATES MATCHING NEW DEVICES. EXTEND NEW NEUTRAL TO SWITCH LOCATION AS REQUIRED FOR NEW WALL STATION LIGHTING CONTROLS.

ELECTRICAL POWER KEYNOTES

- SEE E4.3 FOR GENERAL SCOPE. PROVIDE NEW BRANCH WIRING, RACEWAY, AND BREAKER TO SERVE NEW EQUIPMENT FROM THE EXISTING POWER PANEL SERVICE THIS AREA.
- THREE-GANG RECESSED TV BOX/ARLINGTON STEEL TVBSS07)
- DUAL CHANNEL SURFACE RACEWAY TO SERVE NEW DATA AND RECEPTACLE OUTLETS AS INDICATED.
- PROVIDE COMPLIANT HOOKUP TO REPLACEMENT WATER COOLER.
- TYPICAL TEACHER'S WALL DEVICES. SEE DETAIL E4.1 #4.

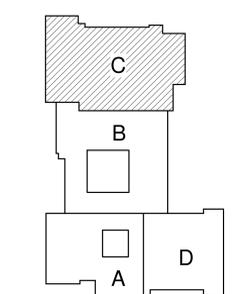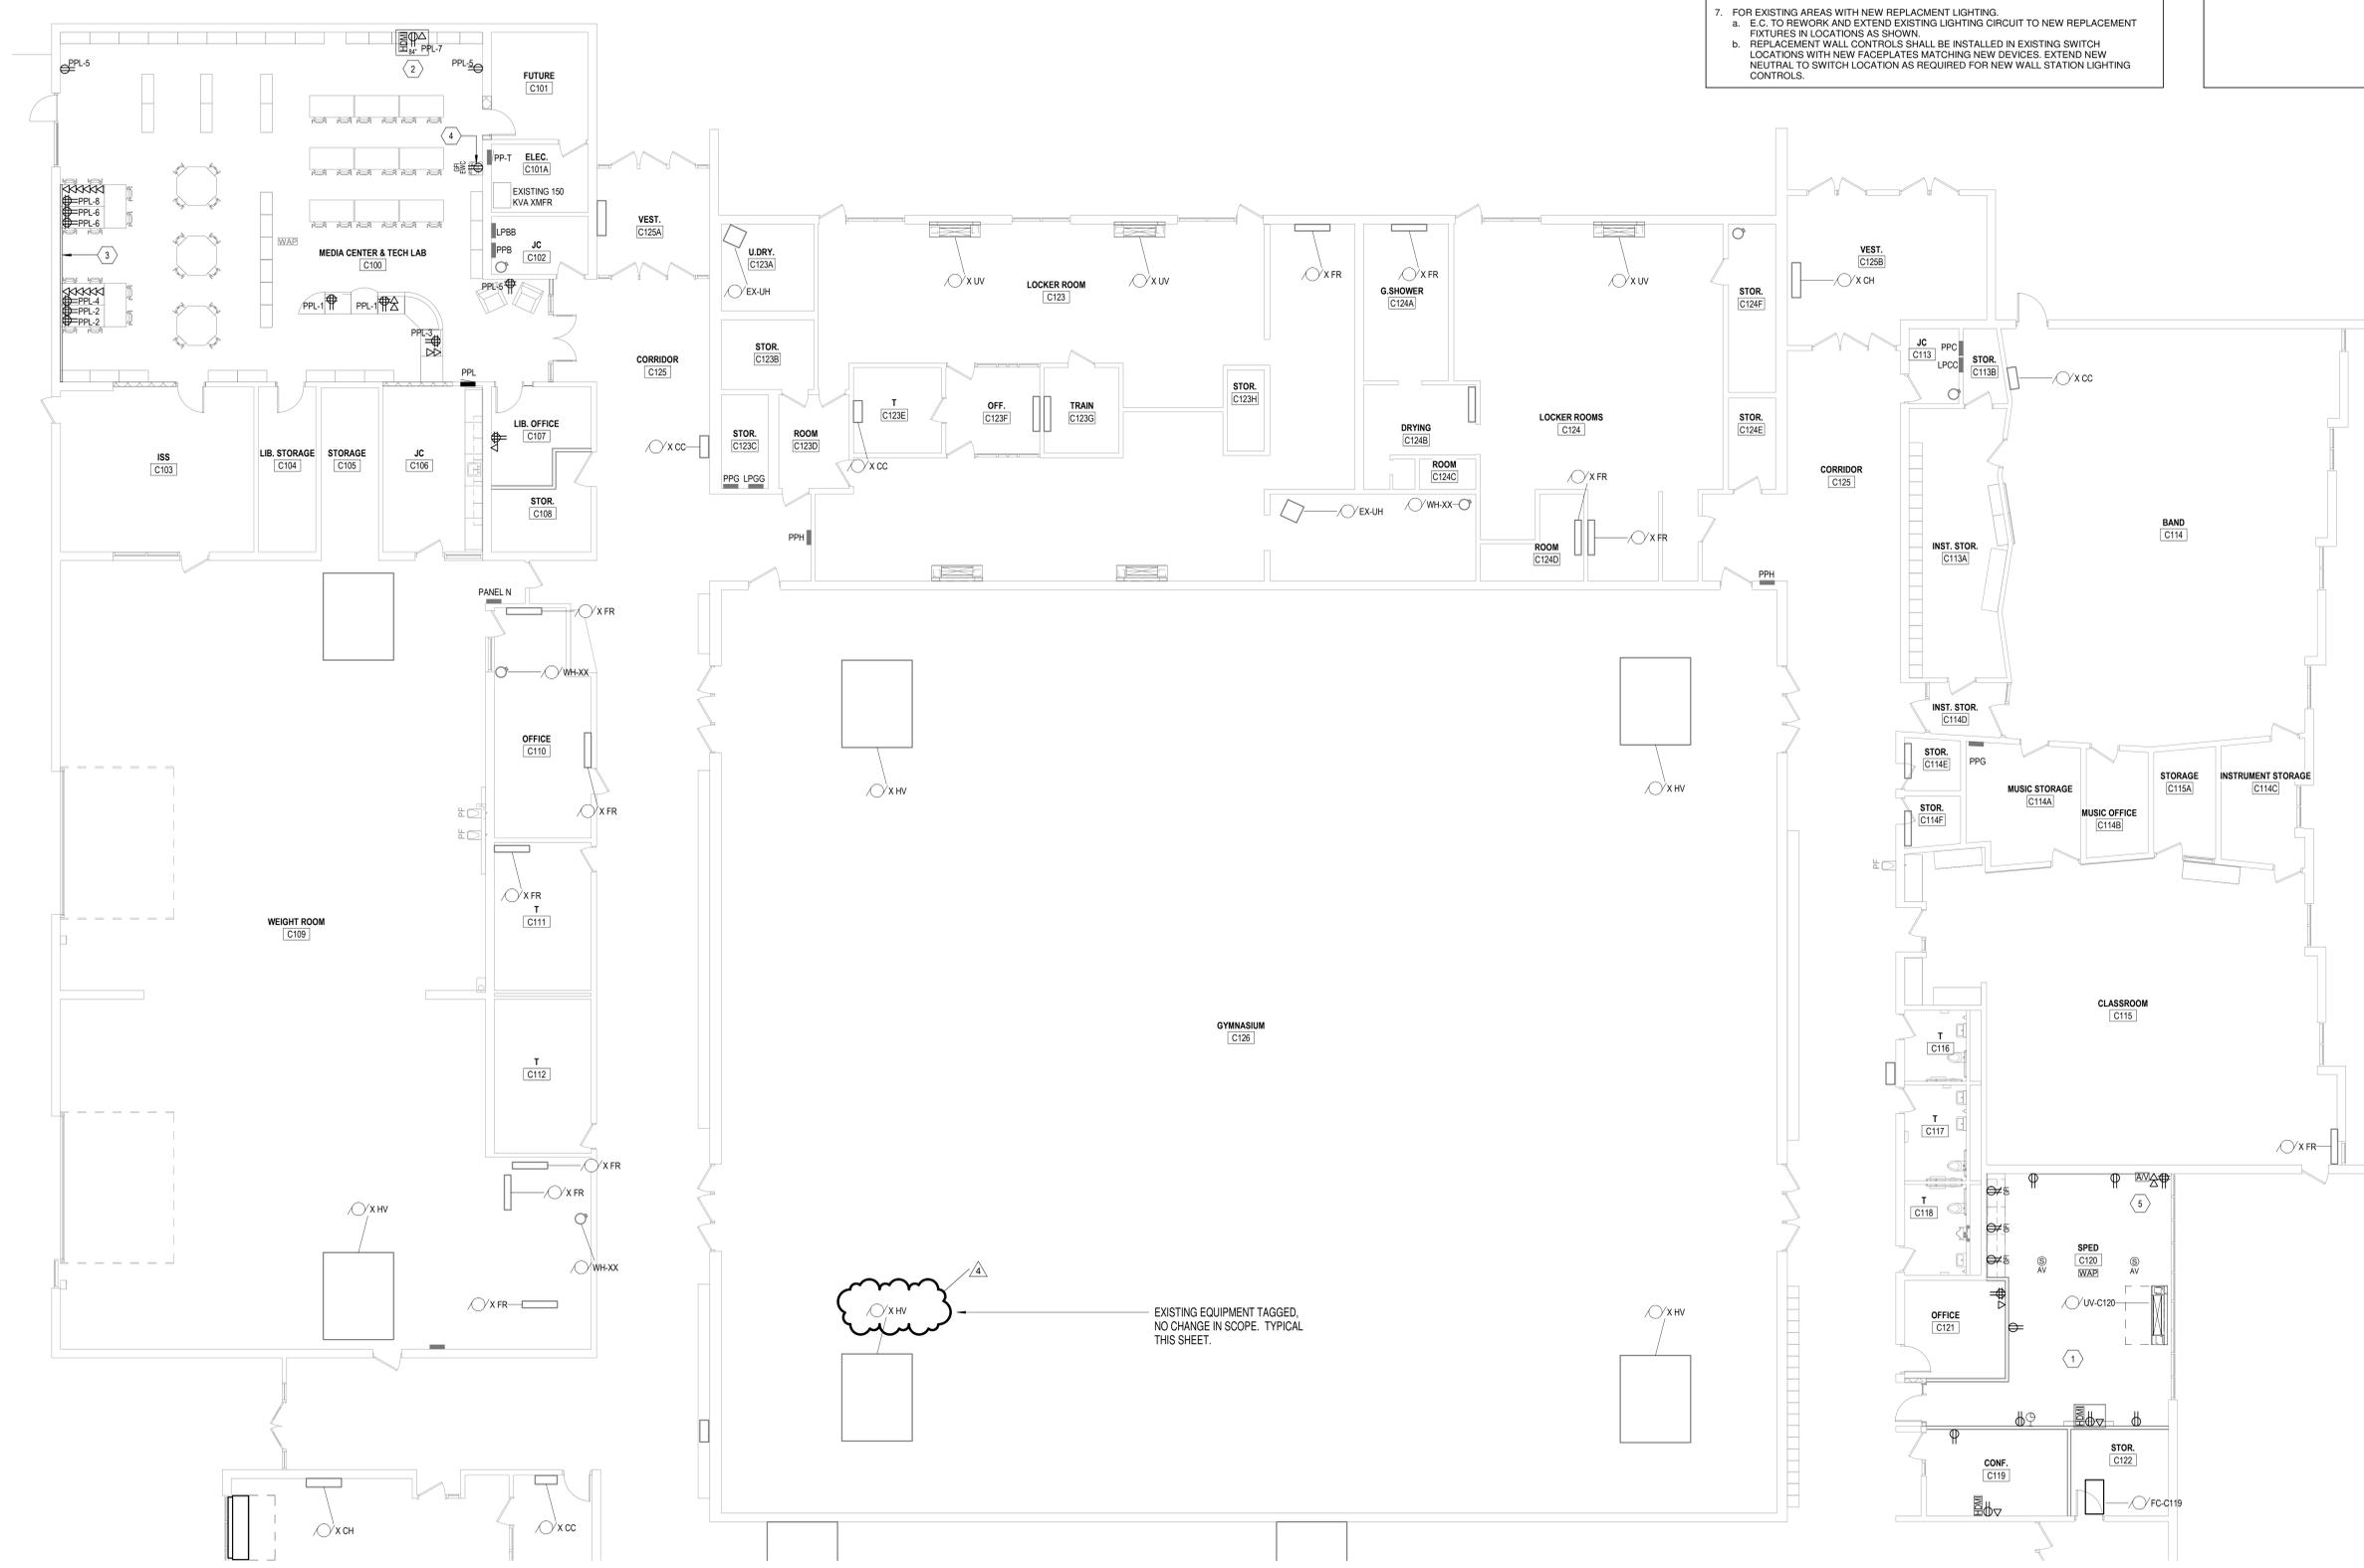

KEY PLAN
 NOT TO SCALE

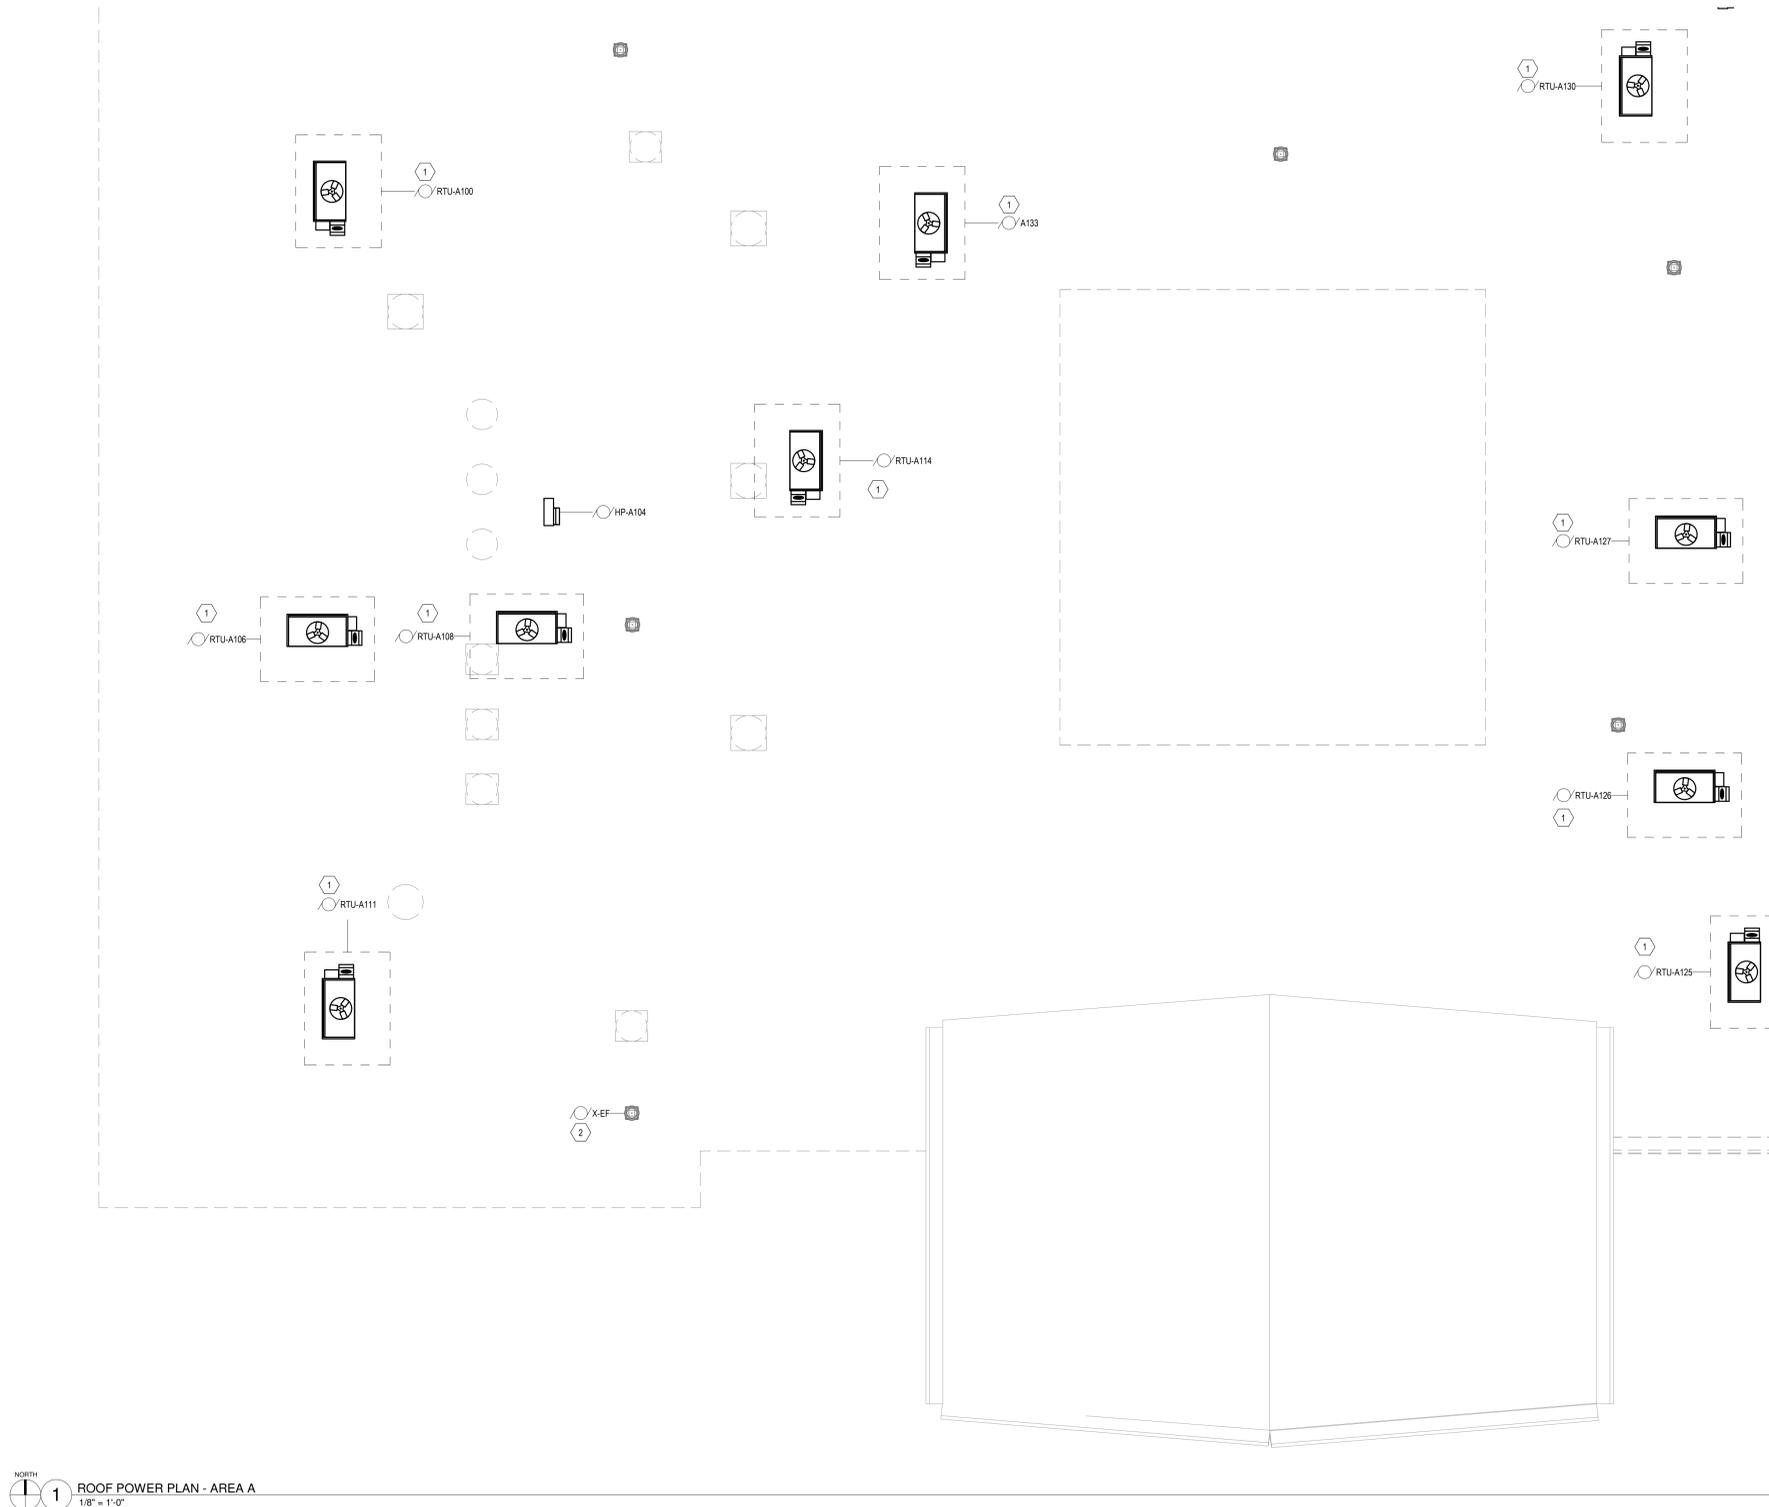


1 ROOF POWER PLAN - AREA A
 1/8" = 1'-0"

GENERAL LIGHTING & POWER NOTES


- REFER TO ARCHITECTURAL, MECHANICAL, PLUMBING, & FIRE PROTECTION PLANS FOR ADDITIONAL INFORMATION ON EXACT POWER, WIRING, & ROUGH-IN REQUIREMENTS AND LOCATIONS OF DEVICES.
- MINIMUM NEW CIRCUIT WIRING SHALL CONSIST OF 2#12, 1#12G, 1#2"Ø, WHERE HOME RUNS EXCEED 75' OR CONTINUOUS LOAD EXCEEDS 85% OF CIRCUIT RATING. MINIMUM CIRCUIT SIZE SHALL CONSIST OF 2#10G, 1#2"Ø. ALL NEW CIRCUITS SHALL INCLUDE A CONTINUOUS EQUIPMENT GROUNDING CONDUCTOR.
- CIRCUITS BEING CONTROLLED BY VARIABLE DIMMING EQUIPMENT SHALL ROUTED WITH SEPARATED DEDICATED NEUTRALS.
- CONTRACTOR SHALL VERIFY EXACT LOCATIONS OF ALL RECESSED LIGHTING FIXTURES WITH ARCHITECTURAL REFLECTED CEILING PLANS PRIOR TO INSTALLATION. VERIFY CEILING CONSTRUCTION WITH ARCHITECT IN ALL AREAS. CONTRACTOR SHALL BE RESPONSIBLE FOR ORDERING FIXTURES WITH CORRECT TRIMS, ETC. TO ASSURE COMPATIBILITY WITH CEILING STRUCTURE.
- WHERE MORE THAN ONE SWITCH IS INDICATED AT A LOCATION, CONTRACTOR SHALL INSTALL CO-LOCATED LIGHT SWITCHES IN A COMMON FACERPLATE. USE MULTI-GANG BACKBOXES. VERIFY MOUNTING HEIGHT WITH ADA REQUIREMENTS. PROVIDE STEEL BARRIES BETWEEN SWITCHES FOR EACH CIRCUIT WHERE MANDATED BY CODE.
- COORDINATE INSTALLATION OF LIGHTING FIXTURES IN MECHANICAL AREAS, EQUIPMENT ROOM, ETC. ADJUST FIXTURE HEIGHTS AND LOCATIONS AS NECESSARY TO OFFSET CONFLICTS.
- FOR EXISTING AREAS WITH NEW REPLACEMENT LIGHTING:
 - E.C. TO REWORK AND EXTEND EXISTING LIGHTING CIRCUIT TO NEW REPLACEMENT FIXTURES IN LOCATIONS AS SHOWN.
 - REPLACEMENT WALL CONTROLS SHALL BE INSTALLED IN EXISTING SWITCH LOCATIONS WITH NEW FACEPLATES MATCHING NEW DEVICES. EXTEND NEW NEUTRAL TO SWITCH LOCATION AS REQUIRED FOR NEW WALL STATION LIGHTING CONTROLS.

ELECTRICAL POWER KEYNOTES

- AFTER PLACEMENT OF NEW EQUIPMENT, EXTEND THE BRANCH CIRCUIT WIRING TO UNIT AND PROVIDE A COMPLIANT CONNECTION. NEW EQUIPMENT WILL HAVE INTEGRAL DISCONNECTS. REPLACE LIQUIDTITE FLEXIBLE RACEWAY; VERIFY ROTATION AND ASSIST IN COMMISSIONING.
- SECURE WIRING AND PROVIDE COMPLIANT HOOKUP FOR EXHAUST FAN.

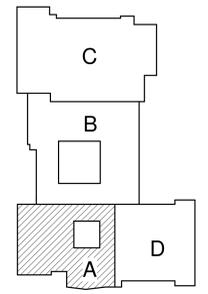

KEY PLAN
 NOT TO SCALE

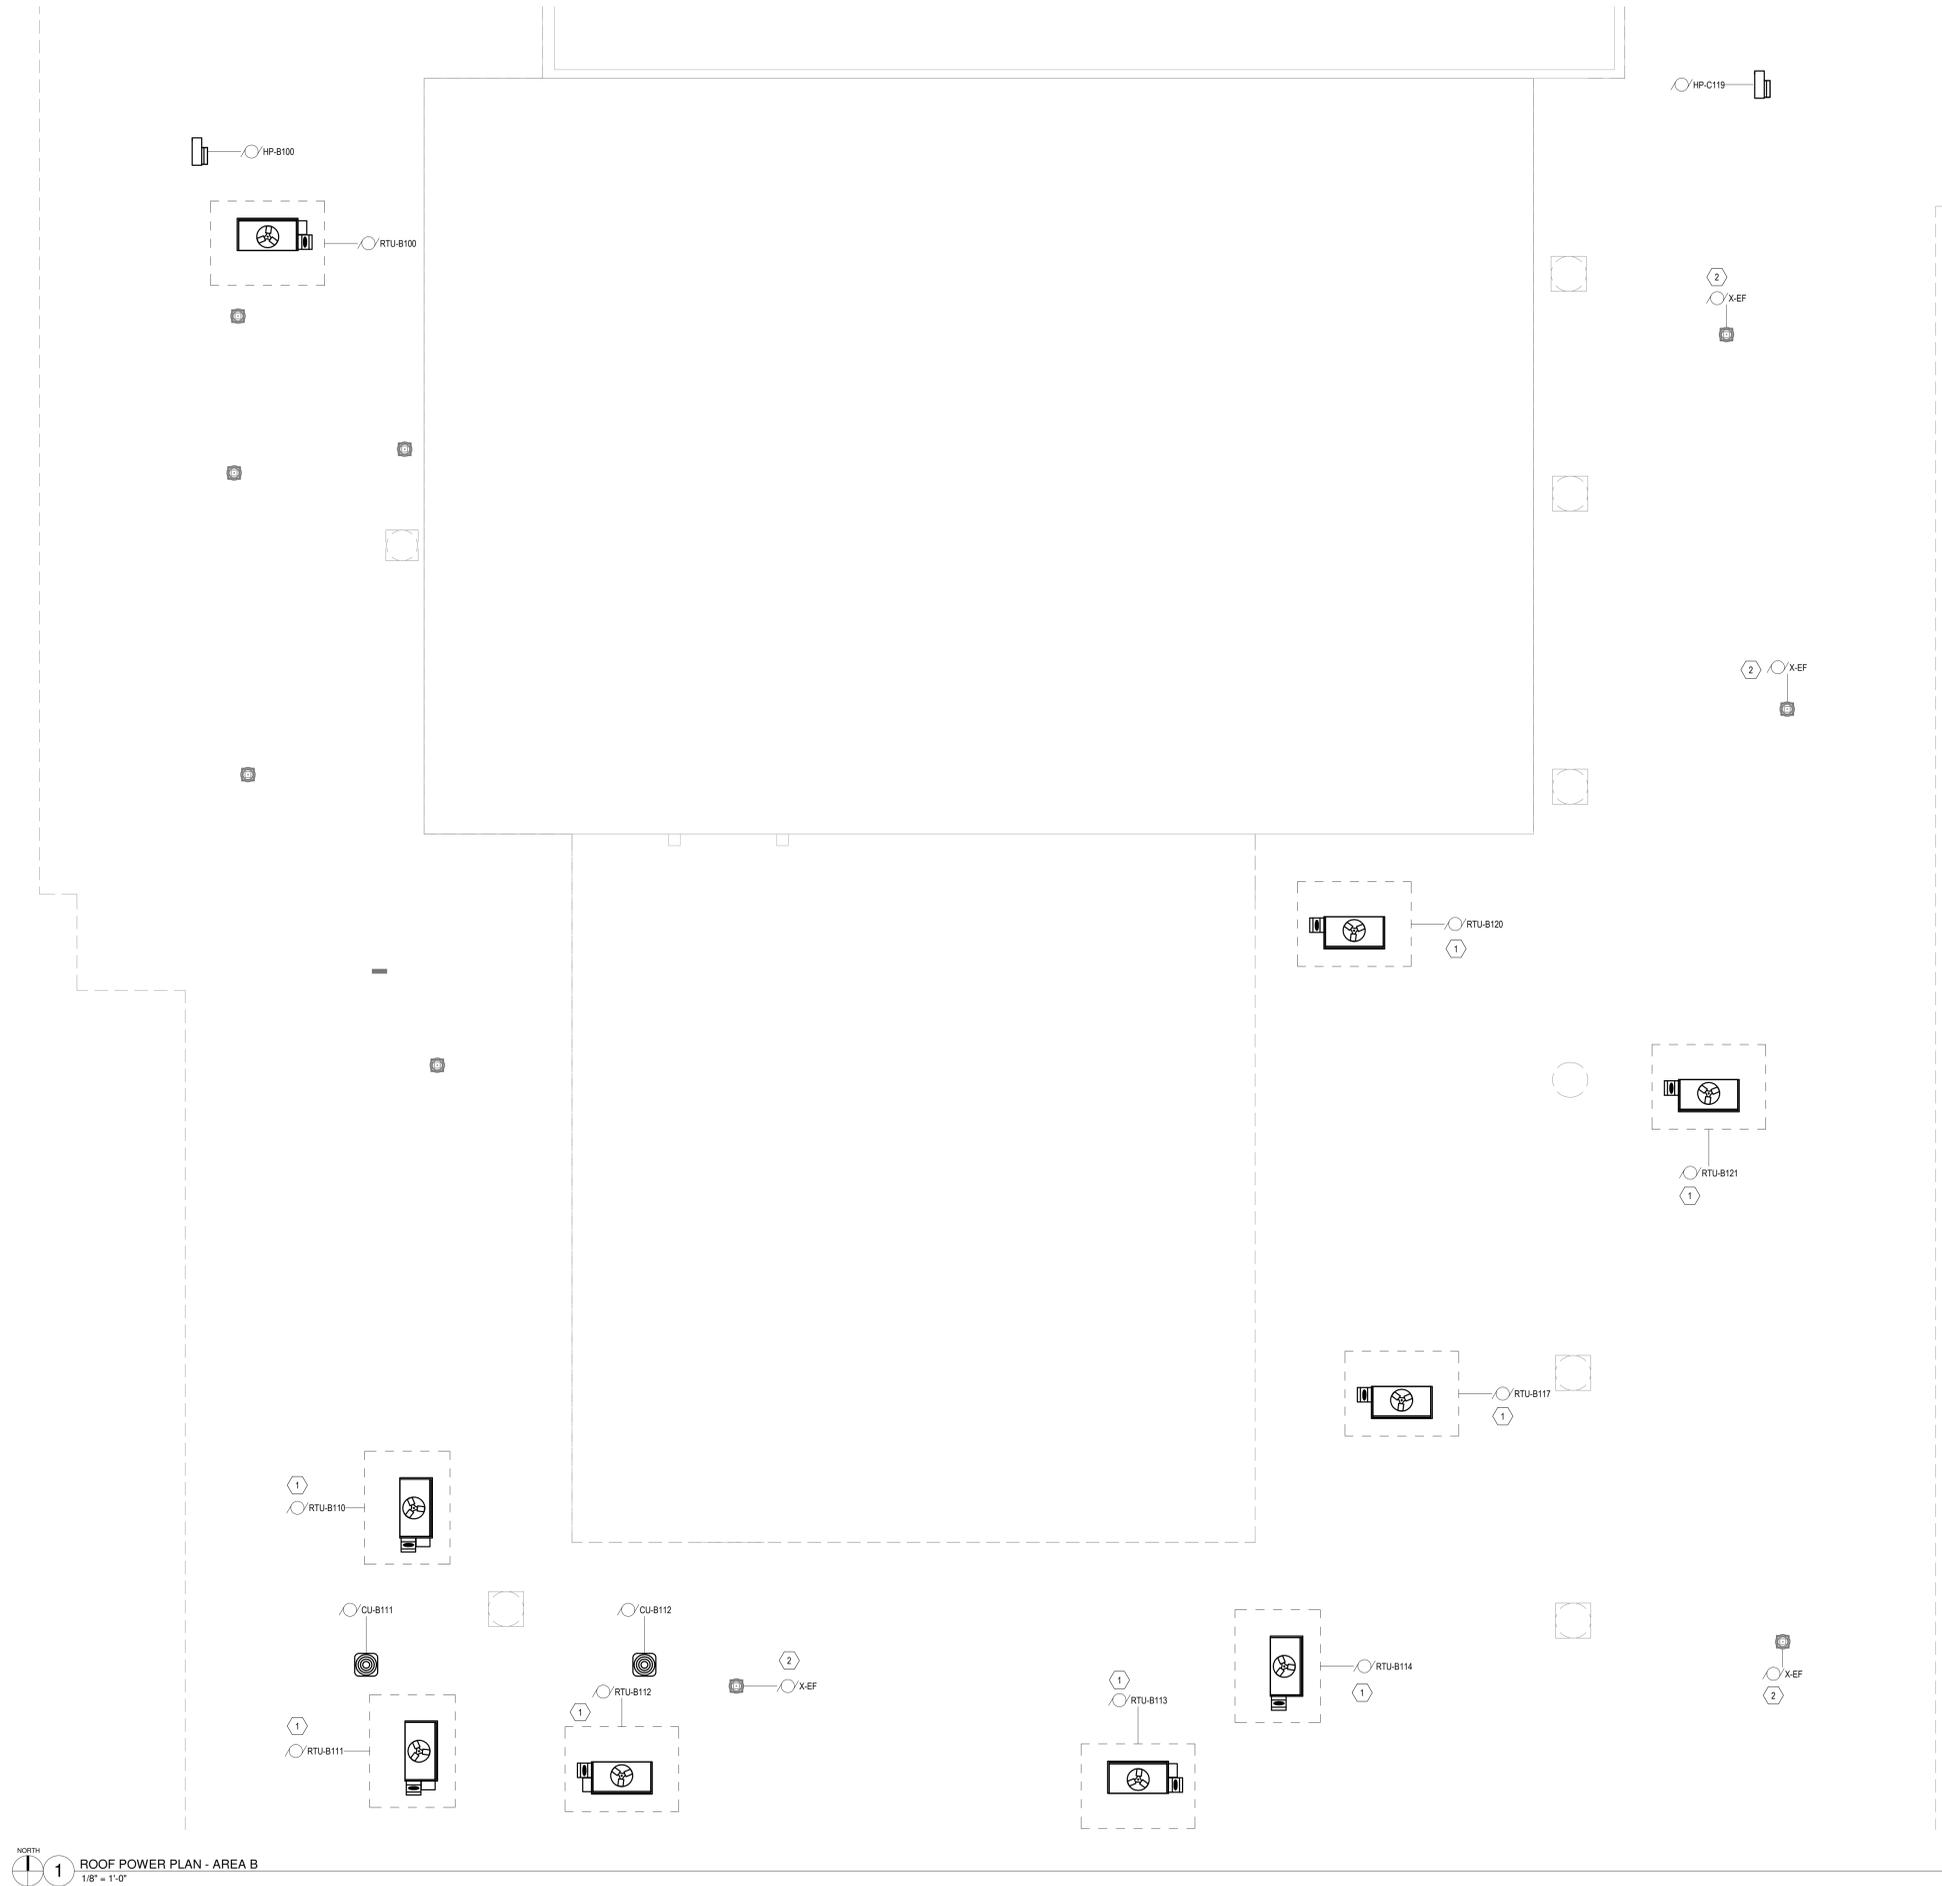


NORTH
 1 ROOF POWER PLAN - AREA B
 1/8" = 1'-0"

GENERAL LIGHTING & POWER NOTES

1. REFER TO ARCHITECTURAL, MECHANICAL, PLUMBING, & FIRE PROTECTION PLANS FOR ADDITIONAL INFORMATION ON EXACT POWER, WIRING, & ROUGH-IN REQUIREMENTS AND LOCATIONS OF DEVICES.
2. MINIMUM NEW CIRCUIT WIRING SHALL CONSIST OF 2#12, 1#12G, 1/2" C, WHERE HOME RUNS EXCEED 75' OR CONTINUOUS LOAD EXCEEDS 65% OF CIRCUIT RATING. MINIMUM CIRCUIT SIZE SHALL CONSIST OF 2#10G, 1/2" C. ALL NEW CIRCUITS SHALL INCLUDE A CONTINUOUS EQUIPMENT GROUNDING CONDUCTOR.
3. CIRCUITS BEING CONTROLLED BY VARIABLE DIMMING EQUIPMENT SHALL ROUTED WITH SEPARATED DEDICATED NEUTRALS.
4. CONTRACTOR SHALL VERIFY EXACT LOCATIONS OF ALL RECESSED LIGHTING FIXTURES WITH ARCHITECTURAL REFLECTED CEILING PLANS PRIOR TO INSTALLATION. VERIFY CEILING CONSTRUCTION WITH ARCHITECT IN ALL AREAS. CONTRACTOR SHALL BE RESPONSIBLE FOR ORDERING FIXTURES WITH CORRECT TRIMS, ETC. TO ASSURE COMPATIBILITY WITH CEILING STRUCTURE.
5. WHERE MORE THAN ONE SWITCH IS INDICATED AT A LOCATION, CONTRACTOR SHALL INSTALL CO-LOCATED LIGHT SWITCHES IN A COMMON FACEPLATE. USE MULTI-GANG BACKBOXES. VERIFY MOUNTING HEIGHT WITH ADA REQUIREMENTS. PROVIDE STEEL BARRIES BETWEEN SWITCHES FOR EACH CIRCUIT WHERE MANDATED BY CODE.
6. COORDINATE INSTALLATION OF LIGHTING FIXTURES IN MECHANICAL AREAS, EQUIPMENT ROOM, ETC. ADJUST FIXTURE HEIGHTS AND LOCATIONS AS NECESSARY TO OFFSET CONFLICTS.
7. FOR EXISTING AREAS WITH NEW REPLACEMENT LIGHTING.
 - a. E.C. TO REWORK AND EXTEND EXISTING LIGHTING CIRCUIT TO NEW REPLACEMENT FIXTURES IN LOCATIONS AS SHOWN.
 - b. REPLACEMENT WALL CONTROLS SHALL BE INSTALLED IN EXISTING SWITCH LOCATIONS WITH NEW FACEPLATES MATCHING NEW DEVICES. EXTEND NEW NEUTRAL TO SWITCH LOCATION AS REQUIRED FOR NEW WALL STATION LIGHTING CONTROLS.

ELECTRICAL POWER KEYNOTES

- 1 AFTER PLACEMENT OF NEW EQUIPMENT, EXTEND THE BRANCH CIRCUIT WIRING TO UNIT AND PROVIDE A COMPLIANT CONNECTION. NEW EQUIPMENT WILL HAVE INTEGRAL DISCONNECTS. REPLACE LIQUIDTITE FLEXIBLE RACEWAY; VERIFY ROTATION AND ASSIST IN COMMISSIONING.
- 2 SECURE WIRING AND PROVIDE COMPLIANT HOOKUP FOR EXHAUST FAN.

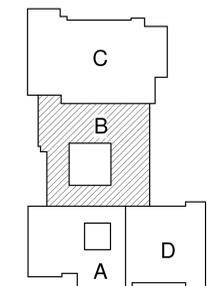



1 KEY PLAN
 NOT TO SCALE

GENERAL LIGHTING & POWER NOTES

1. REFER TO ARCHITECTURAL, MECHANICAL, PLUMBING, & FIRE PROTECTION PLANS FOR ADDITIONAL INFORMATION ON EXACT POWER, WIRING, & ROUGH-IN REQUIREMENTS AND LOCATIONS OF DEVICES.
2. MINIMUM NEW CIRCUIT WIRING SHALL CONSIST OF 2#12, 1#12G, 1/2" C. WHERE HOME RUNS EXCEED 75' OR CONTINUOUS LOAD EXCEEDS 65% OF CIRCUIT RATING, MINIMUM CIRCUIT SIZE SHALL CONSIST OF 2#10G, 1/2" C. ALL NEW CIRCUITS SHALL INCLUDE A CONTINUOUS EQUIPMENT GROUNDING CONDUCTOR.
3. CIRCUITS BEING CONTROLLED BY VARIABLE DIMMING EQUIPMENT SHALL ROUTED WITH SEPARATED DEDICATED NEUTRALS
4. CONTRACTOR SHALL VERIFY EXACT LOCATIONS OF ALL RECESSED LIGHTING FIXTURES WITH ARCHITECTURAL REFLECTED CEILING PLANS PRIOR TO INSTALLATION. VERIFY CEILING CONSTRUCTION WITH ARCHITECT IN ALL AREAS. CONTRACTOR SHALL BE RESPONSIBLE FOR ORDERING FIXTURES WITH CORRECT TRIMS, ETC. TO ASSURE COMPATIBILITY WITH CEILING STRUCTURE.
5. WHERE MORE THAN ONE SWITCH IS INDICATED AT A LOCATION, CONTRACTOR SHALL INSTALL CO-LOCATED LIGHT SWITCHES IN A COMMON FACEPLATE. USE MULTI-GANG BACKBOXES. VERIFY MOUNTING HEIGHT WITH ADA REQUIREMENTS. PROVIDE STEEL BARRIERS BETWEEN SWITCHES FOR EACH CIRCUIT WHERE MANDATED BY CODE.
6. COORDINATE INSTALLATION OF LIGHTING FIXTURES IN MECHANICAL AREAS, EQUIPMENT ROOM, ETC. ADJUST FIXTURE HEIGHTS AND LOCATIONS AS NECESSARY TO OFFSET CONFLICTS
7. FOR EXISTING AREAS WITH NEW REPLACEMENT LIGHTING.
 - a. E.C. TO REWORK AND EXTEND EXISTING LIGHTING CIRCUIT TO NEW REPLACEMENT FIXTURES IN LOCATIONS AS SHOWN
 - b. REPLACEMENT WALL CONTROLS SHALL BE INSTALLED IN EXISTING SWITCH LOCATIONS WITH NEW FACEPLATES MATCHING NEW DEVICES. EXTEND NEW NEUTRAL TO SWITCH LOCATION AS REQUIRED FOR NEW WALL STATION LIGHTING CONTROLS.

ELECTRICAL POWER KEYNOTES

1. AFTER PLACEMENT OF NEW EQUIPMENT, EXTEND THE BRANCH CIRCUIT WIRING TO UNIT AND PROVIDE A COMPLIANT CONNECTION. NEW EQUIPMENT WILL HAVE INTEGRAL DISCONNECTS. REPLACE LIQUIDTITE FLEXIBLE RACEWAY. VERIFY ROTATION AND ASSIST IN COMMISSIONING.

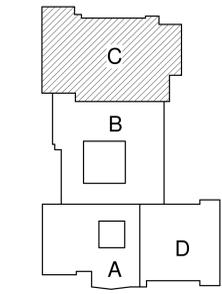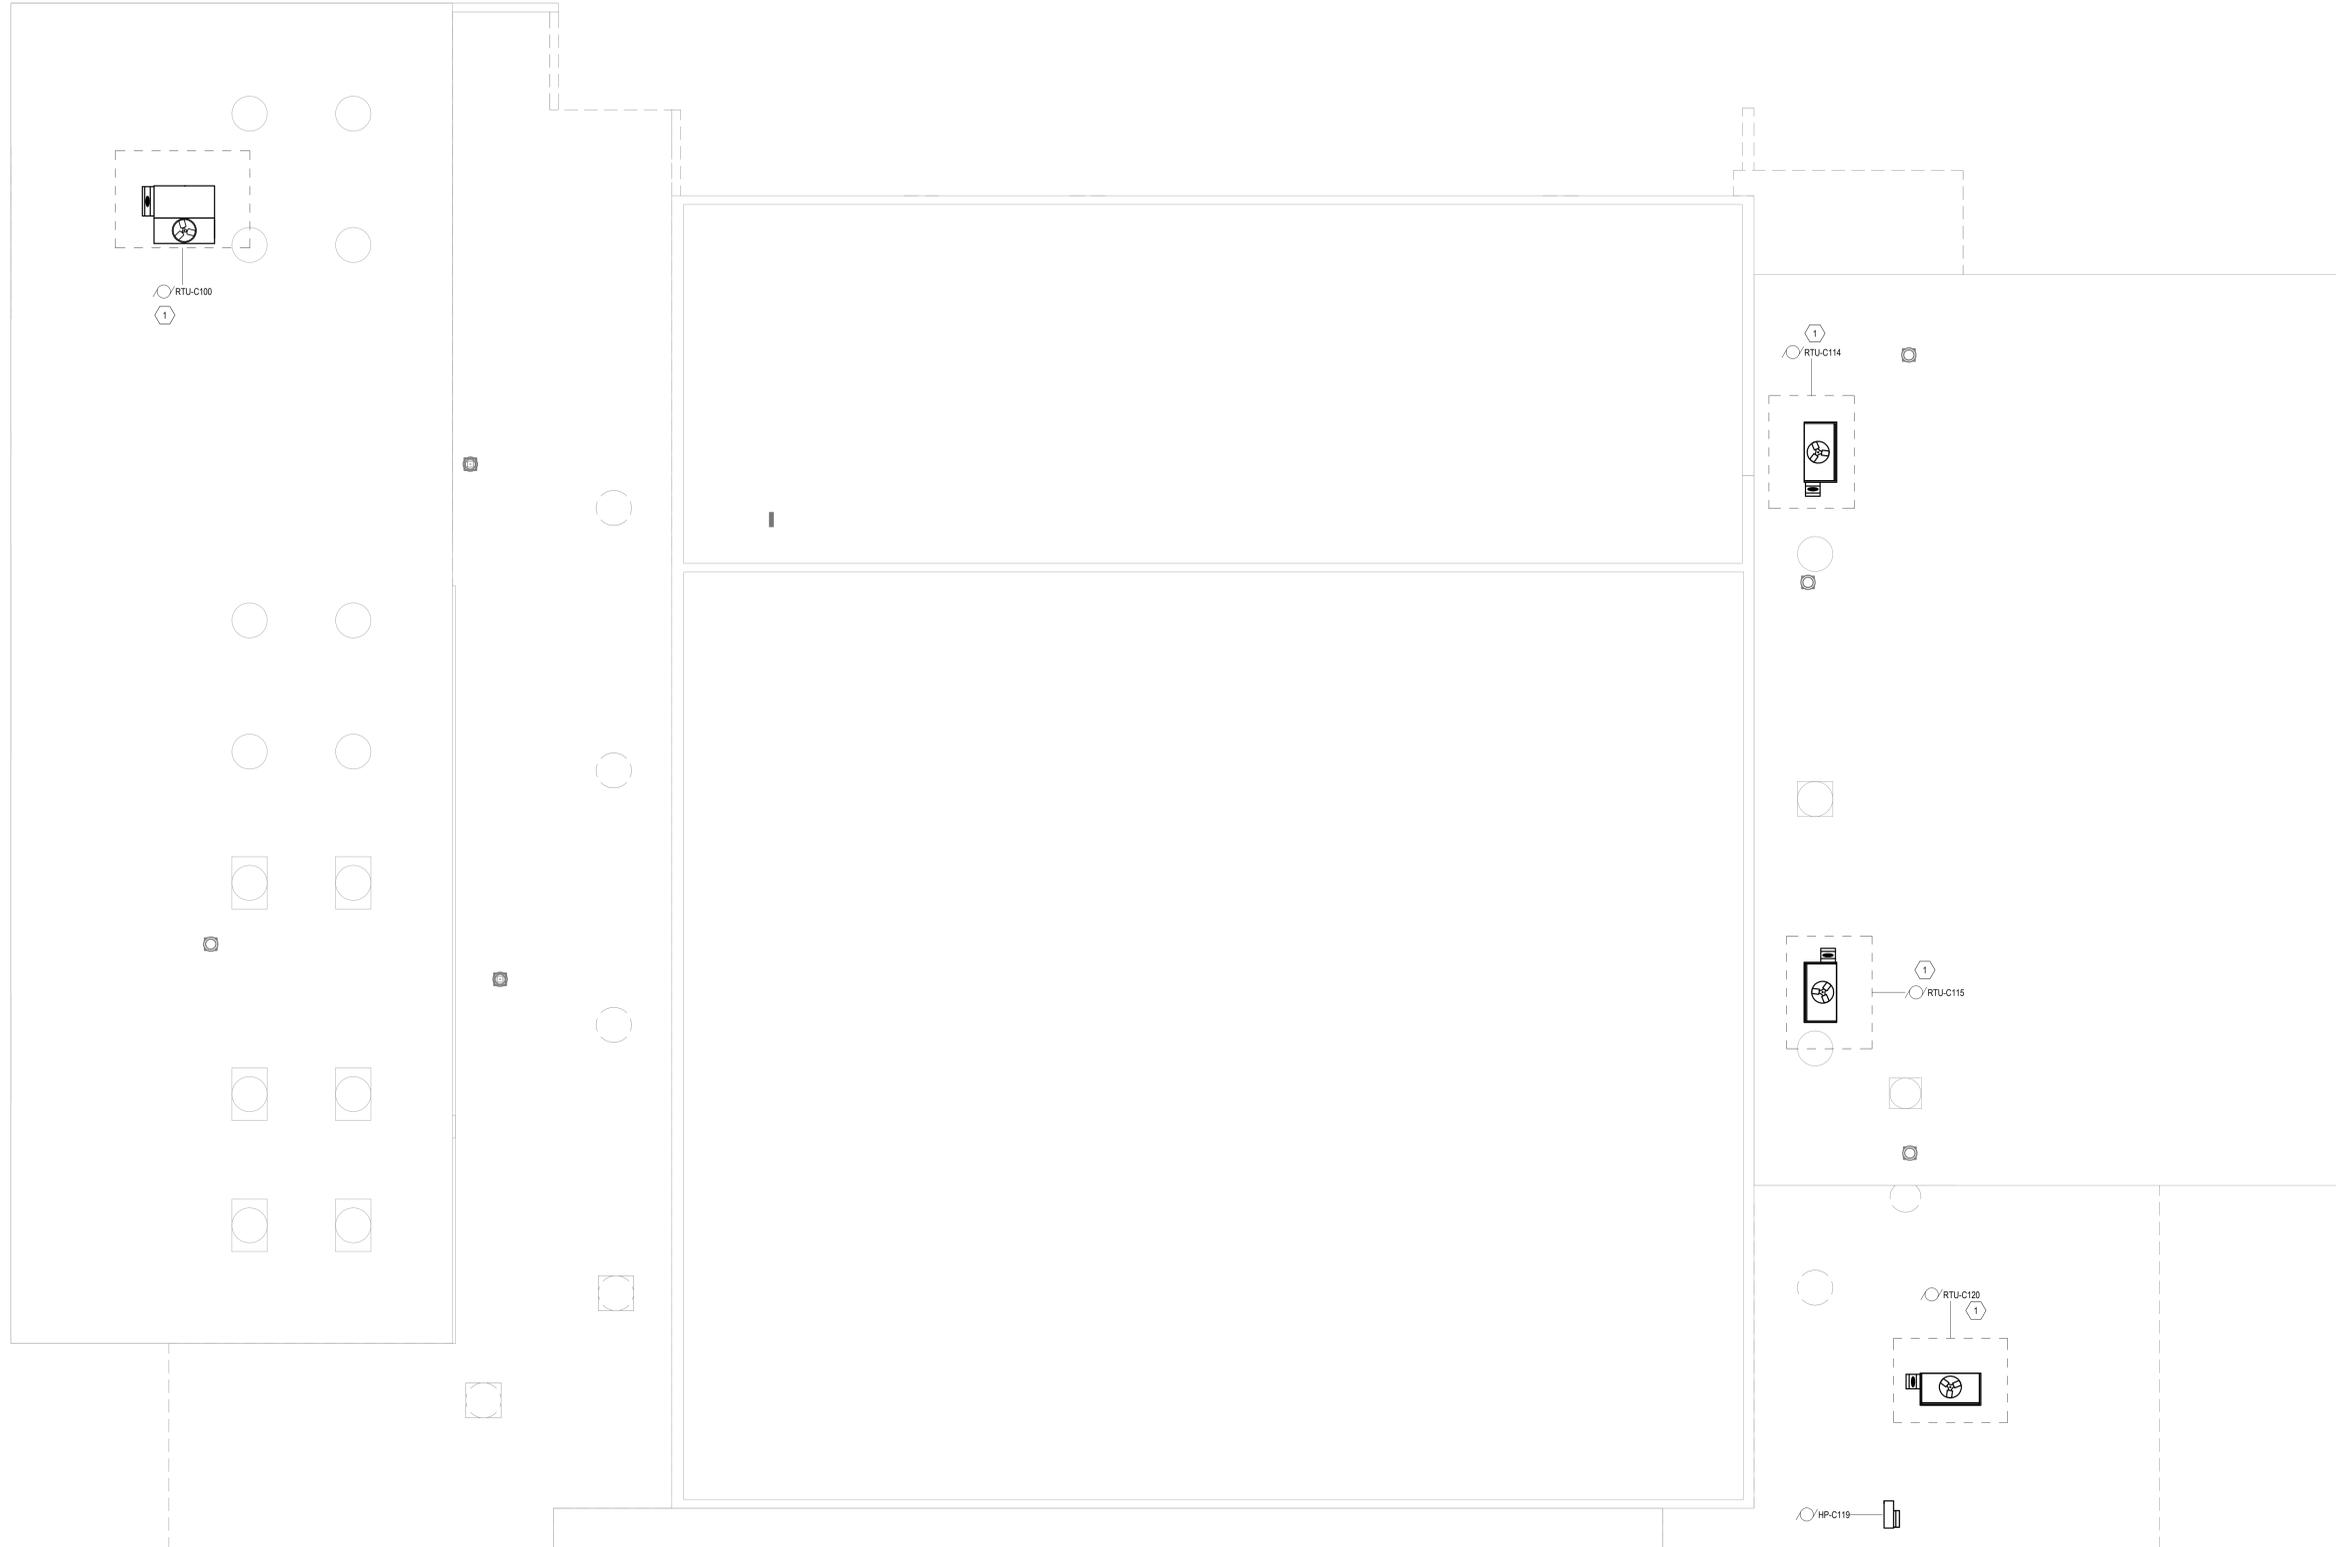

1 KEY PLAN
NOT TO SCALE

4/20/2022 11:02:31 AM
COPYRIGHT © 2022 ALL RIGHTS RESERVED

NORTH
1 ROOF POWER PLAN - AREA C
1/8" = 1'-0"