

ADDENDUM NO. 5

May 24, 2022

**LIBERTY INTERMEDIATE SCHOOL ADDITIONS
AND RENOVATIONS
Chesterton, IN 46304**

TO: ALL BIDDERS OF RECORD

This Addendum forms a part of and modifies the Bidding Requirements, Contract Forms, Contract Conditions, the Specifications, and the Drawings dated April 25, 2022 by Gibraltar Design. Acknowledge receipt of the Addendum in the space provided on the Bid Form. Failure to do so may subject the Bidder to disqualification.

This Addendum consists of Pages ADD 5-1 through ADD 5-2 and attached Addendum No. 5 from Gibraltar Design dated May 23, 2022 and consisting of 3 pages and 21 drawings.

A. SPECIFICATION SECTION 01 12 00 - MULTIPLE CONTRACT SUMMARY

1. BID CATEGORY NO. 2 – MASONRY

a. Add:

Section 07 21 13 Board Insulation (As Applicable)

b. Add:

Section 07 27 31 Air Infiltration Barrier (As Applicable)

c. Add:

Clarification No. 5:

Regarding Specification Section 07 21 13 – Board Insulation: The **Bid Category No. 2 Contractor** shall provide all Board Insulation at perimeter foundations walls in masonry cavity. The **Bid Category No. 3 Contractor** shall provide all other insulation in this specification.

2. **BID CATEGORY NO. 3 – ROOFING**

a. **Add:**

Clarification No. 8:

Regarding Specification Section 07 21 13 – Board Insulation: The **Bid Category No. 2 Contractor** shall provide all Board Insulation at perimeter foundations walls in masonry cavity. The **Bid Category No. 3 Contractor** shall provide all other insulation in this specification.

3. **BID CATEGORY NO. 5 – METAL STUDS/DRYWALL**

a. **Delete:**

Section 07 27 31 Air Infiltration Barrier (As Applicable)

ADDENDUM FIVE

Addendum Five (AD.05) to the drawings and specifications prepared by Gibraltar Design for **Liberty Intermediate School Additions and Renovations** for Duneland School Corporation, Chesterton, Indiana.

All Contractors bidding on this project shall read all of the items covered below and shall comply with all of the requirements as set forth, including any necessary refinements or additions generated by this Addendum and required by the intent of the original contract documents. All Contractors shall acknowledge on their bid form that they have received this Addendum, Addendum One, Addendum Two, Addendum Three, Addendum Four and include the appropriate content of same within their bid proposal.

SPECIFICATIONS

1. **Specification Section 23 73 00** **Interior Central Station Air Handling Units**
 - A. Paragraph 2.01, Add Johnson Controls to list of Acceptable Manufacturers.

DRAWINGS

2. **Sheet S-105**
 - A. Refer to revised full-size drawing included in this Addendum, for revisions.
3. **Sheet S-402**
 - A. Refer to revised full-size drawing included in this Addendum, for revisions.
4. **Sheets AD101, AD105, AD106**
 - A. Refer to Three (3) revised full-size drawings included in this Addendum, for revisions.
5. **Sheets A-102, A-105**
 - A. Refer to Two (2) revised full-size drawings included in this Addendum, for revisions.
6. **Sheets A-408**
 - A. Refer to revised full-size drawing included in this Addendum, for revisions.
7. **Sheets A-740**
 - A. Refer to revised full-size drawing included in this Addendum, for revisions.
 1. Change within Science Casework Schedule; Addition of Sink cabinet S4 includes hot and cold faucet. See schedule and elevations 65, 71 and 74.
8. **Sheets A-802, A-803, A-804**
 - A. Refer to Three (3) revised full-size drawings included in this Addendum, for revisions.
9. **Sheet MP104**
 - A. Refer to revised full-size drawing, included in this Addendum, for the following revisions.
 1. Added pressure regulator to gas piping to fume hood in science room.

10. Sheet MP105

- A. Refer to revised full-size drawing, included in this Addendum, for the following revisions.
1. Added gas piping to kitchen make-up air unit.

11. Sheet M-305

- A. Refer to revised full-size drawing, included in this Addendum, for the following revisions.
1. Added gas piping to make-up air unit.

12. Sheet M-501

- A. Refer to revised full-size drawing, included in this Addendum, for the following revisions.
1. Added UH-1 to mechanical equipment schedule.

13. Sheet M-502

- A. Refer to revised full-size drawing, included in this Addendum, for the following revisions.
1. Added schedule remarks for UH-1.
 2. Updated make-up air unit in as connection schedule.

14. Sheet M-602

- A. Refer to revised full-size drawing, included in this Addendum, for the following revisions.
1. Added 3-way chilled water diagram for unit ventilators.
 2. Added 2-way chilled water diagram for unit ventilators.
 3. Added note to include unit ventilators and fan coils on 2-way hot water coil piping diagram.
 4. Added note to include unit ventilators on 3-way hot water coil piping diagrams.

15. Sheet P-203

- A. Omit domestic hot water supply to lab sinks, LS-1, in Science Lab C-108, C-110, C-113, and C-115.
- B. Where applicable, omit domestic hot water return lines to lab sinks, LS-1 in Science Lab C-108, C-110, C-113, C-115.
- C. On lab sinks, LS-1 that have had domestic hot water services removed, omit reference to thermostatic mixing valves TW-1.
- D. Maintain domestic hot water supplies (and returns) to all emergency showers, EMSH-1 and lab sinks in Storage C-109 and C-114.

16. Sheet P-204

- A. Omit domestic hot water supply to lab sinks, LS-1, in Science Lab D-113, D-115, D-120 and D-122.
- B. Where applicable, omit domestic hot water return lines to lab sinks, LS-1 in Science Lab D-113, D-115, D-120, and D-122.
- C. On lab sinks, LS-1 that have had domestic hot water services removed, omit reference to thermostatic mixing valves TW-1.
- D. Maintain domestic hot water supplies (and returns) to all emergency showers, EMSH-1 and lab sinks in Storage C-109 and C-114.

17. Sheet E-002

- A. Refer to revised full-size drawing, included in this Addendum, for the following revisions.

1. Clarify note regarding temporary transformer pad.

18. Sheet EP-102

- A. Refer to revised full-size drawing, included in this Addendum, for the following revisions.
 1. Revise location of MDF associated receptacles and panels to B-139.
 2. Revise devices in Book Storage B-131.

19. Sheet TS-100

- A. Refer to revised full-size drawing, included in this Addendum, for the following revisions.
 1. Added Plan notes 1 and 2 that clarify the scope of work is just the pathways and that the Owner is responsible for relocating the existing aerial fiber.

20. Sheet T-641

- A. Remove the Drawing from the Bid set.


21. Sheet T-651

- A. Remove the Drawing from the Bid set.

Page 1 through 3, inclusive, and Twenty-One (21) Full-Size Drawings, constitute the total makeup of **Addendum Five**.



Y:\21-139 Duneland SC - Liberty Intermediate School Additions and Renovations\Specs\ADDENDUM FIVE\AD05.doc

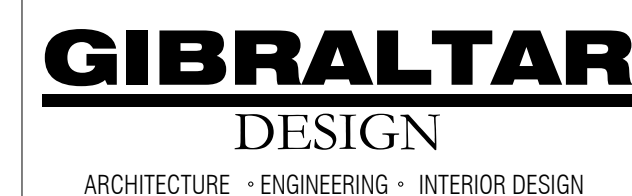

LIBERTY INTERMEDIATE SCHOOL - ADDITIONS & RENOVATIONS

FTG. MARK	FOOTING SIZE		FOOTING REINFORCING	
	WIDTH	DEPTH	LONGITUDINAL	TRANSVERSE
WF24	2'-0"	1'-2"	#5 x CONTINUOUS	#4 x 1'-6" @ 96" O.C.
WF30	2'-6"	1'-2"	#3 x CONTINUOUS	#4 x 2'-0" @ 96" O.C.
WF38	3'-0"	1'-2"	#3 x CONTINUOUS	#4 x 2'-6" @ 96" O.C.

1. CENTER FOOTINGS BENEATH WALLS, U.N.O.

2. REF. S-001 FOR STRUCTURAL NOTES. DESIGN DATA & SCHEDULES
3. ALL CONTRACTORS ARE REQUIRED TO COORDINATE THEIR WORK WITH ALL DISCIPLINES TO AVOID CONFLICTS. THE MECHANICAL, ELECTRICAL, AND PLUMBING ASPECTS ARE NOT IN THE SCOPE OF THESE DRAWINGS. THEREFORE, ALL REQUIRED MATERIALS AND WORK ARE NOT TO BE INDICATED.
3. COORDINATE EXACT SIZE & LOCATION OF ALL MECHANICAL OPENINGS IN FOUNDATION WALLS WITH THE MECHANICAL, ELECTRICAL, & PLUMBING CONTRACTORS.
4. ALL ELEVATIONS ARE REFERENCED FROM THE EXISTING FIRST FLOOR FINISH FLOOR ELEVATION OF ± 0.00 REF. CIV. DWGS
5. REF. ARCH. DRAWINGS FOR ALL DIMENSIONS NOT SHOWN. CONTRACTOR SHALL VERIFY ALL DIMENSIONS REQUIRED FOR CONSTRUCTION AND IMMEDIATELY NOTIFY ARCHITECT ENGINEER OF ANY DISCREPANCIES
6. REF. S-400 & S-401 FOR TYPICAL FOUNDATION DETAILS.
7. NOTE: PERIMETER WALL AND COLUMN FOOTINGS SHALL BE LOWERED AND/or SLEEVED TO EXISTING LEVELS (E.G. SANITARY & STORM SEWER, WATER LINES, ETC.) SHOWN ON THE PLUMBING DRAWINGS. PROVIDE FOOTING STEPS AS REQUIRED PER THE TYPICAL DETAILS ON S-400.
8. ALL SLAB RECESSES SHALL BE LOCATED PER THE ARCHITECTURAL DRAWINGS. COORDINATE POSITIONS OF ALL SLAB RECESSES WITH THE ARCHITECTURAL DRAWINGS AND/OR THE FLOORING SUPPLIER.
9. COORDINATE REINFORCING DOWELS FOR ALL VERTICAL REINFORCING WITH REIN. NOTES ON GRANT & CORES
10. GROUT ALL GAPS OF CUM BELOW FINISH FLOOR SOLID.
11. COLUMN FOOTINGS, TRENCH FOOTINGS AND WALL FOOTINGS SHALL BEAR ON APPROVED SOIL. UNDERLAY AS REQ'D TO SUFFICIENT BEARING MATERIAL, AS DETERMINED BY THE GEOTECHNICAL TESTING AGENCY. REF. TYPICAL FOOTING/DETAILS ON S-400.
12. COLUMN FOOTINGS SUPPORTING MORE THAN ONE COLUMN SHALL BE CENTERED AT THE MIDPOINT BETWEEN THE COLUMNS, UNLESS NOTED OTHERWISE ON PLAN.
13. PROVIDE CONTINUOUS 4×14 V. BARS CONCRETE CURB ON AC/OUTSIDE ISOLATION SLAB. PROVIDE 18" DIA. CURBS TO SURROUND ALL PENETRATIONS THRU SLAB INCLUDING COLUMNS, PIPES, SUMP PITS, ETC.
14. ALL EX. LAYOUT CONSTRUCTION SHOWN IN PLAN AND/OR SECTION WAS DERIVED FROM EXISTING DRAWINGS AND MUST BE FIELD VERIFIED. IF ANY DISCREPANCIES ARE OBSERVED CONTRACTOR MUST SHOW ON THE DRAWINGS AND ACTION CONDITIONS IMMEDIATELY CONTACT ARCHITECT/ENGINEER FOR DIRECTION BEFORE PROCEEDING WITH THE WORK.
15. PROVIDE THICKENED SLAB UNDER ALL EXTERIOR CUM WALLS WITHOUT FOOTINGS. SEE DETAIL DRAWING FOR THICKENED SLAB DETAIL. LAYOUT THICKENED SLAB FROM DIMENSIONS ON THE ARCHITECTURE FLOOR PLAN.
16. PROVIDE CONTRACTOR/CONTRACTOR JOINTS IN SLABS ON GRADE (REF. THE TYPICAL DETAILS ON SHEET S-400). ALL JOINTS IN SLABS TO RECEIVE THIN OR THICK SET TERRAZZO, CERAMIC OR PORCELAIN TILE. VINYL COMPOSITION TILE (CTC) OR VINYL SHEET FLOORING. FLOORING OVER FLOORING SHALL BE CAREFULLY COORDINATED WITH THE FLOORING CONTRACTOR. THE CONTRACTOR SHALL SUBMIT SLAB JOINT LAYOUT TO ARCHITECT/ENGINEER FOR REVIEW PRIOR TO PLACING SLABS.
17. WHERE PARS OCCUR WITHIN A LARGER ARCH. PLASTER OR CUM ENCLASURE FOR E.G. PARS OVER $40'$ SQUARE CANAL PLASTER PROVIDE PER REF. CAGE CENTERED ON THE EXTERIOR FACE OF THE PLASTER. PROVIDE PER REF. S-400 FOR ARCHITECTURAL PLASTER OR CUM ENCLASURE. LAYOUT PLASTER FROM DIMENSIONS ON THE ARCHITECTURE FLOOR PLAN & DETAILS.
18. AT ALL LOCATIONS WHERE NEW FOOTINGS ARE TO BE INSTALLED IN EXISTING SPACES REMOVED EXISTING CONCRETE SLABS AND/OR FOUNDATION WALLS. WALL FOOTINGS AS


FTG. MARK	FOOTING SIZE		FOOTING REINFORCING	
	WIDTH	DEPTH	LONGITUDINAL	TRANSVERSE
WF24	2'-0"	1'-2"	(2) #5 x CONTINUOUS	#4 x 1'-6" @ 96" O.C.
WF30	2'-6"	1'-2"	(3) #5 x CONTINUOUS	#4 x 2'-0" @ 96" O.C.
WF36	3'-0"	1'-2"	(3) #5 x CONTINUOUS	#4 x 2'-6" @ 96" O.C.

1. CENTER FOOTINGS BENEATH WALLS, U.N.O.



NOTES:

1. CENTER FOOTINGS BENEATH COLUMNS, U.N.O.
2. ALL FOOTINGS MUST BE BOARD-FORMED, UNLESS APPROVED.
3. INCREASE FOOTING DEPTH WHERE REQ'D TO ENCASE COLUMN ANCHOR RODS

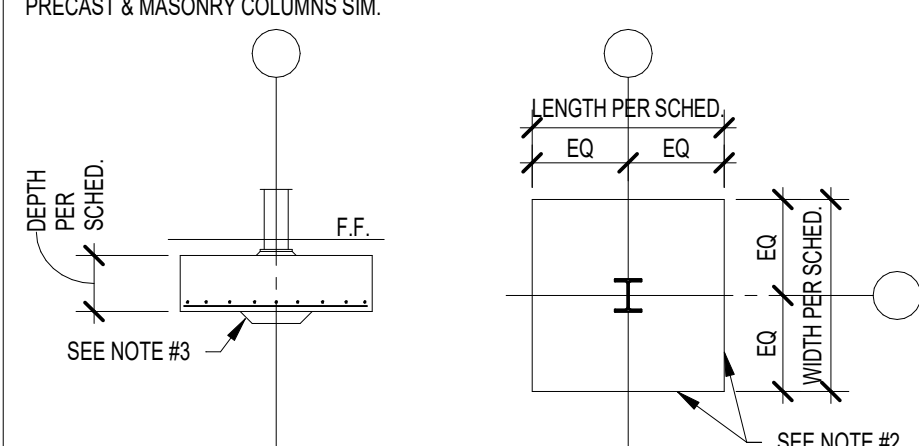

PROJECT
LIBERTY IS - ADDITIONS &
RENOVATIONS

© GIBALTAR DESIGN

SHEET


F

S-105




LIBERTY INTERMEDIATE SCHOOL - ADDITIONS & RENOVATIONS


4 FOUNDATION SECTION
3/4" = 1'-0"

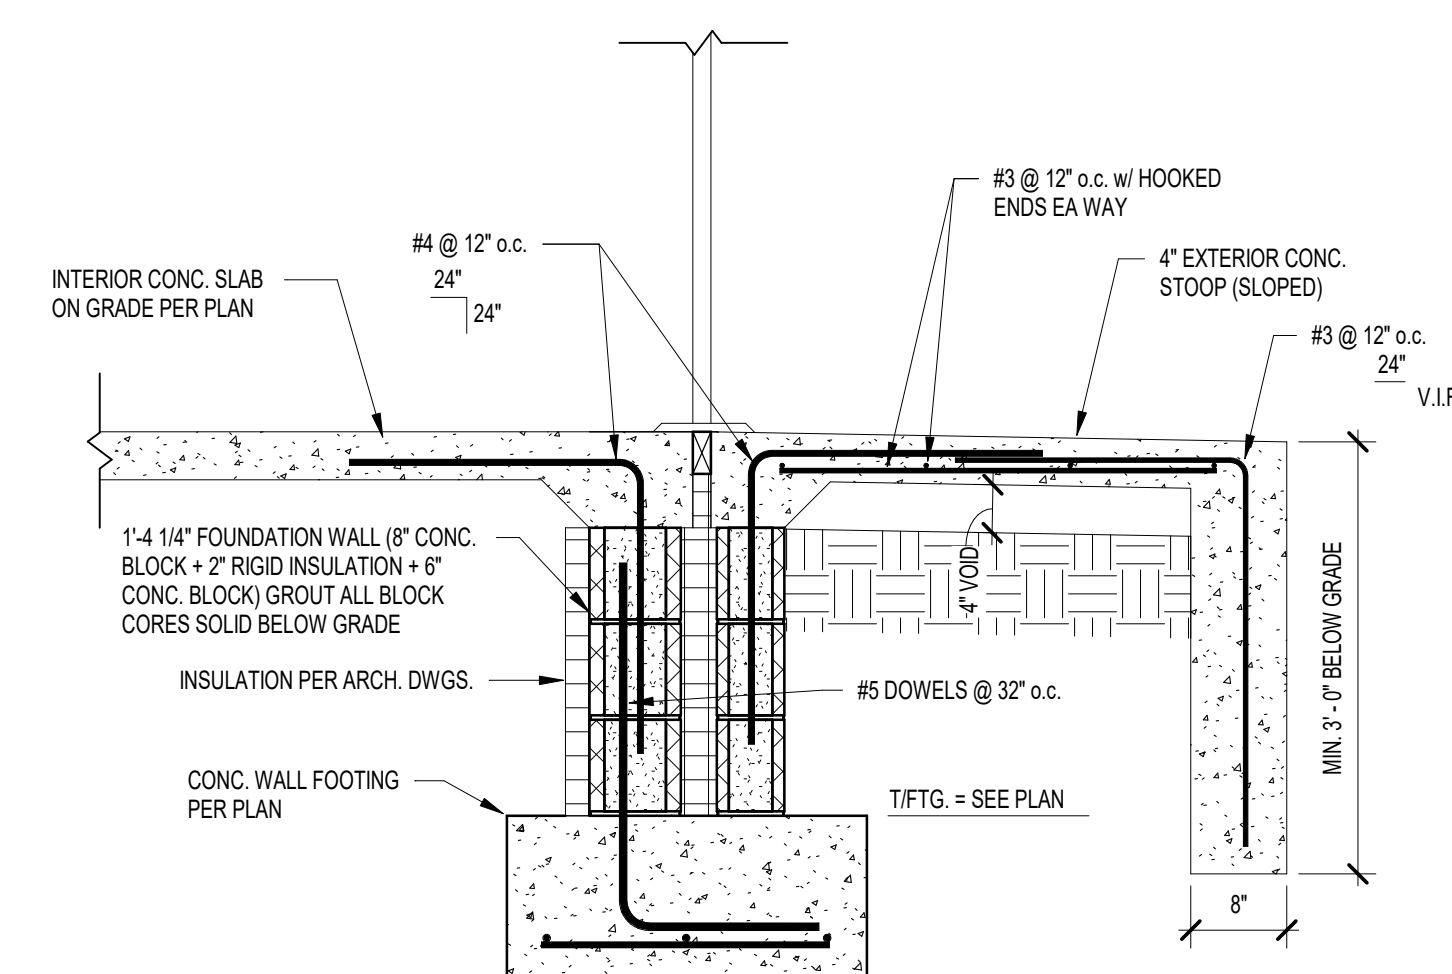


3 FOUNDATION SECTION
3/4" = 1'-0"

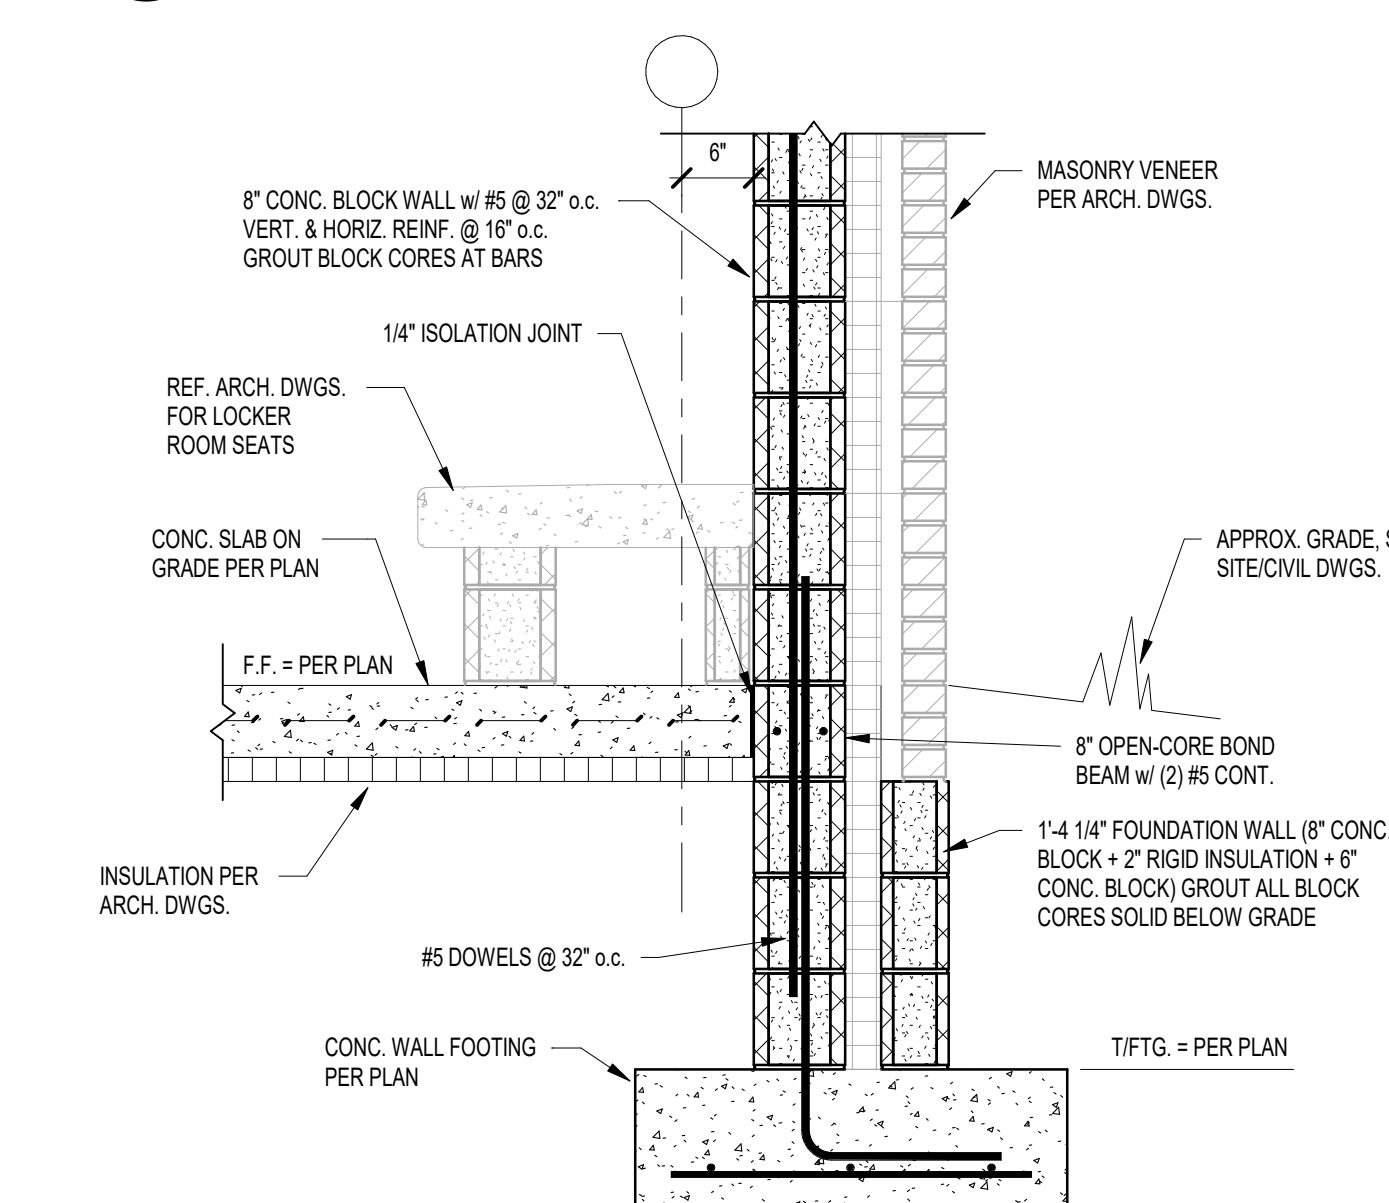


2 FOUNDATION SECTION
3/4" = 1'-0"

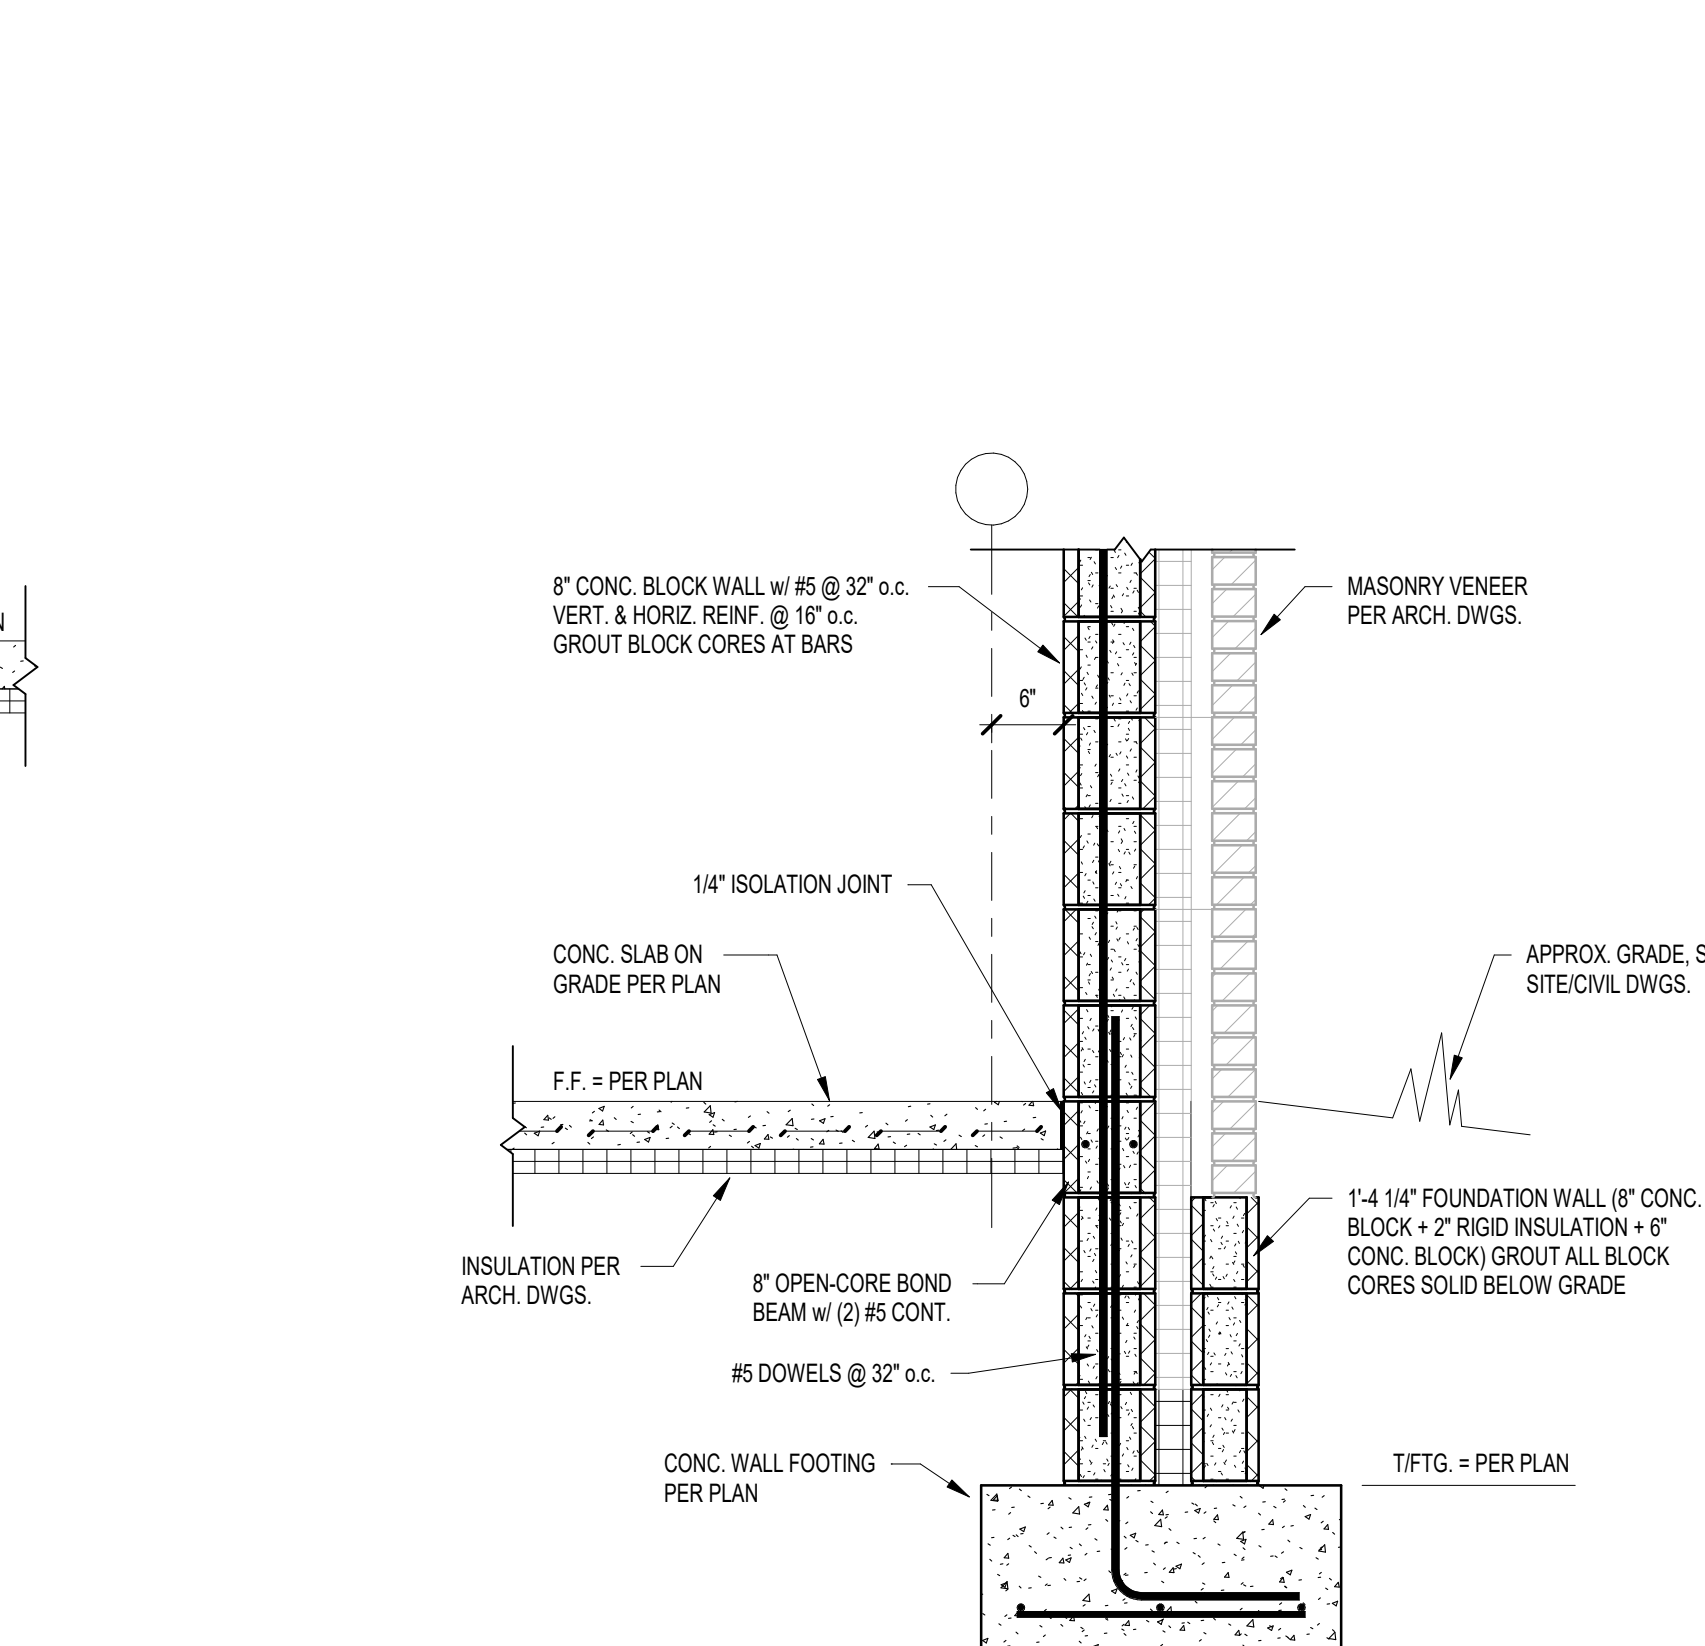


7 FOUNDATION SECTION
3/4" = 1'-0"

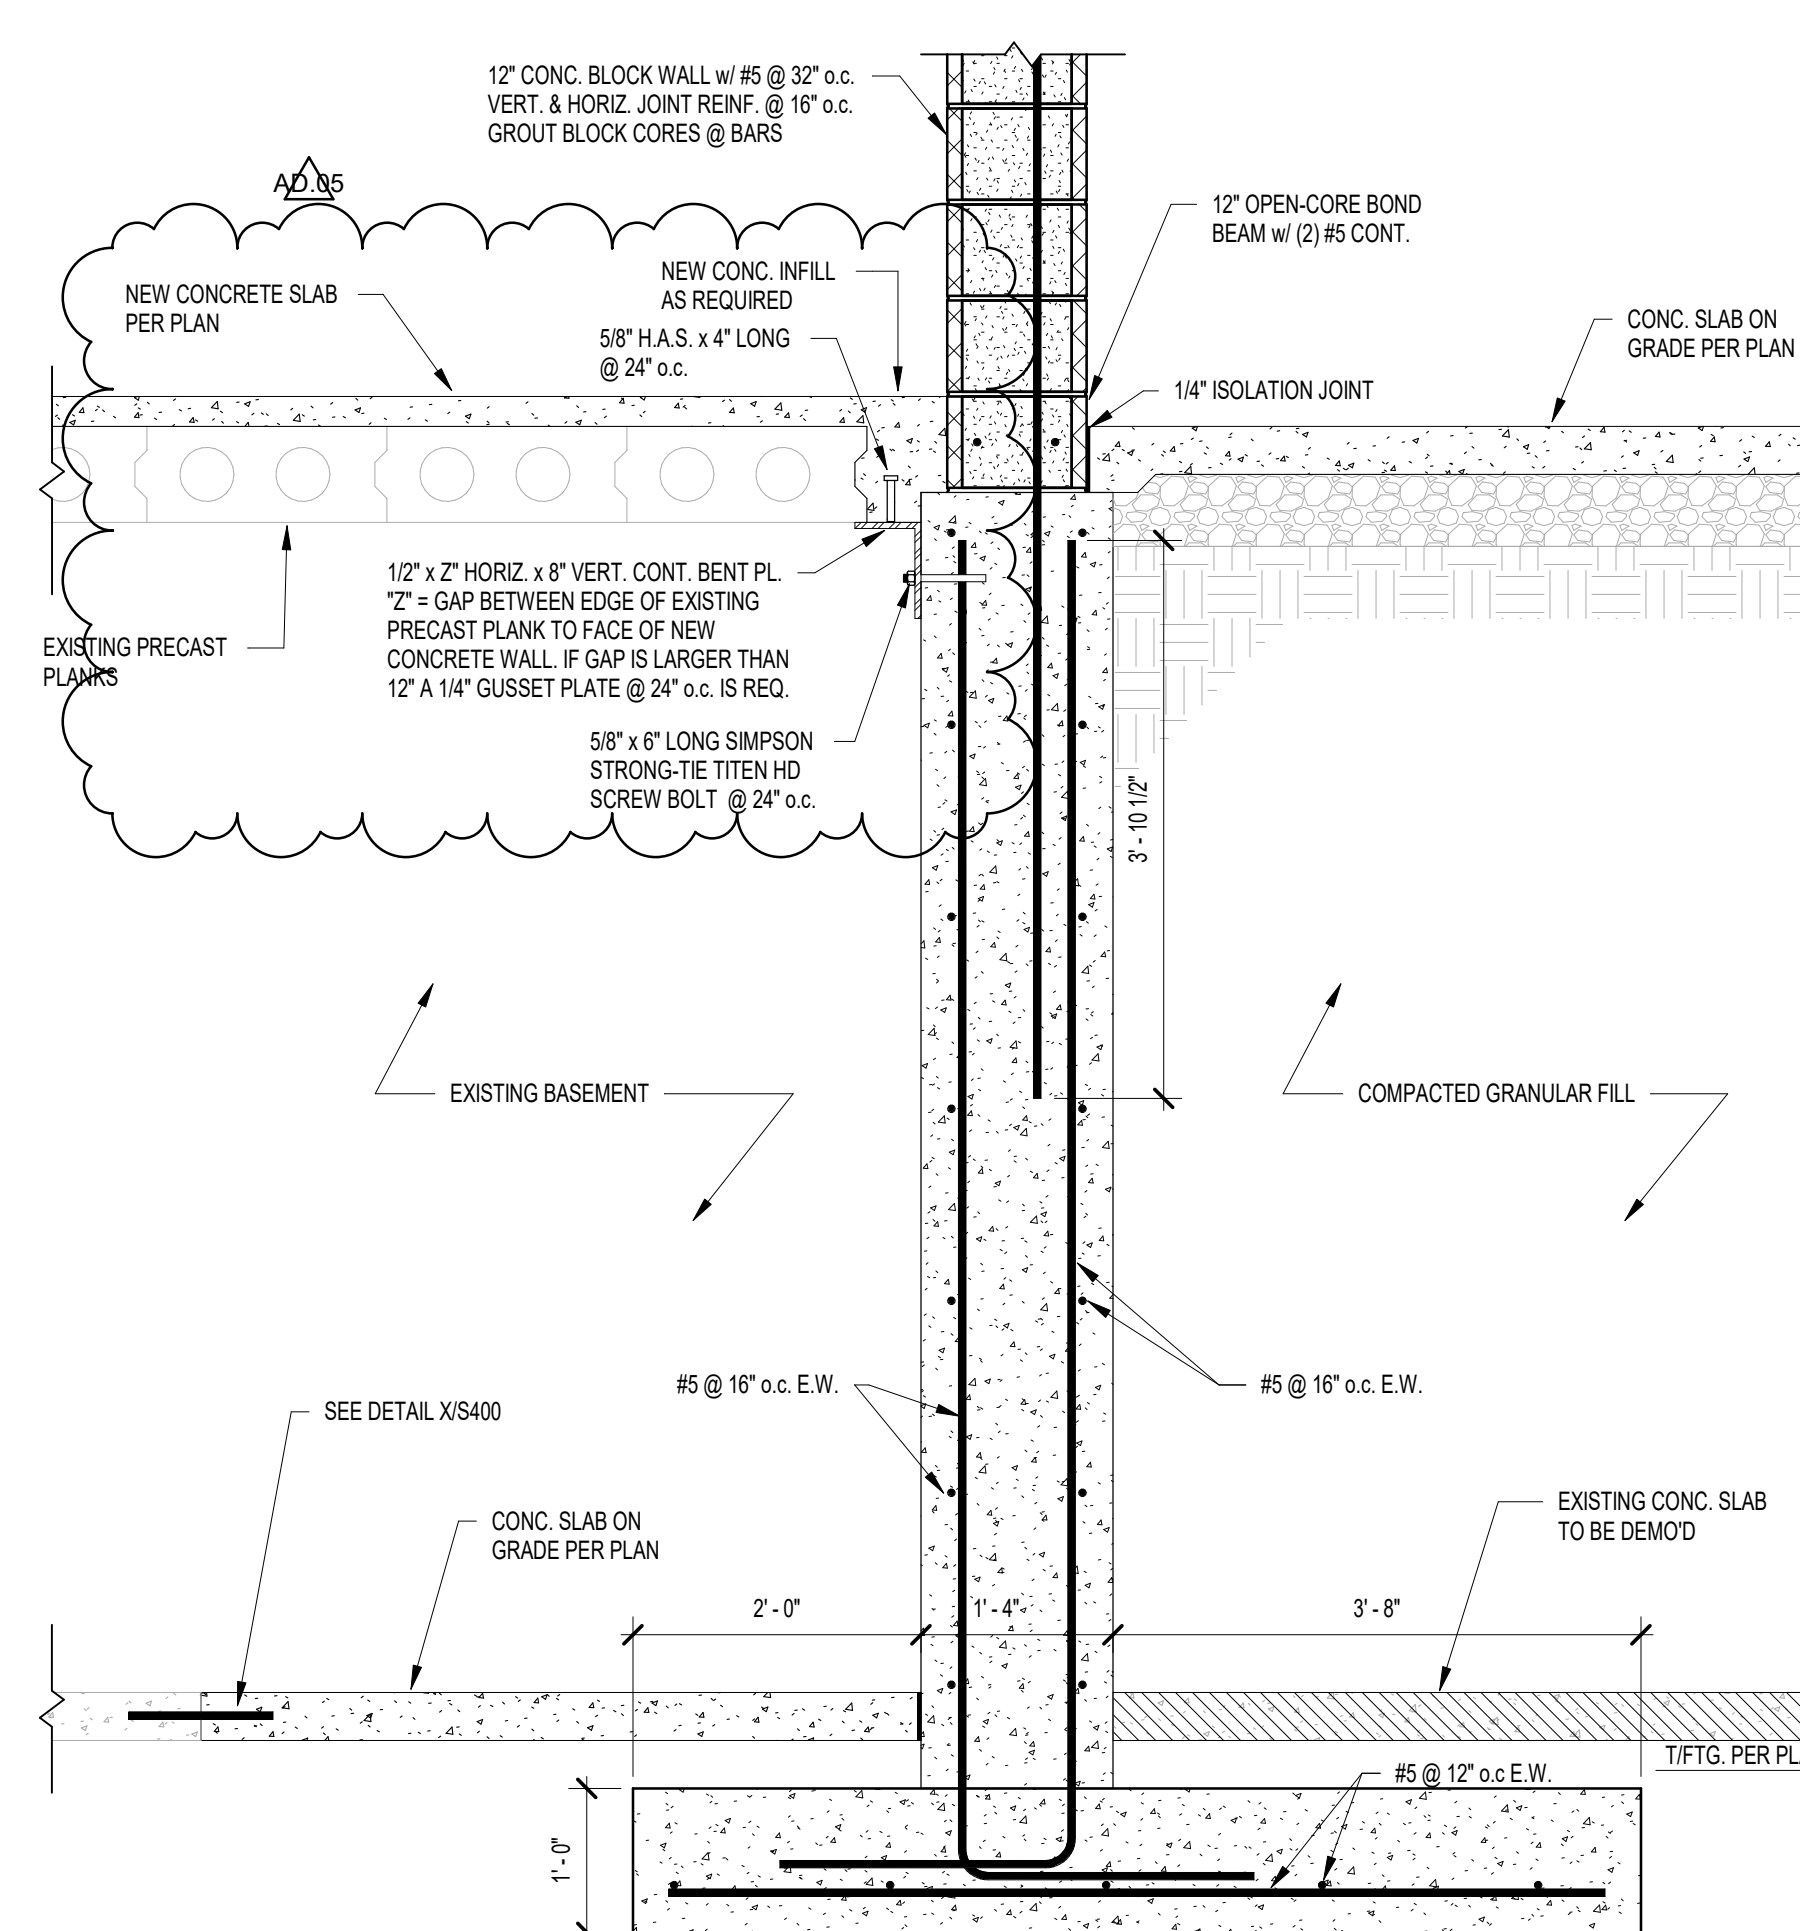


6 FOUNDATION SECTION
3/4" = 1'-0"

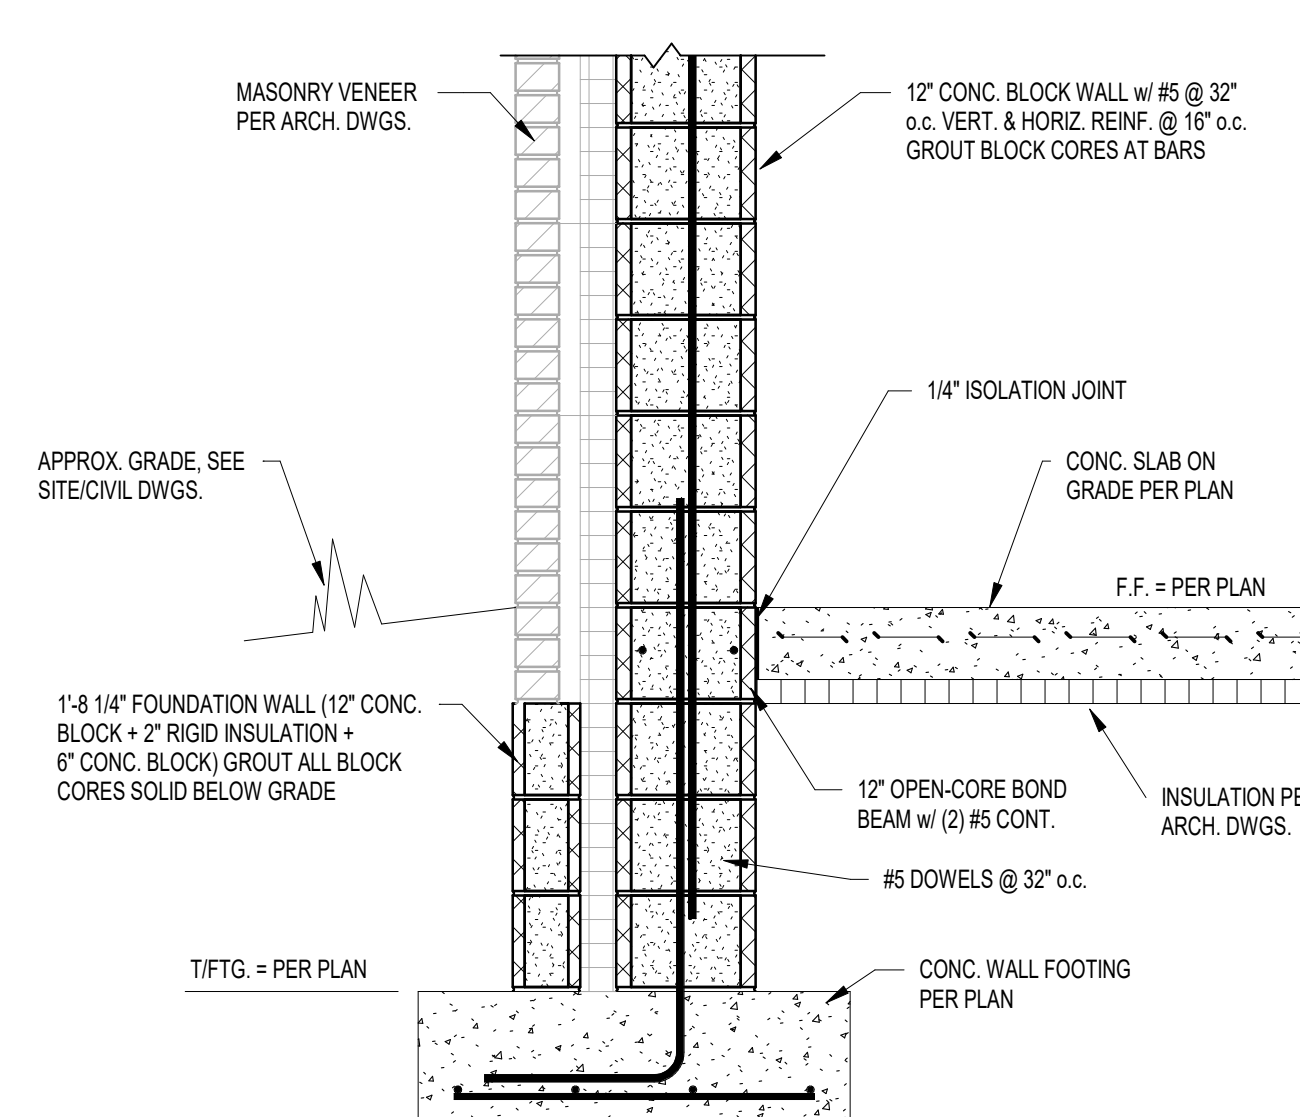


5 FOUNDATION SECTION
3/4" = 1'-0"

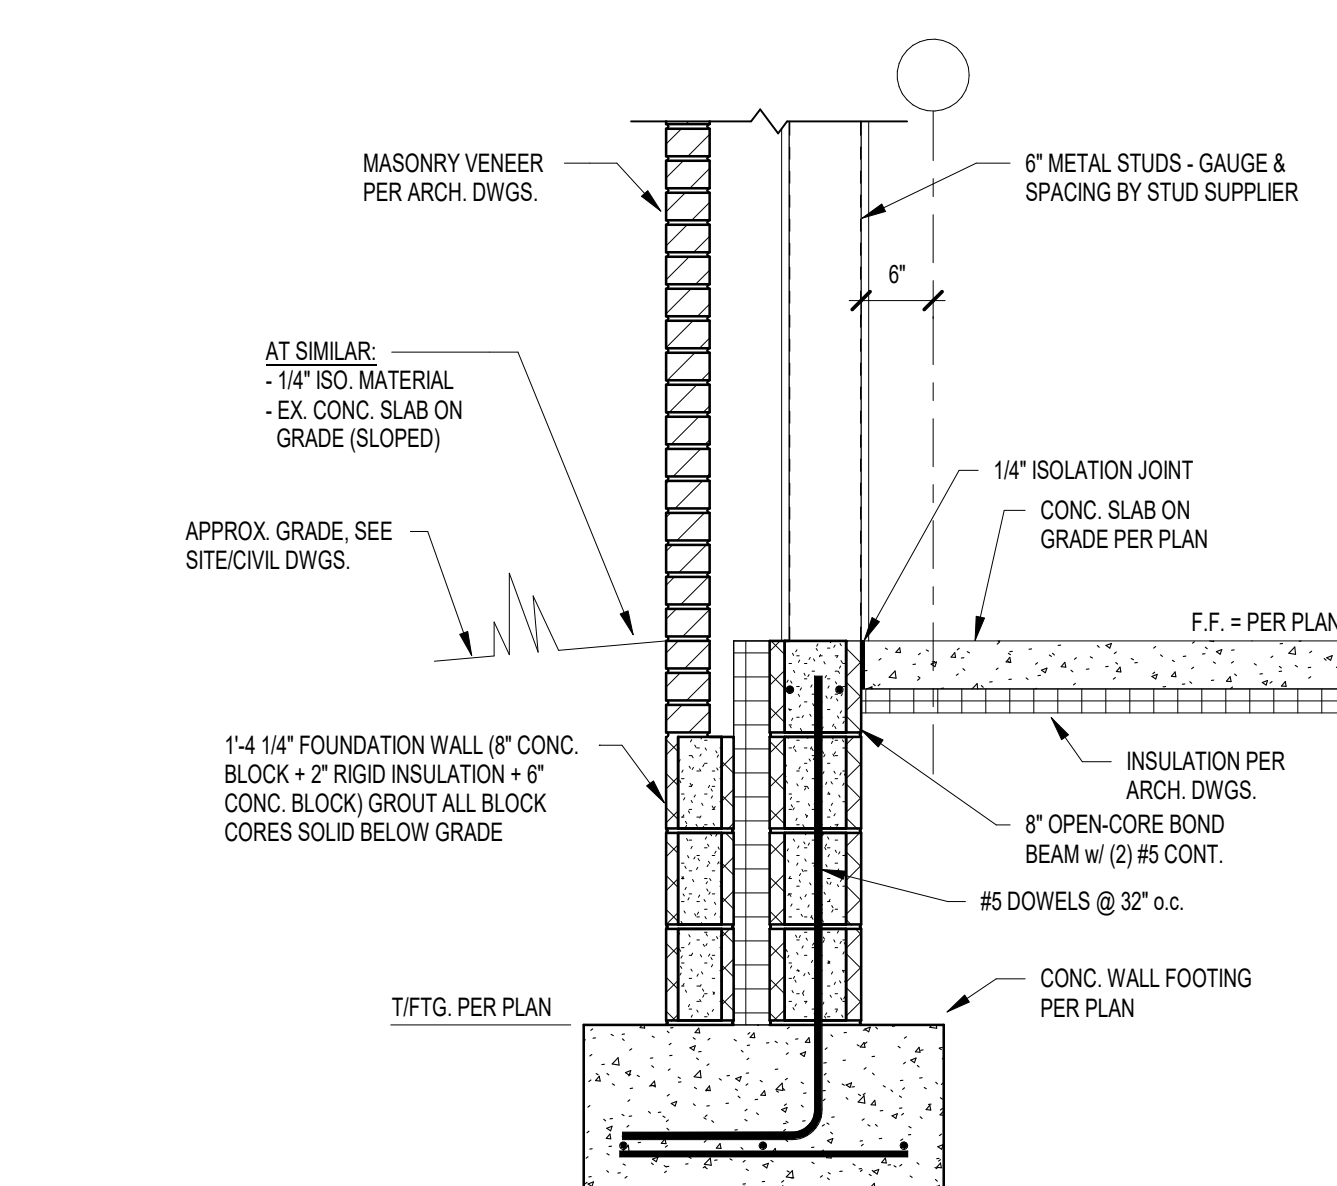


11 FOUNDATION SECTION
3/4" = 1'-0"

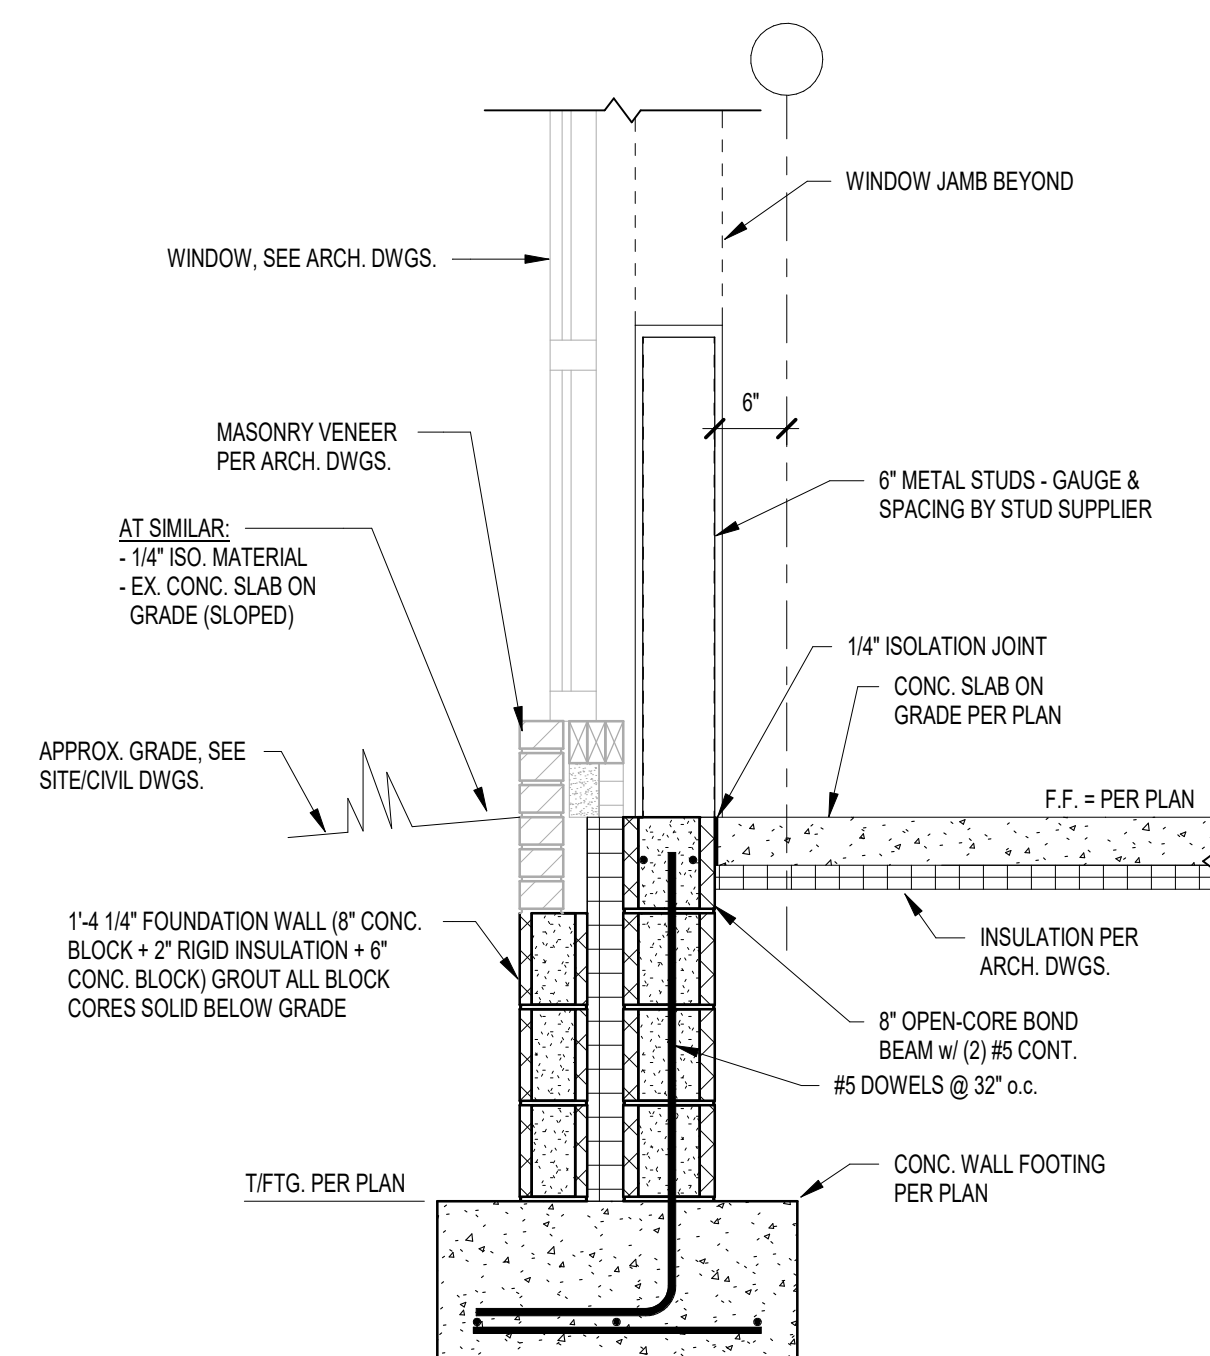


10 FOUNDATION SECTION
3/4" = 1'-0"

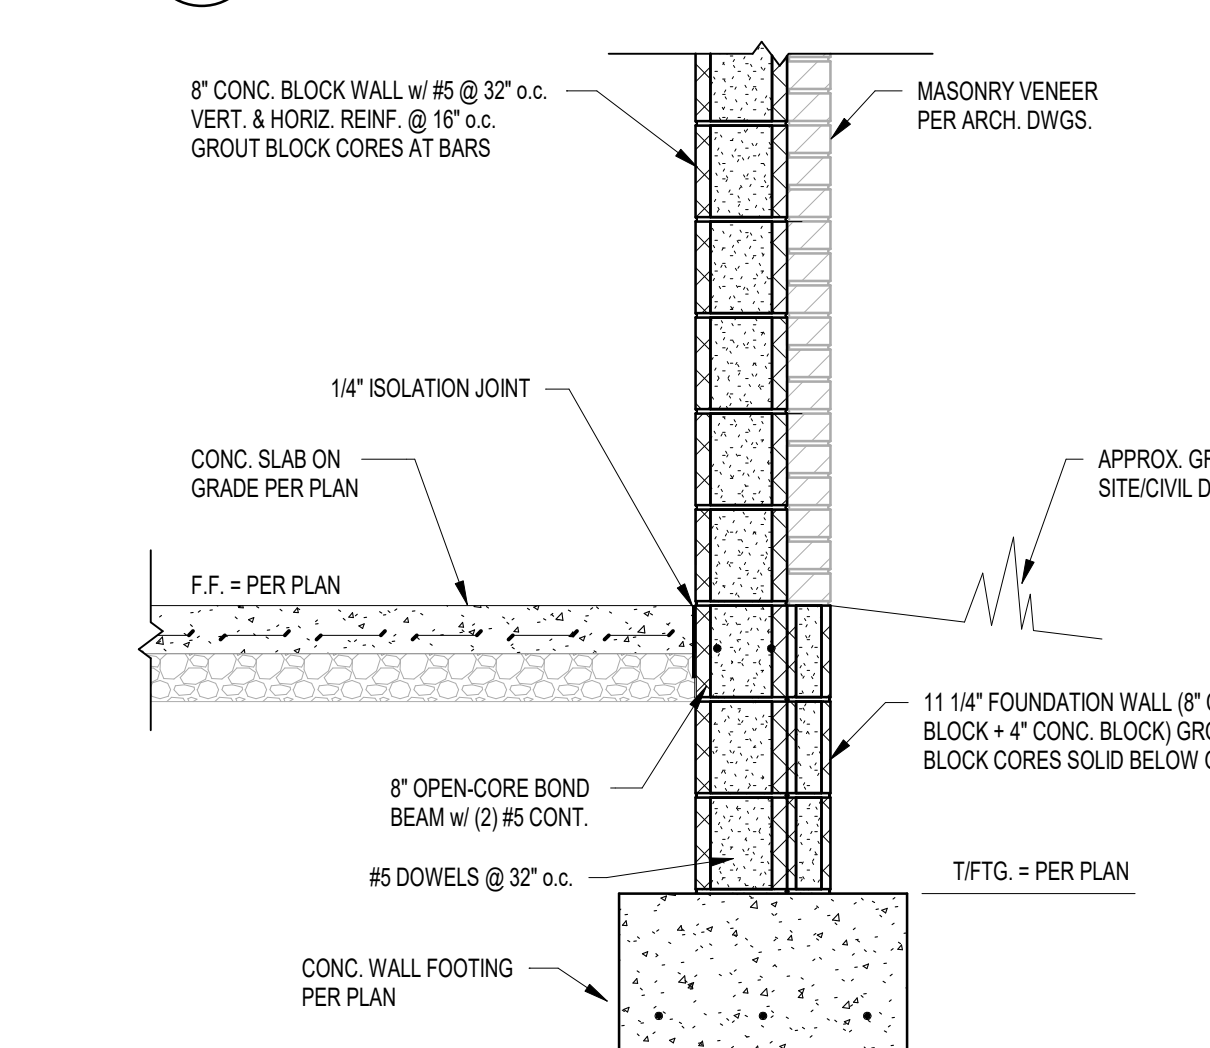


9 FOUNDATION SECTION
3/4" = 1'-0"

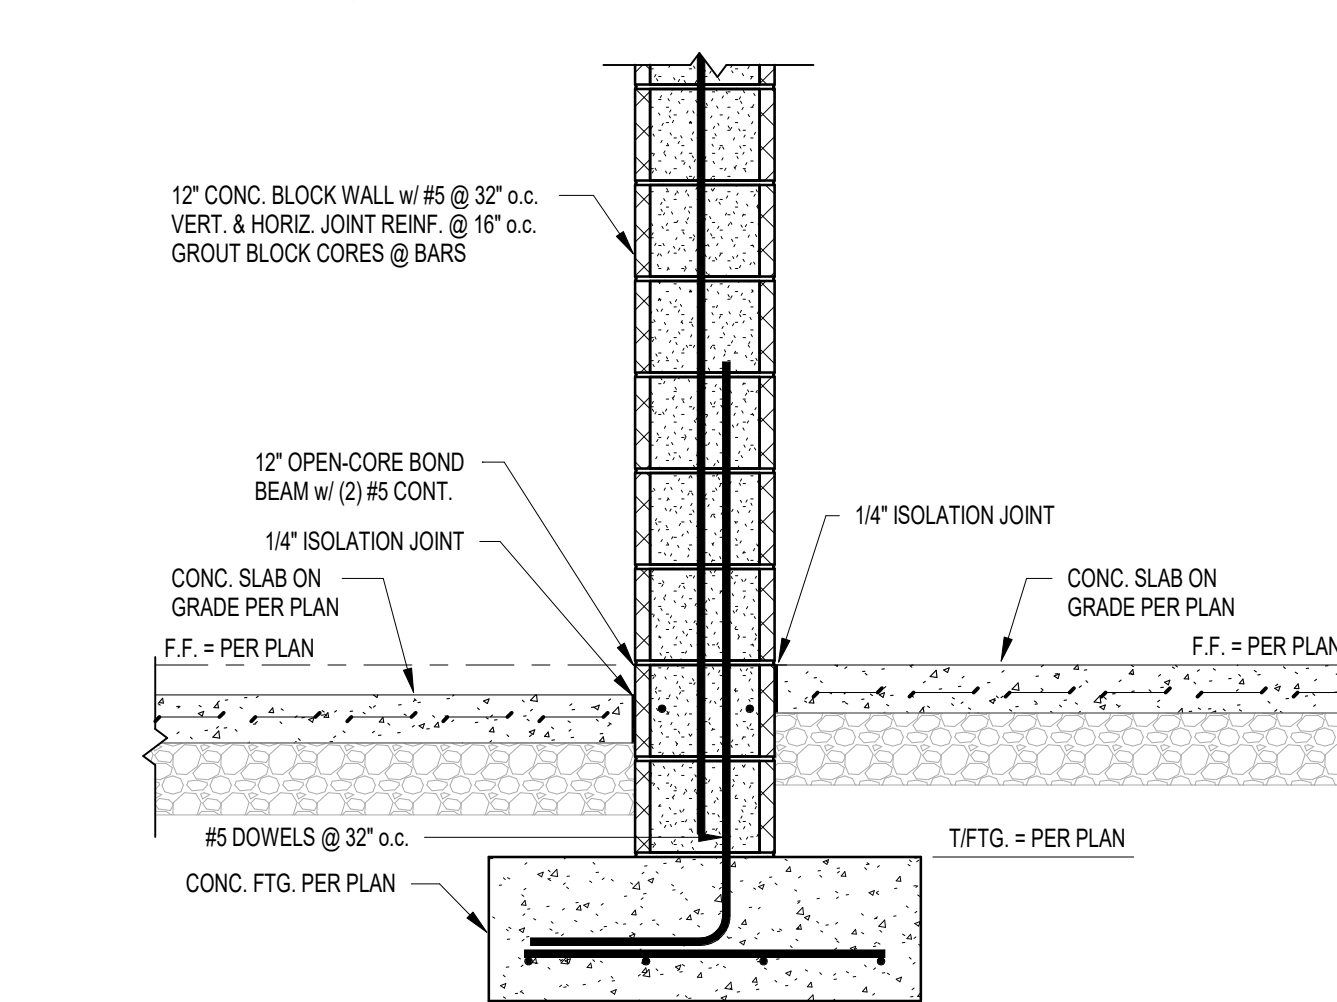


8 FOUNDATION SECTION
3/4" = 1'-0"

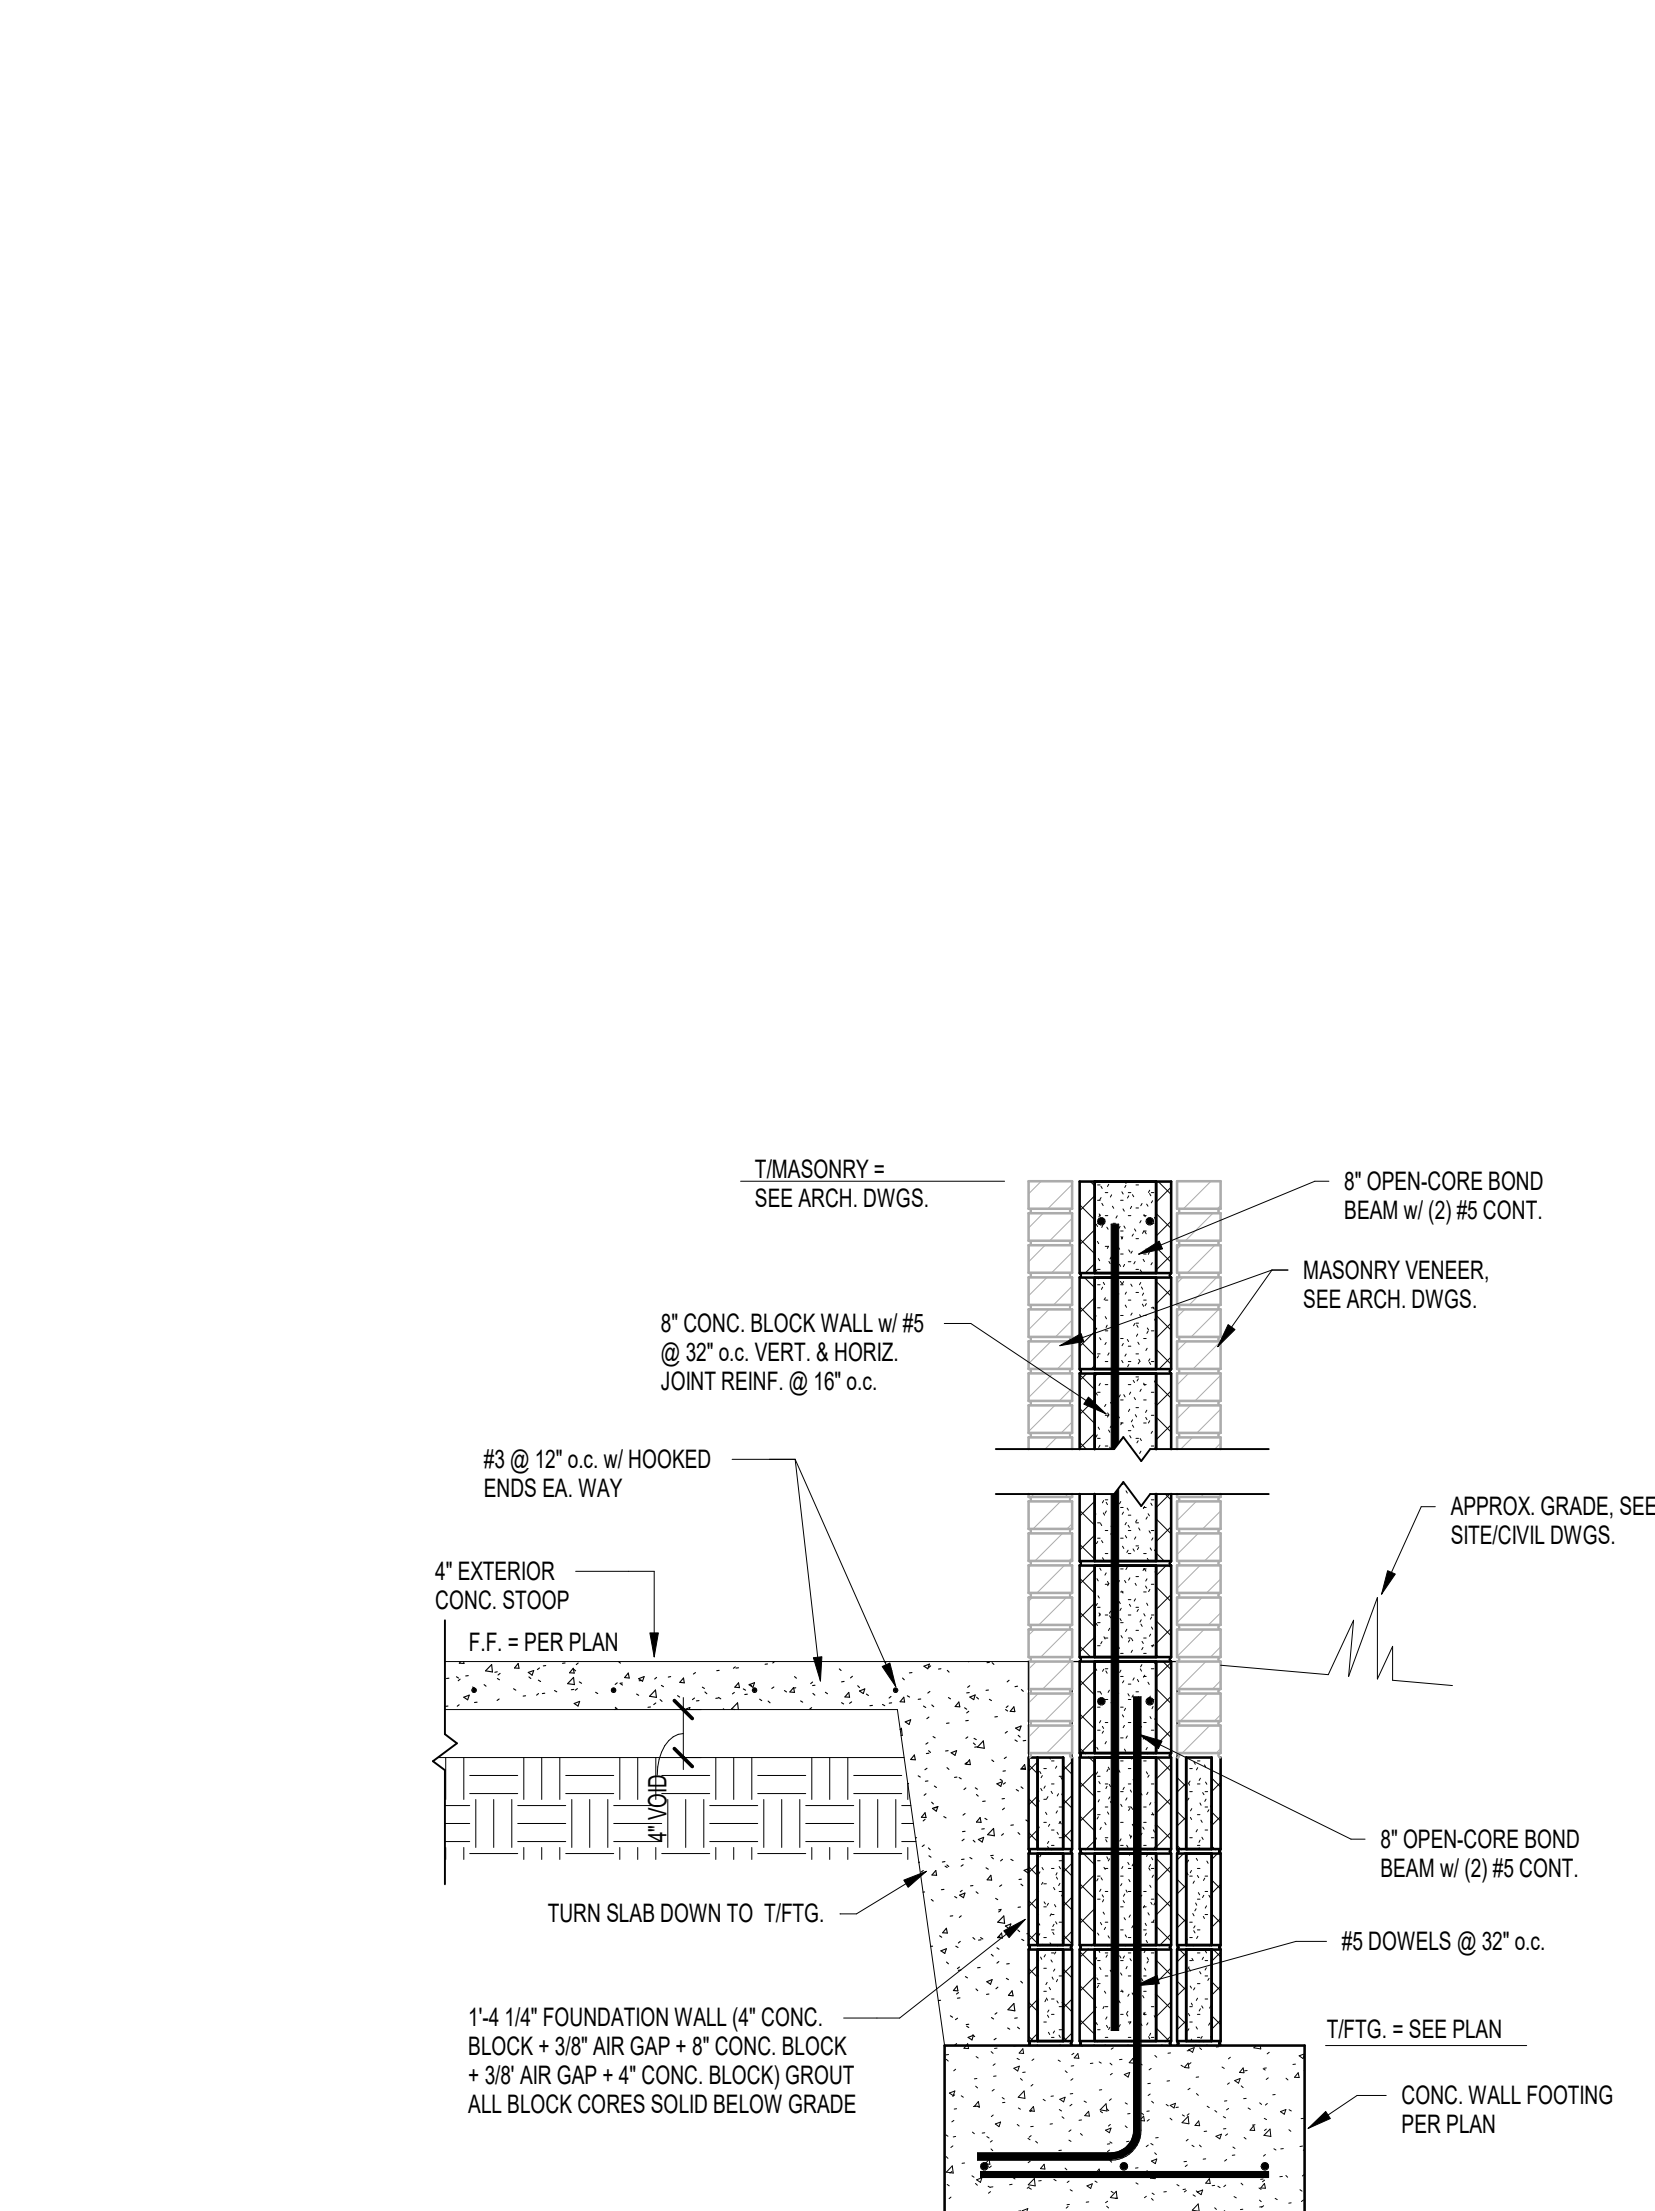

14 FOUNDATION SECTION
3/4" = 1'-0"

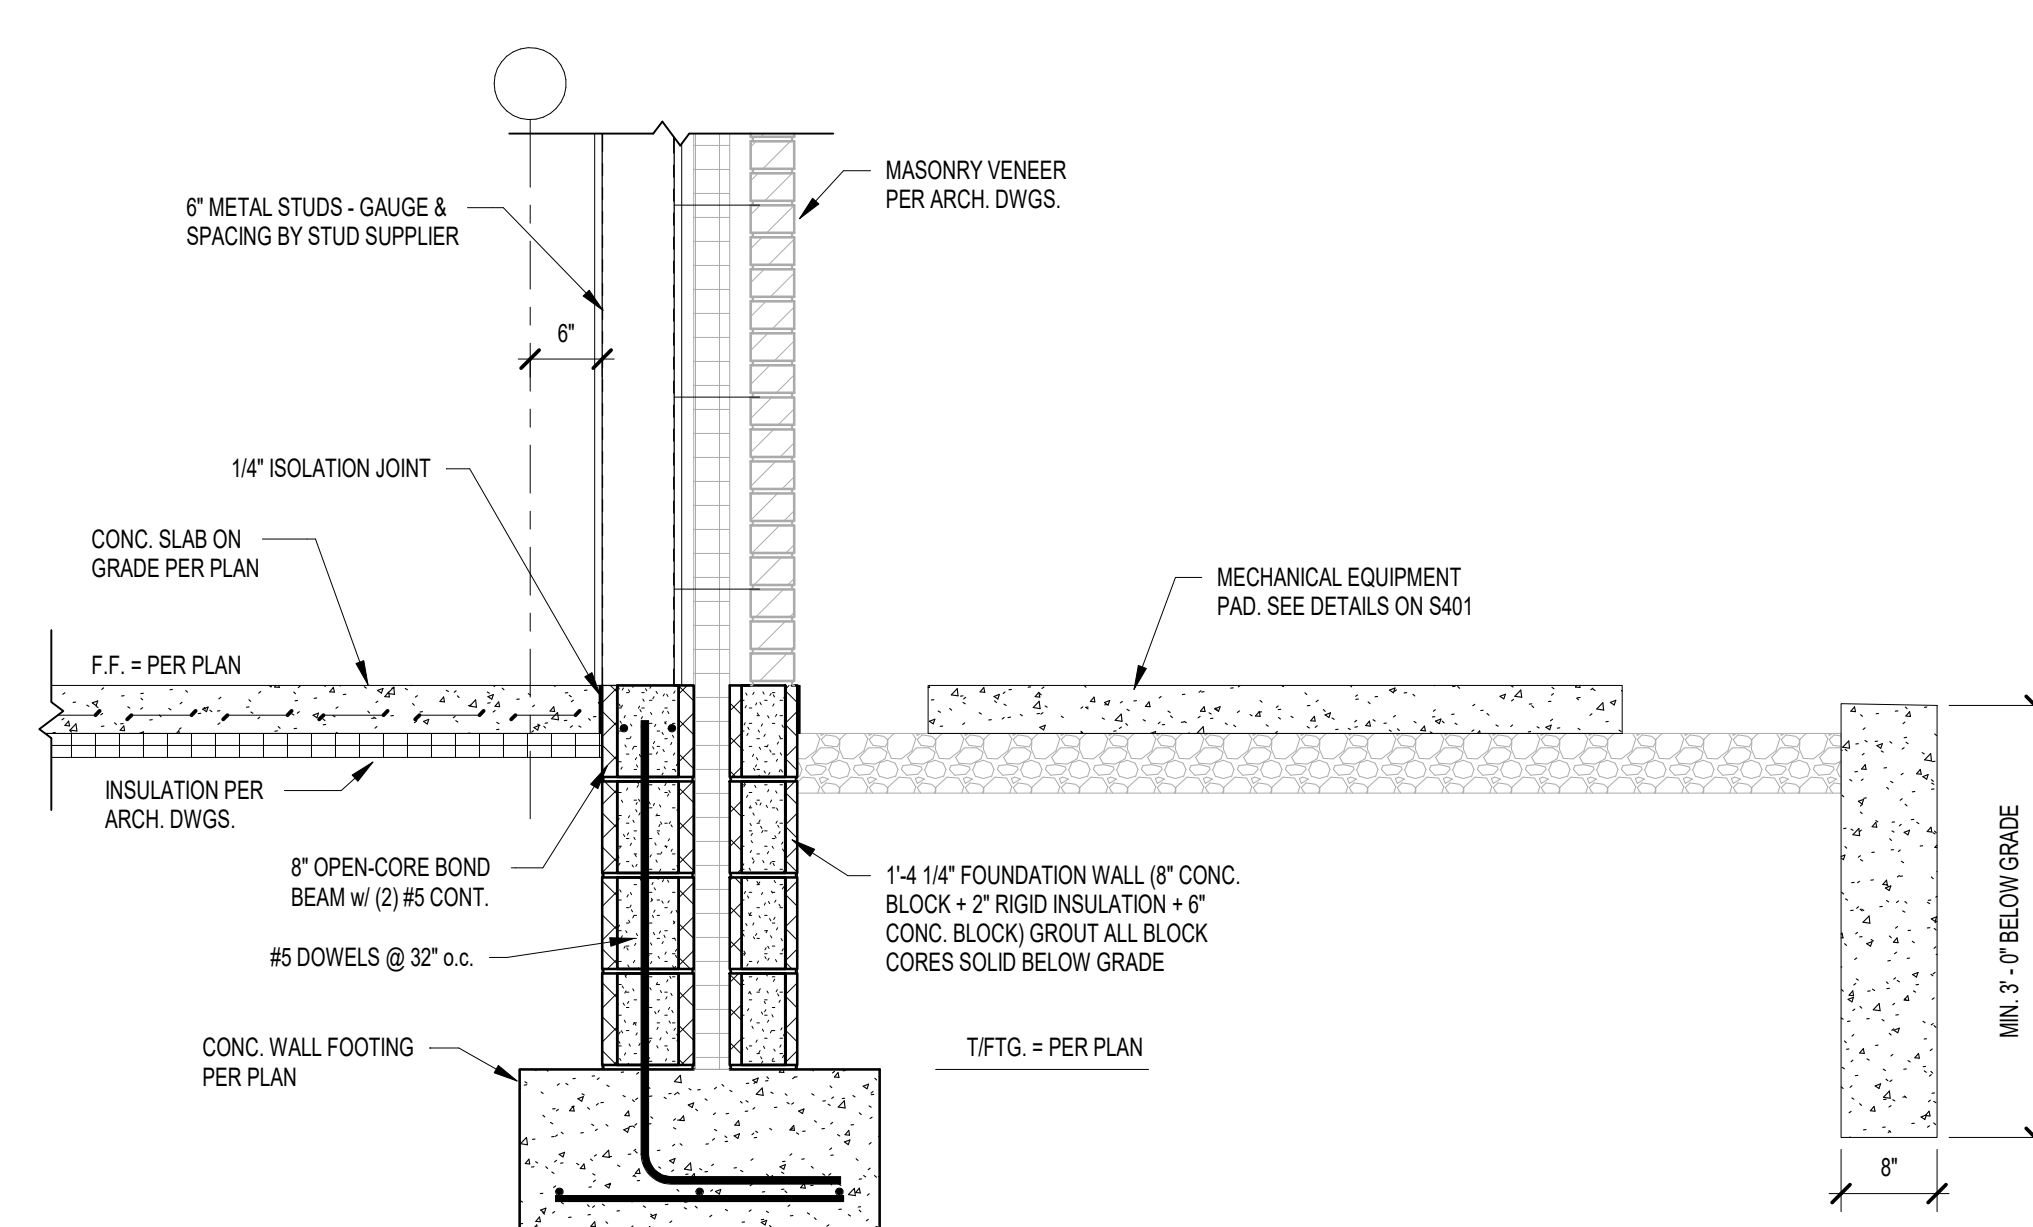

13 FOUNDATION SECTION
3/4" = 1'-0"

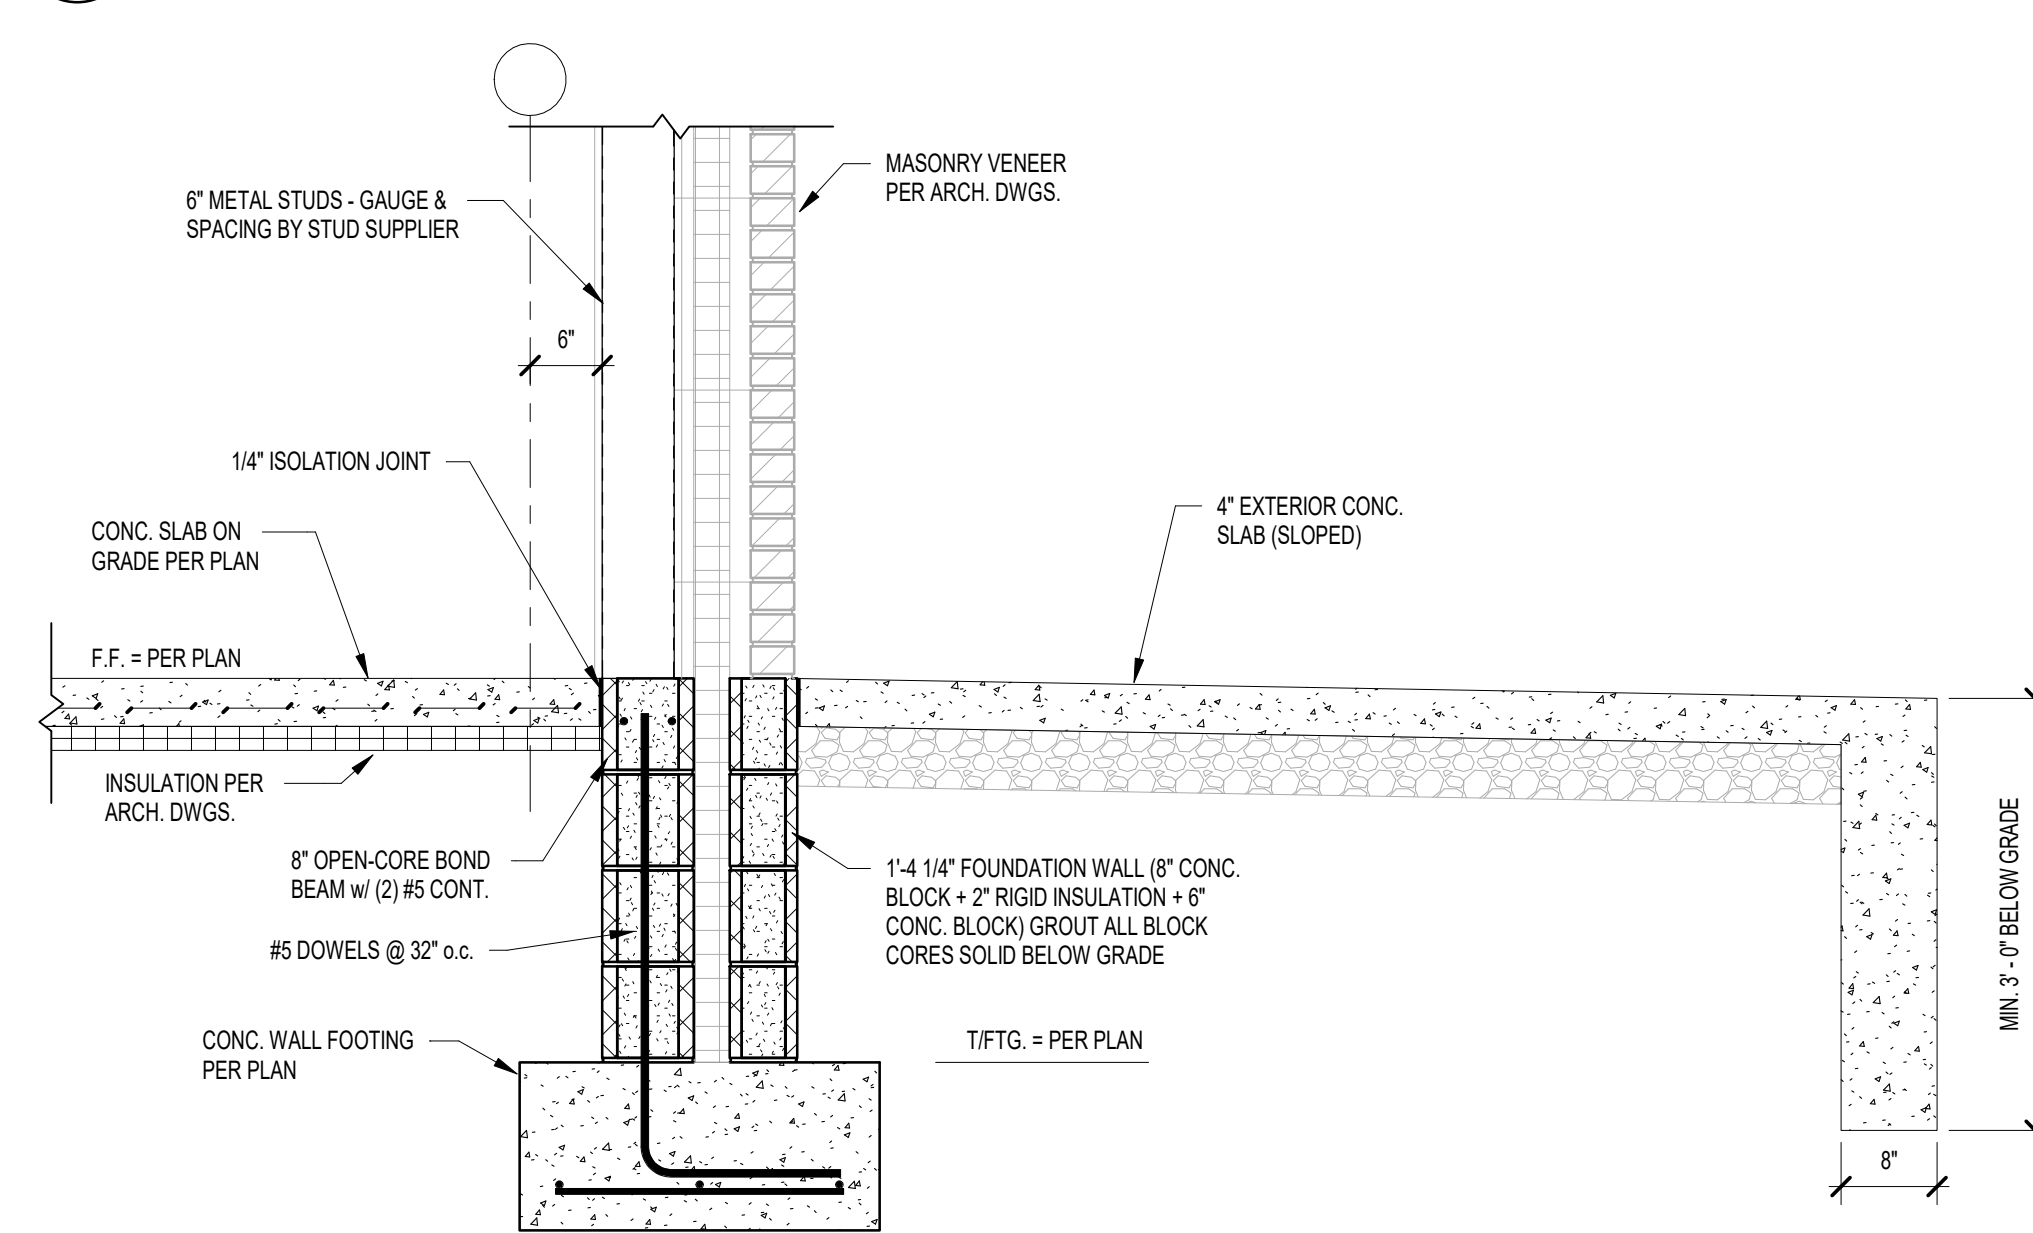


12 FOUNDATION SECTION
3/4" = 1'-0"

9102 N. Meridian St., Ste. 300
Indianapolis, IN 46260
Homepage www.GibraltarDesign.com
Email info@GibraltarDesign.com
Phone 317.580.5777 Fax 317.580.5778

© GIBALTAR DESIGN


S-402

Friday, 5/20/2022 - 10:25 AM - LAST SAVED BY KIMMONS
Y:\21-139 DUNELAND SC - LIBERTY INTERMEDIATE SCHOOL
ADDITIONS AND RENOVATIONS\21-139 DRAWINGS\05
ARCH\0101.DWG

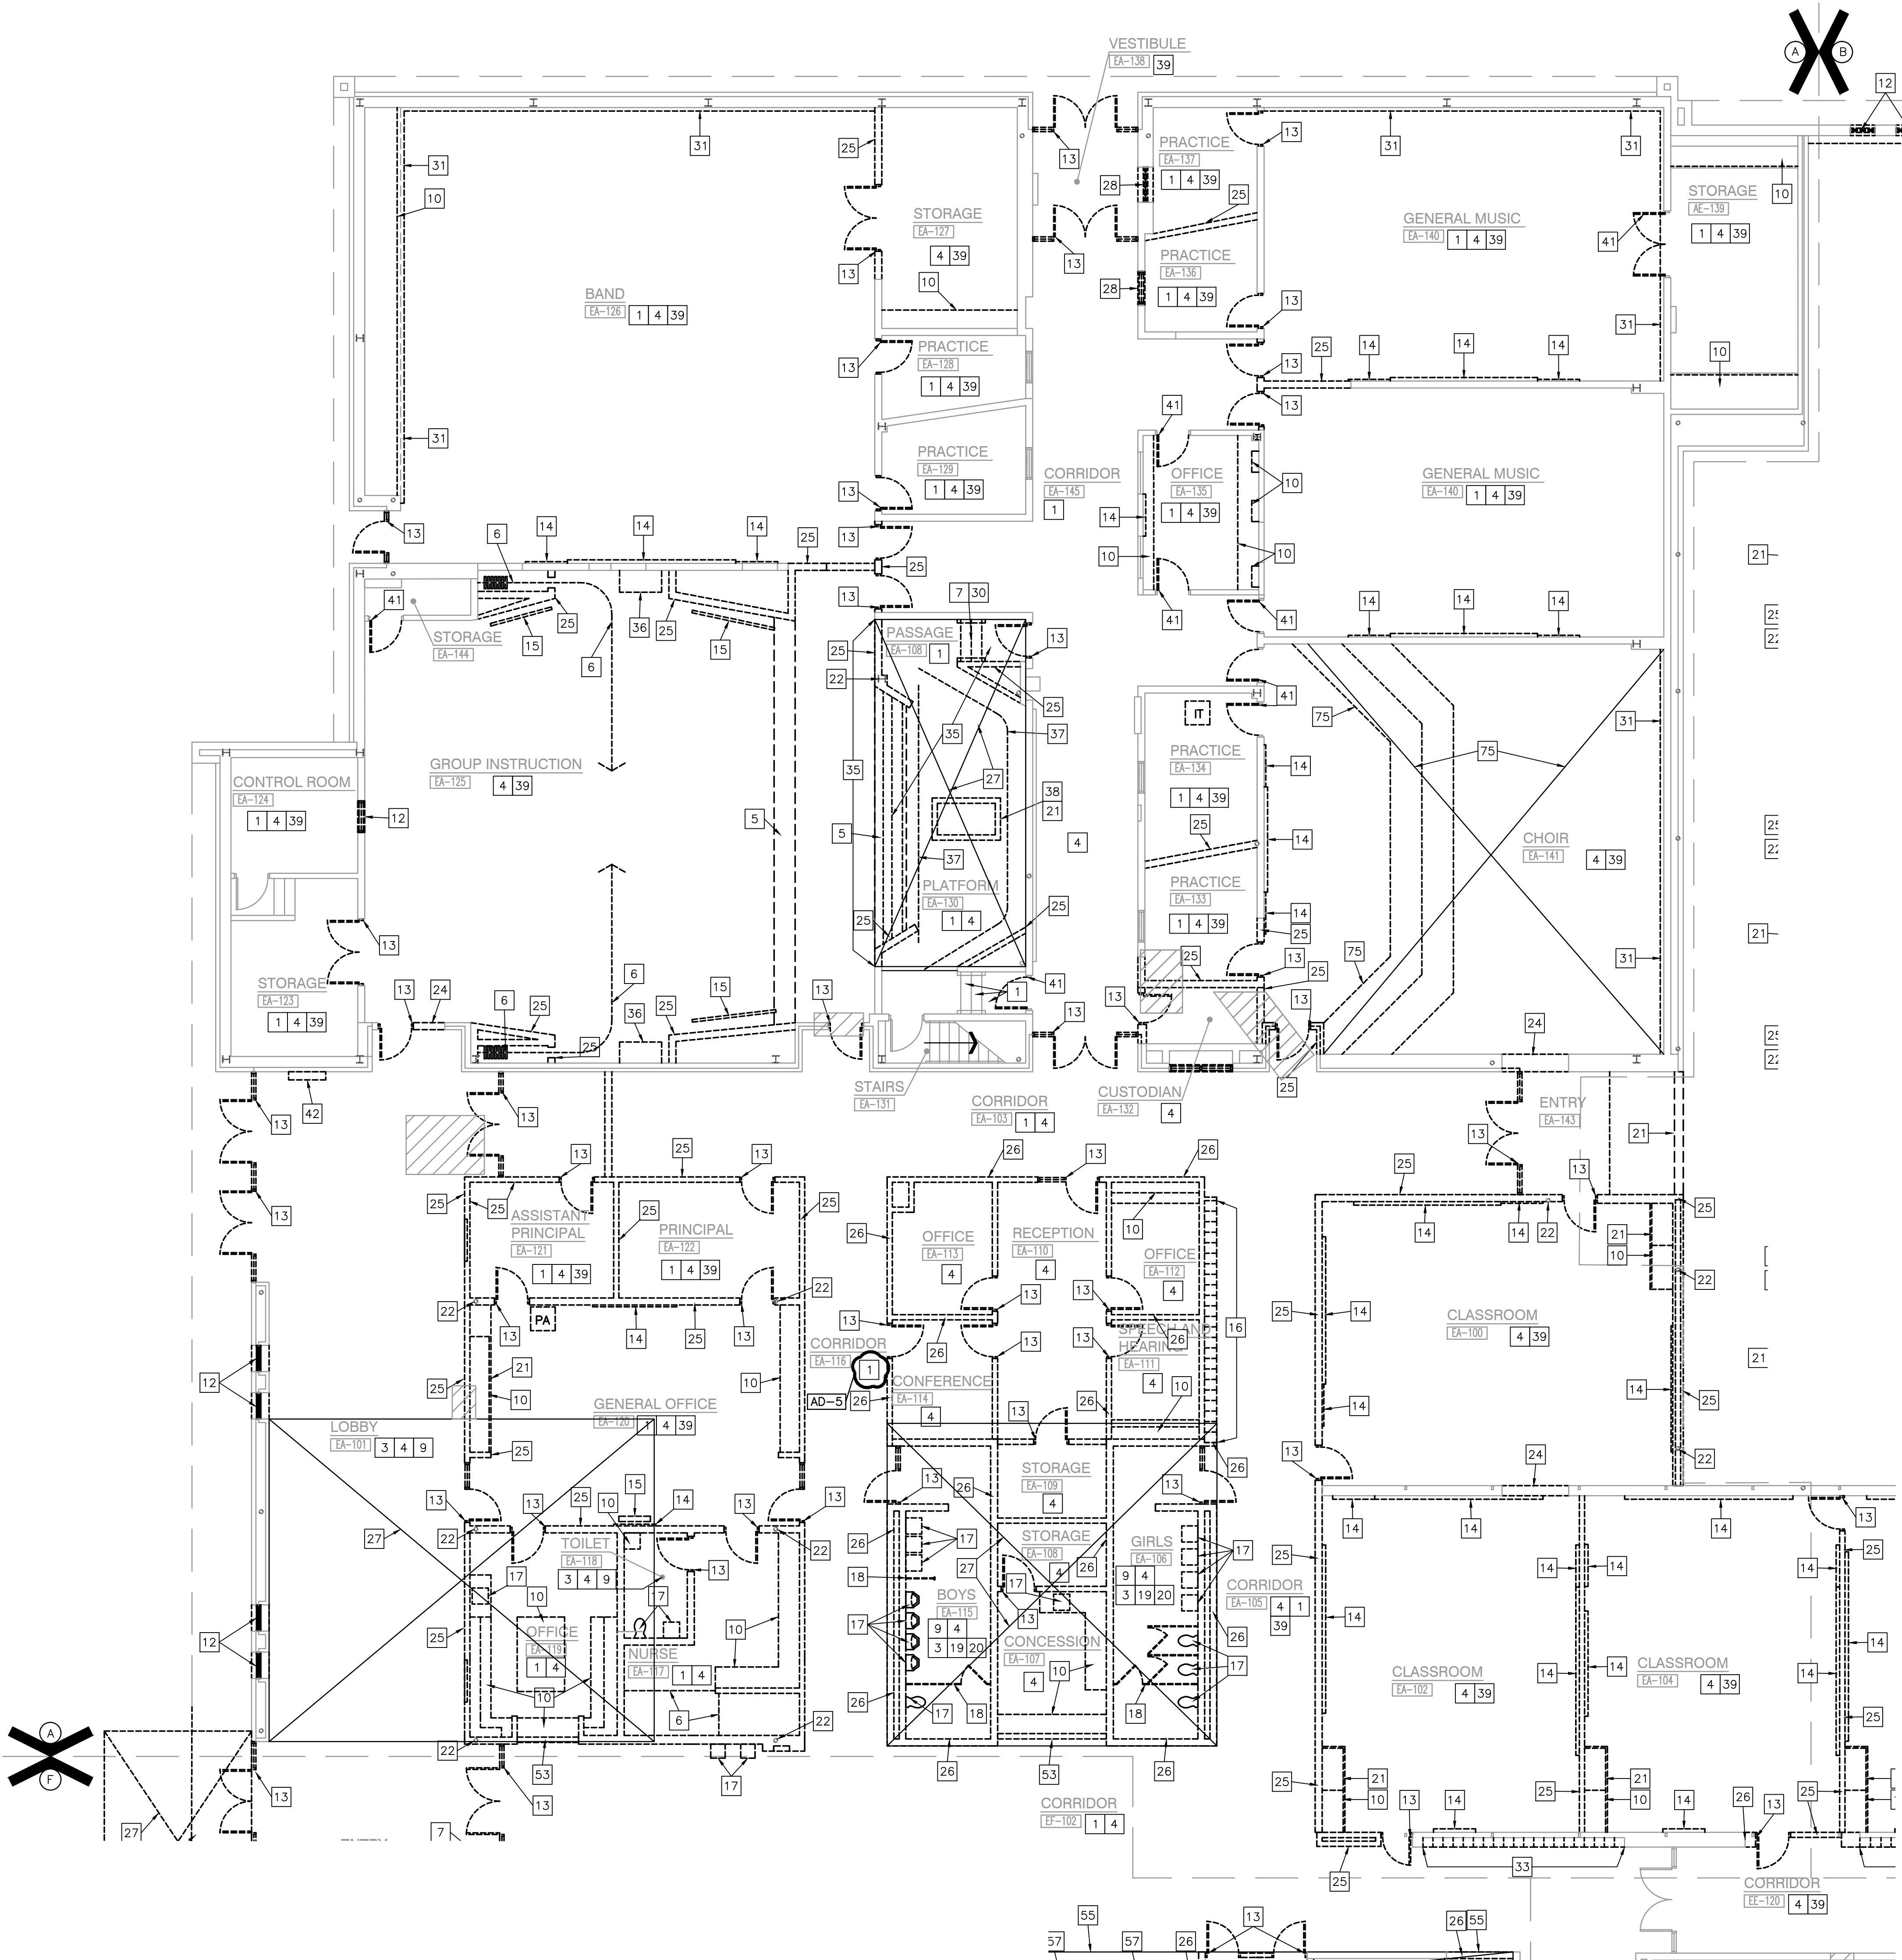


UNIT "A" ARCHITECTURAL FIRST FLOOR DEMOLITION PLAN

SCALE: 1/8" = 1'-0"

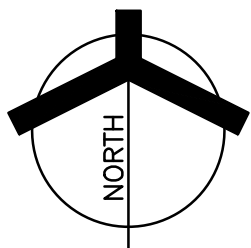

- 39 REMOVE EXISTING FABRIC WALL COVERING AND PREPARE WALLS FOR NEW FINISHES.
- 40 REMOVE EXISTING FLOOR MATERIALS INCLUDING THE VINYL TILE BELOW THE EXISTING FINISH AND WALL BASE.
- 41 REMOVE EXISTING DOOR(S). FRAME TO REMAIN.
- 42 REMOVE MECHANICAL UNIT IN ITS ENTIRETY, INCLUDING METAL SHROUD.
- 43 REMOVE EXISTING FUME HOOD IN ITS ENTIRETY. REFER TO MEP DRAWINGS FOR DEMOLITION NOTES.
- 44 REMOVE FIXED SERVING/BUFFET STATION. PATCH AND REPAIR FLOOR TO RECEIVE NEW FINISHES.
- 45 REMOVE KITCHEN COOLER/FREEZER AND CONNECTED EQUIPMENT IN ITS ENTIRETY. REFER TO KITCHEN AND MECHANICAL DRAWINGS.
- 46 REMOVE EXISTING PIPE BOLLARD. COORDINATE WITH CIVIL DRAWINGS.
- 47 REMOVE EXISTING ROOF AND/OR OVERHANG ASSEMBLY IN ITS ENTIRETY AS REQUIRED FOR NEW CONSTRUCTION. COORDINATE WITH STRUCTURAL DRAWINGS.
- 48 REMOVE MECHANICAL EQUIPMENT (INCLUDING GENERATORS, NATURAL GAS METER/LINES, ETC) AND CONCRETE MOUNTING PAD IN THEIR ENTIRETY. COORDINATE WITH MECHANICAL DRAWINGS.
- 49 REMOVE CHAIN-LINK, METAL, WOOD FENCING ENCLOSURES IN THEIR ENTIRETY, INCLUDING CONCRETE PADS. PATCH REMAINING POST HOLES AS REQUIRED FOR NEW CONSTRUCTION.
- 50 DEMOLISH AND REMOVE SITE CONCRETE (INCLUDING STOOPS, SIDEWALKS, PATHS, AND APRONS WHERE INDICATED. COORDINATE WITH CIVIL DRAWINGS.
- 51 REMOVE EXISTING PIPE BOLLARD. COORDINATE WITH CIVIL DRAWINGS.
- 52 REMOVE EXISTING METAL LOUVER SYSTEM IN ITS ENTIRETY. REFER TO MECHANICAL DRAWINGS.
- 53 REMOVE EXISTING ROLL UP DOOR IN ITS ENTIRETY TO 8" BELOW EXISTING FLOOR LINE. INCLUDING SUPPORTING STRUCTURE AND OPERABLE EQUIPMENT.
- 54 REMOVE EXISTING FLUE AND CHIMNEY IN ITS ENTIRETY. REFER TO STRUCTURAL DRAWINGS.
- 55 REMOVE EXISTING CONCRETE STEPS, SLAB, AND FOUNDATION WALL TO 8" BELOW EXISTING EA-129 FLOOR SLAB AS REQUIRED FOR NEW CONSTRUCTION.
- 56 REMOVE TWO SEATS WIDE FROM END OF EXISTING BLEACHER SEATING. PATCH AND REPAIR ADJACENT WALL AT CONNECTION/ANCHOR POINTS AS REQUIRED TO ACCEPT NEW FINISHES.
- 57 REMOVE EXISTING DISPLAY CASE IN ITS ENTIRETY, INCLUDING WALL CONSTRUCTION ABOVE AND BELOW. PREPARE WALL AND FLOOR TO ACCEPT NEW FINISHES AS REQUIRED FOR NEW CONSTRUCTION.
- 58 REMOVE EXISTING WHEEL CHAIR LIFT.
- 59 REMOVE EXISTING LOUVER.
- 60 REMOVE SAFETY CUSHION WAINSCOT IN ITS ENTIRETY. PREP FOR NEW FINISH.
- 61 REMOVE EXISTING WALL MOUNTED SCORE BOARD. PATCH AND REPAIR WALL AS REQUIRED TO ACCEPT NEW FINISHES.
- 62 REMOVE EXISTING WOOD TRIM.
- 63 REMOVE EXISTING WOOD FLOORING AND SLEEPER SYSTEM, INCLUDING WALL BASE. PREP FLOOR FOR NEW CONCRETE.
- 64 REMOVE EXISTING CONCRETE CURB. PATCH & REPAIR FLOOR.
- 65 REMOVE EXISTING CERAMIC TILE AND CONCRETE SLAB IN ITS ENTIRETY AS REQUIRED FOR NEW CONCRETE FOUNDATION WALL AND FOOTING.
- 66 REMOVE EXISTING METAL LOCKERS AND PLASTER BULKHEAD ABOVE. EXISTING LOCKER LOCKER BENCH TO REMAIN.
- 67 REMOVE ENTIRE BUILDING FROM ROOF TO BOTTOM OF EXISTING FOOTINGS COMPLETE. ALL UTILITIES TO BE CUT AND CAPPED BY RESPECTIVE DISCIPLINES AT THE EDGE OF THE EXISTING PORTION OF THE BUILDING TO REMAIN.
- 68 EXISTING BULKHEAD TO REMAIN.
- 69 REMOVE EXISTING TERRAZZO FLOOR CONCRETE SLAB AND INSULATION IN ITS ENTIRETY. EXISTING RECESSED CONCRETE SLAB TO REMAIN.
- 70 REMOVE WHEELCHAIR LIFT AS REQUIRED FOR CONSTRUCTION AND REINSTALL ONCE COMPLETE.
- 71 REMOVE METAL ENCLOSURE IN ITS ENTIRETY.
- 72 REMOVE EXISTING CONCRETE EQUIPMENT PAD IN ITS ENTIRETY. PREP FOR NEW FINISHES.
- 73 REMOVE EXISTING UNDERGROUND WATER STORAGE TANK. CONCRETE TANK FOUNDATION TO REMAIN. EXISTING UNDERGROUND WATER PIPES TO BE REMOVED AS REQUIRED FOR NEW BUILDING ADDITION.
- 74 REMOVE EXISTING TERRAZZO TO EXISTING RECESSED CONCRETE SLAB APPROXIMATELY 2-1/2" THICK. SEE PLAN 4/ A-830 FOR EXTENT OF TERRAZZO REMOVAL IN CAFETERIA EE-116.
- 75 REMOVE EXISTING CONCRETE SLAB AND RISERS INCLUDING EXCAVATION OF EXISTING SUB GRADE AS REQUIRED FOR NEW CONCRETE SLAB.

DEMOLITION LEGEND

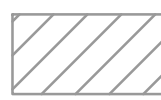 INDICATES APPROXIMATE LOCATION OF EXISTING CONCRETE SLAB TO BE REMOVED AS REQUIRED FOR INSTALLATION OF NEW PLUMBING. REFER TO PLUMBING DRAWINGS FOR EXACT LOCATIONS. REFER TO STRUCTURAL DRAWINGS FOR NEW BACK FILLING AND NEW CONCRETE SLAB INFILL.


GENERAL DEMOLITION NOTES:

- A. FOR GENERAL PROJECT NOTES, MATERIAL INDICATIONS LEGEND, SYMBOL LEGEND, ABBREVIATIONS, ETC., REFER TO GI SERIES SHEETS.
- B. UNLESS NOTED OTHERWISE ON THIS SHEET, THE GENERAL CONTRACTOR IS RESPONSIBLE FOR ALL DEMOLITION AND REMOVAL WORK INDICATED ON THIS SHEET.
- C. CONTRACTORS ENCOUNTERING EXISTING MATERIAL WHICH IS SUSPECTED OF CONTAINING ASBESTOS SHALL STOP WORK IMMEDIATELY AND NOTIFY THE OWNER AND THE OWNERS REPRESENTATIVE.
- D. BOLD DASHED LINES INDICATE EXISTING ITEMS TO BE REMOVED UNLESS OTHERWISE NOTED. THE CONTRACTOR SHALL BE RESPONSIBLE FOR FIELD VERIFYING THE EXTENT OF DEMOLITION WORK PRIOR TO BIDDING AND FOR COORDINATING THE EXTENT OF DEMOLITION WITH THE INSTALLATION OF NEW SYSTEMS.
- E. EACH CONTRACTOR SHALL BE RESPONSIBLE FOR ALL DEMOLITION APPLICABLE TO THEIR SCOPE OF WORK AND AS REQUIRED FOR INSTALLATION OF NEW WORK WHETHER OR NOT IT IS SPECIFICALLY INDICATED OR NOTED IN THESE DOCUMENTS.
- F. REMOVE ALL ITEMS AND FINISHES MADE OBSOLETE BY NEW CONSTRUCTION. VERIFY ITEMS DEEMED OBSOLETE WITH ARCHITECT PRIOR TO REMOVAL. REFER TO NEW CONSTRUCTION DRAWINGS FOR DEMOLITION REQUIRED NOT SHOWN ON DEMOLITION PLANS.
- G. EACH CONTRACTOR SHALL BE RESPONSIBLE FOR OFF SITE REMOVAL OF ALL DEMOLITION MATERIALS AND/OR ITEMS UNLESS NOTED OTHERWISE OR DIRECTED BY THE OWNER.
- H. PRIOR TO STARTING DEMOLITION, CONSTRUCT DUST CONTROL BARRIERS AS REQUIRED TO PREVENT THE SPREAD OF DUST INTO SURROUNDING AREAS (WHERE APPLICABLE).
- I. WHERE BUILDING EGRESS IS REQUIRED TO PASS THROUGH DEMOLITION AREAS, PROVIDE APPROVED BARRIERS, ETC. TO ENSURE SAFETY OF THE PUBLIC.
- J. RELOCATED ITEMS SHALL BE CLEANED AND PLACED IN STORAGE, PER OWNERS' DIRECTION, UNTIL ITEMS ARE READY TO BE INSTALLED. IF ITEMS ARE DAMAGED DURING DEMOLITION OR RELOCATION, THEY SHALL BE REPAIRED OR REPLACED WITH NEW ITEMS AS APPROVED.
- K. DEMOLITION SHALL BE PERFORMED WITHOUT DAMAGE TO EXISTING CONSTRUCTION TO REMAIN. WHERE SUCH DAMAGE OCCURS, PATCH, REPAIR, OR RESTORE WALLS, FLOORS, CEILING, ETC. NEATLY TO MATCH EXISTING ADJACENT SURFACE. PROVIDE SHORING, BRACING, OR SUPPORT AS REQUIRED TO PREVENT MOVEMENT OR SETTLEMENT OF EXISTING STRUCTURES.
- L. EACH CONTRACTOR IS RESPONSIBLE FOR CUTTING, PATCHING, AND DISCONNECTION OF ITEMS APPLICABLE TO THEIR SCOPE OF WORK. WHERE EXISTING SERVICES ARE ABANDONED, CAP AT LEAST 1" BEHIND NEW FINISHES AND/OR EXISTING SURFACE AND PATCH AS REQUIRED TO RECEIVE NEW FINISHES OR MATCH EXISTING FINISH.
- M. ON WALLS THAT ARE TO RECEIVE NEW FINISHES, REMOVE AND REINSTALL EXISTING EQUIPMENT TO REMAIN AS REQUIRED FOR INSTALLATION OF NEW FINISHES.
- N. WHERE WALLS OR BULKHEADS ARE REMOVED, PATCH FLOORS, CEILINGS, AND ADJACENT WALLS AS REQUIRED TO MATCH EXISTING OR RECEIVE NEW FINISHES WHERE APPLICABLE. WHERE EXISTING DUCTWORK, PIPING, OR EQUIPMENT IS REMOVED, PATCH OPENINGS AND/OR SURFACES AS REQUIRED TO MATCH ADJACENT SURFACES OR RECEIVE NEW FINISHES WHERE APPLICABLE. REFER TO ALL DEMOLITION DRAWINGS FOR EXTENT OF ITEMS TO BE REMOVED.
- O. OVER CUT NEW OPENINGS IN EXISTING WALL AS REQUIRED FOR NEW CONSTRUCTION. PATCH AND REPAIR WALLS AS REQUIRED TO MATCH EXISTING. WHERE APPLICABLE, TOOTH NEW MASONRY INTO EXISTING MASONRY.
- P. ALL EQUIPMENT AND FURNITURE WHICH ARE CONSIDERED LOOSE FURNISHING SHALL BE REMOVED BY THE OWNER PRIOR TO DEMOLITION.
- Q. MASONRY WALLS TO BE REMOVED SHALL BE REMOVED TO A POINT 2" MINIMUM BELOW THE EXISTING FLOOR SLAB UNLESS SETTING ON A SLAB OR SPECIFICALLY NOTED OTHERWISE. PATCH WITH NEW CONCRETE TO BE FLUSH WITH THE EXISTING FLOOR SLAB.
- R. EACH CONTRACTOR SHALL BE RESPONSIBLE FOR GENERAL REVIEW OF DEMOLITION NOTES AND GENERAL DEMOLITION NOTES AS THEY APPLY TO THEIR SCOPE OF WORK.
- S. REFER TO THE STRUCTURAL, MECHANICAL, PLUMBING, ELECTRICAL AND TECHNOLOGY DOCUMENTS FOR COMPLETE SCOPE OF DEMOLITION WORK.
- T. "FLOORING" DENOTES FLOOR COVERING MATERIALS INCLUDING BACKING, ADHESIVES, AND BASES DOWN TO BUT EXCLUSIVE OF FLOOR SLABS AND STRUCTURAL MATERIALS UNLESS NOTED OTHERWISE.
- U. WHERE APPLICABLE SALVAGE EXISTING MASONRY (FACE BRICK, GLAZED CMU, FACING TILE) AS REQUIRED FOR PATCHING AND INFILL IN RENOVATED AREAS WHERE INDICATED. DISCARD UNUSED PORTION OFF SITE.

DEMOLITION PLAN NOTES:

(ALL PLAN NOTES MAY NOT BE INDICATED ON THIS SHEET.)

- 1 REMOVE EXISTING FLOOR FINISH AND WALL BASE IN ITS ENTIRETY. PREP FOR NEW FINISHES.
- 2 REMOVE EXISTING FLOOR FINISH AND CONCRETE SLAB IN ITS ENTIRETY.
- 3 REMOVE CERAMIC TILE WALL FINISH IN ITS ENTIRETY.
- 4 REMOVE ACOUSTICAL BOARD CEILING SYSTEM IN ITS ENTIRETY.
- 5 REMOVE EXISTING PLASTER CEILING SYSTEM IN ITS ENTIRETY.
- 6 REMOVE EXISTING FOLDING PARTITION IN ITS ENTIRETY INCLUDING TRACK AND TRACK SUPPORT FRAMING.
- 7 REMOVE EXISTING DIVIDER/HAND RAIL.
- 8 REMOVE SHELVING AND COUNTERTOP SYSTEM IN ITS ENTIRETY. PATCH AND REPAIR FLOOR AS REQUIRED TO ACCEPT NEW FINISHES.
- 9 REMOVE CERAMIC OR PORCELAIN TILE FLOORING SYSTEM INCLUDING SETTING BED IN ITS ENTIRETY.
- 10 REMOVE CASEWORK IN ITS ENTIRETY. PATCH AND REPAIR WALL AND FLOOR AS REQUIRED TO ACCEPT NEW FINISHES.
- 11 REMOVE UNIT VENTILATOR SYSTEM IN ITS ENTIRETY. SEE MECHANICAL DRAWINGS.
- 12 REMOVE WINDOW SYSTEM IN ITS ENTIRETY. PREPARE OPENING TO ACCEPT NEW WINDOW SYSTEM.
- 13 REMOVE EXISTING DOOR AND FRAME SYSTEM IN ITS ENTIRETY.
- 14 REMOVE MARKERBOARD/TACKBOARD/CHALKBOARD IN ITS ENTIRETY, PREP WALL FOR NEW FINISHES.
- 15 REMOVE MOUNTED PROJECTOR/TV/SMARTBOARD/SCREEN IN ITS ENTIRETY.
- 16 REMOVE METAL LOCKERS. REMOVE CONCRETE BASE AS REQUIRED FOR NEW CONSTRUCTION. PATCH AND REPAIR FLOOR TO RECEIVE NEW FINISH.
- 17 REMOVE PLUMBING FIXTURE IN ITS ENTIRETY. CUT AND CAP LINE BELOW WALL OR FLOOR SURFACE. UNLESS OTHERWISE NOTED ON PLUMBING DRAWINGS PATCH AND REPAIR FLOOR AND/OR WALL AS REQUIRED TO ACCEPT NEW FINISHES.
- 18 REMOVE TOILET AND PARTITIONS IN THEIR ENTIRETY.
- 19 REMOVE TOILET ACCESSORIES AND TURN OVER TO OWNER.
- 20 REMOVE EXISTING FLOOR DRAIN. REFER TO PLUMBING DRAWINGS.
- 21 REMOVE METAL STUD AND GYPSUM BOARD BULKHEAD IN ITS ENTIRETY. PATCH AND REPAIR WALL AS REQUIRED FOR NEW FINISHES.
- 22 EXISTING STEEL COLUMN TO REMAIN.
- 23 REMOVE EXISTING COLUMN IN ITS ENTIRETY. COORDINATE WITH STRUCTURAL DRAWINGS.
- 24 REMOVE SECTION OF WALL TO CREATE NEW OPENING FOR DOOR.
- 25 REMOVE METAL STUD AND PLASTER/GYPSUM BOARD WALL IN ITS ENTIRETY. PATCH AND REPAIR ADJACENT WALL AND FLOOR AS REQUIRED TO ACCEPT NEW FINISHES.
- 26 REMOVE MASONRY WALL (AS REQUIRED FOR NEW CONSTRUCTION.) PATCH AND REPAIR ADJACENT FLOOR AND WALL AS REQUIRED TO ACCEPT NEW FINISHES.
- 27 REMOVE CONCRETE SLAB IN ITS ENTIRETY.
- 28 REMOVE EXISTING WINDOW SYSTEM IN ITS ENTIRETY.
- 29 REMOVE ROOF ASSEMBLY IN ITS ENTIRETY FOR NEW CONSTRUCTION. COORDINATE WITH STRUCTURAL DRAWINGS.
- 30 REMOVE STAIR/RAMP ASSEMBLY AND ACCESSORIES IN ITS ENTIRETY. PREPARE FLOOR AND WALL TO ACCEPT NEW FINISHES.
- 31 REMOVE EXISTING ACOUSTIC WALL TREATMENT IN ITS ENTIRETY. PREPARE WALL TO ACCEPT NEW FINISHES.
- 32 REMOVE EXISTING EIFS SOFFIT SYSTEM IN ITS ENTIRETY, INCLUDING FRAMING.
- 33 REMOVE EXISTING METAL LOCKERS. CONCRETE BASE TO REMAIN.
- 34 REMOVE KILN IN ITS ENTIRETY. SALVAGE FOR REINSTALLATION.
- 35 REMOVE EXISTING CONCRETE STEPS AND FOUNDATION WALL TO 8" BELOW EXISTING EA-125 FLOOR SLAB.
- 36 REMOVE WALL MOUNTED BENCH IN ITS ENTIRETY. PATCH AND REPAIR ADJACENT WALL/FLOOR TO ACCEPT NEW FINISHES.
- 37 REMOVE EXISTING STAGE CURTAIN AND TRACK SYSTEM IN ITS ENTIRETY.
- 38 REMOVE EXISTING AUTOMATIC SMOKE VENTILATOR INCLUDING BULKHEAD AND FRAMING IN ITS ENTIRETY.

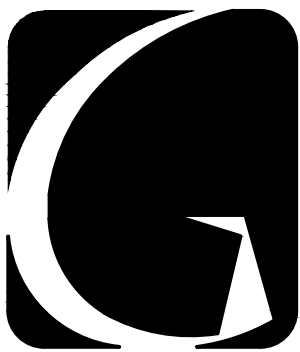


GIBRALTAR
DESIGN

ARCHITECTURE • ENGINEERING • INTERIOR DESIGN

PROJECT

LIBERTY INTERMEDIATE SCHOOL - ADDITIONS & RENOVATIONS

DUNELAND SCHOOL CORPORATION
CHESTERTON, INDIANA

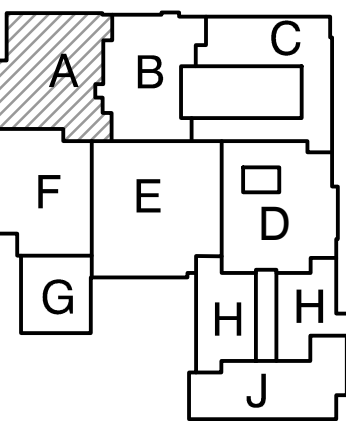

KEY PLAN

GIBRALTAR DESIGN

9102 N. Meridian St., Ste. 300
Indianapolis, IN 46260
Homepage: www.GibraltarDesign.com
Email: info@GibraltarDesign.com
Phone: 317.580.5777 Fax: 317.580.5778

PROJECT

21-139

DATE

04/25/22

COORDINATED BY

DWJ

DRAWN BY

DND

CHECKED BY

BCB

COPYRIGHT NOTICE:

THE CONCEPTS, DESIGNS, PLANS, DETAILS, ETC. SHOWN ON THIS DOCUMENT ARE THE PROPERTY OF GIBRALTAR DESIGN AND WERE CREATED FOR USE ON THIS SPECIFIC PROJECT. NONE OF THIS INFORMATION SHALL BE USED BY ANY OTHER PERSON OR FOR ANY PURPOSE WITHOUT THE EXPRESS WRITTEN CONSENT OF GIBRALTAR DESIGN. THE OWNER MAY RETAIN COPIES FOR INFORMATION AND REFERENCE IN CONNECTION ONLY WITH THIS PROJECT.

REVISIONS

MARK	DATE	ISSUED FOR
AD-1	05/05/22	ADDENDUM NO. 1
AD-3	5/12/22	ADDENDUM NO.3
AD-4	5/18/22	ADDENDUM NO.4
AD-5	5/23/22	ADDENDUM NO.5

DRAWING

UNIT "A" ARCHITECTURAL
FIRST FLOOR DEMOLITION
PLAN

PROJECT

LIBERTY IS -
ADDITIONS & RENOVATIONS


© GIBRALTAR DESIGN

SHEET

A



AD101

Friday, 5/20/2022 - 10:45 AM - LAST SAVED BY KIMMONS
Y:\21-139 DUNELAND SC - LIBERTY INTERMEDIATE SCHOOL
ADDITIONS AND RENOVATIONS\21-139 DRAWINGS\05
ARCH\05-10-2022

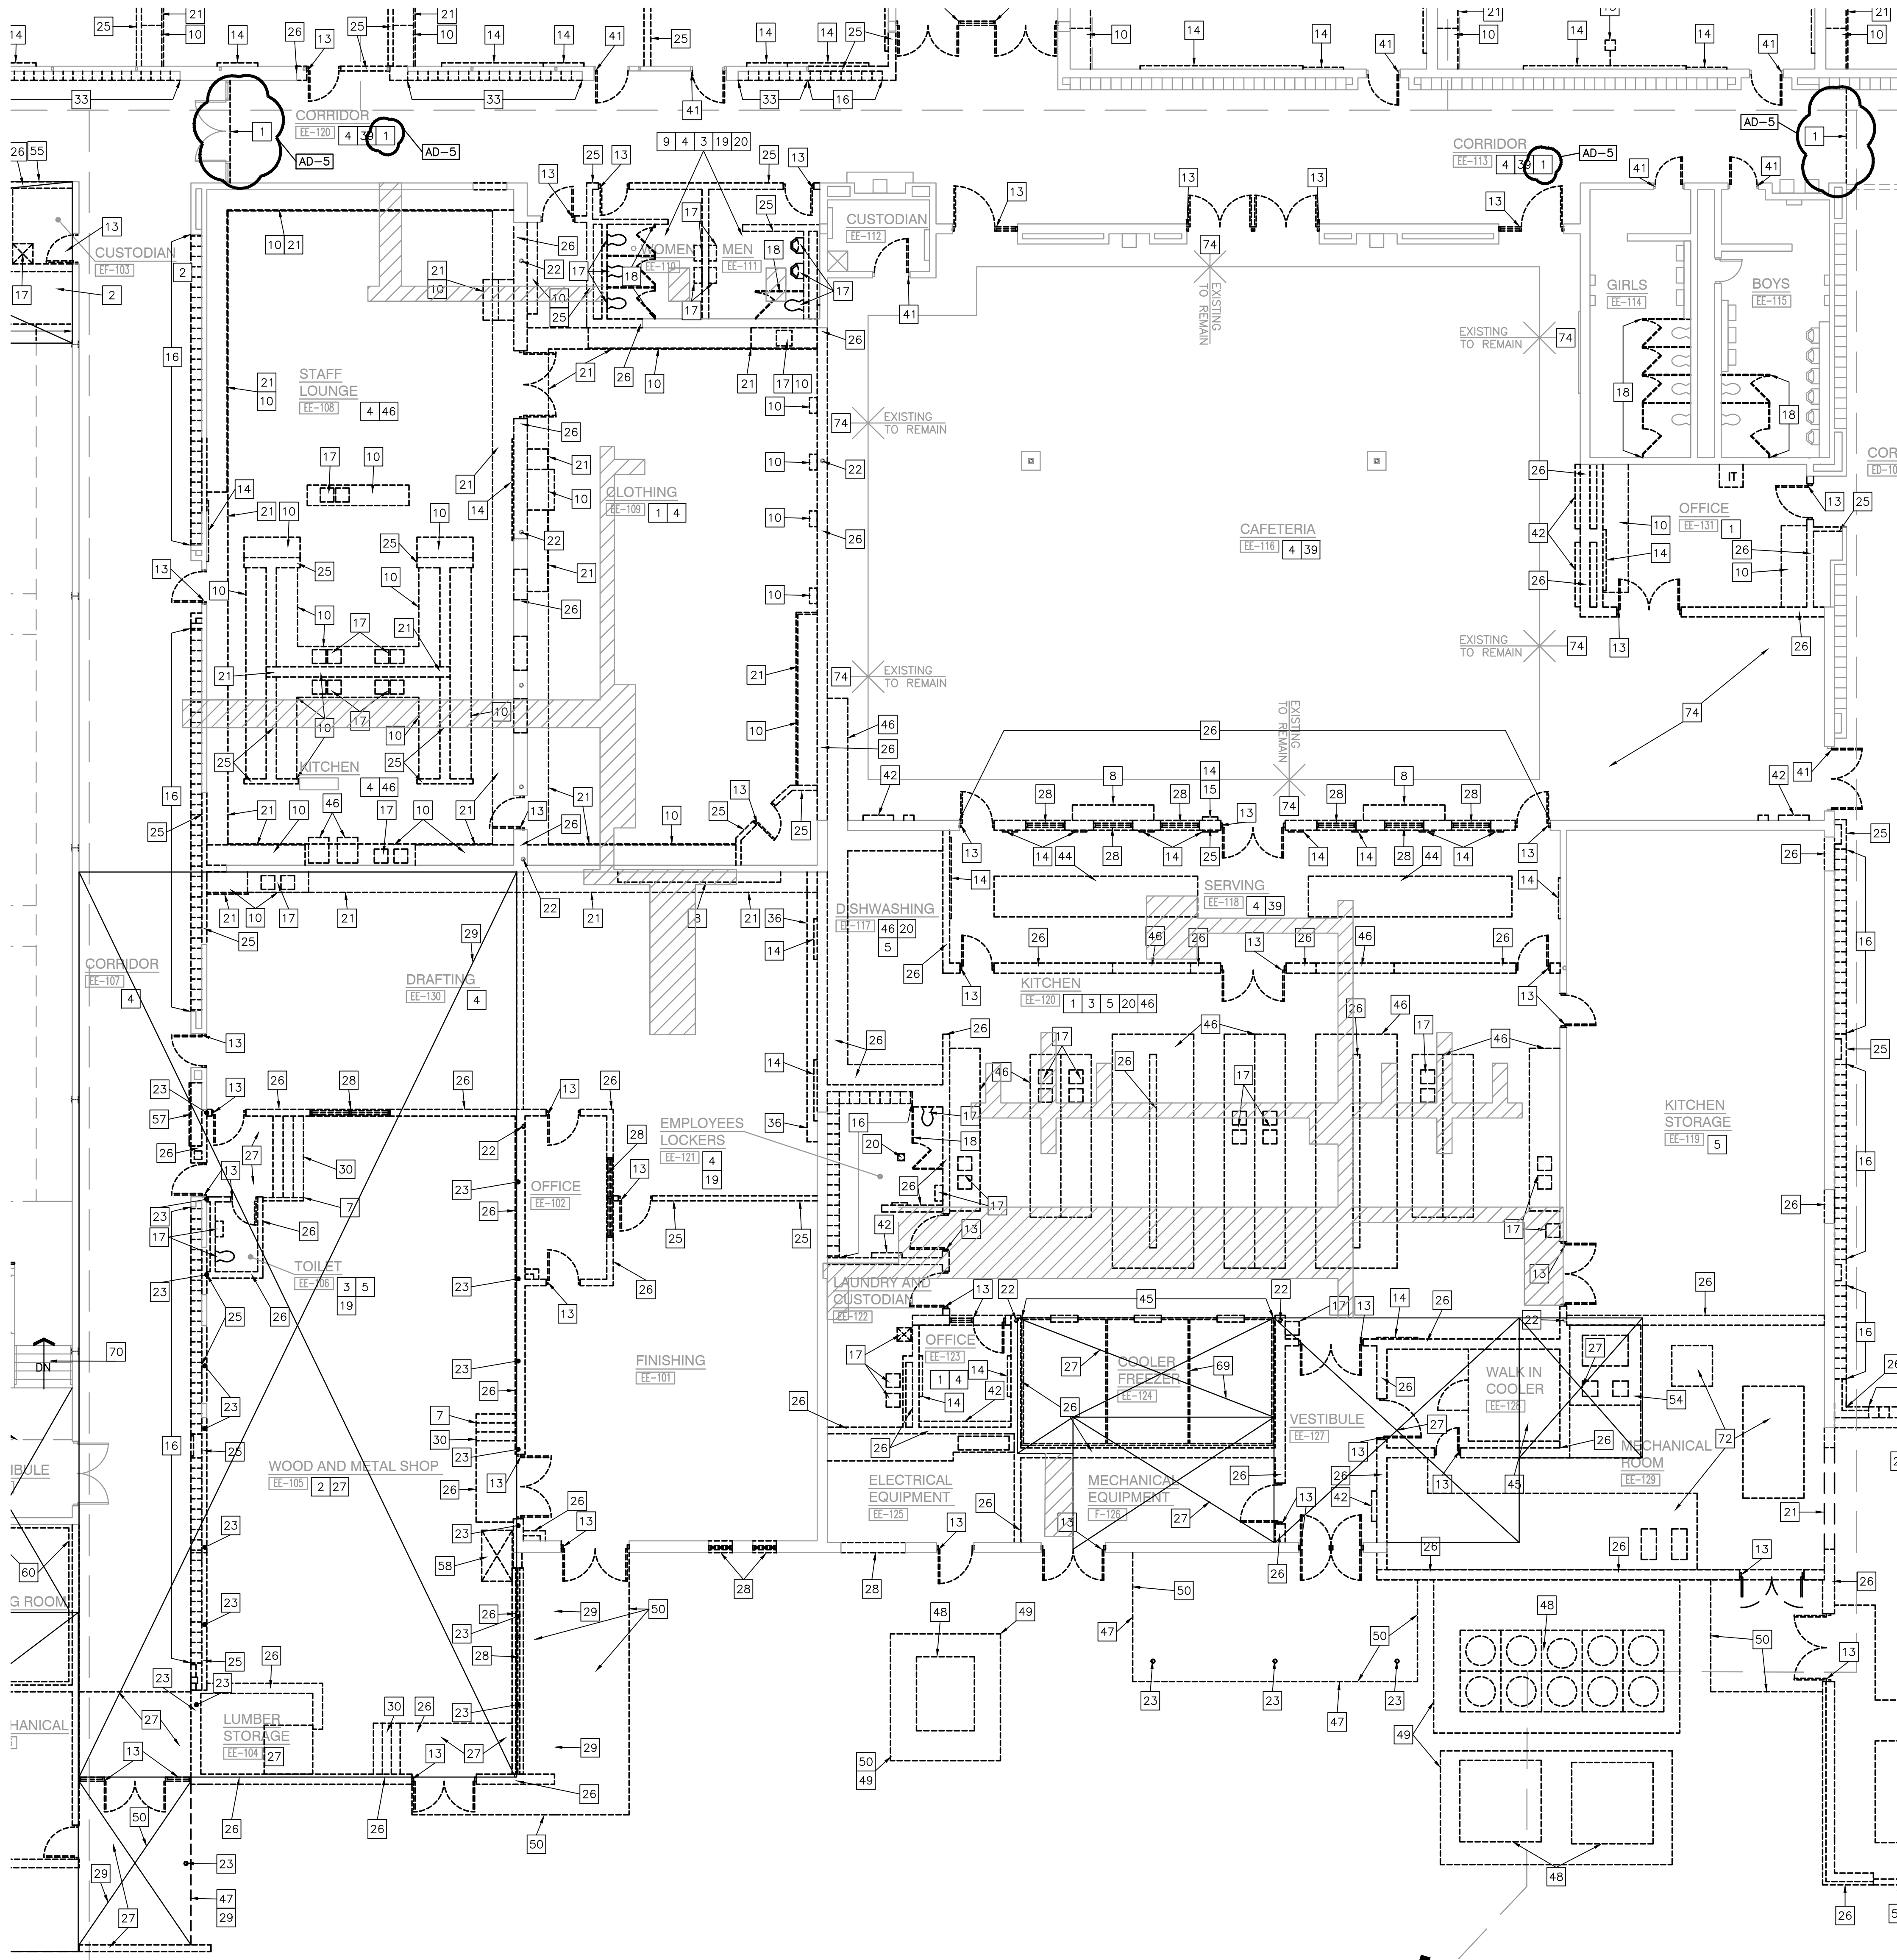

UNIT "E" ARCHITECTURAL FIRST FLOOR DEMOLITION PLAN

SCALE: 1/8" = 1'-0"

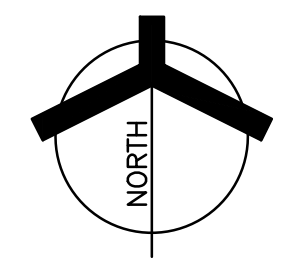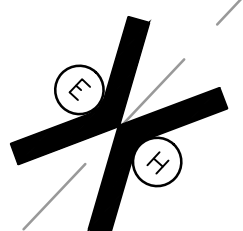

- 39 REMOVE EXISTING FABRIC WALL COVERING AND PREPARE WALLS FOR NEW FINISHES.
- 40 REMOVE EXISTING FLOOR MATERIALS INCLUDING THE VINYL TILE BELOW THE EXISTING FINISH AND WALL BASE.
- 41 REMOVE EXISTING DOOR(S). FRAME TO REMAIN.
- 42 REMOVE MECHANICAL UNIT IN ITS ENTIRETY, INCLUDING METAL SHROUD.
- 43 REMOVE EXISTING FUME HOOD IN ITS ENTIRETY. REFER TO MEP DRAWINGS FOR DEMOLITION NOTES.
- 44 REMOVE FIXED SERVING/BUFFET STATION. PATCH AND REPAIR FLOOR TO RECEIVE NEW FINISHES.
- 45 REMOVE KITCHEN COOLER/FREEZER AND CONNECTED EQUIPMENT IN ITS ENTIRETY. REFER TO KITCHEN AND MECHANICAL DRAWINGS.
- 46 REMOVE ALL EXISTING KITCHEN EQUIPMENT IN ITS ENTIRETY, INCLUDING EXHAUST HOOD(S). REFER TO KITCHEN AND MECHANICAL DRAWINGS.
- 47 REMOVE EXISTING ROOF AND/OR OVERHANG ASSEMBLY IN ITS ENTIRETY AS REQUIRED FOR NEW CONSTRUCTION. COORDINATE WITH STRUCTURAL DRAWINGS.
- 48 REMOVE MECHANICAL EQUIPMENT (INCLUDING GENERATORS, NATURAL GAS METER/LINES, ETC) AND CONCRETE MOUNTING PAD IN THEIR ENTIRETY. COORDINATE WITH MECHANICAL DRAWINGS.
- 49 REMOVE CHAIN-LINK, METAL, WOOD FENCING ENCLOSURES IN THEIR ENTIRETY, INCLUDING CONCRETE PADS. PATCH REMAINING POST HOLES AS REQUIRED FOR NEW CONSTRUCTION.
- 50 DEMOLISH AND REMOVE SITE CONCRETE (INCLUDING STOOPS, SIDEWALKS, PATHS, AND APRONS WHERE INDICATED. COORDINATE WITH CIVIL DRAWINGS.
- 51 REMOVE EXISTING PIPE BOLLARD. COORDINATE WITH CIVIL DRAWINGS.
- 52 REMOVE EXISTING METAL LOUVER SYSTEM IN ITS ENTIRETY. REFER TO MECHANICAL DRAWINGS.
- 53 REMOVE EXISTING ROLL UP DOOR IN ITS ENTIRETY TO 8" BELOW EXISTING FLOOR LINE. INCLUDING SUPPORTING STRUCTURE AND OPERABLE EQUIPMENT.
- 54 REMOVE EXISTING FLUE AND CHIMNEY IN ITS ENTIRETY. REFER TO STRUCTURAL DRAWINGS.
- 55 REMOVE EXISTING CONCRETE STEPS, SLAB, AND FOUNDATION WALL TO 8" BELOW EXISTING EA-129 FLOOR SLAB AS REQUIRED FOR NEW CONSTRUCTION.
- 56 REMOVE TWO SEATS WIDE FROM END OF EXISTING BLEACHER SEATING. PATCH AND REPAIR ADJACENT WALL AT CONNECTION/ANCHOR POINTS AS REQUIRED TO ACCEPT NEW FINISHES.
- 57 REMOVE EXISTING DISPLAY CASE IN ITS ENTIRETY, INCLUDING WALL CONSTRUCTION ABOVE AND BELOW. PREPARE WALL AND FLOOR TO ACCEPT NEW FINISHES AS REQUIRED FOR NEW CONSTRUCTION.
- 58 REMOVE EXISTING WHEEL CHAIR LIFT.
- 59 REMOVE EXISTING LOUVER.
- 60 REMOVE SAFETY CUSHION WAINSCOT IN ITS ENTIRETY. PREP FOR NEW FINISH.
- 61 REMOVE EXISTING WALL MOUNTED SCORE BOARD. PATCH AND REPAIR WALL AS REQUIRED TO ACCEPT NEW FINISHES.
- 62 REMOVE EXISTING WOOD TRIM.
- 63 REMOVE EXISTING WOOD FLOORING AND SLEEPER SYSTEM, INCLUDING WALL BASE. PREP FLOOR FOR NEW CONCRETE.
- 64 REMOVE EXISTING CONCRETE CURB. PATCH & REPAIR FLOOR.
- 65 REMOVE EXISTING CERAMIC TILE AND CONCRETE SLAB IN ITS ENTIRETY AS REQUIRED FOR NEW CONCRETE FOUNDATION WALL AND FOOTING.
- 66 REMOVE EXISTING METAL LOCKERS AND PLASTER BULKHEAD ABOVE. EXISTING LOCKER LOCKER BENCH TO REMAIN.
- 67 REMOVE ENTIRE BUILDING FROM ROOF TO BOTTOM OF EXISTING FOOTINGS COMPLETE. ALL UTILITIES TO BE CUT AND CAPPED BY RESPECTIVE DISCIPLINES AT THE EDGE OF THE EXISTING PORTION OF THE BUILDING TO REMAIN.
- 68 EXISTING BULKHEAD TO REMAIN.
- 69 REMOVE EXISTING TERRAZZO FLOOR CONCRETE SLAB AND INSULATION IN ITS ENTIRETY. EXISTING RECESSED CONCRETE SLAB TO REMAIN.
- 70 REMOVE WHEELCHAIR LIFT AS REQUIRED FOR CONSTRUCTION AND REINSTALL ONCE COMPLETE.
- 71 REMOVE METAL ENCLOSURE IN ITS ENTIRETY.
- 72 REMOVE EXISTING CONCRETE EQUIPMENT PAD IN ITS ENTIRETY. PREP FOR NEW FINISHES.
- 73 REMOVE EXISTING UNDERGROUND WATER STORAGE TANK. CONCRETE TANK FOUNDATION TO REMAIN. EXISTING UNDERGROUND WATER PIPES TO BE REMOVED AS REQUIRED FOR NEW BUILDING ADDITION.
- 74 REMOVE EXISTING TERRAZZO TO EXISTING RECESSED CONCRETE SLAB APPROXIMATELY 2-1/2" THICK. SEE PLAN 4/ A-830 FOR EXTENT OF TERRAZZO REMOVAL IN CAFETERIA EE-116.
- 75 REMOVE EXISTING CONCRETE SLAB AND RISERS INCLUDING EXCAVATION OF EXISTING SUB GRADE AS REQUIRED FOR NEW CONCRETE SLAB.

DEMOLITION LEGEND

- INDICATES APPROXIMATE LOCATION OF EXISTING CONCRETE SLAB TO BE REMOVED AS REQUIRED FOR INSTALLATION OF NEW PLUMBING. REFER TO PLUMBING DRAWINGS FOR EXACT LOCATIONS. REFER TO STRUCTURAL DRAWINGS FOR NEW BACK FILLING AND NEW CONCRETE SLAB INFILL.

GENERAL DEMOLITION NOTES:

- A. FOR GENERAL PROJECT NOTES, MATERIAL INDICATIONS LEGEND, SYMBOL LEGEND, ABBREVIATIONS, ETC., REFER TO GI SERIES SHEETS.
- B. UNLESS NOTED OTHERWISE ON THIS SHEET, THE GENERAL CONTRACTOR IS RESPONSIBLE FOR ALL DEMOLITION AND REMOVAL WORK INDICATED ON THIS SHEET.
- C. CONTRACTORS ENCOUNTERING EXISTING MATERIAL WHICH IS SUSPECTED OF CONTAINING ASBESTOS SHALL STOP WORK IMMEDIATELY AND NOTIFY THE OWNER AND THE OWNERS REPRESENTATIVE.
- D. BOLD DASHED LINES INDICATE EXISTING ITEMS TO BE REMOVED UNLESS OTHERWISE NOTED. THE CONTRACTOR SHALL BE RESPONSIBLE FOR FIELD VERIFICATION OF THE EXISTENCE OF DEMOLITION WORK PRIOR TO BIDDING AND FOR COORDINATING THE EXTENT OF DEMOLITION WITH THE INSTALLATION OF NEW SYSTEMS.
- E. EACH CONTRACTOR SHALL BE RESPONSIBLE FOR ALL DEMOLITION APPLICABLE TO THEIR SCOPE OF WORK AND AS REQUIRED FOR INSTALLATION OF NEW WORK WHETHER OR NOT IT IS SPECIFICALLY INDICATED OR NOTED IN THESE DOCUMENTS.
- F. REMOVE ALL ITEMS AND FINISHES MADE OBSOLETE BY NEW CONSTRUCTION. VERIFY ITEMS DEEMED OBSOLETE WITH ARCHITECT PRIOR TO REMOVAL. REFER TO NEW CONSTRUCTION DRAWINGS FOR DEMOLITION REQUIRED NOT SHOWN ON DEMOLITION PLANS.
- G. EACH CONTRACTOR SHALL BE RESPONSIBLE FOR OFF SITE REMOVAL OF ALL DEMOLITION MATERIALS AND/OR ITEMS UNLESS NOTED OTHERWISE OR DIRECTED BY THE OWNER.
- H. PRIOR TO STARTING DEMOLITION, CONSTRUCT DUST CONTROL BARRIERS AS REQUIRED TO PREVENT THE SPREAD OF DUST INTO SURROUNDING AREAS (WHERE APPLICABLE).
- I. WHERE BUILDING EGRESS IS REQUIRED TO PASS THROUGH DEMOLITION AREAS, PROVIDE APPROVED BARRIERS, ETC. TO ENSURE SAFETY OF THE PUBLIC.
- J. RELOCATED ITEMS SHALL BE CLEANED AND PLACED IN STORAGE, PER OWNERS' DIRECTION, UNTIL ITEMS ARE READY TO BE INSTALLED. IF ITEMS ARE DAMAGED DURING DEMOLITION OR RELOCATION, THEY SHALL BE REPAIRED OR REPLACED WITH NEW ITEMS AS APPROVED.
- K. DEMOLITION SHALL BE PERFORMED WITHOUT DAMAGE TO EXISTING CONSTRUCTION TO REMAIN. WHERE SUCH DAMAGE OCCURS, PATCH, REPAIR, OR RESTORE WALLS, FLOORS, CEILING, ETC. NEATLY TO MATCH EXISTING ADJACENT SURFACE. PROVIDE SHORING, BRACING, OR SUPPORT AS REQUIRED TO PREVENT MOVEMENT OR SETTLEMENT OF EXISTING STRUCTURES.
- L. EACH CONTRACTOR IS RESPONSIBLE FOR CUTTING, PATCHING, AND DISCONNECTION OF ITEMS APPLICABLE TO THEIR SCOPE OF WORK. WHERE EXISTING SERVICES ARE ABANDONED, CAP AT LEAST 1" BEHIND NEW FINISHES AND/OR EXISTING SURFACE AND PATCH AS REQUIRED TO RECEIVE NEW FINISHES OR MATCH EXISTING FINISH.
- M. ON WALLS THAT ARE TO RECEIVE NEW FINISHES, REMOVE AND REINSTALL EXISTING EQUIPMENT TO REMAIN AS REQUIRED FOR INSTALLATION OF NEW FINISHES.
- N. WHERE WALLS OR BULKHEADS ARE REMOVED, PATCH FLOORS, CEILINGS, AND ADJACENT WALLS AS REQUIRED TO MATCH EXISTING OR RECEIVE NEW FINISHES WHERE APPLICABLE. WHERE EXISTING DUCTWORK, PIPING, OR EQUIPMENT IS REMOVED, PATCH OPENINGS AND/OR SURFACES AS REQUIRED TO MATCH ADJACENT SURFACES OR RECEIVE NEW FINISHES WHERE APPLICABLE. REFER TO ALL DEMOLITION DRAWINGS FOR EXTENT OF ITEMS TO BE REMOVED.
- O. OVER CUT NEW OPENINGS IN EXISTING WALL AS REQUIRED FOR NEW CONSTRUCTION. PATCH AND REPAIR WALLS AS REQUIRED TO MATCH EXISTING. WHERE APPLICABLE, TOOTH NEW MASONRY INTO EXISTING MASONRY.
- P. ALL EQUIPMENT AND FURNITURE WHICH ARE CONSIDERED LOOSE FURNISHING SHALL BE REMOVED BY THE OWNER PRIOR TO DEMOLITION.
- Q. MASONRY WALLS TO BE REMOVED SHALL BE REMOVED TO A POINT 2" MINIMUM BELOW THE EXISTING FLOOR SLAB UNLESS SETTING ON A SLAB OR SPECIFICALLY NOTED OTHERWISE. PATCH WITH NEW CONCRETE TO BE FLUSH WITH THE EXISTING FLOOR SLAB.
- R. EACH CONTRACTOR SHALL BE RESPONSIBLE FOR GENERAL REVIEW OF DEMOLITION NOTES AND GENERAL DEMOLITION NOTES AS THEY APPLY TO THEIR SCOPE OF WORK.
- S. REFER TO THE STRUCTURAL, MECHANICAL, PLUMBING, ELECTRICAL AND TECHNOLOGY DOCUMENTS FOR COMPLETE SCOPE OF DEMOLITION WORK.
- T. "FLOORING" DENOTES FLOOR COVERING MATERIALS INCLUDING BACKING, ADHESIVES, AND BASES DOWN TO BUT EXCLUSIVE OF FLOOR SLABS AND STRUCTURAL MATERIALS UNLESS NOTED OTHERWISE.
- U. WHERE APPLICABLE SALVAGE EXISTING MASONRY (FACE BRICK, GLAZED CMU, ETC.) AS REQUIRED FOR PATCHING AND INFILL IN RENOVATED AREAS WHERE INDICATED. DISCARD UNUSED PORTION OFF SITE.

DEMOLITION PLAN NOTES:


(ALL PLAN NOTES MAY NOT BE INDICATED ON THIS SHEET.)

- 1 REMOVE EXISTING FLOOR FINISH AND WALL BASE IN ITS ENTIRETY. PREP FOR NEW FINISHES.
- 2 REMOVE EXISTING FLOOR FINISH AND CONCRETE SLAB IN ITS ENTIRETY.
- 3 REMOVE CERAMIC TILE WALL FINISH IN ITS ENTIRETY.
- 4 REMOVE ACOUSTICAL BOARD CEILING SYSTEM IN ITS ENTIRETY.
- 5 REMOVE EXISTING PLASTER CEILING SYSTEM IN ITS ENTIRETY.
- 6 REMOVE EXISTING FOLDING PARTITION IN ITS ENTIRETY INCLUDING TRACK AND TRACK SUPPORT FRAMING.
- 7 REMOVE EXISTING DIVIDER/HAND RAIL.
- 8 REMOVE SHELVING AND COUNTERTOP SYSTEM IN ITS ENTIRETY. PATCH AND REPAIR FLOOR AS REQUIRED TO ACCEPT NEW FINISHES.
- 9 REMOVE CERAMIC OR PORCELAIN TILE FLOORING SYSTEM INCLUDING AND TRACK SUPPORT FRAMING.
- 10 REMOVE CASEWORK IN ITS ENTIRETY. PATCH AND REPAIR WALL AND FLOOR AS REQUIRED TO ACCEPT NEW FINISHES.
- 11 REMOVE UNIT VENTILATOR SYSTEM IN ITS ENTIRETY. SEE MECHANICAL DRAWINGS.
- 12 REMOVE WINDOW SYSTEM IN ITS ENTIRETY. PREPARE OPENING TO ACCEPT NEW WINDOW SYSTEM.
- 13 REMOVE EXISTING DOOR AND FRAME SYSTEM IN ITS ENTIRETY.
- 14 REMOVE MARKERBOARD/TACKBOARD/CHALKBOARD IN ITS ENTIRETY. PREP WALL FOR NEW FINISHES.
- 15 REMOVE MOUNTED PROJECTOR/TV/SMARTBOARD/SCREEN IN ITS ENTIRETY.
- 16 REMOVE METAL LOCKERS. REMOVE CONCRETE BASE AS REQUIRED FOR NEW CONSTRUCTION. PATCH AND REPAIR FLOOR TO RECEIVE NEW FINISH.
- 17 REMOVE PLUMBING FIXTURE IN ITS ENTIRETY. CUT AND CAP LINE BELOW WALL OR FLOOR SURFACE. UNLESS OTHERWISE NOTED ON PLUMBING DRAWINGS PATCH AND REPAIR FLOOR AND/OR WALL AS REQUIRED TO ACCEPT NEW FINISHES.
- 18 REMOVE TOILET AND PARTITIONS IN THEIR ENTIRETY.
- 19 REMOVE TOILET ACCESSORIES AND TURN OVER TO OWNER.
- 20 REMOVE EXISTING FLOOR DRAIN. REFER TO PLUMBING DRAWINGS.
- 21 REMOVE METAL STUD AND GYPSUM BOARD BULKHEAD IN ITS ENTIRETY. PATCH AND REPAIR WALL AS REQUIRED FOR NEW FINISHES.
- 22 EXISTING STEEL COLUMN TO REMAIN.
- 23 REMOVE EXISTING COLUMN IN ITS ENTIRETY. COORDINATE WITH STRUCTURAL DRAWINGS.
- 24 REMOVE SECTION OF WALL TO CREATE NEW OPENING FOR DOOR.
- 25 REMOVE METAL STUD AND PLASTER/GYPSUM BOARD WALL IN ITS ENTIRETY. PATCH AND REPAIR ADJACENT WALL AND FLOOR AS REQUIRED TO ACCEPT NEW FINISHES.
- 26 REMOVE MASONRY WALL (AS REQUIRED FOR NEW CONSTRUCTION). PATCH AND REPAIR ADJACENT FLOOR AND WALL AS REQUIRED TO ACCEPT NEW FINISHES.
- 27 REMOVE CONCRETE SLAB IN ITS ENTIRETY.
- 28 REMOVE EXISTING WINDOW SYSTEM IN ITS ENTIRETY.
- 29 REMOVE ROOF ASSEMBLY IN ITS ENTIRETY FOR NEW CONSTRUCTION. COORDINATE WITH STRUCTURAL DRAWINGS.
- 30 REMOVE STAIR/RAMP ASSEMBLY AND ACCESSORIES IN ITS ENTIRETY. PREPARE FLOOR AND WALL TO ACCEPT NEW FINISHES.
- 31 REMOVE EXISTING ACOUSTIC WALL TREATMENT IN ITS ENTIRETY. PREPARE WALL TO ACCEPT NEW FINISHES.
- 32 REMOVE EXISTING EIFS SOFFIT SYSTEM IN ITS ENTIRETY, INCLUDING FRAMING.
- 33 REMOVE EXISTING METAL LOCKERS. CONCRETE BASE TO REMAIN.
- 34 REMOVE KILN IN ITS ENTIRETY. SALVAGE FOR REINSTALLATION.
- 35 REMOVE EXISTING CONCRETE STEPS AND FOUNDATION WALL TO 8" BELOW EXISTING EA-129 FLOOR SLAB.
- 36 REMOVE WALL MOUNTED BENCH IN ITS ENTIRETY. PATCH AND REPAIR ADJACENT WALL/FLOOR TO ACCEPT NEW FINISHES.
- 37 REMOVE EXISTING STAGE CURTAIN AND TRACK SYSTEM IN ITS ENTIRETY.
- 38 REMOVE EXISTING AUTOMATIC SMOKE VENTILATOR INCLUDING BULKHEAD AND FRAMING IN ITS ENTIRETY.



GIBALTAR
DESIGN
ARCHITECTURE • ENGINEERING • INTERIOR DESIGN


PROJECT
**LIBERTY
INTERMEDIATE
SCHOOL -
ADDITIONS &
RENOVATIONS**
DUNELAND SCHOOL CORPORATION
CHESTERTON, INDIANA

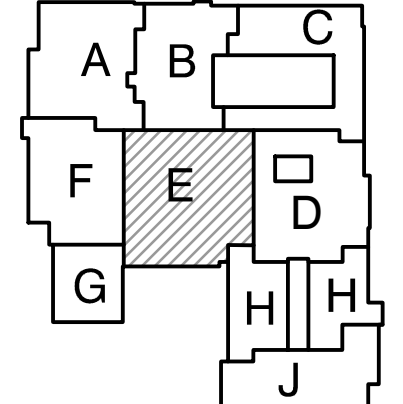

KEY PLAN

GIBALTAR DESIGN
9102 N. Meridian St., Ste. 300
Indianapolis, IN 46260
Homepage: www.GibraltarDesign.com
Email: info@GibraltarDesign.com
Phone: 317.580.5777 Fax: 317.580.5778

PROJECT
21-139
DATE
04/25/22
COORDINATED BY
DWJ
DRAWN BY
DND
CHECKED BY
BCB

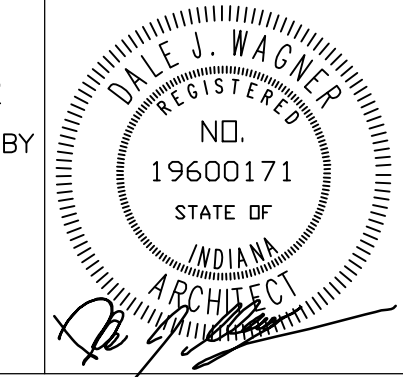

COPYRIGHT NOTICE:
THE CONCEPTS, DESIGNS, PLANS, DETAILS, ETC. SHOWN ON THIS SHEET ARE THE PROPERTY OF GIBALTAR DESIGN AND ARE NOT TO BE REPRODUCED OR USED IN ANY MANNER WITHOUT THE EXPRESS WRITTEN CONSENT OF GIBALTAR DESIGN. THE OWNER MAY RETAIN COPIES FOR INFORMATION AND REFERENCE IN CONNECTION ONLY WITH THIS PROJECT.

REVISIONS		
MARK	DATE	ISSUED FOR
AD-1	05/05/22	ADDENDUM NO. 1
AD-3	5/12/22	ADDENDUM NO.3
AD-4	5/18/22	ADDENDUM NO.4
AD-5	5/23/22	ADDENDUM NO.5

DRAWING
**UNIT "E" ARCHITECTURAL
FIRST FLOOR DEMOLITION
PLAN**

PROJECT
**LIBERTY IS -
ADDITIONS & RENOVATIONS**

© GIBALTAR DESIGN SHEET
E AD105

GENERAL PLAN NOTES:

- A. FOR GENERAL PROJECT NOTES, MATERIAL INDICATIONS LEGEND, SYMBOL LEGEND, ABBREVIATIONS, ETC., REFER TO C SERIES SHEETS.
- B. PLAN DIMENSIONS TO MASONRY WALLS ARE TO FACE OF ROUGH MASONRY. PLAN DIMENSIONS TO STUD WALLS ARE TO FACE OF FINISHED GYPSUM BOARD OR PLASTER. PLAN DIMENSIONS TO STUD WALLS WITH CERAMIC TILE FINISH ARE TO THE FACE OF TILE BACKER BOARD.
- C. ALL CMU WALLS THAT DO NOT LAY OUT IN FULL OR HALF LENGTHS SHOULD BE BALANCED SO AS NOT TO HAVE ANY PIECES LESS THAN 4" IN SIZE EXPOSED TO VIEW.
- D. MASONRY WALLS BEARING ON A THICKENED SLAB AT SLAB DEPRESSIONS REQUIRE CUT MASONRY UNITS SO THAT COURSING BEGINS AT THE FLOOR LINE.
- E. THE BASE FIRST FLOOR ELEVATION INDICATED FOR THE PROJECT IS 100'-0". REFER TO SITE PLAN FOR CORRELATION TO USGS DATUM.
- F. HINGE SIDE OF DOOR JAMB AT CMU WALLS SHALL BE LOCATED 8" MINIMUM FROM ADJACENT WALL AND HINGE SIDE OF DOOR JAMB AT GYPSUM BOARD WALLS SHALL BE LOCATED 4" MINIMUM FROM ADJACENT WALL UNLESS NOTED OTHERWISE.
- G. PROVIDE WOOD BLOCKING (OR METAL STRAPPING WHERE APPLICABLE) AS REQUIRED WITHIN METAL STUD WALLS FOR WALL MOUNTED ITEMS.
- H. REFER TO LIFE SAFETY PLANS REGARDING FIRE RATED WALL LOCATIONS AND OTHER CODE INFORMATION.
- I. INTERIOR CMU WALLS ARE TO BE RUNNING BOND UNLESS NOTED OTHERWISE.
- J. ALL EXPOSED CONCRETE MASONRY UNITS (CMU) CORNERS ARE TO BE BULLNOSED, EXCEPT AT MASONRY BULKHEADS AND EXTERIOR WINDOW JAMBS.
- K. WHERE NEW CMU WALLS INTERSECT EXISTING CMU WALLS AT A CORNER OR ARE ALIGNED WITH EXISTING CMU WALLS, TOOTH NEW CMU INTO EXISTING CMU UNLESS NOTED OTHERWISE.
- L. REFER TO DEMOLITION SHEETS FOR ADDITIONAL PATCHING AND REPAIR WORK.
- M. REFER TO FINISH PLANS FOR INTERIOR ELEVATIONS, LOCATION AND EXTENT OF FINISHED FLOOR AND WALL MATERIAL.
- N. REFER TO EQUIPMENT PLANS FOR CASEWORK, DISPLAY BOARDS, LOCKERS, AND OTHER ADDITIONAL TYPICAL EQUIPMENT NOTES AND INFORMATION.
- O. REFER TO EQUIPMENT PLANS FOR REFERENCE TO ENLARGED TOILET ROOM PLANS AND TOILET ACCESSORIES.


PLAN LEGEND:

- INDICATES STOREFRONT, CURTAIN WALL, OR WINDOW SYSTEM. REFER TO A-600 SERIES DRAWINGS FOR ELEVATIONS AND DETAILS.
- INDICATES WALL TYPES REFER TO G-201 FOR WALL THICKNESS, HEIGHT, AND COMPOSITION.

PLAN NOTES:

(ALL PLAN NOTES MAY NOT BE INDICATED ON THIS SHEET.)


- 1 CONCRETE STOOP/VOID SLAB, REFER TO STRUCTURAL DRAWINGS.
- 2 PUSH PAD FOR ADA OPERATOR, REFER TO ELECTRICAL DRAWINGS.
- 3 CARD/FOB READER, REFER TO ELECTRICAL/TECHNOLOGY DRAWINGS.
- 4 KNOX BOX.
- 5 CASEWORK, MILLWORK, MARKER/TACK BOARDS AND EQUIPEMENT. REFER TO 700 SERIES DRAWINGS.
- 6 PLUMBING FIXTURE. SEE PLUMBING DRAWINGS.
- 7 FILL IN OPENING WITH SAME MATERIAL AS ADJOINING WALLS.
- 8 PROVIDE NEW 4" CONCRETE FLOOR SLAB.
- 9 MOP SINK. REFER TO PLUMBING DRAWINGS.
- 10 HOUSE KEEPING PAD. VERIFY SIZE AND LOCATION WITH MECHANICAL TRADES. SEE STRUCTURAL DRAWINGS FOR DETAIL.
- 11 10'-0" STAINLESS STEEL ROLL-UP DOOR. HEAD AT 8'-0" AFF. COORDINATE BOTTOM OF DOOR WITH KITCHEN EQUIPMENT.
- 12 WALLS AROUND PERIMETER OF VESTIBULE TO EXTEND TO DECK.
- 13 LOCKERS TYPE F.
- 14 GYPSUM BOARD BULKHEAD. REFER TO 900 SERIES DRAWINGS.
- 15 LOCKERS TYPE G.
- 16 ROOF HATCH AND LADDER.
- 17 FLOOR DRAIN, REFER TO PLUMBING DRAWING.
- 18 CABINET HEATER, REFER TO MECHANICAL DRAWINGS.
- 19 UNIT VENTILATOR, REFER TO MECHANICAL DRAWINGS.
- 20 ROOF CONDUCTOR, REFER TO PLUMBING DRAWINGS.
- 21 LINE OF CANOPY ABOVE, REFER TO SECTIONS.
- 22 6" PIPE BOLLARD, REFER TO CIVIL DRAWINGS.
- 23 CHAIN LINK FENCE, REFER TO CIVIL DRAWINGS.
- 24 DOWNSPOUT, REFER TO ROOF PLAN.
- 25 LAMINATE CERAMIC TILE BACKER BOARD TO ALL WALLS.
- 26 FOLDING PARTITION. SEE DETAIL.
- 27 PATCH WALL TO MATCH ADJOINING FINISHES WHERE WALL HAS BEEN REMOVED.
- 28 PATCH WALL TO MATCH ADJOINING FINISHES WHERE FLOOR SLAB HAS BEEN REMOVED.
- 29 NEW CONCRETE SLAB INFILL. REFER TO STRUCTURAL/PLUMBING DRAWINGS FOR EXTENT OF SLAB REMOVAL AND DETAILS.
- 30 PRIVACY CURTAIN TRACK. SEE DETAIL.
- 31 PARTIAL HEIGHT STUD WALL. SEE DETAIL.
- 32 PARTIAL HEIGHT BRICK/CMU WALL. SEE DETAIL.
- 33 VOLLEYBALL INSERT. SEE DETAIL.
- 34 BLEACHERS FULLY EXTENDED.
- 35 MOTORIZED BLEACHERS MOUNTED TO EXISTING WALL.
- 36 FILL IN RECESSED FLOOR WITH ARDEX. PREP TO RECEIVE NEW FLOOR FINISH.
- 37 PROVIDE TACKABLE SURFACE AND WALL FABRIC FROM FLOOR TO EXISTING LINTEL.
- 38 FILL OPENING WITH 6" CMU. HOLD CMU BACK 2" ON CORRIDOR SIDE.
- 39 LAMINATE 5/8" GYPSUM BOARD TO EXISTING OR NEW MASONRY WALL.
- 40 EXISTING WALL PADDING TO REMAIN.
- 41 EXISTING DRINKING FOUNTAINS TO REMAIN.
- 42 FILL IN OPENING WITH 8" CMU.
- 43 PROVIDE "ARDEX" SUBFLOOR/FLOOR PATCHING AND PREP FLOOR FOR NEW FINISH.
- 44 SEE STRUCTURAL DRAWINGS FOR SLAB IN-FILL.
- 45 THREE 2 1/2" STRUCTURAL METAL STUDS INSIDE STOREFRONT FRAMING TO SUPPORT 6" BOXED HEADER ABOVE.
- 46 WRAP COLUMN WITH TYPE C4 WALL TYPES. SEE CLASSROOM G-101 FOR TYPICAL DIMENSIONS.
- 47 WRAP COLUMN WITH 4" CMU AND RECLAIMED EXISTING FACE BRICK.
- 48 BRONZE PLAQUE. REFER TO SPECIFICATIONS.
- 49 PROVIDE NEW CONCRETE SLAB OVER EXISTING CONCRETE PLANKS.
- 50 SAFETY CUSHION WAINSCOTING.
- 51 FILL IN OPENING WITH CMU. FINISH FLUSH WITH ADJACENT SURFACES.
- 52 ELECTROSTATIC PAINT EXISTING LOCKERS.
- 53 6'-0" WIDE X 4'-4" HIGH ROLL-UP DOOR.
- 54 PROVIDE NEW CONCRETE SLAB OVER EXISTING RECESSED CONCRETE SLAB.

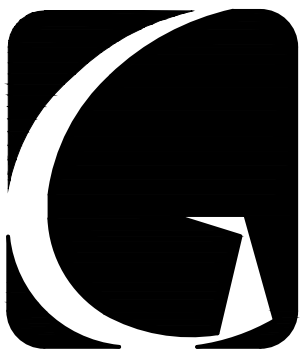

GIBALTAR
DESIGN
ARCHITECTURE • ENGINEERING • INTERIOR DESIGN

PROJECT
**LIBERTY
INTERMEDIATE
SCHOOL -
ADDITIONS &
RENOVATIONS**

DUNELAND SCHOOL CORPORATION
CHESTERTON, INDIANA

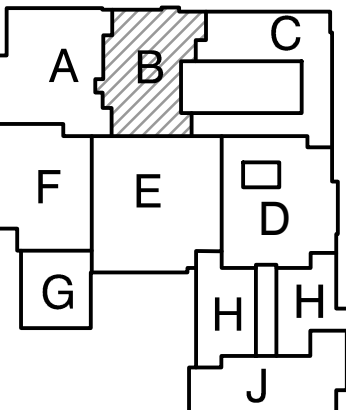

KEY PLAN

GIBALTAR DESIGN

9102 N. Meridian St., Ste. 300
Indianapolis, IN 46260
Homepage www.GibraltarDesign.com
Email info@GibraltarDesign.com
Phone 317.580.5777 Fax 317.580.5778

PROJECT
21-139

DATE
04/25/22

COORDINATED BY
DJW

DRAWN BY
CND KLS

CHECKED BY
BCB

COPYRIGHT NOTICE:
THE CONCEPTS, DESIGNS, PLANS, DETAILS, ETC., SHOWN ON THIS DOCUMENT ARE THE PROPERTY OF GIBALTAR DESIGN AND ARE NOT TO BE REPRODUCED OR USED IN ANY MANNER OR FOR ANY PURPOSE WITHOUT THE EXPRESS WRITTEN CONSENT OF GIBALTAR DESIGN. THE OWNER MAY RETAIN COPIES FOR INFORMATION AND REFERENCE IN CONNECTION ONLY WITH THIS PROJECT.

REVISIONS

MARK DATE ISSUED FOR

AD-5 05/23/22 ADDENDUM NO. 5

DRAWING

UNIT "B" ARCHITECTURAL

FIRST FLOOR PLAN

PROJECT


LIBERTY IS -

ADDITIONS & RENOVATIONS

© GIBALTAR DESIGN SHEET


B

A-102

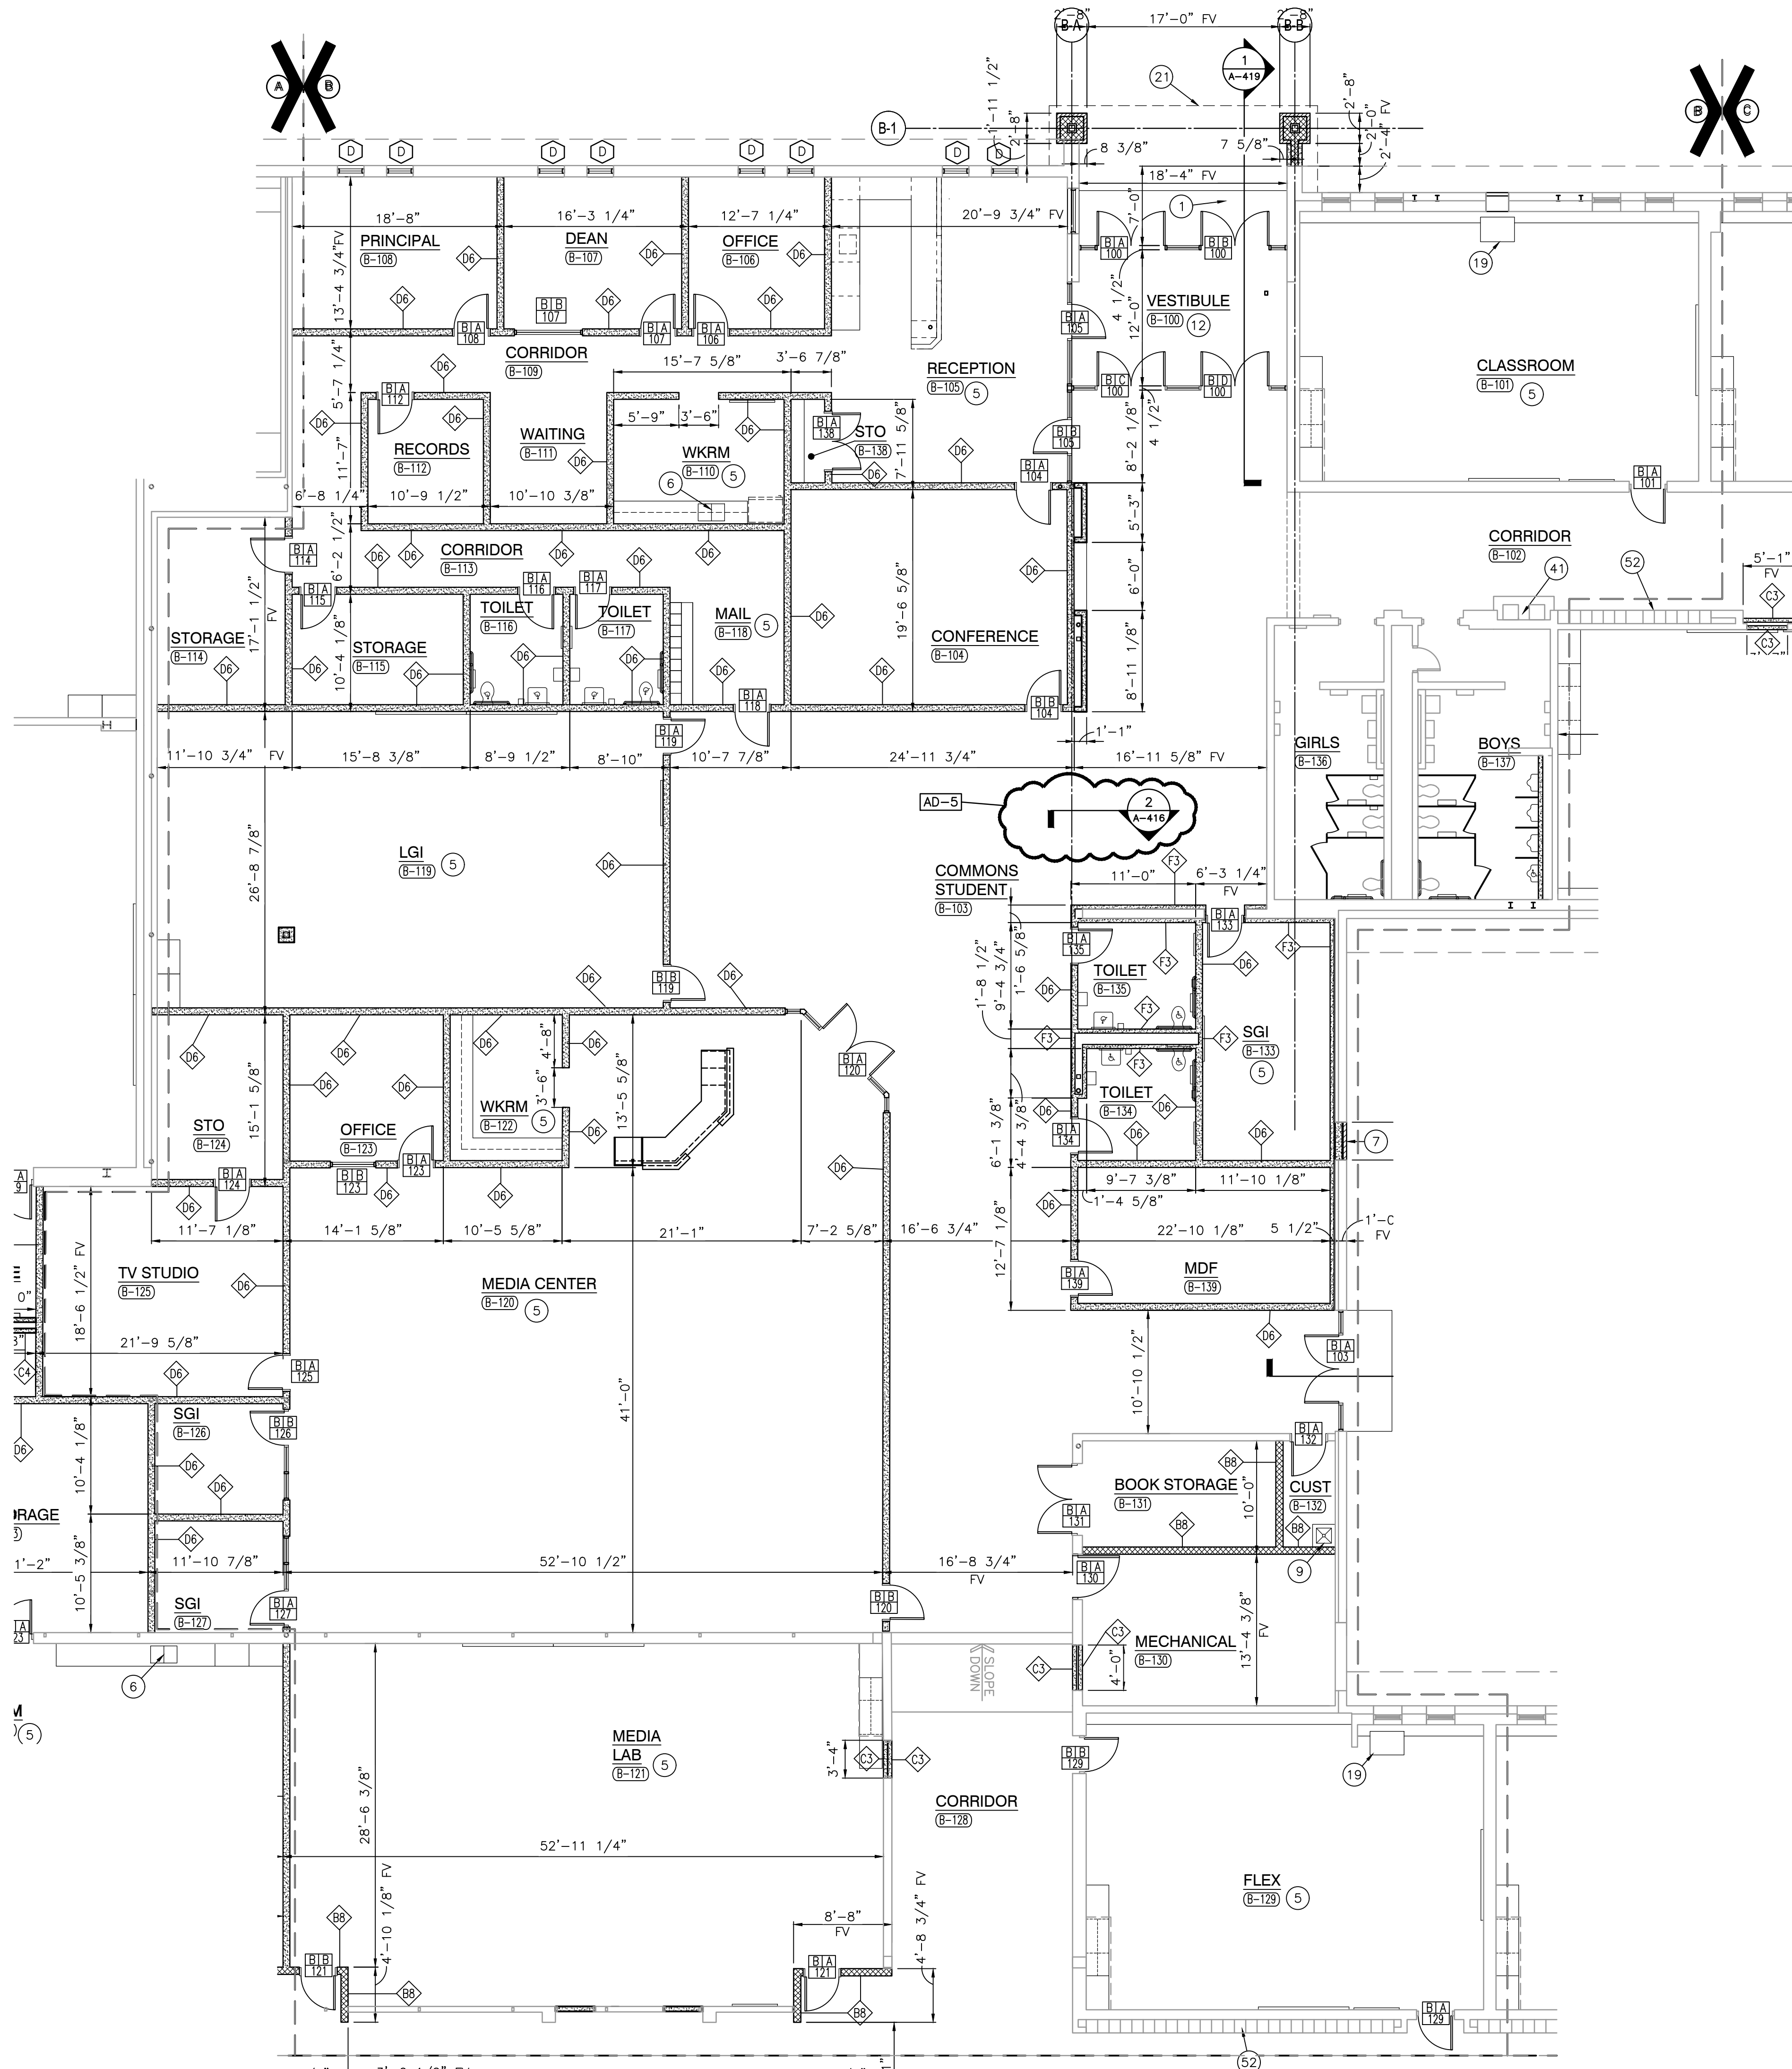

UNIT "B" ARCHITECTURAL FIRST FLOOR PLAN

SCALE: 1/8" = 1'-0"

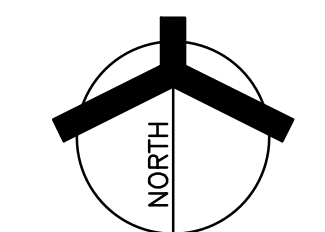

Monday, 5/23/2022 - 2:10 PM - LAST SAVED BY:GDAVIS
Y:\21-139 DUNELAND SC - LIBERTY INTERMEDIATE SCHOOL
ADDITIONS AND RENOVATIONS\21-139 DRAWINGS\05
ARCH\A-102.DWG

GENERAL PLAN NOTES:

- A. FOR GENERAL PROJECT NOTES, MATERIAL INDICATIONS LEGEND, SYMBOL LEGEND, ABBREVIATIONS, ETC., REFER TO 'C' SERIES SHEETS.
- B. PLAN DIMENSIONS TO MASONRY WALLS ARE TO FACE OF ROUGH MASONRY. PLAN DIMENSIONS TO STUD WALLS ARE TO FACE OF FINISHED GYPSUM BOARD OR PLASTER. PLAN DIMENSIONS TO STUD WALLS WITH CERAMIC TILE FINISH ARE TO THE FACE OF TILE BACKER BOARD.
- C. ALL CMU WALLS THAT DO NOT LAY OUT IN FULL OR HALF LENGTHS SHOULD BE BALANCED SO AS NOT TO HAVE ANY PIECES LESS THAN 4" IN SIZE EXPOSED TO VIEW.
- D. MASONRY WALLS BEARING ON A THICKENED SLAB AT SLAB DEPRESSIONS REQUIRE CUT MASONRY UNITS SO THAT COURSING BEGINS AT THE FLOOR LINE.
- E. THE BASE FIRST FLOOR ELEVATION INDICATED FOR THE PROJECT IS 100'-0". REFER TO SITE PLAN FOR CORRELATION TO USGS DATUM.
- F. HINGE SIDE OF DOOR JAMB AT CMU WALLS SHALL BE LOCATED 8" MINIMUM FROM ADJACENT WALL AND HINGE SIDE OF DOOR JAMB AT GYPSUM BOARD WALLS SHALL BE LOCATED 4" MINIMUM FROM ADJACENT WALL UNLESS NOTED OTHERWISE.
- G. PROVIDE WOOD BLOCKING (OR METAL STRAPPING WHERE APPLICABLE) AS REQUIRED WITHIN METAL STUD WALLS FOR WALL MOUNTED ITEMS.
- H. REFER TO LIFE SAFETY PLANS REGARDING FIRE RATED WALL LOCATIONS AND OTHER CODE INFORMATION.
- I. INTERIOR CMU WALLS ARE TO BE RUNNING BOND UNLESS NOTED OTHERWISE.
- J. ALL EXPOSED CONCRETE MASONRY UNITS (CMU) CORNERS ARE TO BE BULLNOSED, EXCEPT AT MASONRY BULKHEADS AND EXTERIOR WINDOW JAMBS.
- K. WHERE NEW CMU WALLS INTERSECT EXISTING CMU WALLS AT A CORNER OR ARE ALIGNED WITH EXISTING CMU WALLS, TOOTH NEW CMU INTO EXISTING CMU UNLESS NOTED OTHERWISE.
- L. REFER TO DEMOLITION SHEETS FOR ADDITIONAL PATCHING AND REPAIR WORK.
- M. REFER TO FINISH PLANS FOR INTERIOR ELEVATIONS, LOCATION AND EXTENT OF FINISHED FLOOR AND WALL MATERIAL.
- N. REFER TO EQUIPMENT PLANS FOR CASEWORK, DISPLAY BOARDS, LOCKERS, AND OTHER ADDITIONAL TYPICAL EQUIPMENT NOTES AND INFORMATION.
- O. REFER TO EQUIPMENT PLANS FOR REFERENCE TO ENLARGED TOILET ROOM PLANS AND TOILET ACCESSORIES.


PLAN LEGEND:

- INDICATES STOREFRONT, CURTAIN WALL, OR WINDOW SYSTEM. REFER TO A-600 SERIES DRAWINGS FOR ELEVATIONS AND DETAILS.
- INDICATES WALL TYPES REFER TO G-201 FOR WALL THICKNESS, HEIGHT, AND COMPOSITION.

PLAN NOTES:

(ALL PLAN NOTES MAY NOT BE INDICATED ON THIS SHEET.)


- 1 CONCRETE STOOP/VOID SLAB, REFER TO STRUCTURAL DRAWINGS.
- 2 PUSH PAD FOR ADA OPERATOR, REFER TO ELECTRICAL DRAWINGS.
- 3 CARD/FOB READER, REFER TO ELECTRICAL/TECHNOLOGY DRAWINGS.
- 4 KNOX BOX.
- 5 CASEWORK, MILLWORK, MARKER/TACK BOARDS AND EQUIPMENT. REFER TO 700 SERIES DRAWINGS.
- 6 PLUMBING FIXTURE. SEE PLUMBING DRAWINGS.
- 7 FILL IN OPENING WITH SAME MATERIAL AS ADJOINING WALLS.
- 8 PROVIDE NEW 4" CONCRETE FLOOR SLAB.
- 9 MOP SINK. REFER TO PLUMBING DRAWINGS.
- 10 HOUSE KEEPING PAD. VERIFY SIZE AND LOCATION WITH MECHANICAL TRADES. SEE STRUCTURAL DRAWINGS FOR DETAIL.
- 11 10'-0" STAINLESS STEEL ROLL-UP DOOR. HEAD AT 8'-0" AFF. COORDINATE BOTTOM OF DOOR WITH KITCHEN EQUIPMENT.
- 12 WALLS AROUND PERIMETER OF VESTIBULE TO EXTEND TO DECK.
- 13 LOCKERS TYPE F.
- 14 GYPSUM BOARD BULKHEAD. REFER TO 900 SERIES DRAWINGS.
- 15 LOCKERS TYPE G.
- 16 ROOF HATCH AND LADDER.
- 17 FLOOR DRAIN, REFER TO PLUMBING DRAWING.
- 18 CABINET HEATER, REFER TO MECHANICAL DRAWINGS.
- 19 UNIT VENTILATOR, REFER TO MECHANICAL DRAWINGS.
- 20 ROOF CONDUCTOR, REFER TO PLUMBING DRAWINGS.
- 21 LINE OF CANOPY ABOVE, REFER TO SECTIONS.
- 22 6" PIPE BOLLARD, REFER TO CIVIL DRAWINGS.
- 23 CHAIN LINK FENCE, REFER TO CIVIL DRAWINGS.
- 24 DOWNSPOUT, REFER TO ROOF PLAN.
- 25 LAMINATE CERAMIC TILE BACKER BOARD TO ALL WALLS.
- 26 FOLDING PARTITION. SEE DETAIL.
- 27 PATCH WALL TO MATCH ADJOINING FINISHES WHERE WALL HAS BEEN REMOVED.
- 28 PATCH WALL TO MATCH ADJOINING FINISHES WHERE FLOOR SLAB HAS BEEN REMOVED.
- 29 NEW CONCRETE SLAB INFILL. REFER TO STRUCTURAL/PLUMBING DRAWINGS FOR EXTENT OF SLAB REMOVAL AND DETAILS.
- 30 PRIVACY CURTAIN TRACK. SEE DETAIL.
- 31 PARTIAL HEIGHT STUD WALL. SEE DETAIL.
- 32 PARTIAL HEIGHT BRICK/CMU WALL. SEE DETAIL.
- 33 VOLLEYBALL INSERT. SEE DETAIL.
- 34 BLEACHERS FULLY EXTENDED.
- 35 MOTORIZED BLEACHERS MOUNTED TO EXISTING WALL.
- 36 FILL IN RECESSED FLOOR WITH AROX. PREP TO RECEIVE NEW FLOOR FINISH.
- 37 PROVIDE TACKABLE SURFACE AND WALL FABRIC FROM FLOOR TO EXISTING LINTEL.
- 38 FILL OPENING WITH 6" CMU. HOLD CMU BACK 2" ON CORRIDOR SIDE.
- 39 LAMINATE 5/8" GYPSUM BOARD TO EXISTING OR NEW MASONRY WALL.
- 40 EXISTING WALL PADDING TO REMAIN.
- 41 EXISTING DRINKING FOUNTAINS TO REMAIN.
- 42 FILL IN OPENING WITH 8" CMU.
- 43 PROVIDE "AROX" SUBFLOOR/FLOOR PATCHING AND PREP FLOOR FOR NEW FINISH.
- 44 SEE STRUCTURAL DRAWINGS FOR SLAB IN-FILL.
- 45 THREE 2 1/2" STRUCTURAL METAL STUDS INSIDE STOREFRONT FRAMING TO SUPPORT 6" BOXED HEADER ABOVE.
- 46 WRAP COLUMN WITH TYPE C4 WALL TYPES.
- 47 SEE CLASSROOM G-101 FOR TYPICAL DIMENSIONS.
- 48 WRAP COLUMN WITH 4" CMU AND RECLAIMED EXISTING FACE BRICK.
- 49 BRONZE PLAQUE. REFER TO SPECIFICATIONS.
- 50 PROVIDE NEW CONCRETE SLAB OVER EXISTING CONCRETE PLANKS.
- 51 SAFETY CUSHION WAINSCOTING.
- 52 FILL IN OPENING WITH CMU. FINISH FLUSH WITH ADJACENT SURFACES.
- 53 ELECTROSTATIC PAINT EXISTING LOCKERS.
- 54 6'-0" WIDE X 4'-4" HIGH ROLL-UP DOOR.
- 55 PROVIDE NEW CONCRETE SLAB OVER EXISTING RECESSED CONCRETE SLAB.

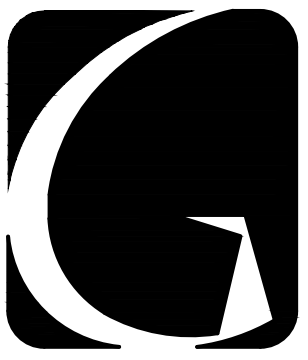

GIBRALTAR
DESIGN
ARCHITECTURE • ENGINEERING • INTERIOR DESIGN

PROJECT
**LIBERTY
INTERMEDIATE
SCHOOL -
ADDITIONS &
RENOVATIONS**

DUNELAND SCHOOL CORPORATION
CHESTERTON, INDIANA

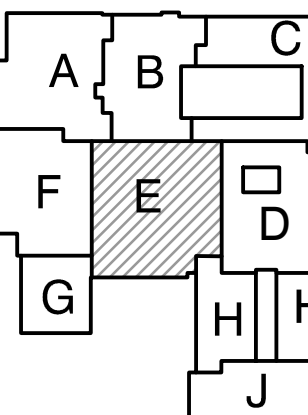

KEY PLAN

GIBRALTAR DESIGN

9102 N. Meridian St., Ste. 300
Indianapolis, IN 46260
Homepage: www.GibraltarDesign.com
Email: info@GibraltarDesign.com
Phone: 317.580.5777 Fax: 317.580.5778

PROJECT
21-139
DATE
04/25/22
COORDINATED BY
DJW
DRAWN BY
CND KLS
CHECKED BY
BCB

COPYRIGHT NOTICE:
THE CONCEPTS, DESIGNS, PLANS, DETAILS, ETC., SHOWN ON THIS DOCUMENT ARE THE PROPERTY OF GIBRALTAR DESIGN AND WERE CREATED FOR USE ON THIS SPECIFIC PROJECT. NONE OF THIS INFORMATION SHALL BE USED BY ANY PERSON OR FIRM FOR ANY PURPOSE WITHOUT THE EXPRESS WRITTEN CONSENT OF GIBRALTAR DESIGN. THE OWNER MAY RETAIN COPIES FOR INFORMATION AND REFERENCE IN CONNECTION ONLY WITH THIS PROJECT.


REVISIONS	MARK	DATE	ISSUED FOR
AD-1	05/05/22	ADDENDUM NO. 1	
AD-3	5/12/22	ADDENDUM NO.3	
AD-4	5/18/22	ADDENDUM NO.4	
AD-5	5/23/22	ADDENDUM NO.5	

DRAWING
**UNIT "E" ARCHITECTURAL
FIRST FLOOR PLAN**

PROJECT
**LIBERTY IS -
ADDITIONS & RENOVATIONS**


© GIBRALTAR DESIGN SHEET

E A-105

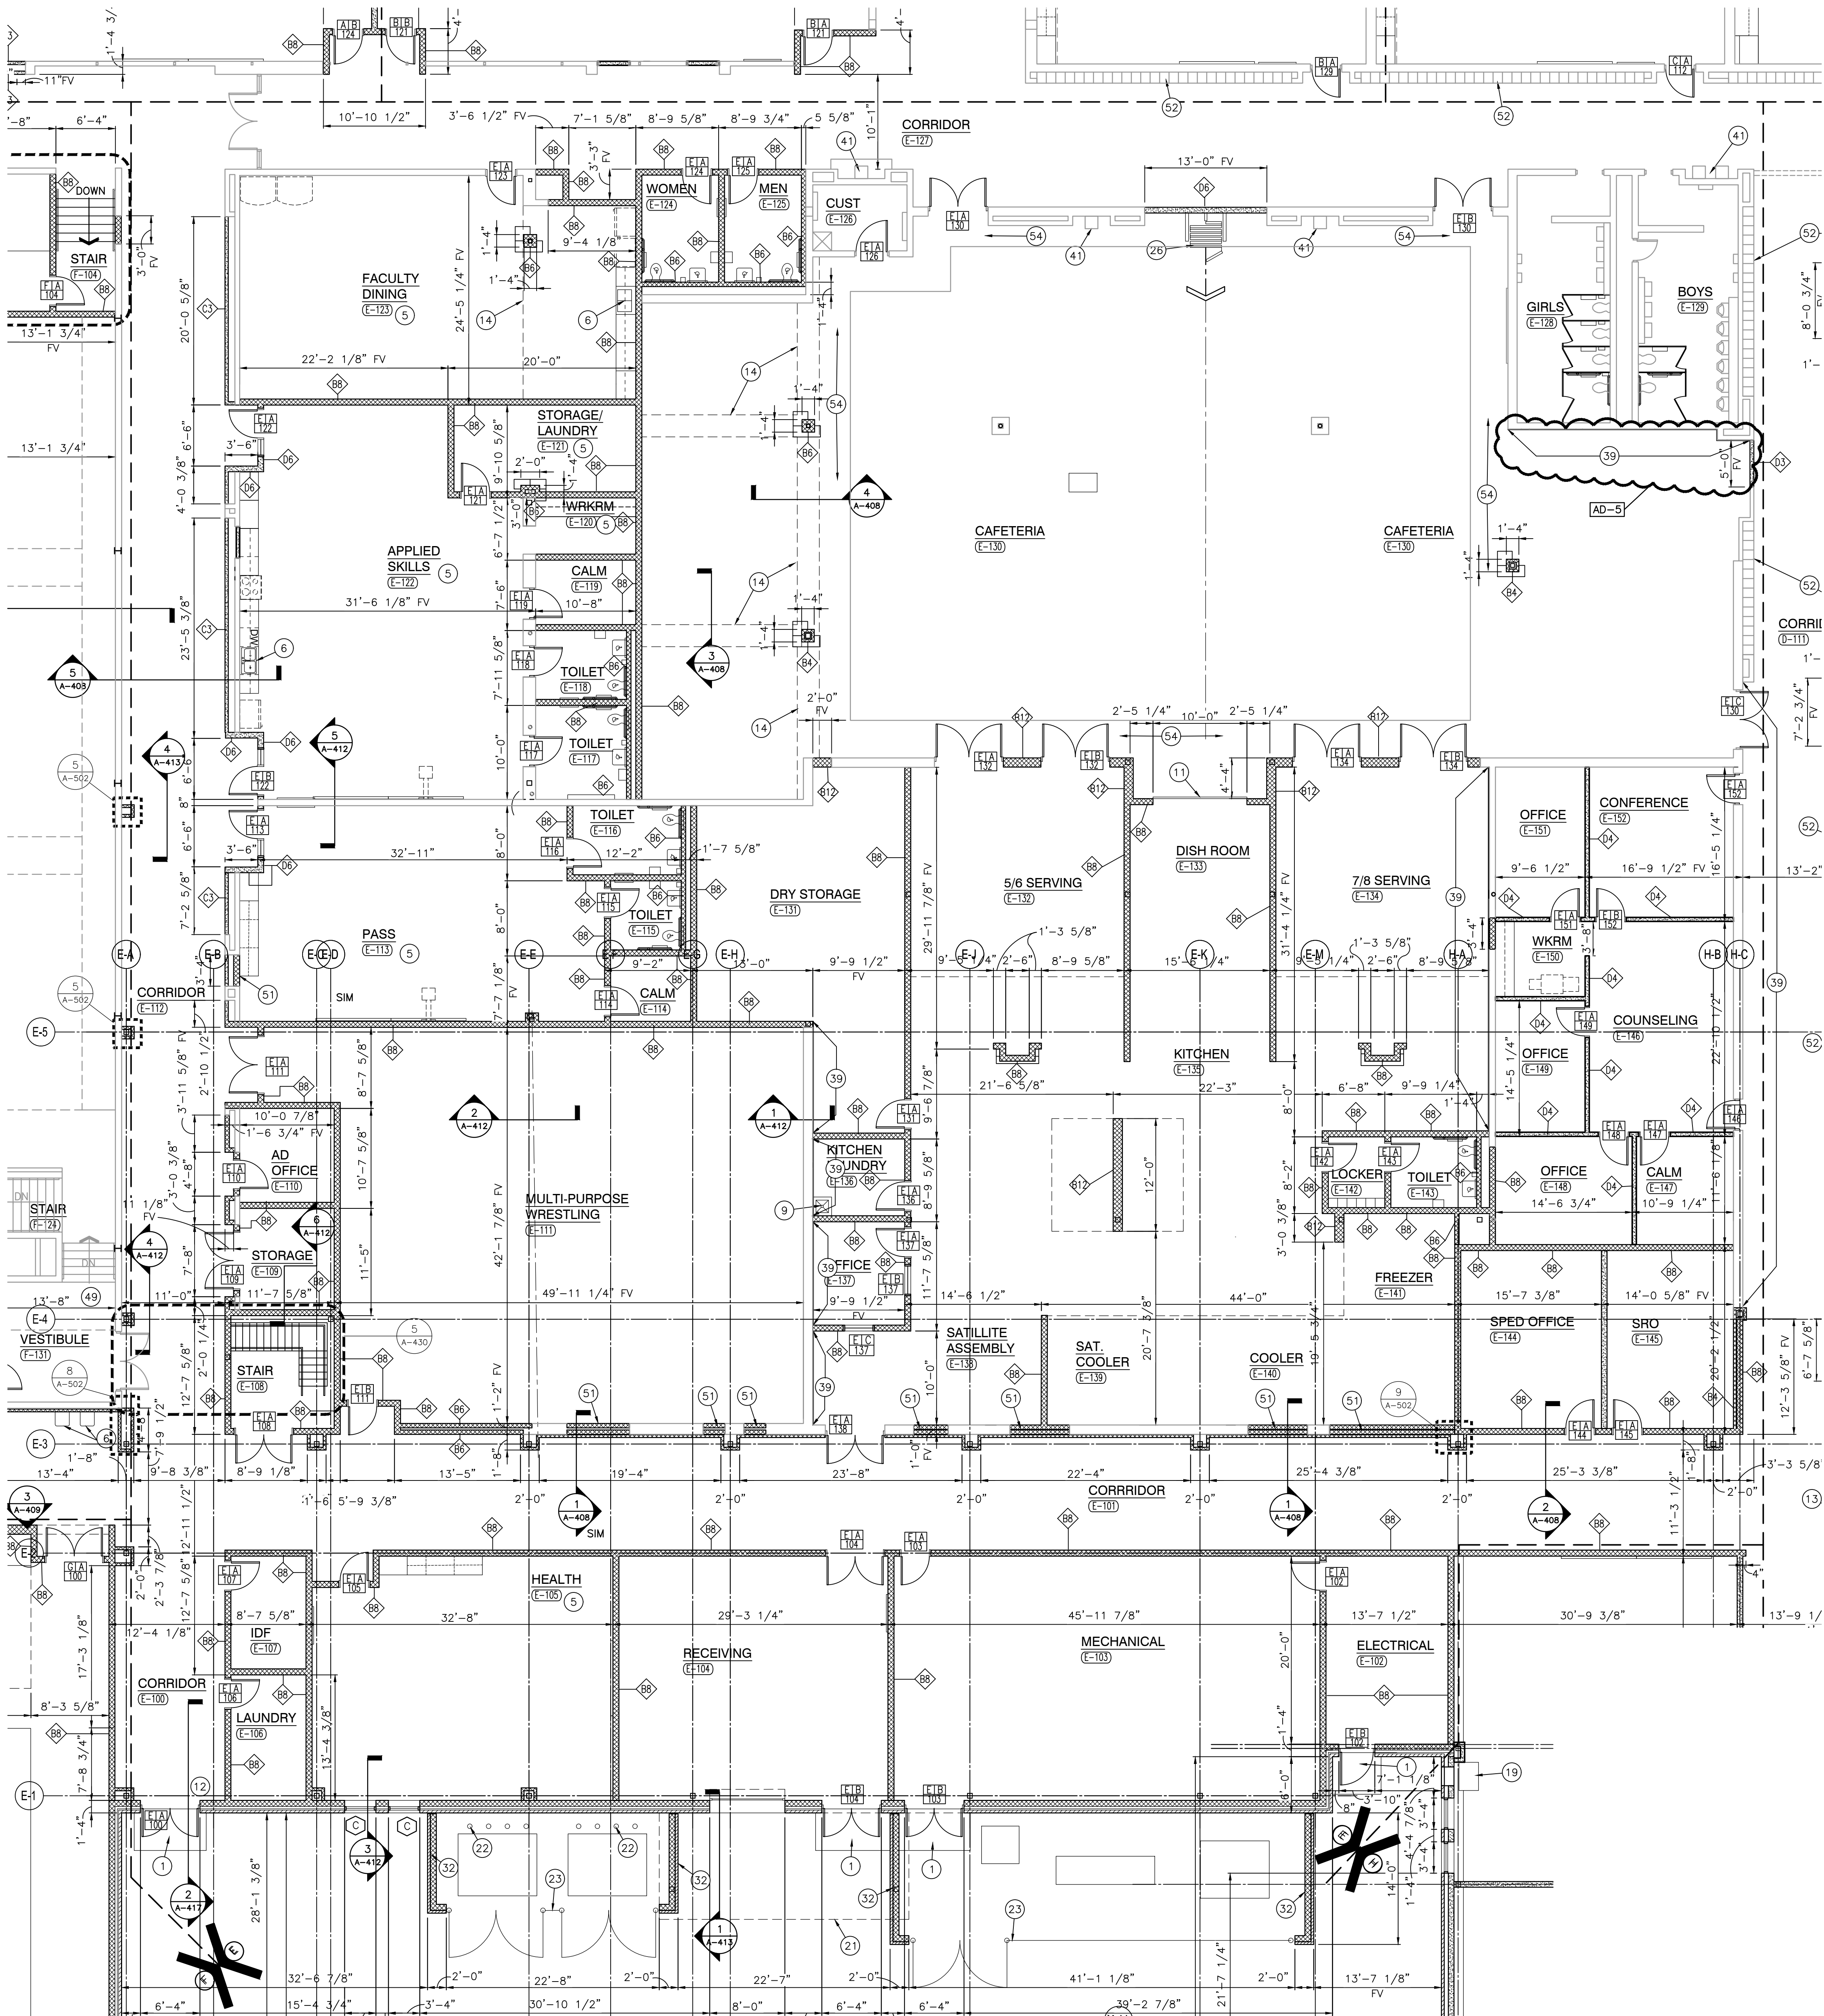


UNIT "E" ARCHITECTURAL FIRST FLOOR PLAN

SCALE: 1/8" = 1'-0"

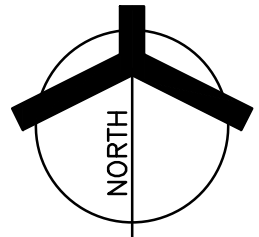

Friday, 5/20/2022 - 10:43 AM - LAST SAVED BY: STERILL
Y:\21-139 DUNELAND SC - LIBERTY INTERMEDIATE SCHOOL
ADDITIONS AND RENOVATIONS\21-139 DRAWINGS\05
ARCH\A-803.DWG

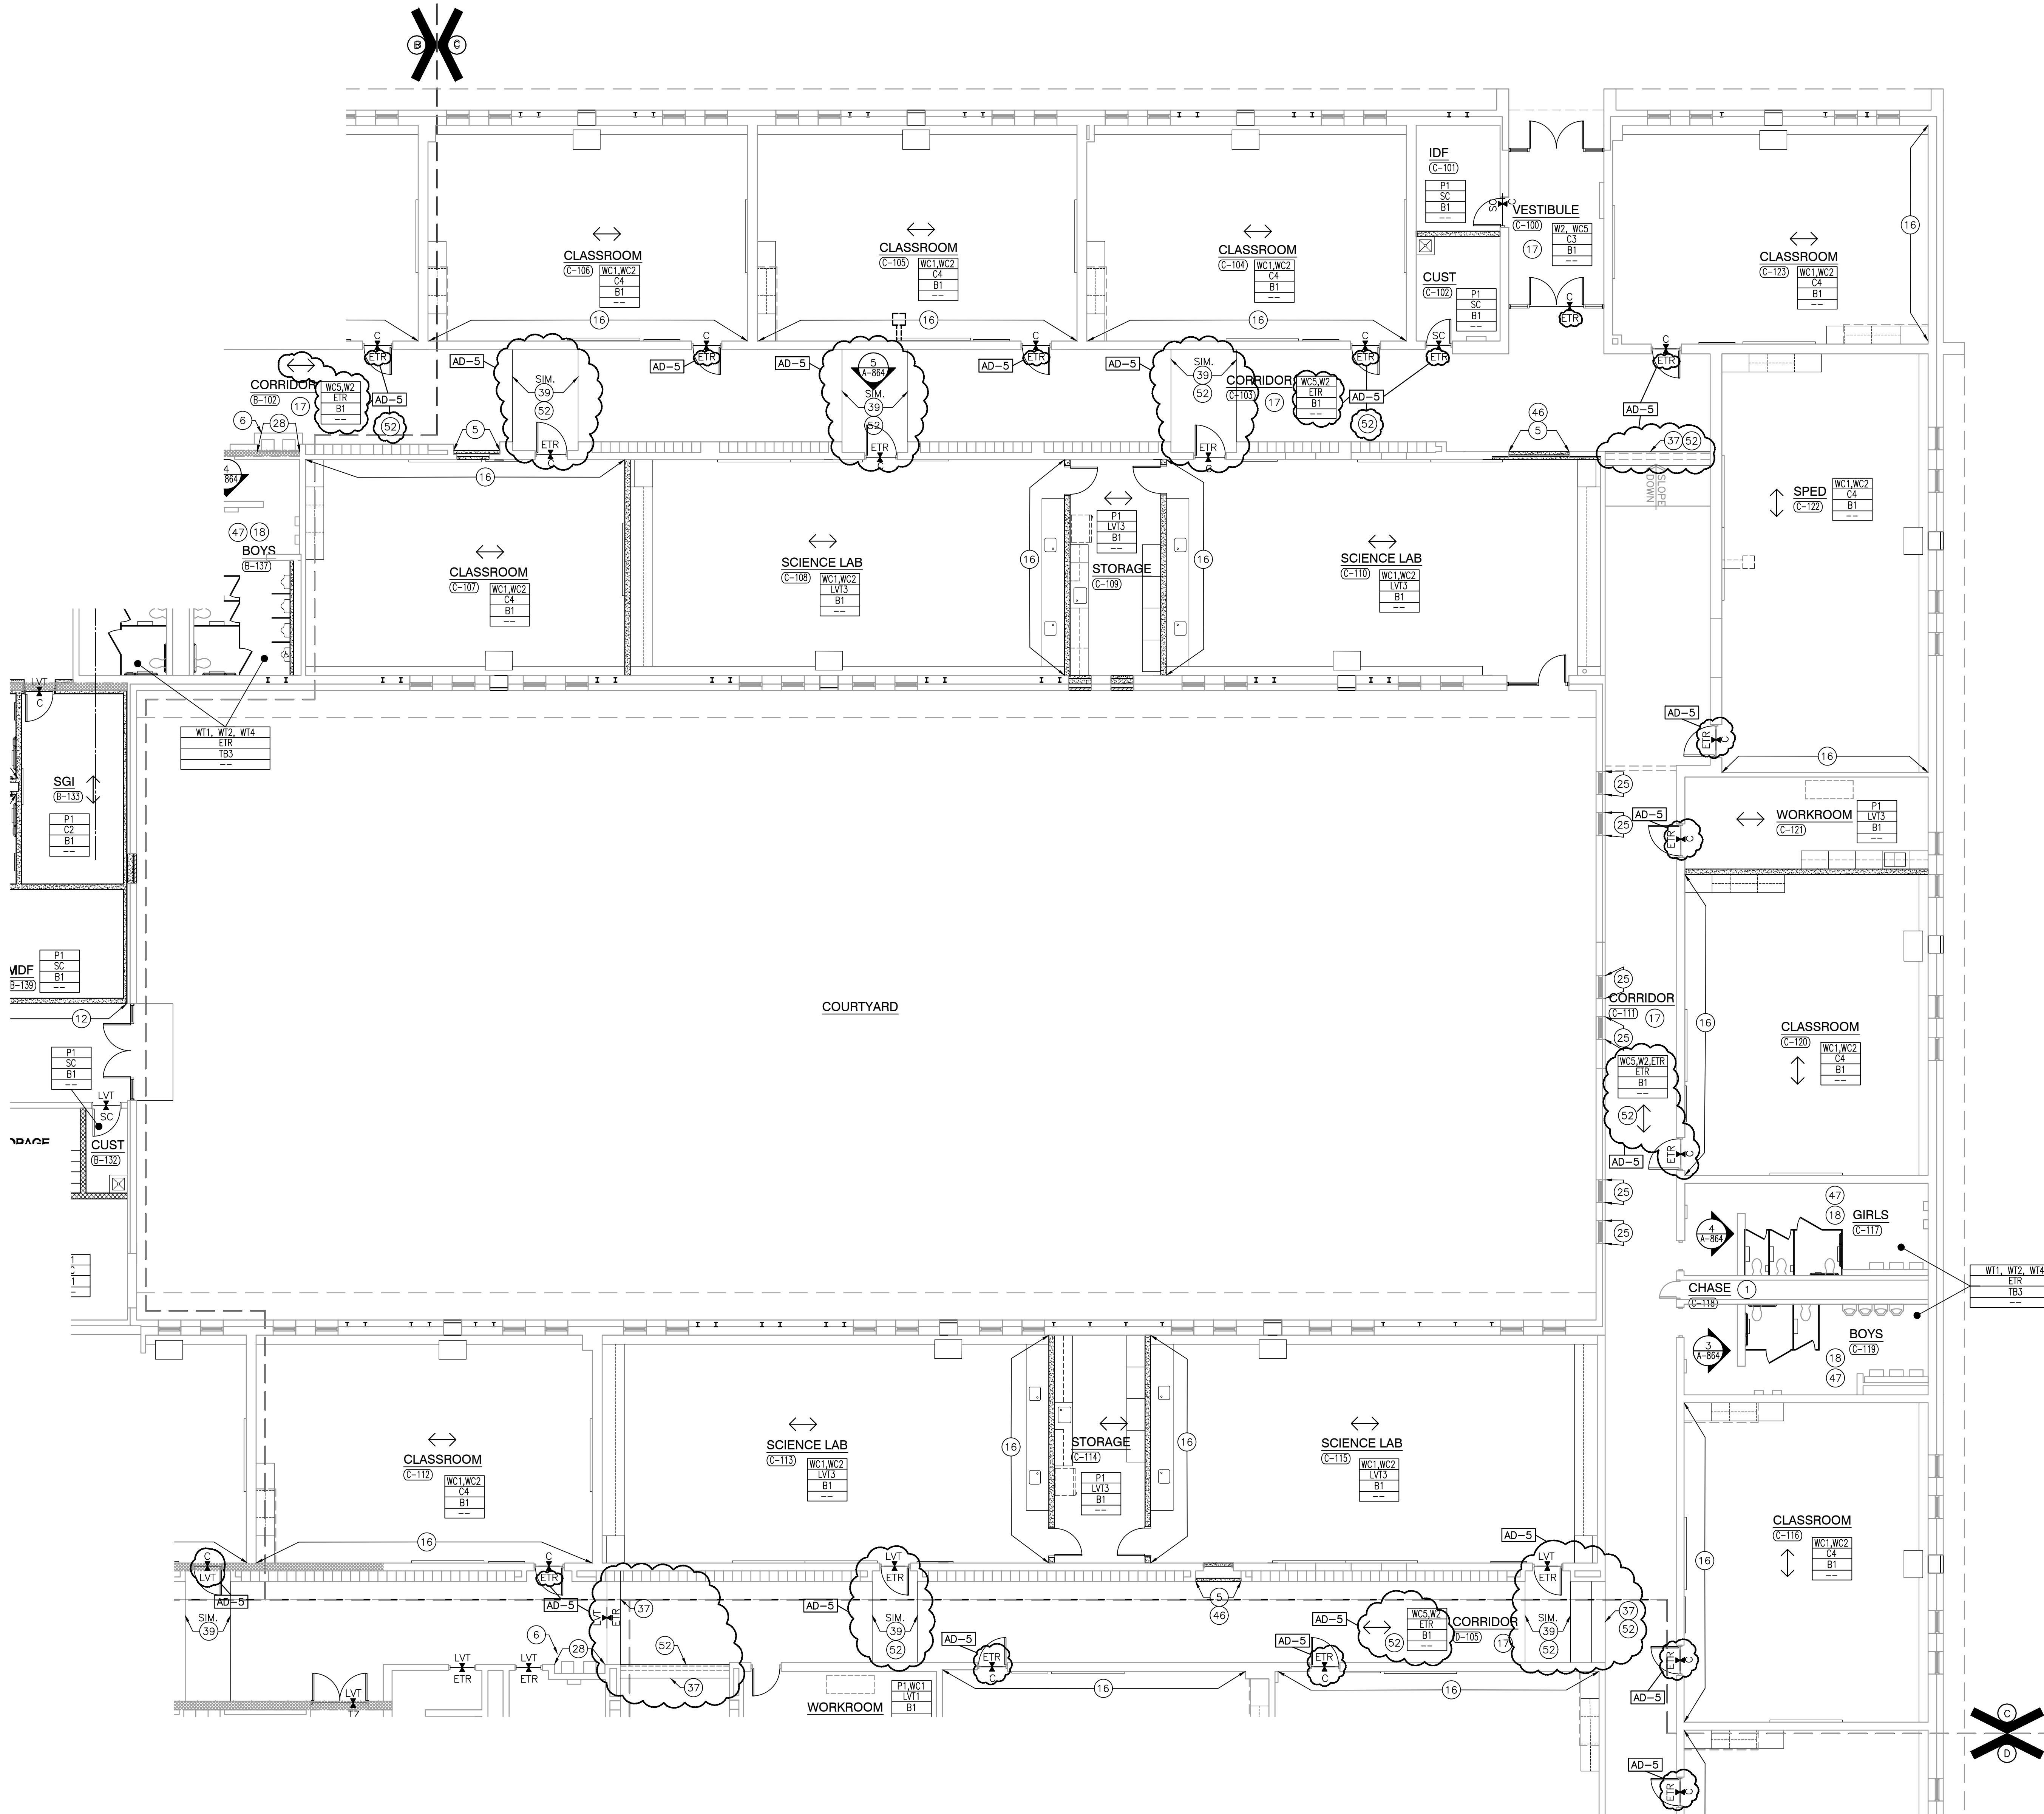

UNIT "C" FIRST FLOOR FINISH PLAN
SCALE: 1/8" = 1'-0"

GENERAL FINISH PLAN NOTES:

- REFERENCE FINISH LEGEND FOR FINISH INFORMATION.
- REFERENCE FLOOR PATTERN PLANS, EQUIPMENT PLANS, INTERIOR ELEVATIONS, REFLECTED CEILING PLANS AND WRITTEN SPECIFICATIONS FOR ADDITIONAL FINISH INFORMATION.
- PRIOR TO INSTALLATION OF NEW FINISHES CONTRACTOR SHALL INSPECT ALL SUBSTRATES. IF A SUBSTRATE IS DEEMED UNACCEPTABLE THE CONTRACTOR SHALL TAKE THE NECESSARY STEPS TO RECTIFY THE SITUATION OR CONTACT THE ARCHITECT WITH THE CONCERN. PROCEEDING WITH THE INSTALLATION OF FINISHES WILL BE CONSTRUED THAT THE INSTALLER AND/OR FINISHER HAS ACCEPTED SAID SUBSTRATE. NO CHANGE ORDER WILL BE ISSUED TO RECTIFY CONCEALED, OR UNSATISFACTORY SUBSTRATE ONCE FINISH WORK HAS PROCEEDED.
- PREPARE ALL WALL CONSTRUCTION, NEW AND EXISTING, TO RECEIVE NEW FINISHES AS PER MANUFACTURE'S RECOMMENDED INSTALLATION METHODS AND MATERIALS FOR ALL FINISHES.
- ALL FLOORING IS TO BE LEVELED WITHIN 1/4" IN 10'-0" WITH LATEX MATERIAL. MOISTURE CONTENT IN AREA IS TO BE TESTED PRIOR TO INSTALLATION OF FLOORING MATERIAL. CONTRACTOR TO INSTALL FLOORING PER MANUFACTURER'S RECOMMENDED METHOD.
- FLOORING CONTRACTOR TO SUBMIT A SEAMING DIAGRAM FOR FLOORING MATERIAL INCLUDING NOTATION OF MATERIAL DIRECTION.
- ALL FLOORING TRANSITIONS SHALL COMPLY WITH ADA GUIDELINES.
- ALL EXPOSED METAL SURFACES, SUCH AS GRILLES, FIRE EXTINGUISHER CABINETS, ETC. THAT ARE NOTED TO BE PAINTED, SHALL BE PAINTED WITH ALKID TYPE PAINT. COLOR TO BE COORDINATED WITH DESIGNER UNLESS OTHERWISE NOTED.
- CONTRACTOR TO PROVIDE AND INSTALL FLOORING TRANSITIONS AS INDICATED ON PLANS. WHERE NONE ARE NOTED, CONTRACTOR SHALL VERIFY REQUIRED TYPE/COLOR WITH ARCHITECT.
- THE CONTRACTOR SHALL BE RESPONSIBLE TO VERIFY THAT ALL NEW INTERIOR WALL AND CEILING FINISHES WILL BE CLASS B MINIMUM, WITH A FLAME SPREAD RATING OF 75 MAXIMUM, AND A SMOKE DEVELOPED INDEX OF 450 MAXIMUM, PER ISO SECTION 803.
- PAINT ALL DOOR FRAMES P4 - ALL SIDES UNLESS NOTED OTHERWISE.
- NO VINYL BASE TO BE INSTALLED ON BRICK WALLS.

FINISH SYMBOL LEGEND:

P1	WALL FINISH
C1	FLOOR FINISH
B1	BASE FINISH
---	MISC FINISH INFORMATION

+	FLOOR TRANSITION STRIP AS REQUIRED
↑	INDICATES DIRECTION OF FLOOR MATERIAL GRAIN

FINISH PLAN NOTES:

(ALL PLAN NOTES MAY NOT BE INDICATED ON THIS PLAN)

- NO NEW FINISHES THIS ROOM, EXCLUDING DOOR FRAMES CONNECTED TO OTHER ROOMS THAT RECEIVE NEW FINISHES.
- PAINT, P2.
- WALLCOATING, MATCH ADJACENT EXISTING PAINT COLOR.
- WALL TILE PATTERN, 5,6/A-864.
- WALLCOVERING, WC5.
- FLOOR TILE, ETR.
- WALLCOATING, W2.
- REFERENCE FLOOR PATTERN PLAN, 4/A-830.
- WALL TILE, HORIZONTAL ASHLAR, WT1.
- HATCH PATTERN INDICATES SEALED CONCRETE, SC AND VINYL BASE, B1 IN THIS AREA.
- SAFETY CUSHION WAINSCOT, ETR.
- END WALLCOVERING HERE.
- PAINT ALL EXPOSED CEILING, P6.
- PATCH FLOORING WITH TZ1.
- WALLCOVERING, WC4.
- WALLCOVERING, WC2.
- PAINT EXISTING WALL TILE, W2.
- PROVIDE TRIM ON ALL OUTSIDE CORNERS, TRIM3.
- WALLCOATING, W3.
- STAIR RISER AND STAIR TREAD WITH INTEGRAL NOSING, ST1.
- WALLCOATING, W1.
- PAINT, MATCH EXISTING WALL FINISHES.
- CT, CERAMIC FLOOR TILE IN SHOWER TO EXTEND 1'0" PAST CURB. ALIGN WITH WALL TILE. REFER TO 13/A-520.
- PAINT BOTTOM AND FACE OF BULKHEAD, P7.
- BRICK, ETR.
- PAINT NEW STEEL RAILINGS.
- PAINT EXISTING STEEL RAILINGS.
- WALL TILE, ETR.
- CERAMIC TILE ON LOCKER BASE, ETR.
- STAIRS, ETR.
- REFERENCE FLOOR PATTERN PLAN, 1/A-830.
- WALL TILE PATTERN, 2/A-862.
- PAINT WAINSCOT TO TOP OF CMU WALL, W2.
- LINE OF NEW BLEACHRS.
- PRIVACY CURTAIN, PC1.
- REFER TO GYMNASIUM COURTLINE PLAY, SHEET A-840.
- LV12, 18" X 18".
- REFERENCE FLOOR PATTERN PLAN, 2/A-830.
- REFERENCE FLOOR PATTERN PLAN, 6/A-830.
- REFERENCE FLOOR PATTERN PLAN, 3/A-830.
- REFERENCE FLOOR PATTERN PLAN, 5/A-830.
- REFERENCE FLOOR PATTERN PLAN, 7/A-830.
- NEW SAFETY CUSHION WAINSCOT.
- USE RUBBER FLOOR, R1 IN AREA WITH HATCH PATTERN.
- METAL TRIM TRANSITION, TRIM1.
- METAL TRIM TRANSITION, PLACED AT MATERIAL EDGE OF WALL, TRIM2.
- ALL WALLS TO RECEIVE WALL TILE, HORIZONTAL BRICK ASHLAR, WT1, UNLESS NOTED OTHERWISE.
- PAINT, P1.
- RAILINGS, ETR.
- PAINT STAIRS.
- NEW RAILING WILL NOT RECEIVE PAINT.
- ALTERNATE BID: FIELD=LV11 AND ACENT=LV12.




GIBRALTAR
DESIGN
ARCHITECTURE • ENGINEERING • INTERIOR DESIGN

PROJECT

LIBERTY INTERMEDIATE SCHOOL - ADDITIONS & RENOVATIONS

DUNELAND SCHOOL CORPORATION
CHESTERTON, INDIANA

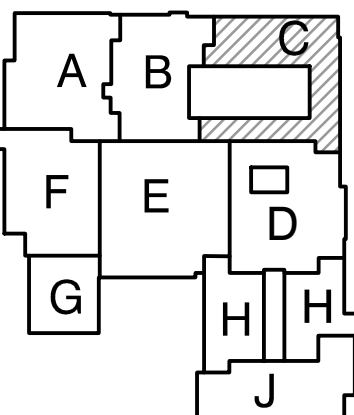

KEY PLAN

GIBRALTAR DESIGN

9102 N. Meridian St., Ste. 300
Indianapolis, IN 46260
Homepage: www.GibraltarDesign.com
Email: info@GibraltarDesign.com
Phone: 317.580.5777 Fax: 317.580.5778

PROJECT

21-139

DATE

04/25/22

COORDINATED BY

DJW

DRAWN BY

SDT

CHECKED BY

DJW

COPYRIGHT NOTICE:
THE CONCEPTS, DESIGNS, PLANS, DETAILS, ETC. SHOWN ON THIS DOCUMENT ARE THE PROPERTY OF GIBRALTAR DESIGN AND WERE CREATED FOR USE ON THIS SPECIFIC PROJECT. NONE OF THIS INFORMATION SHALL BE USED BY ANY PERSON OR FIRM FOR ANY PURPOSE WITHOUT THE EXPRESS WRITTEN CONSENT OF GIBRALTAR DESIGN. THE OWNER MAY RETAIN COPIES FOR INFORMATION AND REFERENCE IN CONNECTION ONLY WITH THIS PROJECT.

REVISIONS

MARK	DATE	ISSUED FOR
AD-1	5/05/22	ADDENDUM NO. 1
AD-5	5/23/22	ADDENDUM NO. 5

DRAWING

UNIT "C" FIRST FLOOR FINISH
PLAN

PROJECT


LIBERTY IS -
ADDITIONS & RENOVATIONS

© GIBRALTAR DESIGN

SHEET

C

A-803

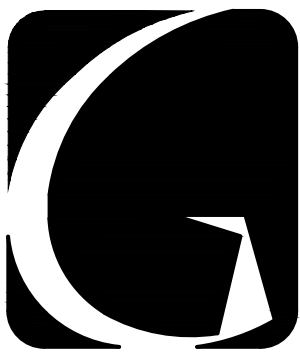


GIBRALTAR
DESIGN

ARCHITECTURE • ENGINEERING • INTERIOR DESIGN

PROJECT

**LIBERTY
INTERMEDIATE
SCHOOL -
ADDITIONS &
RENOVATIONS**

DUNELAND SCHOOL CORPORATION
CHESTERTON, INDIANA

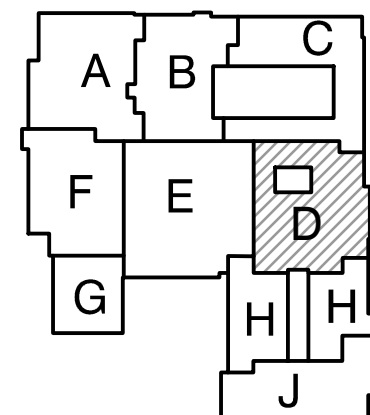

KEY PLAN

GIBRALTAR DESIGN

9102 N. Meridian St., Ste. 300
Indianapolis, IN 46260
Homepage: www.GibraltarDesign.com
Email: info@GibraltarDesign.com
Phone: 317.580.5777 Fax: 317.580.5778

PROJECT

21-139

DATE

04/25/22

COORDINATED BY

DJW

DRAWN BY

SDT

CHECKED BY

DJW

COPYRIGHT NOTICE:
THE CONCEPTS, DESIGNS, PLANS, DETAILS, ETC. SHOWN ON THIS DOCUMENT ARE THE PROPERTY OF GIBRALTAR DESIGN AND WERE CREATED FOR USE ON THIS SPECIFIC PROJECT. NONE OF THIS INFORMATION SHALL BE USED BY ANY PERSON OR FIRM FOR ANY PURPOSE WITHOUT THE EXPRESS WRITTEN CONSENT OF GIBRALTAR DESIGN. THE OWNER MAY RETAIN COPIES FOR INFORMATION AND REFERENCE IN CONNECTION ONLY WITH THIS PROJECT.

REVISIONS

MARK	DATE	ISSUED FOR
AD-1	5/05/22	ADDENDUM NO. 1
AD-5	5/23/22	ADDENDUM NO. 5

DRAWING

UNIT "D" FIRST FLOOR FINISH PLAN

PROJECT

**LIBERTY IS -
ADDITIONS & RENOVATIONS**

© GIBRALTAR DESIGN

SHEET

D

A-804

GENERAL FINISH PLAN NOTES:

- REFERENCE FINISH LEGEND FOR FINISH INFORMATION.
- REFERENCE FLOOR PATTERN PLANS, EQUIPMENT PLANS, INTERIOR ELEVATIONS, REFLECTED CEILING PLANS AND WRITTEN SPECIFICATIONS FOR ADDITIONAL FINISH INFORMATION.
- PRIOR TO INSTALLATION OF NEW FINISHES CONTRACTOR SHALL INSPECT ALL SUBSTRATES. IF A SUBSTRATE IS DEEMED UNACCEPTABLE THE CONTRACTOR SHALL TAKE THE NECESSARY STEPS TO RECTIFY THE SITUATION OR CONTACT THE ARCHITECT WITH THE CONCERN. PROCEEDING WITH THE INSTALLATION OF FINISHES WILL BE CONSTRUED THAT THE INSTALLER AND/OR FINISHER HAS ACCEPTED SAID SUBSTRATE. NO CHANGE ORDER WILL BE ISSUED TO RECTIFY CONCEALED, OR UNSATISFACTORY SUBSTRATE ONCE FINISH WORK HAS PROCEEDED.
- PREPARE ALL WALL CONSTRUCTION, NEW AND EXISTING, TO RECEIVE NEW FINISHES AS PER MANUFACTURER'S RECOMMENDED INSTALLATION METHODS AND MATERIALS FOR ALL FINISHES.
- ALL FLOORING IS TO BE LEVELED WITHIN 1/4" IN 10'-0" WITH LATEX MATERIAL. MOISTURE CONTENT IN AREA IS TO BE TESTED PRIOR TO INSTALLATION OF FLOORING MATERIAL. CONTRACTOR TO INSTALL FLOORING PER MANUFACTURER'S RECOMMENDED METHOD.
- FLOORING CONTRACTOR TO SUBMIT A SEAMING DIAGRAM FOR FLOORING MATERIAL INCLUDING NOTATION OF MATERIAL DIRECTION.
- ALL FLOORING TRANSITIONS SHALL COMPLY WITH ADA GUIDELINES.
- ALL EXPOSED METAL SURFACES, SUCH AS GRILLES, FIRE EXTINGUISHER CABINETS, ETC. THAT ARE NOTED TO BE PAINTED, SHALL BE PAINTED WITH ALKID TYPE PAINT. COLOR TO BE COORDINATED WITH DESIGNER UNLESS OTHERWISE NOTED.
- CONTRACTOR TO PROVIDE AND INSTALL FLOORING TRANSITIONS AS INDICATED ON PLANS. WHERE NONE ARE NOTED, CONTRACTOR SHALL VERIFY REQUIRED TYPE/COLOR WITH ARCHITECT.
- THE CONTRACTOR SHALL BE RESPONSIBLE TO VERIFY THAT ALL NEW INTERIOR WALL AND CEILING FINISHES WILL BE CLASS B MINIMUM, WITH A FLAME SPREAD RATING OF 75 MAXIMUM, AND A SMOKE DEVELOPED INDEX OF 450 MAXIMUM, PER IBC SECTION 803.
- PAINT ALL DOOR FRAMES P4 - ALL SIDES UNLESS NOTED OTHERWISE.
- NO VINYL BASE TO BE INSTALLED ON BRICK WALLS.

FINISH SYMBOL LEGEND:

P1	WALL FINISH
C1	FLOOR FINISH
B1	BASE FINISH
---	MISC FINISH INFORMATION


—X— FLOOR TRANSITION STRIP AS REQUIRED

↑ ↓ INDICATES DIRECTION OF FLOOR MATERIAL GRAIN

FINISH PLAN NOTES:


(ALL PLAN NOTES MAY NOT BE INDICATED ON THIS PLAN)

- NO NEW FINISHES THIS ROOM, EXCLUDING DOOR FRAMES CONNECTED TO OTHER ROOMS THAT RECEIVE NEW FINISHES.
- PAINT, P2.
- WALLCOATING, MATCH ADJACENT EXISTING PAINT COLOR.
- WALL TILE PATTERN, 5,6/A-864.
- WALLCOVERING, WC5.
- FLOOR TILE, ETR.
- WALLCOATING, W2.
- REFERENCE FLOOR PATTERN PLAN, 4/A-830.
- WALL TILE, HORIZONTAL ASHLAR, WT1.
- HATCH PATTERN INDICATES SEALED CONCRETE, SC AND VINYL BASE, B1 IN THIS AREA.
- SAFETY CUSHION WAINSCOT, ETR.
- END WALLCOVERING HERE.
- PAINT ALL EXPOSED CEILING, P6.
- PATCH FLOORING WITH TZ1.
- WALLCOVERING, WC4.
- WALLCOVERING, WC2.
- PAINT EXISTING WALL TILE, W2.
- PROVIDE TRIM ON ALL OUTSIDE CORNERS, TRIM3.
- WALLCOATING, W3.
- STAIR RISER AND STAIR TREAD WITH INTEGRAL NOSING, ST1.
- PAINT, MATCH EXISTING WALL FINISHES.
- WALLCOATING, W1.
- CT, CERAMIC FLOOR TILE IN SHOWER TO EXTEND 1'0" PAST CURB. ALIGN WITH WALL TILE. REFER TO 13/A-820.
- PAINT BOTTOM AND FACE OF BULKHEAD, P7.
- BRICK, ETR.
- PAINT NEW STEEL RAILINGS.
- PAINT EXISTING STEEL RAILINGS.
- WALL TILE, ETR.
- CERAMIC TILE ON LOCKER BASE, ETR.
- STAIRS, ETR.
- REFERENCE FLOOR PATTERN PLAN, 1/A-830.
- WALL TILE PATTERN, 2/A-862.
- PAINT WAINSCOT TO TOP OF CMU WALL, W2.
- LINE OF NEW BLEACHRS.
- PRIVACY CURTAIN, PC1.
- REFER TO GYMNASIUM COURTLINE PLAY, SHEET A-840.
- LV12, 18" X 18"
- REFERENCE FLOOR PATTERN PLAN, 2/A-830.
- REFERENCE FLOOR PATTERN PLAN, 6/A-830.
- REFERENCE FLOOR PATTERN PLAN, 3/A-830.
- REFERENCE FLOOR PATTERN PLAN, 5/A-830.
- REFERENCE FLOOR PATTERN PLAN, 7/A-830.
- NEW SAFETY CUSHION WAINSCOT.
- USE RUBBER FLOOR, R1 IN AREA WITH HATCH PATTERN.
- METAL TRIM TRANSITION, TRIM1.
- METAL TRIM TRANSITION, PLACED AT MATERIAL EDGE OF WALL, TRIM2.
- ALL WALLS TO RECEIVE WALL TILE, HORIZONTAL BRICK ASHLAR, WT1, UNLESS NOTED OTHERWISE.
- PAINT, P1.
- RAILINGS, ETR.
- PAINT STAIRS.
- NEW RAILING WILL NOT RECEIVE PAINT.
- ALTERNATE BID: FIELD=LV11 AND ACCENT=LV12.

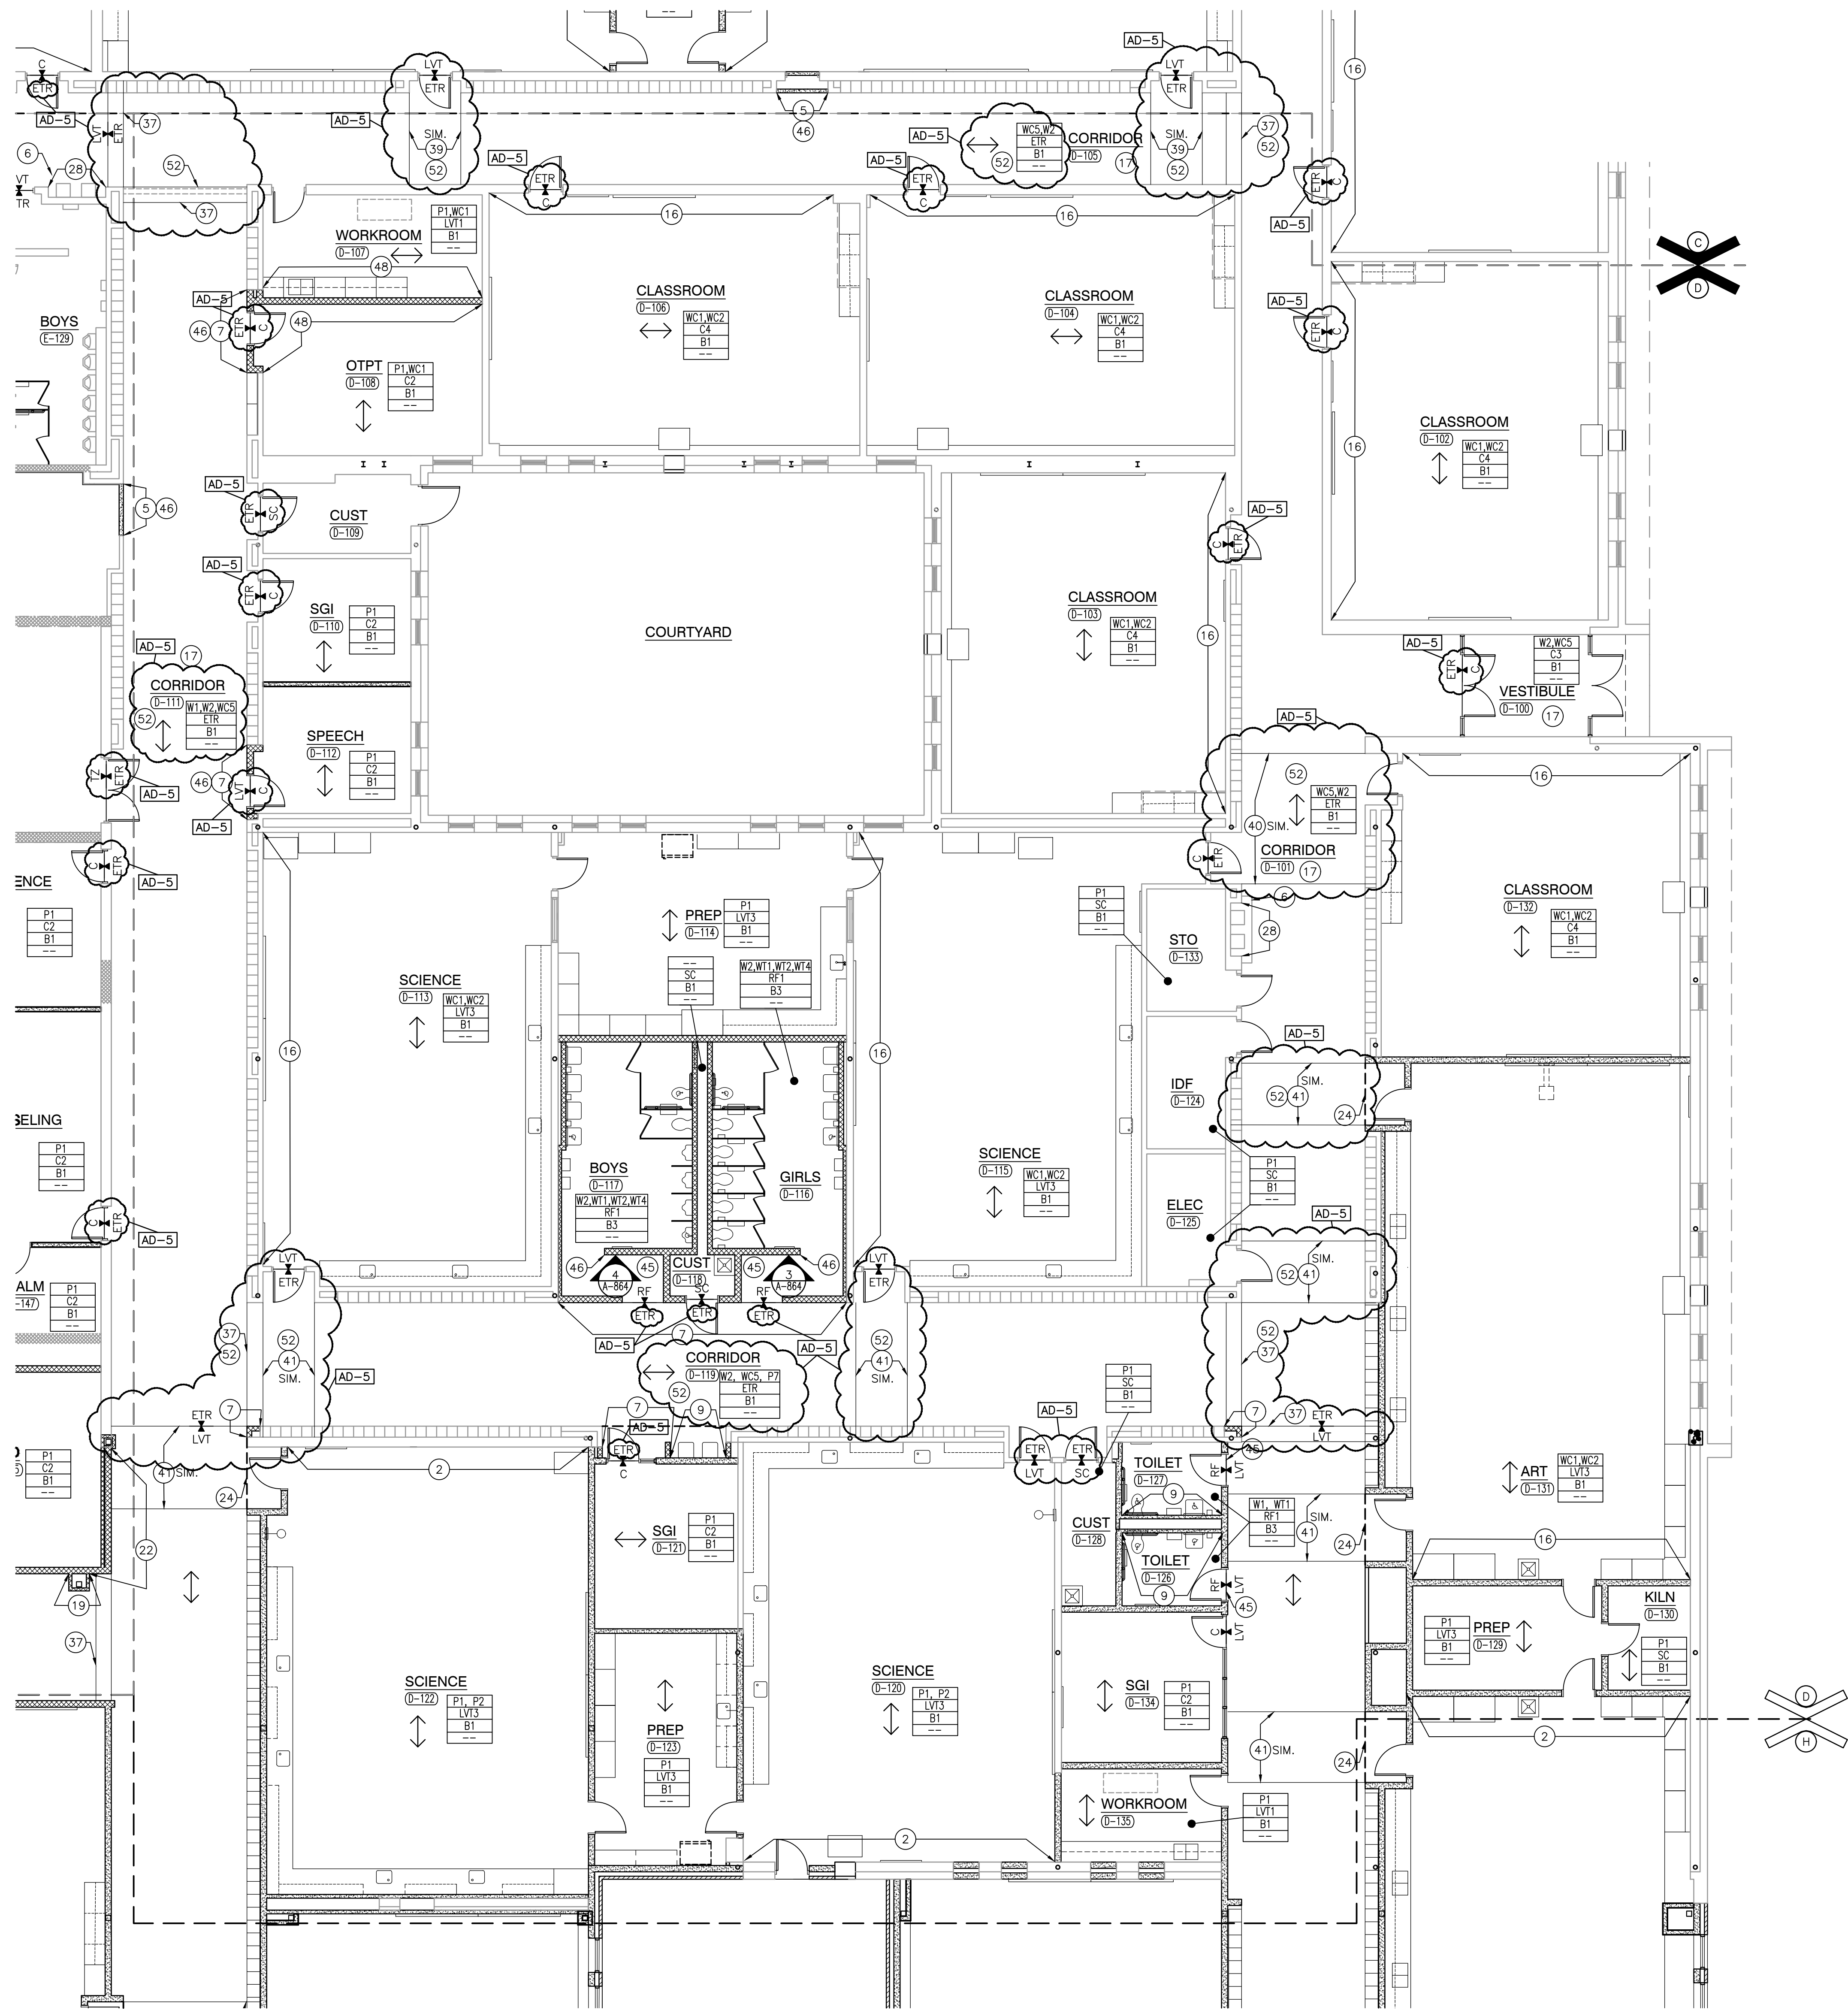


UNIT "D" FIRST FLOOR FINISH PLAN

SCALE: 1/8" = 1'-0"

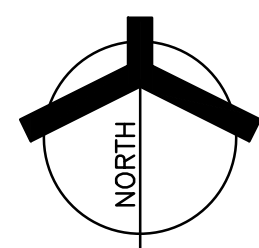


SHEET NOTES

1. EXTEND CONDENSATE PIPING FROM UNIT THRU WALL. TERMINATE WITH 45 DEGREE ELBOW DOWN TO GRADE. SLEEVE AND SEAL PIPE THROUGH WALL PENETRATION WEATHERTIGHT.

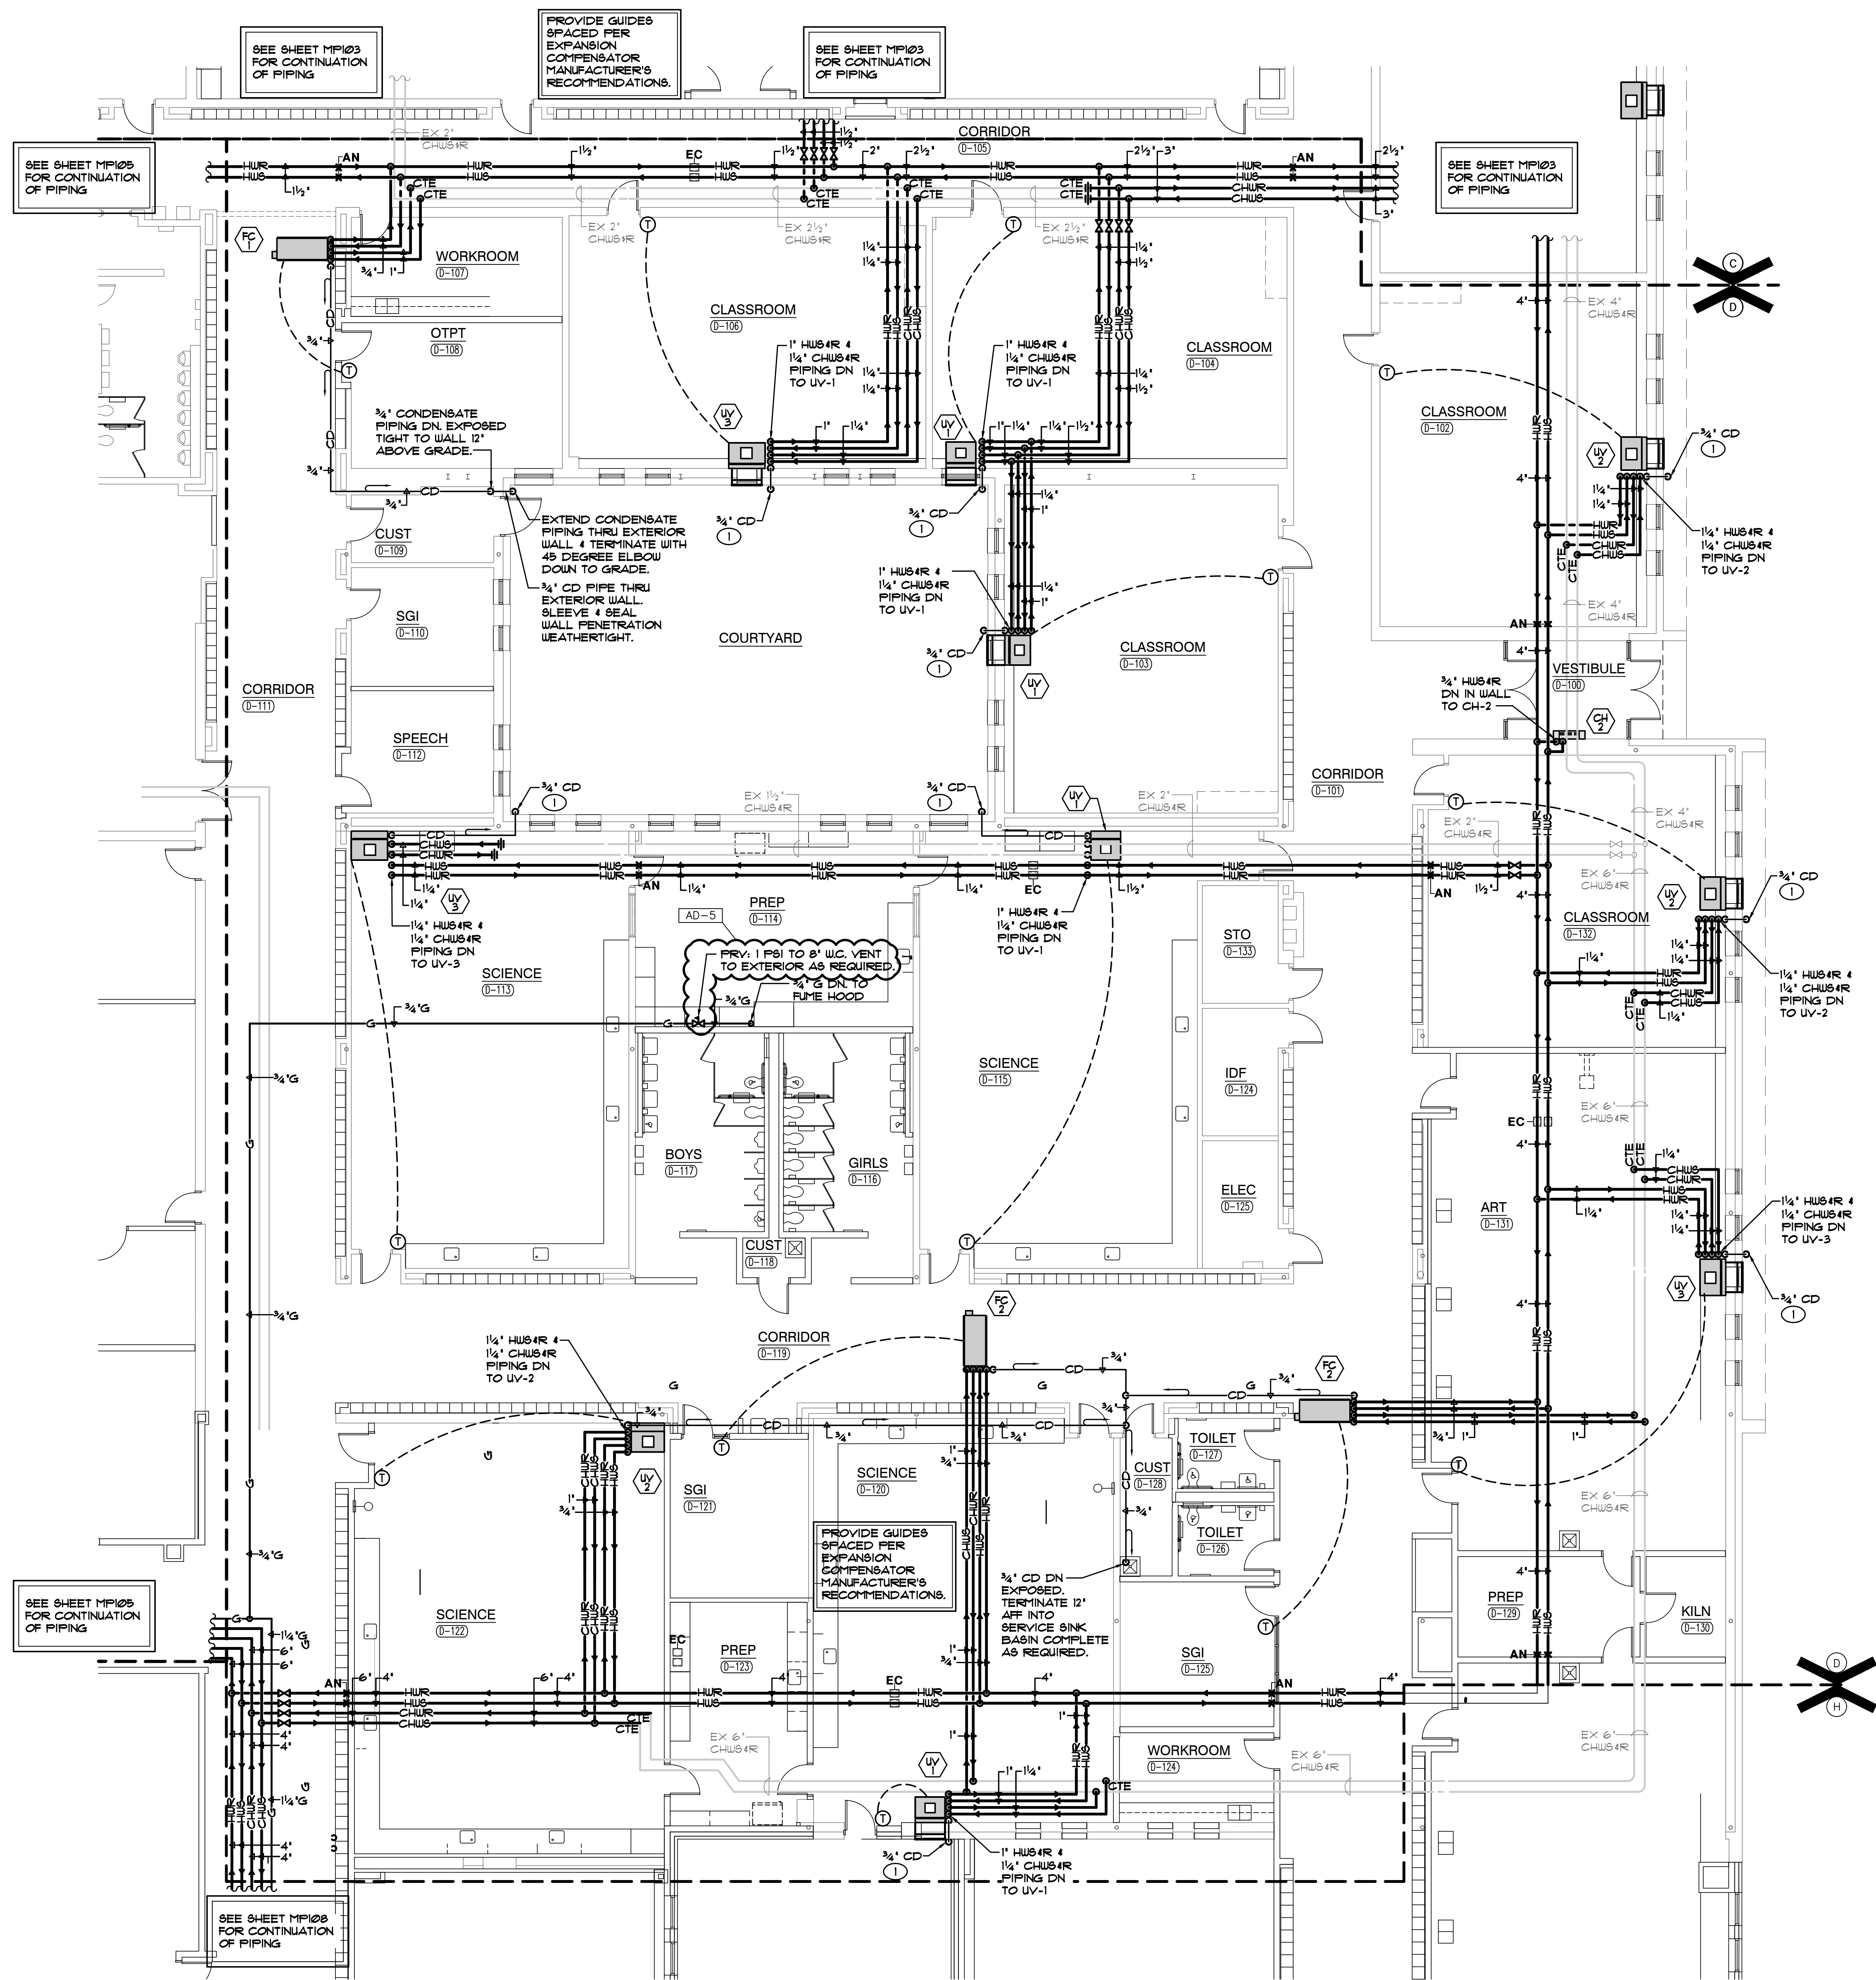


UNIT "D" MECHANICAL FIRST FLOOR PIPING PLAN
SCALE: 1/8" = 1'-0"

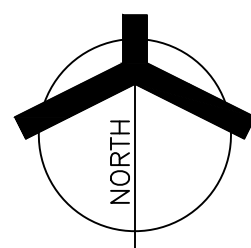

GIBRALTAR
DESIGN
ARCHITECTURE • ENGINEERING • INTERIOR DESIGN

MILLIES
ENGINEERING GROUP
1991 924-8400
www.milliesengineeringgroup.com

PROJECT
**LIBERTY
INTERMEDIATE
SCHOOL -
ADDITIONS &
RENOVATIONS**
DUNELAND SCHOOL CORPORATION
CHESTERTON, INDIANA

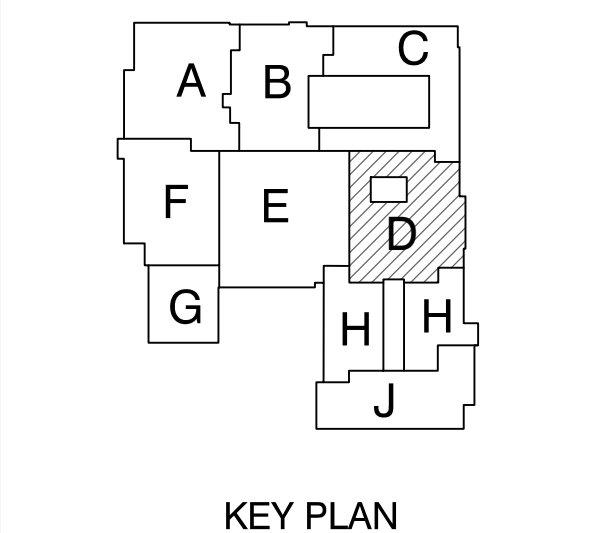

GIBRALTAR DESIGN
9102 N. Meridian St., Ste. 300
Indianapolis, IN 46260
Homepage: www.GibraltarDesign.com
Email: info@GibraltarDesign.com
Phone: 317.580.5777 Fax: 317.580.5778

PROJECT: 21-139
DATE: 04/25/22
COORDINATED BY: JC
DRAWN BY: KS
CHECKED BY: DJ

COPYRIGHT NOTICE:
THE CONCEPTS, DESIGNS, PLANS, DETAILS, ETC., SHOWN ON THIS DOCUMENT ARE THE PROPERTY OF GIBRALTAR DESIGN AND WERE CREATED FOR USE ON THIS SPECIFIC PROJECT. NONE OF THIS INFORMATION SHALL BE USED BY ANY PERSON OR FIRM FOR ANY PURPOSE WITHOUT THE EXPRESS WRITTEN CONSENT OF GIBRALTAR DESIGN. THE OWNER MAY RETAIN COPIES FOR INFORMATION AND REFERENCE IN CONNECTION ONLY WITH THIS PROJECT.

REVISIONS		
MARK	DATE	ISSUED FOR
AD-5	05/23/22	ADDENDUM NO. 5

DRAWING
**UNIT "D" MECHANICAL
FIRST FLOOR PIPING PLAN**

PROJECT
**LIBERTY IS -
ADDITIONS & RENOVATIONS**

© GIBRALTAR DESIGN SHEET
D MP104

MECHANICAL SCHEDULE NOTES

NOTE 1:
PROVIDE WITH:
• ROOF SUPPORTS
• RAILS
• VIBRATION ISOLATORS
• SOUND ATTENUATION KIT
SEE SPECIFICATIONS FOR ADDITIONAL REQUIREMENTS

NOTE 2:
PROVIDE WITH:
• COMBUSTION AIR INTAKE DAMPER
SEE SPECIFICATIONS FOR ADDITIONAL REQUIREMENTS

NOTE 3:
SEE SPECIFICATIONS FOR ADDITIONAL REQUIREMENTS

NOTE 4:
PROVIDE WITH:
• DX COOLING CAPACITIES INDICATED BASED ON A TOTAL EQUIVALENT COOLING FROM A COMBINATION OF DX SECTION & ERV COOLING (PP1 924-840)
• INTEGRATED ECONOMIZER WITH DIFFERENTIAL ENTHALPY SENSORS
• FEEDBACK SIGNAL W/ IECC 2019 COMPLIANT LOW LEAK ECONOMIZER DAMPER
• DIGITAL SCROLL (LEAD ONLY) OR VARIABLE SPEED COMPRESSORS
• 5/4" FLOW EXH DIRECT DRIVE FANS W/VPD, NON-FUSED DISCONNECT SWITCH
• SHORT CIRCUIT RATING 35 K
• PHASE & BROWN-OUT PROTECTION
• HINGED ACCESS DOORS
• VIBRATION ISOLATION CURBS W/ HUSHCORE DECK DB-52 ACOUSTICAL TREATMENT,
• POWERED EXHAUST FAN W/UL95 PRESSURIZATION CONTROL,
• ENERGY RECOVERY WHEEL W/DEFOST & ECONOMIZER BYPASS - SEE HEAT RECOVERY SCHEDULE
• STAINLESS STEEL HEAT EXCHANGER
• MODULATING GAS W/WH TURNDOWN (SEE SCHEDULE)
• FLUE DEFLECTOR
• METAL MESH OUTSIDE AIR INTAKE HOOD FILTER
• CONDENSER FAN W/VPD W/HEAD PRESSURE CONTROL & 91TE GLASS
• VAV HEATING & COOLING
• HAIL CONDENSER COIL GUARD PROTECTION
• FILTERS: ERV(OA) - 2" 30%, ERV(EXH) - 2" 30%, EVAPORATOR - 4" MERV 13
• R/A MOUNTED CO2 SENSOR FOR DEMAND CONTROL VENTILATION
SEE SPECIFICATIONS FOR ADDITIONAL REQUIREMENTS

NOTE 5:
PROVIDE WITH:
• INTEGRATED ECONOMIZER WITH DIFFERENTIAL ENTHALPY SENSORS
• FEEDBACK SIGNAL W/ IECC 2019 COMPLIANT LOW LEAK ECONOMIZER DAMPER
• DIGITAL SCROLL (LEAD ONLY) OR VARIABLE SPEED COMPRESSORS
• 5/4" FLOW EXH DIRECT DRIVE FANS W/VPD, NON-FUSED DISCONNECT SWITCH
• SHORT CIRCUIT RATING 35 K
• PHASE & BROWN-OUT PROTECTION
• HINGED ACCESS DOORS
• VIBRATION ISOLATION CURBS W/ HUSHCORE DECK DB-52 ACOUSTICAL TREATMENT,
• POWERED EXHAUST FAN W/UL95 PRESSURIZATION CONTROL,
• STAINLESS STEEL HEAT EXCHANGER
• MODULATING GAS W/WH TURNDOWN (SEE SCHEDULE)
• FLUE DEFLECTOR
• METAL MESH OUTSIDE AIR INTAKE HOOD FILTER
• CONDENSER FAN W/VPD W/HEAD PRESSURE CONTROL & 91TE GLASS
• VAV HEATING & COOLING
• HAIL CONDENSER COIL GUARD PROTECTION
• FILTERS: 4" MERV 13 & 2" MERV 8
• R/A MOUNTED CO2 SENSOR FOR DEMAND CONTROL VENTILATION
SEE SPECIFICATIONS FOR ADDITIONAL REQUIREMENTS

NOTE 6:
PROVIDE WITH:
• INTEGRATED ENTHALPY ECONOMIZER
• DISCONNECT SWITCH
• FACE/BYPASS DAMPER
• FILTERS
SEE SPECIFICATIONS FOR ADDITIONAL REQUIREMENTS

NOTE 7:
PROVIDE WITH:
• DISCONNECT SWITCH
• VIBRATION ISOLATION HANGERS
• TERMINAL STRIPS FOR DDC READY
SEE SPECIFICATIONS FOR ADDITIONAL REQUIREMENTS

NOTE 8:
PROVIDE WITH:
• INTEGRAL THERMOSTAT
• DISCONNECT SWITCH
• WALL MOUNTING KIT
SEE SPECIFICATIONS FOR ADDITIONAL REQUIREMENTS

NOTE 9:
PROVIDE WITH:
• INTEGRAL THERMOSTAT
• DISCONNECT SWITCH
SEE SPECIFICATIONS FOR ADDITIONAL REQUIREMENTS

NOTE 10:
PROVIDE WITH:
• VIBRATION ISOLATION HANGERS
• INTEGRAL THERMOSTAT
• DISCONNECT SWITCH
SEE SPECIFICATIONS FOR ADDITIONAL REQUIREMENTS

NOTE 11:
PROVIDE WITH:
• PROVIDE WITH DISCONNECT SWITCH
• ECM MOTOR WITH POTENTIOMETER SPEED CONTROLLER
• MOTORIZED DAMPER
• BIRD SCREEN
• ROOF CURB
SEE SPECIFICATIONS FOR ADDITIONAL REQUIREMENTS

NOTE 12:
PROVIDE WITH:
• BUILT-IN BACKDRAFT DAMPER
• INTEGRAL METAL GRILLE
• VIBRATION ISOLATION HANGERS
SEE SPECIFICATIONS FOR ADDITIONAL REQUIREMENTS

NOTE 13:
PROVIDE WITH:
• DISCONNECT SWITCH
• MOTORIZED BACKDRAFT DAMPER
• BIRD SCREEN, ROOF CURB
• HERBESITE COATING
SEE SPECIFICATIONS FOR ADDITIONAL REQUIREMENTS

NOTE 14:
PROVIDE WITH:
• VIBRATION ISOLATION HANGERS
SEE SPECIFICATIONS FOR ADDITIONAL REQUIREMENTS

AD-5

PUMP SCHEDULE

TAG	MANUFACTURER	MODEL NUMBER	DESCRIPTION	GPM	HEAD (FT.)	PUMP MOTOR DATA					STARTER:		SUCTION/ DISCHARGE SIZE	REMARKS
						HP	RPM	VOLT	PHASE	HZ	MC	EC		
BP-1	BELL & GOSSETT	SERIES 80: 4x4x1B	HOT WATER BOILER RECIRC PUMP (EX BOILER)	210	20	3	1750	480	3	60	X	-	4" / 4"	-
BP-2	BELL & GOSSETT	SERIES 80: 4x4x1B	HOT WATER BOILER RECIRC PUMP (EX BOILER)	210	20	3	1750	480	3	60	X	-	4" / 4"	-
BP-3	BELL & GOSSETT	SERIES 80: 3x3x1C	HOT WATER BOILER RECIRCULATION PUMP (B-3)	236	20	2	1750	480	3	60	X	-	3" / 3"	-
HUP-1	BELL & GOSSETT	SERIES 1510: 3EB	HOT WATER DISTRIBUTION PUMP	388	95	15	1750	480	3	60	X	-	4" / 3"	HOT WATER PRIMARY PUMPS W/VPD OPERATING IN PARALLEL, 116 GPM AT 95 FT. HD. WITH DUAL POWER FEEDERS
HUP-2	BELL & GOSSETT	SERIES 1510: 3EB	HOT WATER DISTRIBUTION PUMP	388	95	15	1750	480	3	60	X	-	4" / 3"	
CP-1	BELL & GOSSETT	SERIES 1510: 5A	CHILLED WATER RECIRCULATION PUMP (C-1)	351	30	1 1/2	1750	480	3	60	X	-	6" / 5"	-
CP-2	BELL & GOSSETT	SERIES 1510: 5A	CHILLED WATER RECIRCULATION PUMP (C-2)	351	30	1 1/2	1750	480	3	60	X	-	6" / 5"	-
CWP-1	BELL & GOSSETT	SERIES 1510: 4EB	CHILLED WATER DISTRIBUTION PUMP	351	30	20	1750	480	3	60	X	-	5" / 4"	CHILLED WATER PRIMARY PUMPS W/VPD OPERATING IN PARALLEL, 114 GPM AT 90 FT. HD. WITH DUAL POWER FEEDERS
CWP-2	BELL & GOSSETT	SERIES 1510: 4EB	CHILLED WATER DISTRIBUTION PUMP	351	30	20	1750	480	3	60	X	-	5" / 4"	

GRILLE, REGISTER & DIFFUSER SCHEDULE

TAG	MANUFACTURER	MODEL NO.	DESCRIPTION	AIR PATTERN	MOUNTING	SIZE	TYPE OF CONTROL	REMARKS
A3	NAILOR	6500-O	SUPPLY CEILING DIFFUSER	3-WAY	2' X 2' LAY-IN PANEL	SEE PLANS	O.B.D.	-
A4	NAILOR	6500-O	SUPPLY CEILING DIFFUSER	4-WAY	2' X 2' LAY-IN PANEL	SEE PLANS	O.B.D.	-
A5	NAILOR	6500-O	SUPPLY CEILING DIFFUSER	2-WAY CORNER	2' X 2' LAY-IN PANEL	SEE PLANS	O.B.D.	-
A8	NAILOR	6500-O	SUPPLY CEILING DIFFUSER	3-WAY	2' X 1' LAY-IN PANEL	SEE PLANS	O.B.D.	-
A9	NAILOR	6500-O	SUPPLY CEILING DIFFUSER	4-WAY	2' X 1' LAY-IN PANEL	SEE PLANS	O.B.D.	-
A10	NAILOR	6500-O	SUPPLY CEILING DIFFUSER	2-WAY CORNER	2' X 1' LAY-IN PANEL	SEE PLANS	O.B.D.	-
C4	NAILOR	6100-OA	SUPPLY CEILING DIFFUSER	4-WAY	2' X 2' LAY-IN PANEL	SEE PLANS	O.B.D.	ALUMINUM CONSTRUCTION
E2	NAILOR	61DH-O	SUPPLY CEILING REGISTER	DOUBLE DEFLECTION	SURFACE MOUNTED	SEE PLANS	O.B.D.	HORIZONTAL FRONT BARS, VERTICAL BACK BARS
J4	NAILOR	6550-O	SUPPLY CEILING DIFFUSER	4-WAY	2' X 2' LAY-IN PANEL	SEE PLANS	O.B.D.	-
K1	NAILOR	61DH-C	SUPPLY REGISTER	DOUBLE DEFLECTION	DUCT MOUNTED	SEE PLANS	VOLUME DAMPER	MILL FINISH
L4	NAILOR	501B	CONTINUOUS 1 1/2" SLOT LINEAR SA DIFFUSER	ADJ. PATTERN CONTROLLER	SURFACE MOUNT W/ GYP.BD MTG. FRAME	SEE PLAN FOR #SLOTS/LGTH	NONE	NARROW FLANGE, END CAPS, WHITE FRAME AND WHITE INTERIOR FINISH.
L9	NAILOR	501BR	CONTINUOUS 1 1/2" SLOT LINEAR R/A DIFFUSER	NO PATTERN CONTROLLER	SURFACE MOUNT W/ GYP.BD MTG. FRAME	SEE PLAN FOR #SLOTS/LGTH	NONE	NARROW FLANGE, END CAPS, WHITE FRAME AND WHITE INTERIOR FINISH.
R1	NAILOR	6145H-O	RETURN/EXHAUST REGISTER	LOUVERED GRILLE	LAY-IN PANEL	SEE PLANS	O.B.D.	-
R2	NAILOR	6145H-O	RETURN/EXHAUST REGISTER	LOUVERED GRILLE	SURFACE MOUNTED	SEE PLANS	O.B.D.	-
R3	NAILOR	5145H-O	RETURN/EXHAUST REGISTER	LOUVERED GRILLE	LAY-IN PANEL	SEE PLANS	O.B.D.	ALUMINUM CONSTRUCTION
T1	NAILOR	6145H	RETURN/EXHAUST/T.A. GRILLE	LOUVERED GRILLE	LAY-IN PANEL	SEE PLANS	-	-
T2	NAILOR	6145H	RETURN/EXHAUST/T.A. GRILLE	LOUVERED GRILLE	SURFACE MOUNTED	SEE PLANS	-	-
T3	NAILOR	5145H	RETURN/EXHAUST/T.A. GRILLE	LOUVERED GRILLE	LAY-IN PANEL	SEE PLANS	-	ALUMINUM CONSTRUCTION
T8	NAILOR	6145H-HD	RETURN/EXHAUST/T.A. GRILLE	LOUVERED GRILLE	SURFACE MOUNTED	SEE PLANS	-	HEAVY DUTY GRILLE

* ALL DIFFUSERS AND REGISTERS SHALL HAVE A WHITE FINISH UNLESS OTHERWISE NOTED

DUCTWORK INSULATION/LINING SCHEDULE

REFER TO SPECIFICATIONS FOR ADDITIONAL INSULATION REQUIREMENTS

DUCTWORK TYPE	INSULATION TYPE	
	CONCEALED	EXPOSED
SUPPLY AIR DUCTWORK		
RECTANGULAR	1 1/2" LINER	1 1/2" LINER
ROUND	1 1/2" WRAP, NOTE 1	PERFORATED DOUBLE WALL
OUTSIDE AIR DUCTWORK		
RECTANGULAR	1 1/2" WRAP	1 1/2" WRAP
ROUND	1 1/2" WRAP	1 1/2" WRAP OR PERFORATED DOUBLE WALL
RETURN AIR DUCTWORK		
RECTANGULAR	1 1/2" LINER	1 1/2" LINER
ROUND	PERFORATED DOUBLE WALL	PERFORATED DOUBLE WALL
TRANSFER AIR DUCTWORK	1 1/2" LINER	1 1/2" LINER
DOAS SUPPLY AIR DUCTWORK		
RECTANGULAR	1 1/2" LINER	1 1/2" LINER
ROUND	1 1/2" WRAP, NOTE 1	PERFORATED DOUBLE WALL
DOAS EXHAUST DUCTWORK		
RECTANGULAR	1 1/2" LINER, WITHIN 30'-0" OF UNIT	1 1/2" LINER, WITHIN 30'-0" OF UNIT
ROUND	PERFORATED DOUBLE WALL, WITHIN 30'-0" OF UNIT	PERFORATED DOUBLE WALL, WITHIN 30'-0" OF UNIT
VAV & FAN-POWERED BOXES		
INLET COLLAR	1 1/2" WRAP	1 1/2" WRAP
HOT WATER REHEAT COIL	1 1/2" WRAP	1 1/2" WRAP
EXHAUST DUCTWORK		
WITHIN 10'-0" OF EXHAUST FAN	1 1/2" LINER	1 1/2" LINER

NOTE 1: ROUND DUCT SUPPLYING ONE DIFFUSER AND MORE THAN 30'-0" FROM UNIT

NATURAL GAS CONNECTION SCHEDULE

TAG	DESCRIPTION	LOCATION	CAPACITY CFH	REMARKS
RT-1	ROOF MOUNTED GAS FIRED / DX COOLING ROOFTOP UNIT-VAV	ROOF	150	-
RT-2	ROOF MOUNTED GAS FIRED / DX COOLING ROOFTOP UNIT-VAV	ROOF	350	-
-	EXISTING GAS FIRED BOILER (14'-28" w.c.)	MECH ROOM-E103	3000	-
-	EXISTING GAS FIRED BOILER (14'-28" w.c.)	MECH ROOM-E103	3000	-
B-3	GAS FIRED HOT WATER BOILER (8'-14" w.c.)	MECH ROOM-E103	2500	-
-	COMBI OVEN/STEAMER	KITCHEN-E135	152	-
-	COMBI OVEN/STEAMER	KITCHEN-E135	304	-
-	COMBI OVEN/STEAMER	KITCHEN-E135	304	-
-	ROOF MOUNTED MAKE-UP AIR UNIT	ROOF OF KITCHEN E135	368	-
WH-1	GAS FIRED WATER HEATER	MECH ROOM-E124	400	-
WH-2	GAS FIRED WATER HEATER	MECH ROOM-E124	400	-
-	EXISTING MISC. GAS LOAD	-	200	ESTIMATED
-	EXISTING EMERGENCY GENERATOR	-	1965	-
-	ALTERNATE - NEW EMERGENCY GENERATOR (1'-11" w.c.)	-	2383	ALTERNATE
TOTAL			13693	CFH # 5 P81
ALTERNATE TOTAL			14711	CFH # 5 P81

AD-5

HEAT RECOVERY SCHEDULE

UNIT TAG	MIXED SUPPLY AIR						RETURN AIR						EXHAUST AIR						OUTSIDE AIR						HEAT WHEEL DISCHARGE						REMARKS				
	SUMMER			WINTER			SUMMER			WINTER			SUMMER			WINTER			SUMMER			WINTER													
	CFM	DB	WB		DB	WB	CFM	DB	WB		DB	WB	CFM	DB	WB		DB	WB	CFM	DB	WB		DB	WB	CFM	DB	WB		DB	WB					
RT-1	12,000	52.1	52.0	F	106.5	F	6,556	75	63	F	7.0	53	F	6,556	80.3	71.0	F	12.0	11.3	F	6,556	95	75	F	-10	-11	F	6,556	80.3	66.1	F	46.3	36.9	F	-

INTAKE/RELIEF HOOD SCHEDULE

TAG	MANUFACTURER	MODEL #	THROAT SIZE	DESCRIPTION	HOOD LOCATION	REMARKS
IH-1	ACHE	*TIV	SEE PLANS	OUTSIDE AIR INTAKE HOOD FOR FC'S AND AH'S	SEE PLANS	PROVIDE W/ BIRDSCREEN, AND 18" HIGH ROOF CURB.
RH-1	ACHE	*TIV	SEE PLANS	RELIEF AIR HOOD FOR UV'S AND FC'S	SEE PLANS	PROVIDE W/ BIRDSCREEN, BAROMETRIC RELIEF DAMPER AND 18" HIGH ROOF CURB.
RH-2	ACHE	*TEV	SEE PLANS	EXHAUST/RELIEF AIR HOOD FOR AH'S	SEE PLANS	PROVIDE W/ BIRDSCREEN, AND 18" HIGH ROOF CURB.



GIBRALTAR
DESIGN

ARCHITECTURE • ENGINEERING • INTERIOR DESIGN

MILLIES
ENGINEERING GROUP
PP1 924-8400
www.milliesengineeringgroup.com

PROJECT

LIBERTY
INTERMEDIATE
SCHOOL -
ADDITIONS &
RENOVATIONS

DUNELAND SCHOOL CORPORATION
CHESTERTON, INDIANA

GIBRALTAR DESIGN

9102 N. Meridian St., Ste. 300
Indianapolis, IN 46260
Homepage: www.GibraltarDesign.com
Email: info@GibraltarDesign.com
Phone: 317.580.5777 Fax: 317.580.5778

PROJECT

21-139

DATE

04/25/22

COORDINATED BY

JC

DRAWN BY

GL

CHECKED BY

DJ

COPYRIGHT NOTICE:
THE CONCEPTS, DESIGNS, PLANS, DETAILS, ETC., SHOWN ON THIS DOCUMENT ARE THE PROPERTY OF GIBRALTAR DESIGN AND WERE CREATED FOR USE ON THIS SPECIFIC PROJECT. NONE OF THIS INFORMATION SHALL BE USED BY ANY PERSON OR FIRM FOR ANY PURPOSE WITHOUT THE EXPRESS WRITTEN CONSENT OF GIBRALTAR DESIGN. THE OWNER MAY RETAIN COPIES FOR INFORMATION AND REFERENCE IN CONNECTION ONLY WITH THIS PROJECT.

REVISIONS

MARK

DATE

ISSUED FOR

AD-5

05/23/22

ADDENDUM NO. 5

DRAWING

MECHANICAL SCHEDULES
AND NOTES

PROJECT

LIBERTY IS -
ADDITIONS & RENOVATIONS

© GIBRALTAR DESIGN

SHEET

M-502



GIBALTAR
DESIGN

ARCHITECTURE • ENGINEERING • INTERIOR DESIGN




PROJECT
**LIBERTY
INTERMEDIATE
SCHOOL -
ADDITIONS &
RENOVATIONS**

DUNELAND SCHOOL CORPORATION
CHESTERTON, INDIANA

GIBALTAR DESIGN

9102 N. Meridian St., Ste. 300
Indianapolis, IN 46260
Homepage: www.GibraltarDesign.com
Email: info@GibraltarDesign.com
Phone: 317.580.5777 Fax: 317.580.5778

PROJECT
21-139
DATE
04/25/22
COORDINATED BY
JC
DRAWN BY
MS
CHECKED BY
DJ

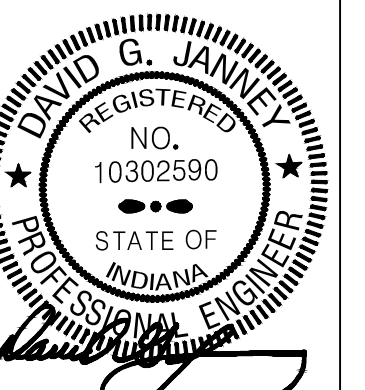


COPYRIGHT NOTICE:
THE CONCEPTS, DESIGNS, PLANS, DETAILS, ETC., SHOWN ON THIS DOCUMENT ARE THE PROPERTY OF GIBALTAR DESIGN AND WERE CREATED FOR USE ON THIS SPECIFIC PROJECT. NONE OF THIS INFORMATION SHALL BE USED BY ANY PERSON OR FIRM FOR ANY PURPOSE WITHOUT THE EXPRESS WRITTEN CONSENT OF GIBALTAR DESIGN. THE OWNER MAY RETAIN COPIES FOR INFORMATION AND REFERENCE IN CONNECTION ONLY WITH THIS PROJECT.

REVISIONS		
MARK	DATE	ISSUED FOR
AD-3	05/12/22	ADDENDUM NO. 3
AD-4	05/18/22	ADDENDUM NO. 4
AD-5	05/23/22	ADDENDUM NO. 5


DRAWING
PARTIAL ELECTRICAL SITE PLAN

PROJECT
**LIBERTY IS -
ADDITIONS & RENOVATIONS**

© GIBALTAR DESIGN SHEET
E-002

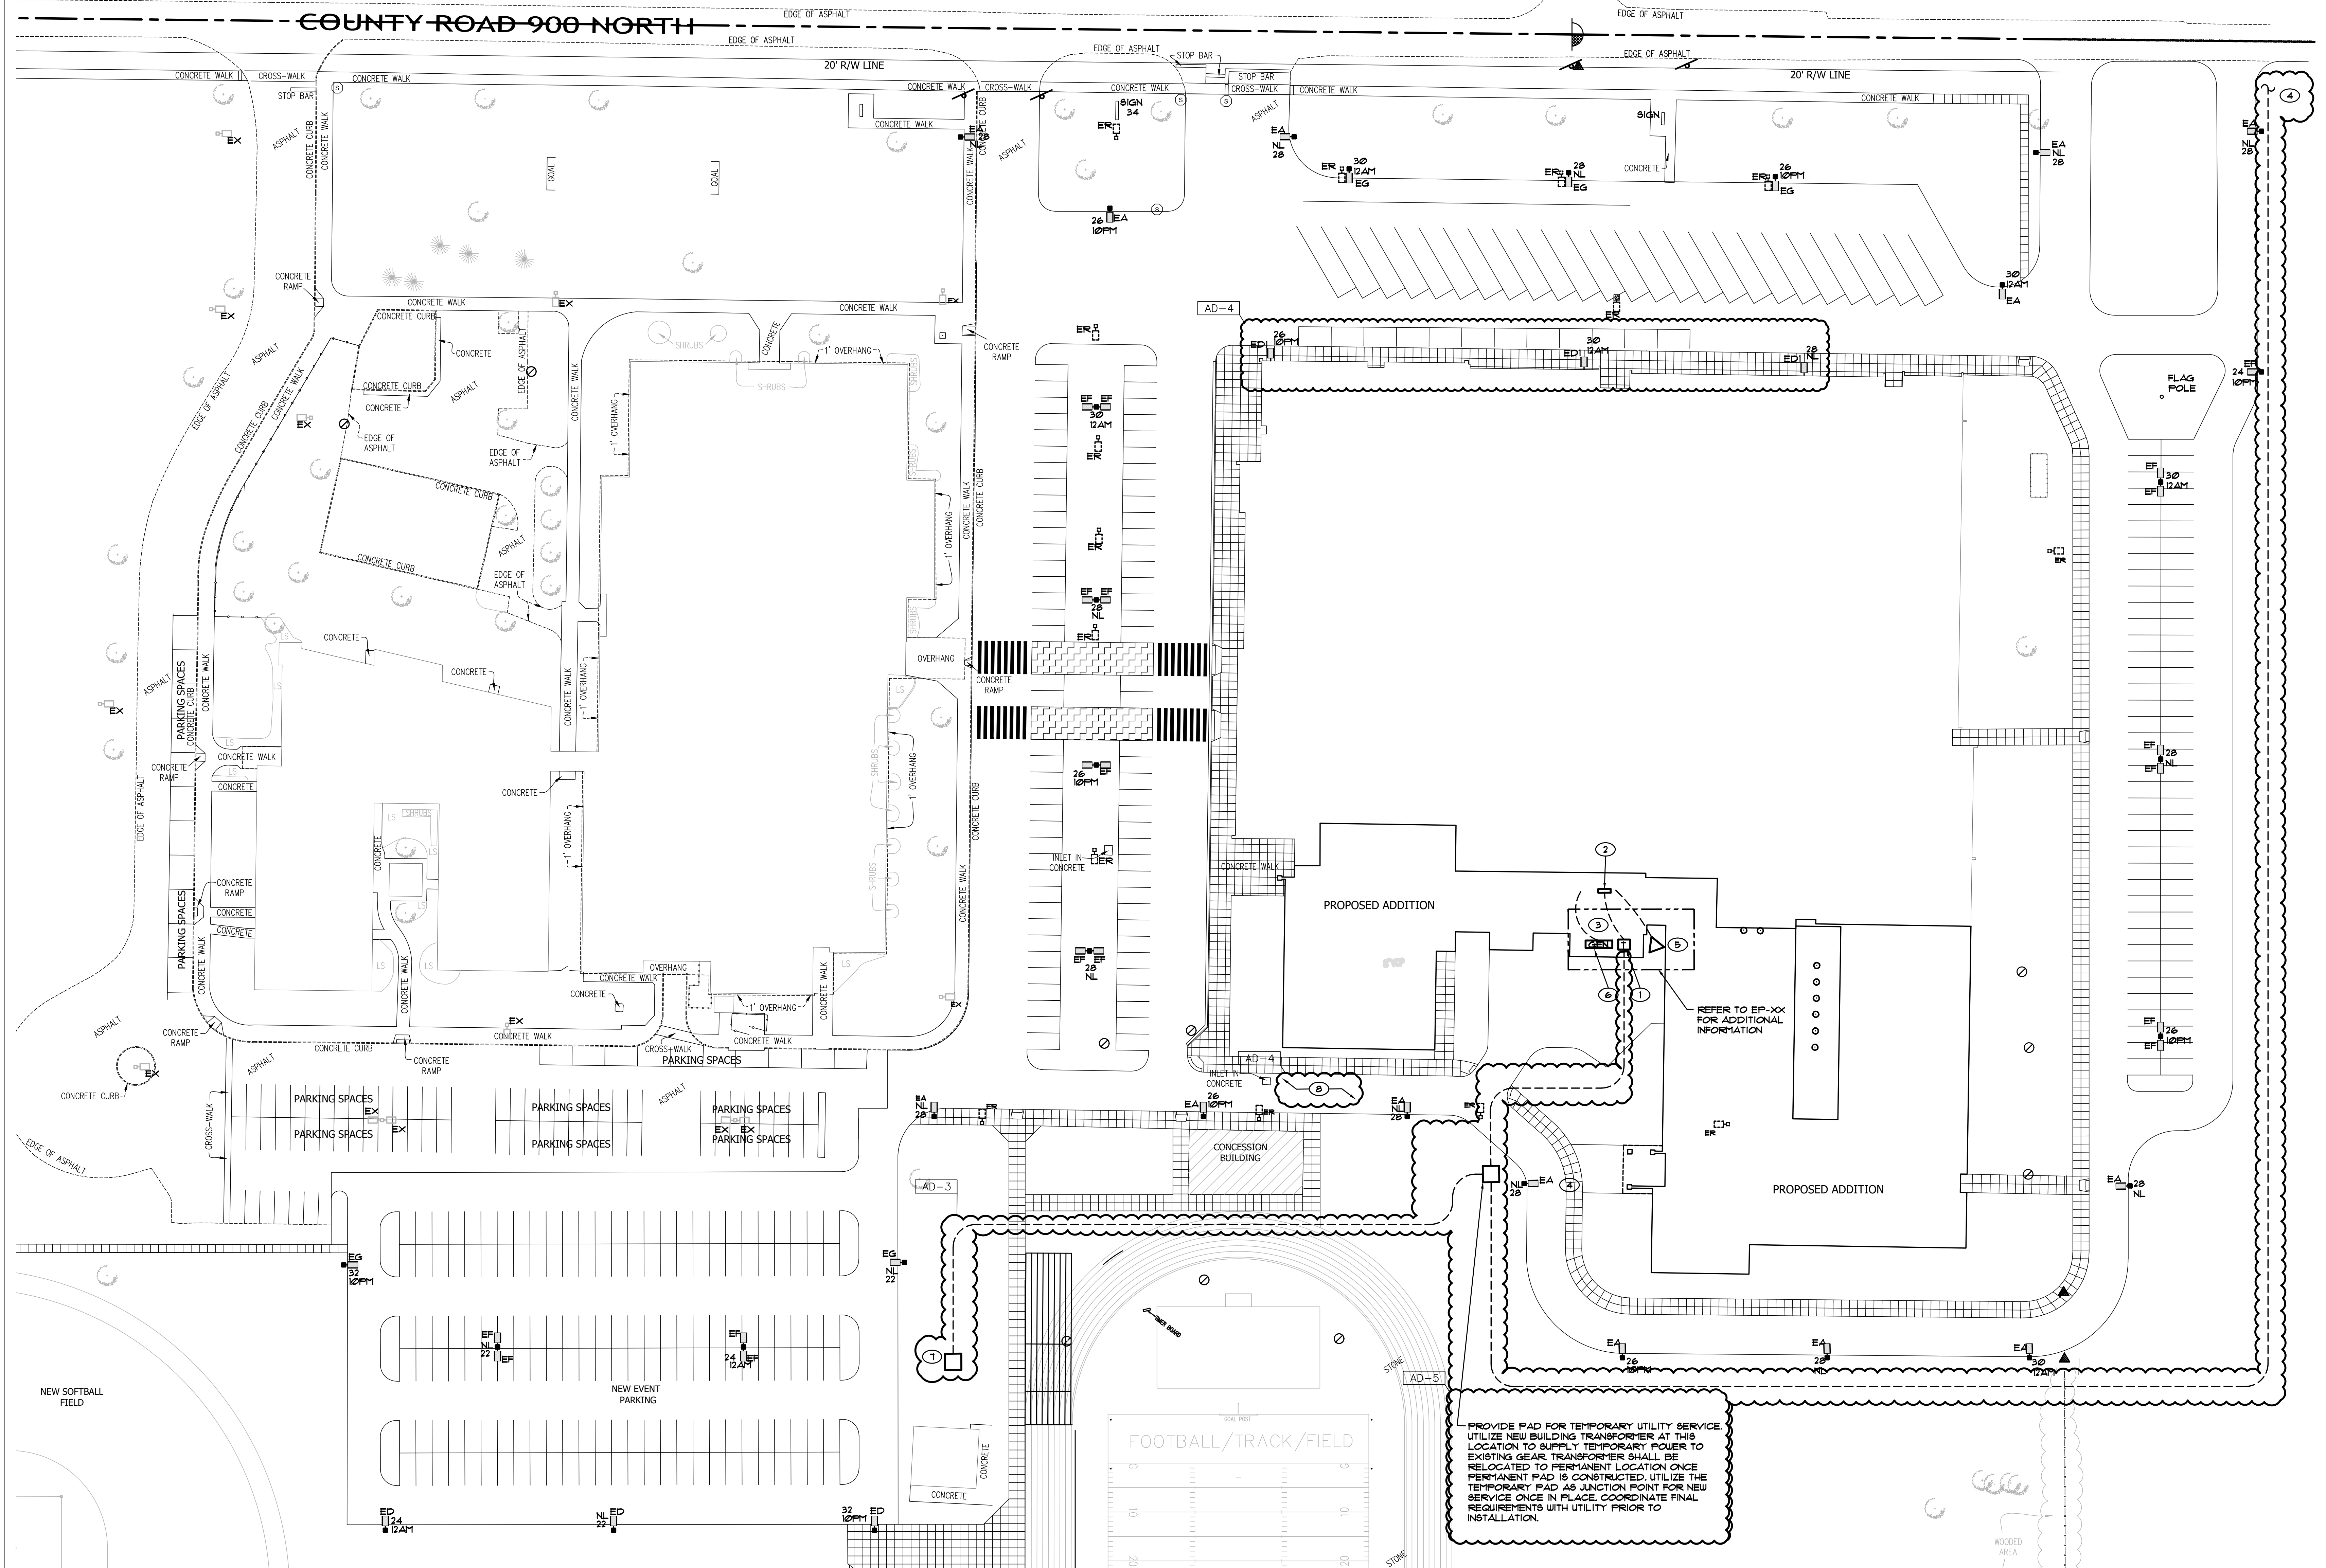

PARTIAL ELECTRICAL SITE PLAN
SCALE: 1" = 40'-0"

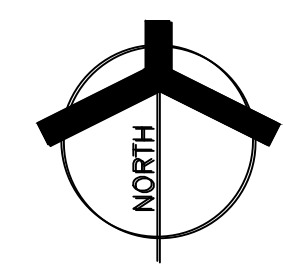


GENERAL NOTES


- ALL CONDUIT BEYOND THE DISTURBED FIELD AREA AND BELOW EXISTING PAVEMENT TO REMAIN SHALL BE DIRECTIONAL BORED.
- EXACT ROUTING OF THE SECONDARY FEEDERS FROM THE TRANSFORMER TO THE SWITCHBOARD SHALL BE VERIFIED WITH AHI FOR ACCEPTABILITY PRIOR TO INSTALLATION.
- VERIFY EXACT LOCATION OF THE METER AND CT CABINET WITH THE UTILITY COMPANY.
- SITE LIGHTING CONDUCTORS SHALL BE #8 AWG MINIMUM, AND SIZED TO MEET N.E.C. VOLTAGE DROP REQUIREMENTS.
- UNLESS OTHERWISE NOTED, ROUTE LIGHTING TO CIRCUITS INDICATED VIA TIME CLOCK, CONTACTORS AND PHOTOCELL.
- REFER TO SITE LIGHTING POLE AND FLOOD LIGHT DETAILS FOR ADDITIONAL INFORMATION.
- CAREFULLY VERIFY BASE SIZE FOR EACH FIXTURE WITH ARCHITECT AND OWNER PRIOR TO INSTALLATION.
- ELECTRICAL CONTRACTOR SHALL CAREFULLY COORDINATE EXACT LAYOUT OF TRANSFORMER, METERING EQUIPMENT AND GENERATOR IN OUTDOOR YARD WITH ARCHITECT AND MECHANICAL CONTRACTOR NO LATER THAN 14 DAYS AFTER CONTRACT AWARD AND PRIOR TO ORDERING OF ANY EQUIPMENT.
- REFER TO TECHNOLOGY DRAWINGS FOR TECHNOLOGY SITE WORK AND PROVIDE RACEWAY AND HAND-HOLE ROUGH-INS AS INDICATED.

SHEET NOTES

- UTILITY COMPANY PAD MOUNTED SERVICE TRANSFORMER FURNISH AND INSTALL TRANSFORMER PAD PER UTILITY COMPANY STANDARDS AND SPECIFICATIONS, INCLUDING GROUNDING, PAD SIZE, ETC.
- APPROXIMATE LOCATION OF MAIN SWITCH BOARD (MSB), CT SECTION AND METER.
- PROVIDE TWO (2) 4" PVC CONDUITS TO UTILITY SERVICE POINT DETERMINED BY UTILITY COMPANY FOR FUTURE SERVICE ENTRANCE CABLE. VERIFY LOCATION IN FIELD WITH UTILITY COMPANY PRIOR TO ROUGH-IN. CAREFULLY LOCATE ALL UNDERGROUND UTILITIES AND COORDINATE WORK TO AVOID ANY CONFLICTS. PROVIDE PULL BOXES AT LOCATIONS INDICATED BY THE UTILITY COMPANY. PULL BOX SHALL MATCH THE UTILITY COMPANY STANDARDS.
- GROUND TRAIL: VERIFY EXACT LOCATION IN FIELD.
- APPROXIMATE LOCATION OF EMERGENCY GENERATOR.
- FUTURE UTILITY TRANSFORMER LOCATION: PROVIDE PRIMARY CONDUIT STUB-UP AND CAP FOR FUTURE UTILITY PAD. VERIFY EXACT LOCATION AND REQUIREMENTS WITH UTILITY COMPANY PRIOR TO ROUGH-IN.
- CONTRACTOR TO REMOVE (4) FOUR CUSTOMER OWNED UTILITY POLES ORIGINALLY SERVING UTILITY BEING REMOVED. NEW UTILITY TO ROUTE UNDERGROUND IN NEW CONDUIT. COORDINATE WITH SITE AND LOW VOLTAGE TRADES AS REQUIRED PRIOR TO REMOVAL.

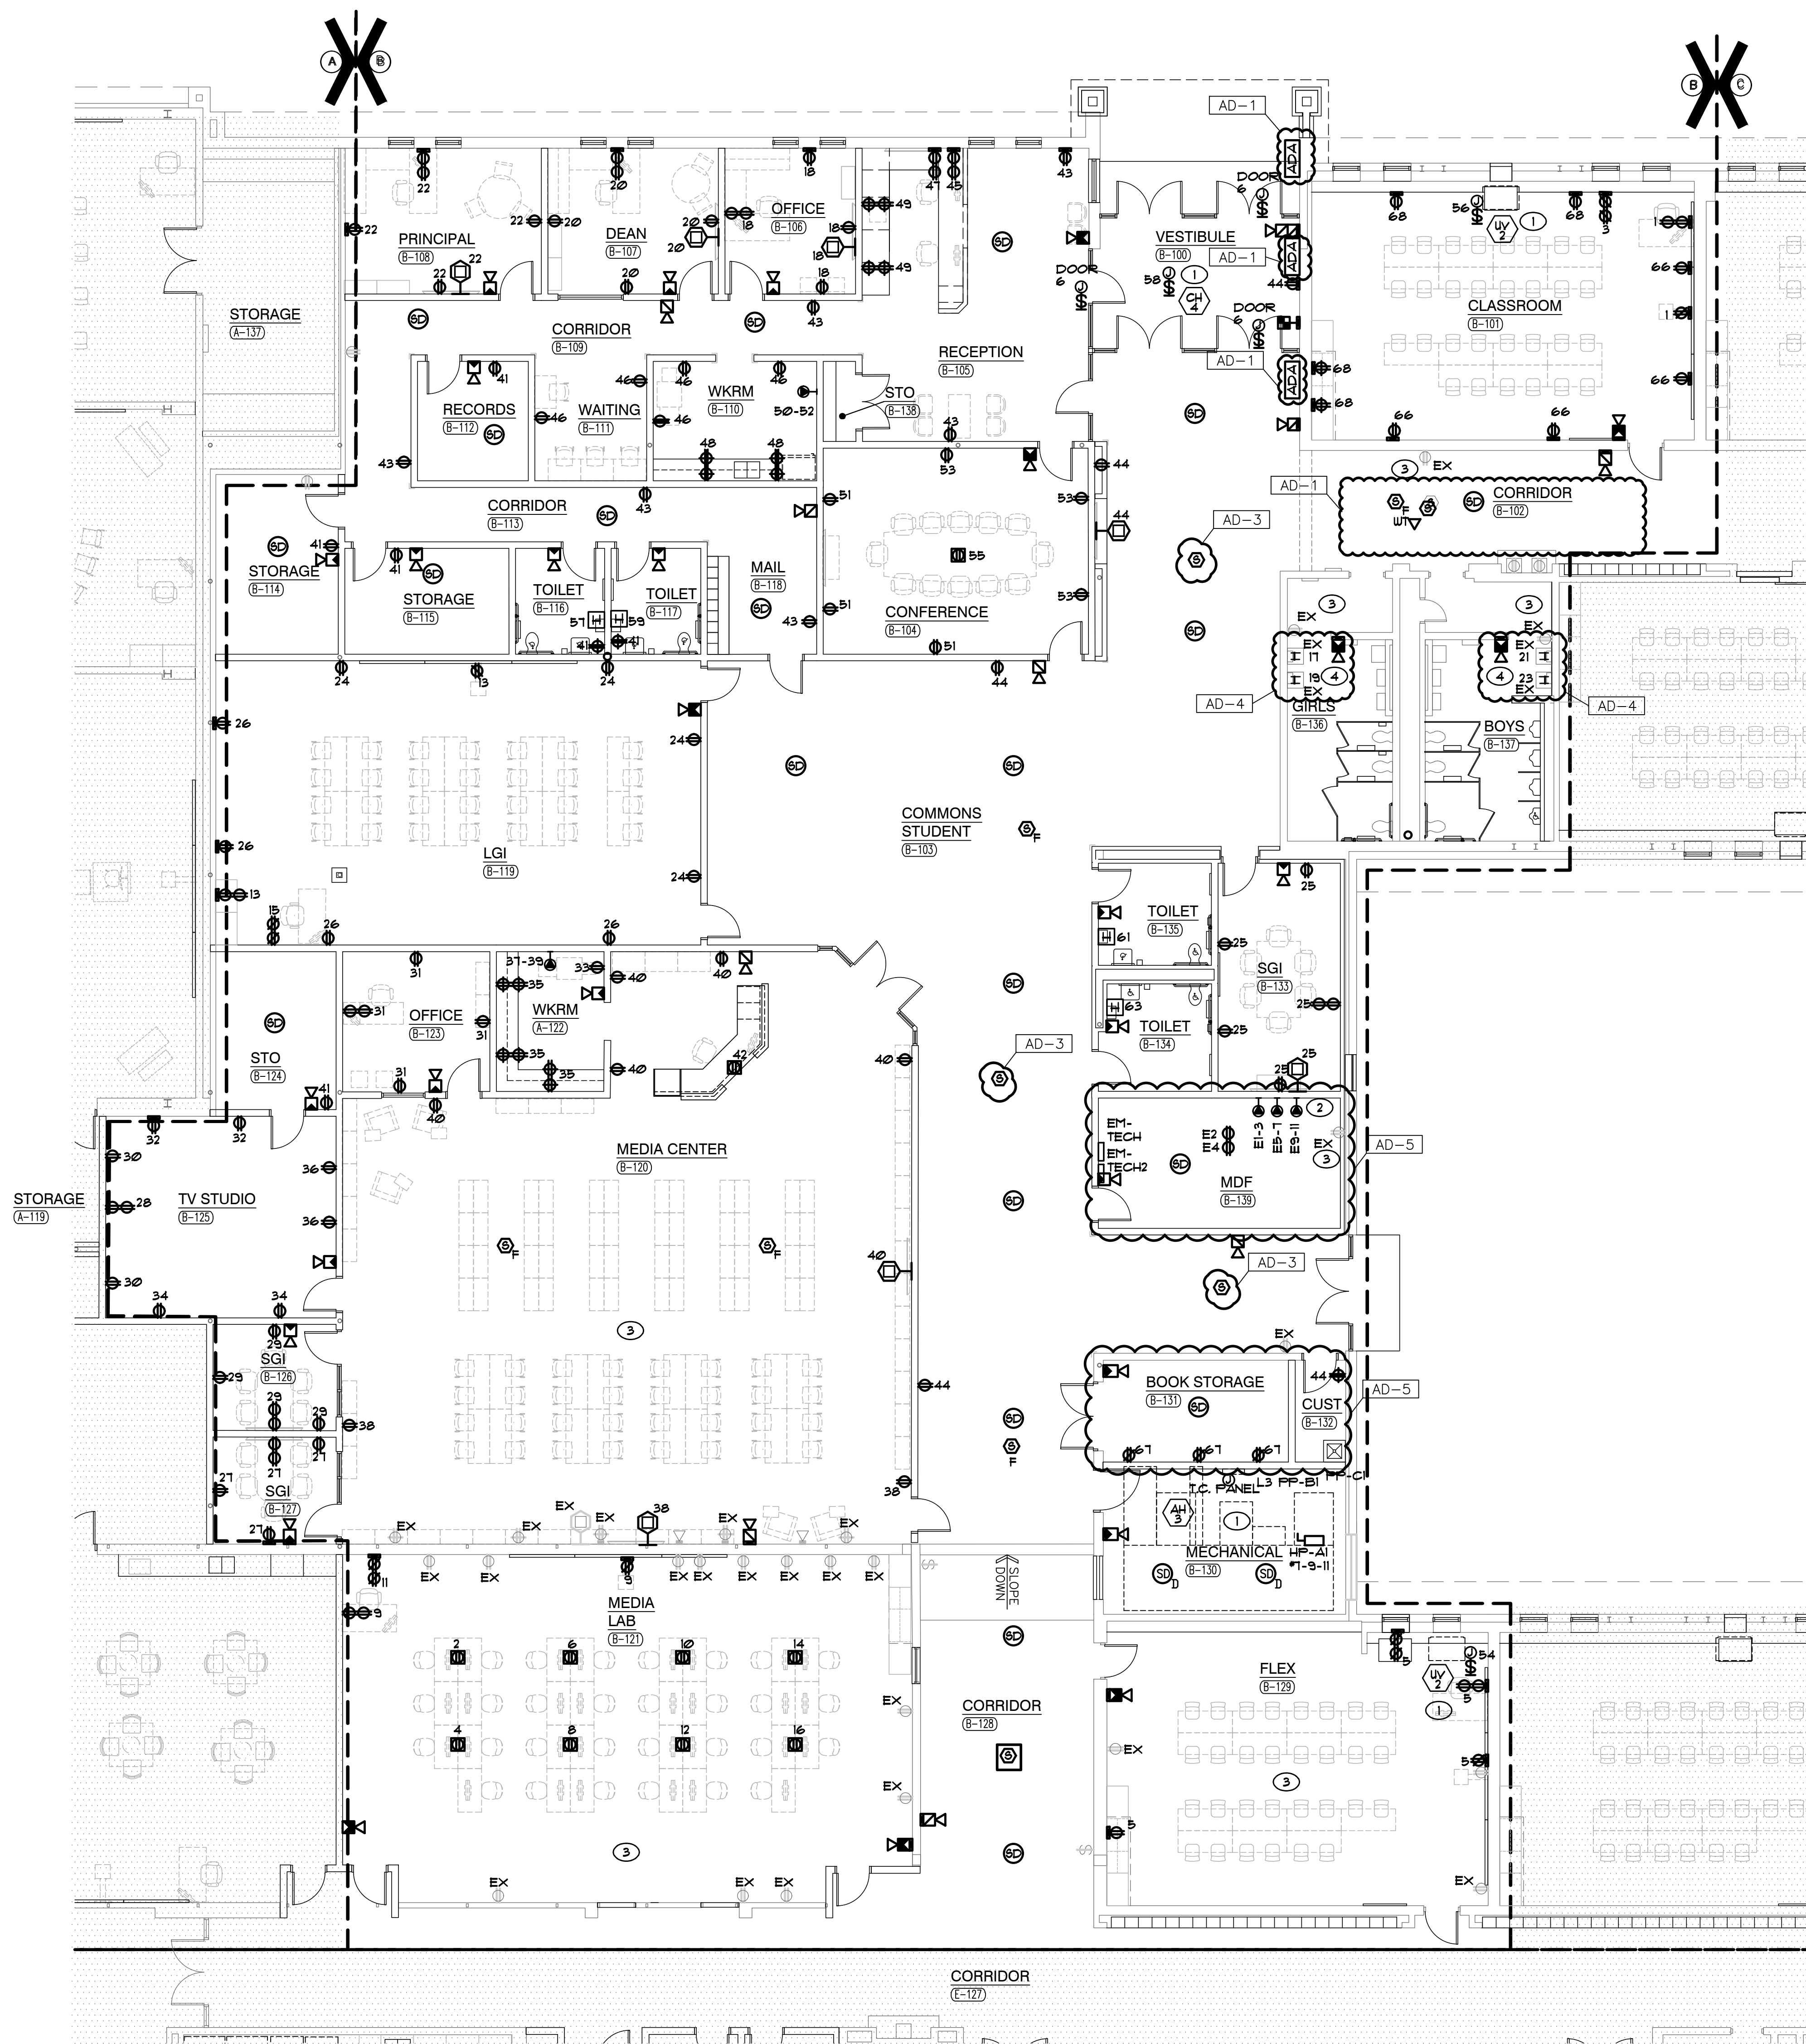

UNIT "B" ELECTRICAL FIRST FLOOR POWER PLAN
SCALE: 1/8" = 1'-0"

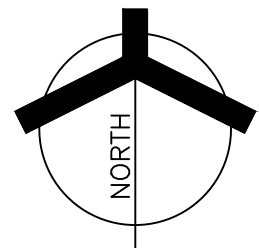

GENERAL NOTES

1. CIRCUIT ALL DEVICES TO PANEL PP-B1 UNLESS OTHERWISE NOTED.
2. REFER TO LOW VOLTAGE DRAWING FOR ROUGH-IN AND RACEWAY INFORMATION FOR ACCESS CONTROL, SOUND SYSTEMS, TECHNOLOGY SYSTEMS AND EQUIPMENT. SEE TECHNOLOGY DRAWINGS AND SPECIFICATIONS FOR LOCATIONS OF DEVICES/EQUIPMENT, MOUNTING HEIGHTS AND ELECTRICAL REQUIREMENTS. COORDINATE AND VERIFY EXACT LOCATIONS OF ALL OF THESE ROUGH-INS AND REQUIREMENTS WITH TECH DYNE, ARCHITECT, OWNER, CONSTRUCTION MANAGER AND DIVISION 21 CONTRACTOR PRIOR TO ROUGH-IN.
3. ALL DEVICES WITH BOX BASES SHALL BE SURFACE MOUNTED TO THE EXISTING WALL. CONTRACTOR SHALL PROVIDE NEW NEATLY ROUTED SURFACE RACEWAY AND SURFACE RACEWAY BACKBOXES FOR NEW DEVICES LOCATED ON EXISTING WALLS. CONTRACTOR SHALL VERIFY EXACT ROUTING OF SURFACE RACEWAY WITH ARCHITECT PRIOR TO INSTALLATION.
4. CIRCUIT ALL DEVICES WITH A 'E' PREFIX TO NEW PANEL EM-TECH1.

SHEET NOTES

1. REFER TO MECHANICAL EQUIPMENT CONNECTION SCHEDULE FOR ELECTRICAL CIRCUITING AND WIRING REQUIREMENTS.
2. TELECOM GROUNDING BUSBAR, COORDINATE FINAL LOCATION IN ROOM WITH TECHNOLOGY EQUIPMENT INSTALLER. REFER TO GROUNDING DETAIL AND GROUNDING BUSBAR DETAIL FOR ADDITIONAL INFORMATION.
3. RECONNECT EXISTING RECEPTACLES TO NEW NORMAL POWER BRANCH CIRCUITRY IN NEW PANELS INSTALLED COMPLETE AS REQUIRED, MAXIMUM 1400W PER 120 VOLT CIRCUIT. WHERE NECESSARY, DUE TO LIMITATIONS IN THE EXISTING BRANCH CIRCUITRY, THIS CONTRACTOR SHALL FURNISH AND INSTALL 20A-1 POLE CIRCUIT BREAKERS AS REQUIRED IN NEW PANEL AND EXTEND 2 #2 AND 1 #2 GND IN 3" CONDUIT COMPLETE AS REQUIRED. VERIFY CONDITIONS AND REQUIREMENTS IN FIELD.
4. INSTALL EXISTING HAND DRYER(S) ORIGINALLY RETAINED DURING DEMOLITION. PROVIDE NEW CIRCUIT AS INDICATED



GIBRALTAR
DESIGN


ARCHITECTURE • ENGINEERING • INTERIOR DESIGN



PROJECT

**LIBERTY
INTERMEDIATE
SCHOOL -
ADDITIONS &
RENOVATIONS**

DUNELAND SCHOOL CORPORATION
CHESTERTON, INDIANA

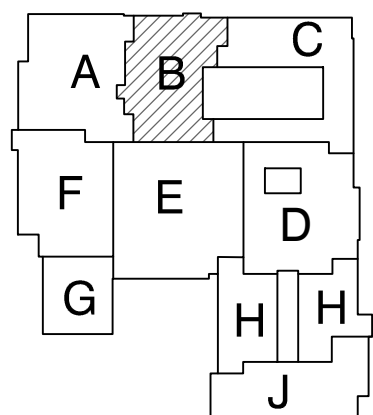


KEY PLAN

GIBRALTAR DESIGN

9102 N. Meridian St., Ste. 300
Indianapolis, IN 46260
Homepage: www.GibraltarDesign.com
Email: info@GibraltarDesign.com
Phone: 317.580.5777 Fax: 317.580.5778

PROJECT
21-139
DATE
04/25/22
COORDINATED BY
JC
DRAWN BY
MS
CHECKED BY
DJ

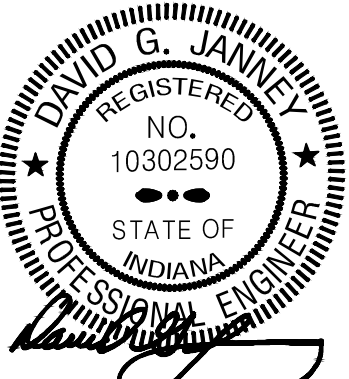

COPYRIGHT NOTICE:
THE CONCEPTS, DESIGNS, PLANS, DETAILS, ETC., SHOWN ON THIS DOCUMENT ARE THE PROPERTY OF GIBRALTAR DESIGN AND WERE CREATED FOR USE ON THIS SPECIFIC PROJECT. NONE OF THIS INFORMATION SHALL BE USED BY ANY PERSON OR FIRM FOR ANY PURPOSE WITHOUT THE EXPRESS WRITTEN CONSENT OF GIBRALTAR DESIGN. THE OWNER MAY RETAIN COPIES FOR INFORMATION AND REFERENCE IN CONNECTION ONLY WITH THIS PROJECT.

REVISIONS		
MARK	DATE	ISSUED FOR
AD-1	05/05/22	ADDENDUM NO. 1
AD-3	05/12/22	ADDENDUM NO. 3
AD-4	05/18/22	ADDENDUM NO. 4
AD-5	05/23/22	ADDENDUM NO. 5

DRAWING
**UNIT "B" ELECTRICAL
FIRST FLOOR POWER
PLAN**

PROJECT
**LIBERTY IS -
ADDITIONS & RENOVATIONS**

© GIBRALTAR DESIGN SHEET
B EP102

AD-5

DUNELAND SCHOOL CORPORATION
CHESTERTON, INDIANA[illegible]

GIBRALTAR DESIGN	SHEET
------------------	-------

TS-100