

**ADDENDUM
NO. 3**

February 2, 2023

**The Riviera Club Aquatics Center
5640 North Illinois Street
Indianapolis, IN 46208**

TO: ALL BIDDERS OF RECORD

This Addendum forms a part of and modifies the Bidding Requirements, Contract Forms, Contract Conditions, the Specifications, and the Drawings dated December 5, 2022, by Schmidt Associates, Inc. Acknowledge receipt of the Addendum in the space provided on the Bid Form. Failure to do so may subject the Bidder to disqualification.

This Addendum consists of Pages ADD 3-1, RFI Listing and attached Schmidt Associates Addendum No. 3 Dated January 31, 2023, Consisting of 25 pages, Specification Sections: 230923 – Digital Control System for HVAC and Addendum Drawings: G000, CL101, LP101, SF1A1, SF1AM, S-401, S-414, AF1B1, A-600, AQS102, M101, M102, M301, M601, M901, P100, P101, P903, E101, E201, E301, E500, E501.

A. SPECIFICATION SECTION 01 23 00 ALTERNATES

Add the following Alternate:

E. Alternate No 5 – Youth Pool and Splash Pad

- a. Base Bid: None
- b. Alternate Bid: Provide Equipment Building and all MEP scope for the Youth Pool and Splash Pad as indicated on the drawings. Youth pool, splash pad features, and associated concrete to be bid at a later date.



Better Foresight
 Better Insight
 Better On-Site
 317.263.6226
 Indianapolis IN
 schmidt_arch.com

Bidding Questions & Responses

2021-178.RVI
 Riviera Club Aquatics Center
 1/31/2023

ID	Question	Answer
BID RFI-001	The General Notes #2 on Sheet CD101 states to "See Electrical Site Plan, for all Electrical , Phone and Technology Demolition Work. There wasn't any electrical site drawings for demolition or install issued in the contract drawings. Will these drawing be issued?	Response (Answered) from: Joyce Myers/Zach Markell (KBSO) Remarks: Addressed in Addenda No. 1 & 2.
Bid RFI-002	Both the civil drawings and the electrical drawings calls out the location of the generator, but I did not see any location calling out the location of the utility transformer. Please advise.	Response (Answered) from: Joyce Myers/Zach Markell (KBSO) Remarks: Addressed in Addenda No. 1 & 2.
Bid RFI-003	There are no details or detail drawings shown for the installation of the utility transformer or generator pad. Please provide details.	Response (Answered) from: Joyce Myers/Zach Markell (KBSO) Remarks: Addressed in Addenda No. 1 & 2.
Bid RFI-004	On Sheet E101, it shows a location for (1) flow & (1) tamper switch located in room BLDG MECH 04. Sheet Keynotes #20 states to coordinate the quantity and location of the tamper and flow switches with the Fire Protection contractor. There are no FP drawings issued in the contract drawing set. Is there a FP contractor and/or will there be any FP drawings issued?	Response (Answered) from: Joyce Myers/Zach Markell (KBSO) Remarks: Addressed in Addenda No. 1 & 2.
Bid RFI-005	Sheet E000 shows the symbols for the Fire Alarm System. In the Specifications, Division 28 has spec section 283100 – Digital, Addressable Fire-Alarm System. However, this spec section appears to be a PDF of the draft document because it has line items stating to insert data (i.e. approved manufacturer etc.). Is there a preferred fire alarm vendor the Riviera Club uses and what Make & model does the Fire system need to be?	Response (Answered) from: Joyce Myers/Zach Markell (KBSO) Remarks: Addressed in Addenda No. 1 & 2.
Bid RFI-006	In the spec section, the Table of Contents, under Division 27, states "NOT APPICABLE". On Sheet E000 there is not any schedule or table showing Division 27 Identity symbols. Sheet E000 does show Fire Alarm Identity symbols and some miscellaneous" Rough-IN Identity Symbols". Sheet E101 Sheet Keynotes#16 states to provide a wall mount hinged 26 RU Technology Rack Enclosure. This is typically a Division 27 item. Does this need to be included in the bid?	Response (Answered) from: Joyce Myers/Zach Markell (KBSO) Remarks: Addressed in Addenda No. 1 & 2.
Bid RFI-007	The following symbols have not been designated in the contract documents.	Response (Answered) from: Joyce Myers (KBSO) Remarks: Addressed in Addenda No. 1.

ID	Question	Answer
Bid RFI-008	Specification section calls for exterior doors to be Kawneer 500T thermally broken doors and the interior doors to be 500 wide stile doors. Would the doors exposed to the pool for example 19, 02.2, and 11.3 need to be thermally broken?	Response (Answered) from: Brandon Fox (SAI) Remarks: No.
Bid RFI-009	Spec Section 06 16 00 2.4 - Indicates this is a 3/4" ventilated nailbase. The roof assembly detail 1C - SH-1 on drawing AR100 does not indicate a ventilated nailbase. Please indicate which is correct?	Response (Answered) from: Brandon Fox (SAI) Remarks: To be addressed in Addendum No. 1.
Bid RFI-010	Roof Assembly SP-2 / 1B on sheet AR100 - This roof assembly has a note that indicates there should be no penetrating fasteners. Spec section 07 54 23 3.4.2 indicates the substrate board should be fastened to the metal deck. Please indicate which is correct? (NRCA does not recommend adhering directly to the metal deck. In this instance, it would be recommended to fasten the substrate to the deck using stainless steel fasteners and adhering the remainder of the roof assembly to the vapor retarder with low rise foam adhesive)	Response (Answered) from: Brandon Fox (SAI) Remarks: No penetrating fasteners above pool environment.
Bid RFI-011	The substrate board in specification 07 54 23 2.5.A states it should be 5/8" thick. Roof assembly SP-2 on sheet AR100 indicates the substrate board to be 1/4". We assume 5/8" is the desired thickness. Please confirm.	Response (Answered) from: Brandon Fox (SAI) Remarks: Substrate boards as specified, with the exception of the bottom layer of substrate board at pool environment which can be 1/4" as indicated.
Bid RFI-012	Specification 07 54 23 2.5.A indicates the substrate board can be type X drywall. Please confirm this is correct.	Response (Answered) from: Brandon Fox (SAI) Remarks: To be addressed in Addendum No. 1.
Bid RFI-013	Specification 07 54 23 2.8.D mentions a cover board but it is not specified. The roof assemblies SP-1 and SP-2 show / mention a coverboard but again it is not specified. What type of coverboard should this be? What thickness?	Response (Answered) from: Brandon Fox (SAI) Remarks: Per specs, roofing membrane manufacturer's approved and warranted cover board.
Bid RFI-014	Specification 07 54 23 2.9.A indicates there are walk way pads but there are none shown on the drawings. Please confirm no walk way pads are required?	Response (Answered) from: Brandon Fox (SAI) Remarks: To be addressed in Addendum No. 1. Also refer to General Roof Plan Note D.
Bid RFI-015	Can the fastening method of the roof assemblies SP-2 and SP-1 be clarified? Spec section 07 54 23 3.6.H indicates to fasten all layers of the insulation but paragraph 07 54 23 3.6.H.2 indicates to fasten the bottom layer and adhere the top layers. (Adhering a roof assembly with low rise foam adhesive is very expensive. The most cost effective assembly while still obtaining a thermal break would be to adhere an HD ISO cover board only and fasten all layers of insulation)	Response (Answered) from: Brandon Fox (SAI) Remarks: To be addressed in Addendum No. 1.

ID	Question	Answer
Bid RFI-016	The AQ drawings indicate the Pool Concrete is to be Mix Design Class "B" however drawing S-600 doesn't reflect the mix designs as which is Class "B". Please confirm the mix design for the pool concrete work as I see the pool concrete is to contain DCI that is not included in any of the S-600 mixes.	Response (Answered) from: Jake Shelley (LHB) Remarks: To be addressed in Addendum No. 1.
Bid RFI-017	Is there to be underdrain monitoring well as not shown on the AQ drawings?	Response (Answered) from: Marv Trietsch (ARD) Remarks: No requirement for monitoring well (soils report indicates water table at -12'. Structurally no reason for it
Bid RFI-018	Substitution Request: 095113 - Soundcore Single Baffles	Response (Answered) from: Asia Coffee (SAI) Remarks: To be addressed in Addendum #1.
Bid RFI-019	Substitution Request: 081613.99 - Special-Lite AF-200 door and AF-150 frame	Response (Answered) from: Brandon Fox (SAI) Remarks: To be addressed in Addendum No. 1.
Bid RFI-020	Substitution Request: 230923 - Reliable Controls	Response (Answered) from: Joyce Myers (KBSO) Remarks: After discussion with the manufacturer, Reliable Controls will not be allowed to bid this project as an acceptable manufacturer.
Bid RFI-021	102600 - Wall and Door Protection, states that Custom Digital Graphics by Construction Specialties - Acrovyn by Design, are to be made with 0.060" thickness. This material is only available in a 0.040" thickness material. Can the Architect please revise this thickness as such?	Response (Answered) from: Asia Coffee (SAI) Remarks: To be addressed in Addendum #1.
Bid RFI-022	Substitution Request: 098413 Sound Seal S-2100 High Impact Acoustical Wall Panels	Response (Answered) from: Asia Coffee (SAI) Remarks: To be addressed in Addendum #1.
Bid RFI-023	Substitution Request: 095113 - Sound Seal Vertex Slim	Response (Answered) from: Asia Coffee (SAI) Remarks: Rejected.
Bid RFI-024	Plastic locker type Y is shown as a 4 tier unit on sheet A401. Specs call for 2 tier. Please clarify which is correct.	Response (Answered) from: Brandon Fox (SAI) Remarks: To be addressed in Addendum No. 1.
Bid RFI-025	Is a certain fire rating or flame spread rating required on the plastic lockers?	Response (Answered) from: Brandon Fox (SAI) Remarks: Bid to the best of your ability based on available information.
Bid RFI-026	Are the loose benches in rooms 09 and 10 part of the scope? If so, please provide specification section and details.	Response (Answered) from: Brandon Fox (SAI) Remarks: To be addressed in Addendum No. 1.
Bid RFI-027	Fire protection: Are we to assume that the area surrounding the pool "Pool Deck" is to be protected?	Response (Answered) from: Joyce Myers (KBSO) Remarks: Yes.
Bid RFI-028	Sheet AR100 Note 6 calls out a pergola on the south side of the pool area. Will protection need to be accounted for under this pergola area?	Response (Answered) from: Brandon Fox (SAI) Remarks: Unable to address prior to addendum being issued.

ID	Question	Answer
Bid RFI-029	Electrical, referencing items from Addendum 1: Does both control panels need to be six pole, 365-day programmable control, astronomical timeclock, and photocell compatability	Response (Answered) from: Joyce Myers (KBSO) Remarks: To be addressed in Addendum No. 2.
Bid RFI-030	Electrical, referencing items from Addendum 1: Are the approved manufacturers for the Lighting Control Panels the same as listed in Spec Section 260923.2.1.A?	Response (Answered) from: Joyce Myers (KBSO) Remarks: To be addressed in Addendum No 2.
Bid RFI-031	Substitution Request: Summit Phenolic Lockers	Response (Answered) from: Brandon Fox (SAI) Remarks: Rejected (remaining with plastic).
Bid RFI-032	The structural drawings, on the foundation plans on the bid set as well as both addendums call for "Grout block cores @ bars" but when I go to the details on S401, they call for "Grout all block cores and collar joints solid below grade". Can you clarify if I am supposed to follow the details on S401 or if I am supposed to follow the foundation floor plan notes?	Response (Answered) from: Jake Shelley (LHB) Remarks: To be addressed in Addendum No. 3.
Bid RFI-033	Along with the grouting locations, can you clarify if the foundation on detail 5/S401 is supposed to be a 12" block, 3" insulation, and a 4" block instead of only a 12" and 4" block. I am confused as to why details 3/S401 and 4/S401 show the 12"CMU+3" Insualtion+4" CMU but the detail 5/S401 is only 12"CMU+4"CMU. See pictures below for more clarification.	Response (Answered) from: Jake Shelley (LHB) Remarks: To be addressed in Addendum No. 3.
Bid RFI-034	Substitution Request: 237313 Ice Western Sales	Response (Answered) from: Joyce Myers (KBSO) Remarks: Rejected.
Bid RFI-035	Substitution Request: 237416 Ice Western Sales	Response (Answered) from: Joyce Myers (KBSO) Remarks: Rejected.

ADDENDUM NO. 3

JANUARY 31, 2023

PREPARED BY SCHMIDT ASSOCIATES FOR:
THE RIVIERA CLUB AQUATICS CENTER
THE RIVIERA CLUB

This Addendum consists of 2 Addendum pages and 23 attachment pages totaling 25 pages.

Acknowledge receipt of this Addendum by inserting its number on the Bid Form. Failure to do so may subject the Bid to disqualification. This Addendum is part of the Contract Documents.

Bidder is encouraged to verify with reprographer of record all Addenda issued (do not rely exclusively on third party plan room services).

PART 1 - CHANGES TO PRIOR ADDENDA (NOT APPLICABLE)

PART 2 - CHANGES TO THE PROJECT MANUAL

Modifications described herein shall be incorporated in the Project Manual. All other Work shall remain unchanged.

2.1 DIVISION 23 - HEATING, VENTILATING, AND AIR-CONDITIONING(HVAC)

A. Section 230923 "DIGITAL CONTROL (DDC) SYSTEM FOR HVAC"

1. DELETE AND REPLACE Paragraph 5.2.B. in its entirety and replace with the following:
"B. The Control System Contractor shall provide 40 hours of comprehensive training in two separate sessions (80 hours total) for system orientation, product maintenance and troubleshooting, programming and engineering. How the 80 training hours (total) shall be used will be discussed and approved with the owner to best suit their needs."

PART 3 - CHANGES TO THE DRAWINGS

Modifications described herein shall be incorporated in the Drawings. All other Work shall remain unchanged.

3.1 DRAWING SHEETS: ADDITIONS, DELETIONS AND REPLACEMENTS

DRAWING NO.	INDICATE ACTION: REPLACE (R), ADD (A), DELETE (D)
G-SERIES DRAWINGS	
G-000	DELETE AND REPLACE
C-SERIES DRAWINGS	
CL101	DELETE AND REPLACE
LP101	DELETE AND REPLACE
S-SERIES DRAWINGS	
SF1A1	DELETE AND REPLACE
SF1AM	DELETE AND REPLACE
S-401	DELETE AND REPLACE
S-414	DELETE AND REPLACE
A-SERIES DRAWINGS	
AF1B1	DELETE AND REPLACE
A-600	DELETE AND REPLACE
AQ-SERIES DRAWINGS	
AQS102	ADD
M-SERIES DRAWINGS	
M101	DELETE AND REPLACE
M102	DELETE AND REPLACE
M301	DELETE AND REPLACE
M601	DELETE AND REPLACE
M901	DELETE AND REPLACE
P-SERIES DRAWINGS	
P100	DELETE AND REPLACE
P101	DELETE AND REPLACE
P903	DELETE AND REPLACE
E-SERIES DRAWINGS	
E101	DELETE AND REPLACE
E201	DELETE AND REPLACE
E301	DELETE AND REPLACE
E500	DELETE AND REPLACE
E501	DELETE AND REPLACE

END OF ADDENDUM 3

The Riviera Club Aquatics Center

2021-178.RVI
5640 N Illinois St
Indianapolis, IN 46208

THE RIVIERA CLUB
EST. 1933



12.05.2022

2021-178.RVI



SHEETS ADDED BY ADDENDUM:
ADDENDUM NO. 1
S-402
P901
P902
P903
E101
ADDENDUM NO. 2
S-414
AF1B1
ADDENDUM NO. 3
A03T12

SHEET INDEX

Number	Sheet Name
1 - General	
G-000	COVER SHEET
G-101	FIRE AND LIFE SAFETY PLAN
2 - Site	
C-001	SITE GENERAL NOTES AND ABBREVIATIONS
1 OF 1	SITE SURVEY
CD101	SITE DEMOLITION PLAN
CL101	SITE LAYOUT PLAN
CL501	SITE LAYOUT DETAILS
CG101	GRADING PLAN
CU101	UTILITY PLAN
CUS01	SITE UTILITY DETAILS
CUS02	SITE UTILITY DETAILS
CUS03	SITE UTILITY DETAILS
CUS04	SITE UTILITY DETAILS
CE101	EROSION CONTROL PLAN
CE501	EROSION CONTROL DETAILS
CE502	EROSION CONTROL DETAILS
LP101	PLANTING PLAN
3 - Structural	
SF1A1	FOUNDATION PLAN
SF1A1	LOW ROOF FRAMING PLAN
SF1AM	MANSARD FRAMING PLAN
SF1AR	HIGH ROOF FRAMING PLAN
S-400	TYPICAL FOUNDATION SECTIONS & DETAILS
S-401	FOUNDATION SECTIONS & DETAILS
S-402	FOUNDATION SECTIONS & DETAILS
S-410	TYPICAL FRAMING & MASONRY SECTIONS & DETAILS
S-411	FRAMING SECTIONS & DETAILS
S-412	FRAMING SECTIONS & DETAILS
S-413	FRAMING ELEVATIONS
S-414	FRAMING SECTIONS & DETAILS
S-600	STRUCTURAL NOTES
4 - Architectural	
A-001	ARCHITECTURAL GENERAL NOTES AND ABBREVIATIONS
A-002	TYPICAL WALL TYPES
AF1A1	FIRST FLOOR PLAN - UNIT A
AF1B1	OUTDOOR EQUIPMENT BUILDING (ALT)
AC1A1	FIRST FLOOR REFLECTED CEILING PLAN - UNIT A
AR100	ROOF PLAN
A-200	OVERALL ELEVATIONS
A-300	BUILDING SECTIONS
A-301	BUILDING SECTIONS
A-310	WALL SECTIONS
A-311	WALL SECTIONS
A-400	ENLARGED PLANS & RAILING DETAILS
A-401	LOCKER DETAILS
A-500	TYPICAL OPENING & SECTION DETAILS
A-600	DOOR & FRAME SCHEDULE
A-900	ISOMETRICS
5 - Interiors	
INTA1	FIRST FLOOR INTERIOR FINISH PLAN
I-201	INTERIOR ELEVATIONS
I-202	ENLARGED DESK PLAN AND CASEWORK ELEVATIONS
I-601	ROOM SIGN TYPES
6 - Aquatics	
AGS100	POOL STRUCTURAL PLAN & ELEVATION
AGS101	POOL UNDERSLAB & PERIMETER DRAIN PLAN
AGS102	OUTDOOR POOL AND SECTIONS
AGS400	POOL STRUCTURAL ELEVATIONS
AGS401	POOL STRUCTURAL SECTIONS & DETAILS
AG100	GENERAL NOTES AND ABBREVIATIONS
AG200	POOL DECK PLAN
AG201	UNDERGROUND PLAN
AG202	POOL DIMENSION PLAN
AG300	POOL EQUIPMENT PLAN
AG400	POOL SECTIONS
AG500	POOL PIPING DIAGRAM
AG501	CHEMICAL CONTROLLER & WIRING DIAGRAMS
AG600	SWIMMING POOL SCHEDULES
AG700	POOL DETAILS
AG701	POOL DETAILS
AG702	POOL DETAILS
AG703	POOL DETAILS
AG704	POOL DETAILS
AG705	POOL DETAILS
AG706	POOL DETAILS
AG707	POOL DETAILS
AG708	POOL DETAILS
AG709	POOL DETAILS
AG700	TIMING SYSTEM DECK PLAN
7 - Mechanical	
M000	SYMBOLS AND ABBREVIATIONS
M101	FIRST FLOOR MECHANICAL PLAN
M102	ROOF MECHANICAL PLAN
M301	MECHANICAL SECTIONS
M501	MECHANICAL DETAILS
M901	MECHANICAL SCHEDULES
M901	TEMPERATURE CONTROL DIAGRAMS
8 - Plumbing	
P000	SYMBOLS AND ABBREVIATIONS
P100	FOUNDATION PLUMBING PLAN
P101	FIRST FLOOR PLUMBING PLAN
P102	ROOF PLUMBING PLAN
P601	PLUMBING DETAILS
P601	PLUMBING SCHEDULES
P901	WASTE AND VENT DIAGRAM
P902	DOMESTIC WATER DIAGRAM
P903	GAS PIPING DIAGRAM
9 - Electrical	
E000	SYMBOLS AND ABBREVIATIONS
E101	ELECTRICAL SITE PLAN
E201	FIRST FLOOR ELECTRICAL PLAN
E202	ROOF ELECTRICAL PLAN
E301	FIRST FLOOR LIGHTING
E500	ELECTRICAL PANEL SCHEDULES
ES01	ELECTRICAL SCHEDULES AND DETAILS
ES02	ELECTRICAL DETAILS
ES01	ELECTRICAL DIAGRAMS

General Notes

Nothing set forth in these Drawings shall release any Contractor from responsibility to provide appropriate quantities, field measurements, dimensional stability, installation, anchorage and coordination with other trades, or waive the Contractor's responsibility to identify and resolve deviations from the requirements of the Contract Documents, or waive the Contractor's responsibility to alert the Architect to errors or omissions contained therein.

Each Contractor shall verify in the field all existing applicable conditions and dimensions shown on the Drawings and as pertinent to the intent of these Drawings. Any discrepancy discovered shall be brought to the attention of the Architect prior to the commencement of any Work affected by, or related to, such discrepancy.

Each Contractor shall be responsible for all costs associated with, or caused by failure to comply with requirement.

Each Contractor shall review in advance all portions of the Work to verify that the Work will not prohibit completion of the Project as intended in these Contract Documents. Any questions shall be promptly referred to the Architect for resolution.


Each Contractor shall refer to the Project Manual for cleaning and disposal requirements.

Each Contractor shall be responsible for the protection of all surfaces and finishes at interior and exterior of building. Damaged surfaces and finishes resulting from the performance of the Work shall be repaired at no cost to the Owner by the responsible Contractor to match existing to the satisfaction of the Owner.


Each Contractor shall coordinate respective cutting and patching Work with the other Prime Contractors.

Each Contractor shall become completely familiar with all aspects of the Work, even those areas designated to be provided by others. This familiarization includes full and complete understanding of the Work described on all Sheets of the Drawings and in all Sections of the Project Manual. Failure by the Contractor to become completely familiar and cognizant of all aspects of the Work shall not relieve the Contractor of the responsibility to provide materials, assemblies, or services indicated in the Contract Documents.

Vicinity Map

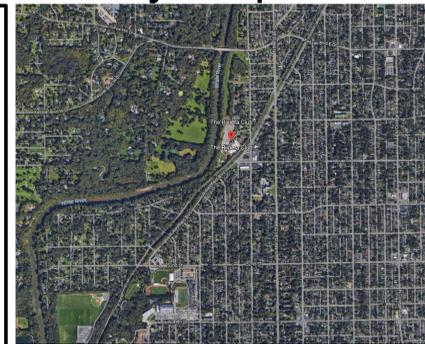

Thoroughfare Map

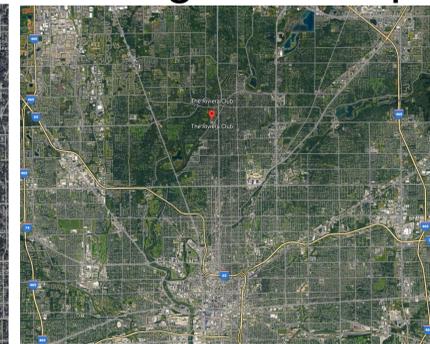

Sarah K. Hempstead



Robert M. De



James J. Kacus



Kyle E. Miller



Joyce Ellen Jones



SCHMIDT
ASSOCIATES

415 Massachusetts Avenue
Indianapolis, IN 46204
www.schmidt-arch.com




Aquatic & Recreation Design



The SKILLMAN Corporation
Project Administration
Construction Management

The Riviera Club
Aquatics Center

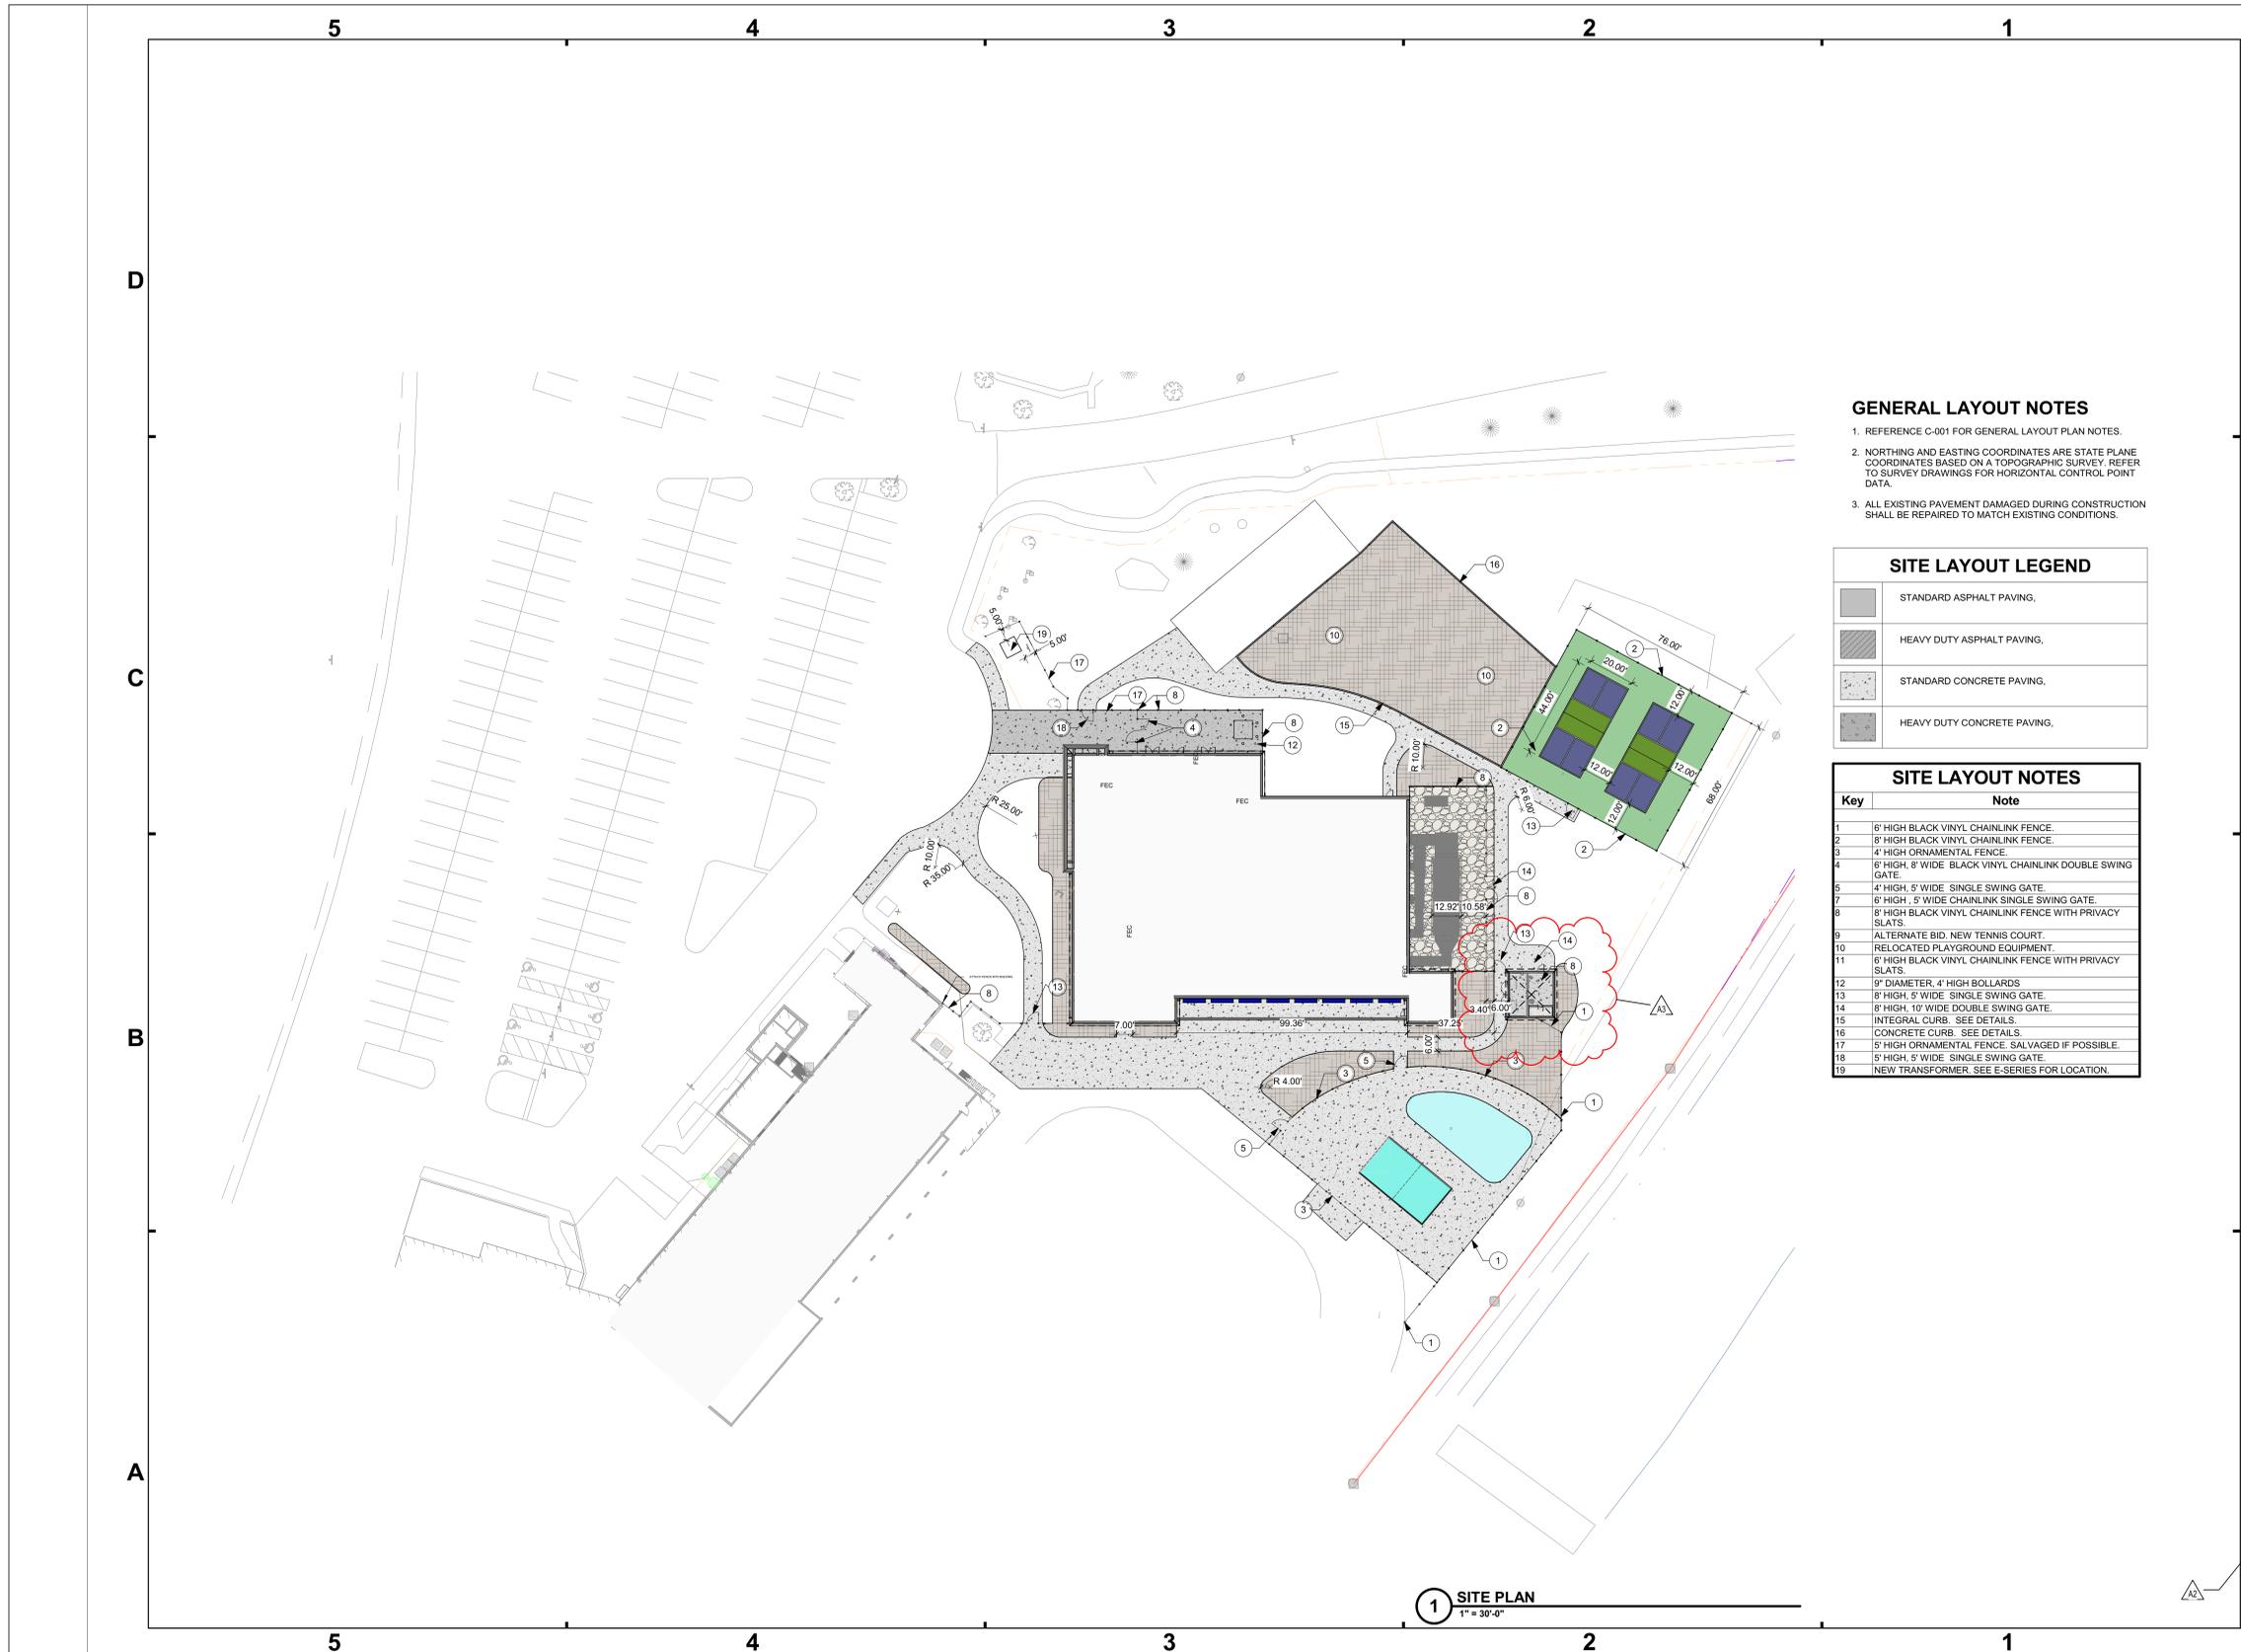

- GENERAL LAYOUT NOTES**
1. REFERENCE C-001 FOR GENERAL LAYOUT PLAN NOTES.
 2. NORTHING AND EASTING COORDINATES ARE STATE PLANE COORDINATES BASED ON A TOPOGRAPHIC SURVEY. REFER TO SURVEY DRAWINGS FOR HORIZONTAL CONTROL POINT DATA.
 3. ALL EXISTING PAVEMENT DAMAGED DURING CONSTRUCTION SHALL BE REPAIRED TO MATCH EXISTING CONDITIONS.

SITE LAYOUT LEGEND

	STANDARD ASPHALT PAVING.
	HEAVY DUTY ASPHALT PAVING.
	STANDARD CONCRETE PAVING.
	HEAVY DUTY CONCRETE PAVING.

SITE LAYOUT NOTES

Key	Note
1	6' HIGH BLACK VINYL CHAINLINK FENCE.
2	8' HIGH BLACK VINYL CHAINLINK FENCE.
3	4' HIGH ORNAMENTAL FENCE.
4	8' HIGH, 8' WIDE BLACK VINYL CHAINLINK DOUBLE SWING GATE.
5	4' HIGH, 5' WIDE SINGLE SWING GATE.
7	6' HIGH, 5' WIDE CHAINLINK SINGLE SWING GATE.
8	8' HIGH BLACK VINYL CHAINLINK FENCE WITH PRIVACY SLATS.
9	ALTERNATE BID. NEW TENNIS COURT.
10	RELOCATED PLAYGROUND EQUIPMENT.
11	6' HIGH BLACK VINYL CHAINLINK FENCE WITH PRIVACY SLATS.
12	9" DIAMETER, 4' HIGH BOLLARDS.
13	8' HIGH, 5' WIDE SINGLE SWING GATE.
14	8' HIGH, 10' WIDE DOUBLE SWING GATE.
15	INTEGRAL CURB. SEE DETAILS.
16	CONCRETE CURB. SEE DETAILS.
17	5' HIGH ORNAMENTAL FENCE. SALVAGED IF POSSIBLE.
18	5' HIGH, 5' WIDE SINGLE SWING GATE.
19	NEW TRANSFORMER. SEE E-SERIES FOR LOCATION.

1 SITE PLAN
1" = 30'-0"



Project No. 2021-178.RVI
Project Date 12.05.2022
Produced KL



These Drawings and Specifications, and all copies thereof are and shall remain the property and copyright of the Architect. They shall be used only with respect to the Project and are not to be used on any other Project or Work without prior written permission from the Architect.

#	Revision	Date
A2	Addendum #2	01-12-2023
A3	Addendum #3	01-31-2023

5640 N Illinois St.
Indianapolis, IN 46208

The Riviera Club

Aquatic Center
Project

SITE LAYOUT PLAN

CL101



Project No. 2021-178.RVI
 Project Date 12.05.2022
 Produced KL



These Drawings and Specifications, and all copies thereof are and shall remain the property and copyright of the Architect. They shall be used only with respect to the Project and are not to be used on any other Project or for any other purpose without prior written permission from the Architect.

#	Revision	Date
A2	Addendum #2	01-12-2023
A3	Addendum #3	01-31-2023


5640 N Illinois St,
 Indianapolis, IN 46208

The Riviera Club

Aquatic Center
 Project

PLANTING PLAN

LP101

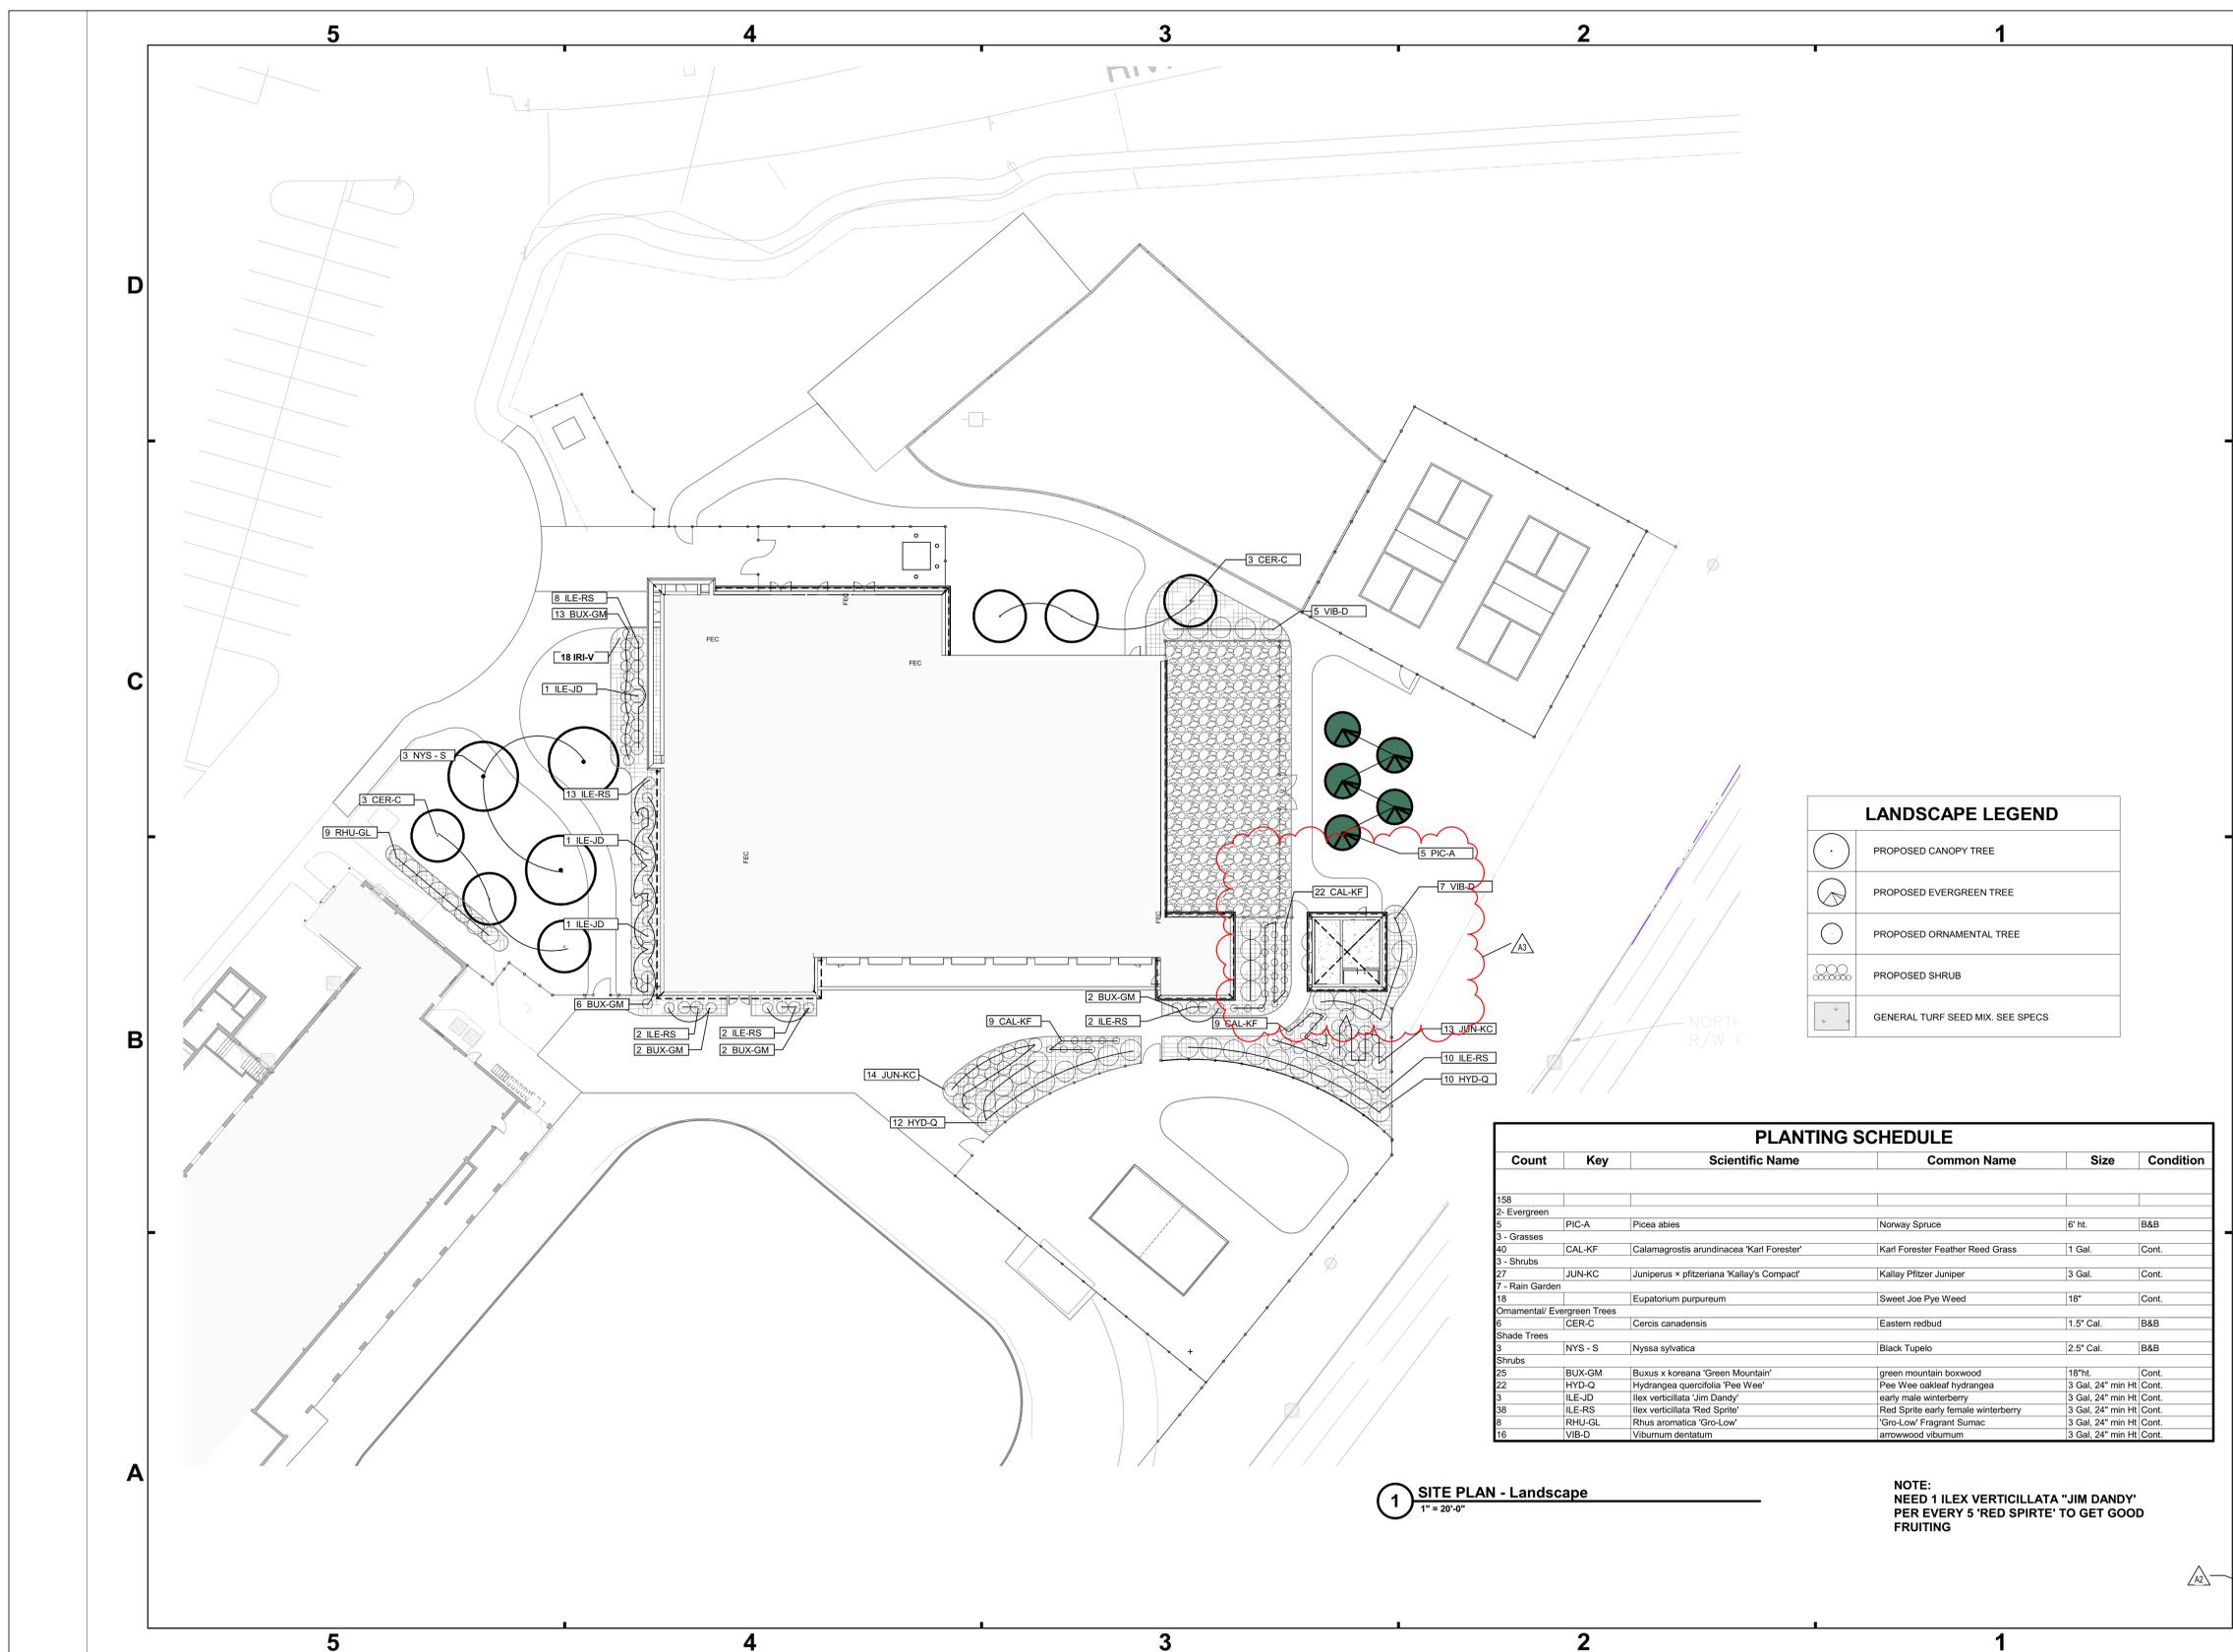

LANDSCAPE LEGEND	
	PROPOSED CANOPY TREE
	PROPOSED EVERGREEN TREE
	PROPOSED ORNAMENTAL TREE
	PROPOSED SHRUB
	GENERAL TURF SEED MIX. SEE SPECS

PLANTING SCHEDULE					
Count	Key	Scientific Name	Common Name	Size	Condition
158					
2	Evergreen				
5	PIC-A	Picea abies	Norway Spruce	6' ht.	B&B
3	Grasses				
40	CAL-KF	Calamagrostis arundinacea 'Karl Forester'	Karl Forester Feather Reed Grass	1 Gal.	Cont.
3	Shrubs				
27	JUN-KC	Juniperus x pfitzeriana 'Kallay's Compact'	Kallay Pfitzer Juniper	3 Gal.	Cont.
7	Rain Garden				
18	Eupatorium purpureum		Sweet Joe Pye Weed	18"	Cont.
Ornamental/ Evergreen Trees					
6	CER-C	Cercis canadensis	Eastern redbud	1.5' Cal.	B&B
Shade Trees					
3	NYS - S	Nyssa sylvatica	Black Tupelo	2.5' Cal.	B&B
Shrubs					
25	BUX-GM	Buxus x koreana 'Green Mountain'	green mountain boxwood	18"ht.	Cont.
22	HYD-Q	Hydrangea quercifolia 'Pee Wee'	Pee Wee oakleaf hydrangea	3 Gal, 24" min HI	Cont.
3	ILE-JD	Ilex verticillata 'Jim Dandy'	early male winterberry	3 Gal, 24" min HI	Cont.
38	ILE-RS	Ilex verticillata 'Red Sprite'	Red Sprite early female winterberry	3 Gal, 24" min HI	Cont.
8	RHU-GL	Rhus aromatica 'Gro-Low'	'Gro-Low' Fragrant Sumac	3 Gal, 24" min HI	Cont.
16	VIB-D	Viburnum dentatum	arrowwood viburnum	3 Gal, 24" min HI	Cont.

1 SITE PLAN - Landscape
 1" = 20'-0"

NOTE:
 NEED 1 ILEX VERTICILLATA "JIM DANDY"
 PER EVERY 5 'RED SPIRTE' TO GET GOOD
 FRUITING



Project No. 2021-178.RV1
 Project Date 12.05.2022
 Produced JMS RMD



These Drawings and Specifications, and all copies thereof are and shall remain the property and copyright of the Architect. They shall be used only with respect to this Project and are not to be used on any other Project or Work without prior written permission from the Architect.

#	Revision	Date
A1	ADDENDUM #1	01/05/2023
A2	ADDENDUM #2	01/12/2023
A3	ADDENDUM #3	1/31/2023

5640 N Illinois St
 Indianapolis, IN 46208

KEY PLAN

The Riviera Club

THE RIVIERA CLUB
 EST. 1933



Aquatics Center

FOUNDATION PLAN

SF1A1


FOUNDATION PLAN NOTES

- REF. S-400 FOR STRUCTURAL NOTES, DESIGN DATA & SCHEDULES.
- ALL CONTRACTORS ARE REQUIRED TO COORDINATE THEIR WORK WITH ALL DISCIPLINES TO AVOID CONFLICTS. THE MECHANICAL, ELECTRICAL, AND PLUMBING ASPECTS ARE NOT IN THE SCOPE OF THESE DRAWINGS. THEREFORE, ALL REQUIRED MATERIALS AND WORK MAY NOT BE INDICATED.
- COORDINATE EXACT SIZE & LOCATION OF ALL MECHANICAL OPENINGS IN FOUNDATION WALLS WITH THE MECHANICAL, ELECTRICAL, & PLUMBING CONTRACTORS.
- ALL ELEVATIONS ARE REFERENCED FROM THE FIRST FLOOR FINISH FLOOR ELEVATION 0'-0" (U.S.G.S. 712.36), REF. CIVIL DWGS.
- REF. ARCH. DRAWINGS FOR ALL DIMENSIONS NOT SHOWN. CONTRACTOR SHALL VERIFY ALL DIMENSIONS PRIOR TO CONSTRUCTION AND IMMEDIATELY NOTIFY ARCHITECT/ENGINEER OF ANY DISCREPANCIES.
- REF. S-400 FOR TYPICAL FOUNDATION DETAILS.
- NOTE: PERIMETER WALL AND COLUMN FOOTINGS SHALL BE LOWERED AND/OR SLEEVED TO PASS BELOW PLUMBING LINES (I.E. SANITARY & STORM SEWERS, WATER LINES, ETC.) SHOWN ON THE PLUMBING DRAWINGS. PROVIDE FOOTING STEPS AS REQUIRED PER THE TYPICAL DETAILS ON S-400.
- ALL SLAB RECESSES SHALL BE LOCATED PER THE ARCHITECTURAL DRAWINGS. COORDINATE DEPTHS OF ALL SLAB RECESSES WITH THE ARCHITECTURAL DRAWINGS AND/OR THE FLOORING SUPPLIER.
- COORDINATE REINFORCING DOWELS FOR CMU VERTICAL REINFORCING WITH REINF. NOTED ON PLANS & SECTIONS.
- GROUT ALL CORES OF CMU BELOW FINISH FLOOR SLID.
- COLUMN FOOTINGS, TRENCH FOOTINGS AND WALL FOOTINGS SHALL BEAR ON APPROVED SOIL. UNDERCUT AS REQ'D TO SUITABLE BEARING MATERIAL AS DETERMINED BY THE GEOTECHNICAL TESTING AGENCY. REF. TYPICAL FOOTING UNDERCUT DETAILS ON SHEET S-400.
- DOWEL ALL INTERIOR NON-LOAD BEARING WALLS TO 6" THICK SLAB ON-GRADE PER DETAIL 10S-400. LAYOUT WALLS PER DIMENSIONS ON ARCHITECTURAL DRAWINGS.
- PROVIDE CONTROL/CONTRACTION JOINTS IN SLABS ON GRADE (REF. THE TYPICAL DETAILS ON SHEET S-400). ALL JOINTS IN SLABS TO RECEIVE THIN OR THICK-SET TERRAZZO, CERAMIC OR PORCELAIN TILE, VINYL COMPOSITION TILE (VCT) OR VINYL SHEET GOODS, EPOXY OR SIMILAR THIN-FILM FINISH FLOORING SHALL BE CAREFULLY COORDINATED WITH THE FLOORING CONTRACTOR. THE CONTRACTOR SHALL SUBMIT SLAB JOINT LAYOUT TO ARCHITECT/ENGINEER FOR REVIEW PRIOR TO PLACING SLABS.
14. PLAN LEGEND:
 - F.F. DENOTES FINISH FLOOR
 - T/X DENOTES TOP OF FTG., SLAB, PIER, ETC.
 - B/X DENOTES BOTTOM OF FTG., ETC.
 - C.J. DENOTES SLAB ON GRADE CONTROL/CONTRACTION JOINT
 - WF36 -2'-0" DENOTES WALL FOOTING MARK & TOP OF FOOTING ELEVATION (SEE WALL FOOTING SCHEDULE)
 - DENOTES PIPE PENETRATION THROUGH FOUNDATION WALL. COORDINATE EXACT LOCATION & VERT. ELEVATION APPROPRIATE TRADE. LOWER BOTTOM OF FOOTING & PROVIDE SLEEVE THROUGH FOUNDATION WALL PER TYPICAL DETAIL ON S-400.
 - S1 DENOTES NEW 4" CONC. SLAB w/ FIBERFORCE 300* FIBERS @ 15 LB/CY, (OR EQUAL) & E5 INTERNAL CURE ADMIXTURE @ 4 OZ/CY & E5 CATALYST SPRAYED ON BETWEEN 800-1,000 SF/GAL OVER 15 MIL VAPOR BARRIER OVER 6" COMPACTED GRANULAR FILL (NO. 53 STONE OR APPROVED EQUIVALENT), TICONG = 0'-0"
 - S2 DENOTES NEW 6" CONC. SLAB w/ 666 W2.9 x W2.9 W.F. & E5 INTERNAL CURE ADMIXTURE @ 4 OZ/CY & E5 CATALYST SPRAYED ON BETWEEN 800-1,000 SF/GAL OVER 15 MIL VAPOR BARRIER OVER 6" COMPACTED GRANULAR FILL (NO. 53 STONE OR APPROVED EQUIVALENT), TICONG = 0'-0"
 - DENOTES WALL FOOTING WITH STEPS, REF. TYP. DETAIL ON S-400

WALL FOOTING SCHEDULE

FTG. MARK	FOOTING SIZE		FOOTING REINFORCING	
	WIDTH	DEPTH	LONGITUDINAL	TRANSVERSE
WF24	2'-0"	1'-0"	(2) #5 x CONTINUOUS	#4 x 1'-6" @ 9" O.C.
WF36	3'-0"	1'-2"	(4) #5 x CONTINUOUS	#4 x 2'-6" @ 9" O.C.

1. CENTER FOOTINGS BENEATH WALLS, U.N.O.

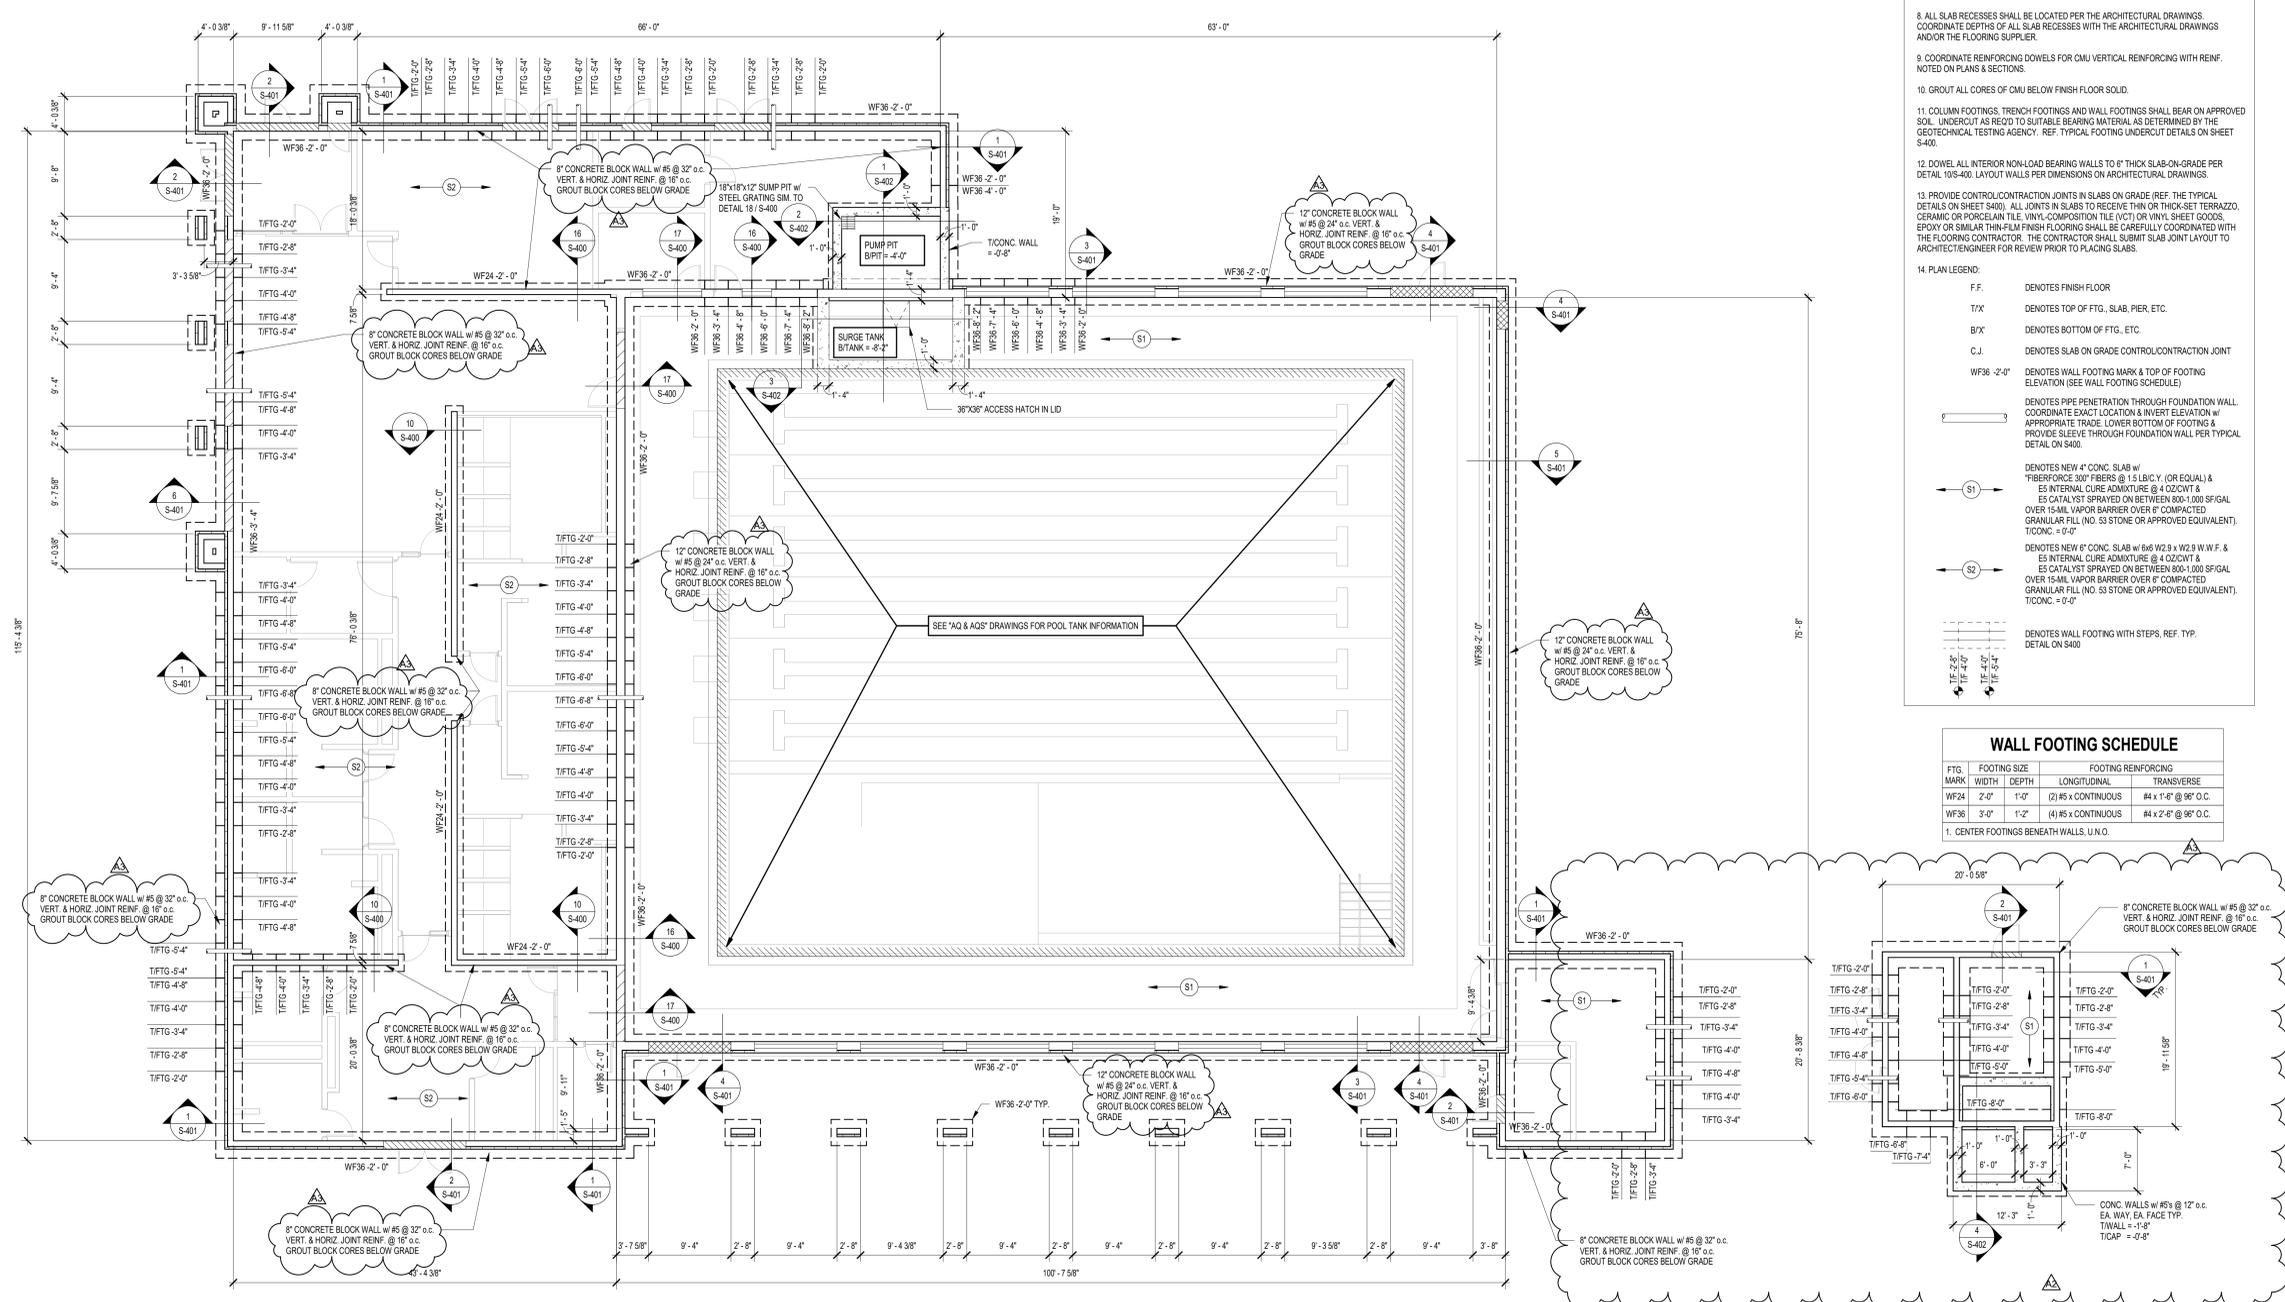

1 FOUNDATION PLAN
 1/8" = 1'-0"

WOOD SHRINKAGE NOTES


The following is a list of recommendations to minimize potential issues related to wood shrinkage and veneer expansion (A portion of clay masonry veneer expansion is irreversible and a portion is seasonal. The majority of wood shrinkage will occur in the first 12-18 months of occupancy. The majority of irreversible clay masonry veneer expansion will occur in the first few weeks, but will continue at a lower rate for several years. Thermal movement is seasonal and variable depending on ambient temperature and sun exposure. The following is a list of recommendations to minimize potential issues related to wood shrinkage and veneer movement.

- Refer to other notes and details to see estimated differential movement between wood framing and brick veneer. If not shown otherwise, a differential movement of 0.15" per floor shall be used for backing of light wood framing for up to 3 stories and 0.20" per floor shall be used for backing of light wood framing for up to 5 stories.
- MEP System Considerations
 - All plumbing pipe and electrical conduit joints and connections shall be flexible and allow for expansion/contraction to prevent a rigid assembly. The use of expansion or slip joints in vertical plumbing runs to allow for wood framing shrinkage is recommended. If not used, another means of mitigating the problem will be required.
 - In lieu of or in addition to A above, provide oversized and vertically slotted holes at pipe horizontal penetration and notches. Refer to typical notching and cutting of stud wall detail for additional considerations on size limitations. Do not exceed the hole sizes allowed by the notes and details and the building code.
 - Hangers and necessary rigid connections shall be adjusted prior to completion of construction or closing of wall ceiling assembly.
 - Vent penetrations shall be provided with double flashing.
 - All sheet metal vertical down spouts shall have intermediate slip joints.
 - Roof drains shall be adjusted back to the roof finish sheathing elevation at the completion of construction and then shall be adjusted as required to maintain proper drainage.
- Construction Tolerance Considerations
 - All studs shall be cut level, square and tight to top and bottom plates to reduce any additional angling of the building due to racking.
 - All wood structural panels on the walls shall have a relief gap at each floor level to reduce the potential for bulging.
 - All floor sheathing shall have 1/8" gaps around all four sides at time of installation to allow for potential bulging.
 - Temporary Expansion Joints in large buildings are required. Follow APA's Technical Note: Temporary Expansion Joints for Large Buildings (A42).
 - At alcove, EPS and thin veneer systems, provide horizontal expansion joints, and slip joints with appropriate flashing.
 - At brick and stone veneers, provide veneer ties designed to accommodate differential movement.
 - Refer to Architectural window and door head sill and jamb details, parapets, and horizontal material changes for specific horizontal gap requirements between materials.
 - Delay placement of self-leveling gypsum underlayment/topping around stair and elevator towers until completion of construction.
- Material Storage and Protection
 - All stored material shall remain covered from the elements to reduce and elevated off the ground to reduce the potential for an increase in moisture content.
 - Do not allow water to pond on installed floor sheathing. Provide drain holes in the floor sheathing as required to relieve any water that might temporarily pond.
- Post Occupancy Consideration
 - Review roof drains every 3 months for the first 18 months of occupancy and then annually. Adjust as needed.
 - Sealant joints at exterior doors, windows and at changes in materials shall be reviewed and caulked as needed as wood shrinkage and veneer expansion occurs and original joint is distressed or fails.
 - Remedial Self-Leveling work may be required around concrete or CMU stair and elevator towers as needed as wood shrinkage occurs.

NOTE: ENGINEER SHALL REVIEW LOADING CONDITIONS ON WALL FOR ALLOWABLE SIZE OF PENETRATION

GAP REQUIRED ABOVE FOR DIFFERENTIAL MOVEMENT/WOOD SHRINKAGE. SEE GENERAL NOTES FOR ANTICIPATED SHRINKAGE OF WOOD STRUCTURE. CONSULT WITH MEP ENGINEER FOR ANTICIPATED MOVEMENT OF CONDUIT OR PIPE.

CONDUIT OR HORIZONTAL PLUMBING RUN LOCATED NEAR THE BOTTOM OF THE HOLE.

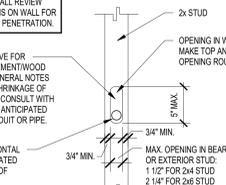



STUD HOLE SHRINKAGE DETAIL

WOOD FRAMING NOTES

- For wood connections not specifically noted or detailed, follow the requirements of IRC 2012 Table 2304.1.1 or ESR-1538.
- All nails are common nails unless noted otherwise. All nails shall be carefully driven and not overdriven. Submit all proposed fasteners for approval prior to construction. Installation of all fasteners shall meet the requirements of NDS and S414 guidelines, including those in ESR-1538, and Section 2303.1.1 of the IRC.
- Refer to the Wall Schedule and/or Framing Plans for size, spacing, and species of wall studs and plates. If not shown otherwise, studs and plates are to be #1 or #2 Spruce-Pine-Fir (SPF) with stud spacing 16" o.c. maximum. If not shown otherwise, bearing wall headers are to be #2 Southern Pine (SP).
- All continuous double studs in non-load bearing interior walls may be premium stud grade spaced at 16" o.c. on all levels.
- Fasten double (DBL) studs together with 0.131" x 3" nails at 8" o.c. unless noted otherwise. For more than two studs, fasten in the same way, nailing as each stud is added.
- See the header schedule for all header sizes and materials. All headers in non-load bearing interior walls are to be (2) 2x4 #2 SPF for openings up to 4'-0" and (2) 2x6 #2 SPF for openings over 4'-0". All headers in non-load bearing walls to have (1) jack stud at each end.
- Refer to the Shear Wall Schedule for sheathing, nailing, strap ties, hold downs, etc. required for wood-sheathed and gypsum-wallboard-sheathed shear walls.
- Use double top plates on all walls, including non-load-bearing walls, with all splices and corners lapped. All "T" intersections do not top top plate of intersecting wall cutting the top plate of the continuous wall, rather use a metal tie plate as described in the exception to Section 2303.2.1 of the IRC.
- Unless otherwise noted on plan or detail, anchor wall plates to foundations and/or supporting structure using Simpson Strong-Tie Titan HD Heavy Duty Screw Anchors, 5/8" diameter with minimum 5" embedment. Space anchors at 48" o.c. for load-bearing and non-load-bearing walls. Reduce spacing to 24" o.c. for all shear walls.
- Coordinate final floor and roof framing including joist or truss layout & truss member configuration with Mechanical, Electrical, & Plumbing (MEP) drawings. Obtain additional MEP information as needed for complete coordination. Keep all mechanical chases free of framing. Do not locate joists or trusses at parallel plumbing walls.
- Always bear floor and roof joists or trusses on available interior and exterior bearing walls. Do not clear-span framing disengaging an available bearing wall where such a bearing wall is identified.
- Where floor trusses are used, use a minimum of (2) 4x2 vertical members in floor trusses at all bearings unless noted otherwise. One of these verticals may be under a ribbon board at the end of the truss where ribbon boards are allowed. Do not allow for, nor use ribbon boards at the ends of trusses where solid, continuous full-height blocking or continuous wood-sheathed knee walls are indicated to be used. Where ribbon boards are used with floor trusses they are to be 2x6 minimum.
- Design roof joists or trusses to support the weight of snow drifting where it applies, as well as rooftop mechanical units, exhaust fans, access hatches, etc. Confirm weights & locations before final design and show the loads for these units/features on the sealed drawings. The Contractor shall ensure the units are installed at their design locations.
- Where framing supported by a joist or truss can cause uplift on that joist or truss (such as at cantilevered balcony framing) the designer shall consider a load case that maximizes the uplift load in combination with no live load applied to the joist or truss supporting the uplift.
- All exposed framing to be pressure preservative treated wood (PPT) as described in the Specifications. All PPT wood to be kiln dried after treatment (KDAT). Hardware used with PPT wood to be hot-dip galvanized or stainless steel.
- All hardware to be by Simpson Strong-Tie or approved equal. Where hardware is not specifically designated, submit proposed hardware for approval. Where more than one type of fastener or fastener pattern is allowed by the hardware manufacturer, hardware fasteners are to be of the type, size, and quantity to maximize the load capacity of the hardware in the specific application shown on these plans, unless noted otherwise.
- Where a wood-framed wall backs up a non-structural masonry veneer, ties must be fastened to the wood framing members using screws meeting the requirements of the tie manufacturer. Where the tie manufacturer allows the use of nails, ring shank nails must be used. Smooth shank nails may never be used to attach masonry ties to wood framing.
- Reference the Architectural Plans for layout of all walls, openings, wall types, etc. Verify all dimensions prior to design of wall panels & immediately notify the Architect and Engineer of any discrepancies.
- Where a Specialty Structural Engineer designs floor and/or roof framing (such as trusses or joists), the floor and/or roof designer shall provide the Wall Panel Designer the loads/reactions and locations of all girder or beam bearing points. The Wall Panel Designer shall specify and the Wall Panel Manufacturer shall install sufficient columns/studs to support all such loads from the girder or beam bearing location down to the supporting foundation or podium framing. The Contractor shall ensure the presence of such columns/studs. Similarly, where walls are field-framed, the Framing Contractor shall install the columns/studs for support of girders and beams. As a minimum, the number of studs shown on the plans shall be used, with a minimum of (2) 2x6 or (3) 2x4 studs.
- At bearing walls, blocking must be added in the floor system to create continuity of all shear wall chord studs, posts and columns, jacking studs at headers, etc. Such blocking shall be part of the sheathed shear blocking panels, or knee walls where they are used. Where there are wood walls below, these studs, columns, posts, etc. must be present in these walls as well creating a continuous load path to structural steel, the foundation, or other identified adequate support.
- Where decks or balconies are wood-framed, if the raling relies on a connection to the wood balcony beams or rim joists for stability and load resistance, then the railing designer shall check torsion and other effects on the edge beams or joists and their connections.

FRAMING PLAN NOTES

- REF. S-400 FOR STRUCTURAL NOTES, DESIGN DATA, SCHEDULES & LEGENDS.
 - REF. THE S-410 SERIES FOR TYPICAL FRAMING AND MASONRY DETAILS.
 - ALL CONTRACTORS ARE REQUIRED TO COORDINATE THEIR WORK WITH ALL DISCIPLINES TO AVOID CONFLICTS. THE MECHANICAL, ELECTRICAL, AND PLUMBING ASPECTS ARE NOT IN THE SCOPE OF THESE DRAWINGS. THEREFORE, ALL REQUIRED MATERIALS AND WORK MAY NOT BE INDICATED.
 - ALL ELEVATIONS ARE REFERENCED FROM THE FIRST FLOOR FIN. FLOOR ELEVATION +0'-0". COORD. USGS ELEVATION WITH CIVIL DWGS.
 - SEE FOUNDATION PLANS FOR SIZES OF STEEL COLUMNS SUPPORTED ON FOUNDATIONS.
 - INSTALL CONTINUOUS ANGLES AT ALL PERIMETER ROOF EDGES. SEE DET. 208-410 FOR ATTACHMENT TO BEAM AND FOR ALL CONDITIONS NOT SPECIFICALLY DEFINED IN FRAMING SECTIONS.
 - ALL WALLS SHALL BE LAD OUT FROM THE ARCHITECTURAL DRAWINGS.
 - REF. ARCH. DRAWINGS. FOR ALL DIMENSIONS NOT SHOWN, CONTRACTOR SHALL VERIFY ALL DIMENSIONS PRIOR TO CONSTRUCTION AND IMMEDIATELY NOTIFY ARCHITECT/ENGINEER OF ANY DISCREPANCIES.
 - COORDINATE EXACT SIZE & LOCATION OF ANY MECHANICAL OPENINGS IN FLOOR SLAB, ROOF DECK, OR WALLS WITH THE MEP CONTRACTOR(S). LOCATION & SIZE OF ALL DUCT OPENINGS, GRILLES, ETC. SHALL BE VERIFIED PRIOR TO CONSTRUCTION.
 - ALL ELEVATIONS SHOWN ON PLAN INDICATE TOP OF STEEL BEAM UNLESS NOTED OTHERWISE.
 - PROVIDE FRAMES AT ALL ROOF DRAINS, ROOF HATCHES & OTHER ROOF OPENINGS PER TYPICAL DETAILS ON S-410, COORD. EXACT NUMBER, LOCATIONS & DIMENSIONS WITH THE APPROPRIATE CONTRACTORS & THE ARCH. & MEP DWGS.
 - PROVIDE CMU REINFORCING AS NOTED ON PLANS. IF NOT SHOWN ON PLANS OR DETAILS, MINIMUM CMU WALL REINFORCING TO BE #4 VERTS @ 48" O.C. PROVIDE OPEN-CORE BOND BEAMS AT TOPS OF WALLS. AT CHANGES IN CMU THICKNESS, AND WHERE INDICATED ON PLANS & SECTIONS 10" O.C. MAX VERTICAL SPACING. PROVIDE 1/2 OF INTERRUPTED VERTICALS AT JAMBS OF OPENINGS AND PROVIDE ADDITIONAL VERTS. AT ENDS OF WALLS.
 - ALL MASONRY BOND BEAMS, OTHER THAN BOND BEAM LINTELS OVER OPENINGS, SHALL BE "OPEN-CORE" BOND BEAMS TO ALLOW VERTICAL REINFORCING TO PASS THROUGH, UNLESS NOTED OTHERWISE.
 - REF. ARCH. DWGS. FOR MASONRY CONTROL & EXPANSION JOINT LOCATIONS.
 - ALL HORIZONTAL AND DIAGONAL BRIDGING FOR STEEL JOISTS SHALL BE DESIGNED, LOCATED & PROVIDED BY THE JOIST SUPPLIER PER SA SPECIFICATIONS.
- PLAN LEGEND:
- F.F. DENOTES FIN. FLOOR
 - T/X DENOTES TOP OF STEEL SLAB, ETC.
 - B/X DENOTES BOTTOM OF LINTEL, ETC.
 - E.O.D. DENOTES EDGE OF DECK, MEASURED FROM BEAM C.L. (IF EOD) NOTE: PERIMETER ROOF ANGLEMENT PL. NOT REQUIRED
 - E.O.L. DENOTES EDGE OF ANGLE MEASURED FROM BEAM C.L. SEE TYPICAL DETAIL BS-410
 - RS-1 DENOTES 1 1/2" 20 GA. GALVANIZED WIDE RIB STEEL ROOF DECK. REF. DETAIL 1/5410.
 - RS-4 DENOTES 4" 20 GA. TORX 44 ACOUSTIC ROOF DECK BY EPIC METALS GALVANIZED AND PRIME PAINTED W/ EPIC'S NATACOT SYSTEM. DECK. REF. DETAIL 2/5410.
23. WIDE-FLANGE BEAM & GIRDER NOTATION:
- REF. THE STEEL CONNECTION NOTES ON S001 FOR DESIGN OF CONNECTIONS AT BEAMS & GIRDERS WITH NO REACTION SHOWN. THE MIN. SHEAR CONNECTION DESIGN LOAD SHALL BE 15 KIPS.

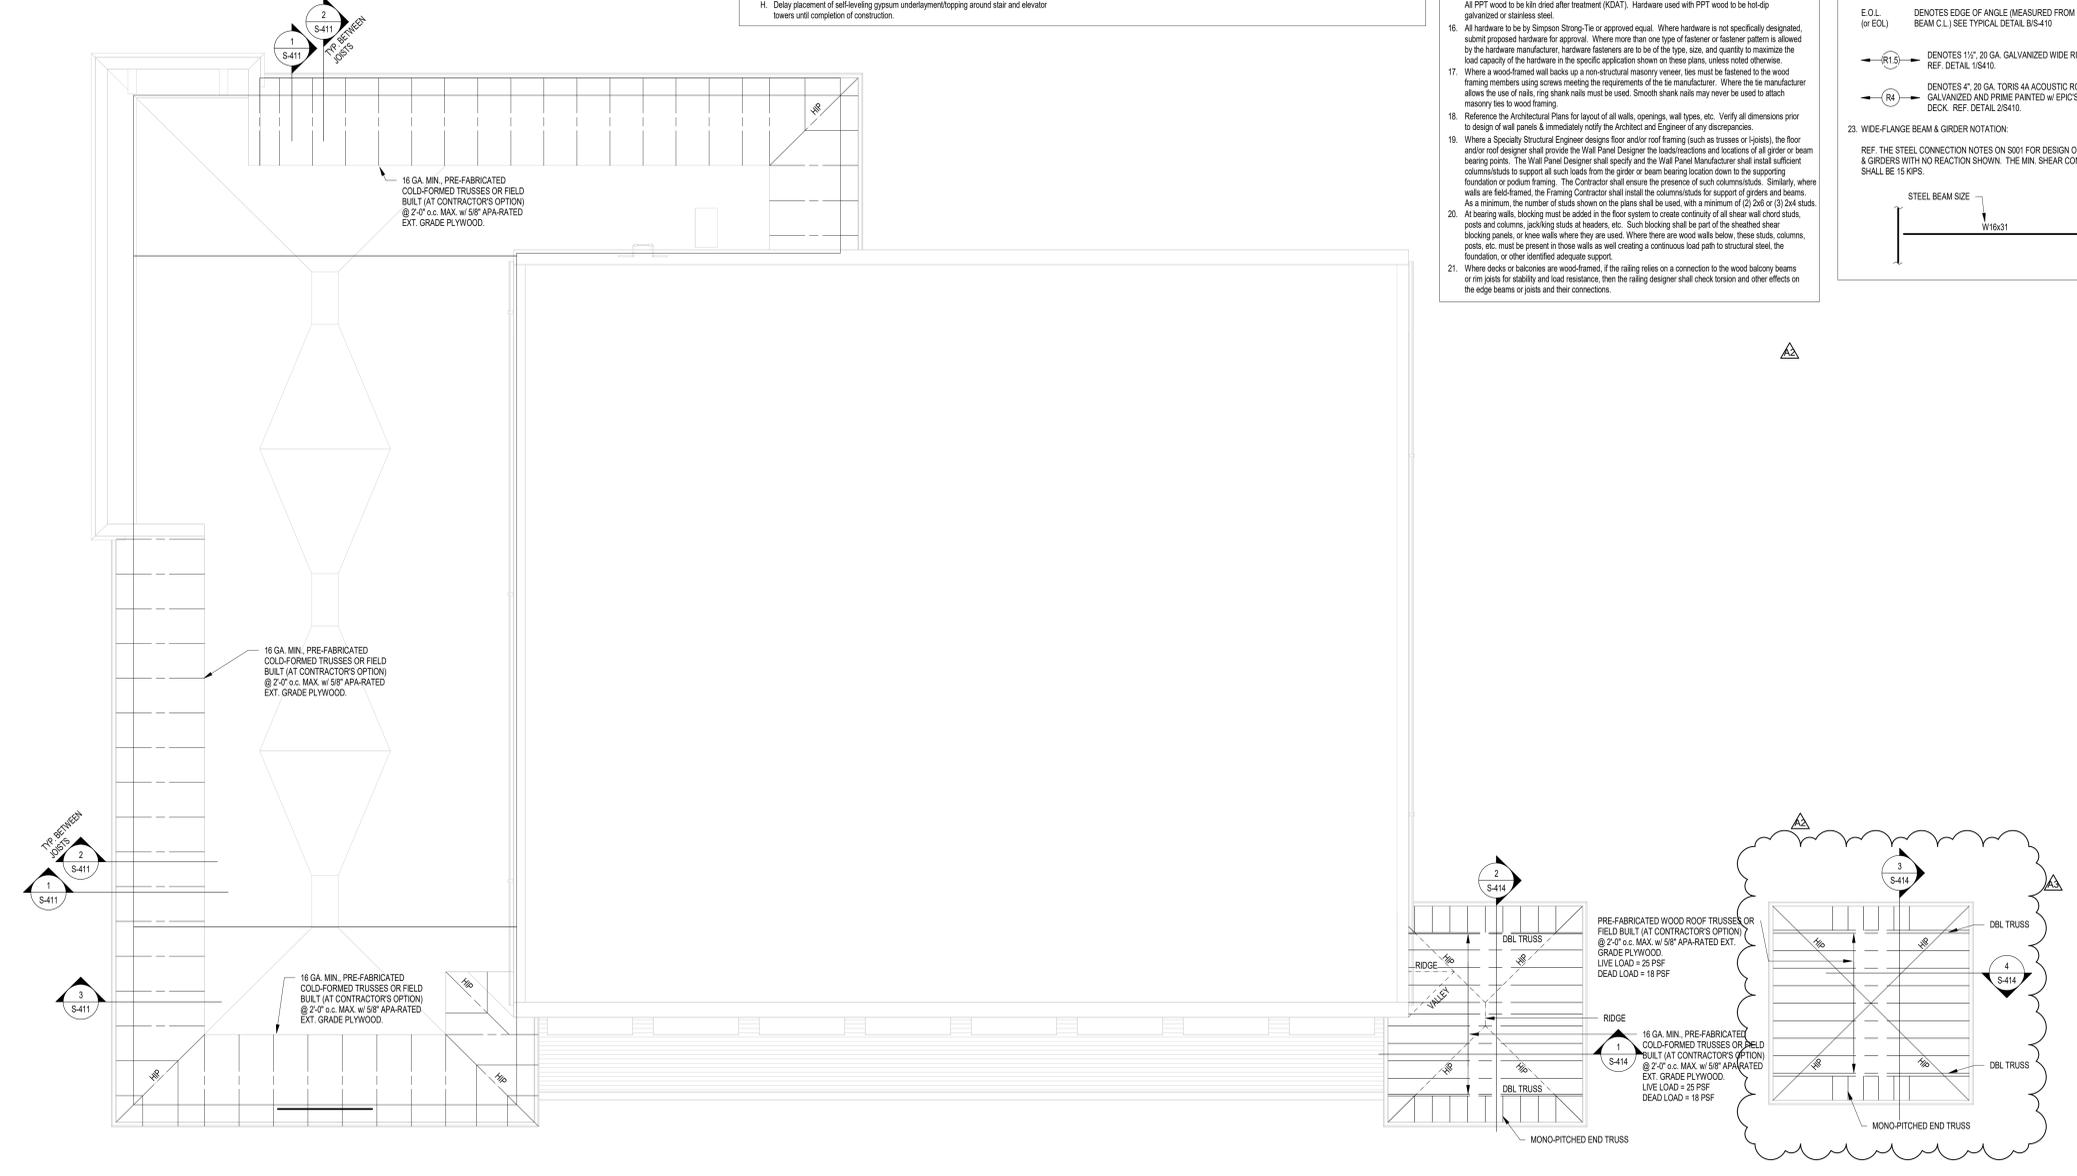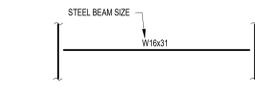

1 MANSARD ROOF FRAMING 1/8" = 1'-0"




Project No. 2021-178.RVI
 Project Date 12.05.2022
 Produced JMS RMD



These Drawings and Specifications, and all copies thereof are and shall remain the property and copyright of the Architect. They shall be used only with respect to this Project and are not to be used on any other Project or Work without prior written permission from the Architect.

#	Revision	Date
A2	ADDENDUM #2	01/12/2023
A3	ADDENDUM #3	1/31/2023

5640 N Illinois St
 Indianapolis, IN 46208

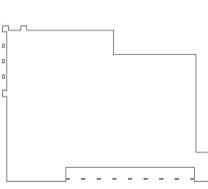

KEY PLAN

The Riviera Club


THE RIVIERA CLUB
 EST. 1933




Aquatics Center

MANSARD FRAMING PLAN

SF1AM

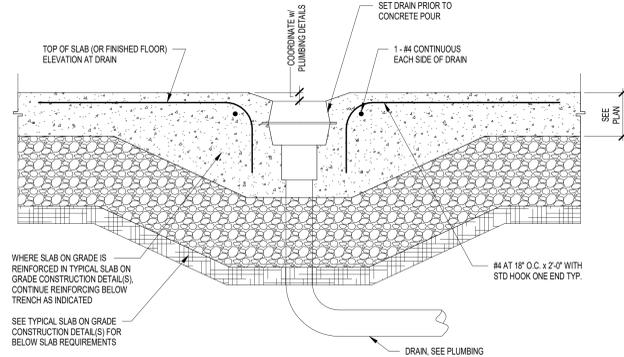


TYPICAL FLOOR TRENCH DRAIN

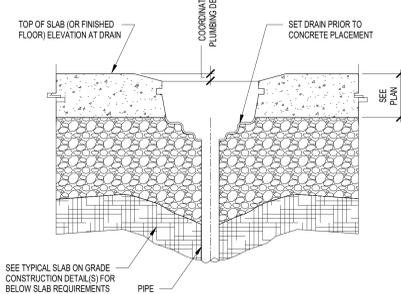


TYPICAL FLOOR DRAIN


11 TYPICAL FLOOR AND TRENCH DRAIN 3/4" = 1'-0"

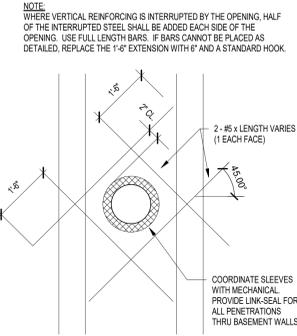


10 C.I.P. WALL ROUND OPENING 3/4" = 1'-0"

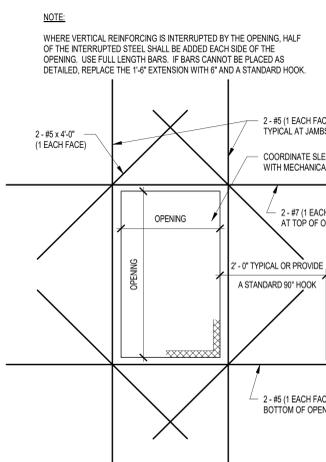


9 C.I.P. WALL RECTANGULAR OPENING 3/4" = 1'-0"

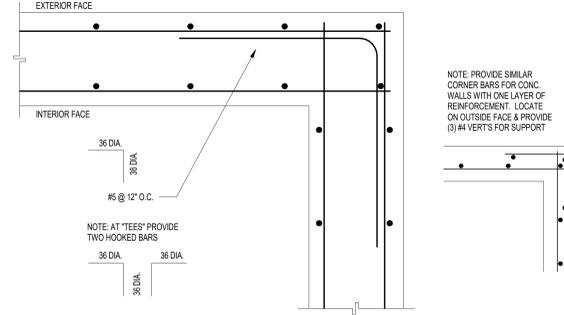


8 C.I.P. WALL CORNER REINFORCING 1" = 1'-0"

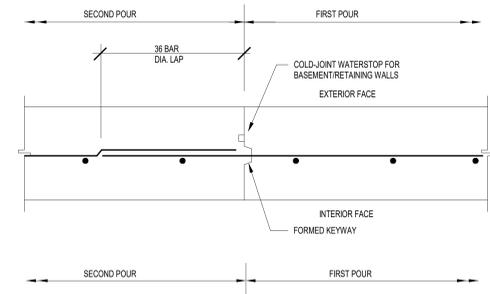


7 C.I.P. WALL CONSTRUCTION JOINTS 1" = 1'-0"

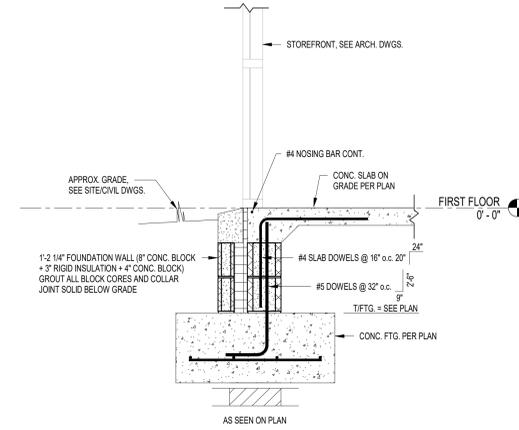


6 FOUNDATION SECTION 3/4" = 1'-0"

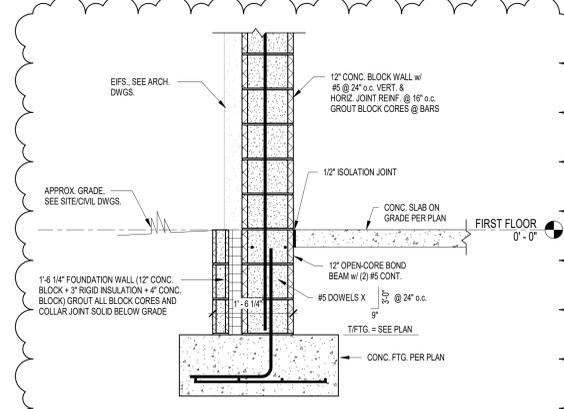


5 FOUNDATION SECTION 3/4" = 1'-0"

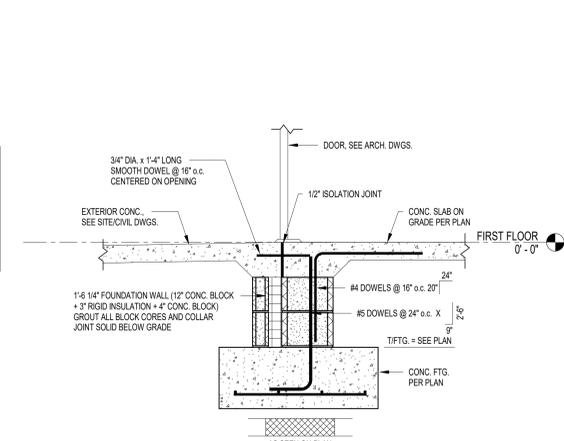


4 FOUNDATION SECTION 3/4" = 1'-0"

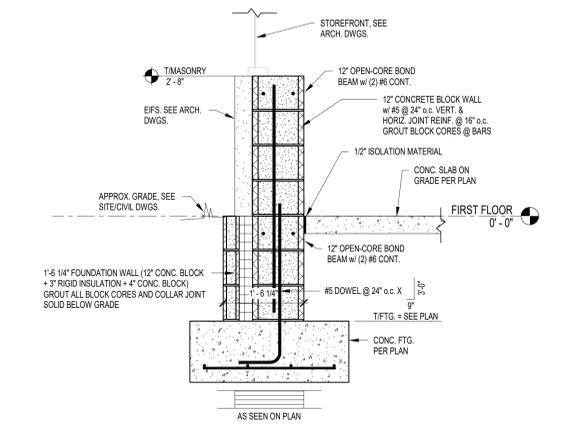

3 FOUNDATION SECTION 3/4" = 1'-0"

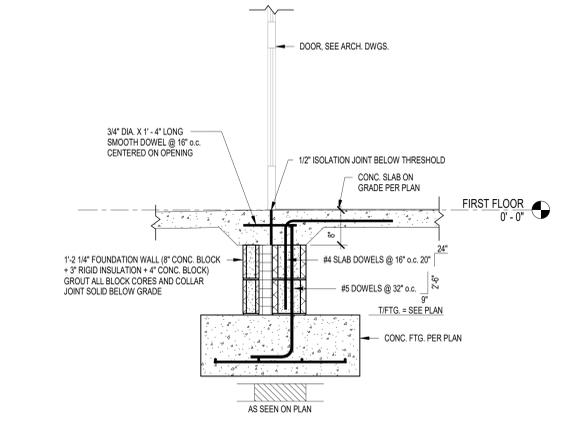

2 FOUNDATION SECTION 3/4" = 1'-0"

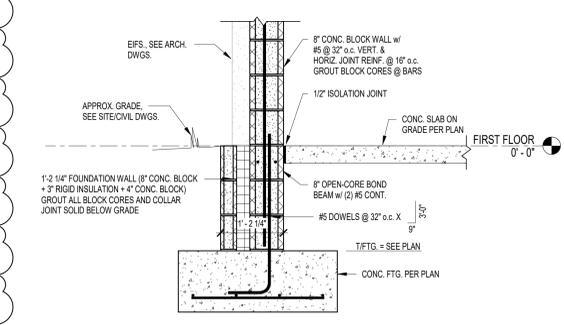


1 FOUNDATION SECTION 3/4" = 1'-0"



These Drawings and Specifications, and all copies thereof are and shall remain the property and copyright of the Architect. They shall be used only with respect to this Project and are not to be used on any other Project or Work without prior written permission from the Architect.

#	Revision	Date
A3	ADDENDUM #3	1/31/2023

5640 N Illinois St
 Indianapolis, IN 46208

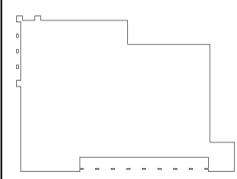

KEY PLAN

The Riviera Club



Aquatics Center

FOUNDATION SECTIONS & DETAILS

S-401

8442 CONSTRUCTION SERVICES & DESIGN
 10000 N. STATE ST. SUITE 1000
 INDIANAPOLIS, IN 46240
 317.552.1222 FAX
 317.552.1222

6

5

4

3

2

1


E

D


C

B


A

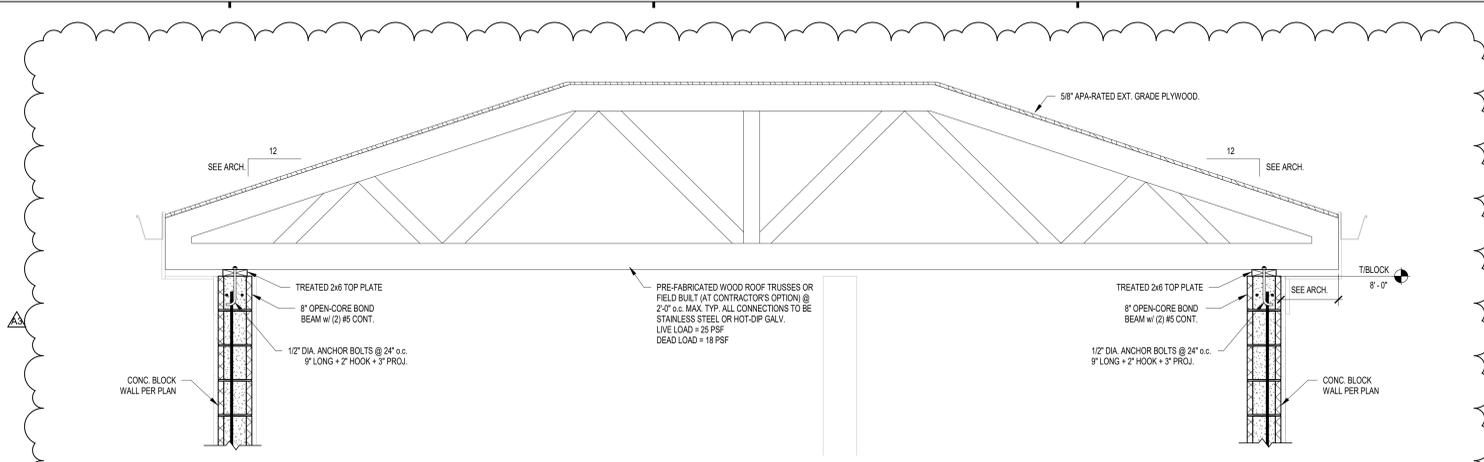


4 FRAMING SECTION
3/4" = 1'-0"

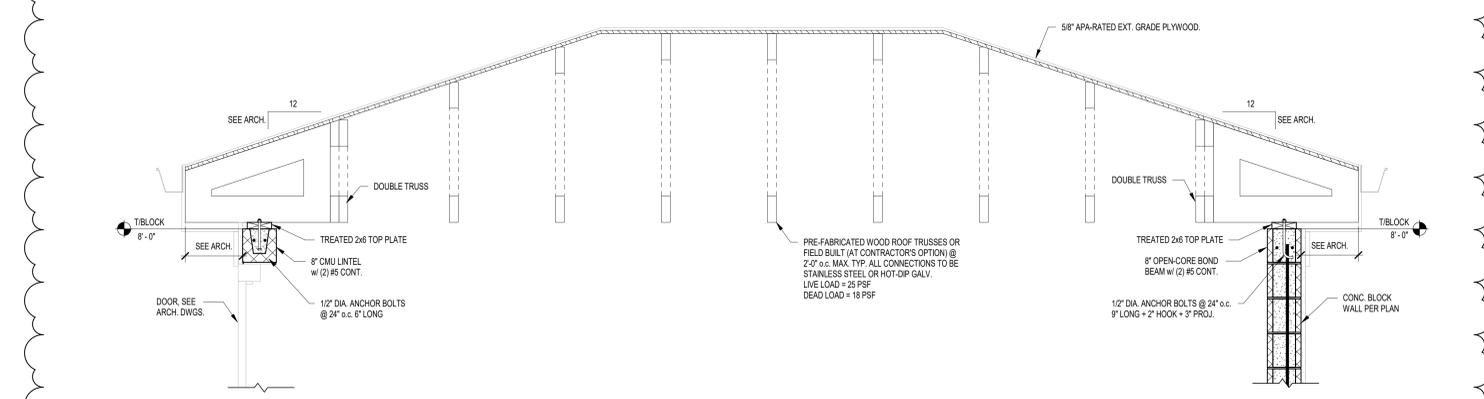

3 FRAMING SECTION
3/4" = 1'-0"

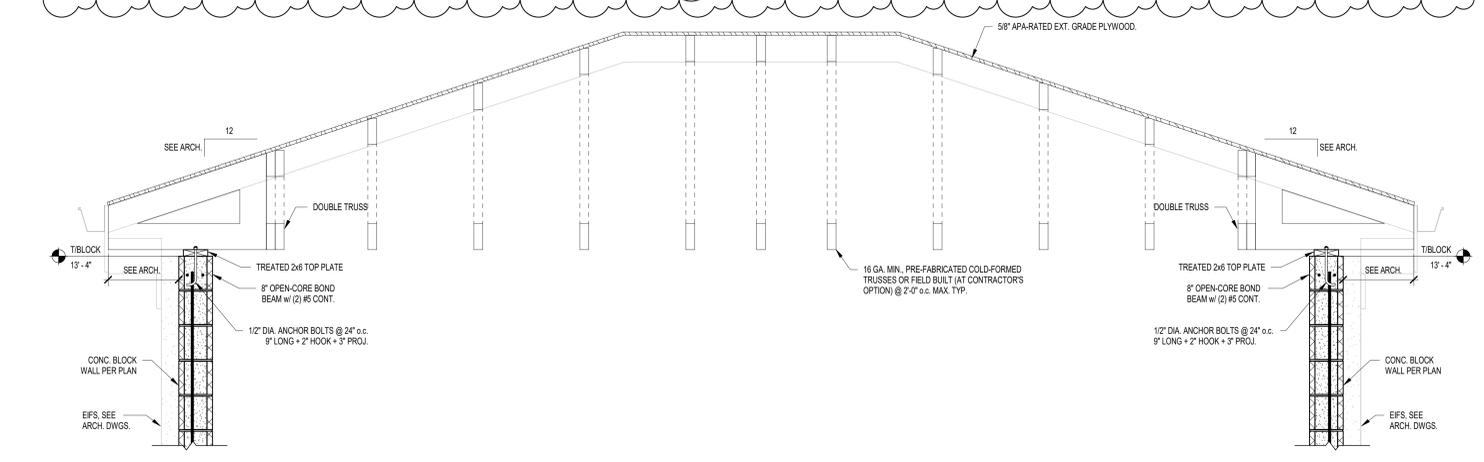

2 FRAMING SECTION
3/4" = 1'-0"

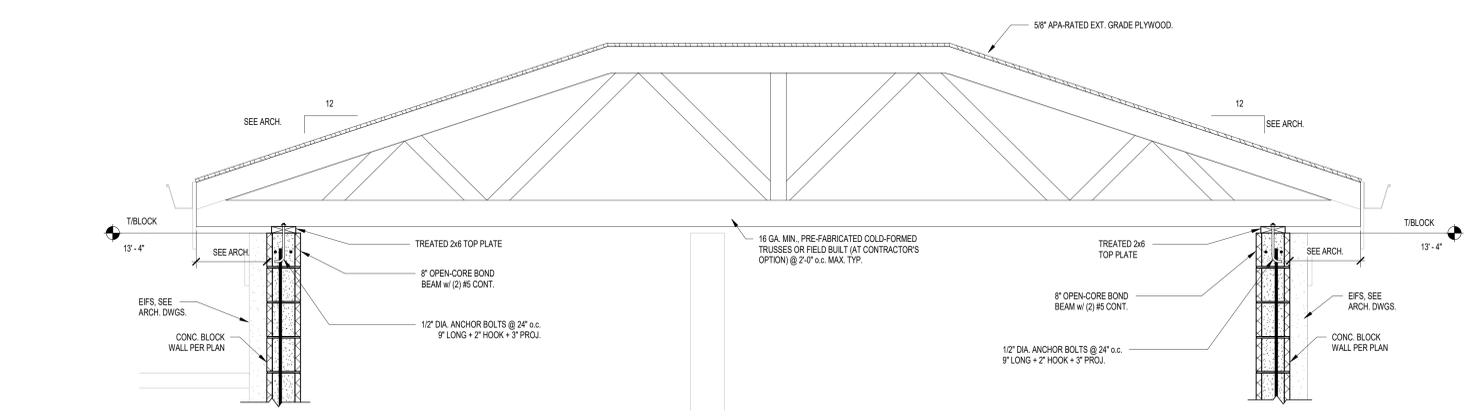

1 FRAMING SECTION
3/4" = 1'-0"




Project No. 2021-178.RV1
 Project Date 12.05.2022
 Produced JMS RMD



These Drawings and Specifications, and all copies thereof are and shall remain the property and copyright of the Architect. They shall be used only with respect to this Project and are not to be used on any other Project or Work without prior written permission from the Architect.

#	Revision	Date
A2	ADDENDUM #2	01/12/2023
A3	ADDENDUM #3	1/31/2023

5640 N Illinois St
 Indianapolis, IN 46208

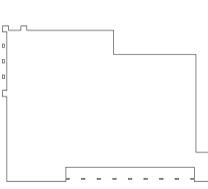

KEY PLAN

The Riviera Club

THE RIVIERA CLUB
 EST. 1933



Aquatics Center

FRAMING SECTIONS & DETAILS

S-414

1. ALL DIMENSIONS UNLESS OTHERWISE NOTED.
 2. REFER TO THE ARCHITECT'S GENERAL NOTES.
 3. ALL MATERIALS SHALL BE AS SHOWN OR APPROVED BY THE ARCHITECT.
 4. ALL WORK SHALL BE IN ACCORDANCE WITH THE LATEST EDITIONS OF THE IBC AND ALL APPLICABLE CODES.
 5. THE CONTRACTOR SHALL BE RESPONSIBLE FOR OBTAINING ALL NECESSARY PERMITS.
 6. THE CONTRACTOR SHALL MAINTAIN ACCESS TO ALL ADJACENT PROPERTIES AT ALL TIMES.
 7. ALL UTILITIES SHALL BE PROTECTED AND MARKED PRIOR TO ANY EXCAVATION.
 8. THE CONTRACTOR SHALL BE RESPONSIBLE FOR THE PROTECTION OF ALL EXISTING UTILITIES.
 9. ALL MATERIALS SHALL BE STORED PROPERLY AND PROTECTED FROM THE ELEMENTS.
 10. THE CONTRACTOR SHALL MAINTAIN A NEAT AND ORDERLY WORK SITE AT ALL TIMES.
 11. ALL WASTE SHALL BE PROPERLY DISPOSED OF AT ALL TIMES.
 12. THE CONTRACTOR SHALL BE RESPONSIBLE FOR THE PROTECTION OF ALL ADJACENT PROPERTIES.
 13. ALL WORK SHALL BE COMPLETED WITHIN THE SPECIFIED TIME FRAME.
 14. THE CONTRACTOR SHALL BE RESPONSIBLE FOR THE PROTECTION OF ALL ADJACENT PROPERTIES.
 15. ALL WORK SHALL BE COMPLETED WITHIN THE SPECIFIED TIME FRAME.

6

5

4

3

2

1

General Roof Plan Notes

- A. Where utilized, tapered insulation shall be installed to achieve positive drainage with a minimum resultant slope of 1/4" per foot, unless noted otherwise.
- B. Low slope roof areas shall have a minimum of 4" rigid insulation over metal roof deck. Saddles, crickets, and slope portions of flat roof deck shall be formed by tapered insulation. Areas where tapered insulation is anticipated have been indicated, but shall not be considered all inclusive. It is Contractor's responsibility to provide sloped surfaces to achieve proper drainage.
- C. Roof penetrations and equipment shown shall not be considered all inclusive. Coordinate with Mechanical, Plumbing and Electrical Documents to confirm penetrations and equipment locations. Flash all roof penetrations in accordance with roofing manufacturer's recommendations. Provide crickets to allow for proper drainage around units.
- D. Roof walkway pads or blocks shall be installed in accordance with roofing manufacturer's recommendation where indicated and around entire perimeter of rooftop equipment.

ROOF PLAN NOTES

#	Note
1	077100 - 8" METAL GUTTER
2	072419 - EIFS CORNICE
3	077100 - MANUFACTURED METAL COPING
4	077100 - ALUMINUM DOWNSPOUT, 4X6
5	107313 - AWNING
6	PERGOLA
7	077200 - ROOF ACCESS HATCH, 30"x54", WITH SAFETY RAILING, COORDINATE OPENING WITH S-SERIES DRAWINGS
8	ROOF AND OVERFLOW DRAIN, REFER TO P-SERIES DRAWINGS
9	ROOFTOP EQUIPMENT, REFER TO MPET-SERIES DRAWINGS
10	055000 - ROOF ACCESS LADDER, PROVIDE ROOF WALKWAY PADS AT TOP & BOTTOM

General Plan Notes

- A. All dimensions shown are to face of stud or masonry, unless noted otherwise. Dimensions designated as "CLR" or "clear" indicate a clear dimension from face to face of finish. Dimensions of exterior walls are to outside edge of foundation.
- B. All openings for Mechanical, Plumbing, Fire Protection and Electrical shall be fire stopped at each floor penetration.
- C. Provide bracing and blocking as required in walls supporting casework, tackboards, markerboards, and restroom accessories.
- D. All door frames are located 4" from adjacent wall, unless noted otherwise.
- E. All exposed outside corners of CMU shall be bullnosed.
- F. Seal all joints between dissimilar materials.
- G. All gypsum wallboard is 5/8" Type "X", unless noted otherwise.
- H. Where new floors meet existing floors, a smooth, straight, and flush transition shall be constructed. Verify in field existing floor elevations and conditions where a new floor shall be constructed adjacent. Trim and patch existing floor as required to achieve desired transition.
- I. All exterior windows are Type "XXX", unless noted otherwise.
- J. All interior walls are Type "M8-D", unless noted otherwise.
- K. Refer to C-Series drawings for base elevation height (0'-0") relative to USGS (United States Geological Survey) data.
- L. Hatching within walls shown in plans and sections indicates new construction.

FLOOR PLAN NOTES

#	Note
1	OWNER PROVIDED WASHER & DRYER
2	ARCHED INSET IN EIFS, 1"
3	077100 - ALUMINUM DOWNSPOUT, 4X6. REFER TO C-SERIES DWGS. FOR BOOT CONNECTION
4	PLASTIC LOCKERS, REFER TO SHEET A-401
5	FIREMAN'S EMERGENCY KEY BOX
6	087100 - ADA ACTUATOR, PEDESTAL MOUNTED, COORDINATE LOCATION W/ARCHITECT
7	087100 - ADA ACTUATOR, WALL MOUNTED, COORDINATE LOCATION W/ARCHITECT
8	REFER TO AQ-SERIES DRAWINGS FOR POOL TANK AND EQUIPMENT INFORMATION
9	055000 - ROOF ACCESS LADDER
10	RECEPTION DESK, REFER TO I-SERIES DRAWINGS
11	055213 - RAILING TYPE A, REFER TO SHEET A-400
12	STAINLESS STEEL LADDER
13	SLOPED FLOOR SLAB, 1/8" PER 1'-0"
14	CENTER DOOR OPENING ON ELEVATION
15	233713 - HEAVY DUTY LINEAR BAR GRILLE MANDREL
16	PROVIDE EXPOY SEALER ON ALL SURFACES INSIDE THE SURGE TANK AND PUMP PIT
17	FLOOR HATCH AND LADDER, REFER TO AQ-SERIES DRAWINGS
18	REFER TO ELEVATIONS AND SECTIONS FOR UPPER WINDOWS (W3)
19	104413 - FIRE EXTINGUISHER CABINET




Project No. 2021-178.RVI
 Project Date 12.05.2022
 Produced BMF



These Drawings and Specifications, and all copies thereof are and shall remain the property and copyright of the Architect. They shall be used only with respect to this Project and are not to be used on any other Project or Work without prior written permission from the Architect.

#	Revision	Date
A2	ADDENDUM 2	01.12.2023
A3	ADDENDUM 3	01.31.2023

5640 N Illinois St
 Indianapolis, IN 46208

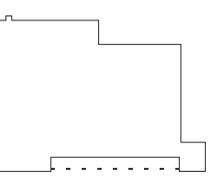

KEY PLAN


The Riviera Club




Aquatics Center

OUTDOOR EQUIPMENT BUILDING (ALT)


AF1B1

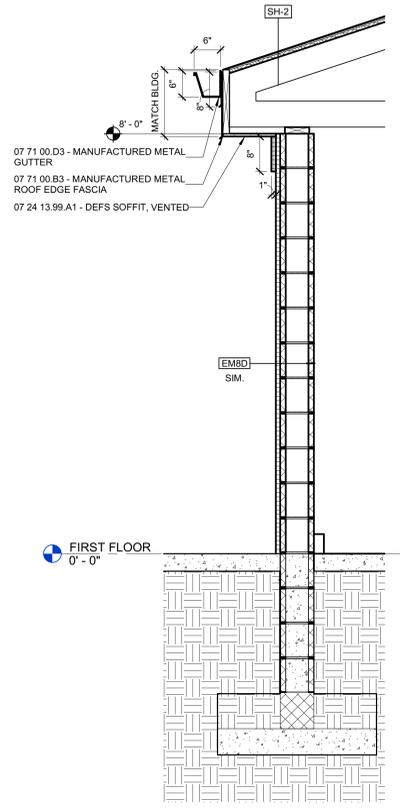


3A WALL SECTION
 3/4" = 1'-0"

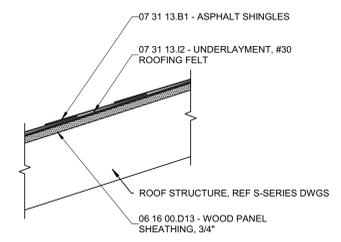

2B ROOF TYPE - SH-2
 1 1/2" = 1'-0"

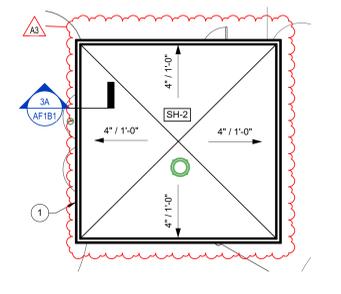

2A OVERALL ROOF PLAN - EQUIPMENT
 1/8" = 1'-0"

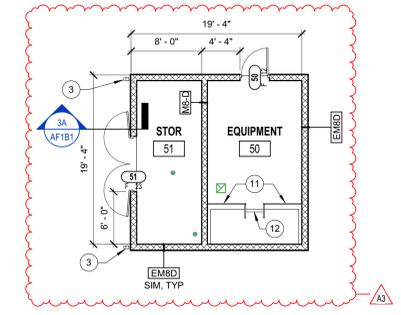

1A FIRST FLOOR PLAN - EQUIPMENT BUILDING
 1/8" = 1'-0"

ALL DIMENSIONS UNLESS OTHERWISE NOTED ARE TO FACE OF STUD OR MASONRY, UNLESS NOTED OTHERWISE. DIMENSIONS DESIGNATED AS "CLR" OR "CLEAR" INDICATE A CLEAR DIMENSION FROM FACE TO FACE OF FINISH. DIMENSIONS OF EXTERIOR WALLS ARE TO OUTSIDE EDGE OF FOUNDATION.

6 5 4 3 2 1

E
D
C
B
A

GENERAL NOTES

- A REFER TO SHEET M000 FOR GENERAL MECHANICAL NOTES, SYMBOLS AND ABBREVIATIONS.
- B REFER TO ARCHITECT'S REFLECTED CEILING PLAN FOR FINAL LOCATIONS OF AIR OUTLETS AND INLETS. ADJUST BRANCH DUCTWORK AS REQUIRED.
- C DUCT RUNOUTS TO TERMINAL UNITS SHALL BE TWO DIAMETERS LARGER THAN TERMINAL UNIT CONNECTION SIZE UNLESS NOTED OTHERWISE.
- D CONTRACTOR SHALL PROVIDE ALL BALANCE DAMPERS AS REQUIRED TO PROVIDE A COMPLETE AND BALANCED SYSTEM.
- E ALL DUCTWORK, DIFFUSERS AND GRILLES IN "WET AREAS" SHALL BE ALUMINUM CONSTRUCTION UNLESS NOTED OTHERWISE.
- F ALL HANGERS, SUPPORTS AND MISCELLANEOUS ACCESSORIES IN POOL BUILDING AND POOL CHEMICAL ROOMS SHALL HAVE A CHLORINE RESISTANT COATING FOR USE IN INDOOR POOLS.

SHEET KEYNOTES

- 1 WATER HEATER FLUE INTAKE.
- 2 MOUNT UNIT ON 12" ROOF CURB. COORDINATE EXACT LOCATION WITH STRUCTURAL DRAWINGS.
- 3 6" DIAMETER FLUE AND 6" DIAMETER INTAKE FROM POOL HEATER. TERMINATE INTAKE 1'-0" ABOVE ROOF WITH APPROVED INTAKE. TERMINATE FLUE AT 3'-0" ABOVE ROOF WITH APPROVED VENT CAP. COORDINATE WITH POOL HEATER MANUFACTURER FOR APPROVED TERMINATIONS. SEE AQUATIC SHEETS FOR MORE INFORMATION.



SCHMIDT ASSOCIATES
415 Massachusetts Avenue
Indianapolis, IN 46204
www.schmidt-arch.com

Project No. 2021-178.RV1
Project Date 12.05.2022
Produced CME CME



These Drawings and Specifications, and all copies thereof are and shall remain the property and copyright of the Architect. They shall be used only with respect to this Project and are not to be used on any other Project or Work without prior written permission from the Architect.

#	Revision	Date
	Addendum #2	01/12/2023
	Addendum #3	01/31/2023

5640 N Illinois St
Indianapolis, IN 46208


KEY PLAN 

The Riviera Club

Aquatics Center

ROOF MECHANICAL PLAN

M102

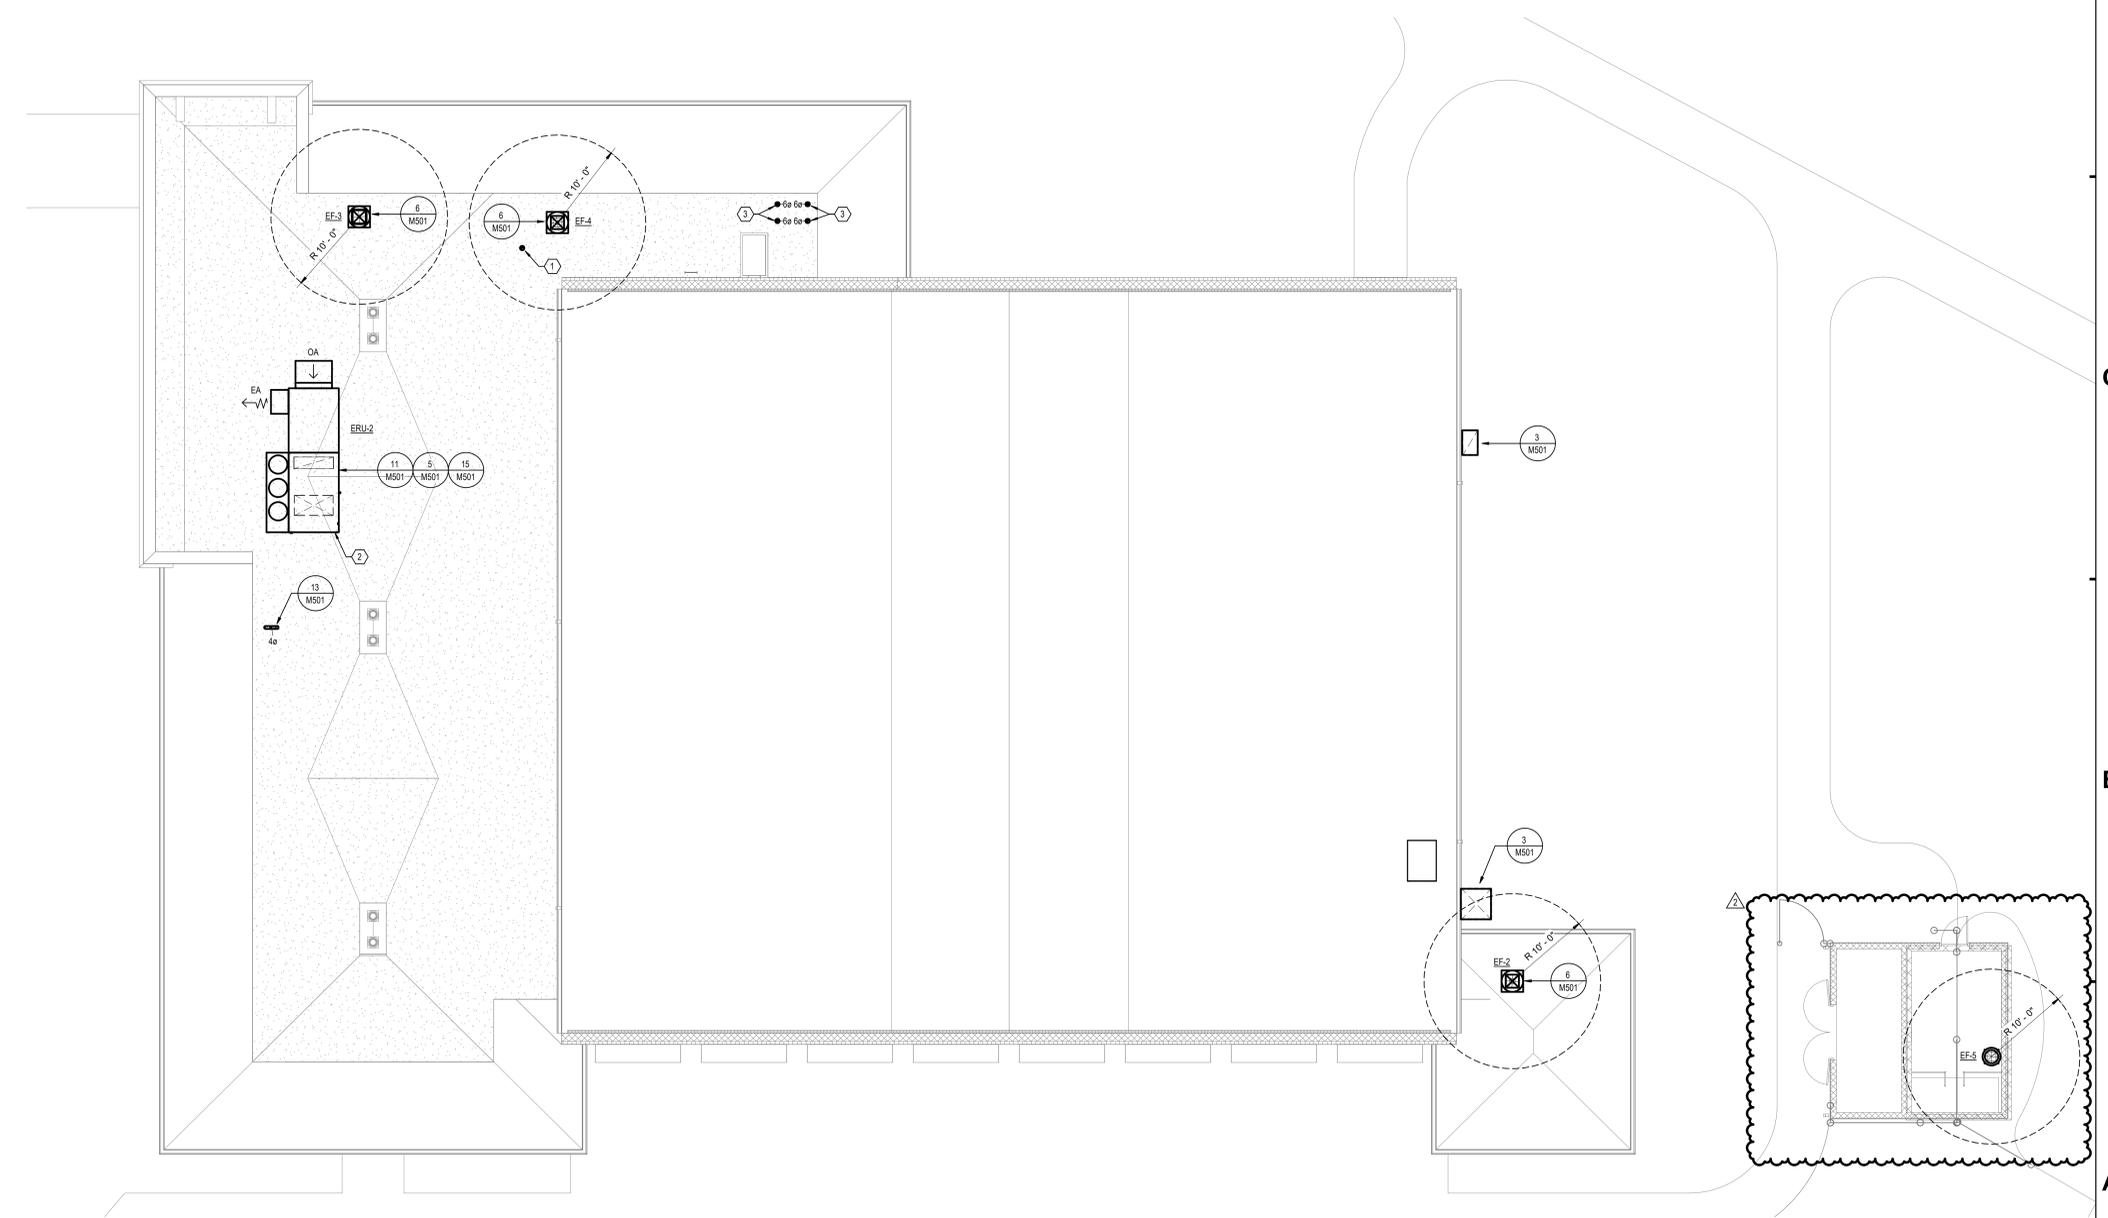

1 ROOF MECHANICAL PLAN
1/8" = 1'-0"

6 5 4 3 2 1

M102 - ROOF MECHANICAL PLAN
 2021-178.RV1 - THE RIVIERA CLUB AQUATICS CENTER
 12/05/2022 10:02 AM


E

D


C

B


A

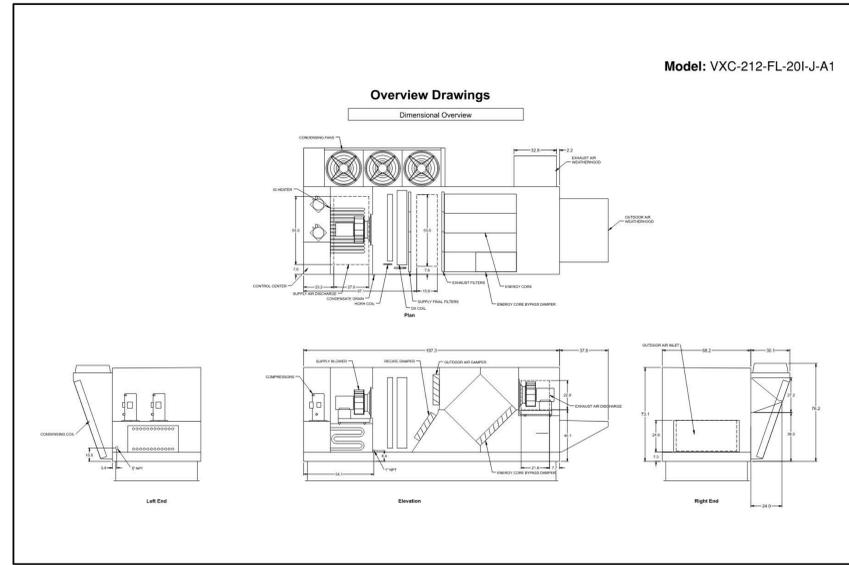


③ ERU-2 SECTION

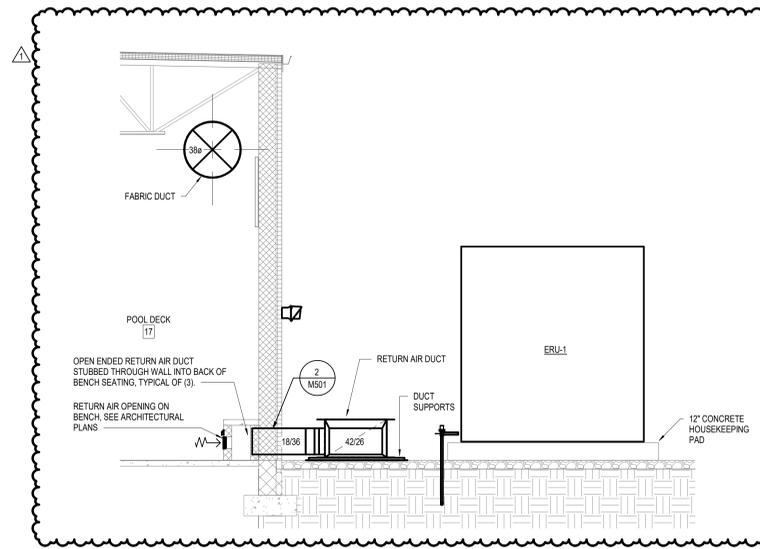

④ POOL BENCH LOW RETURN AIR SECTION

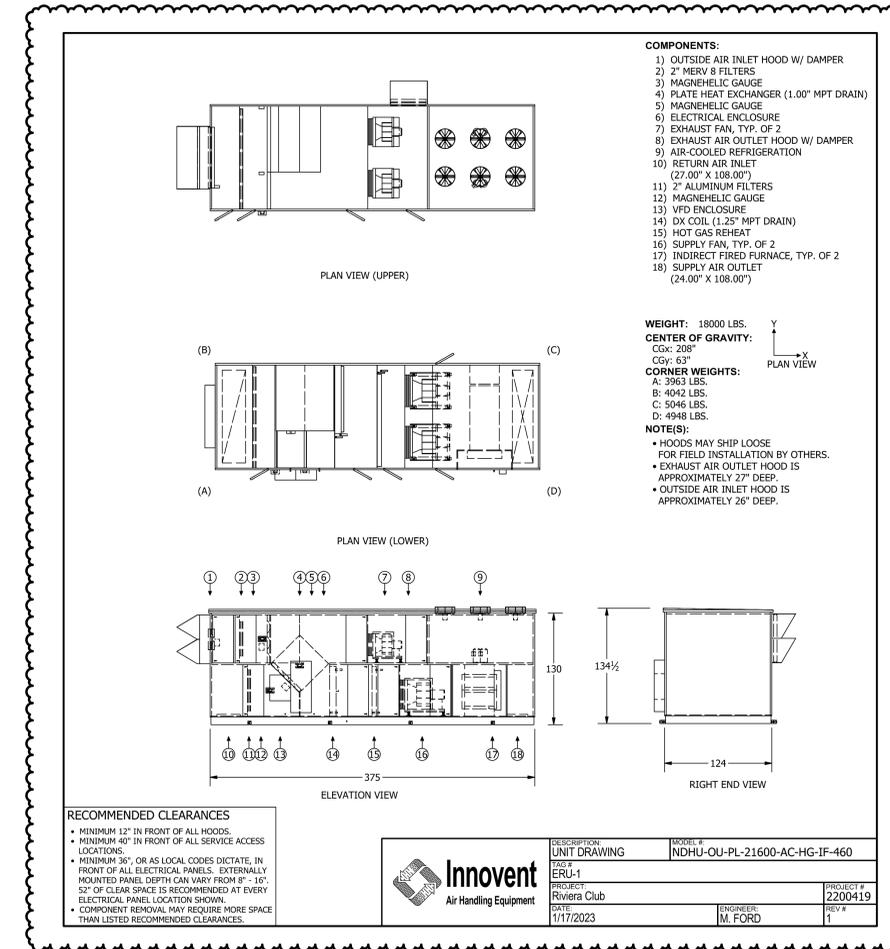

② ERU-1 SECTION

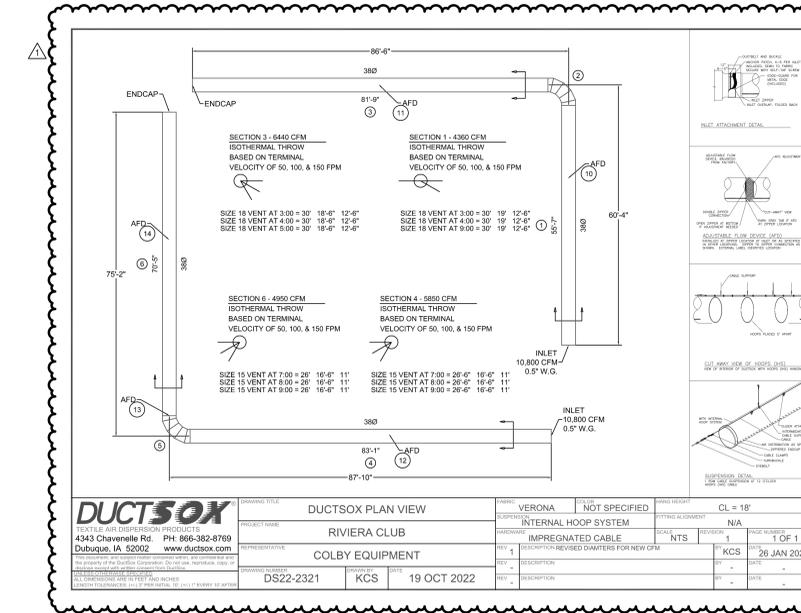

① FABRIC DUCT DETAILS



Project No. 2021-178.RV1
Project Date 12.05.2022
Produced CME CME



These Drawings and Specifications, and all copies thereof are and shall remain the property and copyright of the Architect. They shall be used only with respect to this Project and are not to be used on any other Project or Work without prior written permission from the Architect.

#	Revision	Date
1	Addendum #3	01/31/2023

5640 N Illinois St
Indianapolis, IN 46208

KEY PLAN

The Riviera Club

Aquatics Center

MECHANICAL SECTIONS

M301

6 5 4 3 2 1

GENERAL NOTES

- A REFER TO DRAWING P-000 FOR PLUMBING AND FIRE PROTECTION SYMBOLS AND ABBREVIATIONS.
- B REFER TO DRAWING P-500 SERIES FOR PLUMBING DETAILS.
- C REFER TO DRAWING P-600 SERIES FOR PLUMBING SCHEDULES.
- D ALL FLOOR DRAINS AND FLOOR CLEANOUTS TO BE FLUSH AND LEVEL WITH FINISHED FLOORS. CONTRACTOR IS RESPONSIBLE FOR ANY REWORK NECESSARY FOR IMPROPER INSTALLATION.
- E REFER TO THE "PLUMBING FIXTURE ROUGH-IN SCHEDULE" TO SIZE BRANCH LINES TO INDIVIDUAL PLUMBING FIXTURES.
- F INSTALL UNDERGROUND PVC DWV PIPING ACCORDING TO ASTM D 2321.
- G SLEEVE ALL PIPING PASSING THROUGH FOUNDATION WALLS AND BELOW FOOTINGS. SLEEVE SHALL BE TWO PIPE DIAMETERS LARGER THAN PIPE. SLEEVE SHALL EXTEND BEYOND THE ANGLE OF REPOSE.
- H AVOID ALL CONFLICTS BETWEEN PLUMBING SYSTEMS, AND UNDERGROUND CONDUIT, PIPING, STRUCTURAL MEMBERS, AND ANY OTHER OBSTRUCTIONS ENCOUNTERED. PIPING LAYOUTS ARE DIAGRAMMATIC AND SHOW SYSTEM INTENT. PIPING MAY REQUIRE ADDITIONAL OFFSETS, DROPS, FITTINGS ETC.

SHEET KEYNOTES

- 1 4" CW MAIN UP.
- 2 6" FIRE MAIN UP.
- 3 GAS SERVICE BY UTILITY COMPANY
- 4 2-1/2" G (2 PSI) FROM ABOVE.
- 5 1-1/4" G (2 PSI) UP.
- 6 2" G (2 PSI) UP.
- 7 1-1/2" CW FROM ABOVE.
- 8 1-1/2" CW MAKE-UP UP TO SERVE POOL EQUIPMENT.



Project No. 2021-178.RV1
 Project Date 12.05.2022
 Produced ABT ABT



These Drawings and Specifications, and all copies thereof are and shall remain the property and copyright of the Architect. They shall be used only with respect to this Project and are not to be used on any other Project or Work without prior written permission from the Architect.

#	Revision	Date
	Addendum #1	01/05/2023
	Addendum #2	01/12/2023
	Addendum #3	01/31/2023

5640 N Illinois St
 Indianapolis, IN 46208



KEY PLAN

The Riviera Club

Aquatics Center

FOUNDATION PLUMBING PLAN

P100

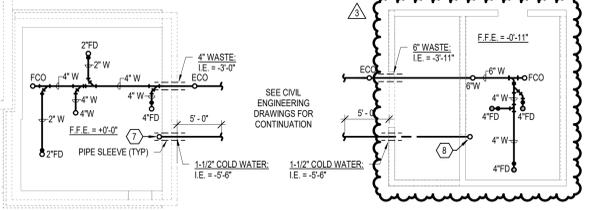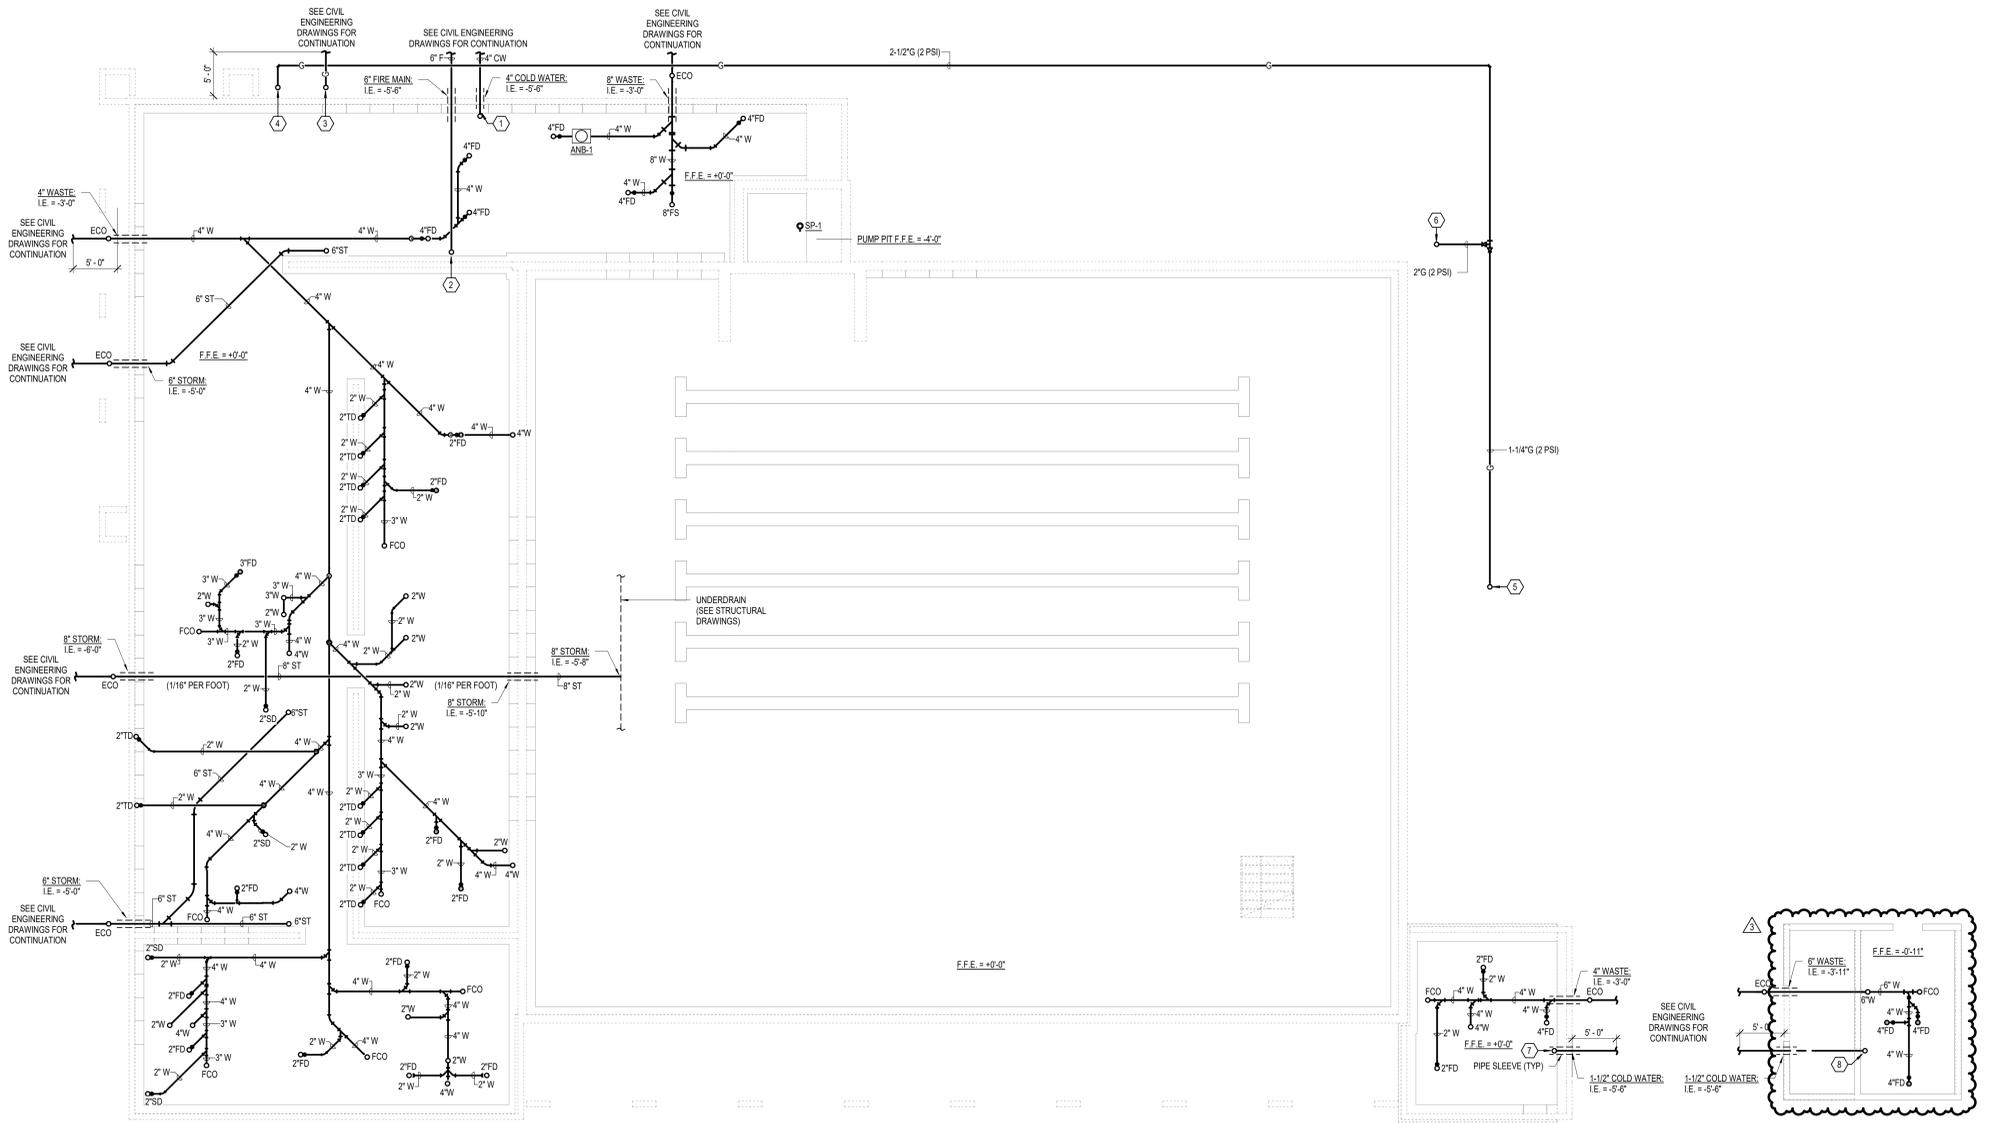


1 PLUMBING FOUNDATION PLAN
 1/8" = 1'-0"

6 5 4 3 2 1

E
D
C
B
A

PLUMBING FOUNDATION PLAN
 1/8" = 1'-0"
 12/20/22 10:48 AM

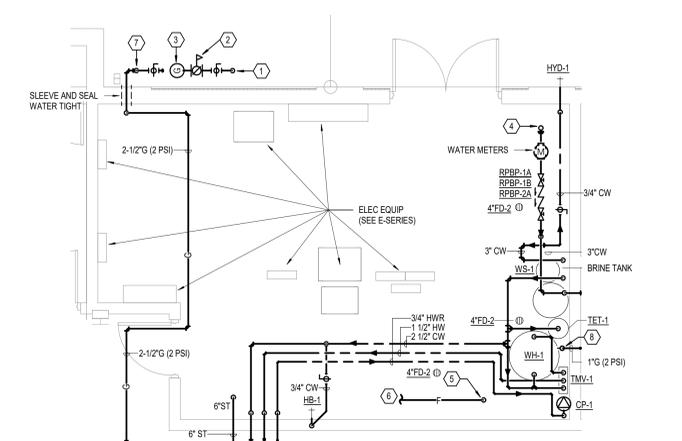

2 ENLARGED BUILDING MECH ROOM PLUMBING PLAN
1/4" = 1'-0"

GENERAL NOTES


- A REFER TO DRAWING P-000 FOR PLUMBING AND FIRE PROTECTION SYMBOLS AND ABBREVIATIONS.
- B REFER TO DRAWING P-500 SERIES FOR PLUMBING DETAILS.
- C REFER TO DRAWING P-600 SERIES FOR PLUMBING SCHEDULES.
- D ALL FLOOR DRAINS AND FLOOR CLEANOUTS TO BE FLUSH AND LEVEL WITH FINISHED FLOORS. CONTRACTOR IS RESPONSIBLE FOR ANY REWORK NECESSARY FOR PROPER INSTALLATION.
- E REFER TO THE "PLUMBING FIXTURE ROUGH-IN SCHEDULE" TO SIZE BRANCH LINES TO INDIVIDUAL PLUMBING FIXTURES.
- F LOCATE SHUT-OFF VALVES ABOVE ACCESSIBLE CEILING OR ACCESS PANELS IN CRY. CEILING.
- G INSTALL PIPING AS HIGH AS POSSIBLE. MAINTAIN CODE REQUIRED SLOPE ON ALL WASTE AND VENT PIPING.
- H AVOID ALL CONFLICTS BETWEEN PLUMBING SYSTEMS, AND CONDUIT, DUCT, EQUIPMENT, PIPING, STRUCTURAL MEMBERS, AND ANY OTHER OBSTRUCTIONS ENCOUNTERED. PIPING LAYOUTS ARE DIAGRAMMATIC AND SHOW INTENT. PIPING MAY REQUIRE ADDITIONAL OFFSETS, DROPS, FITTINGS, ETC.
- I PROVIDE SHUT-OFF, DIRT LEG AND UNION AT EACH NATURAL GAS CONNECTION TO GAS FIRED EQUIPMENT.
- J COORDINATE LOCATION OF NATURAL GAS CONNECTION WITH EQUIPMENT MANUFACTURER'S DATA.
- K PRIME AND PAINT GAS PIPING OUTSIDE BUILDING TO PREVENT RUSTING. APPLY TWO COATS OF RUST-INHIBITING PRIMER AND TWO COATS OF ENAMEL PAINT FORMULATED FOR EXTERIOR USE. COLOR AS SELECTED BY ARCHITECT.

SHEET KEYNOTES

- 1 GAS SERVICE LINE DOWN BELOW GRADE.
- 2 GAS SERVICE GAS PIPING TO GAS METER BY UTILITY.
- 3 GAS METER - SIZE FOR TOTAL CONNECTED LOAD: 6,280,000 BTUH INLET PRESSURE: 2 PSI OUTLET PRESSURE: 14" w.c.
- 4 2" CW DOWN IN CHASE WITH HEADER TO WATER HEATER.
- 5 6" FIRE RISER WITH SUPERVISED CONTROL VALVE, FLOW SWITCH, AND MAIN DRAIN.
- 6 TO SPRINKLER SYSTEM.
- 7 2-1/2" G (2 PSI) DOWN.
- 8 1" G (2 PSI) DOWN WITH SHUT-OFF AND GAS REGULATOR - SIZE FOR CAPACITY: 285,000 BTUH INLET PRESSURE: 2 PSI OUTLET PRESSURE: 14" w.c.
- 9 1" G (2 PSI) UP TO ROOF.
- 10 2" G (2 PSI) DOWN WITH SHUT-OFF AND GAS REGULATOR - SIZE FOR CAPACITY: 1,442,000 BTUH INLET PRESSURE: 2 PSI OUTLET PRESSURE: 14" w.c.
- 11 GAS PRESSURE REGULATOR - SIZE FOR CAPACITY: 850,000 BTUH INLET PRESSURE: 2 PSI OUTLET PRESSURE: 14" w.c.
- 12 1" WASTE DOWN.
- 13 1-1/2" PUMPED WASTE FROM (SP-1) IN PUMP PIT.
- 14 3" VENT UP TO 4" V.T.R.
- 15 2" CW DOWN IN CHASE WITH HEADER TO SERVE FIXTURES. 1/2" HW DOWN IN CHASE WITH HEADER TO SERVE FIXTURES.
- 16 2" CW, 3/4" HW DOWN IN CHASE.
- 17 CW TO EXTEND AND CONNECT TO POOL EQUIPMENT. DESIGN AND LOCATIONS BY OTHERS.
- 18 1" CW UP TO SERVE ROOF HYDRANT. ROUTE 1/2" DRAIN LINE TO JANILAIN ROOM AND TERMINATE ABOVE MCP BASIN.
- 19 1" CW DOWN TO SERVE WATER CLOSET.
- 20 8" WASTE STANDPIPE FOR POOL BACKWASH. SEE POOL DRAWINGS FOR ADDITIONAL INFORMATION.
- 21 1/2" HW FROM LABORATORY.
- 22 GAS REGULATOR - SIZE FOR CAPACITY: 2,081,000 BTUH INLET PRESSURE: 2 PSI OUTLET PRESSURE: 14" w.c.
- 23 1-1/2" CW DOWN. EXTEND TO POOL EQUIPMENT BUILDING.
- 24 6" STORM DOWN IN CHASE.
- 25 1-1/2" PUMPED WASTE DOWN AND TERMINATE WITH AIR GAP ABOVE 8" OPEN SITE DRAIN STANDPIPE.
- 26 1-1/2" CW MAKE-UP TO EXTEND AND CONNECT TO POOL EQUIPMENT. DESIGN AND LOCATION BY OTHERS.
- 27 8" WASTE STANDPIPE FOR POOL BACKWASH. SEE POOL DRAWINGS FOR ADDITIONAL INFORMATION.



Project No. 2021-178.RV1
Project Date 12.05.2022
Produced ABT ABT

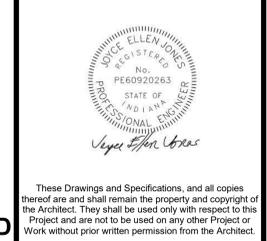

#	Revision	Date
	Addendum #1	01/05/2023
	Addendum #2	01/12/2023
	Addendum #3	01/31/2023

5640 N Illinois St
Indianapolis, IN 46208


KEY PLAN

The Riviera Club

Aquatics Center

FIRST FLOOR PLUMBING PLAN

P101

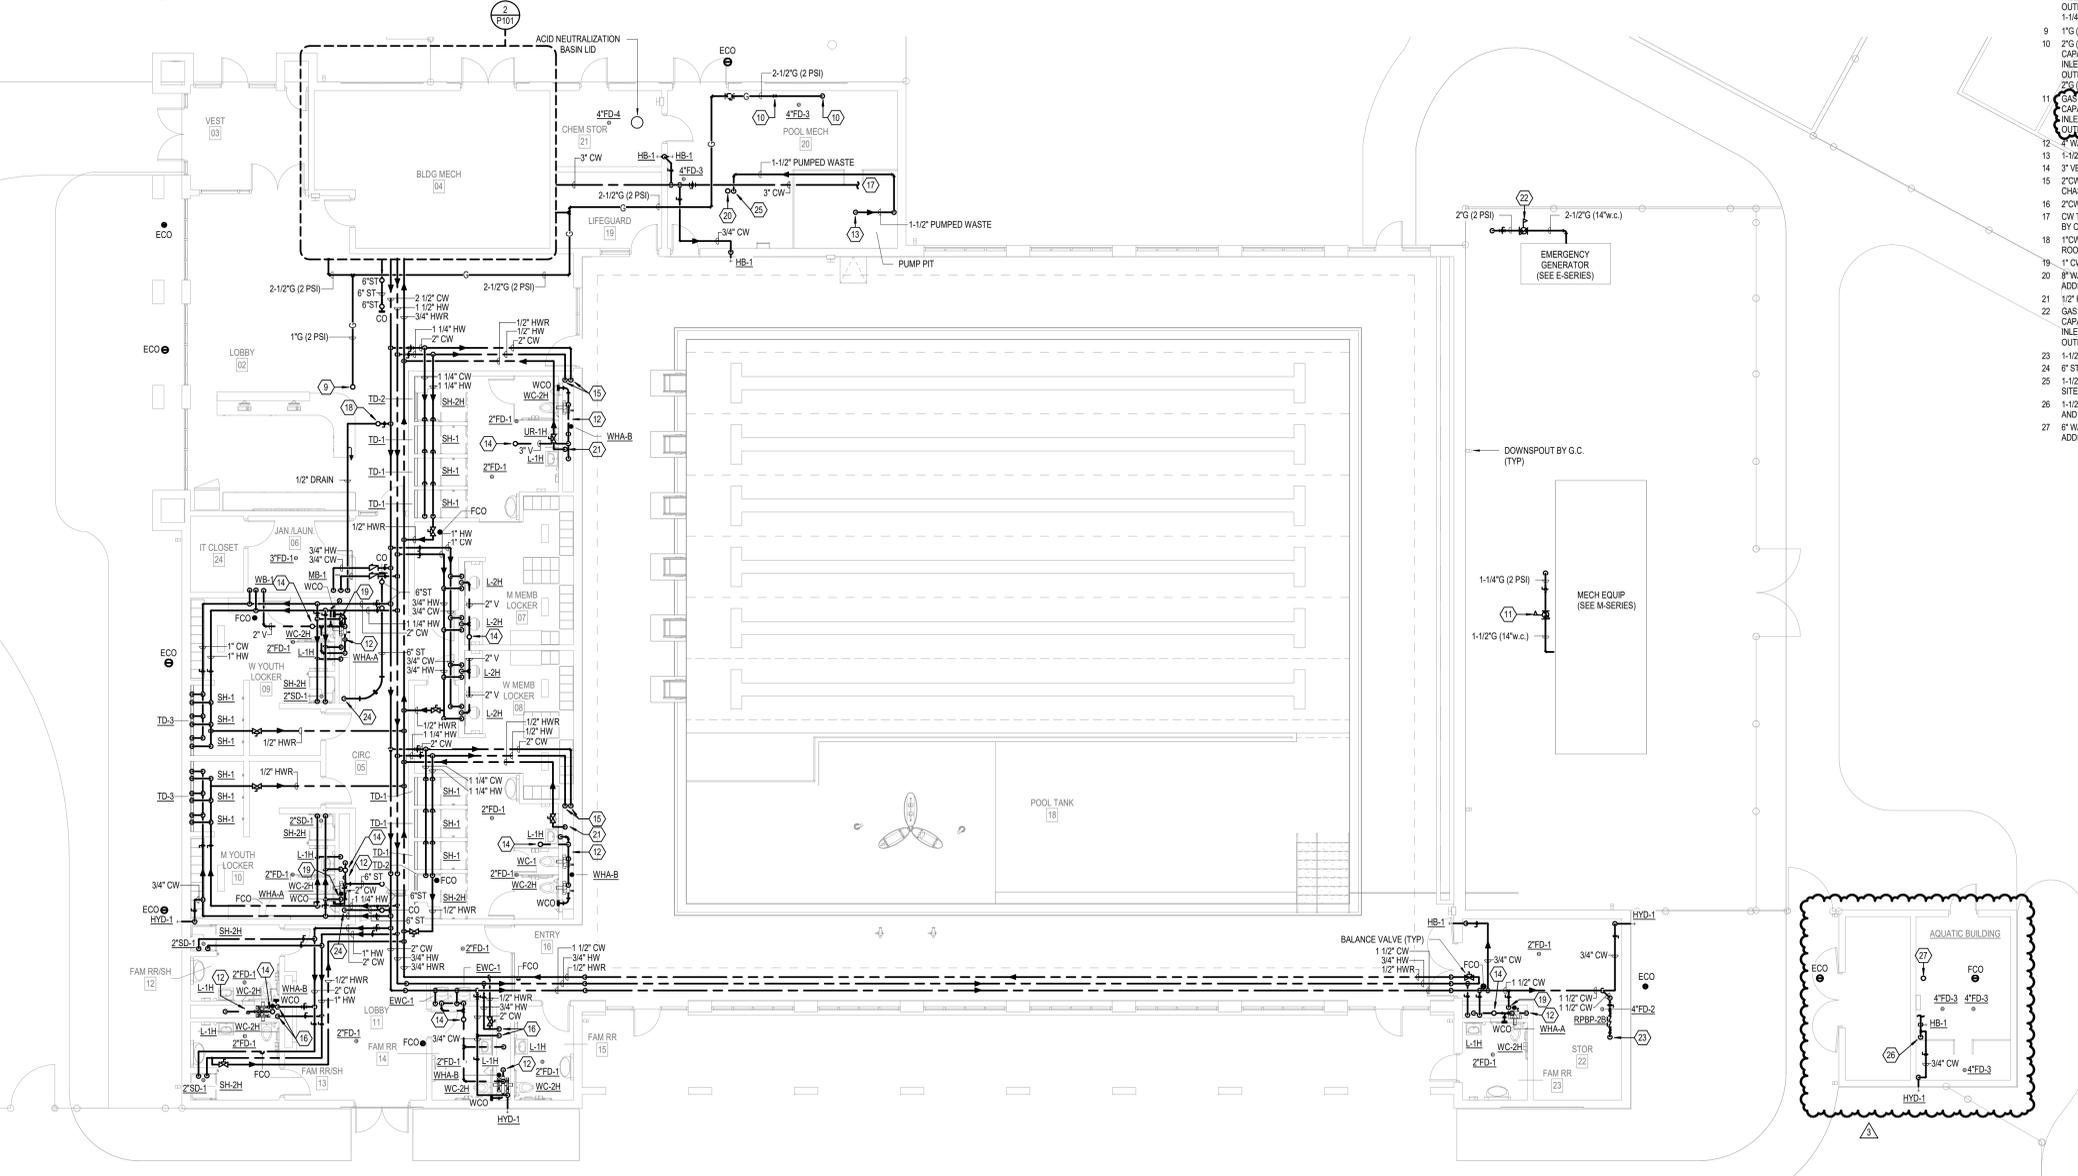

1 FIRST FLOOR PLUMBING PLAN
1/8" = 1'-0"

P101 - FIRST FLOOR PLUMBING PLAN
 12/5/2022 10:45 AM
 12/5/2022 10:45 AM

6


5

4


3

2


1

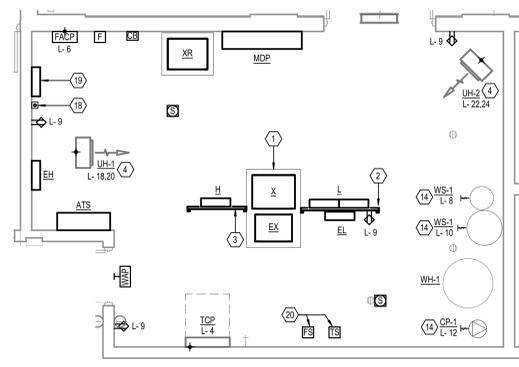

3 ENLARGED ELECTRICAL ROOM
1/4" = 1'-0"

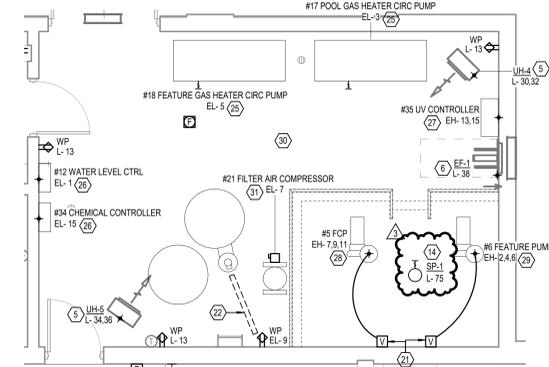

2 ENLARGED POOL MECHANICAL
1/4" = 1'-0"

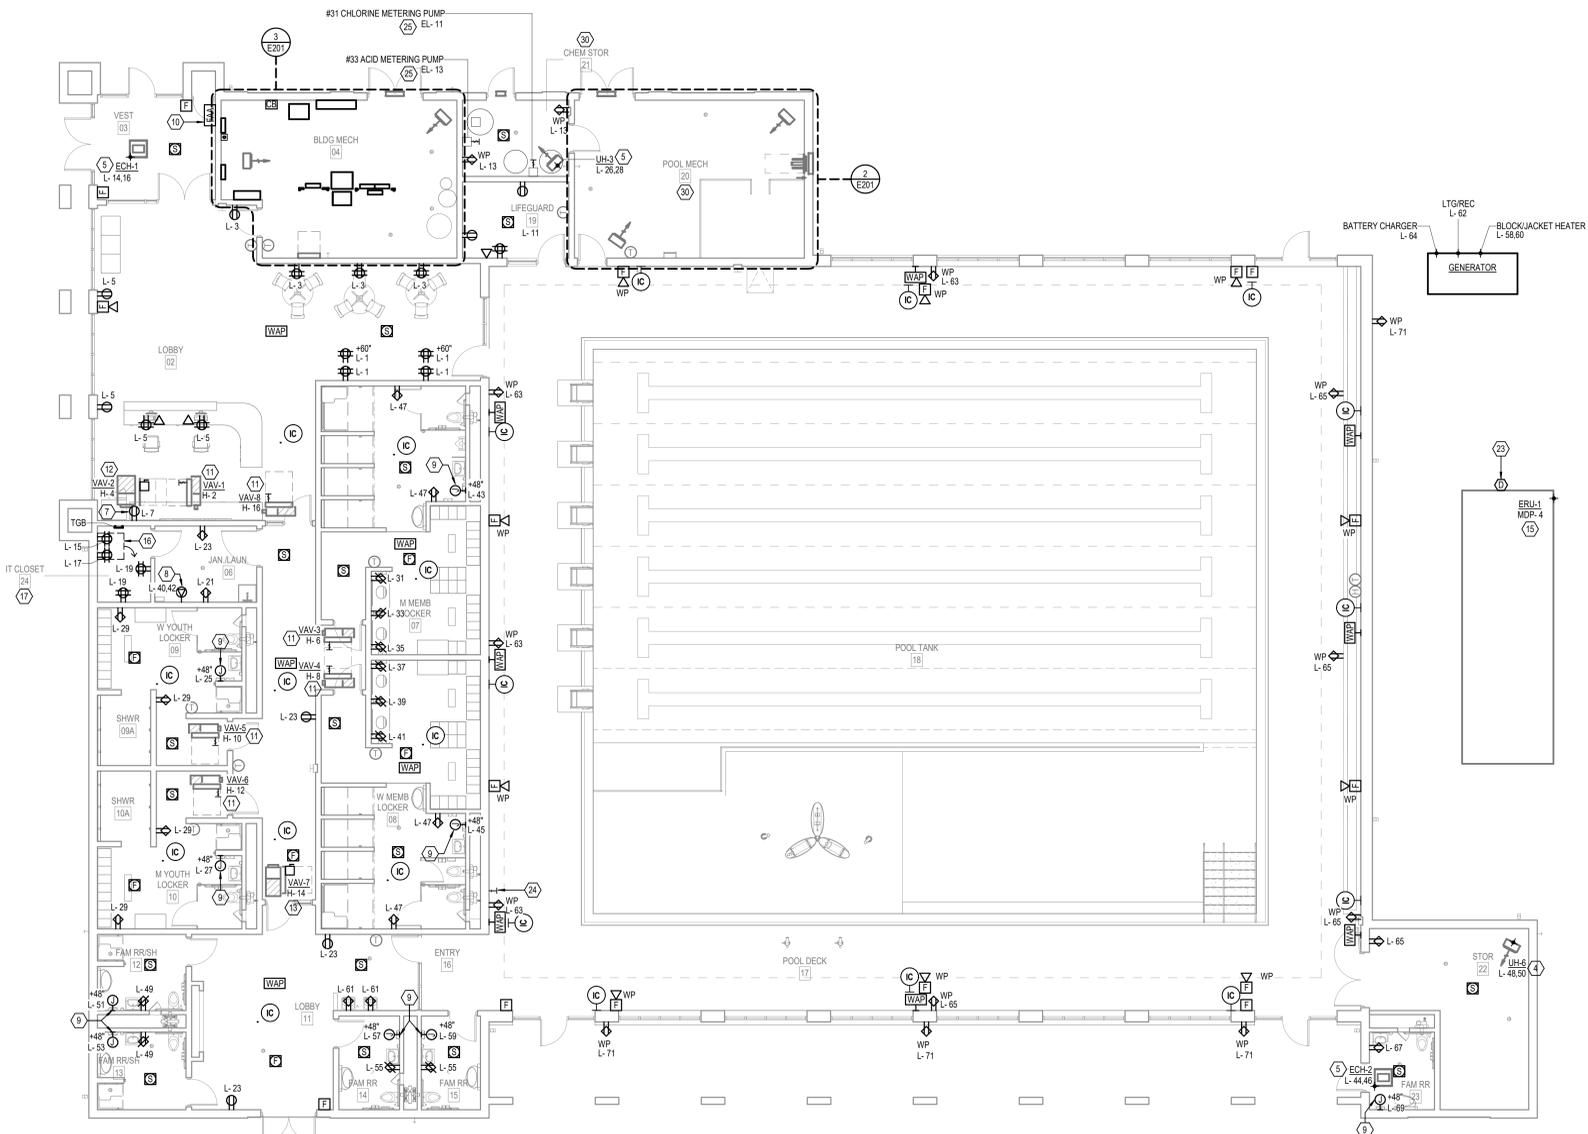


1 FIRST FLOOR ELECTRICAL PLAN
1/8" = 1'-0"

GENERAL NOTES

- A REFER TO SHEET E-000 FOR GENERAL ELECTRICAL NOTES, SYMBOLS AND ABBREVIATIONS.
- B CIRCUIT DESIGNATION AT THE CENTER OF THE ROOM OR BELOW ROOM TAG SIGNIFIES THAT ALL DEVICES WITHIN THAT SPACE ARE TO BE ON NOTED CIRCUIT.
- C ALL RECEPTACLES WITHIN PROJECT SHALL BE TAMPER RESISTANT TYPE.
- D COORDINATE ALL POOL EQUIPMENT LOCATIONS WITH POOL CONTRACTOR. MODIFY POWER FEEDS AND LOCAL DISCONNECT LOCATIONS PER POOL CONTRACTOR.
- E ALL RECEPTACLES FOR FLOORPLANS ARE FOR COPPER WIRE UNLESS NOTED OTHERWISE.

SHEET KEYNOTES

- 1 PROVIDE 4" TALL EQUIPMENT PAD FOR EQUIPMENT AS SHOWN. DIMENSIONS OF PAD SHALL EXTEND 4" PAST THE EXTENT OF EQUIPMENT FOOTPRINT.
- 2 PROVIDE 6'-0" TALL, 4'-8" WIDE, DOUBLE SIDED, FLOOR MOUNTED SECTION OF ALUMINUM UNISTRUT RACK. PROVIDE HORIZONTAL SUPPORTS AS REQUIRED TO SUPPORT ELEMENTS AS SHOWN MOUNT UNISTRUT DIRECTLY ADJACENT TO TRANSFORMER EQUIPMENT PAD.
- 3 PROVIDE 6'-0" TALL, 3'-4" WIDE, DOUBLE SIDED, FLOOR MOUNTED SECTION OF ALUMINUM UNISTRUT RACK. PROVIDE HORIZONTAL SUPPORTS AS REQUIRED TO SUPPORT ELEMENTS AS SHOWN MOUNT UNISTRUT DIRECTLY ADJACENT TO TRANSFORMER EQUIPMENT PAD.
- 4 PROVIDE ELECTRICAL CONNECTION TO 208V 2 POLE MECHANICAL EQUIPMENT WITH INTERGRAL DISCONNECTING MEANS. CIRCUIT SHALL BE 2 #12 IN 1/2" CONDUIT.
- 5 PROVIDE ELECTRICAL CONNECTION TO 208V 3 POLE MECHANICAL EQUIPMENT WITH INTERGRAL DISCONNECTING MEANS. CIRCUIT SHALL BE 2 #12 IN 1/2" CONDUIT.
- 6 PROVIDE ELECTRICAL CONNECTION TO 120V SINGLE POLE MECHANICAL EQUIPMENT WITH INTERGRAL DISCONNECTING MEANS. CIRCUIT SHALL BE 2 #12 IN 1/2" CONDUIT.
- 7 INSTALL RECEPTACLE SO THAT IT IS FLUSH WITH BACK OF CASEWORK. PROVIDE GROMMETED HOLE ON SIDE OF CASEWORK FOR PATHWAY FOR CORDED CONNECTION OF REFRIGERATED MERCHANDISER. RECEPTACLE SHALL BE DEDICATED TO REFRIGERATED MERCHANDISER.
- 8 PROVIDE NEMA 4-30R FOR CLOTHES DRYER. CIRCUIT TO RECEPTACLE SHALL BE 3 #10 #10G IN 1/2" CONDUIT.
- 9 PROVIDE DEDICATED 20A ELECTRICAL CONNECTION FOR HAND DRYER PROVIDED BY OTHERS. CIRCUIT TO HAND DRYER SHALL BE 2#12, #12 G. IN 1/2" CONDUIT.
- 10 FIRE ALARM ANNUNCIATOR PANEL SHALL BE RECESS MOUNTED SO THAT FLUSH WITH WALL.
- 11 PROVIDE ELECTRICAL CONNECTION TO 277V SINGLE POLE MECHANICAL EQUIPMENT. PROVIDE A 20A SINGLE POLE TOGGLE SWITCH AS EQUIPMENT DISCONNECTING MEANS. CIRCUIT SHALL BE 2 #12, #12G IN 3/4" CONDUIT.
- 12 PROVIDE ELECTRICAL CONNECTION TO 277V SINGLE POLE MECHANICAL EQUIPMENT. PROVIDE A 20A SINGLE POLE TOGGLE SWITCH AS EQUIPMENT DISCONNECTING MEANS. CIRCUIT SHALL BE 2 #6, #10G IN 1" CONDUIT.
- 13 PROVIDE ELECTRICAL CONNECTION TO 277V SINGLE POLE MECHANICAL EQUIPMENT. PROVIDE A 20A SINGLE POLE TOGGLE SWITCH AS EQUIPMENT DISCONNECTING MEANS. CIRCUIT SHALL BE 2 #12, #12G IN 3/4" CONDUIT.
- 14 PROVIDE ELECTRICAL CONNECTION TO 120V SINGLE POLE PLUMBING EQUIPMENT. PROVIDE A 20A SINGLE POLE TOGGLE SWITCH AS EQUIPMENT DISCONNECTING MEANS. CIRCUIT SHALL BE 2 #6, #10G IN 1" CONDUIT.
- 15 PROVIDE ELECTRICAL CONNECTION TO 480V 3 POLE MECHANICAL EQUIPMENT WITH INTERGRAL DISCONNECTING MEANS. CIRCUIT SHALL BE 4 #6G, #6G IN 1" CONDUIT FED UNDERGROUND ALONG THE PERIMETER OF THE BUILDING AS NOTED ON SITE PLAN.
- 16 PROVIDE HINGES SO THAT RACK WILL SWING AS SHOWN BY ARROW.
- 17 ENTIRETY OF ROOM FROM 1' AFF TO 1' BELOW FINISHED CEILING SHALL BE COVERED BY 1/2" PLYWOOD PAINTED IN FIRE RETARDANT PAINT. ALL DEVICES SHALL BE MOUNTED SO THAT FLUSH WITH PLYWOOD.
- 18 GENERATOR REMOTE STOP EPO. PROVIDE CONNECTIONS PER GENERATOR NOTES DETAIL.
- 19 GENERATOR ANNUNCIATOR PANEL. PROVIDE CONNECTIONS PER GENERATOR NOTES DETAIL.
- 20 PROVIDE TAMPER AND FLOW SWITCHES FOR FIRE PROTECTION RISER. PROVIDE INTERCONNECTION FROM EACH SWITCH TO FACP. COORDINATE QUANTITY AND LOCATIONS OF TAMPER AND FLOW SWITCHES WITH FIRE PROTECTION CONTRACTOR AND PROVIDE QUANTITY PER FIRE PROTECTION CONTRACTOR COORDINATION.
- 21 VFD FURNISHED BY OTHERS INSTALLED BY ELECTRICAL CONTRACTOR. ALL ASSOCIATED CONNECTIONS TO BE BY ELECTRICAL CONTRACTOR.
- 22 PROVIDE 2 CHANNEL HEAVY DUTY CABLE PROTECTOR FOR CABLE PATHWAY BETWEEN DEDICATED RECEPTACLE AND REGENERATIVE FILTER VACUUM TRANSFER UNIT AS SHOWN BY DASHED LINES. BASIS OF DESIGN IS ULINE H9437 2 CHANNEL CABLE PROTECTOR.
- 23 PROVIDE WEATHER PROOF DUCT DETECTOR ON RETURN DUCT IN LOCATION SHOWN ON MECHANICAL DRAWINGS. PROVIDE INTERCONNECTION TO FACP.
- 24 PROVIDE LOW VOLTAGE DIAL STYLE TIMER SWITCH WITH STAINLESS STEEL FACEPLATE AND PLASTIC DIAL TO BE INTERCONNECTED WITH RELAY TO CONTROL POOL THERAPY JETS. PROVIDE WITH LOCKABLE OPAQUE ENCLOSURE.
- 25 PROVIDE ELECTRICAL CONNECTION TO 120V SINGLE POLE POOL EQUIPMENT. PROVIDE A 20A SINGLE POLE COMBINATION MOTOR STARTER DISCONNECT AS EQUIPMENT DISCONNECTING MEANS AND STARTING METHOD. CIRCUIT SHALL BE 2 #12, #12G IN 3/4" CONDUIT.
- 26 PROVIDE ELECTRICAL CONNECTION TO 120V SINGLE POLE POOL EQUIPMENT WITH INTERGRAL DISCONNECTING MEANS. CIRCUIT SHALL BE 2 #6, #10G IN 1/2" CONDUIT.
- 27 PROVIDE ELECTRICAL CONNECTION TO 480V TWO POLE POOL EQUIPMENT WITH INTERGRAL DISCONNECTING MEANS. CIRCUIT SHALL BE 3 #8, #10G IN 1/2" CONDUIT.
- 28 PROVIDE ELECTRICAL CONNECTION TO 480V THREE POLE POOL EQUIPMENT WITH VFD WITH DISCONNECTING MEANS. VFD TO BE PROVIDED BY OTHERS. CONNECTIONS BETWEEN EQUIPMENT VFD AND PANEL TO BE BY ELECTRICAL CONTRACTOR. CIRCUIT SHALL BE 3 #8, #10G IN 1" CONDUIT.
- 29 PROVIDE ELECTRICAL CONNECTION TO 480V THREE POLE POOL EQUIPMENT WITH VFD WITH DISCONNECTING MEANS. VFD TO BE PROVIDED BY OTHERS. CONNECTIONS BETWEEN EQUIPMENT VFD AND PANEL TO BE BY ELECTRICAL CONTRACTOR. CIRCUIT SHALL BE 3 #8, #10G IN 1" CONDUIT.
- 30 EQUIPMENT SHOWN WITHIN ROOM IS SHOWN AS REFERENCE ONLY. COORDINATE EXACT EQUIPMENT LOCATIONS WITH POOL CONTRACTOR PRIOR TO ROUGH IN.
- 31 PROVIDE ELECTRICAL CONNECTION TO 120V SINGLE POLE POOL EQUIPMENT. PROVIDE A 60A SINGLE POLE NEMA 4X SS, NON-FUSED DISCONNECT AS EQUIPMENT LOCAL DISCONNECTING MEANS. CIRCUIT SHALL BE 2 #6, #10G IN 1" CONDUIT.
- 32 PROVIDE ELECTRICAL CONNECTION TO 120V SINGLE POLE MECHANICAL EQUIPMENT WITH INTERGRAL DISCONNECTING MEANS. CIRCUIT SHALL BE 2 #12, #12G IN 1/2" CONDUIT.
- 33 PROVIDE ELECTRICAL CONNECTION TO 120V SINGLE POLE MECHANICAL EQUIPMENT WITH INTERGRAL DISCONNECTING MEANS. CIRCUIT SHALL BE 2 #12, #12G IN 1/2" CONDUIT.
- 34 PROVIDE ELECTRICAL CONNECTION TO 208V TWO POLE POOL EQUIPMENT WITH INTERGRAL DISCONNECTING MEANS. CIRCUIT SHALL BE 3 #8, #8G IN 1-1/2" CONDUIT.
- 35 PROVIDE ELECTRICAL CONNECTION TO 208V TWO POLE POOL EQUIPMENT WITH INTERGRAL DISCONNECTING MEANS. CIRCUIT SHALL BE 2 #12, #12G IN 3/4" CONDUIT.

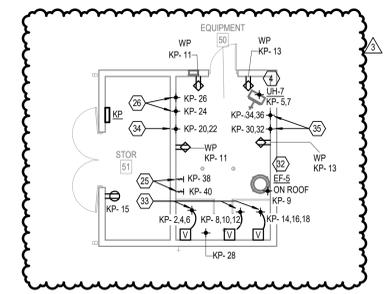

Project No. 2021-178.RV1
Project Date 12.05.2022
Produced Designer/Author



These Drawings and Specifications, and all copies thereof are and shall remain the property and copyright of the Architect. They shall be used only with respect to this Project and are not to be used on any other Project or Work without prior written permission from the Architect.

#	Revision	Date
	Addendum #1	01/05/2023
	Addendum #2	01/12/2023
	Addendum #3	01/31/2023

5640 N Illinois St
Indianapolis, IN 46208

KEY PLAN

The Riviera Club

Aquatics Center

FIRST FLOOR ELECTRICAL PLAN

E201

6

5

4


3

2

1



Project No. 2021-178.RV1
 Project Date 12.05.2022
 Produced Designer Author

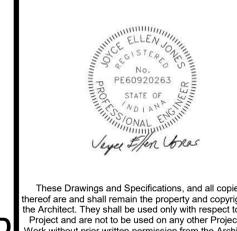

#	Revision	Date
	Addendum #1	01/05/2023
	Addendum #2	01/12/2023
	Addendum #3	01/31/2023

5640 N Illinois St
 Indianapolis, IN 46208

KEY PLAN

The Riviera Club

Aquatics Center

FIRST FLOOR LIGHTING


E301

GENERAL NOTES

- A ANY LIGHT FIXTURE WITH AN "E" DESIGNATION SHALL BE PROVIDED WITH INTEGRAL MANUFACTURER INSTALLED EMERGENCY BATTERY BACKUP UNLESS NOTED OTHERWISE.
- B "NL" SYMBOL REPRESENTS NIGHT LIGHT AND SHOULD REMAIN ALWAYS ON.

SHEET KEYNOTES

- 1 PROVIDE RELAY BASED LIGHTING CONTROL PANEL WITH ALL DIMMABLE RELAYS. RELAY PANEL SHALL HAVE MINIMUM OF 6 SPARE RELAYS. PROVIDE RELAY PANEL SCHEDULE WITHIN DOOR PANEL. PROVIDE SCHEDULE AND ZONING DIAGRAM FOR LCP IN RELAY BASED LIGHTING CONTROL. SUBMITTAL.
- 2 ALL EMERGENCY FIXTURES WITHIN SPACE SHALL HAVE EMERGENCY FEED FROM CENTRAL INVERTER LOCATED IN ELECTRICAL ROOM.
- 3 PROVIDE CENTRAL INVERTER AT 6 A/F FOR EMERGENCY FEED TO FIXTURES AS NOTED ELSEWHERE. BASIS OF DESIGN FOR INVERTER IS IOTA 550 HE.
- 4 ROOM FIXTURE LIGHTING CONTROL SHALL BE BY LIGHTING CONTROL PANEL. PROVIDE 5 BLINK WARNING 3 MINUTES BEFORE FIXTURES ARE TO TURN OFF. PROVIDE MOMENTARY CONTACT SWITCH FOR OFF HOURS OPERATION. MOMENTARY SWITCH TO TURN ROOM LIGHTING ON FOR ONE HOUR. SWITCH SHALL BE LOCATED WITHIN ELECTRICAL ROOM.
- 5 MOMENTARY CONTACT SWITCH FOR POOL SPACE LIGHTING.
- 6 EXTERIOR LIGHTING SHALL BE CONTROLLED BY LIGHTING CONTROL PANEL. PROVIDE PHOTOCELL OVERRIDE CONTROL DURING OPERATING HOURS.
- 7 SPACE SHALL BE CONTROLLED BY LIGHTING CONTROL PANEL. DURING OFF HOURS LIGHTING CONTROL SHALL BE BY OCCUPANCY SENSORS.

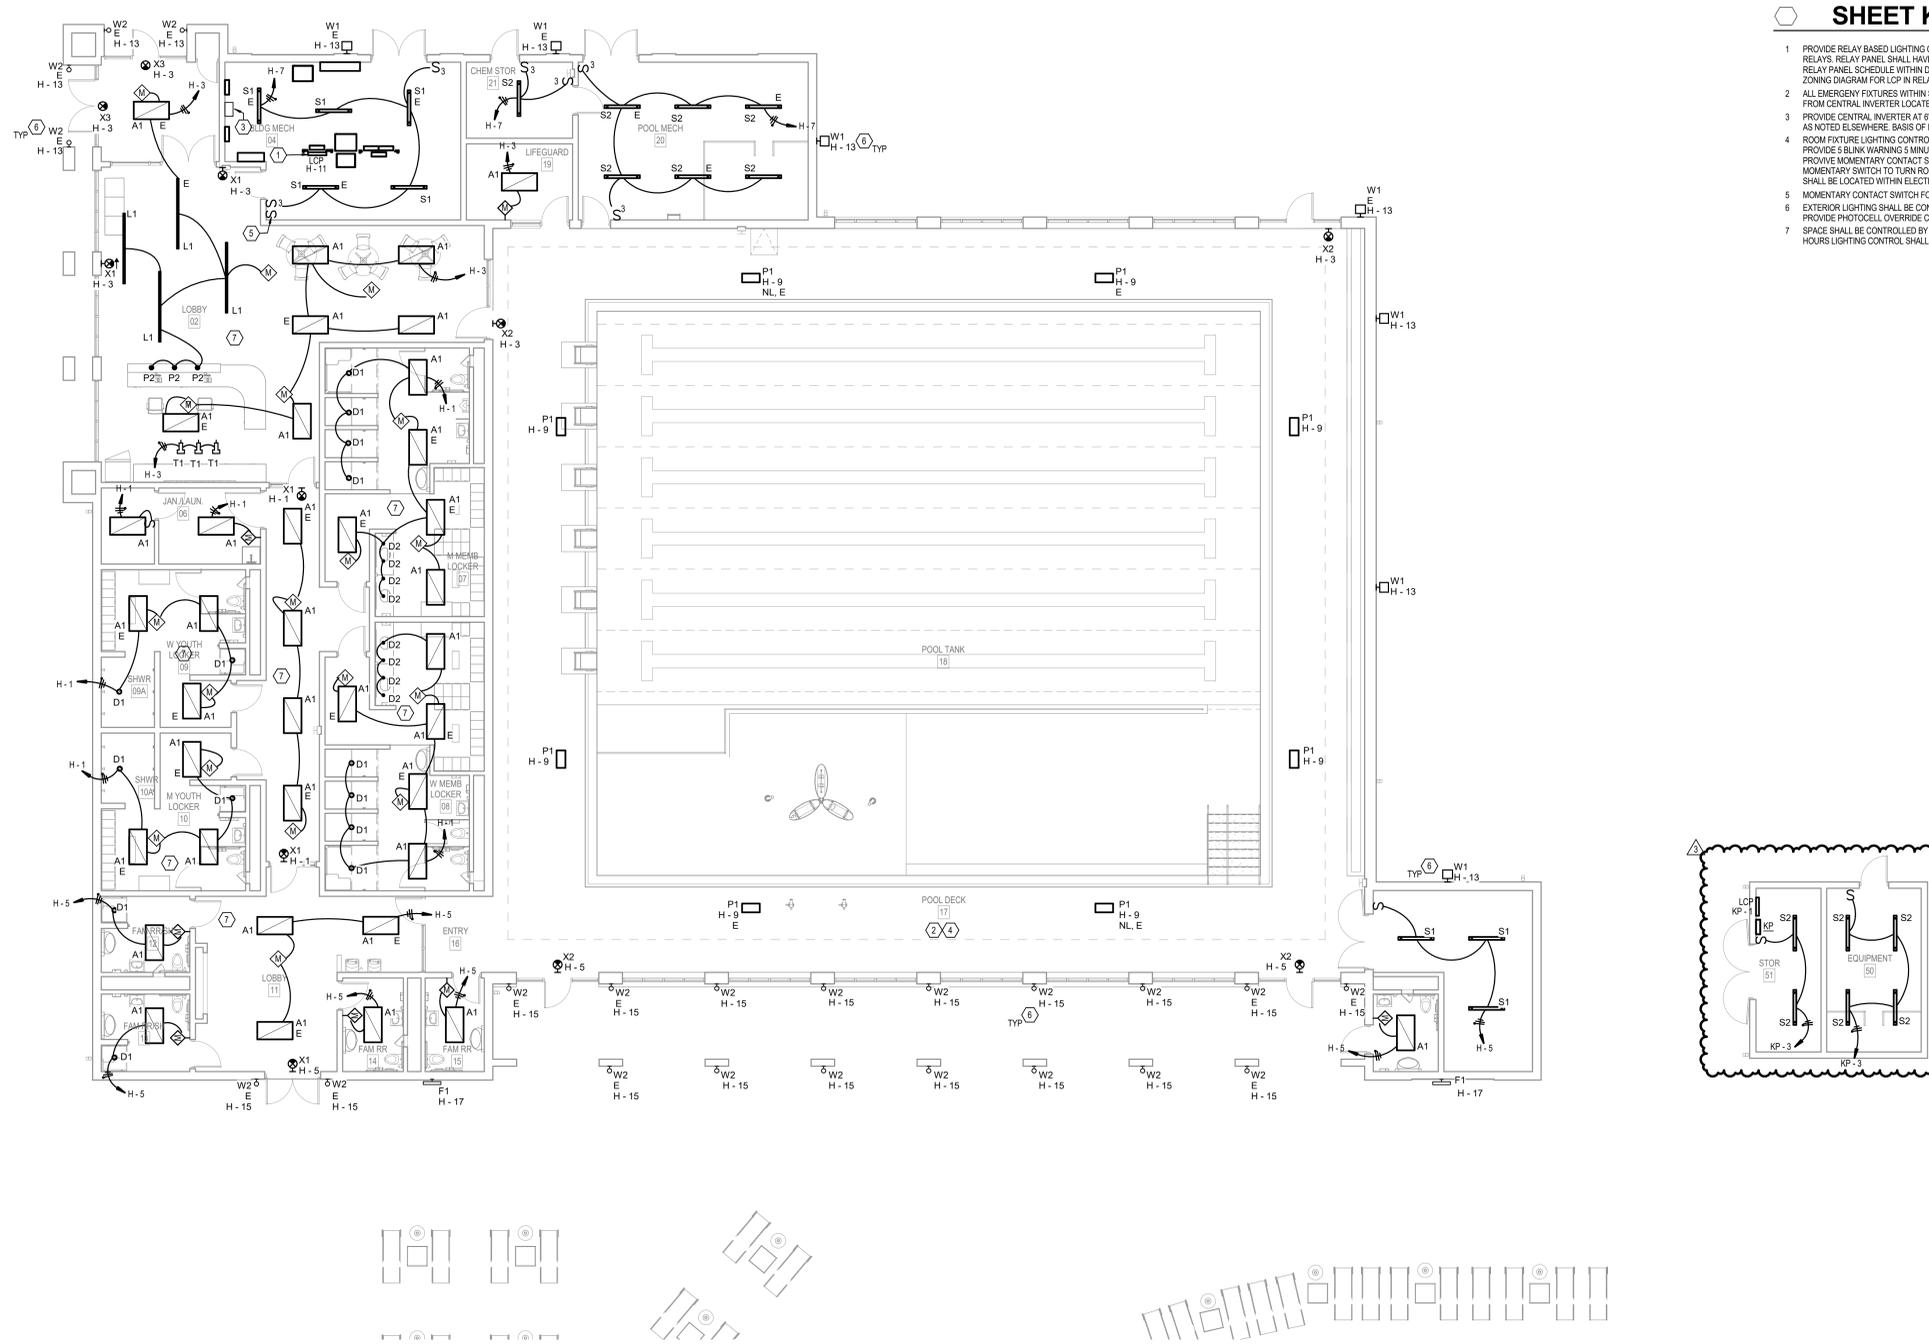

1 FIRST FLOOR LIGHTING PLAN
 1/8" = 1'-0"

6

5

4

3

2

1

Branch Panel: L

Location: BLDG MECH-1 8-1
Supply From: X
Mounting: SURFACE, UNISTRUT
Enclosure: NEMA 1

Volts: 120/208 Wye
Phases: 3
Wires: 4

A.I.C. Rating: 30,000
Mains Type: MCB
Mains Rating: 250 A
MCB Rating: 250 A

Table with columns: CKT, Circuit Description, Trip, Poles, A, B, C, Poles, Trip, Circuit Description, CKT. Lists various electrical loads like RECEPT, LIGHTING, and HVAC.

Legend and Load Classification table. Includes columns for Connected Load, Demand Factor, Estimated Demand, and Panel Totals.

Notes: DOUBLE TUB PANEL SECOND SECTION CONTINUED ON PANEL SCHEDULE L WITH CIRCUIT NUMBERS 42-84. LOAD CALCULATION SHOWN ON THIS PANEL ACCOUNTS FOR SECOND SECTION LOAD.

Branch Panel: L

Location: BLDG MECH-1 8-1
Supply From: L
Mounting: SURFACE, UNISTRUT
Enclosure: NEMA 1

Volts: 120/208 Wye
Phases: 3
Wires: 4

A.I.C. Rating: 30,000
Mains Type: MCB
Mains Rating: 250 A
MCB Rating: 250 A

Table with columns: CKT, Circuit Description, Trip, Poles, A, B, C, Poles, Trip, Circuit Description, CKT. Lists various electrical loads like M MEMBER LOCKER HAND DRYER, RECEPT, and HVAC.

Legend and Load Classification table. Includes columns for Connected Load, Demand Factor, Estimated Demand, and Panel Totals.

Notes: DOUBLE TUB PANEL FIRST SECTION SCHEDULE IS ON PANEL SCHEDULE L WITH CIRCUIT NUMBERS 1-42.

Branch Panel: H

Location: BLDG MECH-1 8-1
Supply From: MDP
Mounting: SURFACE, UNISTRUT
Enclosure: NEMA 1

Volts: 480/277 Wye
Phases: 3
Wires: 4

A.I.C. Rating: 42,000
Mains Type: MLO
Mains Rating: 100 A
MCB Rating: 100 A

Table with columns: CKT, Circuit Description, Trip, Poles, A, B, C, Poles, Trip, Circuit Description, CKT. Lists various electrical loads like LIGHTING, LIFT STATION CONTROL PANEL, and SPARE.

Legend and Load Classification table. Includes columns for Connected Load, Demand Factor, Estimated Demand, and Panel Totals.

Notes:

Branch Panel: EL

Location: BLDG MECH-1 8-1
Supply From: EX
Mounting: SURFACE, UNISTRUT
Enclosure: NEMA 1

Volts: 120/208 Wye
Phases: 3
Wires: 4

A.I.C. Rating: 30,000
Mains Type: MCB
Mains Rating: 100 A
MCB Rating: 100 A

Table with columns: CKT, Circuit Description, Trip, Poles, A, B, C, Poles, Trip, Circuit Description, CKT. Lists various electrical loads like #12 WATER LEVEL CONTROLLER, #17 POOL GAS HEATER CIRC PUMP, and #18 FEATURE GAS HEATER CIRC PUMP.

Legend and Load Classification table. Includes columns for Connected Load, Demand Factor, Estimated Demand, and Panel Totals.

Notes:

Branch Panel: EH

Location: BLDG MECH-1 8-1
Supply From: ATS
Mounting: SURFACE
Enclosure: NEMA 1

Volts: 480/277 Wye
Phases: 3
Wires: 4

A.I.C. Rating: 42,000
Mains Type: MCB
Mains Rating: 200 A
MCB Rating: 200 A

Table with columns: CKT, Circuit Description, Trip, Poles, A, B, C, Poles, Trip, Circuit Description, CKT. Lists various electrical loads like TRANSFORMER EX, #5 FILTER SYSTEM CIRCULATING PUMP (FCP), and #35 UV CONTROLLER.

Legend and Load Classification table. Includes columns for Connected Load, Demand Factor, Estimated Demand, and Panel Totals.

Notes:

Switchboard: MDP

Location: BLDG MECH-1 8-1
Supply From: MDP
Mounting: SURFACE
Enclosure: NEMA 1

Volts: 480/277 Wye
Phases: 3
Wires: 4

A.I.C. Rating: 65,000
Mains Type: MCB
Mains Rating: 1200 A
MCB Rating: 1200 A

Table with columns: CKT, Circuit Description, # of Poles, Trip Rating, Load, Remarks. Lists various electrical loads like SPD TYPE 1, TRANSFORMER XR, and TRANSFORMER X.

Legend and Load Classification table. Includes columns for Connected Load, Demand Factor, Estimated Demand, and Panel Totals.

Notes: 1. COORDINATE BREAKER AMPERAGE WITH SPD MANUFACTURER. PROVIDE BREAKER AMPERAGE PER MANUFACTURER RECOMMENDATIONS.

Branch Panel: KP

Location: STOR 51
Supply From:
Mounting:
Enclosure:

Volts: 120/208 Wye
Phases: 3
Wires: 4

A.I.C. Rating: 30,000
Mains Type: MCB
Mains Rating: 225 A
MCB Rating: 225 A

Table with columns: CKT, Circuit Description, Trip, Poles, A, B, C, Poles, Trip, Circuit Description, CKT. Lists various electrical loads like LIGHTING, HVAC, and RECEPT.

Legend and Load Classification table. Includes columns for Connected Load, Demand Factor, Estimated Demand, and Panel Totals.

Legend and Load Classification table. Includes columns for Connected Load, Demand Factor, Estimated Demand, and Panel Totals.

Notes:



Project No. 2021-178.RV1
Project Date 12.05.2022
Produced Designer Author



These Drawings and Specifications, and all copies thereof are and shall remain the property and copyright of the Architect. They shall be used only with respect to this Project and are not to be used on any other Project or Work without prior written permission from the Architect.

Table with columns: #, Revision, Date. Lists Addendum #1, #2, and #3 with their respective dates.

5640 N Illinois St
Indianapolis, IN 46208




The Riviera Club

Aquatics Center


ELECTRICAL PANEL SCHEDULES

E500


LIGHT FIXTURE SCHEDULE													
UNIT ID	DESCRIPTION	DRIVER	VOLTS (V)	COLOR (K)	LIGHT			LOAD		MOUNTING	MOUNTING HEIGHT (AFF)	MANUFACTURER MODEL NUMBER	EQUIVALENT MANUFACTURERS
					QTY (LM)	UNITS	QTY (W)	UNITS					
A1	2-FOOT BY 4-FOOT FLAT PANEL, WHITE FINISH, DLC LISTED.	0-10V DIMMING TO 10%	277	3500	5037	/FIXTURE	39.3	/FIXTURE	RECESSED	CEILING	COLUMBIA LIGHTING: CBT24-LSCS	LITHONIA LIGHTING: CPX-24X-4000LM-80CR-38K-SWLM-10ZT-MVOLT	
D1	LENSED SHOWER RATED DOWNLIGHT, 6-INCH DIAMETER APERTURE, CLEAR SEMI-SPECULAR REFLECTOR, SELF FLANGED (VERIFY MUD IN FLANGE IS NOT REQUIRED), WET LOCATION LISTED, ENERGY STAR LISTED.	0-10V DIMMING TO 10%	277	3500	1684	/FIXTURE	19.5	/FIXTURE	RECESSED	CEILING	FRESCOLITE: LFR-4RD-M-20L35K9-VD-DM-1-FR4RD7SHWTMML-LFR-4RD-H	GOHAM: EVO4SH-362D-0FF-SMO-MVOLT-EZ10-NLT	
D2	LENSED SHOWER RATED DOWNLIGHT, 2-INCH DIAMETER APERTURE, CLEAR SEMI-SPECULAR REFLECTOR, SELF FLANGED, WET LOCATION LISTED, ENERGY STAR LISTED.	0-10V DIMMING TO 10%	277	3500	717	/FIXTURE	8.6	/FIXTURE	RECESSED	CEILING	ALHABET: 624-RD-SW-10LM-35K-85-D46-UNV-DIM10-NC-WH	GOHAM: ICO-3507-AR-LSS-LT-20D-MVOLT-UGZ	
F1	ADJUSTABLE FLOOD TYPE 4 LIGHT DISTRIBUTION, INTEGRAL POWER SUPPLY, WET LOCATION LISTED, IP67 RATED, FINISH TO BE SELECTED BY ARCHITECT FROM MANUFACTURER'S CATALOG OF STANDARD COLORS.	ELECTRONIC	277	3000	8405	/FIXTURE	74	/FIXTURE	SURFACE WALL	+138"	LIGMAN: UGA-5112-74WLED-14-W30-01-120277-F	OR APPROVED EQUAL	
L1	LINEAR 2-INCH WIDE BY 8-FOOT LONG DIRECT, AIRCRAFT CABLE, FLUSH FROSTED ACRYLIC LENS, ANODIZED FINISH.	0-10V DIMMING TO 10%	277	3500	625	/FT	7.1	/FT	SUSPENDED	+96"	FINELITE: HP2-P-D-8-B-835-F-96L-277-300-FC-10%-FA50-C3-FE-SW	OR APPROVED EQUAL	
P1	2-FOOT EXTRUDED ALUMINUM NATATORIUM FIXTURE WITH PRIMARY DISTRIBUTION INDIRECTLY AND SMALL DIRECT COMPONENT	0-10V DIMMING TO 10%	277	3500	64896	/FIXTURE	435	/FIXTURE	PENDANT MOUNT	+14" AFF	LUX DYNAMICS: WAVEP-2-835-U10-WSM-DEF4	OR APPROVED EQUAL OR APPROVED EQUAL EQUALS TO PROVIDE PHOTOMETRIC CALCULATIONS FOR APPROVAL. MINIMUM PERFORMANCE IN POOL SHALL BE 50FC AVERAGE ACROSS BOTH POOL AND DECK WITH FIXTURES BEING PRIMARILY INDIRECT TO AVOID GLARE.	
P2	16-INCH NOMINAL DIAMETER CYLINDER, STEM MOUNTED, FINISH TO BE SELECTED BY ARCHITECT FROM MANUFACTURER'S CATALOG OF STANDARD FINISHES, ENERGY STAR LISTED.	0-10V DIMMING TO 10%	277	3500	900	/FIXTURE	10	/FIXTURE	PENDANT MOUNT	+78"	LUMEN ART LIGHTING SOLUTIONS: VMMALED-277-3000M-WC-WH-0-10V	LITHONIA LIGHTING: CSS-L48-MVOLT-35K-80CRI	
S1	4-FOOT LENSED STRIP, CHAIN HUNG, FORMED STEEL HOUSING, CURVED FROSTED ACRYLIC LENS, WHITE ENAMEL FINISH, DLC LISTED.	0-10V DIMMING TO 10%	277	3500	4135	/FIXTURE	35.8	/FIXTURE	SUSPENDED	+108"	COLUMBIA LIGHTING: CS-L48-SCS	LITHONIA LIGHTING: CSVT-L48-4000LM-MVOLT-40K-80CRI	
S2	4-FOOT VAPOR TIGHT LENSED STRIP, AIRCRAFT CABLE HUNG, POLYCARBONATE HOUSING, POLYCARBONATE LATCHES, CURVED POLYCARBONATE LENS, DLC LISTED.	0-10V DIMMING TO 10%	277	3500	4065	/FIXTURE	34	/FIXTURE	SUSPENDED	+108"	COLUMBIA LIGHTING: LXM-40ML-RFA-EDU	LITHONIA LIGHTING: CSVT-L48-4000LM-MVOLT-40K-80CRI	
T1	STEM MOUNTED AIMABLE LIGHT, NARROW DISTRIBUTION, FINISH TO BE SELECTED BY ARCHITECT FROM MANUFACTURER'S CATALOG OF STANDARD FINISHES.	0-10V DIMMING TO 10%	277	3500	541	/FIXTURE	5	/FIXTURE	PENDANT	+96"	BRUCK LIGHTING: 137A09-XTM19-35K-85-SAS4-UNV-10V-MP-L18	EUREKA: 2084-LED-4-35-48-277V-DV-S5-36-RC-CHR-XXX-BLKA	
W1	ARCHITECTURAL WALL PACK, WET LOCATION LISTED, FINISH TO BE SELECTED BY ARCHITECT FROM MANUFACTURER'S CATALOG OF STANDARD COLORS.	ELECTRONIC	277	3000	5121	/FIXTURE	37	/FIXTURE	SURFACE WALL	+96"	LIGMAN: UQU-31343-37WLED-T3-W33-01-120277V	OR APPROVED EQUAL	
W2	ARCHITECTURAL WALL SPONGE, WET LOCATION LISTED, FINISH TO BE SELECTED BY ARCHITECT FROM MANUFACTURER'S CATALOG OF STANDARD COLORS.	ELECTRONIC	277	3000	129	/FIXTURE	22	/FIXTURE	SURFACE WALL	+72"	LANDSCAPEFORMS: AP-108-3-079F-30K-UV1-20K-MM1-NTW	OR APPROVED EQUAL	
X1	WHITE THERMOPLASTIC EXIT SIGN, CLEAR FACE, RED LETTERING, IMPACT RESISTANT, SELF POWERED, SELF DIAGNOSTIC, PROVIDE DIRECTIONAL ARROWS AS SHOWN ON PLANS.	ELECTRONIC	277				5	/FIXTURE	SURFACE	N/A	COMPASS: CER	LITHONIA: LQM-S-W-3-R-120277-EL_N-SD	
X2	NEMA 4X POLYCARBONATE SHIELDED EXIT SIGN, WHITE FACE, TAMPER RESISTANT, RED LETTERING, SELF POWERED, SELF DIAGNOSTIC, PROVIDE DIRECTIONAL ARROWS AS SHOWN ON PLANS.	ELECTRONIC	277				5	/FIXTURE	SURFACE	N/A	DUALITE: SEWLSRWE	LITHONIA: LV-W-1-R-120277-EL_N-SD-4X	
X3	WHITE THERMOPLASTIC EXIT SIGN, CLEAR FACE, RED LETTERING, IMPACT RESISTANT, SELF POWERED, SELF DIAGNOSTIC, PROVIDE DIRECTIONAL ARROWS AS SHOWN ON PLANS.	ELECTRONIC	277				5	/FIXTURE	CEILING	N/A	COMPASS: CER	LITHONIA: LQM-S-W-3-R-120277-EL_N-SD	

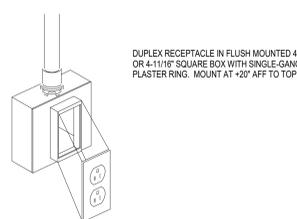


10 TYPICAL FLUSH MOUNTED DUPLX OUTLET
NOT TO SCALE

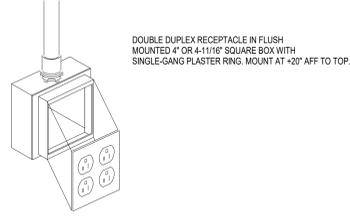


3 TYPICAL FLUSH MOUNTED DOUBLE DUPLX
NOT TO SCALE

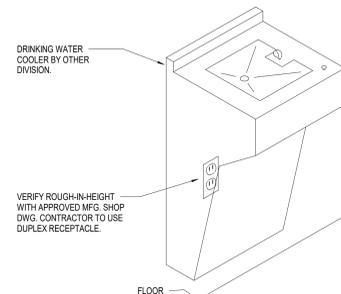


2 EWC WIRING
NOT TO SCALE

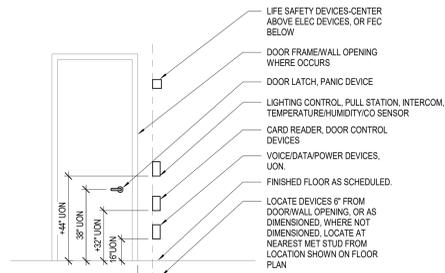



1 DEVICE MOUNTING ELEVATION
NOT TO SCALE

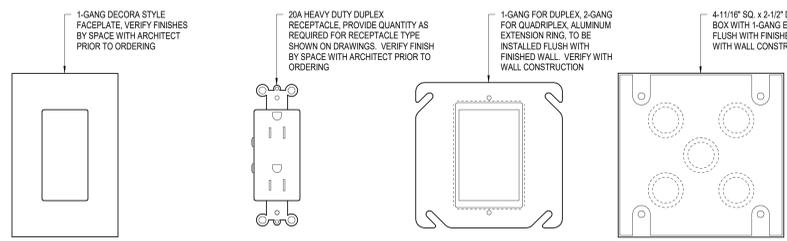


6 TYPICAL RECEPTACLE BOX ASSEMBLY
NOT TO SCALE

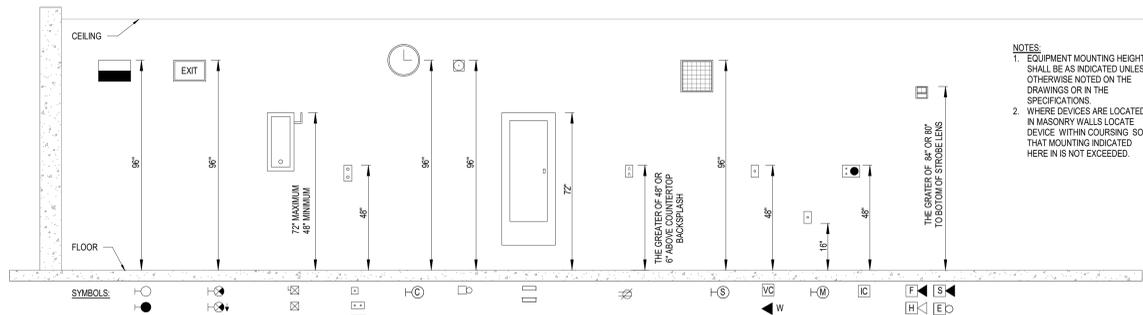

5 TYPICAL ELECTRICAL ELEVATION
NOT TO SCALE

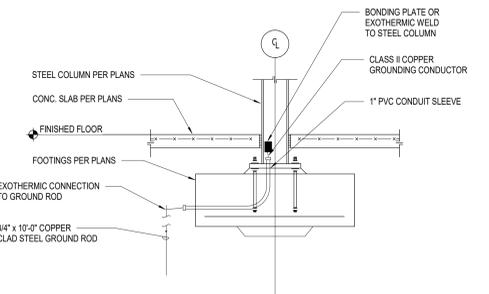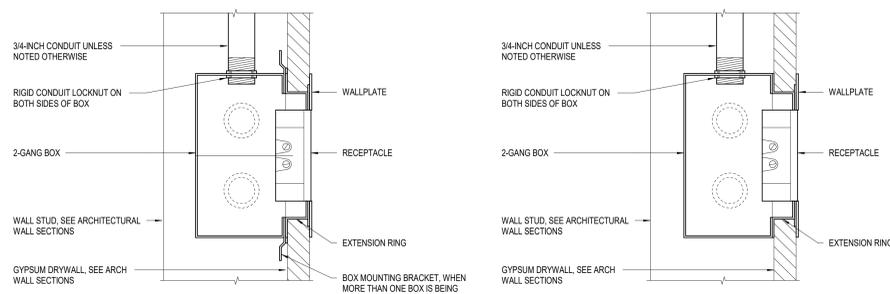

8 COLUMN GROUNDING - SLEEVE
NOT TO SCALE

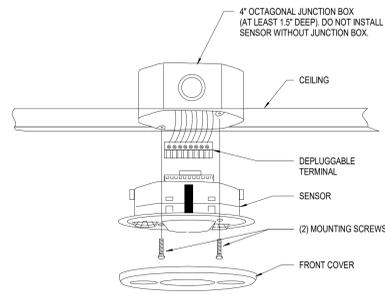

7 TYPICAL OCCUPANCY SENSOR MOUNTING DETAIL
NOT TO SCALE

Project No. 2021-178.RV1
Project Date 12.05.2022
Produced Designer/Author

These Drawings and Specifications, and all copies thereof are and shall remain the property and copyright of the Architect. They shall be used only with respect to this Project and are not to be used on any other Project or Work without prior written permission from the Architect.

#	Revision	Date
	Addendum #1	01/05/2023
	Addendum #2	01/12/2023
	Addendum #3	01/31/2023

5640 N Illinois St
Indianapolis, IN 46208

KEY PLAN

The Riviera Club

Aquatics Center

ELECTRICAL SCHEDULES AND DETAILS

E501