

**ADDENDUM
NO. 3**

November 6, 2023

**HANOVER COMMUNITY SCHOOLS - JANE BALL ELEMENTARY
RENOVATIONS AND HIGH SCHOOL IMPROVEMENTS**

TO: ALL BIDDERS OF RECORD

This Addendum forms a part of and modifies the Bidding Requirements, Contract Forms, Contract Conditions, the Specifications, and the Drawings dated October 13, 2023 by Gibraltar Design. Acknowledge receipt of the Addendum in the space provided on the Bid Form. Failure to do so may subject the Bidder to disqualification.

This Addendum consists of Page ADD 3-1 and attached Addendum No. 3 from Gibraltar Design dated November 3, 2023 and consisting of 3 pages, Revised Specification Sections 10 51 14 - Ventilated Lockers, and 24 drawings.

A. SPECIFICATION SECTION 01 12 00 - MULTIPLE CONTRACT SUMMARY

A. BID CATEGORY NO. 1 - SITEWORK/GENERAL TRADES

1. Add:

Clarification No. 13:

Reference Architectural Drawings; The **Bid Category No. 1 Contractor** is responsible for infilling all remaining openings where mechanical demolition has taken place as indicated on the construction documents.

Clarification No. 14:

Reference Exterior Elevations; The **Bid Category No. 1 Contractor** is responsible for relocating the existing aluminum lettering as indicated on the construction documents.

ADDENDUM THREE

Addendum Two (AD.03) to the drawings and specifications prepared by Gibraltar Design for **Hanover CSC – Jane Ball ES Renovation and HS Improvements** for Hanover Community School Corporation, Cedar Lake, Indiana.

All Contractors bidding on this project shall read all of the items covered below and shall comply with all of the requirements as set forth, including any necessary refinements or additions generated by this Addendum and required by the intent of the original contract documents. All Contractors shall acknowledge on their bid form that they have received this Addendum, Addendum One and Two, and include the appropriate content of same within their bid proposal.

SPECIFICATIONS

1. Specification Section 10 51 14

Ventilated Lockers

- A. Replace Specification Section 10 51 14, Ventilated Lockers, with Specification Section 10 51 14 included in this Addendum.

DRAWINGS

2. Sheet G-201 & G-202

- A. Refer to revised full-size drawing, included in this Addendum for the addition of the Code Summary.

3. Sheet C-1.1

- A. Refer to revised full-size drawing, included in this Addendum for the following revisions.
 - 1. The legend for demolition notes was modified removing the text for the concrete stairs, entranceway, and flagpole.
 - 2. Some additional sidewalk was added to be demolished at the northern entrance.
 - 3. The demolition of the stairs and entranceway was removed from the scope of work.
 - 4. The flagpole removal was removed from scope of work.

4. Sheet C-2.0

- A. Refer to revised full-size drawing, included in this Addendum for the following revisions.
 - 1. Additional sidewalk at the north entrance was added.
 - 2. New flagpole was removed from the scope of work.

5. Sheet C-3.0

- A. Refer to revised full-size drawing, included in this Addendum for the addition of proposed elevations for the new sidewalk.

6. Sheet C-4.0

- A. Refer to revised full-size drawing, included in this Addendum for the revision to the

handicap ramp details.

7. Sheet C-5.0

- A. Refer to revised full-size drawing, included in this Addendum for the addition of silt fencing around the new sidewalk.

8. Sheet S-100

- A. Refer to revised full-size drawing, included in this Addendum for the following revisions.
 - 1. Lintels added for new mechanical ducts.
 - 2. Lintels added at exterior walls for new VUV louvers.

9. Sheet S-101

- A. Refer to new full-size drawing, included in this Addendum for Lintels added at exterior walls for new VUV louvers.

10. Sheet S-102

- A. Refer to revised full-size drawing, included in this Addendum for the following revisions.
 - 1. Sheet number revised (originally S-101).
 - 2. The top of steel elevation for new beams adjusted.
 - 3. Foundation plan note revised as shown.
 - 4. Keynote 4 was added to the framing plan.

11. Sheet S-103

- A. Refer to new full-size drawing, included in this Addendum for mechanical yard wall and typical details.

12. Sheet S-401

- A. Refer to revised full-size drawing, included in this Addendum for the following revisions.
 - 1. Block changed to 8" on sections 1 and 2.
 - 2. The top of steel elevation adjusted on details 9 and 13.
 - 3. Truss heel height noted to be field verified in order to match existing conditions on section 13.
 - 4. New details 14 and 15 added.

13. Sheet AD-110

- 1. Refer to revised full-size drawing, included in this Addendum for the addition of note 16 in the showers in both locker rooms.

14. Sheet A-101

- A. Refer to revised full-size drawing, included in this Addendum for the following revisions.
 - 1. Add note to epoxy inject cracks in the concrete stoop and foundation at and around the north entrance.
 - 2. Revise note 10 to call out louver size.

15. Sheet A-102

- A. Refer to revised full-size drawing, included in this Addendum for the following revisions.
 - 1. Add note 25 to epoxy inject cracks in the concrete stoop and foundation at and around the north entrance.

2. Add note 26 to cap existing mechanical opening in ceiling of the cafeteria.

16. Sheet A-103

- A. Refer to revised full-size drawing, included in this Addendum for the revision of note 10 to call out louver size.

17. Sheet A-110

- A. Refer to revised full-size drawing, included in this Addendum for the addition of note 22 in the showers of both locker rooms.

18. Sheet A-201

- A. Refer to revised full-size drawing, included in this Addendum for the addition of note 6 for the mechanical unit over the cafeteria that is being demoed.

19. Sheet A-301

- A. Refer to revised full-size drawing, included in this Addendum for the location of the relocated Aluminum Letters.

20. Sheet M-102 & M-103

- A. Refer to revised full-size drawing, included in this Addendum for the following revisions.
 1. Remove louver LV-1 and LV-2 tag from self-contained units.
 2. Revise Sheet Note 5.

21. Sheet M-200

- A. Refer to revised full-size drawing, included in this Addendum for the removal of the Louver Schedule.

22. Sheet M-201

- A. Refer to revised full-size drawing, included in this Addendum for revisions to the Unit Ventilator sections.

23. Sheet P-110

- A. Refer to revised full-size drawing, included in this Addendum for revisions to the shower fixture.

Pages 1 through 3, inclusive, Specification Sections 10 51 14 and twenty-four (24) Full-Size Drawings, constitute the total makeup of **Addendum Three**.

SECTION 10 51 14

VENTILATED LOCKERS

1 General

1.1 Section Includes

- A. Ventilated locker units with hinged doors.
- B. Trim and accessories.
- C. Hooks, latches, and hardware.
- D. Attachment hardware.

1.2 Related Sections

- A. Section 03 30 00 - Concrete: Concrete bases.
- B. Section 04 20 00 - Unit Masonry: Masonry for bases.
- C. Section 06 10 00 – Rough Carpentry: Wood grounds and nailing strips.
- D. Section 08 71 00 - Door Hardware: Padlocks.
- E. Section 10 51 13 - Metal Lockers.

1.3 System Description

- A. Lockers Type A: All welded construction; 12-inch x 12-inch x 60-inch single-tier lockers; on concrete bench; with metal base; with sloped tops; recessed combination locks; padlock hasps; end closures; end panels; corner units; fillers; trim molds.
- B. Lockers Type A: All welded construction; 24-inch x 18-inch x 60-inch single-tier lockers; on concrete bench; with metal base; with sloped tops; recessed combination locks; padlock hasps; end closures; end panels; corner units; fillers; trim molds.
- C. Ship all units set-up with no nuts and bolts or hazardous projections used in assembly.
 - 1. Knock down units are not acceptable.

1.4 Submittals

- A. Submit shop drawings under provisions of Division 1.
 - 1. Include locker types, sizes, configurations, layout of groups of lockers, accessories, and numbering plan.

- B. Submit product data under provisions of Division 1.
- C. Submit samples for color selections under provisions of Division 1.

1.5 Protection

- A. Store and protect lockers under provisions of Division 1.
- B. Protect locker finishes and adjacent surfaces from damage during installation.

2 Products

2.1 Ventilated Lockers - Acceptable Manufacturers

- A. Lyon Workspace Products, Aurora, Illinois.
- B. No substitutions will be accepted.

2.2 Materials

- A. Sheet Steel: Prime grade, free from scale and imperfections; of the following minimum thicknesses.
 - 1. Body: 16-gauge steel, flanged to give double thickness of metal at back vertical corners. 18-gauge backs.
 - 2. Door Frame: 16-gauge formed steel channels. Vertical members shall have an additional flange to form continuous door strike. Corners shall be lapped and welded into a rigid assembly. In addition, bottom cross members shall have tang at each end that fits through slot in rear flange of upright frame member to prevent twisting out of alignment. Top and bottom cross members shall provide support for front edge of locker top and locker bottom.
 - 3. Doors: One-piece, 14-gauge steel on single, double and triple tier with both vertical edges formed into channel-shaped formation; top and bottom shall be flanged at 90 degree angle. On multiple tier lockers, hinge side shall be formed into channel shaped formation with other three sides flanged at 90 degree angle.
 - 4. Door Jambs: 48" and higher single tier lockers shall have three door jambs; double tier and triple tier lockers shall have two jambs welded to side of door frames to engage locking device. Design and gauge of jamb shall prevent freeing of locking device by prying. Each jamb shall have easily replaceable soft rubber bumper.
 - 5. Hinges: Shall be not less than 2" high, .050" steel, 5 knuckle, full loop design forming double thickness on each leaf. Hinges to be set in slot in door and frame and projection welded to frame and securely attached to door. Hinge pin to be spun over at ends to resist removal. Single-tier lockers 48", 60" and 72" high to have three hinges. All other tiers to have two hinges – all on right hand side of door. Optional continuous hinge available.

6. Bottoms: Solid, 16 gage.
7. Tops and Horizontal Dividers: Solid, 16 gage.
8. Shelves: Single tier lockers shall have one 16-gauge shelf approximately 9" below top. Flanged on all four sides for strength with the front flange turned 45 degrees for safety and attached at no less than two points through each side flange. Only single tier lockers 48" and taller have shelves.
9. Quiet Locking Devices: Single tier locking device shall engage frame at three points; double tier and triple tier at two points. Channel shaped locking device with full length reinforcing ribs shall be a quiet design utilizing nylon guide inserts to reduce metal to metal contact. The locking device shall include a latch finger that engages the 12-gauge door jamb. Lock bar shall be enclosed on three sides and operate within the channel formation of the door. Locking device shall be prelocking so mechanism can be locked in open position – door locking automatically when closed. An optional single point latch shall be available except on 9" wide lockers. Box locker shall have one-point locking device with a 14-gauge lock clip for attaching padlock. Doors also to be provided with lock hole filler to permit use of built in lock.
10. Sloping Tops: Solid, 20 gage.
11. Metal Zee Base: 14 gage front Zee base, with rear legs, cross bracing, and end plates, 4 inches high.

2.3 Accessories

- A. Hooks: Single tier, double tier and triple tier lockers shall have one double prong hook and three single prong wall hooks. All hooks to be zinc-plated or subjected to a comparable rust retardant treatment and attached with two nuts and bolts.steel.
- B. Number Plate: Polished aluminum, 2 1/4 inches wide by 1 inch high, 3/8 inch black etched numerals; attach with rivets.
- C. Rubber Bumpers: Provide rubber silencers on door jambs.
- D. Locking Device/Handles: On single, double and triple tier lockers, handles shall be stainless steel recessed. No moving parts are to operate against outside surface of locker. Padlock attachment to be integral part of lift which shall be attached directly to locking bar and protected by fixed handle housing. Handle to provide built in padlock strike. The recessed handle shall be 4-1/8"w x 6-1/16"h x 1-1/4"d. Multiple tier lockers shall be equipped with a 16-gauge door pull with padlock attachment when not used with built in locks.
 1. Padlock Hasps: Provide all lockers with padlock hasps.
 - a. Padlocks will be provided by the Owner.

2.4 Fabrication

- A. General: Weld all seams and joints, grind exposed joints smooth.
- B. Size: Refer to Drawings.
- C. Hinges: Three per door for doors 48 inches and higher or continuous hinges.
 - 1. Weld or rivet securely to unit body and weld to unit door.
- D. Provide end panels, sloped metal tops, corner units, metal bases, and filler panels to close off all openings.
- E. Finish edges smooth without burrs.
- F. A. D. A. Compliant Lockers:
 - 1. Single tier locker.
 - 2. Provide recessed handles.
 - 3. Locate locker bottom a minimum of 9 inches off the locker base, or place an extra shelf 9 inches off the locker base.
 - 4. Provide single tier lockers with a shelf 48 inches off the floor.
 - 5. Provide doors assigned for handicapped use with an appropriate symbol sign.

2.5 Finishes

- A. Clean and phosphate treat metal; electrostatically spray with one coat of epoxy based paint and bake to a glossy finish.
- B. Locker doors and bodies may be required to be different colors.
- C. Colors: **Red Velvet.**

3 Execution

3.1 Preparation

- A. Verify bases are properly sized and located.
- B. Obtain job dimensions and coordinate sizes.
- C. Verify quantities of lockers required.

3.2 Installation

- A. Install lockers secure, plumb, square, and in line.
 - 1. Set on prepared base provided.
- B. Anchor lockers with appropriate anchor devices to suit materials encountered.

- C. Install end panels, filler panels, sloped tops, bases, corner units, and trim to completely close off openings.


END OF SECTION

LIFE SAFETY GENERAL NOTE:

LIFE SAFETY INFORMATION IS PROVIDED FOR USE BY ALL CONTRACTORS. CONTRACTORS ARE RESPONSIBLE FOR COMPLYING WITH CODE REQUIREMENTS (INCLUDING BUT NOT LIMITED TO: RATED ASSEMBLIES, FIRE PROTECTION, FIRESTOPPING, DAMPERS, AND HARDWARE) INDICATED INCLUDING CONDITIONS WHERE THESE REQUIREMENTS ARE NOT DETAILED. REPORT CONFLICTS OR DISCREPANCIES TO THE ARCHITECT FOR RESOLUTION PRIOR TO STARTING WORK.

Applicable Code:	2014 Indiana Building Code (IBC 2012) General Administrative Rules, 2nd Edition GAR
Scope of Project:	<ul style="list-style-type: none"> New canopy at front entrance, new entry doors and creation of secure entry. 2 new staff toilet rooms. Window replacement. Replace horizontal unit ventilators with new VUV's and RTU for the Cafeteria. New accessible ramp at north end entrance. EIFS repair at front of building.
Applicability of Codes to the Project:	Alterations and additions are permitted to an existing building without requiring the entire building or portions of the existing building unaffected by the proposed scope of renovation to be brought into compliance with current codes. The scope of construction within the alteration and addition are required to comply with current codes. [Rule 4, Section 12(b), GAR]
Occupancy Classifications:	Educational use areas for elementary school students - E Occupancy [305.1] Assembly uses accessory to an E Occupancy are not considered separate occupancies [303.1.3] Administrative area - accessory occupancy - B Occupancy [304.1, 508.2]
Construction Type:	Type IIB Construction permitted based upon sprinkler protection throughout and 60 feet of surrounding open space - unlimited area. [507.3]
Incidental Use Separations:	None applicable to this project [Table 509]
Corridors:	No change to existing corridor construction
Automatic Sprinklers:	An automatic sprinkler system is existing throughout the building.
Fire Alarm System:	Fire alarm system is existing throughout the building.

AD-3

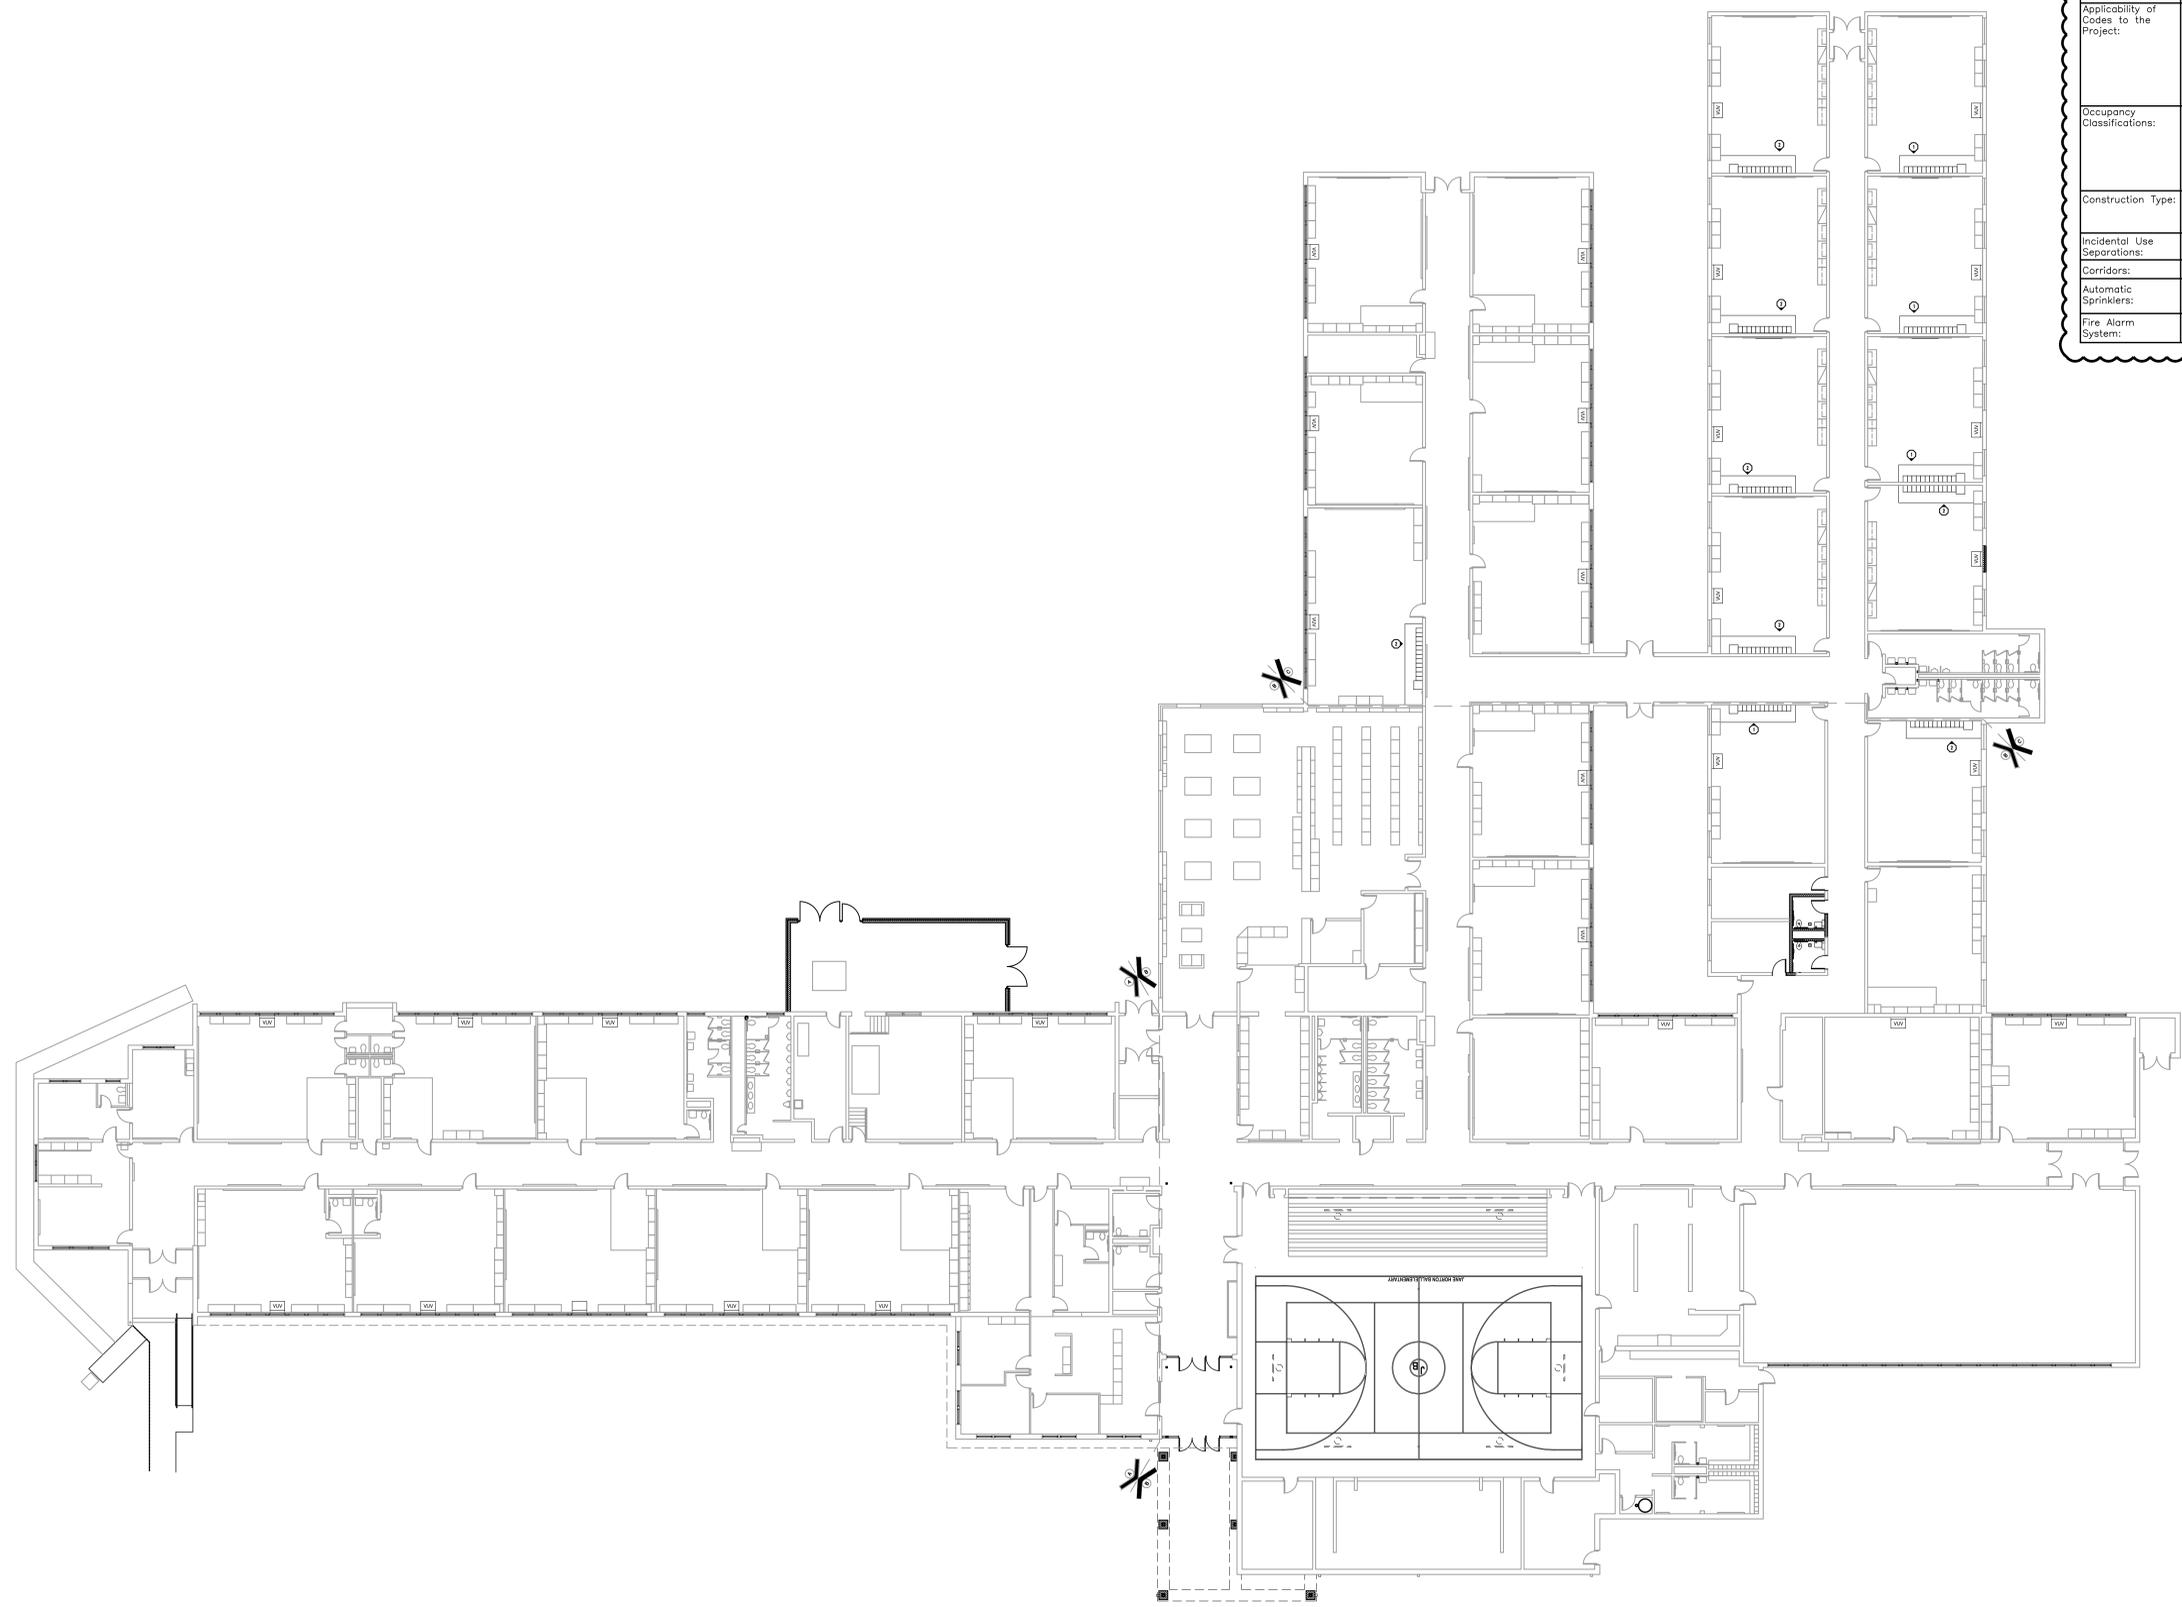


OVERALL FLOOR PLAN
SCALE: 1/16" = 1'-0"



GIBRALTAR DESIGN
ARCHITECTURE • ENGINEERING • INTERIOR DESIGN

PROJECT
HANOVER CSC - JANE BALL ES RENOVATIONS AND HS IMPROVEMENTS


HANOVER COMMUNITY SCHOOL CORPORATION
CEDAR LAKE, INDIANA

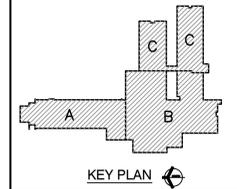

KEY PLAN

GIBRALTAR DESIGN
9102 N. Meridian St., Ste. 300
Indianapolis, IN 46260
Homepage: www.GibraltarDesign.com
Email: info@GibraltarDesign.com
Phone: 317.580.5777 Fax: 317.580.5778

PROJECT: 23-140
DATE: 10/13/23
COORDINATED BY: DTB
DRAWN BY: DTB
CHECKED BY: DTB DJW

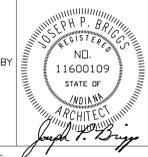

COPYRIGHT NOTICE:
THE CONCEPTS, DESIGNS, PLANS, DETAILS, ETC. SHOWN ON THIS DOCUMENT ARE THE PROPERTY OF GIBRALTAR DESIGN AND WERE CREATED FOR USE ON THIS SPECIFIC PROJECT. NONE OF THIS INFORMATION SHALL BE USED BY ANY PERSON OR FIRM FOR ANY PURPOSE WITHOUT THE EXPRESS WRITTEN CONSENT OF GIBRALTAR DESIGN. THE OWNER MAY RETAIN COPIES FOR INFORMATION AND REFERENCE IN CONNECTION ONLY WITH THIS PROJECT.

MARK	DATE	ISSUED FOR
AD-3	11/03/23	ADDENDUM NO.3

DRAWING
JANE BALL LIE SAFETY PLAN

PROJECT
HANOVER CSC - JANE BALL ES RENOVATIONS AND HS IMPROVEMENTS

GIBRALTAR DESIGN SHEET

JB G-201

Friday, 11/2/2023 11:16 PM - LAST SAVED BY: BURNS
Y:\23-140 HANOVER CSC - JANE BALL ELEMENTARY
SCHOOL RENOVATION\23-140 DRAWINGS\02
GEN\G-201.DWG


LIFE SAFETY GENERAL NOTE:
 LIFE SAFETY INFORMATION IS PROVIDED FOR USE BY ALL CONTRACTORS. CONTRACTORS ARE RESPONSIBLE FOR COMPLYING WITH CODE REQUIREMENTS (INCLUDING BUT NOT LIMITED TO: RATED ASSEMBLIES, FIRE PROTECTION, FIRESTOPPING, DAMPERS, AND HARDWARE) INDICATED INCLUDING CONDITIONS WHERE THESE REQUIREMENTS ARE NOT DETAILED. REPORT CONFLICTS OR DISCREPANCIES TO THE ARCHITECT FOR RESOLUTION PRIOR TO STARTING WORK.

Applicable Code:	2014 Indiana Building Code (IBC 2012) General Administrative Rules, 2nd Edition GAR 2014 Indiana Mechanical Code (IMC)
Scope of Project:	<ul style="list-style-type: none"> New canopy at front entrance, new entry doors and creation of secure entry. 2 new staff toilet rooms. Window replacement. Replace horizontal unit ventilators with new VUV's and RTU for the Cafeteria. New accessible ramp at north end entrance. EIFS repair at front of building.
Applicability of Codes to the Project:	Alterations and additions are permitted to an existing building without requiring the entire building or portions of the existing building unaffected by the proposed scope of renovation to be brought into compliance with current codes. The scope of construction within the alteration and addition are required to comply with current codes. [Rule 4, Section 12(b), GAR]
Occupancy Classifications:	Educational use areas for elementary school students - E Occupancy [305.1] Assembly uses accessory to an E Occupancy are not considered separate occupancies [303.1.3] Administrative area - accessory occupancy [304.1, 508.2] - B Occupancy
Construction Type:	Type IIB Construction existing.
Incidental Use Separations:	None applicable to this project [Table 509]
Corridors:	No change to existing corridor construction
Automatic Sprinklers:	An automatic sprinkler system is existing throughout the building.
Fire Alarm System:	Fire alarm system is existing throughout the building.
Smoke Detectors:	Smoke detectors are required for HVAC shutdown for systems delivering in excess of 2,000 cfm. [606.1 IMC]




GIBRALTAR DESIGN
 ARCHITECTURE • ENGINEERING • INTERIOR DESIGN

PROJECT
HANOVER CSC - JANE BALL ES RENOVATIONS AND HS IMPROVEMENTS
 HANOVER COMMUNITY SCHOOL CORPORATION
 CEDAR LAKE, INDIANA

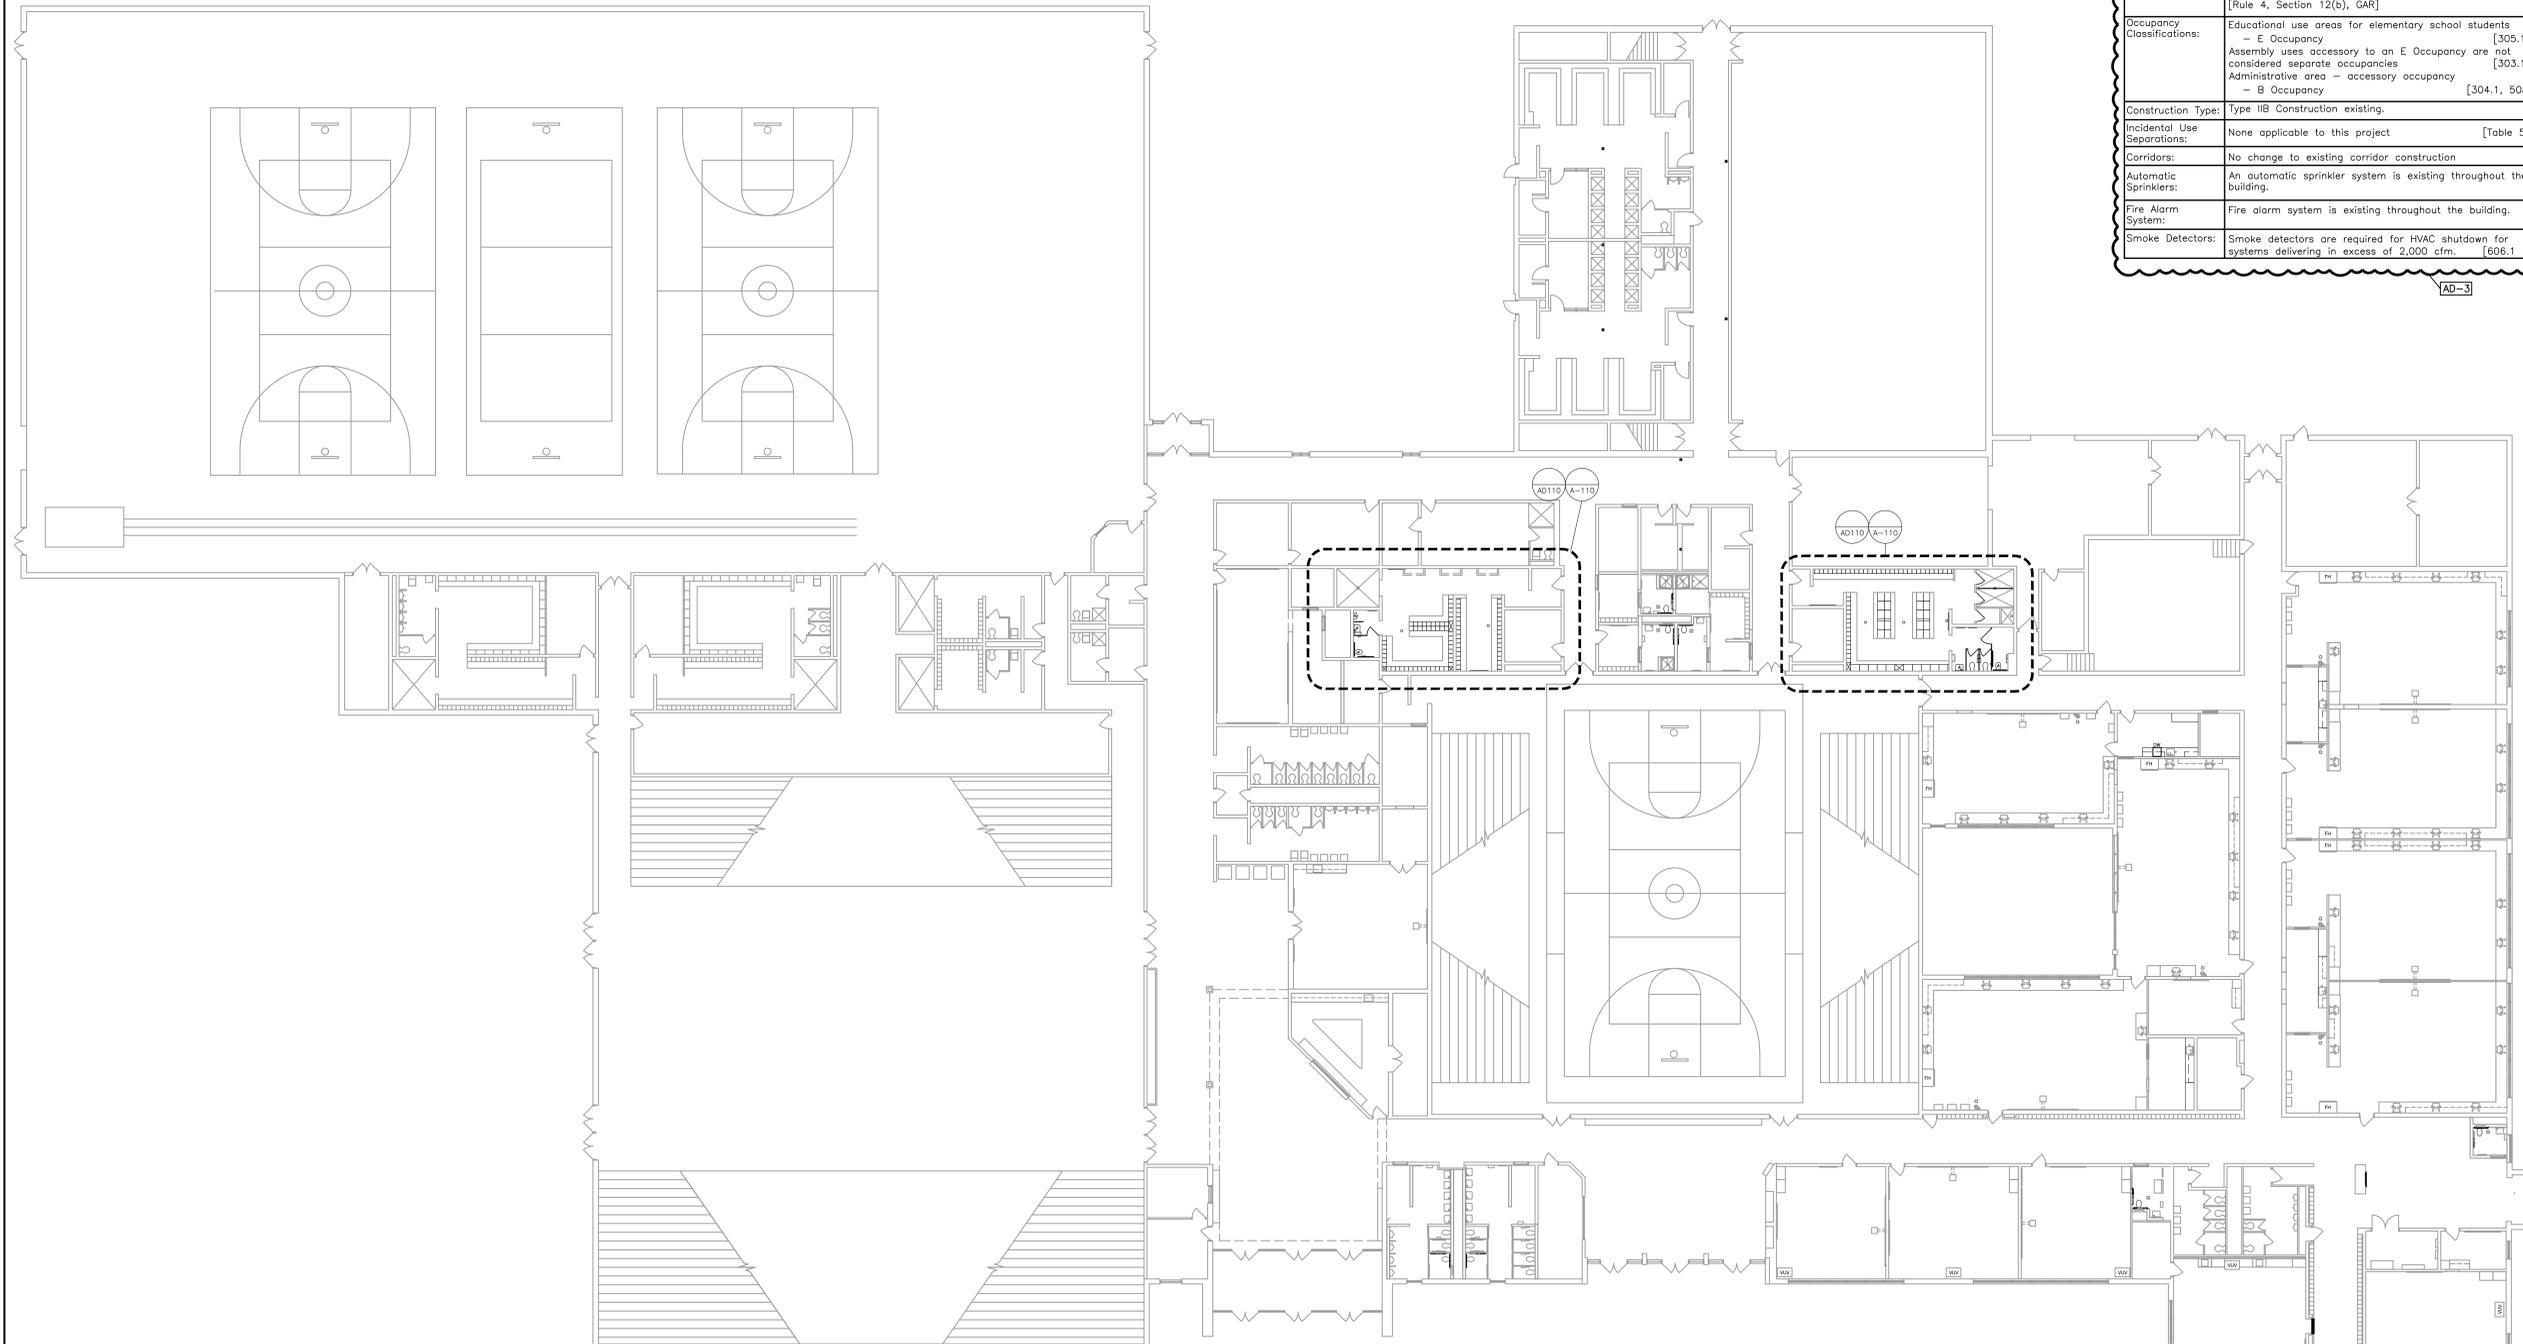

GIBRALTAR DESIGN
 9102 N. Meridian St., Ste. 300
 Indianapolis, IN 46260
 Homepage: www.GibraltarDesign.com
 Email: info@GibraltarDesign.com
 Phone: 317.580.5777 Fax: 317.580.5778

PROJECT: 23-140
 DATE: 10/13/23
 COORDINATED BY: DTB
 DRAWN BY: DTB
 CHECKED BY: DTB DJW

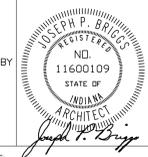

COPYRIGHT NOTICE:
 THE CONCEPTS, DESIGNS, PLANS, DETAILS, ETC. SHOWN ON THIS DOCUMENT ARE THE PROPERTY OF GIBRALTAR DESIGN AND WERE CREATED FOR USE ON THIS SPECIFIC PROJECT. NONE OF THIS INFORMATION SHALL BE USED BY ANY PERSON OR FIRM FOR ANY PURPOSE WITHOUT THE EXPRESS WRITTEN CONSENT OF GIBRALTAR DESIGN. THE OWNER MAY RETAIN COPIES FOR INFORMATION AND REFERENCE IN CONNECTION ONLY WITH THIS PROJECT.

REVISIONS	MARK	DATE	ISSUED FOR
	AD-3	11/03/23	ADDENDUM NO.3

DRAWING
HIGH SCHOOL LIFE SAFETY PLAN

PROJECT
HANOVER CSC - JANE BALL ES RENOVATIONS AND HS IMPROVEMENTS

© GIBRALTAR DESIGN SHEET



G-202

OVERALL ATHLETIC FLOOR PLAN
 SCALE: ViewportScale




Friday, 11/2/2023 - 9:10 AM - LAST SAVED BY: DBURNS
 Y:\23-143 HANOVER CSC - HIGH SCHOOL IMPROVEMENTS
 - LOCKER ROOMS\23-143 DRAWINGS\02
 GBR\G-201.DWG


Z:\2023-5049 Jane Ball\dwg\2023-5049 Jane Ball.dwg 10/16/2023 2:34:22 PM CDT

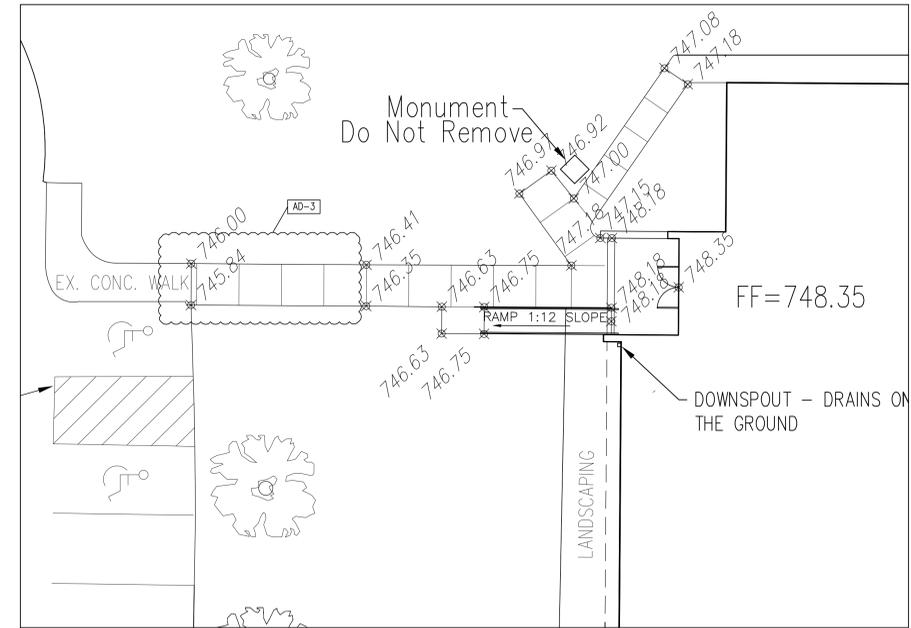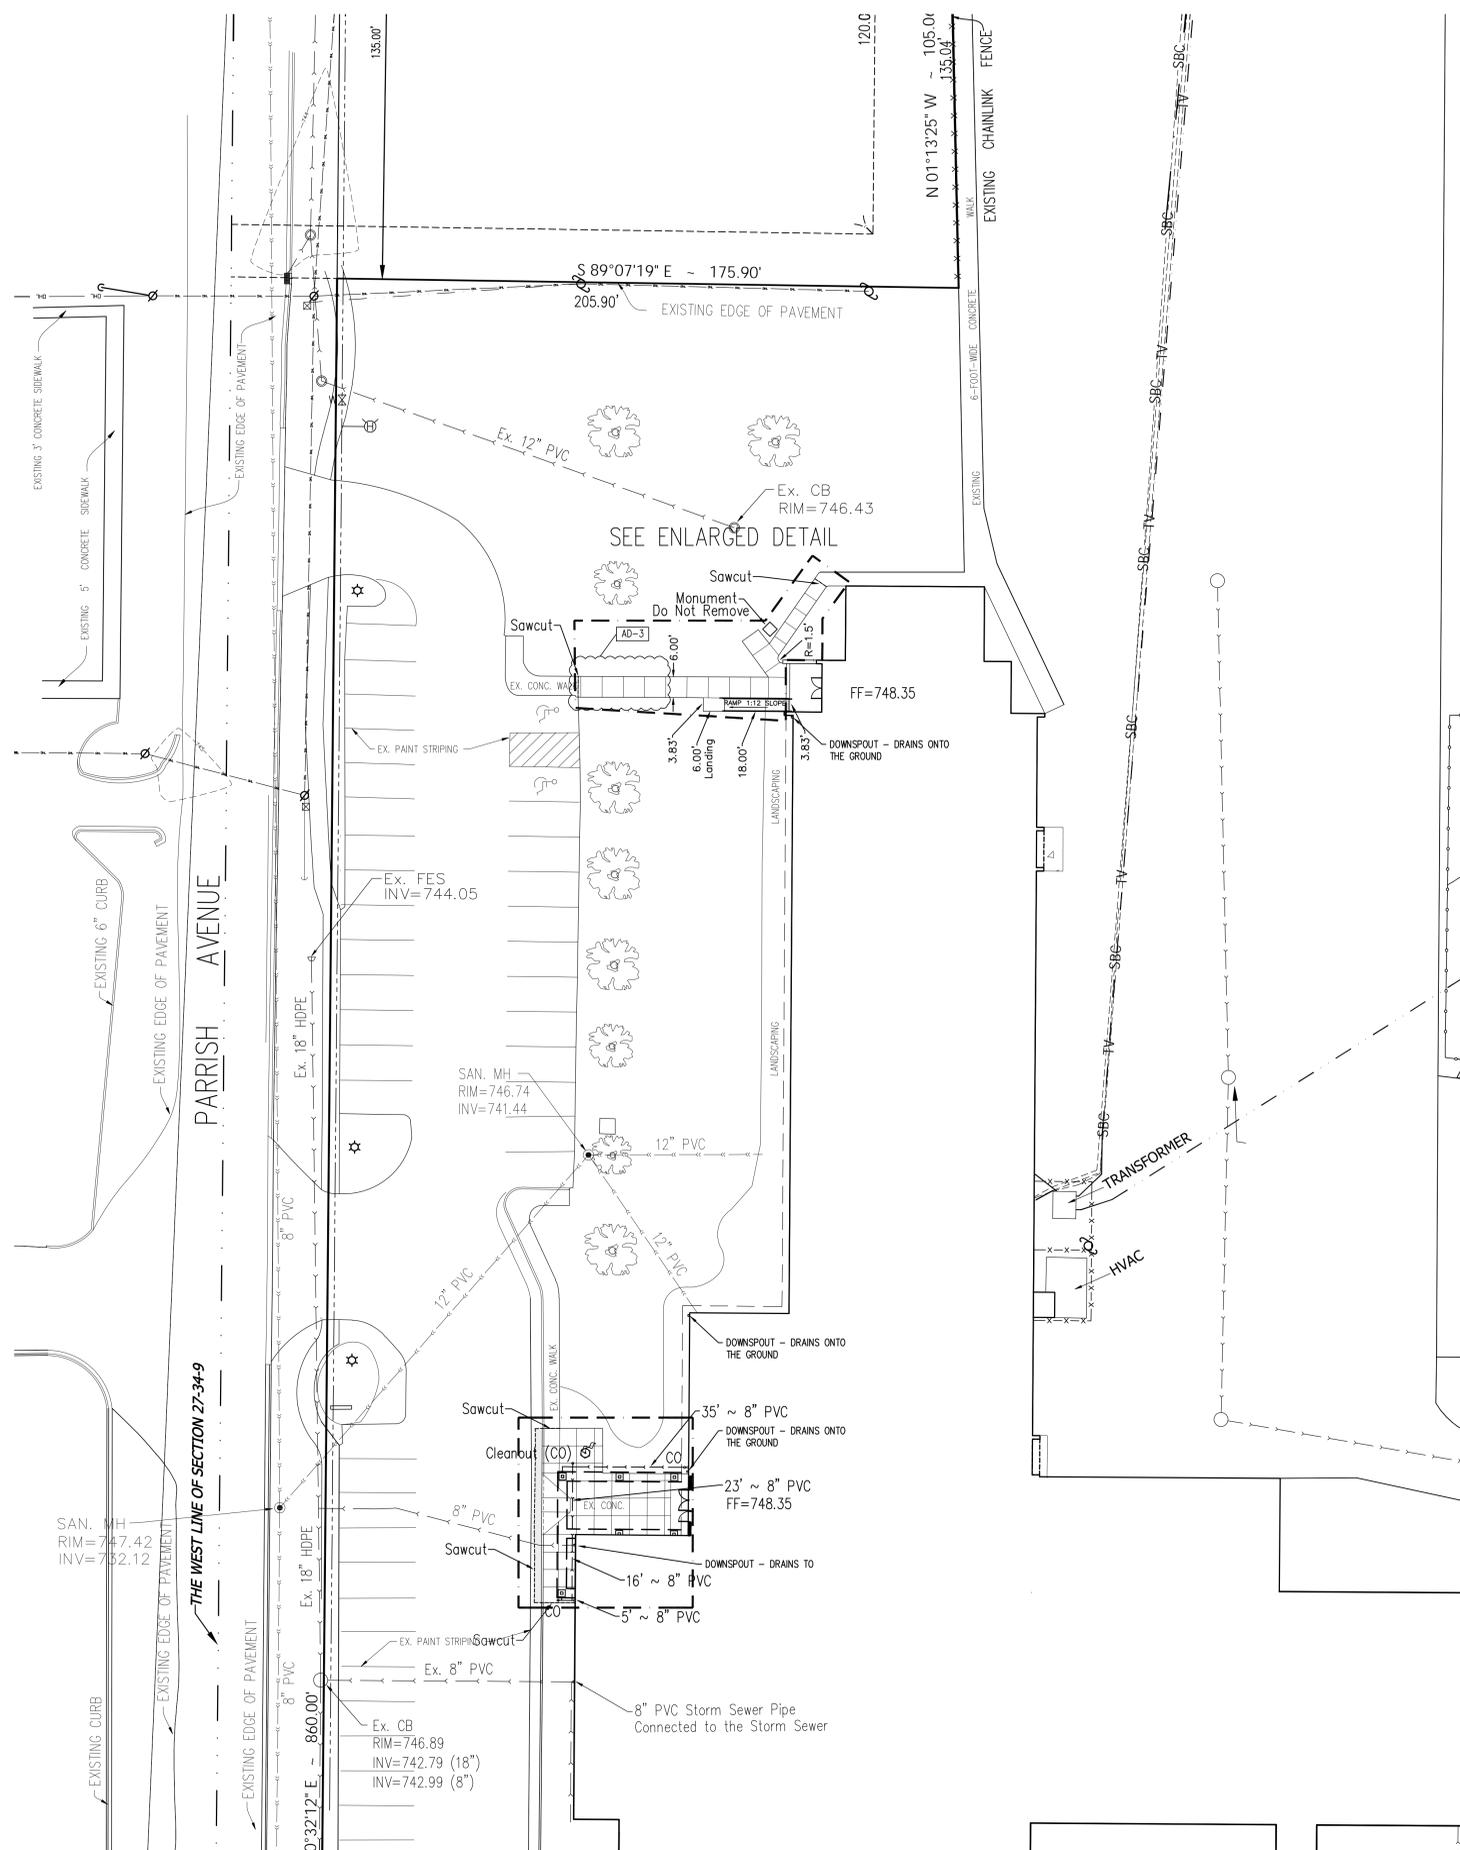

NORTHERN ENTRANCE
SCALE: 1"=40'

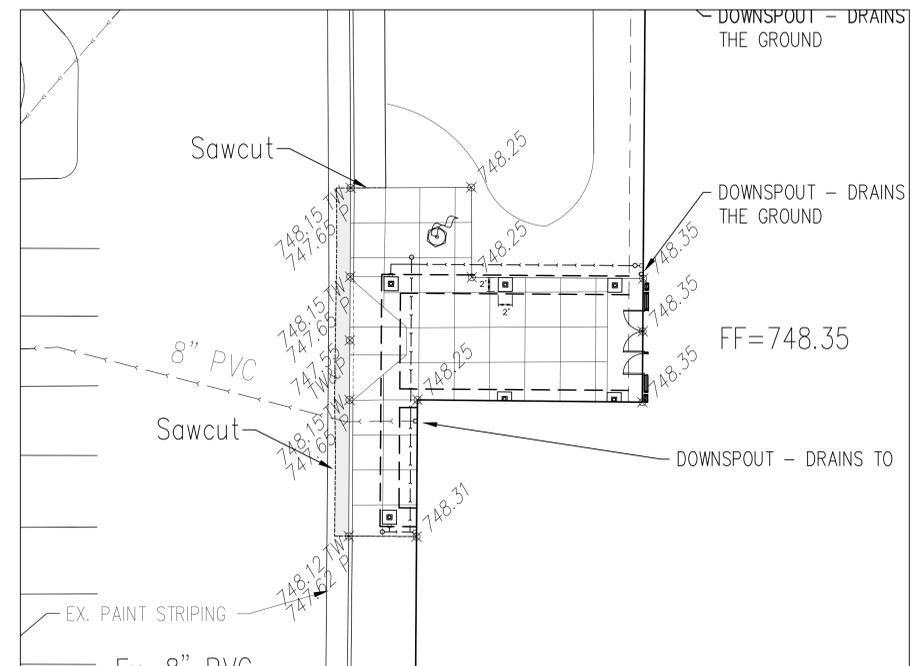

SOUTHERN ENTRANCE
SCALE: 1"=40'

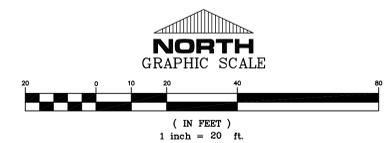

GIBRALTAR
DESIGN
ARCHITECTURE • ENGINEERING • INTERIOR DESIGN

PROJECT
HANOVER CSC - JANE BALL ES RENOVATIONS AND HS IMPROVEMENTS
HANOVER COMMUNITY SCHOOL CORPORATION
CEDAR LAKE, INDIANA

TORRENGA ENGINEERING, INC.
CONSULTING ENGINEERS & LAND SURVEYORS
907 RIDGE ROAD
MONTICELLO, IN 46231
T: (219) 836-8918
F: (219) 836-1136

GIBRALTAR DESIGN
9102 N. Meridian St., Ste. 300
Indianapolis, IN 46260
Homepage: www.GibraltarDesign.com
Email: info@GibraltarDesign.com
Phone: 317.580.5777 Fax: 317.580.5778

PROJECT: 23-140
DATE: 10/16/23
COORDINATED BY: DCT
DRAWN BY: DCT EM
CHECKED BY: DCT

COPYRIGHT NOTICE:
THE CONCEPTS, DESIGNS, PLANS, DETAILS, ETC., SHOWN ON THIS DOCUMENT ARE THE PROPERTY OF SUBMITTER DESIGN AND WERE CREATED FOR USE ON THIS SPECIFIC PROJECT. NONE OF THIS INFORMATION SHALL BE USED BY ANY PERSON OR FIRM FOR ANY PURPOSE WITHOUT THE EXPRESS WRITTEN CONSENT OF GIBRALTAR DESIGN. THE OWNER MAY RETAIN COPIES FOR INFORMATION AND REFERENCE IN CONNECTION ONLY WITH THIS PROJECT.

MARK	DATE	ISSUED FOR
AD-1	10/24/23	ADDENDUM NO. 1
AD-3	11/03/23	ADDENDUM NO. 3


DRAWING
GRADING PLAN

PROJECT
HANOVER CSC - JANE BALL ES RENOVATIONS AND HS IMPROVEMENTS


GIBRALTAR DESIGN SHEET
C-3.0

GENERAL SPECIFICATIONS FOR STORM SEWERS


- All work shall be performed in accordance with the Codes, Ordinances and Development Standards Manual of the Town of Cedar Lake and the 10 State Standards.
- All storm sewer pipe, branches and fittings shall conform to either of the following: (A) Polyvinyl Chloride Type PSM (ASTM D-3034), SDR 26 with push-on rubber gasket joints (ASTM D-3212) less than 15" or (B) Ductile Iron Pipe (AWWA C151), for pipe equal to or greater than 15 inch diameter, or (C) Reinforced concrete pipe (ASTM C-76) with bell and spigot or tongue and groove push-on majestic joints, Class IV reinforced concrete pipe. ADS N12 ST perforated and non-perforated plastic pipe shall be used for drain tile applications only. Installation shall conform with ASTM D-22321 recommended practices, for pipe equal to or greater than 15 inch diameter.
- All storm sewer manholes, catch basins, inlets and yard drains shall be standard precast concrete units (ASTM C-478) conforming to the standard detail sheet of these plans. Special Nyoplast Inline Catch Basins shall be used to drain the soccer field.
- All improvements installed across paved or future paved areas shall be backfilled with graded stone aggregate to the subgrade line. Compaction shall be done in 12" maximum depth lifts to 95% maximum dry density.
- Care shall be taken in parkway areas to assure compaction acceptable for the future stability of driveways and sidewalks. While special backfill material is not required, it shall be the responsibility of the Contractor to protect against potential future settlement of backfilled areas.
- Pipe Grade shall be held within +/- 0.1 feet between manholes and the deviation per pipe length shall not exceed 0.2 foot between manholes.
- All sewers shall be laid at least 10 feet (3.0m) horizontally from any existing or proposed water main. The distance shall be measured edge to edge. All sewers crossing water mains shall be laid to provide a minimum vertical distance of 18 inches (46 cm) between the outside of the water main and the outside of the sewer. This shall be the case where the water main is either above or below the sewer. The crossing shall be arranged so that the sewer joints will be equidistant and as far as possible from the water main joints. Where a water main crosses under a sewer, adequate structural support shall be provided for the sewer to prevent damage to the water main. When it is impossible to obtain proper 10' horizontal and 18" vertical separation as stipulated above, the sewer shall be designed and constructed equal to water main pipe, a full length sewer pipe will be centered on the water main it is crossing.
- Prior to release of any portion of the performance bond and after completion of all public improvements, the Owner shall make, or cause to be made, "As-Built" construction drawing showing the actual location, size, and lengths of all street improvements, sanitary and storm sewer improvements, water main improvements including valves, stubs and lateral and water services, and any other permanent improvements that the subdivider installs. The "As-Built" construction drawing shall be coordinated with sanitary and storm sewer video to ensure that lateral locations are properly located on the drawing. The "As-Built" construction drawing shall include as-built elevations at lot corners, breakpoints, low points, and building pad locations at the same location as shown on the approved grading plan. The "As-Built" construction drawing shall also be based on daily field drawings and no attempt shall be made to reconstruct locations after the fact. The "As-Built" construction drawing shall include as-built inverts, coordinates and rim elevations for all manholes, pipes, valves, and outlet structures. This "As-Built" construction drawing shall bear the signature and seal of a civil engineer registered in the State of Indiana and shall be submitted in three copies to the Administrator on reproducible materials. The as-built drawings shall also be submitted to the Administrator on electronic media in the latest AutoCAD release format. All data shall be provided in the Indiana State Plan Coordinate system.
- Provide an electrically continuous type TW insulated #10 tracer wire. The wire shall be installed along the pipe, fastened to the pipe at twenty foot (20') intervals and terminated above ground with the lead taped around each structure.
- Deflection test in accordance to ASTM D-3033 Standard shall be performed on all flexible pipe materials placed. The contractor shall be responsible for supplying testing materials and apparatuses. The tests shall be conducted after the final backfill has been in place at least 30 days. No pipe shall exceed a deflection of 5%. The deflection test is to be run using a rigid ball or mandrel, it shall have a diameter equal to 95% of the inside diameter of the pipe. The test shall be performed without mechanical pulling devices. Town of Cedar Lake shall be notified when the system (or portion thereof) is ready for testing.

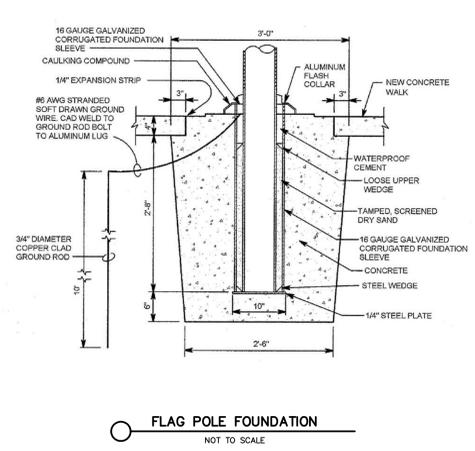


FLAG POLE FOUNDATION
NOT TO SCALE

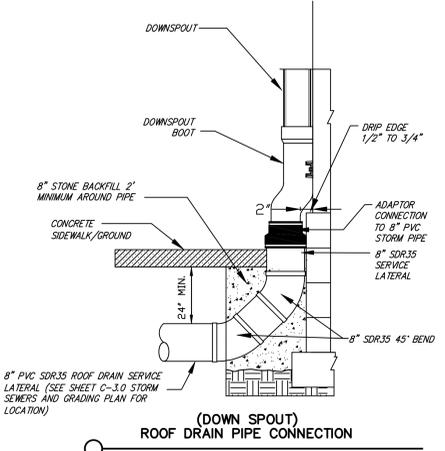


(DOWN SPOUT) ROOF DRAIN PIPE CONNECTION
NOT TO SCALE

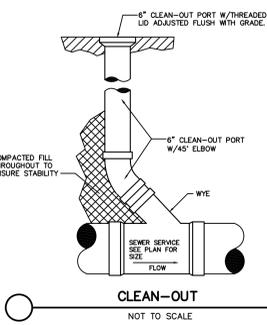


CLEAN-OUT
NOT TO SCALE

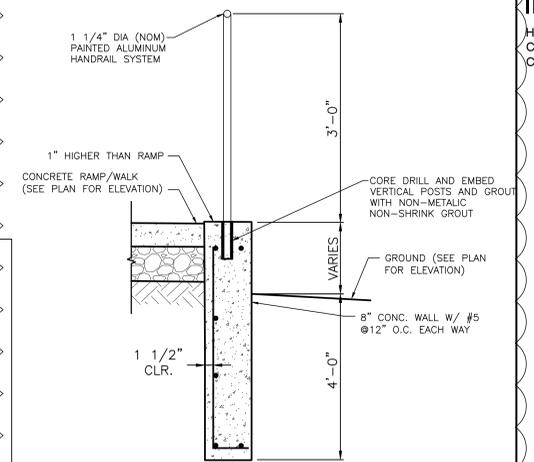


RAMP/CONCRETE RETAINING WALL AND HAND RAILING DETAIL
NOT TO SCALE

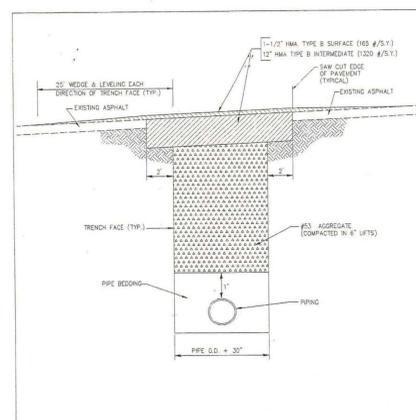


CEDAR LAKE DEVELOPMENT STANDARDS MANUAL
PAVEMENT DETAILS
ASPHALT PAVEMENT REPAIR
SCALE: NONE DATE: APRIL 2007 DWG. NO. ST-7

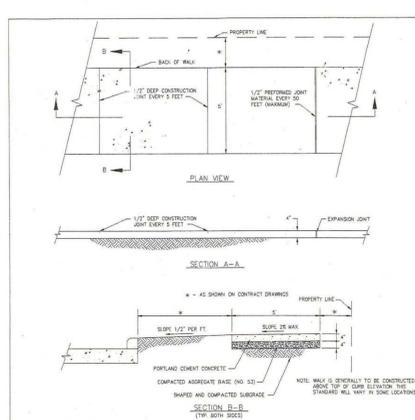

CEDAR LAKE DEVELOPMENT STANDARDS MANUAL
CURB, SIDEWALK & RAMP DETAILS
CONCRETE SIDEWALK
SCALE: NONE DATE: APRIL 2007 DWG. NO. CS-7

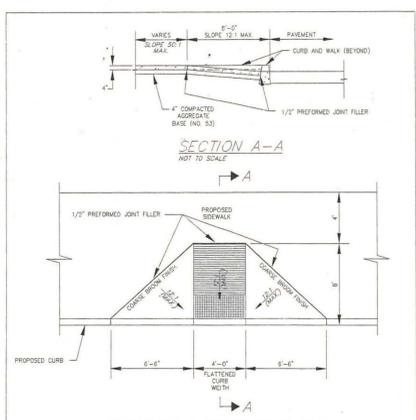

CEDAR LAKE DEVELOPMENT STANDARDS MANUAL
CURB, SIDEWALK & RAMP DETAILS
CURB RAMP, TYPE "A"
SCALE: NONE DATE: APRIL 2007 DWG. NO. CS-8

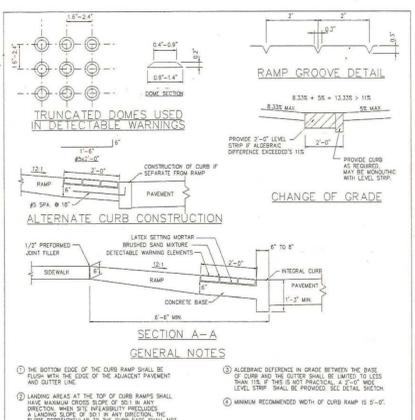


CEDAR LAKE DEVELOPMENT STANDARDS MANUAL
CURB, SIDEWALK & RAMP DETAILS
CURB RAMP DETAILS
SCALE: NONE DATE: APRIL 2007 DWG. NO. CS-14

SCALE: NONE	DATE: APRIL 2007	DWG. NO. ST-7
-------------	------------------	---------------

SCALE: NONE	DATE: APRIL 2007	DWG. NO. CS-7
-------------	------------------	---------------


SCALE: NONE	DATE: APRIL 2007	DWG. NO. CS-8
-------------	------------------	---------------

SCALE: NONE	DATE: APRIL 2007	DWG. NO. CS-14
-------------	------------------	----------------

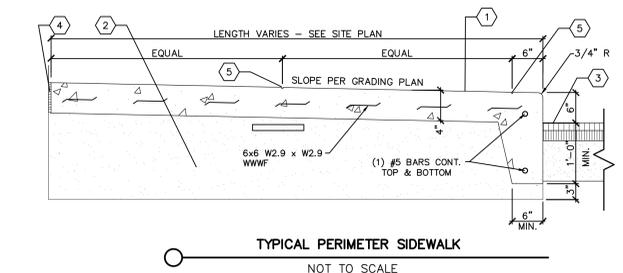


TYPICAL PERIMETER SIDEWALK
NOT TO SCALE

- KEYED NOTES
- 4" THICK CONC. BROOM FINISH WITH 6X6 W2.9XW2.9 WWF
 - 6" COMPACTED GRANULAR FILL
 - PROPOSED PAVEMENT
 - COMPRESSIBLE FILLER (3/4" MAXIMUM). CUT BACK AND PROVIDE SEALANT, TYPICAL AT ALL JOINTS WITH FILLER. (BUTTING BUILDING ONLY)
 - 1/4" TOOLED JOINT (SEE TYPICAL SIDEWALK DETAIL)

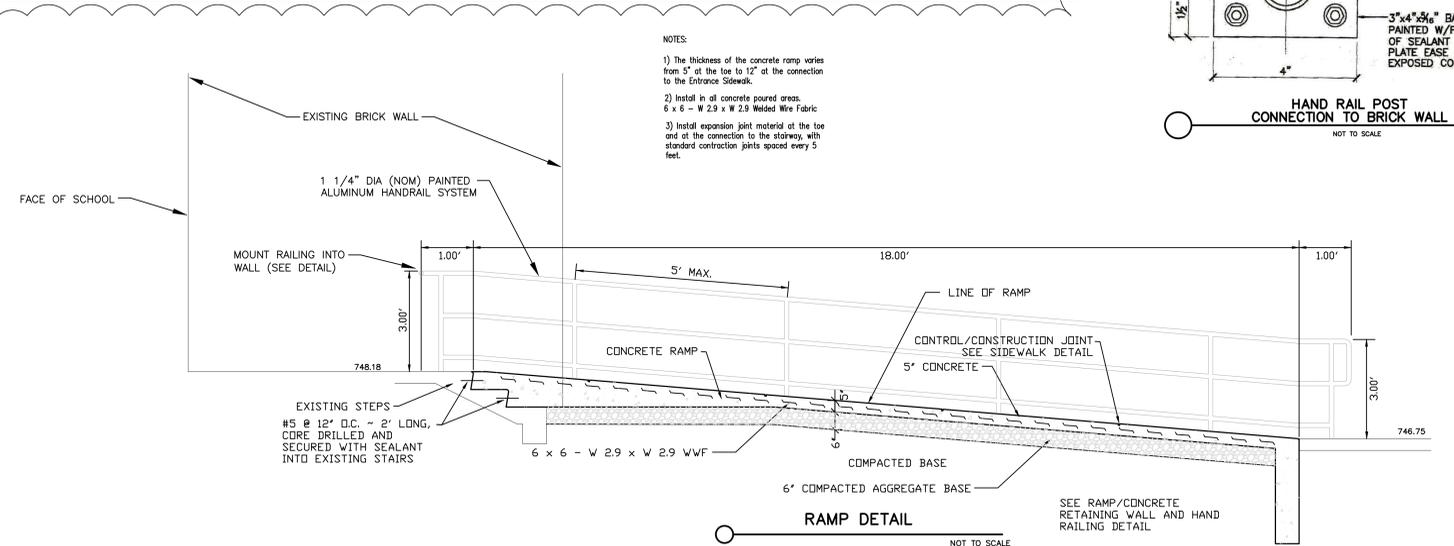

RAMP DETAIL
NOT TO SCALE

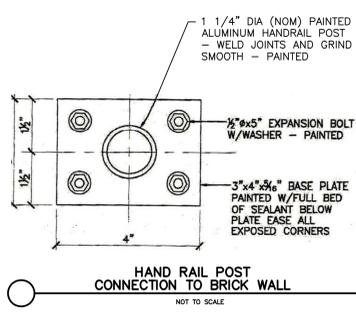

HAND RAIL POST CONNECTION TO BRICK WALL
NOT TO SCALE



GIBRALTAR DESIGN
ARCHITECTURE • ENGINEERING • INTERIOR DESIGN

PROJECT
HANOVER CSC - JANE BALL ES RENOVATIONS AND HS IMPROVEMENTS
HANOVER COMMUNITY SCHOOL CORPORATION
CEDAR LAKE, INDIANA

TORRENGA ENGINEERING, INC.
CONSULTING ENGINEERS & LAND SURVEYORS
807 RIDGE ROAD
MANTON, IN 46321
T: (219) 836-8918
F: (219) 836-1136

GIBRALTAR DESIGN
9102 N. Meridian St., Ste. 300
Indianapolis, IN 46260
Homepage: www.GibraltarDesign.com
Email: info@GibraltarDesign.com
Phone: 317.580.5777 Fax: 317.580.5778

PROJECT: 23-140
DATE: 10/16/23
COORDINATED BY: DCT
DRAWN BY: DCT EM
CHECKED BY: DCT

REVISIONS

MARK	DATE	ISSUED FOR
AD-1	10/24/23	ADDENDUM NO. 1
AD-3	11/3/23	ADDENDUM NO. 3

DRAWING
DETAILS & SPECIFICATIONS

PROJECT
HANOVER CSC - JANE BALL ES RENOVATIONS AND HS IMPROVEMENTS

GIBRALTAR DESIGN SHEET
C-4.0

Z:\2023-5049 - Jane Ball\dwg\2023-5049 - Details.dwg 10/30/2023 11:01:33 AM CDT

- ### FRAMING PLAN KEYED NOTES
- MONO-SLOPE PREFABRICATED COLD-FORMED TRUSSES AT 5'-0" o.c. MAX.
 - GABLE SHAPED PREFABRICATED COLD-FORMED TRUSSES AT 5'-0" o.c. MAX.
 - CANTILEVER BEAM OVER COLUMN TO CARRY LAST MONO-SLOPE TRUSS. COORD. REQUIRED LENGTH WITH COLD-FORMED TRUSS SUPPLIER.
 - PROVIDE COLD-FORMED VALLEY TRUSSES AT 4'-0" o.c. MAX. AS OVERBUILD ON EXISTING ROOF. DEMOLISH EXISTING ROOFING AND INSULATION AS REQUIRED IN ORDER TO FASTEN NEW TRUSSES DIRECTLY TO EXISTING ROOF DECK. PATCH AND REPAIR AS REQUIRED.

- ### FRAMING PLAN NOTES
- REF. S001 FOR STRUCTURAL NOTES, DESIGN DATA, SCHEDULES & LEGENDS.
 - ALL CONTRACTORS ARE REQUIRED TO COORDINATE THEIR WORK WITH ALL DISCIPLINES TO AVOID CONFLICTS. THE MECHANICAL, ELECTRICAL, AND PLUMBING ASPECTS ARE NOT IN THE SCOPE OF THESE DRAWINGS. THEREFORE, ALL REQUIRED MATERIALS AND WORK MAY NOT BE INDICATED.
 - ALL ELEVATIONS ARE REFERENCED FROM THE FIRST FLOOR FIN. FLOOR ELEVATION +0'-0". COORD. USGS ELEVATION WITH CIVIL DWGS.
 - SEE FOUNDATION PLANS FOR SIZES OF STEEL COLUMNS SUPPORTED ON FOUNDATIONS.
 - ALL WALLS SHALL BE LAD OUT FROM THE ARCHITECTURAL DRAWINGS.
 - REF. ARCH. DRAWINGS FOR ALL DIMENSIONS NOT SHOWN. CONTRACTOR SHALL VERIFY ALL DIMENSIONS PRIOR TO CONSTRUCTION AND IMMEDIATELY NOTIFY ARCHITECT/ENGINEER OF ANY DISCREPANCIES.
 - COORDINATE EXACT SIZE & LOCATION OF ANY MECHANICAL OPENINGS ROOF DECK WITH THE MEP CONTRACTOR(S). LOCATION & SIZE OF ALL DUCT OPENINGS, GRILLES, ETC. SHALL BE VERIFIED PRIOR TO CONSTRUCTION.
 - ALL ELEVATIONS SHOWN ON PLAN INDICATE TOP OF STEEL BEAM UNLESS NOTED OTHERWISE.
 - PROVIDE FRAMES AT ALL ROOF DRAINS, ROOF HATCHES & OTHER ROOF OPENINGS PER TYPICAL DETAILS ON S401. COORD. EXACT NUMBER, LOCATIONS & DIMENSIONS WITH THE APPROPRIATE CONTRACTORS & THE ARCH. & MEP DWGS.
- PLAN LEGEND:**
- F.F. DENOTES FIN. FLOOR
 TFX DENOTES TOP OF STEEL SLAB, ETC.
 (R1.5) DENOTES 1 1/2" 20 GA. GALV. & PRIME-PAINTED WIDE RIB STEEL ROOF DECK.

CONCRETE PIER SCHEDULE

PIER MARK	PIER SIZE	PIER REINFORCING			DETAIL	CRITICAL HEIGHT
		VERTICALS	TIES-SIZE & SPA ¹	REINFORCING		
P24	2'-0" x 2'-0"	(8) #8	#4 @ 4" o.c.	A	> 2'-0"	

NOTES:

- PROVIDE MIN. 1" CLEAR TO PIER TIES.
- CRITICAL HEIGHT DENOTES THE HEIGHT ABOVE WHICH LARGER DIAMETER VERTICALS WITH FEWER TIES MAY BE USED. REF. FOUNDATION PLAN(S) FOR TOP OF PIER & FOOTING ELEV.
- REF. TYPICAL CONCRETE PIER REINFORCING ON FOUNDATION DETAIL SHEET FOR FURTHER INFORMATION ON THE SPACING.
- VERTICAL DOWELS ARE TO FUNCTION AS PIER VERTICALS FOR PIERS LESS THAN OR EQUAL TO 5'-0" HIGH. PROVIDE SEPARATE DOWELS & VERTICALS FOR PIERS GREATER THAN OR EQUAL TO 5'-0" HIGH, UNLESS APPROVED.
- CONTACT THE STRUCTURAL ENGINEER FOR DIRECTION IF COLUMN ANCHOR RODS FOUL WITH PIER TIES OR VERTICALS.

DETAIL "A" (1) SET
DETAIL "B" (3) SETS


COLUMN FOOTING SCHEDULE

FOOTING MARK	LENGTH	WIDTH	DEPTH	REINFORCING EACH WAY	
				VERTICALS	TIES-SIZE & SPA ¹
F40	4'-0"	4'-0"	1'-4"	(5) #5 x 3'-6"	(5) #5 x 3'-6"
F42	2'-0"	4'-0"	1'-0"	(3) #5 x 3'-6"	(5) #5 x 2'-3"


NOTES:

- CENTER FOOTINGS BENEATH COLUMNS. U.N.O.
- ALL FOOTINGS MUST BE BOARD-FORMED, UNLESS APPROVED.
- INCREASE FOOTING DEPTH WHERE REQUIRED TO ENCASE COLUMN ANCHOR RODS.

- ### FOUNDATION PLAN NOTES
- REF. S001 FOR STRUCTURAL NOTES, DESIGN DATA & SCHEDULES.
 - ALL CONTRACTORS ARE REQUIRED TO COORDINATE THEIR WORK WITH ALL DISCIPLINES TO AVOID CONFLICTS. THE MECHANICAL, ELECTRICAL, AND PLUMBING ASPECTS ARE NOT IN THE SCOPE OF THESE DRAWINGS. THEREFORE, ALL REQUIRED MATERIALS AND WORK MAY NOT BE INDICATED.
 - ALL ELEVATIONS ARE REFERENCED FROM THE FIRST FLOOR FINISH FLOOR ELEVATION 0'-0". REFER TO THE SITE / CIVIL DWGS. FOR EXACT U.S.G.S. ELEVATION.
 - REF. ARCH. DRAWINGS FOR ALL DIMENSIONS NOT SHOWN. CONTRACTOR SHALL VERIFY ALL DIMENSIONS PRIOR TO CONSTRUCTION AND IMMEDIATELY NOTIFY ARCHITECT/ENGINEER OF ANY DISCREPANCIES.
 - REFER TO SHEET S102 FOR TYPICAL FOUNDATION DETAILS.
 - PERIMETER COLUMN FOOTINGS SHALL BE LOWERED AND/OR SLEEVED TO PASS BELOW PLUMBING LINES (I.E. SANITARY & STORM SEWERS, WATER LINES, ETC.) SHOWN ON THE PLUMBING DRAWINGS. PROVIDE FOOTING STEPS AS REQUIRED PER THE TYPICAL DETAILS ON S102.
 - COORDINATE REINFORCING DOWELS FOR CMU VERTICAL REINFORCING WITH REINFORCING ON PLANS & SECTIONS.
 - COORDINATE ALL CORES OF CMU BELOW FINISH FLOOR SOLID.
 - COLUMN FOOTINGS, TRENCH FOOTINGS AND WALL FOOTINGS SHALL BEAR ON APPROVED SOIL. UNDERCUT AS REQUIRED TO SUITABLE BEARING MATERIAL AS DETERMINED BY THE GEOTECHNICAL TESTING AGENCY. REF. TYPICAL FOOTING UNDERCUT DETAILS ON SHEET S102.
 - ALL EX. CONSTRUCTION SHOWN IN PLAN AND/OR SECTION WAS DERIVED FROM EXISTING DRAWINGS AND MUST BE FIELD VERIFIED. IF ANY DISCREPANCIES ARE DISCOVERED BETWEEN INFO. SHOWN ON THE DRAWINGS AND ACTUAL CONDITIONS IMMEDIATELY CONTACT ARCHITECT/ENGINEER FOR DIRECTION BEFORE PROCEEDING WITH THE WORK.
- PLAN LEGEND:**
- F.F. DENOTES FINISH FLOOR
 TFX DENOTES TOP OF FTG., GRADE BEAM, SLAB, PIER, ETC.
 BFX DENOTES BOTTOM OF FTG., GRADE BEAM, ETC.
- DENOTES PIER MARK & TOP OF PIER ELEVATION (SEE PIER SCHED.)
 F40.0'-0" P24-2'-0" W8X31-BP-1
 F42.0'-0" P24-2'-0" W8X31-BP-2
- DENOTES COLUMN SIZE AND BASE PLATE PER SCHEDULES
 F40.0'-0" P24-2'-0" W8X31-BP-1
 F42.0'-0" P24-2'-0" W8X31-BP-2
- DENOTES COLUMN FOOTING MARK & TOP OF FTG. ELEVATION (SEE FTG. SCHED.)
 F40.0'-0" P24-2'-0" W8X31-BP-1
 F42.0'-0" P24-2'-0" W8X31-BP-2
- COLUMN FOOTING
 CONCRETE PIER
 STEEL COLUMN

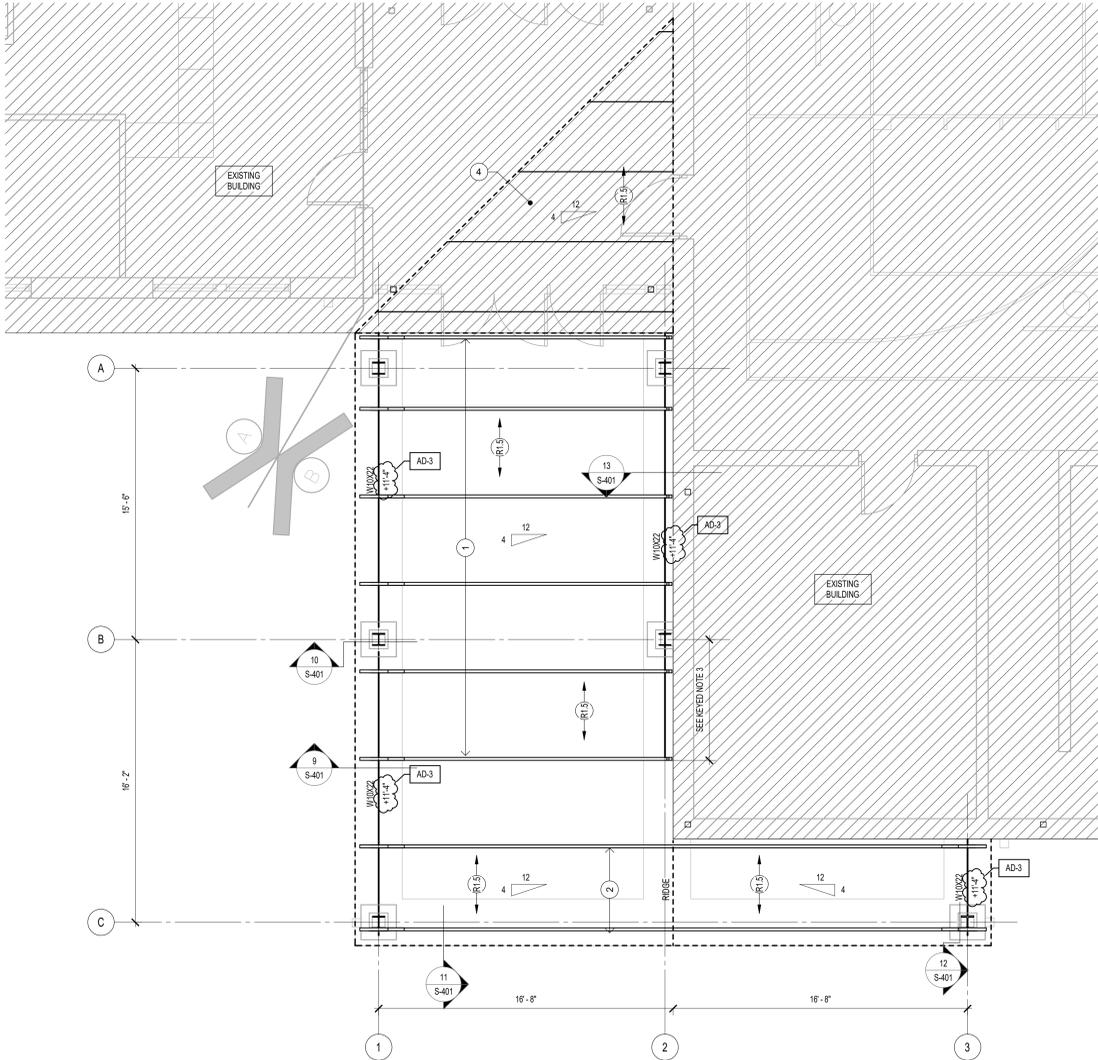


2 NEW CANOPY FRAMING PLAN
 1/4" = 1'-0"

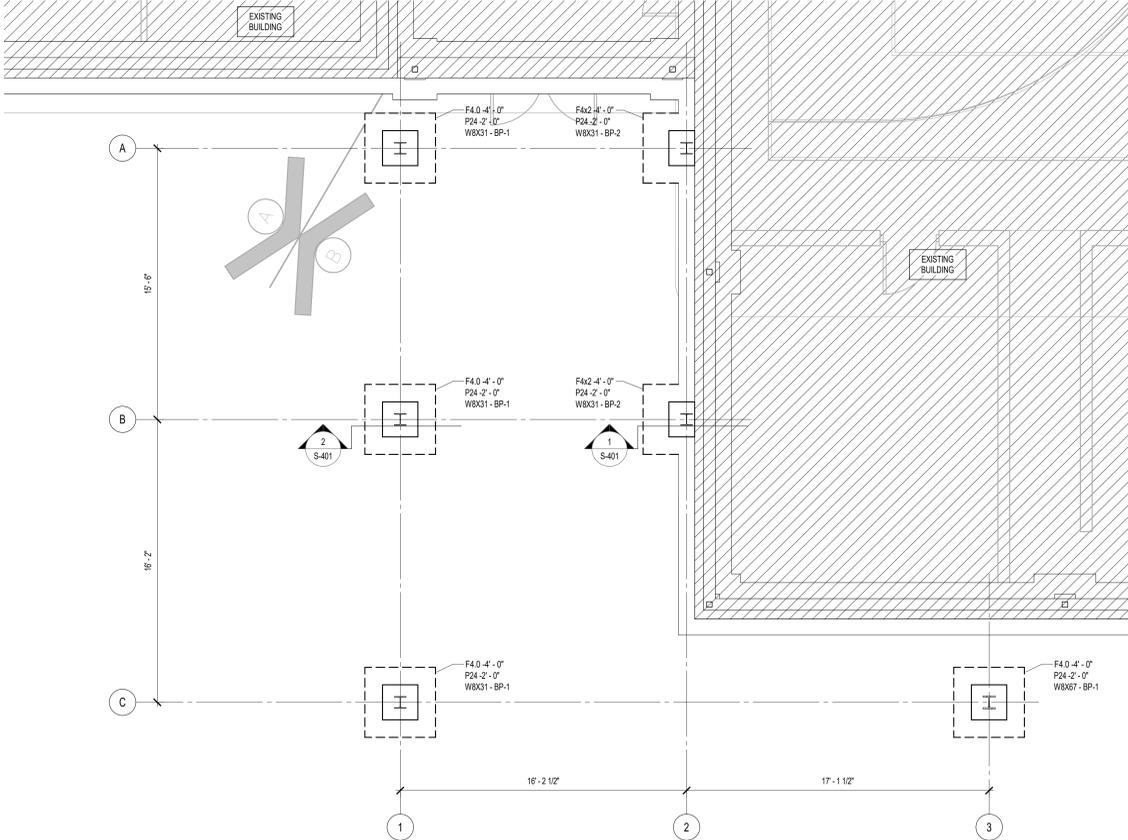

1 FOUNDATION PLAN
 1/4" = 1'-0"



PROJECT:
HANOVER CSC - JANE BALL ES RENOVATIONS AND HS IMPROVEMENTS
 HANOVER COMMUNITY SCHOOL CORPORATION
 CEDAR LAKE, INDIANA

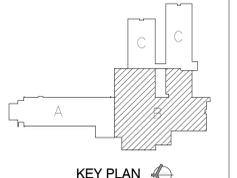

GIBRALTAR DESIGN
 9102 N. Meridian St., Ste. 300
 Indianapolis, IN 46280
 Homepage: www.GibraltarDesign.com
 Email: info@GibraltarDesign.com
 Phone 317.580.5777 Fax 317.580.5778

PROJECT 23-140
 DATE 10/13/23
 COORDINATED BY SAC
 DRAWN BY SAC
 CHECKED BY SAC

COPYRIGHT NOTICE:
 THE CONCEPTS, DESIGN, PLANS, DETAILS, ETC. SHOWN ON THIS DOCUMENT ARE THE PROPERTY OF GIBRALTAR DESIGN AND ARE NOT TO BE REPRODUCED OR USED FOR ANY OTHER PROJECT WITHOUT THE WRITTEN CONSENT OF GIBRALTAR DESIGN. THE OWNER MAY RETAIN COPIES FOR INFORMATION AND REFERENCE IN CONNECTION ONLY WITH THIS PROJECT.

REVISIONS

MARK	DATE	ISSUED FOR
AD-3	11/03/2023	ADDENDUM #3

DRAWING
NEW CANOPY STRUCTURAL PLANS

PROJECT
HANOVER CSC - JANE BALL ES RENOVATIONS AND HS IMPROVEMENTS

GIBRALTAR DESIGN SHEET
JB S-102




GIBRALTAR
DESIGN


ARCHITECTURE - ENGINEERING - INTERIOR DESIGN



PROJECT:
HANOVER CSC - JANE BALL ES RENOVATIONS AND HS IMPROVEMENTS
HANOVER COMMUNITY SCHOOL CORPORATION
CEDAR LAKE, INDIANA

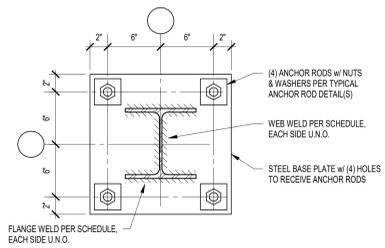


MARK	COLUMN SIZE	BASE PLATE SIZE	ANCHOR ROD DIA.	MAX. HOLE
BP-1	W8x31	1" X 1'-4" X 1'-4" FLANGE WELD = 5/16" WEB WELD = 5/16"	1"	1 3/16"

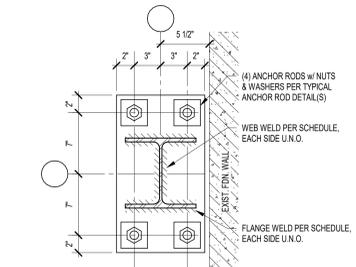


MARK	COLUMN SIZE	BASE PLATE SIZE	ANCHOR ROD DIA.	MAX. HOLE
BP-2	W8x31	1" X 1'-8" X 1'-10" FLANGE WELD = 5/16" WEB WELD = 5/16"	1"	1 3/16"


3 STEEL BASE PLATES
NOT TO SCALE

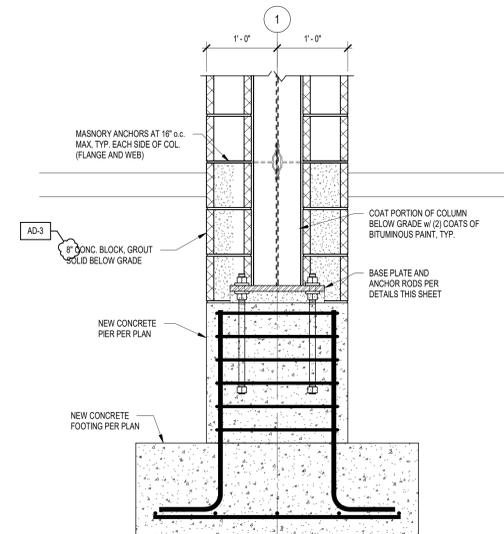

2 FOUNDATION SECTION
1" = 1'-0"

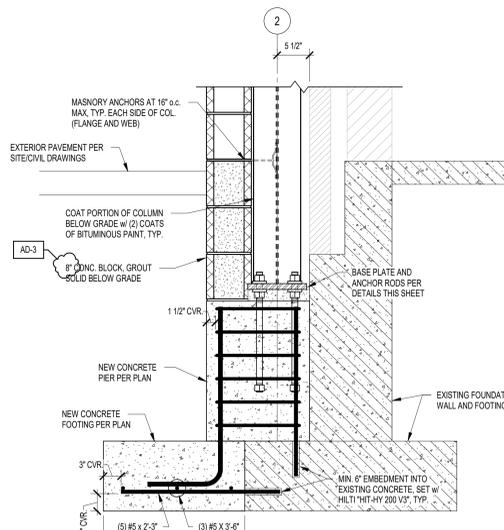


1 FOUNDATION SECTION
1" = 1'-0"

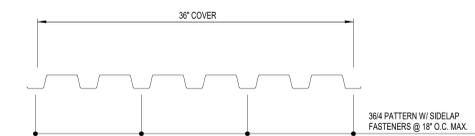


- NOTES:**
- 1 1/2" 20 GA. GALVANIZED WIDE RIB STEEL ROOF DECK. CLEAN, TREAT AND PRIME.
 - USE #10 TEK SCREW SIDELAP FASTENERS, U.N.O.
 - MECHANICAL FASTENERS SHALL BE USED IN LIEU OF WELDS. USE THE FOLLOWING HLT1 POWER ACTUATED FASTENERS:
 - A. X-HSN 24 FOR OPEN-WEB STEEL JOISTS & STRUCTURAL STEEL 1/8" x 1/2" x 3/8"
 - B. X-2HP-15L15 FOR HEAVY OPEN-WEB STEEL JOISTS & STRUCTURAL STEEL 1/2" x 1/4"
 - C. S-SLC 01 M HW SIDELAP FASTENERS
 - ACCEPTABLE ALTERNATE TO THE FASTENERS LISTED ABOVE: PNEUTEK AIRSAFE FASTENING SYSTEM.
 - SUBMIT PROPOSED FASTENERS & TECHNICAL DATA FOR REVIEW.


8 1 1/2" WIDE STEEL ROOF DECK
NOT TO SCALE

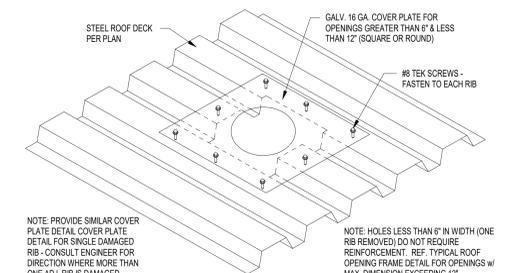


7 SMALL ROOF OPENING DETAIL
NOT TO SCALE

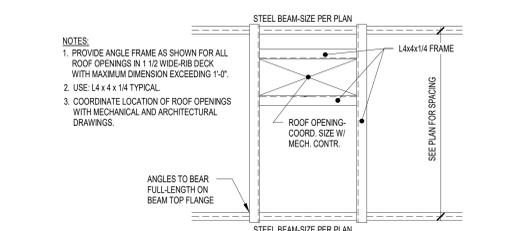


6 NEW ROOF OPENING FRAME
NOT TO SCALE

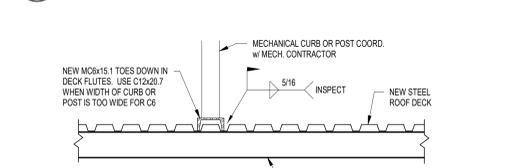


5 ROOF CURB SUPPORT DETAIL
NOT TO SCALE

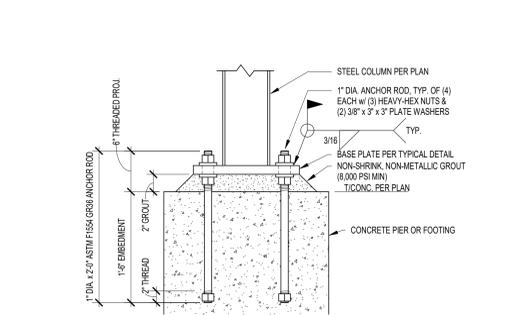


4 1" DIA. ANCHOR RODS
NOT TO SCALE

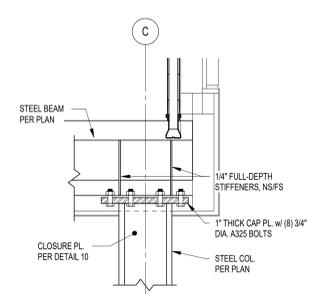


12 FRAMING SECTION
1" = 1'-0"

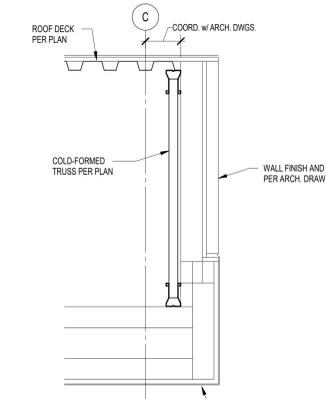


11 FRAMING SECTION
1" = 1'-0"

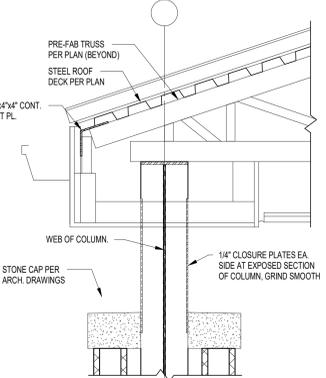


10 FRAMING SECTION
1" = 1'-0"

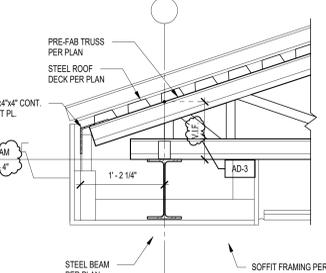


9 FRAMING SECTION
1" = 1'-0"

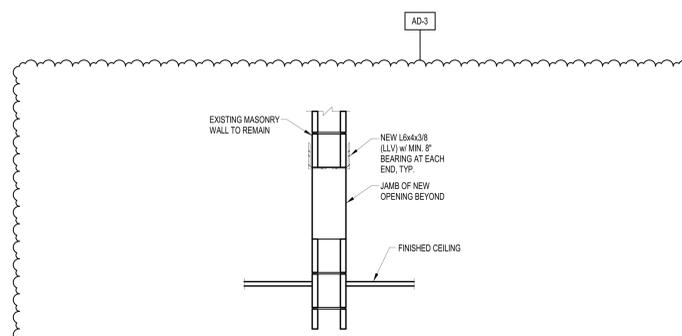

C' OPENING ABOVE CEILING < 32" WIDE

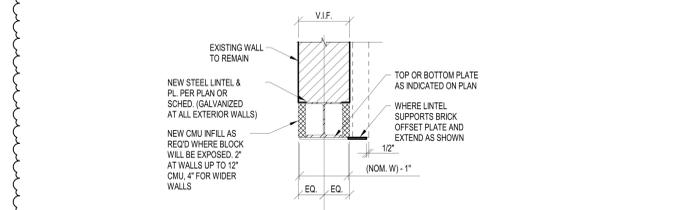


B' SECTION VIEW

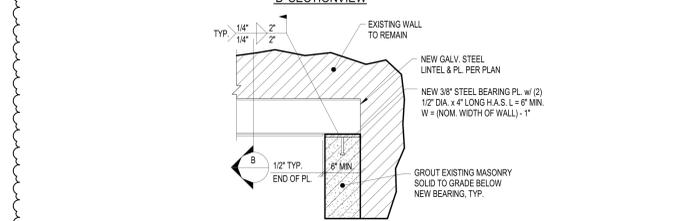


A' ELEVATION VIEW

- NOTES:**
1. THIS DETAIL AND THE SCHEDULE BELOW APPLIES TO ALL NEW OPENINGS REQUIRED IN EXISTING MASONRY WALLS FOR NEW MECHANICAL EQUIPMENT (DUCTS, PIPES, ETC.)
 - OPENINGS > 8" BUT < 6'-0". USE W8x18 LINTELS w/ 3/8" BOTTOM PLATES.
 - OPENINGS > 6'-0" BUT < 12'-0". USE W8x28 LINTELS WITH 3/8" BOTTOM PLATES.
 - OPENINGS > 12'-0". USE W16x40 LINTELS w/ 3/8" BOTTOM PLATES.
 - FIELD VERIFY ALL EXISTING WALL WIDTHS PRIOR TO SUBMITTING SHOP DRAWINGS. NEW BOTTOM PLATE WIDTH = (EXISTING WALL WIDTH) - 1"
 - ALL LINTELS TO HAVE A MINIMUM 8" BEARING AT EACH END.
 - ALL LINTELS AND PLATES LOCATED IN EXTERIOR WALLS ARE TO BE HOT-DIP GALVANIZED.

14 NEW LINTEL IN EXISTING WALL
3/4" = 1'-0"

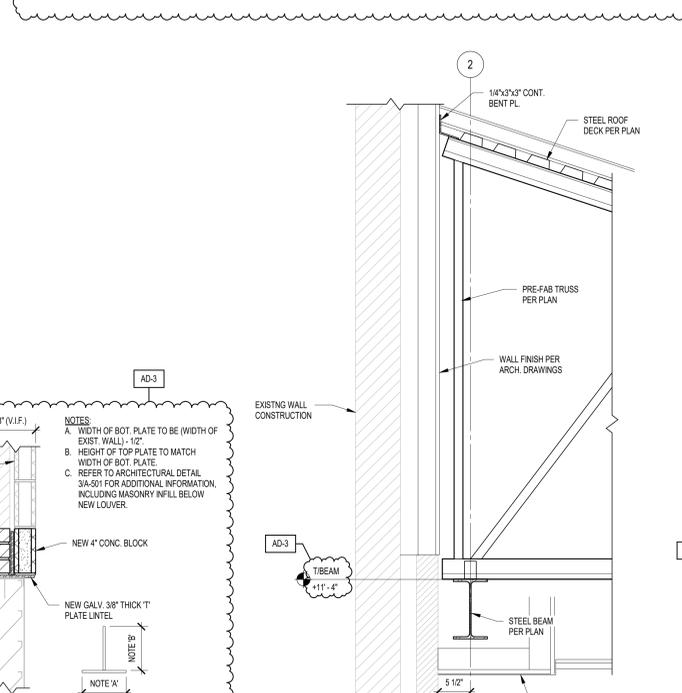

15 STRUCTURAL SECTION
1" = 1'-0"

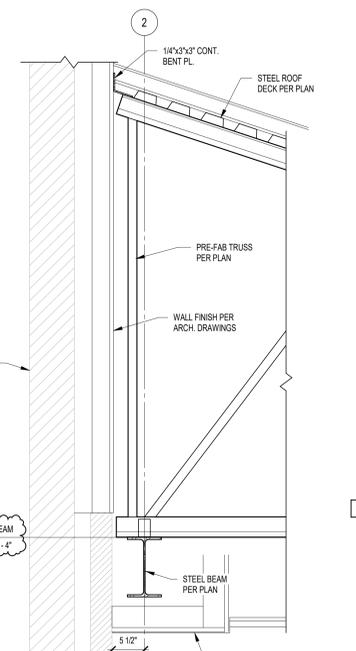

13 FRAMING SECTION
1" = 1'-0"

11/23/2023 8:41:13 AM F:\2023\23106 Hanover Jane Ball Elem School New Canopy\Revit\Jane Ball Elem Canopy_LHB_V23.rvt

GIBRALTAR DESIGN

9102 N. Meridian St., Ste. 300
Indianapolis, IN 46280
Homepage: www.GibraltarDesign.com
Email: info@GibraltarDesign.com
Phone 317.580.5777 Fax 317.580.5778

PROJECT: 23-140
DATE: 10/13/23
COORDINATED BY: SAC
DRAWN BY: SAC
CHECKED BY: SAC



COPYRIGHT NOTICE:
THE CONCEPTS, DESIGN, PLANS, DETAILS, ETC. SHOWN ON THIS DOCUMENT ARE THE PROPERTY OF GIBRALTAR DESIGN AND ARE CREATED FOR USE ON THIS PROJECT. NO REUSE OR REPRODUCTION OF THIS INFORMATION SHALL BE USED BY ANY PERSON OR FIRM FOR ANY PURPOSE WITHOUT THE EXPRESS WRITTEN CONSENT OF GIBRALTAR DESIGN. THE OWNER MAY RETAIN COPIES FOR INFORMATION AND REFERENCE IN CONNECTION ONLY WITH THIS PROJECT.

REVISIONS

MARK	DATE	ISSUED FOR
AD-3	11/03/2023	ADDENDUM #3

DRAWING: **STRUCTURAL SECTIONS AND DETAILS**

PROJECT: **HANOVER CSC - JANE BALL ES RENOVATIONS AND HS IMPROVEMENTS**

PROJECT: **JB S-401**




GIBRALTAR
DESIGN
ARCHITECTURE • ENGINEERING • INTERIOR DESIGN

PROJECT
HANOVER CSC - JANE BALL ES RENOVATIONS AND HS IMPROVEMENTS
HANOVER COMMUNITY SCHOOL CORPORATION
CEDAR LAKE, INDIANA

GIBRALTAR DESIGN
9102 N. Meridian St., Ste. 300
Indianapolis, IN 46260
Homepage: www.GibraltarDesign.com
Email: info@GibraltarDesign.com
Phone: 317.580.5777 Fax: 317.580.5778

PROJECT: 23-140
DATE: 10/13/23
COORDINATED BY: DTB
DRAWN BY: DTB
CHECKED BY: DTB, DJW

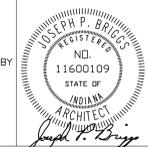

COPYRIGHT NOTICE:
THE CONCEPTS, DESIGNS, PLANS, DETAILS, ETC. SHOWN ON THIS DOCUMENT ARE THE PROPERTY OF GIBRALTAR DESIGN AND WERE CREATED FOR USE ON THIS SPECIFIC PROJECT. NONE OF THIS INFORMATION SHALL BE USED BY ANY PERSON OR FIRM FOR ANY PURPOSE WITHOUT THE EXPRESS WRITTEN CONSENT OF GIBRALTAR DESIGN. THE OWNER MAY RETAIN COPIES FOR INFORMATION AND REFERENCE IN CONNECTION ONLY WITH THIS PROJECT.

REVISIONS	MARK	DATE	ISSUED FOR
	AD-3	11/03/23	ADDENDUM NO.3

DRAWING	PROJECT
HIGH SCHOOL LOCKER ROOM ARCHITECTURAL DEMOLITION PLAN	HANOVER CSC - JANE BALL ES RENOVATIONS AND HS IMPROVEMENTS



PROJECT: HANOVER CSC - JANE BALL ES RENOVATIONS AND HS IMPROVEMENTS
DRAWING: HIGH SCHOOL LOCKER ROOM ARCHITECTURAL DEMOLITION PLAN
SHEET: HS AD110

GENERAL DEMOLITION NOTES:

- A. FOR GENERAL PROJECT NOTES, MATERIAL INDICATIONS, LEGEND, SYMBOL, LEGEND, ABBREVIATIONS, ETC., REFER TO GI SERIES SHEETS.
- B. UNLESS NOTED OTHERWISE ON THIS SHEET, THE GENERAL CONTRACTOR IS RESPONSIBLE FOR ALL DEMOLITION AND REMOVAL WORK INDICATED ON THIS SHEET.
- C. CONTRACTORS ENCOUNTERING EXISTING MATERIAL WHICH IS SUSPECTED OF CONTAINING ASBESTOS SHALL STOP WORK IMMEDIATELY AND NOTIFY THE OWNER AND THE OWNER'S REPRESENTATIVE.
- D. BOLD DASHED LINES INDICATE EXISTING ITEMS TO BE REMOVED UNLESS OTHERWISE NOTED. THE CONTRACTOR SHALL BE RESPONSIBLE FOR FIELD VERIFYING THE EXTENT OF DEMOLITION WORK PRIOR TO BIDDING AND FOR COORDINATING THE EXTENT OF DEMOLITION WITH THE INSTALLATION OF NEW SYSTEMS.
- E. EACH CONTRACTOR SHALL BE RESPONSIBLE FOR ALL DEMOLITION APPLICABLE TO THEIR SCOPE OF WORK AND AS REQUIRED FOR INSTALLATION OF NEW WORK WHETHER OR NOT IT IS SPECIFICALLY INDICATED OR NOTED IN THESE DOCUMENTS.
- F. REMOVE ALL ITEMS AND FINISHES MADE OBSOLETE BY NEW CONSTRUCTION. REFER TO NEW CONSTRUCTION DRAWINGS FOR DEMOLITION REQUIRED NOT SHOWN ON DEMOLITION PLANS.
- G. EACH CONTRACTOR SHALL BE RESPONSIBLE FOR OFF SITE REMOVAL OF ALL DEMOLITION MATERIALS AND/OR ITEMS UNLESS NOTED OTHERWISE OR DIRECTED BY THE OWNER.
- H. PRIOR TO STARTING DEMOLITION, CONSTRUCT DUST CONTROL BARRIERS AS REQUIRED TO PREVENT THE SPREAD OF DUST INTO SURROUNDING AREAS (WHERE APPLICABLE).
- I. WHERE BUILDING EGRESS IS REQUIRED TO PASS THROUGH DEMOLITION AREAS, PROVIDE APPROVED BARRIERS, ETC. TO ENSURE SAFETY OF THE PUBLIC.
- J. RELOCATED ITEMS SHALL BE CLEANED AND PLACED IN STORAGE, PER OWNERS' DIRECTION, UNTIL ITEMS ARE READY TO BE INSTALLED. IF ITEMS ARE DAMAGED DURING DEMOLITION OR RELOCATION, THEY SHALL BE REPAIRED OR REPLACED WITH NEW ITEMS AS APPROVED.
- K. DEMOLITION SHALL BE PERFORMED WITHOUT DAMAGE TO EXISTING CONSTRUCTION TO REMAIN. WHERE SUCH DAMAGE OCCURS, PATCH, REPAIR, OR RESTORE WALLS, FLOORS, CEILING, ETC. NEATLY TO MATCH EXISTING ADJACENT SURFACE. PROVIDE SHORING, BRACING, OR SUPPORT AS REQUIRED TO PREVENT MOVEMENT OR SETTLEMENT OF EXISTING STRUCTURES.
- L. EACH CONTRACTOR IS RESPONSIBLE FOR CUTTING, PATCHING, AND DISCONNECTION OF ITEMS APPLICABLE TO THEIR SCOPE OF WORK. WHERE EXISTING SERVICES ARE ABANDONED, CAP AT LEAST 1" BEHIND NEW FINISHES AND/OR EXISTING SURFACE AND PATCH AS REQUIRED TO RECEIVE NEW FINISHES OR MATCH EXISTING FINISH.
- M. ON WALLS THAT ARE TO RECEIVE NEW FINISHES, REMOVE AND REINSTALL EXISTING EQUIPMENT TO REMAIN AS REQUIRED FOR INSTALLATION OF NEW FINISHES.
- N. WHERE WALLS OR BULKHEADS ARE REMOVED, PATCH FLOORS, CEILINGS, AND ADJACENT WALLS AS REQUIRED TO MATCH EXISTING OR RECEIVE NEW FINISHES WHERE APPLICABLE. WHERE EXISTING DUCTWORK, PIPING, OR EQUIPMENT IS REMOVED, PATCH OPENINGS AND/OR SURFACES AS REQUIRED TO MATCH ADJACENT SURFACES OR RECEIVE NEW FINISHES WHERE APPLICABLE. REFER TO ALL DEMOLITION DRAWINGS FOR EXTENT OF ITEMS TO BE REMOVED.
- O. OVER CUT NEW OPENINGS IN EXISTING WALL AS REQUIRED FOR NEW CONSTRUCTION. PATCH AND REPAIR WALLS AS REQUIRED TO MATCH EXISTING. WHERE APPLICABLE, TOOTH NEW MASONRY INTO EXISTING MASONRY.
- P. ALL EQUIPMENT AND FURNITURE WHICH ARE CONSIDERED LOOSE FURNISHING SHALL BE REMOVED BY THE OWNER PRIOR TO DEMOLITION.
- Q. MASONRY WALLS TO BE REMOVED SHALL BE REMOVED TO A POINT 2" MINIMUM BELOW THE EXISTING FLOOR SLAB UNLESS SETTING ON A SLAB OR SPECIFICALLY NOTED OTHERWISE. PATCH WITH NEW CONCRETE TO BE FLUSH WITH THE EXISTING FLOOR SLAB.
- R. EACH CONTRACTOR SHALL BE RESPONSIBLE FOR GENERAL REVIEW OF DEMOLITION NOTES AND GENERAL DEMOLITION NOTES AS THEY APPLY TO THEIR SCOPE OF WORK.
- S. THE OWNER SHALL RESERVE THE RIGHT TO CLAIM ANY MATERIALS THAT ARE BEING DEMOLISHED PRIOR TO THE CONTRACTOR DISPOSING OF THEM OFF SITE.
- T. REFER TO THE STRUCTURAL, MECHANICAL, PLUMBING, ELECTRICAL AND TECHNOLOGY DOCUMENTS FOR COMPLETE SCOPE OF DEMOLITION WORK.
- U. "FLOORING" DENOTES FLOOR COVERING MATERIALS INCLUDING BACKING, ADHESIVES, AND BASES DOWN TO BUT EXCLUSIVE OF FLOOR SLABS AND STRUCTURAL MATERIALS UNLESS NOTED OTHERWISE.
- V. DEMOLITION IS TO FOLLOW ESTABLISHED CONSTRUCTION SEQUENCE. REFER TO SPECIFICATIONS AND DRAWINGS FOR REQUIREMENTS AND SPECIAL CONDITIONS.
- W. WHERE APPLICABLE SALVAGE EXISTING MASONRY (FACE BRICK, GLAZED CMU, FACING TILE) AS REQUIRED FOR PATCHING AND INFILL IN RENOVATED AREAS WHERE INDICATED. DISCARD UNUSED PORTION OFF SITE.

DEMOLITION PLAN NOTES:

- (ALL PLAN NOTES MAY NOT BE INDICATED ON THIS SHEET.)
- 1 REMOVE ACOUSTICAL BOARD CEILING SYSTEM IN ITS ENTIRETY.
 - 2 REMOVE ALL WALL ACCESSORIES. PATCH AND REPAIR WALL AS REQUIRED TO ACCEPT NEW FINISHES.
 - 3 REMOVE VCT/SHEET VINYL FLOORING SYSTEM IN ITS ENTIRETY. PREPARE FLOOR FOR NEW FINISHES.
 - 4 REMOVE CERAMIC OR PORCELAIN TILE FLOORING SYSTEM IN ITS ENTIRETY. PREPARE FLOOR FOR NEW FINISHES.
 - 5 REMOVE TACK BOARD, MARKER BOARD OR CHALKBOARD IN THEIR ENTIRETY. PATCH WALL AS REQUIRED TO RECEIVE NEW FINISHES.
 - 6 REMOVE PLUMBING FIXTURES IN THEIR ENTIRETY. PREPARE FOR NEW FIXTURES TO GO IN THEIR PLACE, REFER TO PLUMBING.
 - 7 REMOVE TOILET PARTITIONS IN THEIR ENTIRETY.
 - 8 REMOVE METAL LOCKERS. CONCRETE BASE/BENCH TO REMAIN PREPARE AS REQUIRED FOR NEW LOCKERS.
 - 9 REMOVE CEILING MOUNTED MECHANICAL UNIT IN ITS . REFER TO MECHANICAL DRAWINGS.
 - 10 REMOVE TOILET ACCESSORIES AND TURN OVER TO THE OWNER.
 - 11 REMOVE EXISTING FLOOR DRAIN AND PREPARE FOR NEW DRAIN. REFER TO PLUMBING DRAWINGS.
 - 12 REMOVE PAINT AND REPAIR ANY DAMAGE TO CONCRETE BENCHES AND PREPARE FOR NEW PAINT.
 - 13 EXISTING BULKHEAD AND WINDOW WELL TO REMAIN.
 - 14 REMOVE EXISTING HAIR DRYERS, PATCH AND REPAIR WALL AS REQUIRED FOR NEW FINISHES.
 - 15 REMOVE EXISTING SHELF, PATCH AND REPAIR WALL AS REQUIRED FOR NEW FINISHES.
 - 16 PREPARE EXISTING GLAZED BLOCK WALLS AS REQUIRED FOR NEW WALL TILE TO PROPERLY ADHERE.

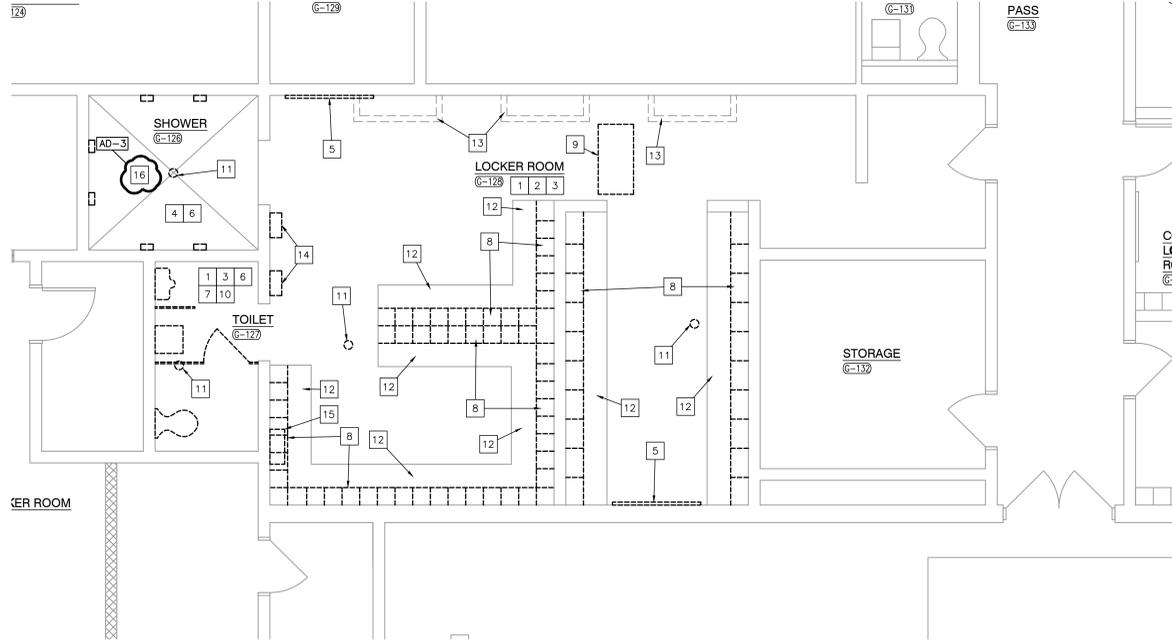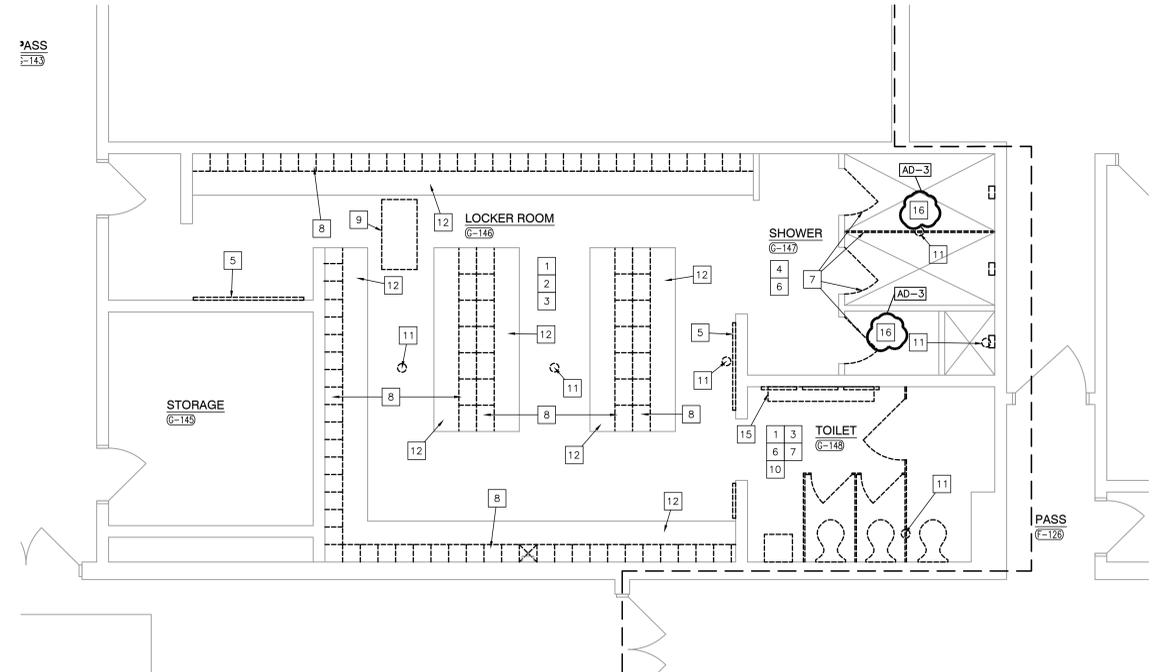

LOCKER ROOM ARCHITECTURAL DEMOLITION PLAN

SCALE: 1/4" = 1'-0"



Friday, 11/2/2023 4:57 PM - LAST SAVED BY: DTBURNS
Y:\23-143 HANOVER CSC - HIGH SCHOOL IMPROVEMENTS
- LOCKER ROOMS\23-143 DRAWINGS\05 ARCH\AD101.DWG



GIBRALTAR DESIGN
ARCHITECTURE • ENGINEERING • INTERIOR DESIGN

PROJECT
HANOVER CSC - JANE BALL ES RENOVATIONS AND HS IMPROVEMENTS
HANOVER COMMUNITY SCHOOL CORPORATION
CEDAR LAKE, INDIANA

KEY PLAN

GIBRALTAR DESIGN
9102 N. Meridian St., Ste. 300
Indianapolis, IN 46260
Homepage: www.GibraltarDesign.com
Email: info@GibraltarDesign.com
Phone: 317.580.5777 Fax: 317.580.5778

PROJECT: 23-140
DATE: 10/13/23
COORDINATED BY: DTB
DRAWN BY: DTB
CHECKED BY: DTB DJW

COPYRIGHT NOTICE:
THE CONCEPTS, DESIGNS, PLANS, DETAILS, ETC. SHOWN ON THIS DOCUMENT ARE THE PROPERTY OF GIBRALTAR DESIGN AND ARE NOT TO BE REPRODUCED OR TRANSMITTED IN ANY FORM OR BY ANY MEANS, ELECTRONIC OR MECHANICAL, INCLUDING PHOTOCOPYING, RECORDING, OR BY ANY INFORMATION STORAGE AND RETRIEVAL SYSTEM, WITHOUT THE EXPRESS WRITTEN CONSENT OF GIBRALTAR DESIGN. THE OWNER MAY RETAIN COPIES FOR INFORMATION AND REFERENCE IN CONNECTION ONLY WITH THIS PROJECT.

REVISIONS	MARK	DATE	ISSUED FOR
	AD-2	10/30/23	ADDENDUM NO.2
	AD-3	11/03/23	ADDENDUM NO.3

DRAWING
UNIT "A" ARCHITECTURAL FIRST FLOOR PLAN

PROJECT
HANOVER CSC - JANE BALL ES RENOVATIONS AND HS IMPROVEMENTS

GIBRALTAR DESIGN SHEET
JB A-101


- 1 CASEWORK AND/OR MILLWORK, REFER TO EQUIPMENT PLANS.
- 2 NEW CONCRETE RAMP, REFER TO CIVIL.
- 3 FLOOR FINISH TRANSITION, REFER TO FINISH PLANS.
- 4 UNIT VENTILATOR, REFER TO MECHANICAL DRAWINGS.
- 5 LINE OF NEW CANOPY, REFER TO SECTIONS.
- 6 INFILL EXISTING LOUVER OPENING BY TOOTHING IN NEW CMU AND BRICK VENEER MATCHING EXISTING IN SIZE, SHAPE, COLOR, AND PROFILE.
- 7 NEW 1 1/2" O.D. PAINTED ALUMINUM HANDRAIL WITH ALUMINUM BRACKETS AT 35" ABOVE SLOPE OF RAMP AND FLOOR, EXTEND RAIL 12" PAST TOP AND BOTTOM OF RAMP AND RETURN ENDS TO WALL.
- 8 UNIT VENTILATOR HEAVY GAUGE PAINTED METAL CLOSURE TO MATCH UNIT VENTILATOR. COORDINATE EACH CONDITION IN FIELD WITH WALL, FLOOR AND CEILING CONDITION.
- 9 TOOTH IN NEW CMU INTO EXISTING.
- 10 NEW 45"W X 48"H LOUVER TOOTH IN NEW CMU AND SALVAGED BRICK AROUND NEW LOUVER WHERE EXISTING LOUVER WAS REMOVED, REFER TO MECHANICAL.
- 11 NEW BACKER ROD AND SEALANT AROUND STONE SILLS AND CLEAN SILL FOR ENTIRE BAY OF WINDOWS OR ENTIRE LENGTH OF WALL AT ADMIN.
- 12 RESET SAGGED STONE SILL ABOVE EXISTING LOUVER SO THAT IT IS BACK INLINE WITH ADJACENT SILLS.
- 13 REPLACE CRACKED SECTION OF STONE SILL WITH NEW MATCHING COLOR AND PROFILE OF EXISTING.
- 14 CLEAN EXISTING CMU WALL.
- 15 NEW ALUMINUM DOWNSPOUT AND BOOT CONNECTED INTO STORM SEWER. ADJUST GUTTER TO WORK WITH NEW DOWNSPOUT LOCATION, REFER TO CIVIL.
- 16 RELOCATE EXISTING ALUMINUM DOWNSPOUT AND BOOT AND CONNECT INTO STORM SEWER, REFER TO CIVIL.
- 17 EXISTING GUTTER AND DOWNSPOUT. MODIFY AS REQUIRED TO CONNECT NEW CANOPY DRAIN SYSTEM AND MAINTAIN POSITIVE DRAINAGE.
- 18 SALVAGED WOOD DOOR AND HARDWARE WITH NEW HOLLOW METAL FRAME.
- 19 RELOCATED SMART BOARD.
- 20 PUSH PAD FOR ADA OPERATOR, REFER TO ELECTRICAL DRAWINGS.
- 21 HARD FOB READER, REFER TO ELECTRICAL DRAWINGS.
- 22 INSTALL SALVAGED KNOX BOX, REPLACE IF DAMAGED.
- 23 MECHANICAL YARD GATE.
- 24 INFILL EXISTING WINDOW OPENING WITH NEW CMU AND BRICK TO MATCH ADJACENT WALLS. COORDINATE WITH NEW LOUVER OPENING.
- 25 EPOXY INJECT CRACKS IN THE CONCRETE STOOP AND THE FOUNDATION IN THIS AREA.

GENERAL PLAN NOTES:

- A. FOR GENERAL PROJECT NOTES, MATERIAL INDICATIONS LEGEND, SYMBOL LEGEND, ABBREVIATIONS, ETC., REFER TO GI SERIES SHEETS.
- B. PLAN DIMENSIONS TO MASONRY WALLS ARE TO FACE OF ROUGH MASONRY. PLAN DIMENSIONS TO STUD WALLS ARE TO FACE OF FINISHED GYPSUM BOARD OR PLASTER. PLAN DIMENSIONS TO STUD WALLS WITH CERAMIC TILE FINISH ARE TO THE FACE OF TILE BACKER BOARD.
- C. ALL CMU WALLS THAT DO NOT LAY OUT IN FULL OR HALF LENGTHS SHOULD BE BALANCED SO AS NOT TO HAVE ANY PIECES LESS THAN 4" IN SIZE EXPOSED TO VIEW.
- D. MASONRY WALLS BEARING ON A THICKENED SLAB AT SLAB DEPRESSIONS REQUIRE CUT MASONRY UNITS SO THAT COURSING BEGINS AT THE FLOOR LINE.
- E. THE BASE FIRST FLOOR ELEVATION INDICATED FOR THE PROJECT IS 100'-0". REFER TO SITE PLAN FOR CORRELATION TO USGS DATUM.
- F. HINGE SIDE OF DOOR JAMB AT CMU WALLS SHALL BE LOCATED 8" MINIMUM FROM ADJACENT WALL AND HINGE SIDE OF DOOR JAMB AT GYPSUM BOARD WALLS SHALL BE LOCATED 4" MINIMUM FROM ADJACENT WALL UNLESS NOTED OTHERWISE.
- G. PROVIDE WOOD BLOCKING (OR METAL STRAPPING WHERE APPLICABLE) AS REQUIRED WITHIN METAL STUD WALLS FOR WALL MOUNTED ITEMS.
- H. REFER TO LIFE SAFETY PLANS REGARDING FIRE RATED WALL LOCATIONS AND OTHER CODE INFORMATION.
- I. INTERIOR CMU WALLS ARE TO BE RUNNING BOND UNLESS NOTED OTHERWISE.
- J. WHERE NEW CMU WALLS INTERSECT EXISTING CMU WALLS AT A CORNER OR ARE ALIGNED WITH EXISTING CMU WALLS, TOOTH NEW CMU INTO EXISTING CMU UNLESS NOTED OTHERWISE.
- K. REFER TO FINISH PLANS FOR LOCATION AND EXTENT OF FINISHED FLOOR AND WALL MATERIAL.
- L. ALL EXPOSED CONCRETE MASONRY UNITS (CMU) CORNERS ARE TO BE BULLNOSED, EXCEPT AT MASONRY BULKHEADS AND EXTERIOR WINDOW JAMBS.
- M. REFER TO DEMOLITION SHEETS FOR ADDITIONAL PATCHING AND REPAIR WORK.

PLAN LEGEND:

- ◻ INDICATES STOREFRONT, CURTAIN WALL, OR WINDOW SYSTEM. REFER TO A-600 SERIES DRAWINGS FOR ELEVATIONS AND DETAILS.
- ◊ INDICATES WALL TYPES REFER TO G-201 FOR WALL THICKNESS, HEIGHT, AND COMPOSITION.
- ⊖ INDICATES CASEWORK ELEVATION SYMBOL - REFER TO A-501 SERIES DRAWINGS FOR ELEVATIONS AND DETAILS.

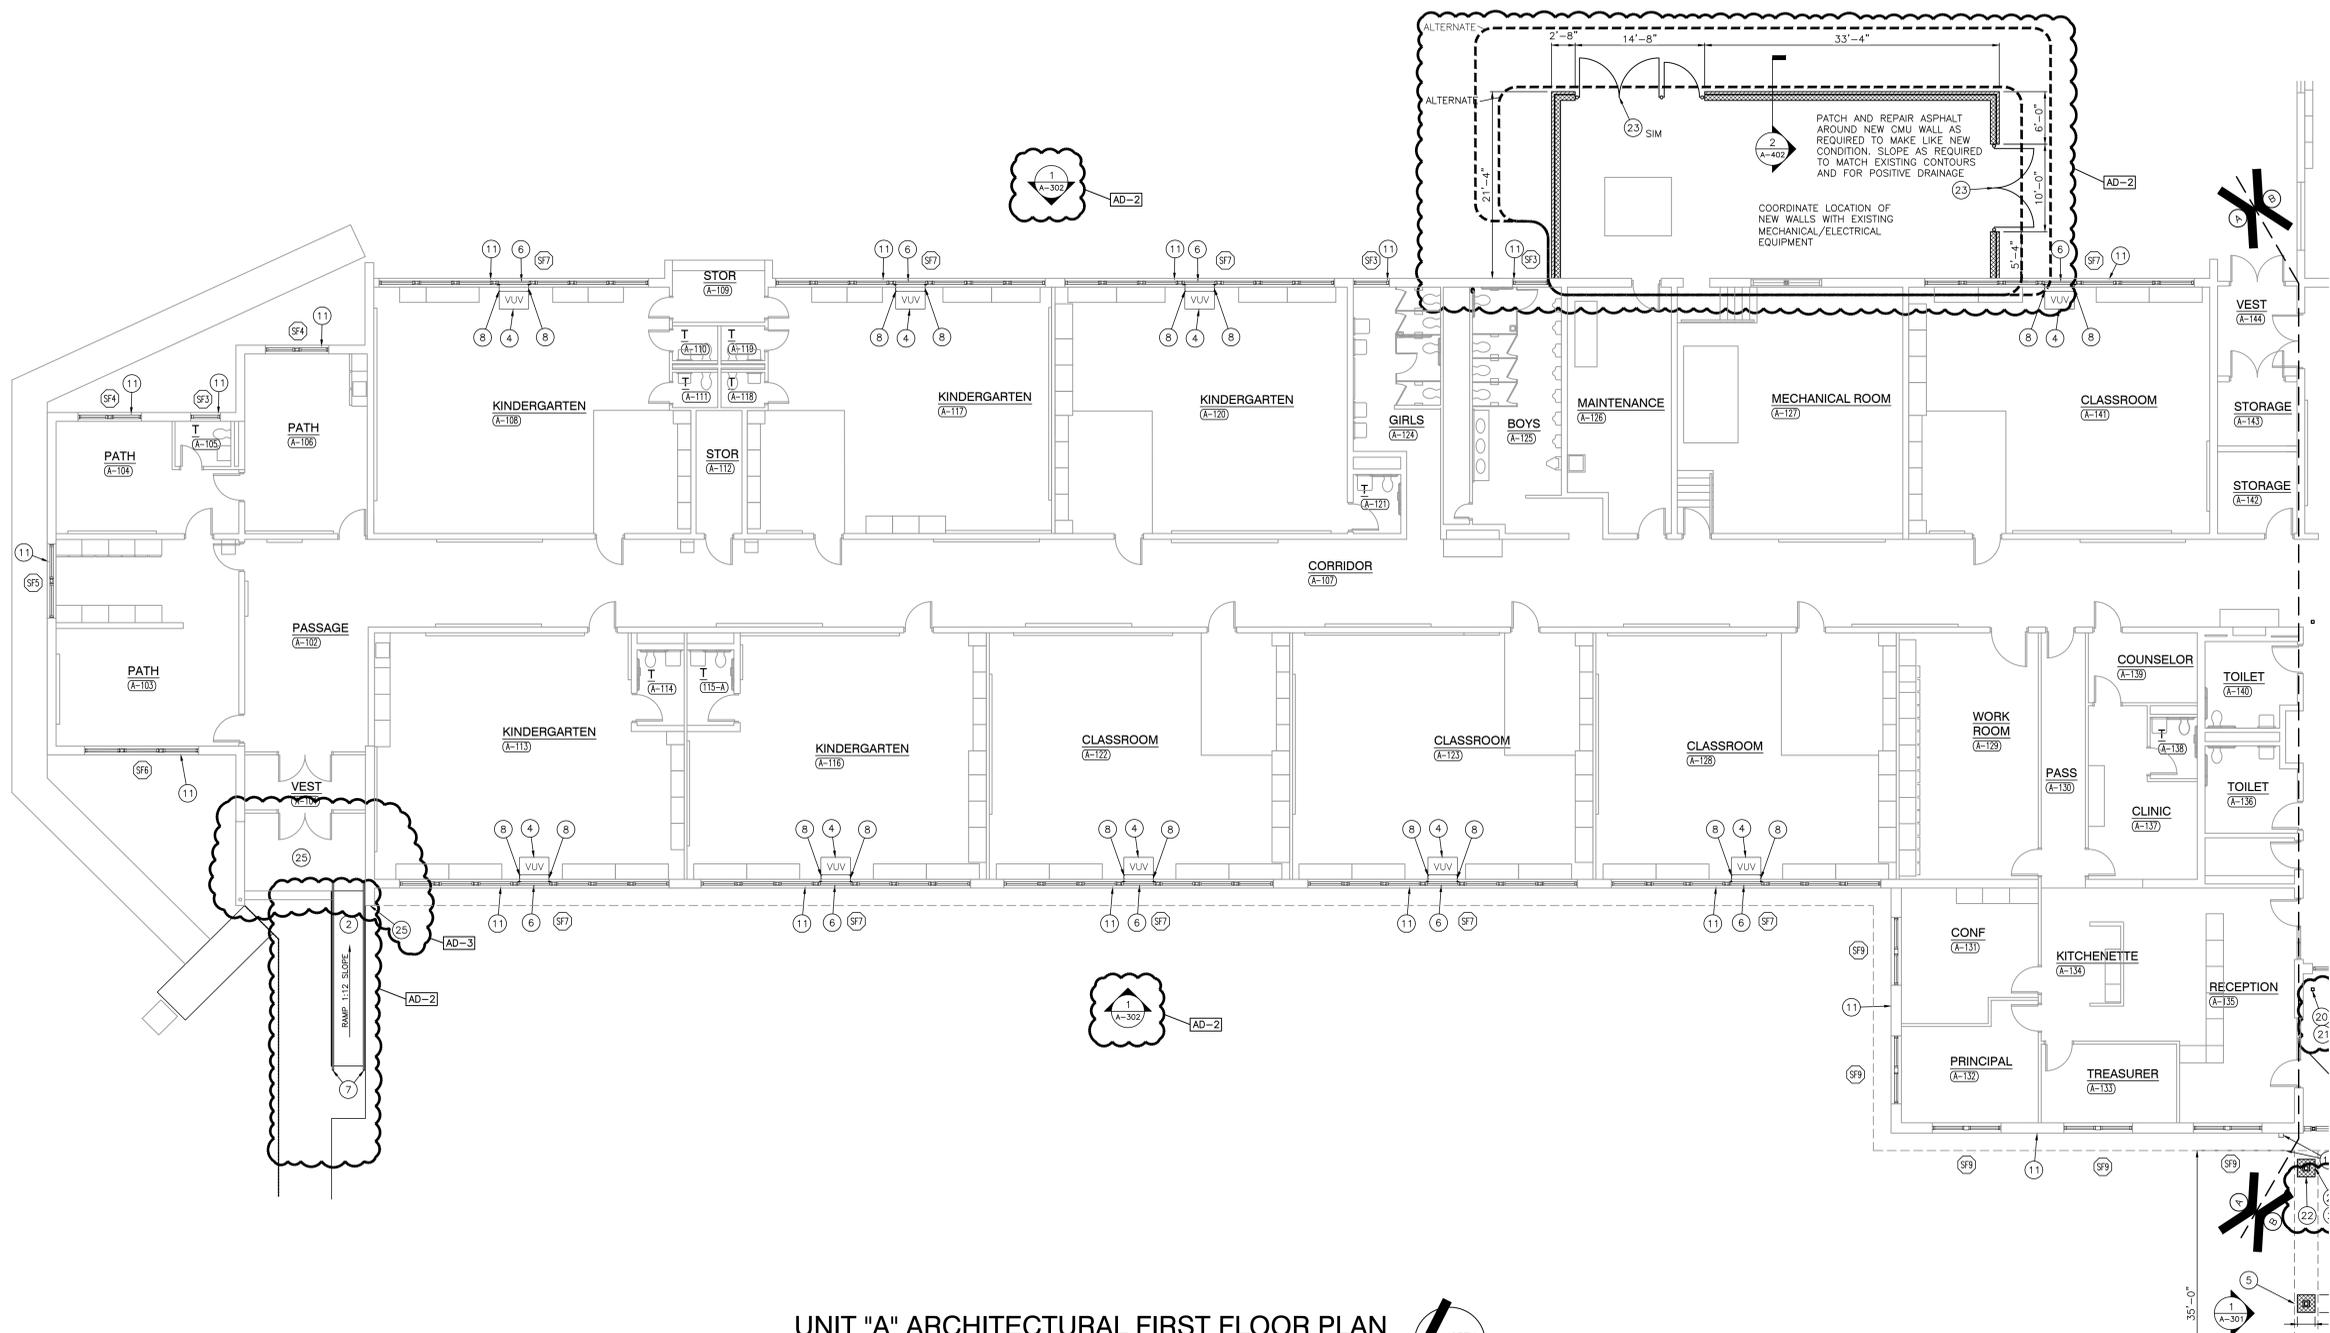

UNIT "A" ARCHITECTURAL FIRST FLOOR PLAN

SCALE: 1/8" = 1'-0"




Friday, 11/2/2023 1:07 PM - LAST SAVED BY: DTBURNS
 Y:\23-140 HANOVER CSC - JANE BALL ELEMENTARY
 SCHOOL RENOVATION\23-140 DRAWINGS\05
 ARCH\A-101.DWG



GIBRALTAR DESIGN
ARCHITECTURE • ENGINEERING • INTERIOR DESIGN

PROJECT
HANOVER CSC - JANE BALL ES RENOVATIONS AND HS IMPROVEMENTS
HANOVER COMMUNITY SCHOOL CORPORATION
CEDAR LAKE, INDIANA

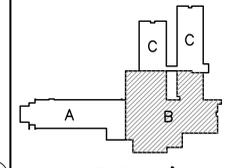

GIBRALTAR DESIGN
9102 N. Meridian St., Ste. 300
Indianapolis, IN 46260
Homepage: www.GibraltarDesign.com
Email: info@GibraltarDesign.com
Phone: 317.580.5777 Fax: 317.580.5778

PROJECT: 23-140
DATE: 10/13/23
COORDINATED BY: DTB
DRAWN BY: DTB
CHECKED BY: DTB DJW

COPYRIGHT NOTICE:
THE CONCEPTS, DESIGNS, PLANS, DETAILS, ETC. SHOWN ON THIS DOCUMENT ARE THE PROPERTY OF GIBRALTAR DESIGN AND ARE NOT TO BE REPRODUCED OR TRANSMITTED IN ANY FORM OR BY ANY MEANS, ELECTRONIC OR MECHANICAL, INCLUDING PHOTOCOPYING, RECORDING, OR BY ANY INFORMATION STORAGE AND RETRIEVAL SYSTEM, WITHOUT THE EXPRESS WRITTEN CONSENT OF GIBRALTAR DESIGN. THE OWNER MAY RETAIN COPIES FOR INFORMATION AND REFERENCE IN CONNECTION ONLY WITH THIS PROJECT.

MARK	DATE	ISSUED FOR
AD-1	10/24/23	ADDENDUM NO.1
AD-2	10/30/23	ADDENDUM NO.2
AD-3	11/03/23	ADDENDUM NO.3

DRAWING
UNIT "B" ARCHITECTURAL FIRST FLOOR PLAN

PROJECT
HANOVER CSC - JANE BALL ES RENOVATIONS AND HS IMPROVEMENTS

SHEET
JB A-102

GENERAL PLAN NOTES:


- A. FOR GENERAL PROJECT NOTES, MATERIAL INDICATIONS LEGEND, SYMBOL LEGEND, ABBREVIATIONS, ETC., REFER TO GI SERIES SHEETS.
- B. PLAN DIMENSIONS TO MASONRY WALLS ARE TO FACE OF ROUGH MASONRY. PLAN DIMENSIONS TO STUD WALLS ARE TO FACE OF FINISHED GYPSUM BOARD OR PLASTER. PLAN DIMENSIONS TO STUD WALLS WITH CERAMIC TILE FINISH ARE TO THE FACE OF TILE BACKER BOARD.
- C. ALL CMU WALLS THAT DO NOT LAY OUT IN FULL OR HALF LENGTHS SHOULD BE BALANCED SO AS NOT TO HAVE ANY PIECES LESS THAN 4" IN SIZE EXPOSED TO VIEW.
- D. MASONRY WALLS BEARING ON A THICKENED SLAB AT SLAB DEPRESSIONS REQUIRE CUT MASONRY UNITS SO THAT COURSING BEGINS AT THE FLOOR LINE.
- E. THE BASE FIRST FLOOR ELEVATION INDICATED FOR THE PROJECT IS 100'-0". REFER TO SITE PLAN FOR CORRELATION TO USGS DATUM.
- F. HINGE SIDE OF DOOR JAMB AT CMU WALLS SHALL BE LOCATED 8" MINIMUM FROM ADJACENT WALL AND HINGE SIDE OF DOOR JAMB AT GYPSUM BOARD WALLS SHALL BE LOCATED 4" MINIMUM FROM ADJACENT WALL UNLESS NOTED OTHERWISE.
- G. PROVIDE WOOD BLOCKING (OR METAL STRAPPING WHERE APPLICABLE) AS REQUIRED WITHIN METAL STUD WALLS FOR WALL MOUNTED ITEMS.
- H. REFER TO LIFE SAFETY PLANS REGARDING FIRE RATED WALL LOCATIONS AND OTHER CODE INFORMATION.
- I. INTERIOR CMU WALLS ARE TO BE RUNNING BOND UNLESS NOTED OTHERWISE.
- J. WHERE NEW CMU WALLS INTERSECT EXISTING CMU WALLS AT A CORNER OR ARE ALIGNED WITH EXISTING CMU WALLS, TOOTH NEW CMU INTO EXISTING CMU UNLESS NOTED OTHERWISE.
- K. REFER TO FINISH PLANS FOR LOCATION AND EXTENT OF FINISHED FLOOR AND WALL MATERIAL.
- L. ALL EXPOSED CONCRETE MASONRY UNITS (CMU) CORNERS ARE TO BE BULLNOSED, EXCEPT AT MASONRY BULKHEADS AND EXTERIOR WINDOW JAMBS.
- M. REFER TO DEMOLITION SHEETS FOR ADDITIONAL PATCHING AND REPAIR WORK.

PLAN LEGEND:

- ⊖ INDICATES STOREFRONT, CURTAIN WALL, OR WINDOW SYSTEM. REFER TO A-G00 SERIES DRAWINGS FOR ELEVATIONS AND DETAILS.
- ◊ INDICATES WALL TYPES REFER TO G-201 FOR WALL THICKNESS, HEIGHT, AND COMPOSITION.
- ⊕ INDICATES CASEWORK ELEVATION SYMBOL - REFER TO A-501 SERIES DRAWINGS FOR ELEVATIONS AND DETAILS.

PLAN NOTES:

- (ALL PLAN NOTES MAY NOT BE INDICATED ON THIS SHEET.)
- 1 CASEWORK AND/OR MILLWORK, REFER TO EQUIPMENT PLANS.
 - 2 NEW CONCRETE RAMP, REFER TO CIVIL.
 - 3 FLOOR FINISH TRANSITION, REFER TO FINISH PLANS.
 - 4 UNIT VENTILATOR, REFER TO MECHANICAL DRAWINGS.
 - 5 LINE OF NEW CANOPY, REFER TO SECTIONS.
 - 6 INFILL EXISTING LOUVER OPENING BY TOOTHING IN NEW CMU AND BRICK VENEER MATCHING EXISTING IN SIZE, SHAPE, COLOR, AND PROFILE.
 - 7 NEW 1 1/2" O.D. PAINTED ALUMINUM HANDRAIL WITH ALUMINUM BRACKETS AT 35" ABOVE SLOPE OF RAMP AND FLOOR. EXTEND RAIL 12" PAST TOP AND BOTTOM OF RAMP AND RETURN ENDS TO WALL.
 - 8 UNIT VENTILATOR HEAVY GAUGE PAINTED METAL CLOSURE TO MATCH UNIT VENTILATOR. COORDINATE EACH CONDITION IN FIELD WITH WALL, FLOOR AND CEILING CONDITION.
 - 9 TOOTH IN NEW CMU INTO EXISTING.
 - 10 NEW 45"W X 48"H LOUVER TOOTH IN NEW CMU AND SALVAGED BRICK AROUND NEW LOUVER WHERE EXISTING LOUVER WAS REMOVED, REFER TO MECHANICAL.
 - 11 NEW BACKER ROD AND SEALANT AROUND STONE SILLS AND CLEAN SILL FOR ENTIRE BAY OF WINDOWS OR ENTIRE LENGTH OF WALL AT ADMIN.
 - 12 RESET SAGGED STONE SILL ABOVE EXISTING LOUVER SO THAT IT IS BACK INLINE WITH ADJACENT SILLS.
 - 13 REPLACE CRACKED SECTION OF STONE SILL WITH NEW MATCHING COLOR AND PROFILE OF EXISTING.
 - 14 CLEAN EXISTING CMU WALL.
 - 15 NEW ALUMINUM DOWNSPOUT AND BOOT CONNECTED INTO STORM SEWER. ADJUST GUTTER TO WORK WITH NEW DOWNSPOUT LOCATION, REFER TO CIVIL.
 - 16 RELOCATE EXISTING ALUMINUM DOWNSPOUT AND BOOT AND CONNECT INTO STORM SEWER, REFER TO CIVIL.
 - 17 EXISTING GUTTER AND DOWNSPOUT. MODIFY AS REQUIRED TO CONNECT NEW CANOPY OUT ABOVE SLOPE OF RAMP AND FLOOR.
 - 18 SALVAGED WOOD DOOR AND HARDWARE WITH NEW HOLLOW METAL FRAME RELOCATED SMART BOARD.
 - 19 PUSH PAD FOR ADA OPERATOR, REFER TO ELECTRICAL DRAWINGS.
 - 20 CARD FOR READER, REFER TO ELECTRICAL DRAWINGS.
 - 21 INSTALL SALVAGED KNOX BOX. REPLACE IF DAMAGED.
 - 22 MECHANICAL YARD GATE.
 - 23 INFILL EXISTING WINDOW OPENING WITH NEW CMU AND BRICK TO MATCH ADJACENT WALLS. COORDINATE WITH NEW LOUVER OPENING.
 - 24 EPOXY INJECT CRACKS IN THE CONCRETE STOOP AND THE FOUNDATION IN THIS AREA.
 - 25 COVER EXISTING OPENING FROM MECHANICAL UNIT WITH METAL CLOSURE PLATE PAINTED TO MATCH CEILING.

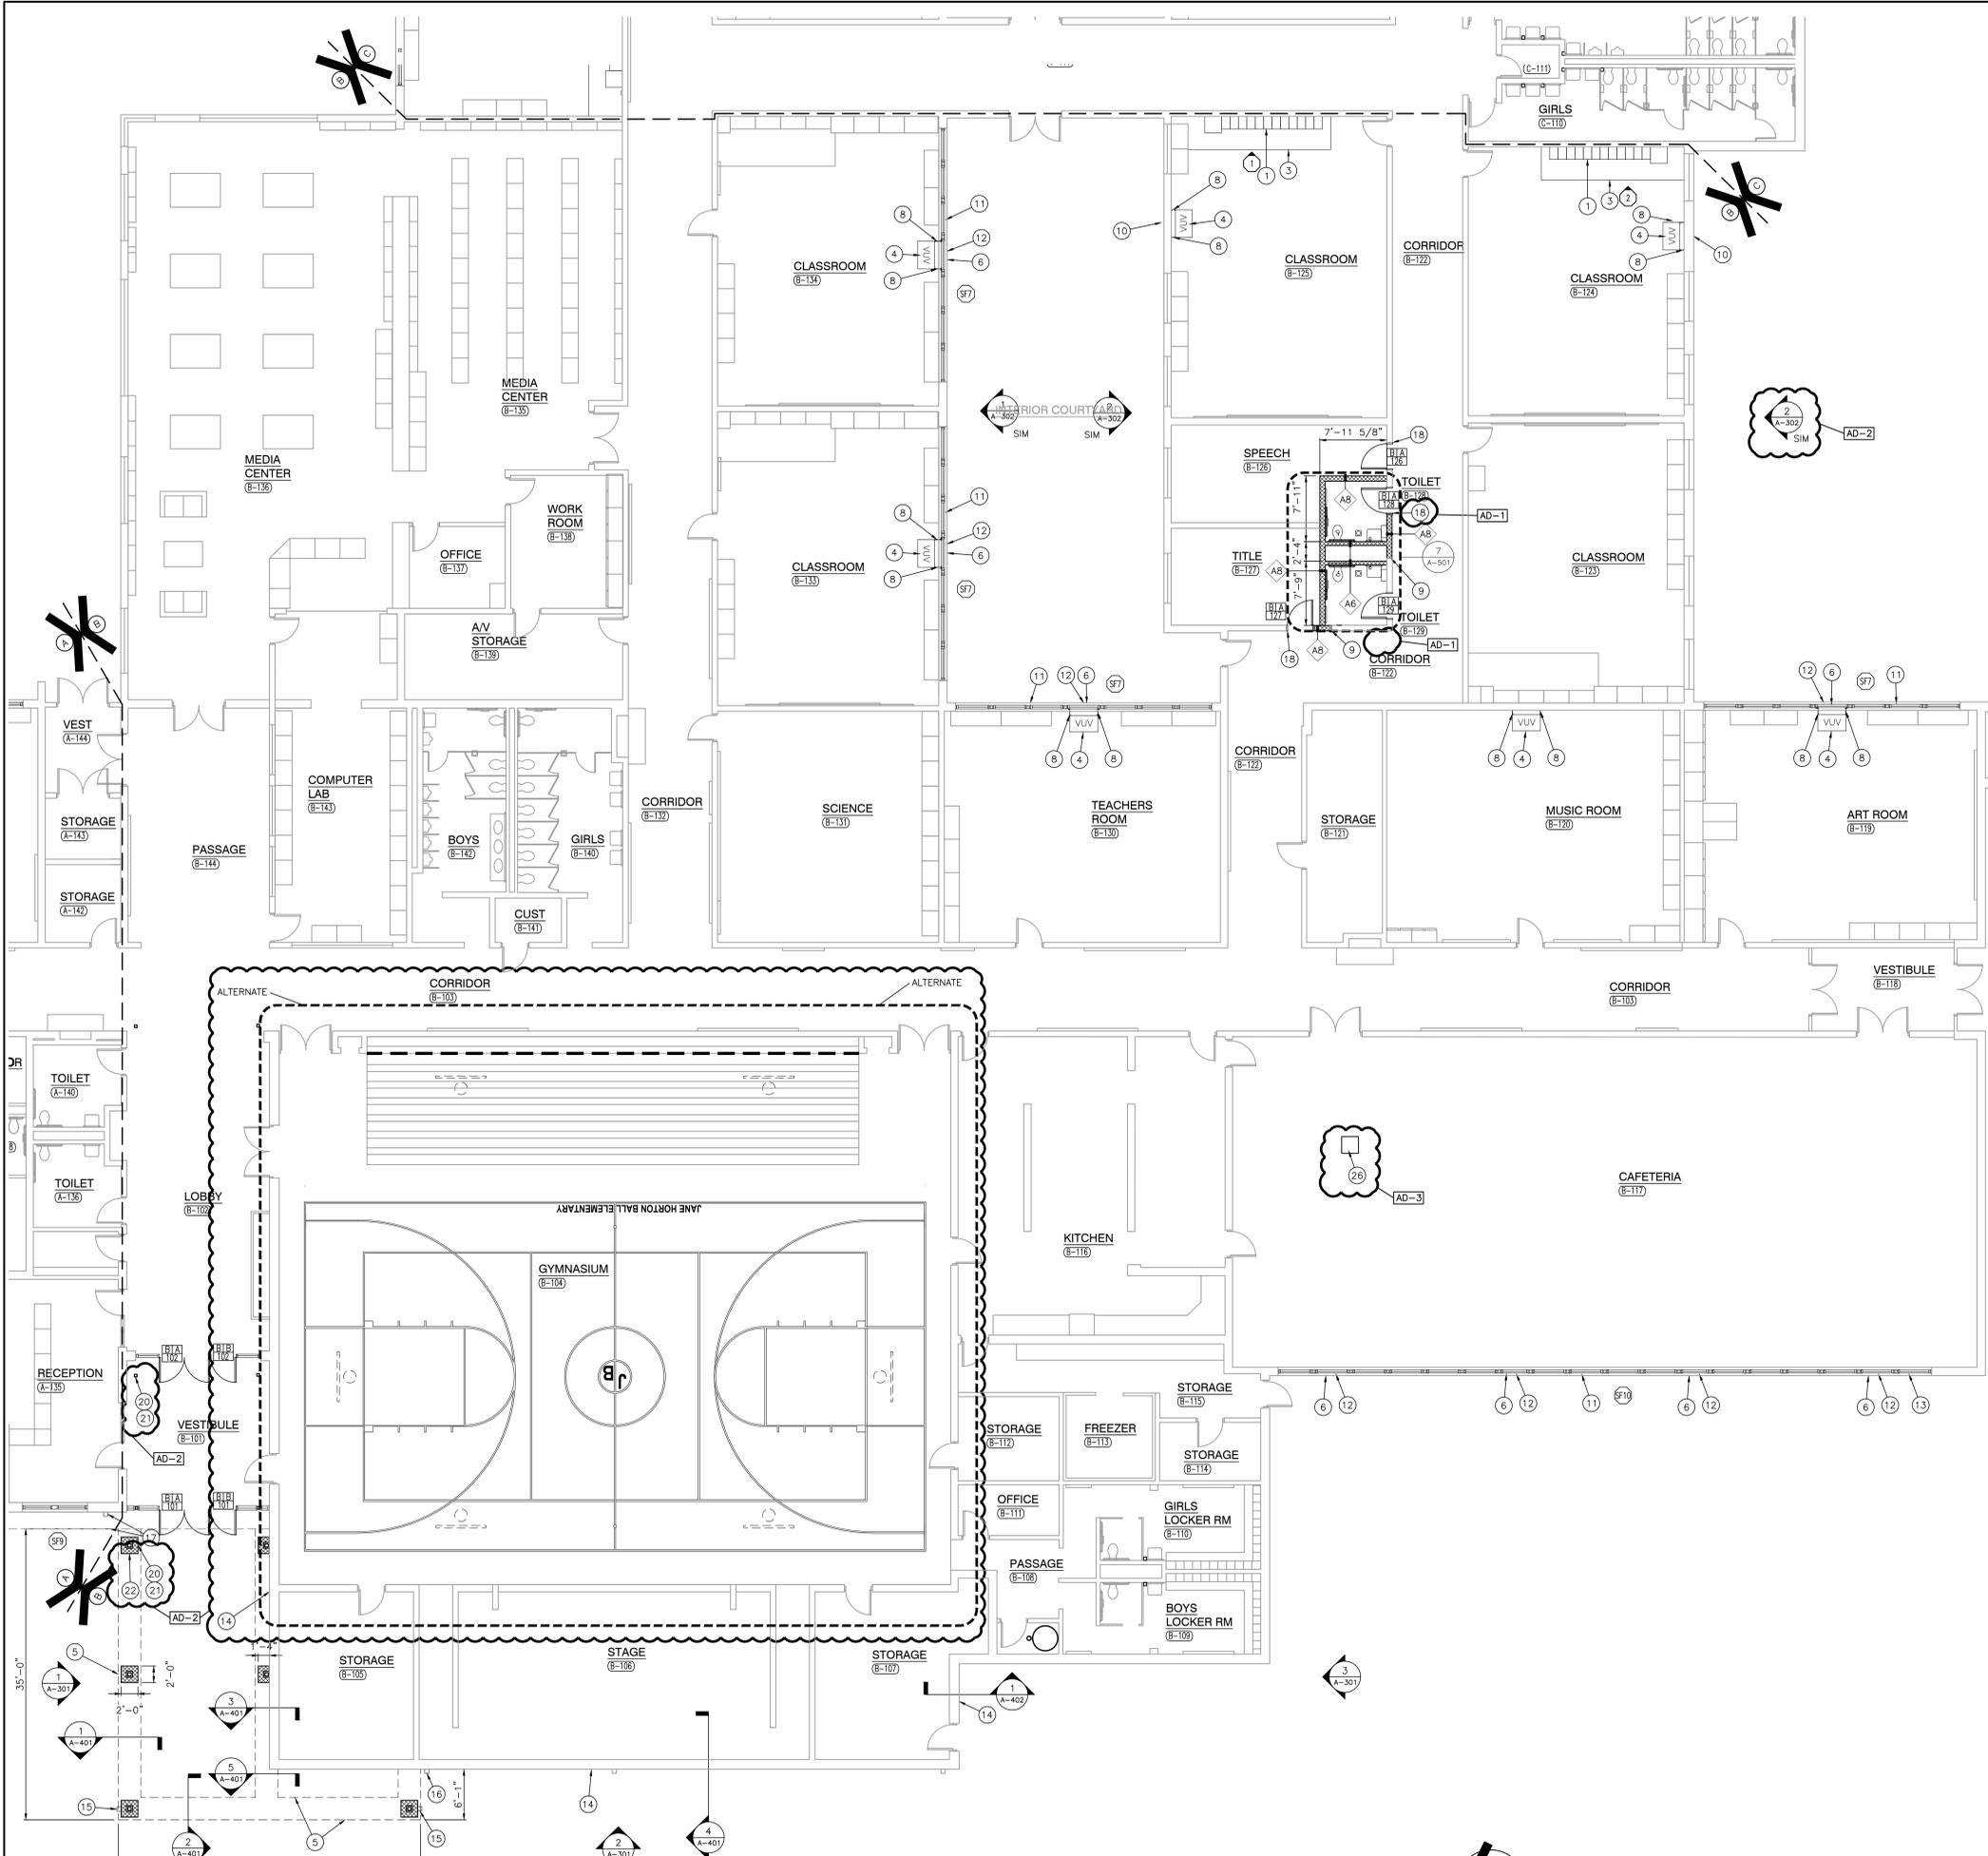

UNIT "B" ARCHITECTURAL FIRST FLOOR PLAN
SCALE: 1/8" = 1'-0"




Friday, 11/2/2023 5:17 PM - LAST SAVED BY: DTBURNS
 Y:\23-140 HANOVER CSC - JANE BALL ELEMENTARY
 SCHOOL RENOVATION\23-140 DRAWINGS\05
 ARCH\A-102.DWG



GIBRALTAR
DESIGN
ARCHITECTURE • ENGINEERING • INTERIOR DESIGN

PROJECT
HANOVER CSC - JANE BALL ES RENOVATIONS AND HS IMPROVEMENTS
HANOVER COMMUNITY SCHOOL CORPORATION
CEDAR LAKE, INDIANA

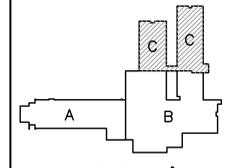

KEY PLAN
GIBRALTAR DESIGN
9102 N. Meridian St., Ste. 300
Indianapolis, IN 46260
Homepage: www.GibraltarDesign.com
Email: info@GibraltarDesign.com
Phone: 317.580.5777 Fax: 317.580.5778

PROJECT
23-140
DATE
10/13/23
COORDINATED BY
DTB
DRAWN BY
DTB
CHECKED BY
DTB DJW

COPYRIGHT NOTICE:
THE CONCEPTS, DESIGNS, PLANS, DETAILS, ETC. SHOWN ON THIS DOCUMENT ARE THE PROPERTY OF GIBRALTAR DESIGN AND WERE CREATED FOR USE ON THIS SPECIFIC PROJECT. NONE OF THIS INFORMATION SHALL BE USED BY ANY PERSON OR FIRM FOR ANY PURPOSE WITHOUT THE EXPRESS WRITTEN CONSENT OF GIBRALTAR DESIGN. THE OWNER MAY RETAIN COPIES FOR INFORMATION AND REFERENCE IN CONNECTION ONLY WITH THIS PROJECT.

MARK	DATE	ISSUED FOR
AD-2	10/30/23	ADDENDUM NO.2
AD-3	11/03/23	ADDENDUM NO.3

DRAWING
UNIT "C" ARCHITECTURAL FIRST FLOOR PLAN

PROJECT
HANOVER CSC - JANE BALL ES RENOVATIONS AND HS IMPROVEMENTS

© GIBRALTAR DESIGN SHEET
JB A-103

GENERAL PLAN NOTES:


- A. FOR GENERAL PROJECT NOTES, MATERIAL INDICATIONS LEGEND, SYMBOL LEGEND, ABBREVIATIONS, ETC., REFER TO GI SERIES SHEETS.
- B. PLAN DIMENSIONS TO MASONRY WALLS ARE TO FACE OF ROUGH MASONRY. PLAN DIMENSIONS TO STUD WALLS ARE TO FACE OF FINISHED GYPSUM BOARD OR PLASTER. PLAN DIMENSIONS TO STUD WALLS WITH CERAMIC TILE FINISH ARE TO THE FACE OF TILE BACKER BOARD.
- C. ALL CMU WALLS THAT DO NOT LAY OUT IN FULL OR HALF LENGTHS SHOULD BE BALANCED SO AS NOT TO HAVE ANY PIECES LESS THAN 4" IN SIZE EXPOSED TO VIEW.
- D. MASONRY WALLS BEARING ON A THICKENED SLAB AT SLAB DEPRESSIONS REQUIRE CUT MASONRY UNITS SO THAT COURSING BEGINS AT THE FLOOR LINE.
- E. THE BASE FIRST FLOOR ELEVATION INDICATED FOR THE PROJECT IS 100'-0". REFER TO SITE PLAN FOR CORRELATION TO USGS DATUM.
- F. HINGE SIDE OF DOOR JAMB AT CMU WALLS SHALL BE LOCATED 8" MINIMUM FROM ADJACENT WALL AND HINGE SIDE OF DOOR JAMB AT GYPSUM BOARD WALLS SHALL BE LOCATED 4" MINIMUM FROM ADJACENT WALL UNLESS NOTED OTHERWISE.
- G. PROVIDE WOOD BLOCKING (OR METAL STRAPPING WHERE APPLICABLE) AS REQUIRED WITHIN METAL STUD WALLS FOR WALL MOUNTED ITEMS.
- H. REFER TO LIFE SAFETY PLANS REGARDING FIRE RATED WALL LOCATIONS AND OTHER CODE INFORMATION.
- I. INTERIOR CMU WALLS ARE TO BE RUNNING BOND UNLESS NOTED OTHERWISE.
- J. WHERE NEW CMU WALLS INTERSECT EXISTING CMU WALLS AT A CORNER OR ARE ALIGNED WITH EXISTING CMU WALLS, TOOTH NEW CMU INTO EXISTING CMU UNLESS NOTED OTHERWISE.
- K. REFER TO FINISH PLANS FOR LOCATION AND EXTENT OF FINISHED FLOOR AND WALL MATERIAL.
- L. ALL EXPOSED CONCRETE MASONRY UNITS (CMU) CORNERS ARE TO BE BULLNOSED, EXCEPT AT MASONRY BULKHEADS AND EXTERIOR WINDOW JAMBS.
- M. REFER TO DEMOLITION SHEETS FOR ADDITIONAL PATCHING AND REPAIR WORK.

PLAN LEGEND:

- ☐ INDICATES STOREFRONT, CURTAIN WALL, OR WINDOW SYSTEM. REFER TO A-600 SERIES DRAWINGS FOR ELEVATIONS AND DETAILS.
- ◊ INDICATES WALL TYPES REFER TO G-201 FOR WALL THICKNESS, HEIGHT, AND COMPOSITION.
- ☉ INDICATES CASEWORK ELEVATION SYMBOL - REFER TO A-501 SERIES DRAWINGS FOR ELEVATIONS AND DETAILS.

PLAN NOTES:

- (ALL PLAN NOTES MAY NOT BE INDICATED ON THIS SHEET.)
- 1 CASEWORK AND/OR MILLWORK, REFER TO EQUIPMENT PLANS.
 - 2 NEW CONCRETE RAMP, REFER TO CIVIL.
 - 3 FLOOR FINISH TRANSITION, REFER TO FINISH PLANS.
 - 4 UNIT VENTILATOR, REFER TO MECHANICAL DRAWINGS.
 - 5 LINE OF NEW CANOPY, REFER TO SECTIONS.
 - 6 INFILL EXISTING LOUVER OPENING BY TOOTHING IN NEW CMU AND BRICK VENEER MATCHING EXISTING IN SIZE, SHAPE, COLOR, AND PROFILE.
 - 7 NEW 1 1/2" O.D. PAINTED ALUMINUM HANDRAIL WITH ALUMINUM BRACKETS AT 35" ABOVE SLOPE OF RAMP AND FLOOR. EXTEND RAIL 12" PAST TOP AND BOTTOM OF RAMP AND RETURN ENDS TO WALL.
 - 8 UNIT VENTILATOR HEAVY GAUGE PAINTED METAL CLOSURE TO MATCH UNIT VENTILATOR. COORDINATE EACH CONDITION IN FIELD WITH WALL, FLOOR AND CEILING CONDITION.
 - 9 TOOTH IN NEW CMU INTO EXISTING. (AD-3)
 - 10 NEW 45"W X 46"H LOUVER TOOTH IN NEW CMU AND SALVAGED BRICK AROUND NEW LOUVER WHERE EXISTING LOUVER WAS REMOVED, REFER TO MECHANICAL. (AD-2)
 - 11 NEW BACKER ROD AND SEALANT AROUND STONE SILLS AND CLEAN SILL FOR ENTIRE BAY OF WINDOWS OR ENTIRE LENGTH OF WALL AT ADMIN.
 - 12 RESET SAGGED STONE SILL ABOVE EXISTING LOUVER SO THAT IT IS BACK INLINE WITH ADJACENT SILLS.
 - 13 REPLACE CRACKED SECTION OF STONE SILL WITH NEW MATCHING COLOR AND PROFILE OF EXISTING.
 - 14 CLEAN EXISTING CMU WALL.
 - 15 NEW ALUMINUM DOWNSPOUT AND BOOT CONNECTED INTO STORM SEWER. ADJUST GUTTER TO WORK WITH NEW DOWNSPOUT LOCATION, REFER TO CIVIL.
 - 16 RELOCATE EXISTING ALUMINUM DOWNSPOUT AND BOOT AND CONNECT INTO STORM SEWER, REFER TO CIVIL.
 - 17 EXISTING GUTTER AND DOWNSPOUT. MODIFY AS REQUIRED TO CONNECT NEW CANOPY GUTTER SYSTEM AND MAINTAIN POSITIVE DRAINAGE.
 - 18 SALVAGED WOOD DOOR AND HARDWARE WITH NEW HOLLOW METAL FRAME.
 - 19 RELOCATED SMART BOARD.
 - 20 PUSH PAD FOR ADA OPERATOR, REFER TO ELECTRICAL DRAWINGS. (AD-1)
 - 21 CARD/FOUR READER, REFER TO ELECTRICAL DRAWINGS. (AD-2)
 - 22 INSTALL SALVAGED KNOX BOX, REPLACE IF DAMAGED. (AD-3)
 - 23 MECHANICAL YARD GATE. (AD-3)
 - 24 INFILL EXISTING WINDOW OPENING WITH NEW CMU AND BRICK TO MATCH ADJACENT WALLS. COORDINATE WITH NEW LOUVER OPENING.
 - 25 EPOXY INJECT CRACKS IN THE CONCRETE STOOP AND THE FOUNDATION IN THIS AREA. (AD-3)

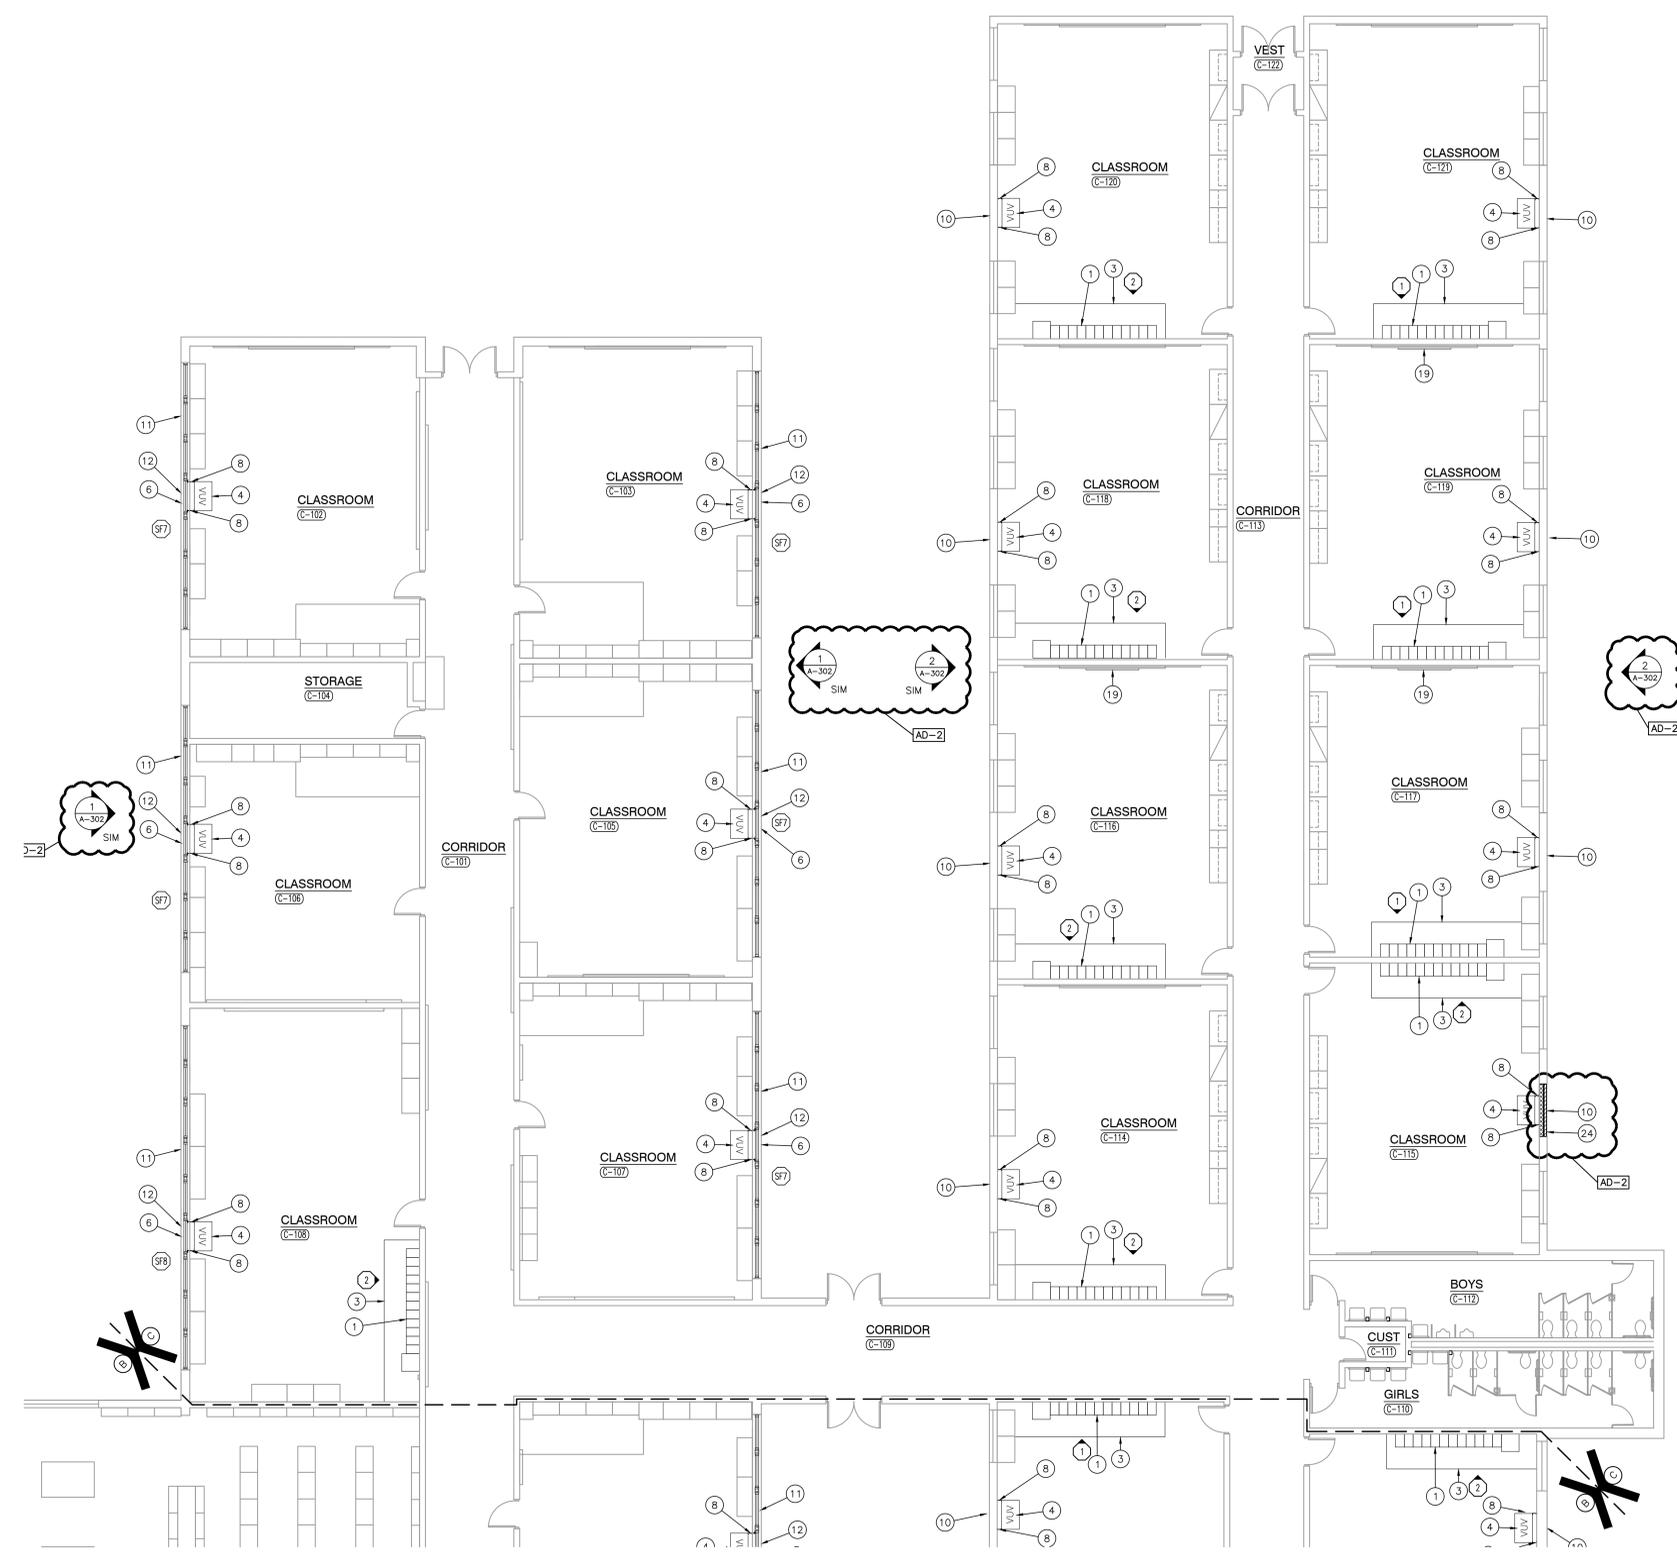


UNIT "C" ARCHITECTURAL FIRST FLOOR PLAN


SCALE: 1/8" = 1'-0"




Friday, 11/2/2023 1:08 PM - LAST SAVED BY: DTBURNS
Y:\23-140 HANOVER CSC - JANE BALL ELEMENTARY
SCHOOL RENOVATION\23-140 DRAWINGS\05
ARCH\A-103.DWG

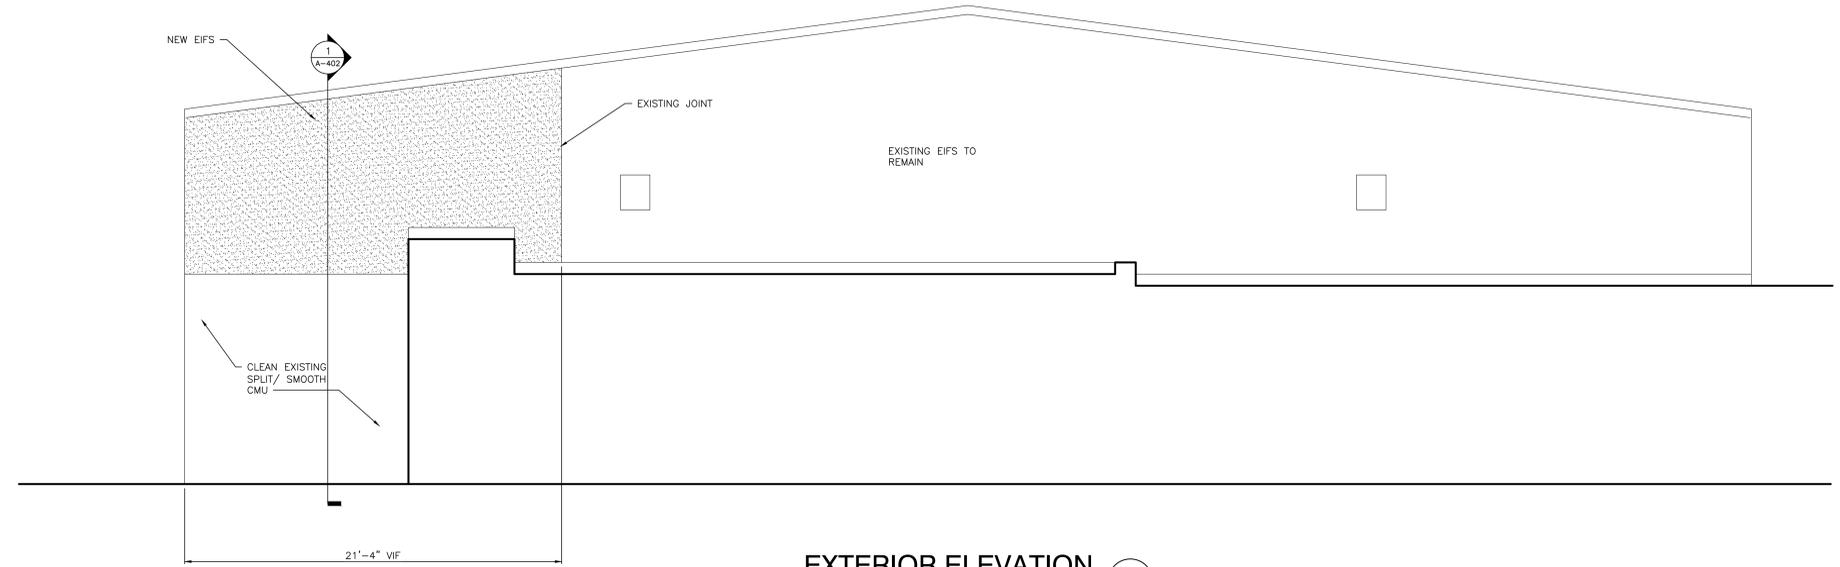

EXTERIOR ELEVATION 3
SCALE: 1/4" = 1'-0"

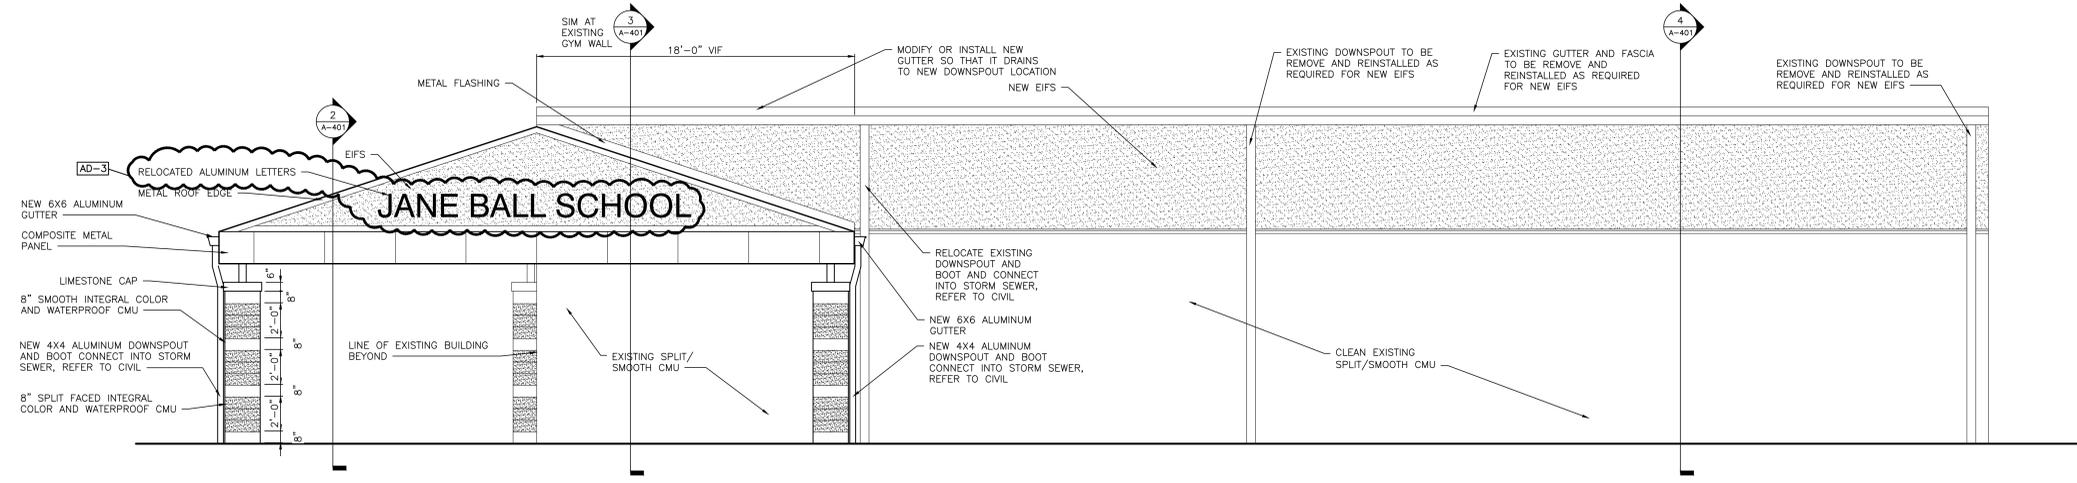

EXTERIOR ELEVATION 2
SCALE: 1/4" = 1'-0"

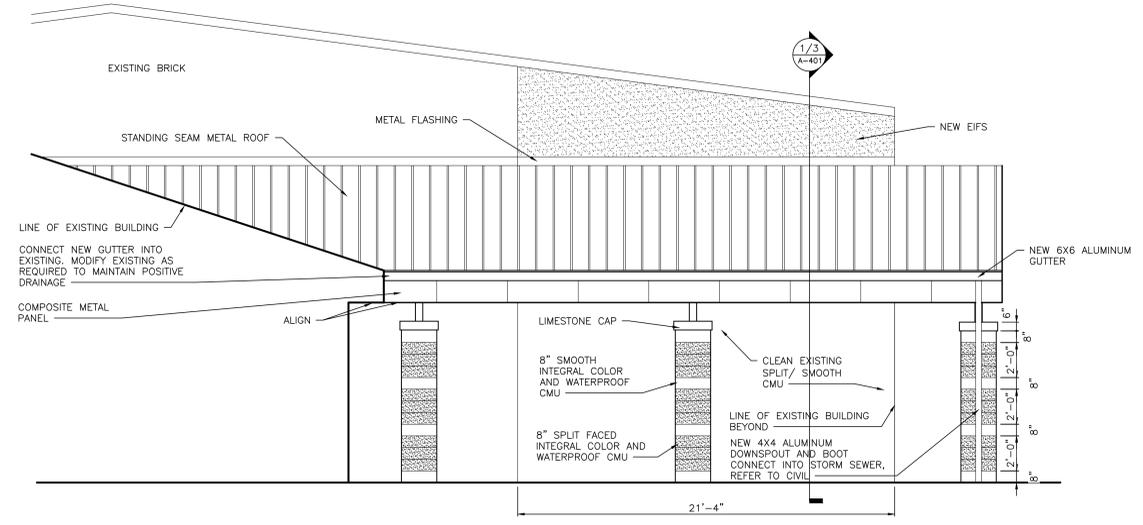

EXTERIOR ELEVATION 1
SCALE: 1/4" = 1'-0"

GIBRALTAR DESIGN
9102 N. Meridian St., Ste. 300
Indianapolis, IN 46260
Homepage: www.GibraltarDesign.com
Email: info@GibraltarDesign.com
Phone: 317.580.5777 Fax: 317.580.5778

PROJECT: 23-140
DATE: 10/13/23
COORDINATED BY: DTB
DRAWN BY: DTB
CHECKED BY: DTB DJW



COPYRIGHT NOTICE:
THE CONCEPTS, DESIGNS, PLANS, DETAILS, ETC. SHOWN ON THIS DOCUMENT ARE THE PROPERTY OF GIBRALTAR DESIGN AND WERE CREATED FOR USE ON THIS SPECIFIC PROJECT. NONE OF THIS INFORMATION SHALL BE USED BY ANY PERSON OR FIRM FOR ANY PURPOSE WITHOUT THE EXPRESS WRITTEN CONSENT OF GIBRALTAR DESIGN. THE OWNER MAY RETAIN COPIES FOR INFORMATION AND REFERENCE IN CONNECTION ONLY WITH THIS PROJECT.


REVISIONS	MARK	DATE	ISSUED FOR
AD-3	11/03/23	ADDENDUM NO.3	

REVISIONS	MARK	DATE	ISSUED FOR
AD-3	11/03/23	ADDENDUM NO.3	

DRAWING
EXTERIOR ELEVATIONS

PROJECT
HANOVER CSC - JANE BALL ES RENOVATIONS AND HS IMPROVEMENTS

© GIBRALTAR DESIGN SHEET
JB A-301

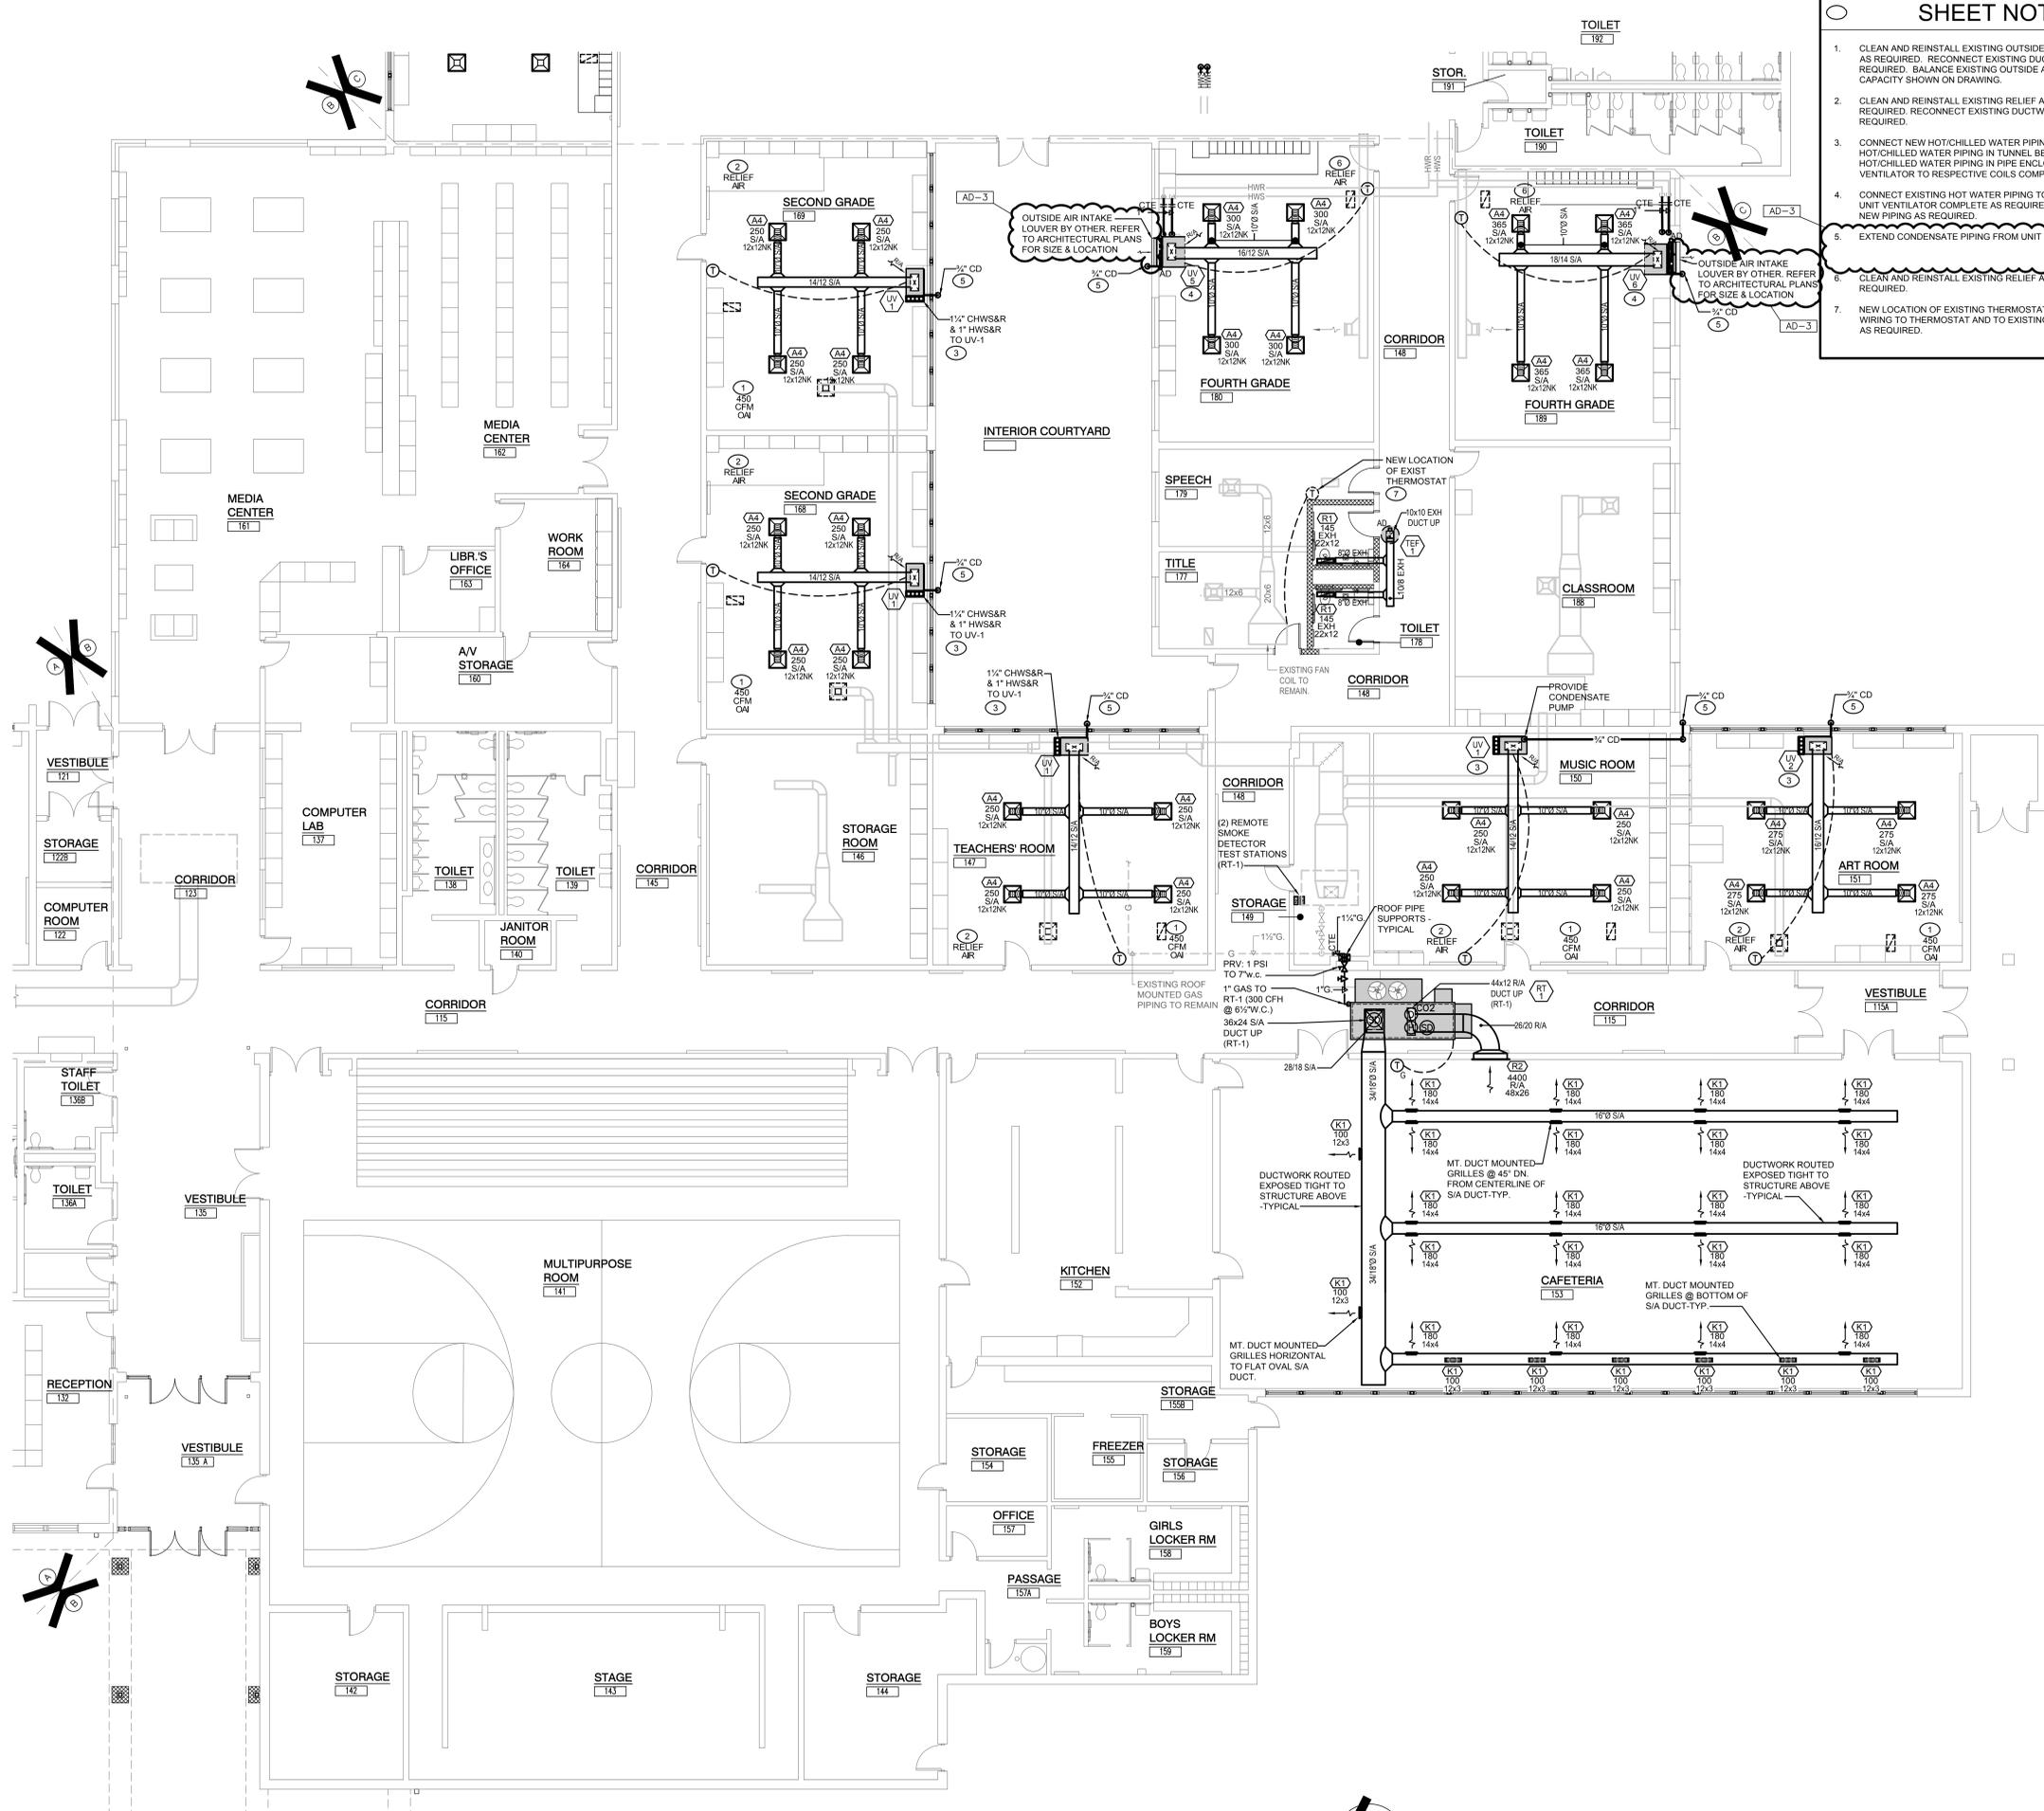


- ### SHEET NOTES
- CLEAN AND REINSTALL EXISTING OUTSIDE AIR DIFFUSER COMPLETE AS REQUIRED. RECONNECT EXISTING DUCTWORK COMPLETE AS REQUIRED. BALANCE EXISTING OUTSIDE AIR DIFFUSER TO AIRFLOW CAPACITY SHOWN ON DRAWING.
 - CLEAN AND REINSTALL EXISTING RELIEF AIR GRILLE COMPLETE AS REQUIRED. RECONNECT EXISTING DUCTWORK COMPLETE AS REQUIRED.
 - CONNECT NEW HOT/CILLED WATER PIPING TO EXISTING HOT/CILLED WATER PIPING IN TUNNEL BELOW. ROUTE NEW HOT/CILLED WATER PIPING IN PIPE ENCLOSURE AT NEW UNIT VENTILATOR TO RESPECTIVE COILS COMPLETE AS REQUIRED.
 - CONNECT EXISTING HOT WATER PIPING TO NEW SELF-CONTAINED UNIT VENTILATOR COMPLETE AS REQUIRED. PROVIDE ADDITIONAL NEW PIPING AS REQUIRED.
 - EXTEND CONDENSATE PIPING FROM UNIT THRU WALL.
 - CLEAN AND REINSTALL EXISTING RELIEF AIR GRILLE COMPLETE AS REQUIRED.
 - NEW LOCATION OF EXISTING THERMOSTAT. ROUTE NEW CONTROL WIRING TO THERMOSTAT AND TO EXISTING FAN COIL UNIT COMPLETE AS REQUIRED.



MILLIES
ENGINEERING GROUP
(317) 924-8400
www.milliesengineeringgroup.com

PROJECT
HANOVER CSC - JANE BALL ES RENOVATIONS AND HS IMPROVEMENTS
HANOVER COMMUNITY SCHOOL CORPORATION
CEDAR LAKE, INDIANA

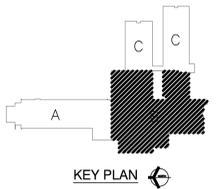

GIBRALTAR DESIGN
9102 N. Meridian St., Ste. 300
Indianapolis, IN 46260
Homepage: www.GibraltarDesign.com
Email: info@GibraltarDesign.com
Phone: 317.580.5777 Fax: 317.580.5778

PROJECT: 23-140
DATE: 10/13/23
COORDINATED BY: JC
DRAWN BY: JC, RH
CHECKED BY: DJ

REGISTERED PROFESSIONAL ENGINEER
DAVID G. JANNIE
NO. 10302590
STATE OF INDIANA

COPYRIGHT NOTICE:
THE CONCEPTS, DESIGNS, PLANS, DETAILS, ETC. SHOWN ON THIS DOCUMENT ARE THE PROPERTY OF GIBRALTAR DESIGN AND WERE CREATED FOR USE ON THIS SPECIFIC PROJECT. NONE OF THIS INFORMATION SHALL BE USED BY ANY PERSON OR FIRM FOR ANY PURPOSE WITHOUT THE EXPRESS WRITTEN CONSENT OF GIBRALTAR DESIGN. THE OWNER MAY RETAIN COPIES FOR INFORMATION AND REFERENCE IN CONNECTION ONLY WITH THIS PROJECT.

REVISIONS	MARK	DATE	ISSUED FOR
AD-2	10/30/23	ADDENDUM NO. 2	
AD-3	11/03/23	ADDENDUM NO. 3	

UNIT "B" FIRST FLOOR PLAN - MECHANICAL HVAC
1/8" = 1'-0"




DRAWING
UNIT "B" FIRST FLOOR PLAN - MECHANICAL HVAC

PROJECT
HANOVER CSC - JANE BALL ES RENOVATIONS AND HS IMPROVEMENTS

GIBRALTAR DESIGN SHEET
JB M-102

- SHEET NOTES**
- CLEAN AND REINSTALL EXISTING OUTSIDE AIR DIFFUSER COMPLETE AS REQUIRED. RECONNECT EXISTING DUCTWORK COMPLETE AS REQUIRED. BALANCE EXISTING OUTSIDE AIR DIFFUSER TO AIRFLOW CAPACITY SHOWN ON DRAWING.
 - CLEAN AND REINSTALL EXISTING RELIEF AIR GRILLE COMPLETE AS REQUIRED. RECONNECT EXISTING DUCTWORK COMPLETE AS REQUIRED.
 - CONNECT NEW HOT/CHILLED WATER PIPING TO EXISTING HOT/CHILLED WATER PIPING IN TUNNEL BELOW. ROUTE NEW HOT/CHILLED WATER PIPING IN PIPE ENCLOSURE AT NEW UNIT VENTILATOR TO RESPECTIVE COILS COMPLETE AS REQUIRED.
 - CONNECT EXISTING HOT WATER PIPING TO NEW SELF-CONTAINED UNIT VENTILATOR COMPLETE AS REQUIRED. PROVIDE ADDITIONAL NEW PIPING AS REQUIRED.
 - EXTEND CONDENSATE PIPING FROM UNIT THRU WALL.
 - CLEAN AND REINSTALL EXISTING RELIEF AIR GRILLE COMPLETE AS REQUIRED.

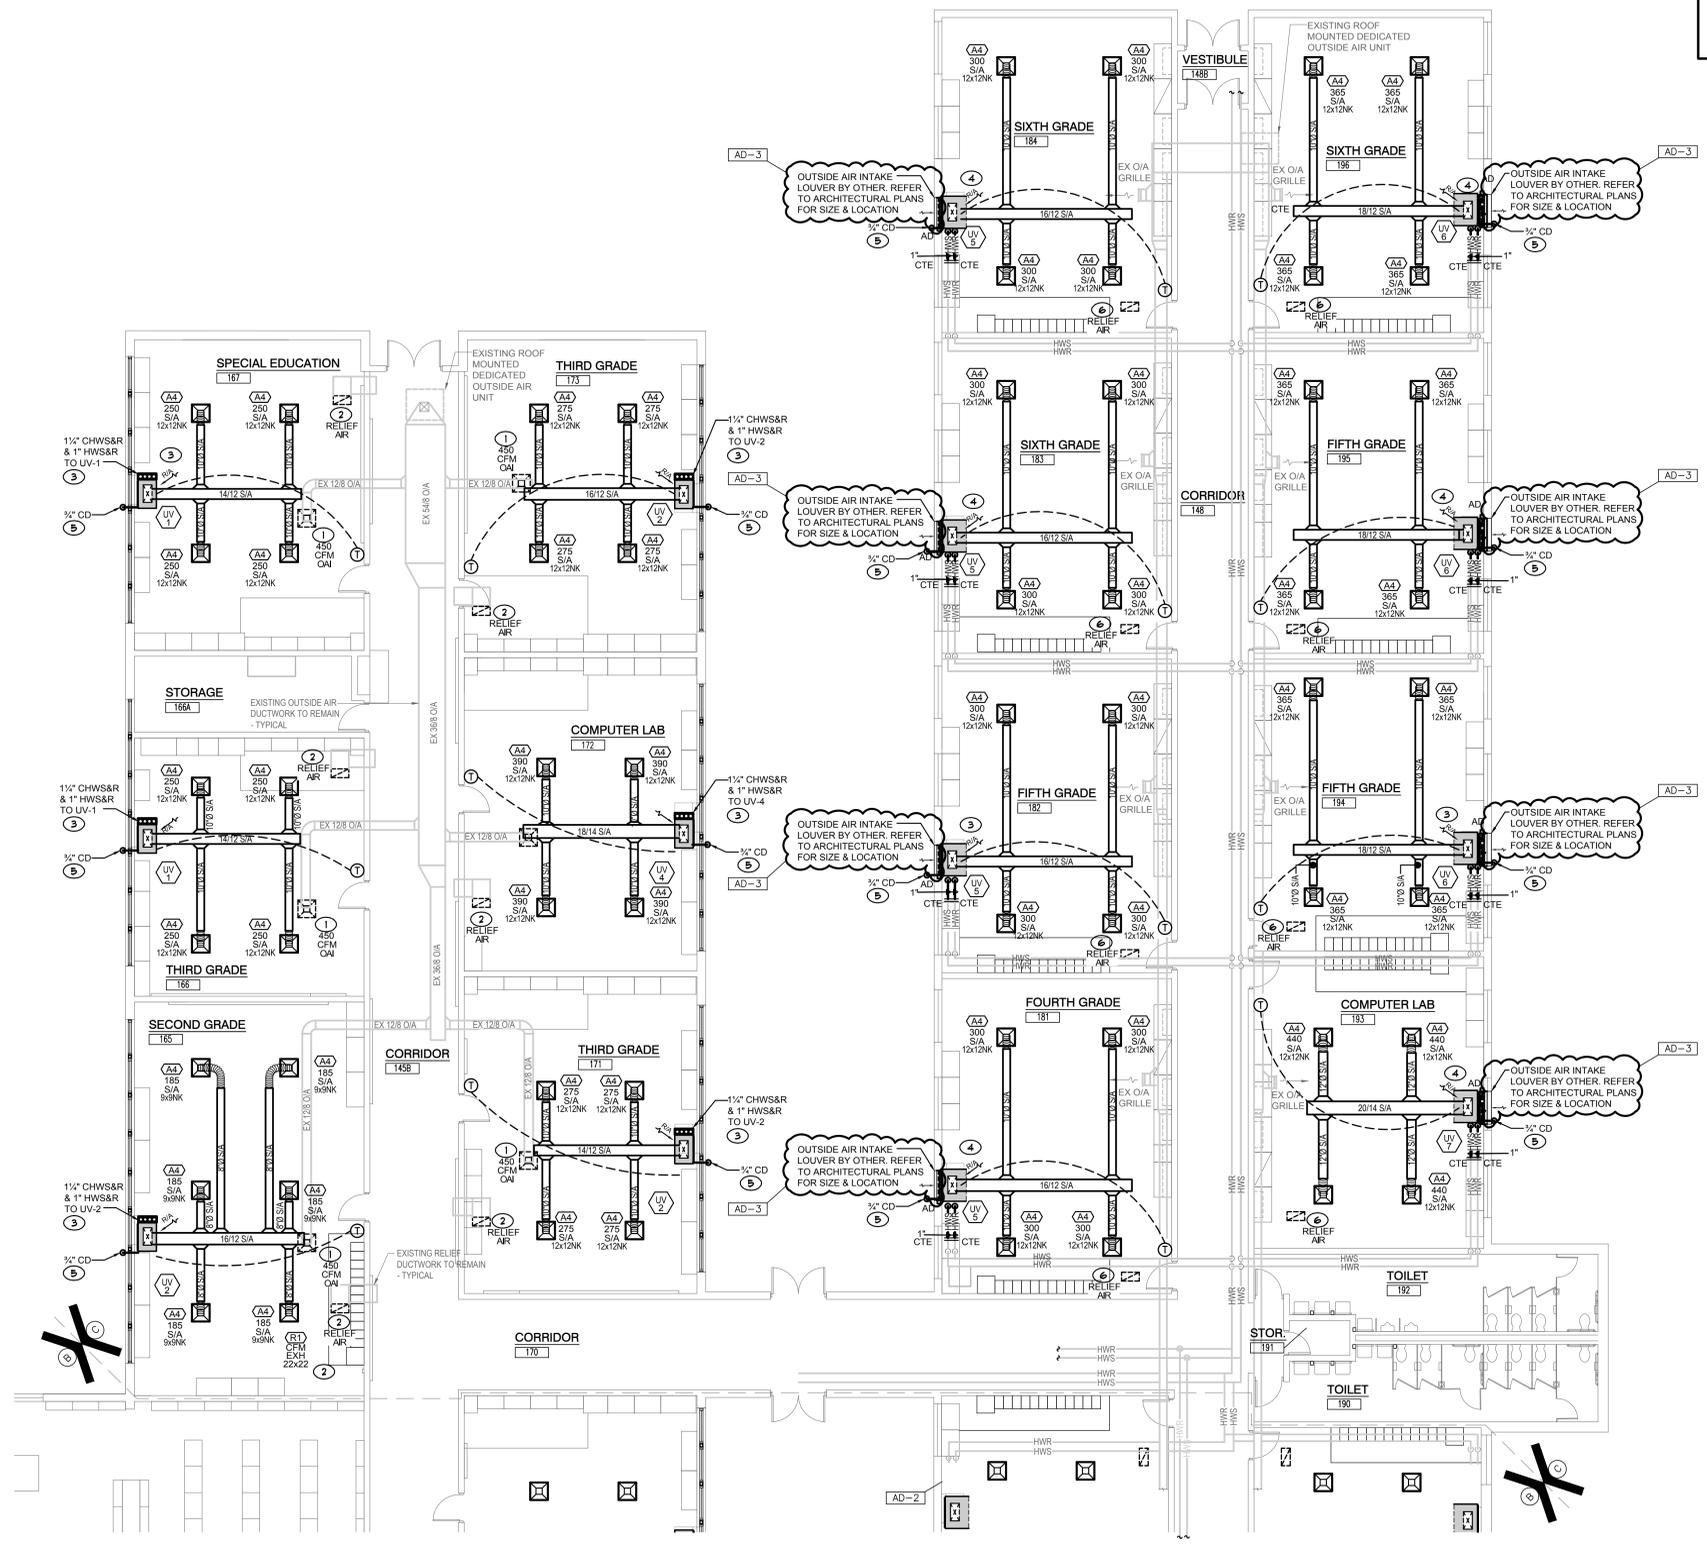


UNIT "C" FIRST FLOOR PLAN - MECHANICAL HVAC
 1/8" = 1'-0"



GIBRALTAR DESIGN
 ARCHITECTURE • ENGINEERING • INTERIOR DESIGN

MILLIES ENGINEERING GROUP
 (219) 924-8400
 www.milliesengineeringgroup.com

PROJECT
HANOVER CSC - JANE BALL ES RENOVATIONS AND HS IMPROVEMENTS
 HANOVER COMMUNITY SCHOOL CORPORATION
 CEDAR LAKE, INDIANA

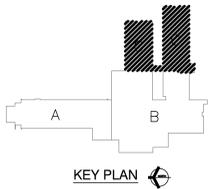

GIBRALTAR DESIGN
 9102 N. Meridian St., Ste. 300
 Indianapolis, IN 46260
 Homepage: www.GibraltarDesign.com
 Email: info@GibraltarDesign.com
 Phone: 317.580.5777 Fax: 317.580.5778

PROJECT: 23-140
 DATE: 10/13/23
 COORDINATED BY: JC
 DRAWN BY: JC, RH
 CHECKED BY: DJ

COPYRIGHT NOTICE:
 THE CONCEPTS, DESIGNS, PLANS, DETAILS, ETC. SHOWN ON THIS DOCUMENT ARE THE PROPERTY OF GIBRALTAR DESIGN AND WERE CREATED FOR USE ON THIS SPECIFIC PROJECT. NONE OF THIS INFORMATION SHALL BE USED BY ANY PERSON OR FIRM FOR ANY PURPOSE WITHOUT THE EXPRESS WRITTEN CONSENT OF GIBRALTAR DESIGN. THE OWNER MAY RETAIN COPIES FOR INFORMATION AND REFERENCE IN CONNECTION ONLY WITH THIS PROJECT.

REVISIONS	MARK	DATE	ISSUED FOR
	AD-2	10/30/23	ADDENDUM NO. 2
	AD-3	11/03/23	ADDENDUM NO. 3

DRAWING
UNIT "C" FIRST FLOOR PLAN - MECHANICAL HVAC

PROJECT
 HANOVER CSC - JANE BALL ES RENOVATIONS AND HS IMPROVEMENTS

GIBRALTAR DESIGN SHEET
JB M-103


PLUMBING FIXTURE SCHEDULE

TAG NO.	FIXTURE/EQUIPMENT TYPE	FIXTURE/EQUIPMENT DESCRIPTION	FIXTURE/EQUIPMENT MANUFACTURER AND MODEL NO.	ACCEPTABLE MANUF.	FIXTURE VALVE/FAUCET TYPE	FIXTURE VALVE/FAUCET TYPE	ACCEPTABLE MANUF.	ACCESSORIES/REMARKS (SEE SPECIFICATIONS FOR ADDITIONAL INFORMATION)
WC-1	WATER CLOSET	VITREOUS CHINA, FLOOR MOUNTED	ZURN Z5655-BWL1	NOTE 1	BATTERY SENSOR FLUSH VALVE, 1.6 GPF	ZURN ZTR6200-WS1	NOTE 2	ZURN Z5955SS-EL SEAT
WC-2	WATER CLOSET	VITREOUS CHINA, FLOOR MOUNTED ADA	ZURN Z5665-BWL 1	NOTE 1	BATTERY SENSOR FLUSH VALVE, 1.6 GPF	ZURN ZTR6200-WS1	NOTE 2	ZURN Z5955SS-EL SEAT
UR-1	URINAL	VITREOUS CHINA, WALL MOUNTED, ADA	ZURN Z5755-U	NOTE 1	BATTERY SENSOR FLUSH VALVE, 0.125 GPF	ZURN ZTR6203-ULF	NOTE 2	-
L-1	LAVATORY	VITREOUS CHINA, WALL MOUNTED, 20"x18" ADA	ZURN Z5344	NOTE 1	0.5 GPM-BATTERY SENSOR, 4" CENTERS	ZURN Z6815-XL-N-TM-V-1	NOTE 3	PROVIDED WITH THERMOSTATIC MIXING VALVE, MCGUIRE PW-2150-WC 1-1/2" PROWRAP, MCGUIRE H2107-CLCK SUPPLIES
SH-1	SHOWER	-	-	-	1.5 GPM SHOWER HEAD AND MIXING VALVE	BRADLEY WS-1WCA-6-0"-TMV-S15-LHV-SD-SHH-VS	NOTE 3	THERMOSTATIC MIXING VALVE
FD-1	FLOOR DRAIN	CAST IRON BODY, ADJUSTABLE 6"x6" NICKEL BRONZE TOP	ZURN Z415S	-	-	-	-	-

NOTE #1: AMERICAN STANDARD, KOHLER, ZURN, SLOAN
 NOTE #2: SLOAN, TOTO
 NOTE #3: SLOAN, DELTA, T&S BRASS, CHICAGO FAUCET CO.

GENERAL NOTES

- A. WORK SHALL COMPLY WITH LOCAL, MUNICIPAL, AND STATE PLUMBING CODES.
- B. THE SCOPE OF WORK SPECIFIED HEREIN AND IN THE SPECIFICATIONS SHALL BE COORDINATED WITH THE CONSTRUCTION MANAGER. REFER TO THE SCOPE OF WORK FOR EACH TRADE. ANY DISCREPANCIES BETWEEN THE CONSTRUCTION DOCUMENTS AND CONSTRUCTION MANAGERS SCOPE SHALL BE BROUGHT TO THE ATTENTION OF THE ARCHITECT/ENGINEER FOR CLARIFICATION. THE ARCHITECT/ENGINEER'S DECISION SHALL BE FINAL.
- C. LAYOUT IS DIAGRAMMATIC. INSTALL PIPING AND EQUIPMENT TO MEET ACTUAL FIELD CONDITIONS. REVIEW PROJECT SPECIFICATIONS BEFORE STARTING ANY WORK. SUBMIT SHOP DRAWINGS OF WORK AS PER SPECIFICATIONS.
- D. COORDINATE PHASING OF WORK AND PROVIDE TEMPORARY PIPING AND SERVICES AS REQUIRED FOR THE IMPLEMENTATION OF WORK WHILE MAINTAINING SERVICES TO PORTIONS OF BUILDING TO REMAIN OCCUPIED.
- E. FIELD VERIFY IF EXISTING ASBESTOS WILL BE ENCOUNTERED PRIOR TO STARTING ANY WORK. IF ASBESTOS IS PRESENT, THE OWNER WILL PROVIDE FOR THE REMOVAL OF ANY MATERIAL CONTAINING ASBESTOS. SEE SPECIFICATIONS FOR FURTHER REQUIREMENTS.
- F. LAYOUT WORK TO AVOID CONFLICTS BETWEEN DUCTWORK, LIGHTING, CEILINGS, PIPING AND BUILDING STRUCTURE.
- G. SCHEDULE WORK TO AVOID DOWNTIME AND INCONVENIENCE TO OWNER. OWNER'S EXISTING FACILITY SHALL REMAIN IN OPERATION AT TIMES. REQUIRED SHUTDOWN OF EXISTING UTILITIES SHALL BE SCHEDULED WITH OWNER'S OPERATING PERSONNEL. NOTIFY OWNER'S REPRESENTATIVE 48 HOURS IN ADVANCE PRIOR TO ANY SHUTDOWN OF EXISTING PLUMBING SYSTEMS.
- H. VERIFY LOCATION AND ELEVATION OF PLUMBING EQUIPMENT, FIXTURES, PIPING, PANELS, ETC. EXPOSED WITHIN OCCUPIED SPACES BEFORE THE START OF ANY ROUGH-IN OR INSTALLATION.
- I. VISIT SITE PRIOR TO BIDDING TO DETERMINE FIELD CONDITIONS. VERIFY EXISTING INTERIOR AND EXTERIOR PLUMBING SYSTEMS TO VERIFY QUANTITIES AND LOCATIONS OF EXISTING SYSTEMS TO DETERMINE EXTENT OF NEW AND DEMOLITION WORK. VERIFY EXISTING INTERIOR AND EXTERIOR STORM AND SANITARY PIPING SYSTEMS AS TO ROUTING, SIZE AND INVERT ELEVATION PRIOR TO ANY INSTALLATION OF NEW AND REMOVAL OF ANY EXISTING.
- J. COORDINATE NEW INSTALLATIONS WITH EXISTING SYSTEMS. ANY EXISTING CONDUIT, PIPING, DUCTWORK, EQUIPMENT, ETC., SHALL BE REWORKED AS REQUIRED TO AVOID CONFLICTS WITH THE INSTALLATION OF THE NEW PLUMBING SYSTEMS. NO EXTRAS WILL BE ALLOWED AFTER BIDDING FOR ANY REWORK OF EXISTING FIELD CONDITIONS TO RESOLVE ANY CONFLICTS OR NOT FULLY UNDERSTANDING THE SCOPE OF THE WORK REQUIRED. EXISTING EQUIPMENT, FIXTURES AND PIPING, ETC., SHALL BE REMOVED AS NOTED ON DRAWINGS AND AS REQUIRED TO MEET NEW SCOPE OF WORK.
- K. REMOVE EXISTING EQUIPMENT, FIXTURES, PIPING, ETC. PRESENTLY SERVING AREAS THAT ARE BEING RENOVATED AND THAT ARE NOT REQUIRED TO STAY IN SERVICE. NO EQUIPMENT, PIPING, SUPPORTS, HANGERS, ETC. IS TO BE LEFT ABANDONED. VERIFY QUANTITY, LOCATION AND ELEVATION OF EXISTING TO BE REMOVED IN FIELD. REMOVE EXISTING ABANDONED EQUIPMENT, FIXTURES AND PIPING IN AREAS THAT ARE TO BE RENOVATED.
- L. EXISTING INFORMATION IDENTIFIED ON THE CONTRACT DOCUMENTS IS SCHEMATIC ONLY AS AN AID TO THE CONTRACTOR. PROPERLY ADDRESS EXISTING CONDITIONS FOR A COMPLETE AND PROPER INSTALLATION OF NEW SYSTEMS. EXISTING EQUIPMENT NOT IDENTIFIED SHALL BE REPORTED IN WRITTEN FORM FOR REVIEW AS TO WHETHER THE EQUIPMENT SHALL REMAIN AND BE RECONNECTED TO THE NEW SERVICES, BE RELOCATED, BE ABANDONED, ETC.
- M. ANY HIDDEN CONDITIONS IDENTIFIED THROUGH THE COURSE OF CONSTRUCTION SHALL BE IMMEDIATELY REPORTED IN WRITTEN FORM FOR REVIEW AND DIRECTION. FAILURE TO DO SO SHALL MAKE THE CONTRACTOR RESPONSIBLE FOR ANY REQUIRED CHANGES AND COSTS TO CORRECT SAID HIDDEN CONDITION.
- N. EXISTING EQUIPMENT SHALL REMAIN PROPERTY OF THE OWNER AND OWNER SHALL DETERMINE IF CONTRACTOR IS TO STORE EQUIPMENT ON SITE AT OWNER SELECTED LOCATION OR IF CONTRACTOR IS TO ABANDON OR REMOVE EQUIPMENT FROM SITE.
- O. PATCH EXISTING CEILING, FLOOR, WALL AND ROOF OPENINGS AND SURROUNDING FINISHES RESULTING FROM REMOVAL OF EXISTING MATERIALS AND EQUIPMENT SO THAT FINISH WILL MATCH EXISTING IN SURROUNDING AREAS.
- P. REMOVE EXISTING CEILINGS REQUIRED FOR INSTALLATION OF NEW WORK. REINSTALL CEILING UPON COMPLETION OF WORK. REPLACE DAMAGED CEILING MATERIALS TO MATCH EXISTING.
- Q. PROVIDE CUTTING, CORE DRILLING AND PATCHING OF EXISTING FLOOR AND WALL CONSTRUCTIONS REQUIRED FOR THE INSTALLATION OF NEW PIPING. SEAL PENETRATIONS THROUGH FLOOR, WALL AND ROOF STRUCTURE WATER TIGHT AND WITH AN APPROVED FIRE STOPPING MATERIAL, INCLUDING APPROVED FIRE RATED SLEEVE.
- R. PROVIDE CUTTING, TRENCHING AND PATCHING OF EXISTING FLOOR SLAB REQUIRED FOR THE INSTALLATION OF NEW UNDERGROUND PIPING.
- S. CUT OR CHANNEL INTO EXISTING WALL CONSTRUCTIONS AS REQUIRED FOR INSTALLATION OF NEW PIPING WITHIN EXISTING WALLS. PATCH WALL SURFACES AND FINISH AS REQUIRED TO MATCH EXISTING CONDITIONS.
- T. PROVIDE ROUGH-IN AND FINAL CONNECTIONS TO PLUMBING EQUIPMENT AND FIXTURES. SET FIXTURES/EQUIPMENT AND FURNISH AND INSTALL NECESSARY FITTINGS, TRAPS, STOPS, ETC. AS REQUIRED.
- U. PLUMBING PIPING ROUTING TO BE FIELD COORDINATED WITH NEW AND EXISTING HVAC DUCTWORK, HVAC PIPING, FIRE PROTECTION PIPING, ELECTRICAL AND STRUCTURE TO ENSURE NO CONFLICTS WILL OCCUR DUE TO INTERFERENCE.
- V. REFER TO ARCHITECTURAL INTERIOR ELEVATIONS FOR FINAL MOUNTING HEIGHTS OF PLUMBING FIXTURES.
- W. PROTECT NEW AND EXISTING DRAIN OPENINGS AND SANITARY LINES DURING CONSTRUCTION TO PREVENT BLOCKAGE. ROD-OUT EXISTING SANITARY PIPING. PIPING SHALL BE FREE OF BLOCKAGE.
- X. REPAIR AND/OR REPLACE DAMAGED PIPE INSULATION THAT OCCURS AS THE RESULT OF THIS CONSTRUCTION.

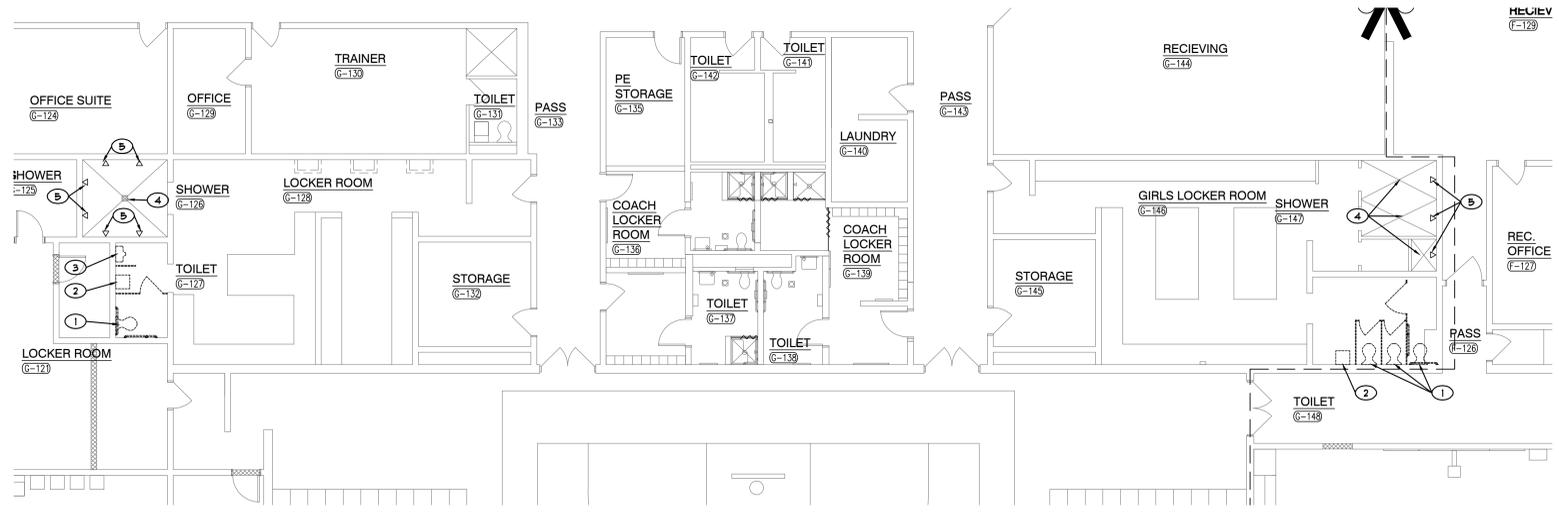


LOCKER ROOM PLUMBING DEMOLITION PLAN

1/8" = 1'-0"



- DEMOLITION SHEET NOTES**
1. REMOVE EXISTING WATER CLOSET AND ASSOCIATED SANITARY, VENT AND DOMESTIC WATER CONNECTIONS COMPLETE AS REQUIRED.
 2. REMOVE EXISTING LAVATORY AND ASSOCIATED SANITARY, VENT AND DOMESTIC WATER CONNECTIONS COMPLETE AS REQUIRED.
 3. REMOVE EXISTING URINAL AND ASSOCIATED SANITARY, VENT AND DOMESTIC WATER CONNECTIONS COMPLETE AS REQUIRED.
 4. REMOVE EXISTING FLOOR DRAIN AND ALL ASSOCIATED VENT PIPING AND CAP EXISTING SANITARY BELOW FLOOR AIR/WATER TIGHT COMPLETE AS REQUIRED.
 5. REMOVE EXISTING SHOWER AND FAUCET AND ALL ASSOCIATED HOT/COLD WATER, SANITARY AND VENT PIPING COMPLETE AS REQUIRED.

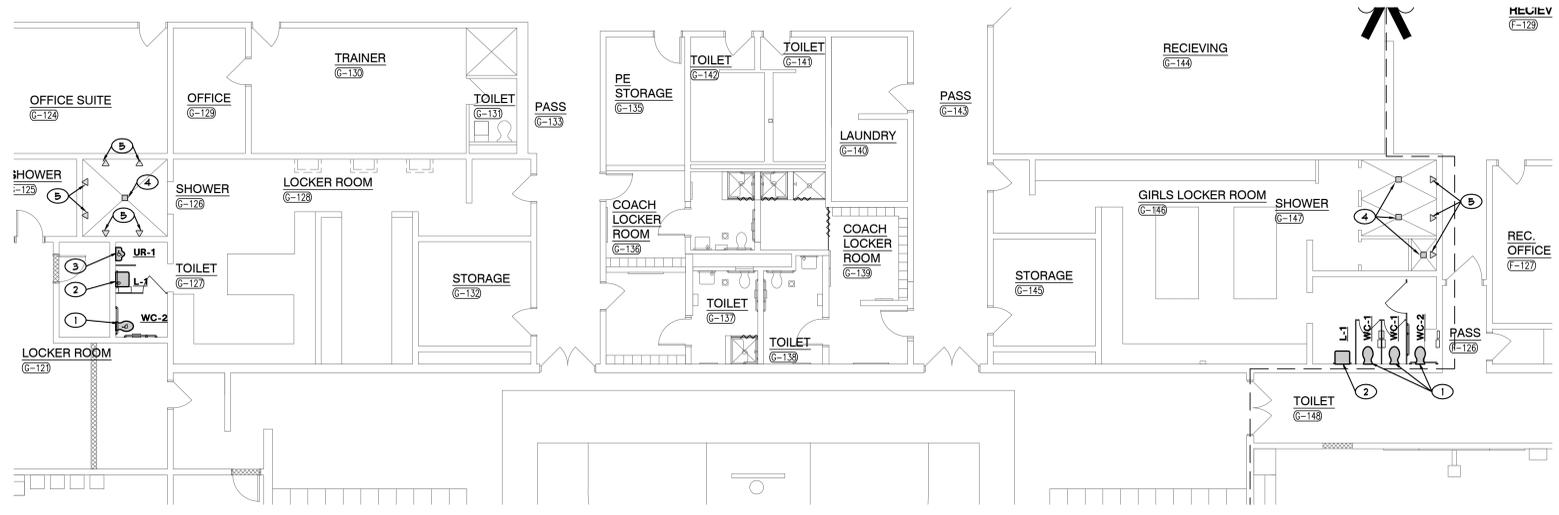

LOCKER ROOM PLUMBING PLAN

1/8" = 1'-0"



- SHEET NOTES**
1. NEW FLOOR MOUNTED WATER CLOSET. CONNECT TO EXISTING SANITARY, VENT AND DOMESTIC WATER COMPLETE AS REQUIRED.
 2. NEW WALL MOUNTED LAVATORY. CONNECT TO EXISTING SANITARY, VENT AND DOMESTIC WATER CONNECTIONS COMPLETE AS REQUIRED.
 3. NEW WALL MOUNTED URINAL. CONNECT TO EXISTING SANITARY, VENT AND DOMESTIC WATER CONNECTIONS COMPLETE AS REQUIRED.
 4. NEW FLOOR DRAIN AND ALL ASSOCIATED VENT PIPING AND SANITARY BELOW FLOOR AIR/WATER TIGHT COMPLETE AS REQUIRED.
 5. NEW SHOWER AND FAUCET AND ALL ASSOCIATED HOT/COLD WATER, SANITARY AND VENT PIPING COMPLETE AS REQUIRED.



GIBRALTAR DESIGN
 ARCHITECTURE • ENGINEERING • INTERIOR DESIGN



PROJECT
HANOVER CSC - JANE BALL ES RENOVATIONS AND HS IMPROVEMENTS
 HANOVER COMMUNITY SCHOOL CORPORATION
 CEDAR LAKE, INDIANA

GIBRALTAR DESIGN
 9102 N. Meridian St., Ste. 300
 Indianapolis, IN 46260
 Homepage: www.GibraltarDesign.com
 Email: info@GibraltarDesign.com
 Phone: 317.580.5777 Fax: 317.580.5778

PROJECT: 23-143
 DATE: 10/13/23
 COORDINATED BY: JC
 DRAWN BY: JC, RH
 CHECKED BY: DJ

COPYRIGHT NOTICE:
 THE CONCEPTS, DESIGNS, PLANS, DETAILS, ETC. SHOWN ON THIS DOCUMENT ARE THE PROPERTY OF GIBRALTAR DESIGN AND WERE CREATED FOR USE ON THIS SPECIFIC PROJECT. NONE OF THIS INFORMATION SHALL BE USED BY ANY PERSON OR FIRM FOR ANY PURPOSE WITHOUT THE EXPRESS WRITTEN CONSENT OF GIBRALTAR DESIGN. THE OWNER MAY RETAIN COPIES FOR INFORMATION AND REFERENCE IN CONNECTION ONLY WITH THIS PROJECT.

REVISIONS	MARK	DATE	ISSUED FOR
AD-3	11/03/23	ADDENDUM NO. 3	

DRAWING
LOCKER ROOM PLUMBING DEMOLITION/NEW PLAN

PROJECT
HANOVER CSC - JANE BALL ES RENOVATIONS AND HS IMPROVEMENTS

GIBRALTAR DESIGN SHEET
HS P110