

**ADDENDUM  
NO. 2**

**December 22, 2023**

**Jeffersonville High School Aquatic Center – New Facility  
2315 Allison Ln  
Jeffersonville, IN 47130**

**TO: ALL BIDDERS OF RECORD**

This Addendum forms a part of and modifies the Bidding Requirements, Contract Forms, Contract Conditions, the Specifications, and the Drawings dated November 20, 2023, by Fanning Howey Associates, Inc. Acknowledge receipt of the Addendum in the space provided on the Bid Form. Failure to do so may subject the Bidder to disqualification.

This Addendum consists of Pages ADD 2-1 through ADD 2-2 and attached Fanning Howey Associates Addendum No. 2, dated December 21, 2023, consisting of 2 pages, and Addendum 2 Drawings: A1.02, A6.03, A6S.01, A9.21, M0.02, M0.03, M1.03, and E1.02.

**A. SPECIFICATION SECTION 00 00 10 – TITLE PAGE**

**BIDDERS' CONTACTS:**

Revise as follows:

Project Manager: Tim Brown

Phone: 317-694-5434

**B. SPECIFICATION SECTION 00 10 00 – INSTRUCTIONS TO BIDDERS**

1.05 Approval Before Bidding

Revise the following:

D. Requests for product approval shall be submitted on the sample form following this Section and to: **The Skillman Corporation, attention Tim Brown [tdbrown@skillman.com](mailto:tdbrown@skillman.com)**

**C. SPECIFICATION SECTION 01 12 00 – MULTIPLE CONTRACT SUMMARY**

1. Paragraph 3.03 Bid Categories

**A. Bid Category No. 1 – Earthwork & Site Utilities**

Add the following Clarifications:

10. Provide all site sanitary and storm complete per the Civil Drawing requirements.

**B. Bid Category No. 2 – General Trades**

Add the following Clarifications:

18. Provide all exterior fencing, handrails, and bollards as referenced in the Civil Drawings.

**E. Bid Category No. 5 – Structural Steel**

Add the following Clarifications:

3. Exterior fencing, handrails, and bollards to be provided by Bid Category 2.

ADDENDUM NO. 2

Jeffersonville High School Natatorium

Greater Clark County Schools  
Jeffersonville, Indiana

Project No. 222038.00

Index of Contents

Addendum No. 2, 5 items, 2 pages  
Revised Drawing Sheets: A1.02, A6.03, A6S.01, A9.21, M0.02, M0.03, M1.03, and E1.02

Date: December 21, 2023

I hereby certify that this Addendum was prepared by me or under my direct supervision and that I am a duly registered Architect/Engineer under the Laws of the State of Indiana.

FANNING/HOWEY ASSOCIATES, INC.  
ARCHITECTS/ENGINEERS/CONSULTANTS



Paul A. Miller, License No. AR10800161  
Expiration Date: 12/31/2023

TO: ALL BIDDERS OF RECORD

ADDENDUM NO. to Drawings and Project Manual, dated November 20, 203, for Jeffersonville High School Natatorium for Greater Clark County Schools, 2112 Utica-Sellersburg Road, Jeffersonville, Indiana 47130; as prepared by Fanning/Howey Associates, Inc., Indianapolis, Indiana.  
This Addendum shall hereby be and become a part of the Contract Documents the same as if originally bound thereto.

The following clarifications, amendments, additions, revisions, changes, and modifications change the original Contract Documents only in the amount and to the extent hereinafter specified in this Addendum.

Each bidder shall acknowledge receipt of this Addendum in his proposal or bid.

NOTE: Bidders are responsible for becoming familiar with every item of this Addendum. (This includes miscellaneous items at the very end of this Addendum.)

RE: ALL BIDDERS

ITEM NO. 1. PROJECT MANUAL, SECTION 07 25 00 – WEATHER BARRIERS

A. Replace 2.1, A., 1., e., as follows:

“e. Wrapshield IT ; VaproShield LLC”

ITEM NO. 2. PROJECT MANUAL, SECTION 09 51 13 – ACOUSTICAL PANEL CEILINGS

A. Replace 2.6, C., 3., as follows:

“3. Profile and Size: “Elevation Change” profile in size as indicated on Drawings.”

ITEM NO. 3. PROJECT MANUAL, SECTION 10 28 00 – TOILET, BATH, AND LAUNDRY ACCESSORIES

A. Delete 2.6, A., 1., in its entirety.

ITEM NO. 4. ACCEPTABLE MANUFACTURERS

The following manufacturers are to be considered acceptable manufacturers (suppliers and fabricators) for the Sections of the Specifications listed. Listed manufacturers are required to bid on products equal in type and design, size, function, and quality to that originally specified. Final decision as to equality of products specified versus those proposed shall be made by the Architect.

Section 09 67 12 – Fluid-Applied Epoxy Flooring  
- PPG Flooring

Section 09 67 23 – Decorative Resinous Flooring  
- PPG Flooring

Section 22 11 19 – Domestic Water Piping Specialties  
- Powers, Watts, Zurn (Thermostatic Mixing Valves)

ITEM NO. 5. REVISED DRAWING SHEET

- A. Drawing Sheets A1.02, A6.03, A6S.01, A9.21, M0.02, M0.03, M1.03, and E1.02 have been revised, dated 12/21/23, and are included with and hereby made a part of this Addendum. These Drawings supersede the original documents.

END OF ADDENDUM

# JEFFERSONVILLE HIGH SCHOOL NATATORIUM

2315 ALLISON LN.  
JEFFERSONVILLE, IN 47130


GREATER CLARK  
COUNTY SCHOOLS



ARCHITECT



317-848-0966 WWW.FHAI.COM  
350 EAST NEW YORK ST.

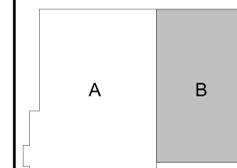

KEY PLAN

ISSUED FOR CONSTRUCTION



PROJECT MANAGER: JM  
DRAWN BY: BMD  
PROJECT NUMBER: 222038.00  
PROJECT ISSUE DATE: 11/20/2023

REV. NO.	DESCRIPTION	DATE
1	ADDENDUM #2	12/21/2023

UNIT B - FIRST FLOOR  
ARCHITECTURAL PLAN

## A1.02

- ARCHITECTURAL PLAN GENERAL NOTES**
- ALL CMU WALLS THAT DO NOT LAY OUT IN FULL OR HALF LENGTHS SHOULD BE BALANCED SO AS NOT TO HAVE ANY PIECES LESS THAN 4" IN SIZE EXPOSED TO VIEW.
  - WHERE DISSIMILAR FLOOR MATERIALS MEET, THEY SHALL DO SO UNDER THE CENTERLINE OF THE DOOR, UNLESS NOTED OTHERWISE.
  - THE BASE FLOOR ELEVATION INDICATED FOR THE PROJECT IS 100'-0". REFER TO SITE PLAN FOR CORRELATION TO USGS DATUM.
  - ALL INTERIOR MASONRY WALLS THAT RUN TO UNDERSIDE OF DECK ABOVE SHALL HAVE A 2" JOINT (U.N.O.) AT THE DECK TO BE FILLED WITH FIRE STOPPING AT RATED WALLS PER PROJECT MANUAL AND MINERAL WOOL AT THE NON-RATED WALLS TO ALLOW FOR DEFLECTION. REFER TO SHEET A1.41 FOR TYPICAL COMMON JOINT DETAILS AND CONSTRUCTION MOVEMENT JOINT DETAILS REFER TO DETAILS ON SHEET A1.42.
  - ALL DIMENSIONS ON FLOOR PLANS ARE TO FINISH FACE OF CMU, CONCRETE, BRICK OR FINISH FACE OF GWB AT METAL STUD WALLS, UNLESS NOTED OTHERWISE. EXCEPTION: EXTERIOR METAL STUD WALLS ARE TO FACE OF METAL STUDS.
  - HINGE SIDE DOOR JAMB AT WALLS WILL TYPICALLY BE LOCATED 4" MINIMUM FROM ADJACENT WALL UNLESS NOTED OTHERWISE.
  - ALL EXPOSED CONCRETE MASONRY UNITS (CMU) CORNERS ARE TO BE BULLNOSE, EXCEPT AT WINDOW JAMBS, BULKHEADS, WINDOW AND DOOR HEADS.
  - SEE REFLECTED CEILING PLANS (R.C.P.) FOR BULKHEAD LOCATIONS AND DETAIL REFERENCES. REFER TO ROOM FINISH SCHEDULE AND EQUIPMENT PLANS FOR LOCATION AND EXTENT OF FINISH FLOOR MATERIALS UNLESS NOTED OTHERWISE.
  - PROVIDE WOOD BLOCKING, AS REQUIRED, WITHIN METAL STUD WALLS FOR WALL MOUNTED ITEMS. REFER TO MASTER CODE PLANS FOR CODE INFORMATION AND FIRE RATED WALL LOCATIONS.
  - PROVIDE SPRAY FOAM INSULATION AND THERMAL BARRIER CONTINUOUS AT INTERSECTION OF EXTERIOR WALLS AND DECK.
  - SF = GLAZED ALUMINUM STOREFRONT SYSTEM. REFER TO FLOOR PLANS AND A6.02.
  - CW = GLAZED ALUMINUM CURTAIN WALL SYSTEM. REFER TO FLOOR PLANS AND A6.02.
  - WW = GLAZED ALUMINUM WINDOW WALL SYSTEM. REFER TO FLOOR PLANS AND A6.02.
  - ALL EXPOSED STEEL COLUMNS TO BE PAINTED.
  - L = ALUMINUM FIXED LOUVER WITH S.S. ANCHORS. REFER TO FLOOR PLANS, MECHANICAL DRAWINGS AND A6.02.
  - PRECAST ARCHITECTURAL CONCRETE WALL PANEL - PROVIDE 3/4" CHAMFER ON EXPOSED CORNERS (TYP) \*DELETE CHAMFER WHEN FINISH MATERIALS, RE WALLS AND OR CEILINGS. ALIGN / ABUT AN EXPOSED CORNER OR WHEN AN EXPOSED CORNER IS HIDDEN FROM VIEW AND AT OPENINGS WHERE FRAMES, TRACKS, GUIDES OR EQUIPMENT ARE MOUNTED. REFER TO WALL SECTIONS, DETAILS, HEADS, JAMBS AND SILLS ETC.

- ARCHITECTURAL PLAN NOTES**  
(ALL NOTES MAY NOT BE INDICATED ON THIS SHEET)
- ##### INDICATES WALL TYPE. REFER TO DRAWING A1.41 FOR WALL THICKNESS, HEIGHT AND COMPOSITION.


- NO. DESCRIPTION**
- PROVIDE A 84" WIDE X 18" HIGH OPENING AT 2' AFF IN PRECAST WALL FOR MECHANICAL PIPING. INFILL OPENING WITH 4" EIFS ON 5/8" SHEATHING ON 3 5/8" METAL STUDS WITH IFPS ON 1/2" GYP SHEATHING. COORDINATE PIPE PENETRATIONS WITH MECHANICAL DRAWINGS.
  - DASHED LINE INDICATES BULKHEAD/SOFFIT ABOVE. REFER TO CEILING PLANS.
  - EXPOSED STRUCTURAL COLUMN. PAINT.
  - ROOF HATCH WITH FIXED ACCESS LADDER (S/M TO O'KEEFE'S #500). REFER TO ROOF PLAN AND 6-6.02.03.
  - MECHANICAL YARD SCREEN WALL. REFER TO CIVIL DRAWINGS.
  - TRANSFORMER SCREEN WALL. REFER TO CIVIL DRAWINGS.
  - PROVIDE A LOCK BOX IN METAL PLATE WALL PANEL.
  - PROVIDE A 52" WIDE X 18" HIGH OPENING AT 2' AFF IN PRECAST WALL FOR MECHANICAL PIPING. INFILL OPENING WITH 4" EIFS ON 5/8" SHEATHING ON 3 5/8" METAL STUDS WITH IFPS ON 1/2" GYP SHEATHING. COORDINATE PIPE PENETRATIONS WITH MECHANICAL DRAWINGS.
  - PROVIDE 5/8" GWB (LEVEL 5 FINISH) ON 7/8" FLUORING CHANNELS 16" O.C. TO 4" ABOVE CEILING.
  - ALIGN FACE OF GWB WITH FACE OF PRECAST COLUMN.
  - RECORDS BOARD. REFER TO INTERIOR ELEVATIONS.
  - DAMP PROOFING W/ PROTECTION COURSE.
  - SCORE BOARD. REFER TO INTERIOR ELEVATIONS.
  - DASHED LINE INDICATES FACE OF WALL ABOVE. REFER TO CEILING PLANS.
  - 42" X 20" ADA BENCH. REFER TO A7 SERIES DETAILS.
  - REFER TO SHEET A7.01 FOR TROPHY CASE DETAILS.

**VERIFICATION NOTE**  
CONTRACTOR SHALL VERIFY ALL DIMENSIONS AND CLEARANCES AND ALL EXISTING FIELD CONDITIONS BEFORE STARTING CONSTRUCTION. COMMENCEMENT OF WORK CONSTITUTES ACCEPTANCE OF CONDITIONS. SHOULD DIFFERENT CONDITIONS BE ENCOUNTERED, CONTACT THE ARCHITECT BEFORE PROCEEDING WITH WORK.

**ROOM LEGEND - FIRST FLOOR UNIT B**

ROOM NO.	OWNER ROOM NO.	ROOM NAME	AREA (SF)
B101		CORRIDOR	1667 SF
B102		ALCOVE	53 SF
B103		FOOTBALL LOCKERS	1533 SF
B104		OFFICE	213 SF
B105		RESTROOM	61 SF
B106A		RESTROOM	199 SF
B106B		SHOWERS	137 SF
B107		LAUNDRY STORAGE	595 SF
B108		ELECTRICAL PANEL	42 SF
B109		GIRLS TRACK	265 SF
B110		OFFICE	64 SF
B111		RESTROOM	113 SF
B112		BOYS TRACK	276 SF
B113		OFFICE	64 SF
B114		RESTROOM	112 SF
B115		TECHNOLOGY	45 SF
B116		VESTIBULE	74 SF
B117A		ALCOVE	59 SF
B117B		ALCOVE	61 SF
B118		GIRLS SWIM	675 SF
B119		RESTROOM	253 SF
B120		OFFICE	134 SF
B121		RESTROOM	99 SF
B122		ALCOVE	65 SF
B123		RESTROOM	65 SF
B124		GIRLS PE SWIM	664 SF
B125		TRAINING	581 SF
B126		RESTROOM	253 SF
B127		OFFICE	137 SF
B128		RESTROOM	64 SF
B129		ALCOVE	61 SF
B130A		ALCOVE	59 SF
B130B		ALCOVE	61 SF
B131		BOYS PE SWIM	666 SF
B132		RESTROOM	253 SF
B133		OFFICE	137 SF
B134		RESTROOM	64 SF
B135		VESTIBULE	229 SF
B136		ALCOVE	65 SF
B137		RESTROOM	65 SF
B138		BOYS SWIM	664 SF
B139		OFFICE	137 SF
B140		RESTROOM	64 SF
B141		RESTROOM	253 SF
B142		ALCOVE	61 SF
B143		STORAGE	174 SF
B144		COMPETITION POOL DECK	6283 SF
B145		COMPETITION POOL	11263 SF
B146		TIMING PLATFORM	132 SF
B147		CORRIDOR	110 SF
B148		RESTROOM	65 SF
B149		RESTROOM	95 SF
B150		STAIR B	197 SF
B151		WATER SERVICE	132 SF
B153		SHOWERS	61 SF
B154		SHOWERS	61 SF
Grand Total			39040 SF

**UNIT B - FIRST FLOOR ARCHITECTURAL PLAN**  
SCALE: 1/8" = 1'-0"

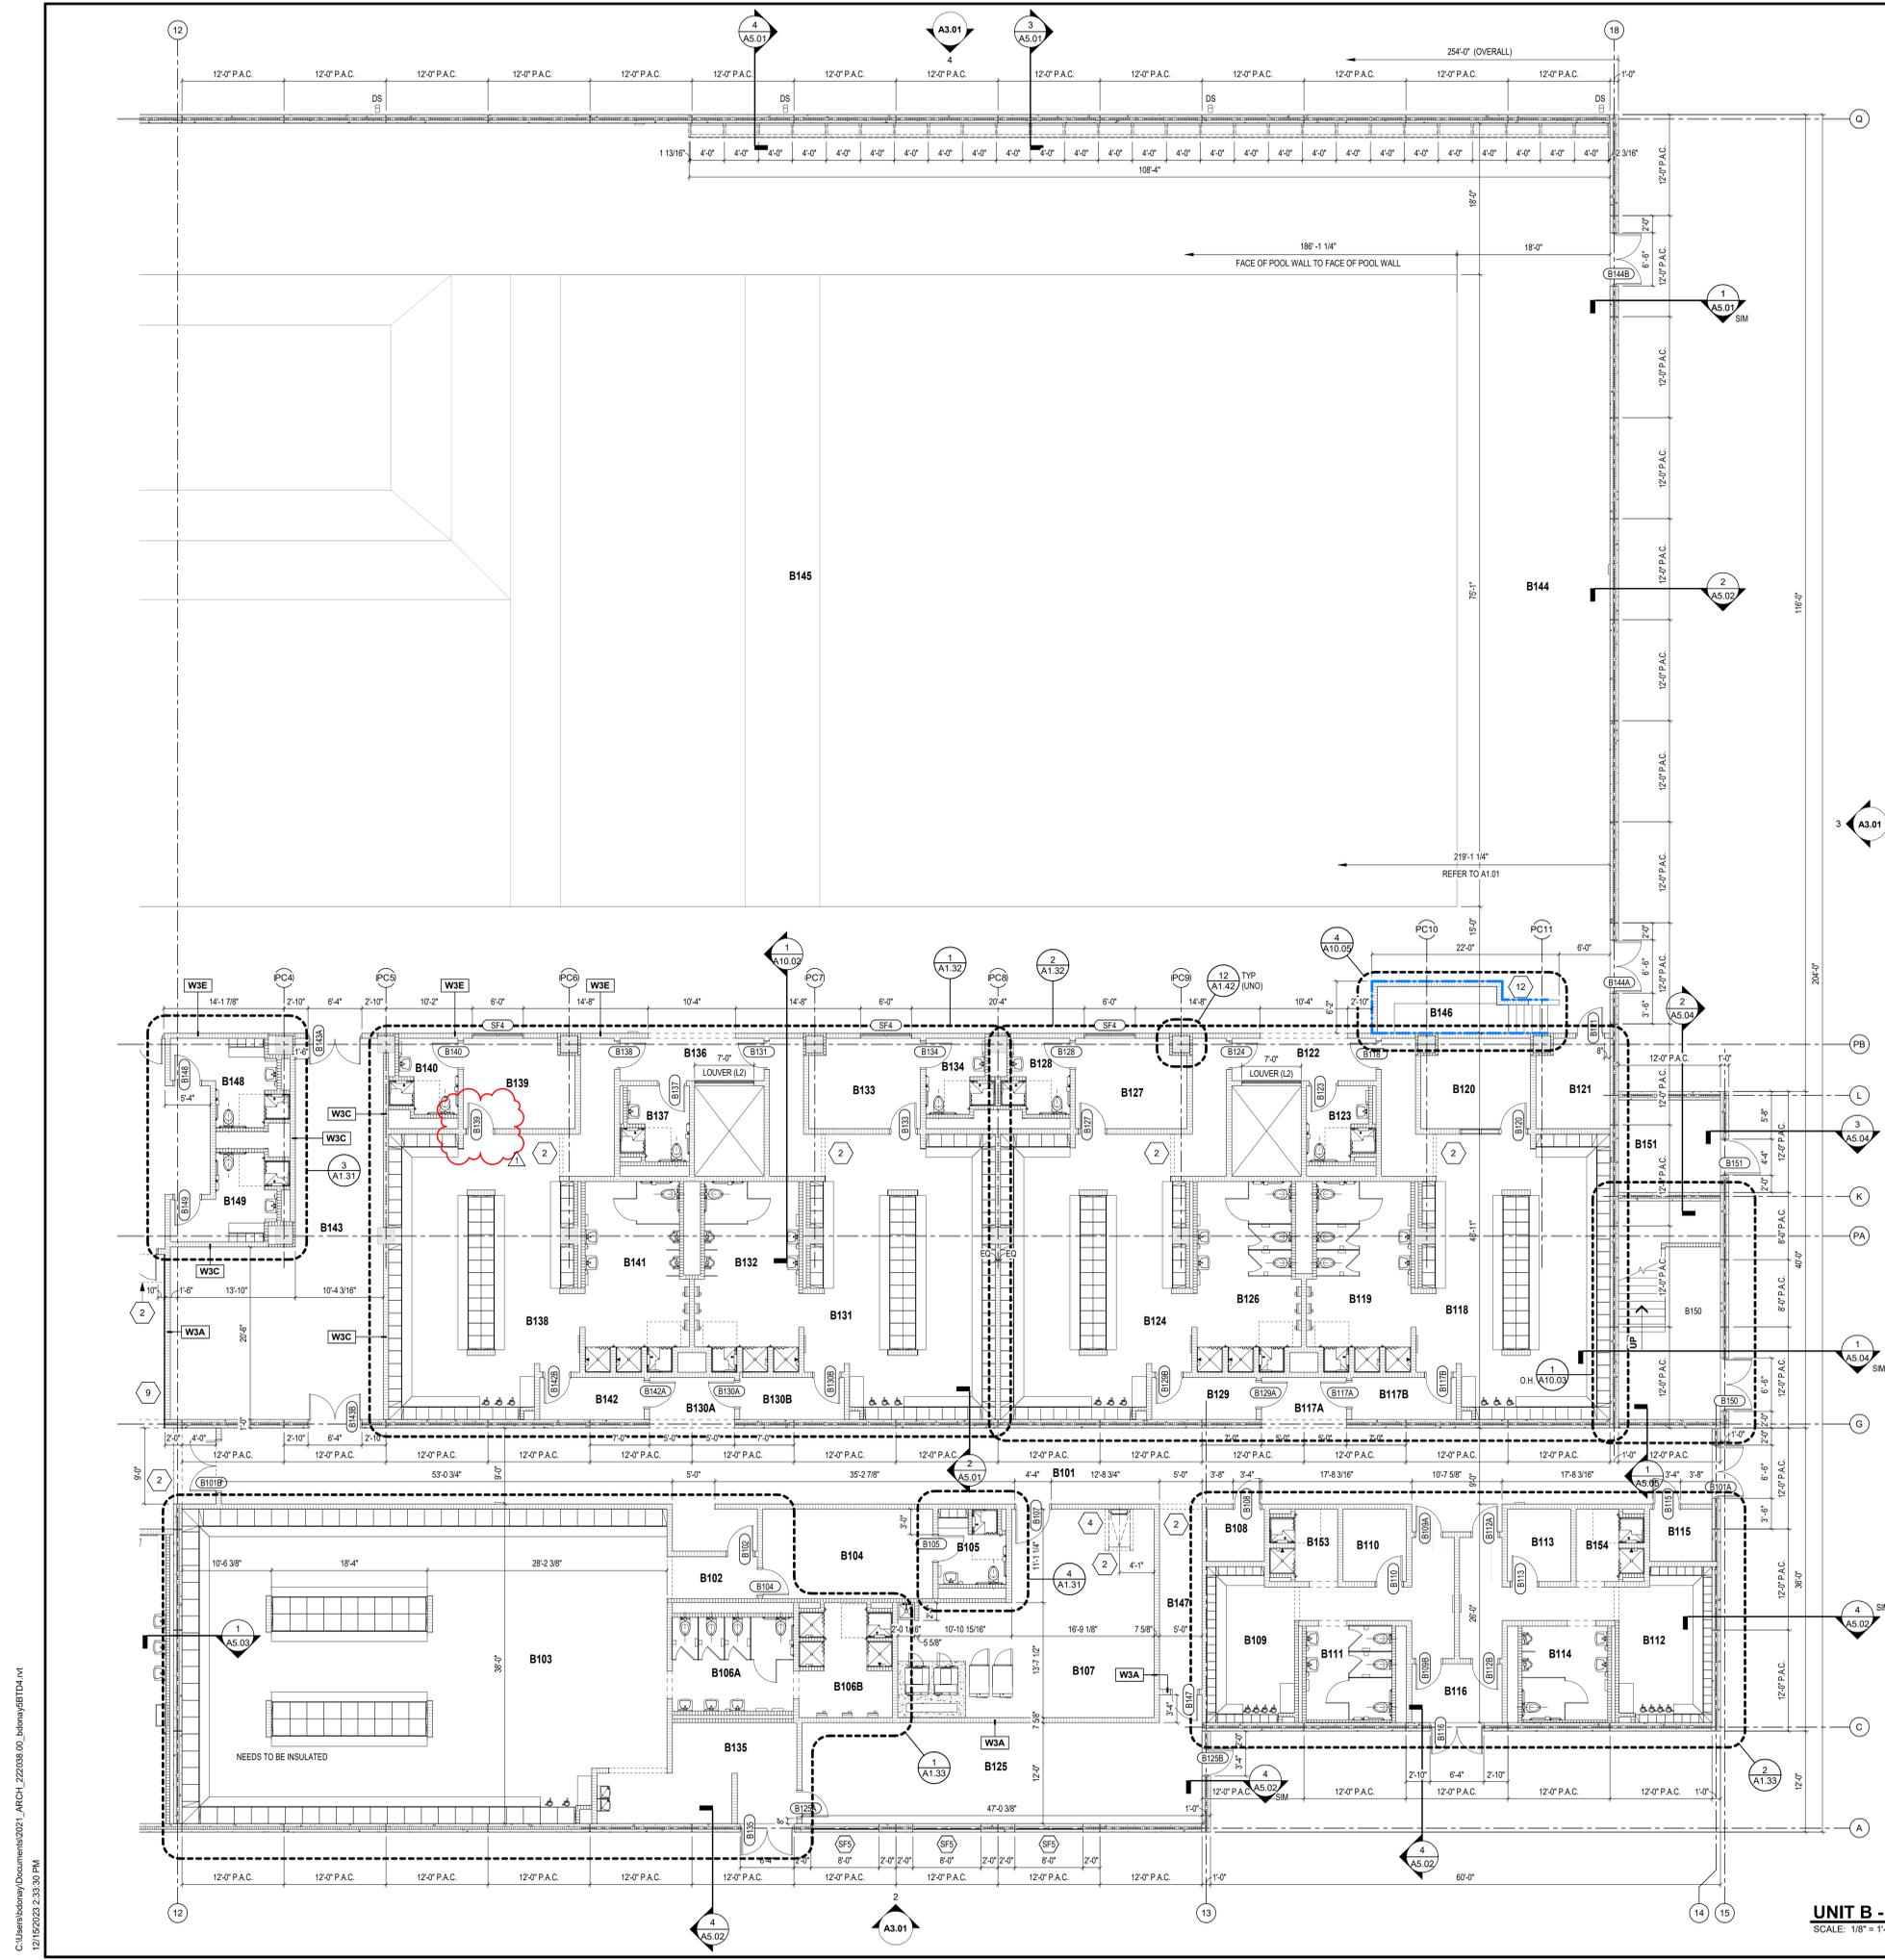



# JEFFERSONVILLE HIGH SCHOOL NATATORIUM

2315 ALLISON LN.  
JEFFERSONVILLE, IN 47130

GREATER CLARK  
COUNTY SCHOOLS




ARCHITECT



317-848-0966 WWW.FHAI.COM  
350 EAST NEW YORK ST.

ISSUED FOR CONSTRUCTION

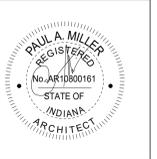

PROJECT MANAGER: JM  
DRAWN BY: BMD MDM  
PROJECT NUMBER: 222038.00  
PROJECT ISSUE DATE: 11/20/2023

REV. NO.	DESCRIPTION	DATE
1	ADDENDUM #2	12/21/2023

DOOR AND FRAME SCHEDULE

## A6S.01

DOOR NUMBER	DOORS		FRAME						FIRE RATING IN MINS.	HARDWARE		STC RATING	REMARKS	DOOR NUMBER
	DOOR SIZE (WxH)	DOOR TYPE	FRAME MATERIAL	FRAME ELEVATION	JAMB DEPTH	HEAD	JAMB	SILL		SET NO.	KEYSIDE ROOM			
A204	PR 3'-0" x 7'-2"	F WD	AL	AL2	4 1/2"	19-A6.03	20-A6.03	-	-	18.0	A204	-	-	A204

DOOR NUMBER	DOORS		FRAME						FIRE RATING IN MINS.	HARDWARE		STC RATING	REMARKS	DOOR NUMBER
	DOOR SIZE (WxH)	DOOR TYPE	FRAME MATERIAL	FRAME ELEVATION	JAMB DEPTH	HEAD	JAMB	SILL		SET NO.	KEYSIDE ROOM			
B202	PR 3'-0" x 7'-2"	F FRP	AL	AL2	4 1/2"	4-A6.03	5-A6.03	-	-	12.0	B202	-	-	B202
B203	PR 3'-0" x 7'-2"	F WD	AL	AL2	4 1/2"	19-A6.03	20-A6.03	-	-	19.0	B203	-	-	B203
B204	PR 3'-0" x 7'-2"	F WD	HM	HM2	8 3/4"	1-A6.03	2-A6.03	-	-	18.0	B204	50	-	B204

DOOR NUMBER	DOORS		FRAME						FIRE RATING IN MINS.	HARDWARE		STC RATING	REMARKS	DOOR NUMBER
	DOOR SIZE (WxH)	DOOR TYPE	FRAME MATERIAL	FRAME ELEVATION	JAMB DEPTH	HEAD	JAMB	SILL		SET NO.	KEYSIDE ROOM			
A302	3'-0" x 7'-2"	F WD	HM	HM1	8 3/4"	1-A6.03	2-A6.03	-	-	38.0	A302	-	-	A302
A303	3'-0" x 7'-2"	F WD	HM	HM1	8 3/4"	1-A6.03	2-A6.03	-	-	38.0	A303	-	-	A303
A304	3'-0" x 7'-2"	F WD	HM	HM1	8 3/4"	1-A6.03	2-A6.03	-	-	36.0	A304	-	-	A304
A307A	8'-0" x 4'-4"	CCD	SS	-	2"	11-A6.03	12-A6.03	13-A6.03	-	40.0	A307A	-	-	A307A
A307B	3'-0" x 7'-2"	F WD	HM	HM1	8 3/4"	1-A6.03	2-A6.03	-	-	27.0	A305	-	-	A307B
A308	3'-0" x 7'-2"	F WD	HM	HM1	8 3/4"	1-A6.03	2-A6.03	-	-	26.0	A308	-	-	A308
A309	PR 3'-0" x 7'-2"	F WD	AL	AL2	4 1/2"	19-A6.03	20-A6.03	-	-	19.0	A309	-	-	A309
A310A	PR 3'-0" x 7'-2"	FGAL2	AL	AL2	4 1/2"	17-A6.03	18-A6.03	-	-	14.0	A305	-	-	A310A
A310B	PR 3'-0" x 7'-2"	FGAL2	AL	AL2	4 1/2"	19-A6.03	20-A6.03	-	-	13.0	A301	-	-	A310B
A310C	PR 3'-0" x 7'-2"	FGAL2	AL	AL2	4 1/2"	19-A6.03	20-A6.03	-	-	13.0	A301	-	-	A310C
A310D	PR 3'-0" x 7'-2"	FGAL2	AL	AL2	4 1/2"	19-A6.03	20-A6.03	-	-	13.0	A301	-	-	A310D

DOOR NUMBER	DOORS		FRAME						FIRE RATING IN MINS.	HARDWARE		STC RATING	REMARKS	DOOR NUMBER
	DOOR SIZE (WxH)	DOOR TYPE	FRAME MATERIAL	FRAME ELEVATION	JAMB DEPTH	HEAD	JAMB	SILL		SET NO.	KEYSIDE ROOM			
B303	PR 3'-0" x 7'-2"	F FRP	AL	AL2	4 1/2"	19-A6.03	20-A6.03	-	-	19.0	B303	-	-	B303

DOOR NUMBER	DOORS		FRAME						FIRE RATING IN MINS.	HARDWARE		STC RATING	REMARKS	DOOR NUMBER	
	DOOR SIZE (WxH)	DOOR TYPE	FRAME MATERIAL	FRAME ELEVATION	JAMB DEPTH	HEAD	JAMB	SILL		SET NO.	KEYSIDE ROOM				
A101A	PR 3'-0" x 7'-2"	FGAL2	AL	CW1	7 1/4"	1-A5.02	13-A1.42	10-A6.03	24-A6.03	-	3.0	EXT	-	REMOVABLE MULLION	A101A
A101B	PR 3'-0" x 7'-2"	FGAL2	AL	CW1	7 1/4"	1-A5.02	13-A1.42	10-A6.03	24-A6.03	-	1.0	EXT	-	-	A101B
A101C	PR 3'-0" x 7'-2"	FGAL2	AL	CW1	7 1/4"	1-A5.02	13-A1.42	10-A6.03	24-A6.03	-	1.0	EXT	-	-	A101C
A101D	PR 3'-0" x 7'-2"	FGAL2	AL	CW3	7 1/4"	1-A5.02	27-A6.03	24-A6.03	-	16.0	EXT	-	-	A101D	
A101E	PR 3'-0" x 7'-2"	FGAL2	AL	CW3	7 1/4"	1-A5.02	27-A6.03	24-A6.03	-	15.0	EXT	-	-	A101E	
A101F	PR 3'-0" x 7'-2"	FGAL2	AL	CW3	7 1/4"	1-A5.02	27-A6.03	24-A6.03	-	15.0	EXT	-	-	A101F	
A105	3'-0" x 7'-2"	F WD	HM	HM1	8 3/4"	1-A6.03	2-A6.03	-	-	27.0	A103	-	-	A105	
A106	3'-0" x 7'-2"	F WD	HM	HM1	8 3/4"	1-A6.03	2-A6.03	-	-	20.0	A103	-	-	A106	
A107	3'-0" x 7'-2"	F WD	HM	HM1	8 3/4"	1-A6.03	2-A6.03	-	-	27.0	A103	-	-	A107	
A108	3'-0" x 7'-2"	F WD	HM	HM1	8 3/4"	1-A6.03	2-A6.03	-	-	23.0	A109	-	-	A108	
A110	PR 3'-0" x 7'-2"	FG2 WD	HM	HM2	8 3/4"	1-A6.03	2-A6.03	-	-	17.0	-	-	-	A110	
A111	3'-0" x 7'-2"	F WD	HM	HM1	8 3/4"	1-A6.03	2-A6.03	-	-	31.0	A111	-	-	A111	
A112	3'-0" x 7'-2"	F WD	HM	HM1	8 3/4"	1-A6.03	2-A6.03	-	-	28.0	A112	-	-	A112	
A113A	3'-0" x 7'-2"	F WD	HM	HM1	8 3/4"	1-A6.03	2-A6.03	-	-	38.0	A113	-	-	A113A	
A113B	3'-0" x 7'-2"	F FRP	AL	AL1	4 1/2"	1-A6.04	2-A6.04	-	-	10.0	EXT	-	-	A113B	
A114A	3'-0" x 7'-2"	F WD	HM	HM1	8 3/4"	1-A6.03	2-A6.03	-	-	38.0	A114	-	-	A114A	
A114B	3'-0" x 7'-2"	F FRP	AL	AL1	4 1/2"	1-A6.04	2-A6.04	-	-	10.0	EXT	-	-	A114B	
A116A	8'-0" x 4'-4"	CCD	SS	-	2"	11-A6.03	12-A6.03	13-A6.03	-	40.0	A116	-	-	A116A	
A116B	3'-0" x 7'-2"	F WD	HM	HM1	8 3/4"	1-A6.03	2-A6.03	-	-	29.0	A116	-	-	A116B	
A116C	8'-0" x 5'-8"	CCD	SS	-	2"	14-A6.03	15-A6.03	16-A6.03	-	40.0	A116	-	-	A116C	
A116D	3'-0" x 7'-2"	F FRP	AL	AL1	4 1/2"	19-A6.03	20-A6.03	10-A6.03	-	7.0	EXT	-	-	A116D	
A118A	PR 3'-0" x 7'-2"	FG2 WD	HM	HM2	8 3/4"	1-A6.03	2-A6.03	-	-	17.0	A109	-	-	A118A	
A118B	3'-0" x 7'-2"	FGAL2	AL	AL1	4 1/2"	4-A6.03	5-A6.03	-	-	33.0	A127	-	-	A118B	
A119	PR 3'-0" x 7'-2"	F WD	HM	HM2	8 3/4"	1-A6.03	2-A6.03	-	-	24.0	A118	-	-	A119	
A120A	PR 3'-0" x 7'-2"	FGAL2	AL	AL2	4 1/2"	19-A6.03	20-A6.03	10-A6.03	-	5.0	EXT	-	-	A120A	
A120B	PR 3'-0" x 7'-2"	FGAL2	AL	AL2	4 1/2"	19-A6.03	20-A6.03	10-A6.03	-	5.0	EXT	-	-	A120B	
A120C	PR 3'-0" x 7'-2"	FGAL2	AL	AL2	4 1/2"	4-A6.03	5-A6.03	-	-	12.0	A110	-	-	A120C	
A123A	PR 3'-0" x 7'-2"	F FRP	AL	AL2	4 1/2"	4-A6.03	5-A6.03	-	-	9.0	A120	-	-	A123A	
A123B	4'-0" x 7'-2"	F FRP	AL	AL1	4 1/2"	19-A6.03	20-A6.03	10-A6.03	-	8.0	EXT	-	-	A123B	
A124	4'-0" x 7'-2"	F FRP	AL	AL1	4 1/2"	4-A6.03	5-A6.03	-	-	11.0	A123	-	-	A124	
A125	4'-0" x 7'-2"	F FRP	AL	AL1	4 1/2"	4-A6.03	5-A6.03	-	-	11.0	A123	-	-	A125	
A126	PR 3'-0" x 7'-2"	F FRP	AL	AL2	4 1/2"	19-A6.03	20-A6.03	10-A6.03	-	5.0	EXT	-	-	A126	

DOOR NUMBER	DOORS		FRAME						FIRE RATING IN MINS.	HARDWARE		STC RATING	REMARKS	DOOR NUMBER	
	DOOR SIZE (WxH)	DOOR TYPE	FRAME MATERIAL	FRAME ELEVATION	JAMB DEPTH	HEAD	JAMB	SILL		SET NO.	KEYSIDE ROOM				
B101A	PR 3'-0" x 7'-2"	FGAL2	AL	AL2	4 1/2"	19-A6.03	20-A6.03	10-A6.03	-	4.0	EXT	-	-	FIXED CENTER MULLION	B101A
B101B	PR 3'-0" x 7'-2"	N WD	HM	HM2	8 3/4"	1-A6.03	2-A6.03	-	-	21.0	-	-	-	-	B101B
B102	3'-0" x 7'-2"	F WD	HM	HM1	8 3/4"	1-A6.03	2-A6.03	-	-	38.0	B102	-	-	-	B102
B104	3'-0" x 7'-2"	F WD	HM	HM1	8 3/4"	1-A6.03	2-A6.03	-	-	31.0	B102	-	-	-	B104
B105	3'-0" x 7'-2"	F WD	HM	HM1	8 3/4"	1-A6.03	2-A6.03	-	-	35.0	B104	-	-	-	B105
B107	4'-0" x 7'-2"	F WD	HM	HM1	8 3/4"	1-A6.03	2-A6.03	-	-	31.0	B101	-	-	-	B107
B108	3'-0" x 7'-2"	F WD	HM	HM1	8 3/4"	1-A6.03	2-A6.03	-	-	20.0	B108	-	-	-	B108
B109A	3'-0" x 7'-2"	F WD	HM	HM1	8 3/4"	1-A6.03	2-A6.03	-	-	38.0	B101	-	-	-	B109A
B109B	3'-0" x 7'-2"	F WD	HM	HM1	8 3/4"	1-A6.03	2-A6.03	-	-	38.0	B116	-	-	-	B109B
B110	3'-0" x 7'-2"	FG WD	HM	HM1	8 3/4"	1-A6.03	2-A6.03	-	-	30.0	B110	-	-	-	B110
B112A	3'-0" x 7'-2"	F WD	HM	HM1	8 3/4"	1-A6.03	2-A6.03	-	-	38.0	B101	-	-	-	B112A
B112B	3'-0" x 7'-2"	F WD	HM	HM1	8 3/4"	1-A6.03	2-A6.03	-	-	38.0	B116	-	-	-	B112B
B113	3'-0" x 7'-2"	FG WD	HM	HM1	8 3/4"	1-A6.03	2-A6.03	-	-	30.0	B113	-	-	-	B113
B115	3'-0" x 7'-2"	F WD	HM	HM1	8 3/4"	1-A6.03	2-A6.03	-	-	23.0	B115	-	-	-	B115
B116	PR 3'-0" x 7'-2"	F FRP	AL	AL2	4 1/2"	19-A6.03	20-A6.03	10-A6.03	-	2.0	EXT	-	-	-	B116
B117A	3'-0" x 7'-2"	F WD	HM	HM1	8 3/4"	1-A6.03	2-A6.03	-	-	38.0	B117A	-	-	-	B117A
B117B	3'-0" x 7'-2"	F WD	HM	HM1	8 3/4"	1-A6.03	2-A6.03	-	-	38.0	B117B	-	-	-	B117B
B118	3'-0" x 7'-2"	F FRP	AL	AL1	4 1/2"	4-A6.03	5-A6.03	-	-	39.0	B122	-	-	-	B118
B120	3'-0" x 7'-2"	F WD	HM	HM5	8 3/4"	1-A6.03	2-A6.03	3-A6.03	-	30.0	B120	-	-	-	B120
B121	3'-0" x 7'-2"	F FRP	AL	AL1	4 1/2"	4-A6.03	5-A6.03	-	-	32.0	B144	-	-	-	B121
B123	3'-0" x 7'-2"	F FRP	AL	AL1	4 1/2"	4-A6.03</									

# JEFFERSONVILLE HIGH SCHOOL NATATORIUM

2315 ALLISON LN.  
JEFFERSONVILLE, IN 47130


GREATER CLARK  
COUNTY SCHOOLS



ARCHITECT



317-848-0966 WWW.FHAI.COM  
350 EAST NEW YORK ST.

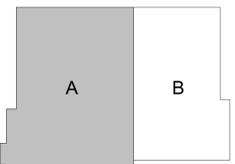

### KEY PLAN

ISSUED FOR CONSTRUCTION



PROJECT MANAGER: JM  
DRAWN BY: BMD  
PROJECT NUMBER: 222038.00  
PROJECT ISSUE DATE: 11/20/2023

REV. NO.	DESCRIPTION	DATE
1	ADDENDUM #2	12/21/2023

UNIT A - SECOND FLOOR  
REFLECTED CEILING PLAN

## A9.21

### REFLECTED CEILING PLAN LEGEND

- BULKHEAD FRAMING SHALL BE ATTACHED TO STRUCTURAL SUPPORTS AND NOT TO THE ROOF DECK
- CEILING GRIDS SHALL BE CONFIGURED SO AS TO NOT HAVE ANY GRIDS SMALLER THEN 6" x AROUND PERIMETER OF ROOM (UNO)

### REFLECTED CEILING PLAN NOTES

(ALL NOTES MAY NOT BE INDICATED ON THIS SHEET)

- GWB BULKHEAD - B/ 10'-0" REFER TO 10-A10.01 (SIM) AND 7-A10.03
- PRECAST WALL PANEL LINTEL - REFER TO FLOOR PLAN AND 2-A3.31
- EXPOSED STRUCTURE (PAINT)
- GWB BULKHEAD - REFER TO 3-A3.31
- GWB BULKHEAD - REFER TO 4-A3.31
- CMU LINTEL - B/ 108"x 318"
- INTERIOR FINISH SYSTEM (I.F.S.) BULKHEAD - REFER TO 5-A3.31
- GWB BULKHEAD - REFER TO 10-A10.01 SIM. ALIGN FACE OF GWB WITH FACE OF GWB BELOW
- GWB BULKHEAD - REFER TO 6-A3.31
- INTERIOR FINISH SYSTEM (I.F.S.) CEILING / BULKHEAD - REFER TO 7-A3.31
- INTERIOR FINISH SYSTEM (I.F.S.) BULKHEAD - REFER TO 1-A10.02
- DASHED LINE INDICATES 30" x 30" LOOSE LOAD ACOUSTIC PADS ON TOP OF CEILING TILE. SET ACOUSTIC PADS AWAY FROM EDGE OF CLOUD APPROXIMATELY 8 INCHES.
- METAL PLATE WALL PANEL SOFFIT - REFER TO WALL SECTIONS
- PRECAST WALL PANEL LINTEL - B/ 10'-0"
- GWB BULKHEAD - REFER TO 6-A3.31
- CMU LINTEL - T/ 108"x 0"
- GWB BULKHEAD AT ROOF HATCH. REFER TO 9-A3.31
- TROPHY CASE - REFER TO SHEET A7S.01 FOR DETAILS
- GWB BULKHEAD WITH SOUND ATTENUATION - REFER TO 14-A10.05
- CEILING TRANSITION. TYP. REFER TO LIST OF FINISHES SHEET A8S.01
- PROVIDE ACOUSTICAL SEMI-RIGID INSULATION BOARD ON UNDERSIDE OF FLOOR SLAB ABOVE.

### REFLECTED CEILING PLAN LEGEND


- 10'-4" INDICATES ELEVATION HEIGHT
- 9'-0" INDICATES CEILING HEIGHT
- A 9'-0" INDICATES ACOUSTIC PANEL CEILING TYPE AND HEIGHT. REFER TO PROJECT MANUAL FOR TYPE
- LIGHT FIXTURE - REFER TO ELECTRICAL DRAWINGS
- LIGHT FIXTURE - REFER TO ELECTRICAL DRAWINGS
- LIGHT FIXTURE - REFER TO ELECTRICAL DRAWINGS
- CLOCK - REFER TO TECHNOLOGY DRAWINGS
- 2' SOFFIT VENT (CONT). HOLD 6" FROM ANY VERTICAL IMPEDIMENT (UNO). REFER TO WALL SECTIONS
- MECHANICAL DIFFUSER - REFER TO MECHANICAL DRAWINGS
- MECHANICAL RETURN AIR GRILLE - REFER TO MECHANICAL DRAWINGS
- CEILING MOUNTED MECHANICAL UNIT - REFER TO MECHANICAL DRAWINGS
- MECHANICAL UNIT HEATER - REFER TO MECHANICAL DRAWINGS
- RECESSED CEILING SPEAKER
- MOTION DETECTOR
- CEILING MOUNTED EXIT LIGHT
- CEILING MOUNTED CAMERA
- WIRELESS ACCESS POINT (WAP)
- CONTROL JOINT IN GYPSUM BOARD CEILING OR BULKHEAD
- SOUND REINFORCEMENT SPEAKER
- FIRE ALARM HEAT DETECTOR
- FIRE ALARM HORN STROBE
- FIRE ALARM SPEAKER STROBE
- FIRE ALARM STROBE
- FIRE ALARM SMOKE DETECTOR
- OCCUPANCY SENSOR
- ACOUSTICAL CEILING TILE (ACT)
- ACOUSTICAL CEILING TILE (ACT)
- GYPSUM WALL BOARD BULKHEAD / CEILING EXTERIOR FINISH SYSTEM (E.F.S.) EXTERIOR INSULATION FINISH SYSTEM (E.I.F.S.)
- INTERIOR FINISH SYSTEM (I.F.S.)
- LINEAR METAL CEILING

### VERIFICATION NOTE

CONTRACTOR SHALL VERIFY ALL DIMENSIONS AND CLEARANCES AND ALL EXISTING FIELD CONDITIONS BEFORE STARTING CONSTRUCTION. COMMENCEMENT OF WORK CONSTITUTES ACCEPTANCE OF CONDITIONS. SHOULD DIFFERENT CONDITIONS BE ENCOUNTERED, CONTACT THE ARCHITECT BEFORE PROCEEDING WITH WORK.

### ROOM LEGEND - SECOND FLOOR UNIT A

ROOM NO.	ROOM NAME	AREA (SF)	Class Abbreviation
A301	UPPER BALCONY	1033 SF	U
A302	RESTROOM	354 SF	U
A303	RESTROOM	355 SF	U
A304	FAMILY RESTROOM	58 SF	U
A305	UPPER LOBBY	333 SF	U
A306	ELEVATOR	85 SF	U
A307	UPPER CONCESSIONS	171 SF	CB
A308	JANITOR	51 SF	U
A309	STAIR A	312 SF	U
A310	CONCOURSE	1151 SF	U
A311	BLEACHERS	1159 SF	IA
Grand total:		11	5142 SF

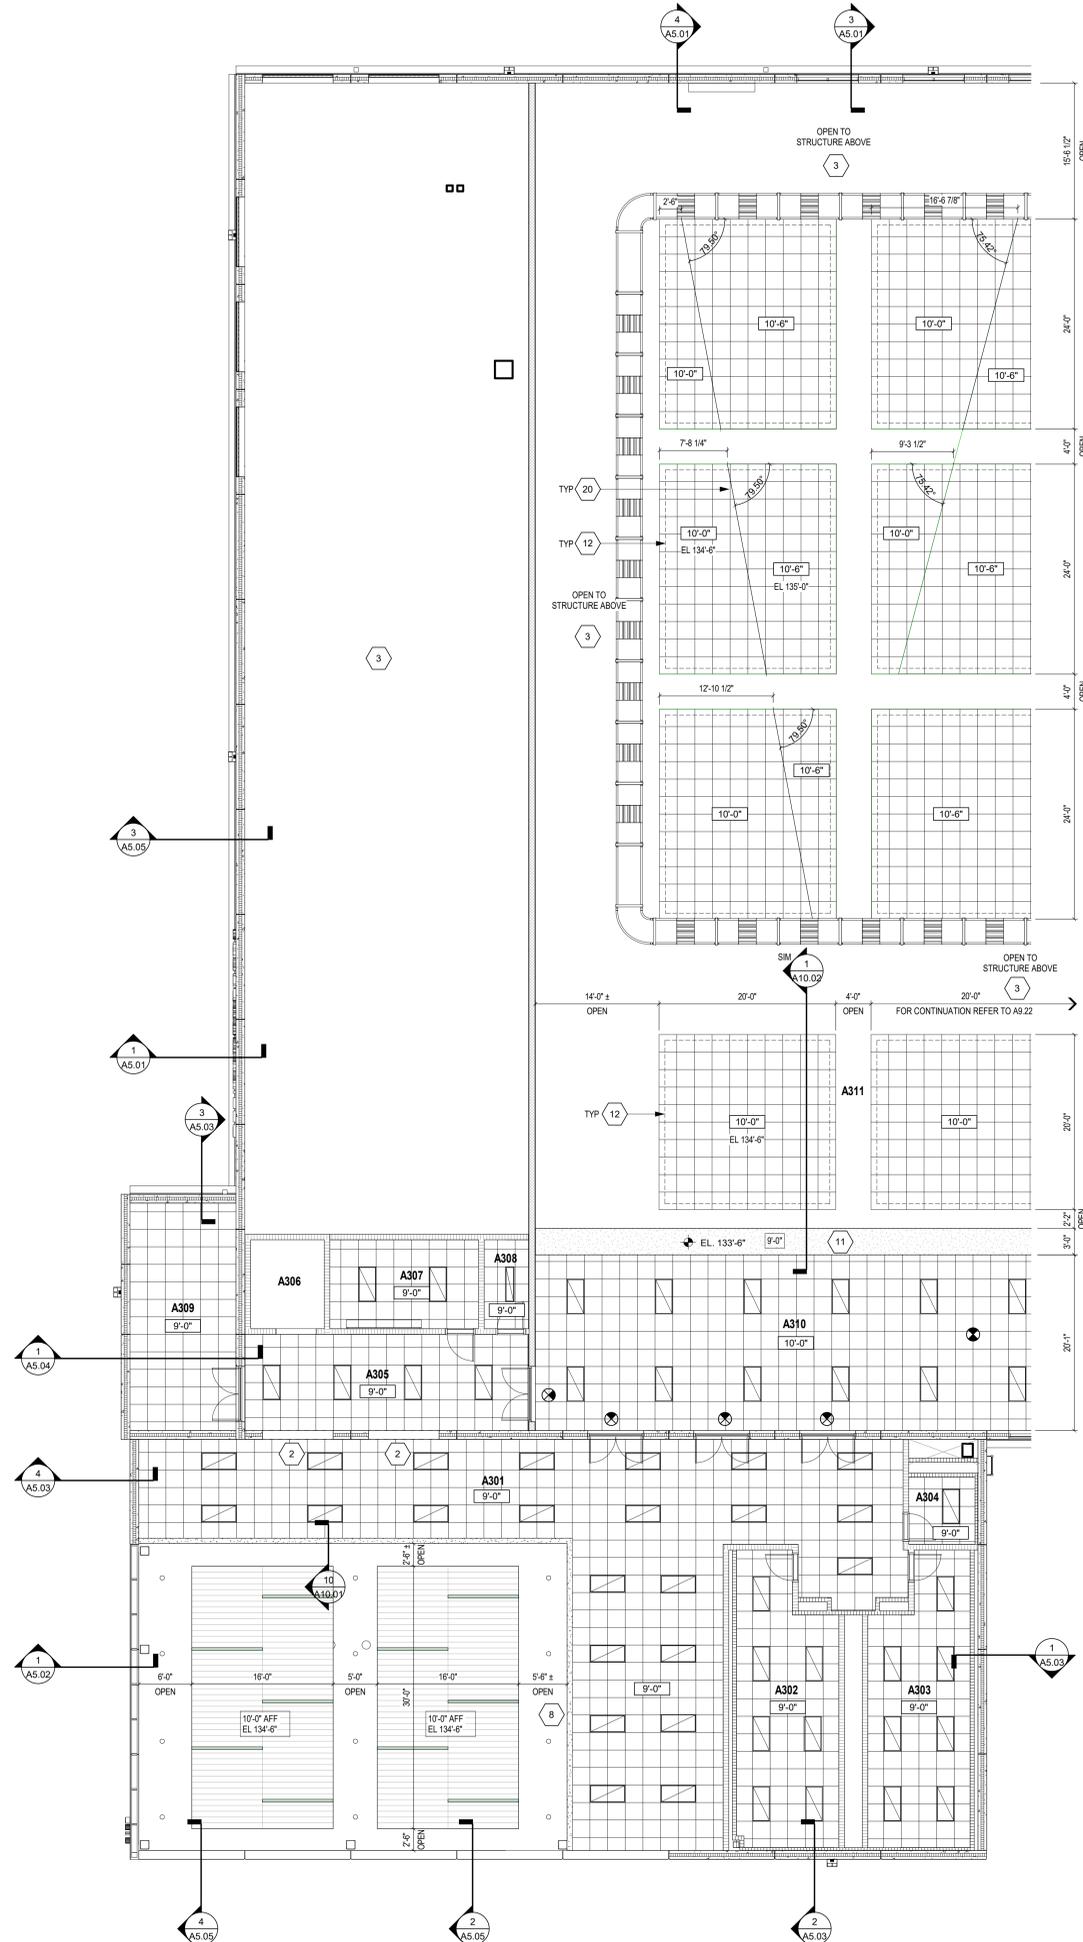

UNIT A - SECOND FLOOR REFLECTED CEILING PLAN  
SCALE: 1/8" = 1'-0"

GENERAL MECHANICAL REQUIREMENTS

- 1 GENERAL CONDITIONS, SUPPLEMENTARY GENERAL CONDITIONS, SPECIAL CONDITIONS, INSTRUCTIONS TO BIDDERS AND ALL OTHER CONTRACT DOCUMENTS APPLY TO THIS BRANCH OF WORK AS DO ALL OTHER SECTIONS OF THE SPECIFICATIONS.
2 EACH SUB-CONTRACTOR SHALL BE GOVERNED BY ANY ALTERNATES AND UNIT PRICES CALLED FOR IN THE FORM OF PROPOSAL, INsofar AS THEY AFFECT THEIR PORTION OF WORK.
3 THIS SECTION (GENERAL MECHANICAL REQUIREMENTS) APPLIES EQUALLY TO HEATING, VENTILATING, AND AIR CONDITIONING.
4 WORK COVERED BY THIS DIVISION OF SPECIFICATIONS CONSISTS OF FURNISHING ALL MATERIALS, LABOR EQUIPMENT, INCIDENTALS, AND PERFORMING ALL OPERATIONS REQUIRED FOR A COMPLETE INSTALLATION OF ALL MECHANICAL SYSTEMS IN ACCORDANCE WITH APPLICABLE DRAWINGS AND SPECIFICATIONS.
5 MECHANICAL CONTRACTOR SHALL FURNISH ALL EQUIPMENT, MATERIAL, AND LABOR MENTIONED IN THIS SPECIFICATION, UNLESS IT IS SPECIFICALLY STATED OTHERWISE.
6 MENTION HEREIN OR INDICATION ON DRAWINGS OF ARTICLES, MATERIALS OR METHODS REQUIRES MECHANICAL CONTRACTOR FOR THIS WORK TO FURNISH AND INSTALL EACH ARTICLE OR MATERIAL MENTIONED OR INDICATED OF QUALITY OR ACCORDING TO QUALIFICATIONS NOTED. PERFORM EACH OPERATION CALLED FOR ACCORDING TO METHOD OR CONDITION PRESCRIBED, AND PROVIDE ALL NECESSARY LABOR, EQUIPMENT, AND INCIDENTALS.
7 MECHANICAL CONTRACTOR SHALL FURNISH AND INSTALL ALL MISCELLANEOUS EQUIPMENT, MATERIAL, AND LABOR WHICH (THOUGH NOT SPECIFICALLY CALLED FOR IN THIS SPECIFICATION) IS NECESSARY FOR A COMPLETE AND SATISFACTORY OPERATING INSTALLATION. MECHANICAL CONTRACTOR SHALL LEASE HIS WORK IN OPERATING CONDITION.
8 FOR PURPOSE OF CLEARNESS AND LEGIBILITY, DRAWINGS ARE ESSENTIALLY DIAGRAMMATIC, ALTHOUGH SIZE AND LOCATION OF EQUIPMENT IS DRAWN TO SCALE WHEREVER POSSIBLE.
9 DRAWINGS AND SPECIFICATIONS ARE INTENDED TO COVER ALL WORK ENUMERATED UNDER THE RESPECTIVE HEADINGS. SUB-CONTRACTORS SHALL NOT TAKE ADVANTAGE OF CONFLICT OR ERROR BETWEEN DRAWINGS AND SPECIFICATIONS, BUT SHALL REQUEST A CLARIFICATION OF SUCH BEFORE MAKING HIS PROPOSAL SHOULD THIS CONDITION EXIST.
10 MECHANICAL CONTRACTOR SHALL OBTAIN A SET OF ARCHITECTURAL AND STRUCTURAL DRAWINGS AND SPECIFICATIONS, AND CONSULT WITH ARCHITECT AND GENERAL CONTRACTOR AS TO GENERAL CONSTRUCTION OF THE BUILDING, HEAD ROOM OF PIPE CHASES, LOCATION OF WALLS, PARTITIONS, BEAMS, ETC., SWING OF DOORS, AND ORDER AND TIME OF PLACEMENT OF ALL MECHANICAL WORK.
11 DRAWINGS ACCOMPANYING THESE SPECIFICATIONS DETERMINE GENERAL DESIGN OF EQUIPMENT. EXACT DISPOSITION OF EQUIPMENT IS SUBJECT TO REQUIREMENTS AND CONSTRUCTION OF MANUFACTURER'S STANDARDS, BUT SPACE OCCUPIED AND GENERAL DESIGN SHALL CORRESPOND TO THAT SHOWN ON THE PLANS.
12 NO CONTRACTOR SHALL UNDER ANY CIRCUMSTANCES SCALE DRAWINGS FOR LOCATION OF EQUIPMENT AND WORK.
13 DRAWINGS INDICATE SIZE AND POINTS OF TERMINATION OF PIPES AND DUCTS, AND SUGGEST PROPER ROUTING TO CONFORM TO STRUCTURE, AVOID OBSTRUCTIONS AND PRESERVE CLEARANCES. IT IS NOT THE INTENTION OF THE DRAWINGS TO INDICATE ALL NECESSARY OFFSETS. INSTALL WORK IN A MANNER TO CONFORM TO STRUCTURE, AVOID OBSTRUCTIONS, PRESERVE HEADROOM, AND KEEP OPENINGS AND PASSAGEWAYS CLEAR WITHOUT FURTHER INSTRUCTIONS OR COST.
14 IT IS INTENDED THAT MATERIALS SHALL BE LOCATED SYMMETRICALLY WITH ARCHITECTURAL ELEMENT, ALTHOUGH LOCATIONS INDICATED BY DRAWINGS MAY BE DISTORTED FOR CLEARNESS OR PRESENTATION.
15 DRAWINGS PERTAINING TO INSTALLATIONS AND SERVICES GENERALLY INDICATE LOCATION OF ACCESSORIES, PIPING, DUCTWORK, ETC., AND OTHER DETAILS NECESSARY TO COMPLETE INSTALLATION OF EACH BRANCH OF WORK. BIDDERS ARE URGED TO ACQUAINT THEMSELVES WITH WORKING CONDITIONS AND REQUIREMENTS AT THE BUILDING SITE AS ANY AND ALL CONTRACTS FOR THIS WORK WILL BE BASED UPON FURNISHING ALL LABOR AND MATERIALS TO ENTIRELY COMPLETE EACH INSTALLATION READY FOR USE.
16 EACH CONTRACTOR IS URGED BEFORE SUBMITTING A PROPOSAL TO VERIFY SIZE AND LOCATION OF ALL SERVICES, AND LIMITATIONS OF EACH.
17 MATERIALS AND EQUIPMENT USED THROUGHOUT SHALL BE NEW AND THE BEST OF THEIR RESPECTIVE KINDS, NO SUBSTITUTIONS OTHER THAN THOSE SPECIFIED IN THESE SPECIFICATIONS APPROVED BY THE ENGINEER. ALL WORK SHALL BE EXECUTED WITH SPEED AND CONSISTENT WITH SAFETY AND GOOD WORKMANSHIP.
18 COMPETENT WORKMEN SHALL BE EMPLOYED ON ALL PHASES OF WORK. POOR WORKMANSHIP WILL BE REJECTED AND WILL CONSTITUTE CAUSE FOR REMOVAL OF THE INDIVIDUAL PERFORMING THE WORK.
19 SHOULD ANY DISPUTE ARISE AS TO THE QUALITY OR FITNESS OF MATERIALS, EQUIPMENT OR WORKMANSHIP, THE DECISION RESTS TO THE QUALITY WITH THE OWNER AND ENGINEER.
20 SEE REQUIREMENTS FOR "SHOP DRAWINGS" IN BOTH GENERAL CONDITIONS AND DIVISION 3.
21 EACH SUB-CONTRACTOR SHALL SUBMIT TO THE GENERAL CONTRACTOR FOR APPROVAL WITHIN THIRTY (30) DAYS AFTER THE DATE OF THE CONTRACT, SIX (6) SETS OF COMPLETE CATALOGUE DATA AND/OR SHOP DRAWINGS FOR EACH ITEM OF MATERIAL OR PIECE OF EQUIPMENT. CATALOGUE DATA SHALL INCLUDE NAME OF MANUFACTURER, MATERIAL NUMBERS, TRADE NAMES, PERFORMANCE DATA, DESCRIPTIVE MATERIAL (SUFFICIENT TO IDENTIFY MANUFACTURER), AND SPECIFIC PERFORMANCE OF PRODUCTS. SHOP DRAWINGS SHALL INCLUDE PROJECT SPECIFIC CATALOGUE DATA AND SHALL SHOW EQUIPMENT IN DETAIL, ARRANGEMENT AND DISPOSITION FOR THIS PARTICULAR PROJECT DESIGN. GENERAL CATALOGUE DATA IS UNACCEPTABLE.
22 SUBMIT FOR APPROVAL SIX (6) COPIES OF BROCHURES, TECHNICAL DATA AND SHOP DRAWINGS OF THE FOLLOWING EQUIPMENT:
A. AIR COOLED CONDENSING UNITS (ACCU)
B. AIR HANDLING UNITS (AHU)
C. BOILERS (BL)
D. BOILER PUMPS (BLBP)
E. CABINET UNIT HEATERS (CUH)
F. ENERGY RECOVERY UNIT (ERV)
G. ELECTRIC UNIT HEATERS (EUH)
H. EXHAUST FANS (EF)
I. HEAT EXCHANGERS (HX)
J. HEATING HOT WATER PUMPS (HWP)
K. HOT WATER UNIT HEATERS (UH)
L. LOUVERS (AL)
M. POOL DEHUMIDIFICATION UNITS (PDH)
N. REMOTE FLUID COOLERS (FC)
O. SPLIT SYSTEMS (DUAL/DUALC)
P. VAV TERMINAL UNITS (VAV)
23 ALL EQUIPMENT SUBMITTALS SHALL SPECIFY ELECTRICAL CHARACTERISTICS AND HORSEPOWER.
24 ENGINEER'S CHECKING AND APPROVING OF CONTRACTOR'S AND SUB-CONTRACTOR'S DRAWINGS OR EQUIPMENT DETAILS DOES NOT RELIEVE CONTRACTOR OF SUB-CONTRACTORS FROM RESPONSIBILITY FOR ERRORS, OMISSIONS OR EQUIPMENT FURNISHED IN ACCORDANCE WITH SUCH CHECKED OR APPROVED DRAWINGS, WHERE SUCH ERRORS OR OMISSIONS ARE LATER DISCOVERED, THEY SHALL BE MADE GOOD BY THE RESPECTIVE SUB-CONTRACTOR (IRRESPECTIVE OF ANY APPROVAL BY ENGINEER).
25 IN THE INSTALLATION CALLED FOR IN THESE CONTRACTS, SPECIAL ATTENTION SHALL BE GIVEN TO ACCESSIBILITY OF PARTS AND EQUIPMENT. ADEQUATE SPACE MUST BE GIVEN FOR OPERATION AND REMOVAL OF ANY PARTS THAT MAY HAVE TO BE EXAMINED AT FUTURE PERIODS.
26 NO WORK OF ANY KIND SHALL BE COVERED UP BEFORE IT HAS BEEN TESTED, EXAMINED AND APPROVED.
27 IT SHALL BE THE RESPONSIBILITY OF RESPECTIVE SUB-CONTRACTORS TO DETERMINE THAT EQUIPMENT WHICH THEY PROPOSE TO FURNISH CAN BE INSTALLED IN AVAILABLE SPACE AND CAN BE BROUGHT INTO THE BUILDING. EQUIPMENT MUST BE INSTALLED SO THAT ALL PARTS ARE READILY ACCESSIBLE FOR INSPECTION AND MAINTENANCE. NO EXCESS COMPENSATION WILL BE ALLOWED FOR DISMANTLING OF EQUIPMENT TO INSTALL IN AVAILABLE SPACE OR TO OBTAIN ENTRANCE INTO THE BUILDING.
28 SUB-CONTRACTOR SHALL INCLUDE CARE IN SELECTION OF EQUIPMENT AND ITS INSTALLATION TO ENSURE THAT NOISES AND VIBRATION WILL BE HELD TO A MINIMUM. IF IT IS THE INTENTION THAT THE ENTIRE SYSTEM SHALL OPERATE WITHOUT EXCESSIBLE NOISE OR VIBRATION, IF OBJECTICNABLE NOISE OR VIBRATION DOES DEVELOP, IT SHALL BE CORRECTED BY SUB-CONTRACTOR TO THE SATISFACTION OF THE ENGINEER WITHOUT ADDITIONAL COMPENSATION.
29 MECHANICAL APPLIANCES ARE REQUIRED TO BE LISTED AND LABELED FOR THE APPLICATION IN WHICH THEY ARE TO BE INSTALLED AND USED. MANUFACTURER'S INSTRUCTIONS MUST BE AVAILABLE ON THE JOB SITE AT THE TIME OF INSPECTION.
30 NO PIPING SHALL BE INSTALLED IN ANY PART OF THE BUILDING WHERE DANGER OF FREEZING DURING CONSTRUCTION MAY EXIST WITHOUT ADEQUATE PROTECTION BEING GIVEN BY THE CONTRACTOR INSTALLING THE PIPE. ALL DAMAGES RESULTING FROM LEAKING PIPES SHALL BE BORNE BY CONTRACTOR WHOSE WORK IS AT FAULT.
31 ALL WORK SHALL BE PROTECTED AT ALL TIMES. ALL PIPE AND DUCT EQUIPMENT SHALL BE CLOSED WITH CAPS OR PLUGS DURING CONSTRUCTION. ALL EQUIPMENT ACCESSORIES AND OPENINGS SHALL BE TIGHTLY COVERED AND PROTECTED AGAINST DIRT, WATER OR OTHER INJURY DURING THE PERIOD OF THE RESPECTIVE CONTRACT.
32 IF IT SHOULD BE NECESSARY TO OPERATE EQUIPMENT BEFORE A FINAL ACCEPTANCE, OWNER SHALL BE ALLOWED TO DO SO BUT ONLY AFTER PROPER ADJUSTMENT AND TRIAL OPERATION AS HEREINAFTER SPECIFIED.
33 OWNER SHALL BE RESPONSIBLE FOR PROPER CARE AND SUPERVISION OF OPERATION OF EQUIPMENT USED BEFORE ACCEPTANCE AND SAFEGUARD EQUIPMENT IN EVERY WAY.

BASIC MECHANICAL MATERIALS AND METHODS

- 34 OWING TO THE NATURE OF THE CONSTRUCTION INVOLVED AND TO PREVENT CONFUSION AND DISCREPANCIES, ONLY APPROXIMATE OR GENERAL DIMENSIONS ARE GIVEN IN SEVERAL CASES. IT BEING INTENDED THAT IN SOME INSTANCES A REASONABLE LIMIT OF VARIATION BE PERMITTED IN ORDER THAT THE MARKING AND SECTION OF THE WORK OF THE SUB-CONTRACTORS MAY BE THEREBY EXPEDITED AND BEST INTERESTS OF THE WORK AS A WHOLE BE SERVED. SUB-CONTRACTORS WILL BE REQUIRED TO ESTABLISH THEIR OWN DIMENSIONS (EACH BY PROMPT CONSULTATION AS TO METHODS AND SIZE OF CONSTRUCTION, TIME OF BEGINNING AND SEQUENCE OF OPERATIONS, AND EXCHANGE OF DRAWINGS AND DETAILS) WITH ONE ANOTHER AS THE GREATEST MEASURE OF COOPERATION AMONG THE INTERESTS INVOLVED WILL BE DEMANDED AND EXPECTED BY THE OWNER AT ALL TIMES.
35 ALL MECHANICAL AND ELECTRICAL SUB-CONTRACTORS SHALL CONSULT FULLY WITH GENERAL CONTRACTOR'S SUPERINTENDENT REGARDING ALL MATTERS AFFECTING THEIR WORK.
36 COOPERATE WITH OTHER TRADES TO OBTAIN MOST PRACTICAL ARRANGEMENT OF WORK.
37 MAKE KNOWN TO OTHER TRADES INTENDED POSITIONING OF MATERIALS AND INTENDED ORDER OF WORK. COORDINATE WORK WITH OTHER TRADES AND PROCEED WITH INSTALLATION TO ASSURE NO DELAYS TO OTHER TRADES. DETERMINE INTENDED POSITIONS OF WORK OF OTHER TRADES AND INTENDED ORDER OF INSTALLATION.
38 AGREE TO MOST PRACTICAL ARRANGEMENT OF WORK WITHIN REQUIREMENTS OF CONTRACT AND CONSULT WITH ARCHITECT/ENGINEER WHEN THERE ARE REASONS FOR DEVIATIONS FROM DRAWINGS OR SPECIFICATIONS, DIFFERENCES OF OPINION BETWEEN CONTRACTORS, OR QUESTIONS CONCERNING INTENT OF DRAWINGS OR SPECIFICATIONS.
39 FAILURE OF CONTRACTOR TO MAKE KNOWN HIS NEEDS OR DETERMINE REQUIREMENTS OF OTHERS WILL NOT BE CAUSE FOR ADDITIONAL COMPENSATION TO CORRECT INTERFERENCES.
40 IT IS NOT INCUMBENT UPON THE ENGINEER TO NOTIFY SUB-CONTRACTOR WHEN TO BEGIN, TO CEASE OR RESUME WORK, NOR TO GIVE EARLY NOTIFICATION OF REFLECTION OF FAULTY WORK, NOR IN ANY WAY TO SUPERSEDE TO RELIEVE SUB-CONTRACTOR OF RESPONSIBILITY OR OF ANY CONSEQUENCE OF CARELESSNESS BY HIM OR HIS SUBORDINATES.
41 ALL MATERIALS AND LABOR SHALL BE FURNISHED AT SUCH TIMES (SHALL BE TO THE BEST INTEREST OF ALL CONTRACTORS AND SUB-CONTRACTORS CONCERNED) TO THE END THAT THE COMBINED WORK MAY BE PROGRESSIVELY AND FULLY COMPLETED ON CONTRACT TIME.
42 ALL PERMITS NECESSARY FOR COMPLETE HEATING, VENTILATING, AND AIR CONDITIONING SYSTEMS SHALL BE OBTAINED BY MECHANICAL CONTRACTOR FROM AUTHORITIES GOVERNING THE WORK. COST OF ALL PERMITS SHALL BE BORNE BY THE CONTRACTOR.
43 HEATING, VENTILATING, AND AIR CONDITIONING WORK SHALL BE DONE IN ACCORDANCE WITH RULES AND REGULATIONS OF THE NATIONAL FIRE PROTECTION ASSOCIATION (NFPA), LATEST STANDARDS RECOGNIZED BY THE AMERICAN SOCIETY OF HEATING AND VENTILATING ENGINEERS, PER THE LATEST EDITION ENFORCED FOR STATE AND LOCAL MECHANICAL CODE.
44 ALL WORK SHALL MEET REQUIREMENTS OF THE LIFE SAFETY CODE, STATE AND CITY FIRE MARSHALS, DEPARTMENT OF HOUSING, BUILDINGS AND CONSTRUCTION.
45 ALL WORK MUST BE APPROVED BY ENGINEER BEFORE FINAL PAYMENT WILL BE MADE.
46 HEATING, VENTILATING, AND AIR CONDITIONING CONTRACTOR SHALL FURNISH ENGINEER WITH A CERTIFICATE OF INSPECTION AND APPROVAL FROM INSPECTING AGENCIES, FREE OF CHARGE, BEFORE CERTIFICATE OF SUBSTANTIAL COMPLETION IS GRANTED. FINAL PAYMENT SHALL BE CONTINGENT UPON THIS CERTIFICATE.
47 RESPECTIVE CONTRACTOR SHALL NOTIFY INSPECTORS, IN WRITING, IMMEDIATELY UPON THE START OF HIS WORK AND A COPY OF NOTICE SENT TO THE ENGINEER.
48 ALL COST INCIDENTAL TO INSPECTIONS SHALL BE BORNE BY RESPECTIVE CONTRACTOR.
49 INSPECTION SHALL BE SCHEDULED FOR ROUGH AS WELL AS FINISHED WORK. ROUGH INSPECTION SHALL BE DIVIDED INTO AS MANY INSPECTIONS AS MAY BECOME NECESSARY TO COVER ALL ROUGH-UPS.
50 ALL INSPECTIONS TO BE BY INSPECTOR HAVING JURISDICTION.
51 EACH CONTRACTOR IS TO REMOVE HIS OWN RUBBISH, BUT IN CASE OF DISPUTE, ENGINEER SHALL HAVE THE RIGHT TO ORDER GENERAL CONTRACTOR TO REMOVE SAID RUBBISH AND COST OF REMOVING SAME SHALL BE CHARGED TO THE GUILTY PARTY AS MAY BE DECIDED BY THE ENGINEER. RUBBISH SHALL BE REMOVED IMMEDIATELY WHEN ORDERED BY OWNER'S REPRESENTATIVE. BUILDING SHALL BE KEPT AS CLEAN AS POSSIBLE DURING THE PROGRESS OF THE WORK.
52 WHEN ANY WORK INCLUDED IN THESE SPECIFICATIONS IS COMPLETED, AND AT SUCH TIME AS DIRECTED BY THE ENGINEER, RESPECTIVE EQUIPMENT MANUFACTURER OR CONTRACTOR SHALL CAREFULLY ADJUST ALL PARTS OF AND EQUIPMENT OF THE COMPLETE SYSTEM, ADVISING ENGINEER WHEN SAME IS COMPLETE AND READY FOR FINAL TESTS.
53 RESPECTIVE CONTRACTORS SHALL, AFTER WORK IS COMPLETED, FULLY AND CAREFULLY INSTRUCT OWNER'S OPERATOR HAVING CHARGE OF THE SYSTEM AS TO ADJUSTMENT, AND EFFICIENT AND PROPER METHODS OF OPERATION OF THE SYSTEM AND VARIOUS APPLICATIONS.
54 BIDDERS SHALL CAREFULLY EXAMINE GENERAL CONSTRUCTION DRAWINGS AND ASSURE THEMSELVES OF MATERIAL TYPES USED THROUGHOUT THE BUILDING THAT MAY IN ANY WAY AFFECT WORK TO BE INSTALLED UNDER THEIR CONTRACT AND PROPER PREPARATION OF THEIR PROPOSALS, AS NO CONTRACT ALLOWANCE WILL BE MADE FOR BIDDERS' FAILURE TO ACQUAINT THEMSELVES WITH THE TYPES OF CONSTRUCTION.
55 LOCATIONS OF ALL PIPING, CONDUITS, CABLES, UTILITIES AND MAN-HOLES, EXISTING TEMPORARILY OR OTHERWISE THAT COME WITHIN THE CONTRACT NO OTHER EXCEPTION THAN OWNER'S PERMISSION TO CUT SAME IF THE NEED ARISES.
56 CONTRACTOR'S ATTENTION IS DIRECTED TO THE FACT THAT ALL OF THESE UTILITIES AND LINES ARE NOT INDICATED ON THE DRAWINGS; HOWEVER, IT IS REQUIRED THAT PRIOR TO ANY EXCAVATION BEING PERFORMED, THAT THE CONTRACTOR CONSULT OWNER'S PERSONNEL TO ASCERTAIN WHETHER ANY UTILITIES OR LINES ARE ENDANGERED BY EXCAVATION.
57 IF AFOREMENTIONED UTILITIES OR LINES OCCUR IN THE EARTH WITHIN THE CONSTRUCTION SITE, IT IS SUGGESTED THAT THE CONTRACTOR FIRST PROBE AND MAKE EVERY EFFORT TO LOCATE LINES PRIOR TO EXCAVATING IN RESPECTIVE AREA.
58 MECHANICAL CONTRACTOR SHALL WARRANT SYSTEMS, EQUIPMENT, AND APPARATUS TO BE PROPERLY BALANCED, AND FREE FROM ANY DEFECTS IN MATERIAL OR WORKMANSHIP FOR A PERIOD OF ONE (1) YEAR FROM DATE OF ACCEPTANCE.
59 ANY NECESSARY STARTERS OR OVERLOAD PROTECTION FOR MECHANICAL EQUIPMENT, SHALL BE FURNISHED BY MECHANICAL CONTRACTOR FOR EQUIPMENT FURNISHED BY HIM OR OWNER, UNLESS OTHERWISE SPECIFIED ELSEWHERE.
60 MECHANICAL CONTRACTOR SHALL (REGARDLESS OF VOLTAGE) FURNISH AND INSTALL ALL TEMPERATURE CONTROL WIRING, AND ALL INTERLOCK WIRING, AND EQUIPMENT CONTROL WIRING FOR EQUIPMENT THAT MECHANICAL CONTRACTOR FURNISHES, UNLESS OTHERWISE SPECIFIED. MECHANICAL CONTRACTOR SHALL FURNISH STARTERS FOR ALL EQUIPMENT FURNISHED BY HIM TO ELECTRICAL CONTRACTOR FOR INSTALLATION. MECHANICAL CONTRACTOR SHALL PROVIDE AND BE RESPONSIBLE FOR ALL STARTER HEATERS THAT MECHANICAL CONTRACTOR FURNISHES.
61 SUB-CONTRACTORS SHALL TAKE THE PREMISES AS THEY ARE AND WILL BE REQUIRED TO DO ALL WORK SHOWN OR IMPLIED IN THE PLANS AND SPECIFICATIONS SO THAT WHEN BUILDING IS COMPLETED, IT SHALL BE COMPLETE IN EVERY RESPECT, EXCEPT SUCH PARTS AS ARE DISTINCTLY MENTIONED AS NOT BEING COVERED UNDER THESE SPECIFICATIONS.
62 FURNISH MARKED-UP PRINTS AND SHOP DRAWINGS OF MECHANICAL SYSTEMS AND EQUIPMENT TO GENERAL CONTRACTOR FOR INCLUSION IN BOUND SETS OF AS-BUILT DRAWINGS.
63 AS-BUILT DRAWINGS SHALL SHOW ALL CHANGES, ADDITIONS, DELETIONS AND DEVIATIONS FROM CONTRACT DRAWINGS NOTED PLAINLY THEREON. SPECIAL EMPHASIS IS PLACED ON RECORDING EXACT LOCATION OF ALL UNDERGROUND UTILITIES BY OFFSET DISTANCES TO BUILDING CORNERS, WALLS, CURBS, ETC.
64 MECHANICAL CONTRACTOR SHALL INSTRUCT OWNER'S REPRESENTATIVE IN PROPER OPERATION OF ALL EQUIPMENT. FURNISH LITERATURE PROVIDED BY MANUFACTURER. PRINTED INSTRUCTION AND MAINTENANCE DATA SHALL BE BOUND WITH COVER IN DUPLICATE AND DELIVERED TO ENGINEER. BOUND COVER SHALL LIST NAME OF PROJECT AND MAKE, ADDRESS, PHONE NUMBER OF ARCHITECT, ENGINEER, AND CONTRACTOR.
65 EACH GROUP SHALL INCLUDE A COMPLETE CONTROL DIAGRAM AND A SEQUENCE OF OPERATION, CONTROL DIAGRAM AND ASSOCIATED SEQUENCE OF OPERATION CHARTS SHALL BE ON SAME SHEET. EACH GROUP SHALL INCLUDE A COMPLETE WIRING OF THE GROUP, INCLUDING PANEL WIRING, COLOR CODING, NUMBER CODING, OILING OR GREASING CHARTS, MAINTENANCE OF OPERATIONS LISTING SUGGESTED OPERATING METHODS AND PERIODS. EACH DEVICE LISTED AND IDENTIFIED AS GIVEN ABOVE AND COMPLETELY DESCRIBED AS TO MANUFACTURER'S NAME, TYPE, NUMBER, WORKING LIMITATIONS, ETC. PARTS OR REPAIR LISTS SHALL BE GIVEN FOR EACH DEVICE.
66 PROVIDE START, TEST, AND CHECK OF MECHANICAL SYSTEM TO ENSURE SYSTEM OPERATES AS DESIGNED.
67 PROVIDE DOCUMENTATION OF OPERATING PARAMETERS AT TIME OF STARTUP, AS PER EQUIPMENT MANUFACTURERS RECOMMENDATIONS. DATA TO INCLUDE PRESENT OPERATING PARAMETERS AS WELL AS AMBIENT CONDITIONS AND DATE AND TIME OF START-UP.
68 CONTRACTORS MUST HAVE FIVE (5) YEARS MINIMUM EXPERIENCE, HAS A SATISFACTORY WORK RESUME WITH COMPARABLE PROJECTS LISTED, HAS A SOUND FINANCIAL BASIS, AND IS TECHNICALLY COMPETENT.
69 EQUIPMENT MANUFACTURERS MUST HAVE EIGHT (8) YEARS OF SUCCESSFUL EXPERIENCE, BE TECHNICALLY COMPETENT, AND BE INDUSTRIAL FINANCIALLY STABLE.
70 OWNER RESERVES THE RIGHT TO REVIEW AND DETERMINE IF CONTRACTORS AND MANUFACTURERS MEET ABOVE CATEGORIES TO HIS SATISFACTION. OWNER HAS THE AUTHORITY TO REJECT ANY EQUIPMENT AND BIDS IF ABOVE STANDARDS ARE NOT MET.
71 ALL FASTENERS SHALL BE STAINLESS STEEL OR MADE OF ANTI-CORROSIVE MATERIAL COMPATIBLE AND INTENDED FOR THE USE WITH THE MATERIAL BEING FASTENED.

HANGERS AND SUPPORTS

- 1.0 BASIC MECHANICAL MATERIALS AND METHODS
1.1 ALL PIPING SHALL HAVE LABELS STATING CONTENTS AND DIRECTIONAL ARROWS INDICATING FLOW. LABELS SHALL BE APPLIED 50 FEET O.C. IN STRAIGHT RUNS EXCEPT NO MORE THAN 25 FEET O.C. IN EQUIPMENT ROOMS. LABELS SHALL BE APPLIED ON BOTH SIDES OF A WALL WHERE PIPE PASSES THROUGH SAME. LABELS SHALL BE SIMILAR TO SETON NAMEPLATE CORP. - SETMARK TYPE SNA OR STK.
1.2 INSTALL NUMBERED VALVE TAGS ON ALL VALVES. FURNISH DIRECTORY OF VALVES GIVING FLUID HANDLED, FUNCTION, SIZE, AREA SERVED, NAME AND NUMBER OF ROOM IN WHICH A VALVE IS LOCATED, ETC. TAGS SHALL BE MINIMUM 3 INCH X 1 INCH LAMINATED ENGRAVED PLASTIC WITH STAINLESS STEEL CHAIN. TAGS SHALL INDICATE FLUID HANDLED AND FUNCTION OF VALVE.
1.3 INSTALL EQUIPMENT LABELS AT EACH MAJOR ITEM OR EQUIPMENT. LABELS SHALL BE LAMINATED ENGRAVED PLASTIC AND SHALL INCLUDE COMPLETE IDENTIFICATION OF EQUIPMENT INCLUDING AREA SERVED, IDENTIFYING NUMBERS AND TAGS USED ON THE DRAWINGS.
1.4 INSTALL PIPING INDICATED TO BE EXPOSED AND PIPING IN EQUIPMENT ROOMS AND SERVICE AREAS AT RIGHT ANGLES OR PARALLEL TO BUILDING WALLS. DIAGONAL RUNS ARE PROHIBITED UNLESS SPECIFICALLY INDICATED OTHERWISE OR APPROVED IN WRITING BY ENGINEER.
1.5 INSTALL UNIONS, IN PIPING 2 INCHES AND SMALLER, ADJACENT TO EACH VALVE AND AT FINAL CONNECTION TO EACH PIECE OF EQUIPMENT. LOCATE UNIONS AND VALVES TO ALLOW FOR REMOVAL OF PIPING DOWNSTREAM FOR EQUIPMENT ACCESS AND SERVICING.
1.6 INSTALL FLANGES IN PIPING 2 1/2 INCHES AND LARGER, ADJACENT TO FLANGED VALVES AND AT FINAL CONNECTION TO EACH PIECE OF EQUIPMENT. LOCATE FLANGES AND VALVES TO ALLOW FOR REMOVAL OF PIPING DOWNSTREAM FOR EQUIPMENT ACCESS AND SERVICING.
1.7 INSTALL DIELECTRIC COUPLING AND NIPPLE FITTINGS TO CONNECT PIPING MATERIALS OF DISSIMILAR METALS. INSTALL SHUTOFF VALVES IN BRANCH PIPING AT DIELECTRIC COUPLINGS TO PROVIDE FOR SERVICING.
1.8 IT SHALL BE THE RESPONSIBILITY OF THE PLUMBING CONTRACTOR TO REVIEW THE GAS SERVICE AND ENSURE THAT EQUIPMENT IS SUPPLIED WITH THE APPROPRIATE GAS PRESSURE AND VOLUME. THIS WORK SHALL INCLUDE, BUT NOT BE LIMITED TO, A LARGER SERVICE OR PRESSURE CHANGES, ADDITIONAL GAS PRESSURE REDUCING VALVES/REGULATORS, INCREASING THE SIZE OF THE GAS SERVICE LINES AS REQUIRED. ALL NEW PIPES SHALL BE OF TYPE AND SPECIFICATION AS RECOMMENDED BY THE RESPECTIVE EQUIPMENT MANUFACTURER. THE LINE BETWEEN THE PVP AND THE EQUIPMENT GAS TRAIN SHALL PROVIDE A SUFFICIENT AMOUNT OF VOLUME TO PREVENT THE PVP/REGULATOR FROM PULSATING (COORDINATE REQUIREMENTS WITH THE EQUIPMENT MANUFACTURER).
1.9 GAS TRAINS SHALL BE PROVIDED WITH GAS VENT LINES FOR ALL DIAPHRAGM DEVICES AND DEDICATED VENTS FOR DOUBLE BLOCK AND VENT GAS TRAINS. GAS TRAINS SHALL BE AN APPROVED UL INSTALLATION. ALL GAS PIPING AND GAS VENTS ARE THE RESPONSIBILITY OF THE PLUMBING CONTRACTOR.
1.10 THERE SHALL BE NO COPPER PIPING OR TUBING IN THE ENTIRE GAS SYSTEM INCLUDING VENT LINES. VENTS SHALL TERMINATE OUTSIDE THE BUILDING THROUGH APPROVED GAS VENTS, SIMILAR TO FISHERS YIELD SERIES VENT FITTINGS. DIAPHRAGM VENTS AND RELIEF VENTS SHALL NOT TERMINATE IN THE SAME FITTING. VENT LINES SHALL NOT BE COMBINED AND/OR MANIFOLDED TOGETHER.
1.11 FLUE PIPE LAYOUT, INSTALLATION AND COORDINATION WITH THE BOILER FLUE SUPPLIER SHALL BE THE RESPONSIBILITY OF THE MECHANICAL CONTRACTOR. THE ROUTING OF FLUE PIPE FOR ALL NEW EQUIPMENT SHALL HAVE PRIORITY OVER ALL OTHER WORK INSTALLED. ALL EQUIPMENT SHALL BE LOCATED AND ARRANGED IN A MANNER WHICH PERMITS AS STRAIGHT OF A ROUTE FOR THE FLUE AS POSSIBLE.
1.12 INSTALL MANUAL AIR VENTS AT ALL HIGH POINTS IN HEATING HOT WATER, AND CHILLED WATER PIPING SYSTEMS.
1.13 ROUTE REFRIGERANT PRESSURE RELIEF VALVES TO EXTERIOR OF BUILDING.
1.14 PRIOR TO EQUIPMENT INSTALLATION, VERIFY THERE IS SPACE TO PROVIDE SLOPE IN PIPING OFF OF COOLING COIL CONDENSATE DRAIN PAN.
1.15 FOR REFRIGERANT PIPING SYSTEMS INSTALL CHARGING VALVES AND INSTALL OIL LIFTING TRAPS BASED ON SYSTEM REQUIREMENTS. INSTALL AND SUPPORT PIPING WITH ALLOWANCE FOR EXPANSION, CONTRACTION, AND VIBRATION.
1.16 INSTALL ACCESS PANELS IN MECHANICAL CHASES WHERE REQUIRED. ACCESS PANELS SHALL BE A MINIMUM OF 12 INCHES SQUARE AND 1/4 GAUGE STEEL. ACCESS PANELS WILL BE PAINTED BY GENERAL CONTRACTOR TO MATCH ADJACENT FINISHES.
1.17 MECHANICAL CONTRACTOR SHALL SIZE ROOM LEVEL DUCTWORK, DIFFUSERS AND BRANCH PIPING SYSTEMS NOT SHOWN ON THE DRAWINGS BASED ON THE ASSOCIATED EQUIPMENT SCHEDULES AND THE FOLLOWING CRITERIA:
A. CHILLED WATER AND HEATING HOT WATER PIPING - LESS THAN 4 FEET OF FRICTION PER 100 FOOT OF PIPE FOR, BUT NOT LESS THAN 3/4 INCHES IN SIZE, AND NOT MORE THAN 8 FT/SEC. FLUID VELOCITY.
B. SUPPLY DUCTS - LESS THAN 0.08 INCHES STATIC PRESSURE DROP PER 100 FEET OF DUCT AND LESS THAN 1,200 FPM VELOCITY.
C. RETURN DUCTS - LESS THAN 0.05 INCHES STATIC PRESSURE DROP PER 100' OF DUCT AND LESS THAN 1,200 FPM VELOCITY.
D. SUPPLY AIR FLOW TO BE EQUALLY SPLIT BETWEEN DIFFUSERS IN EACH CORRESPONDING ROOM BUT NO MORE THAN 300 CFM PER DIFFUSER.
1.18 CLEAN EQUIPMENT THOROUGHLY TO ENSURE IT IS FREE OF DIRT, SCALE, WASTE, DEBRIS, ETC. PAINT DAMAGED OR SCRATCHED FACTORY FINISH WITH TOUCH-UP PAINT MATCHING FACTORY FINISH.
1.19 INSTALL EQUIPMENT PUMPS AND LEVEL. INSTALL ALL EQUIPMENT IN ACCORDANCE WITH MANUFACTURER'S INSTRUCTIONS, LOCAL CODES AND RECOGNIZED INDUSTRY PRACTICES. INSTALL PUMPS, AIR HANDLING UNIT, CHILLERS, ETC. ON NEOPRENE ISOLATION PADS. ARRANGE INSTALLATION OF EQUIPMENT TO PROVIDE ACCESS AROUND UNIT FOR SERVICE AND MAINTENANCE. ROOF OF EQUIPMENT SHALL BE INSTALLED ON CURBS IN A WEATHER TIGHT MANNER. COORDINATE ANY REQUIRED PREP WORK OTHER TRADES PRIOR TO INSTALLATION OF EQUIPMENT.
1.20 RELEASE/REMOVE SHIPPING BOLTS ON FANS, PUMPS, COMPRESSORS, ETC. BEFORE STARTING EQUIPMENT. COORDINATE CHECK-OUT OF MOTOR ROTATION WITH ELECTRICAL SUBCONTRACTOR. DISCONNECT PUMPS FROM MOTORS BEFORE CHECKING ROTATION, RECONNECT AFTER CHECK OUT.
1.21 CHECK LUBRICATION OF BEARINGS ON FANS, PUMPS, MOTORS, ETC. PRIOR TO STARTUP. CHECK ALIGNMENT OF COUPLINGS AND FAN BELTS. ROUTE DRAINS TO FLOOR DRAIN IN AREA.
1.22 CONNECT PIPES AND DUCTS TO EQUIPMENT WITH FLEXIBLE CONNECTORS. ALL PIPING AND DUCTWORK SHALL BE SUPPORTED INDEPENDENT OF EQUIPMENT.
1.23 INSTALL BOILERS, CHILLERS, AND PUMPS ON CONCRETE BASES. ANCHOR EQUIPMENT TO CONCRETE BASES. INSTALL MISCELLANEOUS STRUCTURAL STEEL ON FLOORS, IN CEILINGS OR ON ROOFS TO SUPPORT EQUIPMENT NOT INSTALLED ON CONCRETE BASE.
1.24 INSTALL AND ANCHOR TERMINAL EQUIPMENT TIGHT AND SECURE TO FLOORS AND WALLS.
1.25 REFRIGERANT PIPING SYSTEMS, INCLUDING STRAINERS AND DRIVER/FILTERS, ETC., SHALL BE CLEANED AND DEHYDRATED. PRESSURE TEST REFRIGERANT SYSTEM FOR LEAKAGE IN MANNER RECOMMENDED BY MANUFACTURER. UTILIZE AN ELECTRONIC OR HALIDE LEAK DETECTOR FOR LEAK CHECKS. PROVIDE AND CHARGE CHILLER OR DX CONDENSING SYSTEM WITH REFRIGERANT IN THE QUANTITY AND MIX RECOMMENDED BY THE EQUIPMENT MANUFACTURER AND UNDER THEIR SUPERVISION. BLEED OUT NONCONDENSABLE GASES. ALL REFRIGERANT WORK SHALL MEET OR EXCEED REQUIREMENTS OF EPA TITLE V. SUBMIT RECORDS OF REFRIGERANT INSTALLATION TO ENGINEER.
1.26 CHECK AND STRAIGHTEN FINS ON ALL COILS IN EQUIPMENT PRIOR TO STARTUP.
1.27 INSTALL AIR FILTERS IN EQUIPMENT ONLY AFTER ALL CLEANING HAS BEEN COMPLETED AND PRIOR TO TESTING AND BALANCING. PREVENT PASSAGE OF UNFILTERED AIR AROUND FILTERS WITH FELT, RUBBER OR NEOPRENE GASKETS. INSTALL FILTER GAUGES ON OUTSIDE OF FILTER SECTIONS IN AN ACCESSIBLE POSITION, INSTALL STATIC PRESSURE TAPS UPSTREAM AND DOWNSTREAM OF FILTERS.
1.28 THOROUGHLY CLEAN ALL PIPING SYSTEMS AND EQUIPMENT. FLUSH FREE OF DIRT, SCALE, OIL, WASTE, BLOW DOWN STRAINERS WHEN FLUSHING.
1.29 PROVIDE AND INSTALL VALVES IN ALL SYSTEMS AS REQUIRED TO FACILITATE THE OPERATION OF VARIOUS SYSTEMS AND THE WORK OF OTHER TRADES DURING CONSTRUCTION.
1.30 THOROUGHLY TEST FOR LEAKS, OPERATION, ETC. EACH SYSTEM, DEVICE AND ITEM OF EQUIPMENT INSTALLED AS PART OF THE WORK.
1.31 INSTALL PIPING COMPONENTS WITH PRESSURE RATINGS EQUAL TO OR GREATER THAN SYSTEM OPERATING PRESSURE.
1.32 INSTALL PIPING FREE OF SAGS OR BENDS.

MECHANICAL INSULATION

- 3.0 MECHANICAL INSULATION
3.1 MECHANICAL INSULATION SHALL COMPLY WITH THE REQUIREMENTS OF THE CURRENT INDIANA ENERGY CODE (ANSI /ASHRAE /IESNA STANDARD 90.1-2013 WITH INDIANA AMENDMENTS.)
3.2 INSULATE INDOOR SUPPLY AIR, OUTSIDE AIR, AND COMBUSTION AIR DUCTWORK WITH NOMINAL 2 INCHES OF THICK GLASS FIBER BLANKET INSULATION, ASTM C535, TYPE 11, K-V VALUE OF 0.27 AT 75F, 0.75 LBS/CUBIC FOOT MINIMUM DENSITY, WITH ALL-SERVICE JACKET, VAPOR BARRIER TYPE, MANUFACTURED FROM KRAFT PAPER, REINFORCING SCRIM, ALUMINUM FOLIE AND VINYL FILM. PROVIDE NOMINAL 1/2 INCH INSULATION IN UNHEATED ATTICS AND CRAWL SPACES. OVERLAP INSULATION FACING AT SEAMS AND SEAL WITH VAPOR-RETARDER MASTIC AND PRESSURE-SENSITIVE TAPE HAVING SAME FACING AS INSULATION.
3.3 INSULATE THE FOLLOWING TYPES OF PIPING WITH GLASS FIBER FACTORY MOLDED RIGID INSULATION, ASTM C547 TYPE 1, K-V VALUE 0.8 AT 75F, WITH ALL-SERVICE JACKET, VAPOR BARRIER TYPE. THICKNESS AS LISTED BELOW. OVERLAP INSULATION FACING AT SEAMS AND SEAL WITH VAPOR-RETARDER MASTIC AND PRESSURE SENSITIVE TAPE HAVE SAME FACING AS INSULATION.
A. CONDENSATE DRAINS: FIRST 10 FEET FROM EVAPORATOR WITH 1/2 INCH THICKNESS MOLDED FIBERGLASS OR 1/2 INCH ELASTOMERIC.
B. HEATING HOT WATER: 2 INCH PIPE SIZE - 1" THICKNESS; 2-1/2 INCHES AND LARGER PIPE SIZE - 1-1/2 INCH THICKNESS.
3.4 INSULATE THE FOLLOWING TYPES OF PIPING WITH FLEXIBLE ELASTOMERIC CLOSED-CELL INSULATION, ASTM C534, TYPE I, K-V VALUE OF 0.27 AT 75F. FOR TUBULAR MATERIALS, ADHESIVE AND ULTRAVIOLET-PROTECTIVE COATING AS RECOMMENDED BY THE INSULATION MANUFACTURER. SEAL ALL JOINTS AND SEAMS WITH VAPOR-RETARDER MASTIC. INSULATION RECOMMENDED BY THE INSULATION MANUFACTURER. APPLY TWO COATS OF FINISH IN ACCORDANCE WITH THE MANUFACTURER'S INSTRUCTIONS AS REQUIRED TO PROVIDE A WEATHERPROOF FINISH FOR EXTERIOR INSTALLATION.
A. REFRIGERANT SUCTION AND HOT GAS: 3/4 INCH THICKNESS
3.5 INSULATE THE FOLLOWING TYPES OF PIPING WITH FLEXIBLE ELASTOMERIC CLOSED-CELL INSULATION, ASTM C534, TYPE I, K-V VALUE AS 0.27 AT 75F OR GLASS FIBER FACTORY MOLDED RIGID INSULATION, ASTM C547 TYPE 1, K-V VALUE OF 0.24 AT 75F, WITH ALL-SERVICE JACKET, VAPOR BARRIER TYPE, FOR TUBULAR MATERIALS, ADHESIVE AND ULTRAVIOLET-PROTECTIVE ALUMINUM OR PVC LACKET AS RECOMMENDED BY THE INSULATION MANUFACTURER. SEAL ALL JOINTS AND SEAMS WITH VAPOR-RETARDER MASTIC AS RECOMMENDED BY THE INSULATION MANUFACTURER. APPLY TWO COATS OF FINISH IN ACCORDANCE WITH THE MANUFACTURER'S INSTRUCTIONS AS REQUIRED TO PROVIDE A WEATHERPROOF FINISH FOR EXTERIOR INSTALLATION.
A. EXTERIOR CONDENSER WATER: 3/4 INCH THICKNESS
3.6 APPLY INSULATION OVER FITTINGS, VALVES, AND SPECIALTIES WITH CONTINUOUS THERMAL AND VAPOR RETARDER INTEGRITY. SEAL PENETRATIONS IN INSULATION AT HANGERS, SUPPORTS, ANCHORS, AND OTHER PROJECTIONS WITH VAPOR-RETARDER MASTIC. APPLY INSULATION CONTINUOUSLY THROUGH HANGERS AND AROUND ANCHOR ATTACHMENTS. EXTEND INSULATION ON ANCHOR LEGS AT LEAST 12 INCHES FROM POINT OF ATTACHMENT TO PIPE AND TAPER INSULATION ENDS. SEAL TAPERED ENDS WITH A COMPOUND RECOMMENDED BY THE INSULATION MATERIAL MANUFACTURER TO MAINTAIN VAPOR RETARDER.
3.7 APPLY PIPE INSULATION CONTINUOUSLY THROUGH WALLS AND FLOORS. APPLY DUCT INSULATION CONTINUOUSLY THROUGH WALLS AND PARTITIONS, EXCEPT FIRE-RATED WALLS AND PARTITIONS (TERMINATE DUCT INSULATION AT FIRE/SMOKE DAMPER SLEEVES). TERMINATE DUCT INSULATION AT UNDERSEAM OF FLOOR ASSEMBLY AND AT FLOOR SUPPORT AT TOP OF FLOOR. TAPER TERMINATION AND SEAL INSULATION ENDS WITH VAPOR-RETARDER MASTIC.
3.8 ALL INSULATED SHALL HAVE A FLAME SPREAD INDEX RATING OF 25 OR LESS, AND A SMOKE DEVELOPED INDEX RATING OF 50 OR LESS.
3.9 INSTALL ALL MATERIALS IN ACCORDANCE WITH MANUFACTURER'S INSTRUCTIONS.
3.10 PUMP BODY, EQUIPMENT, STRAINERS, ETC., INSULATION SHALL BE INSTALLED IN SUCH A MANNER THAT IT CAN BE EASILY REMOVED AND REPLACED WITHOUT DAMAGE.
4.0 VALVES
4.1 VALVES IN STEEL PIPING SHALL BE SCREWED 2 INCH AND SMALLER OR FLANGED END 2- 1/2 INCH AND LARGER. VALVES IN COPPER TUBING SHALL BE BRONZE BODY, WITH SOLDERED OR BRAZED ENDS.
4.2 ALL VALVES SHALL BE DRIP-TIGHT, RATED FOR CONTINUOUS DUTY FOR A MINIMUM OF 25 PSIG AND 25 DEG F. HIGHER THAN DUTY IMPOSED. MINIMUM PRESSURE/TEMPERATURE RATINGS: 125 PSIG/250 DEG. F. FOR FLUIDS 99 PSIG AND LESS, 250 PSIG/350 DEG. F. FOR FLUIDS 100 PSIG AND HIGHER.
4.3 CHECK VALVES: NON-SLAM GLOBE TYPE, IRON OR SEMI-STEEL BODY, STAINLESS STEEL SPRING, BRONZE TRIM, 2 INCH AND SMALLER, THREADED OR SOLDERED ENDS. 2-1/2 INCH AND LARGER, FLANGED OR GROOVED END.
4.4 BALL VALVES: 400 PSIG WOG CONSTRUCTION, 250 DEG. F. MINIMUM TEMPERATURE RATING, EQUIPPED WITH REINFORCED TEFLOON SEALS AND SEALS, ANTI-BLOWOUT STEM AND FULL PORT (LINE SIZE PORT), CHROME PLATED BALL, BRONZE OR BRASS BODY, SCREWED/ SOLDERED PATTERN.
4.5 BUTTERFLY VALVES: LUG OR GROOVED PATTERN WAFER TYPE, RATED 250 PSIG/350 DEG. F., STAINLESS STEEL SHAFTS AND DISC, FLANGE SEALS INTEGRAL WITH SEAT OR SEPARATE O-RINGS AND BRONZE DISC, CAST IRON BODY, EQUIPPED WITH REPLACEABLE SEATS. OPERATOR FOR 6 INCH AND SMALLER VALVES SHALL BE TEN (10) POSITION HANDLE. OPERATOR FOR 8 INCH AND LARGER VALVES SHALL BE ENCLOSED GEAR POSITIONER WITH DIAL INDICATOR AND HANDWHEEL WITH SPRINGER.

Table with columns: DATE, BY, ISSUE/REVISION, DWA, ADDENDUM #. Rows 11-20-23, 12-21-23.

Table with columns: DATE, BY, ISSUE/REVISION, DWA, ADDENDUM #. Rows 11-20-23, 12-21-23.



HVAC SPECIFICATIONS
GREATER CLARK COUNTY SCHOOLS
JEFFERSONVILLE HIGH SCHOOL NATATORIUM
2315 ALLISON LANE
JEFFERSONVILLE, IN 47130

JOB NO.: 23084T
SCALE: AS NOTED
DATE: 11-20-2023
DRAWN BY: DJN
APPROVED BY: TC
DRAWING NUMBER:
M0.02
REVISION NO.: 1




KEYNOTES

- PIPE PENETRATION THROUGH PRECAST PANEL. COORDINATE OPENING SIZE AND LOCATION WITH ARCHITECT AND GENERAL CONTRACTOR.


DRAWING NOTES

SEE PIPE SIZING ON PIPING SCHEMATIC DRAWING, SHEET M5.02

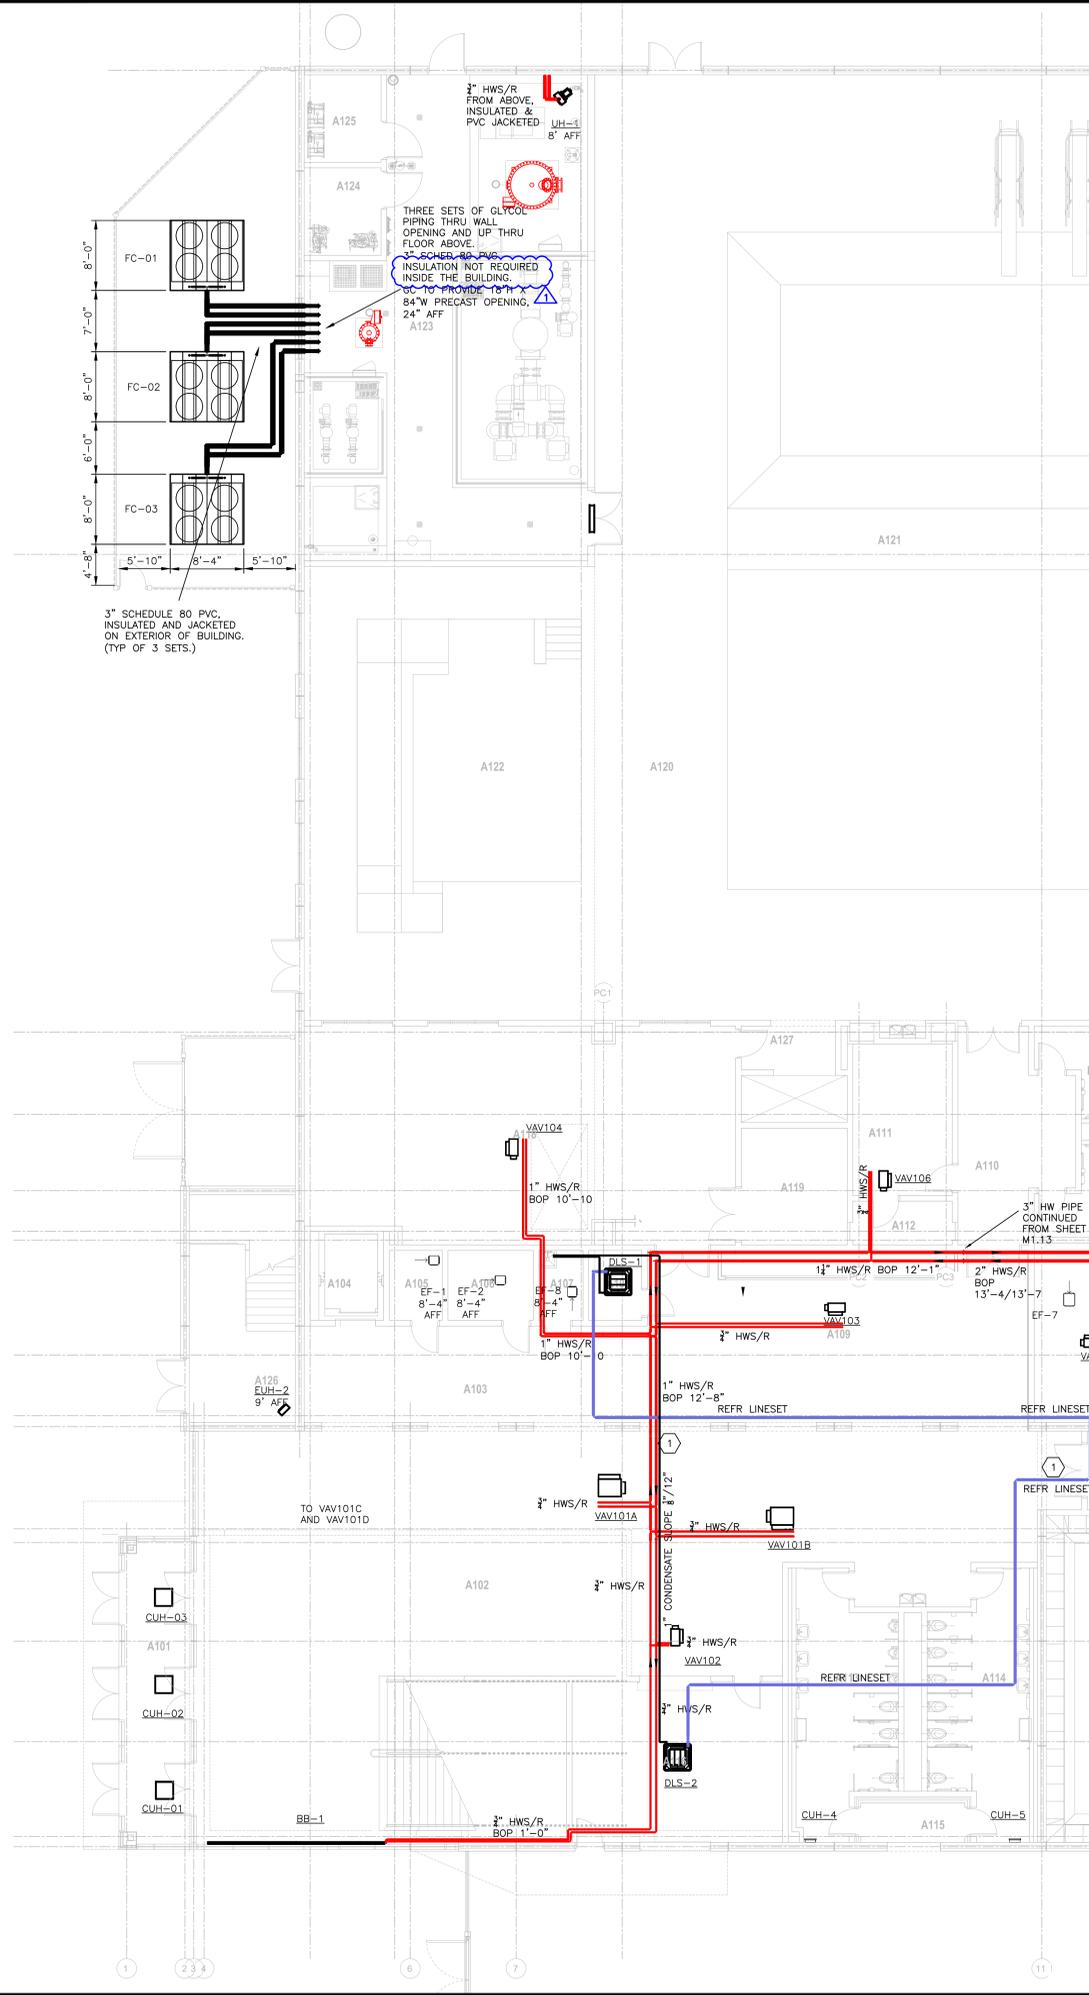

UNIT A - FIRST FLOOR PIPING PLAN - HVAC

1/8"=1'-0"

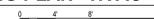


<small>                 MODEL: THIS DRAWING IS THE PROPERTY OF THE ENGINEER OR ARCHITECT. IT IS TO BE USED ONLY FOR THE PROJECT AND SITE SPECIFICALLY IDENTIFIED HEREON. IT IS NOT TO BE REPRODUCED, COPIED, OR TRANSMITTED IN ANY FORM OR BY ANY MEANS, ELECTRONIC OR MECHANICAL, INCLUDING PHOTOCOPYING, RECORDING, OR BY ANY INFORMATION STORAGE AND RETRIEVAL SYSTEM, WITHOUT THE WRITTEN PERMISSION OF THE ENGINEER OR ARCHITECT.             </small>	
<b>ESTD 1951</b>  <b>PERFECTION GROUP</b>	
UNIT A - FIRST FLOOR PIPING PLAN - HVAC GREATER CLARK COUNTY SCHOOLS JEFFERSONVILLE HIGH SCHOOL NATATORIUM 2315 ALLISON LANE JEFFERSONVILLE, IN 47130	
JOB NO.: 23084T SCALE: AS NOTED DATE: 11-20-2023 DRAWN BY: DJN APPROVED BY: TC DRAWING NUMBER: <b>M1.03</b> REVISION NO.: 1	


RA\_2023\GCCS - Jeffersonville Natatorium\_23084T\Engineering\Design\Units\_Elec\3D-FL1 - GCCS - Jeffersonville Nat\_23084T.dwg  
 30x42\_11/28/18

**GROUNDING CODED NOTES:**


- A GROUNDING ELECTRODE CONDUCTOR, BARE, TINNED, STRANDED, COPPER-CONDUCTOR, (30 INCHES BELOW GRADE, MIN.) (24 INCHES FROM FOUNDATION, MIN.) FOR ELECTRICAL SERVICE OF 800 AMP OR LESS USE #20 AWG. FOR ELECTRICAL SERVICE GREATER THAN 800 AMP USE #40 AWG.
- B GROUNDING CONDUCTOR, 2# AWG BARE, TINNED, STRANDED, COPPER-CONDUCTOR.
- C IRREVERSIBLE, COPPER, COMPRESSION CONNECTOR, (CABLE TO CABLE)
- D IRREVERSIBLE, COPPER, COMPRESSION CONNECTOR, (CABLE TO TRAY) BOND EACH SECTION, TRANSITION, RISER, TEE, ETC.
- E MAIN BONDING JUMPER PROVIDED BY MANUFACTURER AS PART OF LISTED AND LABELED SERVICE EQUIPMENT. IF NOT PROVIDED BY MANUFACTURER, PROVIDE #40 BARE, TINNED, STRANDED, COPPER-CONDUCTOR.
- F GROUNDING ELECTRODE CONDUCTOR, #40 AWG STRANDED, BARE, COPPER IN PVC CONDUIT.
- G GROUNDED CONDUCTOR (NEUTRAL); (REFER TO ONE-LINE DIAGRAM FOR CONDUCTOR SIZE).
- H PROVIDE UL 467 LISTED COMPRESSION CONNECTORS, TWO-HOLE LUGS.
- I SYSTEM BONDING JUMPER CONDUCTOR. SYSTEM BONDING JUMPER CONDUCTOR TO BE RUN IN EACH CONDUIT CONTAINING PHASE CONDUCTORS BETWEEN TRANSFORMER AND MAIN SECONDARY DISCONNECT. (REFER TO ONE-LINE DIAGRAM FOR CONDUCTOR SIZE)
- J 10 FOOT BY 3/4" COPPER WELD GROUND ROD. TOP OF ROD SHALL BE 12" MINIMUM BELOW FINISHED GRADE.
- K 8 FOOT BY 5/8" COPPER WELD GROUND ROD. TOP OF ROD SHALL BE 12" MINIMUM BELOW FINISHED GRADE.
- L PROVIDE EXOTHERMIC WELD FOR ALL CABLE TO ROD, CABLE TO CABLE, OR CABLE TO STEEL CONNECTIONS.
- M EQUIPMENT BONDING JUMPER STRANDED, BARE, COPPER, (#110A USE #6, #410A USE #2, #810A USE #20, #2100A USE #40) SCREW OF BUSBAR MAY BE USED WHEN PROVIDED AS PART OF LISTED SERVICE EQUIPMENT.
- N EQUIPMENT GROUNDING CONDUCTOR (REFER TO ONE LINE DIAGRAM FOR CONDUCTOR SIZE).
- O TELECOMMUNICATIONS BONDING BACKBONE: #40 AWG STRANDED BARE COPPER.
- P BONDING CONDUCTOR, 6 AWG STRANDED BARE COPPER.
- Q 1" PVC SLEEVE FOR ALL GROUNDING CONDUCTORS THROUGH FLOOR SLABS. NEVER ROUTE GROUNDING CONDUCTORS IN A METAL CONDUIT.
- R PROVIDE UL 467 LISTED, ELECTRO-TIN-PLATED COPPER BUSBAR, 4" x 20" x 1/4" WITH (2) 2-INCH INSULATED STANDOFF SUPPORTS. PROVIDE ENGRAVED NAMEPLATE, SCREWED TO WALL, 6" ABOVE GROUNDING BUS BAR WHICH READS "IF THESE CONNECTORS OR CABLES ARE LOOSE OR MUST BE REMOVED, PLEASE CALL THE BUILDING TELECOMMUNICATIONS MANAGER".
- S PROVIDE UL 467 LISTED, ELECTRO-TIN-PLATED COPPER BUSBAR, 2" x 12" x 1/4" WITH (2) 2-INCH INSULATED STANDOFF SUPPORTS. PROVIDE ENGRAVED NAMEPLATE, SCREWED TO WALL, 6" ABOVE GROUNDING BUS BAR WHICH READS "IF THESE CONNECTORS OR CABLES ARE LOOSE OR MUST BE REMOVED, PLEASE CALL THE BUILDING TELECOMMUNICATIONS MANAGER".
- T CONTINUOUS, UNSPLICED BONDING CONDUCTOR FOR TELECOMMUNICATIONS: 2# AWG BARE, TINNED, STRANDED, COPPER-CONDUCTOR IN CABLE TRAYS.
- U BRAZED ALUMINUM CABLE FOR LIGHTING DOWNRUNNER. SUPPORT SPACING PER NFPA 780.
- V CONNECT GROUND CABLE TO EXISTING SERVICE GROUNDING ELECTRODE AT UTILITY TRANSFORMER OR MAIN SWITCHBOARD GROUND BAR.
- W CONNECT TO EXISTING BUILDING GROUND LOOP IF FOUND, DISTURBED, OR DAMAGED, PROVIDE (K) AT ALL SPLICES AND NEW CABLE CONNECTIONS.
- X WELD A MINIMUM 6" x 3" x 1/4" STEEL PLATE TO UNDERSIDE OF BOTTOM FLANGE OF ROOF JOIST. THE STEEL PLATE SHALL BE WELDED TO THE BOTTOM FLANGE USING A NORMAL WELDING PROCEDURE WITH WELDS PARALLEL TO THE BOTTOM FLANGE ALONG THE EDGE. THEN BOND THE GROUNDING CONDUCTOR TO THE STEEL PLATE AT LEAST 1" AWAY FROM FLANGE, USING AN EXOTHERMIC WELD.
- Y PROVIDE WRAP AROUND PLASTIC LABEL ON EACH CONDUCTOR AT GROUND BAR. IDENTIFY WHAT THE CABLE IS CONNECTED TO.

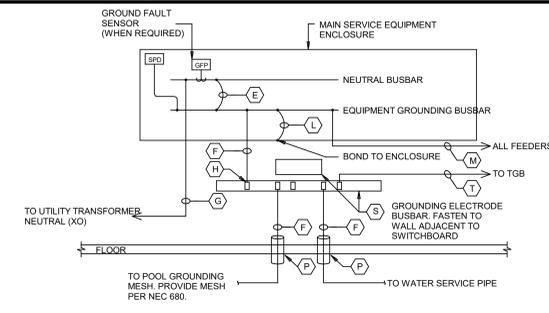


**1 MAIN SERVICE GROUNDING ELECTRODE BUSBAR DETAIL**  
NO SCALE

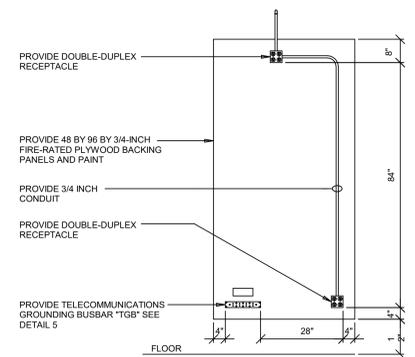


**2 TYPICAL TR BACKBOARD**  
NO SCALE

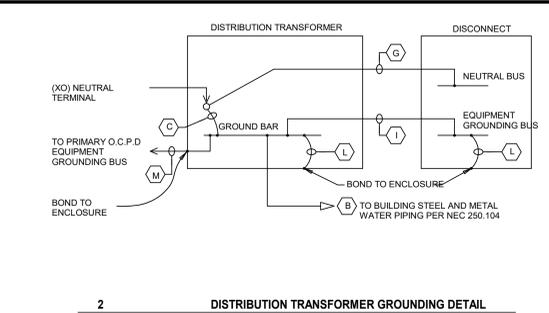


**3 DISTRIBUTION TRANSFORMER GROUNDING DETAIL**  
NO SCALE

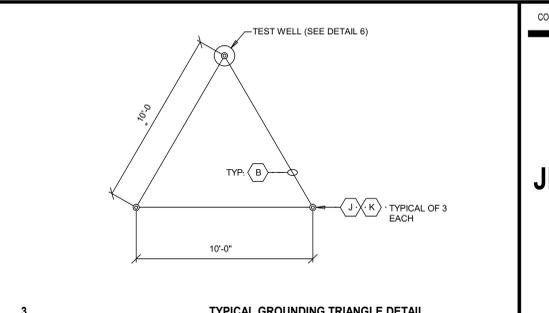


**4 TYPICAL GROUNDING TRIANGLE DETAIL**  
NO SCALE

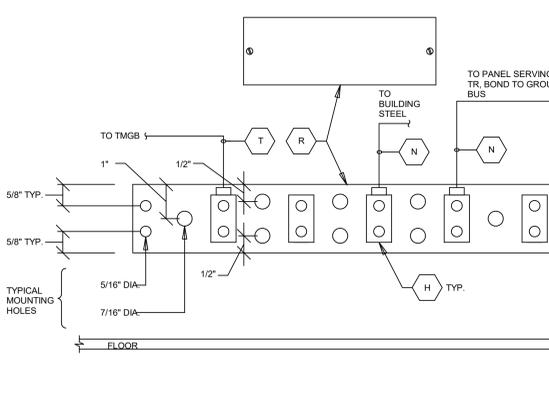


**5 TYPICAL TR TELECOMMUNICATIONS GROUNDING BUSBAR (TGB) DETAIL**  
NO SCALE

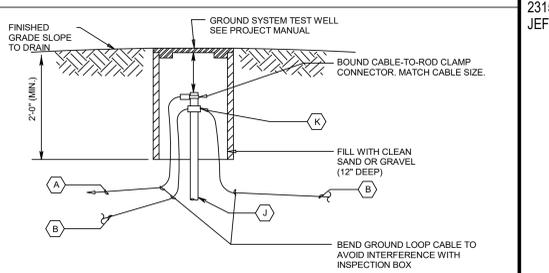


**6 GROUND TEST WELL DETAIL**  
NO SCALE

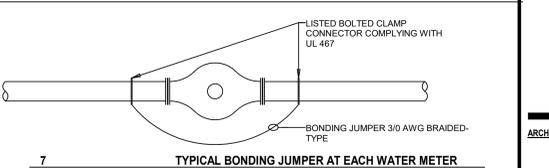


**7 TYPICAL BONDING JUMPER AT EACH WATER METER**  
NO SCALE

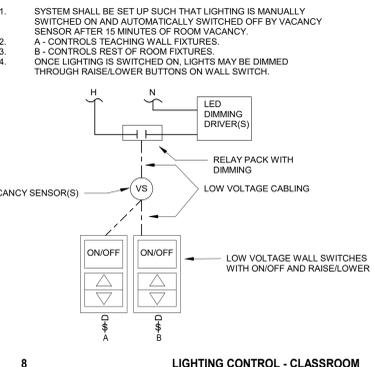


**8 LIGHTING CONTROL - CLASSROOM**  
NO SCALE

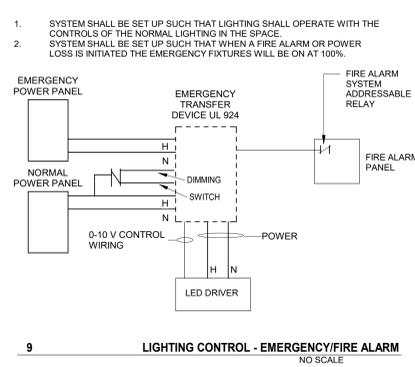


**9 LIGHTING CONTROL - EMERGENCY/FIRE ALARM**  
NO SCALE

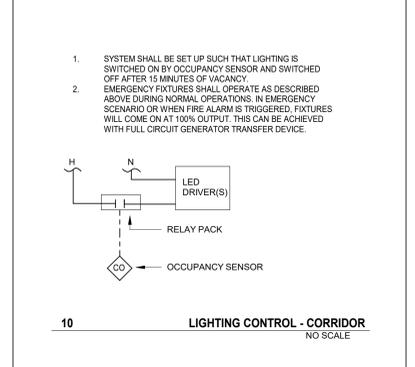

**10 LIGHTING CONTROL - CORRIDOR**  
NO SCALE

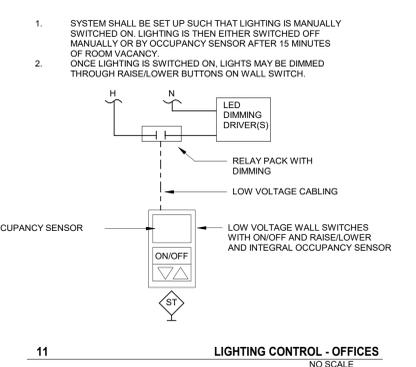

**11 LIGHTING CONTROL - OFFICES**  
NO SCALE

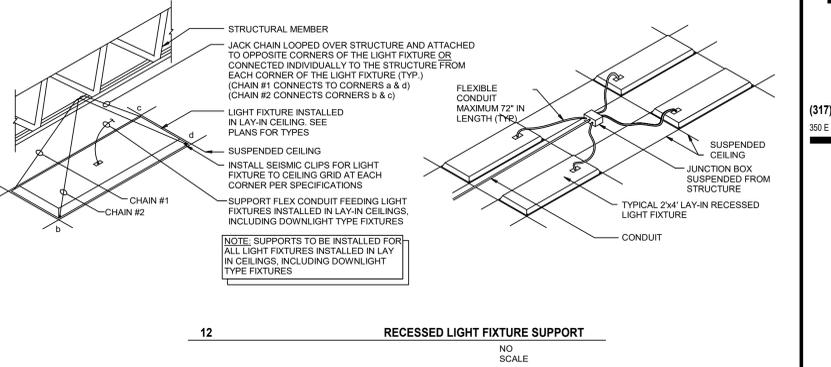

**12 RECESSED LIGHT FIXTURE SUPPORT**  
NO SCALE

**LUMINAIRE SCHEDULE - GENERAL NOTES:**

- 1. SEE SPECIFICATIONS FOR DRIVER REQUIREMENTS.
- 2. FOR ALL DOWNLIGHTING FIXTURES, PROVIDE REQUIRED MOUNTING HARDWARE FOR MOUNTING IN LAY-IN TYPE CEILING.
- 3. CONTRACTOR TO VERIFY TYPES AND QUANTITY OF LIGHT FIXTURES REQUIRING EMERGENCY TRANSFER DEVICES AND PROVIDE REQUIRED QUANTITY OF EMERGENCY TRANSFER DEVICES, LABOR, MATERIAL, ETC. IN THE PROJECT BID FOR FIELD INSTALLATION OF EMERGENCY TRANSFER DEVICES.
- 4. LIGHT FIXTURE SUBMITTALS TO INCLUDE DATA SHEETS FOR ALL FIXTURE TYPES, INCLUDING ADDITIONAL DATA SHEETS FOR DRIVER REQUIREMENTS. SUBMITTALS SHALL ALSO INDICATE COLOR FOR ANY CUSTOM COLOR LIGHT FIXTURES.

LUMINAIRE SCHEDULE						
PLAN TYPE	MANUFACTURER/CATALOG	MOUNTING	LAMPS	APPLIED VOLTAGE	DESCRIPTION	VA LOAD
LD61	HALO HC6 SERIES LITHONIA L0NS SERIES PRESCOLITE LFBLED SERIES H.E. WILLIAMS 6CR SERIES	RECESSED	LED 1500 lm	277 V	6-INCH ROUND APERTURE OPEN REFLECTOR LED DOWNLIGHT, MEDIUM DISTRIBUTION, WHITE SPECULAR FINISH, WHITE FLANGE, SELF-FLANGED, 0-10VDC DIMMING, 4000K, BAR HANGER ACCESSORY.	22 VA
LD61X	HALO HC6 SERIES LITHONIA L0NS SERIES PRESCOLITE LFBLED SERIES H.E. WILLIAMS 6CR SERIES	RECESSED	LED 1500 lm	277 V	6-INCH ROUND APERTURE OPEN REFLECTOR LED DOWNLIGHT, MEDIUM DISTRIBUTION, WHITE SPECULAR FINISH, WHITE FLANGE, SELF-FLANGED, 0-10VDC DIMMING, 4000K, BAR HANGER ACCESSORY. PROVIDE WITH EMERGENCY TRANSFER DEVICE COMPATIBLE WITH CENTRAL BATTERY INVERTER.	22 VA
LD81	HALO HC6 SERIES LITHONIA L0NS SERIES PRESCOLITE LFBLED SERIES H.E. WILLIAMS 6CR SERIES	RECESSED	LED 6000 lm	277 V	8-INCH ROUND APERTURE OPEN REFLECTOR LED DOWNLIGHT, MEDIUM DISTRIBUTION, WHITE SPECULAR FINISH, WHITE FLANGE, SELF-FLANGED, 0-10VDC DIMMING, 4000K, BAR HANGER ACCESSORY.	50 VA
LD81X	HALO HC6 SERIES LITHONIA L0NS SERIES PRESCOLITE LFBLED SERIES H.E. WILLIAMS 6CR SERIES	RECESSED	LED 6000 lm	277 V	8-INCH ROUND APERTURE OPEN REFLECTOR LED DOWNLIGHT, MEDIUM DISTRIBUTION, WHITE SPECULAR FINISH, WHITE FLANGE, SELF-FLANGED, 0-10VDC DIMMING, 4000K, BAR HANGER ACCESSORY. PROVIDE WITH EMERGENCY TRANSFER DEVICE COMPATIBLE WITH CENTRAL BATTERY INVERTER.	50 VA
LDW61	LITHONIA L0NS SERIES PRESCOLITE LFBLED SH SERIES H.E. WILLIAMS 6DR SERIES PORTFOLIO LDB8 SERIES	RECESSED	LED 1000 lm	277 V	6-INCH ROUND APERTURE LED SHOWER LIGHT WITH REGRESSED LENS REFLECTOR, WHITE REFLECTOR AND TRIM, SELF-FLANGED, IP65 WET LOCATION LISTED.	8 VA
LDW61X	LITHONIA L0NS SERIES PRESCOLITE LFBLED SH SERIES H.E. WILLIAMS 6DR SERIES PORTFOLIO LDB8 SERIES	RECESSED	LED 1000 lm	277 V	6-INCH ROUND APERTURE LED SHOWER LIGHT WITH REGRESSED LENS REFLECTOR, WHITE REFLECTOR AND TRIM, SELF-FLANGED, IP65 WET LOCATION LISTED.	8 VA
LE1X	LITHONIA CPX SERIES EVENLITE WEATHERWAY SERIES COMPASS CUV SERIES BIG BEAM EXCELITE SERIES	SURFACE WALL	LED 1000 lm	277 V	OUTDOOR EMERGENCY LIGHT FIXTURE, DIE-CAST ALUMINUM HOUSING, SELF-DIAGNOSTICS, WIRED NORMALLY OFF, EMERGENCY TRANSFER DEVICE COMPATIBLE WITH CENTRAL BATTERY INVERTER, WET LOCATION, 3200K, DARK BRONZE. MOUNT AT 8'-0" A.F.G. UNLESS NOTED OTHERWISE	11 VA
LE2	LITHONIA DSXW2 SERIES GARDCO PWS SERIES MCGRAW-EDISON GWC SERIES BEACON GEOPAK 2 SERIES CREE EDGE SERIES	SURFACE WALL	LED 10890 lm	277 V	WALL MOUNTED LED LUMINAIRE WITH DIE CAST ALUMINUM HOUSING, BOTTOM DIFFUSER FLUSH WITH THE DIE CASTING, TYPE 2 DISTRIBUTION, 4000K, 70 CRI LEDS, BLACK FINISH. MOUNT ONTO JUNCTION BOX. PROVIDE WITH INTEGRAL PHOTOCELL AND OCCUPANCY SENSOR. FIXTURES TO BE ON/OFF TO 50% BY PHOTOCELL AND INCREASED TO 100% WHEN FIXTURE IS ON. VANDAL RESISTANT.	110 VA
LE3	LITHONIA DSXW2 SERIES GARDCO PWS SERIES MCGRAW-EDISON GWC SERIES BEACON GEOPAK 2 SERIES CREE EDGE SERIES	SURFACE WALL	LED 6200 lm	277 V	WALL MOUNTED LED LUMINAIRE WITH DIE CAST ALUMINUM HOUSING, BOTTOM DIFFUSER FLUSH WITH THE DIE CASTING, TYPE 2 DISTRIBUTION, 4000K, 70 CRI LEDS, BLACK FINISH. MOUNT ONTO JUNCTION BOX. PROVIDE WITH INTEGRAL PHOTOCELL AND OCCUPANCY SENSOR. FIXTURES TO BE ON/OFF TO 50% BY PHOTOCELL AND INCREASED TO 100% WHEN FIXTURE IS ON. VANDAL RESISTANT.	54 VA
LF1	LITHONIA CPX SERIES EATON METALUX CGT SERIES COLUMBIA CFP SERIES ABOVE ALL SBFLP SERIES	RECESSED	LED 3000 lm	277 V	1 BY 4-FOOT, BACK LIT FLAT PANEL WITH ALUMINUM FRAME, 4000K, 80+ CRI, 0-10V DIMMING.	27 VA
LF1X	LITHONIA CPX SERIES EATON METALUX CGT SERIES COLUMBIA CFP SERIES ABOVE ALL SBFLP SERIES	RECESSED	LED 3000 lm	277 V	1 BY 4-FOOT, BACK LIT FLAT PANEL WITH ALUMINUM FRAME, 4000K, 80+ CRI, 0-10V DIMMING. PROVIDE WITH TRANSFER DEVICE COMPATIBLE WITH CENTRAL BATTERY INVERTER.	27 VA
LF2	LITHONIA CPX SERIES EATON METALUX CGT SERIES COLUMBIA CFP SERIES ABOVE ALL SBFLP SERIES	RECESSED	LED 4000 lm	277 V	2 BY 4-FOOT, BACK LIT FLAT PANEL WITH ALUMINUM FRAME, 4000K, 80+ CRI, 0-10V DIMMING.	36 VA
LF2X	LITHONIA CPX SERIES EATON METALUX CGT SERIES COLUMBIA CFP SERIES ABOVE ALL SBFLP SERIES	RECESSED	LED 4000 lm	277 V	2 BY 4-FOOT, BACK LIT FLAT PANEL WITH ALUMINUM FRAME, 4000K, 80+ CRI, 0-10V DIMMING. PROVIDE WITH TRANSFER DEVICE COMPATIBLE WITH CENTRAL BATTERY INVERTER.	36 VA
LN4	LUMENWERX VIA 4 SERIES MARK ARCHITECTURAL SLOT 4 SERIES LITECONTROL MOD 4 LED SERIES	SUSPENDED	LED 3900 lm	277 V	LENGTH AS INDICATED BY 4" SLOT TYPE INDIRECT/DIRECT PENDANT HUNG FIXTURE. ONE PERCENT DIMMING, HIGH LUMEN OUTPUT, SQUARE CANOPY, AIR CRAFT CABLE SUSPENSION AND WHITE POWER CORD. MOUNT AT 8'-6" ABOVE FINISH FLOOR UNLESS NOTED OTHERWISE.	36 VA
LN4X	LUMENWERX VIA 4 SERIES MARK ARCHITECTURAL SLOT 4 SERIES LITECONTROL MOD 4 LED SERIES	SUSPENDED	LED 3900 lm	277 V	LENGTH AS INDICATED BY 4" SLOT TYPE INDIRECT/DIRECT PENDANT HUNG FIXTURE. ONE PERCENT DIMMING, HIGH LUMEN OUTPUT, SQUARE CANOPY, AIR CRAFT CABLE SUSPENSION AND WHITE POWER CORD. MOUNT AT 8'-6" ABOVE FINISH FLOOR UNLESS NOTED OTHERWISE. PROVIDE WITH EMERGENCY TRANSFER DEVICE COMPATIBLE WITH CENTRAL BATTERY INVERTER.	36 VA

LUMINAIRE SCHEDULE						
PLAN TYPE	MANUFACTURER/CATALOG	MOUNTING	LAMPS	APPLIED VOLTAGE	DESCRIPTION	VA LOAD
LR4	METALUX WLED SERIES LITHONIA SBL SERIES COLUMBIA LAW SERIES H.E. WILLIAMS 1T SERIES	SUSPENDED	LED 6000 lm	277 V	4-FOOT WRAP LED AROUND FIXTURE, ACRYLIC PRISMATIC DIFFUSER, 0-10VDC DIMMING. IF SUSPENDED, INSTALL AT 8-FOOT AFF WITH CONDUIT STEMS (UNO).	55 VA
LR4X	METALUX WLED SERIES LITHONIA SBL SERIES COLUMBIA LAW SERIES H.E. WILLIAMS 1T SERIES	SUSPENDED	LED 6000 lm	277 V	4-FOOT WRAP LED AROUND FIXTURE, ACRYLIC PRISMATIC DIFFUSER, 0-10VDC DIMMING, WITH EMERGENCY TRANSFER DEVICE COMPATIBLE WITH CENTRAL BATTERY INVERTER. IF SUSPENDED, INSTALL AT 8-FOOT AFF WITH CONDUIT STEMS (UNO).	55 VA
LT8	SPI LIGHTTRUSS LED SERIES REFER TO FIXTURE TYPE LTB FOR ALLOWANCE FOR MATERIAL ONLY. ADD LABOR REQUIRED FOR INSTALLATION. CONTACT BRUCE FELDMAN WITH SPECIFIED LIGHTING (317)-313-7441 WITH ANY QUESTIONS.	TRUSS	LED 109807 lm	277 V	LIGHTTRUSS GEN 2 LED 33.5° FIXTURE HEAD, 33.5° TRUSS SYSTEM, 7' LONG TRUSS SECTIONS, 4000K, 0-10V DIMMING, INSTALL WITH AN 8 DEGREE TILT.	866 VA
LT8X	SPI LIGHTTRUSS LED SERIES REFER TO FIXTURE TYPE LTB FOR ALLOWANCE TOTAL FOR MATERIAL ONLY. ADD LABOR REQUIRED FOR INSTALLATION. CONTACT BRUCE FELDMAN WITH SPECIFIED LIGHTING (317)-313-7441 WITH ANY QUESTIONS.	TRUSS	LED 109807 lm	277 V	LIGHTTRUSS GEN 2 LED 33.5° FIXTURE HEAD, 33.5° TRUSS SYSTEM, 7' LONG TRUSS SECTIONS, 4000K, 0-10V DIMMING, INSTALL WITH AN 8 DEGREE TILT. PROVIDE WITH EMERGENCY TRANSFER DEVICE COMPATIBLE WITH CENTRAL BATTERY INVERTER.	866 VA
LWB52X	METALUX SWLED SERIES LITHONIA WLA SERIES LITHONIA WLS SERIES COLUMBIA MPS SERIES H.E. WILLIAMS SLF SERIES	SURFACE WALL	LED 3800 lm	277 V	4-FOOT WALL BRACKET TYPE LED STAIRWELL FIXTURE, FROSTED ACRYLIC LENS, INTEGRAL OCCUPANCY SENSOR, 4000K, 80+ CRI, BLACK FINISH. PROVIDE WITH DRIVER AS REQUIRED FOR AUTOMATIC DIMMING TO 50% OUTPUT DURING UNOCCUPIED TIMES. PROVIDE WITH EMERGENCY BATTERY INVERTER.	32 VA
LWB52XA	METALUX SWLED SERIES LITHONIA WLA SERIES LITHONIA WLS SERIES COLUMBIA MPS SERIES H.E. WILLIAMS SLF SERIES	SURFACE WALL	LED 3800 lm	120 V	4-FOOT WALL BRACKET TYPE LED STAIRWELL FIXTURE, FROSTED ACRYLIC LENS, INTEGRAL OCCUPANCY SENSOR, 4000K, 80+ CRI, BLACK FINISH. PROVIDE WITH DRIVER AS REQUIRED FOR AUTOMATIC DIMMING TO 50% OUTPUT DURING UNOCCUPIED TIMES. PROVIDE WITH EMERGENCY BATTERY INVERTER.	32 VA
TL1	CONTEC TL1 SERIES KULS DESIGN STRIP LED	SURFACE	LED 248 lm	277 V	LED TAPE LIGHT, 12V POWER SUPPLY, CUTTABLE, 0-10V DIMMING. LUMENS AND WATTAGE ARE PER FOOT.	2 VA
XC	SURE-LITES CX SERIES BIG BEAM DCL SERIES LITHONIA SIGNATURE SERIES DUAL-LITE SEMBRA SERIES	SURFACE CEILING	RED 0 lm	277 V	CAST ALUMINUM AC ONLY EXIT SIGN, SINGLE FACE, DIRECTIONAL ARROWS INDICATED, WHITE HOUSING. REFER TO PROJECT MANUAL FOR ADDITIONAL REQUIREMENTS.	3 VA
XVC	SURE-LITES LUX SERIES CHLORIDE 60 LINE SERIES LITHONIA LV SERIES DUAL-LITE SEWJ SERIES	SURFACE CEILING	RED 0 lm	277 V	CAST ALUMINUM, VANDAL RESISTANT AC ONLY EXIT SIGN, SINGLE FACE, DIRECTIONAL ARROWS INDICATED, WHITE HOUSING, LISTED FOR WET LOCATIONS. REFER TO PROJECT MANUAL FOR ADDITIONAL REQUIREMENTS.	3 VA
XW	SURE-LITES LUX SERIES CHLORIDE 60 LINE SERIES LITHONIA LV SERIES DUAL-LITE SEWJ SERIES	SURFACE WALL	RED 0 lm	277 V	CAST ALUMINUM, VANDAL RESISTANT AC ONLY EXIT SIGN, SINGLE FACE, DIRECTIONAL ARROWS INDICATED, WHITE HOUSING, LISTED FOR WET LOCATIONS. REFER TO PROJECT MANUAL FOR ADDITIONAL REQUIREMENTS.	3 VA
XW	SURE-LITES CX SERIES BIG BEAM DCL SERIES LITHONIA SIGNATURE SERIES DUAL-LITE SEMBRA SERIES	SURFACE WALL	RED 0 lm	277 V	CAST ALUMINUM AC ONLY EXIT SIGN, SINGLE FACE, DIRECTIONAL ARROWS INDICATED, WHITE HOUSING. REFER TO PROJECT MANUAL FOR ADDITIONAL REQUIREMENTS.	3 VA

**JEFFERSONVILLE HIGH SCHOOL NATATORIUM**

2315 ALLISON LN.  
JEFFERSONVILLE, IN 47130

**GREATER CLARK COUNTY SCHOOLS**



ARCHITECT

**FANNING HOWE**

(317) 848-0966 WWW.FHAI.COM  
30 E NEW YORK ST, SUITE 300 INDIANAPOLIS, IN 46204

ISSUED FOR CONSTRUCTION



DRAWN BY: AMN  
PROJECT NUMBER: 222038.00  
PROJECT ISSUE DATE: 11/20/2023

REV. NO.	DESCRIPTION	DATE
1	ADDENDUM #2	12/21/2023

ELECTRICAL DETAILS

**E1.02**