

# ADDENDUM NO. 1

**July 7, 2026**

## **SCHOOL CITY OF HOBART VARSITY BASEBALL AND SOFTBALL TURF FIELDS PROJECT**

### **TO: ALL BIDDERS OF RECORD**

This Addendum forms a part of and modifies the Bidding Requirements, Contract Forms, Contract Conditions, the Specifications, and the Drawings dated June 29, 2026 by Gibraltar Design. Acknowledge receipt of the Addendum in the space provided on the Bid Form. Failure to do so may subject the Bidder to disqualification.

This Addendum consists of page ADD 1-1 and attached and attached Addendum No. 1 from Gibraltar Design dated July 7, 2026, consisting of 2 pages and 9 Drawings.

## ADDENDUM ONE

**Addendum One (AD.01)** to the drawings and specifications prepared by Gibraltar Design for **Hobart High School Baseball and Softball Field Replacement and Related Work** for School City of Hobart, Hobart, Indiana.

All Contractors bidding on this project shall read all of the items covered below and shall comply with all of the requirements as set forth, including any necessary refinements or additions generated by this Addendum and required by the intent of the original contract documents. All Contractors shall acknowledge on their bid form that they have received this Addendum and include the appropriate content of same within their bid proposal.

## SPECIFICATIONS

### 1. Specification Section 32 18 12                      **Synthetic Turf System**

A. Add additional criteria to Paragraph 2.2.B. as follows:

| <u>Standard</u> | <u>Property</u>                                                                                       | <u>Specification</u>   |
|-----------------|---|------------------------|
| ASTM D418/D5848 | Pile Weight<br>(Baseball/Softball –<br>Red Clay Areas –<br>Pitchers Mounds and<br>Batters Halo/Box's) | Minimum 80 oz./sq. yd. |

B. Revise Criteria in Paragraph 2.2.B. where 'Brown Areas' is called out, change to 'Clay Red Areas'.

### 2. Specification Section 32 31 13                      **Chain Link Fences and Gates**

A. Delete Paragraph 1.1.C. in its entirety.

B. Delete Paragraph 2.4.B.1. in its entirety.

C. Add Paragraph 1.5.B.2. for clarification on Delegated Design Criteria, as follows:

“2. Minimum Standard for Fence posts are included in Post Size Tables.

Seismic Zone: 1

Wind Speed: 110 Vmph

Height: Refer to Drawings.

Exposure: C

Additional Factors: Ice, Windscreens, Soils Capacities, included in Geotech Report included in Project Manual.”



## DRAWINGS

**3. Sheet C-101**

A. Refer to full-size drawing for revisions.

**4. Sheet C-102**

A. Refer to full-size drawing for revisions.

**5. Sheet C-201**

A. Additional Plan Note #29

B. Revision to Softball Pitcher's Circle

**6. Sheet C-202**

A. Revision to Plan Note #6

**7. Sheet C-301**

A. Refer to full-size drawing for revisions.

**8. Sheet C-302**

A. Refer to full-size drawing for revisions.

**9. Sheet C-400**

A. Refer to full-size drawing for revisions.

**10. Sheet C-402**

A. Refer to full-size drawing for revisions.

**11. Sheet ES102**

A. Modifications to light pole locations for Varsity Baseball.

Pages 1 through 2, inclusive, and Nine (9) Full-Size Drawings, constitute the total makeup of **Addendum One**.

**GIBRALTAR**

DESIGN

Y:\26-122 SC Hobart - Hobart HS BB and SB FIELD REPLACEMENT\SPCS\AD01\AD01.DOCX






FOR:  
SCHOOL CITY OF HOBART  
32 E. 7TH STREET, HOBART, IN  
46342

- A. SITE SURVEY INFORMATION IS PROVIDED BY TORRENZA SURVEYING, LLC. CONTRACTOR IS TO VERIFY ALL ELEVATIONS AND NOTIFY CONSTRUCTION MANAGER AND ARCHITECT OF ANY DISCREPANCIES.
- B. UNDERGROUND UTILITIES ARE SHOWN IN APPROXIMATE LOCATIONS BASED ON INFORMATION AT THE TIME OF SURVEY, AND SOME UTILITIES ARE NOT SHOWN. THE RESPONSIBILITY OF THE CONTRACTOR IS TO RECONSTRUCT AND VERIFY DETERMINING EXACT LOCATIONS OF ALL EXISTING UNDERGROUND UTILITIES TO REMAIN AND REPAIRING OR REPLACING ANY DAMAGE DUE TO CONSTRUCTION ACTIVITY. CONTRACTOR IS TO NOTIFY CM AND ARCHITECT OF ANY DISCREPANCIES.
- C. THE LOCATION OF THE IRRIGATION SPRINKLER SYSTEM AND SUB SURFACE (UNDERDRAIN) SEWER SYSTEM IS DEPICTED AS SHOWN ON THE 01/26/2006 DRAWING SET FOR THE HOBART HIGH SCHOOL PREPARED BY GIBRALTAR DESIGN. THE LOCATIONS SHOWN WERE PROPOSED AND ARE NOT AS-BUILT. THE LOCATIONS ARE APPROXIMATE AND SHOULD BE FIELD VERIFIED BY THE CONTRACTOR.
- D. CONTRACTOR IS RESPONSIBLE FOR COSTS ASSOCIATED WITH DISCONNECTING, REMOVING, OR RELOCATING/RECONNECTING EXISTING UTILITIES ALONG WITH RELOCATING NEW UTILITIES TO THE PROPOSED CONSTRUCTION. VALVES, MANHOLES, HAND-HOLES, UTILITY BOXES, AND SIMILAR STRUCTURES NOT DESIGNATED FOR REMOVAL, SHALL BE PROTECTED AND ADJUSTED TO NEW FINISH ELEVATIONS BY CONTRACTOR.
- F. CONTRACTOR IS RESPONSIBLE FOR VERIFYING, VERTICALLY AND HORIZONTALLY, BETWEEN EXISTING AND NEW CONSTRUCTION, AND UTILITY CONSTRUCTION MANAGER/ARCHITECT IF ANY DISCREPANCIES.

|      |    |   |
|------|----|---|
| AD-1 | 11 | REMOVE EXISTING CONCRETE – INTENT IS ALONG CONTROL JOINTS                                                            |
|      | 12 | REMOVE EXISTING CHAIN LINK FENCE & GATE – COMPLETE                                                                   |
|      | 13 | REMOVE EXISTING BACKSTOP FENCING – COMPLETE                                                                          |
|      | 14 | REMOVE EXISTING FOOT BALL POLE COMPLETE                                                                              |
|      | 5  | REMOVE GRAVEL AREA                                                                                                   |
| AD-1 | 6  | REMOVE UNDERDRAINAGE – CAP WHERE LEAVES FIELD/PATCH BASE AT REMOVED CONNECTION                                       |
|      | 7  | REMOVE APPROXIMATE LOCATION OF IRRIGATION SYSTEM WITHIN THE BALLFIELD – CAP LINES LEAVING FIELD-MARK ON DRAWING      |
|      | 8  | REMOVE BALLFIELD AS REQUIRED FOR NEW FIELD                                                                           |
|      | 9  | REMOVE PRACTICE/DIRT AREA                                                                                            |
|      | 10 | REMOVE AND REPAIR EXISTING FENCE IN KIND                                                                             |
|      | 11 | REMOVE EXISTING STORM SEWER PIPE – VERIFY LENGTH                                                                     |
| AD-1 | 12 | REMOVE SCOREBOARD & RELOCATE                                                                                         |
|      | 13 | REMOVE FLAGPOLE AND STORE FOR REINSTALLATION                                                                         |
|      | 14 | REMOVE EXISTING FENCING TO EXTENT NECESSARY FOR NEW FENCE INSTALLATION – CONNECT BACK INTO NEW FENCING ONCE COMPLETE |
|      | 15 | CONTRACTOR IS TO REMOVE GOOD CLAY FROM SOFTBALL/BASEBALL FIELD AND USE FOR DIRT BED UNDER NEW FIELD                  |

- 1) THE CONTRACTOR IS TO REMOVE THE EXISTING SUB SURFACE DRAINAGE SYSTEM IN ITS ENTIRETY AND PREPARE AS REQUIRED FOR NEW ARTIFICIAL TURF SYSTEM (SEE GENERAL DEMOLITION NOTES REGARDING SUB SURFACE DRAINAGE SYSTEM LOCATIONS SHOWN ON THE PLAN SET).
- 2) THE CONTRACTOR IS TO REMOVE THE EXISTING IRRIGATION SYSTEM IN ITS ENTIRETY AND PREPARE AS REQUIRED FOR NEW ARTIFICIAL TURF SYSTEM (SEE GENERAL DEMOLITION NOTES REGARDING IRRIGATION LOCATIONS SHOWN ON THE PLAN SET).
- 3) THE CONTRACTOR IS TO REMOVE THE EXISTING CHAIN LINK FENCE IN ITS ENTIRETY, WHERE EXISTING FENCE IS IN CONCRETE SIDEWALK, PATCH AND REPAIR CONCRETE SIDEWALK TO MAKE LIKE NEW.
- 4) THE CONTRACTOR IS TO REMOVE THE MINIMUM AMOUNT OF EXISTING CONCRETE IN ORDER TO INSTALL NEW CONCRETE CURB.

|  |                              |
|--|------------------------------|
|  | MANHOLE                      |
|  | SANITARY MANHOLE             |
|  | CATCH BASIN/INLET            |
|  | FOUL BALL POLE               |
|  | POWER POLE                   |
|  | LIGHT POLE                   |
|  | WATER VALVE                  |
|  | FIRE HYDRANT                 |
|  | GAS VALVE                    |
|  | PVC PIPING W/ SIZE (APPROX.) |
|  | SPRINKLER HEADS              |
|  | CONTROL VALVE                |
|  | GATE VALVE                   |
|  | WINTER BLOWOUT CONNECTION    |
|  | BACKFLOW PREVENTER           |
|  | GAS LINE                     |
|  | ELECTRIC LINE                |
|  | CHAIN LINK FENCE             |
|  | UNDERDRAIN PIPE SYSTEM       |
|  | EXISTING SANITARY SEWER      |
|  | EXISTING STORM SEWER         |
|  | EXISTING WATER MAIN          |
|  | CONTOUR                      |
|  | EXISTING SPOT ELEVATION      |

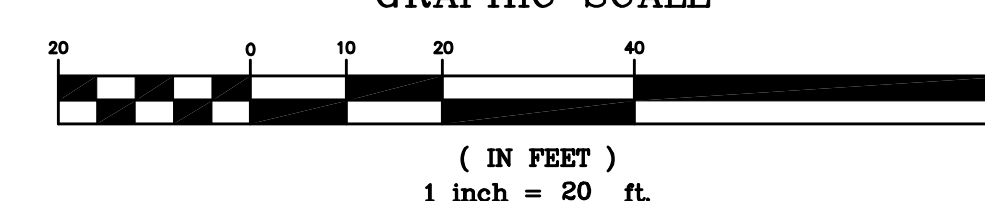

PROJECT  
26-122  
DATE  
06/29/26  
COORDINATED BY  
DCT  
DRAWN BY  
DCT EM  
CHECKED BY  
DCT

  
*Donald C. Torrendo*

THIS DOCUMENT ARE THE PROPERTY OF GIBRALTAR DESIGN  
WERE CREATED FOR USE ON THIS SPECIFIC PROJECT. NONE  
THIS INFORMATION SHALL BE USED BY ANY PERSON OR FIRM  
FOR ANY PURPOSE WITHOUT THE EXPRESS WRITTEN CONSENT  
OF GIBRALTAR DESIGN. THE OWNER MAY RETAIN COPIES FOR  
INFORMATION AND REFERENCE IN CONNECTION ONLY WITH THIS  
PROJECT.

| REVISIONS |          |                |
|-----------|----------|----------------|
| MARK      | DATE     | ISSUED FOR     |
| AD-1      | 07/07/26 | ADDENDUM NO. 1 |


DRAWING  
CONDITION & DEMOLITION PLAN

PROJECT  
HOBART HS BASEBALL & SOFTBALL  
FIELD REPLACEMENT AND RELATED  
WORK

|                   |                       |
|-------------------|-----------------------|
| © GIBALTAR DESIGN | SHEET<br><b>C-101</b> |
|-------------------|-----------------------|

Z:\2026-5017 Hobart High School BB &amp; SB Fields\dwg\2026-5017.dwg 7/6/2026 12:04:32 PM CDT



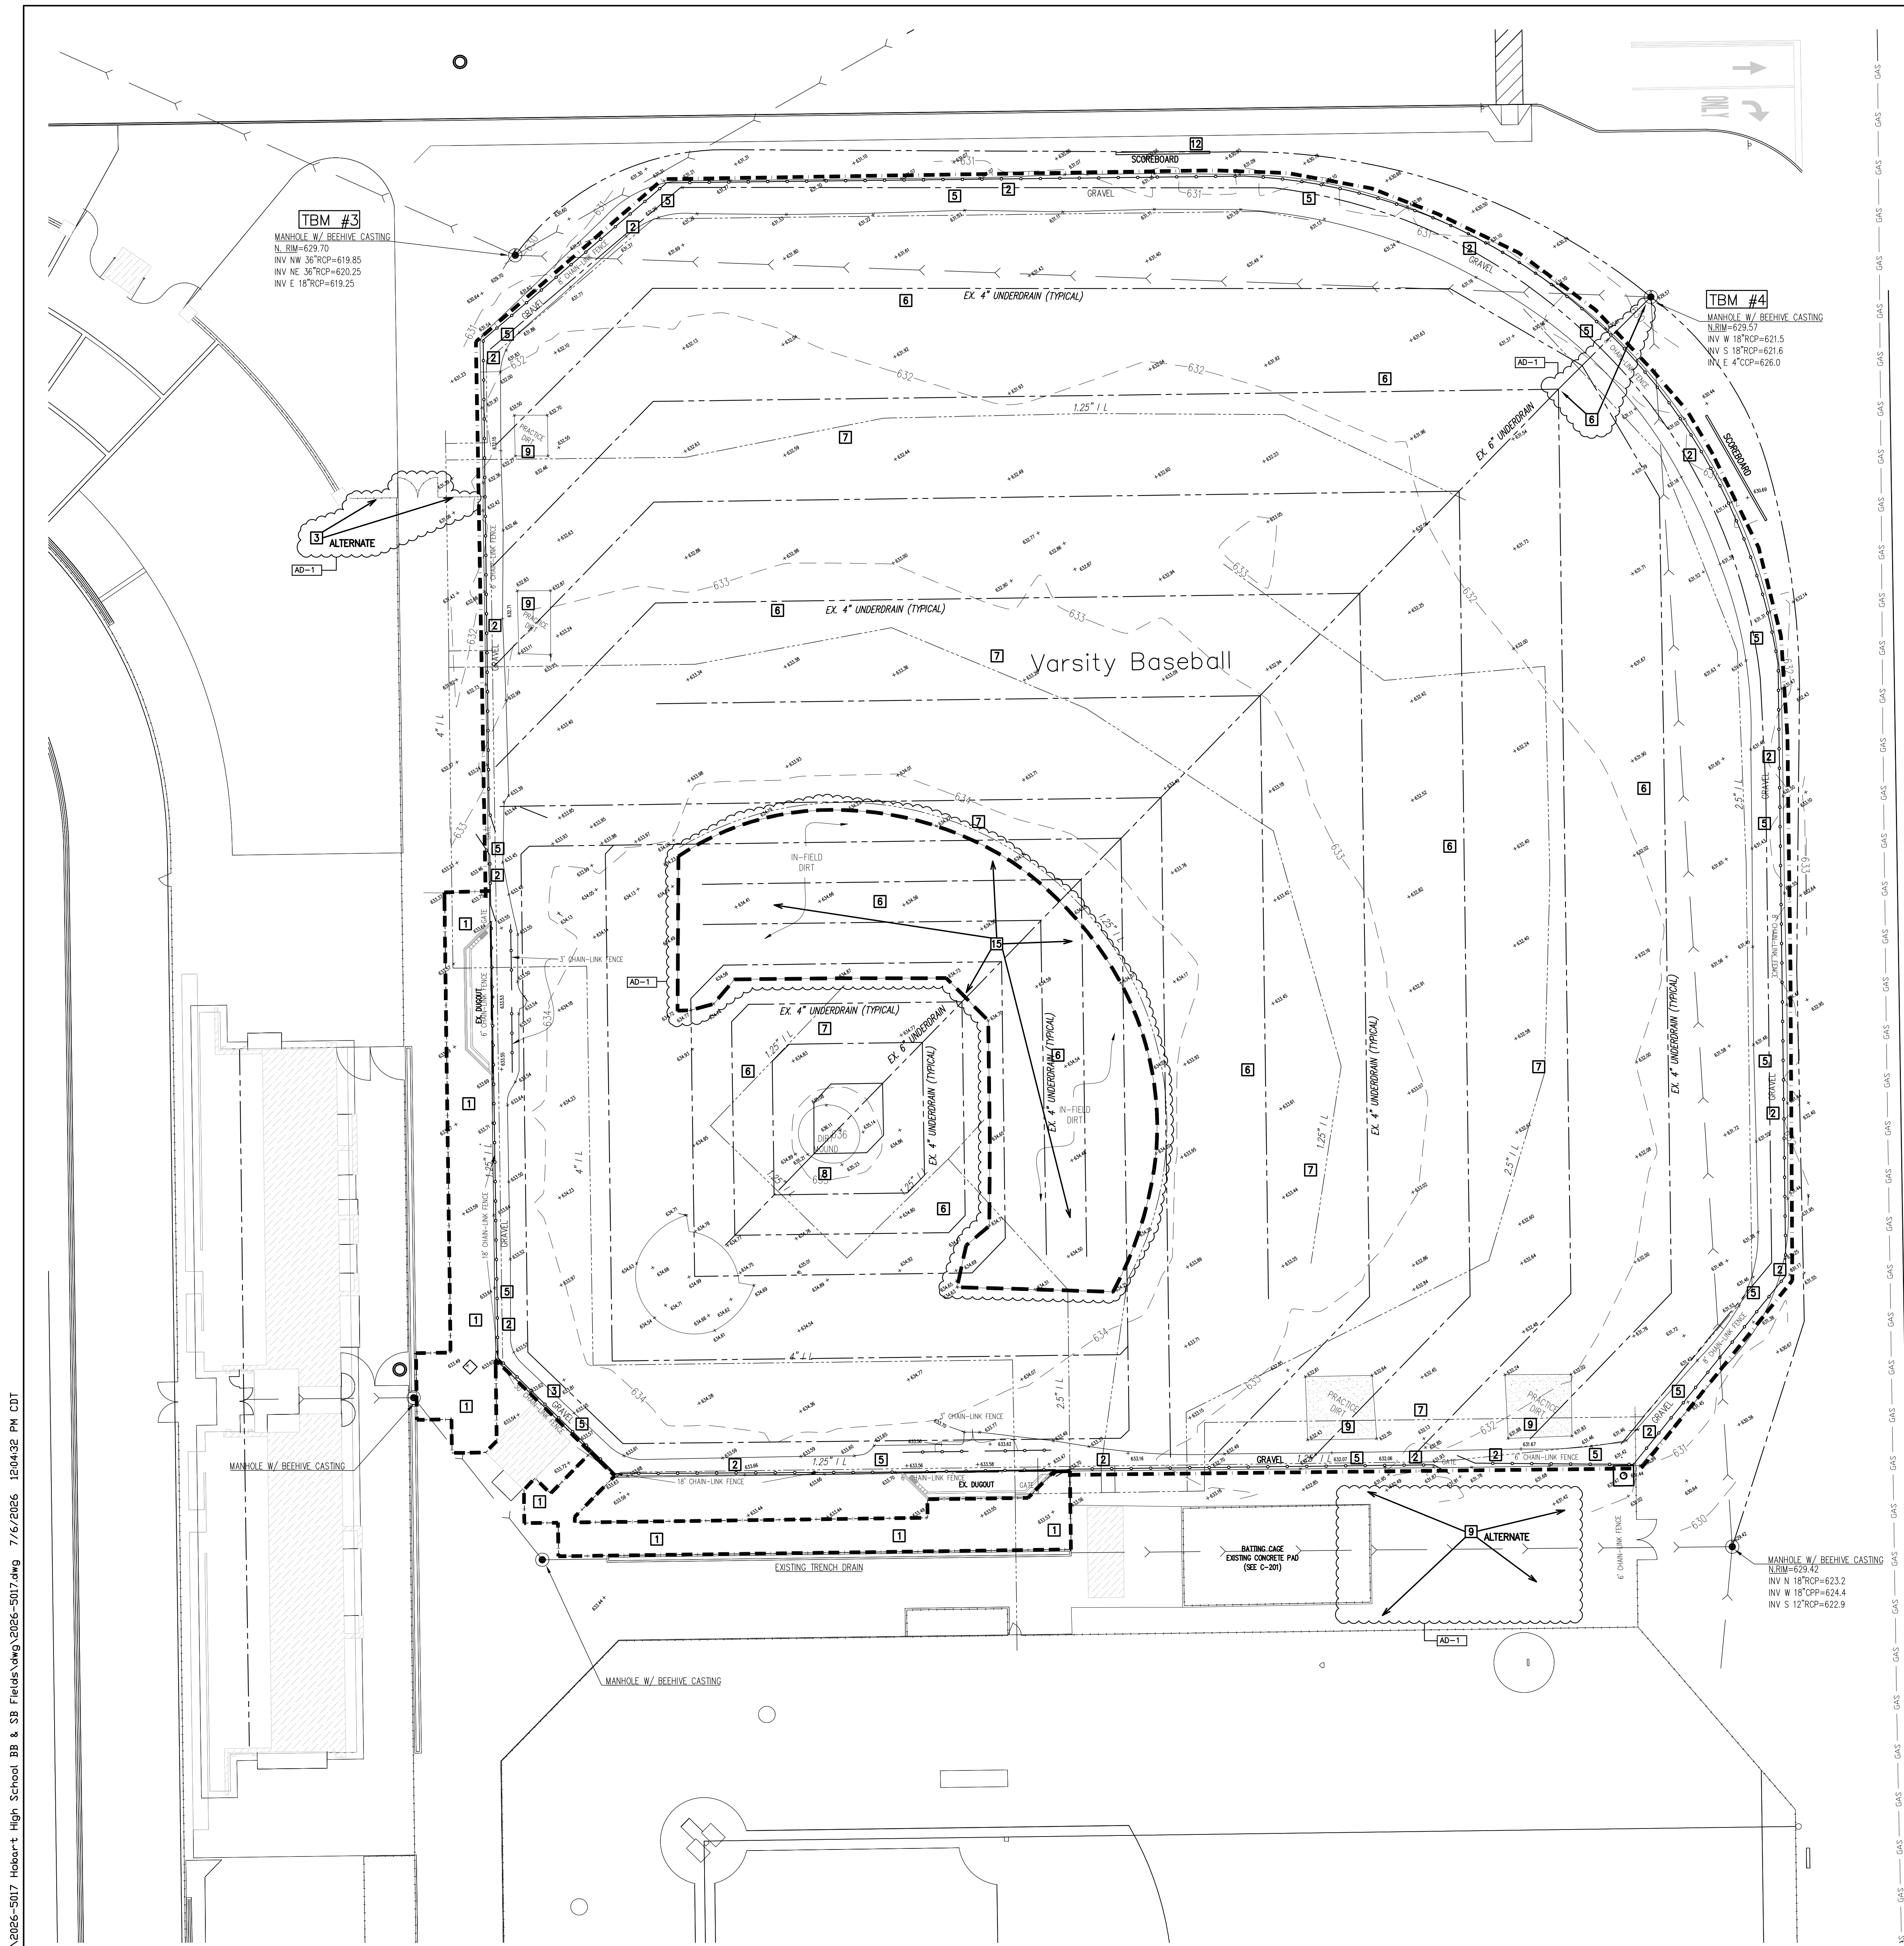



GENERAL DEMOLITION NOTES:

- A. SITE SURVEY INFORMATION IS PROVIDED BY TORRENGA ENGINEERING. CONTRACTOR IS TO VERIFY ALL ELEVATIONS AND NOTIFY CONSTRUCTION MANAGER AND ARCHITECT OF ANY DISCREPANCIES.
- B. UNDERGROUND UTILITIES ARE SHOWN IN APPROXIMATE LOCATIONS BASED ON INFORMATION AT THE TIME OF SURVEY. CONTRACTOR IS RESPONSIBLE FOR DETERMINING EXACT LOCATIONS OF ALL EXISTING UNDERGROUND UTILITIES TO REMAIN AND REPAIRING OR REPLACING ANY DAMAGE DUE TO CONSTRUCTION ACTIVITY. CONTRACTOR IS TO NOTIFY CM AND ARCHITECT OF ANY DISCREPANCIES.
- C. CONTRACTOR IS TO MATCH UP TO ALL EXISTING CONCRETE SLABS, DUG-OUT WALLS/SLABS, ETC. TO THE GREATEST DEGREE POSSIBLE WHILE MAINTAINING TRUE ALIGNMENT OF THE PERIMETER LAYOUT OF FENCING.
- D. CONTRACTOR IS REQUIRED TO MATCH EXISTING GRADES TO THE GREATEST DEGREE POSSIBLE - REFER TO GRADING PLANS.
- E. CONTRACTOR IS RESPONSIBLE FOR COSTS ASSOCIATED WITH DISCONNECTING, REMOVING, OR RELOCATING/RECONNECTING EXISTING UTILITIES ALONG WITH CONNECTING NEW UTILITIES ASSOCIATED WITH CONSTRUCTION SCOPE.
- F. VALVES, MANHOLES, HAND-HOLES, UTILITY BOXES, AND SIMILAR STRUCTURES NOT DESIGNATED FOR REMOVAL, SHALL BE PROTECTED AND ADJUSTED TO NEW FINISH ELEVATIONS BY CONTRACTOR.
- G. CONTRACTOR IS TO VERIFY ALL DIMENSIONS, VERTICALLY AND HORIZONTALLY BETWEEN EXISTING AND NEW CONSTRUCTION, AND NOTIFY CONSTRUCTION MANAGER/ARCHITECT IF ANY DISCREPANCIES.
- H. CONTRACTOR IS TO PROVIDE TOTAL ARTIFICIAL TURF INSTALL COMPLETE, NEW TURF, NEW TURF DRAINAGE SYSTEM, NEW INFILL, NEW 2X4 PERIMETER TREATED WOOD BLOCKING, AND NEW LOGOS/TEXT AS INDICATED.
- I. CONTRACTOR IS TO COORDINATE AND PROVIDE FOR SUB-TURF ACCESS TO ANY EXISTING VALVES, HAND-HOLES, OR UTILITY BOXES AS REQUIRED.

LEGEND:

- INDICATES AREA OF NEW CONCRETE SLAB FOR NEW SLAB ON GRADE OR INFILL AT FENCING, NETTING POLE LOCATION, ELECTRICAL RUNS.
- INDICATES AREA OF NEW GRAVEL.

SITE LAYOUT NOTES


(ALL PLAN NOTES MAY NOT BE INDICATED ON THIS SHEET.)

- 1 PROVIDE NEW SYNTHETIC TURF AND SUB-BASE DRAINAGE SYSTEMS AS SPECIFIED. FULL PERIMETER CONCRETE CURB AND FENCING WITH 2X4 TREATED WOOD NAILER FOR TURF.
- 2 NEW SYNTHETIC TURF AND SUB-BASE DRAINAGE SYSTEM AS SPECIFIED INFELD AND WARNING TURF.
- 3 ARTIFICIAL TURF BULLPEN.
- 4 INLAID TURF LOGO. REFER TO SPECIFICATIONS.
- 5 EXISTING BATTING CAGE TO REMAIN, PROVIDE NEW CARPET ON EXISTING CONCRETE.
- 6 RAISED PITCHING MOUND - WITH CONCRETE SUB-BASE WITH FIBER REINFORCING IN LIEU OF STONE SUB-BASE. CONTOUR CONCRETE SUB-BASE SIMILAR TO STONE MOUND SLOPING AWAY FROM PITCHING RUBBER. PROVIDE INSERT FOR PITCHING RUBBER ANCHORAGE. SET CONTOURED CONCRETE, INTEGRATED INTO A 4" CONCRETE SLAB BELOW MOUND ON A MINIMUM OF 4" STONE DRAINAGE FILL.
- 7 NEW 4" OF #8 STONE IN THIS AREA.
- 8 NEW CONCRETE SLAB INFILL AND STONE BASE.
- 9 EXISTING FENCING TO REMAIN.
- 10 NEW 4'-0" TALL BLACK VINYL COATED FENCING SET IN CONCRETE.
- 11 NEW 6'-0" TALL BLACK VINYL COATED FENCING SET IN PERIMETER CONCRETE CURB.
- 12 RETAINING WALL NAILER CURB AT VARSITY SOFTBALL OUTFIELD WITH 6'-0" TALL BLACK VINYL FENCE. REFER TO GRADING PLAN.
- 13 VARSITY BASEBALL DUGOUT FENCING. 3'-6" TALL BLACK VINYL COATED.
- 14 VARSITY SOFTBALL DUGOUT FENCING. 3'-6" TALL BLACK VINYL COATED. PROVIDE OPENING ON BOTH ENDS OF EXISTING DUGOUT.
- 15 NEW 4'-0" BLACK VINYL COATED FENCING TIED INTO EXISTING.
- 16 NEW 6'-0" BLACK VINYL COATED FENCING TIED INTO EXISTING.
- 17 NEW 6'-0" HIGH BY 4'-0" WIDE BLACK VINYL COATED GATE TIED INTO DUGOUT CORNER.
- 18 NEW 6'-0" HIGH BY 12'-0" WIDE BLACK VINYL COATED DOUBLE GATE.
- 19 NEW 6'-0" HIGH BY 20'-0" WIDE SLIDING BLACK VINYL COATED GATE.
- 20 EXISTING DUGOUT. MASONRY WALL CONSTRUCTION WITH WOOD FRAMED ROOF TO REMAIN.
- 21 RELOCATE EXISTING SOFTBALL FLAG POLE TO THIS LOCATION. PROVIDE NEW FOUNDATION FOR EXISTING FLAGPOLE.
- 22 NEW FOUL POLE.
- 23 ATHLETIC LIGHTS, REFER TO ELECTRICAL.
- 24 EXISTING FLAGPOLE TO REMAIN
- 25 NEW 6'-0" TALL GALVANIZED FENCE TIED INTO EXISTING GALVANIZED FENCING
- 26 NEW 30'-0" BLACK NETTING BACKSTOP WITH SS CABLE SUPPORTS.
- 27 NEW 40'-0" TALL BLACK NETTING BACKSTOP WITH SS CABLE SUPPORTS.
- 28 APPROXIMATE LOCATION OF NEW NETTING POLE SUPPORT FOR BACKSTOP AND SAFETY NETTING SYSTEM OVER SPECTATOR SEATING AND CONCESSIONS. EXACT LOCATION OF NETTING POLES TO BE DETERMINED BY BACKSTOP NETTING DESIGNER AND ENGINEER. REFER TO SPECIFICATIONS TO RELEGATED DESIGN REQUIREMENTS.
- 29 CONCRETE SUB-BASE AT PITCHERS' CIRCLE - PROVIDE 4" FLAT SLAB OF CONCRETE WITH FIBER MESH REINFORCEMENT, AND MINIMUM OF 4" COMPACTED DRAINAGE STONE BELOW SLAB. SIZE OF SLAB IS TO COVER SIZE OF STANDARD PITCHING CIRCLE. INSTALL PITCHING RUBBER INTO MOUND, PROVIDE INSET FOR PITCHING RUBBER ANCHORAGE.

ALTERNATE - SITE LAYOUT NOTES

(ALL PLAN NOTES MAY NOT BE INDICATED ON THIS SHEET.)

- A SCOREBOARDS: REMOVE AND RELOCATE EXISTING VARSITY FIELD SCOREBOARDS TO JUNIOR VARSITY BALL FIELDS, PER SPECIFICATIONS. PROVIDE NEW SCOREBOARD FOR VARSITY FIELDS, PER SPECIFICATIONS. VARSITY BASEBALL: DEMO EXISTING BASEBALL SCOREBOARD, SUPPORTS, AND ELECTRICAL IN ITS ENTIRETY. NEW SCOREBOARD TO BE INSTALLED IN NEW LOCATION INDICATED ON LAYOUT PLAN. VARSITY SOFTBALL: DEMO EXISTING SUPPORTS IN THEIR ENTIRETY AND PROVIDE NEW SUPPORTS FOR NEW BOARD AT EXISTING LOCATION. JUNIOR VARSITY SOFTBALL AND BASEBALL: PROVIDE RELOCATED SCOREBOARDS ON TWO EXISTING SUPPORTS AND PROVIDE TWO NEW STRUCTURAL SUPPORTS FOR RELOCATED BOARDS, PER SPECIFICATIONS. CONTRACTOR IS TO PAINT ALL EXISTING STRUCTURAL STEEL THAT IS TO BE REUSED.
- B ELECTRIC POWER BOX SET IN SYNTHETIC TURF. REFER TO ELECTRICAL.
- C NEW MASONRY WALL FOR NETTING BACKSTOP
- D EMS ACCESS: PROVIDE NEW VEHICLE ACCESS RAMP ON EXISTING SIDEWALK. WIDEN EXISTING SIDEWALK BY 6'-0" WITH NEW CONCRETE WALK WITH TURN DOWN EDGE OF SLAB TO EXTENTS INDICATED DUE TO GRADE CHANGE. REFER TO GRADING PLAN. PROVIDE NEW 12'-0" DOUBLE BLACK VINYL COATED GATE IN NEW FENCE.
- E GRANDSTANDS: RELOCATE EXISTING FIXED ALUMINUM GRANDSTANDS FROM VARSITY BALL FIELDS TO JUNIOR VARSITY FIELDS. PROVIDE NEW GRANDSTANDS, ON EXISTING CONCRETE PAD, ELEVATED 4'-0" AT VARSITY SOFTBALL FIELD. PROVIDE NEW GRANDSTANDS, ON EXISTING CONCRETE PAD, AT VARSITY BASEBALL FIELD.
- F PROVIDE NEW CONCRETE SLAB IN LIEU OF GRAVEL IN THIS LOCATION BETWEEN VARSITY AND JUNIOR VARSITY FIELDS.

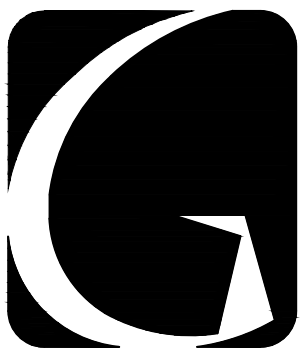

**GIBALTAR**  
DESIGN  
ARCHITECTURE • ENGINEERING • INTERIOR DESIGN

PROJECT  
**HOBBART HS  
BASEBALL AND  
SOFTBALL FIELD  
REPLACEMENT  
AND RELATED  
WORK**

FOR:  
SCHOOL CITY OF HOBBART  
32 E. 7TH STREET, HOBBART, IN  
46342

100% CONSTRUCTION  
DRAWINGS  
06/29/2026

**GIBALTAR DESIGN**  
4030 Vincennes Rd, Suite 100,  
Indianapolis, IN 46268  
Homepage [www.GibraltarDesign.com](http://www.GibraltarDesign.com)  
Email: [info@GibraltarDesign.com](mailto:info@GibraltarDesign.com)  
Phone: (317) 580-5777

PROJECT  
26-122  
DATE  
06/29/26  
COORDINATED BY  
JPB

DRAWN BY  
CND  
CHECKED BY  
JPB

COPYRIGHT NOTICE:  
THE CONCEPTS, DESIGNS, PLANS, DETAILS, ETC. SHOWN ON THIS DOCUMENT ARE THE PROPERTY OF GIBALTAR DESIGN AND WERE CREATED FOR USE ON THIS SPECIFIC PROJECT. NONE OF THIS INFORMATION SHALL BE USED BY ANY PERSON OR FIRM FOR ANY PURPOSE WITHOUT THE EXPRESS WRITTEN CONSENT OF GIBALTAR DESIGN. THE OWNER MAY RETAIN COPIES FOR INFORMATION AND REFERENCE IN CONNECTION ONLY WITH THIS PROJECT.

REVISIONS

| MARK  | DATE     | ISSUED FOR      |
|-------|----------|-----------------|
| AD.01 | 07/07/26 | ADDENDUM NO. 01 |

DRAWING  
**Varsity Softball Turf  
Layout Plan**

PROJECT  
**HOBBART HS BASEBALL & SOFTBALL  
FIELD REPLACEMENT AND RELATED  
WORK**

© GIBALTAR DESIGN


SHEET

**C-201**



**VARSITY SOFTBALL TURF LAYOUT PLAN**

0 10' 20' 40'  
SCALE: 1" = 20'

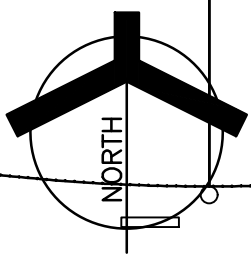



GENERAL DEMOLITION NOTES:

- A. SITE SURVEY INFORMATION IS PROVIDED BY TORRENGA ENGINEERING. CONTRACTOR IS TO VERIFY ALL ELEVATIONS AND NOTIFY CONSTRUCTION MANAGER AND ARCHITECT OF ANY DISCREPANCIES.
- B. UNDERGROUND UTILITIES ARE SHOWN IN APPROXIMATE LOCATIONS BASED ON INFORMATION AT THE TIME OF SURVEY. CONTRACTOR IS RESPONSIBLE FOR DETERMINING EXACT LOCATIONS OF ALL EXISTING UNDERGROUND UTILITIES TO REMAIN AND REPAIRING OR REPLACING ANY DAMAGE DUE TO CONSTRUCTION ACTIVITY. CONTRACTOR IS TO NOTIFY CM AND ARCHITECT OF ANY DISCREPANCIES.
- C. CONTRACTOR IS TO MATCH UP TO ALL EXISTING CONCRETE SLABS, DUG-OUT WALLS/SLABS, ETC. TO THE GREATEST DEGREE POSSIBLE WHILE MAINTAINING TRUE ALIGNMENT OF THE PERIMETER LAYOUT OF FENCING.
- D. CONTRACTOR IS REQUIRED TO MATCH EXISTING GRADES TO THE GREATEST DEGREE POSSIBLE - REFER TO GRADING PLANS.
- E. CONTRACTOR IS RESPONSIBLE FOR COSTS ASSOCIATED WITH DISCONNECTING, REMOVING, OR RELOCATING/RECONNECTING EXISTING UTILITIES ALONG WITH CONNECTING NEW UTILITIES ASSOCIATED WITH CONSTRUCTION SCOPE.
- F. VALVES, MANHOLES, HAND-HOLES, UTILITY BOXES, AND SIMILAR STRUCTURES NOT DESIGNATED FOR REMOVAL, SHALL BE PROTECTED AND ADJUSTED TO NEW FINISH ELEVATIONS BY CONTRACTOR.
- G. CONTRACTOR IS TO VERIFY ALL DIMENSIONS, VERTICALLY AND HORIZONTALLY BETWEEN EXISTING AND NEW CONSTRUCTION, AND NOTIFY CONSTRUCTION MANAGER/ARCHITECT IF ANY DISCREPANCIES.
- H. CONTRACTOR IS TO PROVIDE TOTAL ARTIFICIAL TURF INSTALL COMPLETE, NEW TURF, NEW TURF DRAINAGE SYSTEM, NEW INFILL, NEW 2X4 PERIMETER TREATED WOOD BLOCKING, AND NEW LOGOS/TEXT AS INDICATED.
- I. CONTRACTOR IS TO COORDINATE AND PROVIDE FOR SUB-TURF ACCESS TO ANY EXISTING VALVES, HAND-HOLES, OR UTILITY BOXES AS REQUIRED.

LEGEND:

- INDICATES AREA OF NEW CONCRETE SLAB FOR NEW SLAB ON GRADE OR INFILL AT FENCING, NETTING POLE LOCATION, ELECTRICAL RUNS.
- INDICATES AREA OF NEW GRAVEL.

SITE LAYOUT NOTES

(ALL PLAN NOTES MAY NOT BE INDICATED ON THIS SHEET.)

- 1 PROVIDE NEW SYNTHETIC TURF AND SUB-BASE DRAINAGE SYSTEMS AS SPECIFIED. FULL PERIMETER CONCRETE CURB AND FENCING WITH 2X4 TREATED WOOD NAILER FOR TURF.
- 2 NEW SYNTHETIC TURF AND SUB-BASE DRAINAGE SYSTEM AS SPECIFIED INFIELD AND WARNING TURF.
- 3 ARTIFICIAL TURF BULLETP.
- 4 INLAID TURF LOGO. REFER TO SPECIFICATIONS.
- 5 EXISTING BATTING CAGE TO REMAIN, PROVIDE NEW CARPET ON EXISTING CONCRETE.
- 6 RAISED PITCHING MOUND - WITH CONCRETE SUB-BASE WITH FIBER REINFORCING IN LIEU OF STONE MOUND COMPLETE. CONTOUR CONCRETE SUB-BASE SIMILAR TO STONE MOUND SLOPING AWAY FROM PITCHING RUBBER. PROVIDE INSERT FOR PITCHING RUBBER ANCHORAGE. SET CONTOURED CONCRETE INTEGRATED INTO A 4" CONCRETE SLAB BELOW MOUND ON A MINIMUM OF 4" STONE DRAINAGE FILL.
- 7 NEW 4" OF #8 STONE IN THIS AREA.
- 8 NEW CONCRETE SLAB INFILL AND STONE BASE.
- 9 EXISTING FENCING TO REMAIN.
- 10 NEW 4'-0" TALL BLACK VINYL COATED FENCING SET IN CONCRETE.
- 11 NEW 6'-0" TALL BLACK VINYL COATED FENCING SET IN PERIMETER CONCRETE CURB.
- 12 RETAINING WALL NAILER CURB AT VARSITY SOFTBALL OUTFIELD WITH 6'-0" TALL BLACK VINYL FENCE. REFER TO GRADING PLAN.
- 13 VARSITY BASEBALL DUGOUT FENCING. 3'-6" TALL BLACK VINYL COATED.
- 14 VARSITY SOFTBALL DUGOUT FENCING. 3'-6" TALL BLACK VINYL COATED. PROVIDE OPENING ON BOTH ENDS OF EXISTING DUGOUT.
- 15 NEW 4'-0" BLACK VINYL COATED FENCING TIED INTO EXISTING.
- 16 NEW 6'-0" BLACK VINYL COATED FENCING TIED INTO EXISTING.
- 17 NEW 6'-0" HIGH BY 4'-0" WIDE BLACK VINYL COATED GATE TIED INTO DUGOUT CORNER.
- 18 NEW 6'-0" HIGH BY 12'-0" WIDE BLACK VINYL COATED DOUBLE GATE.
- 19 NEW 6'-0" HIGH BY 20'-0" WIDE SLIDING BLACK VINYL COATED GATE.
- 20 EXISTING DUGOUT. MASONRY WALL CONSTRUCTION WITH WOOD FRAMED ROOF TO REMAIN.
- 21 RELOCATE EXISTING SOFTBALL FLAG POLE TO THIS LOCATION. PROVIDE NEW FOUNDATION FOR EXISTING FLAGPOLE.
- 22 NEW FOUL POLE.
- 23 ATHLETIC LIGHTS. REFER TO ELECTRICAL.
- 24 EXISTING FLAGPOLE TO REMAIN.
- 25 NEW 6'-0" TALL GALVANIZED FENCE TIED INTO EXISTING GALVANIZED FENCING.
- 26 NEW 30'-0" BLACK NETTING BACKSTOP WITH SS CABLE SUPPORTS.
- 27 NEW 40'-0" TALL BLACK NETTING BACKSTOP WITH SS CABLE SUPPORTS.
- 28 APPROXIMATE LOCATION OF NEW NETTING POLE SUPPORT FOR BACKSTOP AND SAFETY NETTING SYSTEM OVER SPECTATOR SEATING AND CONCESSIONS. EXACT LOCATION OF NETTING POLES TO BE DETERMINED BY BACKSTOP NETTING DESIGNER AND ENGINEER. REFER TO SPECIFICATIONS TO RELEVANT DESIGN REQUIREMENTS.
- 29 CONCRETE SUB-BASE AT PITCHERS' CIRCLE - PROVIDE 4" FLAT SLAB OF CONCRETE WITH FIBER MESH REINFORCEMENT, AND MINIMUM OF 4" COMPACTED DRAINAGE STONE BELOW SLAB. SIZE OF SLAB IS TO COVER SIZE OF STANDARD PITCHING CIRCLE. INSTALL PITCHING RUBBER INTO MOUND, PROVIDE INSERT FOR PITCHING RUBBER ANCHORAGE.

ALTERNATE - SITE LAYOUT NOTES

(ALL PLAN NOTES MAY NOT BE INDICATED ON THIS SHEET.)

- A SCOREBOARDS: REMOVE AND RELOCATE EXISTING VARSITY FIELD SCOREBOARDS TO JUNIOR VARSITY BALL FIELDS, PER SPECIFICATIONS. PROVIDE NEW SCOREBOARD FOR VARSITY FIELDS, PER SPECIFICATIONS.
- VARISITY BASEBALL: DEMO EXISTING BASEBALL SCOREBOARD, SUPPORTS, AND ELECTRICAL IN ITS ENTIRETY. NEW SCOREBOARD TO BE INSTALLED IN NEW LOCATION INDICATED ON LAYOUT PLAN.
- VARISITY SOFTBALL: DEMO EXISTING SUPPORTS IN THEIR ENTIRETY AND PROVIDE NEW SUPPORTS FOR NEW BOARD AT EXISTING LOCATION.
- JUNIOR VARSITY SOFTBALL AND BASEBALL: PROVIDE RELOCATED SCOREBOARDS ON TWO EXISTING SUPPORTS AND PROVIDE TWO NEW STRUCTURAL SUPPORTS FOR RELOCATED SCOREBOARDS. PER SPECIFICATIONS. CONTRACTOR IS TO PAINT ALL EXISTING STRUCTURAL STEEL THAT IS TO BE REUSED.
- B ELECTRIC POWER BOX SET IN SYNTHETIC TURF. REFER TO ELECTRICAL.
- C NEW MASONRY WALL FOR NETTING BACKSTOP
- D EMS ACCESS: PROVIDE NEW VEHICLE ACCESS RAMP ON EXISTING SIDEWALK. WIDEN EXISTING SIDEWALK BY 6'-0" WITH NEW CONCRETE WALK WITH TURN DOWN EDGE OF SLAB TO EXTENTS INDICATED DUE TO GRADE CHANGE. REFER TO GRADING PLAN. PROVIDE NEW 12'-0" DOUBLE BLACK VINYL COATED GATE IN NEW FENCE.
- E GRANDSTANDS: RELOCATE EXISTING FIXED ALUMINUM GRANDSTANDS FROM VARSITY BALL FIELDS TO JUNIOR VARSITY FIELDS. PROVIDE NEW GRANDSTANDS, ON EXISTING CONCRETE PAD, ELEVATED 4'-0" AT VARSITY SOFTBALL FIELD. PROVIDE NEW GRANDSTANDS, ON EXISTING CONCRETE PAD, AT VARSITY BASEBALL FIELD. PROVIDE NEW CONCRETE SLAB IN LIEU OF GRAVEL IN THIS LOCATION BETWEEN VARSITY AND JUNIOR VARSITY FIELDS.
- F



**GIBRALTAR**  
DESIGN  
ARCHITECTURE • ENGINEERING • INTERIOR DESIGN

PROJECT  
**HOBBART HS  
BASEBALL AND  
SOFTBALL FIELD  
REPLACEMENT  
AND RELATED  
WORK**

FOR:  
SCHOOL CITY OF HOBBART  
32 E. 7TH STREET, HOBBART, IN  
46342

100% CONSTRUCTION  
DRAWINGS  
06/29/2026

**GIBRALTAR DESIGN**  
4030 Vincennes Rd, Suite 100,  
Indianapolis, IN 46268  
Homepage: www.GibraltarDesign.com  
Email: info@GibraltarDesign.com  
Phone: (317) 550-5777

PROJECT

26-122

DATE

06/29/26

COORDINATED BY

JPB

DRAWN BY

CND

CHECKED BY

JPB

COPYRIGHT NOTICE:  
THE CONCEPTS, DESIGNS, PLANS, DETAILS, ETC. SHOWN ON THIS DOCUMENT ARE THE PROPERTY OF GIBRALTAR DESIGN AND WERE CREATED FOR USE ON THIS SPECIFIC PROJECT. NONE OF THIS INFORMATION SHALL BE USED BY ANY PERSON OR FIRM FOR ANY PURPOSE WITHOUT THE EXPRESS WRITTEN CONSENT OF GIBRALTAR DESIGN. THE OWNER MAY RETAIN COPIES FOR INFORMATION AND REFERENCE IN CONNECTION ONLY WITH THIS PROJECT.

REVISIONS

| MARK  | DATE     | ISSUED FOR      |
|-------|----------|-----------------|
| AD.01 | 07/07/26 | ADDENDUM NO. 01 |

DRAWING  
**VARISITY BASEBALL TURF  
LAYOUT PLAN**

PROJECT  
**HOBBART HS BASEBALL & SOFTBALL  
FIELD REPLACEMENT AND RELATED  
WORK**

© GIBRALTAR DESIGN SHEET  
**C-202**

Tuesday, 7/7/2026 - 7:44 AM - LAST SAVED BY:GDANS  
Y:\26-122 SC HOBBART - HOBBART HS BB AND SB FIELD  
REPLACEMENT\26-122 CAD\03 SITE\C-202.DWG









PROJECT  
HOBART HS  
BASEBALL AND  
SOFTBALL FIELD  
REPLACEMENT  
AND RELATED  
WORK

FOR:  
SCHOOL CITY OF HOBART  
32 E. 7TH STREET, HOBART, IN  
46342

**GENERAL PLAN NOTES:**

1. THE CONTRACTOR IS RESPONSIBLE TO VERIFY ALL EXISTING SITE CONDITIONS AND SHALL NOTIFY THE ARCHITECT/ENGINEER IMMEDIATELY OF ANY DISCREPANCIES BETWEEN THE EXISTING CONDITIONS AND ALL PROPOSED IMPROVEMENTS IN THE CONSTRUCTION DRAWINGS.
2. THE LOCATION OF THE IRRIGATION SPRINKLER SYSTEM AND SUB SURFACE (UNDERDRAIN) SEWER SYSTEM IS DEPICTED AS SHOWN ON THE 01/26/2006 DRAWING SET FOR THE HOBBART HIGH SCHOOL PREPARED BY GIBRALTR DESIGN. THE LOCATIONS SHOWN WERE PROPOSED AND ARE NOT AS-BUILT. THE LOCATIONS ARE APPROXIMATE AND SHOULD BE FIELD VERIFIED BY THE CONTRACTOR.
3. TEMPORARY BENCH MARKS FOR CONSTRUCTION ARE:
  - 1) TBM #1, THE NORTH RIM OF THE EXISTING BEEHIVE CATCH BASIN LOCATED NORTHWEST OF THE VARSITY SOFTBALL FIELD.  
ELEVATION = 628.68
  - 2) TBM #2, THE NORTH RIM OF THE EXISTING BEEHIVE CATCH BASIN LOCATED NORTHEAST OF THE VARSITY SOFTBALL FIELD.  
ELEVATION = 629.88
  - 3) TBM #3, THE NORTH RIM OF THE EXISTING BEEHIVE CATCH BASIN LOCATED NORTHWEST OF THE VARSITY BASEBALL FIELD.  
ELEVATION = 629.70
  - 4) TBM #4, THE NORTH RIM OF THE EXISTING BEEHIVE CATCH BASIN LOCATED NORTHEAST OF THE VARSITY BASEBALL FIELD.  
ELEVATION = 629.57

**LEGEND**  
PROPOSED

- |                                                                                       |                               |
|---------------------------------------------------------------------------------------|-------------------------------|
| C                                                                                     | CONCRETE                      |
| CB                                                                                    | CATCH BASIN                   |
| MH                                                                                    | MANHOLE                       |
| OG                                                                                    | OPEN GRATE                    |
| TC                                                                                    | TOP OF CURB                   |
| TU                                                                                    | TOP OF ARTIFICIAL TURF        |
|  | GRADE                         |
|  | DRAINAGE FLOW                 |
|  | NEW MANHOLE / NEW CATCH BASIN |
|  | NEW STORM SEWER               |

**LEGEND**  
EXISTING

- |  |                              |
|--|------------------------------|
|  | MANHOLE                      |
|  | SANITARY MANHOLE             |
|  | CATCH BASIN/INLET            |
|  | FOUL BALL POLE               |
|  | POWER POLE                   |
|  | LIGHT POLE                   |
|  | WATER VALVE                  |
|  | FIRE HYDRANT                 |
|  | GAS VALVE                    |
|  | PVC PIPING W/ SIZE (APPROX.) |
|  | SPRINKLER HEADS              |
|  | CONTROL VALVE                |
|  | GATE VALVE                   |
|  | WINTER BLOWOUT CONNECTION    |
|  | BACKFLOW PREVENTER           |
|  | GAS LINE                     |
|  | ELECTRIC LINE                |
|  | CHAIN LINK FENCE             |
|  | UNDERDRAIN PIPE SYSTEM       |
|  | EXISTING SANITARY SEWER      |
|  | EXISTING STORM SEWER         |
|  | EXISTING WATER MAIN          |
|  | CONTOUR                      |
|  | EXISTING SPOT ELEVATION      |

