

**ADDENDUM
NO. 2**

March 24, 2023

**Whiteland High School Phase 1A
300 Main Street
Whiteland, IN 46184**

TO: ALL BIDDERS OF RECORD

This Addendum forms a part of and modifies the Bidding Requirements, Contract Forms, Contract Conditions, the Specifications and the Drawings dated March 24, 2023, by Lancer Associates Architecture. Acknowledge receipt of the Addendum in the space provided on the Bid Form. Failure to do so may subject the Bidder to disqualification.

This Addendum consists of Pages ADD 2-1 through ADD 2-1 and attached Lancer Associates Architecture Addendum No. 2 dated March 24, 2023 consisting of three (3) Addendum pages and Addendum 2 Drawings: 100, 200, 201, 202, 203, 204, 205, 206, 207, 300, 301, 302, 400, 500, 600, 601, 700, 701, 800, 801, 802, 900, and 901.

A. SPECIFICATION SECTION 00 20 00 – INFORMATION AVAILABLE TO BIDDERS

Delete the following.

The previously issued Site Logistics Plan can be deleted. The fencing, gates, and trailer location are now shown in the Architect Addendum 2 drawings.

ADDENDUM NO. TWO

PROJECT: Whiteland Community High School Phase 1a

PROJECT NUMBER: 22130

DATE OF ADDENDUM: March 24, 2023



THIS ADDENDUM FORMS A PART OF THE CONTRACT DOCUMENTS AND IS ISSUED IN ACCORDANCE WITH THE INSTRUCTIONS TO BIDDERS. ACKNOWLEDGE RECEIPT OF THIS ADDENDUM BY SIGNING THE ADDENDUM ACKNOWLEDGMENT SECTION OF THE BID FORM.

Drawings:

1. Title Sheet (sheet 100) – revised plan index to include new Site Dimension Plan sheet 302.
2. Overall Existing Site Layout (sheet 200) – revised to include temporary benchmark (TBM) information and show TBM locations.
3. Topographic Survey (sheets 201-206) – revised to include temporary benchmark (TBM) information and show TBM locations.
4. Topographic Survey (sheet 203) – revised to include buried electric line located on the north end of proposed parking area 'B'.

5. Demolition Plan (sheet 207) – revised to include buried electric line located on the north end of proposed parking area 'B'.
6. Overall Proposed Site Layout (sheet 300) – revised parking analysis table.
7. Site Dimension Plan (sheet 301) – revised parking analysis table. Added temporary construction fence and revised material requirements on A.D.A. accessible parking space detail.
8. Site Dimension Plan (sheet 302) – new sheet created to show permanent construction fence and field office location for Phase 1 to be installed at the end of Phase 1A construction.
9. Utility Plan (sheet 400) – revised to denote Class IV reinforced concrete pipe (RCP) for structures as required. Changed Str. No. 7 from curb inlet to storm manhole type 'C' (no change to casting type).
10. Grading Plan (sheet 500) – revised to include temporary benchmark (TBM) information.
11. Drainage Plan (sheet 600) – revised chamber inlet scour protection and inlet manifold elevations per manufacturer's review. Revised outlet structure details for Str. No. 23 to show 4" diameter orifices in weir plate.
12. Drainage Plan (sheet 601) – revised chamber inlet scour protection, updated number of SC-740 chambers (decreased from 590 to 587) and end caps (increased from 48 to 52), and updated manifold configurations per manufacturer's review. Revised outlet structure details for Str. No. 12 to show 4" diameter orifices in weir plate.
13. Storm Plan and Profile (sheet 700) – updated existing utility depths shown on profiles STM-A, STM-D, and STM-E based on utility potholing results provided by Fluid Waste Services. Revised alignment of STM-G (Str. No. 2 to Str. No. 6) to match updated storm layout.
14. Storm Plan and Profile (sheet 701) – updated existing utility depths shown on profile STM-L based on utility potholing results provided by Fluid Waste Services.
15. Overall Erosion Control Plan (sheet 800) – revised to show Phase 1 field office and port-o-let locations to be installed at the end of Phase 1A construction.

16. Erosion Control Plan (sheet 801) – revised to show NOI/SWPPP posting board and port-o-let locations. Add silt fence along the north and west construction limits.
17. Miscellaneous Details (sheet 900) – removed word “handicap” from pavement message marking detail for A.D.A. symbol. Add Town of Whiteland standard detail for sanitary manhole connections.
18. Miscellaneous Details (sheet 901) – revised invert elevation of 18” manifold connecting to Str. No. 22.

Attachments: Sheets 100-901, MEP Addendum

End of Addendum 2


FINAL CONSTRUCTION PLANS

WHITELAND COMMUNITY HIGH SCHOOL

PHASE 1A

300 E. MAIN STREET

WHITELAND, INDIANA

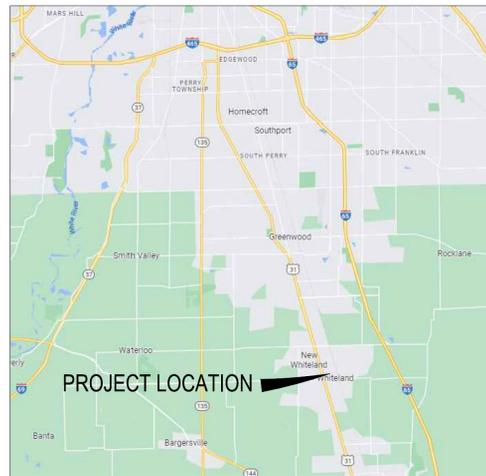

VICINITY MAP
NO SCALE



LOCATION MAP
NO SCALE

PLAN INDEX	
SHEET #	SUBJECT
100	TITLE SHEET
200	OVERALL EXISTING SITE LAYOUT
201-206	TOPOGRAPHICAL SURVEY
207	DEMOLITION PLAN
300	OVERALL PROPOSED SITE LAYOUT
301-302	SITE DIMENSION PLAN
400	UTILITY PLAN
500	GRADING PLAN
601-600	DRAINAGE PLAN
700-701	STORM PLAN AND PROFILE
800	OVERALL EROSION CONTROL PLAN
801	EROSION CONTROL PLAN
802	STORMWATER POLLUTION PREVENTION PLAN
900-901	MISCELLANEOUS DETAILS

OWNER
 CLARK-PLEASANT COMMUNITY
 SCHOOL CORPORATION
 50 CENTER STREET
 WHITELAND, IN 46184
 PHONE: (317) 535-7579
 CONTACT: BENJI BETTS
 EMAIL: bbetts@cpcsc.k12.in.us

ENGINEER
 CROSSROAD ENGINEERS, PC
 115 N. 17TH AVENUE
 BEECH GROVE, IN 46107
 PHONE: (317) 780-1555
 CONTACT: GREGORY J. ILKO
 EMAIL: gilko@crossroadengineers.com



TITLE SHEET		WHITELAND HIGH SCHOOL PHASE 1A	
JOB No.	DRAWN	CHECKED	TEN
DATE	FEBRUARY 27, 2023	DESIGNED	GJ
		DMS	
		APPR.	
			100



NO.	DATE	REVISIONS	BY
1	03.03.23	REVISION BASIN BY RETENTION ELEVATIONS AND OUTLET CONTROL STRUCTURE DETAIL (STR. NO. 12)	DMS
2	03.24.23	ADDENDUM 2-REVISIONS PER TOWN OF WHITELAND TRC COMMENTS, UTILITY POTHOLES RESULTS, ADS STORMTECH REVIEW, & CBBE REVIEW	GJ
3			
4			
5			
6			
7			
8			
9			

DIRECTORY PATH : R:\Adv\Uncon+Revised\Whiteland High School\Design\CAD\Plans\PHASE 1A
 DATE/USER : 3/23/2023 8:45 AM / K10g



TOPOGRAPHICAL SURVEY


WHITELAND HIGH SCHOOL PHASE 1A

JOB NO.	DRAWN	CHECKED	TEN
DATE	FEBRUARY 27, 2023	DESIGNED	GJI
		APPR.	



Derek M. Snyder

NO.	DATE	REVISIONS
1	03.03.23	ADDITION 2-REVISIONS PER TOWN OF WHITELAND TRC COMMENTS, UTILITY FLOODING RESULTS, AISC STORMTECH REVIEW, & CBBE REVIEW
2	03.03.23	REVISED BASIN BY RETENTION ELEVATIONS AND OUTLET CONTROL STRUCTURE DETAIL (STR. NO. 12)
3	03.03.23	

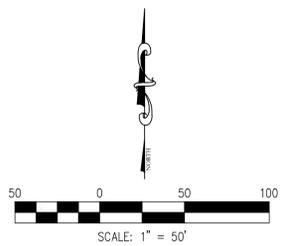


EXISTING UTILITY SIZE AND MATERIAL INFORMATION SHOWN ON THESE PLANS ARE PER THE BEST GRAPHICAL AND VISIBLE INFORMATION AVAILABLE. CONFLICTS MAY EXIST AND IT SHALL BE THE CONTRACTOR'S RESPONSIBILITY TO FIELD VERIFY ALL SIZING AND MATERIAL INFORMATION PROVIDED. IF ACTUAL CONDITIONS DIFFER FROM THAT INFORMATION SHOWN ON THE PLANS, THE CONTRACTOR SHALL, PRIOR TO THE INSTALLATION OF ANY PROPOSED INFRASTRUCTURE, NOTIFY THE DESIGN ENGINEER IMMEDIATELY.

PROPERTY BOUNDARY SHOWN IS PRELIMINARY PENDING COMPLETION OF THE ALTA/NSPS LAND TITLE SURVEY BEING PREPARED BY G.W. CHARLES, L.S. WITH CROSSROAD ENGINEERS, P.C.

BENCHMARK INFORMATION

ORIGINATING BENCHMARK
 DESIGNATION - X 13
 PID - KA0010
 STATE/COUNTY - IN/MORGAN
 USGS QUAD - MOORESVILLE EAST (1980)
 VERT ORDER - FIRST CLASS II
 DESCRIBED BY COAST AND GEODETIC SURVEY 1946
 1.2 MI FROM MARYLETT
 IN JOHNSON COUNTY, 1.2 MILES NORTH ALONG STATE HIGHWAY 37 FROM THE INTERSECTION OF STATE HIGHWAY 144 AT MARYLETT, MORGAN COUNTY, 125 YARDS NORTH OF THE MORGAN-JOHNSON COUNTY LINE, 26 FEET WEST OF THE CENTERLINE OF THE HIGHWAY, IN LINE WITH THE WEST RIGHT-OF-WAY FENCE, 1.5 FEET SOUTH OF A WHITE WOODEN WITNESS POST, AND ABOUT 2 FEET HIGHER THAN THE HIGHWAY. A STANDARD DISK, STAMPED 696.370 X 13 1900 AND SET IN THE TOP OF A CONCRETE POST PROJECTING 7 INCHES ABOVE GROUND.
 RECOVERY NOTE BY IN DEPT OF NAT RES 1985
 NEW DESC- AT THE INTERSECTION OF NEW STATE ROAD 144 AND OLD STATE ROAD 37, IN THE SOUTHWEST QUARTER OF THE INTERSECTION, WITNESS POST IS ONE RIGHT-OF-WAY FENCE IS CONC. ALL OTHER INFORMATION APPEARS TO BE CORRECT.
 ELEVATION = 685.94 (NAVD 88)
TRM #400
 RR SPIKE SET IN E FACE OF PP#P21063" LOCATED ±180' N OF "TRACT NORTH DRIVE" ±40' WEST OF "SAINT CHARLES WAY"
 ELEV.=805.77
TRM #401
 RR SPIKE SET IN E FACE OF PP#P21042" LOCATED ±46' W OF "TRACY ST." ±40' S OF N PARKING LOT ENTRANCE @ "CLARK PLEASANT EMPLOYEE HEALTH & WELLNESS CENTER"
 ELEV.=805.07
TRM #402
 OUT BOX ON TOP OF CONC PEDESTAL FOR UP ON N EDGE OF CONC. LOCATED @ NE MOST CORNER OF PARKING LOT FOR "199 US-31 "BIG SPLASH CAR WASH"
 ELEV.=806.18
TRM #403
 SE MOST CORNER OF BOTTOM CONC STEP LOCATED @ SE CORNER OF "STUDIO 31 SALON" ±43 N. US-31" ON E FACE OF BUILDING.
 ELEV.=801.28
TRM #404
 NE CORNER OF TOP CONC STEP CONNECTED TO LEAD WALK @ "239 E MAIN ST." LOCATED SE QUAD OF "E MAIN ST." & "TICHENOR LN."
 ELEV.=799.80
TRM #405
 RR SPIKE SET IN E FACE POWERPOLE, LOCATED ±5' S OF "E MAIN ST." & ±100' W OF DRIVE @ "399 E MAIN ST."
 ELEV.=790.98
TRM #406
 SW CORNER OF CONC PORCH @ "49 CENTER ST."
 ELEV.=797.61
TRM #407
 RR SPIKE SET IN S FACE OF PP# "P22C73". LOCATED ±5' E OF "CENTER ST." & ±150' N OF "CLEM ST."
 ELEV.=800.07
TRM #408
 RR SPIKE SET IN E FACE OF POWER POLE, LOCATED @ SW CORNER OF PROPERTY OF "329 CHRISTINA DR."
 ELEV.=800.89

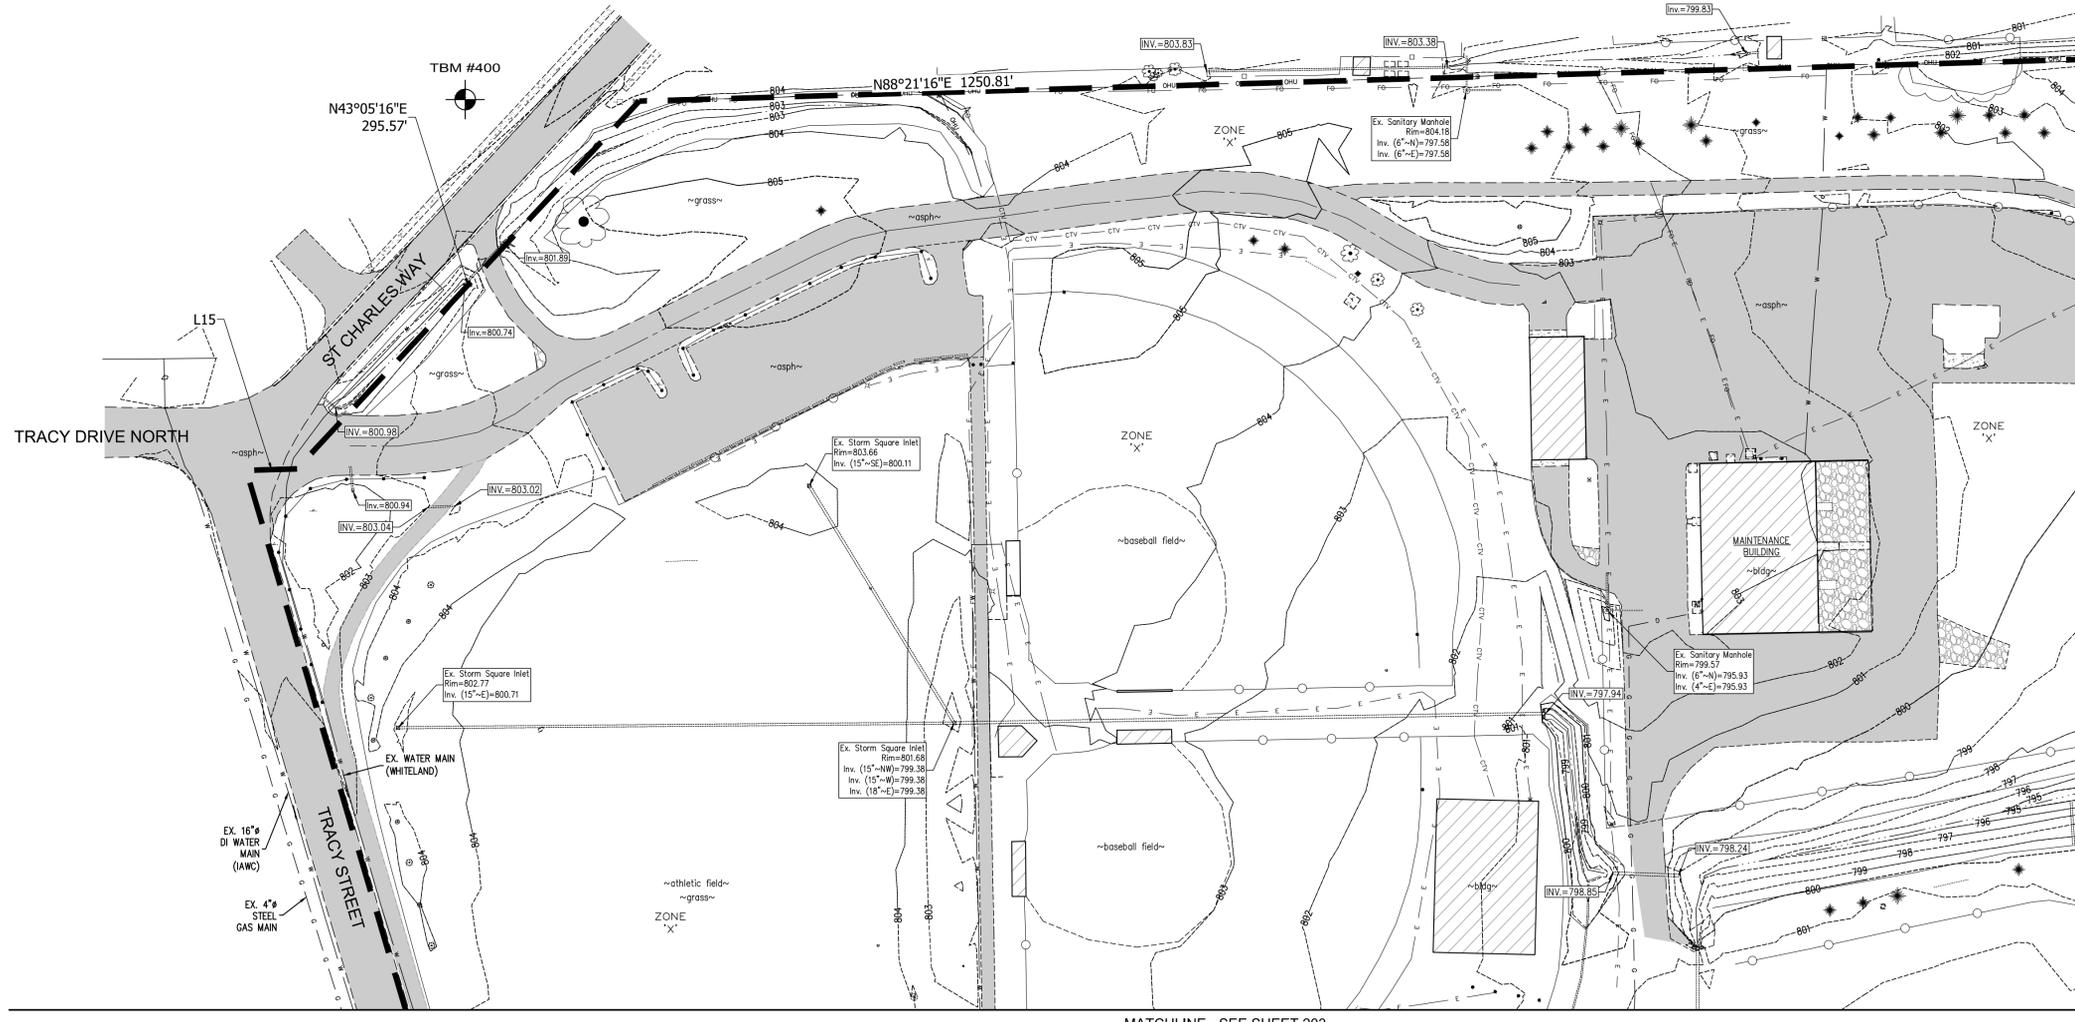

UTILITIES

Note: Listed below are the Indiana Underground Plant Protection Services Contacts; Others not listed may exist.

- SANITARY SEWER**
TOWN OF WHITELAND
SANITATION DEPARTMENT
549 MAIN STREET
WHITELAND, IN 46184
PHONE: (317) 557-2955
EMAIL: SEWERSUP@WHITELAND.IN.US
CONTACT: JESSE JONES
- TOWN OF NEW WHITELAND**
SANITATION DEPARTMENT
540 TRACY ROAD, SUITE A
NEW WHITELAND, IN 46184
PHONE: (317) 941-3544
EMAIL: MATT.GILLOCK@NEWWHITELAND.IN.GOV
CONTACT: MATT GILLOCK
- STORM SEWER**
TOWN OF WHITELAND
DEPARTMENT OF PUBLIC WORKS
549 MAIN STREET
WHITELAND, IN 46184
PHONE: (317) 557-1033
EMAIL: STREETDEPT@WHITELAND.IN.US
CONTACT: SHAWN YOUNG
- GAS**
CENTERPOINT ENERGY
600 INDUSTRIAL DRIVE
FRANKLIN, IN 46131
PHONE: (765) 257-2119
EMAIL: JONATHAN.EASTHAM@CENTERPOINTENERGY.COM
CONTACT: JONATHAN EASTHAM
- WATER**
TOWN OF WHITELAND
DEPARTMENT OF PUBLIC WORKS
549 MAIN STREET
WHITELAND, IN 46184
PHONE: (317) 557-1033
EMAIL: STREETDEPT@WHITELAND.IN.US
CONTACT: SHAWN YOUNG
- INDIANA AMERICAN WATER COMPANY**
153 N. EMERSON AVENUE
GREENWOOD, IN 46143
PHONE: (317) 209-5837
EMAIL: JONNY.NORRIS@IAMWC.COM
CONTACT: JONNY NORRIS
- ELECTRIC**
TOWN OF BARGERSVILLE
24 N. MAIN STREET
BARGERSVILLE, IN 46106
PHONE: (317) 422-5117
EMAIL: KILLINGER@BARGERSVILLE.IN.GOV
CONTACT: KEVIN KILLINGER
- JOHNSON COUNTY REMC**
750 INTERNATIONAL DRIVE
FRANKLIN, IN 46131
PHONE: (317) 738-7639
EMAIL: JEANS@JCREM.COM
CONTACT: SCOTT JEAN

- TELECOMMUNICATIONS**
JOHNSON COUNTY REMC FIBER
750 INTERNATIONAL DRIVE
FRANKLIN, IN 46131
PHONE: (317) 797-9796
EMAIL: BENNETT@JCREM.COM
CONTACT: ERIC BENNETT
- BRIGHTSPEED**
50 N. JACKSON STREET
FRANKLIN, IN 46131
PHONE: (880) 376-1445
EMAIL: JAMES.WIRLLEY@BRIGHTSPEED.COM
CONTACT: JAMES ROLLEY
- EVERSTREAM**
342 MASSACHUSETTS AVENUE
INDIANAPOLIS, IN 46204
PHONE: (317) 213-3137
EMAIL: MPOUGH@EVERSTREAM.NET
CONTACT: MARK PUGH
- COMCAST**
1600 W. VERNAL PIKE
BLOOMINGTON, IN 47404
PHONE: (812) 360-3090
EMAIL: STEVE.MCARTOR@COMCAST.COM
CONTACT: STEVE MCARTOR
- METRONET**
3701 COMMUNICATIONS WAY
EVANSVILLE, IN 47715
PHONE: (812) 253-2196
EMAIL: MARK.DECKARD@METRONET.COM
CONTACT: MARK DECKARD

TOPOGRAPHICAL NOTES

- CONTRACTOR SHALL DISPOSE OF ALL MATERIALS IN ACCORDANCE WITH FEDERAL, STATE, AND LOCAL REGULATIONS.
- UTILITIES ARE GRAPHICAL REPRESENTATION PER SURVEY AND MAPPING. CONTRACTOR SHALL FIELD VERIFY ALL UTILITIES PRIOR TO CONSTRUCTION.
- CONTRACTOR SHALL COORDINATE WITH APPLICABLE UTILITY COMPANIES FOR SERVICE DIS-CONNECTIONS AND/OR RELOCATIONS.

FLOODPLAIN INFORMATION

BY GRAPHIC PLOTTING ONLY, THIS TRACT OF LAND DESCRIBED HEREON LIES WITHIN THE UNSHADDED PORTION OF ZONE "X" (AREAS OUTSIDE THE 0.2% ANNUAL CHANCE FLOODPLAIN), FLOODPLAIN ZONE "X" (AREAS OF 0.2% ANNUAL CHANCE FLOOD), FLOODPLAIN ZONE "AE" (AREA OF 1% ANNUAL CHANCE FLOOD WITH ESTABLISHED BASE FLOOD ELEVATIONS), AND FLOODWAY ZONE "AE" AND IS IN A SPECIAL FLOOD HAZARD AREA AS PLOTTED ON THE FEDERAL EMERGENCY MANAGEMENT AGENCY FLOOD INSURANCE RATE MAP FOR JOHNSON COUNTY, INDIANA, COMMUNITY PANEL NO. 18081C0370, WHICH BEARS AN EFFECTIVE DATE OF 08/02/2007.

EXISTING LEGEND

POWERPOLE	-----800-----	CONTOURS
POWERPOLE W/LIGHT	-----	PROPERTY LINE
LIGHT POLE	-----	SECTION LINE
ELECTRIC METER	-----	RIGHT-OF-WAY
ELECTRIC BOX	-----	EASEMENT
YARD LIGHT	-----	ADJOINER LINE
GUIDE WIRE	-----	PAVEMENT LINE
TELEPHONE MANHOLE	-----	FIELD LINE
TELEPHONE RISER	-----	PRIVACY FENCE
WATER VALVE	-----	CHAINLINK FENCE
FIRE HYDRANT	-----	SPLIT RAIL FENCE
WATER MANHOLE	-----	DITCH
WATER METER	-----	FIBER OPTIC LINE
GAS VALVE	-----	GAS LINE
GAS METER	-----	TELEPHONE LINE
CABLE TV RISER	-----	WATER LINE
FIBER OPTIC BOX	-----	CABLE TV LINE
CLEANOUT	-----	ELECTRIC LINE
SIGN	-----	OVERHEAD UTILITY LINE
STORM ROUND INLET	-----	TREE LINE
STORM CURB INLET	-----	SANITARY SEWER W/MANHOLE
RIGHT-OF-WAY MARKER	-----	STORM SEWER W/ MANHOLE & END SECTION
TREE, BUSH & STUMP	-----	
TEMP. BENCHMARK	-----	

NOTE: The underground utilities shown have been located from field survey information and existing drawings. The surveyor makes no guarantee that the underground utilities comprise all such utilities in the area, either in-service or abandoned. The surveyor further does not warrant that the underground utilities shown are in the exact location indicated although the surveyor does certify that they are located as accurately as possible from information available. The surveyor has not physically located the underground utilities.

DIRECTORY PATH : R:\Adv\Utilities\Bldgs\Whiteland High School\Design\CAD\Plans\Phase 1A
 DATE/USER : 3/27/2023 9:01 AM / KJG



TOPOGRAPHICAL SURVEY

WHITELAND HIGH SCHOOL PHASE 1A


JOB NO.	DRAWN	CHECKED	TEN
DATE	DESIGNED	APPR.	GJI
FEBRUARY 27, 2023	DMS		



NO.	DATE	BY	REVISIONS
1	03.03.23		ADDITIONAL 2 REVISIONS PER TOWN OF WHITELAND TRC COMMENTS, UTILITY POTHOLING RESULTS, AISC STORMTECH REVIEW, & CBBE REVIEW
2	03.03.23		REVISED BASIN BY RETENTION ELEVATIONS AND OUTLET CONTROL STRUCTURE DETAIL (STR. NO. 12)

EXISTING LEGEND

POWERPOLE	CONTOURS
POWERPOLE W/RISER	PROPERTY LINE
POWERPOLE W/LIGHT	SECTION LINE
LIGHT POLE	RIGHT-OF-WAY
ELECTRIC METER	EASEMENT
ELECTRIC BOX	ADJONER LINE
YARD LIGHT	PAVEMENT LINE
GUIDE WIRE	FIELD LINE
TELEPHONE MANHOLE	PRIVACY FENCE
TELEPHONE RISER	CHAINLINK FENCE
WATER VALVE	SPLIT RAIL FENCE
FIRE HYDRANT	DITCH
WATER MANHOLE	FIBER OPTIC LINE
WATER METER	GAS LINE
GAS VALVE	TELEPHONE LINE
GAS METER	WATER LINE
CABLE TV RISER	CABLE TV LINE
FIBER OPTIC BOX	ELECTRIC LINE
CLEANOUT	OVERHEAD UTILITY LINE
SIGN	TREE LINE
STORM ROUND INLET	SANITARY SEWER
STORM CURB INLET	W/MANHOLE
RIGHT-OF-WAY MARKER	STORM SEWER W/ MANHOLE & END SECTION
TREE, BUSH & STUMP	
TEMP. BENCHMARK	
	(D) DEED (M) MEASURE (PS) PLAT SURVEY
	ASPHALT BUILDING CONCRETE
	GRAVEL REMOVAL/DEMOLISH

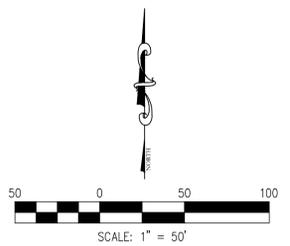

EXISTING UTILITY SIZE AND MATERIAL INFORMATION SHOWN ON THESE PLANS ARE PER THE BEST GRAPHICAL AND VISIBLE INFORMATION AVAILABLE. CONFLICTS MAY EXIST AND IT SHALL BE THE CONTRACTOR'S RESPONSIBILITY TO FIELD VERIFY ALL SIZING AND MATERIAL INFORMATION PROVIDED. IF ACTUAL CONDITIONS DIFFER FROM THAT INFORMATION SHOWN ON THE PLANS, THE CONTRACTOR SHALL, PRIOR TO THE INSTALLATION OF ANY PROPOSED INFRASTRUCTURE, NOTIFY THE DESIGN ENGINEER IMMEDIATELY.

PROPERTY BOUNDARY SHOWN IS PRELIMINARY PENDING COMPLETION OF THE ALTA/NSPS LAND TITLE SURVEY BEING PREPARED BY G.W. CHARLES, L.S. WITH CROSSROAD ENGINEERS, P.C.

BENCHMARK INFORMATION

ORIGINATING BENCHMARK
 DESIGNATION - X 13
 PID - RA0010
 STATE/COUNTY - IN/MORGAN
 USGS QUAD - MOORESVILLE EAST (1980)
 VERT ORDER - FIRST CLASS II
 DESCRIBED BY COAST AND GEODETIC SURVEY 1946
 1.2 MI N FROM WAKELY,
 IN JANSON COUNTY, 1.2 MILES NORTH ALONG STATE HIGHWAY 37 FROM THE INTERSECTION OF STATE HIGHWAY 144 AT WAKELY, MORGAN COUNTY, 125 YARDS NORTH OF THE MORGAN-JANSON COUNTY LINE, 28 FEET WEST OF THE CENTERLINE OF THE HIGHWAY, IN LINE WITH THE WEST RIGHT-OF-WAY FENCE, 13 FEET SOUTH OF A WHITE WOODEN WITNESS POST, AND ABOUT 2 FEET HIGHER THAN THE HIGHWAY, A STANDARD DISK, STAMPED 686.370 X 13 1930 AND SET IN THE TOP OF A CONCRETE POST PROJECTING 7 INCHES ABOVE GROUND.
 RECOVERY NOTE BY IN DEPT OF NAT RES 1985
 NEW DESS- AT THE INTERSECTION OF NEW STATE ROAD 144 AND OLD STATE ROAD 37, IN THE SOUTHWEST QUARTER OF THE INTERSECTION, WITNESS POST IS GONE RIGHT-OF-WAY FENCE IS GONE, ALL OTHER INFORMATION APPEARS TO BE CORRECT.
 ELEVATION = 685.94 (NAVD 88)
 TBM #400
 RR SPIKE SET IN E FACE OF PIP#P21063 LOCATED ±180' N OF "TRACT NORTH DRIVE" ±40' WEST OF "SAINT CHARLES WAY"
 ELEV=805.77
 TBM #401
 RR SPIKE SET IN E FACE OF PIP#P21042 LOCATED ±6' W OF "TRACY ST." ±40' S OF N PARKING LOT ENTRANCE @ "CLARK PLEASANT EMPLOYEE HEALTH & WELLNESS CENTER"
 ELEV=805.07
 TBM #402
 CUT BOX ON TOP OF CONC PEDESTAL FOR UP ON N EDGE OF CONC. LOCATED @ NE MOST CORNER OF PARKING LOT FOR "199 US-31 "BIG SPLASH CAR WASH"
 ELEV=806.18
 TBM #403
 SE MOST CORNER OF BOTTOM CONC STEP LOCATED @ SE CORNER OF "STUDIO 31 SALON" ±43 N. US-31 ON E FACE OF BUILDING.
 ELEV=801.28
 TBM #404
 NE CORNER OF TOP CONC STEP CONNECTED TO LEAD WALK @ "239 E MAIN ST." LOCATED SE QUAD OF "E MAIN ST." & "TICHERON LN."
 ELEV=799.80
 TBM #405
 RR SPIKE SET IN E FACE POWERPOLE. LOCATED ±5' S OF "E MAIN ST." & ±XX' W OF DRIVE @ "399 E MAIN ST."
 ELEV=790.98
 TBM #406
 SW CORNER OF CONC PORCH @ "49 CENTER ST."
 ELEV=797.61
 TBM #407
 RR SPIKE SET IN S FACE OF PIP# "P22C73". LOCATED ±5' E OF "CENTER ST." & ±150' N OF "CLEM ST."
 ELEV=800.07
 TBM #408
 RR SPIKE SET IN E FACE OF POWER POLE. LOCATED @ SW CORNER OF PROPERTY OF "329 CHRISTINA DR."
 ELEV=800.89

UTILITIES

Note: Listed below are the Indiana Underground Plant Protection Services Contacts; Others not listed may exist.

- SANITARY SEWER**
TOWN OF WHITELAND
SANITATION DEPARTMENT
549 MAIN STREET
WHITELAND, IN 46184
PHONE: (317) 557-2955
EMAIL: SEWER@TOWNSHIPWHITELAND.IN.GOV
CONTACT: JESSE JONES
- TOWN OF NEW WHITELAND**
SANITATION DEPARTMENT
540 TRACY ROAD, SUITE A
NEW WHITELAND, IN 46184
PHONE: (317) 941-3544
EMAIL: MATT.GILLOCK@NEWWHITELAND.IN.GOV
CONTACT: MATT GILLOCK
- STORM SEWER**
TOWN OF WHITELAND
DEPARTMENT OF PUBLIC WORKS
549 MAIN STREET
WHITELAND, IN 46184
PHONE: (317) 557-1033
EMAIL: STREETDEPT@TOWNSHIPWHITELAND.IN.GOV
CONTACT: SHAWN YOUNG
- GAS**
CENTERPOINT ENERGY
600 INDUSTRIAL DRIVE
FRANKLIN, IN 46131
PHONE: (765) 287-2119
EMAIL: JONATHAN.EASTHAM@CENTERPOINTENERGY.COM
CONTACT: JONATHAN EASTHAM
- WATER**
TOWN OF WHITELAND
DEPARTMENT OF PUBLIC WORKS
549 MAIN STREET
WHITELAND, IN 46184
PHONE: (317) 557-1033
EMAIL: STREETDEPT@TOWNSHIPWHITELAND.IN.GOV
CONTACT: SHAWN YOUNG
- INDIANA AMERICAN WATER COMPANY**
153 N. EMERSON AVENUE
GREENWOOD, IN 46143
PHONE: (317) 209-5837
EMAIL: JONNY.NORRIS@IAWATER.COM
CONTACT: JONNY NORRIS
- ELECTRIC**
TOWN OF BARGERSVILLE
24 N. MAIN STREET
BARGERSVILLE, IN 46106
PHONE: (317) 422-5117
EMAIL: KILLINGER@BARGERSVILLE.IN.GOV
CONTACT: KEVIN KILLINGER
- JOHNSON COUNTY REMC**
750 INTERNATIONAL DRIVE
FRANKLIN, IN 46131
PHONE: (317) 738-7639
EMAIL: JEAN@JOHNSONREM.COM
CONTACT: SCOTT JEAN
- TELECOMMUNICATIONS**
JOHNSON COUNTY REMC FIBER
750 INTERNATIONAL DRIVE
FRANKLIN, IN 46131
PHONE: (317) 797-9786
EMAIL: BENNETTE@JOHNSONREM.COM
CONTACT: ERIC BENNETT
- BRIGHTSPEED**
50 N. JACKSON STREET
FRANKLIN, IN 46131
PHONE: (980) 376-1445
EMAIL: JAMES.WROLLEY@BRIGHTSPEED.COM
CONTACT: JAMES WROLLEY
- EVERSTREAM**
342 MASSACHUSETTS AVENUE
INDIANAPOLIS, IN 46204
PHONE: (317) 213-3137
EMAIL: MPOUGH@EVERSTREAM.NET
CONTACT: MARK PUGH
- COMCAST**
1600 W. VERNAL PIKE
BLOOMINGTON, IN 47404
PHONE: (812) 360-3090
EMAIL: STEVE_MCARTOR@COMCAST.COM
CONTACT: STEVE MCAUTOR
- METRONET**
3701 COMMUNICATIONS WAY
EVANSVILLE, IN 47715
PHONE: (812) 253-2196
EMAIL: MARK.DECKARD@METRONETINC.COM
CONTACT: MARK DECKARD

NOTE: The underground utilities shown have been located from field survey information and existing drawings. The surveyor makes no guarantee that the underground utilities comprise all such utilities in the area, either in-service or abandoned. The surveyor further does not warrant that the underground utilities shown are in the exact location indicated although the surveyor does certify that they are located as accurately as possible from information available. The surveyor has not physically located the underground utilities.



TOPOGRAPHICAL NOTES

- CONTRACTOR SHALL DISPOSE OF ALL MATERIALS IN ACCORDANCE WITH FEDERAL, STATE, AND LOCAL REGULATIONS.
- UTILITIES ARE GRAPHICAL REPRESENTATION PER SURVEY AND MAPPING. CONTRACTOR SHALL FIELD VERIFY ALL UTILITIES PRIOR TO CONSTRUCTION.
- CONTRACTOR SHALL COORDINATE WITH APPLICABLE UTILITY COMPANIES FOR SERVICE DIS-CONNECTIONS AND/OR RELOCATIONS.

FLOODPLAIN INFORMATION

BY GRAPHIC PLOTTING ONLY, THIS TRACT OF LAND DESCRIBED HEREON LIES WITHIN THE UNSHADOWED PORTION OF ZONE "X" (AREAS OUTSIDE THE 0.2% ANNUAL CHANCE FLOODPLAIN), FLOODPLAIN ZONE "X" (AREAS OF 0.2% ANNUAL CHANCE FLOOD), FLOODPLAIN ZONE "AE" (AREA OF 1% ANNUAL CHANCE FLOOD WITH ESTABLISHED BASE FLOOD ELEVATIONS), AND FLOODWAY ZONE "AE" AND IS IN A SPECIAL FLOOD HAZARD AREA AS PLOTTED ON THE FEDERAL EMERGENCY MANAGEMENT AGENCY FLOOD INSURANCE RATE MAP FOR JOHNSON COUNTY, INDIANA, COMMUNITY PANEL NO. 18081C01370, WHICH BEARS AN EFFECTIVE DATE OF 08/02/2007.

DIRECTORY PATH : R:\Adv\Utilities\Bldgs\Whiteland High School\Design\CAD\Plans\PHASE 1A
 FILENAME : 230223_9.10.AMY_K099
 DATE/TIME : 3/27/2023 9:10 AM / K099

TOPOGRAPHICAL SURVEY

WHITELAND HIGH SCHOOL PHASE 1A

JOB NO.	DRAWN	CHECKED	TEN
	KLF		GJ
DATE	DESIGNED	APPR.	GJ
FEBRUARY 27, 2023			



NO.	DATE	REVISIONS
1	03.03.23	REVISION 1 - REVISIONS PER TOWN OF WHITELAND, ITC COMMENTS: UTILITY FLOODING RESULTS, ADD STORMTECH REVIEW & CBBE REVIEW
2	03.24.23	REVISION 2 - REVISIONS PER TOWN OF WHITELAND, ITC COMMENTS: UTILITY FLOODING RESULTS, ADD STORMTECH REVIEW & CBBE REVIEW

EXISTING LEGEND

POWERPOLE	CONTOURS
POWERPOLE W/RISER	PROPERTY LINE
LIGHT POLE	SECTION LINE
ELECTRIC METER	RIGHT-OF-WAY
ELECTRIC BOX	EASEMENT
YARD LIGHT	ADJOINER LINE
GUIDE WIRE	PAVEMENT LINE
TELEPHONE MANHOLE	FIELD LINE
TELEPHONE RISER	PRIVACY FENCE
WATER VALVE	CHAINLINK FENCE
FIRE HYDRANT	SPLIT RAIL FENCE
WATER MANHOLE	DITCH
WATER METER	FIBER OPTIC LINE
GAS VALVE	GAS LINE
GAS METER	TELEPHONE LINE
CABLE TV RISER	WATER LINE
FIBER OPTIC BOX	CABLE TV LINE
CLEANOUT	ELECTRIC LINE
SIGN	OVERHEAD UTILITY LINE
STORM ROUND INLET	TREE LINE
STORM CURB INLET	SANITARY SEWER
RIGHT-OF-WAY MARKER	W/MANHOLE
TREE, BUSH & STUMP	MANHOLE & END SECTION
TEMP. BENCHMARK	

BENCHMARK INFORMATION

ORIGINATING BENCHMARK
 DESIGNATION - X 13
 PID - RA0010
 STATE/COUNTY - IN/MORGAN
 USGS QUAD - MOORESDALE EAST (1980)

VERT ORDER - FIRST CLASS II

DESCRIBED BY COAST AND GEODETIC SURVEY 1946
 1.2 MI N FROM WARELY,
 IN JOHNSON COUNTY, 1.2 MILES NORTH ALONG STATE HIGHWAY 37 FROM
 THE INTERSECTION OF STATE HIGHWAY 144 AT WARELY, MORGAN COUNTY,
 125 YARDS NORTH OF THE MORGAN-JOHNSON COUNTY LINE, 26 FEET WEST
 OF THE CENTERLINE OF THE HIGHWAY, IN LINE WITH THE WEST
 RIGHT-OF-WAY FENCE, 1.5 FEET SOUTH OF A WHITE WOODEN WITNESS
 POST, AND ABOUT 2 FEET HIGHER THAN THE HIGHWAY, A STANDARD IRON
 STAMPED 686.370 X 13 1930 AND SET IN THE TOP OF A CONCRETE POST
 PROJECTING 7 INCHES ABOVE GROUND.

RECOVERY NOTE BY IN DEPT OF NAT RES 1985
 NEW DESC - AT THE INTERSECTION OF NEW STATE ROAD 144 AND OLD STATE
 ROAD 37, IN THE SOUTHWEST QUARTER OF THE INTERSECTION, WITNESS POST
 IS GONE RIGHT-OF-WAY FENCE IS GONE, ALL OTHER INFORMATION APPEARS TO
 BE CORRECT.

ELEVATION = 685.94 (NAVD 88)

TBM #400
 RR SPIKE SET IN E FACE OF PP#P21063 LOCATED ±180' N OF "TRACT
 NORTH DRIVE" ±40' WEST OF "SAINT CHARLES WAY"
 ELEV.=805.77

TBM #401
 RR SPIKE SET IN E FACE OF PP#P21042 LOCATED ±61' W OF "TRACY ST."
 ±40' S OF N PARKING LOT ENTRANCE @ "CLARK PLEASANT EMPLOYEE
 HEALTH & WELLNESS CENTER"
 ELEV.=805.07

TBM #402
 CUT BOX ON TOP OF CONC PEDESTAL FOR UP ON E EDGE OF CONC.
 LOCATED @ NE MOST CORNER OF PARKING LOT FOR "199 US-31 'BIG
 SPLASH CAR WASH"
 ELEV.=806.18

TBM #403
 SE MOST CORNER OF BOTTOM CONC STEP LOCATED @ SE CORNER OF
 "STUDIO 31 SALON" "43 N. US-31" ON E FACE OF BUILDING.
 ELEV.=801.28


TBM #404
 NE CORNER OF TOP CONC STEP CONNECTED TO LEAD WALK @ "239 E MAIN
 ST." LOCATED SE QUAD OF "E MAIN ST." & "TIOCHENR LN."
 ELEV.=799.80

TBM #405
 RR SPIKE SET IN E FACE POWERPOLE, LOCATED ±5' S OF "E MAIN ST." &
 ±XX W OF DRIVE @ "399 E MAIN ST."
 ELEV.=790.98

TBM #406
 SW CORNER OF CONC PORCH @ "49 CENTER ST."
 ELEV.=797.61

TBM #407
 RR SPIKE SET IN S FACE OF PP#P22073, LOCATED ±5' E OF "CENTER
 ST." & ±150' N OF "CLM ST."
 ELEV.=800.07

TBM #408
 RR SPIKE SET IN E FACE OF POWER POLE, LOCATED @ SW CORNER OF
 PROPERTY OF "329 CHRISTINA DR."
 ELEV.=800.89

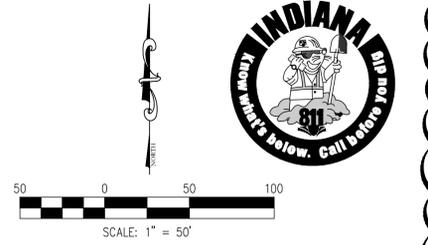

EXISTING UTILITY SIZE AND MATERIAL INFORMATION SHOWN ON THESE PLANS ARE PER THE BEST GRAPHICAL AND VISIBLE INFORMATION AVAILABLE. CONFLICTS MAY EXIST AND IT SHALL BE THE CONTRACTOR'S RESPONSIBILITY TO FIELD VERIFY ALL SIZING AND MATERIAL INFORMATION PROVIDED. IF ACTUAL CONDITIONS DIFFER FROM THAT INFORMATION SHOWN ON THE PLANS, THE CONTRACTOR SHALL, PRIOR TO THE INSTALLATION OF ANY PROPOSED INFRASTRUCTURE, NOTIFY THE DESIGN ENGINEER IMMEDIATELY.

PROPERTY BOUNDARY SHOWN IS PRELIMINARY PENDING COMPLETION OF THE ALTA/NPS LAND TITLE SURVEY BEING PREPARED BY G.W. CHARLES, L.S. WITH CROSSROAD ENGINEERS, P.C.


- ### TOPOGRAPHICAL NOTES
- CONTRACTOR SHALL DISPOSE OF ALL MATERIALS IN ACCORDANCE WITH FEDERAL, STATE, AND LOCAL REGULATIONS.
 - UTILITIES ARE GRAPHICAL REPRESENTATION PER SURVEY AND MAPPING. CONTRACTOR SHALL FIELD VERIFY ALL UTILITIES PRIOR TO CONSTRUCTION.
 - CONTRACTOR SHALL COORDINATE WITH APPLICABLE UTILITY COMPANIES FOR SERVICE DIS-CONNECTIONS AND/OR RELOCATIONS.

FLOODPLAIN INFORMATION

BY GRAPHIC PLOTTING ONLY, THIS TRACT OF LAND DESCRIBED HEREON LIES WITHIN THE UNSHADDED PORTION OF ZONE 'X' (AREAS OUTSIDE THE 0.2% ANNUAL CHANCE FLOODPLAIN), FLOODPLAIN ZONE 'X' (AREAS OF 0.2% ANNUAL CHANCE FLOOD), FLOODPLAIN ZONE 'AE' (AREA OF 1% ANNUAL CHANCE FLOOD WITH ESTABLISHED BASE FLOOD ELEVATIONS), AND FLOODWAY ZONE 'AE' AND IS IN A SPECIAL FLOOD HAZARD AREA AS PLOTTED ON THE FEDERAL EMERGENCY MANAGEMENT AGENCY FLOOD INSURANCE RATE MAP FOR JOHNSON COUNTY, INDIANA, COMMUNITY PANEL NO. 1808010137D, WHICH BEARS AN EFFECTIVE DATE OF 08/02/2007.

- ### UTILITIES
- Note: Listed below are the Indiana Underground Plant Protection Services Contacts; Others not listed may exist.
- SANITARY SEWER**
TOWN OF WHITELAND
SANITATION DEPARTMENT
549 MAIN STREET
WHITELAND, IN 46184
PHONE: (317) 557-2955
EMAIL: SEWERSUPT@WHITELAND.IN.GOV
CONTACT: JESSE JONES
 - TOWN OF NEW WHITELAND**
SANITATION DEPARTMENT
540 TRACY ROAD, SUITE A
NEW WHITELAND, IN 46184
PHONE: (317) 941-3544
EMAIL: MATI.GLOCK@NEWWHITELAND.IN.GOV
CONTACT: MATT GLOCK
 - STORM SEWER**
TOWN OF WHITELAND
DEPARTMENT OF PUBLIC WORKS
549 MAIN STREET
WHITELAND, IN 46184
PHONE: (317) 557-1033
EMAIL: STREETDEPT@WHITELAND.IN.GOV
CONTACT: SHAWN YOUNG
 - GAS**
CENTERPOINT ENERGY
600 INDUSTRIAL DRIVE
FRANKLIN, IN 46131
PHONE: (765) 287-2119
EMAIL: JONATHAN.EASTHAM@CENTERPOINTENERGY.COM
CONTACT: JONATHAN EASTHAM
 - WATER**
TOWN OF WHITELAND
DEPARTMENT OF PUBLIC WORKS
549 MAIN STREET
WHITELAND, IN 46184
PHONE: (317) 557-1033
EMAIL: STREETDEPT@WHITELAND.IN.GOV
CONTACT: SHAWN YOUNG
 - INDIANA AMERICAN WATER COMPANY**
153 N. EMERSON AVENUE
GREENWOOD, IN 46143
PHONE: (317) 209-5837
EMAIL: JONNY.NORRIS@IAMWATER.COM
CONTACT: JONNY NORRIS
 - ELECTRIC**
TOWN OF BARGERSVILLE
24 N. MAIN STREET
BARGERSVILLE, IN 46106
PHONE: (317) 422-5117
EMAIL: KILLINGER@BARGERSVILLE.IN.GOV
CONTACT: KEVIN KILLINGER
 - JOHNSON COUNTY REMC**
750 INTERNATIONAL DRIVE
FRANKLIN, IN 46131
PHONE: (317) 738-7639
EMAIL: JEANS@CREMC.COM
CONTACT: SCOTT JEAN
 - TELECOMMUNICATIONS**
JOHNSON COUNTY REMC FIBER
750 INTERNATIONAL DRIVE
FRANKLIN, IN 46131
PHONE: (317) 797-9786
EMAIL: BENNETTE@CREMC.COM
CONTACT: ERIC BENNETT
 - BRIGHTSPEED**
50 N. JACKSON STREET
FRANKLIN, IN 46131
PHONE: (800) 376-1445
EMAIL: JAMES.WROLLEY@BRIGHTSPEED.COM
CONTACT: JAMES ROLLEY
 - EVERSTREAM**
342 MASSACHUSETTS AVENUE
INDIANAPOLIS, IN 46204
PHONE: (317) 213-3137
EMAIL: MW@EVERSTREAM.NET
CONTACT: MARK PUGH
 - COMCAST**
1600 W. VERNAL PIKE
BLOOMINGTON, IN 47404
PHONE: (812) 360-3090
EMAIL: STEVE.MCARTOR@COMCAST.COM
CONTACT: STEVE MCARTOR
 - METRONET**
3701 COMMUNICATIONS WAY
EVANSVILLE, IN 47715
PHONE: (812) 253-2196
EMAIL: MARK.DECKARD@METRONETINC.COM
CONTACT: MARK DECKARD

NOTE: The underground utilities shown have been located from field survey information and existing drawings. The surveyor makes no guarantee that the underground utilities comprise all such utilities in the area, either in-service or abandoned. The surveyor further does not warrant that the underground utilities shown are in the exact location indicated although the surveyor does certify that they are located as accurately as possible from information available. The surveyor has not physically located the underground utilities.

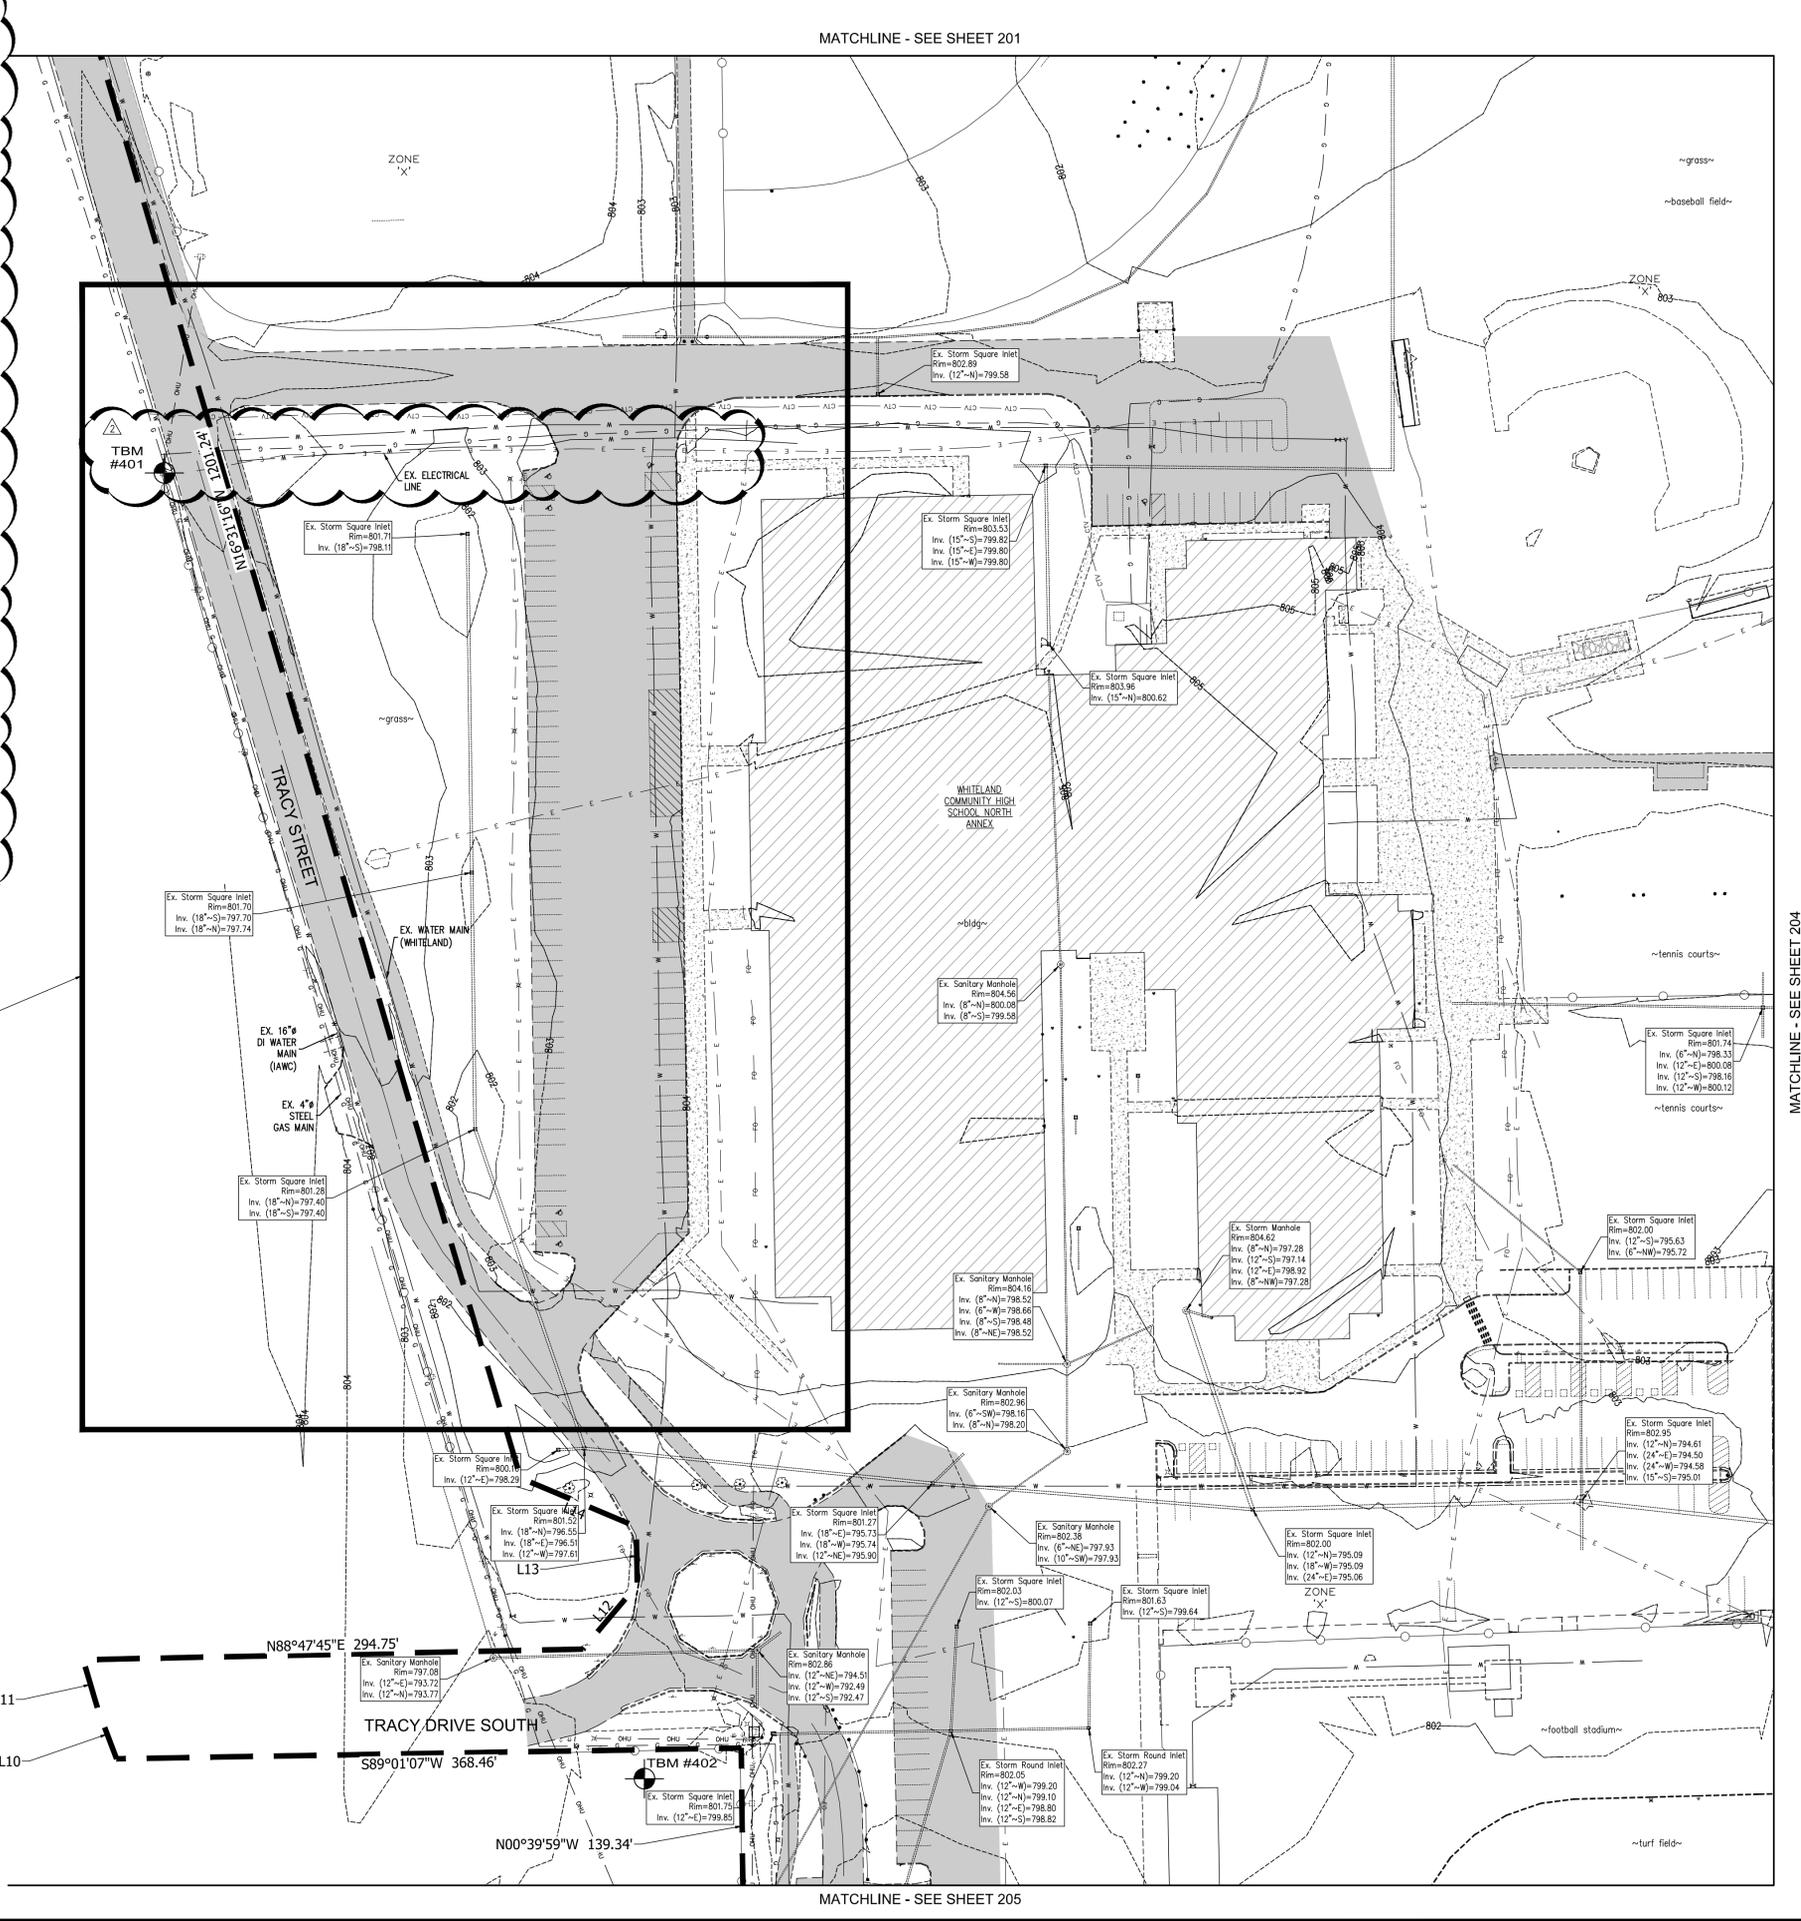


MATCHLINE - SEE SHEET 201

MATCHLINE - SEE SHEET 205

NO.	DATE	REVISIONS	BY	APPR.
2	03.24.23	ADDITION 2-REVISIONS PER TOWN OF WHITELAND TRC COMMENTS, UTILITY FOOTING RESULTS, ADIS STORMTECH REVIEW, & CBRE REVIEW		
3	03.24.23	REVISED BASIN BY RETENTION ELEVATIONS AND OUTLET CONTROL STRUCTURE DETAIL (STR. NO. 12)		
4	03.03.23			

MATCHLINE - SEE SHEET 202

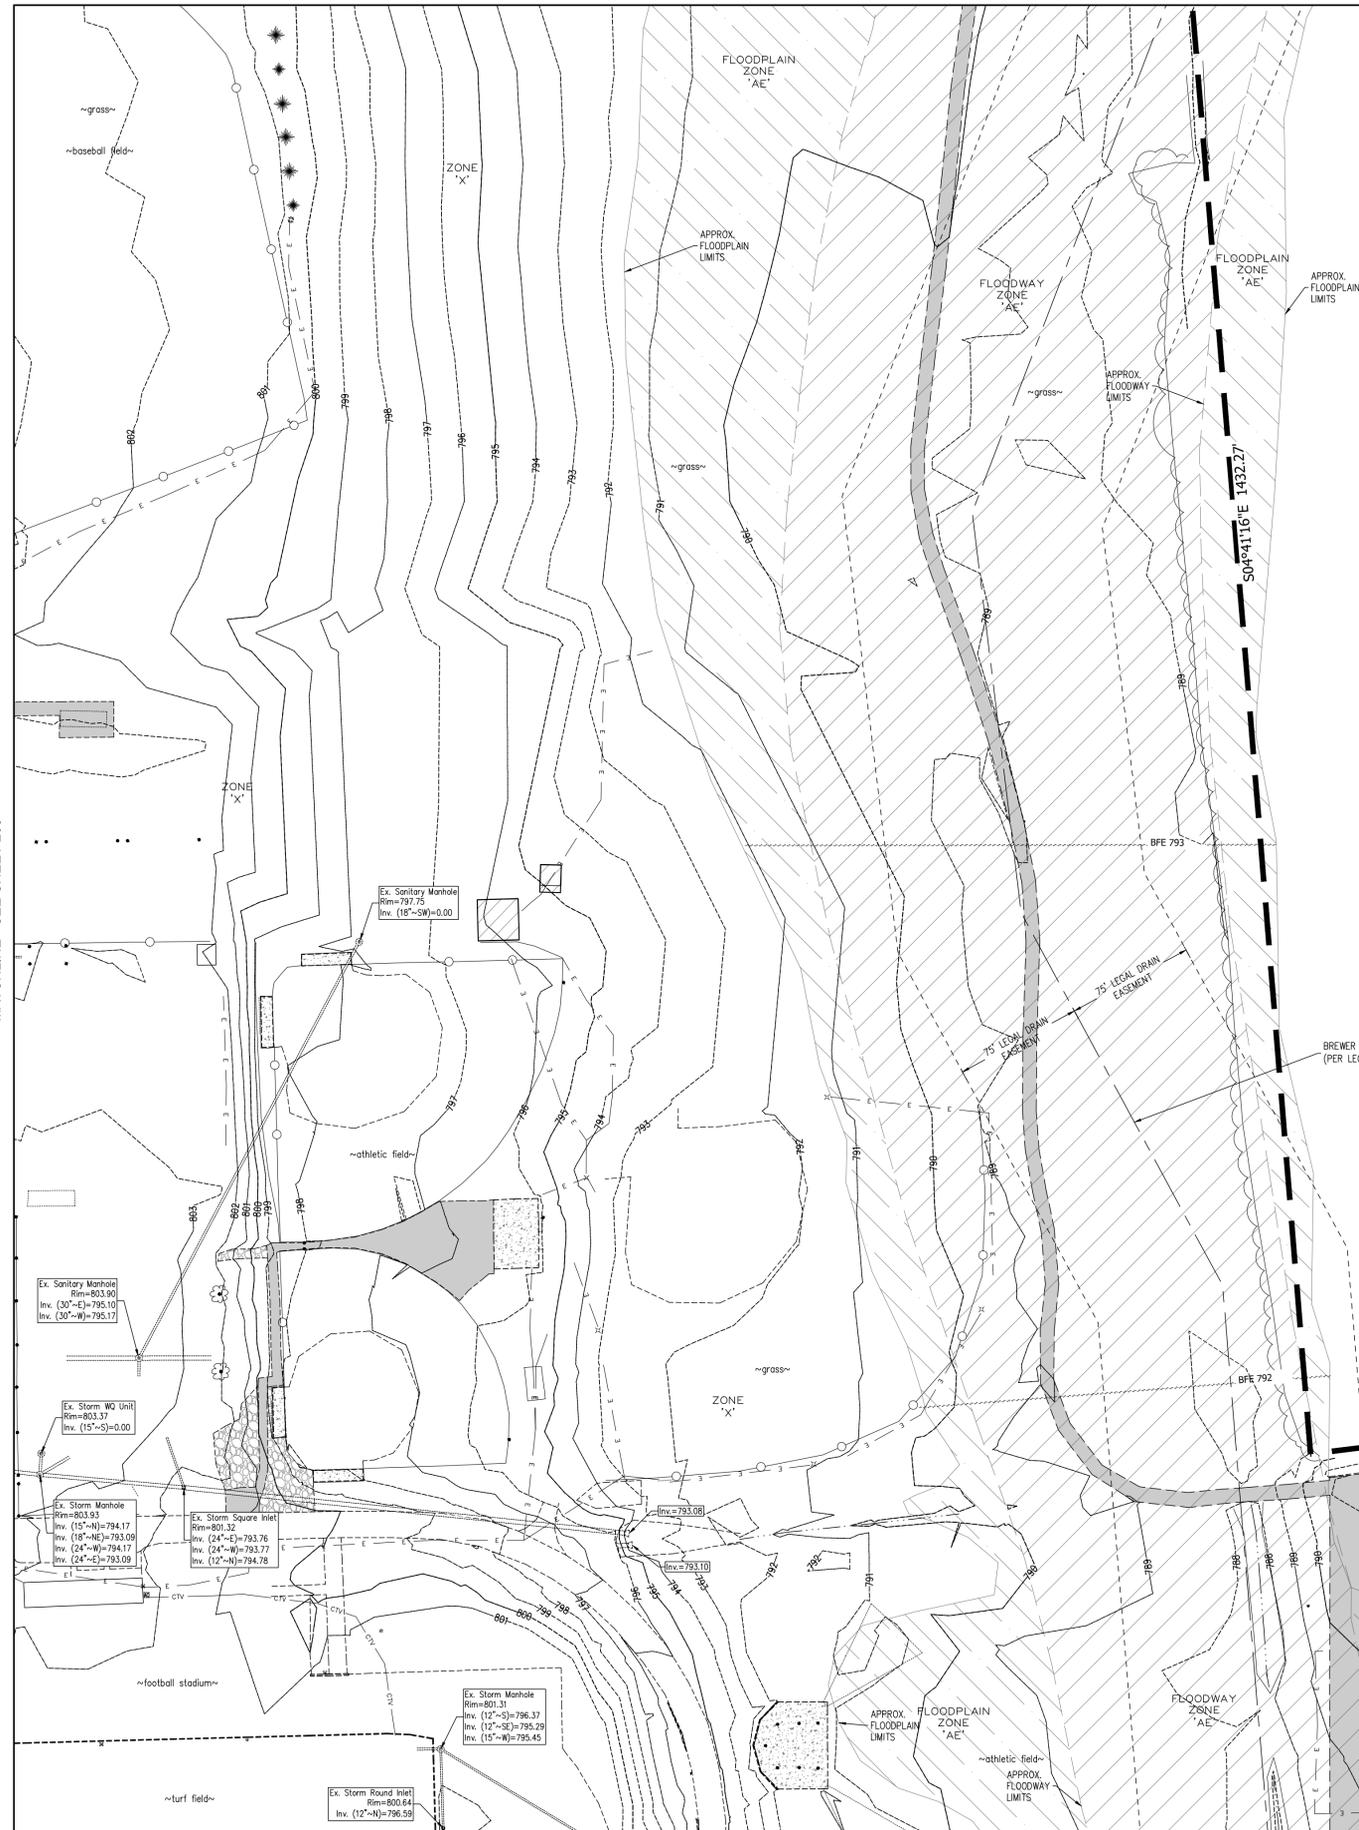

EXISTING LEGEND

POWERPOLE	CONTOURS
POWERPOLE W/LIGHT	PROPERTY LINE
LIGHT POLE	SECTION LINE
ELECTRIC METER	RIGHT-OF-WAY
ELECTRIC BOX	EASEMENT
YARD LIGHT	ADJOINER LINE
GUIDE WIRE	PAVEMENT LINE
TELEPHONE MANHOLE	FIELD LINE
TELEPHONE RISER	PRIVATE FENCE
WATER VALVE	CHAINLINK FENCE
FIRE HYDRANT	SPLIT RAIL FENCE
WATER MANHOLE	DITCH
WATER METER	FIBER OPTIC LINE
GAS VALVE	GAS LINE
GAS METER	TELEPHONE LINE
CABLE TV RISER	WATER LINE
FIBER OPTIC BOX	CABLE TV LINE
CLEANOUT	ELECTRIC LINE
SIGN	OVERHEAD UTILITY LINE
STORM ROUND INLET	TREE LINE
STORM CURB INLET	SANITARY SEWER
RIGHT-OF-WAY MARKER	W/MANHOLE
TREE, BUSH & STUMP	STORM SEWER W/ MANHOLE & END SECTION
TEMP. BENCHMARK	

(D) DEED (M) MEASURE (PS) PLAT SURVEY

ASPHALT BUILDING CONCRETE
 GRAVEL REMOVAL/DEMOLISH

UTILITIES

Note: Listed below are the Indiana Underground Plant Protection Services Contacts; Others not listed may exist.

SANITARY SEWER
 TOWN OF WHITELAND
 SANITATION DEPARTMENT
 549 MAIN STREET
 WHITELAND, IN 46184
 PHONE: (317) 557-2955
 EMAIL: SEWERSUP@WHITELAND.IN.US
 CONTACT: JESSE JONES

TOWN OF NEW WHITELAND
 SANITATION DEPARTMENT
 540 TRACY ROAD, SUITE A
 NEW WHITELAND, IN 46184
 PHONE: (317) 941-3544
 EMAIL: MATT.GILLOCK@NEWWHITELAND.IN.GOV
 CONTACT: MATT GILLOCK

STORM SEWER
 TOWN OF WHITELAND
 DEPARTMENT OF PUBLIC WORKS
 549 MAIN STREET
 WHITELAND, IN 46184
 PHONE: (317) 557-1033
 EMAIL: STREETDEPT@WHITELAND.IN.US
 CONTACT: SHAUN YOUNG

GAS
 CENTERPOINT ENERGY
 600 INDUSTRIAL DRIVE
 FRANKLIN, IN 46131
 PHONE: (765) 287-2119
 EMAIL: JONATHAN.EASTHAM@CENTERPOINTENERGY.COM
 CONTACT: JONATHAN EASTHAM

WATER
 TOWN OF WHITELAND
 DEPARTMENT OF PUBLIC WORKS
 549 MAIN STREET
 WHITELAND, IN 46184
 PHONE: (317) 557-1033
 EMAIL: STREETDEPT@WHITELAND.IN.US
 CONTACT: SHAUN YOUNG

INDIANA AMERICAN WATER COMPANY

TELECOMMUNICATIONS
 JOHNSON COUNTY REMC FIBER
 750 INTERNATIONAL DRIVE
 FRANKLIN, IN 46131
 PHONE: (317) 797-9786
 EMAIL: BENNETTE@CREM.CM
 CONTACT: ERIC BENNETT

BRIGHTSPEED
 50 N. JACKSON STREET
 INDIANAPOLIS, IN 46204
 PHONE: (317) 213-3137
 EMAIL: JAMES.W.ROLLEY@BRIGHTSPEED.COM
 CONTACT: JAMES ROLLEY


EVERSTREAM
 342 MASSACHUSETTS AVENUE
 INDIANAPOLIS, IN 46204
 PHONE: (317) 422-5117
 EMAIL: MPU@EVERSTREAM.NET
 CONTACT: MARK PUGH

ELECTRIC
 TOWN OF BARGERSVILLE
 24 N. MAIN STREET
 BARGERSVILLE, IN 46106
 PHONE: (317) 422-5117
 EMAIL: KYLLINGER@BARGERSVILLE.IN.GOV
 CONTACT: KEVIN KILLINGER

JOHNSON COUNTY REMC
 750 INTERNATIONAL DRIVE
 FRANKLIN, IN 46131
 PHONE: (317) 738-7639
 EMAIL: JEANS@CREM.COM
 CONTACT: SCOTT JEAN

METRONET
 3701 COMMUNICATIONS WAY
 EVANSVILLE, IN 47715
 PHONE: (812) 253-2196
 EMAIL: MARK.DEX@METRONETINC.COM
 CONTACT: MARK DECKARD

NOTE: The underground utilities shown have been located from field survey information and existing drawings. The surveyor makes no guarantees that the underground utilities shown are in the exact location indicated although the surveyor does certify that they are located as accurately as possible from information available. The surveyor has not physically located the underground utilities.

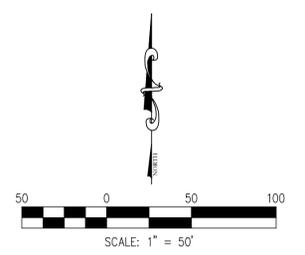

TOPOGRAPHICAL NOTES

- CONTRACTOR SHALL DISPOSE OF ALL MATERIALS IN ACCORDANCE WITH FEDERAL, STATE, AND LOCAL REGULATIONS.
- UTILITIES ARE GRAPHICAL REPRESENTATION PER SURVEY AND MAPPING. CONTRACTOR SHALL FIELD VERIFY ALL UTILITIES PRIOR TO CONSTRUCTION.
- CONTRACTOR SHALL COORDINATE WITH APPLICABLE UTILITY COMPANIES FOR SERVICE DIS-CONNECTIONS AND/OR RELOCATIONS.

FLOODPLAIN INFORMATION

BY GRAPHIC PLOTTING ONLY, THIS TRACT OF LAND DESCRIBED HEREON LIES WITHIN THE UNSHADED PORTION OF ZONE 'X' (AREAS OUTSIDE THE 0.2% ANNUAL CHANCE FLOODPLAIN), FLOODPLAIN ZONE 'X' (AREAS OF 0.2% ANNUAL CHANCE FLOOD), FLOODPLAIN ZONE 'AE' (AREA OF 1% ANNUAL CHANCE FLOOD WITH ESTABLISHED BASE FLOOD ELEVATIONS), AND FLOODWAY ZONE 'AE' AND IS IN A SPECIAL FLOOD HAZARD AREA AS PLOTTED ON THE FEDERAL EMERGENCY MANAGEMENT AGENCY FLOOD INSURANCE RATE MAP FOR JOHNSON COUNTY, INDIANA, COMMUNITY PANEL NO. 18081C0137D, WHICH BEARS AN EFFECTIVE DATE OF 08/02/2007.

BENCHMARK INFORMATION

ORIGINATING BENCHMARK
 DESIGNATION - X 13
 PD = KAD010
 STATE/COUNTY - IN/MORGAN
 QUAD - MOORESVILLE EAST (1980)

VERT ORDER - FIRST CLASS II

DESCRIBED BY COAST AND GEODETIC SURVEY 1946
 1.2 MI W FROM WARELY:
 IN JOHNSON COUNTY, 1.2 MILES NORTH ALONG STATE HIGHWAY 37 FROM THE INTERSECTION OF STATE HIGHWAY 144 AT WARELY, MORGAN COUNTY, 125 YARDS NORTH OF THE MORGAN-JOHNSON COUNTY LINE, 20 FEET WEST OF THE CENTERLINE OF THE HIGHWAY, IN LINE WITH THE WEST RIGHT-OF-WAY FENCE, 1.5 FEET SOUTH OF A WHITE WOODEN WINE POST, AND ABOUT 2 FEET HIGHER THAN THE HIGHWAY, A STANDARD DISK, STAMPED 686.370 X 13 1930 AND SET IN THE TOP OF A CONCRETE POST PROJECTING 7 INCHES ABOVE GROUND.

RECOVERY NOTE BY IN DPT OF NAT RES 1985
 NEW DESC - AT THE INTERSECTION OF NEW STATE ROAD 144 AND OLD STATE ROAD 37, IN THE SOUTHWEST QUARTER OF THE INTERSECTION, WITNESS POST IS ONE RIGHT-OF-WAY FENCE IS ONE, ALL OTHER INFORMATION APPEARS TO BE CORRECT.

ELEVATION = 685.94 (NAVD 88)

TBM #400
 RR SPIKE SET IN E FACE OF PP#P21063" LOCATED ±180' N OF "TRACT NORTH DRIVE" ±40' WEST OF "SAINT CHARLES WAY"
 ELEV.=805.77

TBM #401
 RR SPIKE SET IN E FACE OF PP#P21042" LOCATED ±6' W OF "TRACY ST." ±40' S OF N PARKING LOT ENTRANCE @ "CLARK PLEASANT EMPLOYEE HEALTH & WELLNESS CENTER"
 ELEV.=805.07

TBM #402
 CUT BOX ON TOP OF CONC PEDESTAL FOR UP ON N EDGE OF CONC. LOCATED @ NE MOST CORNER OF PARKING LOT FOR "199 US-31 "BIG SPLASH CAR WASH"
 ELEV.=806.18

TBM #403
 SE MOST CORNER OF BOTTOM CONC STEP LOCATED @ SE CORNER OF "STUDIO 31 SALON" "43 N. US-31" ON E FACE OF BUILDING.
 ELEV.=801.28

TBM #404
 NE CORNER OF TOP CONC STEP CONNECTED TO LEAD WALK @ "239 E MAIN ST." LOCATED SE QUAD OF "E MAIN ST." & "TIOCHENOR LN."
 ELEV.=799.80

TBM #405
 RR SPIKE SET IN E FACE POWERPOLE, LOCATED ±5' S OF "E MAIN ST." & ±XX' W OF DRIVE @ "399 E MAIN ST."
 ELEV.=790.98

TBM #406
 SW CORNER OF CONC PORCH @ "49 CENTER ST."
 ELEV.=797.61

TBM #407
 RR SPIKE SET IN S FACE OF PP# "P222C73". LOCATED ±5' E OF "CENTER ST." & ±150' N OF "CLEM ST."
 ELEV.=800.07

TBM #408
 RR SPIKE SET IN E FACE OF POWER POLE. LOCATED @ SW CORNER OF PROPERTY OF "329 CHRISTINA DR."
 ELEV.=800.89

PROPERTY BOUNDARY SHOWN IS PRELIMINARY PENDING COMPLETION OF THE ALTA/NSPS LAND TITLE SURVEY BEING PREPARED BY G.W. CHARLES, L.S. WITH CROSSROAD ENGINEERS, P.C.

EXISTING UTILITY SIZE AND MATERIAL INFORMATION SHOWN ON THESE PLANS ARE PER THE BEST GRAPHICAL AND VISIBLE INFORMATION AVAILABLE. CONFLICTS MAY EXIST AND IT SHALL BE THE CONTRACTOR'S RESPONSIBILITY TO FIELD VERIFY ALL SIZING AND MATERIAL INFORMATION PROVIDED. IF ACTUAL CONDITIONS DIFFER FROM THAT INFORMATION SHOWN ON THE PLANS, THE CONTRACTOR SHALL PRIOR TO THE INSTALLATION OF ANY PROPOSED INFRASTRUCTURE, NOTIFY THE DESIGN ENGINEER IMMEDIATELY.



DIRECTORY PATH : R:\Adv\Utilities\Bases\Whiteland High School\Design\CAD\Plans\PHASE 1A
 DATE USER : 3/27/2023 9:10 AM / K069

MATCHLINE - SEE SHEET 206

TOPOGRAPHICAL SURVEY

WHITELAND HIGH SCHOOL PHASE 1A

JOB NO.	DRAWN BY	CHECKED BY	TEN	CU
DATE	DESIGNED BY	APPR.		
FEBRUARY 27, 2023				

DATE: FEBRUARY 27, 2023

DESIGNED BY: [Signature]

BY: [Signature]

REVISIONS PER TOWN OF WHITELAND, ITC COMMENTS, UTILITY FOOTING RESULTS, AISC STORMTECH REVIEW, & CBBE REVIEW

ADDITION 2-REVISIONS PER TOWN OF WHITELAND, ITC COMMENTS, UTILITY FOOTING RESULTS, AISC STORMTECH REVIEW, & CBBE REVIEW

REVISIONS PER TOWN OF WHITELAND, ITC COMMENTS, UTILITY FOOTING RESULTS, AISC STORMTECH REVIEW, & CBBE REVIEW

DATE: 03.03.23

SHEET 205

EXISTING LEGEND

POWERPOLE	CONTOURS	
POWERPOLE W/ RISER	PROPERTY LINE	
POWERPOLE W/ LIGHT	SECTION LINE	
LIGHT POLE	RIGHT-OF-WAY	
ELECTRIC METER	EASEMENT	
ELECTRIC BOX	ADJOINER LINE	
YARD LIGHT	PAVEMENT LINE	
GUIDE WIRE	FIELD LINE	
TELEPHONE MANHOLE	PRIVACY FENCE	
TELEPHONE RISER	CHAINLINK FENCE	
WATER VALVE	SPILT RAIL FENCE	
FIRE HYDRANT	DITCH	
WATER MANHOLE	FIBER OPTIC LINE	
WATER METER	GAS LINE	
GAS VALVE	TELEPHONE LINE	
GAS METER	WATER LINE	
CABLE TV RISER	CABLE TV LINE	
FIBER OPTIC BOX	ELECTRIC LINE	
CLEAN	OVERHEAD UTILITY LINE	
STORM ROUND INLET	TREE LINE	
STORM CURB INLET	SANITARY SEWER W/ MANHOLE	
RIGHT-OF-WAY MARKER	MANHOLE & END SECTION	
TREE, BUSH & STUMP		
TEMP. BENCHMARK		
(D) DEED (M) MEASURE (PS) PLAT SURVEY		
ASPHALT	BUILDING	CONCRETE
GRAVE	REMOVAL/DEMOLISH	

BENCHMARK INFORMATION

ORIGINATING BENCHMARK
 DESIGNATION - X 13
 PID - KA0010
 STATE/COUNTY - IN/MORGAN
 USGS QUAD - MOORESVILLE EAST (1980)
 VERT ORDER - FIRST CLASS II
 DESCRIBED BY COAST AND GEODETIC SURVEY 1946
 1.2 MI N FROM MAVERLY
 IN JOHNSON COUNTY, 1.2 MILES NORTH ALONG STATE HIGHWAY 37 FROM THE INTERSECTION OF STATE HIGHWAY 144 AT MAVERLY, JOHNSON COUNTY, 125 YARDS NORTH OF THE MORGAN-JOHNSON COUNTY LINE, 26 FEET WEST OF THE CENTERLINE OF THE HIGHWAY, IN LINE WITH THE WEST RIGHT-OF-WAY FENCE, 15 FEET SOUTH OF A WHITE WOODEN WITNESS POST, AND ABOUT 2 FEET HIGHER THAN THE HIGHWAY. A STANDARD DISK, STAMPED 686.370 ± 13.1300 AND SET IN THE TOP OF A CONCRETE POST PROJECTING 7 INCHES ABOVE GROUND.
 RECOVERY NOTE BY IN DEPT OF NAT RES 1985
 NEW DES - AT THE INTERSECTION OF NEW STATE ROAD 144 AND OLD STATE ROAD 37, IN THE SOUTHWEST QUARTER OF THE INTERSECTION, WITNESS POST IS ONE RIGHT-OF-WAY FENCE IS GONE. ALL OTHER INFORMATION APPEARS TO BE CORRECT.
 ELEVATION = 685.94 (NAVD 88)

- TBM #400**
RR SPIKE SET IN E FACE OF PPA#P21063 LOCATED #180' N OF "TRACT NORTH DRIVE" 440' WEST OF "SAINT CHARLES WAY"
ELEV.=805.77
- TBM #401**
RR SPIKE SET IN E FACE OF PPA#P21042 LOCATED #6' W OF "TRACY ST." #40' S OF N PARKING LOT ENTRANCE @ "CLARK PLEASANT EMPLOYEE HEALTH & WELLNESS CENTER"
ELEV.=805.07
- TBM #402**
CUT BOX ON TOP OF CONC PEDESTAL FOR UP ON N EDGE OF CONC. LOCATED @ NE MOST CORNER OF PARKING LOT FOR "189 US-31" "BIG SPLASH CAR WASH"
ELEV.=806.18
- TBM #403**
SE MOST CORNER OF BOTTOM CONC STEP LOCATED @ SE CORNER OF "STUDIO 31 SALON" 43 N. US-31 ON E FACE OF BUILDING.
ELEV.=801.28
- TBM #404**
NE CORNER OF TOP CONC STEP CONNECTED TO LEAD WALK @ "239 E MAIN ST." LOCATED SE QUAD OF "E MAIN ST." & "TICHENOR LN."
ELEV.=799.80
- TBM #405**
RR SPIKE SET IN E FACE POWERPOLE LOCATED #5' S OF "E MAIN ST." & #XX W OF DRIVE @ "399 E MAIN ST."
ELEV.=790.98
- TBM #406**
SW CORNER OF CONC PORCH @ "49 CENTER ST."
ELEV.=797.61
- TBM #407**
RR SPIKE SET IN S FACE OF PPA# "P22233", LOCATED #5' E OF "CENTER ST." & #150' N OF "CLEM ST."
ELEV.=800.07
- TBM #408**
RR SPIKE SET IN E FACE OF POWER POLE. LOCATED @ SW CORNER OF PROPERTY OF "329 CHRISTINA DR."
ELEV.=800.89

TOPOGRAPHICAL NOTES


- CONTRACTOR SHALL DISPOSE OF ALL MATERIALS IN ACCORDANCE WITH FEDERAL, STATE, AND LOCAL REGULATIONS.
- UTILITIES ARE GRAPHICAL REPRESENTATION PER SURVEY AND MAPPING. CONTRACTOR SHALL FIELD VERIFY ALL UTILITIES PRIOR TO CONSTRUCTION.
- CONTRACTOR SHALL COORDINATE WITH APPLICABLE UTILITY COMPANIES FOR SERVICE DIS-CONNECTIONS AND/OR RELOCATIONS.

FLOODPLAIN INFORMATION

BY GRAPHIC PLOTTING ONLY, THIS TRACT OF LAND DESCRIBED HEREON LIES WITHIN THE UNSHADED PORTION OF ZONE 'X' (AREAS OUTSIDE THE 0.2% ANNUAL CHANCE FLOODPLAIN, FLOODPLAIN ZONE 'X' (AREAS OF 0.2% ANNUAL CHANCE FLOOD), FLOODPLAIN ZONE 'AE' (AREA OF 1% ANNUAL CHANCE FLOOD WITH ESTABLISHED BASE FLOOD ELEVATIONS), AND FLOODWAY ZONE 'AE' AND IS IN A SPECIAL FLOOD HAZARD AREA AS PLOTTED ON THE FEDERAL EMERGENCY MANAGEMENT AGENCY FLOOD INSURANCE RATE MAP FOR JOHNSON COUNTY, INDIANA, COMMUNITY PANEL NO. 1808101370, WHICH BEARS AN EFFECTIVE DATE OF 08/02/2007.

- ### UTILITIES
- Note: Listed below are the Indiana Underground Plant Protection Services Contacts; Others not listed may exist.
- | SANITARY SEWER | WATER | TELECOMMUNICATIONS |
|---|---|--|
| TOWN OF WHITELAND
SANITATION DEPARTMENT
549 MAIN STREET
WHITELAND, IN 46184
PHONE: (317) 557-2965
EMAIL: SEWERSUP@WHITELAND.IN.US
CONTACT: JESSE JONES | TOWN OF WHITELAND
DEPARTMENT OF PUBLIC WORKS
549 MAIN STREET
WHITELAND, IN 46184
PHONE: (317) 557-1033
EMAIL: STREETDEPT@WHITELAND.IN.US
CONTACT: SHAWN YOUNG | JOHNSON COUNTY REMC FIBER
750 INTERNATIONAL DRIVE
FRANKLIN, IN 46131
PHONE: (317) 797-9786
EMAIL: BENNETT@REMCFIBER.COM
CONTACT: ERIC BENNETT |
| STORM SEWER | INDIANA AMERICAN WATER COMPANY | BRIGHTSPEED |
| TOWN OF WHITELAND
DEPARTMENT OF PUBLIC WORKS
549 MAIN STREET
WHITELAND, IN 46184
PHONE: (317) 557-1033
EMAIL: STREETDEPT@WHITELAND.IN.US
CONTACT: SHAWN YOUNG | 153 N. EMERSON AVENUE
GREENWOOD, IN 46143
PHONE: (317) 209-5837
EMAIL: JONNY.NORRIS@IAMWATER.COM
CONTACT: JONNY NORRIS | 342 MASSACHUSETTS AVENUE
INDIANAPOLIS, IN 46204
PHONE: (317) 213-3137
EMAIL: MPO@BRIGHTSPEED.NET
CONTACT: MARK PUGH |
| GAS | EVEREST | COMCAST |
| CENTERPOINT ENERGY
600 INDUSTRIAL DRIVE
FRANKLIN, IN 46131
PHONE: (765) 287-2119
EMAIL: JONATHAN.EASTHAM@CENTERPOINTENERGY.COM
CONTACT: JONATHAN EASTHAM | 750 INTERNATIONAL DRIVE
FRANKLIN, IN 46131
PHONE: (317) 738-7639
EMAIL: JEANS@CREM.COM
CONTACT: SCOTT JEAN | 1600 N. VERNAL PIKE
BLOOMINGTON, IN 47404
PHONE: (812) 360-3090
EMAIL: STEVE.MCARTOR@COMCAST.COM
CONTACT: STEVE MCARTOR |
| METRON | METRON | METRON |
| 3703 COMMUNICATIONS WAY
EVANSVILLE, IN 47715
PHONE: (812) 253-2196
EMAIL: MARK.DECKARD@METRONET.COM

NOTICE: The underground utilities shown have been located from field survey information and existing drawings. The surveyor makes no guarantee that the underground utilities comprise all such utilities in the area either in-service or abandoned. The surveyor further does not warrant that the underground utilities shown are in the exact location indicated although the surveyor does certify that they are located as accurately as possible from information available. The surveyor has not physically located the underground utilities.

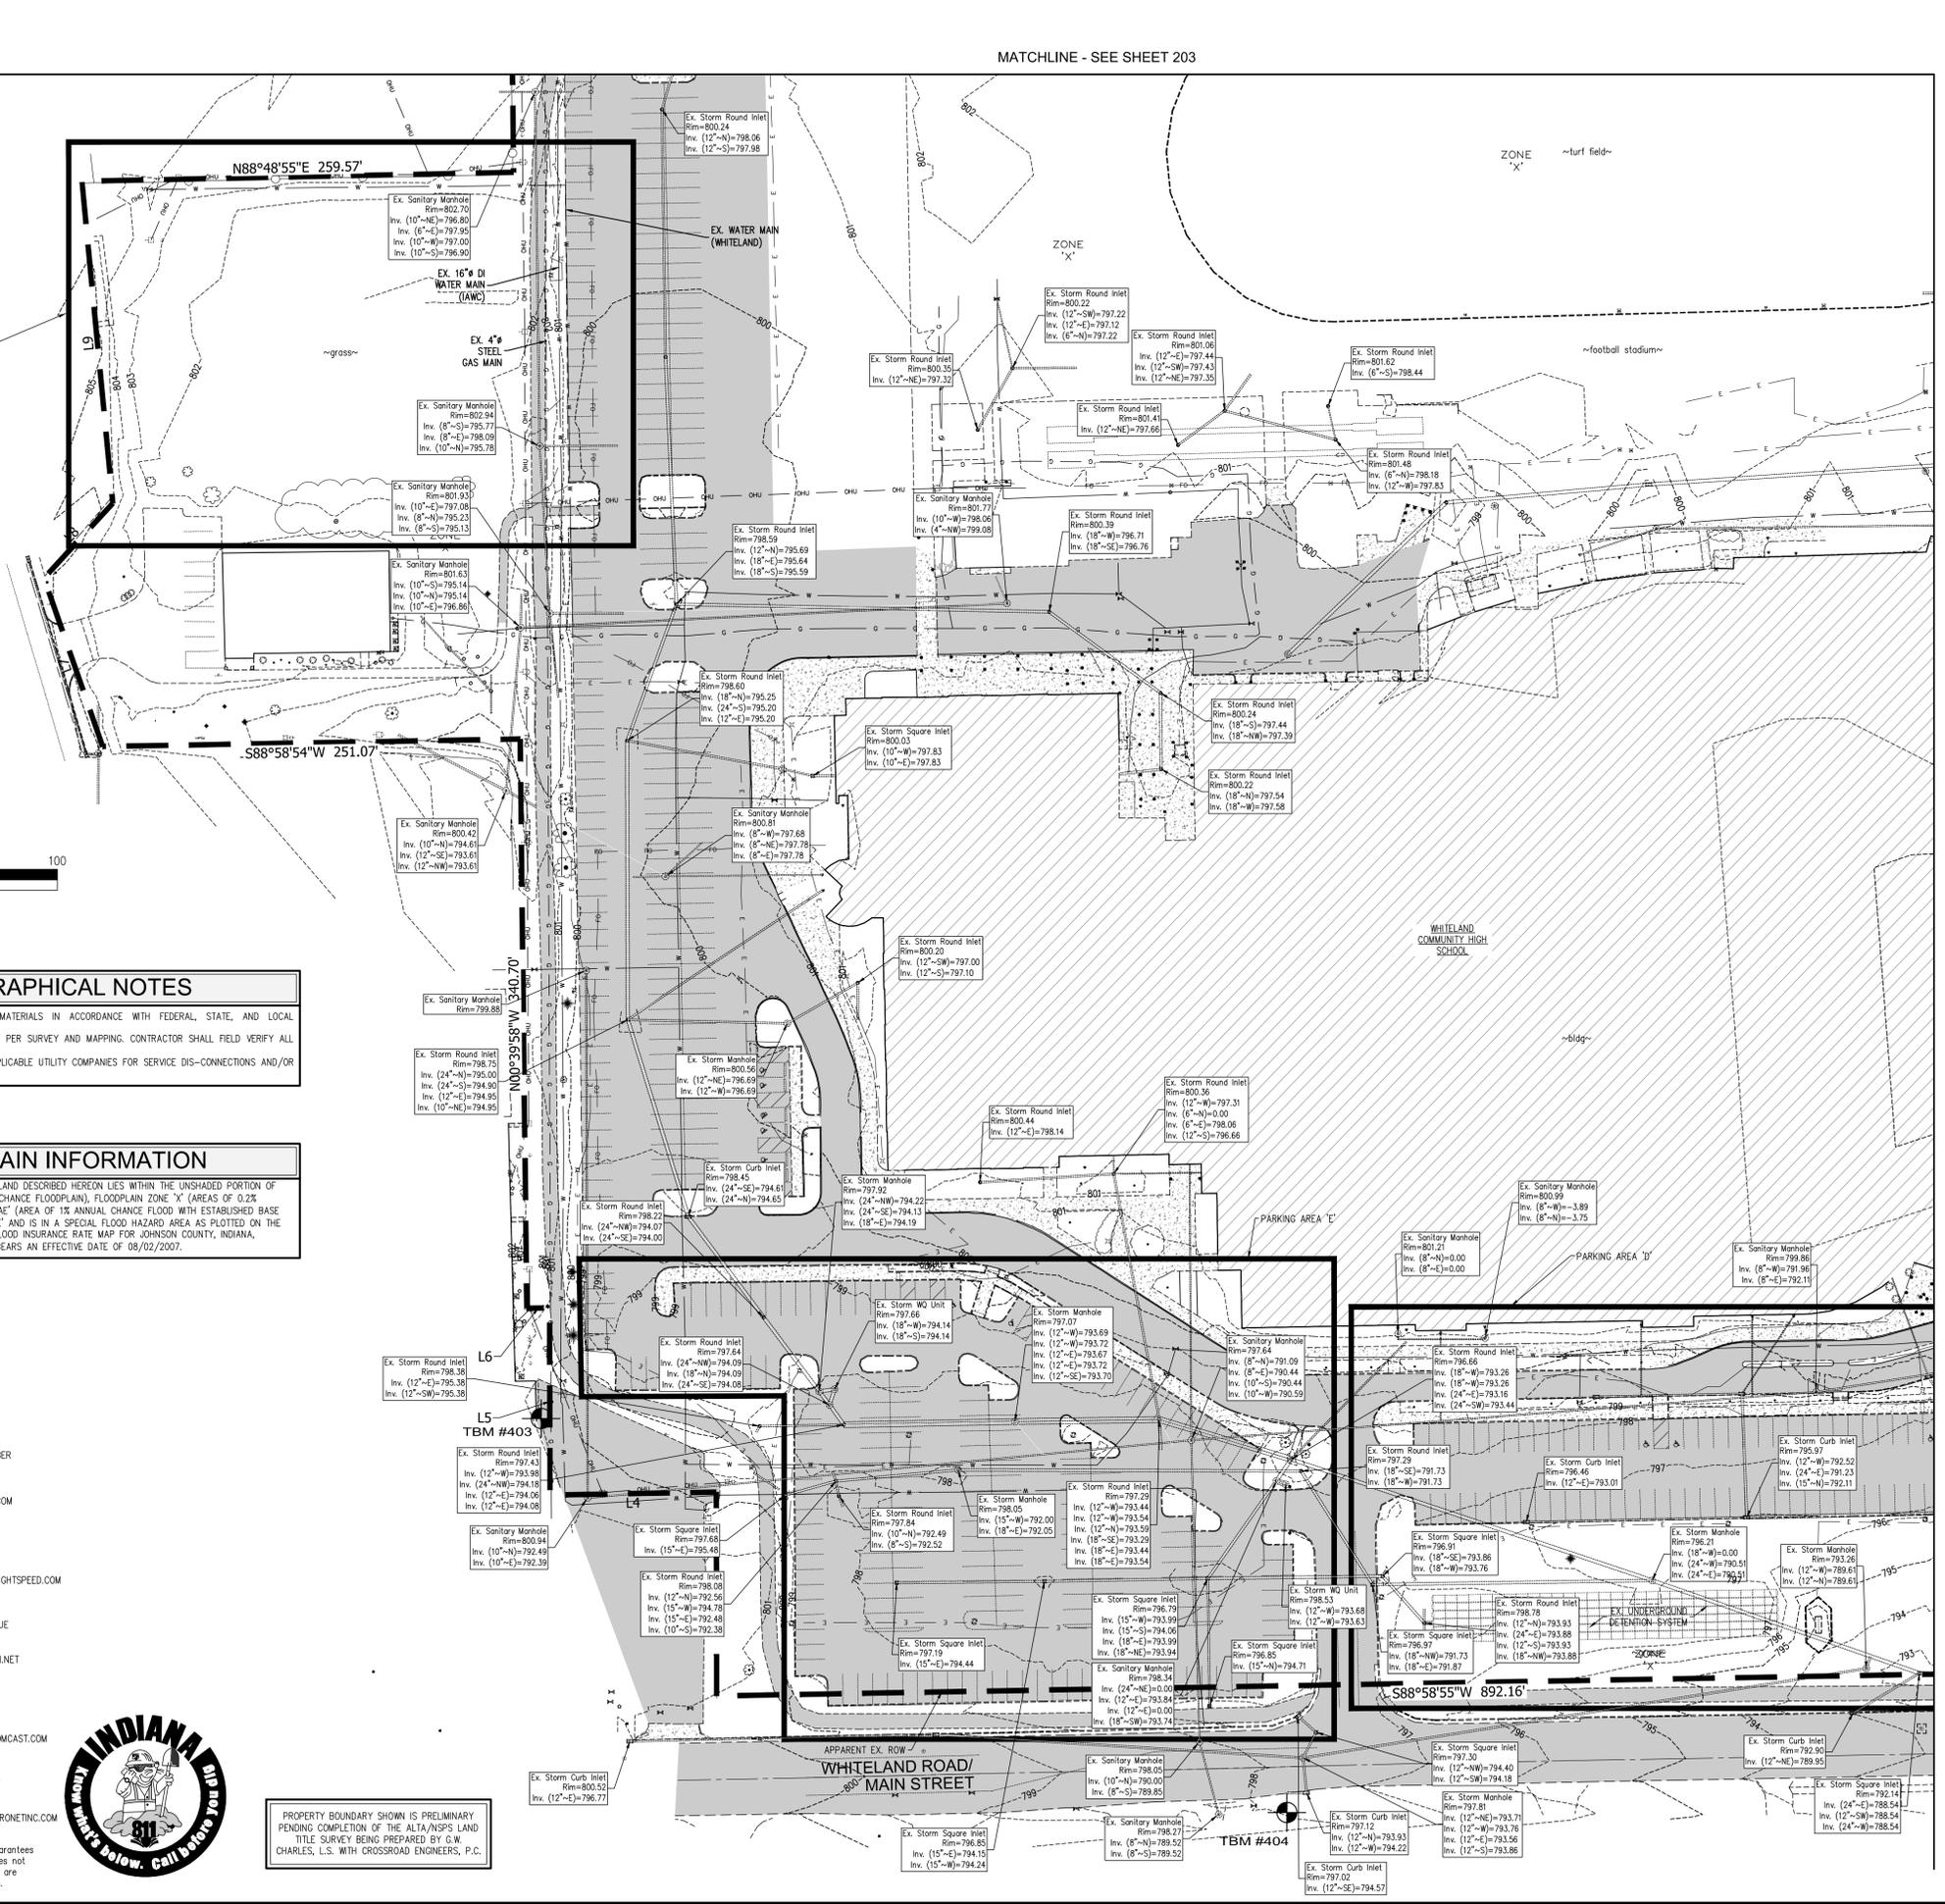

PROPERTY BOUNDARY SHOWN IS PRELIMINARY PENDING COMPLETION OF THE ALTA/SUPPLEMENTAL TITLE SURVEY BEING PREPARED BY P.C. CHARLES, L.S. WITH CROSSROAD ENGINEERS, P.C.

MATCHLINE - SEE SHEET 203

MATCHLINE - SEE SHEET 206

BENCHMARK INFORMATION

ORIGINATING BENCHMARK
DESIGNATION - X 13
PID - KA0010
STATE/COUNTY - IN/MORGAN
USGS QUAD - MOOREVILLE EAST (1980)
VERT ORDER - FIRST CLASS II
DESCRIBED BY COAST AND GEODETIC SURVEY 1944
1.2 MI N FROM WARELY
IN JOHNSON COUNTY, 1.2 MILES NORTH ALONG STATE HIGHWAY 37 FROM THE INTERSECTION OF STATE HIGHWAY 144 AT WARELY, MORGAN COUNTY, 125 YARDS NORTH OF THE MORGAN-JOHNSON COUNTY LINE, 28 FEET WEST OF THE CENTERLINE OF THE HIGHWAY, IN LINE WITH THE WEST RIGHT-OF-WAY FENCE, 1.5 FEET SOUTH OF A WHITE WOODEN WITNESS POST AND ABOUT 2 FEET HIGHER THAN THE HIGHWAY A STANDARD BOK, STAMPED 686.370 X 13 1930 AND SET IN THE TOP OF A CONCRETE POST PROJECTING 7 INCHES ABOVE GROUND.
RECOVERY NOTE BY IN DEPT OF NAT RES 1985
NEW BENCH - AT THE INTERSECTION OF NEW STATE ROAD 144 AND OLD STATE ROAD 37, IN THE SOUTHWEST QUARTER OF THE INTERSECTION, WITNESS POST IS GONE RIGHT-OF-WAY FENCE IS GONE, ALL OTHER INFORMATION APPEARS TO BE CORRECT.
ELEVATION = 685.94 (NAVD 88)
TBM #400
RR SPIKE SET IN E FACE OF PP#P21063 LOCATED 1180' N OF TRACT NORTH DRIVE ±40' WEST OF 'SAINT CHARLES WAY' ELEV.=805.77
TBM #401
RR SPIKE SET IN E FACE OF PP#P21042 LOCATED ±16' W OF 'TRACY ST.' ±40' S OF N PARKING LOT ENTRANCE @ 'CLARK PLEASANT EMPLOYEE HEALTH & WELLNESS CENTER' ELEV.=805.07
TBM #402
OUT BOX ON TOP OF CONC PEDESTAL FOR UP ON N EDGE OF CONC. LOCATED @ NE MOST CORNER OF PARKING LOT FOR '199 US-31 'BIG SPLASH CAR WASH' ELEV.=806.18
TBM #403
SE MOST CORNER OF BOTTOM CONC STEP LOCATED @ SE CORNER OF 'STUDIO 31 SALON' 43 N. US-31' ON E FACE OF BUILDING. ELEV.=801.28
TBM #404
NE CORNER OF TOP CONC STEP CONNECTED TO LEAD WALK @ '239 E MAIN ST.' LOCATED SE QUAD OF 'E MAIN ST.' & 'TICHENOR LN.' ELEV.=799.80
TBM #405
RR SPIKE SET IN E FACE POWERPOLE, LOCATED ±5' S OF 'E MAIN ST.' & ±2X W OF DRIVE @ '399 E MAIN ST.' ELEV.=790.98
TBM #406
SW CORNER OF CONC PORCH @ '49 CENTER ST.' ELEV.=797.61
TBM #407
RR SPIKE SET IN S FACE OF PP#P22073, LOCATED ±5' E OF 'CENTER ST.' & ±150' N OF 'OLEM ST.' ELEV.=800.07
TBM #408
RR SPIKE SET IN E FACE OF POWER POLE, LOCATED @ SW CORNER OF PROPERTY OF '329 CHRISTINA DR.' ELEV.=800.89



PROPERTY BOUNDARY SHOWN IS PRELIMINARY PENDING COMPLETION OF THE ALTA/NPS/LAND TITLE SURVEY BEING PREPARED BY C.W. CHARLES, L.S. WITH CROSSROAD ENGINEERS, P.C.

EXISTING LEGEND

Legend table listing symbols for utilities (power pole, electric meter, gas valve, etc.), floodplains (Zone X, Zone AE), and other features (contours, property lines, etc.).

UTILITIES

Note: Listed below are the Indiana Underground Plant Protection Services Contacts; Others not listed may exist.

- Sanitary Sewer: TOWN OF WHITELAND, SANITATION DEPARTMENT, 549 MAIN STREET, WHITELAND, IN 46184.
Water: TOWN OF WHITELAND, DEPARTMENT OF PUBLIC WORKS, 549 MAIN STREET, WHITELAND, IN 46184.
Telecommunications: JOHNSON COUNTY REMC, 750 INTERNATIONAL DRIVE, FRANKLIN, IN 46131.
Brightspeed: 50 N. JACKSON STREET, FRANKLIN, IN 46133.
Electric: BARGERSVILLE, 24 N. MAIN STREET, BARGERSVILLE, IN 46106.
Comcast: 1600 W. VERNAL PIKE, BLOOMINGTON, IN 47404.
Metronet: 3701 COMMUNICATIONS WAY, EVANSVILLE, IN 47715.

NOTE: The underground utilities shown have been located from field survey information and existing drawings. The surveyor makes no guarantee that the underground utilities comprise all such utilities in the area, either in-service or abandoned. The surveyor further does not warrant that the underground utilities shown are in the exact location indicated although the surveyor does certify that they are located as accurately as possible from information available. The surveyor has not physically located the underground utilities.

TOPOGRAPHICAL NOTES

- 1. CONTRACTOR SHALL DISPOSE OF ALL MATERIALS IN ACCORDANCE WITH FEDERAL, STATE, AND LOCAL REGULATIONS.
2. UTILITIES ARE GRAPHICAL REPRESENTATION PER SURVEY AND MAPPING. CONTRACTOR SHALL FIELD VERIFY ALL UTILITIES PRIOR TO CONSTRUCTION.
3. CONTRACTOR SHALL COORDINATE WITH APPLICABLE UTILITY COMPANIES FOR SERVICE DIS-CONNECTIONS AND/OR RELOCATIONS.

FLOODPLAIN INFORMATION

BY GRAPHIC PLOTTING ONLY, THIS TRACT OF LAND DESCRIBED HEREON LIES WITHIN THE UNSHADED PORTION OF ZONE 'X' (AREAS OUTSIDE THE 0.2% ANNUAL CHANCE FLOODPLAIN), FLOODPLAIN ZONE 'X' (AREAS OF 0.2% ANNUAL CHANCE FLOOD), FLOODPLAIN ZONE 'AE' (AREA OF 1% ANNUAL CHANCE FLOOD WITH ESTABLISHED BASE FLOOD ELEVATIONS), AND FLOODWAY ZONE 'AE' AND IS IN A SPECIAL FLOOD HAZARD AREA AS PLOTTED ON THE FEDERAL EMERGENCY MANAGEMENT AGENCY FLOOD INSURANCE RATE MAP FOR JOHNSON COUNTY, INDIANA, COMMUNITY PANEL NO. 18081C01370, WHICH BEARS AN EFFECTIVE DATE OF 08/02/2007.

EXISTING UTILITY SIZE AND MATERIAL INFORMATION SHOWN ON THESE PLANS ARE PER THE BEST GRAPHICAL AND VISIBLE INFORMATION AVAILABLE. CONFLICTS MAY EXIST AND IT SHALL BE THE CONTRACTOR'S RESPONSIBILITY TO FIELD VERIFY ALL SIZING AND MATERIAL INFORMATION PROVIDED. IF ACTUAL CONDITIONS DIFFER FROM THAT INFORMATION SHOWN ON THE PLANS, THE CONTRACTOR SHALL, PRIOR TO THE INSTALLATION OF ANY PROPOSED INFRASTRUCTURE, NOTIFY THE DESIGN ENGINEER IMMEDIATELY.



TOPOGRAPHICAL SURVEY
WHITELAND HIGH SCHOOL PHASE 1A



Table with columns for Job No., Date, Checked, Drawn, KLF, DMS, DESIGNED, APPR., and SHEET. Includes revision notes and dates.

DIRECTORY PATH: R:\Adv\Utilities\esb\esb\Whiteland High School\Design\CAD\Plans\PHASE 1A
DATE/USER: 3/23/2023 9:33 AM / K.069

MATCHLINE - SEE SHEET 205





NO.	DATE	REVISIONS	BY	APPR.
1	03.24.23	ADDITION 2-REVISIONS PER TOWN OF WHITELAND TRC COMMENTS: UTILITY FLOODING RESULTS, ADS STORMTECH REVIEW, & CBBE REVIEW		
2	03.24.23	REVISED BASIN BY RETENTION ELEVATIONS AND OUTLET CONTROL STRUCTURE DETAIL (SHEET NO. 12)		
3	03.03.23			
4				
5				
6				
7				
8				
9				

EXISTING LEGEND

POWERPOLE W/RISER	CONTOURS
POWERPOLE W/LIGHT	PROPERTY LINE
LIGHT POLE	SECTION LINE
ELECTRIC METER	RIGHT-OF-WAY
ELECTRIC BOX	EASEMENT
YARD LIGHT	ADJONER LINE
GUIDE WIRE	PAVEMENT LINE
TELEPHONE MANHOLE	FIELD LINE
TELEPHONE RISER	PRIVACY FENCE
WATER VALVE	CHAINLINK FENCE
FIRE HYDRANT	SPLIT RAIL FENCE
WATER MANHOLE	DITCH
WATER METER	FIBER OPTIC LINE
GAS VALVE	GAS LINE
GAS METER	TELEPHONE LINE
CABLE TV RISER	WATER LINE
FIBER OPTIC BOX	CABLE TV LINE
CLEANOUT	ELECTRIC LINE
STORM ROUND INLET	OVERHEAD UTILITY LINE
STORM CURB INLET	TREE LINE
RIGHT-OF-WAY MARKER	SANITARY SEWER W/MANHOLE
TEMP. BENCHMARK	STORM SEWER W/MANHOLE & END SECTION
SAWOUT	(D) DEED (M) MEASURE (PS) PLAT SURVEY
	ASPHALT
	GRAVEL
	BUILDING
	CONCRETE
	REMOVAL/DEMOLISH

BENCHMARK INFORMATION

ORIGINATING BENCHMARK
 DESIGNATION - X 13
 FID - K40010
 STATE/COUNTY - IN/MORGAN
 USGS QUAD - MOOREVILLE EAST (1880)
 VERT ORDER - FIRST CLASS II
 DESCRIBED BY COAST AND GEODETIC SURVEY 1946
 12.24 M FROM WATER'S EDGE
 IN JOHNSON COUNTY, 12 MILES NORTH ALONG STATE HIGHWAY 37 FROM THE INTERSECTION OF STATE HIGHWAY 144 AT WARDEN, MORGAN COUNTY, 125 YARDS NORTH OF THE MORGAN-JOHNSON COUNTY LINE, 26 FEET WEST OF THE CENTERLINE OF THE HIGHWAY, IN LINE WITH THE WEST RIGHT-OF-WAY FENCE, 1.5 FEET SOUTH OF A WHITE WOODEN WINDMILL POST, AND ABOUT 2 FEET HIGHER THAN THE HIGHWAY, A STANDARD DISK, STAMPED 686.370 X 13 1930 AND SET IN THE TOP OF A CONCRETE POST PROJECTING 7 INCHES ABOVE GROUND.
 RECOVERY NOTE BY IN DEPT OF NAT RES 1985
 NEW DISK: AT THE INTERSECTION OF NEW STATE ROAD 144 AND OLD STATE ROAD 37, IN THE SOUTHWEST QUARTER OF THE INTERSECTION, WINDMILL POST IS GONE. RIGHT-OF-WAY FENCE IS GONE, ALL OTHER INFORMATION APPEARS TO BE CORRECT.
 ELEVATION = 685.94 (NAVD 88)

TBM #400
 RR SPIKE SET IN E FACE OF PP#P21063, LOCATED ±180' N OF "TRACT NORTH DRIVE" ±40' WEST OF "SAINT CHARLES WAY"
 ELEV.=805.77

TBM #401
 RR SPIKE SET IN E FACE OF PP#P21042, LOCATED 46' W OF "TRACY ST." ±40' S OF N PARKING LOT ENTRANCE @ "CLARK PLEASANT EMPLOYEE HEALTH & WELLNESS CENTER"
 ELEV.=805.07

TBM #402
 CUT BOX ON TOP OF CONC PEDESTAL FOR UP ON N EDGE OF CONC. LOCATED @ NE MOST CORNER OF PARKING LOT FOR "199 US-31" "BIG SPLASH CAR WASH"
 ELEV.=806.19

TBM #403
 SE MOST CORNER OF BOTTOM CONC STEP LOCATED @ SE CORNER OF "STUDIO 31 SALON" "43 N. US-31" ON E FACE OF BUILDING.
 ELEV.=801.28

TBM #404
 NE CORNER OF TOP CONC STEP CONNECTED TO LEAD WALK @ "239 E MAIN ST." LOCATED SE QUAD OF "E MAIN ST." & "TICHENOR LN."
 ELEV.=799.80

TBM #405
 RR SPIKE SET IN E FACE POWERPOLE, LOCATED ±5' S OF "E MAIN ST." & ±XX W OF DRIVE @ "399 E MAIN ST."
 ELEV.=790.98

TBM #406
 SW CORNER OF CONC PORCH @ "49 CENTER ST."
 ELEV.=797.61


TBM #407
 RR SPIKE SET IN S FACE OF PP#P22273, LOCATED ±5' E OF "CENTER ST." & ±150' N OF "CLEM ST."
 ELEV.=800.07

TBM #408
 RR SPIKE SET IN E FACE OF POWER POLE, LOCATED @ SW CORNER OF PROPERTY OF "329 CHRISTINA DR."
 ELEV.=800.89

UTILITIES

Note: Listed below are the Indiana Underground Plant Protection Services Contacts; Others not listed may exist.

SANITARY SEWER TOWN OF WHITELAND SANITATION DEPARTMENT 549 MAIN STREET WHITELAND, IN 46184 PHONE: (317) 557-2955 EMAIL: SEWERSUP@WHITELAND.IN.GOV CONTACT: JESSE JONES	WATER TOWN OF WHITELAND DEPARTMENT OF PUBLIC WORKS 549 MAIN STREET WHITELAND, IN 46184 PHONE: (317) 557-1033 EMAIL: STREETDEPT@WHITELAND.IN.GOV CONTACT: SHAWN YOUNG	TELECOMMUNICATIONS JOHNSON COUNTY REMC FIBER 750 INTERNATIONAL DRIVE FRANKLIN, IN 46131 PHONE: (317) 797-8786 EMAIL: BENNETT@CREM.COM CONTACT: ERIC BENNETT
TOWN OF NEW WHITELAND SANITATION DEPARTMENT 540 TRACY ROAD, SUITE A NEW WHITELAND, IN 46184 PHONE: (317) 941-3544 EMAIL: MATT.GILLOCK@NEWWHITELAND.IN.GOV CONTACT: MATT GILLOCK	INDIANA AMERICAN WATER COMPANY 153 N. EMERSON AVENUE GREENWOOD, IN 46143 PHONE: (317) 209-5837 EMAIL: JONNY.NORRIS@IAMWATER.COM CONTACT: JONNY NORRIS	BRIGHTSPEED 50 N. JACKSON STREET FRANKLIN, IN 46131 PHONE: (980) 376-1445 EMAIL: MURPHY@BRIGHTSPEED.COM CONTACT: JAMES ROLLEY
STORM SEWER TOWN OF WHITELAND DEPARTMENT OF PUBLIC WORKS 549 MAIN STREET WHITELAND, IN 46184 PHONE: (317) 557-1033 EMAIL: STREETDEPT@WHITELAND.IN.GOV CONTACT: SHAWN YOUNG	GAS CENTERPOINT ENERGY 600 INDUSTRIAL DRIVE FRANKLIN, IN 46131 PHONE: (215) 281-2919 EMAIL: JONATHAN.EASTHAM@CENTERPOINTENERGY.COM CONTACT: JONATHAN EASTHAM	EVERSTREAM 342 MASSACHUSETTS AVENUE INDIANAPOLIS, IN 46204 PHONE: (317) 213-3137 EMAIL: MURPHY@EVERSTREAM.NET CONTACT: MARK PUGH
COMCAST 1600 W. VERNAL PIKE BLOOMINGTON, IN 47404 PHONE: (812) 360-3090 EMAIL: STEVE_MCARTOR@COMCAST.COM CONTACT: STEVE MCARTOR	JOHNSON COUNTY REMC 750 INTERNATIONAL DRIVE FRANKLIN, IN 46131 PHONE: (317) 738-7639 EMAIL: JEAN@CREM.COM CONTACT: SCOTT JEAN	NETRONT 2701 COMMUNICATIONS WAY EVANSVILLE, IN 47715 PHONE: (812) 253-2196 EMAIL: MARK.DECKARD@NETRONT.COM CONTACT: MARK DECKARD

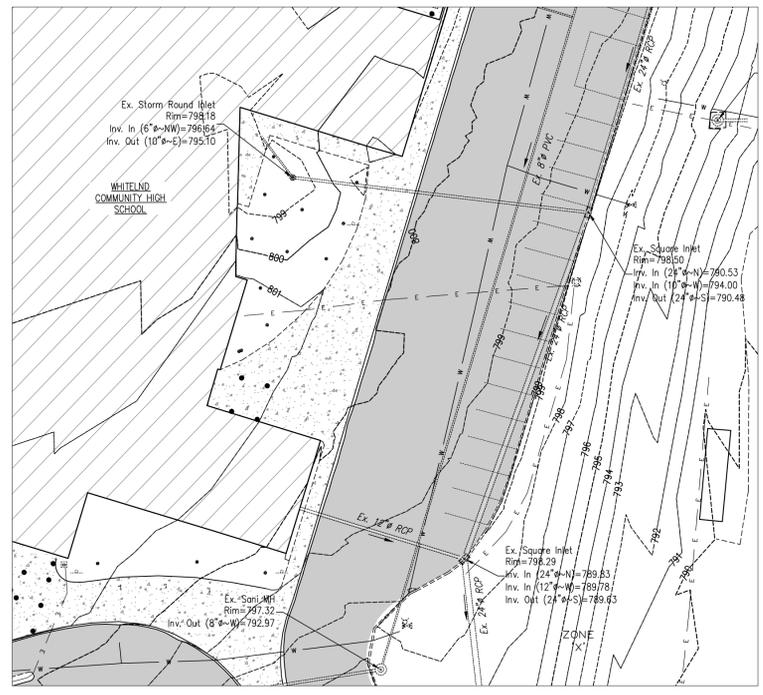


FLOODPLAIN INFORMATION

BY GRAPHIC PLOTTING ONLY, THIS TRACT OF LAND DESCRIBED HEREON LIES WITHIN THE UNSHADED PORTION OF ZONE 'X' (AREAS OUTSIDE THE 0.2% ANNUAL CHANCE FLOODPLAIN), FLOODPLAIN ZONE 'X' (AREAS OF 0.2% ANNUAL CHANCE FLOOD), FLOODPLAIN ZONE 'AE' (AREA OF 1% ANNUAL CHANCE FLOOD WITH ESTABLISHED BASE FLOOD ELEVATIONS), AND FLOODPLAIN ZONE 'A2' AND IS IN A SPECIAL FLOOD HAZARD AREA AS PLOTTED ON THE FEDERAL EMERGENCY MANAGEMENT AGENCY FLOOD INSURANCE RATE MAP FOR JOHNSON COUNTY, INDIANA, COMMUNITY PANEL NO. 18081C0137D, WHICH BEARS AN EFFECTIVE DATE OF 08/02/2007.

TOPOGRAPHICAL NOTES

- CONTRACTOR SHALL DISPOSE OF ALL MATERIALS IN ACCORDANCE WITH FEDERAL, STATE, AND LOCAL REGULATIONS.
- UTILITIES ARE GRAPHICAL REPRESENTATION PER SURVEY AND MAPPING. CONTRACTOR SHALL FIELD VERIFY ALL UTILITIES PRIOR TO CONSTRUCTION.
- CONTRACTOR SHALL COORDINATE WITH APPLICABLE UTILITY COMPANIES FOR SERVICE DIS-CONNECTIONS AND/OR RELOCATIONS.

NOTE: The underground utilities shown have been located from field survey information and existing drawings. The surveyor makes no guarantees that the underground utilities comprise all such utilities in the area, either in-service or abandoned. The surveyor further does not warrant that the underground utilities shown are in the exact location indicated although the surveyor does certify that they are located as accurately as possible from information available. The surveyor has not physically located the underground utilities.

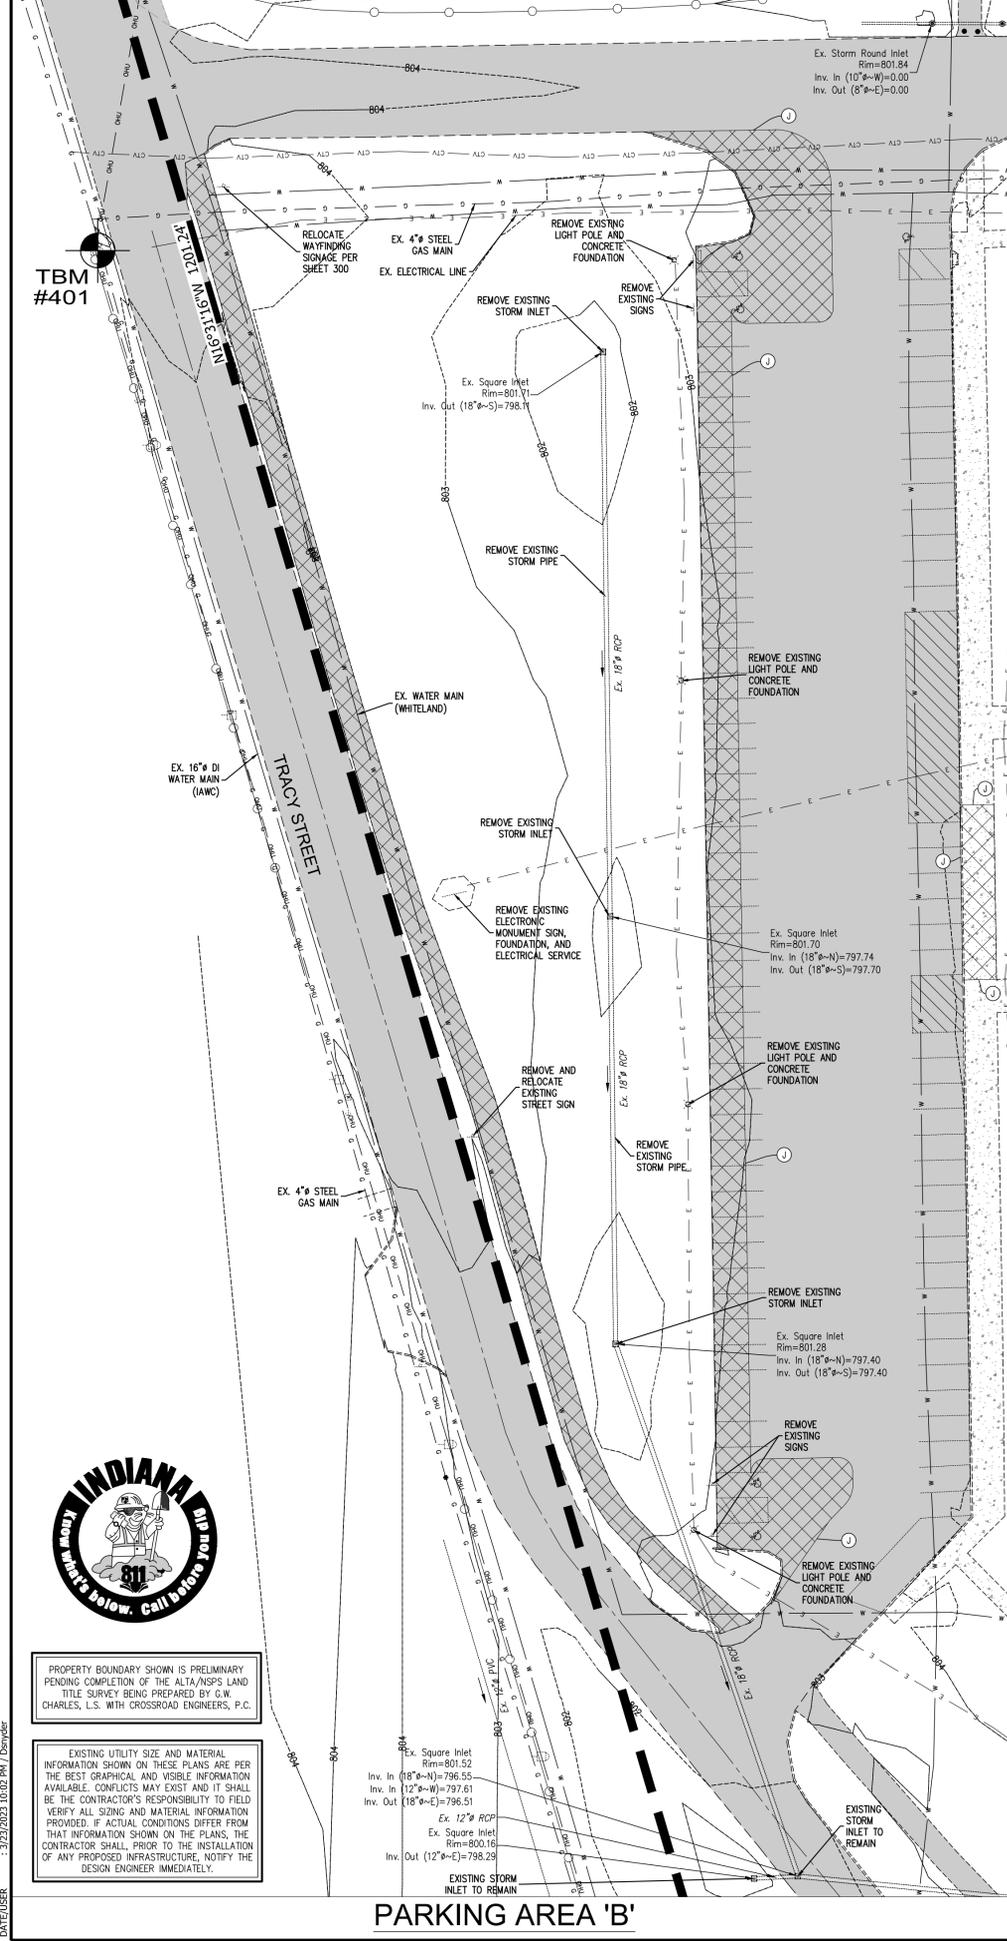

PROPERTY BOUNDARY SHOWN IS PRELIMINARY PENDING COMPLETION OF THE ALTA/NSPS LAND TITLE SURVEY BEING PREPARED BY G.W. CHARLES, L.S. WITH CROSSROAD ENGINEERS, P.C.

EXISTING UTILITY SIZE AND MATERIAL INFORMATION SHOWN ON THESE PLANS ARE PER THE BEST GRAPHICAL AND VISIBLE INFORMATION AVAILABLE. CONFLICTS MAY EXIST AND IT SHALL BE THE CONTRACTOR'S RESPONSIBILITY TO FIELD VERIFY ALL SIZING AND MATERIAL INFORMATION PROVIDED. IF ACTUAL CONDITIONS DIFFER FROM THAT INFORMATION SHOWN ON THE PLANS, THE CONTRACTOR SHALL, PRIOR TO THE INSTALLATION OF ANY PROPOSED INFRASTRUCTURE, NOTIFY THE DESIGN ENGINEER IMMEDIATELY.

**OVERALL PROPOSED
 SITE LAYOUT
 WHITELAND HIGH SCHOOL PHASE 1A**

JOB No. _____
 DATE: FEBRUARY 27, 2023
 DRAWN: _____
 CHECKED: _____
 DESIGNED: _____
 APPROVED: _____



DATE: _____
 DRAWN: _____
 CHECKED: _____
 DESIGNED: _____
 APPROVED: _____

DATE: _____
 DRAWN: _____
 CHECKED: _____
 DESIGNED: _____
 APPROVED: _____

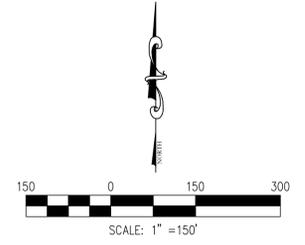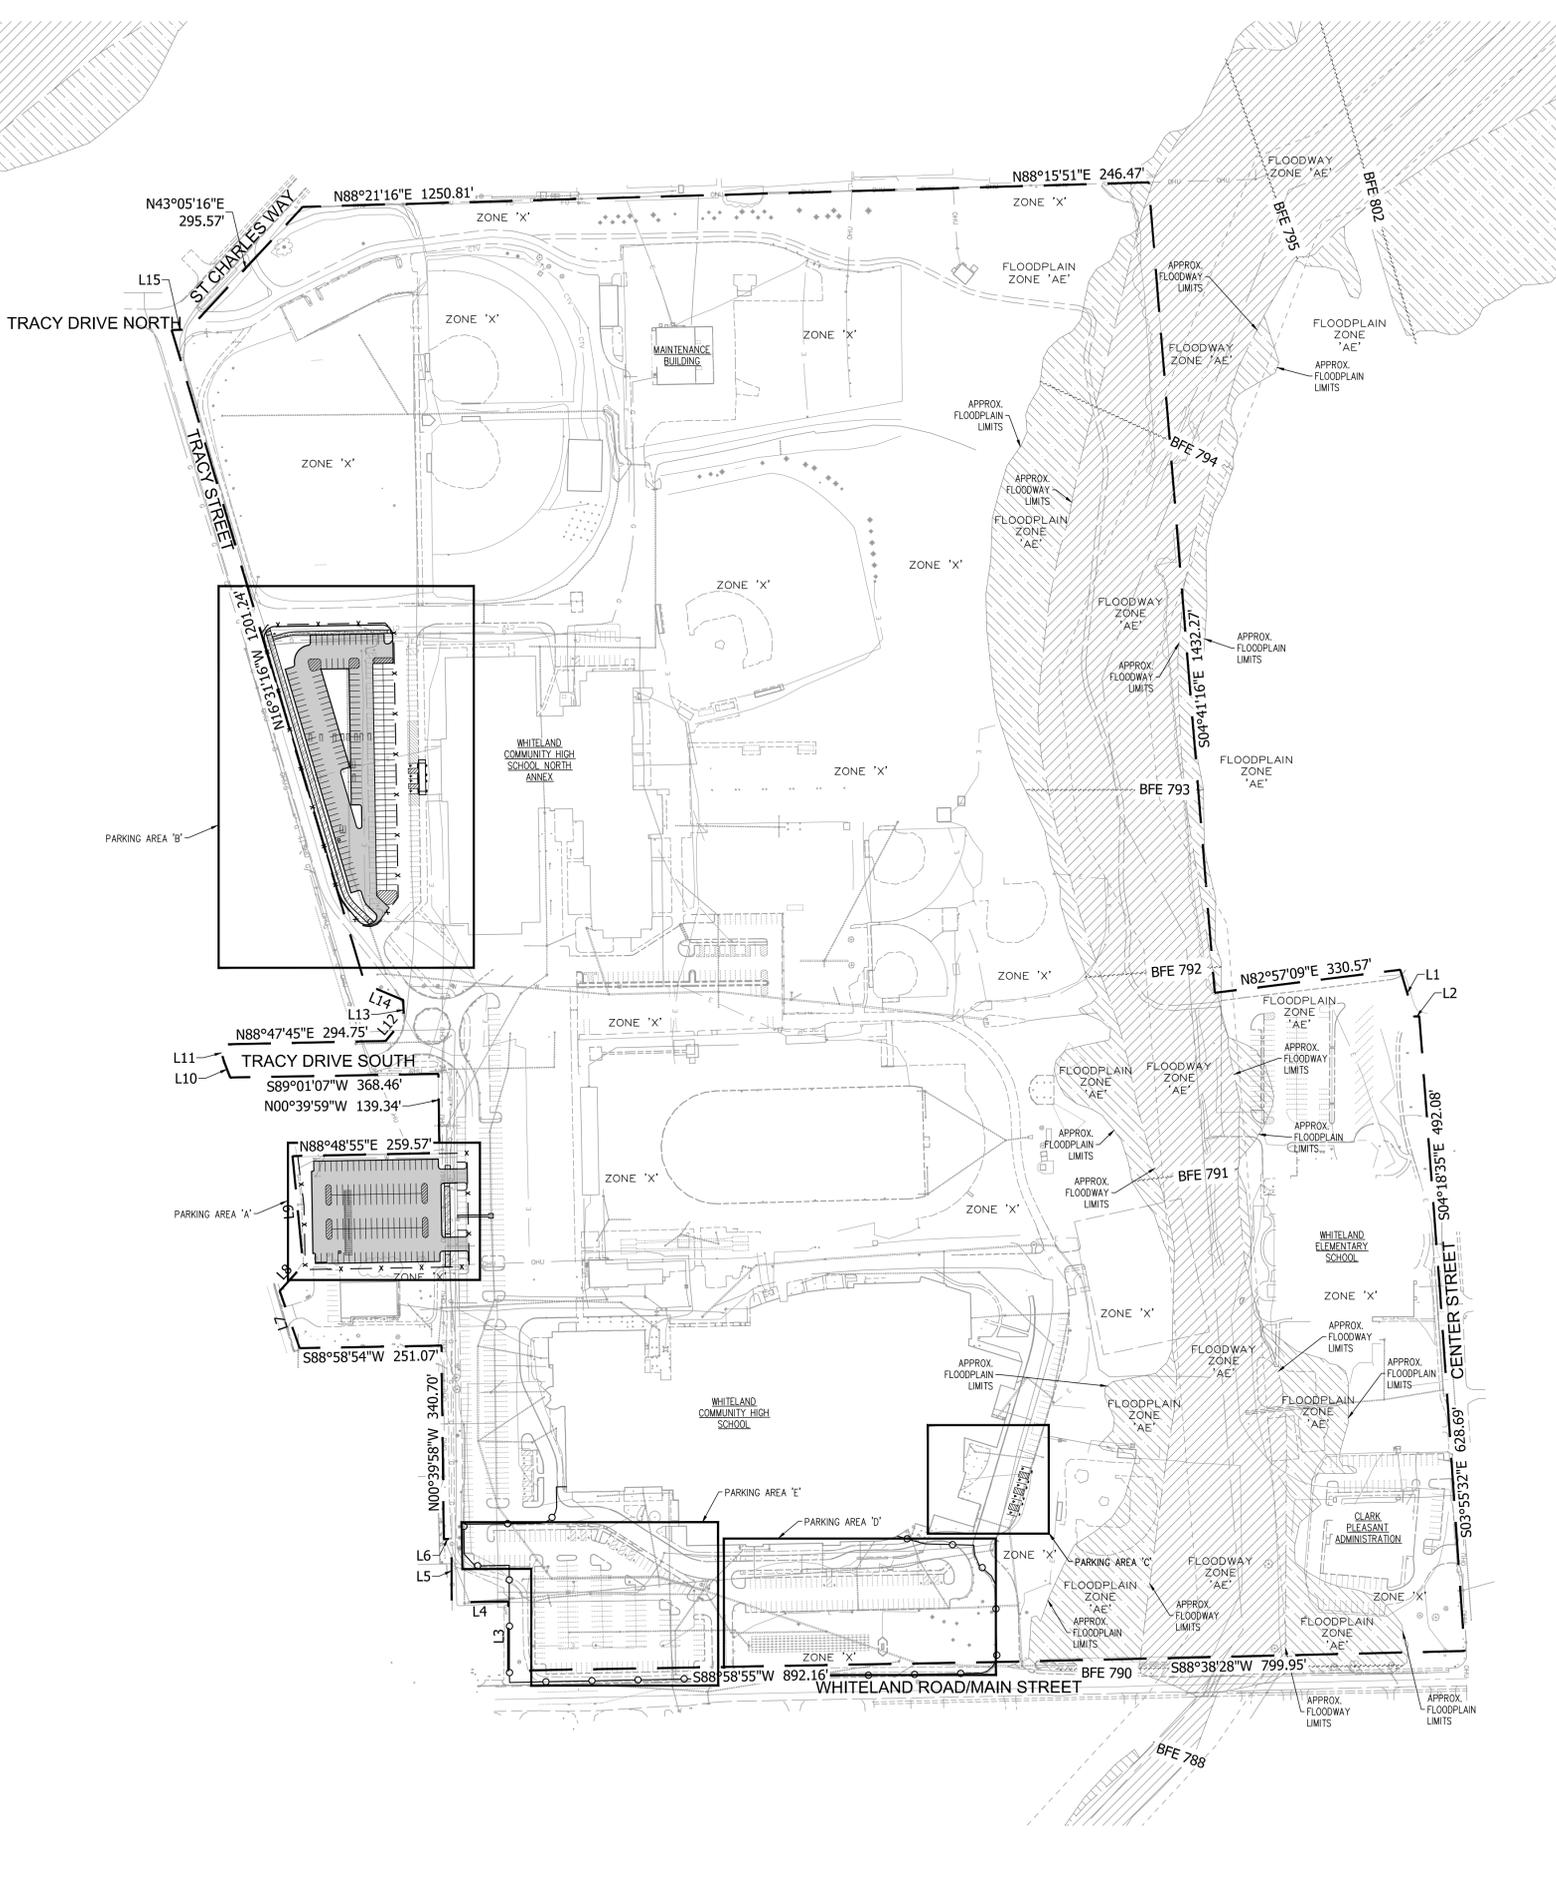

SITE DIMENSION NOTES

- ALL NEW SIGNAGE AND PARKING LOT LIGHTS SHALL MATCH WHITELAND COMMUNITY HIGH SCHOOLS' EXISTING SIGNAGE AND LIGHTING. CONTRACTOR SHALL COORDINATE WITH OWNER, LANDSCAPE ARCHITECT (CONTEXT DESIGN), AND MEP DESIGNER FOR LIGHT STYLES AND LAYOUT.
- CONTRACTOR SHALL NOTIFY ENGINEER, IF PROOF ROLL OF SUBGRADE FAILS, TO DETERMINE IF LIME STABILIZATION OF SUBGRADE IS NECESSARY.
- ALL RADI DIMENSIONS ARE TO THE FACE OF PROPOSED CURB.
- SIGNAGE SHALL INCLUDE ALL NECESSARY HARDWARE AND FITTINGS, INCLUDING 10 FT. OF 11 GAUGE FLANGED CHANNEL SIGN POST.
- REFER TO LANDSCAPE AND ARCHITECTURAL PLANS FOR ADDITIONAL SIGNAGE. VERIFY CONFLICTS WITH OWNER, ARCHITECT, AND LANDSCAPE ARCHITECT.
- CONTRACTOR SHALL BE RESPONSIBLE FOR MAINTAINING TRAFFIC AND PROVIDING ALL NECESSARY FLAGMAN, BARRELS, SIGNAGE, ETC. DURING CONSTRUCTION. ALL APPLICABLE M.U.T.C.D. STANDARDS SHALL GOVERN THIS WORK.
- LANDSCAPING PLAN TO BE PROVIDED BY CONTEXT DESIGN. CONTRACTOR SHALL COORDINATE WITH OWNER AND CONTEXT FOR SPECIFICATIONS.
- EXISTING UTILITY SIZE AND MATERIAL INFORMATION SHOWN ON THESE PLANS ARE PER THE BEST GRAPHICAL AND VISIBLE INFORMATION AVAILABLE. CONFLICTS MAY EXIST AND IT SHALL BE THE CONTRACTOR'S RESPONSIBILITY TO FIELD VERIFY ALL SIZING AND MATERIAL INFORMATION PROVIDED. IF ACTUAL CONDITIONS DIFFER FROM THAT INFORMATION SHOWN ON THE PLANS, THE CONTRACTOR SHALL, PRIOR TO THE INSTALLATION OF ANY PROPOSED INFRASTRUCTURE, NOTIFY THE DESIGN ENGINEER IMMEDIATELY.

Boundary Line Table

Line #	Direction	Length
L1	S16°51'24"E	86.00'
L2	N87°08'36"E	8.81'
L3	N00°07'39"W	121.99'
L4	S88°58'56"W	99.96'
L5	N00°07'39"W	112.00'
L6	S88°58'16"W	13.76'
L7	N19°16'56"W	106.79'
L8	N42°42'49"E	60.96'
L9	N05°29'15"W	193.57'
L10	N20°48'54"W	30.97'
L11	N16°27'01"W	30.46'
L12	N40°12'44"E	49.65'
L13	N01°07'16"W	34.00'
L14	N67°41'17"W	74.01'
L15	N88°17'44"E	29.87'



Derek M. Snyder

NOTE:
 NO EARTHWORK OR DISTURBING ACTIVITY
 MAY COMMENCE UNTIL A STORM WATER
 MANAGEMENT PERMIT IS OBTAINED.



PARKING ANALYSIS - PHASE 1A

PARKING AREA	EXISTING # OF SPACES		PROPOSED # OF SPACES		NET CHANGE IN # OF SPACES	
	A.D.A. ACCESSIBLE	STANDARD	A.D.A. ACCESSIBLE	STANDARD	A.D.A. ACCESSIBLE	STANDARD
"A"	0	21	0	119	0	+98
"B"	5	83	5	213	0	+130
"C"	0	16	6	7	+6	-9
"D"	5	71	5	71	0	0
"E"	7	198	7	198	0	0
TOTALS =	17	389	23	608	+6	+219

NOTE: NO CHANGES ARE PROPOSED FOR EXISTING PARKING AREAS "D" AND "E" IN PHASE 1A. SAID PARKING AREAS HAVE BEEN INCLUDED IN THE PARKING ANALYSIS FOR REFERENCE ONLY. SEE SITE DIMENSION PLAN (SHEET 301) FOR LAYOUTS OF PARKING AREAS "A", "B", AND "C". SEE SITE DIMENSION PLAN (SHEET 302) FOR LAYOUTS OF PARKING AREAS "D" AND "E".

PROPERTY BOUNDARY SHOWN IS PRELIMINARY
 PENDING COMPLETION OF THE ALTA/NSP'S LAND
 TITLE SURVEY BEING PREPARED BY G.W.
 CHARLES, L.S. WITH CROSSROAD ENGINEERS, P.C.




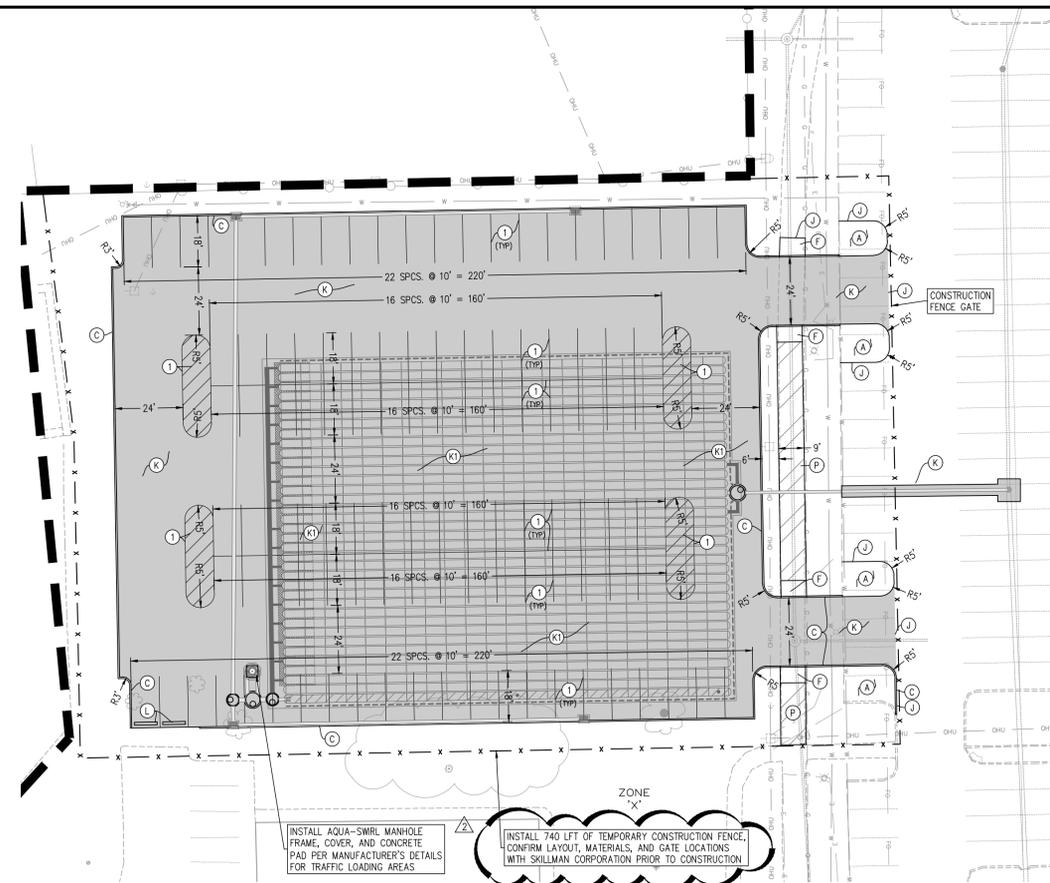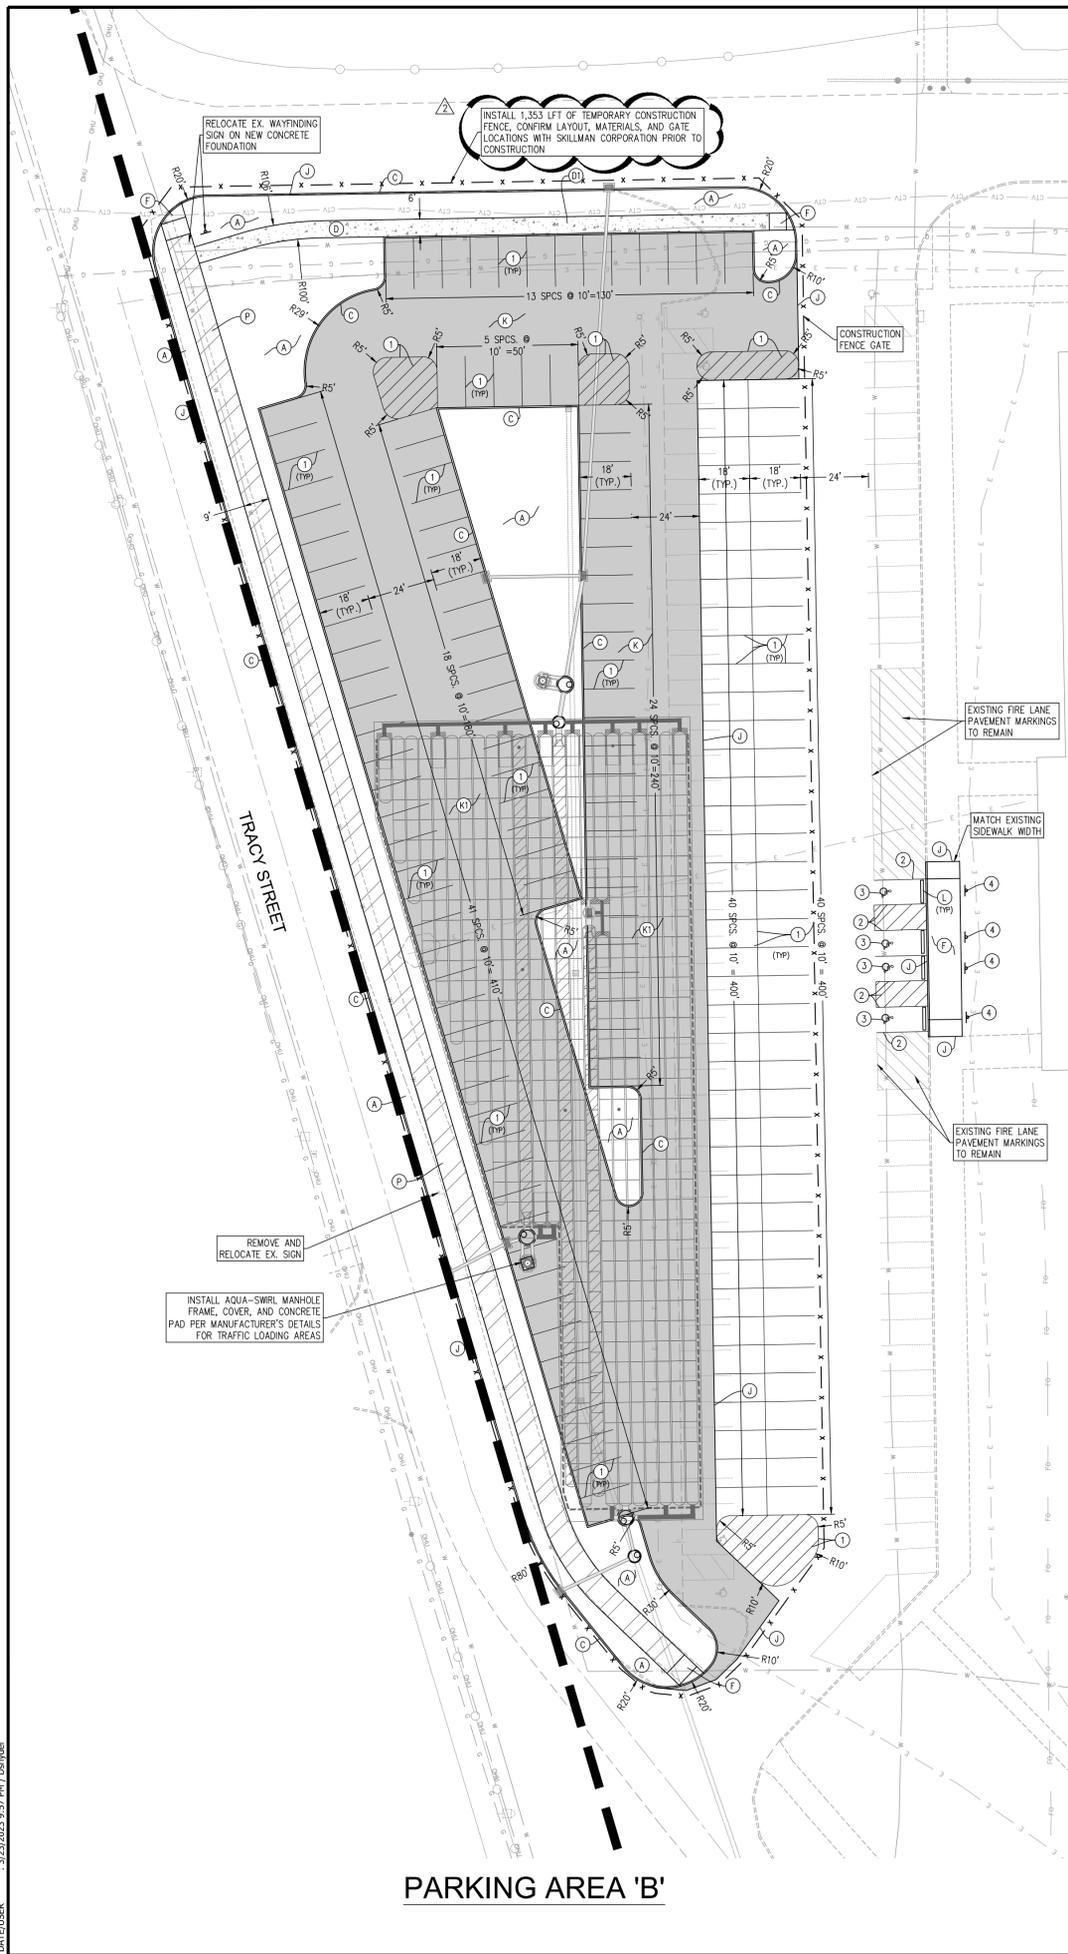

PARKING ANALYSIS - PHASE 1A

PARKING AREA	EXISTING # OF SPACES		PROPOSED # OF SPACES		NET CHANGE IN # OF SPACES	
	A.D.A. ACCESSIBLE	STANDARD	A.D.A. ACCESSIBLE	STANDARD	A.D.A. ACCESSIBLE	STANDARD
"A"	0	21	0	119	0	+98
"B"	5	83	5	213	0	+130
"C"	0	16	6	7	+6	-9
"D"	5	71	5	71	0	0
"E"	7	198	7	198	0	0
TOTALS =	17	389	23	608	+6	+219


NOTE: NO CHANGES ARE PROPOSED FOR EXISTING PARKING AREAS "D" AND "E" IN PHASE 1A. SAID PARKING AREAS HAVE BEEN INCLUDED IN THE PARKING ANALYSIS FOR REFERENCE ONLY. SEE SITE DIMENSION PLAN (SHEET 302) FOR LOCATIONS OF PARKING AREAS "D" AND "E".

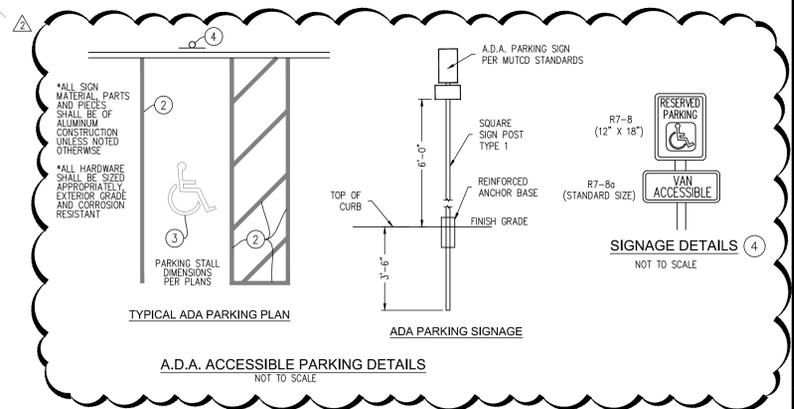

- SITE DIMENSION LEGEND**
- (A) MULCH SEEDING/LANDSCAPE AREAS
 - (B) STRAIGHT CONCRETE CURB (SEE DETAIL-SHEET 900)
 - (C) 4" CONCRETE SIDEWALK (SEE DETAIL-SHEET 900)
 - (D) MONOLITHIC CONCRETE CURB AND SIDEWALK (SEE DETAIL-SHEET 900)
 - (E) A.D.A. RAMP (SEE DETAIL-SHEET 900)
 - (F) SAWCUT
 - (K) TYPICAL LIGHT DUTY ASPHALT SECTION
1.5" HMA SURFACE 9.5mm, ON
3" HMA INTERMEDIATE 19.0mm, ON
6" COMPACTED AGGREGATE #53, ON
COMPACTED SUBGRADE (SEE DETAIL-SHEET 900)
 - (K1) TYPICAL LIGHT DUTY ASPHALT SECTION OVER DETENTION SECTION
1.5" HMA SURFACE 9.5mm, ON
3" HMA INTERMEDIATE 19.0mm, ON
VARIABLE DEPTH COMPACTED AGGREGATE #53, ON
GEOTEXTILE FABRIC OVER UNDERGROUND DETENTION
(SEE DETAIL-SHEET 900)
 - (L) CONCRETE WHEEL STOP (SEE DETAIL-SHEET 900)
 - (P) TYPICAL ASPHALT PATH SECTION
1" HMA SURFACE 9.5mm, ON
2" HMA INTERMEDIATE 19.0mm, ON
6" COMPACTED AGGREGATE #53, ON
COMPACTED SUBGRADE (SEE DETAIL - SHEET 900)
 - (1) LINE, PAINTED, SOLID WHITE, 4"
 - (2) LINE, PAINTED, SOLID BLUE, 4"
 - (3) A.D.A. SYMBOL, PAINTED, SOLID BLUE, 4"
 - (4) SIGNAGE (SEE DETAIL-THIS SHEET)

- SITE DIMENSION NOTES**
1. ALL NEW SIGNAGE AND PARKING LOT LIGHTS SHALL MATCH WHITELAND COMMUNITY HIGH SCHOOLS' EXISTING SIGNAGE AND LIGHTING. CONTRACTOR SHALL COORDINATE WITH OWNER, LANDSCAPE ARCHITECT (CONTEXT DESIGN), AND MEP DESIGNER FOR LIGHT STYLES AND LAYOUT.
 2. CONTRACTOR SHALL NOTIFY ENGINEER, IF PROOF ROLL OF SUBGRADE FAILS, TO DETERMINE IF LIME STABILIZATION OF SUBGRADE IS NECESSARY.
 3. ALL RADI DIMENSIONS ARE TO THE FACE OF PROPOSED CURB.
 4. SIGNAGE SHALL INCLUDE ALL NECESSARY HARDWARE AND FITTINGS, INCLUDING 10 FT. OF 11 GAUGE FLANGED CHANNEL SIGN POST.
 5. REFER TO LANDSCAPE AND ARCHITECTURAL PLANS FOR ADDITIONAL SIGNAGE. VERIFY CONFLICTS WITH OWNER, ARCHITECT, AND LANDSCAPE ARCHITECT.
 6. CONTRACTOR SHALL BE RESPONSIBLE FOR MAINTAINING TRAFFIC AND PROVIDING ALL NECESSARY FLAGMAN, BARRELS, SIGNAGE, ETC. DURING CONSTRUCTION. ALL APPLICABLE M.U.T.C.D. STANDARDS SHALL GOVERN THIS WORK.
 7. LANDSCAPING PLAN TO BE PROVIDED BY CONTEXT DESIGN. CONTRACTOR SHALL COORDINATE WITH OWNER AND CONTEXT FOR SPECIFICATIONS.
 8. EXISTING UTILITY SIZE AND MATERIAL INFORMATION SHOWN ON THESE PLANS ARE PER THE BEST GRAPHICAL AND VISIBLE INFORMATION AVAILABLE. CONFLICTS MAY EXIST AND IT SHALL BE THE CONTRACTOR'S RESPONSIBILITY TO FIELD VERIFY ALL SIZING AND MATERIAL INFORMATION PROVIDED. IF ACTUAL CONDITIONS DIFFER FROM THAT INFORMATION SHOWN ON THE PLANS, THE CONTRACTOR SHALL, PRIOR TO THE INSTALLATION OF ANY PROPOSED INFRASTRUCTURE, NOTIFY THE DESIGN ENGINEER IMMEDIATELY.

- PROPOSED LEGEND**
- PROPERTY LINE
 - SECTION LINE
 - SETBACK LINE
 - DITCH LINE
 - STORM POWER W/MANHOLE END SECTION
 - ELECTRIC LINE
 - STORM MANHOLES
 - STORM INLETS
 - STORM CURB INLETS
 - AQUA-SWIRL UNITS
 - SIGN
 - PERMANENT CONSTRUCTION FENCE WITH SCREENING ON DRIVEN POSTS
 - TEMPORARY CONSTRUCTION FENCE ON STANDS WITH SAND BAGS

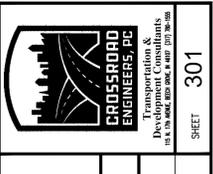

SITE DIMENSION PLAN

WHITELAND HIGH SCHOOL PHASE 1A

JOB NO. _____ DRAWN: KLF CHECKED: TEN APPR. GJI

DATE: FEBRUARY 27, 2023 DESIGNED: _____




REVISIONS

NO.	DATE	BY	REVISIONS
1	03.03.23		ADDENDUM 2-REVISIONS PER TOWN OF WHITELAND TRC COMMENTS, UTILITY POTHOLES RESULTS, AAS STORMTECH REVIEW, & CBBE REVIEW
2	03.24.23		REVISION BASIN BY RETENTION ELEVATIONS AND OUTLET CONTROL STRUCTURE DETAIL (STR. NO. 12)


NO. 301

SITE DIMENSION PLAN
WHITELAND HIGH SCHOOL PHASE 1A

JOB No. DRAWN BY CHECKED BY TEN
 DATE: FEBRUARY 27, 2023 DESIGNED BY APPR. BY GJI

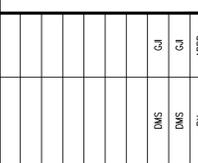

NO.	DATE	REVISIONS	BY	APPR.
1	03.03.23	REVISION BASIN BY RETENTION ELEVATIONS AND OUTLET CONTROL STRUCTURE DETAIL (STR. NO. 12)		
2	03.24.23	ADDITION 2-REVISIONS PER TOWN OF WHITELAND, ITC COMMENTS, UTILITY POTHOLING RESULTS, ADS STORMTECH REVIEW, & CBBE REVIEW		

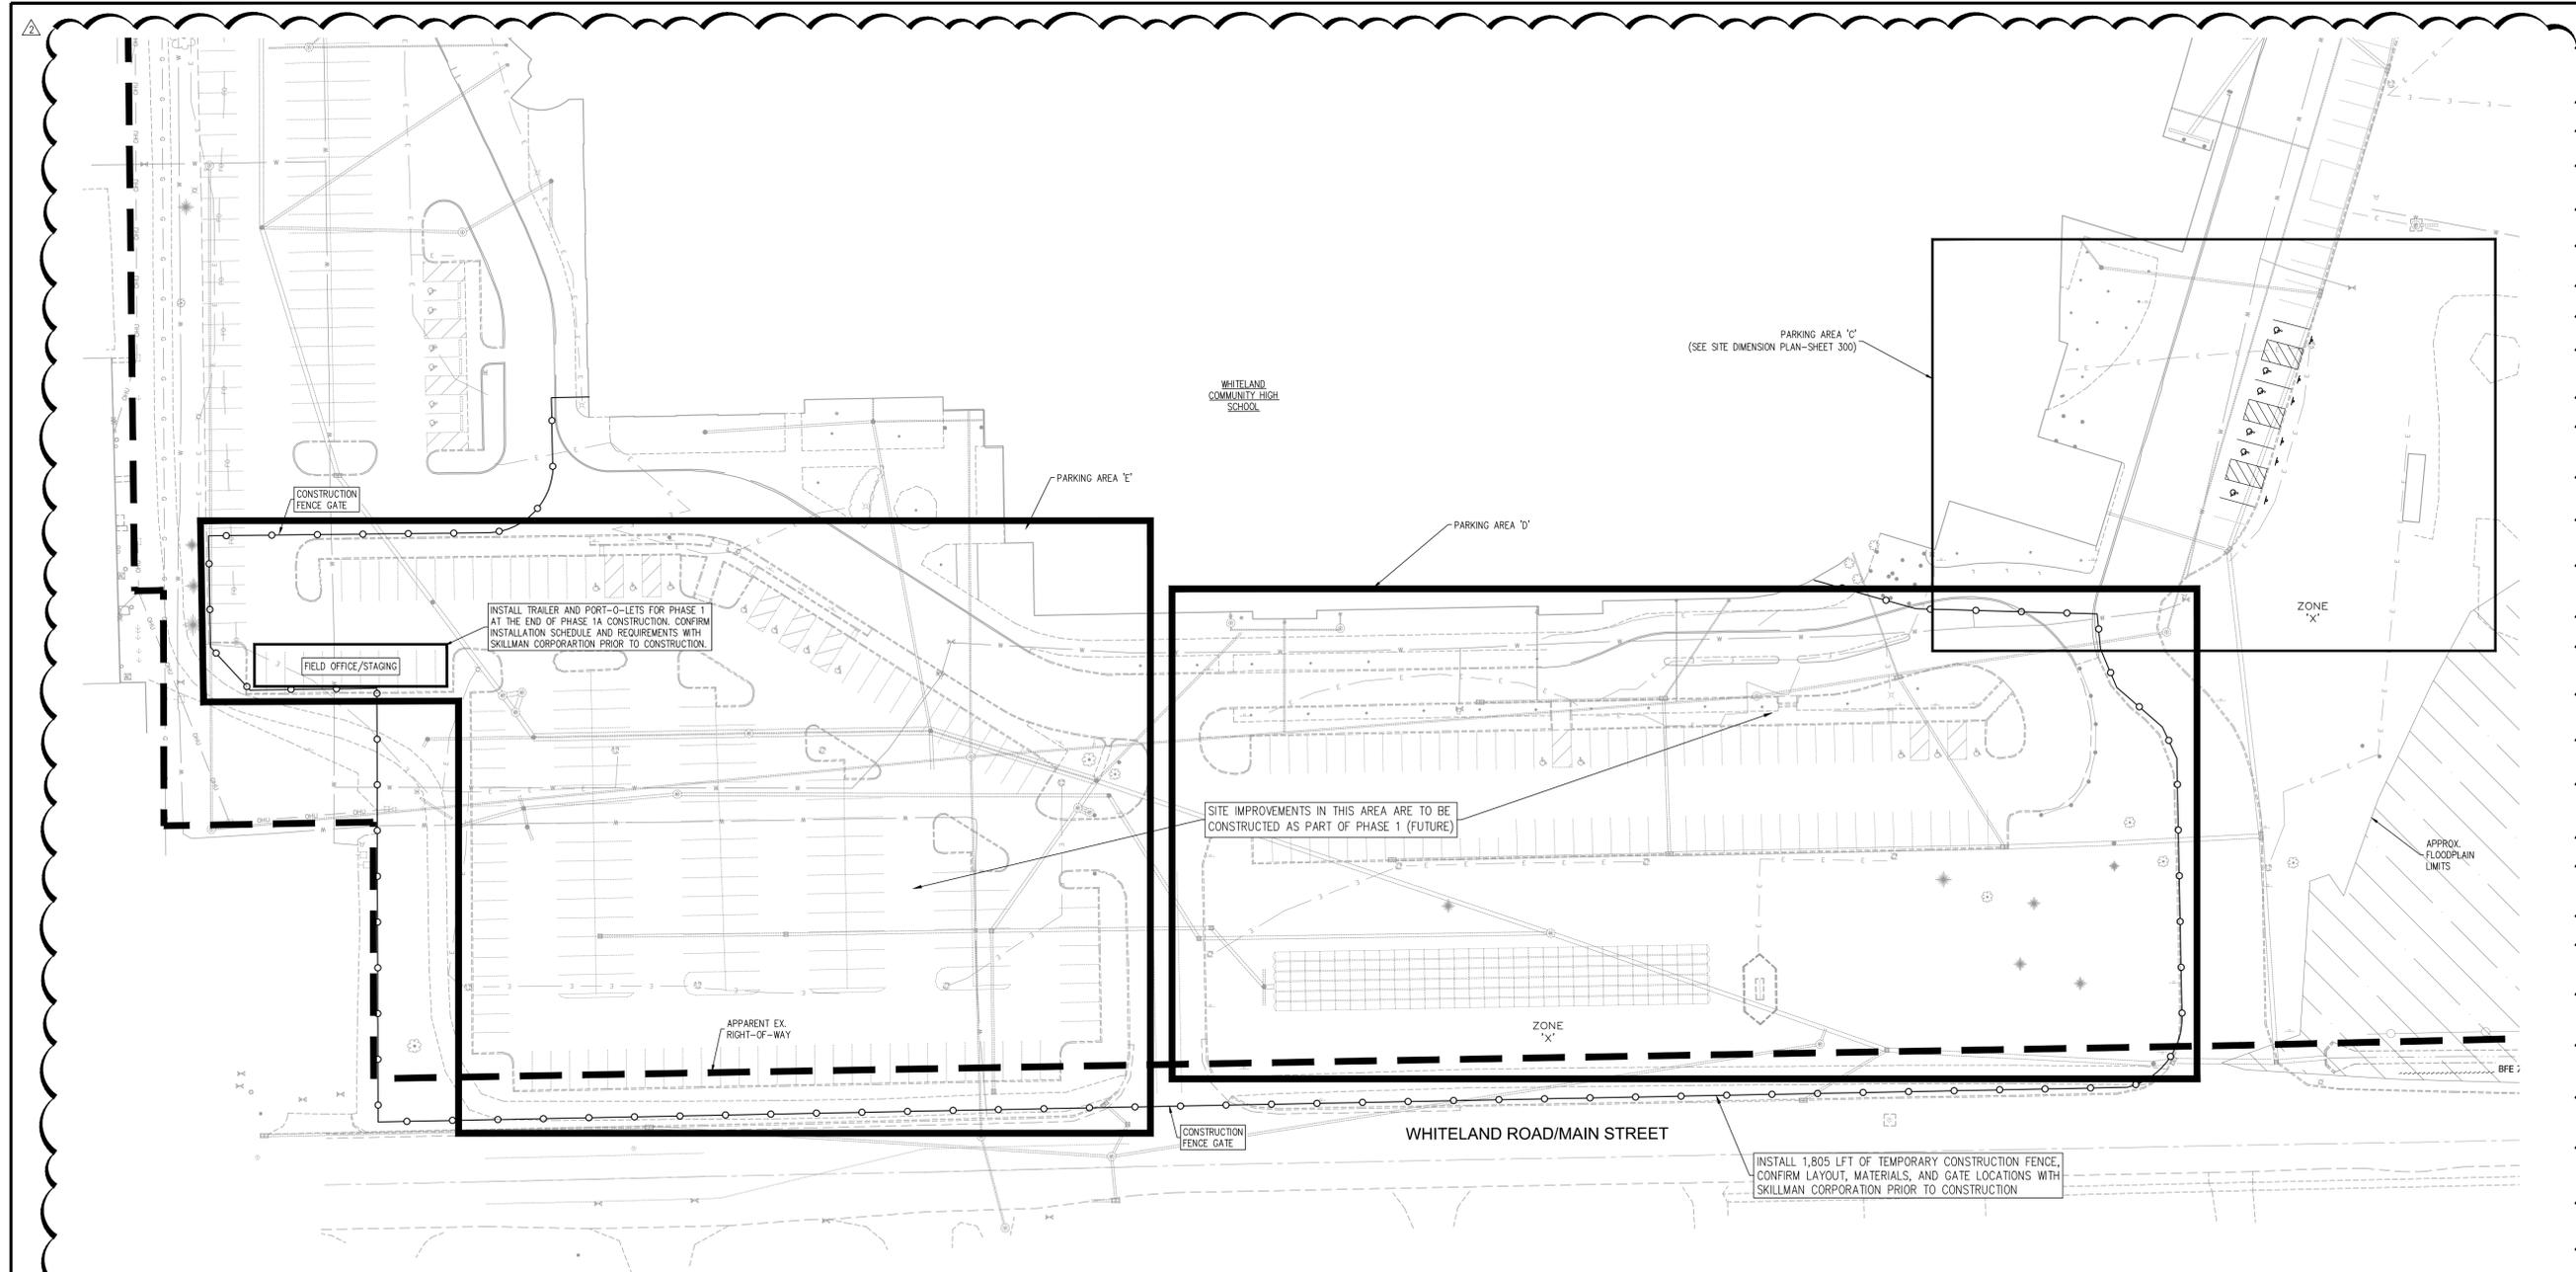


PARKING AREAS 'D' & 'E'

PROPOSED LEGEND

---	PROPERTY LINE
---	SECTION LINE
---	SETBACK LINE
---	DITCH LINE
---	STORM SEWER W/MANHOLE & END SECTION
---	ELECTRIC LINE
○	STORM MANHOLES
○	STORM INLETS
○	STORM CURB INLETS
○	AQUA-SWIRL UNITS
○	SIGN
---	PERMANENT CONSTRUCTION FENCE WITH SCREENING ON DRIVEN POSTS
---	TEMPORARY CONSTRUCTION FENCE ON STANDS WITH SAND BAGS

- SITE DIMENSION NOTES**
1. ALL NEW SIGNAGE AND PARKING LOT LIGHTS SHALL MATCH WHITELAND COMMUNITY HIGH SCHOOLS' EXISTING SIGNAGE AND LIGHTING. CONTRACTOR SHALL COORDINATE WITH OWNER, LANDSCAPE ARCHITECT (CONTEXT DESIGN), AND MEP DESIGNER FOR LIGHT STYLES AND LAYOUT.
 2. CONTRACTOR SHALL NOTIFY ENGINEER, IF PROOF ROLL OF SUBGRADE FAILS, TO DETERMINE IF LINE STABILIZATION OF SUBGRADE IS NECESSARY.
 3. ALL RADI DIMENSIONS ARE TO THE FACE OF PROPOSED CURB.
 4. SIGNAGE SHALL INCLUDE ALL NECESSARY HARDWARE AND FITTINGS, INCLUDING 10 FT. OF 11 GAUGE FLANGED CHANNEL SIGN POST.
 5. REFER TO LANDSCAPE AND ARCHITECTURAL PLANS FOR ADDITIONAL SIGNAGE. VERIFY CONFLICTS WITH OWNER, ARCHITECT, AND LANDSCAPE ARCHITECT.
 6. CONTRACTOR SHALL BE RESPONSIBLE FOR MAINTAINING TRAFFIC AND PROVIDING ALL NECESSARY FLAGMAN, BARRELS, SIGNAGE, ETC. DURING CONSTRUCTION. ALL APPLICABLE M.U.T.C.D. STANDARDS SHALL GOVERN THIS WORK.
 7. LANDSCAPING PLAN TO BE PROVIDED BY CONTEXT DESIGN. CONTRACTOR SHALL COORDINATE WITH OWNER AND CONTEXT FOR SPECIFICATIONS.
 8. EXISTING UTILITY SIZE AND MATERIAL INFORMATION SHOWN ON THESE PLANS ARE PER THE BEST GRAPHICAL AND VISIBLE INFORMATION AVAILABLE. CONFLICTS MAY EXIST AND IT SHALL BE THE CONTRACTOR'S RESPONSIBILITY TO FIELD VERIFY ALL SIZING AND MATERIAL INFORMATION PROVIDED. IF ACTUAL CONDITIONS DIFFER FROM THAT INFORMATION SHOWN ON THE PLANS, THE CONTRACTOR SHALL, PRIOR TO THE INSTALLATION OF ANY PROPOSED INFRASTRUCTURE, NOTIFY THE DESIGN ENGINEER IMMEDIATELY.

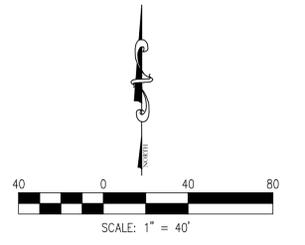

NOTE:
 NO EARTHWORK DISTURBING ACTIVITY MAY COMMENCE UNTIL A STORM WATER MANAGEMENT PERMIT IS OBTAINED.

PARKING ANALYSIS - PHASE 1A


PARKING AREA	EXISTING # OF SPACES		PROPOSED # OF SPACES		NET CHANGE IN # OF SPACES	
	A.D.A. ACCESSIBLE	STANDARD	A.D.A. ACCESSIBLE	STANDARD	A.D.A. ACCESSIBLE	STANDARD
"A"	0	21	0	119	0	+98
"B"	5	83	5	213	0	+130
"C"	0	16	6	7	+6	-9
"D"	5	71	5	71	0	0
"E"	7	198	7	198	0	0
TOTALS =	17	389	23	608	+6	+219

NOTE: NO CHANGES ARE PROPOSED FOR EXISTING PARKING AREAS "D" AND "E" IN PHASE 1A. SAID PARKING AREAS HAVE BEEN INCLUDED IN THE PARKING ANALYSIS FOR REFERENCE ONLY.


DIRECTORY PATH : R:\Active\Users\kbecker\Whiteland High School\Design\CAD\Plans\PHASE 1A
 DATE USER : 3/22/2023 9:54 PM / Dsnyder



NO.	DATE	REVISIONS	BY
1	03.03.23	REVISION 1-REVISED BASIN B DETENTION ELEVATIONS AND OUTLET CONTROL STRUCTURE DETAIL (STR. NO. 12)	DMS
2	03.24.23	ADDENDUM 2-REVISIONS PER TOWN OF WHITELAND TRC COMMENTS, UTILITY FOOTING RESULTS, AISC STORMTECH REVIEW, & CBBE REVIEW	GJI


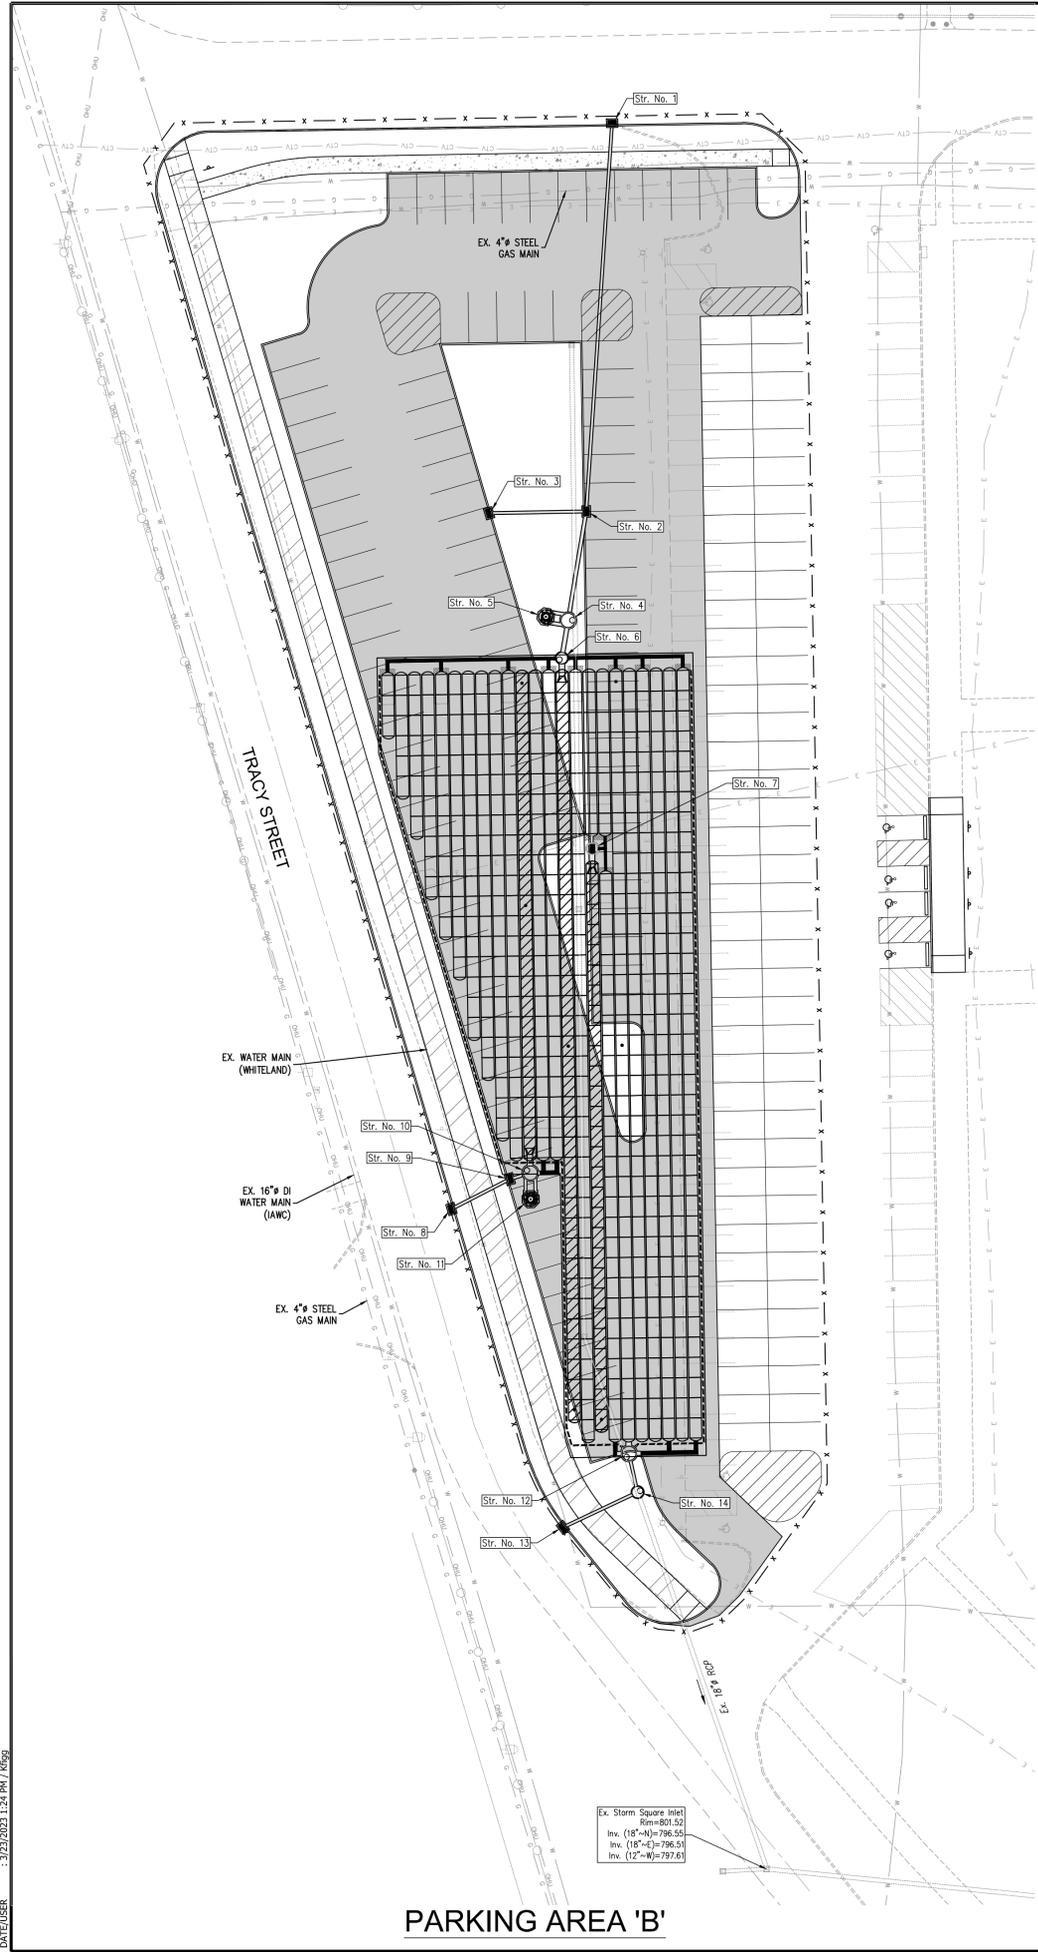


PARKING AREA 'B'

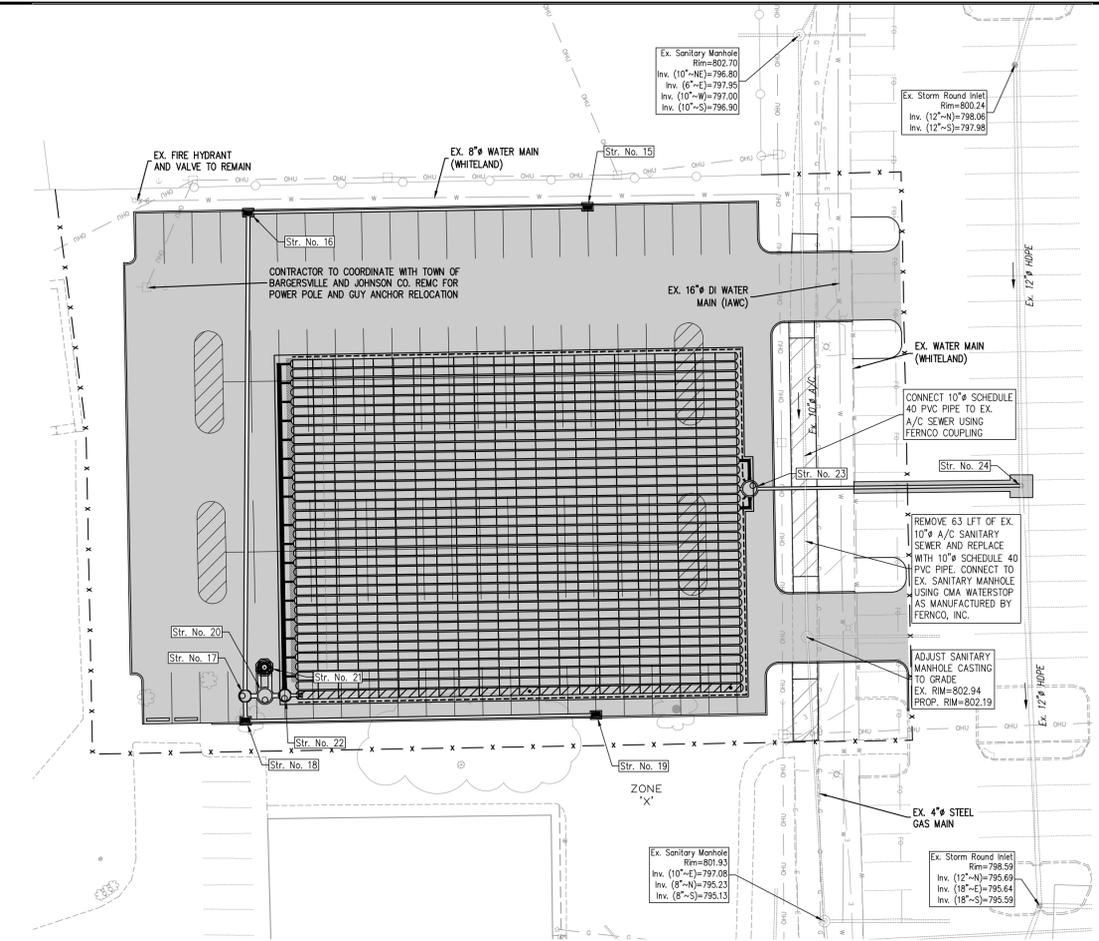

PARKING AREA 'A'


STORM SEWER STRUCTURE TABLE	STORM SEWER STRUCTURE TABLE	STORM SEWER STRUCTURE TABLE	STORM SEWER STRUCTURE TABLE	STORM SEWER STRUCTURE TABLE	STORM SEWER STRUCTURE TABLE
<p>STR. NO. 1</p> <p>INSTALL TYPE 'J' INLET WITH NEENAH R-3287-10V CASTING OR APPROVED EQUAL AND 137 LFT OF 12" RCP @ 0.30% RIM=803.38 INV OUT (12"-S)=799.03</p> <p>STR. NO. 2</p> <p>INSTALL TYPE 'M' INLET WITH NEENAH R-3287-10V CASTING OR APPROVED EQUAL AND 39 LFT OF 15" RCP @ 0.69% RIM=802.51 INV IN (12"-N)=798.62 INV IN (12"-W)=798.62 INV OUT (15"-S)=798.37</p> <p>STR. NO. 3</p> <p>INSTALL TYPE 'J' INLET WITH NEENAH R-3287-10V CASTING OR APPROVED EQUAL AND 34 LFT OF 12" RCP @ 0.32% RIM=802.40 INV OUT (12"-S)=798.73</p> <p>STR. NO. 4</p> <p>INSTALL MODIFIED TYPE 'J' MANHOLE FOR WATER QUALITY DIVERSION STRUCTURE WITH NEENAH R-1772 CASTING OR APPROVED EQUAL AND 8 LFT OF 15" RCP @ 0.30% RIM=803.18 INV IN (15"-N)=798.10 INV IN (15"-W)=798.02 INV OUT (15"-W)=798.10 INV OUT (18"-S)=798.02</p> <p>STR. NO. 5</p> <p>INSTALL PCS AQUA-SWRL AS-5 IN OFFLINE HORSESHOE CONFIGURATION WITH 8 LFT OF 15" HOPE PIPE @ 0.50% RIM=803.16 INV IN (15"-E)=798.06 INV OUT (15"-E)=798.06</p>	<p>STR. NO. 6</p> <p>INSTALL TYPE 'C' MANHOLE WITH NEENAH R-1772 CASTING OR APPROVED EQUAL AND 4 LFT OF 24" HOPE PIPE @ 0.50% RIM=803.23 INV IN (18"-W)=797.98 INV IN (15"-W)=798.70 INV IN (15"-E)=798.70 INV OUT (24"-S)=797.98</p> <p>STR. NO. 7</p> <p>INSTALL TYPE 'C' MANHOLE WITH NEENAH R-3287-10V CASTING OR APPROVED EQUAL AND 4 LFT OF 24" HOPE PIPE @ 0.46% RIM=802.42 INV OUT (12"-N)=798.38 INV OUT (24"-S)=797.98 INV OUT (12"-E)=798.38</p> <p>STR. NO. 8</p> <p>INSTALL TYPE 'J' INLET WITH NEENAH R-3287-10V CASTING OR APPROVED EQUAL AND 23 LFT OF 12" RCP @ 2.72% RIM=803.04 INV OUT (12"-NE)=799.36</p> <p>STR. NO. 9</p> <p>INSTALL TYPE 'M' INLET WITH NEENAH R-3287-10V CASTING OR APPROVED EQUAL AND 8 LFT OF 12" RCP @ 2.13% RIM=802.40 INV IN (12"-SW)=798.73 INV OUT (12"-E)=798.32</p> <p>STR. NO. 10</p> <p>INSTALL MODIFIED TYPE 'J' MANHOLE FOR WATER QUALITY DIVERSION STRUCTURE WITH NEENAH R-1772 CASTING OR APPROVED EQUAL AND 4 LFT OF 24" HOPE PIPE @ 0.46% RIM=802.46 INV IN (12"-W)=798.16 INV IN (12"-S)=797.98 INV IN (18"-E)=798.60 INV OUT (24"-N)=797.98 INV OUT (12"-S)=798.16</p>	<p>STR. NO. 11</p> <p>INSTALL PCS AQUA-SWRL AS-4 IN OFFLINE HORSESHOE CONFIGURATION WITH 9 LFT OF 12" HOPE PIPE @ 0.98% RIM=802.48 INV IN (12"-N)=798.07 INV OUT (12"-N)=798.07</p> <p>STR. NO. 12</p> <p>INSTALL MODIFIED TYPE 'J' MANHOLE FOR DETENTION OUTLET CONTROL STRUCTURE WITH NEENAH R-1772 CASTING OR APPROVED EQUAL AND 14 LFT OF 12" RCP @ 0.43% RIM=803.51 INV IN (24"-N)=798.08 INV IN (18"-E)=798.08 INV IN (18"-W)=798.08 INV IN (16"-NE)=797.20 INV IN (6"-NW)=797.20 INV OUT (12"-S)=797.20</p> <p>STR. NO. 13</p> <p>INSTALL TYPE 'J' INLET WITH NEENAH R-3287-10V CASTING OR APPROVED EQUAL AND 29 LFT OF 12" RCP @ 1.00% RIM=802.19 INV OUT (12"-NE)=799.51</p> <p>STR. NO. 14</p> <p>INSTALL TYPE 'C' MANHOLE WITH NEENAH R-1772 CASTING OR APPROVED EQUAL AND CONNECT TO EXISTING 18" STORM SEWER RIM=803.51 INV IN (12"-N)=797.14 INV IN (12"-SW)=799.22 INV OUT (18"-S)=797.14</p> <p>NOTE: STR. NO. 6, 7, AND 10 SHALL HAVE A 12" SUMP.</p>	<p>STR. NO. 15</p> <p>INSTALL TYPE 'J' INLET WITH NEENAH R-3287-10V CASTING OR APPROVED EQUAL AND 120 LFT OF 12" RCP @ 0.35% RIM=802.55 INV OUT (12"-W)=799.49</p> <p>STR. NO. 16</p> <p>INSTALL TYPE 'M' INLET WITH NEENAH R-3287-10V CASTING OR APPROVED EQUAL AND 170 LFT OF 15" RCP @ 0.25% RIM=802.38 INV IN (18"-E)=799.07 INV OUT (15"-S)=799.07</p> <p>STR. NO. 17</p> <p>INSTALL TYPE 'C' MANHOLE WITH NEENAH R-1772 CASTING OR APPROVED EQUAL AND 7 LFT OF 18" RCP @ 0.43% RIM=802.22 INV IN (15"-S)=798.65 INV IN (15"-W)=798.65 INV OUT (18"-E)=798.65</p> <p>STR. NO. 18</p> <p>INSTALL TYPE 'M' INLET WITH NEENAH R-3287-10V CASTING OR APPROVED EQUAL AND 9 LFT OF 15" RCP @ 0.34% RIM=801.99 INV IN (12"-S)=798.64 INV OUT (15"-N)=798.68</p>	<p>STR. NO. 19</p> <p>INSTALL TYPE 'J' INLET WITH NEENAH R-3287-10V CASTING OR APPROVED EQUAL AND 124 LFT OF 12" RCP @ 0.35% RIM=802.14 INV OUT (12"-W)=798.08</p> <p>STR. NO. 20</p> <p>INSTALL MODIFIED TYPE 'J' MANHOLE FOR WATER QUALITY DIVERSION STRUCTURE WITH NEENAH R-1772 CASTING OR APPROVED EQUAL AND 7 LFT OF 18" RCP @ 0.43% RIM=802.19 INV IN (18"-W)=798.62 INV IN (15"-N)=798.54 INV OUT (18"-E)=798.54</p> <p>STR. NO. 21</p> <p>INSTALL PCS AQUA-SWRL AS-5 IN OFFLINE HORSESHOE CONFIGURATION WITH 10 LFT OF 15" HOPE PIPE @ 0.40% RIM=802.44 INV IN (15"-S)=798.58 INV OUT (15"-S)=798.58</p> <p>STR. NO. 22</p> <p>INSTALL MODIFIED TYPE 'C' MANHOLE FOR ISOLATOR ROW W/ BYPASS WITH NEENAH R-1772 CASTING OR APPROVED EQUAL AND 4 LFT OF 12" HOPE PIPE @ 0.50% RIM=802.23 INV IN (18"-W)=798.51 INV OUT (12"-E)=798.51 INV OUT (18"-N)=798.28</p>	<p>STR. NO. 23</p> <p>INSTALL MODIFIED TYPE 'J' MANHOLE FOR DETENTION OUTLET CONTROL STRUCTURE WITH NEENAH R-1772 CASTING OR APPROVED EQUAL AND 96 LFT OF 12" RCP @ 1.50% RIM=803.25 INV IN (12"-W)=798.49 INV IN (12"-N)=798.49 INV IN (12"-S)=798.49 INV IN (4"-SW)=797.91 INV IN (4"-NW)=797.91 INV OUT (12"-E)=797.91</p> <p>STR. NO. 24</p> <p>MECHANICALLY CORE EXISTING INLET AND CONNECT PIPE FROM STR. NO. 23 RIM=799.03 INV IN (12"-W)=796.47 INV IN (12"-N)=796.47 INV OUT (18"-S)=796.47</p> <p>NOTE: STR. NO. 22 SHALL HAVE A 24" SUMP AND STR. NO. 23 SHALL HAVE A 12" SUMP.</p> <p>NOTE: RCP FOR STR. NO. 15, 16, 17, 18, 19, 20, AND 23 SHALL BE CLASS IV ALL OTHER RCP SHALL BE CLASS III.</p>

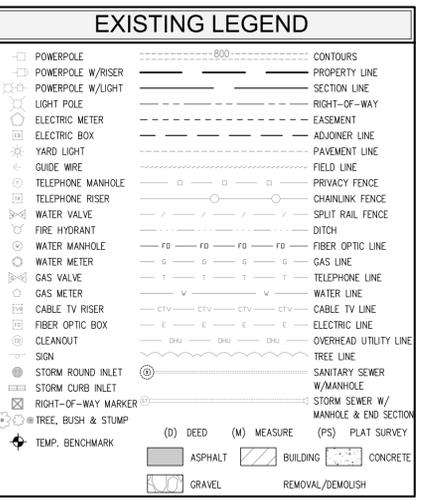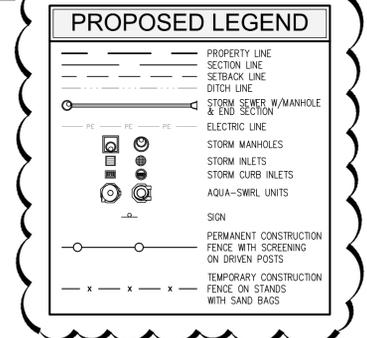


- UTILITIES NOTES**
- CONTRACTOR SHALL BE RESPONSIBLE FOR MAINTAINING TRAFFIC AND PROVIDING ALL NECESSARY FLAGMAN, BARRELS, SIGNAGE, ETC. DURING CONSTRUCTION. ALL APPLICABLE M.U.I.C.D. STANDARDS SHALL GOVERN THIS WORK.
 - CONTRACTOR SHALL REFER TO THE ELECTRICAL SITE PLAN PREPARED BY PRIMARY ENGINEERING, INC. FOR PARKING LOT LIGHTING AND SPECIFICATIONS.
 - ALL STORM SEWER CASTINGS SHALL BE NPDES PHASE II COMPLIANT. CASTINGS SHALL BE MANUFACTURED WITH A STATEMENT SAYING: "DUMP NO WASTE, DRAINS TO RIVER" IN 1/2" RAISED LETTERS.
 - ALL FIELD TILES DISTURBED DURING CONSTRUCTION MUST BE REPAIRED/CONNECTED TO NEW STORMWATER FACILITIES.
 - EXISTING UTILITY SIZE AND MATERIAL INFORMATION SHOWN ON THESE PLANS ARE PER THE BEST GRAPHICAL AND VISIBLE INFORMATION AVAILABLE. CONFLICTS MAY EXIST AND IT SHALL BE THE CONTRACTOR'S RESPONSIBILITY TO FIELD VERIFY ALL SIZES AND MATERIAL INFORMATION PROVIDED. IF ACTUAL CONDITIONS DIFFER FROM THAT INFORMATION SHOWN ON THE PLANS, THE CONTRACTOR SHALL, PRIOR TO THE INSTALLATION OF ANY PROPOSED INFRASTRUCTURE, NOTIFY THE DESIGN ENGINEER IMMEDIATELY.




DIRECTORY PATH : R:\Active\Users\kbeep\Whiteland High School\Design\CAD\Plans\PHASE 1A
DATE/USER : 3/23/2023 11:24 PM / Kbeep

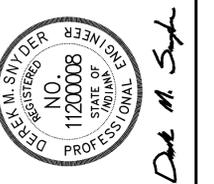

NO.	DATE	REVISIONS	BY
1	03.03.23	ADDITION 2-REVISIONS PER TOWN OF WHITELAND TRC COMMENTS, UTILITY FOTHOLOG RESULTS, ADS STORMTECH REVIEW, & CBBE REVIEW	DMS
2	03.03.23	REVISED BASIN BY RETENTION ELEVATIONS AND OUTLET CONTROL STRUCTURE DETAIL (STR. NO. 12)	DMS
3			CU
4			CU
5			APPR.
6			
7			
8			
9			

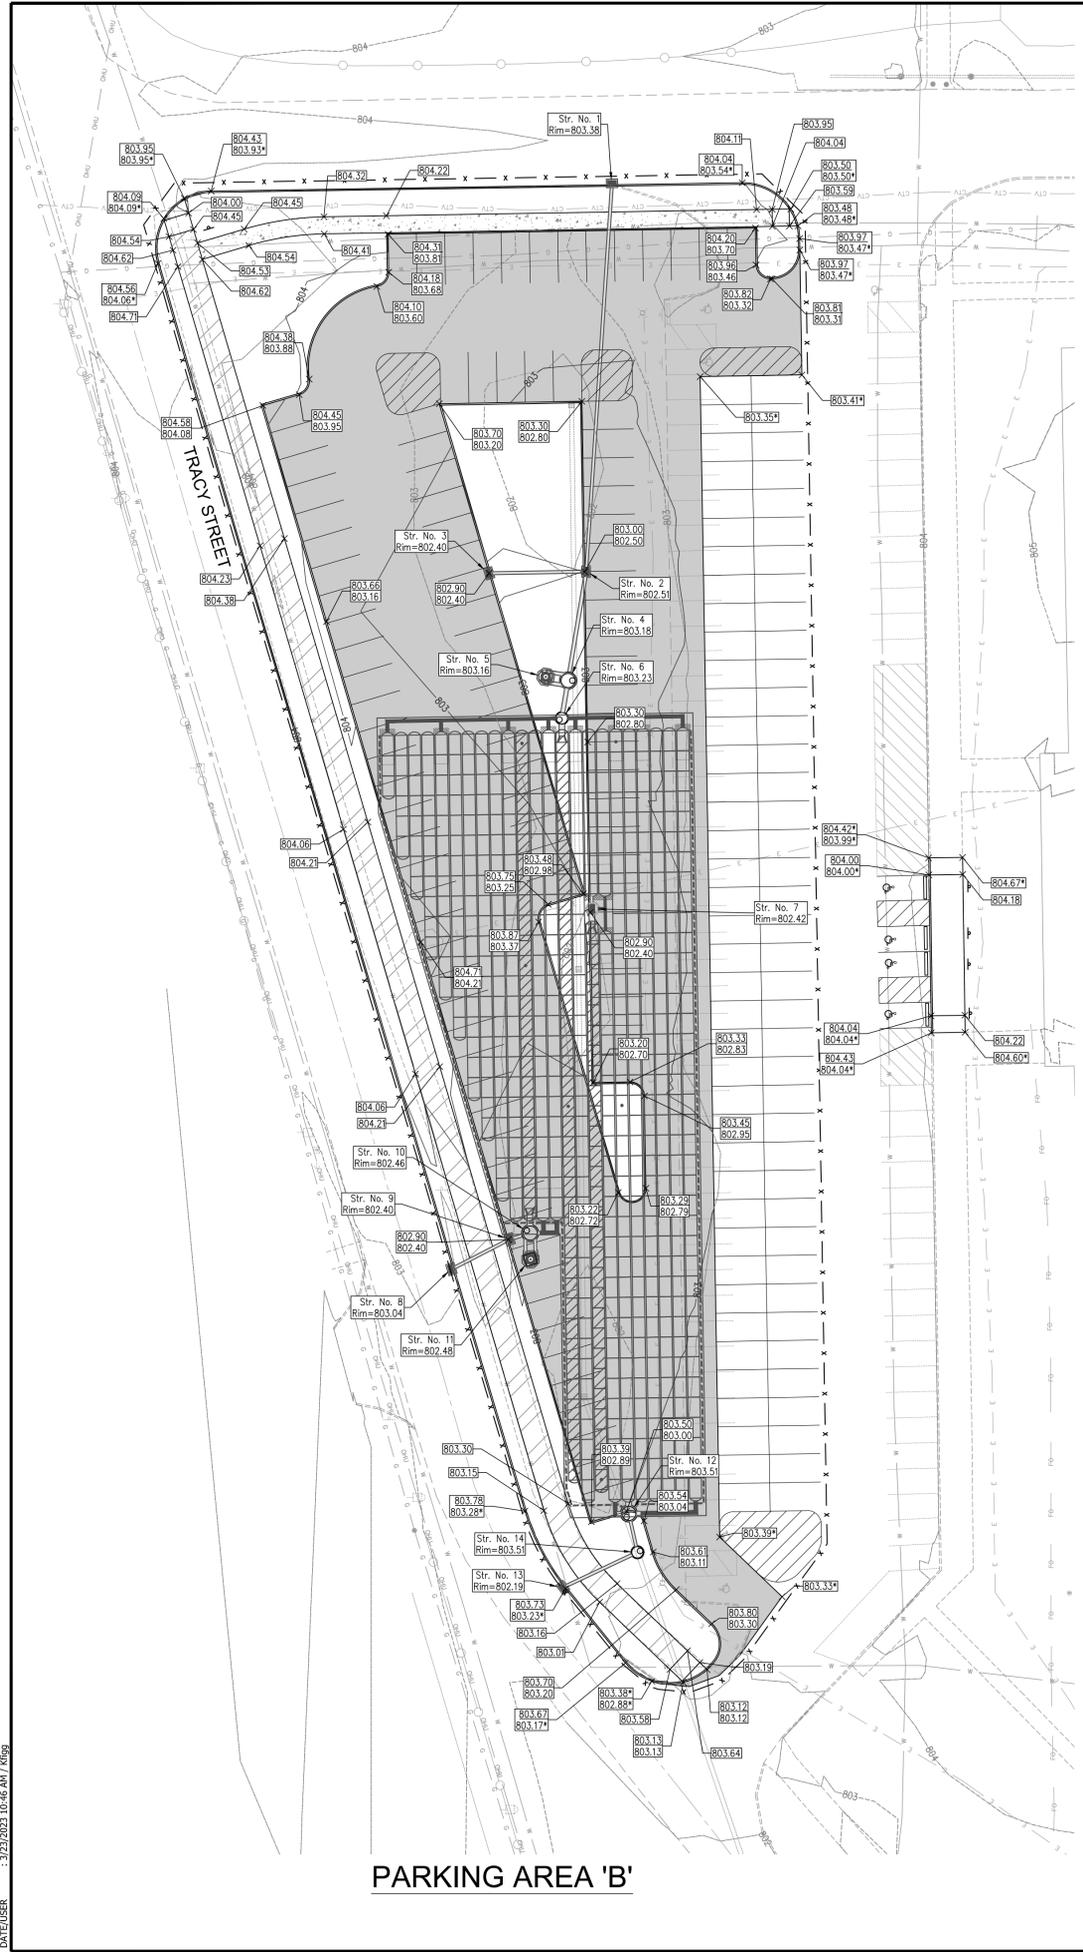

PARKING AREA 'B'

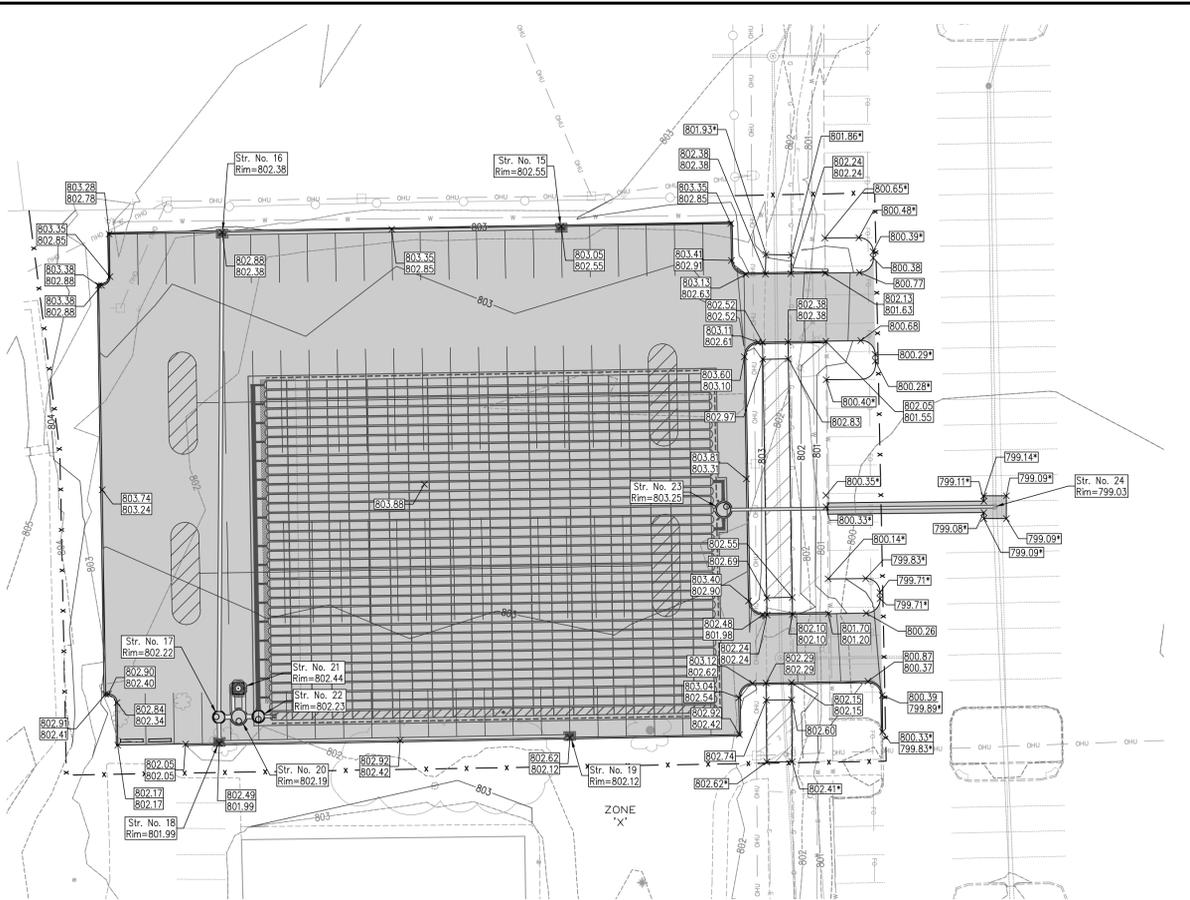

PARKING AREA 'A'

BENCHMARK INFORMATION

ORIGINATING BENCHMARK
 DESIGNATION - X 13
 PID - KA0010
 STATE/COUNTRY - IN/MORGAN
 USGS QUAD - MOORESVILLE EAST (1980)
 VERT ORDER - FIRST CLASS II

DESCRIBED BY COAST AND GEODETIC SURVEY 1946
 1.2 MI. N FROM WAVERLY
 IN JOHNSON COUNTY, 1.2 MILES NORTH ALONG STATE HIGHWAY 37 FROM
 THE INTERSECTION OF STATE HIGHWAY 144 AT WAVERLY, MORGAN COUNTY,
 125 YARDS NORTH OF THE MORGAN-JOHNSON COUNTY LINE, 26 FEET WEST
 OF THE CENTERLINE OF THE HIGHWAY, IN LINE WITH THE WEST
 RIGHT-OF-WAY FENCE, 1.5 FEET SOUTH OF A WHITE WOODEN WITNESS
 POST, AND ABOUT 2 FEET HIGHER THAN THE HIGHWAY. A STANDARD DISK,
 STAMPEL K86.070 X 13 1800 AND SET IN THE TOP OF A CONCRETE POST
 PROJECTING 7 INCHES ABOVE GROUND.

RECOVERY NOTE BY IN DEPT. OF NAT RES 1985
 NEW DESC - AT THE INTERSECTION OF NEW STATE ROAD 144 AND OLD STATE
 ROAD 37, IN THE SOUTHWEST QUARTER OF THE INTERSECTION, WITNESS POST
 IS DONE RIGHT-OF-WAY FENCE IS GONE, ALL OTHER INFORMATION APPEARS TO
 BE CORRECT.

ELEVATION = 685.94 (NAVD 88)

BTM #400
 RR SPIKE SET IN E FACE OF PPI#P21063" LOCATED ±180' N OF "TRACY
 NORTH DRIVE" ±40' WEST OF "SAINT CHARLES WAY"
 ELEV.=805.77

BTM #401
 RR SPIKE SET IN E FACE OF PPI#P21042" LOCATED ±6' W OF "TRACY ST."
 ±40' S OF N PARKING LOT ENTRANCE @ "CLARK PLEASANT EMPLOYEE
 HEALTH & WELLNESS CENTER"
 ELEV.=805.07

BTM #402
 CUT BOX ON TOP OF CONC PEDESTAL FOR UP ON N EDGE OF CONC.
 LOCATED @ NE MOST CORNER OF PARKING LOT FOR "199 US-31" "BIG
 SPLASH CAR WASH"
 ELEV.=806.18

BTM #403
 SE MOST CORNER OF BOTTOM CONC STEP LOCATED @ SE CORNER OF
 "STUDIO 31 SALON" "43 N. US-31" ON E FACE OF BUILDING.
 ELEV.=801.26

BTM #404
 NE CORNER OF TOP CONC STEP CONNECTED TO LEAD WALK @ "239 E MAIN
 ST" LOCATED SE QUAD OF "E MAIN ST." & "HICHER LN."
 ELEV.=799.80

BTM #405
 RR SPIKE SET IN E FACE POWERPOLE, LOCATED ±5' S OF "E MAIN ST." &
 ±XX W OF DRIVE @ "399 E MAIN ST."
 ELEV.=790.98

BTM #406
 SW CORNER OF CONC PORCH @ "49 CENTER ST."
 ELEV.=797.61

BTM #407
 RR SPIKE SET IN S FACE OF PPI# "P22C73", LOCATED ±5' E OF "CENTER
 ST." & ±150' N OF "OLEM ST."
 ELEV.=800.07


BTM #408
 RR SPIKE SET IN E FACE OF POWER POLE, LOCATED @ SW CORNER OF
 PROPERTY OF "329 CHRISTINA DR."
 ELEV.=800.89


GRADING LEGEND

X	860.00	TOP OF CURB	PROPOSED ELEVATIONS
X	859.50	EDGE OF PAVEMENT	PROPOSED ELEVATIONS
X	860.00	FINISH GRADE	(TO BE FIELD VERIFIED)
X	859.50		
X	860.00		
- - -	800	PROPOSED DRAINAGE SWALE	
- - -	800	EXISTING CONTOURS	
- - -	800	PROPOSED CONTOURS	
- - -		GRADE BREAK	
- - -		CURB HEIGHT TO TAPER FROM 0.5' TO 0.0' IN 6 LFT.	


GRADING NOTES

- CONTRACTOR SHALL PROVIDE POSITIVE DRAINAGE AWAY FROM ALL BUILDINGS IN FINAL GRADING OF SITE. NO INSTANCE SHALL DRAINAGE TOWARDS THE BUILDING FOUNDATION BE ALLOWED.
- CONTRACTOR SHALL FIELD VERIFY EXISTING PAVEMENT, SIDEWALK, AND CURB ELEVATIONS AT ALL THE IN LOCATIONS PRIOR TO CONSTRUCTION AND REPORT DISCREPANCIES TO THE ENGINEER IMMEDIATELY.
- ALL CURB RAMPS SHALL BE A.D.A. COMPLIANT AND THE LONGITUDINAL AND CROSS SLOPES SHALL NOT EXCEED THE MAXIMUM SLOPES IDENTIFIED ON THE MISCELLANEOUS DETAILS (SEE SHEET 800). CONTRACTOR SHALL NOTIFY ENGINEER IMMEDIATELY IF FIELDS CONDITIONS PREVENT CURB RAMPS FROM BEING CONSTRUCTED WITHOUT EXCEEDING MAXIMUM SLOPES.

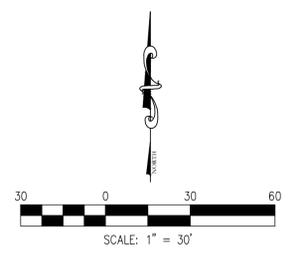


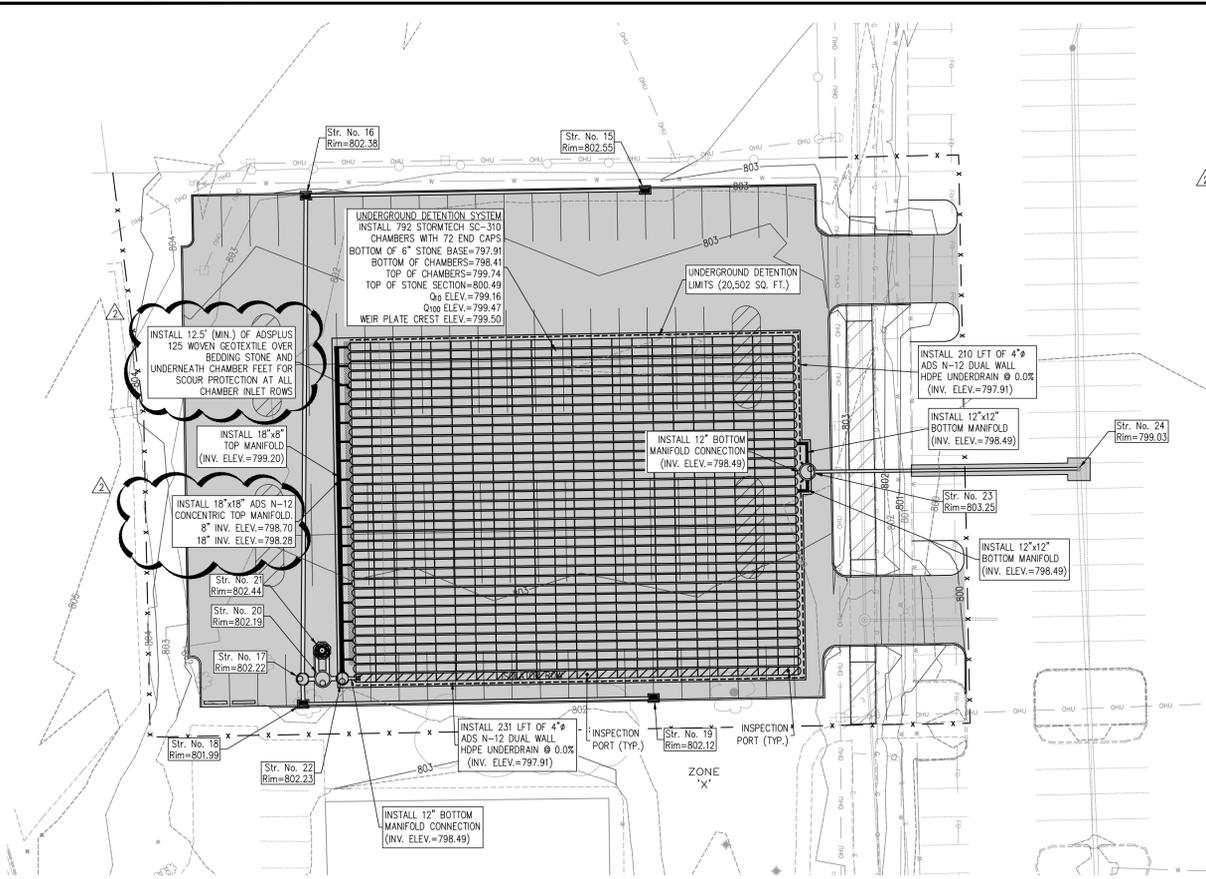


PARKING AREA 'A'

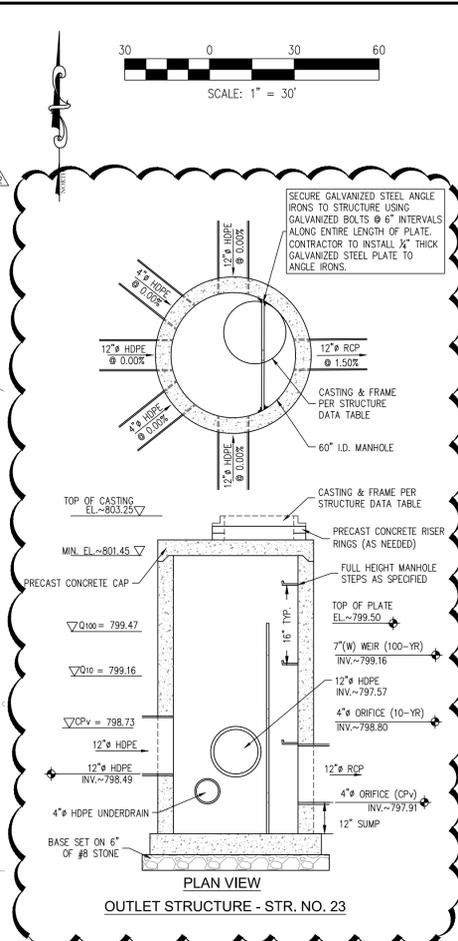

PLAN VIEW
OUTLET STRUCTURE - STR. NO. 23

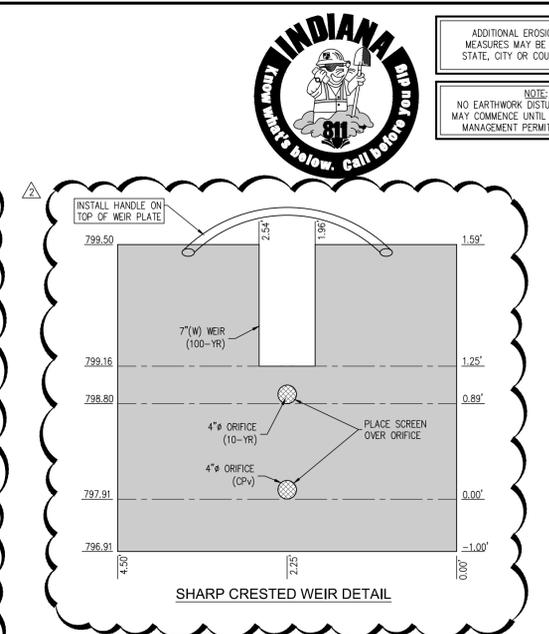

SHARP CRESTED WEIR DETAIL

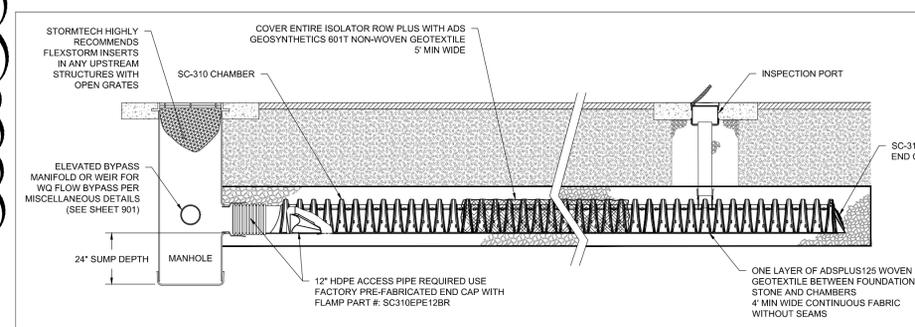


SC-310 ISOLATOR ROW PLUS DETAIL

ACCEPTABLE FILL MATERIALS: STORMTECH SC-310 CHAMBER SYSTEMS

MATERIAL LOCATION	DESCRIPTION	AASHTO MATERIAL CLASSIFICATIONS	COMPACTION / DENSITY REQUIREMENT
D	FINAL FILL: FILL MATERIAL FOR LAYER 'D' STARTS FROM THE TOP OF THE 'C' LAYER TO THE BOTTOM OF FLEXIBLE PAVEMENT OR UNPAVED FINISHED GRADE ABOVE. NOTE THAT PAVEMENT SUBBASE MAY BE PART OF THE 'D' LAYER.	ANY SOIL/ROCK MATERIALS, NATIVE SOILS, OR PER ENGINEER'S PLANS. CHECK PLANS FOR PAVEMENT SUBGRADE REQUIREMENTS.	N/A
C	INITIAL FILL: FILL MATERIAL FOR LAYER 'C' STARTS FROM THE TOP OF THE EMBEDMENT STONE ('B' LAYER) TO 18" ABOVE THE TOP OF THE CHAMBER. NOTE THAT PAVEMENT SUBBASE MAY BE A PART OF THE 'C' LAYER.	GRANULAR WELL-GRADED SOIL/AGGREGATE MIXTURES, <35% FINES OR PROCESSED AGGREGATE. MOST PAVEMENT SUBBASE MATERIALS CAN BE USED IN LIEU OF THIS LAYER.	AASHTO M145 ¹ A-1, A-2.4, A-3 OR AASHTO M43 ¹ 3, 357, 4, 467, 5, 56, 57, 6, 67, 68, 7, 78, 8, 89, 9, 10
B	EMBEDMENT STONE: FILL SURROUNDING THE CHAMBERS FROM THE FOUNDATION STONE ('A' LAYER) TO THE 'C' LAYER ABOVE.	CLEAN, CRUSHED, ANGULAR STONE	AASHTO M43 ¹ 3, 357, 4, 467, 5, 56, 57
A	FOUNDATION STONE: FILL BELOW CHAMBERS FROM THE SUBGRADE UP TO THE FOOT (BOTTOM) OF THE CHAMBER.	CLEAN, CRUSHED, ANGULAR STONE	AASHTO M43 ¹ 3, 357, 4, 467, 5, 56, 57

PLEASE NOTE:
 1. THE LISTED AASHTO DESIGNATIONS ARE FOR GRADATIONS ONLY. THE STONE MUST ALSO BE CLEAN, CRUSHED, ANGULAR. FOR EXAMPLE, A SPECIFICATION FOR #4 STONE WOULD STATE: "CLEAN, CRUSHED, ANGULAR NO. 4 (AASHTO M43) STONE."
 2. STORMTECH COMPACTION REQUIREMENTS ARE MET FOR 'A' LOCATION MATERIALS WHEN PLACED AND COMPACTED IN 6" (MAX) LIFTS USING TWO FULL COVERSAGES WITH A VIBRATORY COMPACTOR.
 3. WHERE INFILTRATION SURFACES MAY BE COMPROMISED BY COMPACTION, FOR STANDARD DESIGN LOAD CONDITIONS, A FLAT SURFACE MAY BE ACHIEVED BY RAKING OR DRAGGING WITHOUT COMPACTION EQUIPMENT. FOR SPECIAL LOAD DESIGNS, CONTACT STORMTECH FOR COMPACTION REQUIREMENTS.
 4. ONCE LAYER 'C' IS PLACED, ANY SOIL/MATERIAL CAN BE PLACED IN LAYER 'D' UP TO THE FINISHED GRADE. MOST PAVEMENT SUBBASE SOILS CAN BE USED TO REPLACE THE MATERIAL REQUIREMENTS OF LAYER 'C' OR 'D' AT THE SITE DESIGN ENGINEER'S DISCRETION.

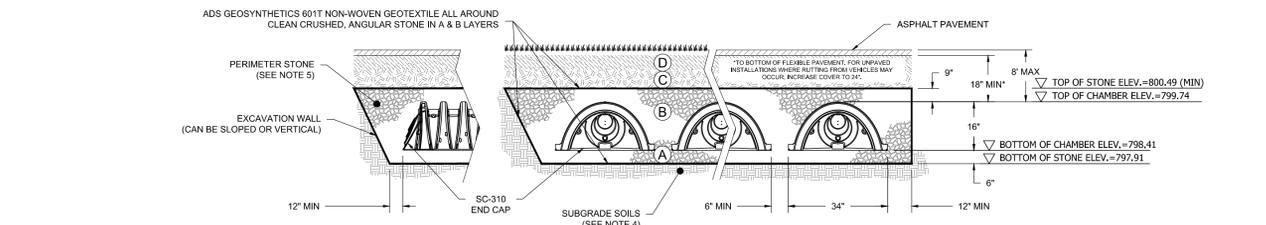


NOTES:

- CHAMBERS SHALL MEET THE REQUIREMENTS OF ASTM F2922 (POLETHYLENE) OR ASTM F2418 (POLYPROPYLENE), "STANDARD SPECIFICATION FOR CORRUGATED WALL STORMWATER COLLECTION CHAMBERS".
- SC-310 CHAMBERS SHALL BE DESIGNED IN ACCORDANCE WITH ASTM F2787 "STANDARD PRACTICE FOR STRUCTURAL DESIGN OF THERMOPLASTIC CORRUGATED WALL STORMWATER COLLECTION CHAMBERS".
- THE SITE DESIGN ENGINEER IS RESPONSIBLE FOR ASSESSING THE BEARING RESISTANCE (ALLOWABLE BEARING CAPACITY) OF THE SUBGRADE SOILS AND THE DEPTH OF FOUNDATION STONE WITH CONSIDERATION FOR THE RANGE OF EXPECTED SOIL MOISTURE CONDITIONS.
- PERIMETER STONE MUST BE EXTENDED HORIZONTALLY TO THE EXCAVATION WALL FOR BOTH VERTICAL AND SLOPED EXCAVATION WALLS.
- REQUIREMENTS FOR HANDLING AND INSTALLATION:
 - TO MAINTAIN THE WIDTH OF CHAMBERS DURING SHIPPING AND HANDLING, CHAMBERS SHALL HAVE INTEGRAL, INTERLOCKING STACKING LUGS.
 - TO ENSURE A SECURE JOINT DURING INSTALLATION AND BACKFILL, THE HEIGHT OF THE CHAMBER JOINT SHALL NOT BE LESS THAN 2".
 - TO ENSURE THE INTEGRITY OF THE ARCH SHAPE DURING INSTALLATION, a) THE ARCH STIFFNESS CONSTANT AS DEFINED IN SECTION 6.2.8 OF ASTM F2922 SHALL BE GREATER THAN OR EQUAL TO 400 LBS./FT.² AND b) TO RESIST CHAMBER DEFORMATION DURING INSTALLATION AT ELEVATED TEMPERATURES (ABOVE 73° F / 23° C), CHAMBERS SHALL BE PRODUCED FROM REFLECTIVE GOLD OR YELLOW COLORS.

***THIS CROSS SECTION DETAIL REPRESENTS MINIMUM REQUIREMENTS FOR INSTALLATION. PLEASE SEE THE LAYOUT SHEETS(S) FOR PROJECT SPECIFIC REQUIREMENTS.

SC-310 CROSS SECTION DETAIL

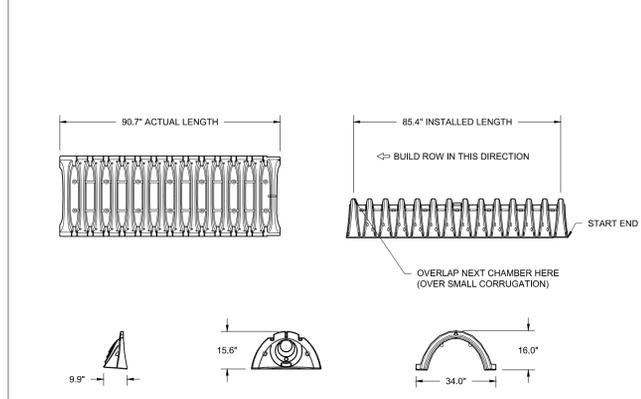

NOMINAL CHAMBER SPECIFICATIONS
 SIZE (W X H X INSTALLED LENGTH)
 CHAMBER STORAGE
 MINIMUM INSTALLED STORAGE*
 WEIGHT


PART #	STUB	A	B	C
SC310EP06T / SC310EP06TPC	6"	9.6"	5.8"	0.5"
SC310EP08B / SC310EP08BPC	8"	11.9"	3.5"	0.6"
SC310EP10T / SC310EP10TPC	10"	12.7"	1.4"	0.7"
SC310EP10B / SC310EP10BPC	12"	13.5"	0.9"	0.9"
SC310EP12B	12"	13.5"	0.9"	0.9"

ALL STUBS, EXCEPT FOR THE SC310EP12B ARE PLACED AT BOTTOM OF END CAP SUCH THAT THE OUTSIDE DIAMETER OF THE STUB IS FLUSH WITH THE BOTTOM OF THE END CAP. FOR ADDITIONAL INFORMATION CONTACT STORMTECH AT 1-888-892-2694.


* FOR THE SC310EP12B THE 12" STUB LIES BELOW THE BOTTOM OF THE END CAP APPROXIMATELY 0.25". BACKFILL MATERIAL SHOULD BE REMOVED FROM BELOW THE N-12 STUB SO THAT THE FITTING SITS LEVEL.

NOTE: ALL DIMENSIONS ARE NOMINAL

SC-310 TECHNICAL SPECIFICATIONS

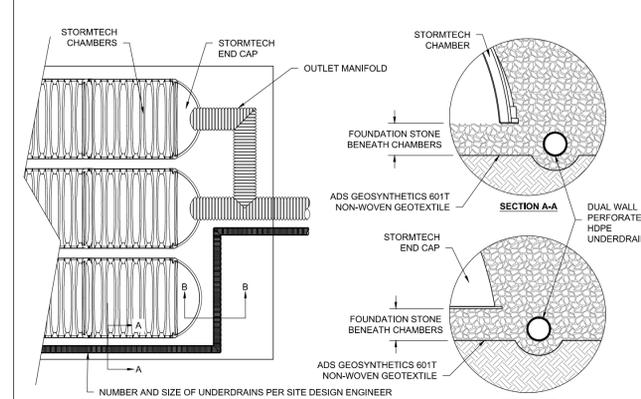

UNDERDRAIN DETAIL

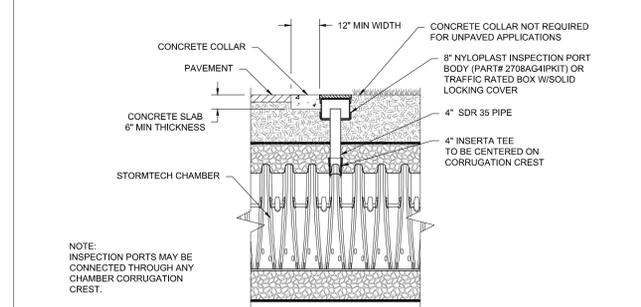

4" PVC INSPECTION PORT DETAIL (SC SERIES CHAMBER)

INDIANA DEPARTMENT OF TRANSPORTATION
811

ADDITIONAL EROSION CONTROL MEASURES MAY BE REQUIRED BY STATE, CITY OR COUNTY OFFICIALS.

NOTE:
NO EARTHWORK DISTURBING ACTIVITY MAY COMMENCE UNTIL A STORM WATER MANAGEMENT PERMIT IS OBTAINED.

PROPOSED LEGEND

- PROPERTY LINE
- SECTION LINE
- SETBACK LINE
- DITCH LINE
- STORM SEWER / MANHOLE & END SECTION
- STORM INLETS
- AQUA-SMRL UNITS
- SIGN
- PERMANENT CONSTRUCTION FENCE WITH SCREENING ON DRIVEN POSTS
- TEMPORARY CONSTRUCTION FENCE ON STANDS WITH SAND BAGS

9800
SHEET

DRAINAGE PLAN

WHITELAND HIGH SCHOOL PHASE 1A

CROSSROAD ENGINEERS, P.C.

Development Consultants
1500 N. State Street, Suite 200
Indianapolis, IN 46204
Phone: 317.331.1111
Fax: 317.331.1112
www.crossroadeng.com

JOB NO. _____

DATE: FEBRUARY 27, 2023

DESIGNED: _____

APPR. _____

DRAWN: _____

CHECKED: _____

TEN: _____

CU: _____

REGISTERED PROFESSIONAL ENGINEER

STATE OF INDIANA

NO. 1120008

DEK M. SWYDER

DATE: _____

BY: _____

DMS

DMS

APPR.

9

8

7

6

5

4

3

2

1

SHEET

600

DATE












DIRECTORY PATH : R:\In\user\cros\hwhs\Whiteland High School\Design\CAD\Plans\PHASE 1A
 FILENAME : 3/24/2023 6:43 AM / Dmsdrw

STORM PLAN AND PROFILE

WHITELAND HIGH SCHOOL PHASE 1A



NO.	DATE	APPR.	DESIGNED	DIMS	CHKD	TEN	CU
1	FEBRUARY 27, 2023						
2	03.24.23						
3	03.03.23						
4							
5							
6							
7							
8							

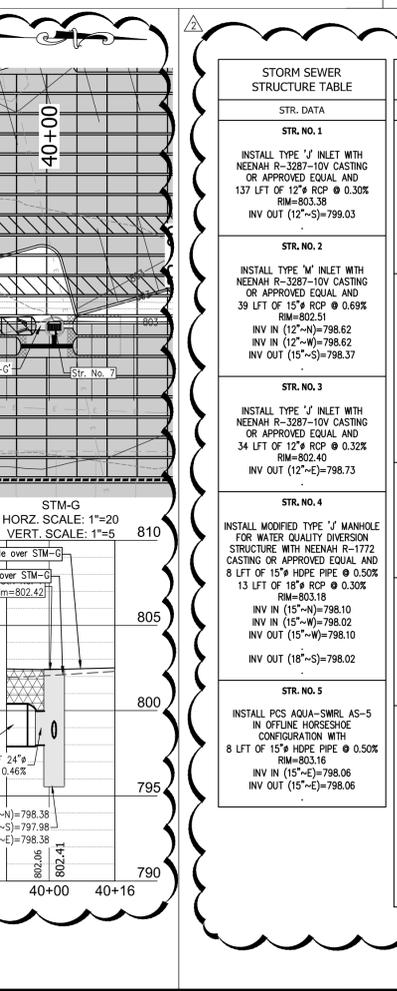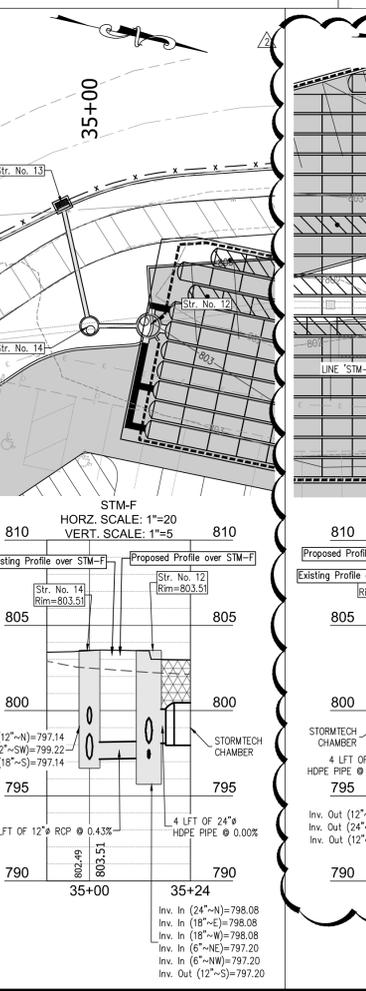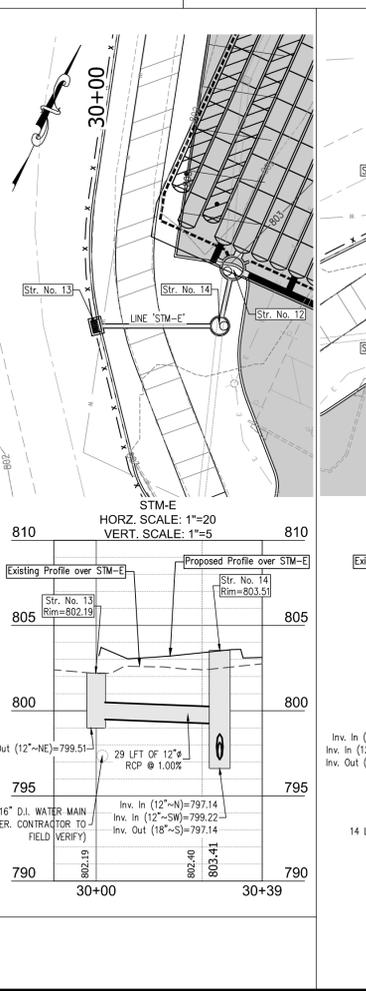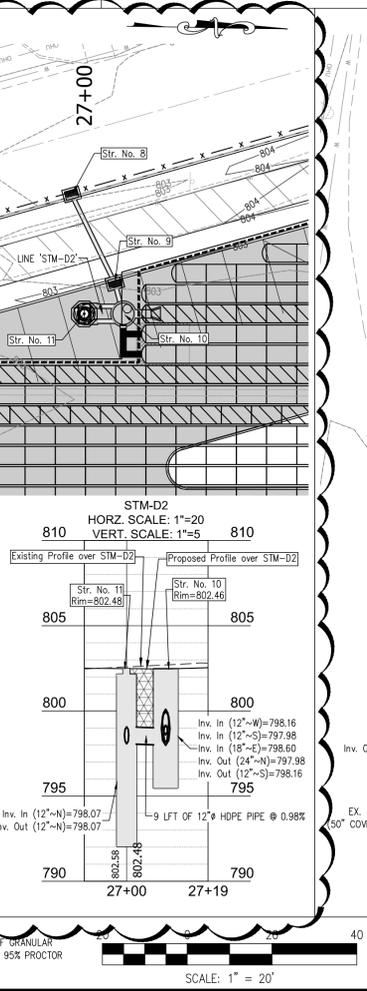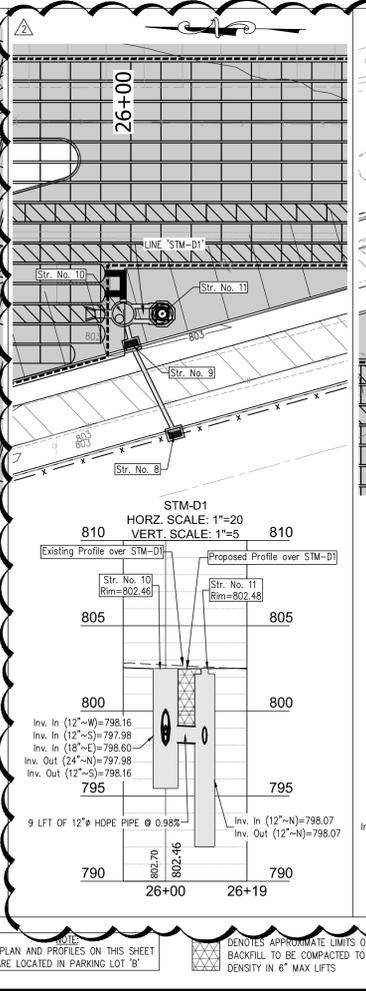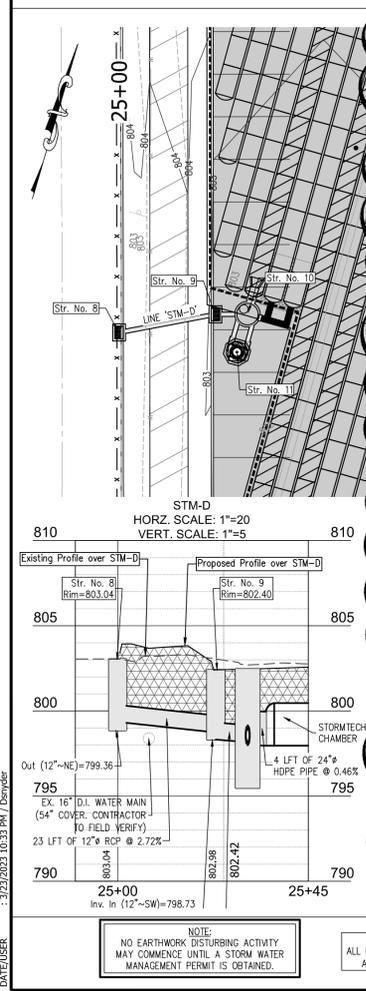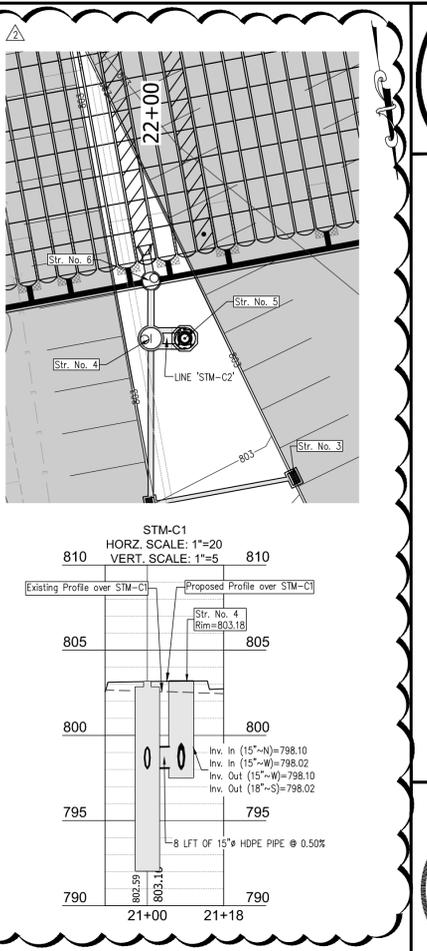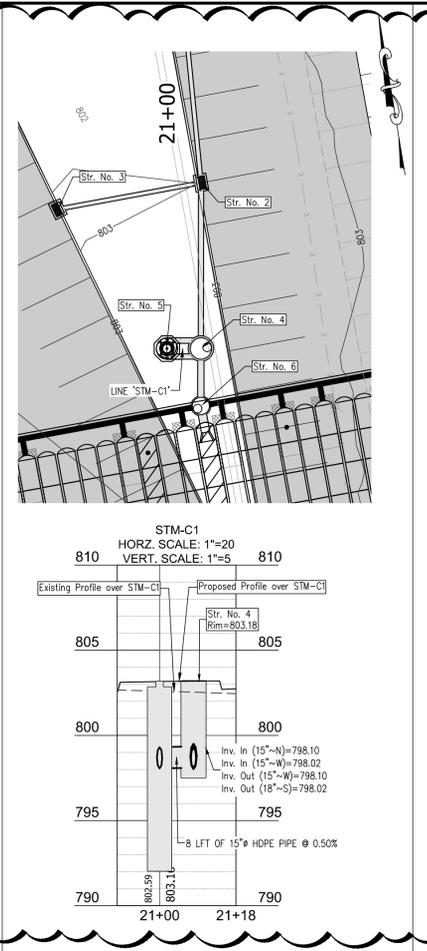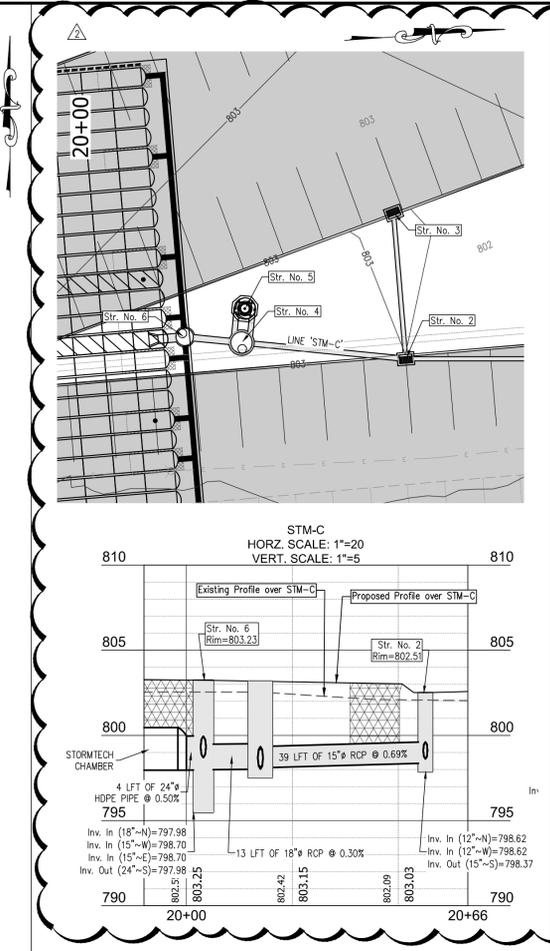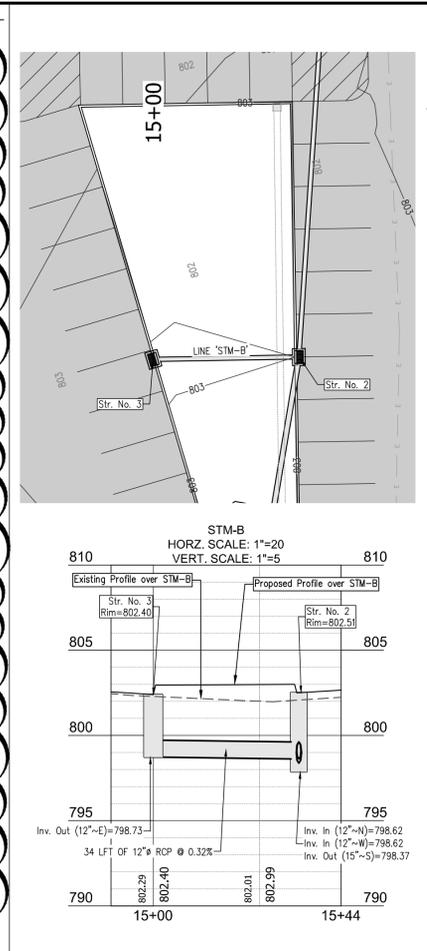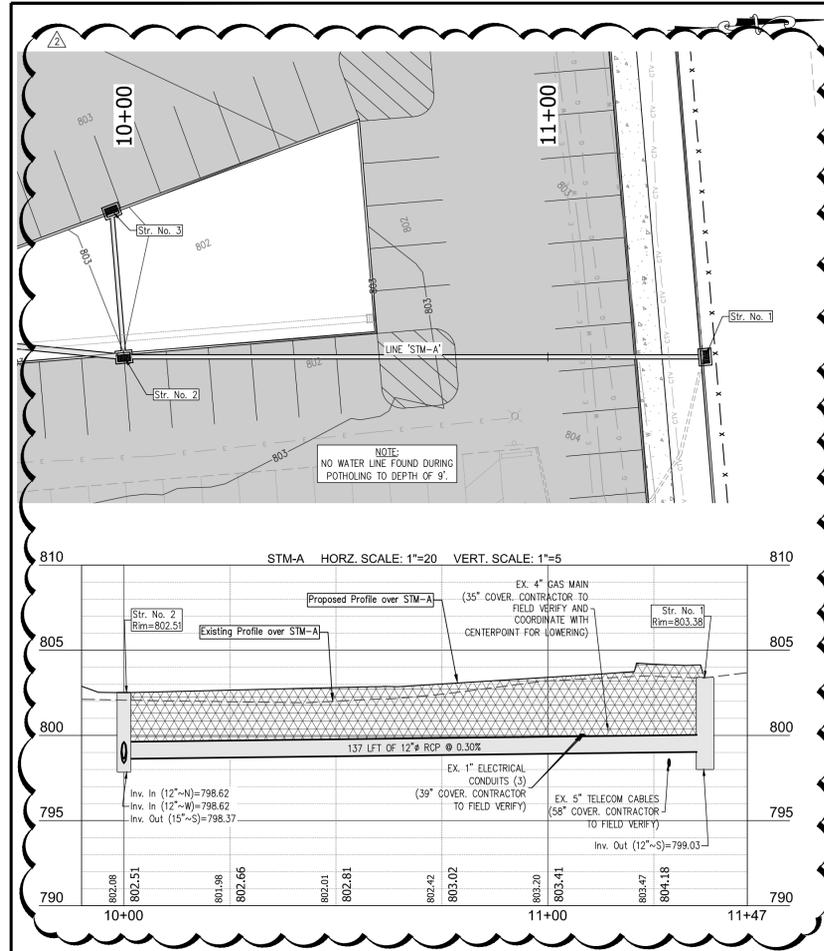


STR. DATA	STR. DATA	STR. DATA






NOTE: NO EARTHWORK DISTURBING ACTIVITY MAY COMMENCE UNTIL A STORM WATER MANAGEMENT PERMIT IS OBTAINED.

NOTE: ALL PLAN AND PROFILES ON THIS SHEET ARE LOCATED IN PARKING LOT 'B'















NOTE: DENOTES APPROXIMATE LIMITS OF GRANULAR BACKFILL TO BE COMPACTED TO 95% PROCTOR DENSITY IN 6" MAX LIFTS

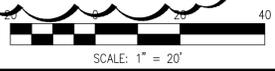

DIRECTORY PATH: R:\Adv\Inhouse\Revised\Whiteland High School\Design\CAD\Phase 1A
 FILENAME: 230223_10_33 PM / E:\user
 DATE: 2/27/2023 10:33 PM / E:\user



NO.	DATE	REVISIONS	BY	APPR.
1	03.03.23	ADDITION 2-REVISIONS PER TOWN OF WHITELAND, TRC COMMENTS, UTILITY FOTHOLOG RESULTS, AISC STORMTECH REVIEW, & CBBE REVIEW		
2	03.24.23	REVISED BASIN BY DETENTION ELEVATIONS AND OUTLET CONTROL STRUCTURE DETAIL (STR. NO. 12)		
3	03.03.23			
4				
5				
6				
7				
8				
9				

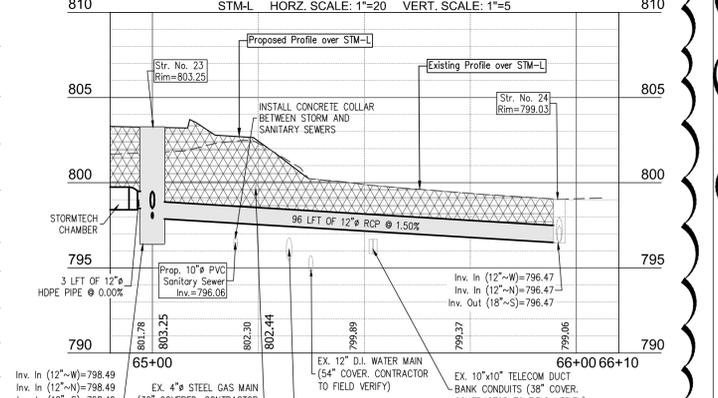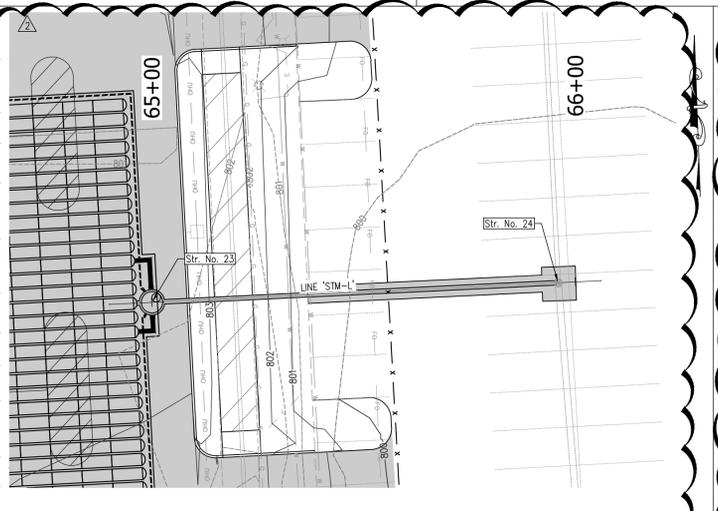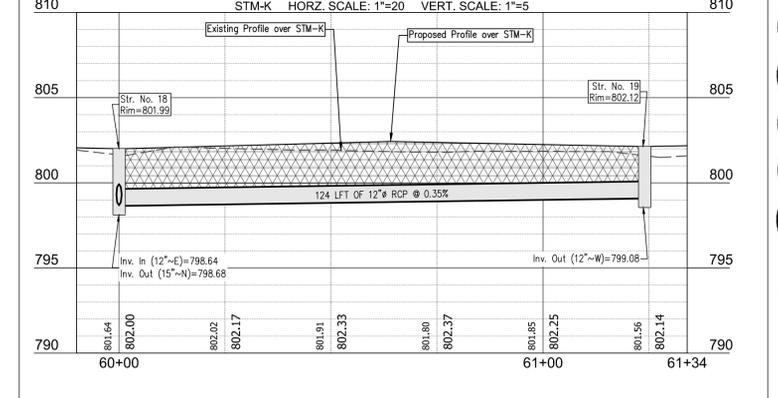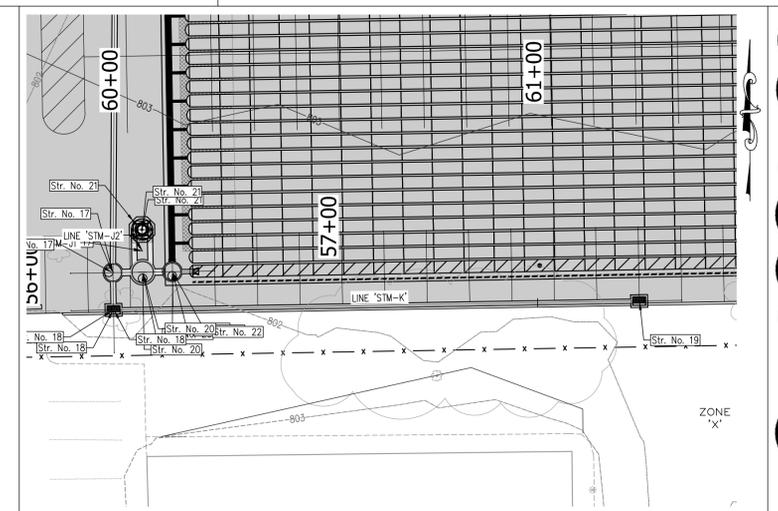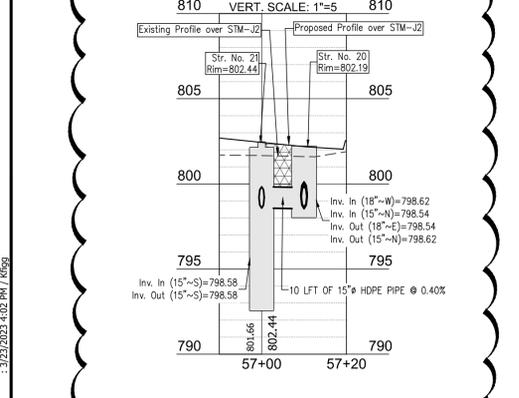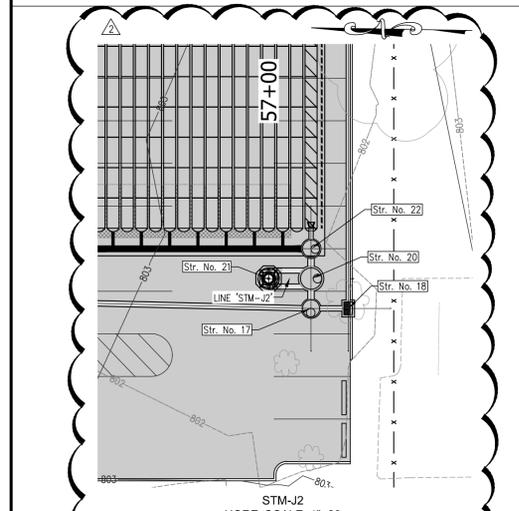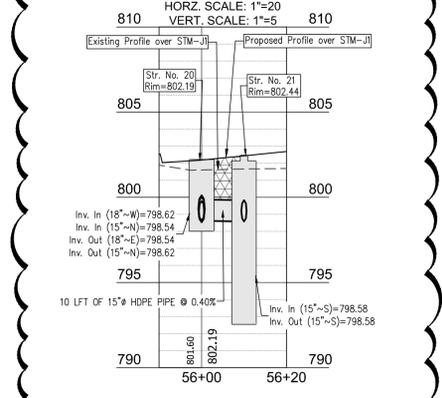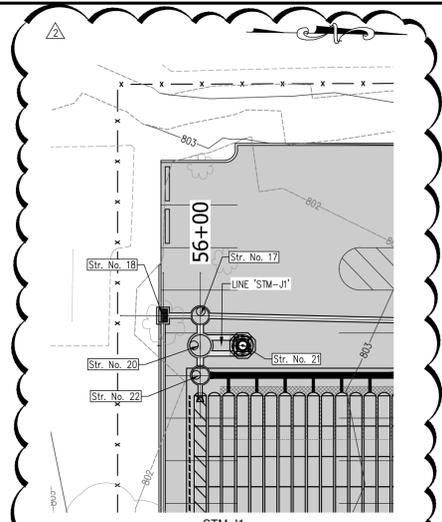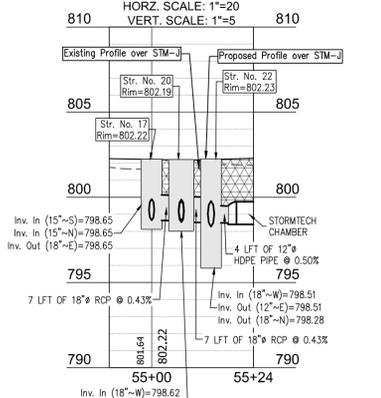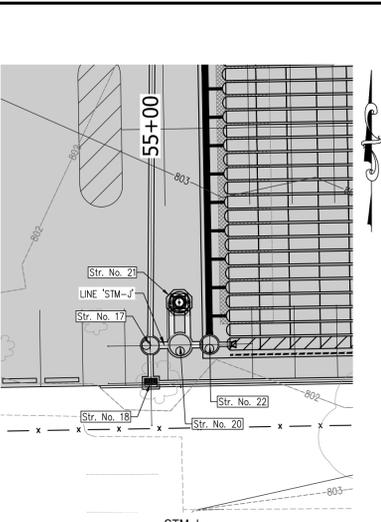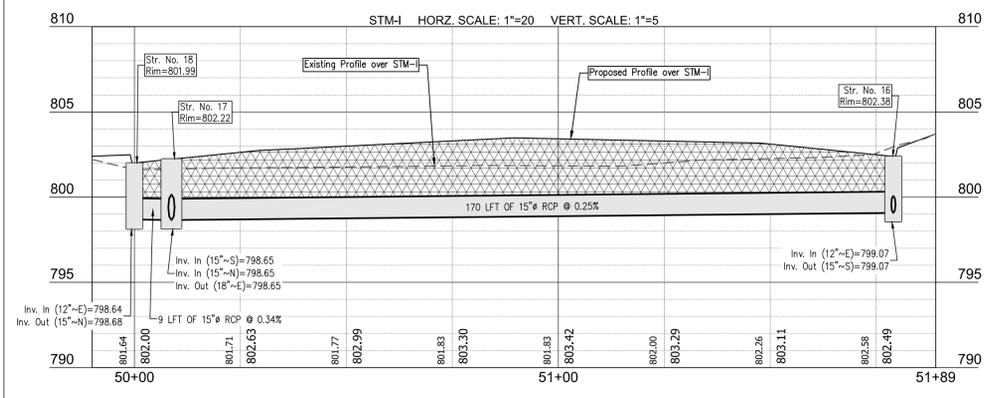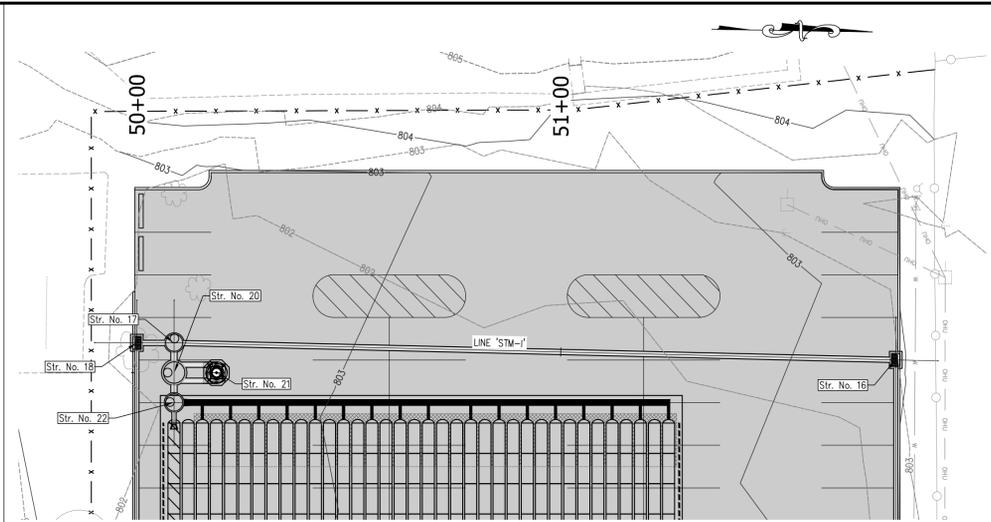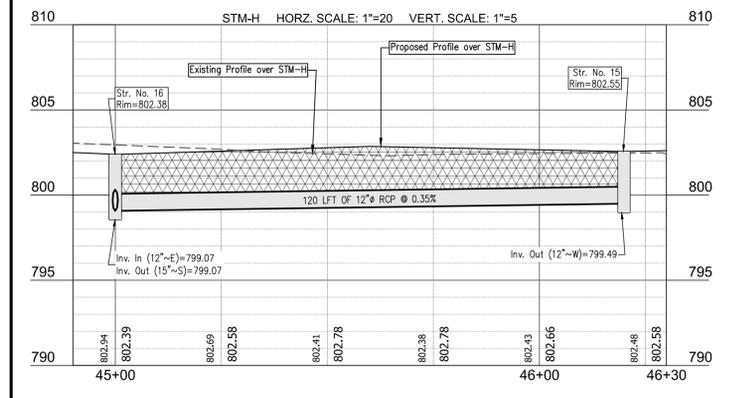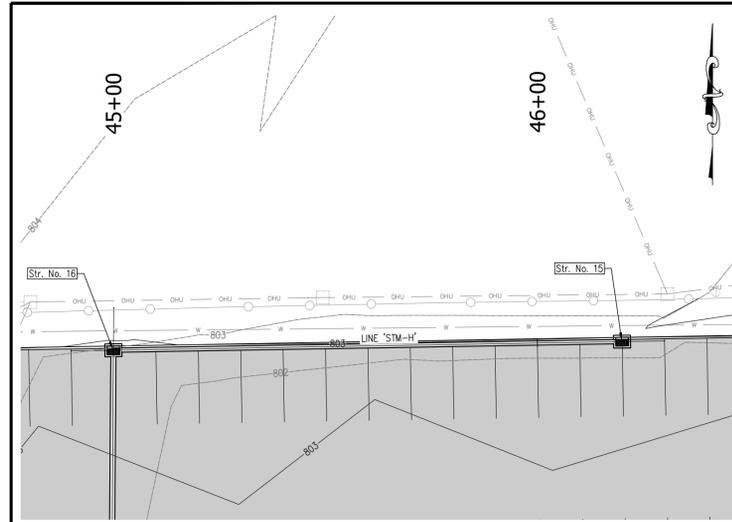

STORM SEWER STRUCTURE TABLE	STORM SEWER STRUCTURE TABLE	STORM SEWER STRUCTURE TABLE
STR. DATA	STR. DATA	STR. DATA
STR. NO. 15 INSTALL TYPE 'J' INLET WITH NEENAH R-3287-10V CASTING OR APPROVED EQUAL AND 120 LFT OF 12" RCP @ 0.35% RIM=802.55 INV OUT (12"-W)=799.49	STR. NO. 19 INSTALL TYPE 'J' INLET WITH NEENAH R-3287-10V CASTING OR APPROVED EQUAL AND 124 LFT OF 12" RCP @ 0.35% RIM=802.12 INV OUT (12"-W)=799.08	STR. NO. 23 INSTALL MODIFIED TYPE 'J' MANHOLE FOR DETENTION OUTLET CONTROL STRUCTURE WITH NEENAH R-1772 CASTING OR APPROVED EQUAL AND 96 LFT OF 12" RCP @ 1.50% RIM=803.25 INV IN (12"-W)=798.49 INV IN (12"-N)=798.49 INV IN (4"-SW)=797.91 INV OUT (12"-E)=797.91
STR. NO. 16 INSTALL TYPE 'M' INLET WITH NEENAH R-3287-10V CASTING OR APPROVED EQUAL AND 170 LFT OF 15" RCP @ 0.25% RIM=802.38 INV IN (12"-E)=799.07 INV OUT (15"-S)=799.07	STR. NO. 20 INSTALL MODIFIED TYPE 'J' MANHOLE FOR WATER QUALITY DIVERSION STRUCTURE WITH NEENAH R-1772 CASTING OR APPROVED EQUAL AND 7 LFT OF 18" RCP @ 0.43% RIM=802.19 INV IN (18"-W)=798.51 INV IN (15"-N)=798.54 INV OUT (18"-E)=798.54	STR. NO. 24 MECHANICALLY CORE EXISTING INLET AND CONNECT PIPE FROM STR. NO. 23 RIM=799.03 INV IN (12"-W)=798.47 INV IN (12"-N)=798.47 INV OUT (18"-E)=796.47
STR. NO. 17 INSTALL TYPE 'C' MANHOLE WITH NEENAH R-1772 CASTING OR APPROVED EQUAL AND 7 LFT OF 18" RCP @ 0.43% RIM=802.22 INV IN (15"-S)=798.65 INV IN (15"-N)=798.65 INV OUT (18"-E)=798.65	STR. NO. 21 INSTALL PCS AQUA-SWIRL AS-5 IN OFFLINE HORSESHOE CONFIGURATION WITH 10 LFT OF 15" HDPE PIPE @ 0.40% RIM=802.44 INV IN (15"-S)=798.58 INV OUT (15"-S)=798.58	NOTE: STR. NO. 22 SHALL HAVE A 24" SUMP AND STR. NO. 23 SHALL HAVE A 12" SUMP.
STR. NO. 18 INSTALL TYPE 'M' INLET WITH NEENAH R-3287-10V CASTING OR APPROVED EQUAL AND 9 LFT OF 15" RCP @ 0.34% RIM=801.99 INV IN (12"-E)=798.64 INV OUT (15"-N)=798.66	STR. NO. 22 INSTALL MODIFIED TYPE 'C' MANHOLE FOR ISOLATOR ROW BYPASS WITH NEENAH R-1772 CASTING OR APPROVED EQUAL AND 4 LFT OF 12" HDPE PIPE @ 0.50% RIM=802.23 INV IN (12"-W)=798.51 INV OUT (12"-E)=798.51 INV OUT (18"-W)=798.28	NOTE: RCP FOR STR. NO. 15, 16, 17, 18, 19, 20, AND 23 SHALL BE CLASS IV. ALL OTHER RCP SHALL BE CLASS III.

DENOTES APPROXIMATE LIMITS OF GRANULAR BACKFILL TO BE COMPACTED TO 95% PROCTOR DENSITY IN 6" MAX LIFTS.

NO EARTHWORK DISTURBING ACTIVITY MAY COMMENCE UNTIL A STORM WATER MANAGEMENT PERMIT IS OBTAINED.

ALL PLAN AND PROFILES ON THIS SHEET ARE LOCATED IN PARKING LOT 'A'.

SCALE: 1" = 20'



DIRECTORY PATH : R:\Adv\In\Projects\Whiteland High School\Design\CAD\Plans\PHASE 1A
 DATE/USER : 3/23/2023 4:02 PM / KJG



OVERALL EROSION CONTROL PLAN
WHITELAND HIGH SCHOOL PHASE 1A






NO.	DATE	BY	REVISIONS
1	02.24.23	DMS	REVISION 2 - REVISIONS PER TOWN OF WHITELAND, TRC COMMENTS, UTILITY POTHOLES RESULTS, ADS STORMTECH REVIEW, & CBBE REVIEW
2	03.03.23	DMS	REVISED BASIN BY RETENTION ELEVATIONS AND OUTLET CONTROL STRUCTURE DETAIL (STR. NO. 12)
3			
4			
5			
6			
7			
8			
9			

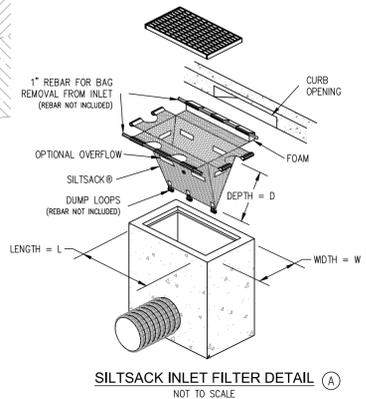
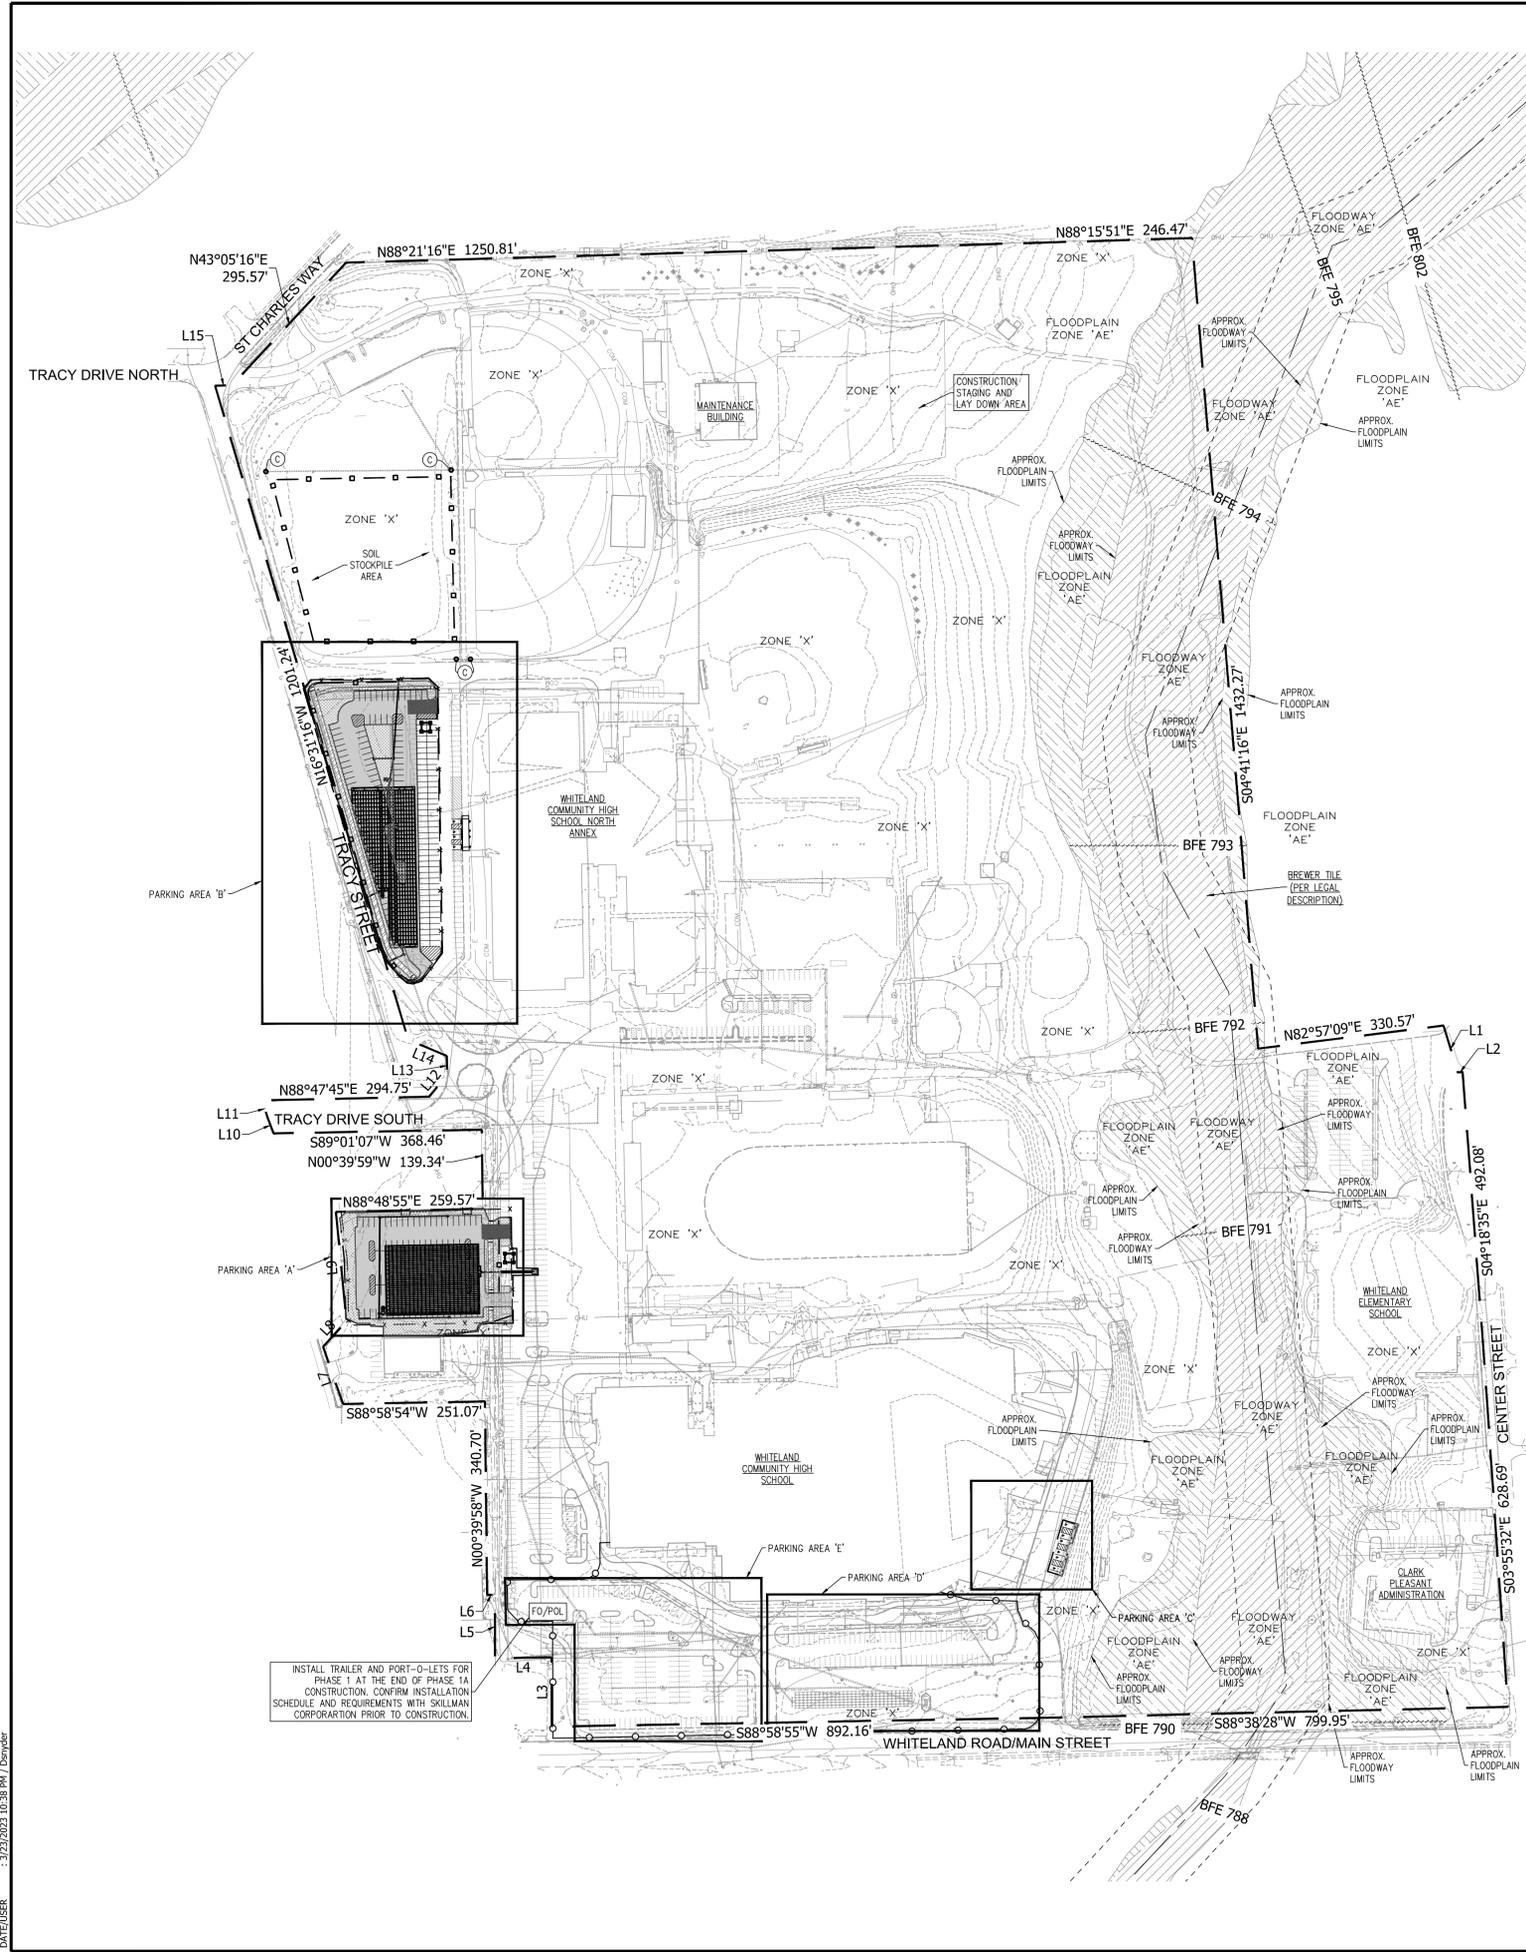


EROSION CONTROL LEGEND

[Symbol]	MULCHED SEEDING
[Symbol]	TEMPORARY CONSTRUCTION ENTRANCE (SEE DETAIL-SHEET 801)
[Symbol]	EXISTING CONTOURS
[Symbol]	PROPOSED CONTOURS
[Symbol]	SILT FENCE SLOPE CHECK (NOTE: 3 NWS-6 OR APPROVED EQUAL)
[Symbol]	CONSTRUCTION LIMITS
(A)	CURB INLET PROTECTION (SEE DETAIL-SHEET 800)
(B)	CONCRETE WASHOUT AREA (SEE DETAIL-SHEET 800)
(C)	FABRIC DROP INLET PROTECTION (SEE DETAIL-SHEET 800)

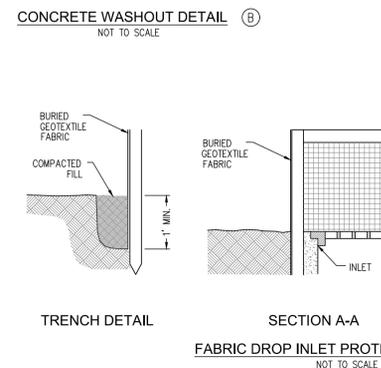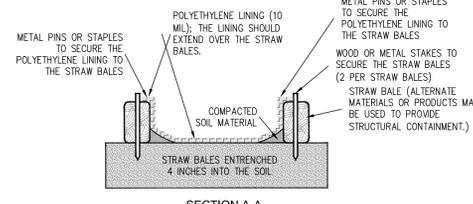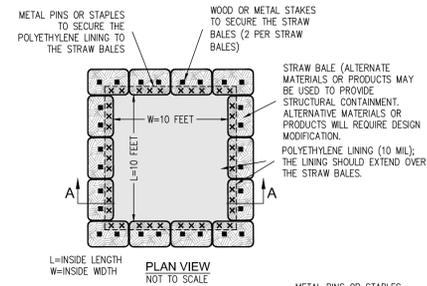

- EROSION CONTROL NOTES**
- ADDITIONAL EROSION CONTROL MEASURES MAY BE REQUIRED BY STATE, COUNTY, OR LOCAL OFFICIALS.
 - ADDITIONAL EROSION CONTROL MEASURES MAY BE REQUIRED IN THE FIELD BY THE INSPECTOR.
 - THERE SHALL BE NO DIRT, DEBRIS, OR STORAGE OF MATERIALS WITHIN EXISTING OR PROPOSED PARKING AREAS OR PUBLIC RIGHT-OF-WAY.
 - CONSTRUCTION STAGING AREA (TO BE DETERMINED BY CONTRACTOR) SHALL INCLUDE THE NOI POSTING, PORT-O-LETS, TRASH CONTAINERS, AND FUELING TANKS. CONTRACTOR SHALL NOT LOCATE STAGING AREA WITHIN PROPOSED PARKING LOTS.
 - A TRAINED INDIVIDUAL MUST PERFORM AN INSPECTION ONCE A WEEK AND AFTER EVERY 1/2" OR MORE RAIN EVENT. A LOG OF THE INSPECTION REPORTS MUST BE KEPT AND MADE AVAILABLE TO THE TOWN INSPECTOR UPON REQUEST.



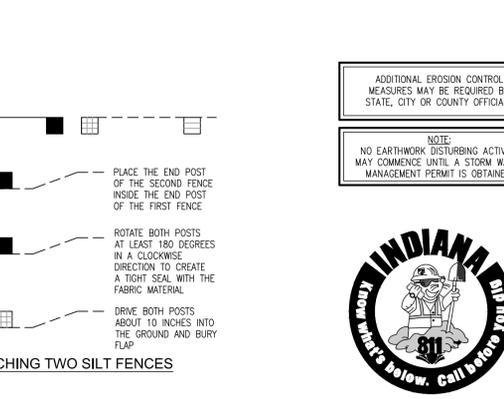
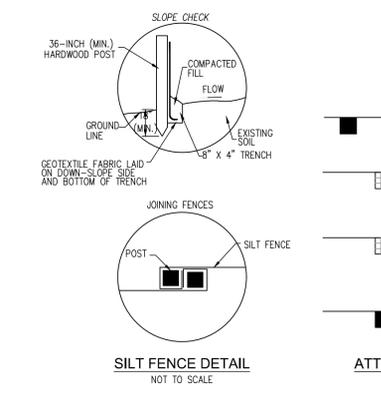


ADDITIONAL EROSION CONTROL MEASURES MAY BE REQUIRED BY STATE, CITY OR COUNTY OFFICIALS.




DIRECTORY PATH : R:\Inventures\Users\kbecker\Whiteland High School\Design\CAD\Phase\PHASE 1A
PROJECT NO. : 23230233 10-38 PM / 12/20/2023
DATE/USER : kbecker

INSTALL TRAILER AND PORT-O-LETS FOR PHASE 1 AT THE END OF PHASE 1A CONSTRUCTION. CONFIRM INSTALLATION SCHEDULE AND REQUIREMENTS WITH SKILLMAN CORPORATION PRIOR TO CONSTRUCTION.

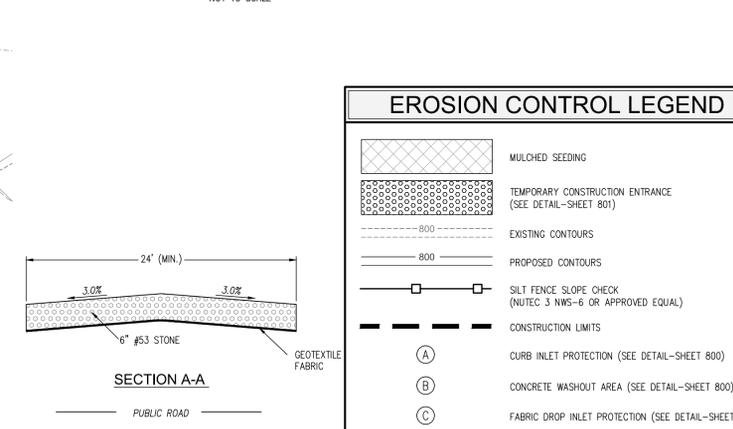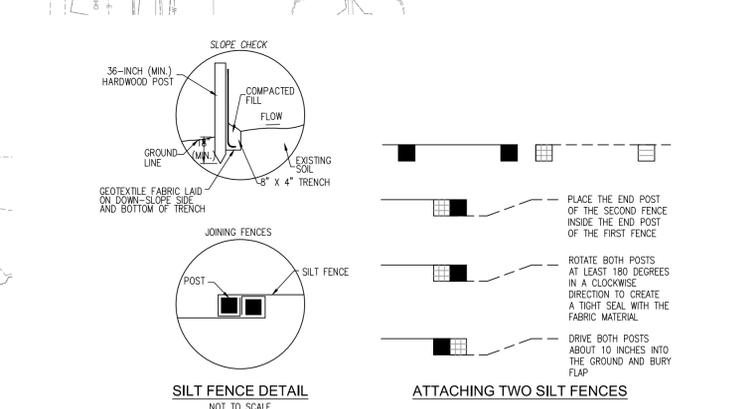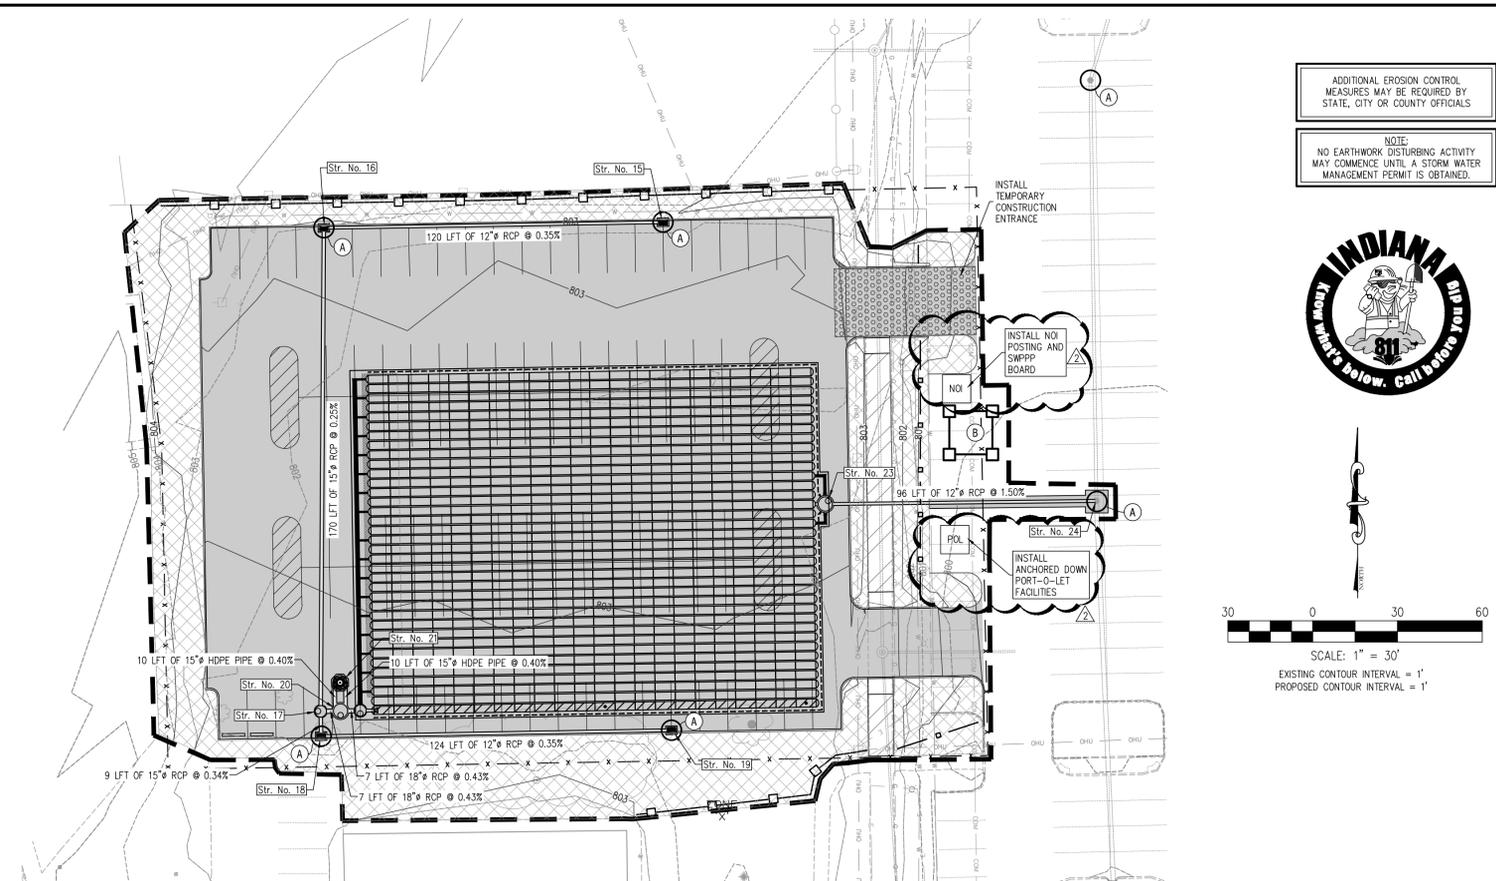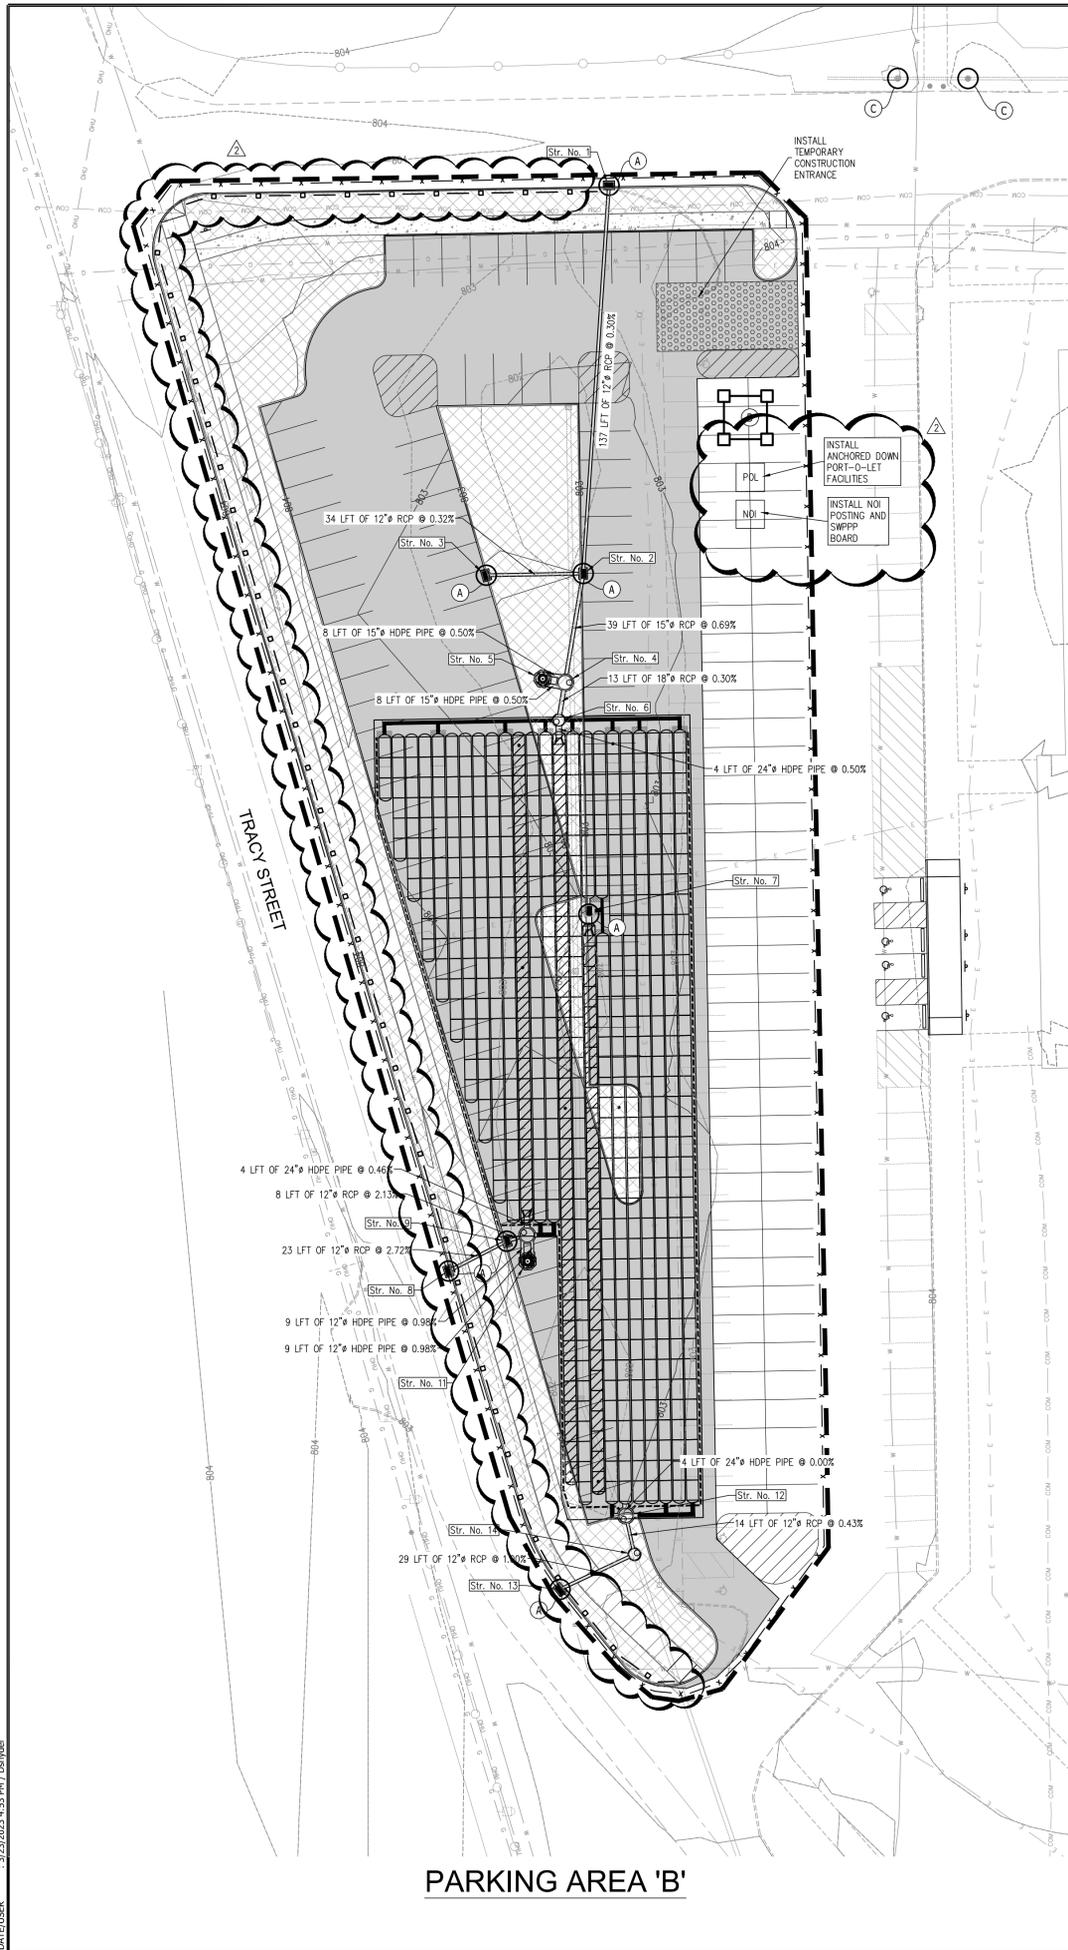

EROSION CONTROL LEGEND	
	MULCHED SEEDING
	TEMPORARY CONSTRUCTION ENTRANCE (SEE DETAIL-SHEET 801)
	EXISTING CONTOURS
	PROPOSED CONTOURS
	SILT FENCE SLOPE CHECK (NUTEC 3 NWS-6 OR APPROVED EQUAL)
	CONSTRUCTION LIMITS
	CURB INLET PROTECTION (SEE DETAIL-SHEET 800)
	CONCRETE WASHOUT AREA (SEE DETAIL-SHEET 800)
	FABRIC DROP INLET PROTECTION (SEE DETAIL-SHEET 800)

- EROSION CONTROL NOTES**
- ADDITIONAL EROSION CONTROL MEASURES MAY BE REQUIRED BY STATE, COUNTY, OR LOCAL OFFICIALS.
 - ADDITIONAL EROSION CONTROL MEASURES MAY BE REQUIRED IN THE FIELD BY THE INSPECTOR.
 - THERE SHALL BE NO DIRT, DEBRIS, OR STORAGE OF MATERIALS WITHIN EXISTING OR PROPOSED PARKING AREAS OR PUBLIC RIGHT-OF-WAY.
 - CONSTRUCTION STAGING AREA (TO BE DETERMINED BY CONTRACTOR) SHALL INCLUDE THE NOI POSTING, PORT-O-LETS, TRASH CONTAINERS, AND FUELING TANKS. CONTRACTOR SHALL NOT LOCATE STAGING AREA WITHIN PROPOSED PARKING LOTS.
 - A TRAINED INDIVIDUAL MUST PERFORM AN INSPECTION ONCE A WEEK AND AFTER EVERY 3" OR MORE RAIN EVENT. A LOG OF THE INSPECTION REPORTS MUST BE KEPT AND MADE AVAILABLE TO THE TOWN INSPECTOR UPON REQUEST.

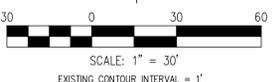

ADDITIONAL EROSION CONTROL MEASURES MAY BE REQUIRED BY STATE, CITY OR COUNTY OFFICIALS.

NOTE: NO EARTHWORK DISTURBING ACTIVITY MAY COMMENCE UNTIL A STORM WATER MANAGEMENT PERMIT IS OBTAINED.

CROSSROAD ENGINEERS, P.C.
 1000 N. STATE ST. SUITE 200
 INDIANAPOLIS, IN 46204
 TEL: 317.633.1111
 FAX: 317.633.1112
 WWW.CROSSROADENGINEERS.COM

SHEET **801**

EROSION CONTROL PLAN

WHITELAND HIGH SCHOOL PHASE 1A

JOB NO. _____

DATE: FEBRUARY 27, 2023

DRAWN: _____

DESIGNED: _____

CHECKED: _____

APPR. _____

TEN

DMS

GJI

REGISTERED PROFESSIONAL ENGINEER

NO. 11200008

STATE OF INDIANA

DEREK M. SWYDER

Derek M. Swyder

NO.	DATE	REVISIONS	BY	APPR.
1	03.03.23	REVISION 2-REVISIONS PER TOWN OF WHITELAND TPC COMMENTS, UTILITY POT-HOLING RESULTS, AIS STORMTECH REVIEW, & CBBE REVIEW		
2	03.24.23	REVISED BASIN BY RETENTION ELEVATIONS AND OUTLET CONTROL STRUCTURE DETAIL (STR. NO. 12)		

SHEET **801**

EROSION CONTROL PLAN INDEX

Table with 7 columns: ELEMENT, SHEET, ELEMENT, SHEET, ELEMENT, SHEET, SHEET. Includes Rule 5 Erosion Control Plan Index and Vicinity Map.

A1 VICINITY MAP A vicinity map depicting the project site location is located in right half of the Stormwater Pollution Prevention Plan.

A3 PROJECT MARKING The project involves the construction of two new parking lots on the Whiteland Community High School campus. The project is located along the west side of said campus located at 300 Main Street in Whiteland, Indiana. Curb, parking lots, and walks necessary for the development shall be constructed as part of the construction plans herein.

A5 LATITUDE & LONGITUDE Latitude N 39°33'11" Longitude W 86°05'11" LEGAL DESCRIPTION The Legal Description of the project site is located in the lower right quadrant of the Stormwater Pollution Prevention Plan.

A6 ADJACENT LAND USE The 11x17 inch Plat has been submitted to the respective Soils and Water Conservation District.

A7 100 YEAR FLOOD PLAINS, FLOODWAY AND FLOODWAY FRINGS By plotting graphic only, this tract of land described herein lies within the unshaded portion of Zone 'X' (areas outside the 0.2% annual chance floodplain), Floodplain Zone 'X' (areas of 0.2% annual chance flood), Floodplain Zone 'AE' (area of 1% annual chance flood with established base flood elevations), and Floodway Zone 'AE' and is in a Special Flood Hazard Area as plotted on the Federal Emergency Management Agency Flood Insurance Rate Map for Johnson County, Indiana, Community Panel No. 18081C0130D, which bears an effective date of 08/02/2007.

A8 ADJACENT LAND USE The adjacent land uses are labeled commercial (west) and residential (north, south, and east).

A9 DESCRIPTION OF TOTAL MAXIMUM DAILY LOAD (TMDL) REPORT Not applicable to this project/watershed/receiving waters.

A10 RECEIVING WATERS The receiving water for this project is Brewer Ditch via the existing onsite storm sewer system.

A11 DESCRIPTION OF 303(d) LIST Not applicable to this project/watershed/receiving waters.

A12 SOILS MAP AND DESCRIPTIONS The soils map and all pertinent soil type information are located on the upper right quadrant of the Stormwater Pollution Prevention Plan (this sheet).

A13 WETLANDS, LAKES AND WATER COURSES There are no potential wetland areas located within the project site, nor shall any potential wetland areas be disturbed as a result of construction.

A14 STATE AND/OR FEDERAL WATER QUALITY PERMITS An IDEM Construction Stormwater General Permit (CSGP) is required. No other State of Federal water quality permits are required for this project.

A15 EXISTING VEGETATION COVER The existing site consists of grass covered lots.

A16 EXISTING SITE TOPOGRAPHY Existing one-foot contours are shown on the Erosion Control Plan (sheet 801).

A17 EXISTING RUN-OFF ENTRANCE AREA Existing runoff sheet flows into the project site via the existing parking lots and buildings adjacent to the site.

A18 EXISTING RUN-OFF DISCHARGE AREA Existing runoff discharges from the project site via existing storm sewers.

A19 EXISTING STORMWATER SYSTEMS The existing stormwater system sizes and dimensions are labeled on the Topographic Survey Plan (sheets 202-208).

A20 EXISTING RETENTION/DETENTION FACILITIES There are no existing retention/detention facilities located within the limits of the proposed improvements. Existing underground detention systems are located throughout the high school campus outside the construction limits.

A21 POTENTIAL DISCHARGES TO GROUNDWATER There are no potential locations where stormwater may enter the groundwater.

A22 TOTAL PROJECT AREA The total project area covers 1102.65 acres.

A23 EXPECTED DISTURBED AREA The expected project land disturbance is 15.00 acres.

A24 PROPOSED SITE TOPOGRAPHY Proposed one-foot contours are shown on the Erosion Control Plan (sheet 801).

A25 DISTURBED AREAS The construction limits (boundary of disturbed area) are shown on the Erosion Control Plan (sheet 801).

A26 PROPOSED STORMWATER SYSTEMS The proposed stormwater system sizes and dimensions are labeled on the Erosion Control Plan (sheet 801).

A27 PROPOSED STORMWATER DISCHARGE Stormwater discharge shall leave the site via a proposed underground detention system connecting to the existing private storm sewer system onsite.

A28 SITE IMPROVEMENTS All site improvements are shown on the Erosion Control Plan (sheet 801).

A29 SOIL STOCKPILES, BORROW/DISPOSAL AREAS Topsoil shall be stockpiled in a convenient location (as determined by the owner and/or contractor) within the construction site as shown on the Erosion Control Plan (sheet 801).

A30 CONSTRUCTION SUPPORT ACTIVITIES The existing parking lot at the high school's maintenance building will be utilized as the field office, staging, and material storage area.

A31 IN-STREAM ACTIVITIES No in-stream activities are associated with this project.

STORMWATER POLLUTION PREVENTION - DURING CONSTRUCTION

POTENTIAL POLLUTANT SOURCES ASSOCIATED WITH CONSTRUCTION ACTIVITIES There is a potential for pollutants associated with construction machinery including diesel fuel, hydraulic fluid, engine oils and lubricants, antifreeze and other petroleum products. It is unavoidable for a small amount of these pollutants to contaminate soil in the grading and construction of the site. Sediment pollution from site disturbing activities shall be remedied by Erosion Control measures (see following sections).

CONSTRUCTION ENTRANCE The construction entrances shall be constructed at the northeast corners of each parking lot as indicated on the Erosion Control Plan (sheet 801). Specifications and details are located on the Stormwater Pollution Prevention Plan.

TEMPORARY & PERMANENT STABILIZATION Temporary & Permanent surface stabilization methods are shown on the Erosion Control Plan and detailed on the Stormwater Pollution Prevention Plan.

SEDIMENT CONTROL MEASURES FOR CONCENTRATED FLOW AREAS No sediment control measures for concentrated flow are required for this project.

SEDIMENT CONTROL MEASURES FOR SHEET FLOW AREAS Sediment Control measures for Sheet Flow areas are shown on the Erosion Control Plan (sheet 801). Specifications and details are located on the Stormwater Pollution Prevention Plan.

RUNOFF CONTROL MEASURES No runoff control measures are required for this project.

STORMWATER OUTLET PROTECTION MEASURES No stormwater outlet protection measures are required for this project.

GRADE STABILIZATION STRUCTURES No grade stabilization structures are required for this project.

DEWATERING ACTIVITIES If required during excavation operations, dewatering shall be completed as shown on the Erosion Control Plan. Specifications and details are located on the Erosion Control Plan and Stormwater Pollution Prevention Plan.

WATERBODY QUALITY MEASURES No waterbody quality measures are required for this project.

MONITORING AND MAINTENANCE GUIDELINES Monitoring and Maintenance Guidelines are located in the middle on the Stormwater Pollution Prevention Plan (this sheet).

STORMWATER POLLUTION PREVENTION - POST CONSTRUCTION

C1 PROPOSED POLLUTANTS AND SOURCES ASSOCIATED WITH PROPOSED LAND USE Potential pollutants include petroleum products and antifreeze from automobiles using the parking areas and sediment.

C2 PROPOSED POST CONSTRUCTION STORMWATER MEASURES Post construction stormwater quality measures shall consist of hydrodynamic separator units and isolator rows in the underground detention system.

C3 LOCATION, DIMENSIONS, SPECIFICATIONS AND DETAILS OF EACH STORMWATER QUALITY MEASURE The locations of the hydrodynamic separator units and isolator rows in the underground detention system are shown on the construction plans.

C4 STORMWATER QUALITY MEASURE IMPLEMENTATION Stormwater quality measures are implemented by construction of the site improvements which include hydrodynamic separator units and isolator rows for stormwater quality treatment.

C5 MAINTENANCE GUIDELINES OF POST CONSTRUCTION STORMWATER QUALITY MEASURES All landscape areas shall be maintained by mowing, removing trash and debris, and re-planting any vegetated areas as necessary. The proposed storm sewer inlets shall be inspected for blockage of any type after each storm event. All obstructions, trash, and debris shall be removed upon inspection. Maintenance and inspection of hydrodynamic separator units and isolator rows shall be performed in accordance with the manufacturer's recommendation and the Operations and Maintenance (O&M) Manual approved by the Town of Whiteland.

C6 OWNER RESPONSIBLE FOR POST-CONSTRUCTION STORMWATER POLLUTION PREVENTION PARTNER: Clark Pleasant Community School Corporation Operator: Clark Pleasant Community School Corporation

MONITORING AND MAINTENANCE GUIDELINES

GRAVEL CONSTRUCTION DRIVE AND PARKING AREA: A. Inspect daily and after each storm event. Immediately remove mud and sediment tracked or washed onto public roads.

B. Top dress with clean aggregate as needed. Reshape pad as needed for drainage and runoff control. C. Flushing should only be used if the water can be conveyed into a sediment trap or basin.

TOPSOIL: A. Inspect daily until vegetation is established. B. Check for erosion or damage of newly spread topsoil and repair immediately.

TEMPORARY AND PERMANENT SEEDING: A. Inspect seeding within 24 hours of each rain event and at least once every seven calendar days until vegetation is established.

B. Check for erosion or removal of mulch and repair immediately. C. Plan to add fertilizer following growing season according to soil test recommendations.

D. Repair damaged, bare, or sparse areas by filling any gullies, re-fertilizing, over- or re-seeding, and mulching. E. If plant cover is sparse or patchy, review the plant materials chosen, soil fertility, moisture condition, and mulching; repair the affected area either by over-seeding or by re-seeding and mulching after re-preparing the seed bed.

F. If vegetation fails to grow, consider soil testing to determine acidity or nutrient deficiency problems. G. If additional fertilization is needed to get a satisfactory stand, do so according to soil test recommendations. H. Reference INDOT Specification 621.05.

MULCHING: A. Inspect within 24 hours of each rain event to check for movement of mulch or for erosion. B. If washout, breakage, or erosion is present, repair damage areas, re-seed, apply new mulch, and anchor mulch in place.

C. Continue inspections until vegetation is firmly established. D. Reference INDOT Specification 621.05.

SILT FENCE: A. Inspect within 24 hours of each rain event and at least once every seven calendar days. B. If fence fabric tears, starts to decompose, or in any way becomes ineffective, replace the affected portion immediately.

C. Remove deposited sediment when it reaches half the height of the filter at its lowest point or is causing the fabric to bulge. D. Take care to avoid undermining the fence during clean out. E. After the contributing drainage area has been stabilized, remove the fence and sediment deposits, bring the disturbed area to grade and stabilize.

SILT SOCK INLET PROTECTION: A. Inspect the silt sock inlet protection periodically and after each "X" storm event. B. Remove deposited sediment when it reaches half the height of the filter at the lowest point. C. Remove the Silt Sock Inlet Protection and sediment deposits after contributing drainage area is stabilized.

FABRIC DROP INLET PROTECTION: A. Inspect the fabric barrier after storm events, and make needed repairs immediately. B. Remove sediment from the pool area to provide storage for the next storm. Avoid damaging or undercutting the fabric during sediment removal. C. When the contributing drainage area has been stabilized, remove and properly dispose of all construction material and sediment, grade the area to the elevation of the top of the inlet, then stabilize.

CONCRETE WASHOUT: A. Concrete washout area shall be installed prior to any concrete placement on site. B. Signs shall be placed at the construction entrance, at the washout area, and elsewhere as necessary to clearly indicate the location of the concrete washout area to operators of concrete trucks and pump trucks. C. The concrete washout area shall be repaired and enlarged or cleaned out as necessary to maintain capacity for washed concrete. D. At the end of construction, all concrete shall be removed from the site and disposed of at an approved waste site. E. When the concrete washout area is removed, the disturbed area shall be seeded and mulched or otherwise stabilized in a manner approved by the inspector.

CONSTRUCTION SEQUENCE & SCHEDULE OF EROSION CONTROL IMPLEMENTATION

- 1. Notify the Town of Whiteland (317-530-9233) at least 48 hours prior to starting construction.
2. Install silt fence per the Erosion Control Plan (sheet 801) before any land disturbing activity begins.
3. Begin removal operations.
4. Install temporary construction entrances per Erosion Control Plan (sheet 801). The construction entrances shall remain in place until the completion of all earthwork operations. The concrete washout areas shall remain in place until the completion of all concrete placement.
5. Install concrete washouts per Erosion Control Plan (sheet 801). Concrete washouts shall remain in place until all concrete work is complete.
6. Strip topsoil within construction limits and stockpile within the project limits shown on the Erosion Control Plan (sheet 801).
7. Begin earthwork operations.
8. Federal, state, and local requirements should be observed for any stationary above ground storage tanks.
9. Inspect and maintain.
10. Immediately clean up spills and properly dispose of contaminated soils.
11. Final grading operations.
12. Final paving operations. All temporary erosion control measures, except those specified for removal in the sequences above, shall remain in place until vegetation is secure.

GENERAL EROSION CONTROL REQUIREMENTS FOR COMPLIANCE WITH IDEM GENERAL PERMIT RULES FOR STORM WATER RUNOFF FROM CONSTRUCTION SITES

- 1. All Erosion Control practices shall be in accordance with the latest edition of the INDIANA STORM WATER QUALITY MANUAL.
2. The Erosion Control measures included in this plan shall be installed prior to initial land disturbance activities or as soon as practical. Sediment shall be prevented from discharging from the project site by installing and maintaining silt fence, straw bales, sediment basins, etc. As shown on this plan, energy-dissipation devices or Erosion Control at the outfall of the storm sewer system shall be installed at the time of the construction of the outfall.
3. All on-site storm drain inlets shall be protected against sedimentation with silt sock inlet filters, filter fabric, or equivalent barriers as shown on this plan.
4. Except as prevented by inherent weather conditions or other circumstances beyond the control of the contractor/owner appropriate Erosion Control practices will be initiated within (7) seven days of the last land disturbing activity at the site. The site shall be stabilized by seeding, sodding, mulching, covering, or by other equivalent Erosion Control measures.
5. This Erosion Control plan shall be implemented on all disturbed areas within the construction site. All measures involving Erosion Control practices shall be installed under the guidance of a qualified person experienced in Erosion Control and following the plans and specifications included herein.
6. During the period of construction activity, all sediment basins and other Erosion Control measures shall be maintained by the contractor. At the completion of construction, the contractor shall coordinate the transfer of required maintenance responsibilities with the owner.
7. Public or private roadways shall be kept cleared of accumulated sediment. Bulk clearing of accumulated sediment shall include flushing the area with water. Cleared sediment shall be returned to the point of heavy origin or other suitable location.
8. The contractor shall control wastes, garbage, debris, wastewater, and other substances on the site in such a way that they shall not be transported from the site by the action of winds, storm water runoff, or other forces. Proper disposal or management of all wastes and unused building materials appropriate to the nature of the waste or material is required.
9. Additional Erosion Control measures may be required by state or county agencies.

ADDITIONAL MATERIAL HANDLING AND SPILL PREVENTION PLAN

A. PURPOSE The purpose of this plan is two fold: 1. To help protect the health and safety of those working on the site as well as the environment. 2. Preventing the contamination of storm water runoff. Pollutants generated onsite may include gasoline, diesel fuel, oils, grease, paints, pesticides, nutrients, concrete washout, soil, solvents, paper, plastic, Styrofoam, metals, glass and other forms of liquid or solid wastes.

B. PREVENTION AND READINESS 1. The contractor or responsible party will prepare a contact list in the event of a spill on the site. The contact list will have names and contact numbers. The contact list will specify first responders and a chain of command. Include information on what circumstances require the initiation of the contact list and chain of command.
2. The contractor/owner shall maintain a list of qualified contractors, Vac-Trucks, tank pumpers and other equipment or businesses qualified to do clean-up operations. Absorbent materials and supplies need to be available onsite in sufficient quantities to address minor spills. All employees need to be educated on the proper application of the absorbent materials.
3. All maintenance and equipment operators must be aware and trained for prevention of spills. A continuing education program is required for new employees and emphasizing the importance to all employees.
4. All materials used in the course of a cleanup will be disposed in a manner approved by Indiana Department of Environmental Management.
5. Using water to flush spilled material will not be permitted unless authorized by a state, federal, or local agency. Trops can be used to cover spilled material during rain events.

C. SPILL RESPONSE 1. Inspect daily and after each storm event to check for movement of mulch or for erosion.
2. If washout, breakage, or erosion is present, repair damage areas, re-seed, apply new mulch, and anchor mulch in place.
3. Continue inspections until vegetation is firmly established.
4. Reference INDOT Specification 621.05.

SEMI-SIGNIFICANT SPILLS - Approximately ten gallons or less of pollutant with no contamination of ground or surface waters. Minor spills can be generally controlled by the first responder with help from other site personnel. This response may require other operations to stop to make sure the spill is quickly and safely addressed. At the discovery of the spill:
1. Contain spill to prevent material from entering storm or ground water. Do not flush with water or bury.
2. Use absorbent material to clean-up spill material and any subsequently contaminated soil and dispose of properly.

HAZARDOUS SPILLS - More than ten gallons, there is the potential for death, injury or illness to humans or animals, or the potential for surface or groundwater pollution.
1. Control or contain the spill without risking bodily harm. Temporarily plug storm drains if possible to prevent migration of the spill into the stormwater system.
2. Contact the local Fire Department at 911 to report any hazardous material spill.
3. Contact supervisors and designated inspectors immediately. Other county or municipal officials (list as needed) responsible for storm water facilities should be contacted as well. The contractor is responsible for having these contact numbers available at the job site. A written report should be submitted to the owner as soon as possible.
4. As soon as possible but within 2 hours of discovery, contact the Department of Environmental Management.

OFFICE OF EMERGENCY RESPONSE 1-888-233-7745. The following information should be noted for IDEM or the National Response Center.
1. Name, address and phone number of person making the spill report
2. The location of the spill
3. The time of the spill
4. Identification of the spilled substance
5. Approximate quantity of the substance that has been spilled or may be further spilled
6. The duration and source of the spill
7. Name and location of the damaged waters
8. Name of spill response organization
9. What measures were taken in the spill response
10. Other information that may be significant.

ADDITIONAL REGULATION OR REQUIREMENTS MAY BE PRESENT. A spill response professional should be consulted to make sure all appropriate and required steps have been taken. Contaminated solids should only be removed from the site after approval is given by Emergency Response.

THE FOLLOWING PROCEDURES AND PRACTICES WILL HELP PREVENT UNNECESSARY SPILLS

I. Vehicle and Equipment Fueling Description and Purpose:
1. Vehicle equipment fueling procedures and practices are designed to prevent fuel spills and leaks, and reduce or eliminate contamination of stormwater. This can be accomplished by using offsite facilities, fueling in designated areas only enclosing or covering stored fuel, implementing spill controls, and training employees and subcontractors in proper fueling procedures.

Limitations:
1. Onsite vehicle and equipment fueling should only be used where it is impractical to send vehicles and equipment offsite for fueling.
2. Fueling operations should not be left unattended.

Implementation:
1. Use offsite fueling stations as much as possible. These businesses are better equipped to handle fuel and spills properly. Performing this work offsite can also be economical by eliminating the need for a separate fueling area at a site.
2. Discourage "topping-off" of fuel tanks.
3. Absorbent spill cleanup materials and spill kits should be available in fueling areas and on fueling trucks, and should be disposed of properly after use.
4. Drip pans or absorbent pads should be used during vehicle and equipment fueling, unless the fueling is performed over an impermeable surface in a dedicated fueling area.
5. Fueling materials promptly and dispose of properly.
6. Avoid mobile fueling of mobile construction equipment around the site; rather, transport the equipment to designated fueling areas.
7. Train employees and subcontractors in proper fueling and cleanup procedures.
8. Dedicated fueling areas should be protected from stormwater run-on and runoff, and should be located at least 50 feet away from the downstream drainage facilities and watercourses. Fueling must be performed on level-grade areas.
9. Protect fueling areas with berms and dikes to prevent run-on, and to contain spills.
10. Nozzles used in vehicle and equipment fueling should be equipped with an automatic shutoff to control drips. Fueling operations should not be left unattended.

II. Solid Waste Management Description and Purpose:
1. Solid waste management procedures and practices are designed to prevent or reduce the discharge of pollutants to stormwater from solid or construction waste by providing designated waste collection areas and containers, arranging for regular disposal, and training employees and subcontractors.
2. Domestic wastes including food containers such as beverage cans, coffee cups, paper bags, plastic wrappers, and cigarettes.
3. Construction waste including brick, mortar, lumber, steel and metal scraps, pipe and electrical cuttings, non-hazardous equipment parts, Styrofoam and other materials sent transport and package construction materials.

Implementation:
1. Solid waste generated from trees and shrubs removed during land clearing, demolition of existing structures (mobile, and building construction).
2. Packaging materials including wood, paper, and plastic.
3. Scrap or surplus building materials including scrap metals, rubber, plastic, glass pieces, and masonry products.
4. Domestic wastes including food containers such as beverage cans, coffee cups, paper bags, plastic wrappers, and cigarettes.
5. Construction waste including brick, mortar, lumber, steel and metal scraps, pipe and electrical cuttings, non-hazardous equipment parts, Styrofoam and other materials sent transport and package construction materials.



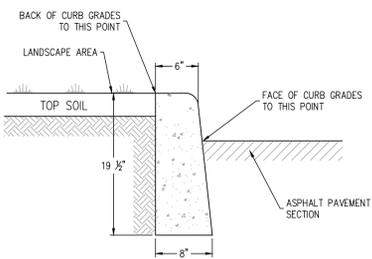


STRAIGHT CONCRETE CURB
NOT TO SCALE

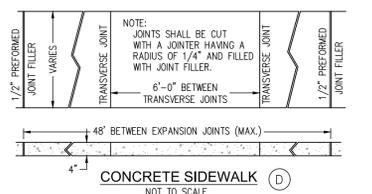


CONCRETE SIDEWALK
NOT TO SCALE

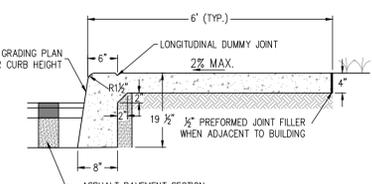


MONOLITHIC CONCRETE CURB AND SIDEWALK
NOT TO SCALE

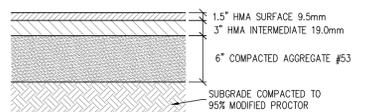


TYPICAL SECTION LIGHT DUTY ASPHALT PAVEMENT
NOT TO SCALE

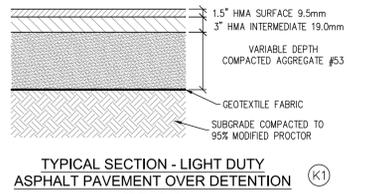


TYPICAL SECTION - LIGHT DUTY ASPHALT PAVEMENT OVER DETENTION
NOT TO SCALE

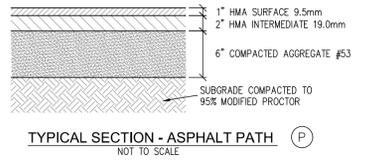


TYPICAL SECTION - ASPHALT PATH
NOT TO SCALE

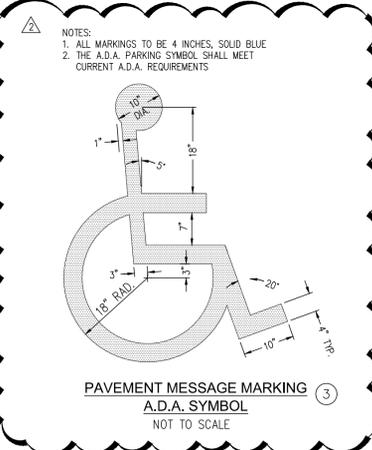


PAVEMENT MESSAGE MARKING A.D.A. SYMBOL
NOT TO SCALE

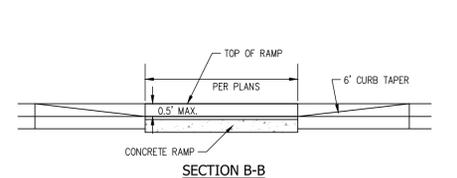


SECTION B-B

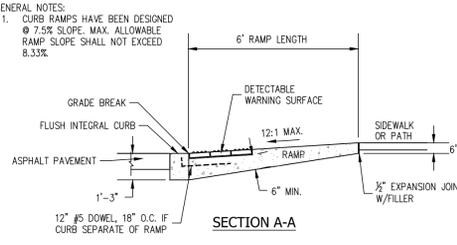


SECTION A-A

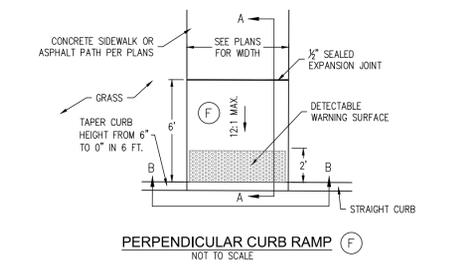


NOT TO SCALE

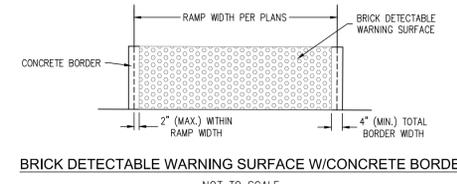


BRICK DETECTABLE WARNING SURFACE W/CONCRETE BORDER
NOT TO SCALE

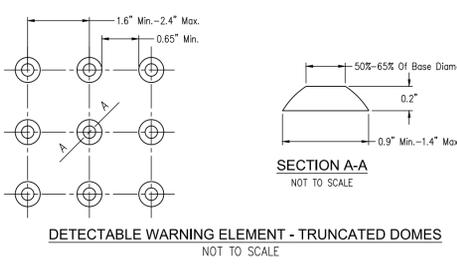


DETECTABLE WARNING ELEMENT - TRUNCATED DOMES
NOT TO SCALE

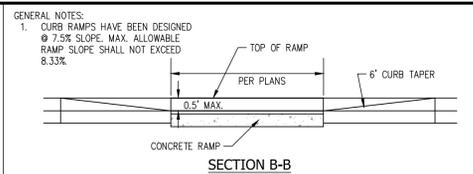


SECTION B-B

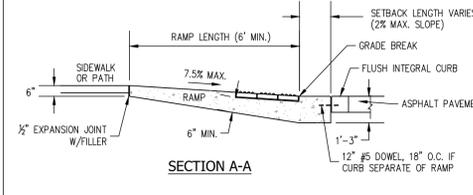


SECTION A-A

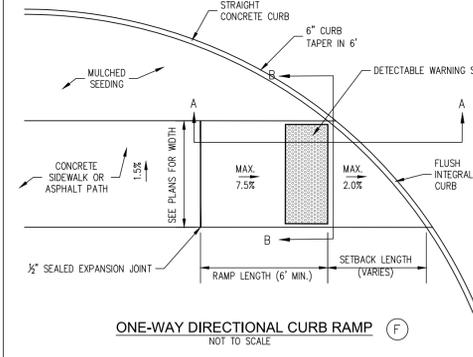


NOT TO SCALE

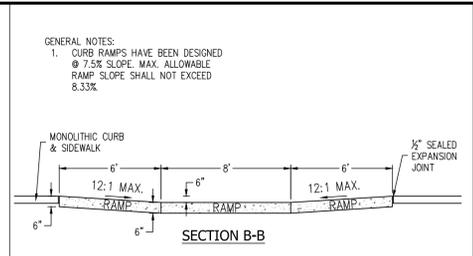


SECTION B-B

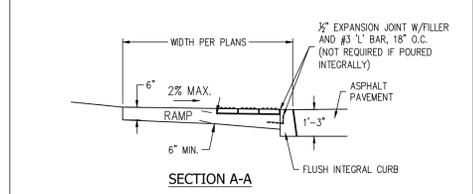


SECTION A-A

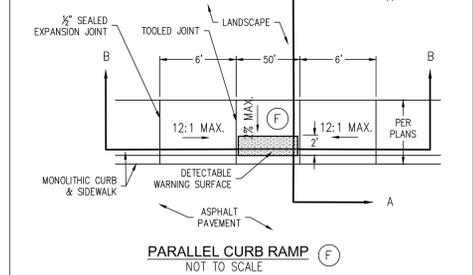


NOT TO SCALE

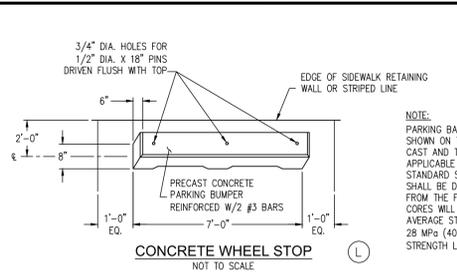


CONCRETE WHEEL STOP
NOT TO SCALE

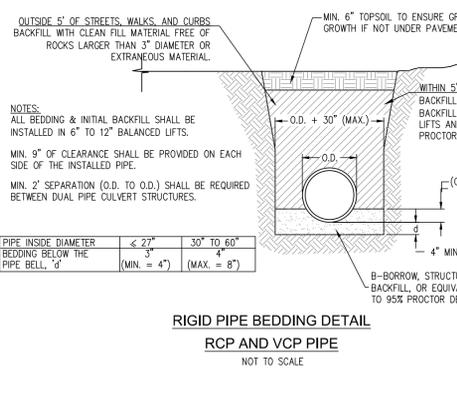


RIGID PIPE BEDDING DETAIL RCP AND VCP PIPE
NOT TO SCALE

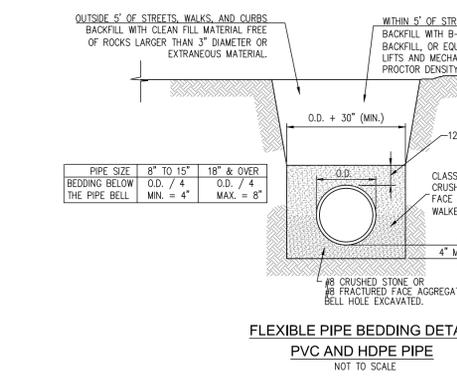


FLEXIBLE PIPE BEDDING DETAIL PVC AND HDPE PIPE
NOT TO SCALE

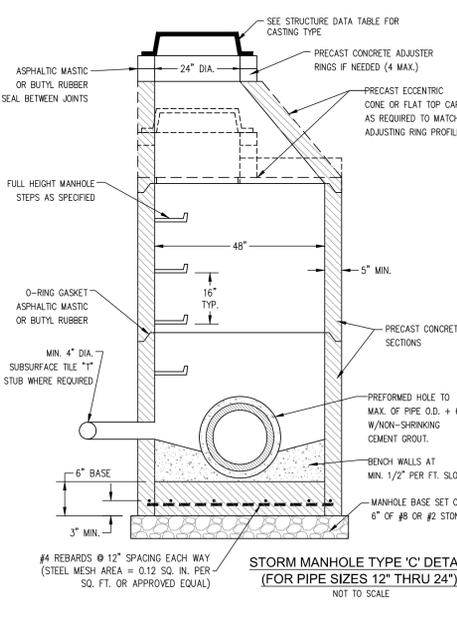


STORM MANHOLE TYPE 'C' DETAIL (FOR PIPE SIZES 12" THRU 24")
NOT TO SCALE

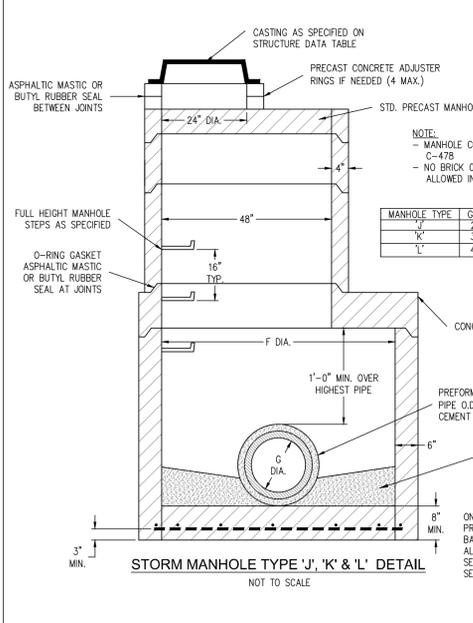

STORM MANHOLE TYPE 'J', 'K' & 'L' DETAIL
NOT TO SCALE

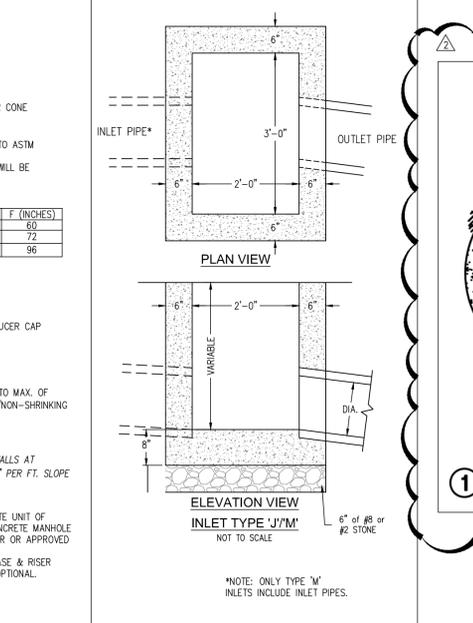

ELEVATION VIEW INLET TYPE 'J' M
NOT TO SCALE

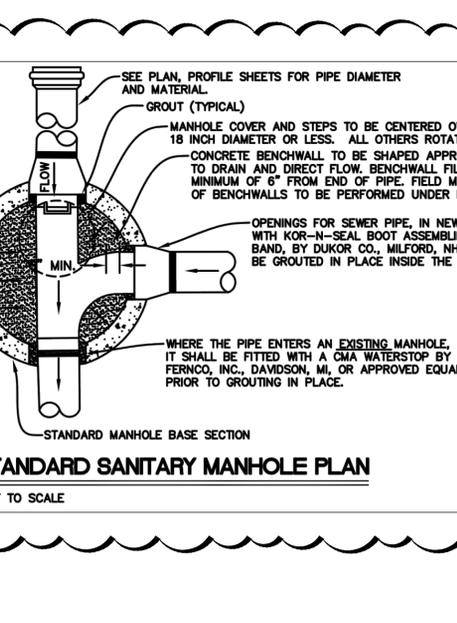

STANDARD SANITARY MANHOLE PLAN
NOT TO SCALE

DIRECTORY PATH : R:\Active\user\Beebe\Whiteland High School\Design\CAD\Plans\Phase 1A
 FILENAME : 20230223_4188_P1A_K950
 DATE/TIME : 2/23/2023 4:08 PM / 7:05


900 SHEET

MISCELLANEOUS DETAILS

WHITELAND HIGH SCHOOL PHASE 1A

DATE: FEBRUARY 27, 2023

DESIGNED: GJI

APPROVED: GJI

JOB NO.:

DRAWN: KLF

CHECKED: TEN

DATE: FEBRUARY 27, 2023

DESIGNED: GJI

APPROVED: GJI

NO. 1120008

PROFESSIONAL ENGINEER


DATE: FEBRUARY 27, 2023

REVISION 1: 03.03.23

REVISION 2: 03.24.23


NO. 9

NO. 8

NO. 7

NO. 6

NO. 5

NO. 4

NO. 3

NO. 2

NO. 1

REVISIONS

DATE

BY





Aqua-Swirl® Polymer Coated Steel (PCS) Stormwater Treatment System




Projected View
SCALE 1:80

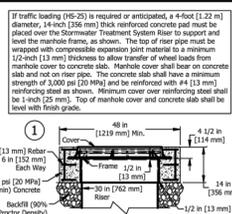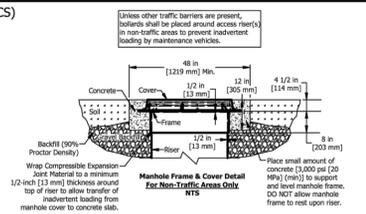


Please see accompanied Aqua-Swirl® specification notes. See Site Plan for actual system orientation. Approximate dry (pick) weight: 2000 lbs [900 kg].

- As an alternative, 42 in [1067 mm] diameter, HS-20/25 rated precast concrete rings may be substituted. 14 in [356 mm] thickness must be maintained.
- AS-4 inlet/outlet pipe size ranges from 4 in [102 mm] to 12 in [305 mm].
- AS-4 chamber height may vary from 84 in [2134 mm] to 104 in [2642 mm], depending on inlet/outlet pipe size.

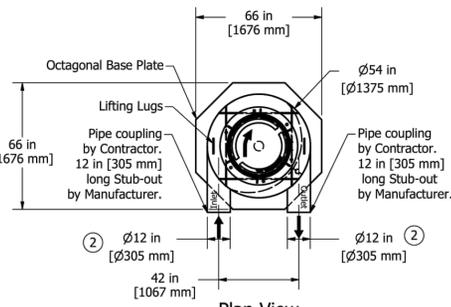

Plan View
SCALE 1:40

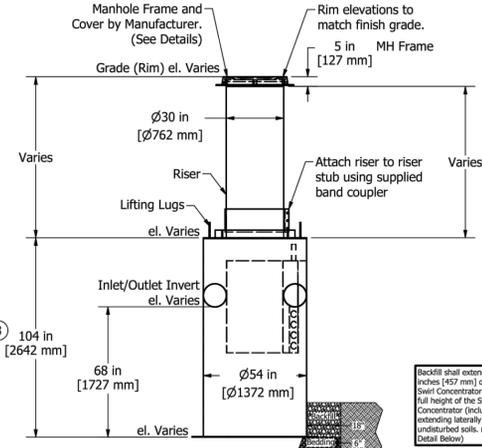



Elevation View
SCALE 1:40

AquaShield®	Aqua-Swirl® Concentrator AS-4 HorseShoe CW	Structure #:	AS-4 STD	Revised:	Rev. Date:
2733 Kanawha Drive, Suite 111, Chattanooga, TN 37424 Phone (888) 344-9044 Fax (423) 626-2112 www.aquashieldinc.com	Standard Detail	Drawn By:	DHarris	Scale:	As Shown
		Date:	2/25/2023		
		U.S. Patent No. 6524473 and other Patent Pending			

Aqua-Swirl® Polymer Coated Steel (PCS) Stormwater Treatment System




Projected View
SCALE 1:80

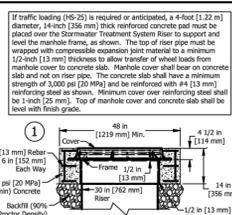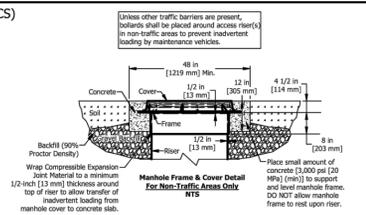


Please see accompanied Aqua-Swirl® specification notes. See Site Plan for actual system orientation. Approximate dry (pick) weight: 2200 lbs [1000 kg].

- As an alternative, 42 in [1067 mm] diameter, HS-20/25 rated precast concrete rings may be substituted. 14 in [356 mm] thickness must be maintained.
- AS-5 inlet/outlet pipe size ranges from 4 in [102 mm] to 12 in [305 mm].
- AS-5 chamber height may vary from 84 in [2134 mm] to 104 in [2642 mm], depending on inlet/outlet pipe size.

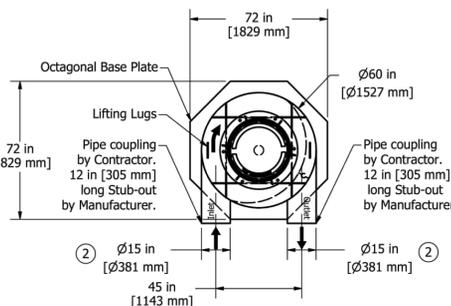


Plan View
SCALE 1:40

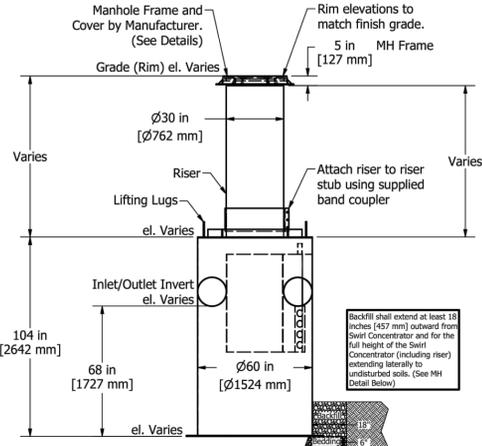


Elevation View
SCALE 1:40


AquaShield®	Aqua-Swirl® Concentrator AS-5 HorseShoe CW	Structure #:	AS-5 STD	Revised:	Rev. Date:
2733 Kanawha Drive, Suite 111, Chattanooga, TN 37424 Phone (888) 344-9044 Fax (423) 626-2112 www.aquashieldinc.com	Standard Detail	Drawn By:	DHarris	Scale:	As Shown
		Date:	2/25/2023		
		U.S. Patent No. 6524473 and other Patent Pending			

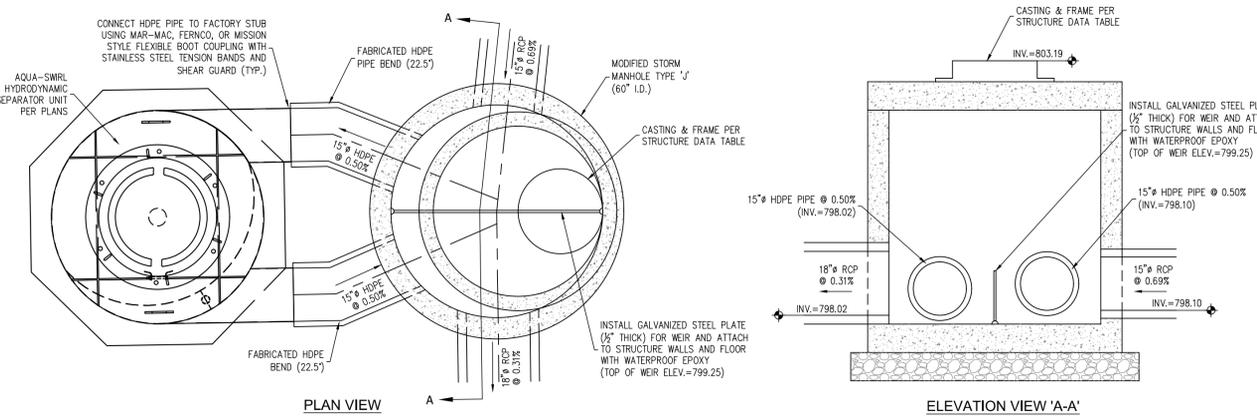


DIVERSION STRUCTURE DETAIL
STR. NO. 4
NOT TO SCALE

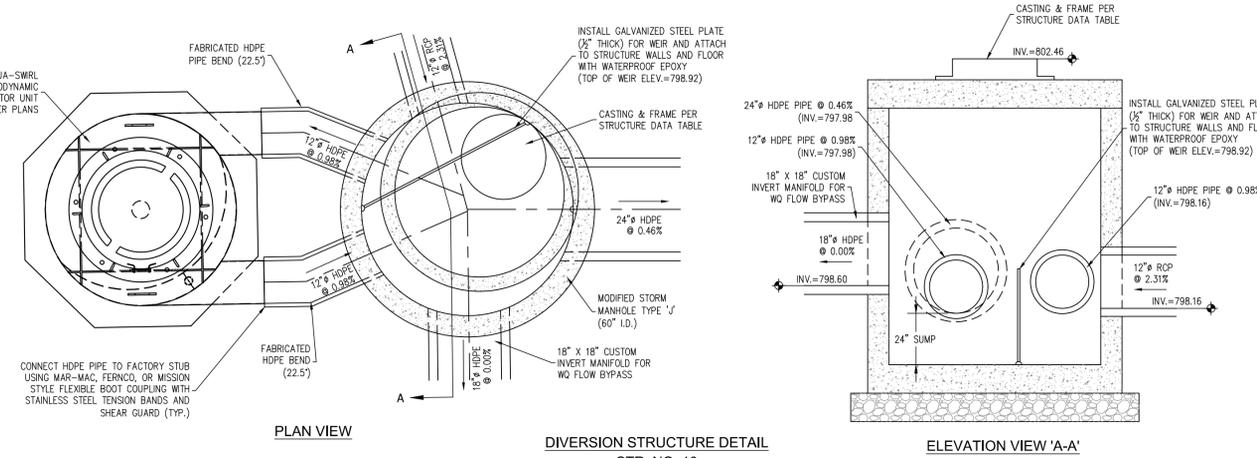

DIVERSION STRUCTURE DETAIL
STR. NO. 10
NOT TO SCALE

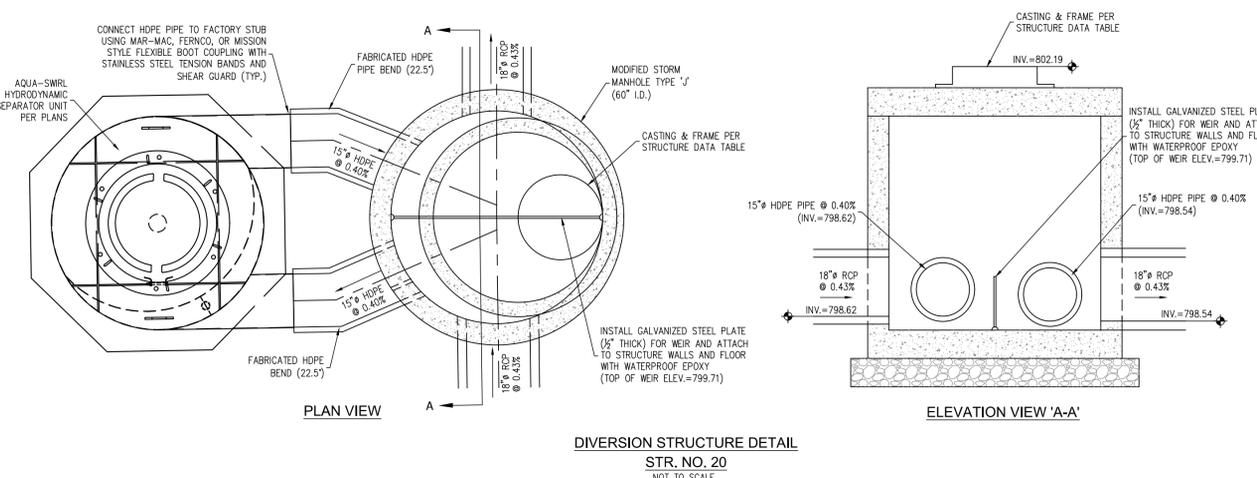

DIVERSION STRUCTURE DETAIL
STR. NO. 20
NOT TO SCALE

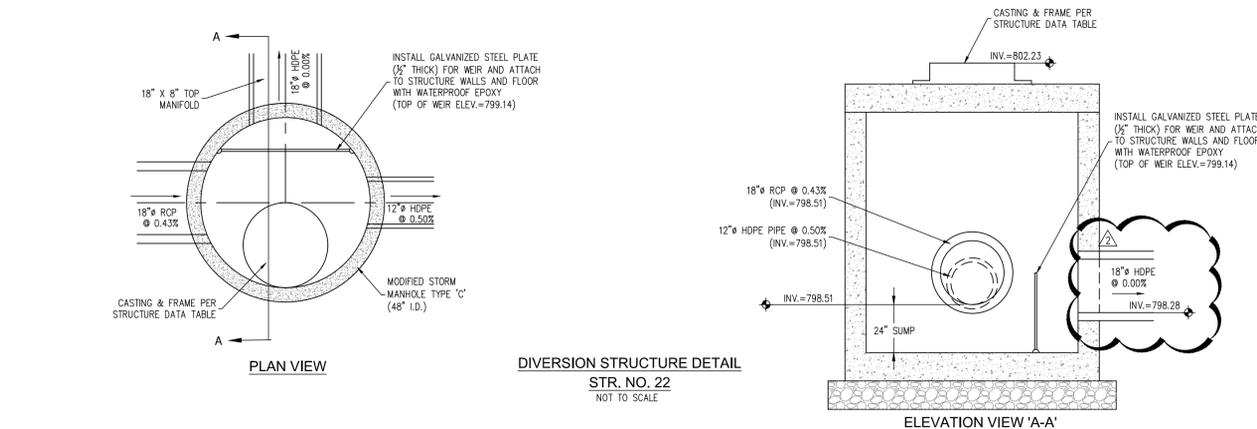

DIVERSION STRUCTURE DETAIL
STR. NO. 22
NOT TO SCALE

MISCELLANEOUS DETAILS

WHITELAND HIGH SCHOOL PHASE 1A

JOB No.	DRAWN	KLF	CHECKED	TEN	GJI
DATE	FEBRUARY 27, 2023	DESIGNED	APPR.		

901 SHEET

REVISIONS

NO.	DATE	BY	DESCRIPTION
1	03.03.23		REVISIONS PER TOWN OF WHITELAND TRC COMMENTS, UTILITY FOTHOLOG RESULTS, ADS STORMTECH REVIEW, & CBBE REVIEW
2	03.24.23		REVISIONS PER RETENTION ELEVATIONS AND OUTLET CONTROL STRUCTURE DETAIL (STR. NO. 12)

APPROVED: *[Signature]*

PROFESSIONAL ENGINEER
NO. 1120008

DIRECTORY PATH : R:\Active\Users\hbebe\Whiteland High School\Design\CAD\Phase\PHASE 1A
 FILENAME : 2322023 4.08 PM / K950
 DATE/USER :



Primary Engineering, Inc.
9785 Crosspoint Blvd., Ste. 103
Indianapolis, Indiana 46256
317-324-1221 ph
www.primary-eng.com

Addendum: **2**

Date: **03/24/2023**

Project: **Clark-Pleasant Community School Corporation
Whiteland Community High School Phase 1A**

Comm #: **22417**

The following items shall be incorporated into the specifications and drawings and are considered to be integral to the bid documents for the project. Acknowledgement of receipt of this addendum is required on the bid form.

Item #1: Drawing Sheet ES101

A. Exterior Light Fixture Schedule:

- SL1: Revise Streetworks fixture to be the following: STREETWORKS #VERD-M-CA3-160-740-HV-T4-A15-XX-MS/DIM-L40 WITH #SSA4T30W-XX-1-FGV
- SL1-HS: Revise Streetworks fixture to be the following: STREETWORKS #VERD-M-CA3-160-740-HV-T4-A15-XX-HSS-MS/DIM-L40 WITH #SSA4T30W-XX-1-FGV
- SL1: Revise Streetworks fixture to be the following: STREETWORKS #VERD-M-CA3-160-740-HV-T5-A15-XX-MS/DIM-L40 WITH #SSA4T30W-XX-1-FGV